


500 Carteret Street  
As Built  
Beaufort, SC, 29902

Prepared for  
Parker Barnes  
500 Carteret Street  
Beaufort, SC, 29902  
843-522-2600

This drawing and design in paper and electronic format are the property of P. Barnes. Any use of the drawing, design or electronic file without written consent from P. Barnes is subject to legal action. All Copyrights Apply.

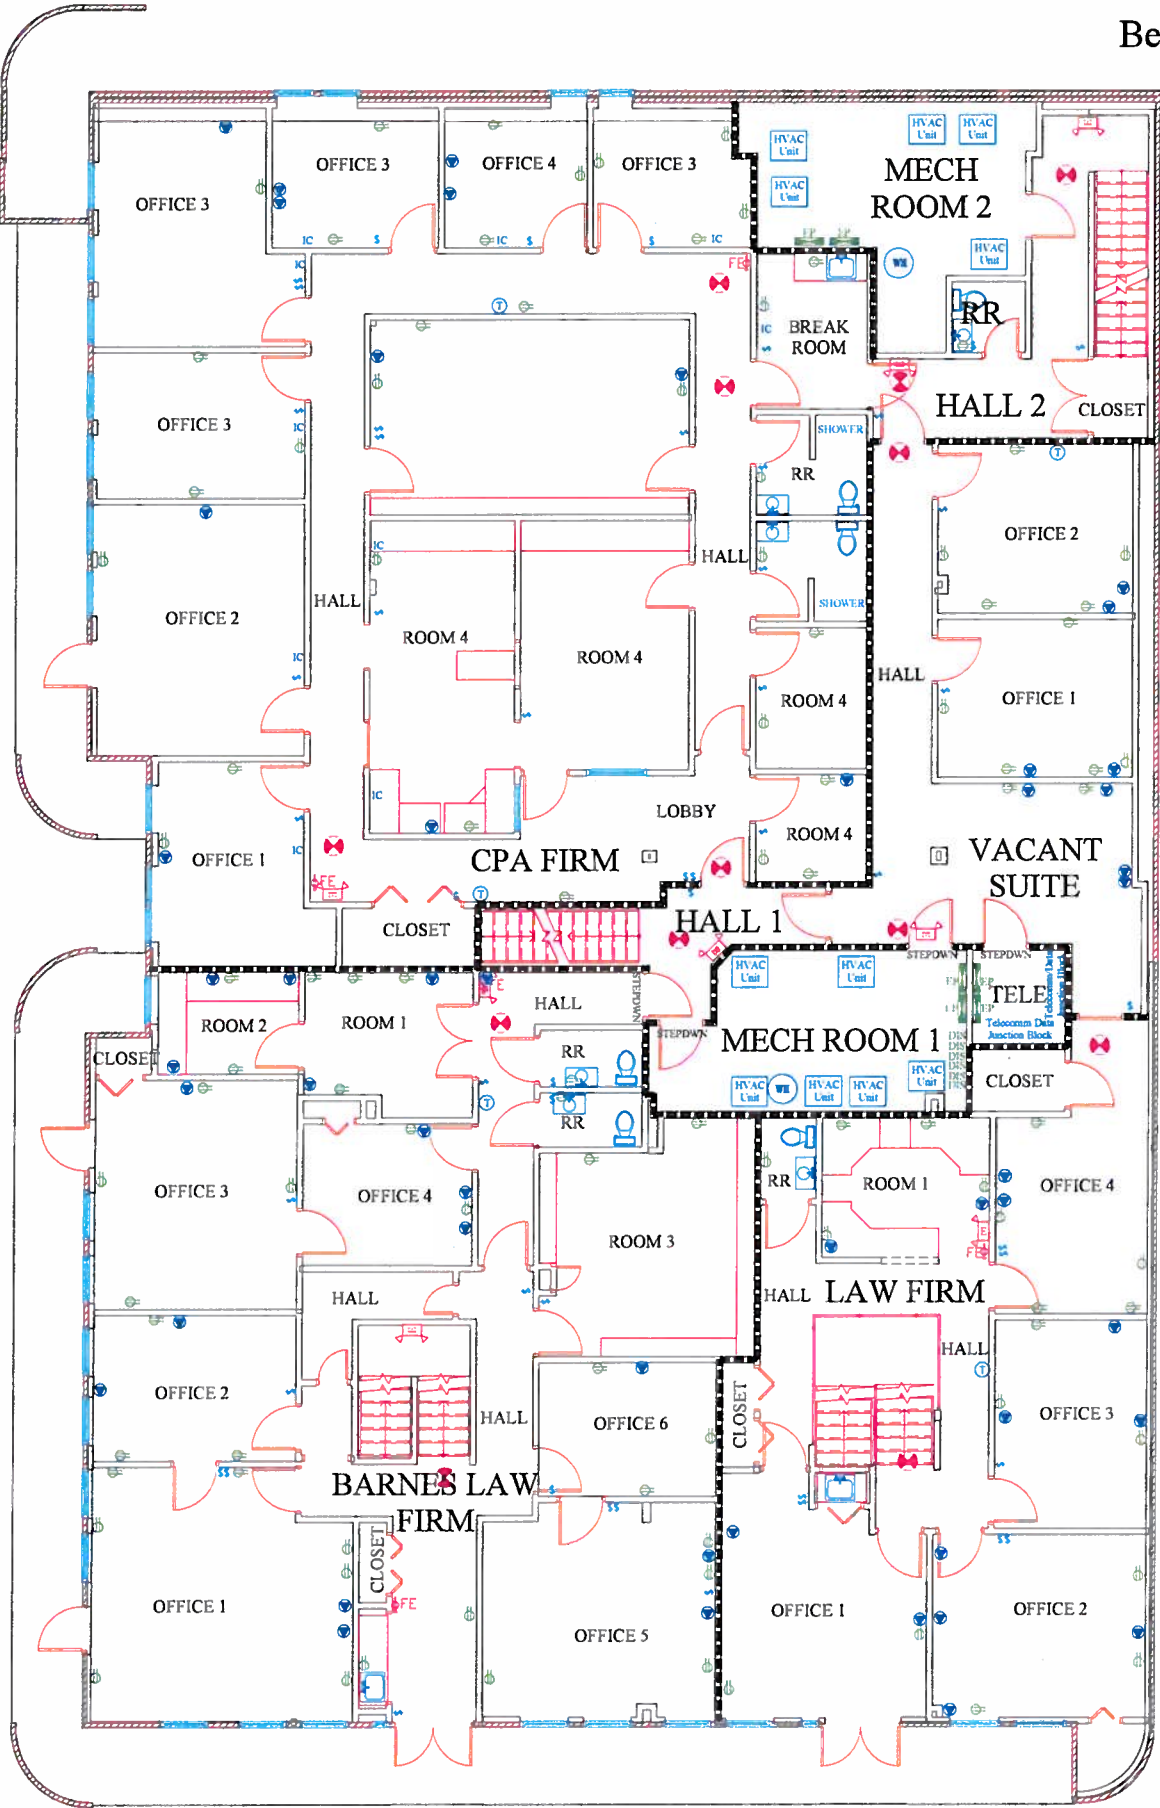

- Symbol Legend**
- \$ - Standard Single Pole Switch
  - ⊕ - Standard 110v Outlet
  - - Voice/Data
  - CTV - CTV Connection
  - T - Tstat
  - EP - Electrical Panel
  - PNL Misc Panel
  - ⊠ - HVAC Return
  - ⊠ - HVAC Supply
  - ⊕ - Recessed Can Fixture
  - ⊕ - 2' x 2' Fluorescent Light Fixture
  - ⊕ - 2' x 4' Fluorescent Light Fixture
  - - Surface Mount Light Fixture
  - ⊠ - Exhaust Fan
  - ⊗ - Ceiling Fan
  - ⊠ - Emergency Lighting
  - ⊠ - Exit Sign
  - MS - Motion Sensor
  - CAM - Camera
  - FP - Emergency Fire Pull
  - FE - Fire Extinguisher
  - ⊕ - Water Fountain
- Wall Legend**
- Existing Wall
  - Demising Wall

# 500 Carteret Street As Built Beaufort, SC, 29902

Prepared for  
Parker Barnes  
500 Carteret Street  
Beaufort, SC, 29902  
843-522-2600

This drawing and design in paper and electronic format are the property of P. Barnes. Any use of the drawing, design or electronic file without written consent from P. Barnes is subject to legal action. All Copyrights Apply.

