


1 A1.1a ACADAMIC CLASSROOM BUILDING - FLOOR PLAN
Scale: 1/8" = 1'-0"

REFER TO SHEET A1.1b FOR GENERAL NOTES, TAG NOTES, AND SYMBOLS LEGEND.

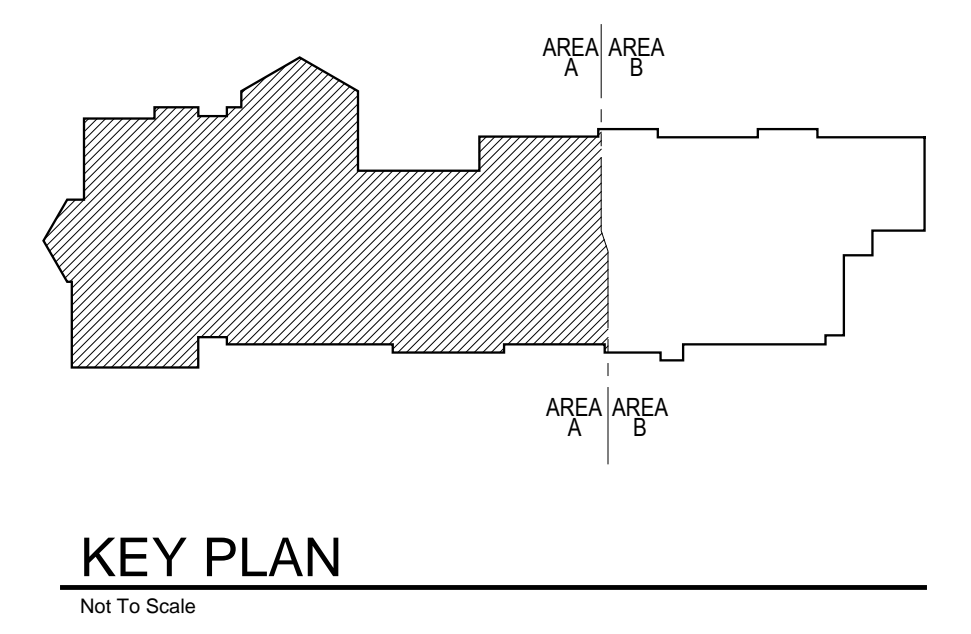

Tate Hill Jacobs Architects
346 East Main Street • Lexington • Kentucky • 40507
Telephone 859 • 252 • 5994 Facsimile 859 • 253 • 1607

RECORD DRAWINGS

Academic Classroom Building Floor Plan - Area "A"
FAYETTE COUNTY PUBLIC SCHOOLS
Locust Trace Agriscience Farm
3591 Leesstown Road Lexington, KY 40511

Proj. #: 0901
Date: 06.08.2012
Drawn: EEF, MFI
Checked: SSH
Revised:

A1.1a