

REQUEST FOR PROPOSALS

Adaptive Reuse of Care1st Avondale Resource Center

NFS 20-055

Addendum No. 4

Date: August 3, 2020

From: Jill Lin, Senior Buyer

Subject: Addendum No. 4 to Solicitation No. NFS 20-055









Bid Deadline: August 5, 2020 5:00 p.m. (local time, Phoenix, Arizona)

PURPOSE

This Addendum forms a part of the Contract and clarifies, corrects, or modifies the original Invitation for Bids document prepared by the City of Avondale. Acknowledge receipt of this Addendum in the space provided on the attached “Acknowledgment of Addenda Received” form; this acknowledgement must accompany the submitted bid. Failure to do so may subject the bidder to disqualification.

This Addendum No. 4 consists of the Center floor plan, please see Exhibit A – Floor Plan.


Exhibit A - Floor Plan

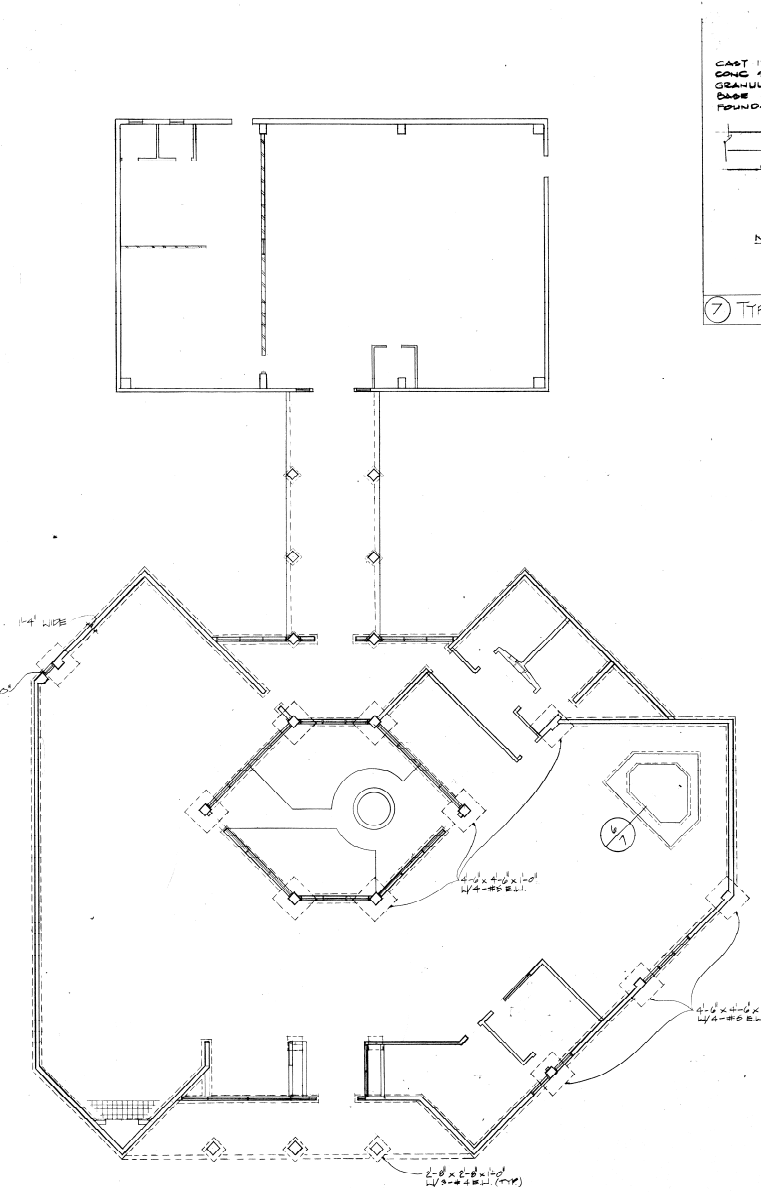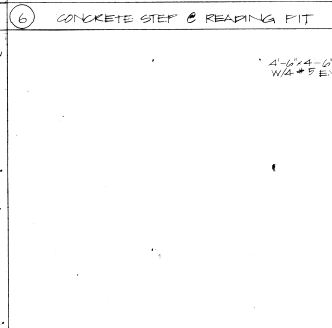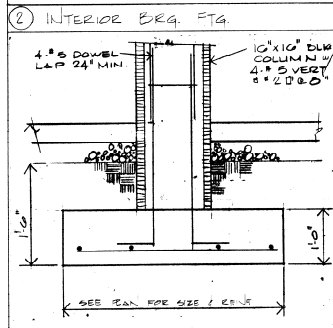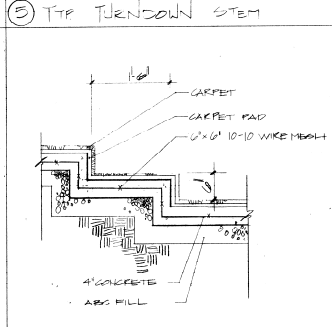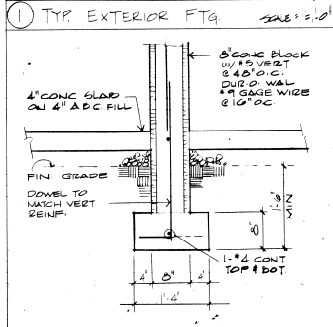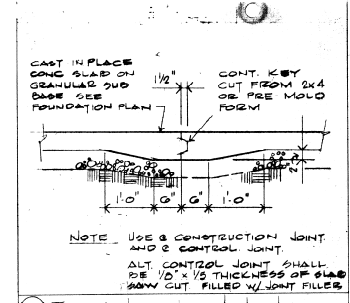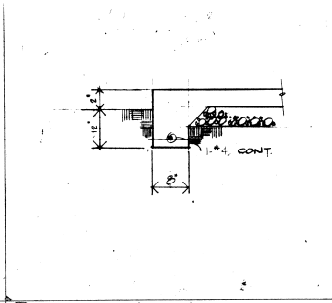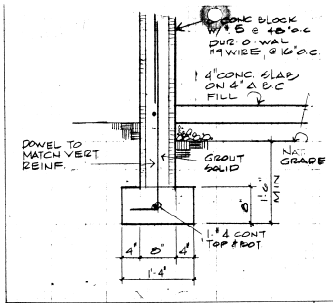

FOUNDATION PLAN
SCALE: 1/8" = 1'-0"

(4) BLOCK PLASTER

Exhibit A – Floor Plan

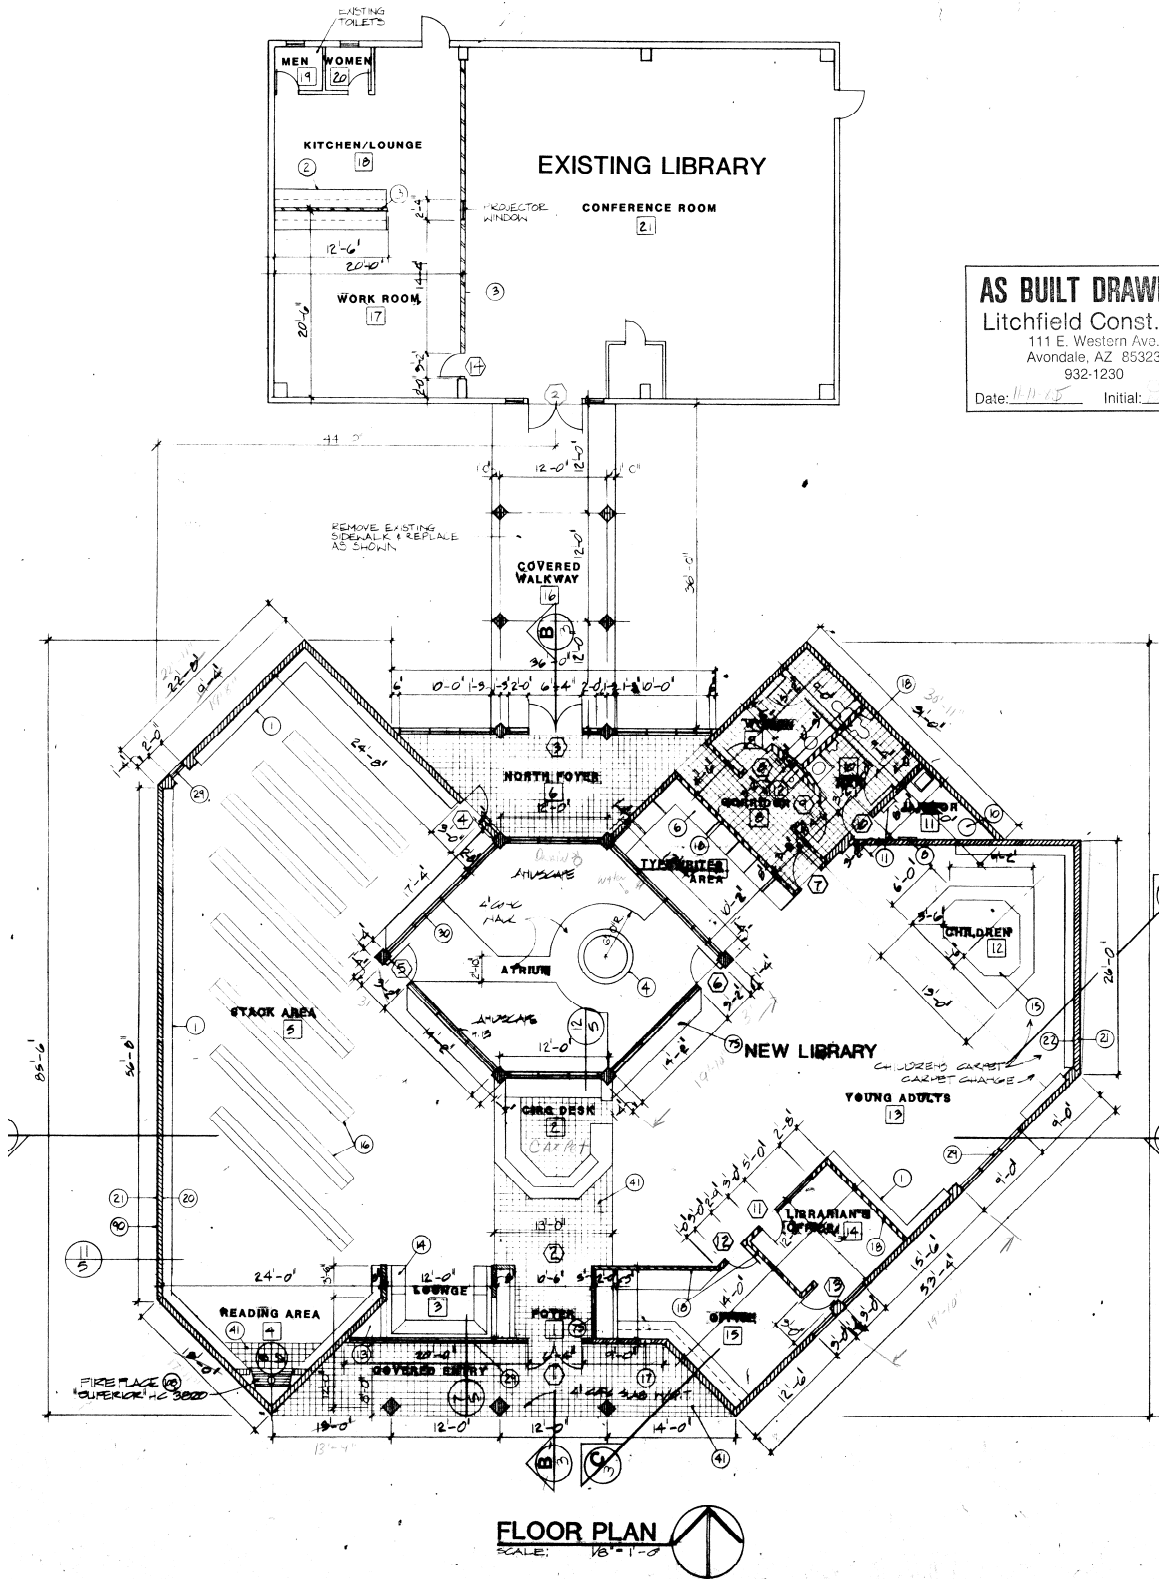

AS BUILT DRAWING
 Litchfield Const.
 111 E. Western Ave.
 Avondale, AZ 85323
 932-1230
 Date: 11.11.15 Initial: [Signature]

FLOOR PLAN
 SCALE: 1/8" = 1'-0"

**CITY OF AVONDALE
ACKNOWLEDGMENT OF ADDENDA RECEIVED
REQUEST FOR PROPOSALS**

Adaptive Reuse of Care1st Avondale Resource Center

NFS 20-055

Addendum No. 4

_____, affirms that ADDENDUM No. 4 has been
(Name of Vendor/Designee)
received and that the information contained in ADDENDUM No. 4 has been incorporated in
formulating the Vendor's Offer.

_____, _____ 2020
Signed Date

Print Name

Title

Company Name

Address

City, State, Zip Code

END OF ADDENDUM No. 4