


DEMOLITION PLAN
SCALE: 1/8" = 1'-0"

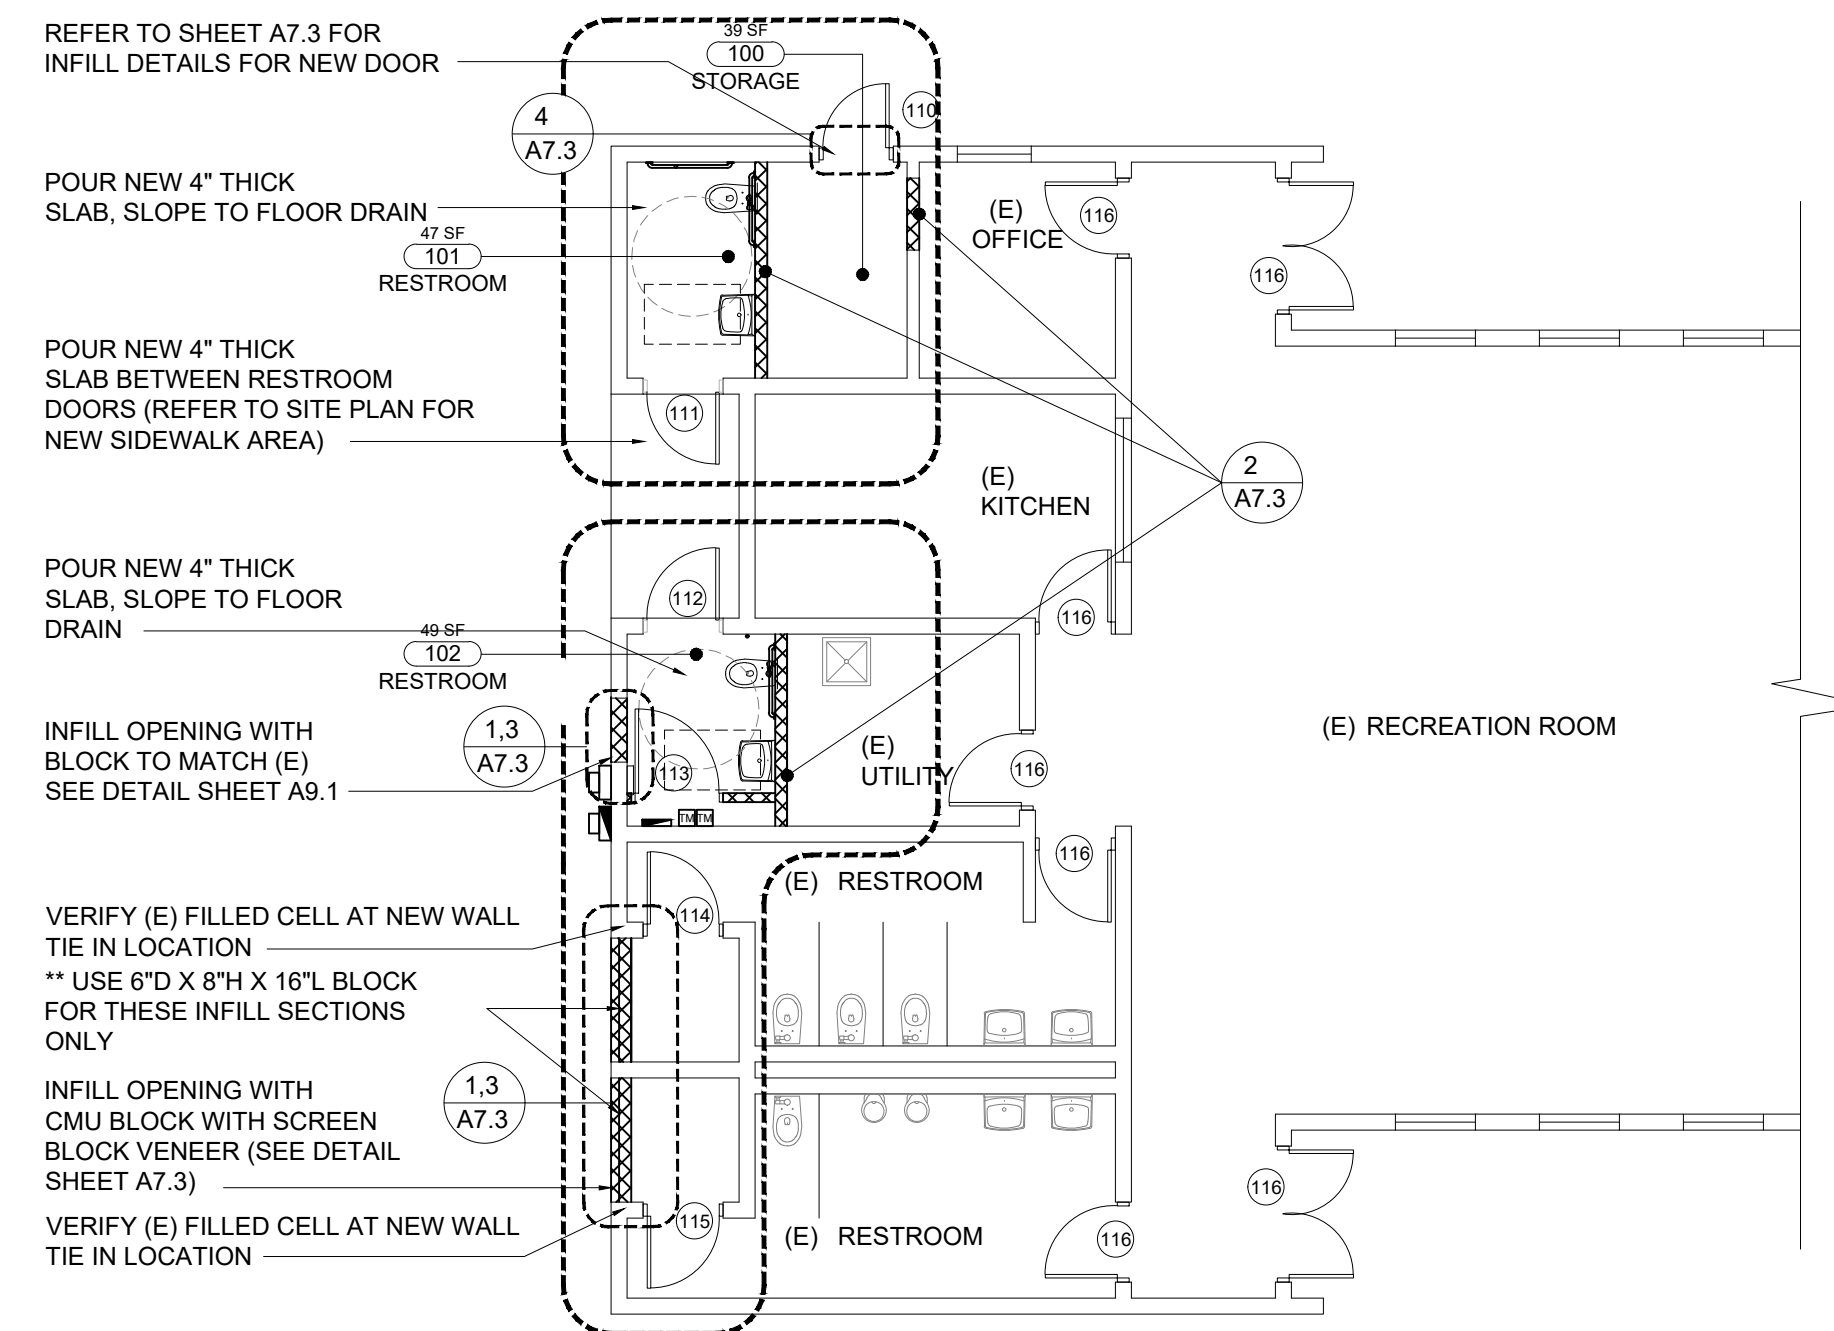

FLOOR PLAN
SCALE: 1/8" = 1'-0"

ISSUE	DATE
BID SET	4.24.19
ADDENDUM 1	5.10.19

DEMOLITION LEGEND

- EXISTING NON-RATED WALL TO REMAIN
- EXISTING DOOR ASSEMBLY TO REMAIN
- WALL TO BE DEMOLISHED BY CONTRACTOR

DEMOLITION NOTES

- EXTENT OF DEMOLITION WORK IS INDICATED ON DRAWINGS.
- PROTECT FROM DAMAGE EXISTING FINISH WORK THAT IS TO REMAIN IN PLACE AND BECOMES EXPOSED DURING DEMOLITION OPERATIONS.
- CLEAN UP AND REPAIR: UPON COMPLETION OF DEMOLITION WORK, REMOVE TOOLS, EQUIPMENT AND DEMOLISHED MATERIALS FROM SITE. SATISFACTORILY REPAIR DEMOLITION PERFORMED IN EXCESS OF THAT REQUIRED.
- RETURN STRUCTURES AND SURFACES TO REMAIN TO CONDITION EXISTING PRIOR TO COMMENCEMENT OF DEMOLITION WORK OR AS REQUIRED BY THESE PLANS AND ACCORDING TO SPECIFICATIONS.
- REPAIR ADJACENT CONSTRUCTION OR SURFACES SOILED OR DAMAGED BY SELECTIVE DEMOLITION. PATCH EXISTING WALLS & CEILING WHERE WALLS HAVE BEEN DEMOLISHED.


FLOOR PLAN NOTES

- FOR FLOOR PLAN DIMENSIONS REFER TO SHEET A4.1


LEGEND

- EXISTING NON-RATED WALL
- NEW CMU WALL TO MATCH (E)

DOOR TYPE

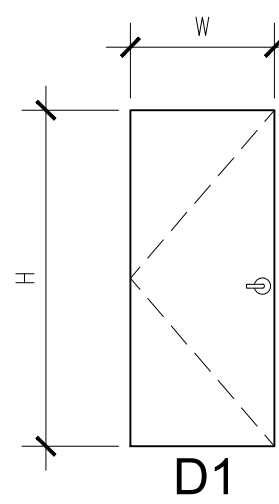

FRAME TYPE

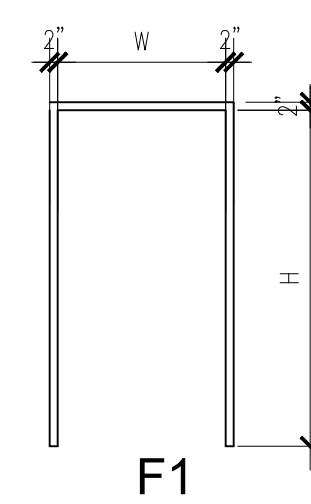

DOOR HARDWARE GROUPS

- HW-1 STOREROOM**
- 3 HINGES
 - 1 DOUBLE CYLINDER DEADBOLT
 - 1 ENTRANCE LOCKSET
 - 3 SILENCERS
 - 1 SET THERMAL GASKETING
 - 1 THRESHOLD
- HW-2 RESTROOM**
- 3 HINGES
 - 1 DOUBLE CYLINDER DEADBOLT
 - 1 ENTRANCE LOCKSET (PRIVACY FUNCTION FOR RESTROOMS)
 - 1 WALL STOP
 - 1 THRESHOLD
 - 1 THERMAL GASKET
 - 1 COAT HOOK
 - 1 10" KICK PLATE
 - 1 16"X16" LOUVER OPENING, FLUSH MOUNTED

DOOR FRAMES STEEL FRAMES, PAINTED TO MATCH WALL COLOR

HINGES: FULL MORTISE, HEAVY DUTY HINGE, SATIN STAINLESS FINISH

LOCKSET: SCHLAGE L9050 SERIES MORTISE LOCKSET (PRIMUS KEYWAYS ON ALL DOORS)

FUNCTIONALITY

- EGRESS: ALL DOORS TO BE OPERABLE FROM INSIDE (ALONG DIRECTION OF EGRESS) WITHOUT THE USE OF A KEY OR ANY SPECIAL KNOWLEDGE OR EFFORT.
- DOOR CLOSERS: SHALL BE LISTED TO ALLOW (3) SECONDS TO CLOSE FROM OPEN POSITION.
- DOOR THRESHOLDS: SHALL BE A MAXIMUM OF 1/2" HEIGHT WITH A 1:2 VERTICAL TO HORIZONTAL BEVEL PROPORTION

DOOR SCHEDULE

SYMBOL	QUANTITY	MANUFACTURER	STYLE/SERIES	DOOR TYPE	FRAME TYPE	CONFIGURATION	SIZE		U-FACTOR	HARDWARE GROUP	NOTES	FINISH NOTES
							WIDTH	HEIGHT				
110	1	TBD	SLAB	D1 (HOLLOW METAL)	F1	SINGLE / HINGED	3'-0"	6'-8"	NA	HW-1	PRIMED / PAINTED (SPRAYED) SHERWIN WILLIAMS DURATION SW6718 PLEASE PROVIDE COLOR SAMPLE FOR APPROVAL	DOOR FRAME TO MATCH BUILDING COLOR (REFER TO FINISH SCHEDULE)
111	1	TBD	SLAB	D1 (HOLLOW METAL)	F1	SINGLE / HINGED	3'-0"	6'-8"	NA	HW-2	PRIMED / PAINTED (SPRAYED) SHERWIN WILLIAMS DURATION SW6718 PLEASE PROVIDE COLOR SAMPLE FOR APPROVAL	DOOR FRAME TO MATCH BUILDING COLOR (REFER TO FINISH SCHEDULE)
112	1	TBD	SLAB	D1 (HOLLOW METAL)	F1	SINGLE / HINGED	3'-0"	6'-8"	NA	HW-2	PRIMED / PAINTED (SPRAYED) SHERWIN WILLIAMS DURATION SW6718 PLEASE PROVIDE COLOR SAMPLE FOR APPROVAL	DOOR FRAME TO MATCH BUILDING COLOR (REFER TO FINISH SCHEDULE)
113	1	TBD	SLAB	D1 (HOLLOW METAL)	F1	SINGLE / HINGED	3'-0"	6'-8"	NA	HW-1	PRIMED / PAINTED (SPRAYED) SHERWIN WILLIAMS DURATION SW6718 PLEASE PROVIDE COLOR SAMPLE FOR APPROVAL	DOOR FRAME TO MATCH BUILDING COLOR (REFER TO FINISH SCHEDULE)
114	1	TBD	SLAB	D1 (HOLLOW METAL)	F1	SINGLE / HINGED	3'-0"	6'-8"	NA	HW-1	PRIMED / PAINTED (SPRAYED) SHERWIN WILLIAMS DURATION SW6718 PLEASE PROVIDE COLOR SAMPLE FOR APPROVAL	DOOR FRAME TO MATCH BUILDING COLOR (REFER TO FINISH SCHEDULE)
115	1	TBD	SLAB	D1 (HOLLOW METAL)	F1	SINGLE / HINGED	3'-0"	6'-8"	NA	HW-1	PRIMED / PAINTED (SPRAYED) SHERWIN WILLIAMS DURATION SW6718 PLEASE PROVIDE COLOR SAMPLE FOR APPROVAL	DOOR FRAME TO MATCH BUILDING COLOR (REFER TO FINISH SCHEDULE)
116	1	EXISTING	SLAB	D1 (HOLLOW METAL)	F1	EXISTING	VARIES		NA	EXISTING	PRIMED / PAINTED (SPRAYED) SHERWIN WILLIAMS DURATION SW6718 PLEASE PROVIDE COLOR SAMPLE FOR APPROVAL	DOOR FRAME TO MATCH BUILDING COLOR (REFER TO FINISH SCHEDULE)

SCALE: AS NOTED
DRAWN: BCC
CHECKED: BCC
PROJECT NO: 2019-010

BUILDING REMODEL, SITE IMPROVEMENTS AND PAVILIONS FOR SUNNYLAND PARK

825 WASHINGTON ST.
DAYTONA BEACH, FL
32114