



2020377.05

ADDENDUM No. 1

March 7, 2023

to

BID DOCUMENTS dated 02/06/2023

for

CITY OF CANTON – SANITATION BUILDING PROJECT – GP 1376

2801 REGENT AVE. NE

CANTON, OH 44705

- A. The original bidding documents for the above referenced project are hereby amended as noted in this Addendum.
- B. This Addendum supersedes and takes precedence over information provided prior to the date of this Addendum.

RECEIVED QUESTIONS AND RESPONSES:

- 1. *Question: The bid form does not have a line to write in the base bid price. Please advise.*
Response: The information to write the base bid price is on the very last page of the bid form.
- 2. *Question: Who pays for utility consumption?*
Response: Owner will pay for utility consumption.
- 3. *Question: Who will be required to extend the gas line along Regent; Dominion or GC?*
Response: The service line extension for the gas line is the responsibility of the contractor.
- 4. *Question: Who pays for testing?*
Response: The Owner has engaged GPD Group for geotechnical engineering and construction material testing for the project. It will be the responsibility of the contractor to contact GPD Group for testing during construction. The Owner will pay for the testing.
- 5. *Question: The specifications on drawing C-132, Note E, state "THE INCOMING POWER SHALL BE 120/208 VOLTS, 3 PHASE 60 HERTZ." However, the pump schedule on drawing C-133, upper right-hand corner, states the voltage is 208 and single phase. Please advise which electrical properties are required for this project.*
Response: Three phase.
- 6. *Question: Allow Simplex as fire alarm system manufacturer.*
Response: This is acceptable.
- 7. *Question: Section 27 11 00 2.4C says 18" ladder rack and print T-103 says 12" ladder. What size?*
Response: Provide 18" as called for in 27 11 00 2.4C. Note T7 on sheet T103 will be changed to 18" for the conformed document set.



8. *Question: Looking for information as to where the wall tile is in rooms 112 & 113? Is there an elevation?*
Response: Information on tile location/extents can be found in the room finish schedule on I-601, and I-109. Installation pattern of the tile can be found in the material schedule on I-601.
9. *Question: What is the depth of the existing salt dome foundation to be demolished?*
Response: See attached wall section of the largest salt dome showing a 3'-4" deep foundation. The other (2) salt dome foundation depths are unknown; but from a bidding standpoint assume 4'-0".
10. *Question: C131 has a note 213 where the new sanitary meets the existing line at Regent Ave. However, coded notes do not specify what note 213 is intended to mean.*
Response: The keynote 215 is tagged at the connection of proposed sanitary to existing sanitary manhole. Keynote updated to see proposed profile on Sheet C-131 for connection information.
11. *Question: The proposed gravel berm seems to have note 2 (flush curb) next to everywhere except for the curved area in the Northeast corner of the parking lot by Regent Ave. Do I need flush curb there as well? Page C111.*
Response: Flush curbing is not required here.
12. *Question: Is the permit cost a pass-through cost back to the owner?*
Response: The City of Canton will waive city building department fees. Permits are still required but the fee is waived. All City inspections shall be coordinated/scheduled by the contractor.
13. *Question: Are the tap fees a pass back cost to the owner?*
Response: Yes. The Owner may elect to pay these directly during construction.
14. *Question: Is there somewhere on site that soil spoils can be stockpiled and left?*
Response: If there are clean spoils, accommodations will be made on-site. Coordination with the Owner is required to determined how much of the spoils can be located on-site and where they can be located.

SUBSTITUTION REQUEST:

Specification 10 21 13.17 – Phenolic-Core Toilet Systems; Scranton Products is an acceptable manufacturer. Product shall meet or exceed the quality and performance characteristics of the product listed in the specification and drawings.

Specification 10 51 13 – Metal Lockers; Scranton Products is NOT an acceptable manufacturer for metal lockers and benches.

Specification 13 34 19 – Metal Building Systems; Iron City Structures is an acceptable manufacturer. Product shall meet or exceed the quality and performance characteristics of the product listed in the specification and drawings.

Specification 31 66 13 - Rammed Aggregate Piers; Vibro Stone Columns are similar in concept to rammed aggregate piers. GPD takes no objections to this substitution



request, but just like rammed aggregate piers this is a designated design feature and the bidder shall meet the requirements we outlined relative to maximum settlement and minimum allowable bearing capacity in the specification.

SPECIFICATION REVISIONS:

1. 00 31 26 EXISTING HAZARDOUS MATERIAL INFORMATION
 - a. Added "Three Salt Domes" asbestos report.
2. 10 21 13.17 PHENOLIC-CORE TOILET COMPARTMENTS
 - a. Revised surface-burning characteristics: must meet NFPA 286 requirements.
 - b. Removed Bobrick Washroom Equipment, Inc. as manufacturer.
 - c. Added Scranton Products as manufacturer.
 - d. Added Hadrian Solutions ULC as manufacturer.
3. 28 46 21.11 Addressable Fire Alarm Systems
 - a. Added Simplex as a manufacturer.

DRAWING REVISIONS:

1. TS-001 TITLE SHEET
 - a. Added sheet C-013 SWPP DETAILS to the drawing index.
2. C-011 SWPP PLAN
 - a. Added Construction Sequence Note 1.1
 - b. Added Bioretention and Topsoil Stockpile boxed note.
 - c. Added Sediment Basin
3. C-012 WATER QUALITY PLAN
 - a. Updated Bioretention soil media notes #3.
 - b. Revised Plan Elevation G.
 - c. Added Bioretention Filter Media Drawdown Calculations.
 - d. Revised plan bioretention callouts.
4. C-013 SWPP DETAILS
 - a. Added sheet
5. C-101 DEMOLITION PLAN
 - a. Removed Catch Basin.
 - b. Revised Plan Keynote #4.
6. C-111 SITE PLAN
 - a. Revised Motorized Gates and motor location.
 - b. Revised keynotes #15 and #16.
 - c. Added Proposed Catch Basin.
 - d. Curbing from Garage door changed to being Flush curb until 6' curb taper by flag pole.
7. C-121 GRADING PLAN



- a. Revised Drive on the west side of bioretention to drain back towards the proposed bioretention basin.
 - b. Grading updated at east side gate for flush curbing.
- 8. C-122 GRADING ENLARGEMENT
 - a. Revised curbing at garage to show flush curbing.
- 9. C-131 UTILITY PLAN
 - a. Added proposed ODOT 2-2A catch basin with a window on north side.
 - b. Revised OW-1 to add callout for detail on sheet C-503.
 - c. Updated proposed domestic water to be 4".
 - d. Updated domestic and fire line to be tapped off existing main at north side with a tee and separate lines run to proposed connections at the building. All associated keynotes revised.
 - e. Added note #6 to Utility crossing notes.
 - f. Keynote updated to see proposed profile on Sheet C-132 for connection information.
- 10. C-132 SANITARY PUMP STATION NOTES AND PLAN
 - a. Updated Oil and Water Separator to be 2500 Gallon in callout.
- 11. C-133 SANITARY PUMP STATION PLAN AND DETAILS
 - a. Additional 1.5" ball valve added to valve vault to allow for future forcemain by-pass.
- 12. C-502 DETAILS
 - a. Added A3 Temporary Sediment Basin detail.
- 13. C-503 CITY WATER AND COUNTY SANITARY DETAILS
 - a. Added grease trap detail for general sizing purposes.
 - b. Added City of Canton acceptable water service materials list.
- 14. C-504 DETAILS
 - a. Added Motorized Gate details.
- 15. A-102 ENLARGED OFFICE PLAN
 - a. Changed window tag to SF-4 at Mike's Office 108
 - b. Changed window tag to SF-8 at Meeting Room 116
- 16. A-201 EXTERIOR ELEVATIONS
 - a. Changed window tag to SF-4 Drawing D1
- 17. A-202 EXTERIOR ELEVATIONS
 - a. Changed window tag to SF-8 Drawing B1
- 18. A-302 BUILDING SECTIONS
 - a. Changed window tag to SF-8 Drawing C1
- 19. A-352 WALL SECTIONS
 - a. Changed window tag to SF-8 Drawing A2
 - b. Changed window tag to SF-4 Drawing A5



20. A-603 WINDOW ELEVATIONS

- a. Added window elevation SF-8 Drawing B3

21. A-604 WINDOW DETAILS

- a. Added window sill detail Drawing A3
- b. Added window jamb detail Drawing B3
- c. Modified window sill detail Drawing C1

22. ES-101 ELECTRICAL SITE PLAN

- a. Adjusted motorized gate locations and associated coded notes.
- b. Revised lift station voltage.

23. E-102 ENLARGED LIGHTING PLANS – OFFICE, WASH BAY, FIRE PUMP RM

- a. Added notes for receptacle control in the interior lighting control scheme.

24. E-202 ENLARGED POWER PLAN – OFFICES

- a. Added designations for receptacle control in offices and conference rooms.
- b. Added associated coded note for receptacle control.

25. E-601 ELECTRICAL SINGLE LINE DIAGRAM

- a. Revised source for lift station.

26. E-602 ELECTRICAL PANELBOARD SCHEDULES

- a. Revised source for lift station.

27. Plumbing and Mechanical Sheets (FP-101, M-601, P-501, P-703)

- a. Misc. revisions

ATTACHMENTS:

1. Specifications

- a. 00 31 26 Existing Hazardous Material Information – SHED Only
- b. 10 21 13.17 Phenolic-Core Toilet Compartments
- c. 28 46 21.11 Addressable Fire-Alarm Systems

2. Drawings

- a. TS-001
- b. C-011
- c. C-012
- d. C-013
- e. C-101
- f. C-111
- g. C-121
- h. C-122
- i. C-131
- j. C-132
- k. C-133
- l. C-502
- m. C-503
- n. C-504
- o. A-102
- p. A-201



- q. A-202
 - r. A-302
 - s. A-352
 - t. A-603
 - u. A-604
 - v. FP-101
 - w. M-601
 - x. P-501
 - y. P-703
 - z. ES-101
 - aa. E-102
 - bb. E-202
 - cc. E-601
 - dd. E-602
3. Other
- a. Pre-Bid Meeting Minutes and Sign-In Sheet.
 - b. Salt Dome Section

END OF ADDENDUM

DOCUMENT 00 31 26 - EXISTING HAZARDOUS MATERIAL INFORMATION

1.1 EXISTING HAZARDOUS MATERIAL INFORMATION

- A. This Document with its referenced attachments is part of the Procurement and Contracting Requirements for Project. They provide Owner's information for Bidders' convenience and are intended to supplement rather than serve in lieu of Bidders' own investigations. They are made available for Bidders' convenience and information, but are not a warranty of existing conditions. This Document and its attachments are not part of the Contract Documents.
- B. An existing asbestos report for Project, prepared by Pardee Environmental dated January 25, 2023, **entitled "Shed and Barn"** is available for viewing as appended to this Document.
- C. **An existing asbestos report for Project, prepared by Pardee Environmental dated February 21, 2023, entitled "Three Salt Domes" is available for viewing as appended to this Document.**
- D. Related Requirements:
 - 1. "Instructions to Bidders" for the Bidder's responsibilities for examination of Project site and existing conditions.
 - 2. Document 00 31 32 "Geotechnical Data" for reports and soil-boring data from geotechnical investigations that are made available to bidders.
 - 3. Section 02 41 16 "Structure Demolition" for notification requirements if materials suspected of containing hazardous materials are encountered.

END OF DOCUMENT 00 31 26



January 25, 2023

To: Rick Bodenschatz, PS
CANTON CITY ENGINEERING DEPT.

From: John Pardee, President
PARDEE ENVIRONMENTAL

Re: Environmental Screening Inspection Report:
Shed and barn
2436 30th St. NE.
Canton, Ohio 44705

Mr. Bodenschatz,

As per your request, Pardee Environmental conducted an environmental screening and an asbestos inspection on January 18, 2023 on the identified barn and shed at the above listed address. Below and attached are the findings.

- **Scope of work:** Two buildings were assessed for environmental issues in advance of their planned demolition. One was a 9x7 wooden shed and the other was a 30x21 wood and metal barn.
- **Shed:** I inspected the shed and found it to be fairly modern construction and based on my observations, no samples were collected from this structure. It is a simple wood framed and sided building with the only interior finishes being the peal & stick floor tile. The roofing is made of asphalt shingles. I have never found peal & stick floor tile to be an asbestos containing material (ACM) and the EPA allows all flooring to remain in the building during demo, regardless of asbestos content, as long as the material is not burned, abraded or purposefully pulverized. Same goes for asphalt roofing that is still pliable, as in this case, making it a non-friable roofing material which can also stay on the building during demo with the same caveats as the floor tile. We inspected the core material of the door since it is a fire-rated door and we did not find anything other than a wood composite fill. The demo contractor should simply list both the floor tile (63 sq. ft.) and the roofing (80 sq. ft.) as Presumed ACM's (PACM's) on the demolition notice to the EPA. The EPA does not allow refrigerant containing equipment to remain in buildings to be demolished so the wall-mounted AC unit will have to be removed prior to demo. It can be reused, sold or disposed of at a facility that will reclaim the refrigerant. Although the two florescent light fixtures appear quite modern, I would recommend they too be removed and reused or recycled prior to demo.
- ~~**Barn:** The barn was found to be framed with old log beams and joists with metal cladding on the sides and roof. The metal was inspected and found to be rusting indicating the absence of lead in the alloy nor was there any fibrous material on or in the siding eliminating the concerns about these materials being "Metal-bestos" products. The interior has a concrete floor with an 18x4 foot trench in the center with a dirt floor bottom. The dirt appeared on the surface to be clean and dry with no visible staining or odor. Using a 4-inch diameter hand auger, we advanced two borings to an approximate depth of 4 feet, one in either end of the trench. We found no discoloration, staining, odor or liquid that wasn't groundwater. The only finding of note was~~

~~from the sample on the east end of the trench where we noted some bits of coal at the surface. Coal is not a regulated material. Both samples were found to be primarily clean native soil so the decision was made to forego the collection and analysis of the soils in the trench. The only suspect ACM's found in the barn was the window glazing on the two lower westward facing windows. Both were sampled and the samples were submitted to EMSL Analytical in Indianapolis, IN for analysis. One sample was found to not contain asbestos while the other was found to contain less than 1% Chrysotile asbestos which, by EPA definition, is not a regulated amount of asbestos. In conclusion, there are no environmental encumbrances or issues relating to the demolition of this structure and the demo contractor is free to file their notice of intent to demo with the EPA as is required by law for the demolition of commercial buildings.~~

Regards,



John P. Pardee, President
Pardee Environmental
Asbestos Hazard Evaluation Specialist Cert. #ES3201

Attachments: Lab report and chain-of-custody
Site photos
State certifications

QUALITY CONTROL
SAMPLE TRANSMITTAL
CHAIN - OF - CUSTODY FORM

162301532

X Regular Rush Results needed by: 3 day TATSamples taken at: 2436 30th St., Canton, OHType of samples: Bulk Analysis requested: PLM/Point Count as per agreement

SAMPLE #	SAMPLE DESCRIPTION	SAMPLE LOCATION
A-1	Window glazing	Barn
A-2	Window glazing	Barn


TRANSFERAL RECORD

Relinquished by: John Pardee Relinquished to: Date: 01-18-23
Relinquished by: Relinquished to: Date:
Sent by courier: FedEx (indicate type)

hfenise farrell 1/20/23 9:40 AM EX

PARDEE ENVIRONMENTAL, 47391 Garfield Road, Oberlin, Ohio 44074

Email: jpincenv@gmail.com || Phone: (440) 315-2735

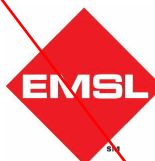

EMSL Analytical, Inc.

6340 CastlePlace Dr. Indianapolis, IN 46250

Tel/Fax: (317) 803-2997 / (317) 803-3047

<http://www.EMSL.com> / indianapolislaboratory@emsl.com

EMSL Order: 162301532

Customer ID: JPCI50

Customer PO:

Project ID:

Attention: John Pardee

JP ENVIRONMENTAL CONSULT, INC.

47391 Garfield Road

Oberlin, OH 44074

Phone: (440) 315-2735

Fax: (440) 984-3145

Received Date: 01/20/2023 9:46 AM

Analysis Date: 01/25/2023

Collected Date:

Project: 2436 30th St., Canton, OH

Test Report: Asbestos Analysis of Bulk Materials via AHERA Method 40CFR 763 Subpart E Appendix E supplemented with EPA 600/R-93/116 using Polarized Light Microscopy

Sample	Description	Appearance	Non-Asbestos		Asbestos
			% Fibrous	% Non-Fibrous	% Type
A-1 162301532-0001	Barn - Window Glazing	White Non-Fibrous Homogeneous		100% Non-fibrous (Other)	<1% Chrysotile
A-2 162301532-0002	Barn - Window Glazing	Tan Non-Fibrous Homogeneous		100% Non-fibrous (Other)	None Detected

Analyst(s)

Paul Rihm (2)

Asbestos Laboratory Manager
or Other Approved Signatory

EMSL maintains liability limited to cost of analysis. Interpretation and use of test results are the responsibility of the client. This report relates only to the samples reported above, and may not be reproduced, except in full, without written approval by EMSL. EMSL bears no responsibility for sample collection activities or analytical method limitations. The report reflects the samples as received. Results are generated from the field sampling data (sampling volumes and areas, locations, etc.) provided by the client on the Chain of Custody. Samples are within quality control criteria and met method specifications unless otherwise noted. The above analyses were performed in general compliance with Appendix E to Subpart E of 40 CFR (previously EPA 600/M4-82-020 "Interim Method") but augmented with procedures outlined in the 1993 ("final") version of the method. This report must not be used by the client to claim product certification, approval, or endorsement by NVLAP, NIST or any agency of the federal government. Non-friable organically bound materials present a problem matrix and therefore EMSL recommends gravimetric reduction prior to analysis. Unless requested by the client, building materials manufactured with multiple layers (i.e. linoleum, wallboard, etc.) are reported as a single sample. Estimation of uncertainty is available on request.

Samples analyzed by EMSL Analytical, Inc. Indianapolis, IN NVLAP Lab Code 200188-0, AZ0939, CA 2575, CO AL-15132, TX 300262

Initial report from: 01/25/2023 09:53:14



EMSL Analytical, Inc.

6340 CastlePlace Dr. Indianapolis, IN 46250

Phone/Fax: (317) 803-2997 / (317) 803-3047

<http://www.EMSL.com> / indianapolislaboratory@emsl.com

EMSL Order: 162301532

Customer ID: JPC150

Customer PO:

Project ID:

Attention: John Pardee
JP ENVIRONMENTAL CONSULT, INC.
47391 Garfield Road
Oberlin, OH 44074

Phone: (440) 315-2735
Fax: (440) 984-3145
Received: 01/20/2023 9:46 AM
Analysis Date: 01/25/2023
Collected:

Project: 2436 30th St., Canton, OH

Test Report: Asbestos Analysis of Bulk Materials via AHERA Method 40CFR 763 Subpart E Appendix E supplemented with EPA 600/R-93/116 using Polarized Light Microscopy. Quantitation using 400 Point Count Procedure

Sample	Description	Appearance	Non-Asbestos		Asbestos
			% Fibrous	% Non-Fibrous	% Type
A-1 162301532-0001	Barn - Window Glazing	White Non-Fibrous Homogeneous		99.75% Non-fibrous (Other)	0.25% Chrysotile

Analyst(s)

Paul Rihm (1)

Asbestos Laboratory Manager
or other approved signatory

EMSL maintains liability limited to cost of analysis. Interpretation and use of test results are the responsibility of the client. This report relates only to the samples reported above, and may not be reproduced, except in full, without written approval by EMSL. EMSL bears no responsibility for sample collection activities or analytical method limitations. The report reflects the samples as received. Results are generated from the field sampling data (sampling volumes and areas, locations, etc.) provided by the client on the Chain of Custody. Samples are within quality control criteria and met method specifications unless otherwise noted. The above analyses were performed in general compliance with Appendix E to Subpart E of 40 CFR (previously EPA 600/M4-82-020 "Interim Method") but augmented with procedures outlined in the 1993 ("final") version of the method. This report must not be used by the client to claim product certification, approval, or endorsement by NVLAP, NIST or any agency of the federal government. Non-friable organically bound materials present a problem matrix and therefore EMSL recommends gravimetric reduction prior to analysis. Unless requested by the client, building materials manufactured with multiple layers (i.e. linoleum, wallboard, etc.) are reported as a single sample. Estimation of uncertainty is available on request.

Samples analyzed by EMSL Analytical, Inc. Indianapolis, IN NVLAP Lab Code 200188-0

Initial report from: 01/25/2023 09:53:11



AC unit in shed



Florescent lights in shed



Peal and Stick floor tile in shed



West facing window in barn that were sampled for asbestos



Floor trench in barn



West side sampling with hand auger



Sample of clean soil found at one foot in the west side of the trench




Sample of clean soil found at three feet in the west side of the trench



Sample of clean soil found at four feet in the west side of the trench



Sampling the east side of the trench

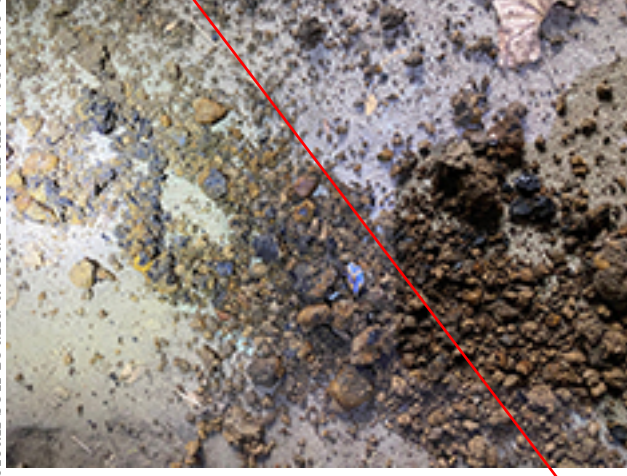

Some of the coal fragments from the east boring at the surface

State of Ohio
Environmental Protection Agency
Asbestos Program

Asbestos Hazard Evaluation Specialist

John
Pardee



47391 Garfield Road
Oberlin OH 44074



Certification Number Expiration Date

ES3201

2/11/23

DOB: 1/11/61

Card not Valid
if Altered

State of Ohio
Environmental Protection Agency
Asbestos Program

Asbestos Hazard Abatement Project Designer

John
Pardee



47391 Garfield Road
Oberlin OH 44074



Certification Number Expiration Date

PD60060

2/11/23

DOB: 1/11/61

Card not Valid
if Altered



February 21, 2023

To: Rick Bodenschatz, PS
CANTON CITY ENGINEERING DEPT.

From: John Pardee, President
PARDEE ENVIRONMENTAL

Re: Asbestos Inspection Report:
Three salt domes
2436 30th St. NE.
Canton, Ohio 44705

Mr. Bodenschatz,

As per your request, Pardee Environmental conducted an environmental screening and an asbestos inspection on February 9, 2023 on the three salt domes at the above listed address. Below and attached are the findings.

- **Site observations:** Two of the three salt domes appear fairly modern wooden structures with asphalt shingles and the only material we sampled was the asphalt shingle roofing in order to confirm my suspicion about there not being asbestos in the roofing in order to simply the demo process. One salt dome was smaller than the other two and was constructed of concrete with a painted white & black exterior coating. The coating material was also sampled.
- **Sample results:** The asphalt shingles from the modern wooden domes were not found to contain any asbestos while the exterior coating on the concrete dome did have a low percentage of asbestos in it. I ordered a follow-up EPA-approved Point Count analysis on the coating samples that required a “gravimetric reduction” preparation and the final result found the two samples of the coating had asbestos concentrations of 0.6% and 0.4%. Anything less than 1% is considered by the EPA as a non-asbestos containing material. Furthermore, the coating was still very pliable and as such not a risk to become friable during demolition.
- **Conclusions:** There are no restrictions regarding the demolition of these three structures. I would advise the demolition contractor to not recycle (pulverize) the coated concrete but to bust it up in manageable pieces and dispose of as construction debris. I saw no other environmental issues with respect to these structures. Demolition is free to commence.
- **EPA notification:** The demo contractor needs to file a pre-demolition notification with the Ohio EPA for all of the buildings we inspected including the shed, the barn, the house and the three salt domes. They are free to contact me if they have any questions about this filing.

Regards,

A handwritten signature in blue ink that reads "John Pardee". The signature is fluid and cursive, with a long horizontal stroke at the end.

John P. Pardee, President
Pardee Environmental
Asbestos Hazard Evaluation Specialist Cert. #ES3201

Attachments: Lab report and chain-of-custody
State certifications



**QUALITY CONTROL
SAMPLE TRANSMITTAL
CHAIN - OF - CUSTODY FORM**

X Regular Rush Results needed by: 5 day TAT #162303086

Samples taken at: Canton City Complex Salt Domes, 30th St, Canton, Ohio

Type of samples: Bulk Analysis requested: PLM/Point Count as per agreement

SAMPLE #	SAMPLE DESCRIPTION	SAMPLE LOCATION
S-1	Dome coating	White dome
S-2	Dome coating	White dome
S-3	Roof shingle	SW dome
S-4	Roof shingle	SW dome
S-5	Roof shingle	W dome
S-6	Roof shingle	W dome

TRANSFERAL RECORD

Relinquished by: John Pardee Relinquished to: Date: 02-09-23
 Relinquished by: Relinquished to: Date:
 Sent by courier: FedEx (indicate type)

*Denise Farrell 2/10/23 10:17AM
EFX*



EMSL Analytical, Inc.

6340 CastlePlace Dr. Indianapolis, IN 46250

Tel/Fax: (317) 803-2997 / (317) 803-3047

<http://www.EMSL.com> / indianapolislaboratory@emsl.com

EMSL Order: 162303086

Customer ID: JPCI50

Customer PO:

Project ID:

Attention: John Pardee

JP ENVIRONMENTAL CONSULT, INC.

47391 Garfield Road

Oberlin, OH 44074

Phone: (440) 315-2735

Fax: (440) 984-3145

Received Date: 02/10/2023 10:17 AM

Analysis Date: 02/16/2023

Collected Date:

Project: Canton City Complex Salt Domes, 30th St., Canton, Ohio

Test Report: Asbestos Analysis of Bulk Materials via AHERA Method 40CFR 763 Subpart E Appendix E supplemented with EPA 600/R-93/116 using Polarized Light Microscopy

Sample	Description	Appearance	Non-Asbestos		Asbestos
			% Fibrous	% Non-Fibrous	% Type
S-1 162303086-0001	Dome Coating - White Dome	White/Black Non-Fibrous Homogeneous		100% Non-fibrous (Other)	<1% Chrysotile
S-2 162303086-0002	Dome Coating - White Dome	White/Black Non-Fibrous Homogeneous		100% Non-fibrous (Other)	<1% Chrysotile
S-3 162303086-0003	Roof Shingle - SW Dome	Red/Black Fibrous Heterogeneous	15% Glass	85% Non-fibrous (Other)	None Detected
S-4 162303086-0004	Roof Shingle - SW Dome	Red/Black Fibrous Heterogeneous	15% Glass	85% Non-fibrous (Other)	None Detected
S-5 162303086-0005	Roof Shingle - W Dome	Red/Black Fibrous Heterogeneous	15% Glass	85% Non-fibrous (Other)	None Detected
S-6 162303086-0006	Roof Shingle - W Dome	Red/Black Fibrous Heterogeneous	15% Glass	85% Non-fibrous (Other)	None Detected

Analyst(s)

Maggie Hayden (6)

Asbestos Laboratory Manager
or Other Approved Signatory

EMSL maintains liability limited to cost of analysis. Interpretation and use of test results are the responsibility of the client. This report relates only to the samples reported above, and may not be reproduced, except in full, without written approval by EMSL. EMSL bears no responsibility for sample collection activities or analytical method limitations. The report reflects the samples as received. Results are generated from the field sampling data (sampling volumes and areas, locations, etc.) provided by the client on the Chain of Custody. Samples are within quality control criteria and met method specifications unless otherwise noted. The above analyses were performed in general compliance with Appendix E to Subpart E of 40 CFR (previously EPA 600/M4-82-020 "Interim Method") but augmented with procedures outlined in the 1993 ("final") version of the method. This report must not be used by the client to claim product certification, approval, or endorsement by NVLAP, NIST or any agency of the federal government. Non-friable organically bound materials present a problem matrix and therefore EMSL recommends gravimetric reduction prior to analysis. Unless requested by the client, building materials manufactured with multiple layers (i.e. linoleum, wallboard, etc.) are reported as a single sample. Estimation of uncertainty is available on request.

Samples analyzed by EMSL Analytical, Inc. Indianapolis, IN NVLAP Lab Code 200188-0, AZ0939, CA 2575, CO AL-15132, TX 300262, A2LA Accredited - Certificate #2845.25

Initial report from: 02/16/2023 11:08:23

**EMSL Analytical, Inc.**

6340 CastlePlace Dr., Indianapolis, IN 46250

Phone/Fax: (317) 803-2997 / (317) 803-3047

<http://www.EMSL.com>indianapolislab@emsl.com

EMSL Order: 162303086

CustomerID: JPCI50

CustomerPO:

ProjectID:

Attn: **John Pardee**
JP ENVIRONMENTAL CONSULT, INC.
47391 Garfield Road
Oberlin, OH 44074

Phone: (440) 315-2735
Fax: (440) 984-3145
Received: 2/10/2023 10:17 AM
Analysis Date: 2/21/2023
Collected:

Project: **Canton City Complex Salt Domes, 30th St., Canton, Ohio**

Test Report: Asbestos Analysis of Bulk Materials via AHERA Method 40CFR 763
Subpart E Appendix E supplemented with EPA 600/R-93/116 using Polarized Light
Microscopy with Gravimetric Reduction. Quantitation using 400 Point Count Procedure.

SAMPLE ID	DESCRIPTION	APPEARANCE	(%) Matrix Organic Acid		NON- ASBESTOS % Fibrous	NON- ASBESTOS % NON-FIBROUS	ASBESTOS % TYPES
S-1 162303086-0001	Dome Coating - White Dome	White/Black Non-Fibrous Homogeneous	49.1	0.0		50.5 Non-fibrous (other)	0.4 Chrysotile
S-2 162303086-0002	Dome Coating - White Dome	White/Black Non-Fibrous Homogeneous	41.8	0.0		57.6 Non-fibrous (other)	0.6 Chrysotile

Analyst(s)

Hilary Jarvis (2)

Asbestos Laboratory Manager
or other approved signatory

EMSL maintains liability limited to cost of analysis. Interpretation and use of test results are the responsibility of the client. This report relates only to the samples reported above, and may not be reproduced, except in full, without written approval by EMSL. EMSL bears no responsibility for sample collection activities or analytical method limitations. The report reflects the samples as received. Results are generated from the field sampling data (sampling volumes and areas, locations, etc.) provided by the client on the Chain of Custody. Samples are within quality control criteria and met method specifications unless otherwise noted. The above analyses were performed in general compliance with Appendix E to Subpart E of 40 CFR (previously EPA 600/M4-82-020 "Interim Method") but augmented with procedures outlined in the 1993 ("final") version of the method. This report must not be used by the client to claim product certification, approval, or endorsement by NVLAP, NIST or any agency of the federal government. Unless requested by the client, building materials manufactured with multiple layers (i.e. linoleum, wallboard, etc.) are reported as a single sample. Some samples may contain asbestos fibers present in dimensions below PLM resolution limits. EMSL suggests that samples reported as <0.25% or none detected undergo additional analysis via TEM. Estimation of uncertainty is

Samples analyzed by EMSL Analytical, Inc. Indianapolis, IN NVLAP Lab Code 200188-0, A2LA Accredited - Certificate #2845.25

Initial report from 02/21/2023 10:16:50

State of Ohio
Environmental Protection Agency
Asbestos Program

Asbestos Hazard Evaluation Specialist

John
Pardee



47391 Garfield Road
Oberlin OH 44074



Certification Number Expiration Date

ES3201

2/11/23

DOB: 1/11/61

Card not Valid
if Altered

State of Ohio
Environmental Protection Agency
Asbestos Program

Asbestos Hazard Abatement Project Designer

John
Pardee



47391 Garfield Road
Oberlin OH 44074



Certification Number Expiration Date

PD60060

2/11/23

DOB: 1/11/61

Card not Valid
if Altered

1.5 MAINTENANCE MATERIAL SUBMITTALS

- A. Extra Stock Materials: Furnish extra materials to Owner that match products installed and that are packaged with protective covering for storage and identified with labels describing contents.
 - 1. Door Hinges: One hinge(s) with associated fasteners.
 - 2. Latch and Keeper: One latch(es) and keeper(s) with associated fasteners.
 - 3. Door Bumper: One door bumper(s) with associated fasteners.
 - 4. Door Pull: One door pull(s) with associated fasteners.
 - 5. Fasteners: 10 fasteners of each size and type.

1.6 FIELD CONDITIONS

- A. Field Measurements: Verify actual locations of toilet fixtures, walls, columns, ceilings, and other construction contiguous with toilet compartments by field measurements, and coordinate before fabrication.

PART 2 - PRODUCTS

2.1 SOURCE LIMITATIONS

- A. Obtain phenolic-core toilet compartments from single source from single manufacturer.

2.2 PERFORMANCE REQUIREMENTS

- A. Surface-Burning Characteristics: Comply with **NFPA 286**; testing by a qualified testing agency. Identify products with appropriate markings of applicable testing agency.
- B. Structural Performance: Where grab bars are mounted on toilet compartments, design panels to comply with the following requirements:
 - 1. Panels are able to withstand a concentrated load on grab bar of at least 250 lbf applied at any direction and at any point, without deformation of panel.
- C. Regulatory Requirements: Comply with applicable provisions in ICC A117.1 for toilet compartments designated as accessible.

2.3 PHENOLIC-CORE TOILET COMPARTMENTS

- A. Manufacturers: Subject to compliance with requirements, provide products by one of the following:
 - 1. ASI Global Partitions.
 - 2. ~~Bobrick Washroom Equipment, Inc.~~
 - 3. Bradley Corporation.
 - 4. **Scranton Products**
 - 5. **Hadrian Solutions ULC**
- B. Toilet-Enclosure Style: Overhead braced, Floor anchored.
- C. Urinal-Screen Style: Wall hung.

4. Detector Bases: Quantity equal to two percent of amount of each type installed, but no fewer than one unit of each type.
5. Keys and Tools: One extra set for access to locked or tamperproofed components.
6. Audible and Visual Notification Appliances: One of each type installed.
7. Fuses: Two of each type installed in system. Provide in box or cabinet with compartments marked with fuse types and sizes.

1.8 QUALITY ASSURANCE

A. Installer Qualifications:

1. Personnel must be trained and certified by manufacturer for installation of units required for this Project.
2. Installation must be by personnel certified by NICET as fire-alarm Level IV technician.
3. Obtain certification by NRTL in accordance with NFPA 72.
4. Licensed or certified by authorities having jurisdiction.

1.9 WARRANTY

A. Special Warranty: Manufacturer agrees to repair or replace fire-alarm system equipment and components that fail because of defects in materials or workmanship within specified warranty period.

1. Warranty Period: Five years from date of Substantial Completion.

PART 2 - PRODUCTS

2.1 ADDRESSABLE FIRE-ALARM SYSTEM

A. Manufactures

1. Gamewell-FCI, Honeywell Fire Systems.
2. Notifier
3. Siemens
- 4. SIMPLEX**

B. Description:

1. Noncoded, UL-certified addressable system, with multiplexed signal transmission and horn-and-strobe notification for evacuation.

C. Performance Criteria:

1. Regulatory Requirements:

- a. Fire-Alarm Components, Devices, and Accessories: Listed and labeled by a NRTL in accordance with NFPA 70 for use with selected fire-alarm system and marked for intended location and application.

2. General Characteristics:

- a. Automatic sensitivity control of certain smoke detectors.

BENCHMARKS
STATE PLANE GRID NORTH, NAD 83 (2011),
OHIO NORTH ZONE.
ELEVATIONS ARE NAVD 88, GEOID 18,
TIED BY GPS TO THE O.D.O.T. VRS.

BENCHMARK #2 - MAG SPIKE ON SOUTH SIDE OF UTILITY POLE
N 425092, E 2289710
ELEVATION = 1060.95

BENCHMARK #4 - MAG SPIKE ON WEST SIDE OF UTILITY POLE
N 425103, E 2289890
ELEVATION = 1066.51

BENCHMARK #6 - NORTH EAST BONNET BOLT BETWEEN VILLE & ALA
N 425232, E 2290227
ELEVATION = 1077.30



UTILITIES SHOWN ON SURVEY WERE LOCATED
BASED ON FIELD MARKING PROVIDED BY OUPS
REQUEST #A207700537 AND #A207700538.

CONSTRUCTION SEQUENCE

1. DURING PRECONSTRUCTION MEETING ALL EROSION & SEDIMENT CONTROL FACILITIES & PROCEDURES SHALL BE DISCUSSED. A GENERAL CONSTRUCTION SEQUENCE FOLLOWS AND MAY NEED TO BE UPDATED BY THE CONTRACTOR TO SUIT THE SPECIFICS OF THE SITE AND INTENDED CONSTRUCTION SEQUENCES.
 - 1.1. CONTACT STARK SOIL AND WATER CONSERVATION DISTRICT TO SCHEDULE A PRECONSTRUCTION MEETING AT 3:00-4:15 PM PRIOR TO ANY EARTH MOVING ACTIVITY.
 - 1.2. INSTALL CONSTRUCTION ENTRANCE AS DETAILLED ON PLANS. TEMPORARY CONSTRUCTION FENCING SHALL BE INSTALLED AROUND PERIMETER OF CONSTRUCTION SITE. WHERE THERE IS EXISTING FENCE ALONG THE PERIMETER OF THE SITE, IT CAN BE UTILIZED. FENCING SHALL BE USED TO RESTRICT OUTSIDE TRAFFIC TO SITE.
 - 1.3. DELIVER CONSTRUCTION TRAILER TO SITE AND INSTALL TEMPORARY POWER AND TELEPHONE. IF REQUIRED. TEMPORARY UTILITY SERVICES ARE THE SOLE RESPONSIBILITY OF THE CONTRACTOR.
 - 1.4. STRIKE AND/OR FLAG LIMITS OF CLEARING.
 - 1.5. CLEAR & GRUB, AS NECESSARY, FOR INSTALLATION OF PERIMETER CONTROLS. INSTALL SILT PERIMETER CONTROLS AS SHOWN ON PLANS. SILT PERIMETER CONTROLS SHALL BE INSTALLED LEVEL, ALONG THE CONTOURS, WITH ENDS TURNED UPSLOPE TO PREVENT CONCENTRATED FLOW AT THE SILT PERIMETER CONTROLS.
 - 1.6. INSTALL TEMPORARY SILT INLET PROTECTION ON ALL EXISTING CATCH BASINS AND INLETS, AS DESIGNATED IN THE PLANS. REMOVAL OF SILT INLET PROTECTION FROM DESIGNATED INLETS CAN ONLY OCCUR WHEN A STRUCTURE IS REMOVED, AND AS REQUIRED BY THE PROGRESSION OF THE DEMOLITION AND CONSTRUCTION.
 - 1.7. CLEAR & GRUB THE SITE AS NECESSARY. TOPSOIL SHALL BE STRIPPED AND STOCKPILED ON SITE FOR REUSE, OR REMOVED TO AN APPROVED OFFSITE SPOIL AREA.
 - 1.8. UTILIZE DUST CONTROL MEASURES AS REQUIRED TO MINIMIZE AIR-BORNE POLLUTION BY METHODS APPROVED BY THE AUTHORIZING EPA OFFICE.
 - 1.9. REMOVE HAZARDOUS SOIL FROM SITE AND DISPOSE IN APPROPRIATE LANDFILL.
 - 1.10. BEGIN FILLING & GRADING AS REQUIRED TO REACH SUBGRADE.
 - 1.11. ONCE PAVEMENT GRADIES HAVE BEEN ESTABLISHED, AS DESIGNATED ON THE PLANS, THE CONTRACTOR SHALL UTILIZE THESE AREAS FOR STRUCTURE CONSTRUCTION.
 - 1.12. CONSTRUCT UNDERGROUND UTILITY WORK INCLUDING STORM DRAINAGE FACILITIES. UPON INSTALLATION OF STORM DRAINAGE CATCH BASINS, YARD DRAINS AND INLETS, INSTALL REQUIRED INLET PROTECTION.
 - 1.13. DO NOT REPLACE ANY TOPSOIL. SEED OR INSTALL FINAL PAVEMENT PRIOR TO COMPLETION OF BUILDING SHELL. SHOULD SITEWORK BE COMPLETED PRIOR TO THIS DATE, MULCH DISTURBED AREAS TO BE PLANTED AND INSTALL STONE SUBBASE IN DISTURBED AREAS TO BE PAVED.
 - 1.14. FOLLOWING COMPLETION OF BUILDING SHELL AND PAVEMENT INSTALLATION, BEGIN BIORETENTION BASIN AND LANDSCAPE INSTALLATION.
 - 1.15. COMPLETE SITEWORK, PAVEMENT MARKINGS AND FINAL CLEAN-UP. RESEED ANY AREAS THAT MAY REQUIRE ATTENTION IMMEDIATELY. NOTE THAT LAWN AREAS WILL NOT BE DEEMED STABLE UNTIL A MINIMUM 80% VEGETATIVE DENSITY HAS BEEN ACHIEVED.
 - 1.16. MAINTAIN EROSION & SEDIMENTATION CONTROL MEASURES UNTIL THE SITE HAS BEEN COMPLETELY STABILIZED. ALL AREAS OF VEGETATIVE SURFACE, WHETHER PERMANENT OR TEMPORARY, SHALL BE CONSIDERED TO BE IN PLACE AND FUNCTIONAL WHEN THE REQUIRED UNIFORM RATE OF COVERAGE (80%) IS OBTAINED.
 - 1.17. REMOVE SEDIMENT CONTROLS.

PROJECT DESCRIPTION

THIS SITE IS HOME TO THREE SALT DOMES AND ASSOCIATED ASPHALT AND GRAVEL PAVEMENT THAT WILL BE DEMOLISHED AND REMOVED. A PROPOSED SANITATION BUILDING WILL BUILT WITH ASPHALT PARKING STALLS AND ASSOCIATED SIDEWALKS.

PROJECT COMPLETION STATISTICS

FARCEL SIZE: 32.67 ACRES (TOTAL CAMPUS)
TOTAL DISTURBED AREA: 18.42 ACRES

*WATER QUALITY WILL BE OF THE ENTIRE CAMPUS IMPROVEMENTS, WHICH INCLUDE TWO SEPARATE PROJECTS. ALL WATER QUALITY REQUIRED FOR CAMPUS WILL BE DESIGNED AND ACCOUNTED ON THIS PROJECT SET.

EXISTING LAND USE FOR THE SITE IS A SALT DOME WITH PAVEMENT.
ESTIMATED PRE-CONSTRUCTION IMPERVIOUS AREA: **22.85 ACRES
ESTIMATED POST-CONSTRUCTION IMPERVIOUS PERCENT: **59.4%
PRE-CONSTRUCTION RUN-OFF COEFFICIENT: **0.77

PROPOSED LAND USE WILL BE SANITATION BUILDING WITH ASPHALT PARKING
ESTIMATED POST-CONSTRUCTION IMPERVIOUS AREA: **23.67 ACRES
ESTIMATED POST-CONSTRUCTION IMPERVIOUS PERCENT: **72.5%
POST-CONSTRUCTION RUN-OFF COEFFICIENT: **0.78

** NUMBERS BASED ON ENTIRE CAMPUS IMPROVEMENTS.

PROJECT LOCATION:

LATITUDE: 40° 49' 38" N
LONGITUDE: 81° 20' 16" W

EXISTING SITE SOIL TYPES:

UW: UDORTHENTS
WHA: WEINBACH SILT LOAM, 0 TO 2 PERCENT SLOPES, HSG = C/D
Pg: PITS, GRAVEL
W: WATER
Ge: GINAT SILT LOAM, HSG = C/D
REFERENCE: USDA NATIONAL RESOURCES CONSERVATION SERVICE WEB SOIL SURVEY.

WETLAND INFORMATION:

THERE ARE NO WETLANDS ON THIS SITE.

FIRST AND SUBSEQUENT RECEIVING STREAM:

INITIAL RECEIVING WATER AN EXISTING SEWER SYSTEM AND THE SUBSEQUENT RECEIVING WATER IS THE MIDDLE BRANCH NIMISHILLEN CREEK.

OWNER CONTACT:

JAMES DIMARZIO
215 CLEVELAND AVENUE SW
P.O. BOX 24218
CANTON, OHIO 44701
330.438.8941
JAMES.DIMARZIO@CANTONOHIO.GOV

ANTICIPATED TIMING:

CONSTRUCTION BEGIN: SPRING 2023
CONSTRUCTION COMPLETE: FALL 2024
CONTRACTOR:
CONTACT:
PHONE NUMBER:

CONTRACTOR SHALL MAINTAIN A CONSTRUCTION LOG DOCUMENTING ALL GRADING AND STABILIZATION ACTIVITIES.

SWPP COORDINATION NOTE:

1. PRIOR TO THE START OF CONSTRUCTION, THE CONTRACTOR SHALL COORDINATE THE AREAS DESIGNATED FOR THE STORAGE AND DISPOSAL OF SOLID, SANITARY, AND TOXIC WASTES INCLUDING DUMPSTER AREAS AND AREAS FOR VEHICLE FUELING/MAINTENANCE) WITH THE OWNER'S REPRESENTATIVE. FINAL LOCATION SHALL BE APPROVED BY A SWPP AUTHORITY REPRESENTATIVE.
2. NO ABOVE GROUND FUEL TANKS STORED ON SITE. ALL FUEL FOR HEAVY EQUIPMENT TO BE DELIVERED TO SITE AND DISPENSED CAREFULLY INTO FUEL TANKS.

PLAN CERTIFICATION

I, THE UNDERSIGNED, REPRESENT THAT THIS DOCUMENT AND ALL ATTACHMENTS BEARING MY STAMP/SEAL WERE PREPARED UNDER MY DIRECTION OR SUPERVISION IN GENERAL ACCORDANCE WITH A SYSTEM DESIGNED TO ASSURE THAT QUALIFIED PERSONNEL PROPERLY GATHERED AND EVALUATED THE INFORMATION SUBMITTED. BASED ON MY INQUIRY OF THE PERSON OR PERSONS WHO MANAGED THE SYSTEM OR THOSE PERSONS DIRECTLY RESPONSIBLE FOR GATHERING THE INFORMATION, THE INFORMATION SUBMITTED IS, TO MY REASONABLE KNOWLEDGE AND BELIEF, TRUE, ACCURATE, AND COMPLETE. I AM AWARE THAT THERE ARE SIGNIFICANT PENALTIES FOR SUBMITTING FALSE INFORMATION, INCLUDING THE POSSIBILITY OF FINE FOR KNOWING VIOLATIONS.

LEONARDO SFERRA, P.E.
GPD GROUP

TOPSOIL STOCKPILE

ANY TOPSOIL THAT IS TO REMAIN ON SITE IN A STOCKPILE SHALL BE COORDINATED WITH THE OWNER ON LOCATION. CONTRACTOR SHALL PLACE APPROPRIATE PERIMETER SEDIMENT CONTROL DEVICES AND NOTIFY STARK SOIL AND WATER FOR APPROVAL.

BIORETENTION

SEE SHEET C-012 FOR BIORETENTION LOCATION AND DETAILS.


SWPP KEYNOTES

- TS TEMPORARY SEEDING
- PS PERMANENT SEEDING
- CVW CONCRETE WASHOUT AREA
- RC ROCK CHECK DAM
- SF SILT FENCE
- FS FILTER SOCK
- CE CONSTRUCTION ENTRANCE
- BR BIO-RETENTION BASIN
- IP INLET PROTECTION
- CF TEMPORARY CONSTRUCTION FENCE
- CS CONSTRUCTION STAGING / LAYDOWN AREA
- LS PERMANENT LEVEL SPREADER
- ECM PERMANENT EROSION CONTROL MATTING

LEGEND

(SEE SHEET C-001 FOR GENERAL LEGEND)

- PROPOSED SILT BARRIER REFER TO SWPP DETAILS
- PROPOSED SILT FENCE REFER TO SWPP DETAILS
- PROPOSED FILTER SOCK REFER TO SWPP DETAILS
- PROPOSED CONSTRUCTION ENTRANCE REFER TO SWPP DETAILS
- PROPOSED CONCRETE WASHOUT FACILITY REFER TO SWPP DETAILS
- LIMITS OF DISTURBANCE
- TEMPORARY CONSTRUCTION FENCE
- PROPOSED CONSTRUCTION STAGING / LAYDOWN AREA.
- NORTH AMERICAN GREEN, ROLLMAX VMAX SC-250 PERMANENT EROSION CONTROL MATTING ANCHORED WITH ARMORMAX ENGINEERED ANCHORS.

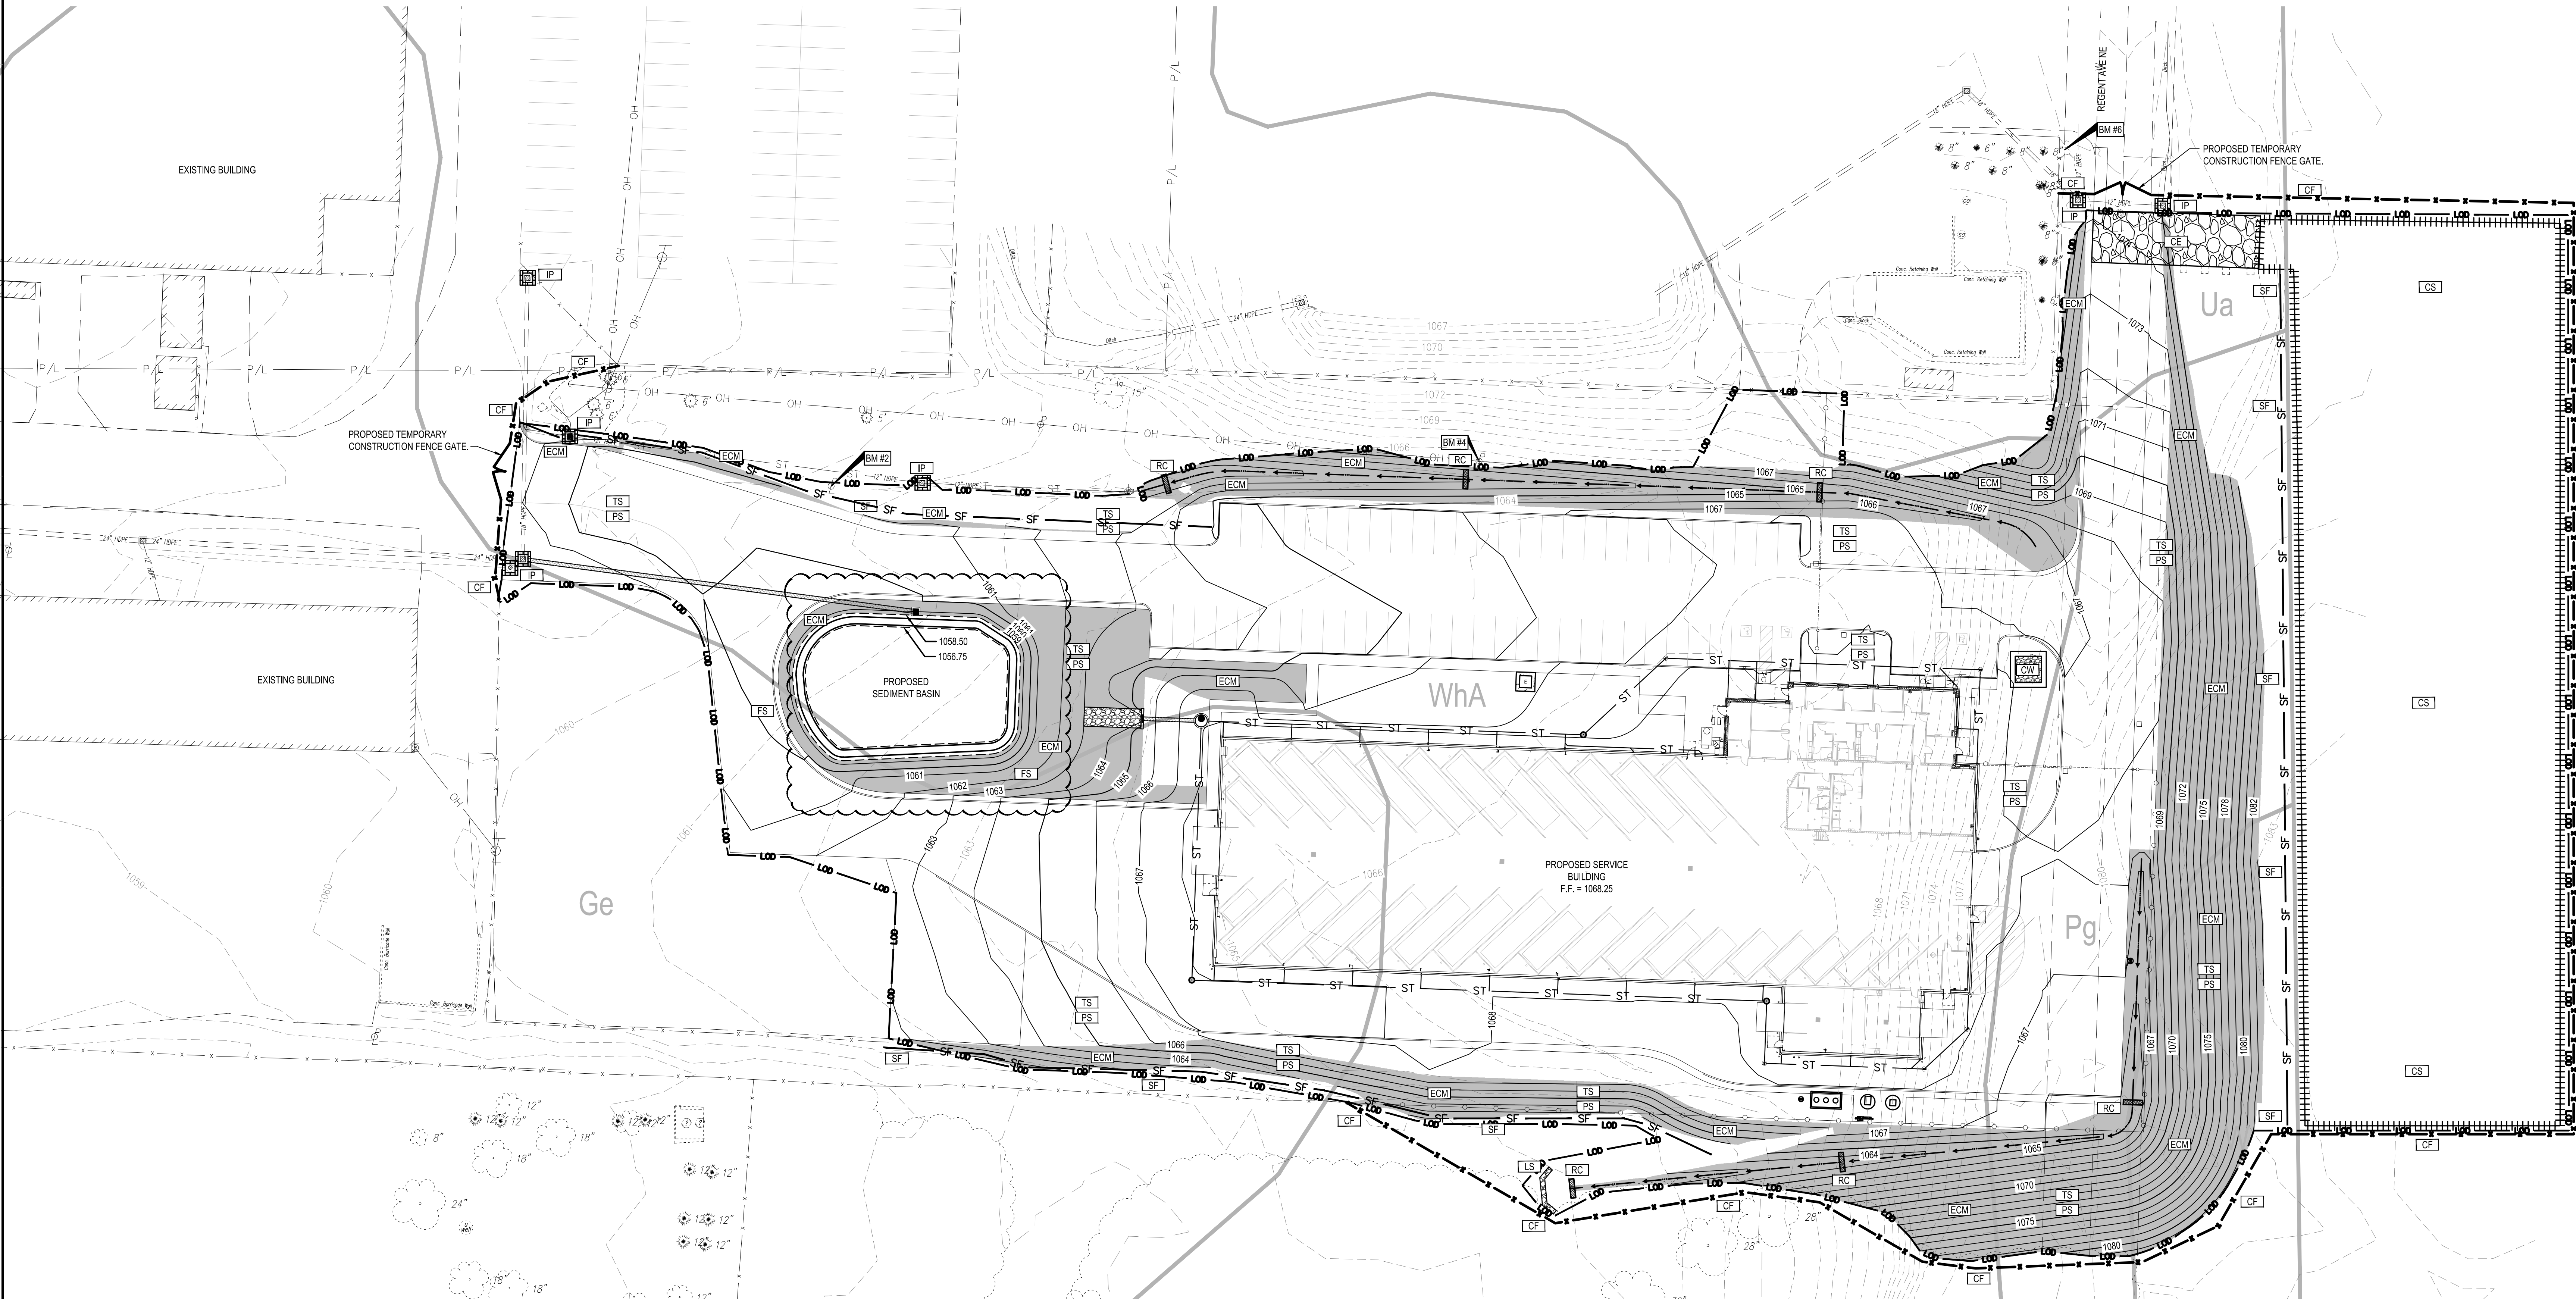

DESCRIPTION

ADDITIONAL 01

DATE

03/03/2023

REV

1

SANITATION BUILDING PROJECT - GP 1376
2801 REGENT AVE NE,
CANTON, OHIO 44705

SWPP PLAN

ISSUED FOR:

PERMIT	02/06/2023
BID	02/06/2023
CONSTRUCTION	noted/none
RECORD	noted/none

PROJECT MANAGER	DESIGNER
MLH	TJW

JOB NO.
2020377.05

C-011

NOTES:

4. FILTER LAYER - THREE INCHES OF CLEAN MEDIAL CONCRETE SAND (ASTM C-33) OVER THREE INCHES OF #8 OR #78 STONE (PEA GRAVEL).
5. FILTER LAYER AND SAND SHALL BE PLACED IN A 12 INCH BED CONSISTING OF #78 WASHED STONE (EXCLUDING RECYCLED CONCRETE) SHALL BE PROVIDED AS DRAINAGE MEDIA AND BEDDING MATERIAL FOR UNDERDRAIN PIPES. THE GRAVEL SHALL BE PLACED GENERALLY AT A MINIMUM OF 12 INCH MINIMUM OF 3% OF GRAVEL PROVIDED ABOVE AND BELOW UNDERDRAIN PIPES.
6. PLANTING SOIL MEDIA STOCK TO BE USED ON PROJECT SHALL BE TESTED AND CERTIFIED BY A CERTIFIED LABORATORY TO INSURE THEY MEET THE REQUIRED SPECIFICATIONS.
7. PLANTING SOIL MEDIA SHALL BE PLACED IN 12 INCH UNITS AND LIGHTLY SETTLING BY SOAKING WITH WATER. THIS SHALL BE COMPLETED AT A STEADY RATE, DO NOT RUSH. THE FACTOR SHALL BE 10% OF THE TOTAL VOLUME OF MEDIA TO BE USED TO ACCOUNT FOR SETTLEMENT. DO NOT COMPACT DURING OR AFTER INSTALLATION.

BIORETENTION FILTER MEDIA DRAWDOWN CALCULATION:

WQI=(AREA OF FILTER MEDIA*INFILTRATION RATE OF MEDIA IN FT/DAY)

BASED ON USING THE OHIO RAINWATER AND LAND DEVELOPMENT MANUAL'S RECOMMENDATIONS FOR SOIL MEDIA PERMEABILITY (1" TO 4" PER HOUR), THE DRAWDOWN CALCULATION RANGE IS AS FOLLOWS:

1" PER HOUR	
$\frac{5,621 \text{ C.F.}}{(5.207 \text{ S.F.} \times 2 \text{ FT/DAY})}$	= 0.539 DAY = 12.94 HRS
4" PER HOUR	
$\frac{5,621 \text{ C.F.}}{(5.207 \text{ S.F.} \times 8 \text{ FT/DAY})}$	= 0.135 DAY = 3.24 HRS

DRAWDOWN RATES MEET THE 24 HOUR MAXIMUM DRAWDOWN REQUIREMENT.

BIORETENTION FILTER MEDIA DRAWDOWN CALCULATION:

WQI=(AREA OF FILTER MEDIA*INFILTRATION RATE OF MEDIA IN FT/DAY)

BASED ON USING THE OHIO RAINWATER AND LAND DEVELOPMENT MANUAL'S RECOMMENDATIONS FOR SOIL MEDIA PERMEABILITY (1" TO 4" PER HOUR), THE DRAWDOWN CALCULATION RANGE IS AS FOLLOWS:


1" PER HOUR	
$\frac{5,621 \text{ C.F.}}{(5.207 \text{ S.F.} \times 2 \text{ FT/DAY})}$	= 0.539 DAY = 12.94 HRS
4" PER HOUR	
$\frac{5,621 \text{ C.F.}}{(5.207 \text{ S.F.} \times 8 \text{ FT/DAY})}$	= 0.135 DAY = 3.24 HRS


DRAWDOWN RATES MEET THE 24 HOUR MAXIMUM DRAWDOWN REQUIREMENT.

DRAWDOWN RATES MEET THE 24 HOUR MAXIMUM DRAWDOWN REQUIREMENT.

NOTE:
1. WQv REQUIRED FOR THE ENTIRE CAMPUS PROJECT AREAS AS REDEVELOPMENT = 5,621 CF.
TOTAL PROVIDED = 5,623 CF.






 NORTH AMERICAN GREEN, ROLLMAX VMAX SC-250 PERMANENT EROSION CONTROL MATTING ANCHORED WITH ARMORMAX ENGINEERED ANCHORS.

 BIORETENTION BASIN FILTER BED AREA.



Drawing Name: O:\2020\2020377\05 - Sanitation Building\4_Working Files\00_CAD (2020)\C\Sheets\2020377.05 SWPP
File Name: 2020377.05 SWPP
Date: 12/28/2023 7:28 PM - Night

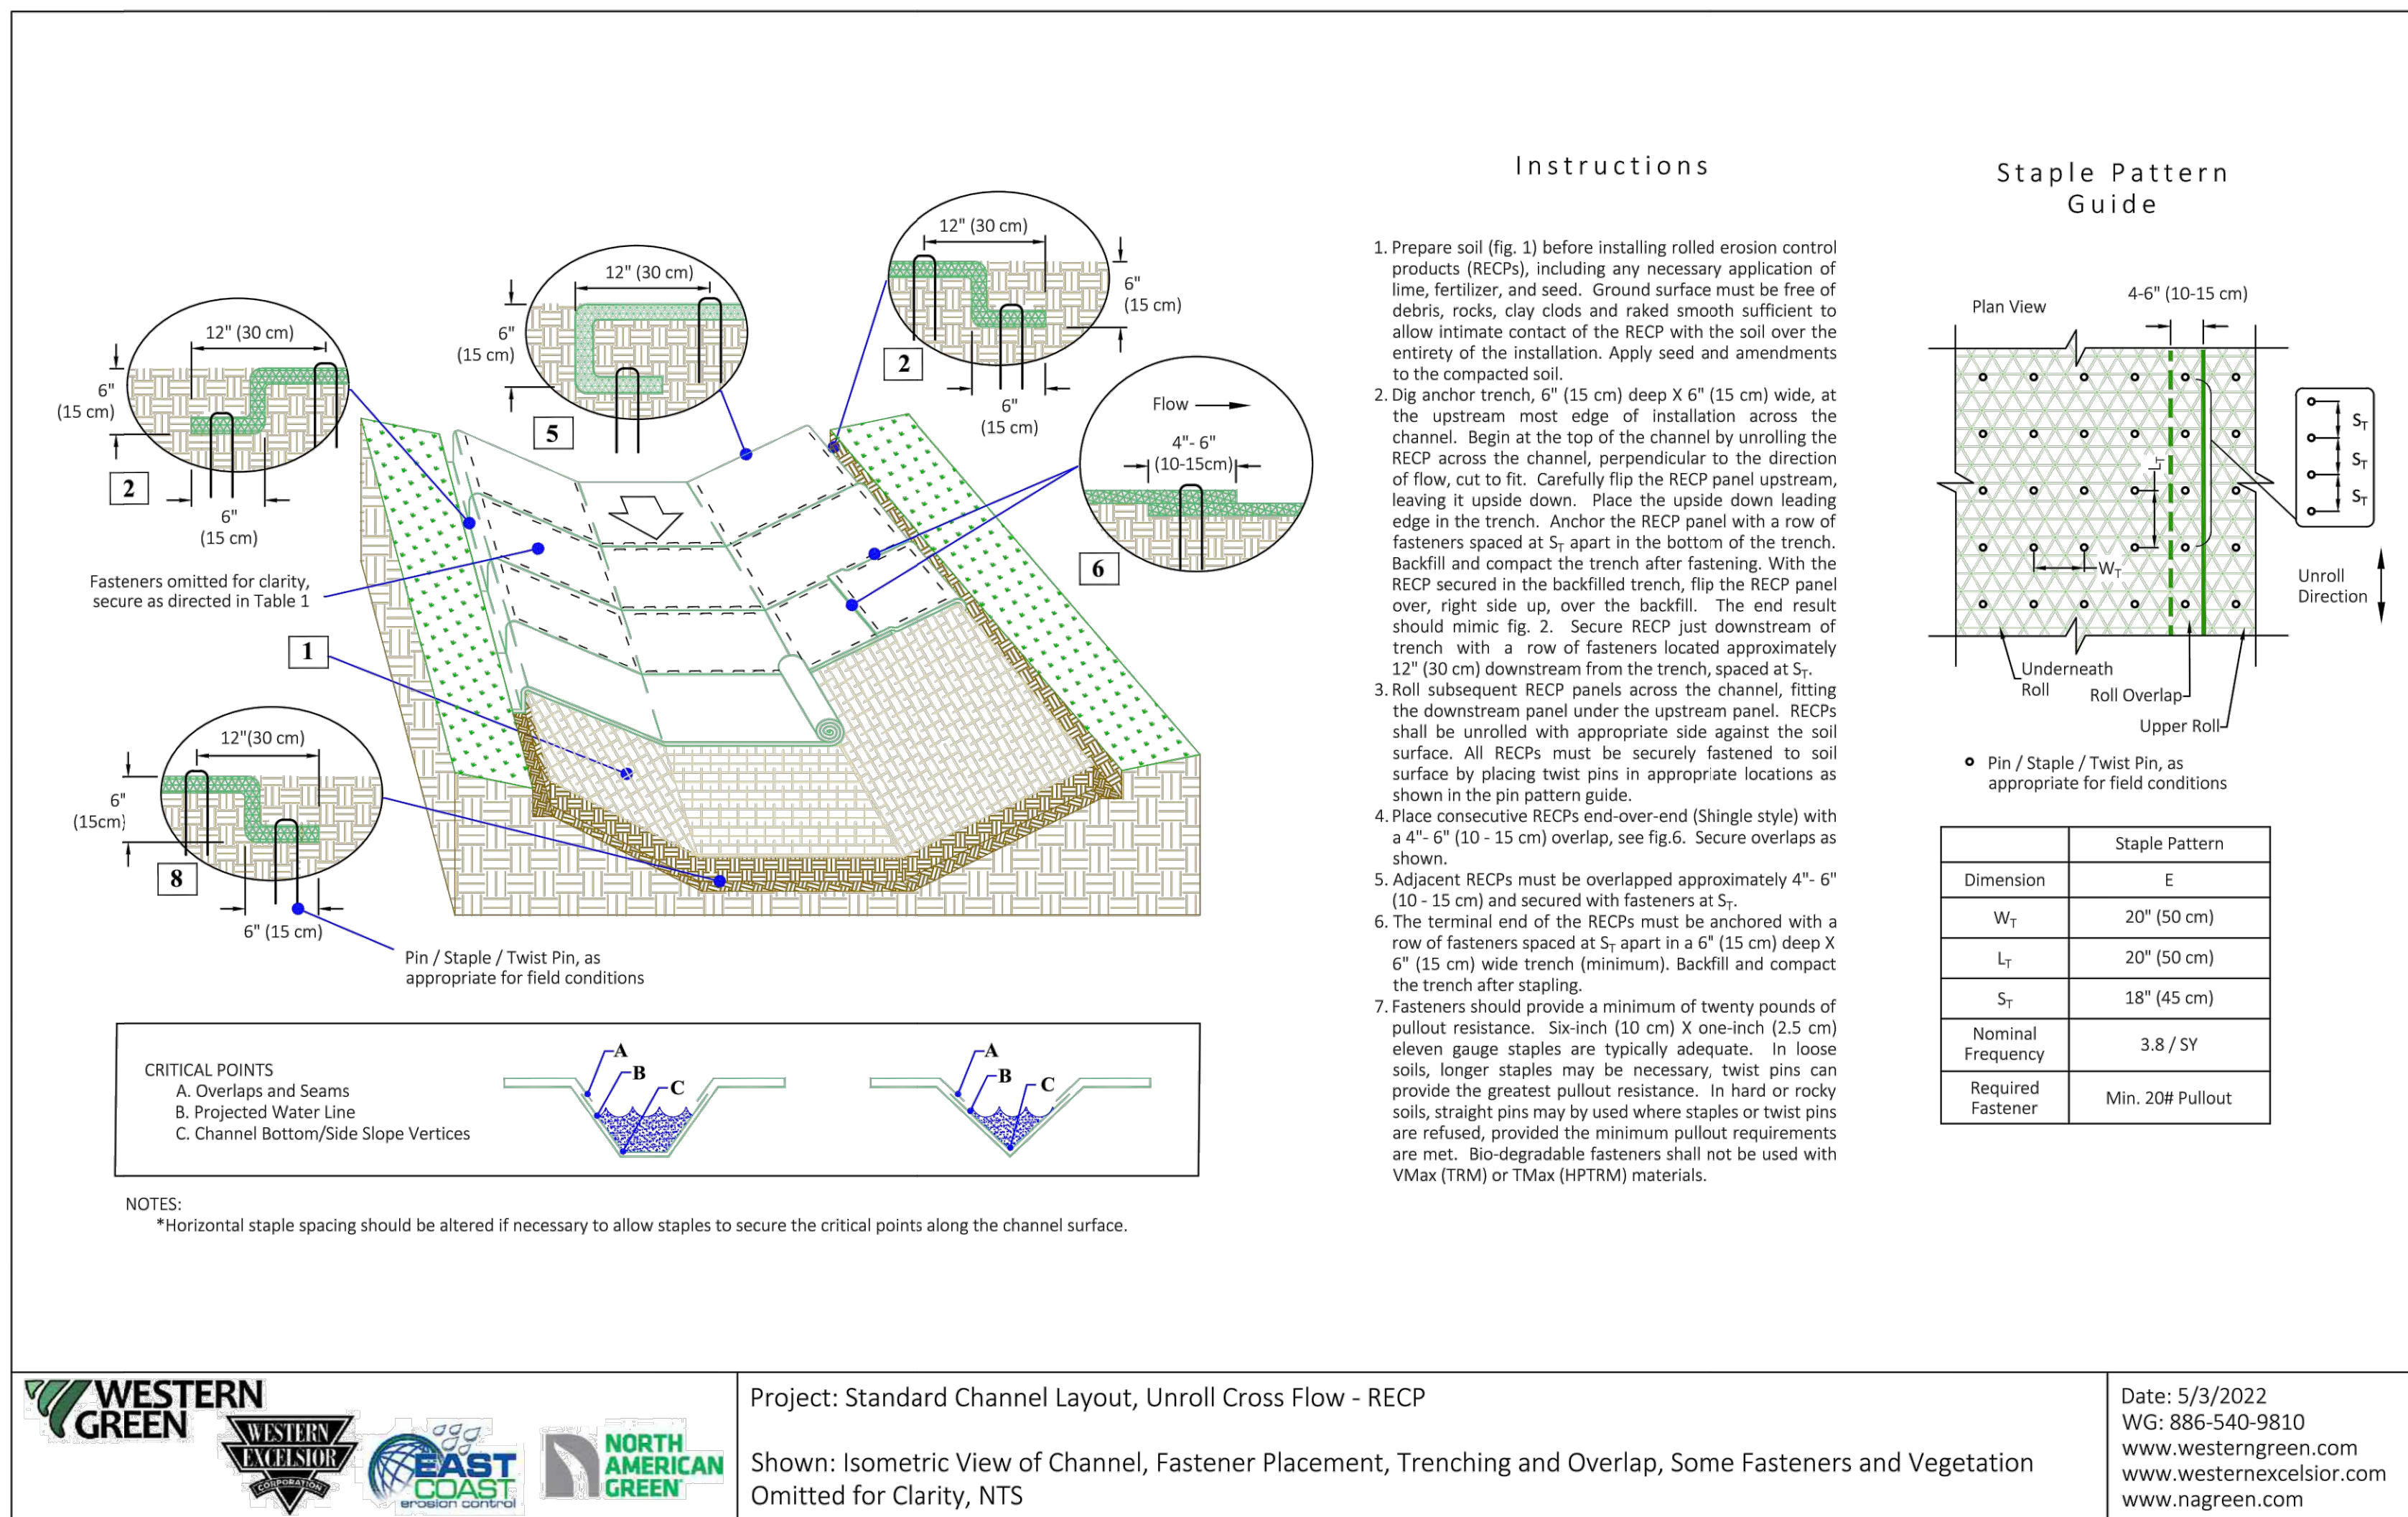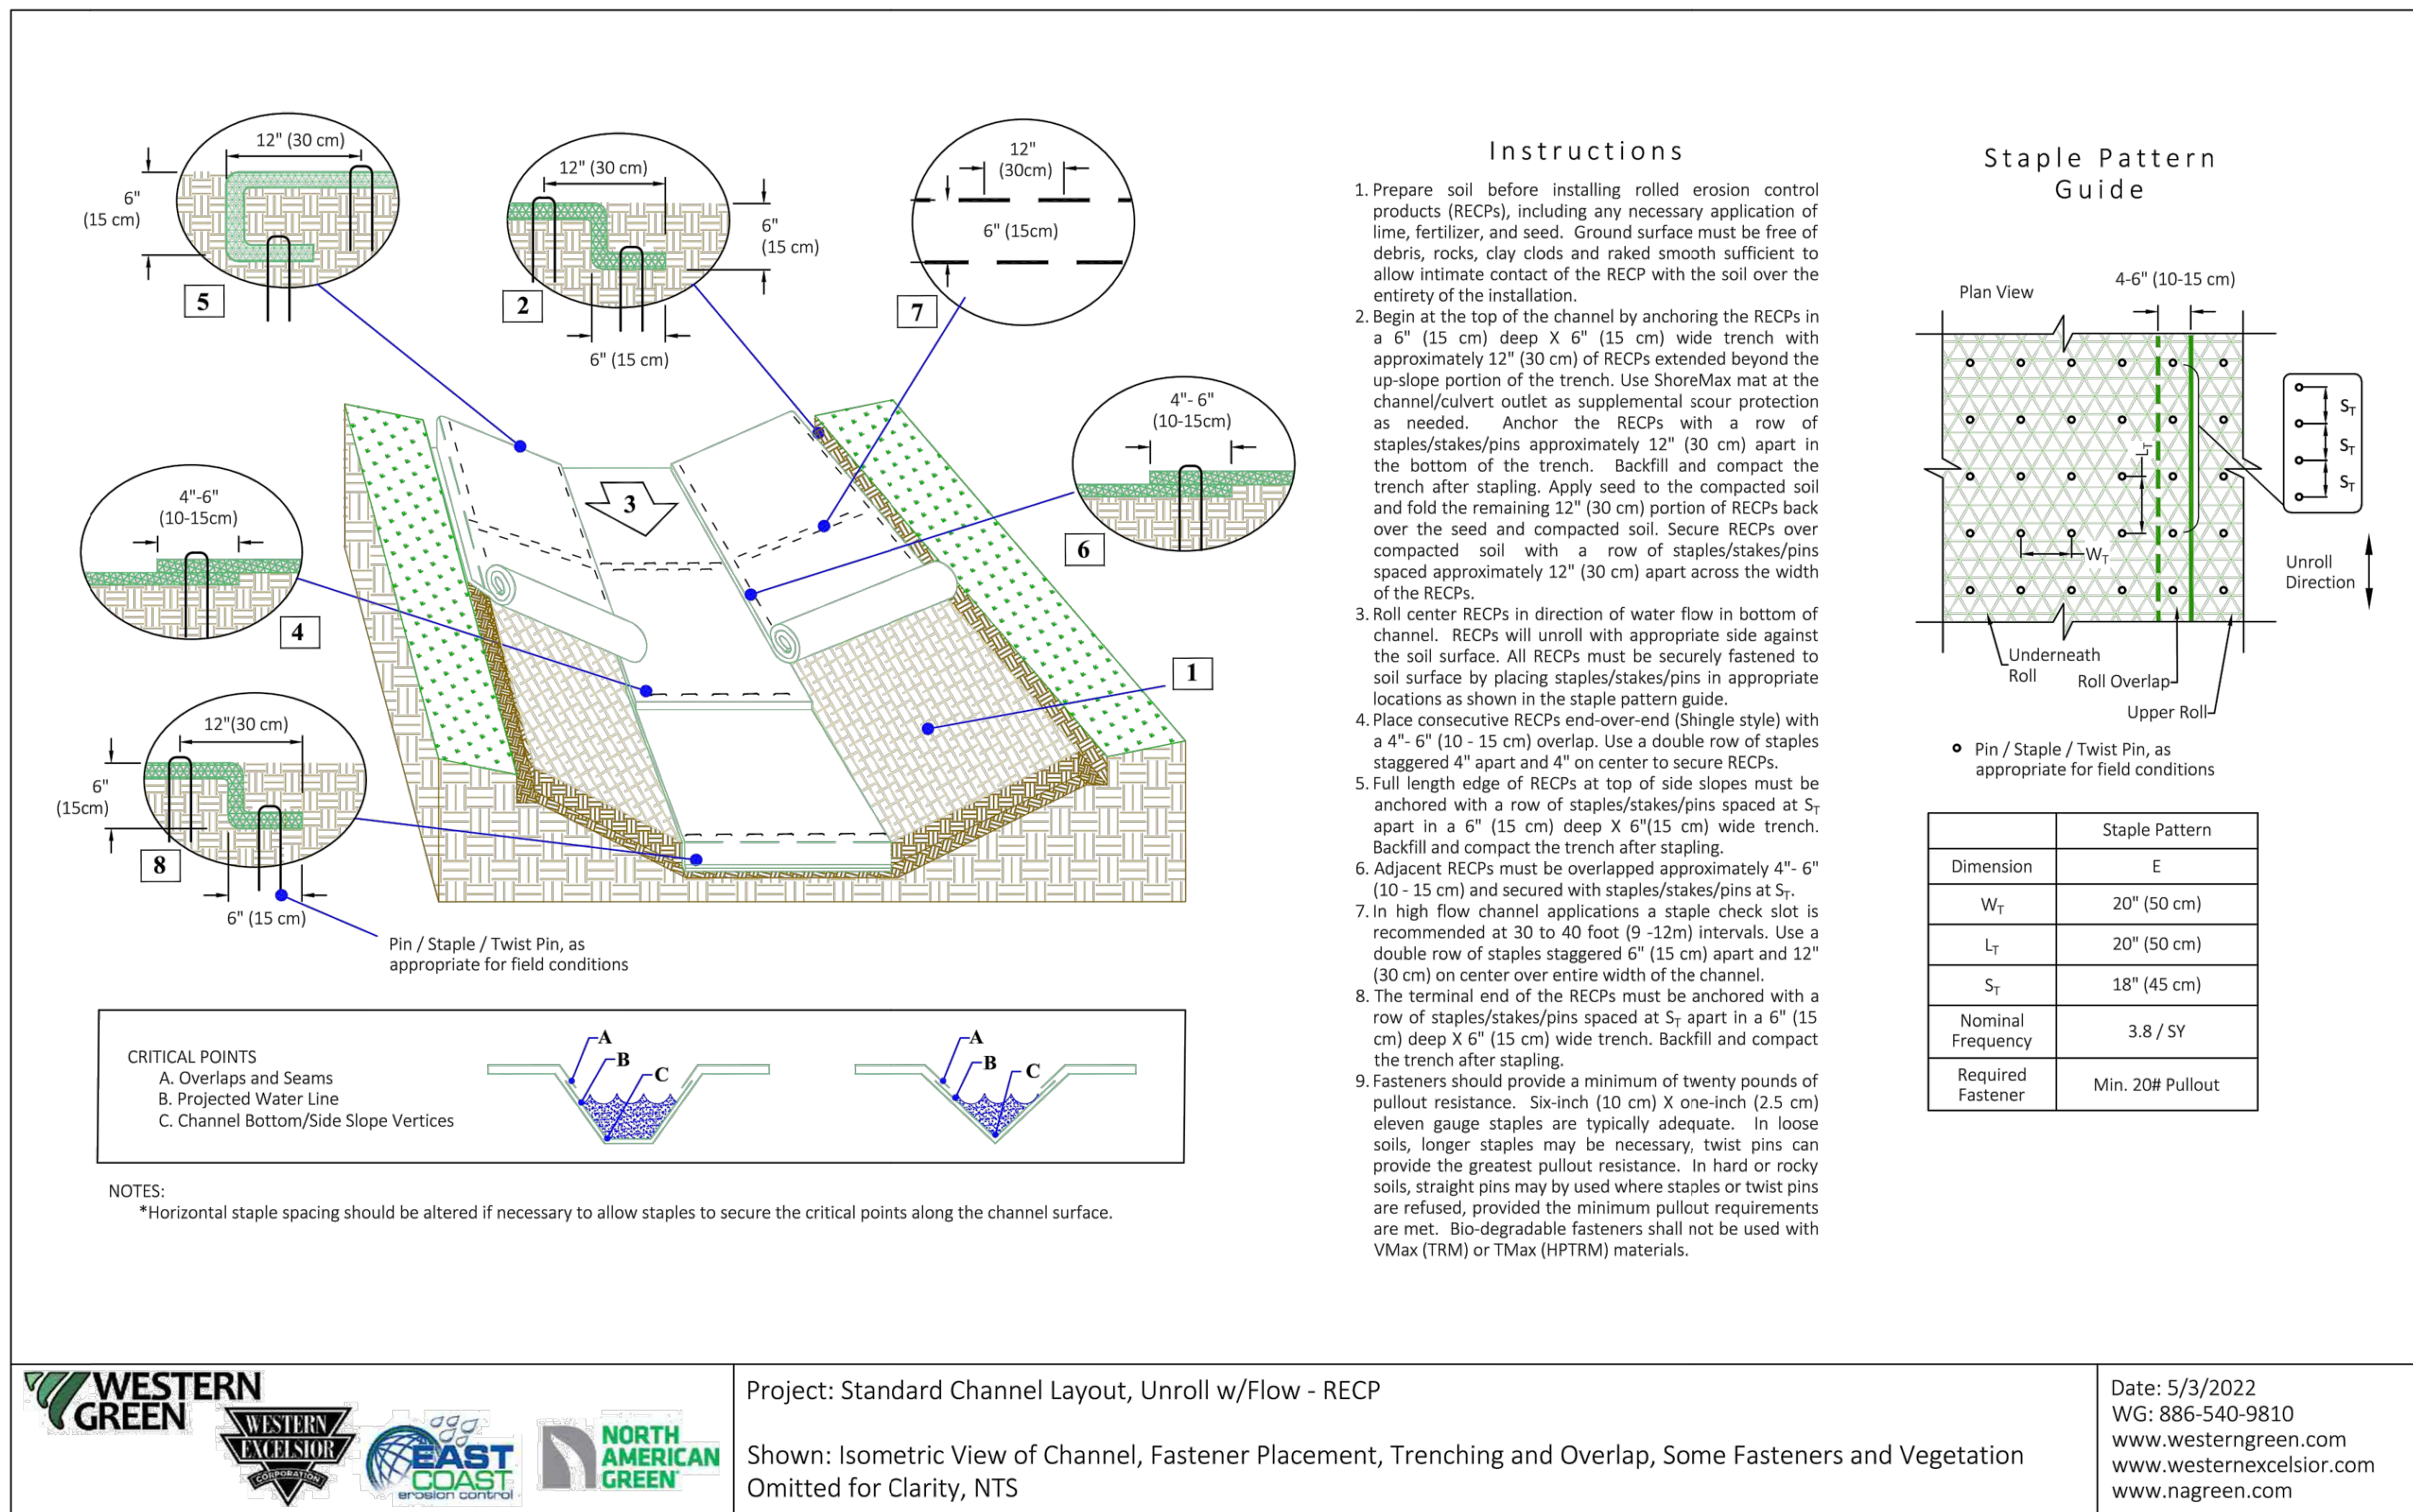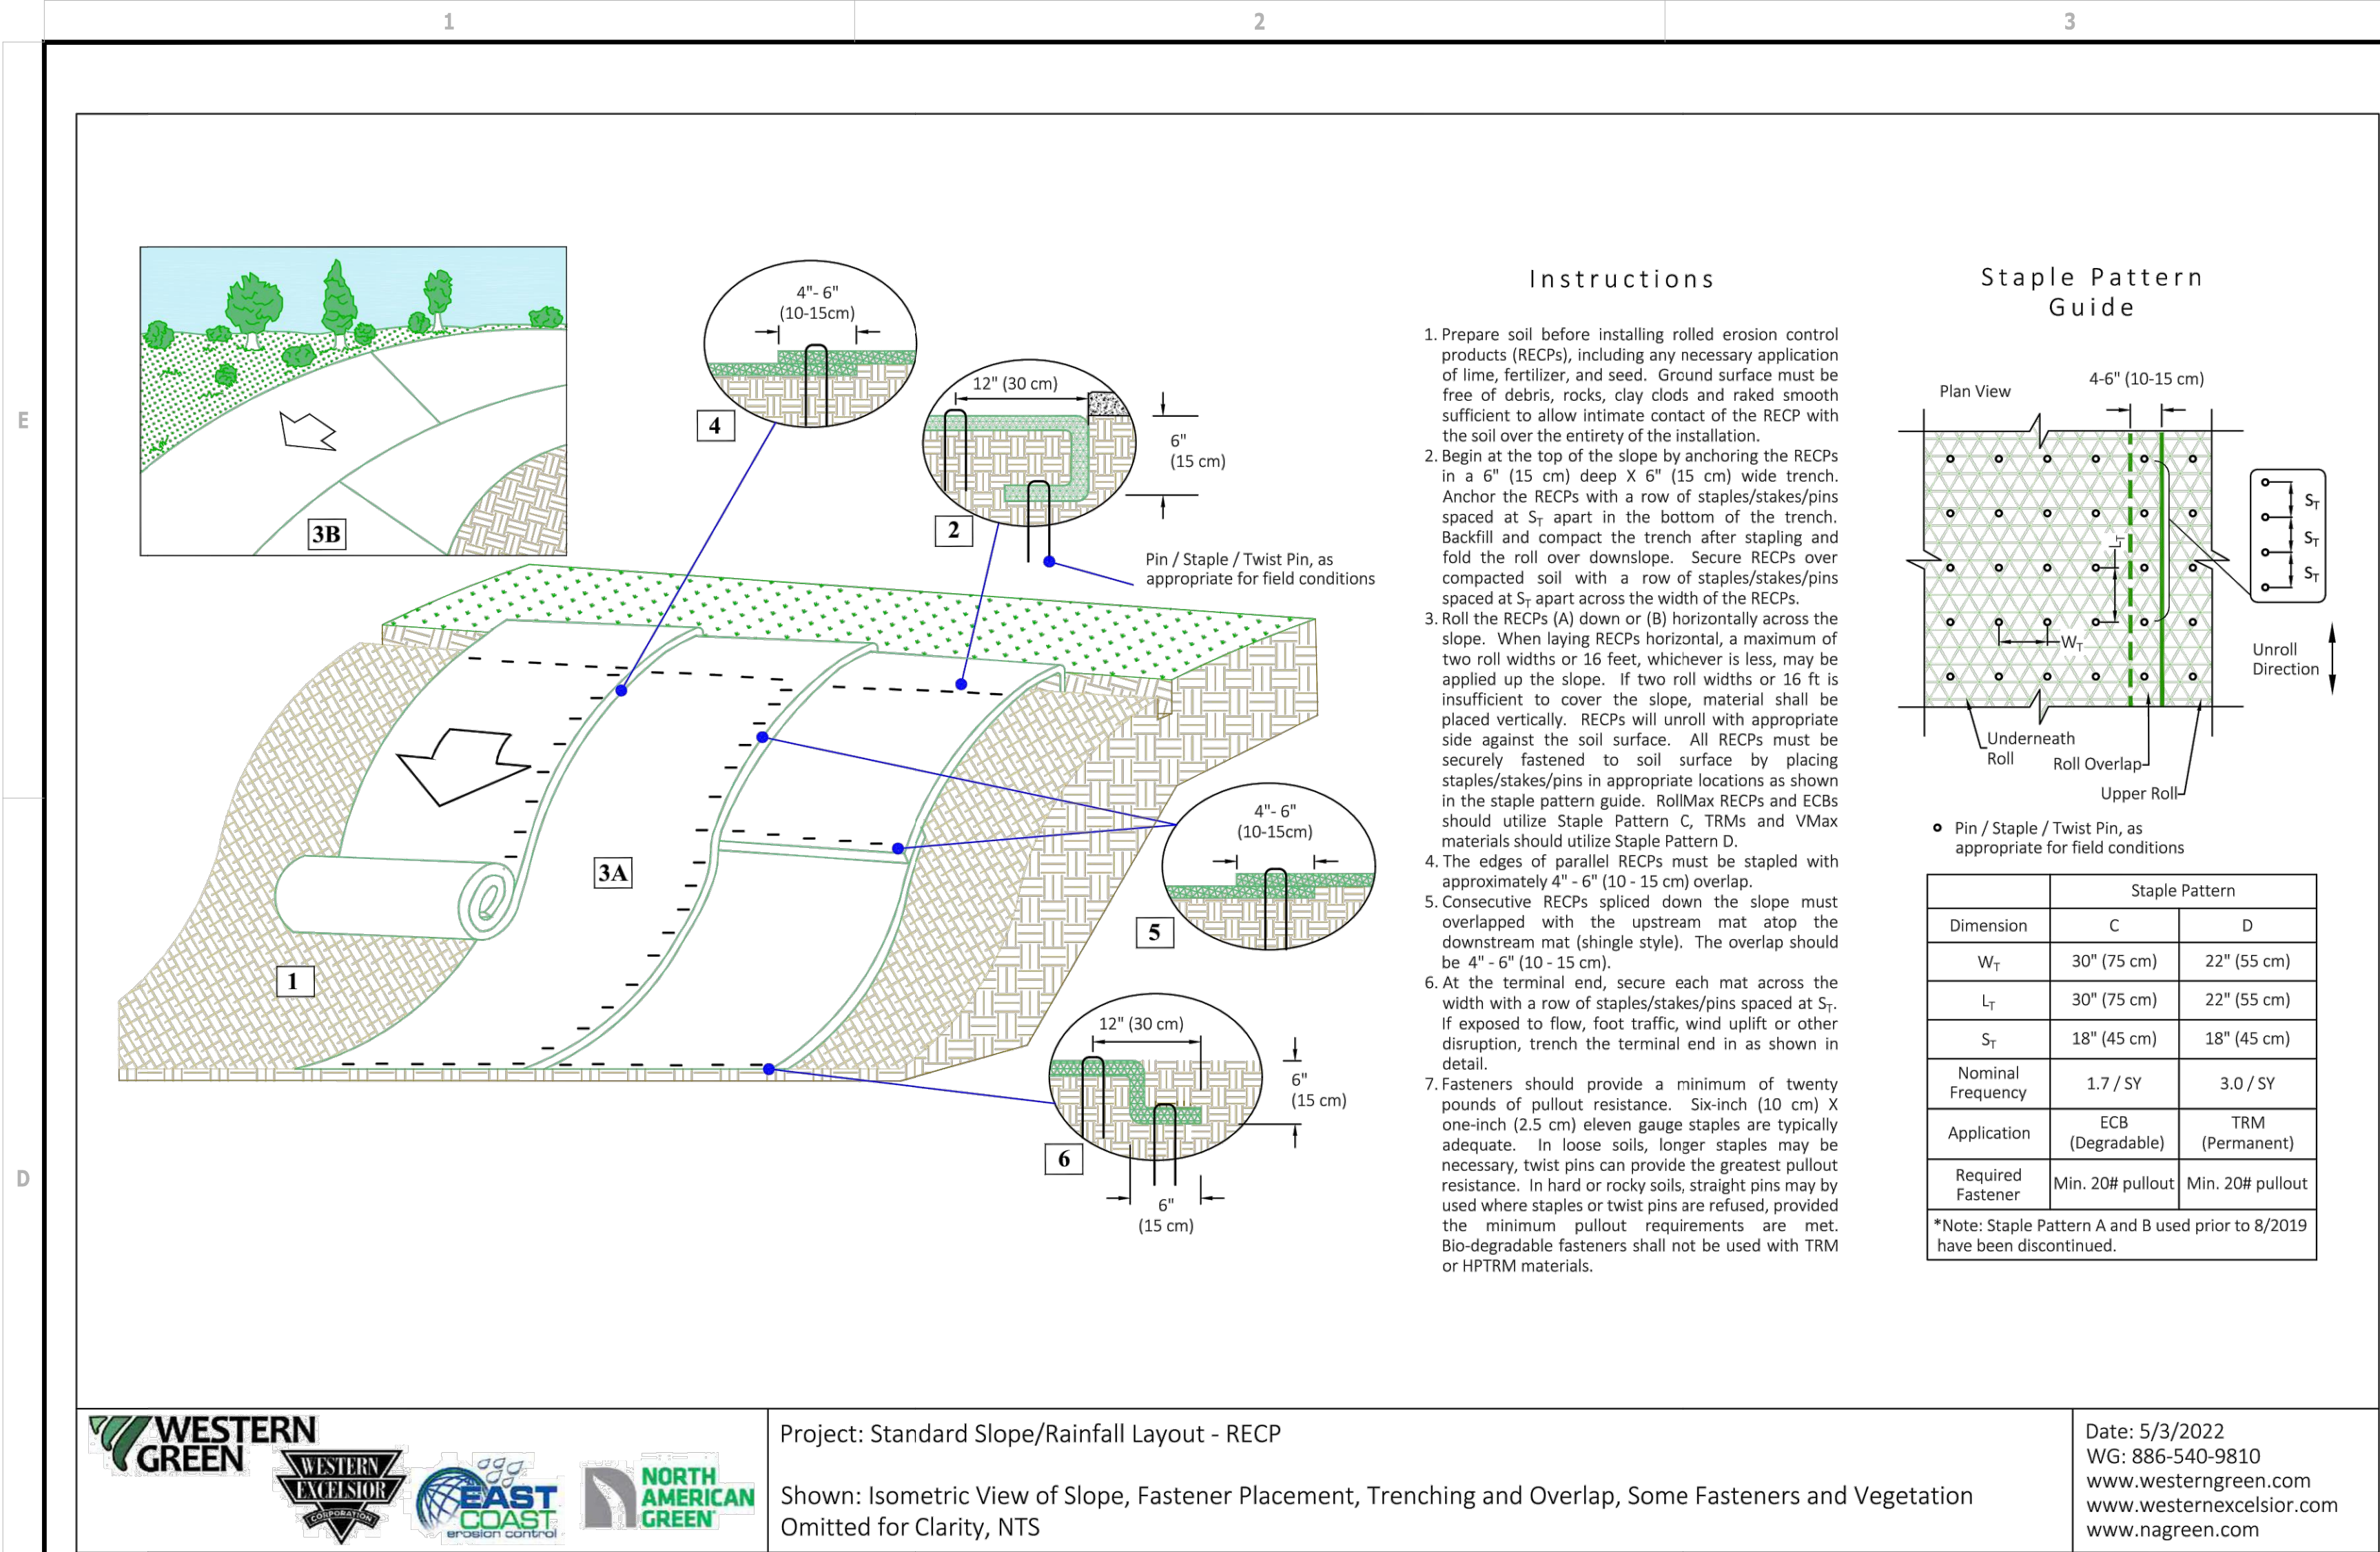

DESCRIPTION
ADDITIONAL 01
DATE
03/03/2023
REV
1

FOR
REFERENCE
ONLY

SANITATION BUILDING PROJECT - GP 1376
2801 REGENT AVE NE
CANTON, OHIO 44705

SWPP DETAILS

ISSUED FOR:	
PERMIT	02/06/2023
BID	02/06/2023
CONSTRUCTION	02/06/2023
RECORD	02/06/2023
PROJECT MANAGER	DESIGNER
MLH	TJW

JOB NO.
2020377.05

C-013

This document has not been reviewed by the stamping party. Therefore, the stamping party makes no representation(s) with respect to its contents, and shall not be liable for such. Any reliance on this stamp shall be at the relying party(ies)'s own risk and hereby waives any and all claim(s) related to the existence of the stamp or otherwise.

BENCHMARKS
STATE PLANE GRID NORTH, NAD 83 (2011),
OHIO NORTH ZONE.
ELEVATIONS ARE NAVD 88, GEOID 18.
TIED BY GPS TO THE O.D.O.T. VRS.

BENCHMARK #2 - MAG SPIKE ON SOUTH SIDE OF UTILITY POLE
N 425092, E 2289710
ELEVATION = 1060.95

BENCHMARK #4 - MAG SPIKE ON WEST SIDE OF UTILITY POLE
N 425103, E 2289980
ELEVATION = 1066.51

BENCHMARK #6 - NORTH EAST BONNET BOLT BETWEEN VILLE & ALA
N 425232, E 2290227
ELEVATION = 1077.30



UTILITIES SHOWN ON SURVEY WERE LOCATED
BASED ON FIELD MARKING PROVIDED BY OUP'S
REQUEST #A207700537 AND #A207700538.


E2 IDENTIFIED UNSUITABLE SOIL REMOVAL LIMITS
1"=60'

IDENTIFIED UNSUITABLE SOIL

1. PROPOSED LIMITS OF SOIL (67,775 SF) TO BE REMOVED FROM THE SITE AND BE DISPOSED OF OR OTHERWISE USED IN AN AREA NOT WITHIN THE SOURCE WATER PROTECTION AREAS OF THE CITY OF CANTON, OR ANY OTHER SOURCE WATER PROTECTION AREA, OR FOR RESIDENTIAL USE.
2. CONTRACTOR SHALL REMOVE 2' FROM FINISH GRADE. UNSUITABLE SOIL REMOVED = 5,020 CY
3. SOIL SAMPLES WERE ANALYZED IN JUNE 2022, WITH RESULTS PROVIDED IN SPECIFICATION SECTION 00 31 32.

LEGEND
(SEE SHEET C-001 FOR GENERAL LEGEND)


- EXISTING ASPHALT PAVEMENT TO BE SAWCUT AND REMOVED
- EXISTING CONCRETE PAVEMENT TO BE SAWCUT AND REMOVED
- EXISTING GRAVEL PAVEMENT TO BE REMOVED
- EXISTING TREE LIMITS TO BE REMOVED
- DEMOTES LIMITS OF SAWCUT
- DEMOLITION KEYNOTE

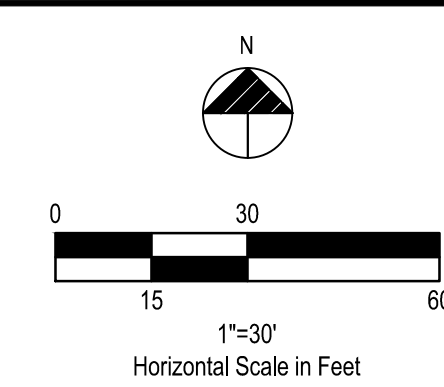

PLAN KEYNOTES

1. EXISTING ASPHALT CURB AND GUTTER TO BE REMOVED.
2. EXISTING GRAVEL PAVEMENT TO BE REMOVED.
3. EXISTING FENCE TO BE REMOVED.
4. EXISTING STRUCTURE AND APPURTENANCES TO BE REMOVED.
5. EXISTING ASP UTILITY POLE TO BE CAREFULLY REMOVED AND RELOCATED. CONTRACTOR SHALL CALL 1.800.672.2231 TO PREPARE THE WORK ORDER AND COORDINATE WITH MICHAEL BURNELL FOR THE REMOVAL AND RELOCATION. COST FOR RELOCATION WILL BE REIMBURSED AT OWNERS EXPENSE AT TIME OF RELOCATION.
6. EXISTING TREES AND BUSHES TO BE REMOVED.
7. EXISTING OVERHEAD POWER LINE TO BE REMOVED. CONTRACTOR TO COORDINATE WITH THE UTILITY COMPANY.
8. EXISTING PILE OF CONCRETE CONSTRUCTION DEBRIS TO BE REMOVED.
9. EXISTING 12" RCP DRIVE CULVERT TO BE CAREFULLY REMOVED AND DELIVERED PER OWNERS DIRECTION TO THE CITY.
10. EXISTING CHAINLINK FENCE GATE STOP TO BE REMOVED.
11. EXISTING CONCRETE BOLLARDS TO BE CAREFULLY REMOVED AND DELIVERED PER OWNERS DIRECTION TO THE CITY.
12. EXISTING ASPHALT TO BE SAWCUT AND REMOVED TO PROVIDE CLEAN EDGE FOR PROPOSED DRIVE CONNECTION.
13. EXISTING ASPHALT PAVEMENT AND BASE TO BE SAWCUT AND REMOVED.
14. EXISTING SALT DOME AND CONCRETE PADFOUNDATION BASE TO BE REMOVED. SEE ARCHITECTURAL DEMO PLAN.
15. EXISTING CATCH BASIN AND 18" STORM SEWER TO BE REMOVED.
16. EXISTING CATCH BASIN TO REMAIN AND BE PROTECTED THROUGHOUT CONSTRUCTION.
17. EXISTING UTILITY POLE TO REMAIN AND BE PROTECTED THROUGHOUT CONSTRUCTION.
18. EXISTING 6" STEEL GAS LINE TO REMAIN AND BE PROTECTED THROUGHOUT CONSTRUCTION.
19. EXISTING LIGHT POLE TO BE REMOVED.
20. EXISTING CATCH BASIN TO BE REMOVED AND REPLACED.

DEMOLITION NOTE:
ALL EXISTING SITE AND SURROUNDING FEATURES SUCH AS UTILITIES, PAVEMENT, CURB, LANDSCAPING, ETC. SHALL REMAIN AND BE PROTECTED THROUGHOUT CONSTRUCTION UNLESS NOTED OTHERWISE, OR ARE REQUIRED TO BE MODIFIED OR REMOVED FOR THE INSTALLATION OF PROPOSED IMPROVEMENTS. ALL DISTURBED FEATURES SHALL BE RESTORED OR RELOCATED AS REQUIRED TO THE SATISFACTION OF THE OWNER. CONTRACTOR SHALL REPAIR/REPLACE ANY SURROUNDING FEATURES DAMAGED AS A RESULT OF CONSTRUCTION ACTIVITIES AT NO ADDITIONAL COST AND TO THE SATISFACTION OF THE OWNER.

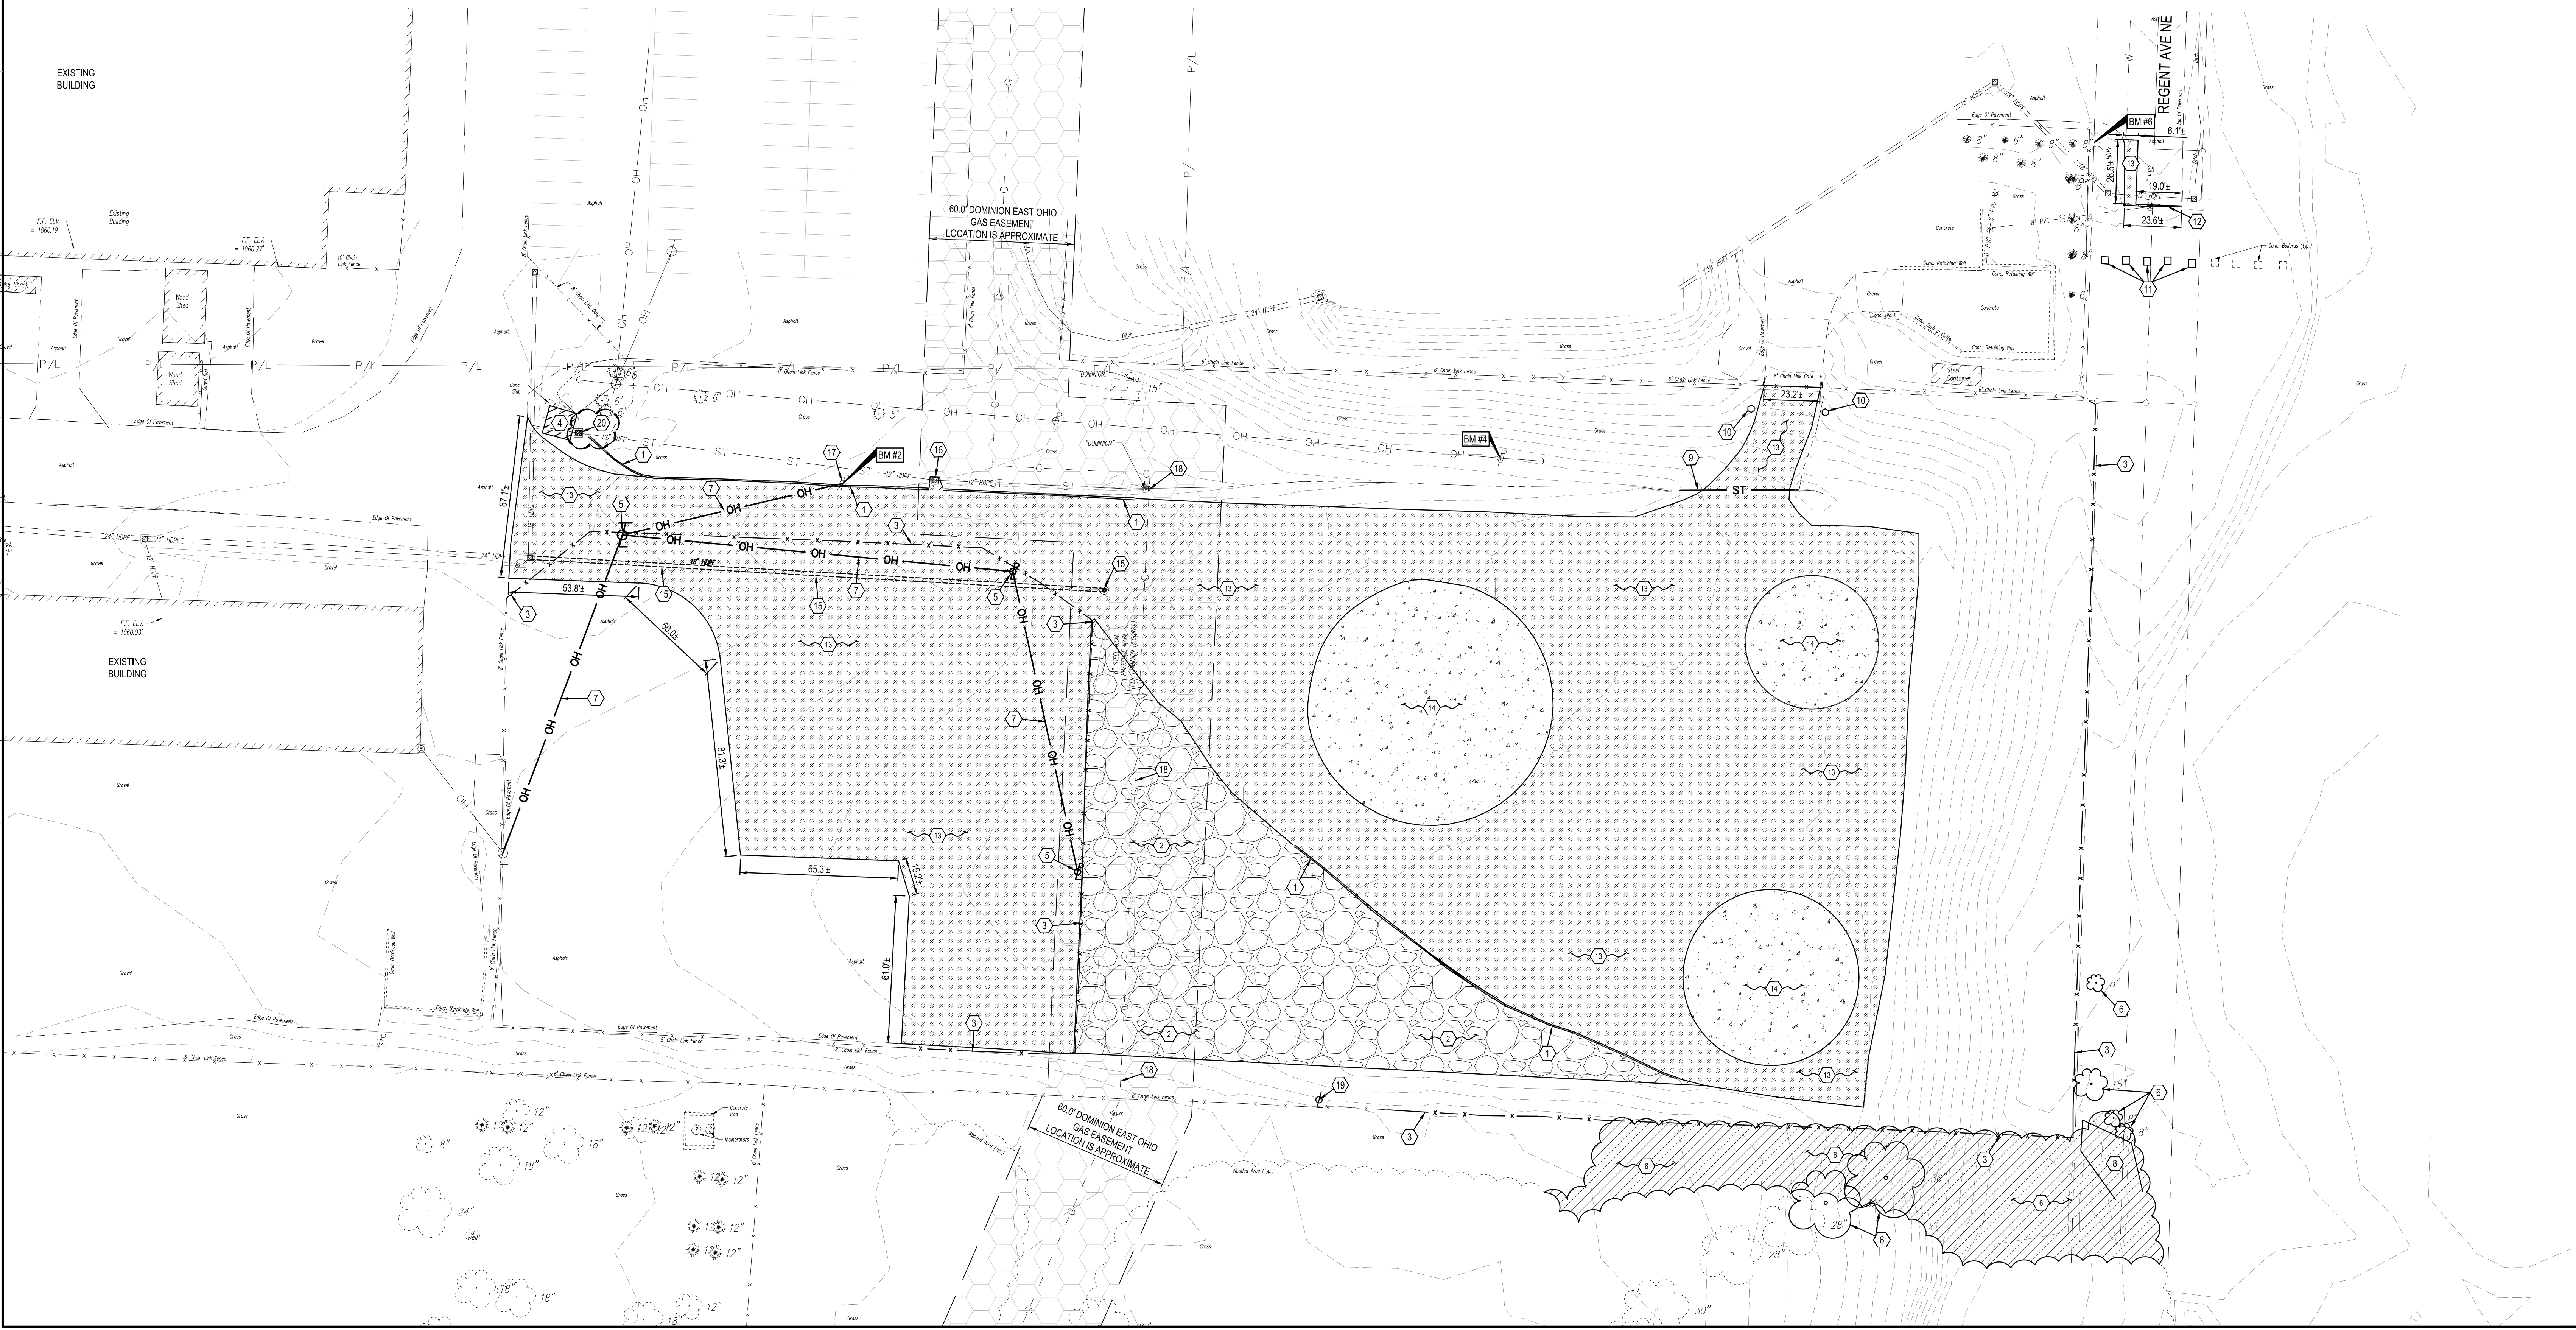

DESCRIPTION	
REV	DATE
1	03/03/2023
ADDITIONAL 01	

SANITATION BUILDING PROJECT - GP 1376
2801 REGENT AVENUE
CANTON, OHIO 44705

DEMOLITION PLAN

ISSUED FOR:	
PERMIT	02/06/2023
BID	02/06/2023
CONSTRUCTION	noted/none
RECORD	noted/none
PROJECT MANAGER	DESIGNER
MLH	TJW

JOB NO.
2020377.05

C-101


BENCHMARKS:
STATE PLANE GRID NORTH, NAD 83 (2011),
OHIO NORTH ZONE.
ELEVATIONS ARE NAVD 88, GEOID 18,
TIED BY GPS TO THE O.D.O.T. VRS.
BENCHMARK #2 - MAG SPIKE ON SOUTH SIDE OF UTILITY POLE
N 425092, E 2269710
ELEVATION = 1060.95
BENCHMARK #1 - MAG SPIKE ON WEST SIDE OF UTILITY POLE
N 425103, E 2269880
ELEVATION = 1066.51
BENCHMARK #6 - NORTH EAST BONNET BOLT BETWEEN VILLE & ALA
N 425232, E 2292027
ELEVATION = 1077.30.



UTILITIES SHOWN ON SURVEY WERE LOCATED
BASED ON FIELD MARKING PROVIDED BY OUPS
REQUEST #A207700537 AND #A207700538.


LEGEND
(SEE SHEET C-001 FOR GENERAL LEGEND)

- PROPOSED STANDARD DUTY ASPHALT, SEE SHEET C-501.
- PROPOSED HEAVY DUTY ASPHALT, SEE SHEET C-501.
- PROPOSED CONCRETE
- CONSTRUCTION KEYNOTE
- PROPOSED PARKING SPACE NUMBER

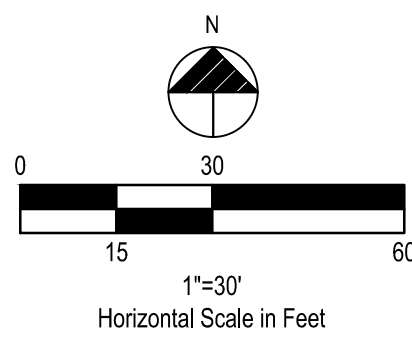

PLAN KEYNOTES

- PROPOSED CONCRETE CURB, SEE SHEET C-501.
- PROPOSED FLUSH CONCRETE CURB, SEE SHEET C-501.
- PROPOSED CONCRETE CURB TAPER, SEE SHEET C-501.
- PROPOSED CONCRETE CURBED WALK, SEE SHEET C-501.
- PROPOSED CONCRETE WALK, SEE SHEET C-501.
- PROPOSED 30' TALL FLAGPOLE WITH LIGHTS, SEE SHEET C-504 AND ELECTRICAL SHEETS. FLAG POLE FOUNDATION TO BE PER MANUFACTURERS SPECIFICATION.
- PROPOSED HANDICAP PARKING SIGN, SEE SHEET C-501.
- PROPOSED LANDSCAPING AREA, CONTRACTOR SHALL SEED ALL DISTURBED AREAS, SEE SHEET C-010 FOR SEEDING NOTES.
- PROPOSED PAINTED TRANSVERSE STRIPING, SEE SHEET C-501.
- PROPOSED PAINTED 4" WIDE SOLID STRIPE - WHITE ON ASPHALT, YELLOW ON CONCRETE.
- PROPOSED PAINTED INTERNATIONAL ADA SYMBOL PER ADA SPECIFICATIONS AND SHEET C-501.
- PROPOSED ADA ACCESSIBLE RAMP PER ADA SPECIFICATIONS AND SHEET C-501.
- PROPOSED FROST SLAB AT DOOR. SEE STRUCTURAL DRAWINGS FOR DETAIL.
- PROPOSED 6' CHAIN LINK FENCE WITH BARBED WIRE, SEE SHEET C-501. CONTRACTOR SHALL REMOVE EXISTING PAVEMENT AS NECESSARY FOR INSTALLATION OF PROPOSED FENCE POLES
- PROPOSED 28' ROLLING MANUAL SLIDING GATE (OR APPROVED EQUAL) WITH FUTURE ENTRANCE KEYPAD AND GATE MOTOR PER SHEET C-504.
- PROPOSED 28' ROLLING MOTORIZED SLIDING GATE (OR APPROVED EQUAL) WITH ENTRANCE KEYPAD (NORTH SIDE) AND EXIT SENSOR LOOP (SOUTH SIDE) PER SHEET C-504.
- PROPOSED 28' ROLLING MOTORIZED SLIDING GATE (OR APPROVED EQUAL) WITH ENTRANCE KEYPAD (NORTH SIDE) AND EXIT SENSOR LOOP (SOUTH SIDE) PER SHEET C-504.
- PROPOSED LIFT STATION, SEE SHEET C-132.
- PROPOSED GRAVEL BERM, SEE SHEET C-501.
- PROPOSED 10' CONCRETE APRON, SEE SHEET C-501.
- PROPOSED DETERRENT BOLLARD, SEE SHEET C-501.
- PROPOSED BIORETENTION, SEE SHEET C-012.
- PROPOSED 8' WIDE X 24' LONG ROCK CHANNEL PROTECTION, SEE SHEET C-501.
- PROPOSED FUTURE GATE MOTOR.
- PROPOSED MECHANICAL UNITS, SEE MECHANICAL PLANS.
- PROPOSED LEVEL SPREADER, SEE SHEET C-504.
- PROPOSED GENERATOR, SEE ELECTRICAL SHEETS.
- PROPOSED TRANSFORMER, SEE ELECTRICAL SHEETS.
- PROPOSED FREE STANDING CURB, SEE SHEET C-501.

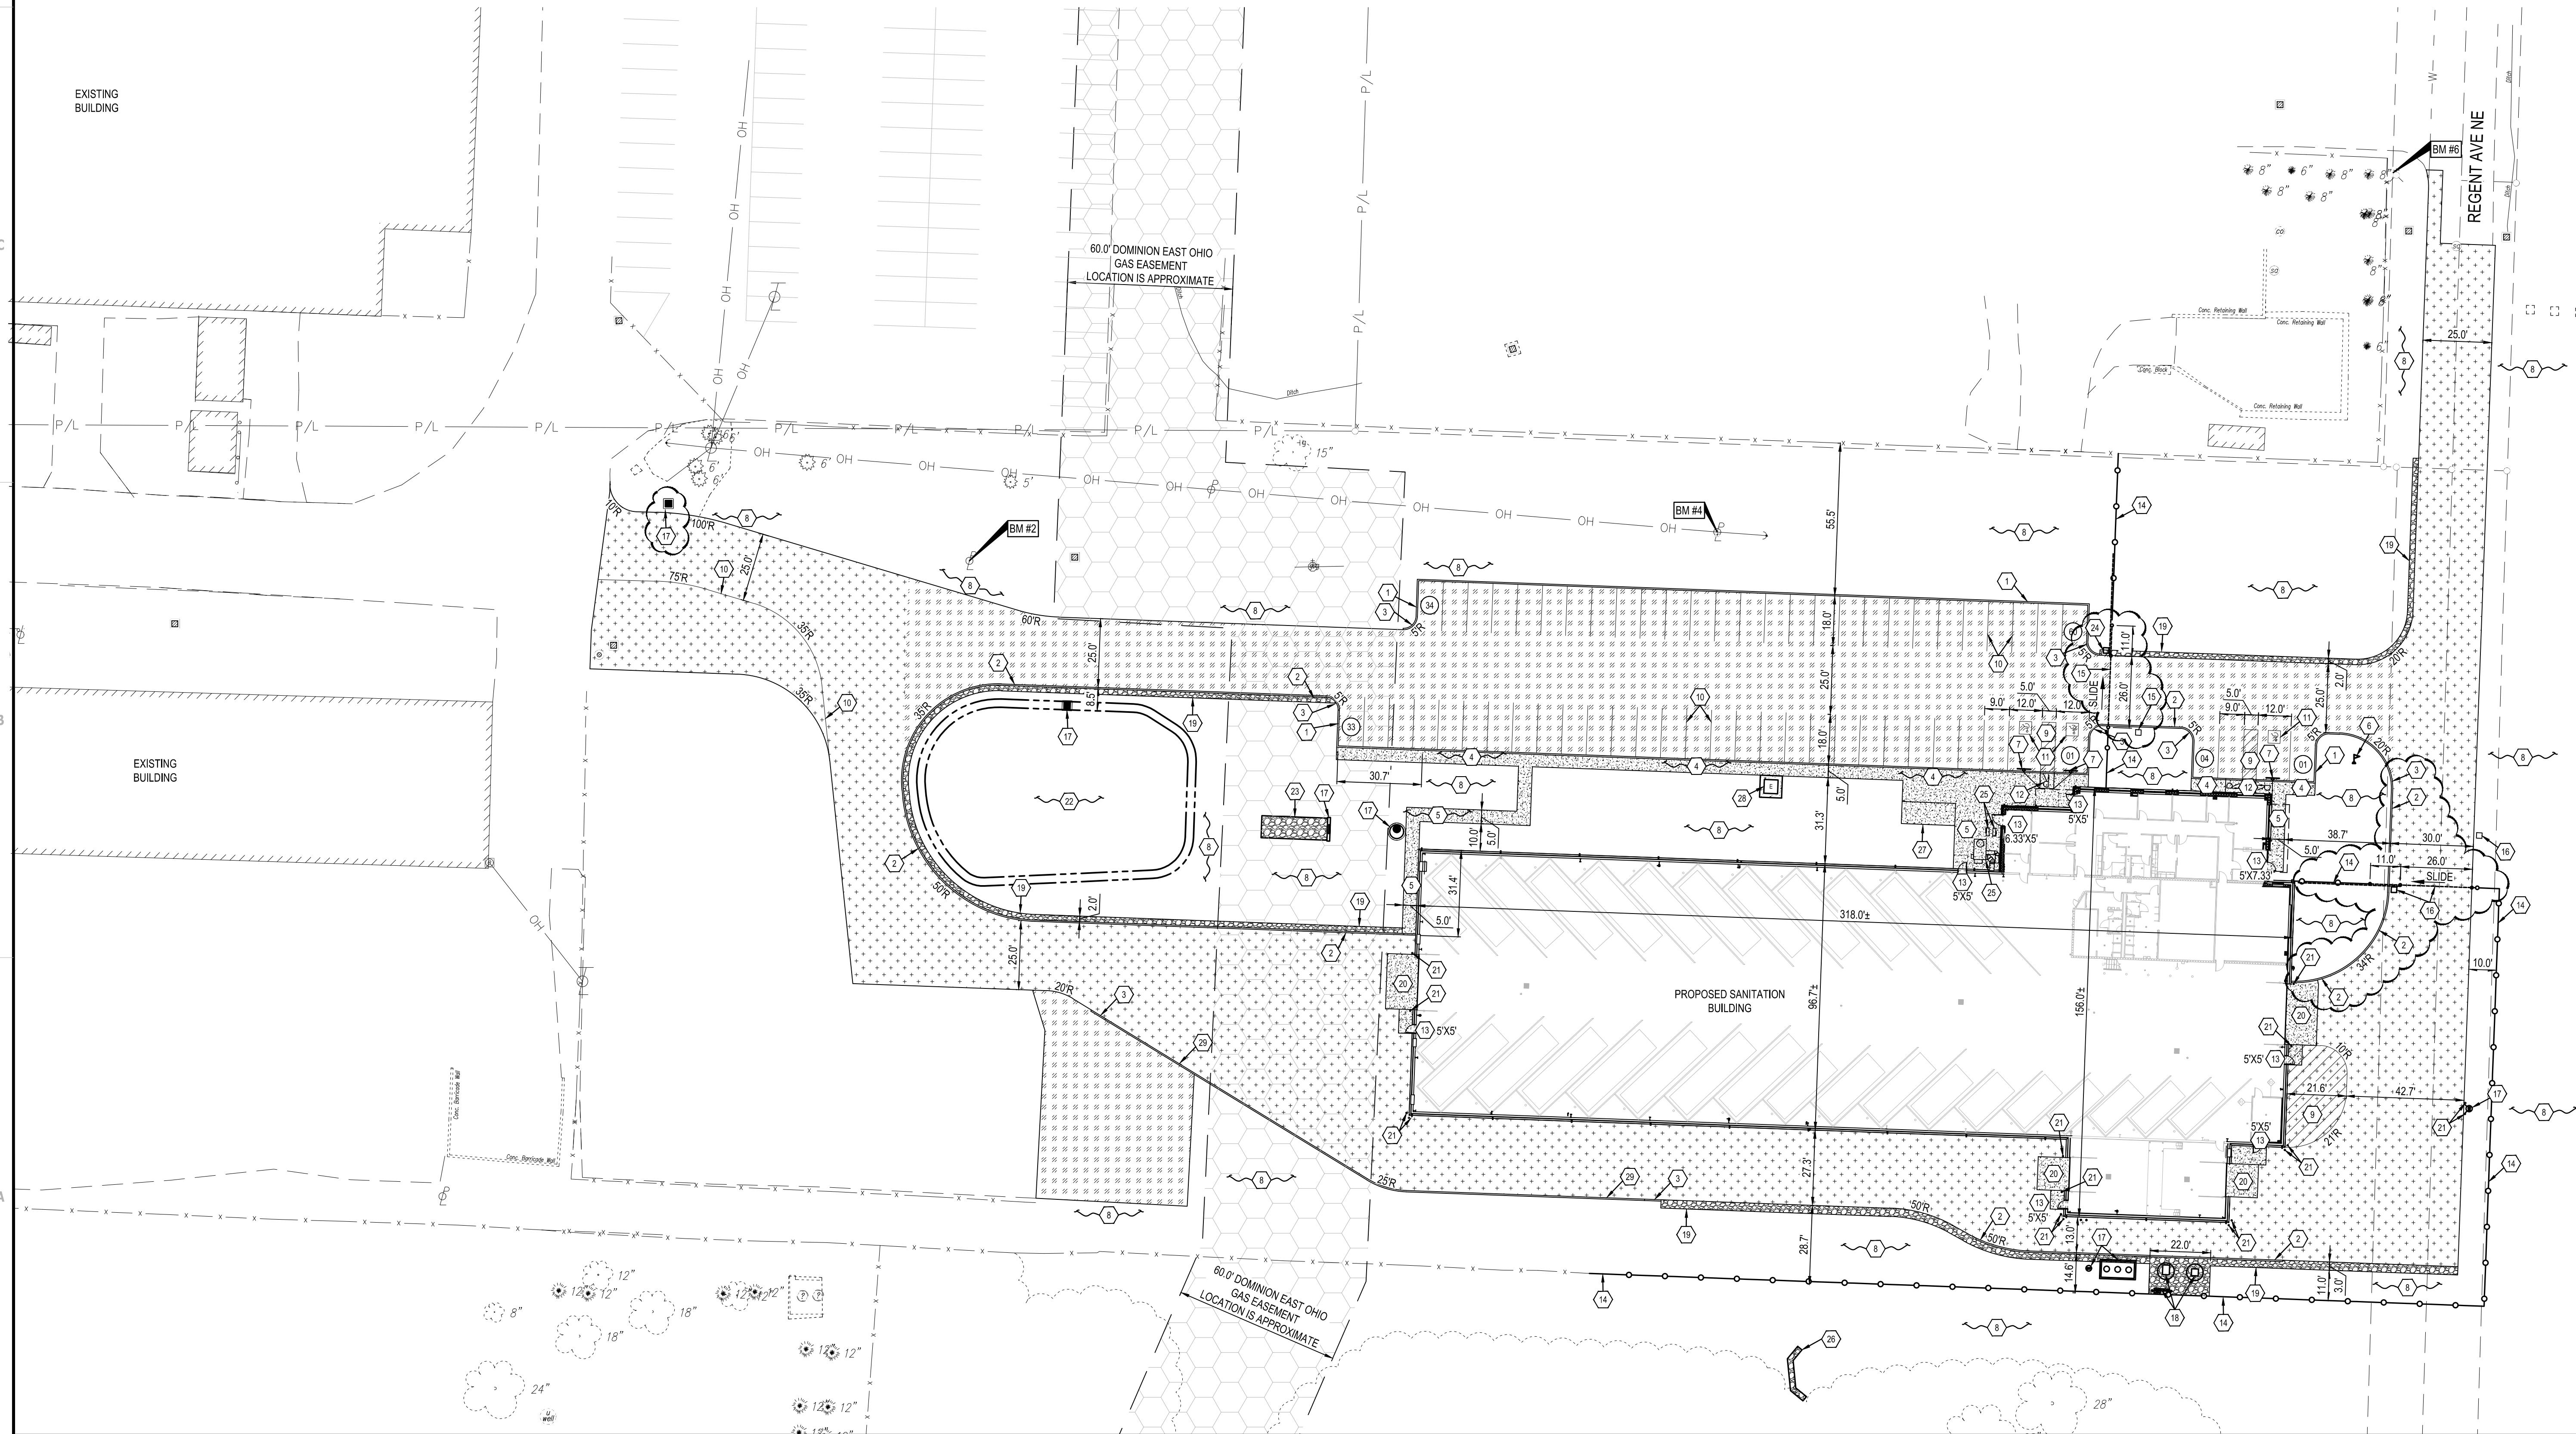

DESCRIPTION

ADDITIONAL 01

DATE

03/03/2023

REV

1

SANITATION BUILDING PROJECT - GP 1376
2801 REGENT AVENUE,
CANTON, OHIO 44705

SITE PLAN

ISSUED FOR:


PERMIT	02/06/2023
BID	02/06/2023
CONSTRUCTION	noted
RECORD	noted

PROJECT MANAGER	DESIGNER
MLH	TJW

JOB NO.
2020377.05

C-111

Drawing Name: C:\2020\2020377\05 - Sanitation Building\1 - Working Files\00_CAD (2020)\C\Sheets\2020377.05 Plan
Grading.dwg
March 17, 2023 12:29 PM - hngit

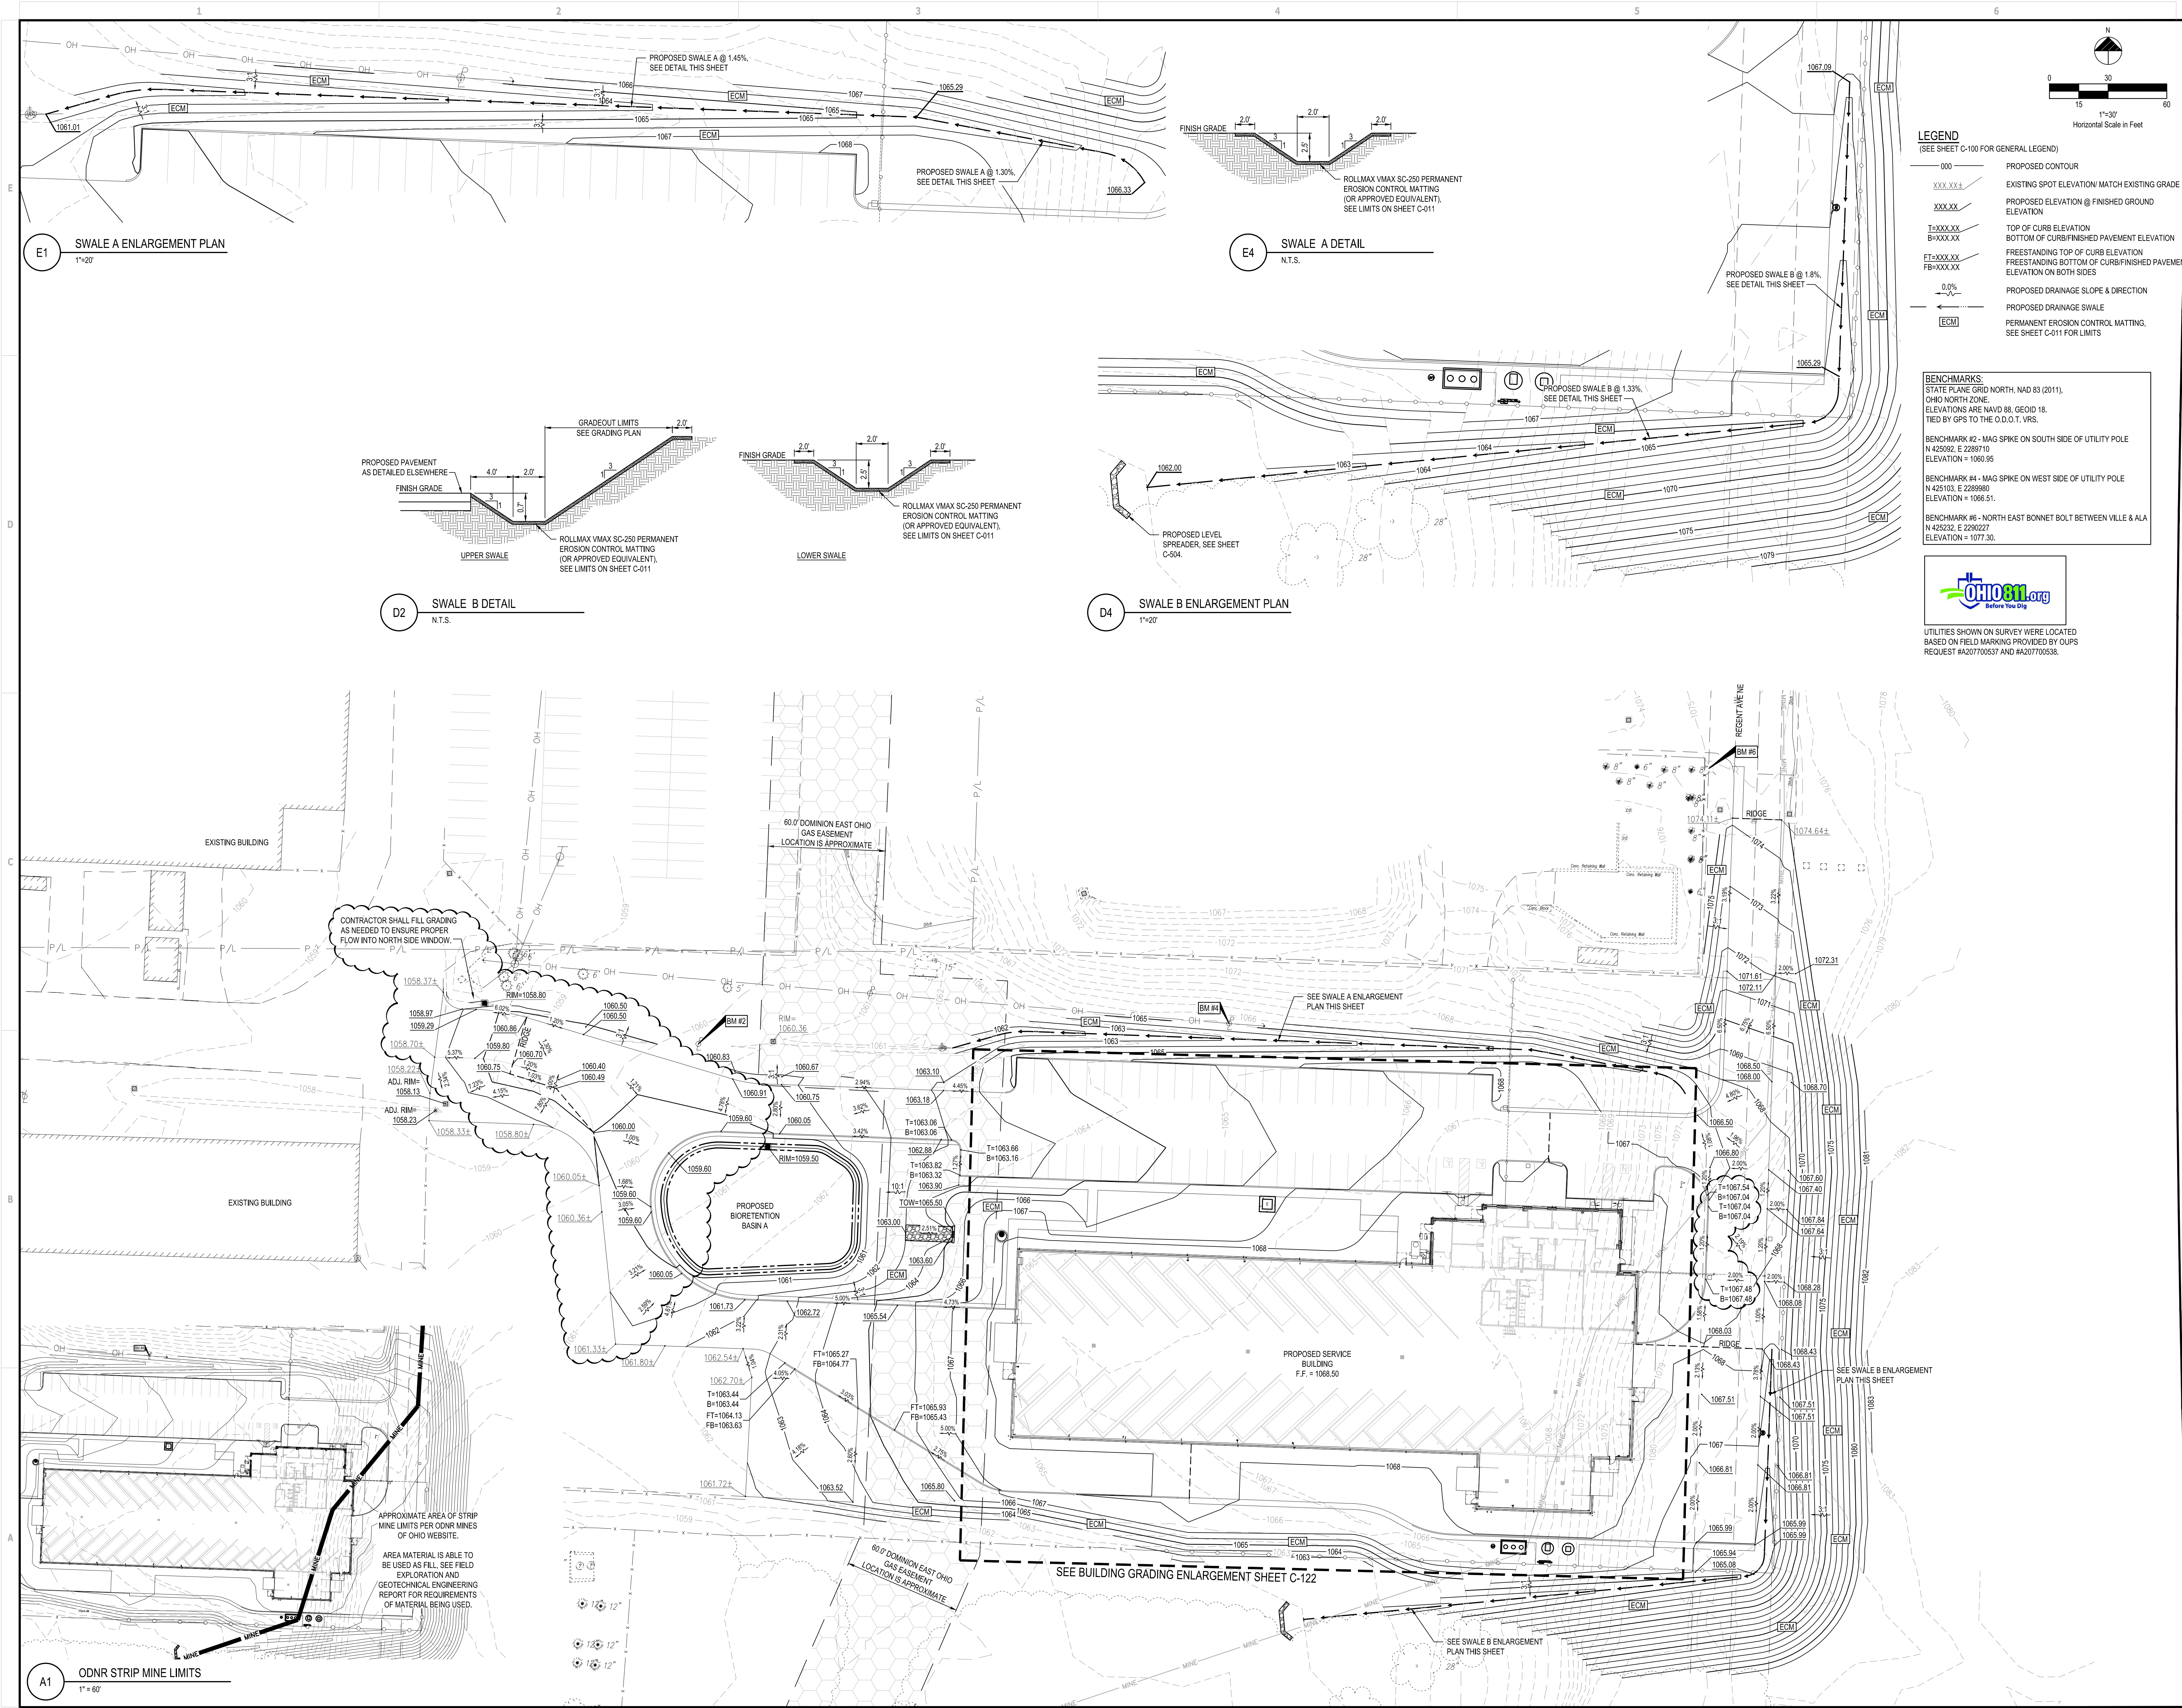

- LEGEND**
(SEE SHEET C-100 FOR GENERAL LEGEND)
- PROPOSED CONTOUR
 - XXX.XX+/- EXISTING SPOT ELEVATION/ MATCH EXISTING GRADE
 - XXX.XX PROPOSED ELEVATION @ FINISHED GROUND ELEVATION
 - T=XXX.XX, B=XXX.XX TOP OF CURB ELEVATION, BOTTOM OF CURB/ FINISHED PAVEMENT ELEVATION
 - FT=XXX.XX, FB=XXX.XX FREESTANDING TOP OF CURB ELEVATION, FREESTANDING BOTTOM OF CURB/ FINISHED PAVEMENT ELEVATION ON BOTH SIDES
 - 0.0% PROPOSED DRAINAGE SLOPE & DIRECTION
 - ECM PROPOSED DRAINAGE SWALE
 - PERMANENT EROSION CONTROL MATTING, SEE SHEET C-011 FOR LIMITS

BENCHMARKS:
STATE PLANE GRID NORTH, NAD 83 (2011), OHIO NORTH ZONE.
ELEVATIONS ARE NAVD 88, GEOID 18, TIED BY GPS TO THE O.D.O.T. VRS.

BENCHMARK #2 - MAG SPIKE ON SOUTH SIDE OF UTILITY POLE N 425092, E 2289710
ELEVATION = 1060.95

BENCHMARK #4 - MAG SPIKE ON WEST SIDE OF UTILITY POLE N 425103, E 2289980
ELEVATION = 1066.51

BENCHMARK #6 - NORTH EAST BONNET BOLT BETWEEN VILLE & ALA N 425232, E 2290227
ELEVATION = 1077.30



UTILITIES SHOWN ON SURVEY WERE LOCATED BASED ON FIELD MARKING PROVIDED BY OUPS REQUEST #4207700537 AND #4207700538.

DESCRIPTION		
REV	DATE	DESCRIPTION
1	03/03/2023	ADDITIONAL 01

SANITATION BUILDING PROJECT - GP 1376
2801 REGENT AVENUE
CANTON, OHIO 44705

GRADING PLAN

ISSUED FOR:	
PERMIT	02/06/2023
BID	02/06/2023
CONSTRUCTION	noted/none
RECORD	noted/none
PROJECT MANAGER	DESIGNER
MLH	TJW


JOB NO.
2020377.05

C-121




UTILITIES SHOWN ON SURVEY WERE LOCATED
BASED ON FIELD MARKING PROVIDED BY UFS
REQUEST #A207700537 AND #A207700538.

- LEGEND**
(SEE SHEET C-100 FOR GENERAL LEGEND)
- 000--- PROPOSED CONTOUR
 - XXX.XX+ EXISTING SPOT ELEVATION MATCH EXISTING GRADE
 - XXX.XX- PROPOSED ELEVATION @ FINISHED GROUND ELEVATION
 - T=XXX.XX TOP OF CURB ELEVATION
 - B=XXX.XX BOTTOM OF CURB/FINISHED PAVEMENT ELEVATION
 - FT=XXX.XX FREESTANDING TOP OF CURB ELEVATION
 - FB=XXX.XX FREESTANDING BOTTOM OF CURB/FINISHED PAVEMENT ELEVATION ON BOTH SIDES
 - 0.0% PROPOSED DRAINAGE SLOPE & DIRECTION
 - ADA--- LIMITS OF ADA ROUTING

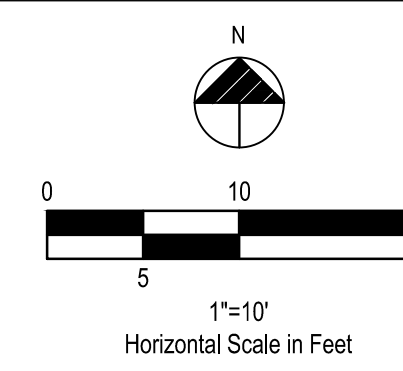

520 South Main Street, Suite 201
Akron, OH 44311
330.912.2100 Fax 330.912.2101
Copyright © Ohio, Pyle, Schomer, Burns & DeFonzo, Inc. 2023

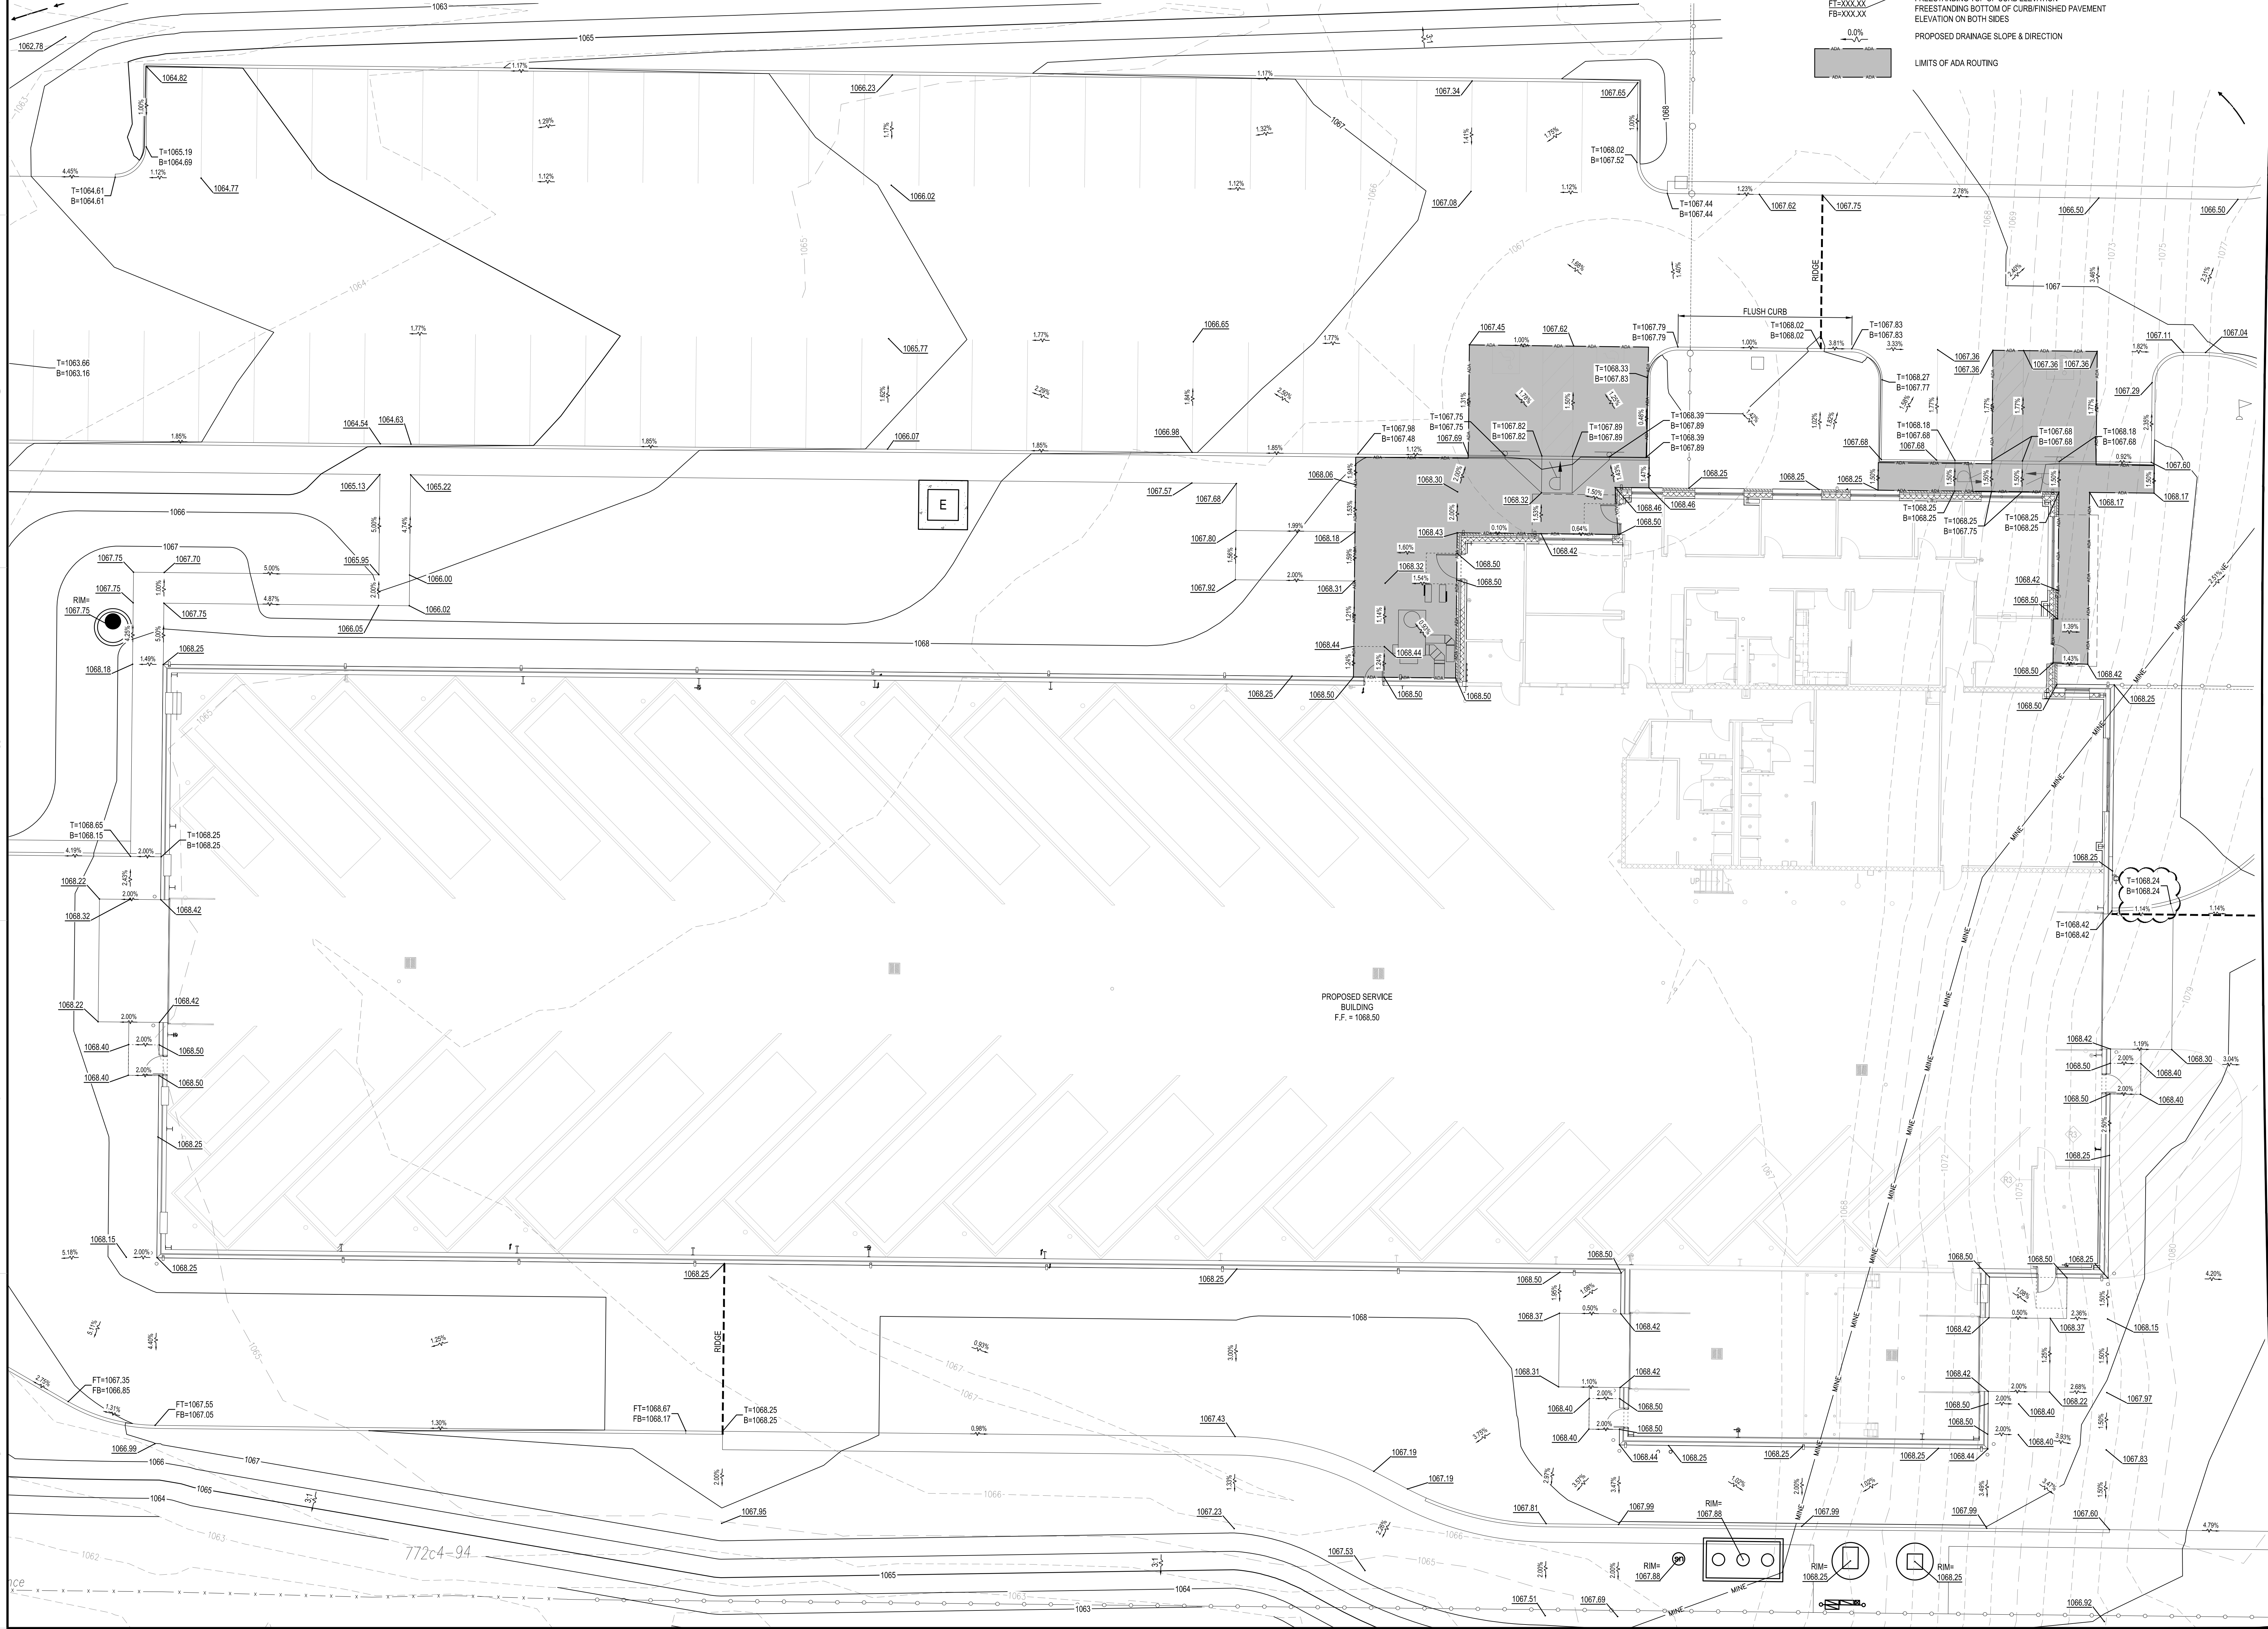

REV	DATE	DESCRIPTION
1	03/03/2023	ADDITIONAL 01

SANITATION BUILDING PROJECT - GP 1376
2801 REGENT AVENUE,
CANTON, OHIO 44705

BUILDING GRADING ENLARGEMENT

ISSUED FOR:	
PERMIT	02/06/2023
BID	02/06/2023
CONSTRUCTION	noted/none
RECORD	noted/none
PROJECT MANAGER	DESIGNER
MLH	TJW

JOB NO.
2020377.05


C-122

Drawing Name: O:\2020\2020377\05 - Sanitation Building\Working Files\00_CAD (2020)\C\Sheets\2020377.05 Plan
Grading.dwg
March 1, 2023 2:30 PM - Night


BENCHMARKS:
STATE PLANE GRID NORTH, NAD 83 (2011),
OHIO NORTH ZONE,
ELEVATIONS ARE NAVD 88, GEOID 18,
TIED BY GPS TO THE O.D.O.T. VRS.
BENCHMARK #2 - MAG SPIKE ON SOUTH SIDE OF UTILITY POLE
N 425092, E 2269710
ELEVATION = 1060.95
BENCHMARK #4 - MAG SPIKE ON WEST SIDE OF UTILITY POLE
N 425103, E 2269880
ELEVATION = 1066.51
BENCHMARK #6 - NORTH EAST BONNET BOLT BETWEEN VILLE & ALA
N 425232, E 2269227
ELEVATION = 1077.30.



UTILITIES SHOWN ON SURVEY WERE LOCATED
BASED ON FIELD MARKING PROVIDED BY OUPS
REQUEST #420770537 AND #420770538.

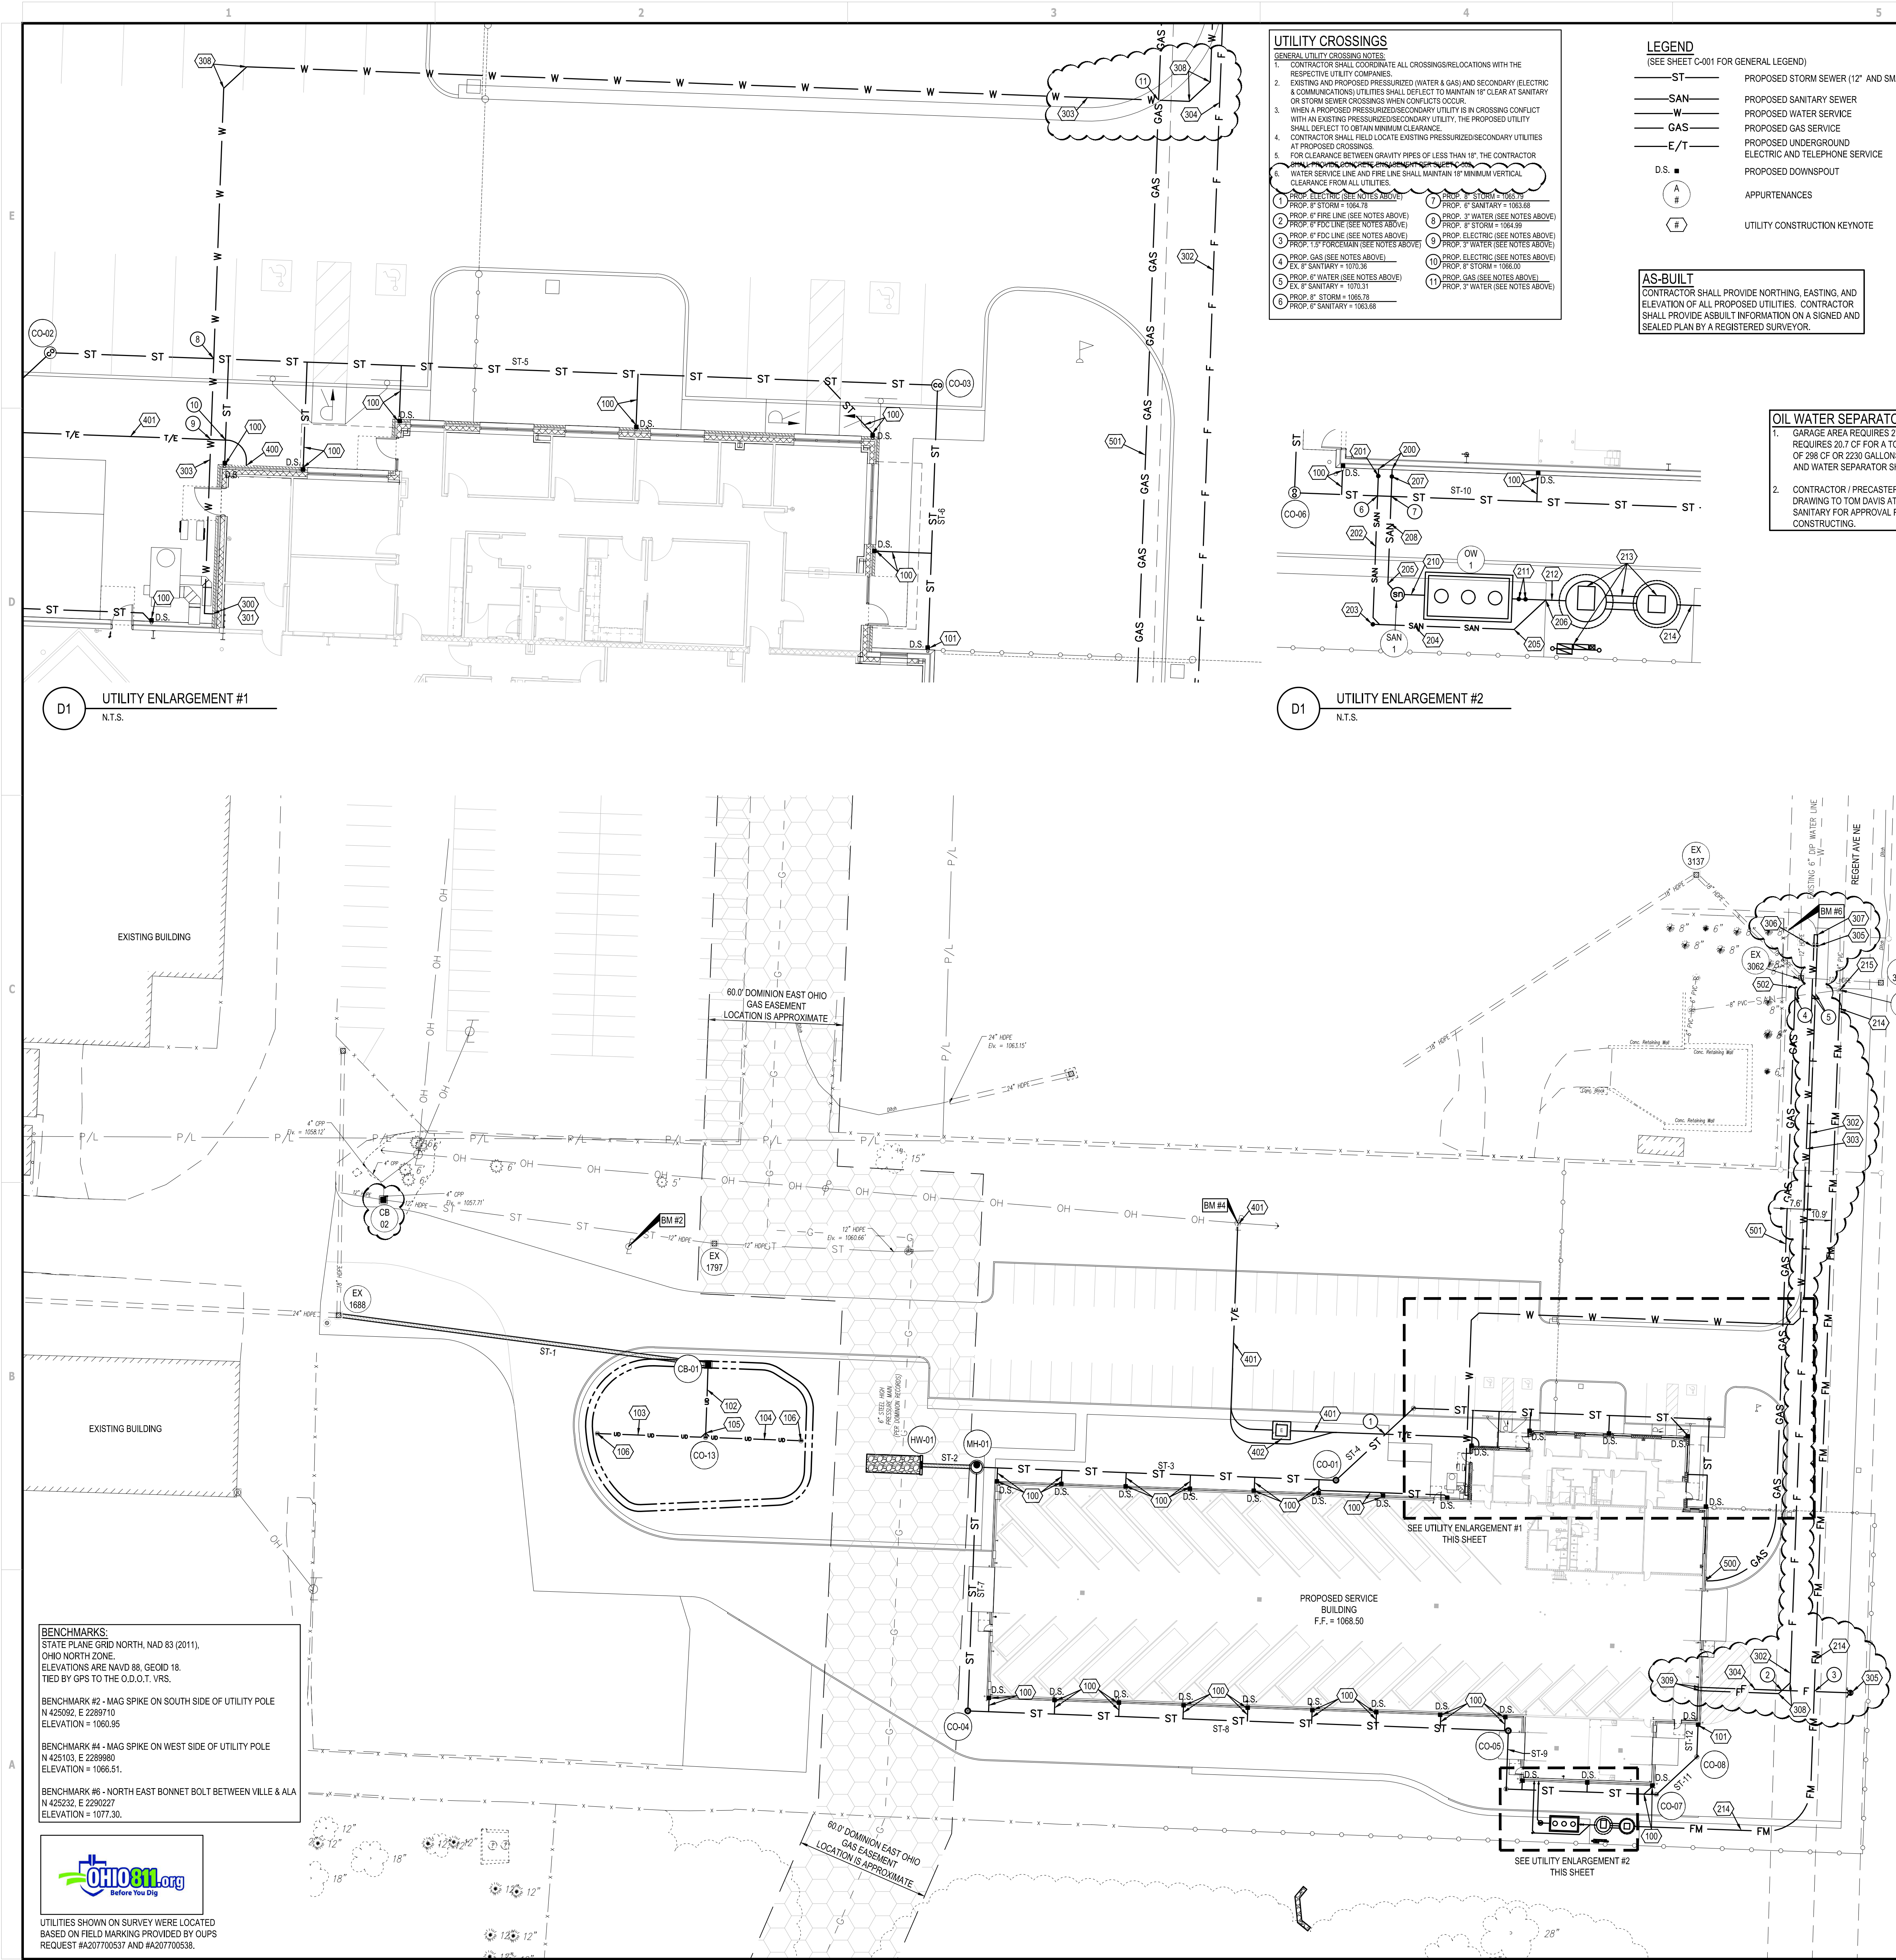

- UTILITY CROSSINGS**
GENERAL UTILITY CROSSING NOTES:
1. CONTRACTOR SHALL COORDINATE ALL CROSSINGS/RELOCATIONS WITH THE RESPECTIVE UTILITY COMPANIES.
2. EXISTING AND PROPOSED PRESSURIZED (WATER & GAS) AND SECONDARY (ELECTRIC & COMMUNICATIONS) UTILITIES SHALL DEFLECT TO MAINTAIN 18" CLEAR AT SANITARY OR STORM SEWER CROSSINGS WHEN CONFLICTS OCCUR.
3. WHEN A PROPOSED PRESSURIZED/SECONDARY UTILITY IS IN CROSSING CONFLICT WITH AN EXISTING PRESSURIZED/SECONDARY UTILITY, THE PROPOSED UTILITY SHALL DEFLECT TO OBTAIN MINIMUM CLEARANCE.
4. CONTRACTOR SHALL FIELD LOCATE EXISTING PRESSURIZED/SECONDARY UTILITIES AT PROPOSED CROSSINGS.
5. FOR CLEARANCE BETWEEN GRAVITY PIPES OF LESS THAN 18" THE CONTRACTOR SHALL FIELD LOCATE EXISTING PRESSURIZED/SECONDARY UTILITIES AT PROPOSED CROSSINGS.
6. WATER SERVICE LINE AND FIRE LINE SHALL MAINTAIN 18" MINIMUM VERTICAL CLEARANCE FROM ALL UTILITIES.
- LEGEND
(SEE SHEET C-001 FOR GENERAL LEGEND)
ST - PROPOSED STORM SEWER (12" AND SMALLER)
SAN - PROPOSED SANITARY SEWER
W - PROPOSED WATER SERVICE
GAS - PROPOSED GAS SERVICE
E/T - PROPOSED UNDERGROUND ELECTRIC AND TELEPHONE SERVICE
D.S. - PROPOSED DOWNSPOUT
A - APPURTENANCES
- UTILITY CONSTRUCTION KEYNOTE
- AS-BUILT**
CONTRACTOR SHALL PROVIDE NORTHING, EASTING, AND ELEVATION OF ALL PROPOSED UTILITIES. CONTRACTOR SHALL PROVIDE AS-BUILT INFORMATION ON A SIGNED AND SEALED PLAN BY A REGISTERED SURVEYOR.

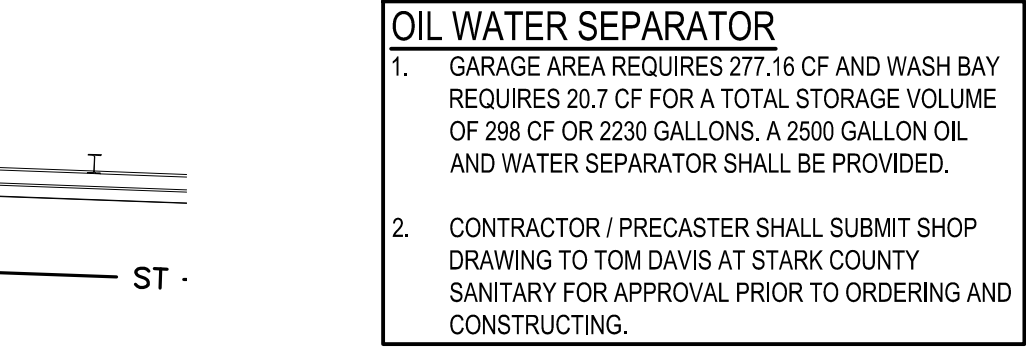

- PLAN KEYNOTES**
STORM
100. PROPOSED 6" DOWNSPOUT COLLECTOR LINE @ 2.00% MINIMUM WITH WYE. 8" INV. = 1066.25 AT BUILDING. CONTRACTOR SHALL PROVIDE A WYE CONNECTION WHERE 6" COLLECTOR LINES TIE INTO 8" AND 12" STORM SEWERS.
101. 8" INV. = 1066.25 AT BUILDING.
102. PROPOSED 32 L.F. OF 6" PERFORATED PVC @ 0.00%.
103. PROPOSED 48 L.F. OF 6" PERFORATED PVC @ 0.00%.
104. PROPOSED 45 L.F. OF 6" PERFORATED PVC @ 0.00%.
105. PROPOSED DOUBLE WYE, SEE SHEET C-502.
106. PROPOSED CLEANOUT IN BIORETENTION, SEE SHEET C-502. 6" INV.=1055.25.
SANITARY
200. PROPOSED 6" BUILDING INV. = 1063.75
201. PROPOSED PAVEMENT CLEANOUT, SEE SHEET C-502 AND WYE CONNECTION SHEET C-502. 6" INV.=1063.74.
202. PROPOSED 23 L.F. OF 6" PVC SANITARY SEWER @ 1.50%.
203. PROPOSED CLEANOUT, SEE SHEET C-502 AND WYE CONNECTION SHEET C-502. 6" INV.=1063.35.
204. PROPOSED 27 L.F. OF 6" PVC SANITARY SEWER @ 1.50%.
205. PROPOSED 45' BEND.
206. PROPOSED 6" WYE. 6" INV. = 1063.00.
207. PROPOSED PAVEMENT CLEANOUT, SEE SHEET C-502 AND WYE CONNECTION SHEET C-502. 6" INV.=1063.74.
208. PROPOSED 18 L.F. OF 6" PVC SANITARY SEWER @ 1.88%.
209. PROPOSED FORCEMAIN CONNECTION AT EXISTING SANITARY MANHOLE, SEE SHEET C-132.
210. PROPOSED 4 L.F. OF 6" PVC SANITARY SEWER @ 2.50%.
211. PROPOSED CLEANOUTS PER OIL AND WATER SEPARATOR DETAIL, SEE SHEET C-503.
212. PROPOSED 6 L.F. OF 6" PVC SANITARY SEWER @ 2.00%.
213. PROPOSED LIFT STATION, SEE SHEET C-132 AND C-133.
214. PROPOSED CONNECTION TO EXISTING SANITARY MANHOLE, SEE PROFILE ON SHEET C-132.
ELECTRIC AND COMMUNICATIONS
400. PROPOSED ELECTRIC METER PER ELECTRIC COMPANY SPECIFICATIONS. SEE BUILDING DRAWINGS FOR EXACT LOCATION. ELECTRIC SERVICE LINE TO BE COORDINATED WITH THE ELECTRIC COMPANY.
401. PROPOSED ELECTRIC AND TELECOMMUNICATIONS SERVICE LINES, SEE ELECTRICAL PLANS.
402. PROPOSED TRANSFORMER, SEE ELECTRICAL PLANS.
GAS
GAS LINE SHALL NOT BE BURIED GREATER THAN 5' FROM PROPOSED FINISH GRADE, UNLESS WATER LINE IS BEING DEFLECTED AROUND EXISTING / PROPOSED UTILITY LINE TO MAINTAIN 18" MINIMUM CLEARANCE.
500. PROPOSED GAS METER PER GAS COMPANY SPECIFICATIONS. SEE BUILDING DRAWINGS FOR EXACT LOCATION. GAS SERVICE LINE TO BE COORDINATED WITH THE GAS COMPANY.
501. PROPOSED 283 L.F. GAS SERVICE TO END OF EXISTING ROAD. GAS CONNECTION TO BE COORDINATED WITH THE GAS COMPANY.
502. CONTRACTOR TO COORDINATE WITH GAS COMPANY INSTALLATION OF PROPOSED GAS LINE TO EXISTING SERVICE LINE DOWN RECENT AVE.

PROPOSED HEADWALLS	
Structure Name	Structure Details
HW-01	PROPOSED FULL HEIGHT HEADWALL (SEE SHEET C-502) 15" HDPE INV (E)=1063.60

Pipe Table	
Pipe Name	Design
ST-1	168 LF OF 18" HDPE Pipe @ 0.56%
ST-2	24 LF OF 15" HDPE @ 1.03%
ST-3	160 LF OF 12" HDPE @ 0.50%
ST-4	47 LF OF 8" PVC Pipe @ 0.50%
ST-5	132 LF OF 8" PVC Pipe @ 0.50%
ST-6	39 LF OF 8" PVC Pipe @ 1.80%
ST-7	109 LF OF 12" HDPE @ 0.48%
ST-8	241 LF OF 12" HDPE @ 0.50%
ST-9	26 LF OF 8" PVC Pipe @ 0.50%
ST-10	67 LF OF 8" PVC Pipe @ 0.50%
ST-11	25 LF OF 8" PVC Pipe @ 0.50%
ST-12	14 LF OF 8" PVC Pipe @ 0.50%

EXISTING STRUCTURES	
STRICT. ID	STRUCTURE DETAILS
EX 1658	EXISTING CATCH BASIN RM = 1057.70 12" HDPE (W) = 1054.90 12" HDPE (E) = 1054.90
EX 1688	EXISTING CATCH BASIN RM = 1057.92 18" HDPE (N) = 1054.32 18" HDPE (E) = 1054.32 (REMOVED) 24" HDPE (W) = 1054.32 PROP. 12" HDPE (N) = 1054.32
EX 1797	EXISTING CATCH BASIN RM = 1062.29 12" HDPE (W) = 1057.39 12" HDPE (E) = 1057.69
EX 2527	EXISTING SANITARY MANHOLE RM = 1076.86 6" PVC (N) = 1070.61 6" PVC (S) = 1070.61 6" PVC (E) = 1070.61
EX 3057	EXISTING SANITARY MANHOLE RM = 1074.45 6" PVC (N) = 1070.25 6" PVC (W) = 1070.25 PROP. 15" OR 9" HDPE (S) = 1070.45
EX 3137	EXISTING CATCH BASIN RM = 1073.50 18" HDPE (W) = 1066.30 18" HDPE (SE) = 1066.30
EX 3062	EXISTING CATCH BASIN RM = 1073.50 18" HDPE (NW) = 1067.65 12" HDPE (N) = 1067.90 12" HDPE (E) = 1067.90
EX 3078	EXISTING CATCH BASIN RM = 1073.04 12" HDPE (W) = 1070.54

PROPOSED STRUCTURE TABLE	
Structure Name	Structure Details
CB-01	PROPOSED CONTROL STRUCTURE (SEE SHEET C-502) RM = 1059.50 8" PVC Pipe INV (S)=1055.25 18" HDPE Pipe INV (E)=1065.25
CB-02	PROPOSED ODOT 2-2A CATCH BASIN (PER ODOT STD. DWG CB 2-2A) RM=1058.80 WINDOW (N) = 1058.30 EX. INV. 12" HDPE (W/E) = 1054.90
CO-01	PROPOSED 12" WATER DEST. DRAIN BASIN (OR APPROVED EQUAL) (SEE SHEET C-504) RM = 1067.78 12" HDPE INV (W)=1064.65 8" PVC Pipe INV (NE)=1064.65
CO-04	PROPOSED 12" TRAFFIC RATED NYLOPLAST DRAIN BASIN (OR APPROVED EQUAL) (SEE SHEET C-504) RM = 1067.77 12" HDPE INV (N)=1064.38 12" HDPE INV (E)=1064.39
CO-05	PROPOSED 12" TRAFFIC RATED NYLOPLAST DRAIN BASIN (OR APPROVED EQUAL) (SEE SHEET C-504) RM = 1068.40 12" HDPE INV (W)=1065.59 8" PVC Pipe INV (S)=1065.59
MH-01	PROPOSED 48" DIA. STORM MANHOLE PER ODOT STD. DWG MH-3 (OR APPROVED EQUAL) RM = 1067.75 15" HDPE INV (W)=1063.85 12" HDPE INV (E)=1063.85 12" HDPE INV (S)=1063.85
SAN 1	PROPOSED SANITARY MANHOLE (SEE SHEET C-503) RM=1067.88 INV. 6" PVC (N/E) = 1063.40
OW 1	PROPOSED 2500 GALLON OIL AND WATER SEPARATOR (SEE SHEET C-503). CONTRACTOR SHALL SUBMIT SHOP DRAWING TO TOM DAVIS AT STARK COUNTY SANITARY FOR APPROVAL PRIOR TO ORDERING) RM=1068.25 INV. 6" INLET (W)=1063.30 INV. 6" OUTLET (E)=1063.30 INV. 6" OUTLET AT CLEANOUTS = 1063.05

PROPOSED STRUCTURE TABLE	
Structure Name	Structure Details
CO-02	PROPOSED CLEANOUT IN PAVEMENT (SEE SHEET C-502) RM = 1067.26 8" PVC Pipe INV (SW)=1064.89
CO-03	PROPOSED CLEANOUT IN PAVEMENT (SEE SHEET C-502) RM = 1067.59 8" PVC Pipe INV (W)=1065.55
CO-06	PROPOSED CLEANOUT IN PAVEMENT (SEE SHEET C-502) RM = 1068.19 8" PVC Pipe INV (N)=1065.72
CO-07	PROPOSED CLEANOUT IN PAVEMENT (SEE SHEET C-502) RM = 1068.28 8" PVC Pipe INV (W)=1066.06
CO-08	PROPOSED CLEANOUT IN PAVEMENT (SEE SHEET C-502) RM = 1068.06 8" PVC Pipe INV (SW)=1066.18
CO-13	PROPOSED CLEANOUT (SEE SHEET C-502) RM = 1058.50 6" PVC Pipe INV (N)=1055.25

ISSUED FOR:

PERMIT

02/06/2023

BID

02/06/2023

CONSTRUCTION

02/06/2023

RECORD

02/06/2023

PROJECT MANAGER

MLH

DESIGNER

TJW

JOB NO.

2020377.05

C-131

GPD GROUP
Glenview, PA, Schuylkill, Berks & Delaware, Inc.
520 South Main Street, Suite 201
Glenview, PA 19038
610.512.2100 Fax 610.512.2101
Copyright © 2023 GPD Group, Schuylkill, Berks & Delaware, Inc.

DATE

02/06/2023

REV

1

DESCRIPTION

SANITATION BUILDING PROJECT - GP 1376

SANITATION BUILDING PROJECT - GP 1376

2801 REGENT AVENUE

CANTON, OHIO 44705

UTILITY PLAN

1. JOINT SEAL BETWEEN PRECAST MANHOLE SECTIONS SHALL BE RESILIENT AND FLEXIBLE GASKET JOINTS PER ASTM C443 OR LATEST EDITION.
2. PRECAST MANHOLE SHALL CONFORM TO THE REQUIREMENTS OF ASTM C478 AND SHALL BE CLASS III, 1500 PSI, MINIMUM OF A 12" X 16" GROUT CASTED BAR WITH INJECTED COPOLYMER POLYPROPYLENE DURE, STEPS TO MEET ASTM C478, ASHTO M-199 AND OSHA SPECIFICATIONS.
3. WET WELL AND VALVE W/BE TO BE 4.500 PSI CONCRETE.
4. ALL HARDWARE, BRACKETS, SUPPORTS, RAILS, AND LIFTING CABLE WITHIN THE WET WELL ARE TO BE STAINLESS STEEL.
5. CONTRACTOR IS RESPONSIBLE FOR SHEETING AND ENSURING THAT FLOTATION OF THE PROPOSED STRUCTURE WILL NOT OCCUR DURING CONSTRUCTION. PRESSURE RELIEF VALVES, PUMP PUMPS, TEMPORARY BALLAST, AND OTHER MEANS OF PREVENTING FLOTATION MAY BE REQUIRED UNTIL THE PUMP STATION EXCAVATION IS COMPLETELY BACKFILLED AND COMPACTED.


CONTROL PANEL GENERAL NOTES

- [illegible]

1. ALL SANITARY SEWERS, FORCE MAINS AND APPURTENANCES SHALL BE CONSTRUCTED IN STRICT ACCORDANCE WITH CURRENT INDUSTRY STANDARDS, THE REQUIREMENTS OF THESE PLANS, AND SPECIFICATIONS.


- CONTRACTOR SHALL OBTAIN PERMIT TO CONNECT TO STARK COUNTY SANITARY SEWER SYSTEM.
3. THE CONTRACTOR SHALL CONDUCT HIS OPERATIONS SO THAT THE FLOW OF ALL EXISTING SEWERS AND LATERALS WILL BE MAINTAINED AT ALL TIMES. ANY ADDITIONAL LABOR OR COST INCURRED IN MAINTAINING THIS FLOW BY PUMPING OR BY ANY OTHER APPROVED METHOD WHICH IS NECESSARY FOR THE COMPLETION OF THIS PROJECT, SHALL BE INCLUDED IN THE AMOUNT BID.
4. FOREMAN TO BE 1.5 AWWA C-901, 2SD HPIPE, 250 PSI, IPS, WITH ASTM 2321, CLASS 1 AND APPROVED EQUIV. JOINTS TO BE FUSED OR METAL JOINT ASTM-2620. THE FORCE MAIN SHALL BE PRESSURE TESTED IN THE PRESENCE OF THE INSPECTOR.
5. FORCE MAINS SHALL BE SUBJECT TO A LOW PRESSURE AIR TEST. AIR TEST SHALL MEET ALL THE PROCEDURES AND REQUIREMENTS OF ASTM F1417 WITH THE FOLLOWING EXCEPTION: TEST PRESSURE SHALL BE 30 PSI (APPROXIMATELY 15 TIMES THE WORKING PRESSURE). CONTRACTOR IS RESPONSIBLE FOR ENSURING THAT ALL TEMPORARY PLUGS, CAPS, ETC ARE SECURELY INSTALLED DURING THE TEST.
6. FORCE MAINS FAILING THE PRESSURE TEST SHALL BE REPAIRED/REPLACED AND RETESTED AT THE CONTRACTORS COST. THE CONTRACTOR IS RESPONSIBLE FOR THE COSTS OF RETESTING THE FORCE MAIN UNTIL AN ACCEPTABLE TEST IS ACHIEVED.
7. THE CONTRACTOR SHALL PROVIDE THE OWNER A SET OF AS-BUILT DRAWINGS WITH THE LOCATIONS OF ALL SANITARY SEWER, GAS SERVICES, STORM SEWERS/DRAINS, WATER SERVICES AND ALL OTHER UNDERGROUND UTILITIES ENCOUNTERED FOR THE ENTIRE PROJECT. NO SEPARATE PAYMENT SHALL BE MADE FOR THIS WORK.
8. PDF SHOP DRAWINGS OF ALL MATERIALS SHALL BE SUBMITTED TO THE ENGINEER FOR APPROVAL, PRIOR TO PURCHASE.
9. THE CONTRACTOR SHALL SCHEDULE INSPECTION WITH REGULATORY AGENCIES (STARK COUNTY SANITARY ENGINEER) SO THAT WORK PROGRESS IS BEING MONITORED BY INSPECTION REQUIREMENTS.
10. NOTIFY OWNER TWO (2) WEEKS PRIOR TO STARTING CONSTRUCTION.
11. EXCAVATION OUTSIDE NORMAL WORK LIMITS SHALL NOT BE COMMENCED WITHOUT APPROVAL OF THE OWNER.
12. TOPSOIL, FERTILIZING, SEEDING AND MULCHING FOR RESTORATION OF DISTURBED LAWN AREAS SHALL CONFORM TO SECTIONS 600 AS SPECIFIED IN THE 2019 LATEST EDITION OF D.O.T. CONSTRUCTION AND MAINT. SPECIFICATIONS. EXCEPT FAIRLAWN SEED MIX SHALL BE USED. CONTRACTOR TO THOROUGHLY WATER SEEDED AREAS AFTER INSTALLATION AND EVERY OTHER DAY FOR A TOTAL OF FIVE (5) WATERINGS.
13. ALL DISTURBED SIGNS, GUARDRAIL, MAIL AND/OR PAPER BUCKS, DRIVES AND DRIVE CULVERTS SHALL BE REPAIRED AND/OR REPLACED AS DIRECTED AT NO COST TO THE OWNER.
14. ALL DISTURBED AND/OR DAMAGED UTILITIES, STORM SEWER PIPES & APPURTENANCES, PAVEMENT, BERMS AND DITCHES SHALL BE REPAIRED AS DIRECTED AT NO COST TO THE OWNER.
20. TOP ELEVATIONS OF STRUCTURES, AS INDICATED ON THE PLAN AND PROFILE ARE APPROXIMATE AND SHOULD BE USED FOR BIDDING PURPOSES ONLY. ACTUAL TOP ELEVATIONS SHALL BE MEASURED BY THE CONTRACTOR AT THE TIME OF CONSTRUCTION. CONTRACTOR SHALL BE NOTED THAT NO EXTRAS WILL BE AWARDED NOR SHALL ANY DEDUCTION BE MADE FOR MANHOLES WHOSE AS-BUILT DEPTHS MAY VARY FROM THOSE SHOWN ON PLANS. ADJUSTMENT OF THE CASTING HEIGHT MAY BE MADE WITH GRADE RINGS AND THE REMOVAL OF THE COURSES OF BRICK. MAXIMUM ADJUSTMENT IS 6". NO CHANGE IN PAYMENT WILL OCCUR DUE TO AS-BUILT DEPTHS VARYING FROM PLAN DEPTHS. MANHOLE LIDS SHALL BE 0.5" ABOVE PAVED SURFACES AND TWO (2) INCHES ABOVE UNPAVED GROUND (UNLESS OTHERWISE NOTED IN THE PLANS). NO EXTRAS WILL BE PROVIDED FOR FIELD ADJUSTMENT OF MANHOLE PIPES.
16. WHERE INLET AND OUTLET PIPES CONNECT TO STRUCTURES, A FLEXIBLE WATERTIGHT JOINT IS REQUIRED. FLEXIBLE MANHOLE CONNECTIONS SHALL MEET ASTM C-923. PRECAST MANHOLE CONSTRUCTION SHALL MEET ASTM C-1151 WITH JOINTS PER ASTM C-945. MANHOLES SHALL BE VACUUM TESTED PER ASTM C-1244. MANHOLES FAILING THE VACUUM TEST SHALL BE SEPALED AND RETESTED, UNTIL A PASSING TEST OCCURS. AT THE CONTRACTORS EXPENSE.
17. SANITARY SEWER SHALL BE ASTM D-3034, 3SD 36 PVC WITH JOINTS PER ASTM D-3212 AND BEDDING PER ASTM D-2321. CLASS 1, LGR SEWER SEWERS MUST PASS A LEAKAGE TEST PRIOR TO ACCEPTANCE BY THE OWNER. PIPE FAILING THE LEAKAGE TEST SHALL BE REPAIRED AND RETESTED AT THE CONTRACTORS EXPENSE UNTIL A SUCCESSFUL TEST OCCURS.
18. ALL FLEXIBLE PIPE, SANITARY SEWERS AND LATERALS SHALL BE SUBJECT TO A PIPE DEFLECTION. THE TEST SHALL NOT OCCUR UNTIL AT LEAST 20 DAYS AFTER THE SLOPIPE SYSTEM HAS BEEN INSTALLED. THE TEST SHALL CONSIST OF HAND PULLING A MANHOLE DEVICE THROUGH THE SEWER. THE MANHOLE SHALL BE EITHER A FULL CIRCLE OR B-ARM TYPE WHICH HAS OUTSIDE DIMENSIONS WHICH ARE 95% OF THE I.D. OF THE PIPE BEING TESTED. PIPE FAILING THE MANHOLE TEST SHALL BE REPLACED AT NO COST TO THE OWNER (INCLUDING EXCAVATION, SITE RESTORATION, RE-TESTING, ETC).
19. THE DEPTH OF EXISTING UTILITIES ON PROFILES ARE APPROXIMATE AND FOR GENERAL INFORMATION ONLY.
20. BACKFILL MATERIAL EXTENDING MORE THAN SIX (6) INCHES ABOVE THE LEVEL OF THE SIDES OF THE TRENCH MUST BE REMOVED FROM THE JOB SITE. ANY PAVEMENT CUT, DAMAGED OR UNDERMINED BY EXCAVATION, SHALL BE REMOVED AND REPLACED. TEMPORARY PAVEMENT REPLACEMENTS SHALL BE MAINTAINED IN GOOD CONDITION BY THE CONTRACTOR. PERMANENT REPLACEMENTS MUST BE COMPLETED AS SOON AS PRACTICAL.
21. ROOF DRAINS, FOUNDATION DRAINS, AND OTHER CLEAN WATER CONNECTIONS TO THE SANITARY SEWER ARE PROHIBITED.
22. THE CONTRACTOR MUST MAINTAIN A 10'-00" MINIMUM HORIZONTAL CLEARANCE FROM THE EDGE OF ALL WATER MAINS TO THE EDGE OF ALL SANITARY SEWER AND/OR FORCE MAIN PIPES.
23. THE CONTRACTOR MUST MAINTAIN AN 18-INCH MINIMUM VERTICAL CLEARANCE FROM THE EDGE OF ALL WATER MAINS AND SEWERS TO THE OUTSIDE EDGE OF ALL SANITARY SEWER PIPES WHERE THEY CROSS.
24. THE CONTRACTOR MUST MAINTAIN A 12" MINIMUM VERTICAL CLEARANCE BETWEEN SANITARY SEWER AND STORM SEWERS AT CROSSLINGS.
25. COST OF ANY SHEETING OR DOWBARING NECESSARY FOR INSTALLATION OF THE SANITARY SEWER OR THE PUMP STATION SHALL BE INCLUDED IN PRICE BID FOR THE RESPECTIVE ITEMS.


300. PROPOSED ELECTRICAL H-FRAME, SEE ELECTRICAL SHEET FOR ELECTRICAL ROUTING FROM BUILDING.

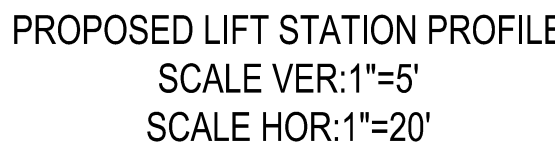

EX 3057	EXISTING SANITARY MANHOLE RIM = 1074.45 8" PVC (N) = 1070.25 8" PVC (W) = 1070.25 PROP. 1.5" DR 9 HDPE (S) = 1070.45
------------	--

PROPOSED FORCEMAIN CONNECTION AT EXISTING
SANITARY MANHOLE. CONTRACTOR SHALL
CONNECT USING KOR-N-SEAL OR APPROVED
EQUAL. DISCHARGE PIPE SHALL BE INCLUDE
FITTINGS (AS DIRECTED BY THE COUNTY
INSPECTOR) TO MAXIMIZE FLOW TRANSITION.

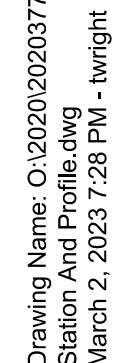

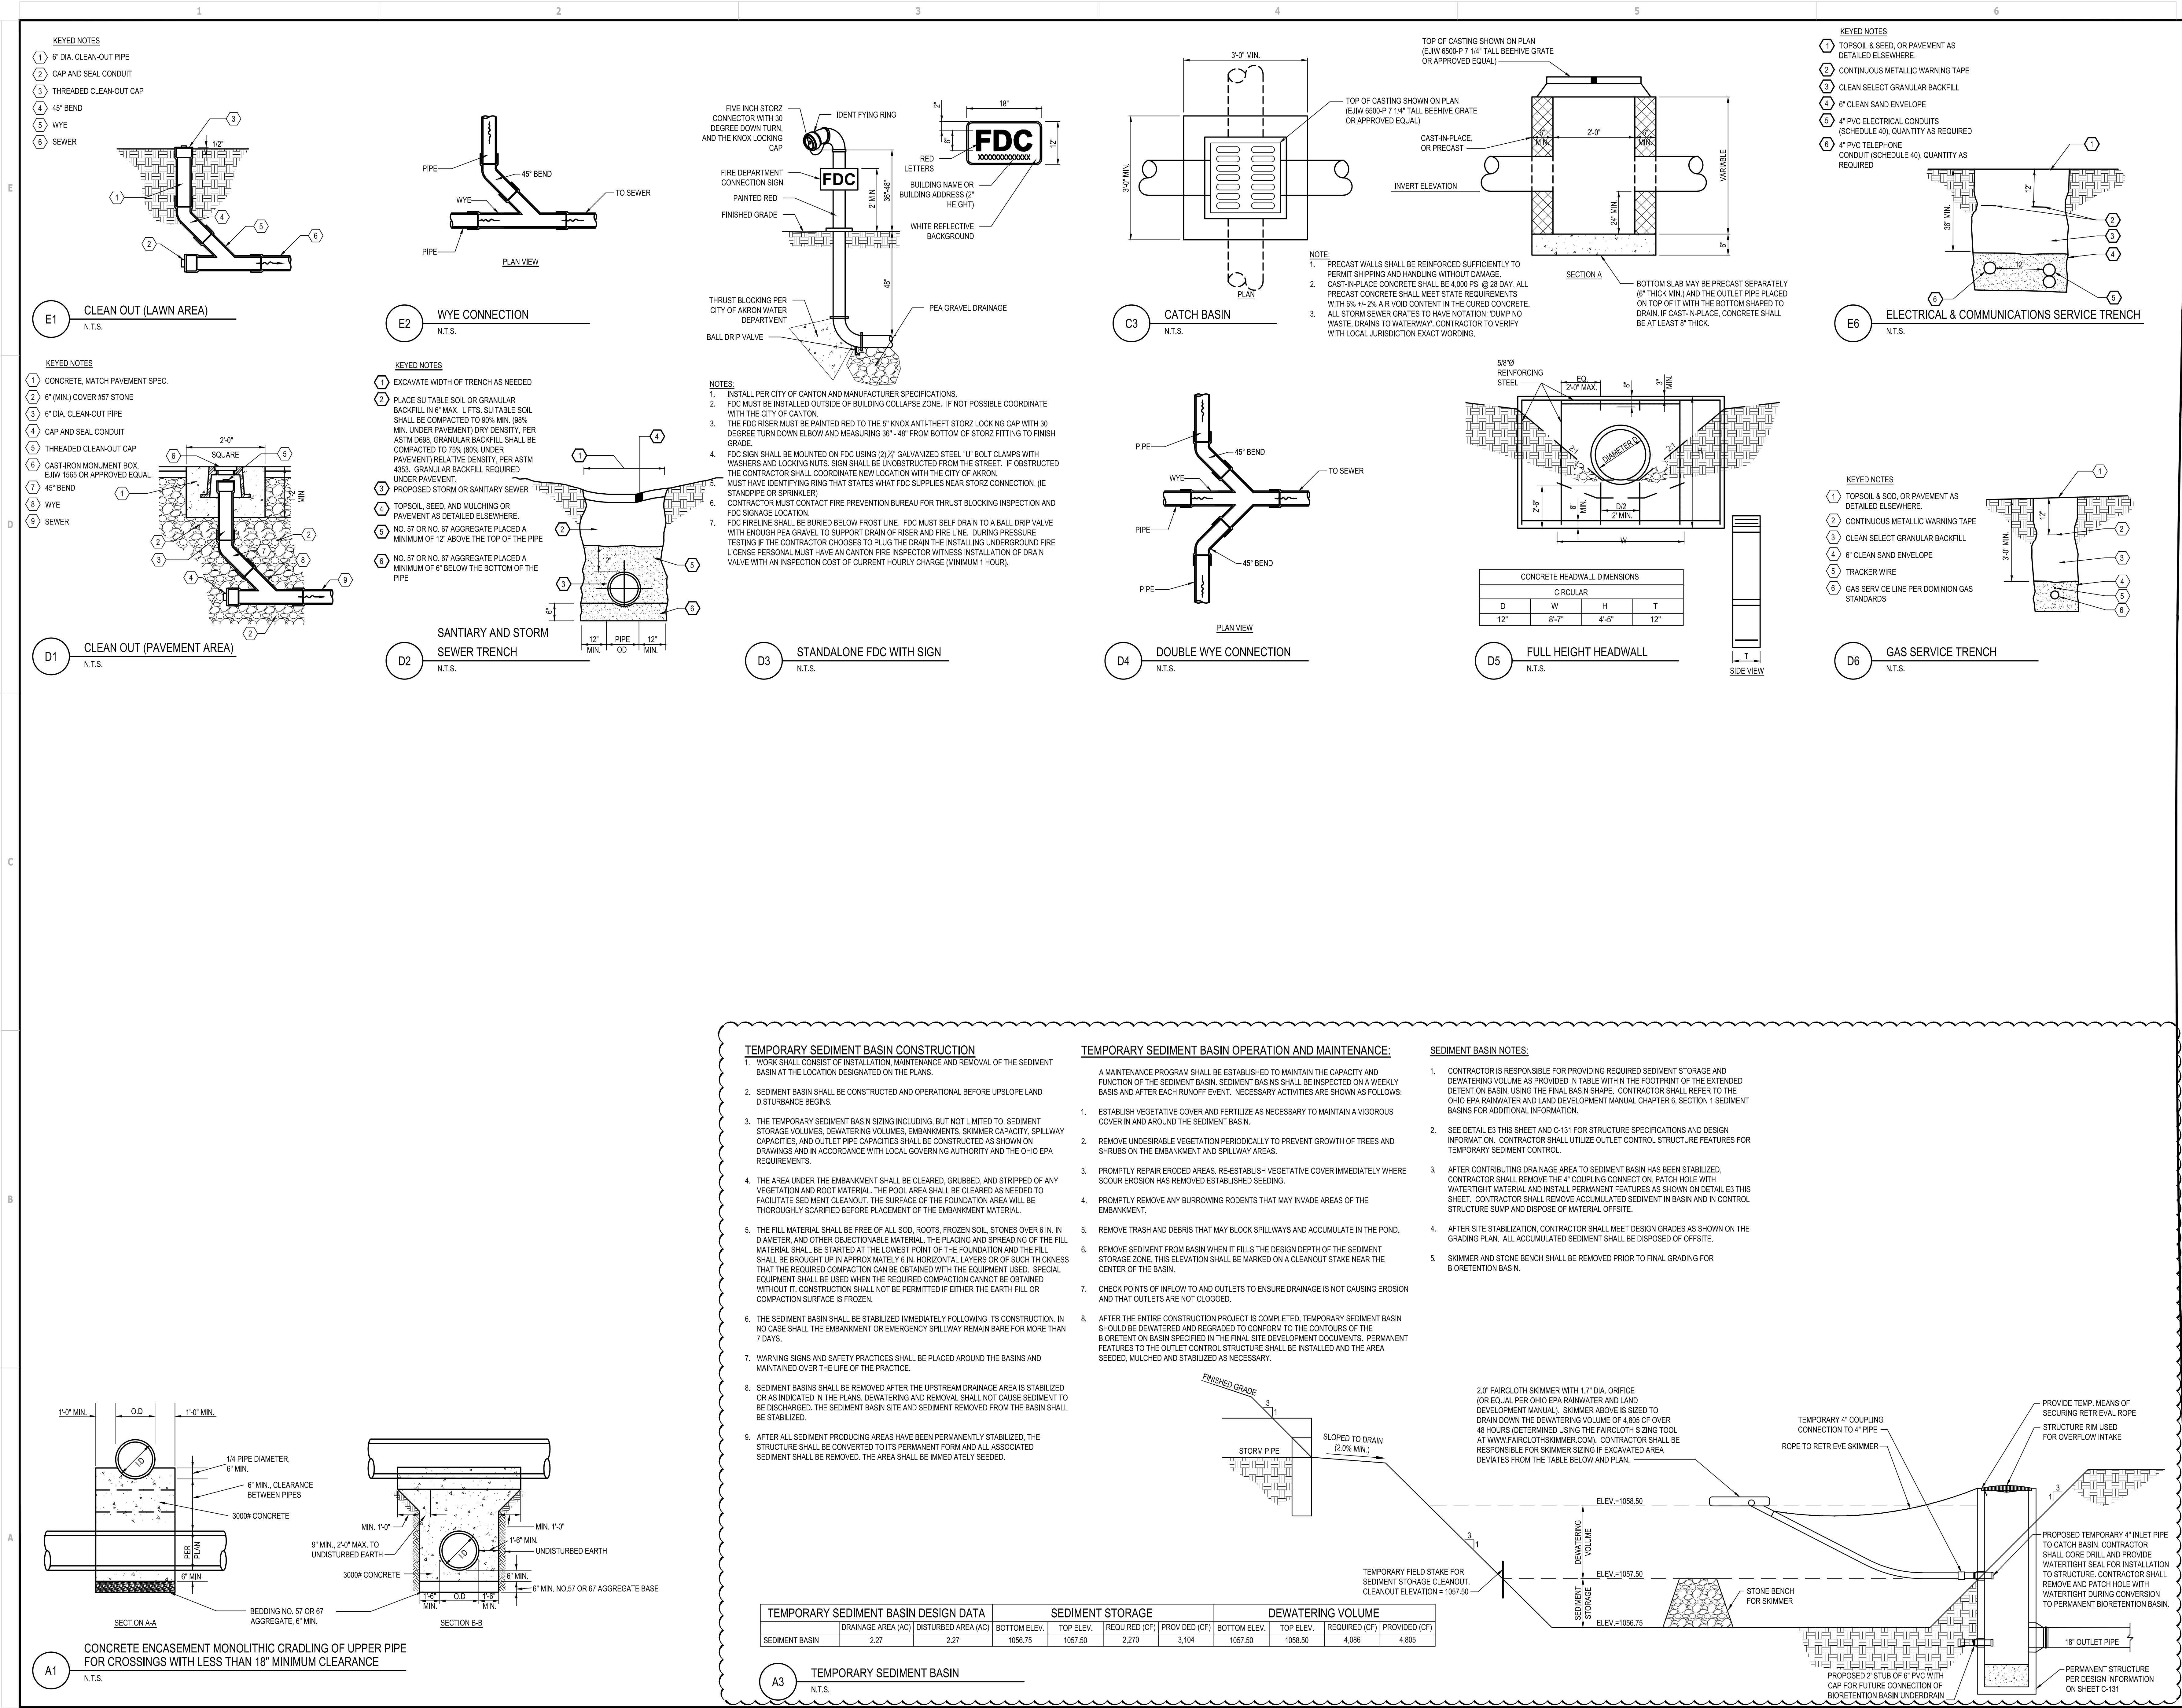

GPD GROUP
Glenview, Pyle, Schomer, Burns & DeFornow, Inc.
520 South Main Street, Suite 201
Akron, OH 44311
330.972.2700 Fax 330.972.2701
Copyright © Glenview, Pyle, Schomer, Burns & DeFornow, Inc. 2023

REV	DATE	DESCRIPTION
1	03/02/2023	ADDITIONAL 01


SANITATION BUILDING PROJECT - GP 1376
2801 REGENT AVENUE,
CANTON, OHIO 44705

DETAILS

ISSUED FOR:	
PERMIT	02/06/2023
BID	02/06/2023
CONSTRUCTION	noted/none
RECORD	noted/none
PROJECT MANAGER	DESIGNER
MLH	TJW

JOB NO.
2020377.05

C-502

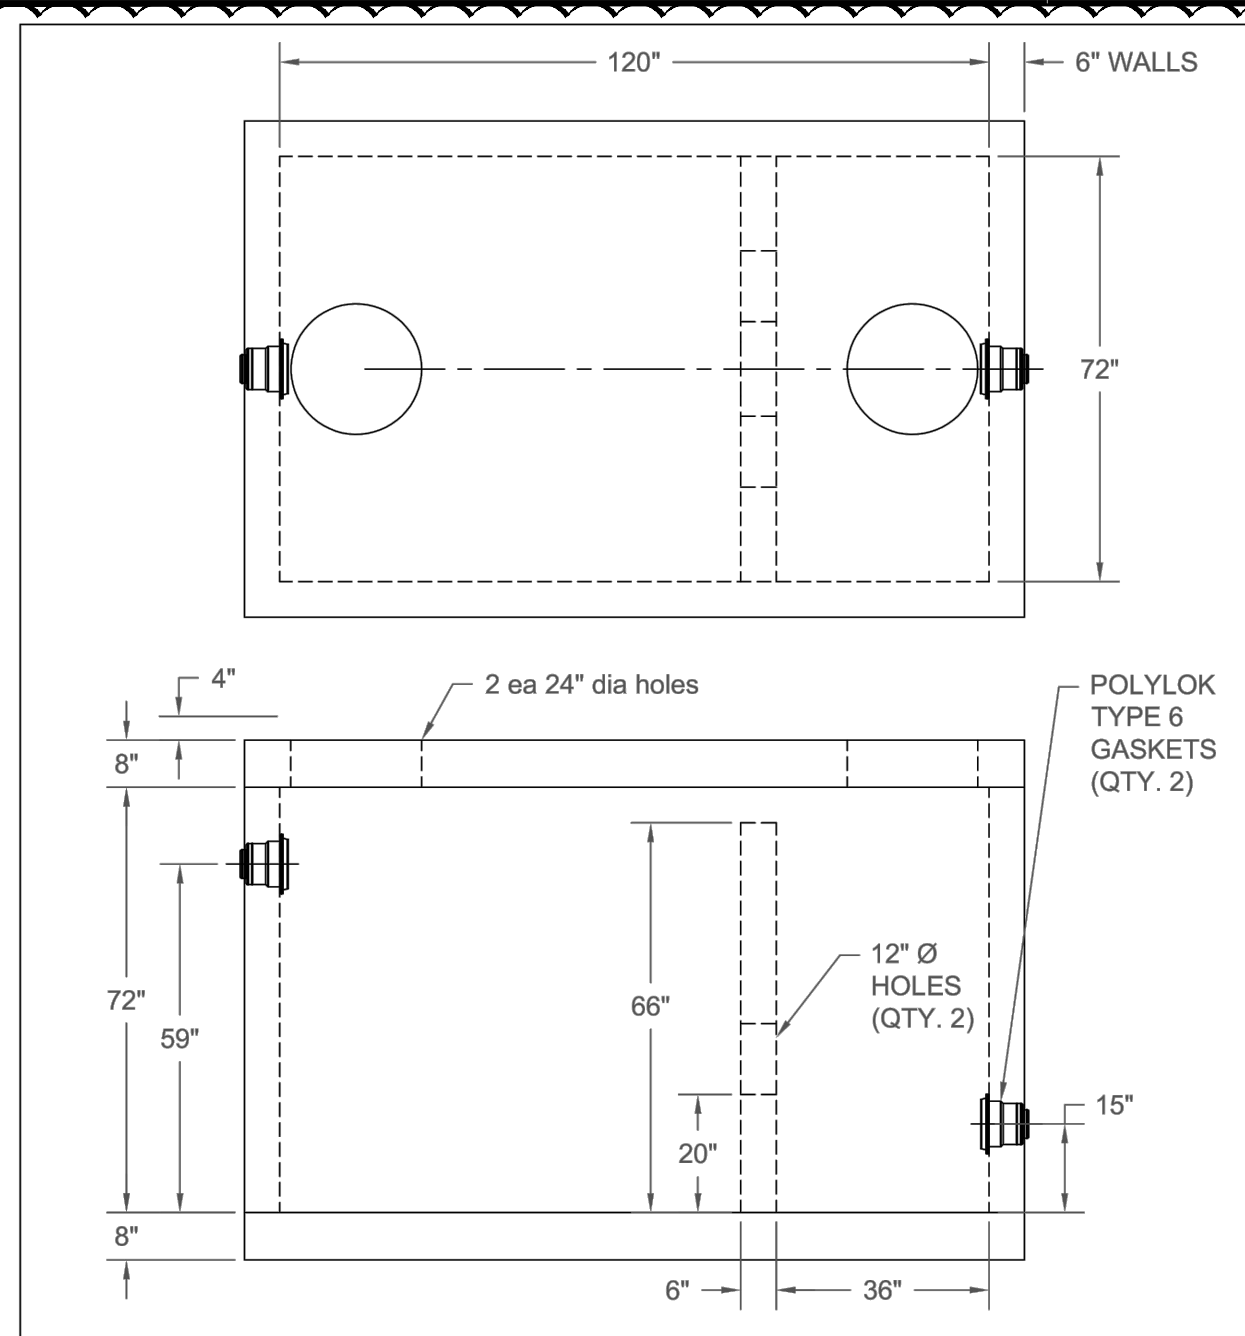


NOTES:

- 1) CONCRETE: 4,500 PSI @ 28 DAYS.
- 2) REINFORCED TO HS-20 LOADING.
- 3) JOINTS SEALED WITH CONSEAL CS-102.


DATE	BY	REVISION
1/10/13	ARM	16

DETAIL SHOWN FOR GENERAL SIZING PURPOSES ONLY. CONTRACTOR SHALL SUBMIT SHOP DRAWING TO TOM DAVIS AT STARK COUNTY SANITARY FOR APPROVAL PRIOR TO ORDERING

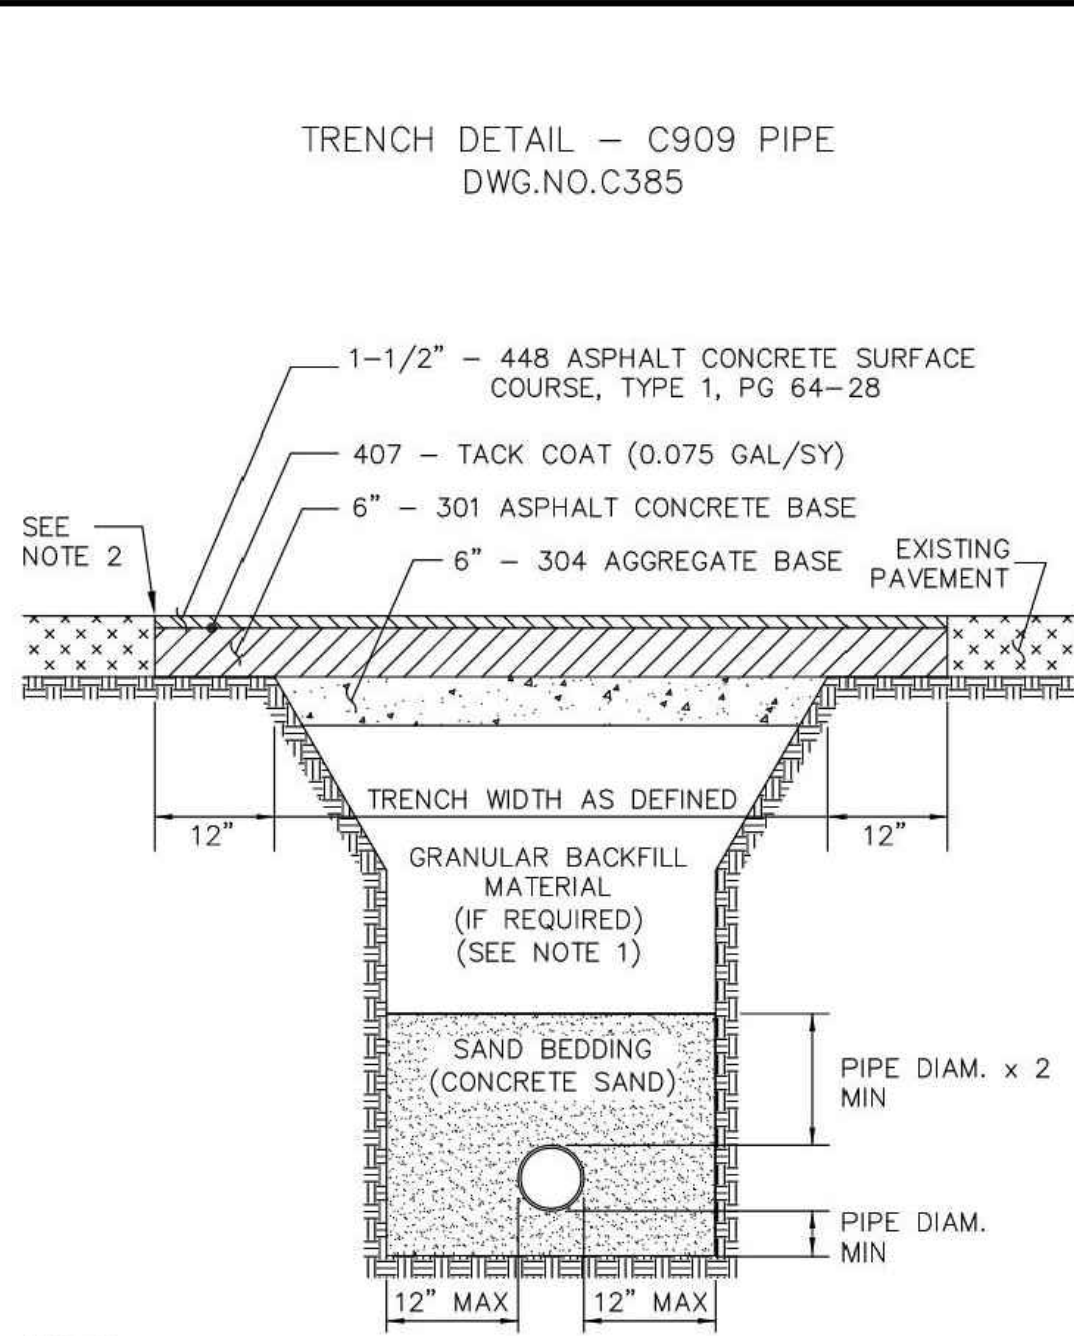


- NOTES:
1. CHECK WITH LOCAL AUTHORITY HAVING JURISDICTION WITHIN THE RIGHT-OF-WAY REGARDING BACKFILL REQUIREMENTS.
 2. SAW CUT EXISTING PAVEMENT, SEAL JOINT PER ODOT ITEM 423 - CRACK SEALING, TYPE IV. INCLUDE COST IN BID PRICE FOR THE PROPOSED PAVEMENT.
 3. IF ADJACENT PAVEMENT IS DAMAGED OR UNDERMINED DURING CONSTRUCTION, ADDITIONAL PAVEMENT SHALL BE SAW CUT AND REMOVED IN ORDER TO PROVIDE A SOUND PAVEMENT EDGE.

VERTICAL WATER MAIN CLEARANCE (C186)

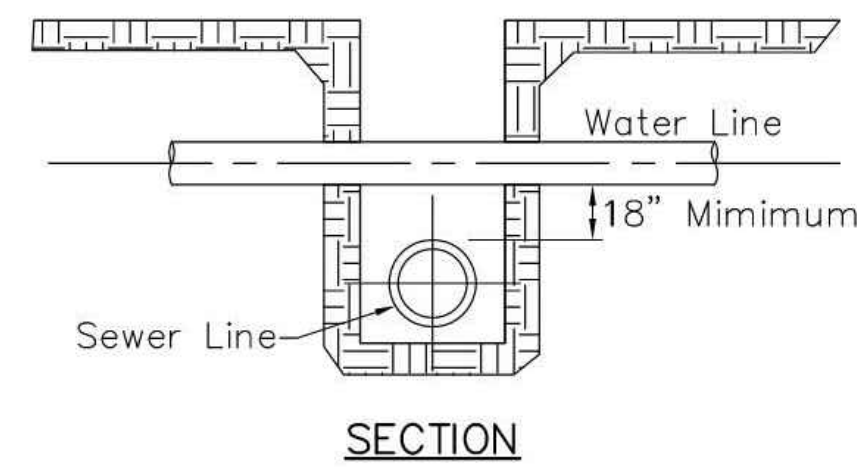

- NOTES:
1. If joint on water main is within limits of sewer trench, install mechanical bell joint clamp
 2. If clearance is less than 18":
 - For Storm sewers, concrete encase the storm sewer pipe, 6 ft. on each side of water main.
 - For Sanitary sewers, replace the sanitary sewer pipe with PVC C900 pipe, 10 ft. on each side of water main. Approved couplings shall be used to tie onto the existing sewer.
 3. In no case shall the sewer pipe contact any water main, service line or appurtenance.


CONCRETE THRUST BLOCKS FOR VERTICAL BENDS ON WATER MAINS POURED IN PLACE (CLASS C) (C147)

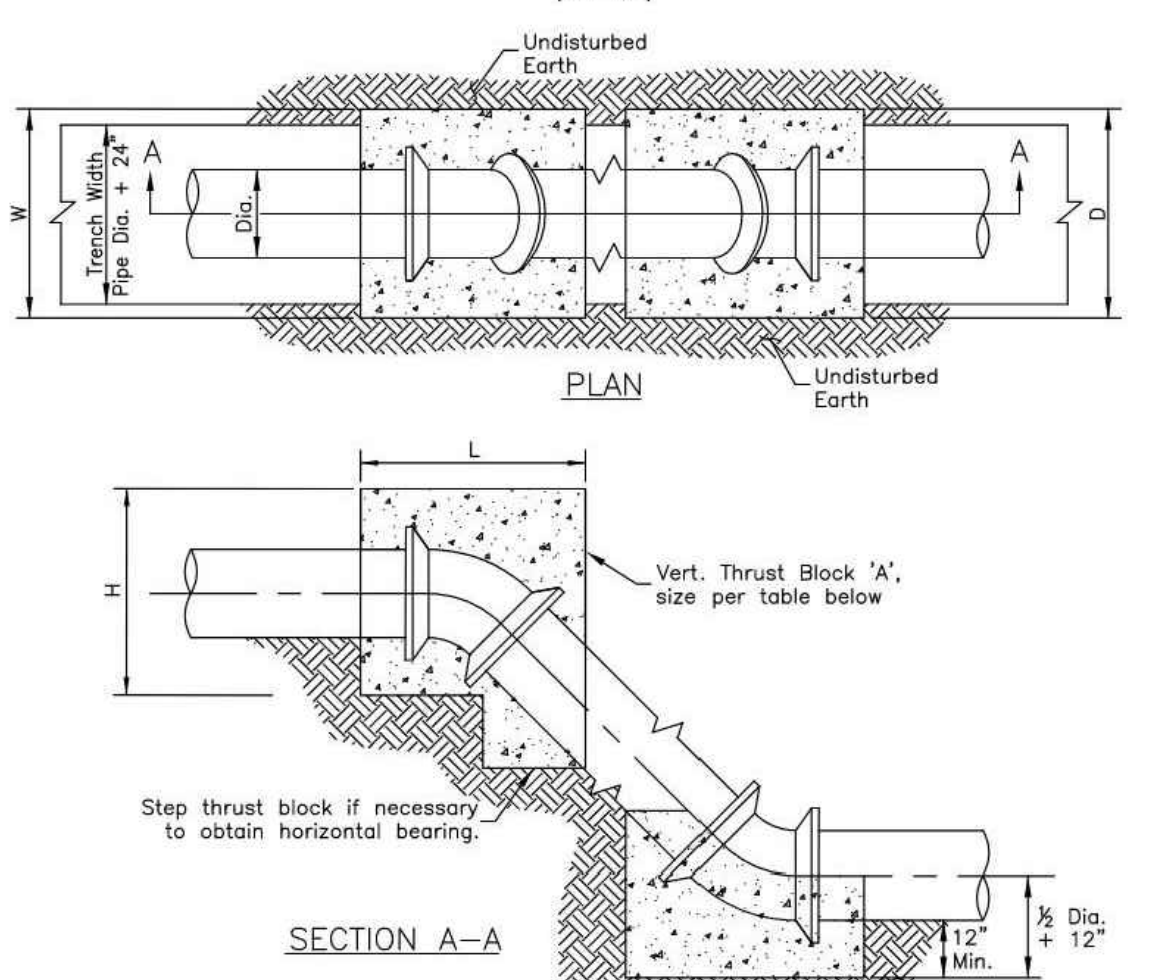


- NOTES:
1. Thrust blocks shall be placed against undisturbed soil. Where it is not possible, the fill between the bearing surface and undisturbed soil must be compacted to at least 90% Standard Proctor density.
 2. Pipe, bolts, nuts and fittings shall be wrapped with polyethylene film to prevent corrosion and concrete adhesion.
 3. Thrust blocks to be centered on bend horizontally.
 4. Thrust block 'A' shall be off centered on bend vertically to shift the majority of the block above the fitting.
 5. All joints to be Megalugged.
 6. Concrete thrust blocks to be placed on all vertical bends.

SIZE OF PIPE	DEGREE OF BEND											
	11 1/2°				22 1/2°				45°			
	L	W	H	V (cy)	L	W	H	V (cy)	L	W	H	V (cy)
6"	12	48	18	0.2	15	43	36	0.5	28	55	24	0.8
8"	12	63	24	0.4	18	57	34	0.7	36	67	33	1.4
12"	20	54	36	0.8	37	62	37	1.7	48	62	51	3.1
16"	31	65	38	1.6	55	65	39	3.0	65	65	65	5.6
20"	40	56	50	2.4	57	66	59	4.8	82	74	68	8.8
24"	48	60	60	3.5	67	72	66	6.9	91	91	72	12.7

WATER MAIN CROSSING STORM DRAIN (C187)

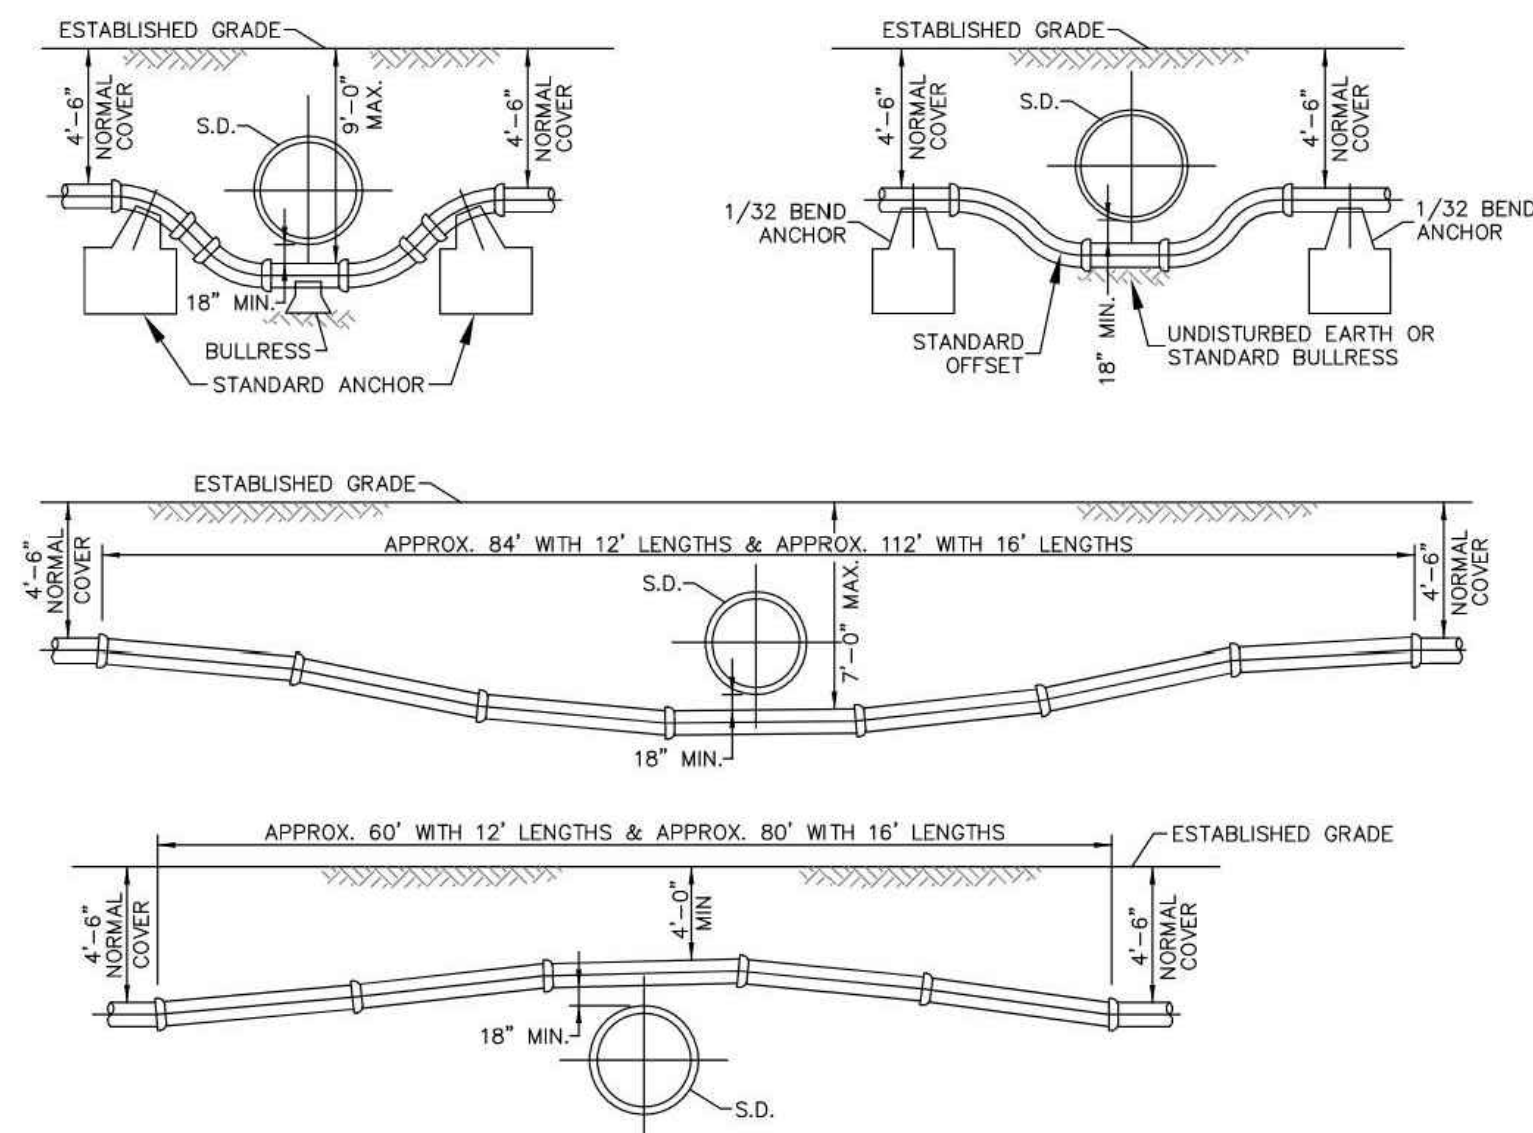

HORIZONTAL THRUST BLOCKS (C130)

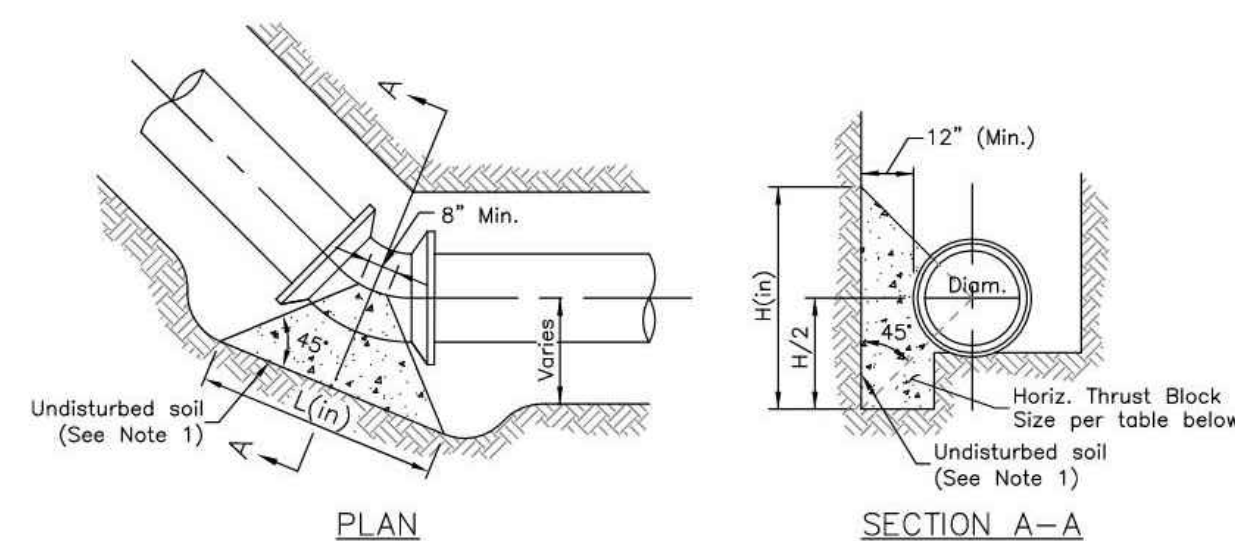

- NOTES:
1. Thrust blocks shall be placed against undisturbed soil. Where it is not possible, the fill between the bearing surface and undisturbed soil must be compacted to at least 90% Standard Proctor density.
 2. Pipe, bolts, nuts and fittings shall be wrapped with polyethylene film to prevent corrosion and concrete adhesion.
 3. All joints to be Megalugged.

SIZE OF PIPE	DEGREE OF BEND											
	11 1/2°				22 1/2°				45°			
	L	W	H	V (cy)	L	W	H	V (cy)	L	W	H	V (cy)
6"	16	8	16	10	24	14	32	18				
8"	16	10	21	14	31	18	44	24				
12"	21	16	32	20	48	26	66	36				
16"	29	20	42	28	66	34	90	46				
20"	37	24	50	36	73	48	107	60				
24"	46	28	64	40	93	54	128	72				

DESCRIPTION
ADDITIONAL 01
DATE
03/03/2023
REV
1

FOR
REFERENCE
ONLY



SANITATION BUILDING PROJECT - GP 1376
2801 REGENT AVE NE,
CANTON, OHIO 44705

CITY WATER AND COUNTY SANITARY DETAILS


ISSUED FOR:	
PERMIT	02/08/2023
BID	02/08/2023
CONSTRUCTION	02/08/2023
RECORD	02/08/2023
PROJECT MANAGER	DESIGNER
MLH	TJW

JOB NO.
2020377.05


C-503

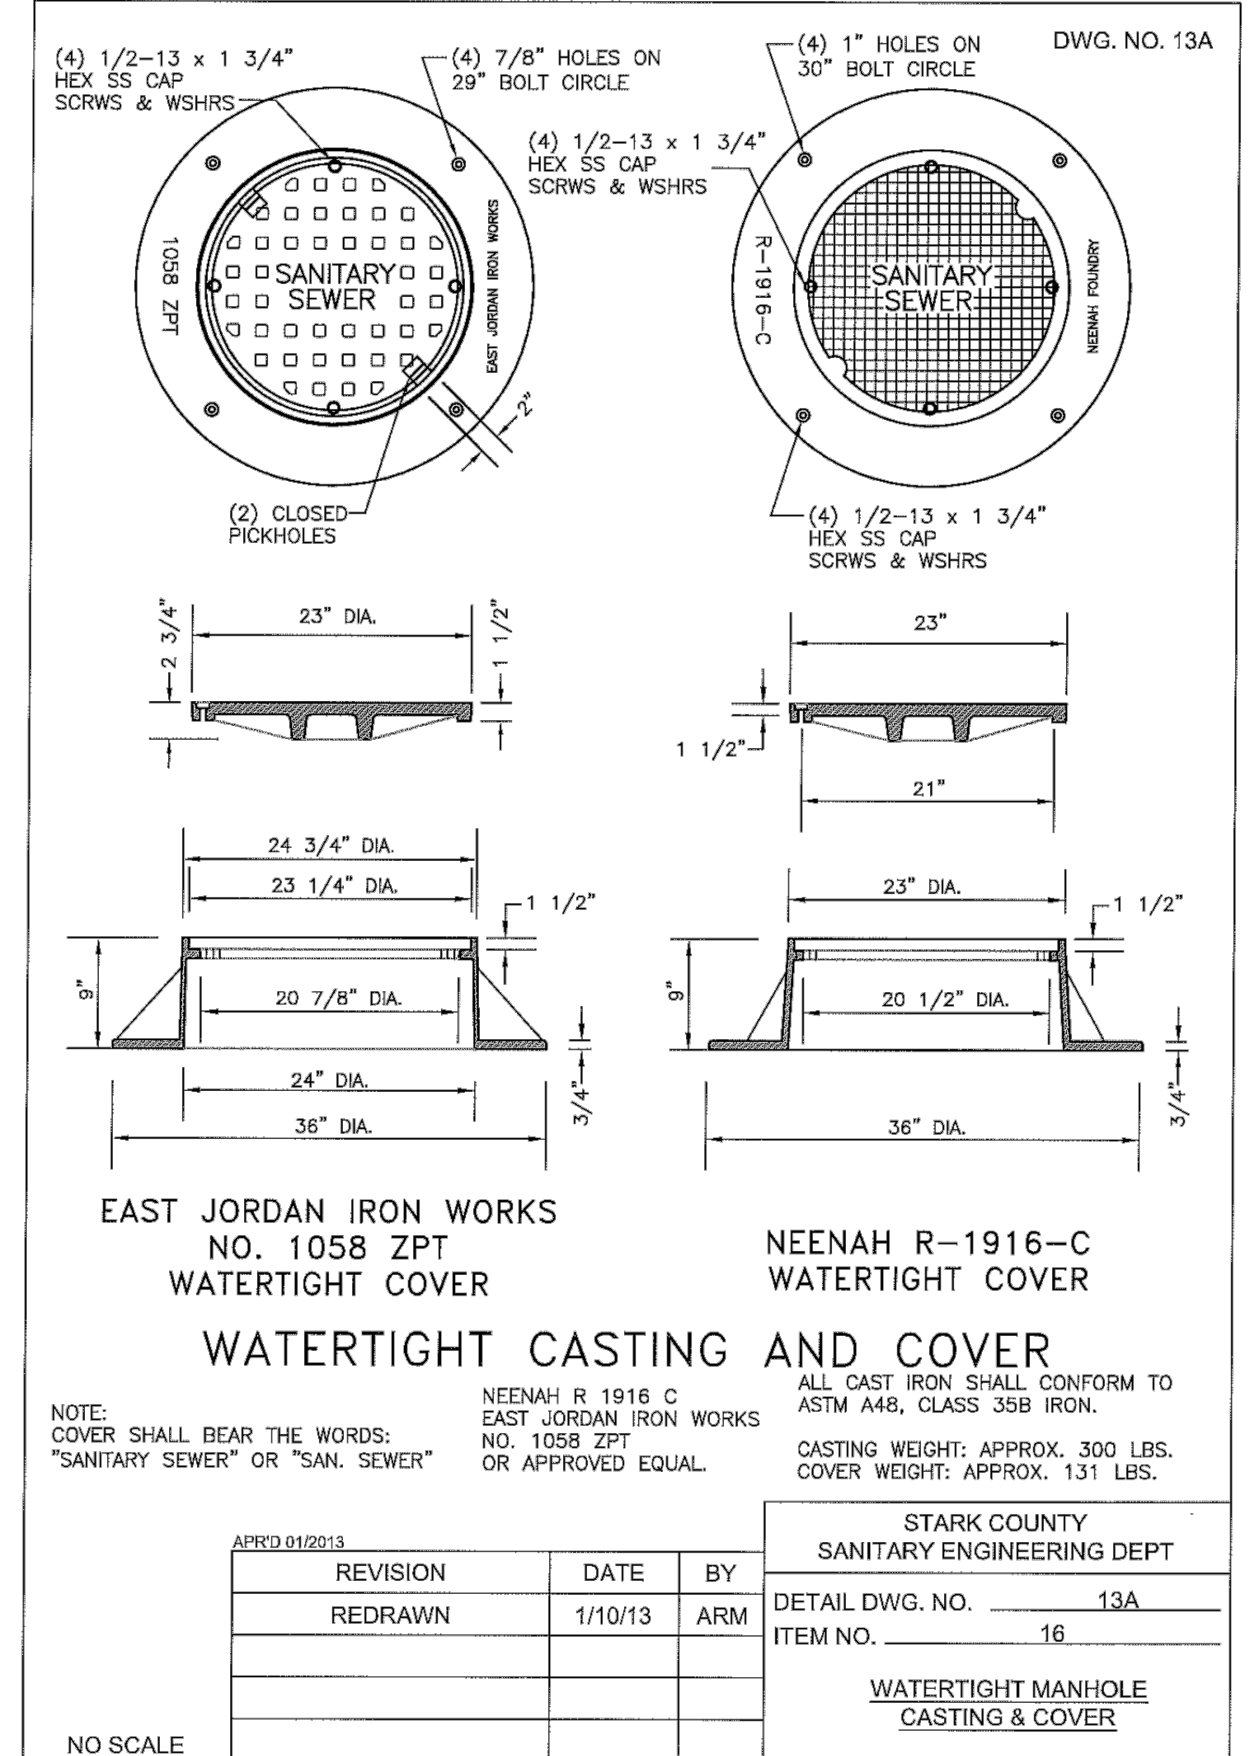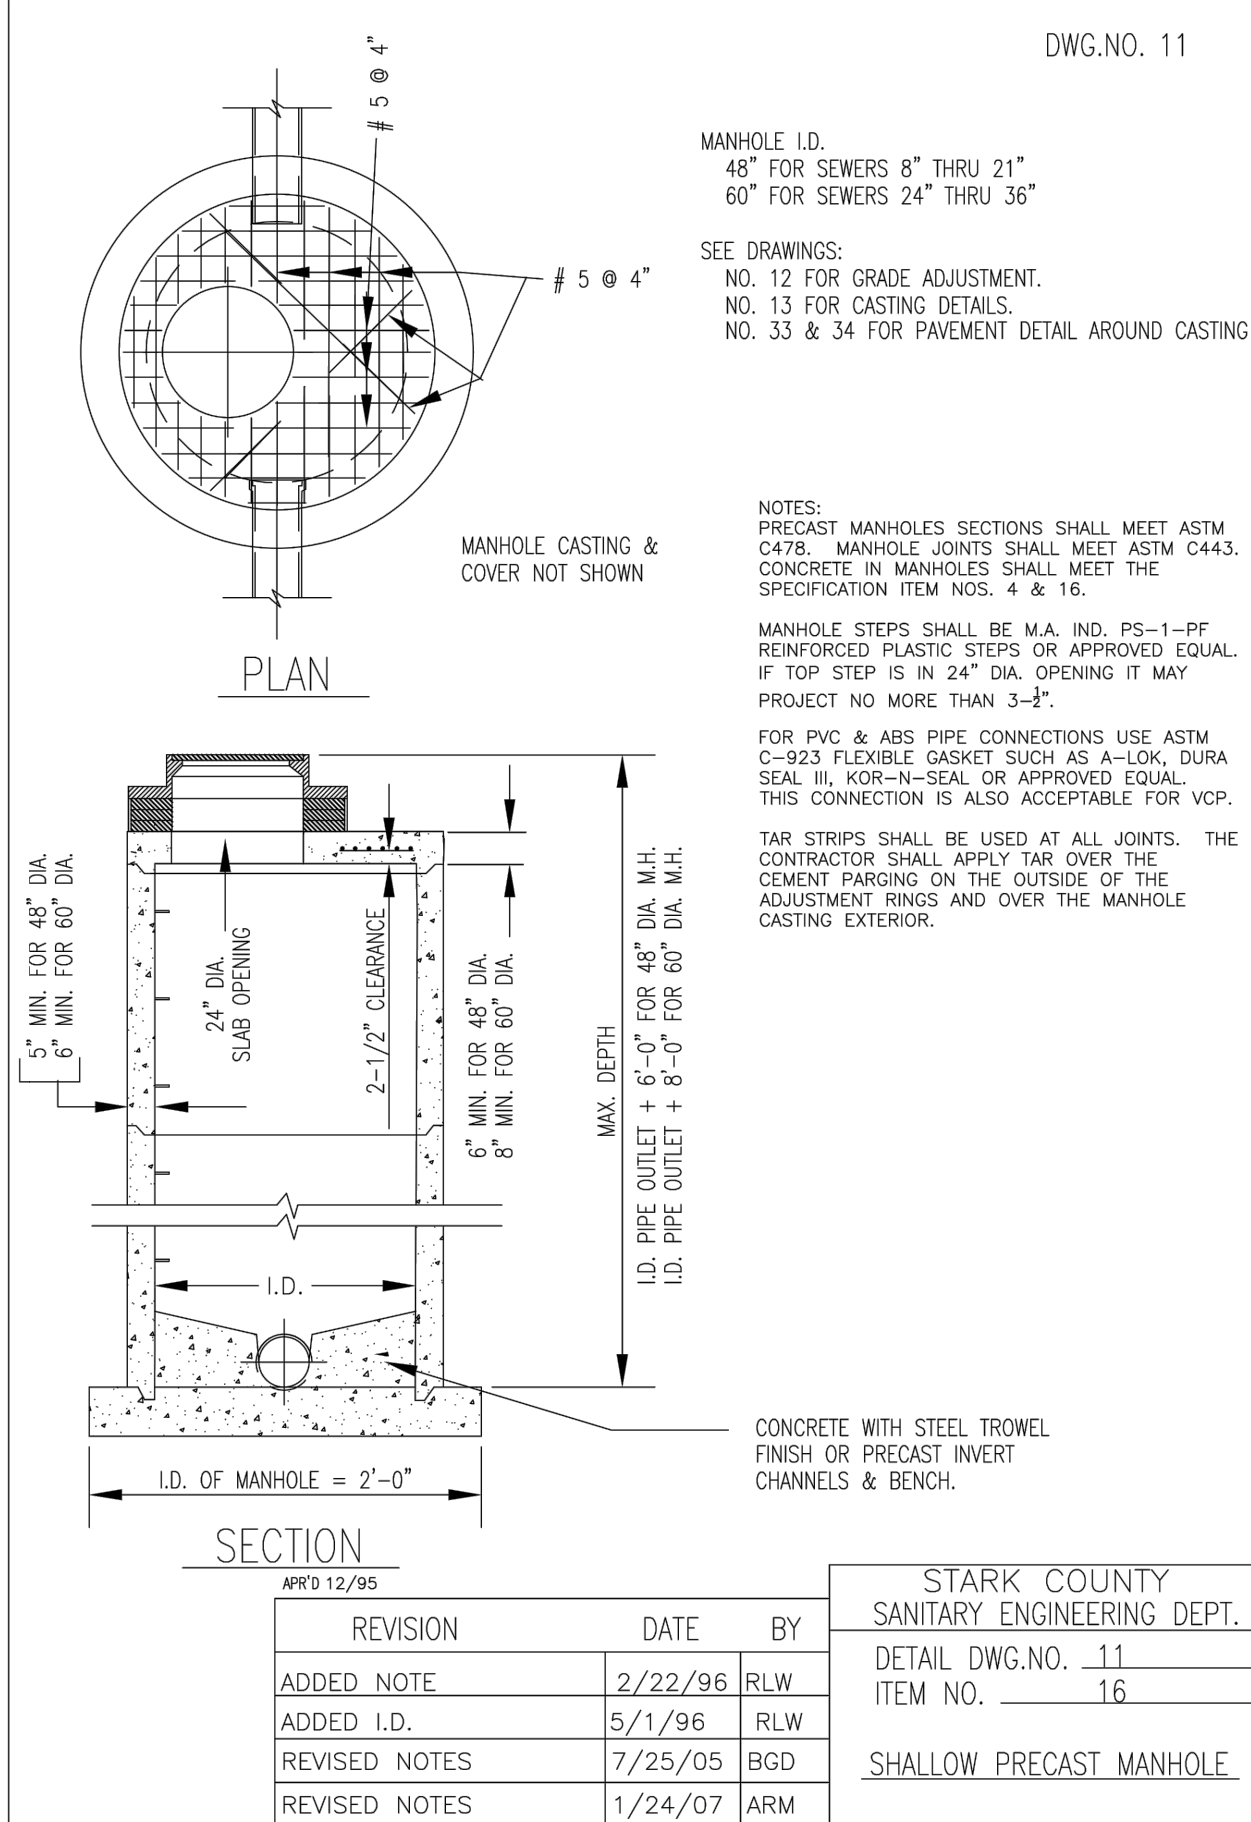

TYPICAL DUAL SERVICE (C109)

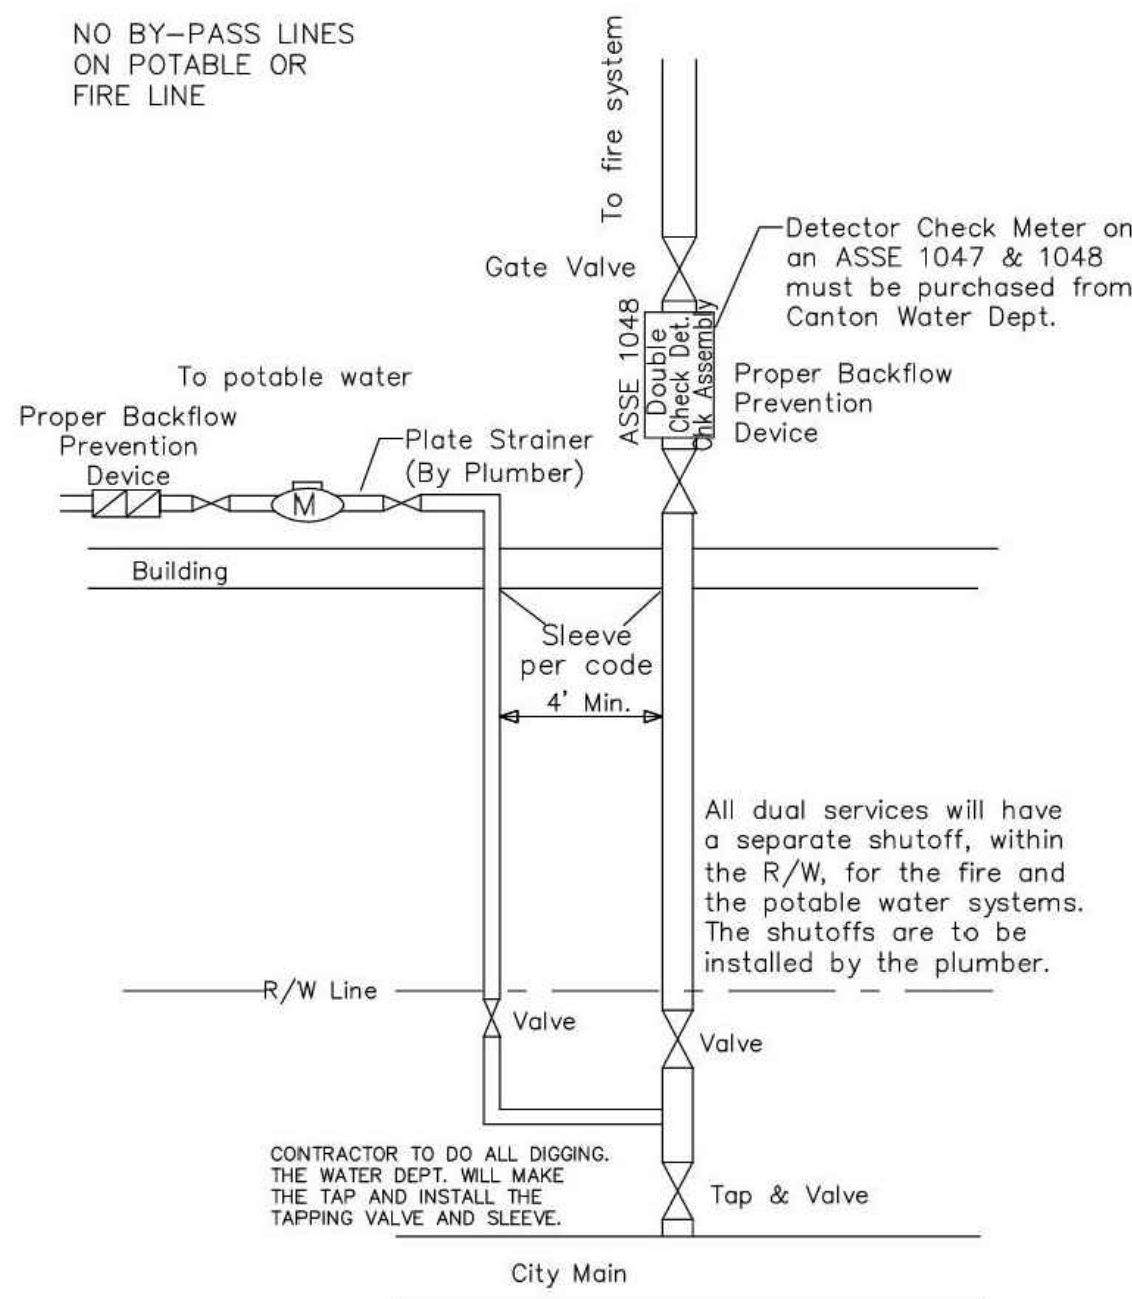

TYPICAL WATER SERVICE (C94)

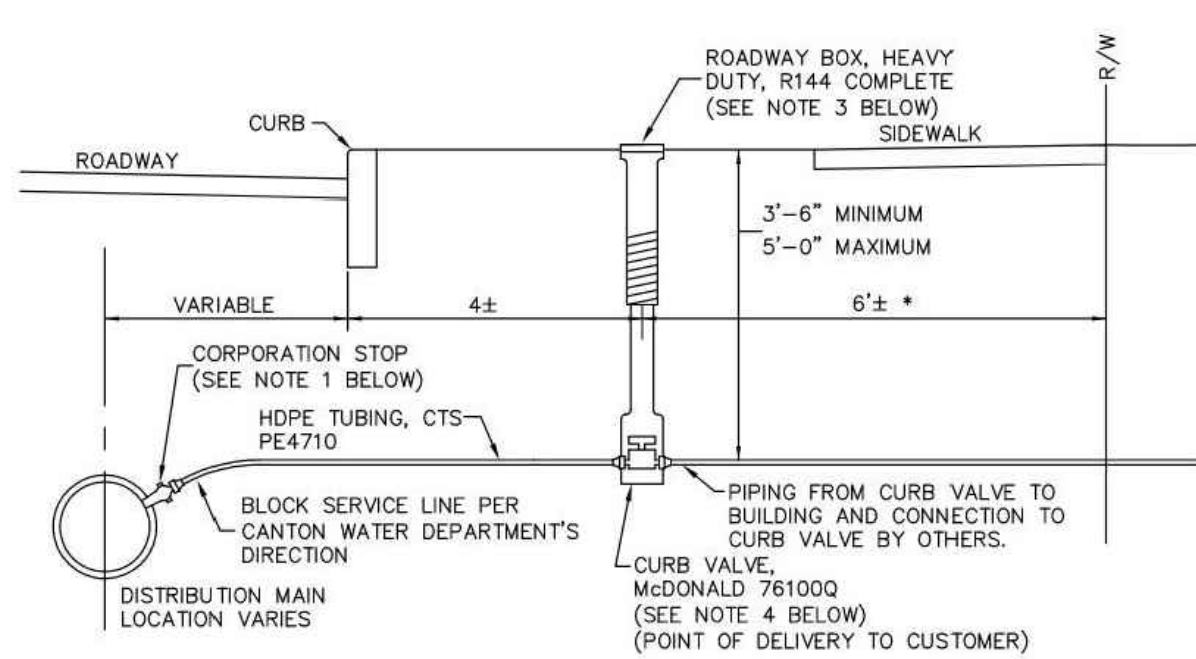

- NOTES:
1. CORPORATION STOP AND ASSEMBLY SHALL BE AS FOLLOWS:
 - 1" CORP. STOP ON DIP: INSTALL AT THE 2:00 POSITION, A MUELLER B-25008 CORPORATION STOP WITH A COMPRESSION CONNECTION.
 - 1" CORP. STOP ON PVC C909: INSTALL AT THE 2:00 POSITION, A MUELLER B-25008 CORPORATION STOP WITH A COMPRESSION CONNECTION AND A FORD, STAINLESS STEEL, EPOXY COATED TAPPING SADDLE (FC202 STYLE).
 - 1 1/2" CORP. STOP: INSTALL AT THE 2:00 POSITION, A MUELLER B-25008 CORPORATION STOP WITH A COMPRESSION CONNECTION AND A FORD, STAINLESS STEEL, EPOXY COATED TAPPING SADDLE (FC202 STYLE).
 - 2" CORP. STOP: INSTALL AT A 45° ANGLE, A MUELLER H-10003 CORPORATION STOP WITH 2" IRON TOP, A STANDARD NO LEAD BRASS 45° ELBOW AND A MUELLER H-15428 COMPRESSION MALE WITH INSERT COUPLING. ASSEMBLY SHALL ALSO CONSIST OF A FORD, STAINLESS STEEL, EPOXY COATED TAPPING SADDLE (FC202 STYLE).
 2. A SERVICE CLAMP MUST BE USED WHEN THE MAIN SIZE IS 2 INCH OR SMALLER.
 3. HEAVY DUTY VALVE BOXES, COMPLETE, MUST BE USED IN PLACE OF ROADWAY BOXES WHEN THE CURB VALVE IS LOCATED IN ROADWAYS OR ASPHALT DRIVES.
 4. WHEN CONNECTING A NEW 1" SERVICE TO AN EXISTING 3/4" SERVICE, THE CURB VALVE SIZE SHALL BE A 1 1/4" REDUCING CURB VALVE.
 5. BRASS REDUCING BUSHINGS OR SWIVEL ELLS WILL NOT BE ALLOWED.
 6. APPROVED EQUALS MAY BE USED IN PLACE OF SPECIFIED ITEMS.

CITY OF CANTON ACCEPTABLE WATER SERVICE MATERIALS

1", 1-1/2" AND 2"

- TYPE "K" COPPER OR
- POLYETHYLENE SERVICE TUBING - Polyethylene water main and service tubing 2" and under shall be copper tube size, SDR 9, with a minimum pressure class of 200 psi and meet standards ASTM-D2737 PE4710 and AWWA C901. The acceptable tubing is:
 - o CP Chem Performance Pipe Driscopex 5100-Ultra-line
 - o Charter Plastics Inc. Blue Ice
 - o Endot Endopure
 - o ADS Polyflex.

GREATER THAN 2"

- 4" TO 8"
 - DUCTILE IRON PIPE CLASS 52
 - OR
 - C909 (PVC) 235 psi

- 12"
 - DUCTILE IRON PIPE CLASS 53

GREATER THAN 12"

- DUCTILE IRON PIPE CLASS 54

NO EXCEPTIONS

L:\WORK\DRP\ENGINEERING\DRISCO_2020.mxd

A1 STARK COUNTY SANITARY DETAILS
N.T.S.

Drawing Name: C:\2020\2020377\05 - Sanitation Building\4 - Working Files\00_CAD (2020)\C\Sheets\2020377_05 Notes And Details.dwg
Date: 12/23/2023 7:32 PM - Night



Aluminum Slide Gate Specifications

- Scope:**
Specification for the materials and construction requirements for chain link cantilever slide gates with enclosed aluminum track and hardware manufactured to comply with ASTM F-1184, ASTM F-2200, and Underwriter's Laboratory UL-325 safety standards.
- Manufacturer:**
Sharon Fence Company
One Miller Court
Sharon, PA 16164
Phone (724) 981-6050 Fax (724) 346-0234 www.sharonfence.com
- Warranty:** Sharon Fence warrants this product for a period of 5 years when installed in accordance with manufacturers standards and maintained in proper manner.

- General:**
A. Gate Frame: The entire frame and support members shall be manufactured with the same aluminum material, alloy and temper 6061-T6 (ASTM 1184). Fabricate chain link cantilever slide gates in accordance with ASTM F-1184, Type II, Class 2, using 2 inch square aluminum outside vertical members (1.10 lb/ft). Members are welded together with a continuous top track (8.43 lb/ft) and bottom rail to form a rigid one-piece frame. Vertical interior support uprights will be positioned equally throughout the frame structure.

For 15 ft. - 22 ft. opening gates, the vertical interior support uprights will be 1.5 inch square aluminum (6061-T6) tubing (0.809 lb/ft). The bottom rail shall be a continuous one-piece 2 inch square aluminum (6061-T6) tube (1.10 lb/ft).

Standard Opening Overall Gate Length Bays
15 ft. to 18 ft. 26' 3" 4
19 ft. to 22 ft. 31' 3" 5

For 23 ft. - 30 ft. opening gates, the vertical interior support uprights will be 2-inch square aluminum (6061-T6) tubing (1.10 lb/ft). The bottom rail shall be a continuous one-piece 2-inch by 4-inch rectangular tube (1.69 lb/ft). An additional 2-inch square support rail shall be welded adjacent to the top track horizontal rail. The cantilever overhang will be 40% or greater for any given opening size.

Standard Opening Overall Gate Length Bays
23 ft. to 26 ft. 37' 3" 6
27 ft. to 30 ft. 42' 3" 7

For 23 ft. - 30 ft. opening gates, the vertical interior support uprights will be 2-inch square aluminum (6061-T6) tubing (1.10 lb/ft). The bottom rail shall be a continuous one-piece 2-inch by 4-inch rectangular tube (1.69 lb/ft). An additional 2-inch square support rail shall be welded adjacent to the top track horizontal rail. The cantilever overhang will be 40% or greater for any given opening size.

B. There will be two track assemblies (secured to the guide posts) which operate inside the top track. They shall be swivel type one die cast with 4 sealed and lubricated ball bearing rollers (2" dia., 3/16" width) and two side rollers (front and back) to assure alignment in the top track.

C. The top track and rail is an enclosed combination one-piece aluminum (6061-T6) extrusion weighing 3.83 lb/ft. Top track to withstand a 2,000 lb. reaction load.

D. Chain link fabric shall be installed over the entire gate length (UL-325) which will create a universal design (gate can be used for right or left hand applications). Fabric will be attached securely with tension bars that are attached on either frame end by tension bands. High tensile wire will provide additional fabric support across the top and bottom of the gate structure.

E. Diagonal bracing shall be 1"x2" aluminum (6061-T6) tubing (0.809 lb/ft) welded to the uprights to form a rigid bracing system that does not require field adjustment.

F. Bottom guide wheel assemblies have two 3" dia. rubber wheels (with protective covers - UL325) straddling the bottom horizontal gate rail. One assembly shall be attached to each guide post.

G. Gate post brackets, latch, and keepers are galvanized steel.

H. Gate posts shall be 4" OD schedule 40 pipe (51 lb/ft). Two support posts and 1 latch post shall be installed.

5. **Installation:** Gate posts shall be set in concrete (3000 psi compressive strength). The footing shall be 16" in diameter with depth approximately 6" deeper than the post bottom. Deeper footing may be required in areas with loose or soft soil. Set post bottom at least 36" below the surface. Posts must be plumb. Install gates plumb, level and secure for the full opening size making sure they move free of obstructions. Adjust hardware for smooth operation.

Sharon Fence Distributors | One Miller Court, Sharon PA 16146 | (724) 981-6050
Dated 8.15.2019

SLIDING GATE DETAILS
N.T.S.



CSL24UL 24VDC HIGH-TRAFFIC COMMERCIAL SLIDE GATE OPERATOR

Ideal for the most demanding slide gate environments.



PRODUCT HIGHLIGHT
BATTERY BACKUP
Provides up to 208 Cycles or 24 Days of Standby Power

RELIABLE

BATTERY BACKUP PROVIDES SEAMLESS ACCESS BY PROVIDING STANDBY POWER WHEN THE POWER IS DOWN.

COMMERCIAL GEAR-DRIVEN TRANSMISSION PROVIDES UNSURPASSED RELIABILITY.

SMOOTH START/STOP OPERATION AND MID-TRAVEL REVERSAL EXTEND OPERATOR HARDWARE LIFE.

WARRANTY 5 YEARS COMMERCIAL, 7 YEARS RESIDENTIAL.

SMART

myQ® TECHNOLOGY ENABLES YOU TO SECURELY CONTROL AND MONITOR YOUR GATE OPERATOR FROM ANYWHERE.*

WIRELESS DUAL-GATE COMMUNICATION SYNCHRONIZES GATE OPENING/CLOSING AND ELIMINATES EXPENSIVE DRIVEWAY TRENCHING COSTS.

SAFE AND SECURE

SECURITY+ 2.0® SAFEGUARDS ACCESS WITH AN ENCRYPTED TRI-BAND SIGNAL TO VIRTUALLY ELIMINATE INTERFERENCE AND OFFER EXTENDED RANGE.

QUICK CLOSE AND ANTI-TAILGATE QUICKLY SECURES THE PROPERTY, PREVENTING UNAUTHORIZED ACCESS.

FIRE DEPARTMENT COMPLIANCE ALLOWS GATE TO AUTO-OPEN UPON LOSS OF AC POWER OR BATTERY DEPLETION.

MANUAL DISCONNECT WHEN UNLOCKED ALLOWS GATE TO BE OPENED MANUALLY.

UL® LISTED GATE OPERATORS WITH MONITORED SAFETY ENTRAPMENT PROTECTION DEVICES.

* Cellular data or Wi-Fi® connection required. Test equipment regularly and follow safety instructions.

PRODUCT GUIDE CSL24UL
24VDC HIGH-TRAFFIC COMMERCIAL
SLIDE GATE OPERATOR

CSL24UL

24VDC HIGH-TRAFFIC COMMERCIAL SLIDE GATE OPERATOR

Ideal for the most demanding slide gate environments.

INCLUDED ACCESSORIES:

MONITORED RETRO-REFLECTIVE PHOTO EYE
Enhanced retro-reflective photo eye rose with heater and wider beam, engineered to stay aligned; max. range: 50 ft.

MONITORED SMALL PROFILE RESISTIVE EDGE
Pressure-sensitive edge stops and/or reverses gate when obstructed.

SAFETY ADD-ONS:

MONITORED THROUGH-BEAM PHOTO EYES
Enhanced through-beam now with wider beam and heater for high performance in most environments; max. range: 90 ft.

MONITORED WIRELESS EDGE KIT
Low-energy bluetooth® connection between a LiftMaster Monitored Resistive Edge and the gate operator; max. range: 130 ft.**

MONITORED SAFETY ENTRAPMENT EDGES
Full line of Small, Large and Wraparound Profile Edges that sense obstructions.

MONITORED SAFETY ENTRAPMENT EDGES
Full line of Small, Large and Wraparound Profile Edges that sense obstructions.

TOTAL SOLUTION ACCESSORIES:

CONNECTED ACCESS PORTAL, HIGH CAPACITY
Cloud-based access control for residential communities.

PLUG-IN LOOP DETECTOR
Prevents the gate from closing on a vehicle in the path; power efficient for maximum cycles on Battery Backup.

INTERNET GATEWAY
Connects myQ-enabled gate operators to the internet and enables control through the myQ App.

** Wireless kit for up to 4 transmitters and 2 receivers; ranges per transmitter.

LiftMaster ELITE SERIES

MASTERFUL ENGINEERING.

MECHANICS

- 24VDC Continuous Duty
- Operator Duty Rating: High-Cycle, High-Temperature Continuous Duty
- Wormgear Reduction: Commercial Oil-Bath Gearbox Provides 10:1 Wormgear Reduction
- Chain: #41 Black Oxide (30 ft. Supplied)

POWER

- 120/230V Single-Phase
- Optional Kit (SPICCONV) to Convert an Input Voltage of 208/230/240/250VAC to an Output Voltage of 120VAC
- Solar-Ready Ultra-Reliable System Delivers Power When and Where You Need It (LMRUL/LMTRUL Heater Option Not Recommended for Solar Applications)
- Accessory Power: 24VDC 500mA Output; Switched and Unswitched Power

COMMERCIAL-GRADE DESIGN

- Chassis Constructed with 1/4 in. Gold Zinc-Plated Steel for Rust Prevention
- Cover: High-Density, UV-Resistant Polycarbonate 2-Piece Cover for Excellent Heat and Corrosion Resistance
- UL® Usage Classification: I, II, III and IV
- Operator Weight: 140 lbs.

TEMPERATURE SPECIFICATIONS

WITHOUT HEATER -4°F (-20°C)
WITH HEATER (DTR) -40°F (-40°C)

WITHOUT HEATER -140°F (-95°C)
WITH HEATER (DTR) -140°F (-95°C)

BATTERY BACKUP OPERATION

Battery Cycles Standby Time
(2) 7AH 208 24 Days
(2) 35AH 1,178 165 Days
(Cycles and Standby Time Based on Stand-Alone System)

CSL24UL

24VDC HIGH-TRAFFIC
COMMERCIAL SLIDE
GATE OPERATOR



25.07"
15.55"
19.51"

SLIDE RATING

1,000 lbs.
500 lbs.
0 lbs.

GATE SPEED

12" per second

STANDARD FEATURES.

INHERENT REVERSING SENSOR
- Detects Obstructions and Reverses Gate When Closing or Stops/Reverses Gate When Opening

SECURITY+ 2.0® ON-BOARD RADIO RECEIVER
- Tri-Band 310/315/330 Mhz Frequency Up to 50 Remote Controls (Unlimited with 811LM/813LM)

LED DIAGNOSTIC DISPLAY
- Simplifies Installation and Troubleshooting


PROGRAMMABLE AUXILIARY RELAYS
- Make Adding Additional Features Easy

HOMELINK® COMPATIBLE
- Version 4.0 or Higher*

* Requires an external adapter depending on the model and year of your vehicle. Visit Homelink.com for additional information.


© 2019 The Chamberlain Group, Inc. All Rights Reserved. LiftMaster, the LiftMaster logo, myQ and the myQ logo are registered trademarks of The Chamberlain Group, Inc.
24VDC High-Traffic Commercial Slide Gate Operator
UL and myQ are trademarks of UL LLC © 2019 All Rights Reserved.
Wi-Fi is a registered trademark of Wi-Fi Alliance.
© 2019 LiftMaster LLC. All rights reserved.
Homelink and the Homelink logo are registered trademarks of Chamberlain Corporation.
LHMFG2019-01-01

LiftMaster ELITE SERIES

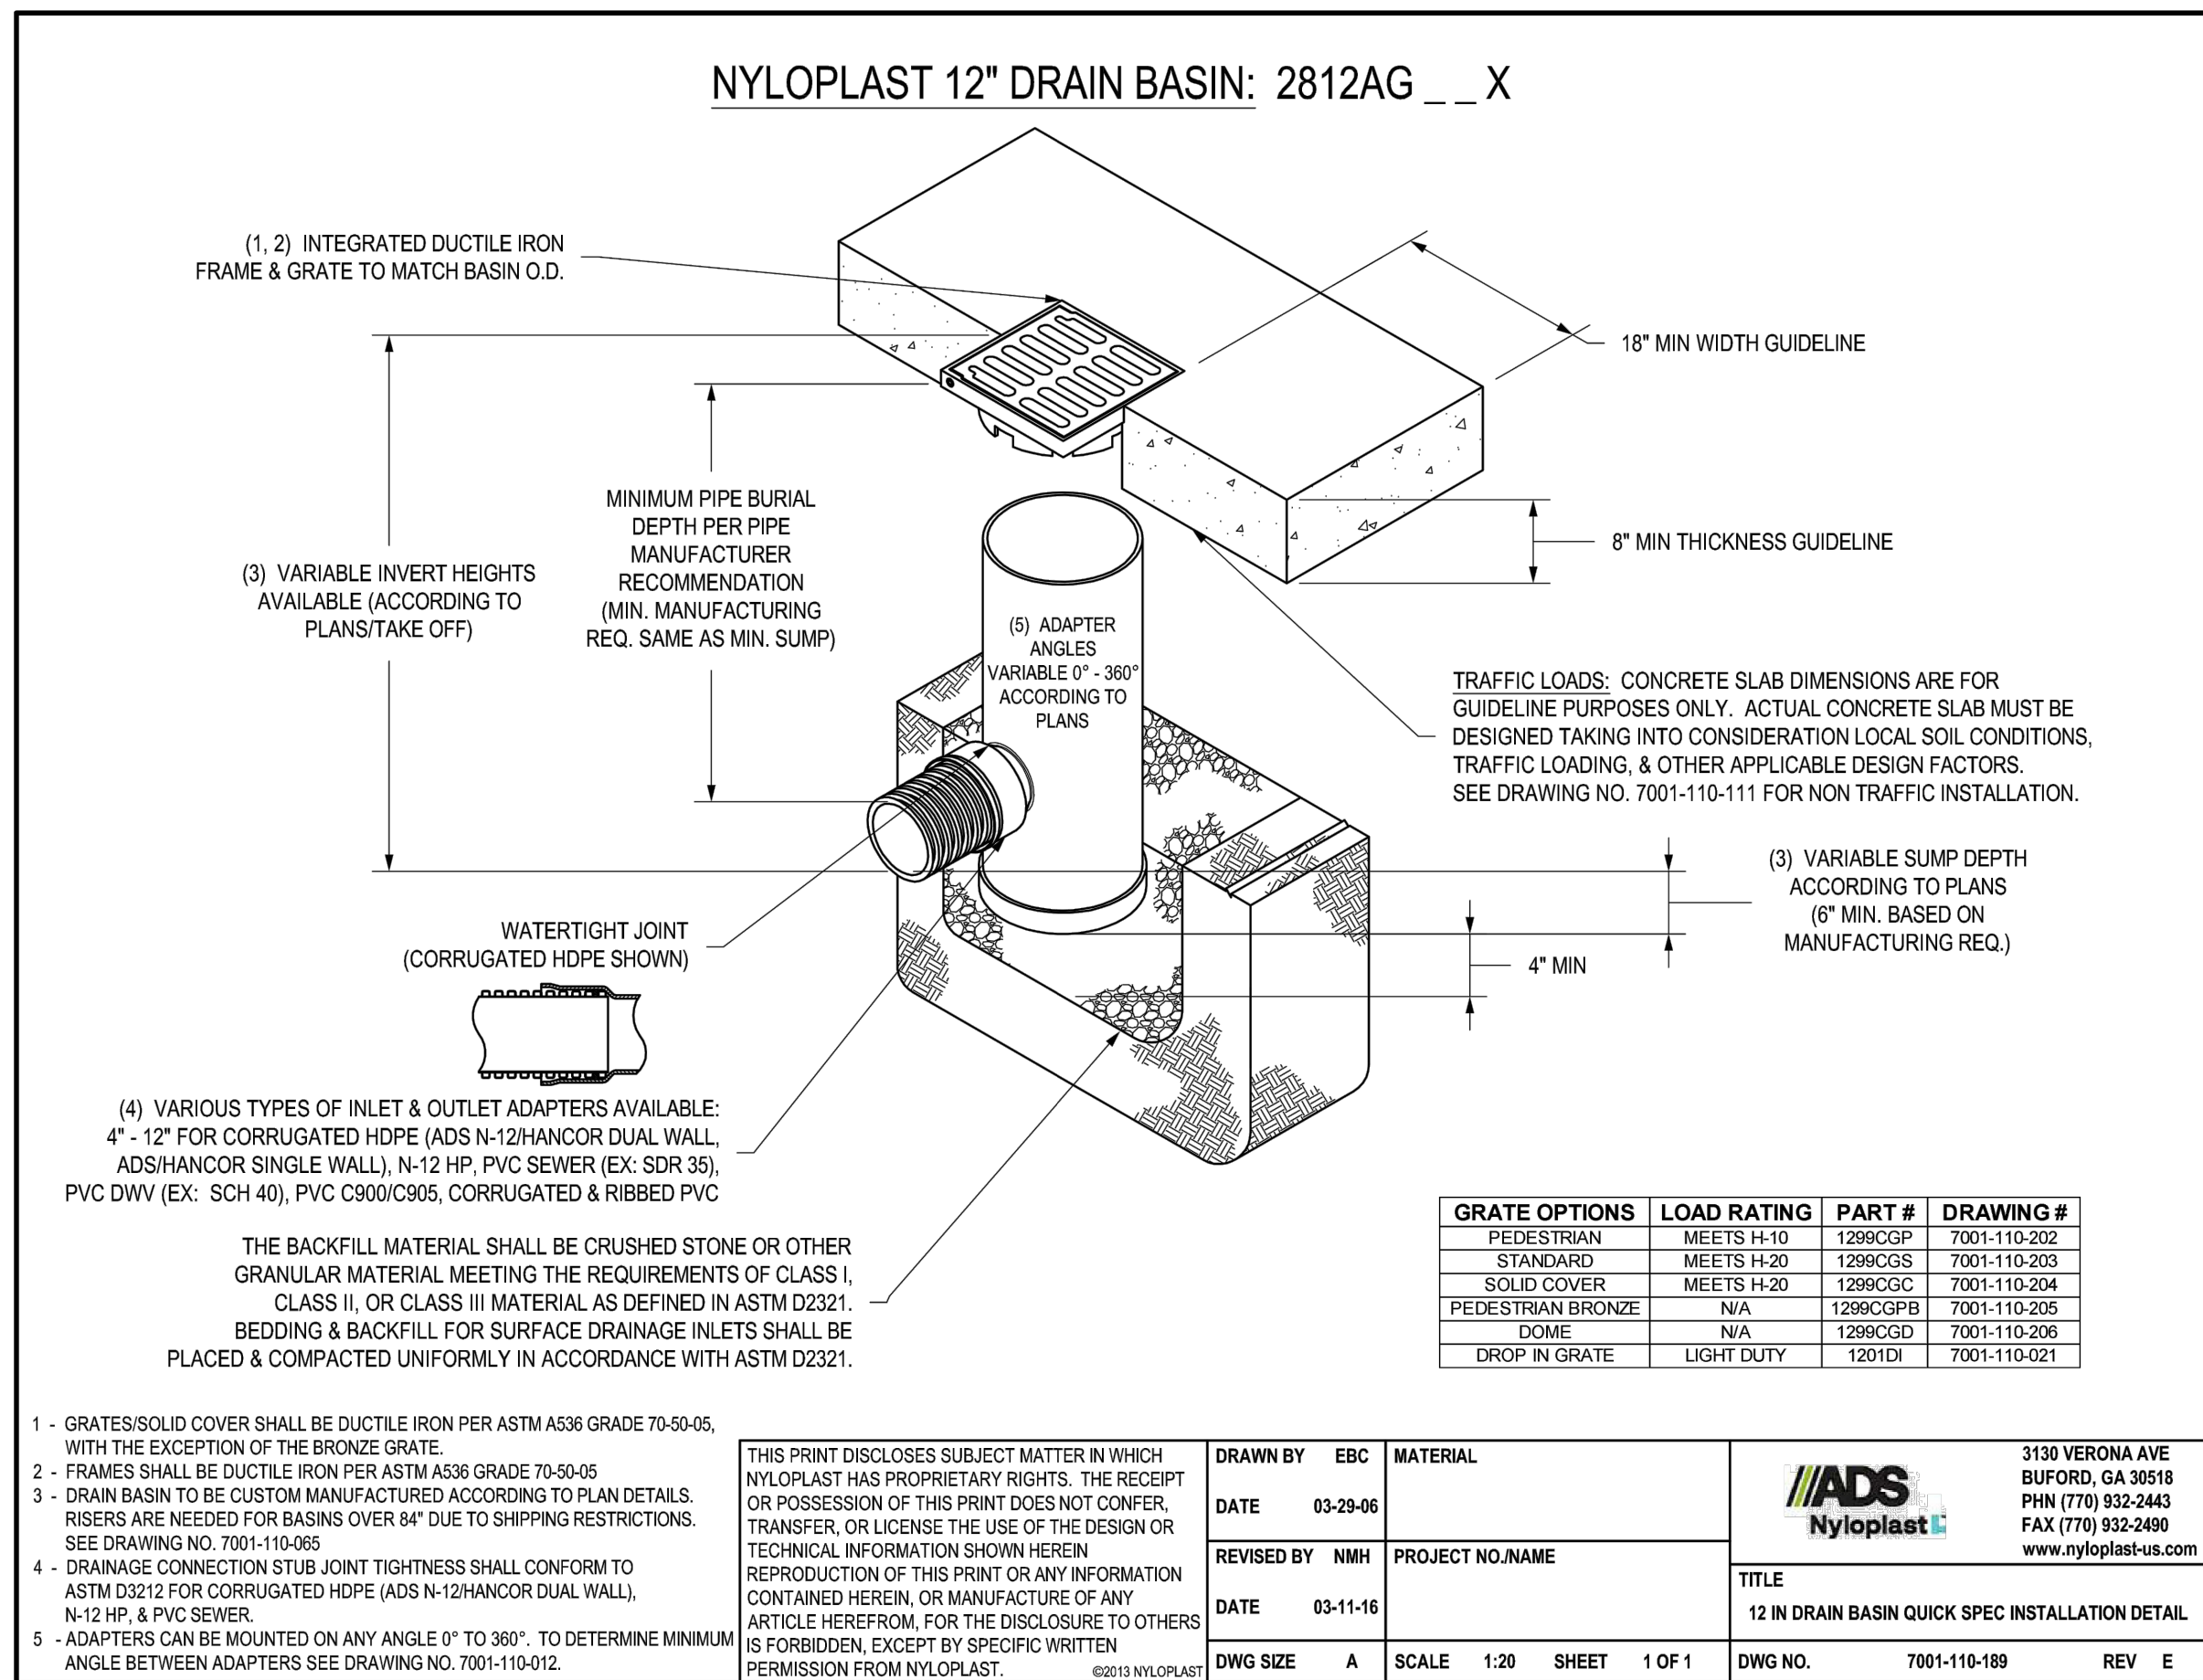

ESR30C51-02


External Single Revolving - Ground Set

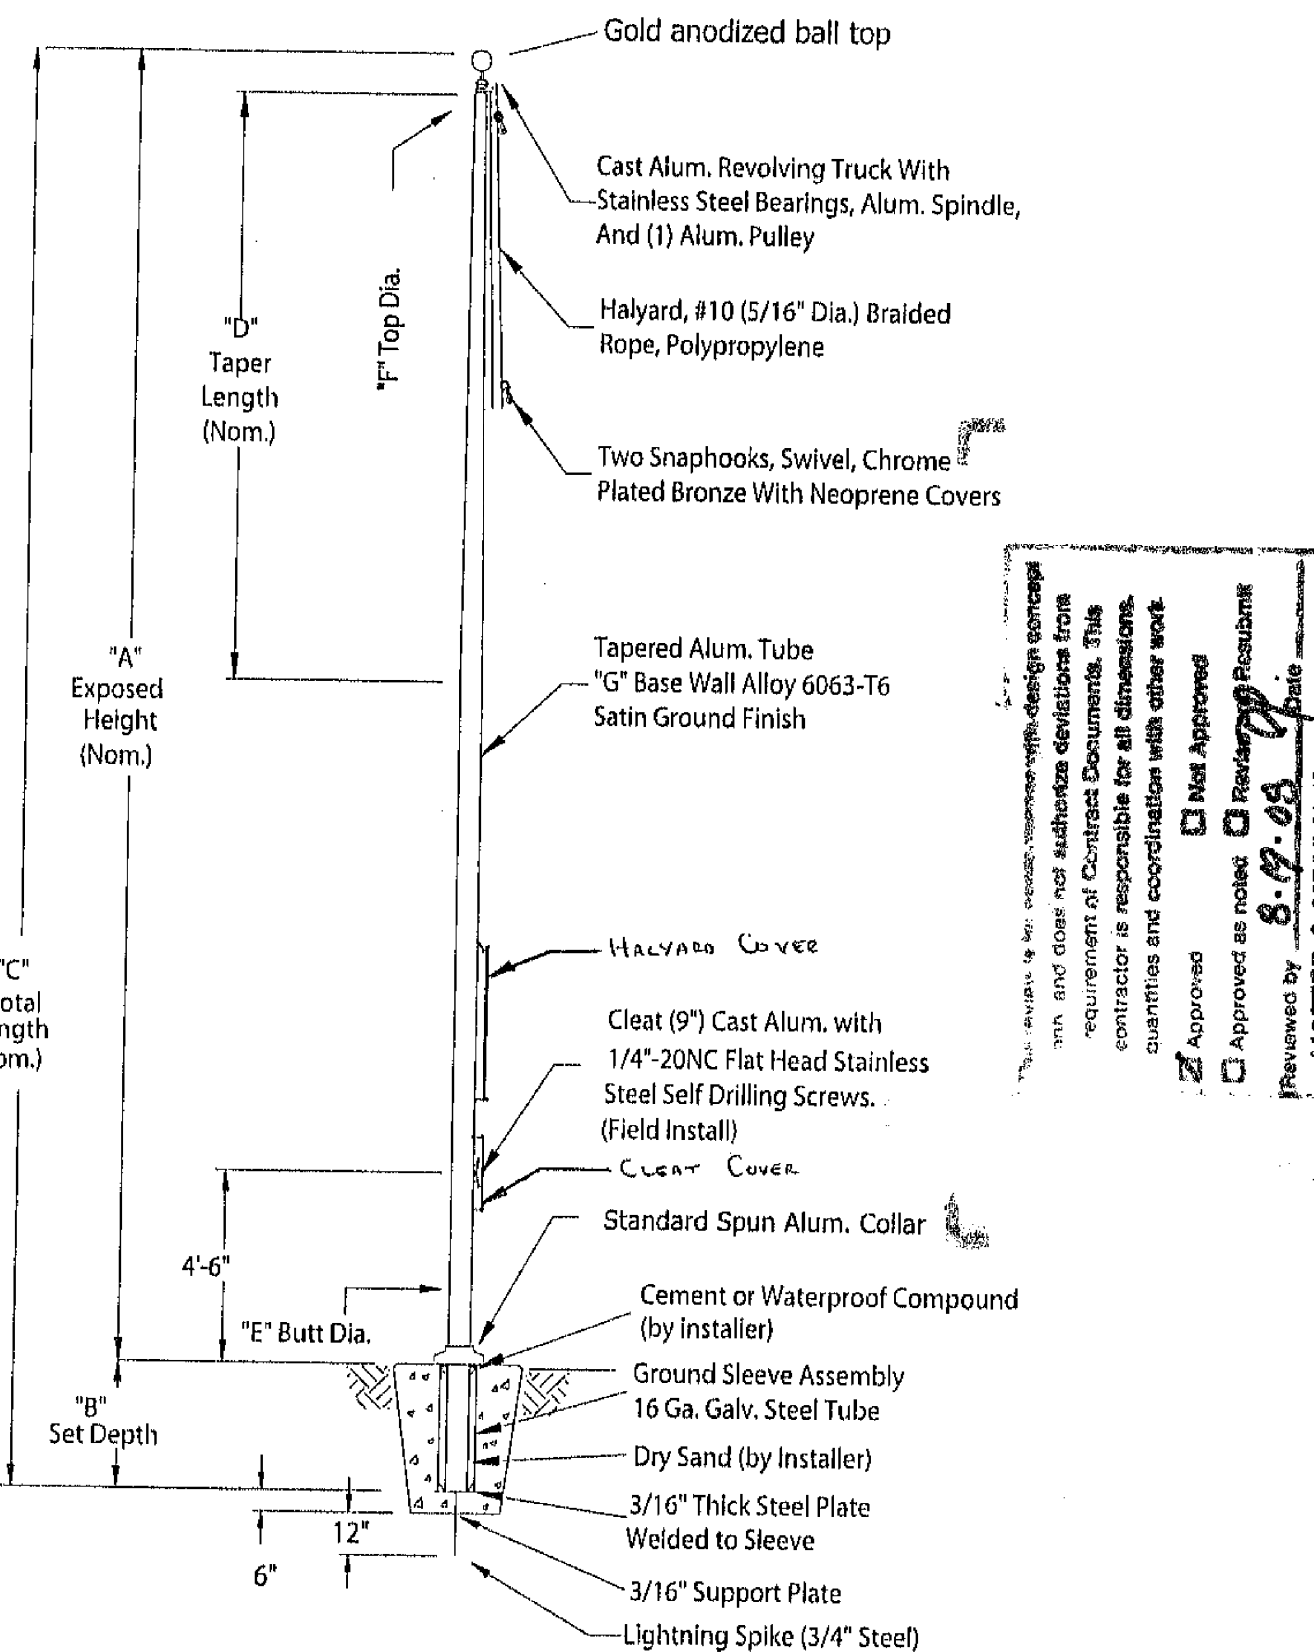

A	30 ft.	Exposed Height
B	3 ft.	Set Depth
C	33 ft.	Total Length
D	11 ft. 0 in.	Taper
E	5 in.	Butt Diameter
F	3 in.	Top Diameter
G	0.156 in.	Wall Thickness
Finish: Satin Aluminum, 80 Grit		Pieces: 1
Accessories:		
Gold anodized ball top, standard collar		

Customer Name: N.L. Construction
Rep Name: REM Graphics
Project: Canton Collection Systems
Location:
PO Number:
Quantity: 1
Notes:

Specifications for Rigid Lip Level Spreader

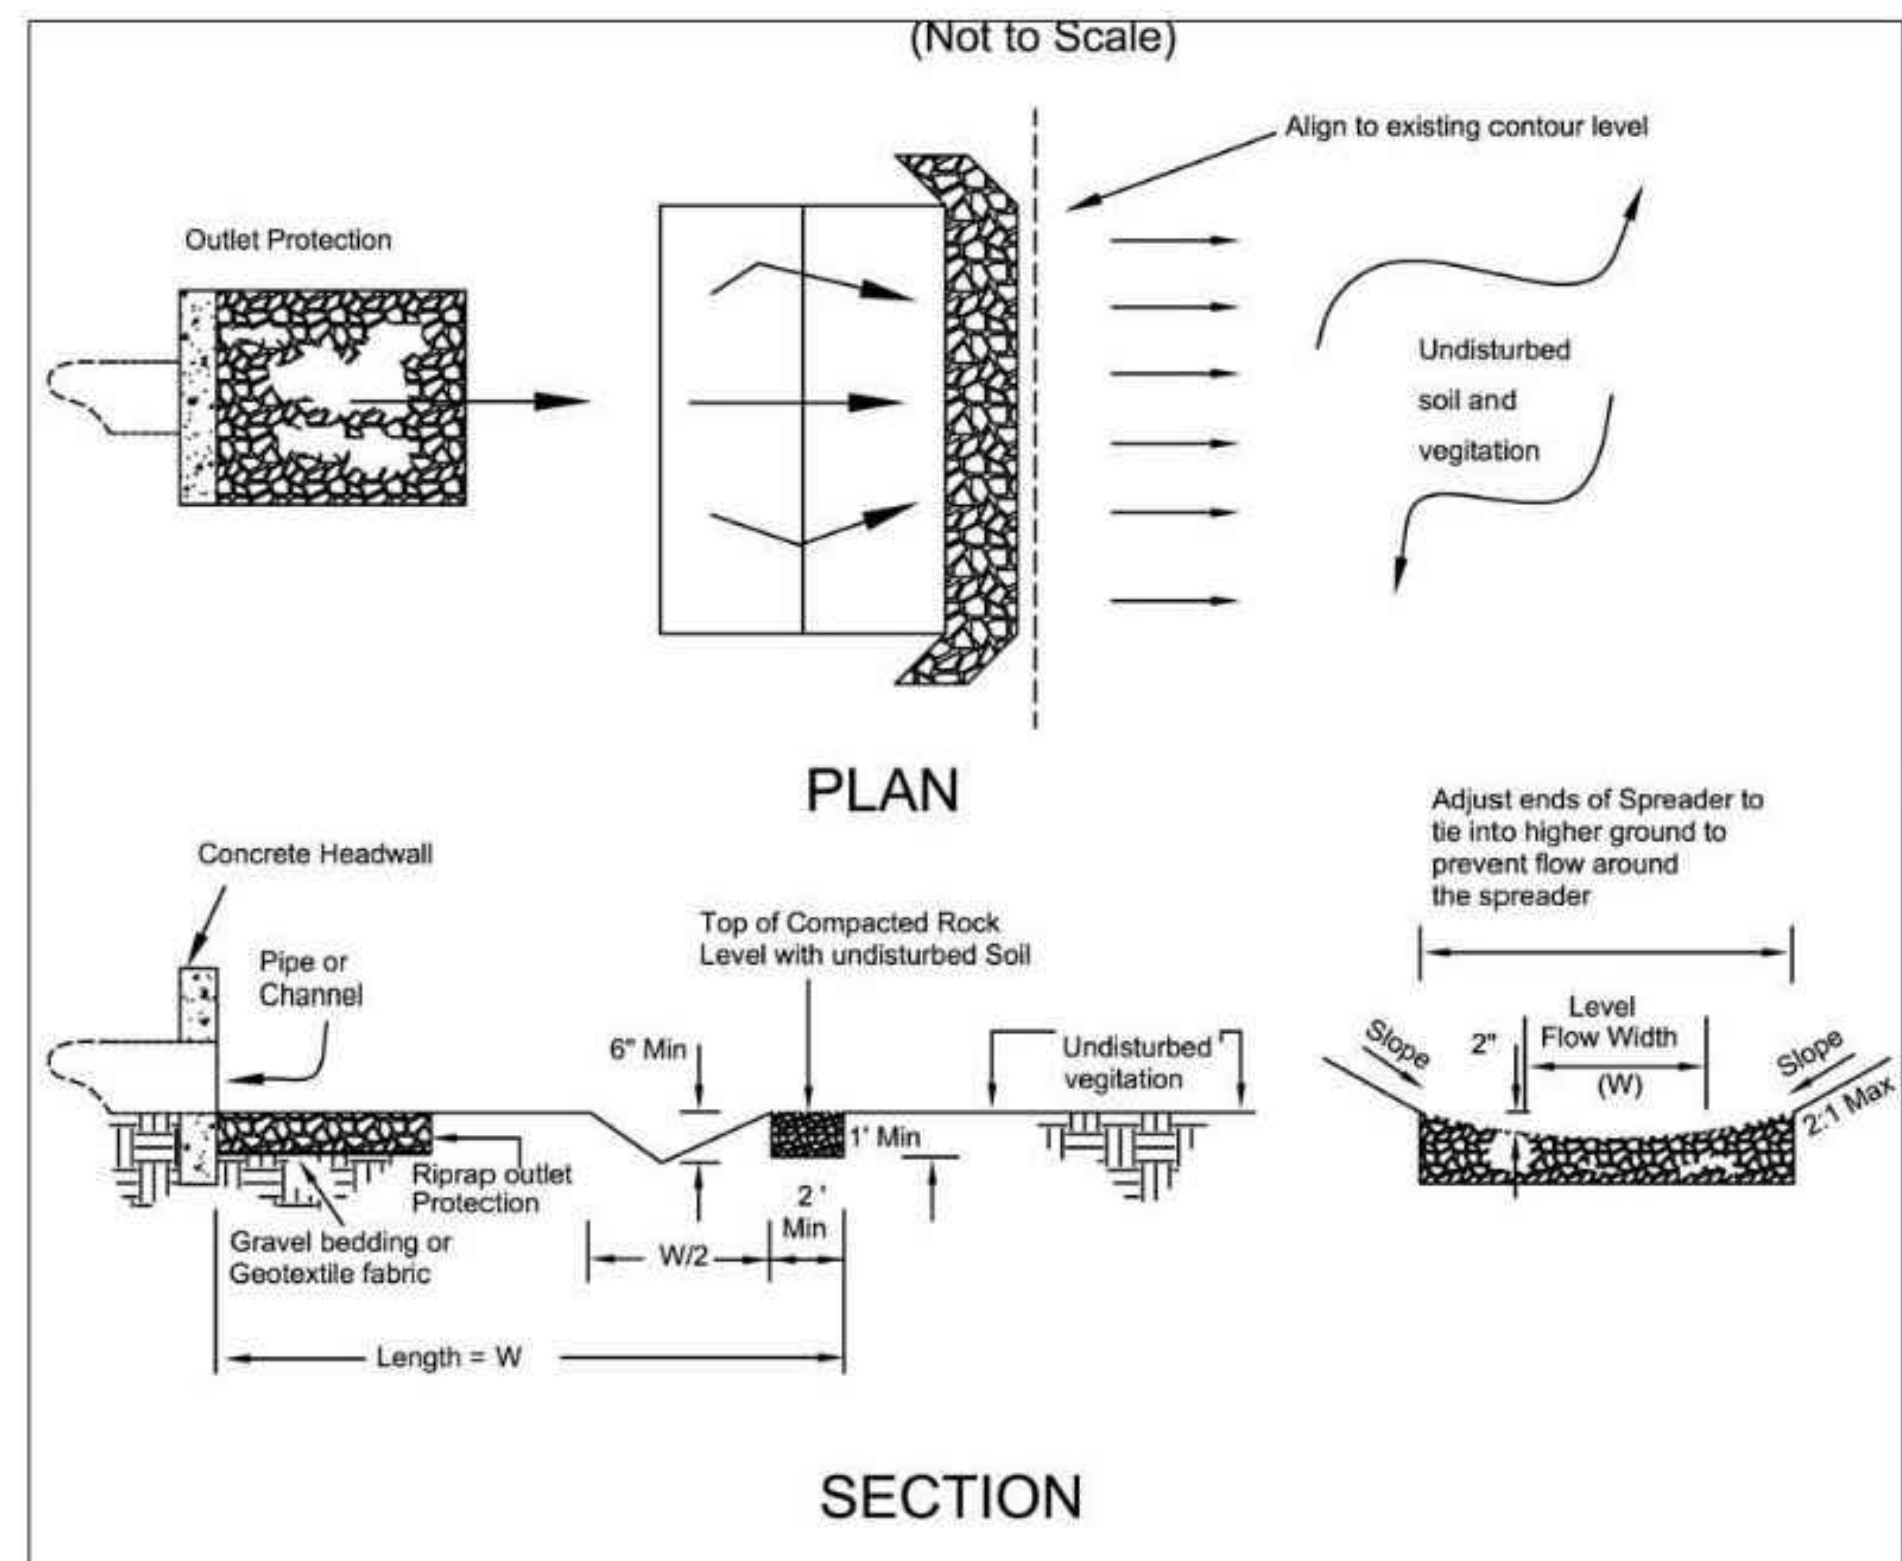

- Construct level spreader on a level grade to ensure uniform spreading of storm runoff.
- Level spreaders must be constructed on undisturbed soil, NOT on fill.
- The level spreader must outlet to erosion-resistant areas with established existing vegetation.
- Rock shall be ODOT Type D where 50% of the material by weight is larger than 6 inches, and 85% of the material by weight is larger than 3 inches but less than 12 inches.
- Rock in level spreader shall be compacted with at least two passes of heavy machinery to prevent further settling. Spread gravel or soil over top of the placed riprap surface to fill the voids and interlock the riprap together.
- Fertilizing, seeding, and mulching shall conform to the recommendations in the applicable vegetative specification.

CHAPTER 4 Permanent Runoff Control 13

This document has not been reviewed by the stamping party. Therefore, the stamping party makes no representation(s) with respect to its contents, and shall not be liable for such. Any reliance on this stamp shall be at the relying party(ies)'s own risk and hereby waives any and all claim(s) related to the existence of the stamp or otherwise.

DESCRIPTION

ADDITIONAL 01

DATE

03/02/2023

REV

1

FOR
REFERENCE
ONLY


SANITATION BUILDING PROJECT - GP 1376
2801 REGENT AVE NE,
CANTON, OHIO 44705

DETAILS

ISSUED FOR:	
PERMIT	02/08/2023
BID	02/08/2023
CONSTRUCTION	02/08/2023
RECORD	02/08/2023
PROJECT MANAGER	DESIGNER
MLH	TJW

JOB NO.
2020377.05

C-504

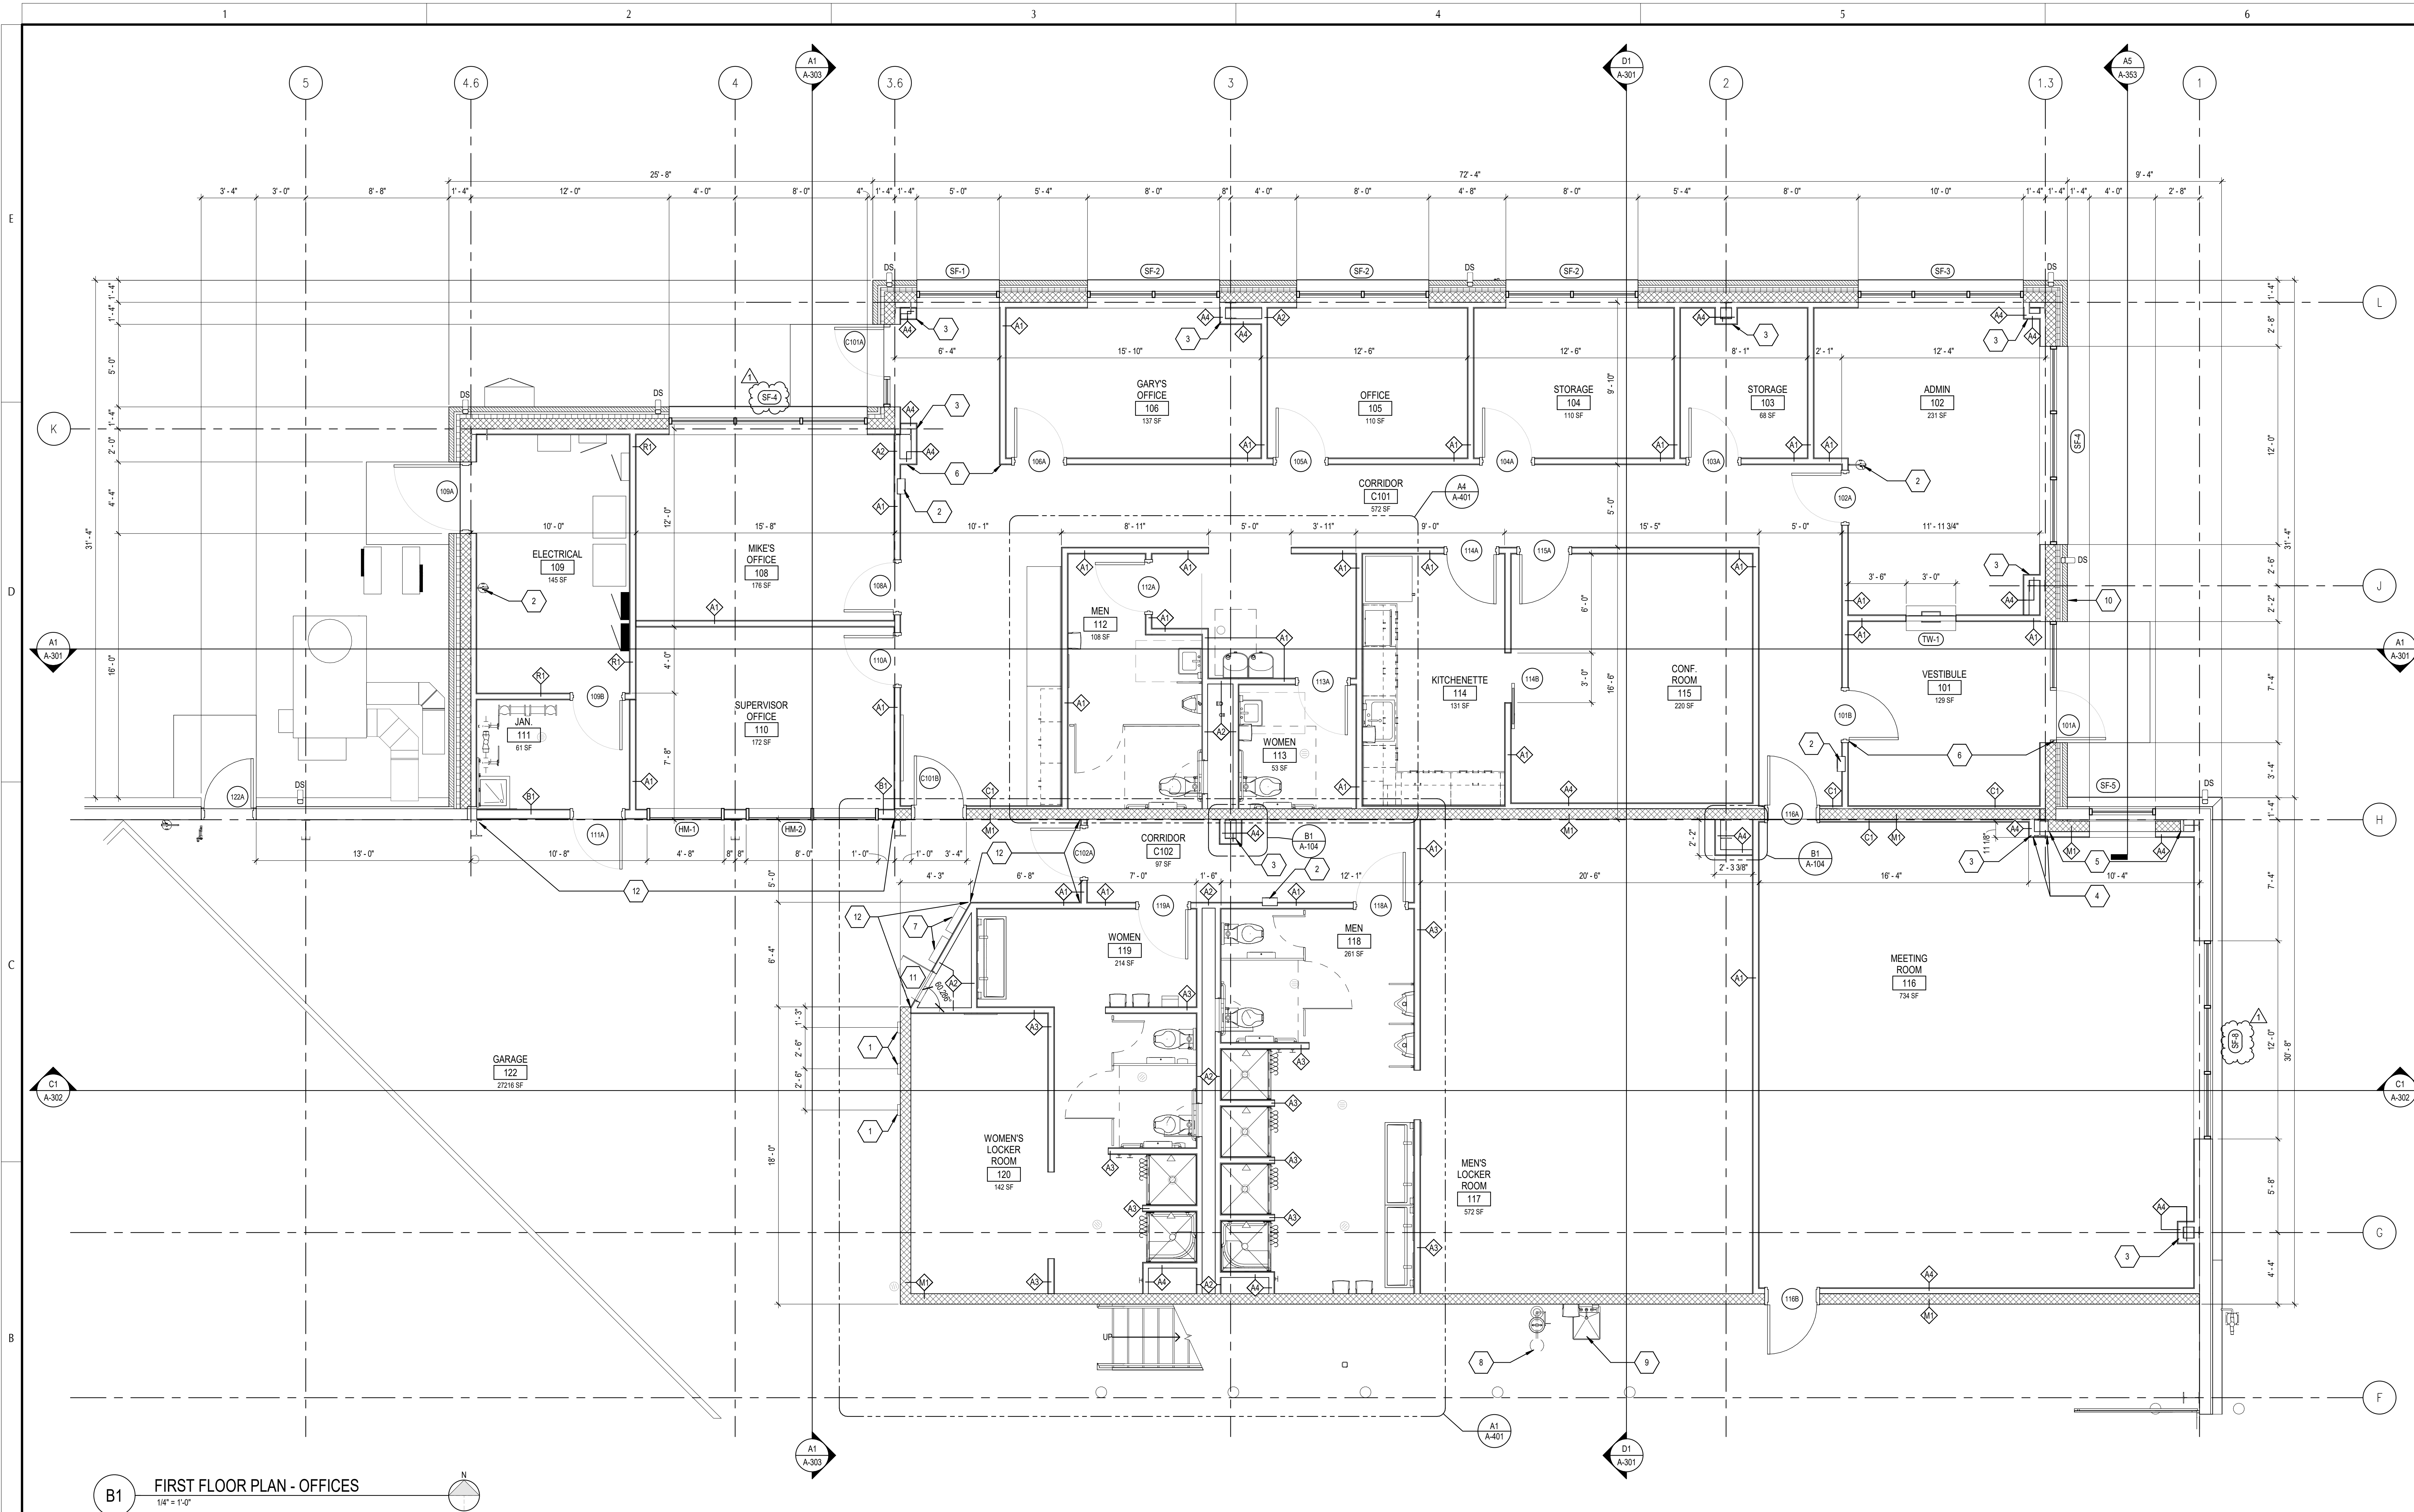

B1 FIRST FLOOR PLAN - OFFICES
1/4" = 1'-0"

GENERAL NOTES

1. DIMENSIONS ARE TAKEN AT 3'-0" A.F.F.
2. COLUMN CENTERLINES AT EXTERIOR WALLS ARE LOCATED AT THE INSIDE FACE OF GIRTS AND OUTSIDE FACE OF STRUCTURE.
3. EXTERIOR DIMENSIONS ARE TO FINISHED FACE OF MASONRY AND COLUMN CENTERLINES.
4. INTERIOR DIMENSIONS ARE TO FINISHED FACE OF WALLS AND COLUMN CENTERLINES.
5. DOORS FRAMES ARE LOCATED 4" FROM FACE OF PERPENDICULAR WALLS UNLESS OTHERWISE NOTED.
6. SEE A-501 FOR PARTITION TYPES.
7. SEE I-102 FOR FURNITURE.
8. SEE I-107 FOR EQUIPMENT.

SHEET KEYNOTES

1. TIMELOCK - SEE ELECTRICAL AND TECHNOLOGY DRAWINGS.
2. FIRE EXTINGUISHER AND JIR CABINET - SEE LIFE SAFETY PLAN AND EQUIPMENT PLAN.
3. HOLD STUDS TIGHT TO PEMB STRUCTURAL COLUMNS - ALIGN WITH OPENINGS WHERE DEPICTED.
4. EXTEND QWB PAST COLUMN SECURED TO METAL STUD FRAMING EACH SIDE OF COLUMN.
5. SEE WALL SECTION FOR DEPTH OF WALL DIMENSION. SEE WINDOW DETAILS FOR ADDITIONAL INFORMATION. HOLD CMU 2" FROM COLUMNS.
6. ALIGN.
7. CONTROL PANEL - SEE MECHANICAL DRAWINGS.
8. EMERGENCY EYEWASH & SHOWER - SEE PLUMBING DRAWINGS.
9. SINK/LAUNDRY TUB TYPE - SEE PLUMBING DRAWINGS.
10. SURFACE MOUNTED KNOX BOX, TYPE AND LOCATION PER CITY OF CANTON FIRE DEPARTMENT REQUIREMENTS.
11. 2X2 KEYPAD ACCESS DOOR.
12. PROVIDE GLASS-MAT GYPSUM BOARD WITH LEVEL 5 FINISH ON EXPOSED TO GARAGE SIDE OF ALL GYPSUM BOARD WALLS.

DESCRIPTION

ADDENDUM 01

DATE

REV

1

SANITATION BUILDING PROJECT GP1376
2801 REGENT AVE. N.E.
CANTON, OH 44705

ENLARGED OFFICE PLAN

DATE:	02/06/2023
PERMIT	02/06/2023
BID	02/06/2023
CONSTRUCTION	---
RECORDED	---
PROJECT MANAGER	DESIGNER
RG	SH

JOB NO.
2020377.05

A-102

GENERAL NOTES

1. ALL ROOF PANELS TO BE COLOR 1.
2. ALL GUTTERS, DOWNSPOUTS, AND ROOF TRIMS (INCLUDING RIDGE TRIM) TO BE COLOR 2.
3. TOP OF BRICK TRIM TO BE COLOR 1.
4. TOP OF CMU TRIM TO BE COLOR 1.
5. WINDOW SILL FLASHING IN BRICK TO BE COLOR 2.
6. UNLESS NOTED OTHERWISE ALL FLASHINGS AND TRIMS IN METAL PANELS SHALL MATCH THE COLOR OF THE METAL PANEL THEY ARE IN.
7. ALUMINUM WINDOWS AND DOORS TO BE KAWNEER COLOR ANODIZED DARK BRONZE.
8. PAINT ALL HOLLOW METAL DOORS AND FRAMES TO MATCH COLOR 2.
9. BEEL BRICK EXPANSION JOINT. LOCATE WHERE INDICATED AND AT INTERSECTIONS WITH DIFFERENT EXTERIOR WALL TYPES. 3/8" COLOR MATCHED JOINT SEALANT OVER COMPRESSIBLE FILL MATERIAL DEPTH OF BRICK. SEE STRUCTURAL FOR LOAD BEARING CMU CONTROL JOINT LOCATIONS. DL
10. C.J. CONTROL JOINT FOR CMU VENEER. LOCATE WHERE INDICATED OR AT MAXIMUM OF 20' O.C. LOCATE AT ALL INSIDE CORNERS. AT EXTERIOR CORNERS (L1 + L2) SHALL BE < 20'. 3/8" PAINTABLE JOINT SEALANT OVER COMPRESSIBLE FILL MATERIAL DEPTH OF CMU. SEE STRUCTURAL FOR LOAD BEARING CMU CONTROL JOINT LOCATIONS.

REFERENCED KEYNOTES

04 20 00 A01	CLAY MASONRY VENEER (TYPE 1)
04 20 00 C12	STANDARD CMU (JAMB/HS)
08 11 13 A	HOLLOW METAL DOOR AND FRAME
08 36 13 A	2" INSULATED SECTIONAL DOOR
08 41 13 A	ALUMINUM FRAMED STOREFRONT
13 34 19 E	METAL WALL PANEL SYSTEM

ELEVATION KEYNOTES

1. MAPES CANOPIES - SUPER LUMIDECK, WITH HANGER ROD SUPPORTS, WITH 2 COAT KYNAR FINISH COLOR 3 INTERSTATE BLUE. PEMB ENGINEER SHALL PROVIDE AND DESIGN SUPPORT STRUCTURE AS REQUIRED BY CANOPY MANUFACTURER.
2. BUILDING MOUNTED LIGHT. SEE ELECTRICAL DRAWINGS.
3. CITY OF CANTON COLOR LOGO MATCH CITY OF CANTON STANDARD COLORS WHITE, GRAY, AND BLUE. SEE SPEC 10 14 23 - WALL MOUNTED PANEL SIGNAGE. PEMB ENGINEER SHALL PROVIDE AND DESIGN SUPPORT STRUCTURE AS REQUIRED BY CANOPY MANUFACTURER.
4. 6" LETTERING, MATCH CITY OF CANTON GRAY. SEE SPEC 10 14 19 - DIMENSIONAL LETTER SIGNAGE. PEMB ENGINEER SHALL PROVIDE AND DESIGN SUPPORT STRUCTURE AS REQUIRED BY CANOPY MANUFACTURER.
5. 6" LETTERING, MATCH CITY OF CANTON GRAY. SEE SPEC 10 14 19 - DIMENSIONAL LETTER SIGNAGE. PEMB ENGINEER SHALL PROVIDE AND DESIGN SUPPORT STRUCTURE AS REQUIRED BY CANOPY MANUFACTURER.
6. EXHAUST FANS AND WEATHER HOODS - MATCH COLOR 1. SEE MECHANICAL DRAWINGS FOR SIZE AND SPEC. SEE A-605 FOR HEAD, JAMB, AND SILL DETAILS.
7. LOUVER - MATCH COLOR 1. SEE MECHANICAL DRAWINGS FOR SIZE AND SPEC. SEE A-605 FOR HEAD, JAMB, AND SILL DETAILS.
8. SEE A-605 FOR DUCT PENETRATION DETAILS.
9. ROOF PENETRATION - SEE A-101 MECHANICAL AND PLUMBING DRAWINGS.
10. GENERATOR OUTLINE SHOWN FOR REFERENCE - SEE ELECTRICAL DRAWINGS.
11. ELECTRICAL CABINET - SEE ELECTRICAL DRAWINGS.
12. EXHAUST FAN - SEE MECHANICAL DRAWINGS.
13. COORDINATE DOWNSPOUT REQUIREMENTS WITH MAPES CANOPIES.

LEGEND

	13 34 19 E - METAL PANEL COLOR 1
	13 34 19 E - METAL PANEL COLOR 2
	04 20 00 A01 - BRICK ST. SIMON
	04 20 00 C12 - STANDARD CMU PAINT TO MATCH COLOR 2

COLOR 1 - MSCI CUSTOM COLOR MATCH "LIGHT STONE"

COLOR 2 - MSCI STANDARD COLOR "MIDNIGHT BRONZE"

COLOR 3 - MAPES CANOPIES STANDARD COLOR "INTERSTATE BLUE"

DESCRIPTION

DATE
3/2/2023

REV
1




SANITATION BUILDING PROJECT GP1376
2801 REGENT AVE. N.E.
CANTON, OH 44705

EXTERIOR ELEVATIONS

DATE:	02/06/2023
PERMIT	02/06/2023
BID	---
CONSTRUCTION	---
RECORDED	---
PROJECT MANAGER	DESIGNER
RG	SH

JOB NO.
2020377.05

A-202

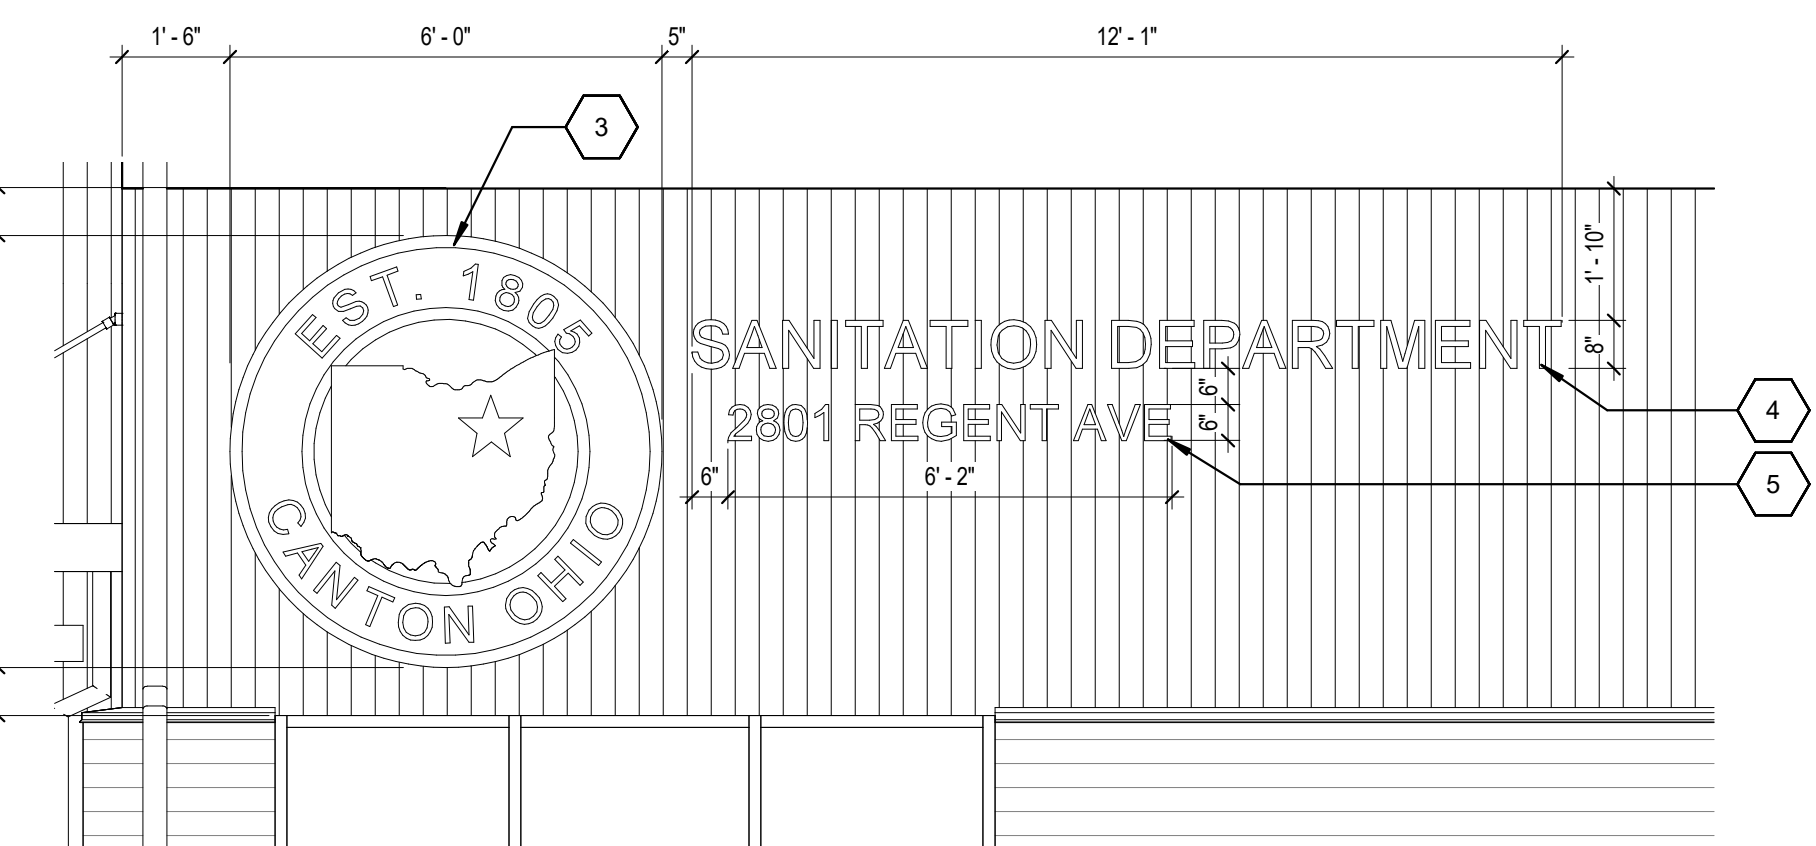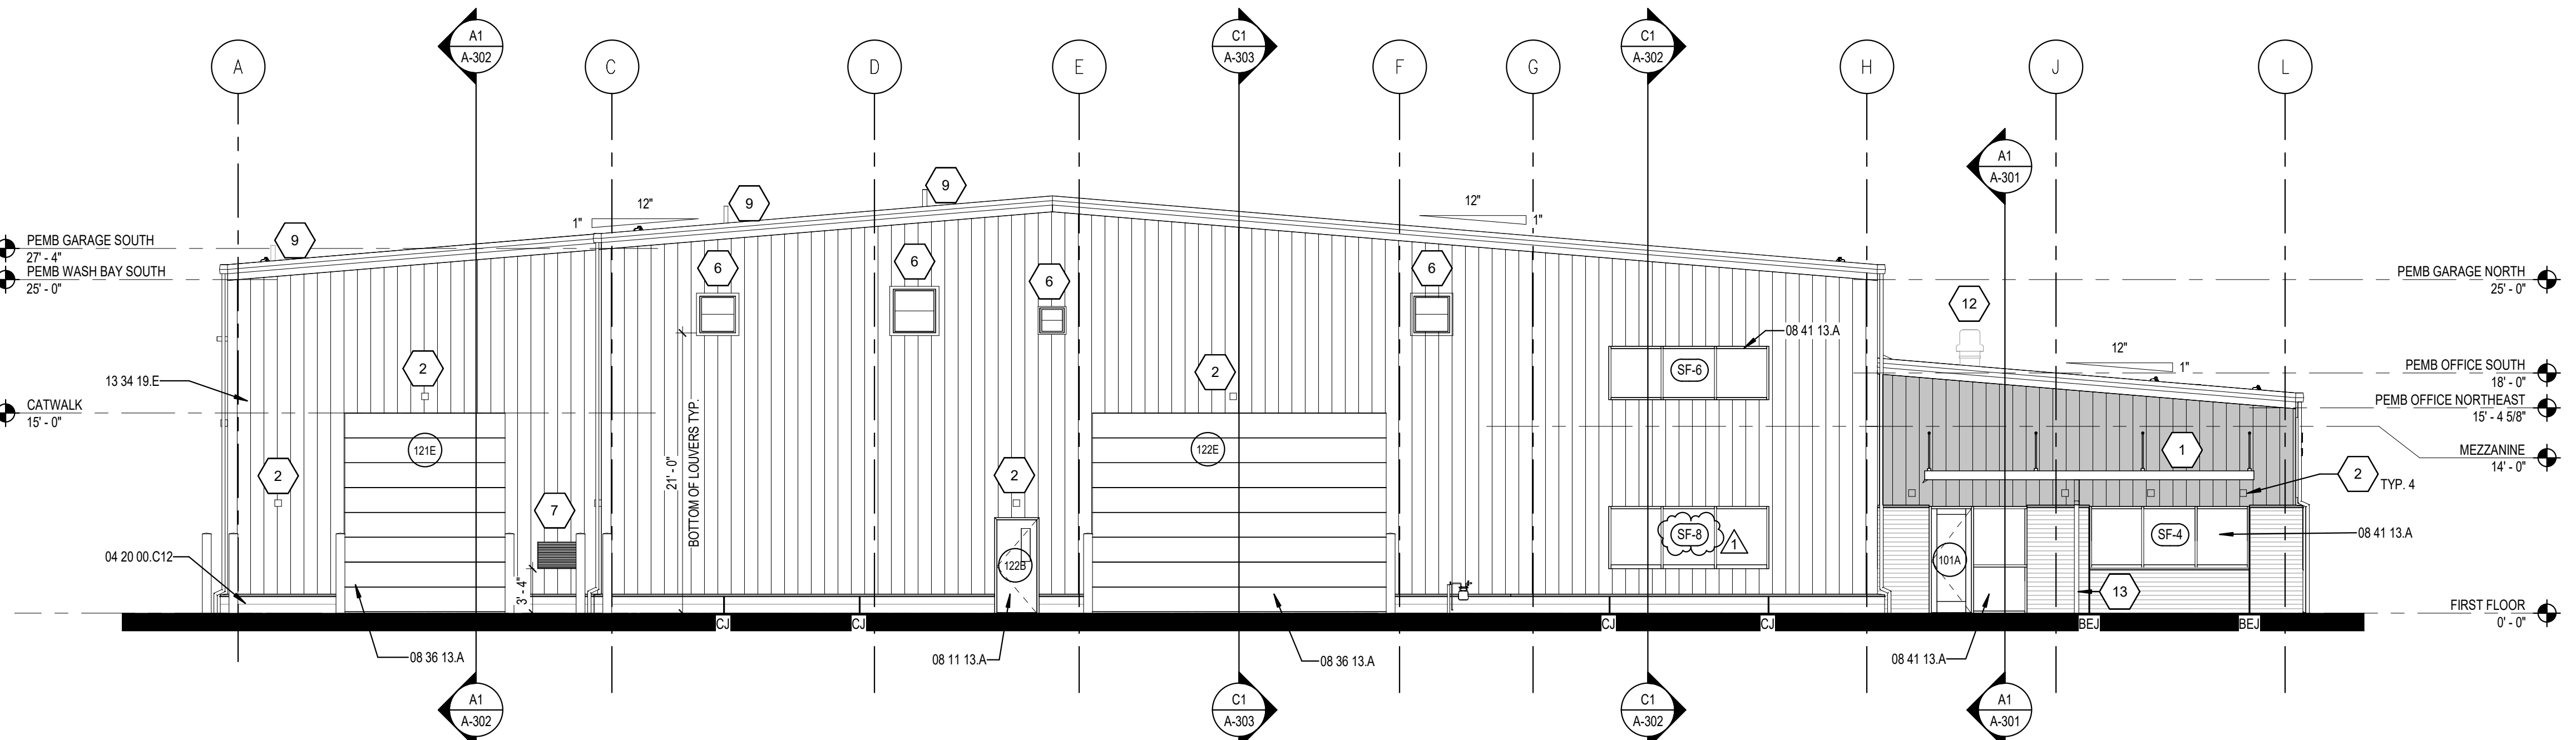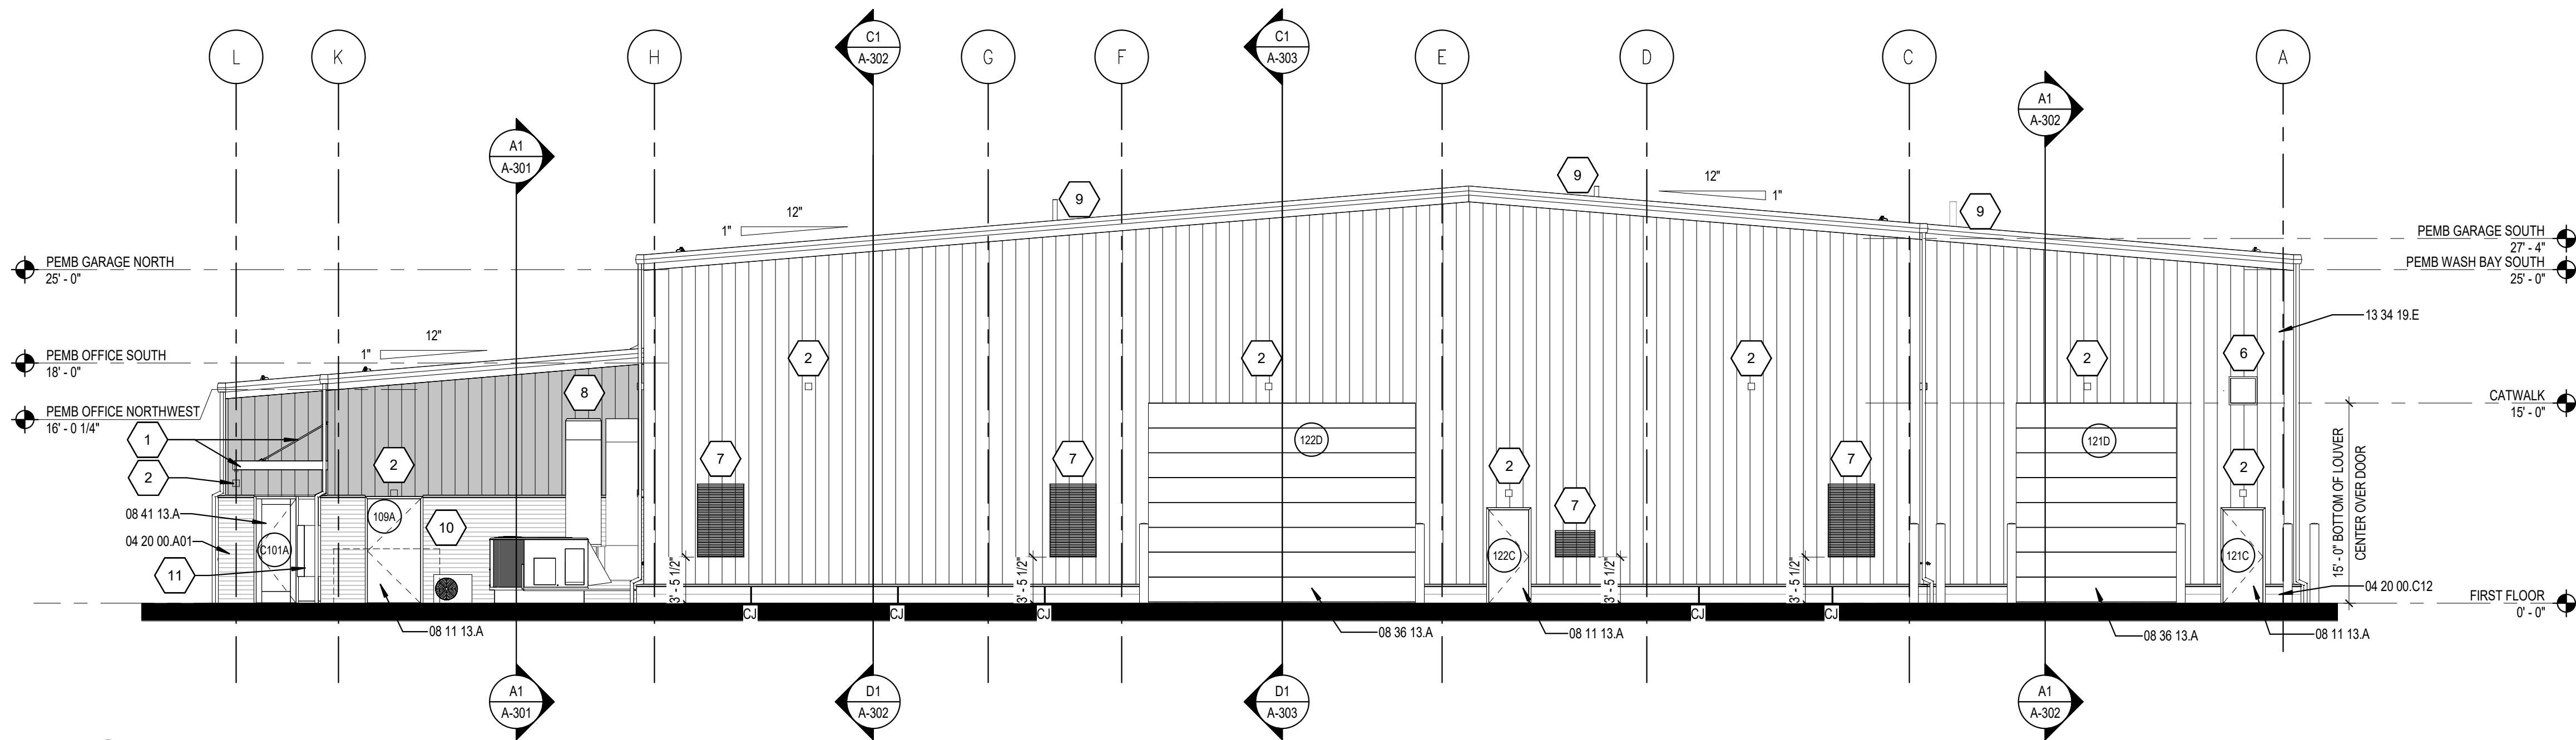

DATE:	
PERMIT	02/06/2023
BID	02/06/2023
CONSTRUCTION	--/------
RECORDED	--/------
PROJECT MANAGER	DESIGNER
RG	SH

JOB NO.
2020377.05


A-302

1. PEMB ELEVATION LEVELS INDICATE TOP OF STEEL FRAME / BOTTOM OF 10" ROOF PURLIN
2. SEE A-200 SERIES EXTERIOR ELEVATIONS FOR EXTERIOR COLOR SELECTIONS.

03 00 00	CONCRETE
03 30 00.A	CONCRETE SLAB ON GRADE
03 30 00.E	CONCRETE FOOTING - REFER TO STRUCTURAL DWGS.
04 20 00.C12	STANDARD CMU 4x8x16
05 12 00.B	STRUCTURAL STEEL BEAM - REFER TO STRUCTURAL DWGS
13 34 19.A	STRUCTURAL STEEL FRAMING SYSTEM
13 34 19.E	METAL WALL PANEL SYSTEM
13 34 19.F	METAL ROOF PANEL SYSTEM

- 1 SLOPE SLAB ON GRADE TO DRAINS - SEE A-101 FOR SLOPE REQUIREMENTS.
- 2 DETROIT BOLLARD - TYPICAL. SEE A-118 FOR DIMENSIONS. SEE CIVIL DRAWINGS FOR DETAILS. SEE STRUCTURAL DRAWINGS FOR FOUNDATION COORDINATION REQUIREMENTS.
- 3 SUSPENDED LIGHT FIXTURE TYPICAL - SEE ELECTRICAL DRAWINGS
- 4 PROVIDE GLASS-MAT GYPSUM BOARD WITH LEVEL 5 FINISH ON EXPOSED TO GARAGE SIDE OF ALL GYPSUM BOARD WALLS.
- 5 WATER HEATER - SEE PLUMBING DRAWINGS
- 6 CONCENTRIC FLYE TYPICAL - SEE PLUMBING DRAWINGS
- 7 SUSPENDED LIGHT FIXTURE TYPICAL - SEE ELECTRICAL DRAWINGS
- 8 DELEGATED DESIGNER FREE STANDING CATAWALK PLATFORM, FRAMING, AND ALTERNATING TREAD DEVICES SEE A-104 FOR ADDITIONAL INFORMATION.



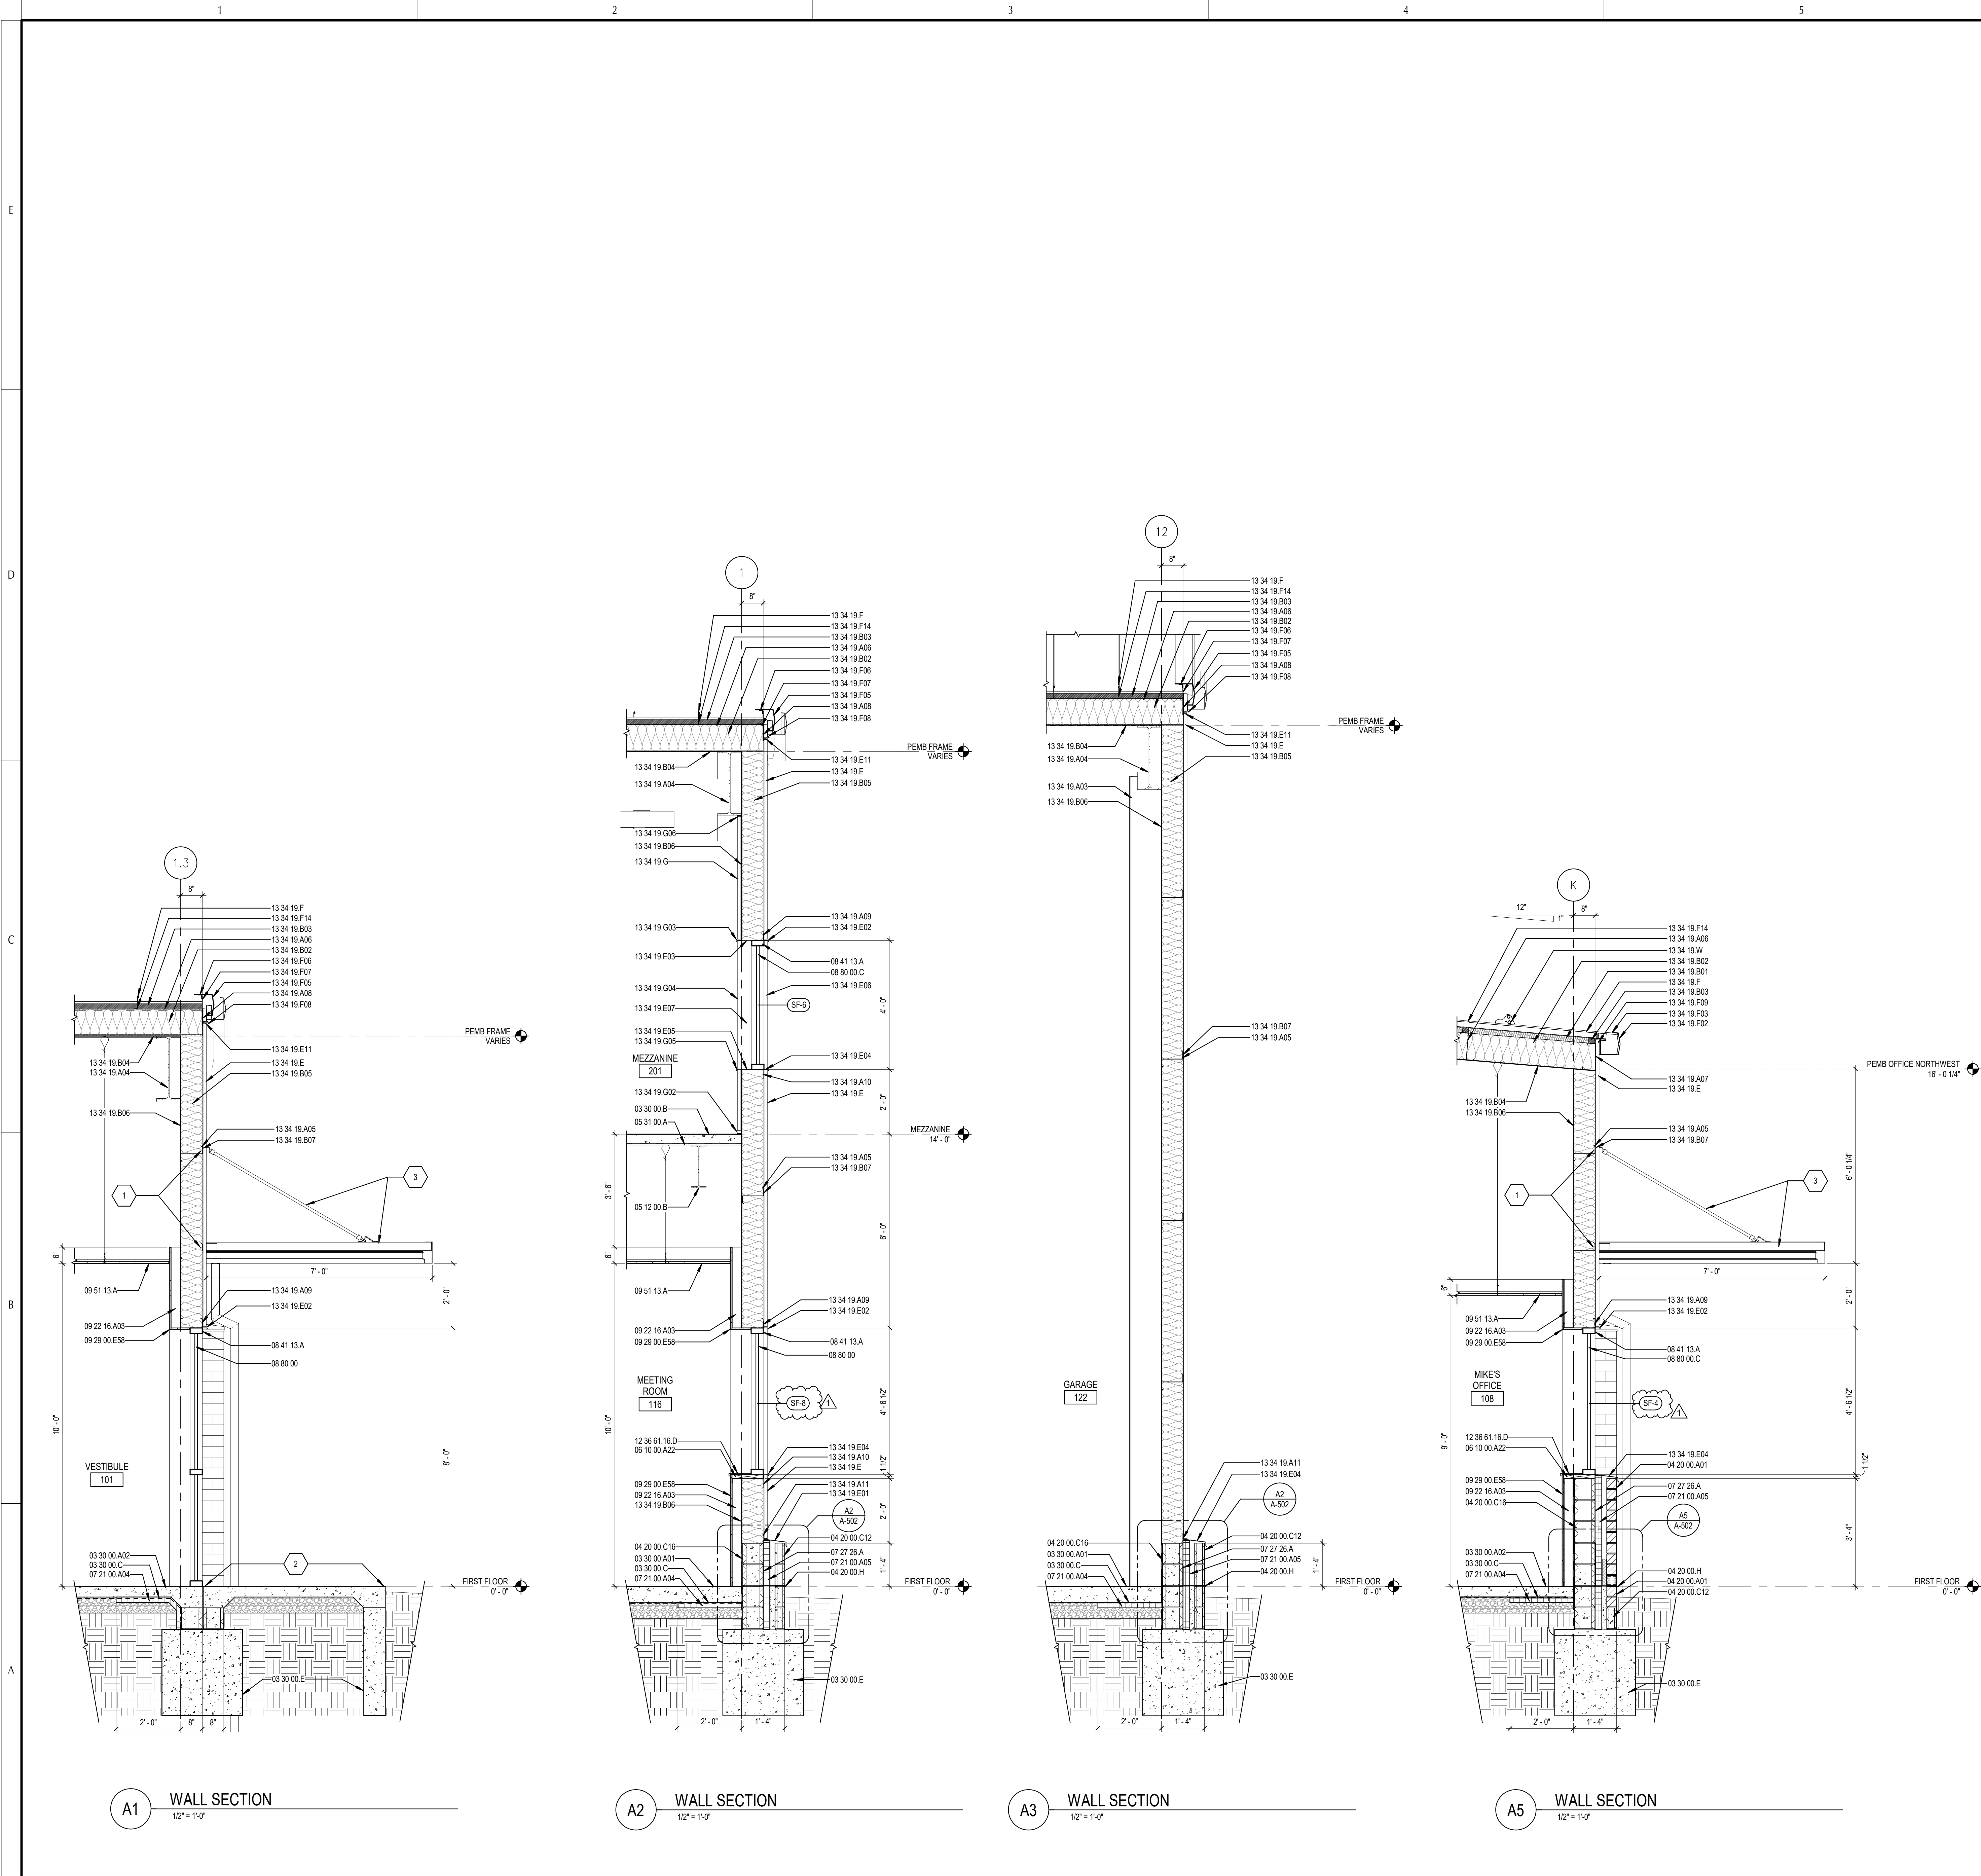

GENERAL NOTES

1. SEE A-600 SERIES SHEETS FOR ALL DOOR AND WINDOW DETAILS.
2. SEE A-200 SERIES EXTERIOR ELEVATIONS FOR EXTERIOR COLOR SELECTIONS.
3. FOOTER SIZE AND DEPTH VARIES - SEE STRUCTURAL DRAWINGS.
4. EXTERIOR GRADE VARIES - SEE CIVIL DRAWINGS.

REFERENCED KEYNOTES

03 30 00.A01	CONCRETE SLAB ON GRADE [R]
03 30 00.A02	CONCRETE SLAB ON GRADE [R]
03 30 00.B	COMPOSITE SLAB
03 30 00.C	VAPOR BARRIER
03 30 00.E	CONCRETE FOOTING - REFER TO STRUCTURAL DWGS.
04 20 00.A01	CLAY MASONRY VENEER [TYPE 1]
04 20 00.C12	STANDARD CMU [48x16]
04 20 00.C16	STANDARD CMU [84x16]
04 20 00.H	EMBEDDED FLASHING
05 12 00.B	STRUCTURAL STEEL BEAM - REFER TO STRUCTURAL DWGS.
05 31 00.A	METAL DECK - REFER TO STRUCTURAL DWGS.
06 10 00.A22	WOOD BLOCKING [2x12]
07 21 00.A04	BOARD INSULATION [2" R-10 MIN.]
07 21 00.A05	BOARD INSULATION [2 1/2" R-12.5 MIN.]
07 27 26.A	FLUID-APPLIED MEMBRANE AIR BARRIER
08 41 13.A	ALUMINUM FRAMED STOREFRONT
08 80 00	GLAZING
08 80 00.C	INSULATING GLASS
09 22 16.A03	STUDS AND TRACK [3 5/8" @ 16" O.C. MAX.]
09 29 00.E58	GYPSUM WALL BOARD [5/8"]
09 51 13.A	ACOUSTICAL PANEL CEILINGS
12 36 61 16.D	SOLID SURFACE MATERIAL SILL
13 34 19.A03	ENDWALL COLUMN
13 34 19.A04	ENDWALL RAFTER
13 34 19.A05	WALL GIRT
13 34 19.A06	ROOF PURLIN
13 34 19.A07	EAVE STRUT
13 34 19.A08	RAKE ANGLE
13 34 19.A09	HEADER CHANNEL
13 34 19.A10	SILL CHANNEL
13 34 19.A11	BASE CHANNEL
13 34 19.B01	CONTINUOUS ROOF INSULATION [R-8 MIN.]
13 34 19.B02	ROOF INSULATION FULL CAVITY BETWEEN PURLINS [R-30 MIN.]
13 34 19.B03	ROOF THERMAL SPACER BLOCK [R-3 MIN.]
13 34 19.B04	ROOF INSULATION FABRIC VAPOR BARRIER AND BANDING
13 34 19.B05	WALL INSULATION FULL CAVITY BETWEEN GIRTS [R-25 MIN.]
13 34 19.B06	WALL INSULATION FABRIC VAPOR BARRIER AND BANDING
13 34 19.B07	WALL INSULATION THERMAL TAPE
13 34 19.E	METAL WALL PANEL SYSTEM
13 34 19.E01	METAL WALL PANEL BASE FLASHING
13 34 19.E02	METAL WALL PANEL HEAD FLASHING
13 34 19.E03	METAL WALL PANEL HEAD CAP TRIM
13 34 19.E04	METAL WALL PANEL SILL FLASHING
13 34 19.E05	METAL WALL PANEL SILL CAP TRIM
13 34 19.E06	METAL WALL PANEL JAMB TRIM
13 34 19.E07	METAL WALL PANEL JAMB CAP TRIM
13 34 19.E11	METAL WALL PANEL OUTSIDE CLOSURE
13 34 19.F	METAL ROOF PANEL SYSTEM
13 34 19.F02	METAL ROOF SCULPTURED GUTTER
13 34 19.F03	METAL ROOF GUTTER STRAP
13 34 19.F06	METAL ROOF SCULPTURED RAKE TRIM
13 34 19.F06	METAL ROOF RAKE CLEAT
13 34 19.F07	METAL ROOF RAKE SUPPORT ANGLE
13 34 19.F08	METAL ROOF RAKE SLIDE
13 34 19.F09	METAL ROOF CAP TRIM
13 34 19.F14	METAL ROOF FLOATING CLIP
13 34 19.G	METAL WALL PANEL LINER SYSTEM
13 34 19.G02	METAL WALL PANEL LINER SQUARE BASE FLASHING
13 34 19.G03	METAL WALL PANEL LINER HEAD TRIM FLASHING
13 34 19.G04	METAL WALL PANEL LINER JAMB TRIM
13 34 19.G05	METAL WALL PANEL LINER SILL TRIM FLASHING
13 34 19.G06	METAL WALL PANEL LINER TRIM
13 34 19.W	SNOW GUARD

SHEET KEYNOTES

1. PEMB ENGINEER SHALL PROVIDE AND DESIGN SUPPORT STRUCTURE AS REQUIRED BY CANOPY MANUFACTURER.
2. FROST SLAB. SEE CIVIL FOR DIMENSION AND SLOPE. SEE STRUCTURAL FOR DETAIL.
3. MAPES CANOPIES - SUPER LUMIDEC WITH HANGAR ROD SUPPORTS.

SANITATION BUILDING PROJECT GP1376
2801 REGENT AVE. N.E.
CANTON, OH 44705

WALL SECTIONS

PERMIT	02/06/2023
BID	02/06/2023
CONSTRUCTION	---
RECORDED	---
PROJECT MANAGER	DESIGNER
Designer	Author

JOB NO.
2020377.05

A-352

DESCRIPTION
A-352

DATE
3/2/2023

REV
1


SANITATION BUILDING PROJECT GP1376
2801 REGENT AVE. N.E.
CANTON, OH 44705

WALL SECTIONS


PERMIT	02/06/2023
BID	02/06/2023
CONSTRUCTION	---
RECORDED	---
PROJECT MANAGER	DESIGNER
Designer	Author

JOB NO.
2020377.05


A-352

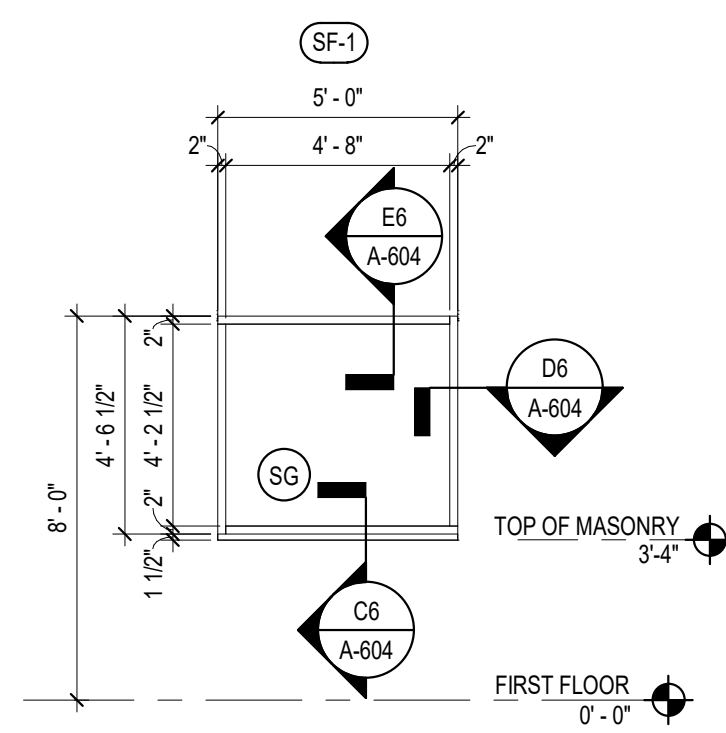


E1 SF-1
1/4" = 1'-0"

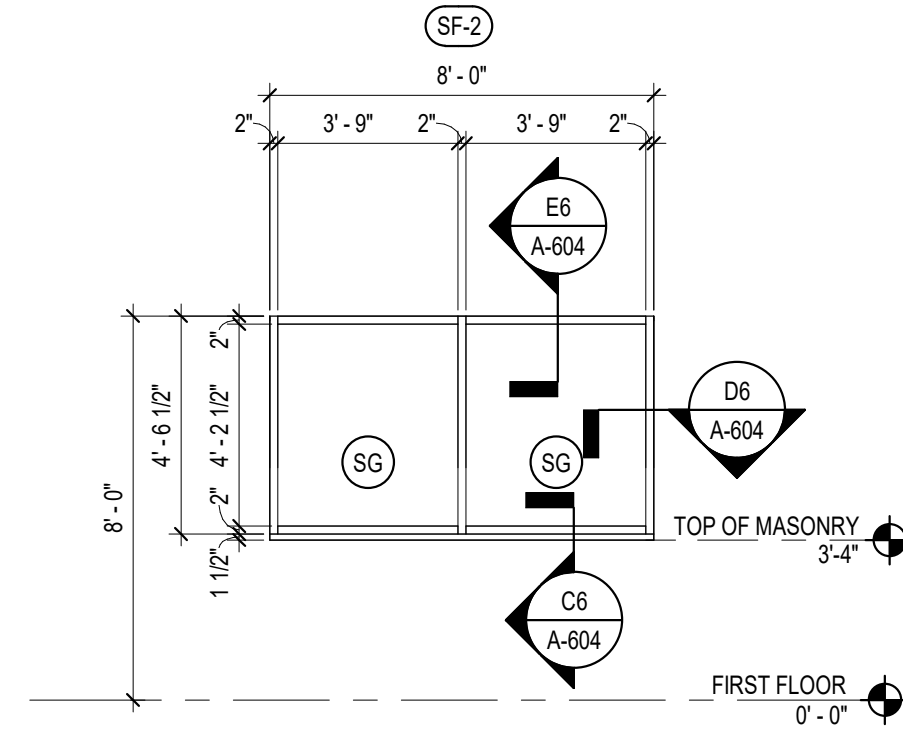


E2 SF-2
1/4" = 1'-0"

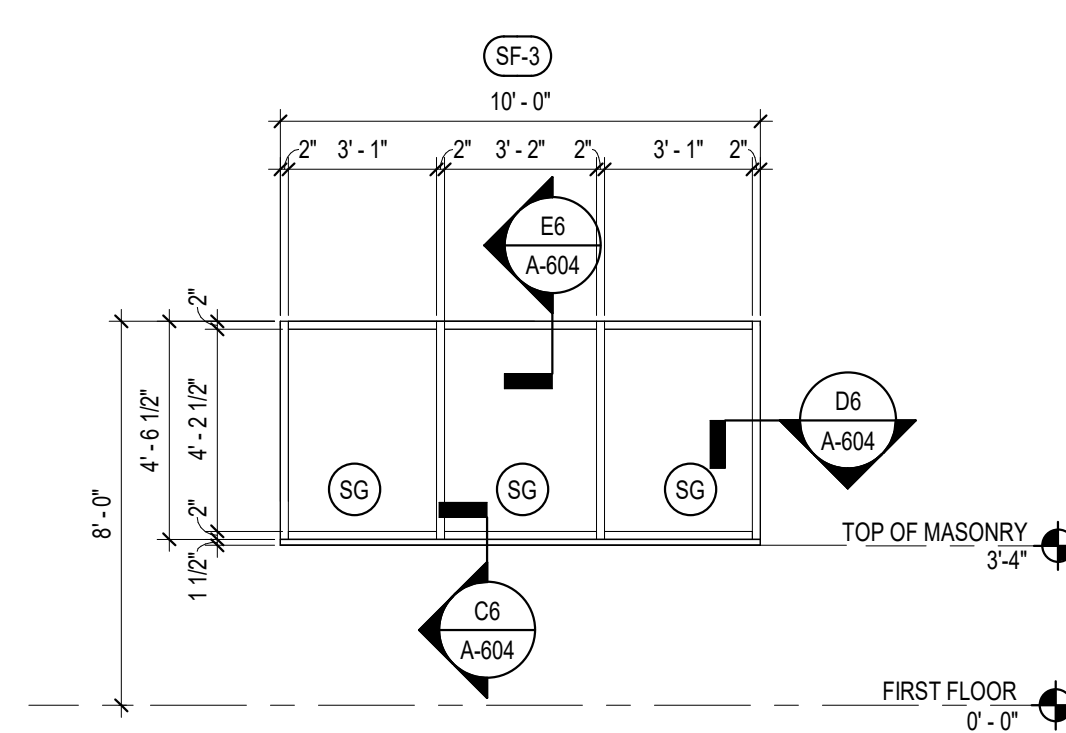


E3 SF-3
1/4" = 1'-0"

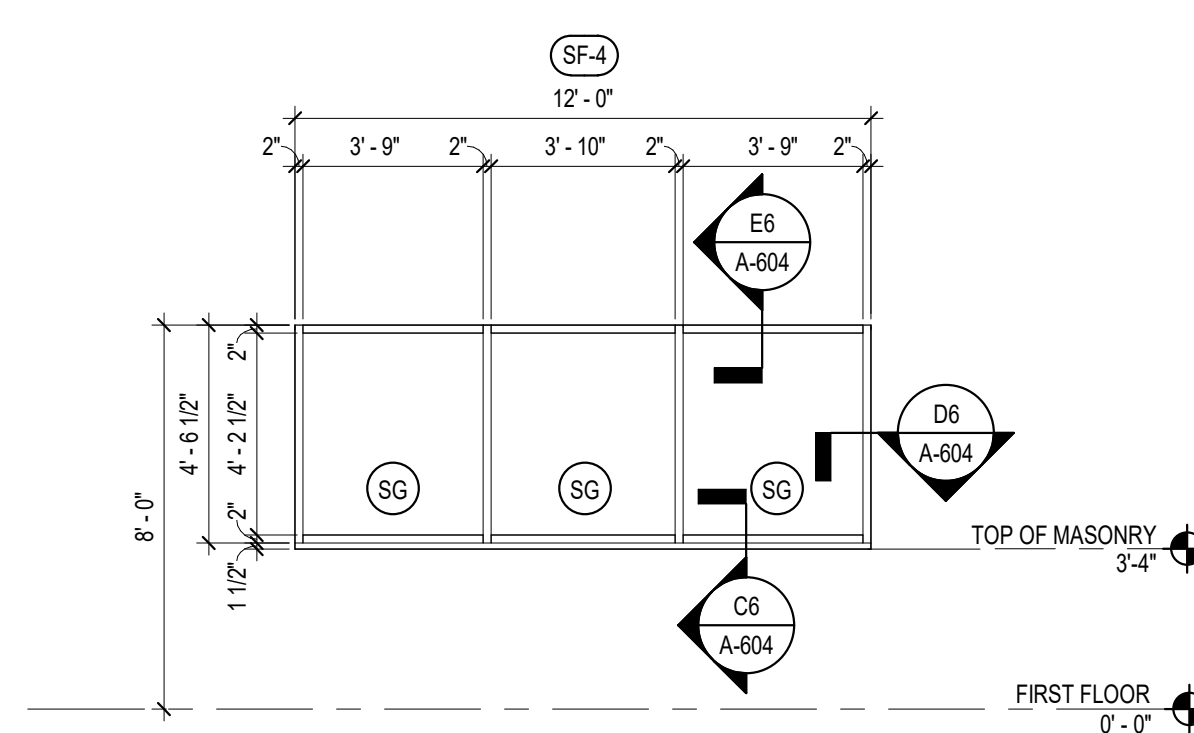


E4 SF-4
1/4" = 1'-0"

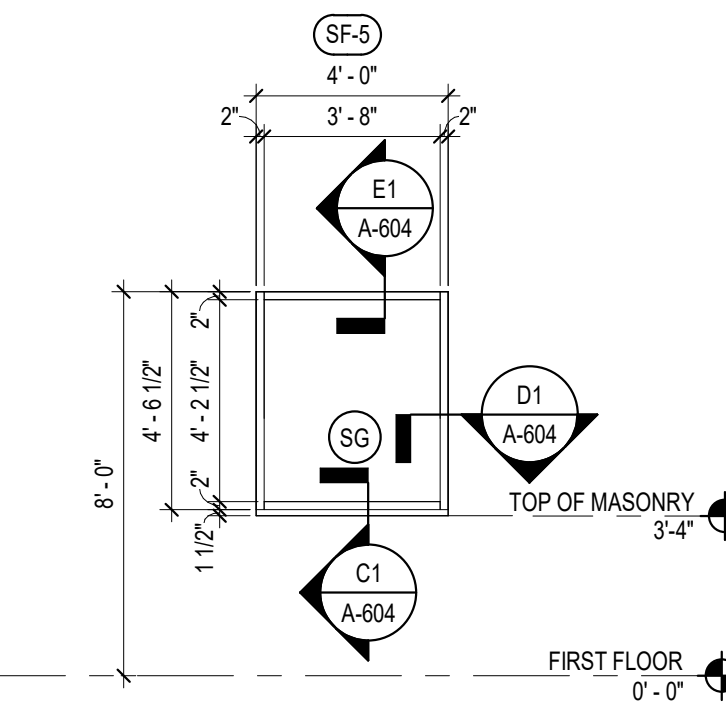


C1 SF-5
1/4" = 1'-0"

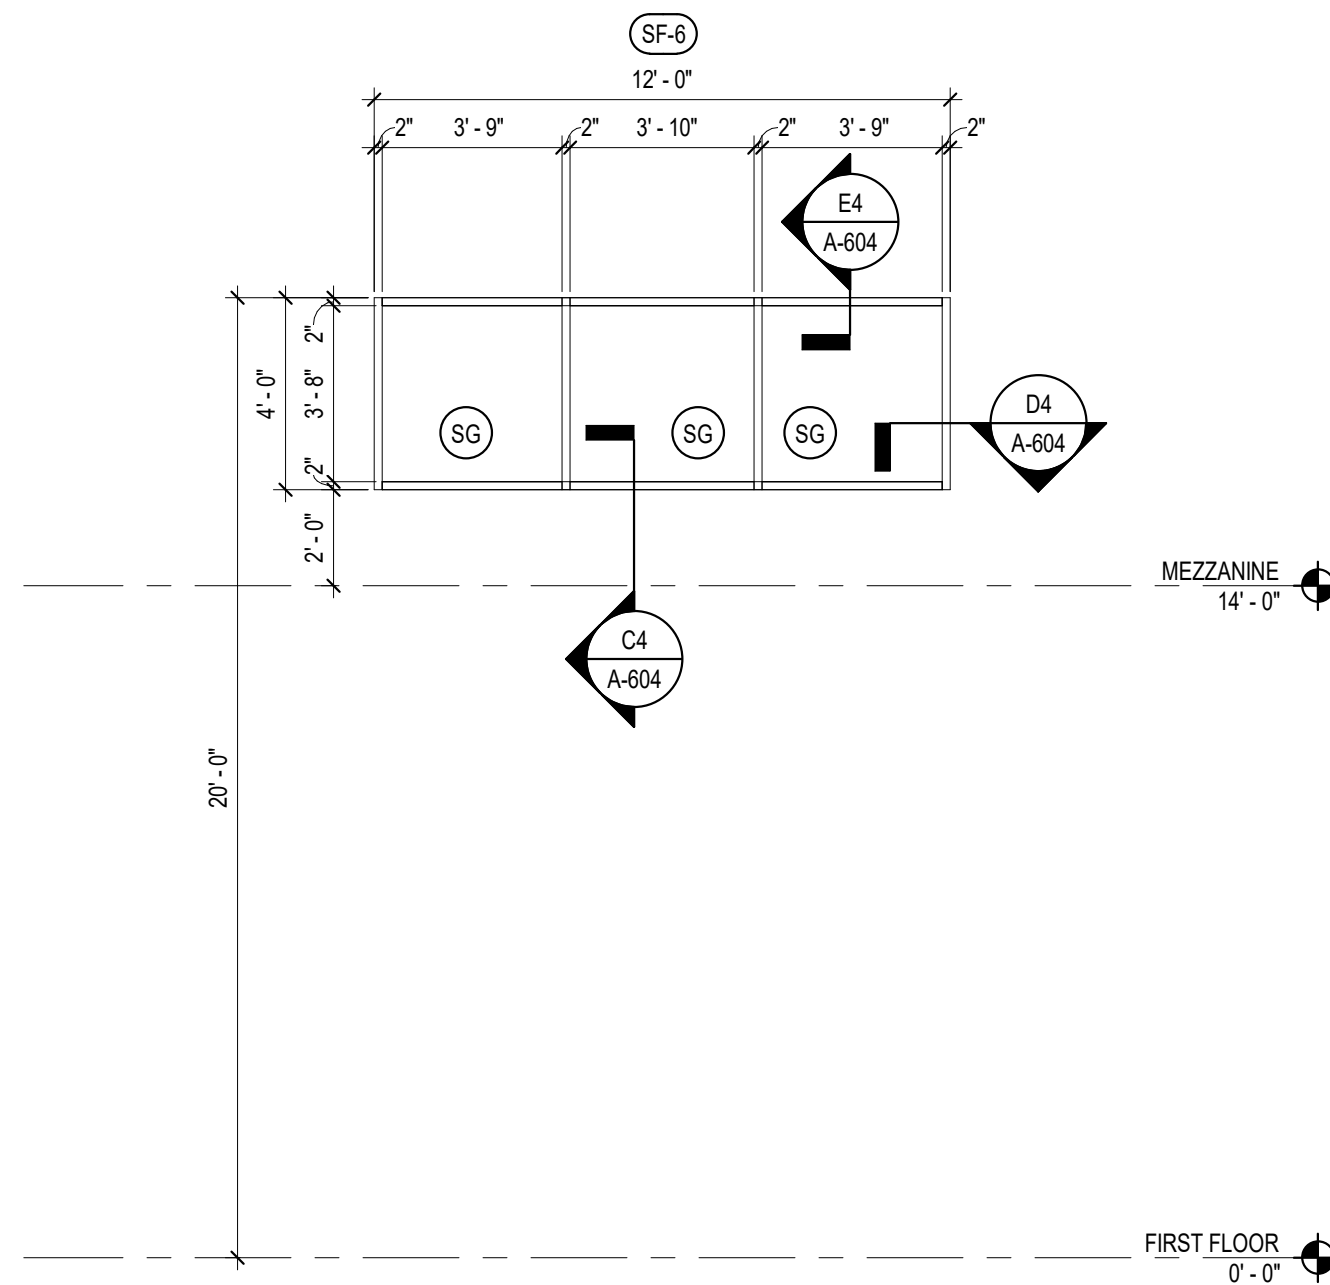


C2 SF-6
1/4" = 1'-0"

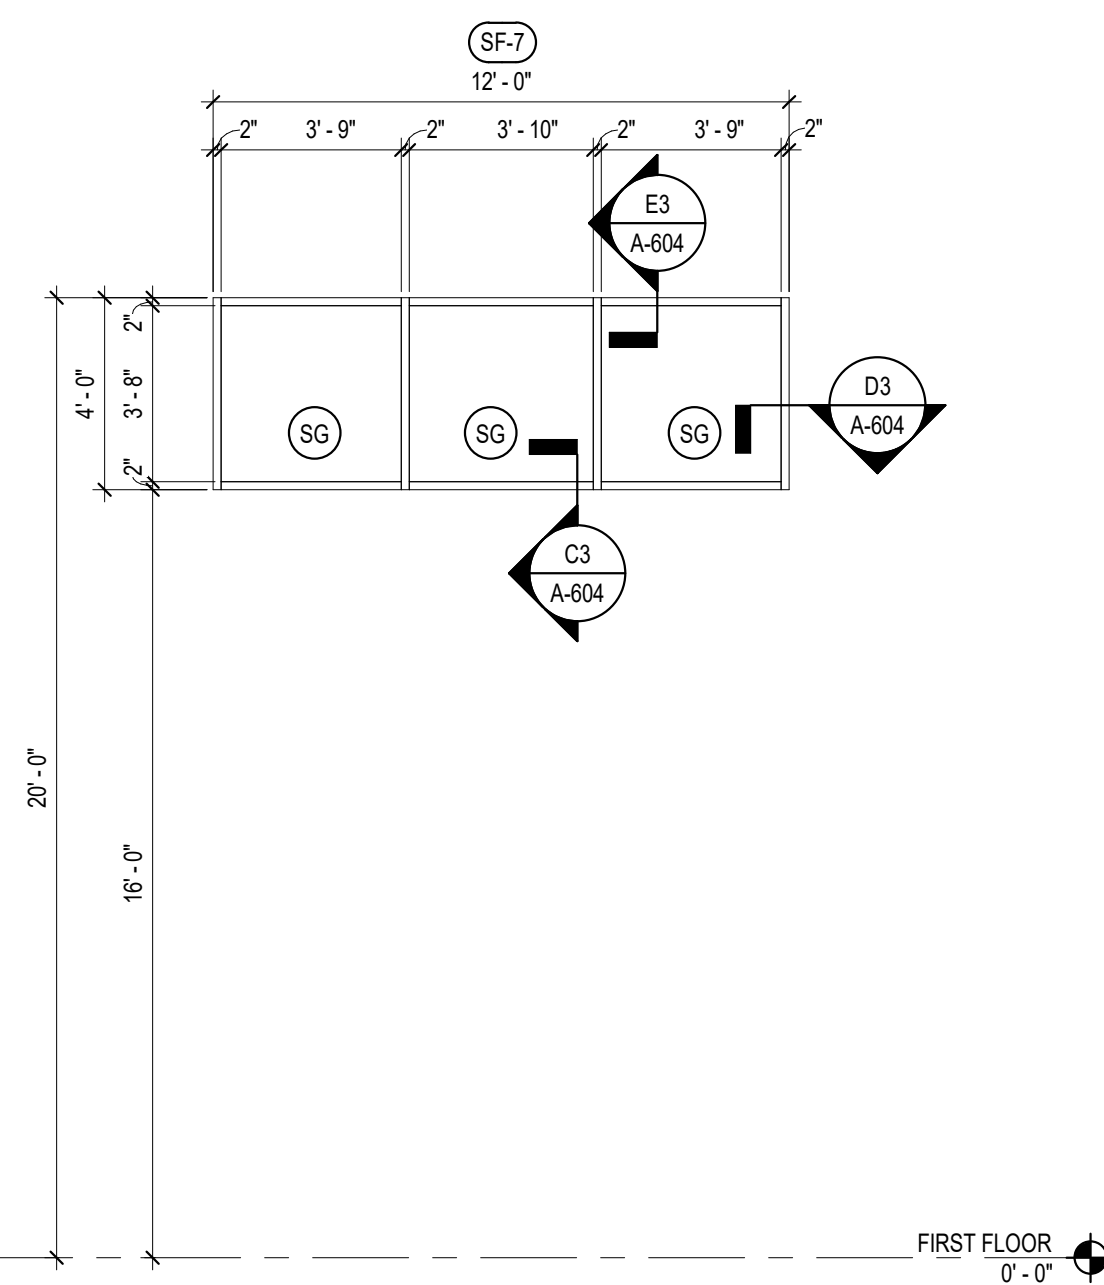


C3 SF-7
1/4" = 1'-0"

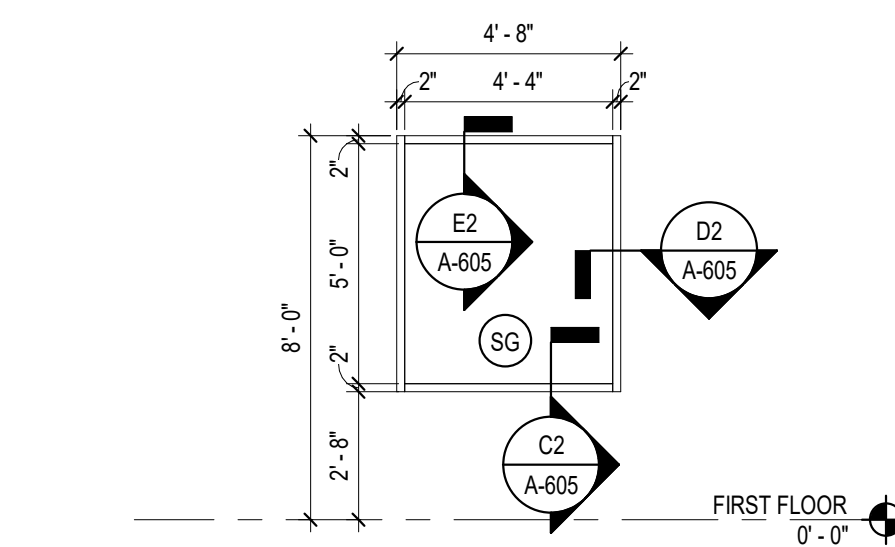


C4 HM-1
1/4" = 1'-0"

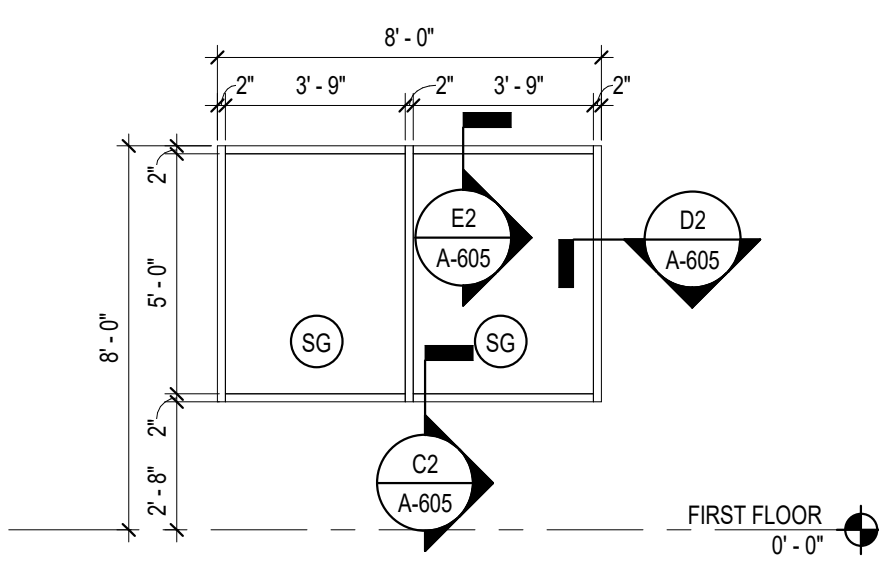

B1 HM-2
1/4" = 1'-0"

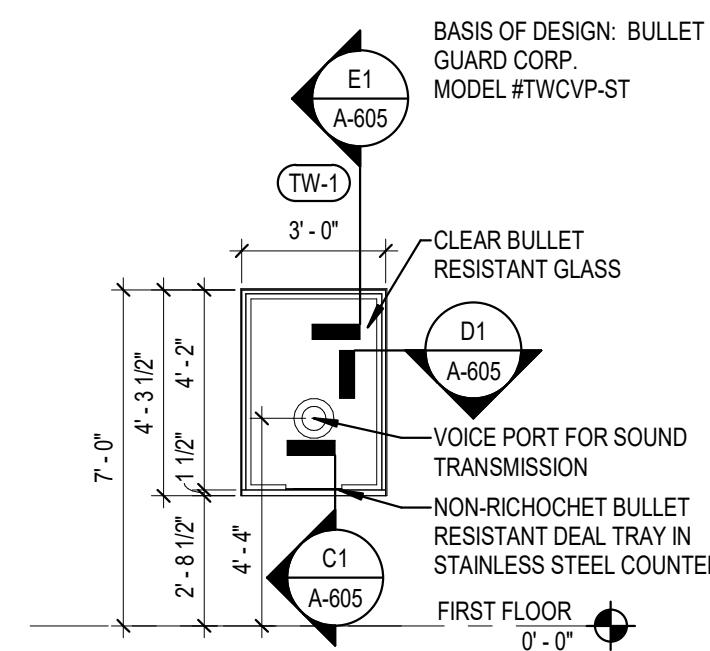

B2 TW-1
1/4" = 1'-0"

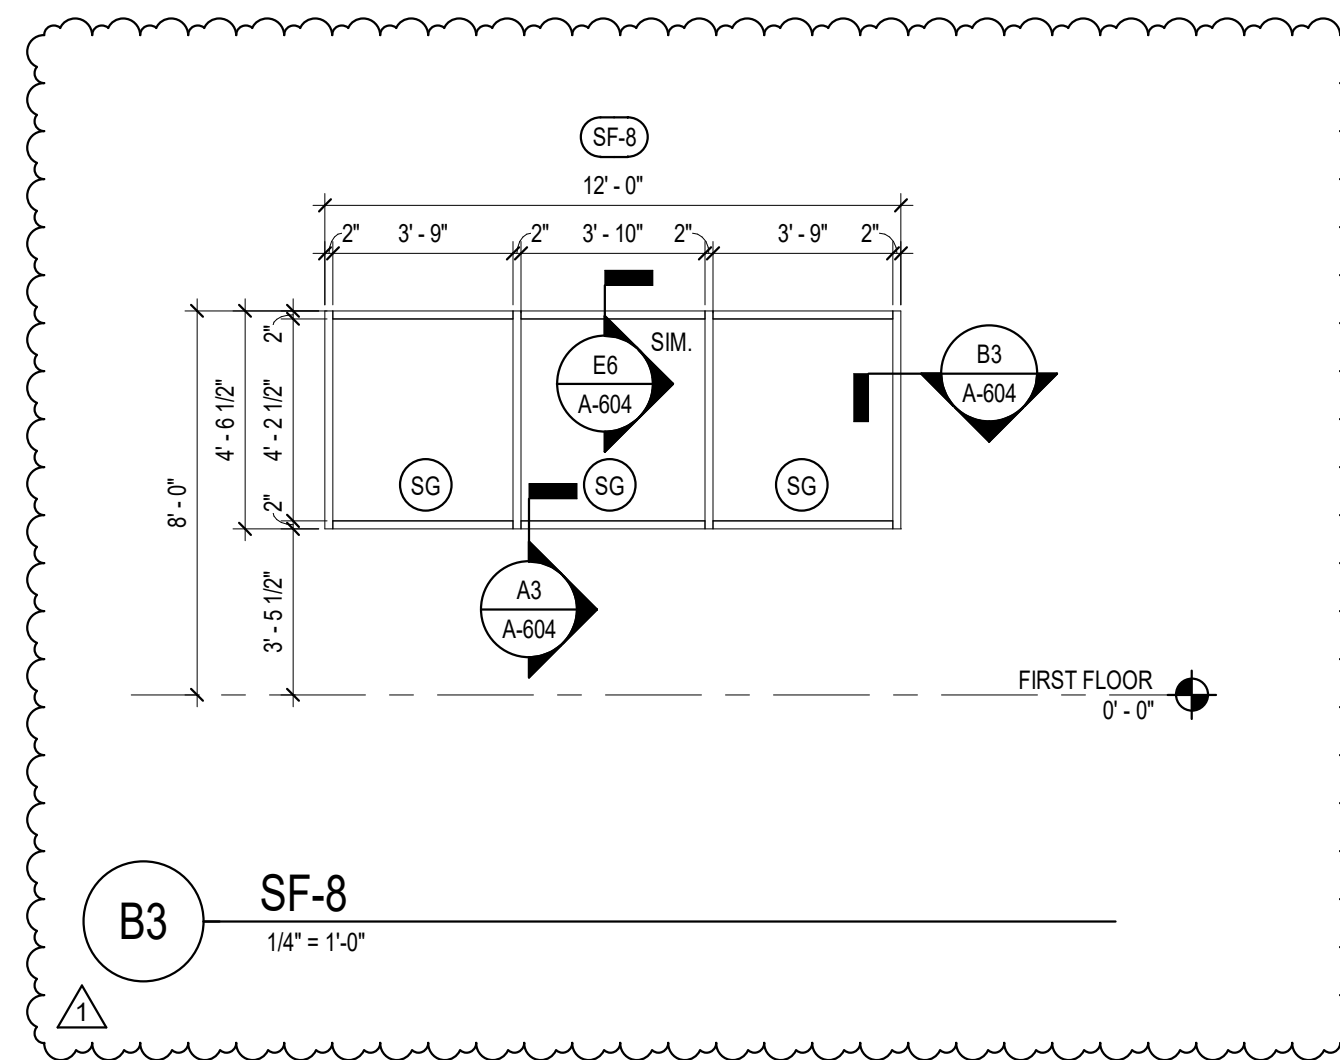

B3 SF-8
1/4" = 1'-0"

LEGEND
SG SAFETY GLAZING - UNLESS OTHERWISE NOTED ALL GLAZING SHALL BE SAFETY GLAZING.
ALL INTERIOR GLAZING SHALL BE 1/4" ALL EXTERIOR GLAZING SHALL BE 1" INSULATED.
REFER TO SPECIFICATIONS 08 80 00 FOR ADDITIONAL INFORMATION.

DESCRIPTION

ADDENDUM 01

DATE

REV

1


SANITATION BUILDING PROJECT GP1376
2801 REGENT AVE. N.E.
CANTON, OH 44705

WINDOW ELEVATIONS


PERMIT	DATE:
BID	02/06/2023
CONSTRUCTION	---
RECORDED	---
PROJECT MANAGER	DESIGNER
Designer	Author

JOB NO.
2020377.05


A-603

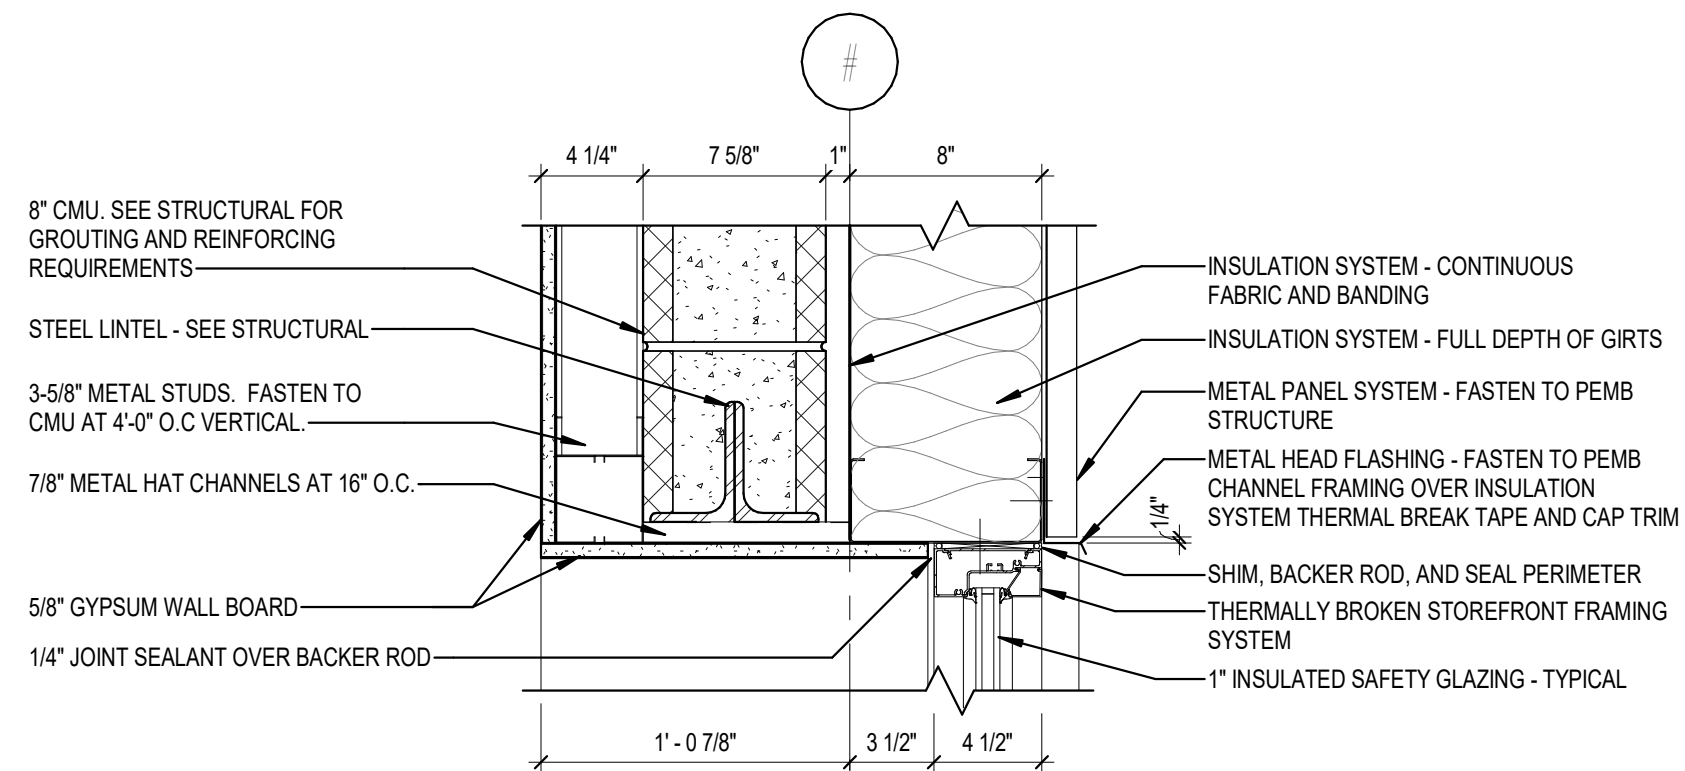


E1 WINDOW HEAD DETAIL
1 1/2" = 1'-0"

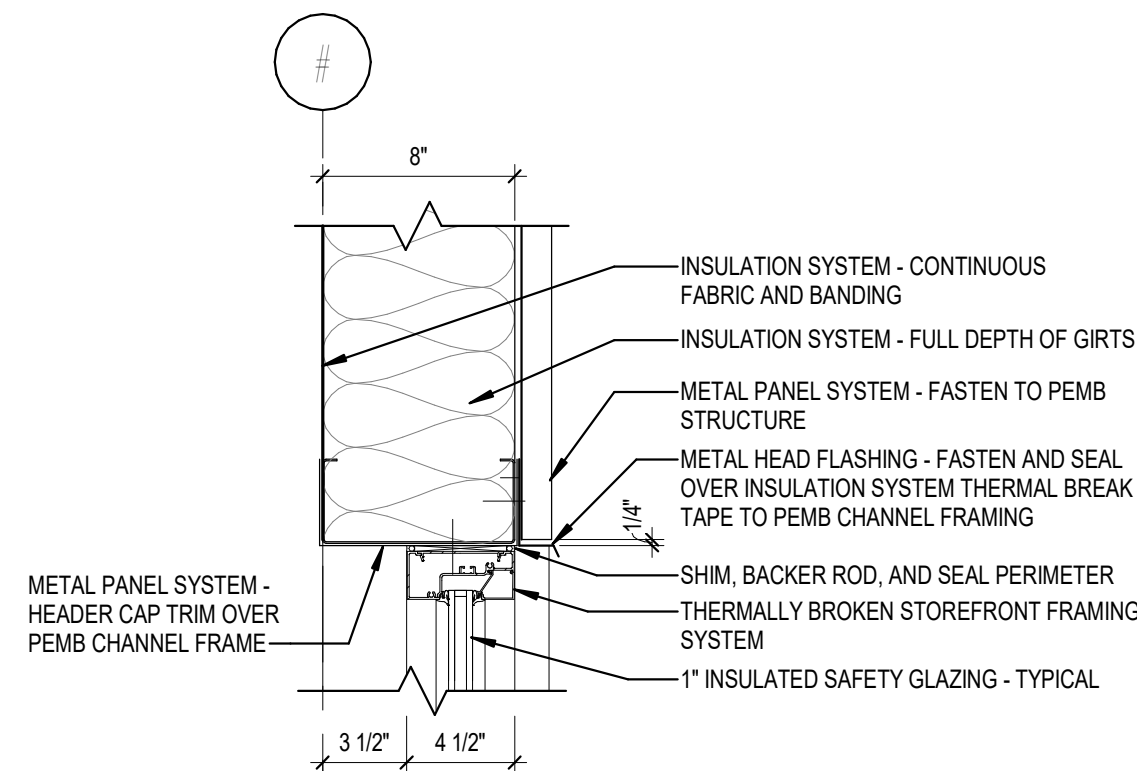


E3 WINDOW HEAD DETAIL
1 1/2" = 1'-0"

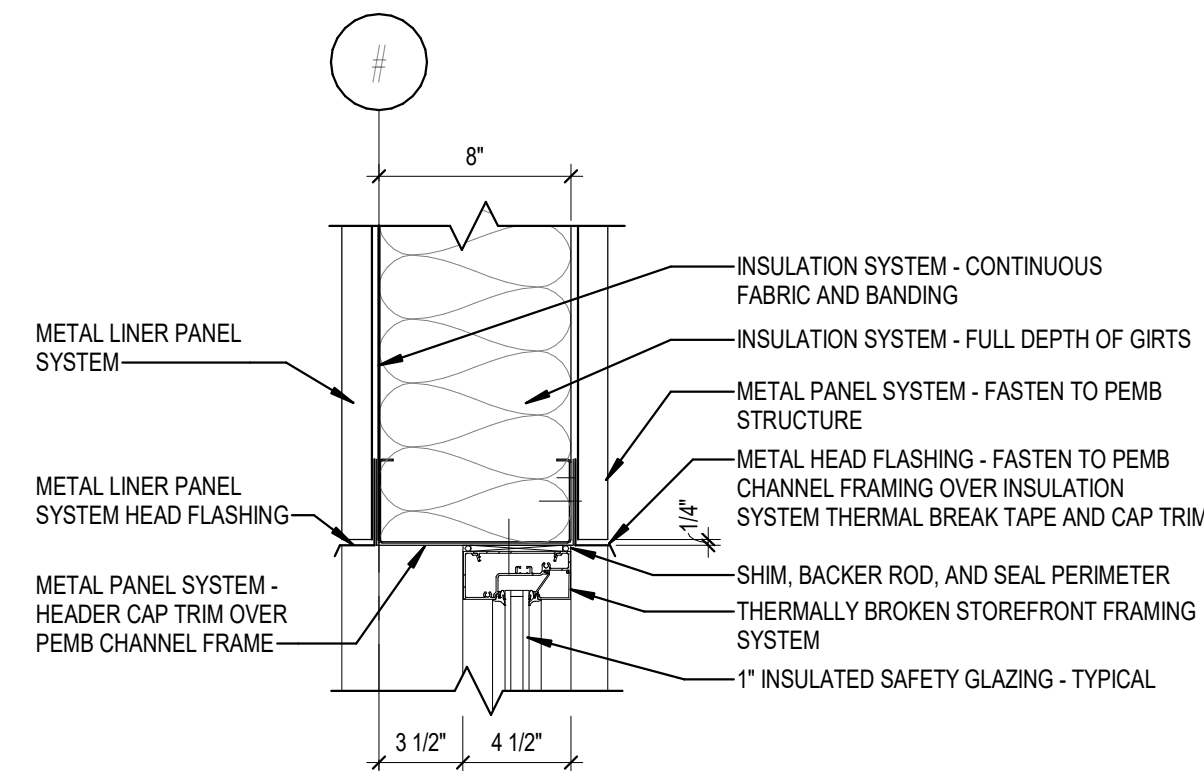


E4 WINDOW HEAD DETAIL
1 1/2" = 1'-0"

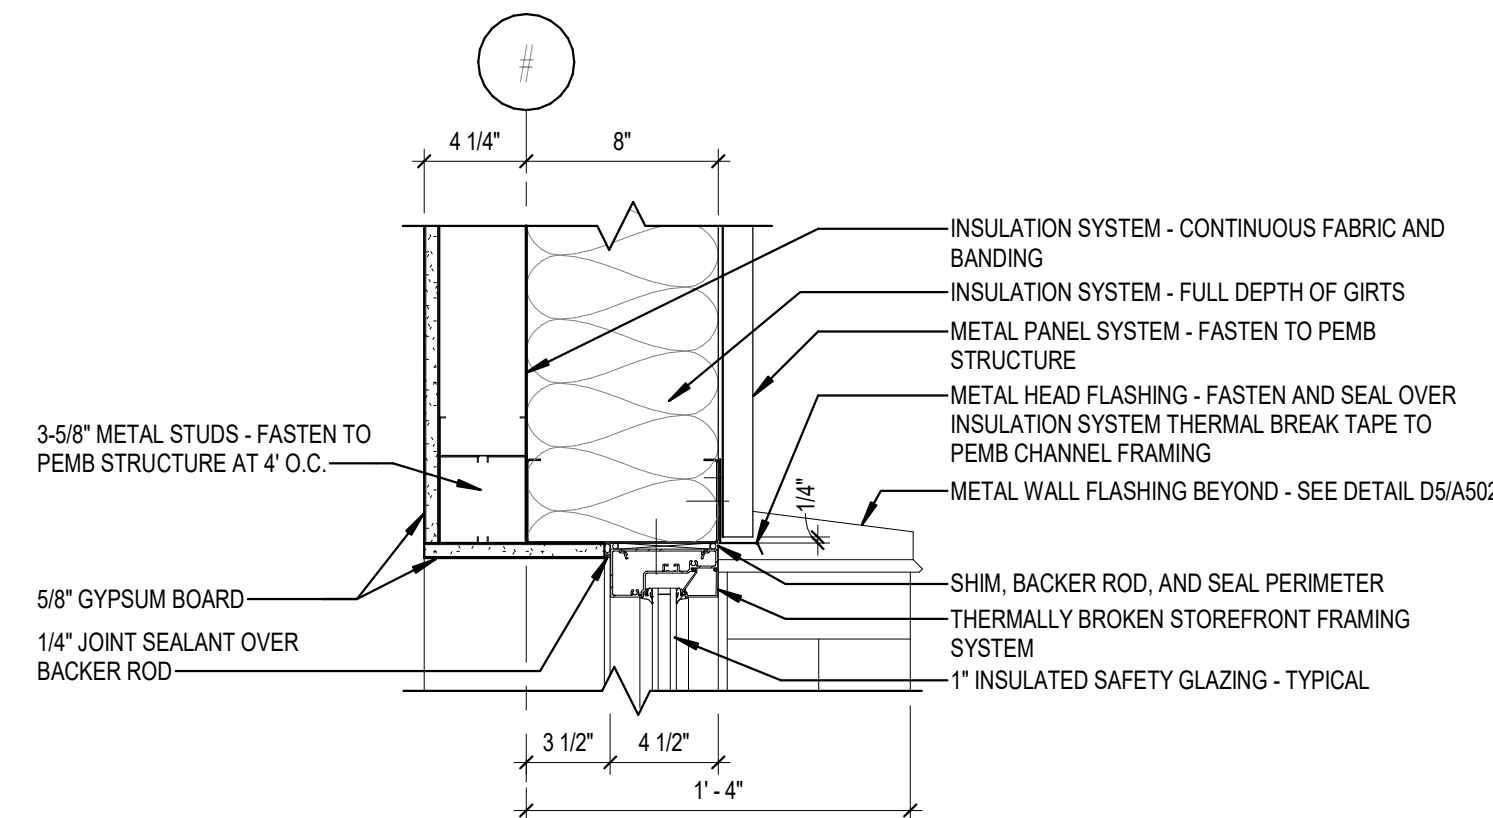


E6 WINDOW HEAD DETAIL
1 1/2" = 1'-0"

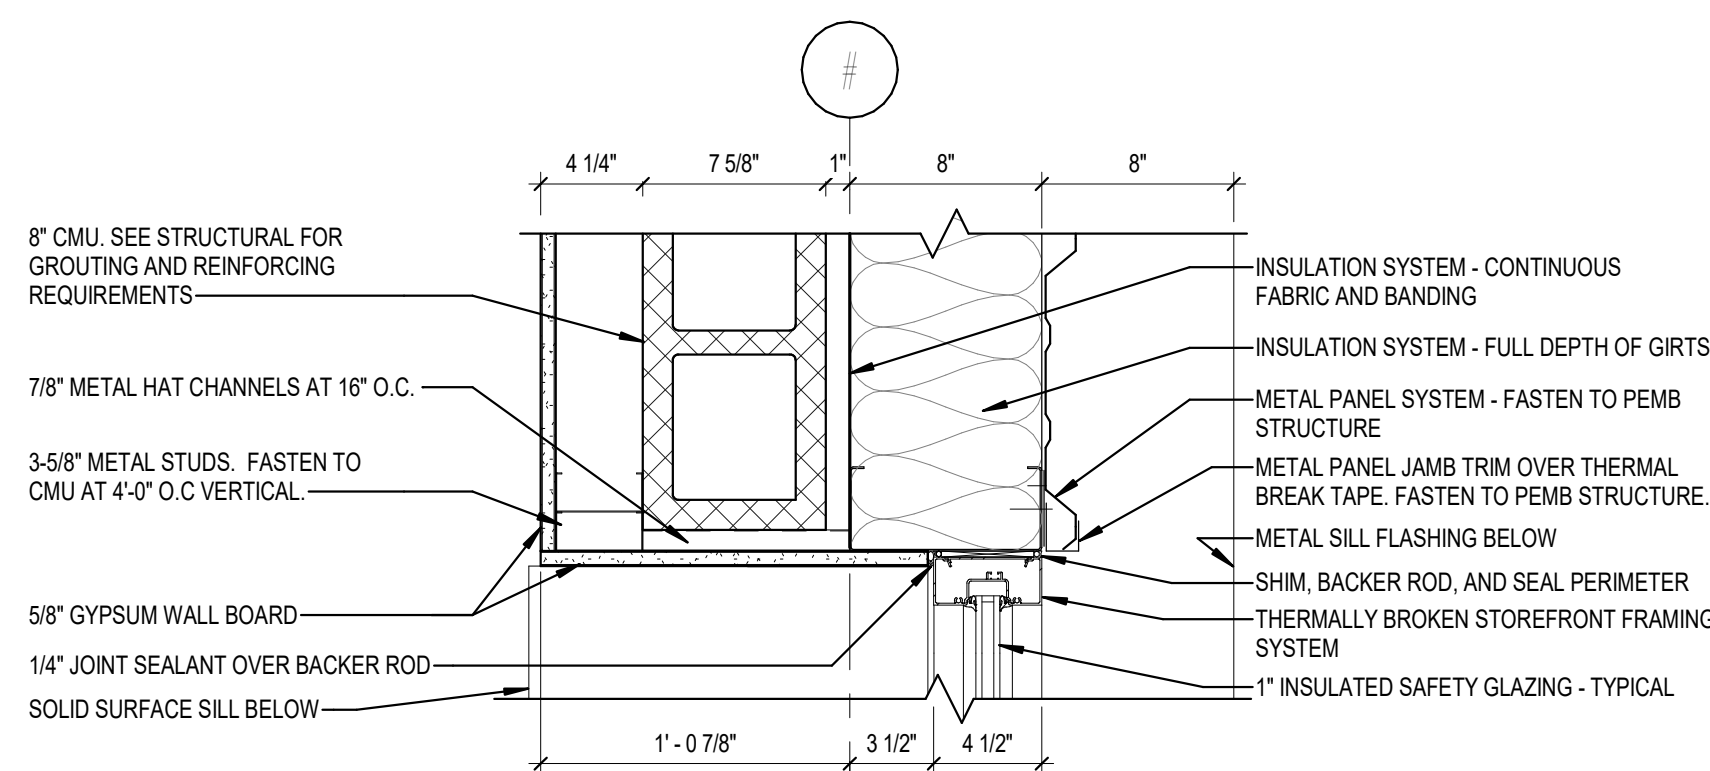


D1 WINDOW JAMB DETAIL
1 1/2" = 1'-0"

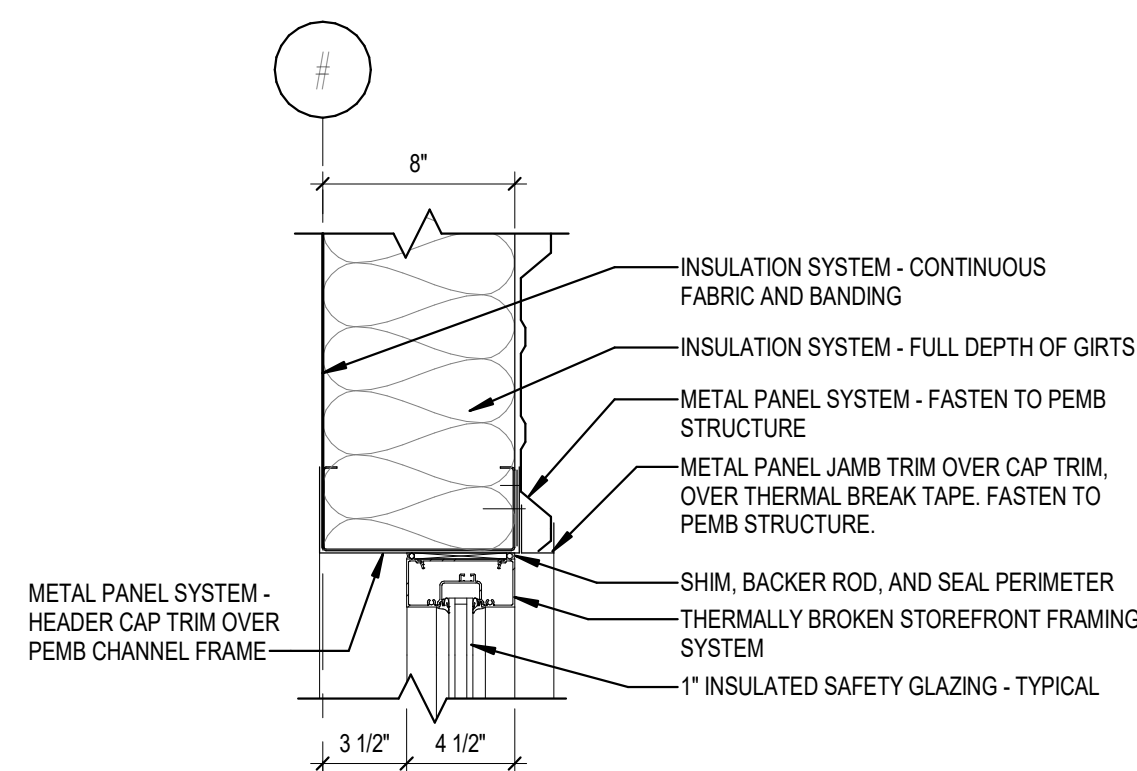


D3 WINDOW JAMB DETAIL
1 1/2" = 1'-0"

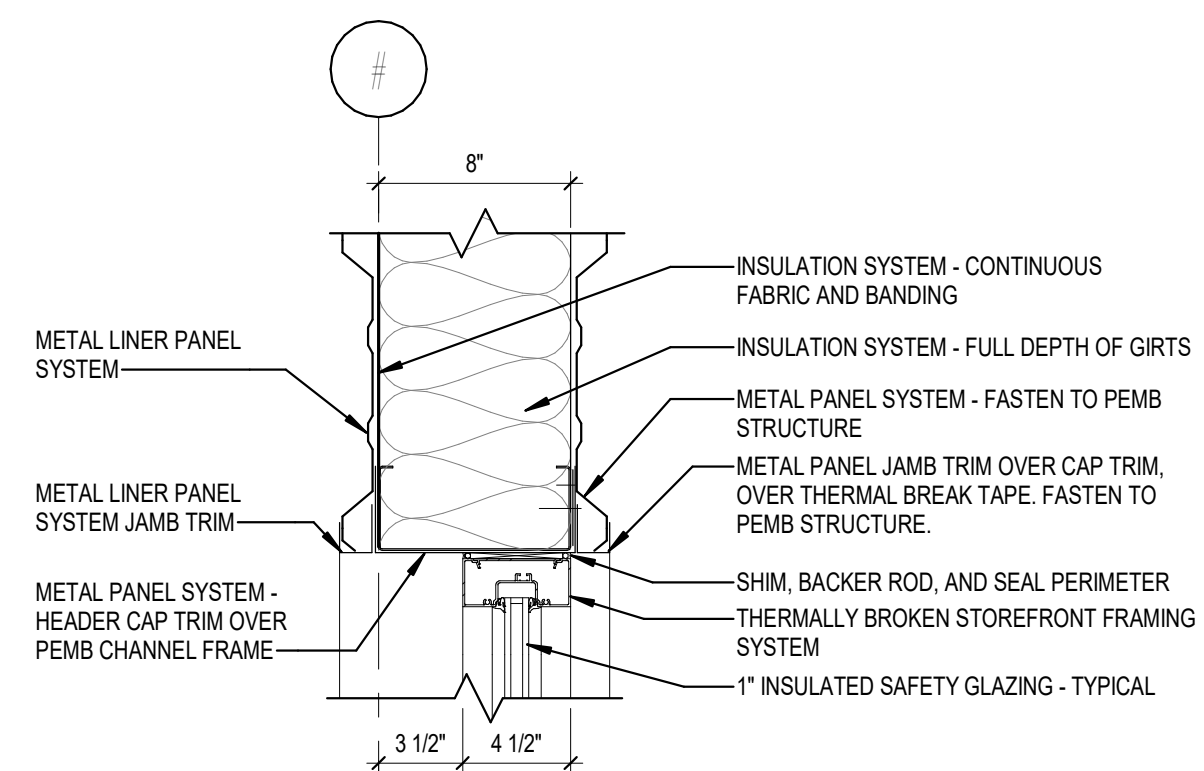


D4 WINDOW JAMB DETAIL
1 1/2" = 1'-0"

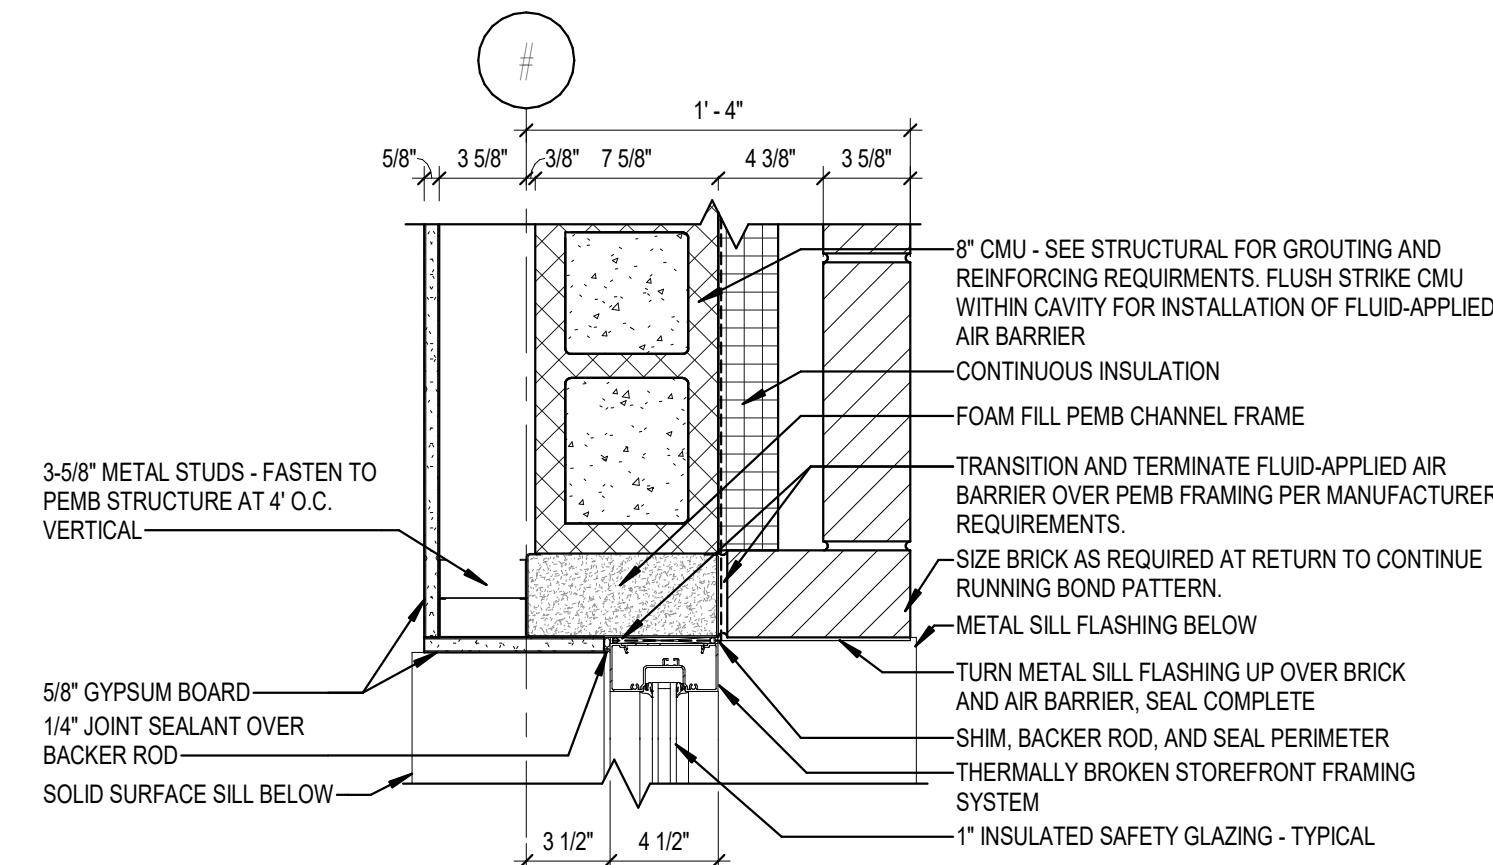


D6 WINDOW JAMB DETAIL
1 1/2" = 1'-0"

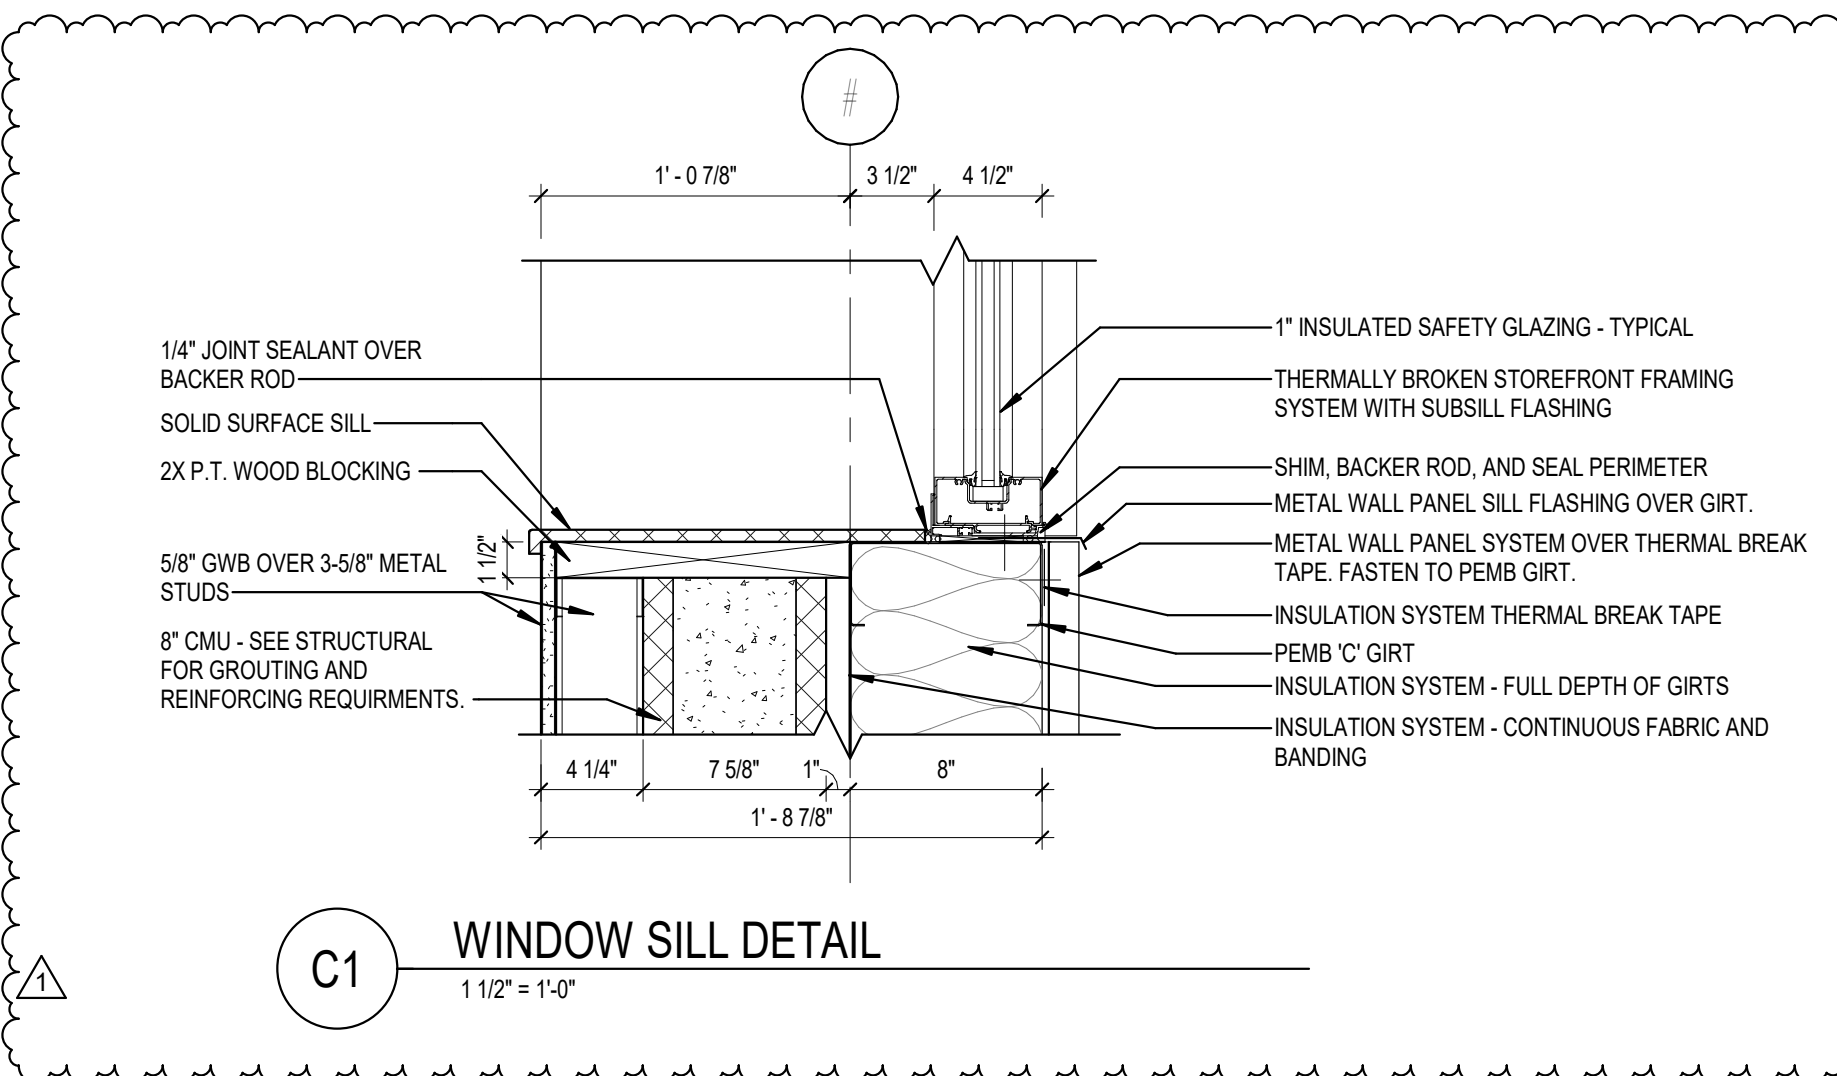


C1 WINDOW SILL DETAIL
1 1/2" = 1'-0"

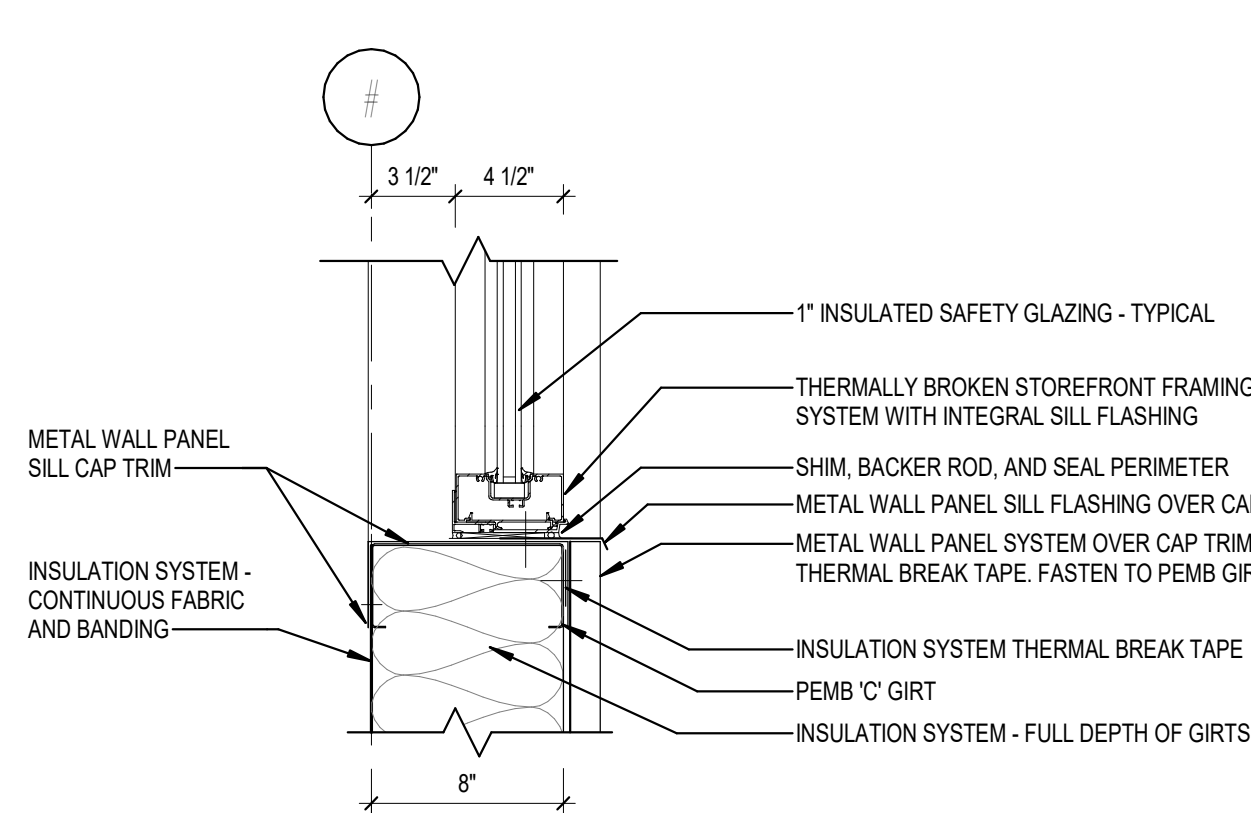


C3 WINDOW SILL DETAIL
1 1/2" = 1'-0"

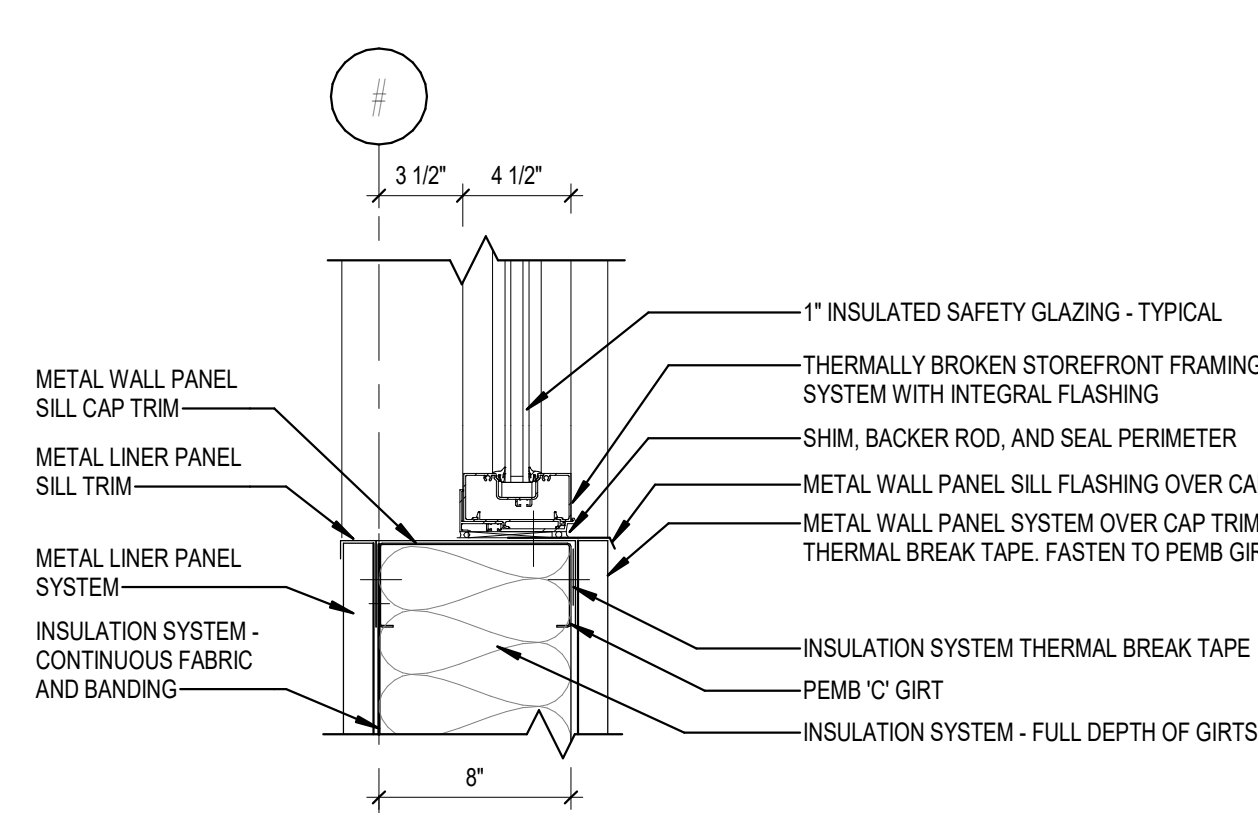


C4 WINDOW SILL DETAIL
1 1/2" = 1'-0"

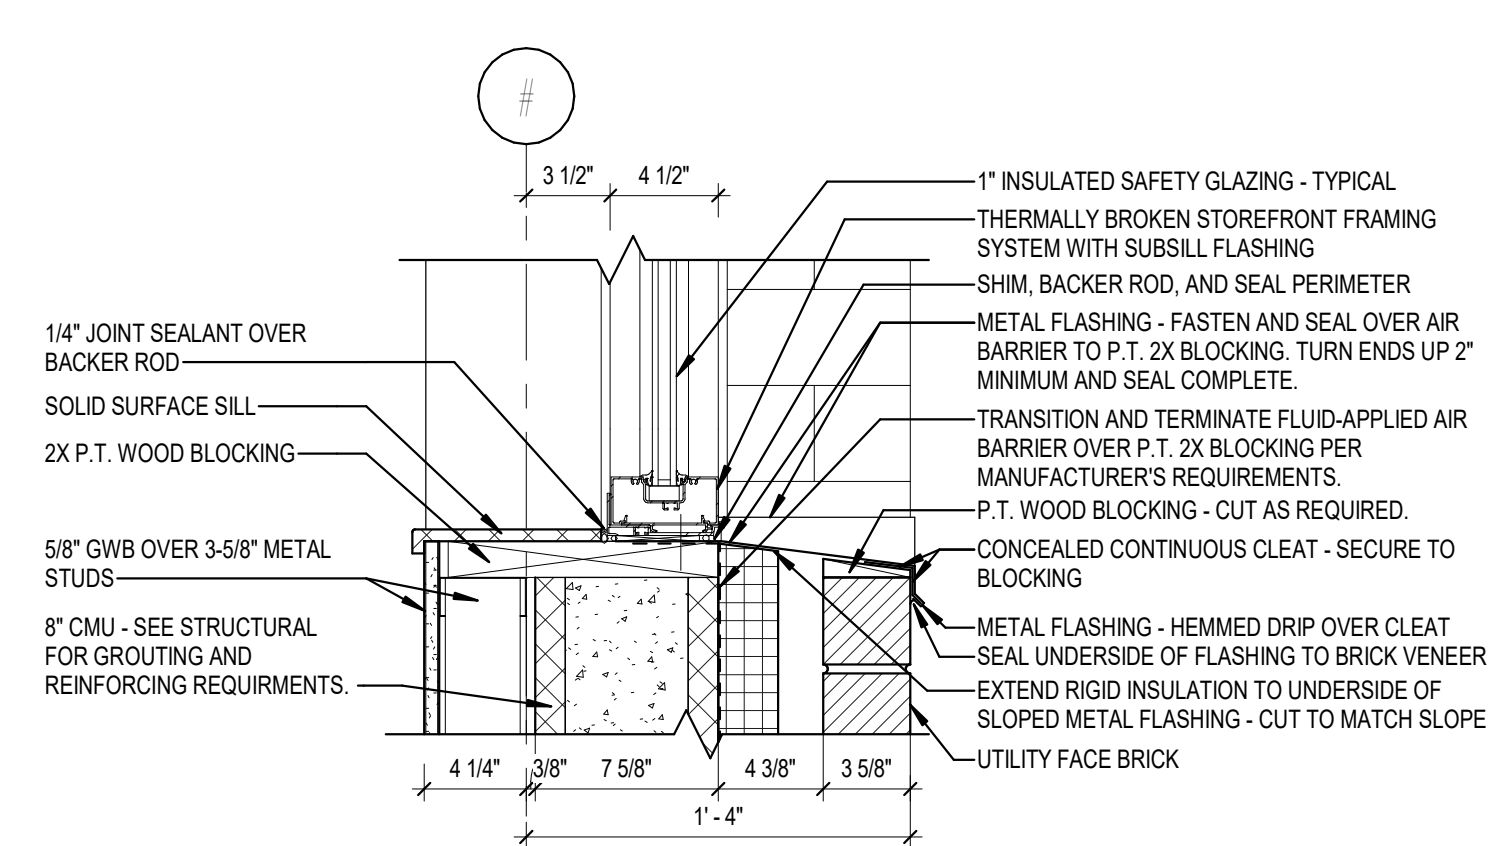

C6 WINDOW SILL DETAIL
1 1/2" = 1'-0"

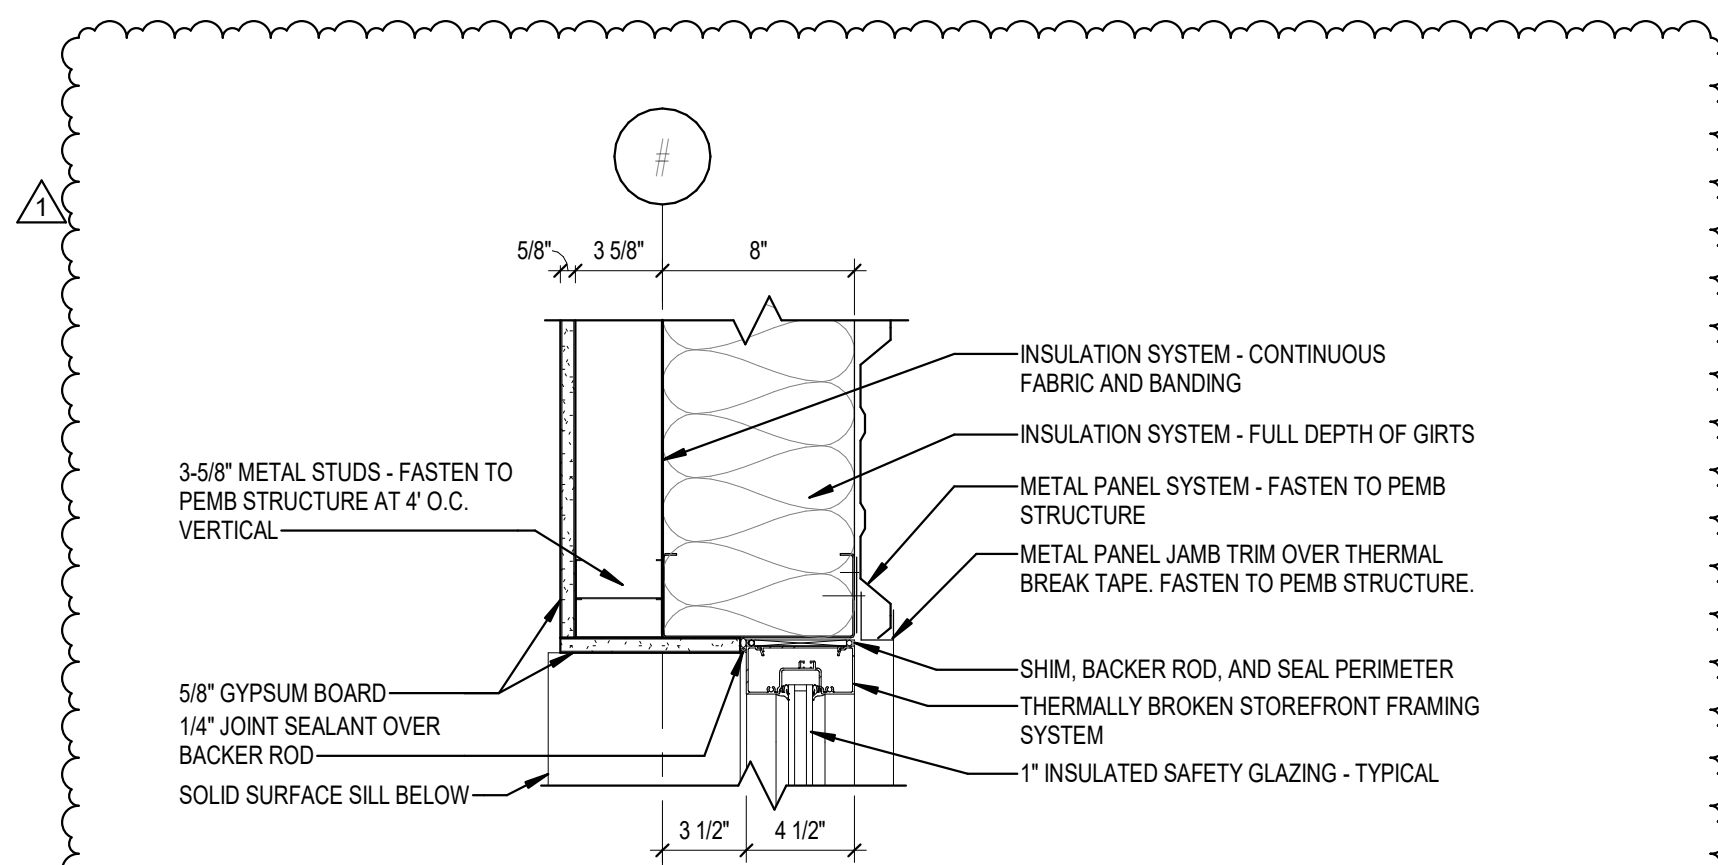

B3 WINDOW JAMB DETAIL
1 1/2" = 1'-0"

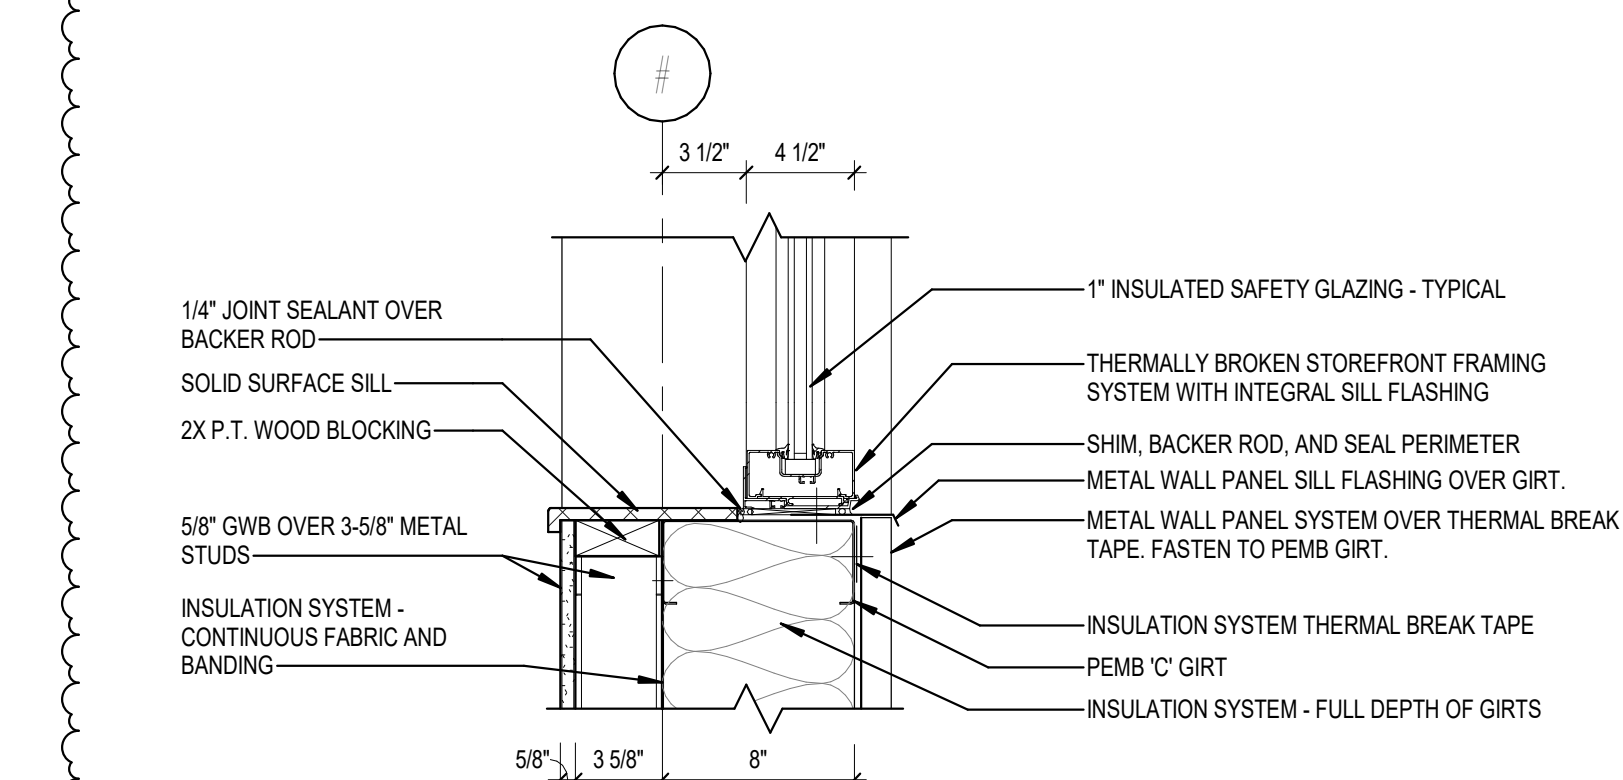

A3 WINDOW SILL DETAIL
1 1/2" = 1'-0"

DESCRIPTION

ADDENDUM 01

DATE
3/2/2023

REV
1


SANITATION BUILDING PROJECT GP1376
2801 REGENT AVE. N.E.
CANTON, OH 44705

WINDOW DETAILS


DATE:	
PERMIT	02/06/2023
BID	02/06/2023
CONSTRUCTION	---
RECORDED	---
PROJECT MANAGER	DESIGNER
Designer	Author

JOB NO.
2020377.05

A-604

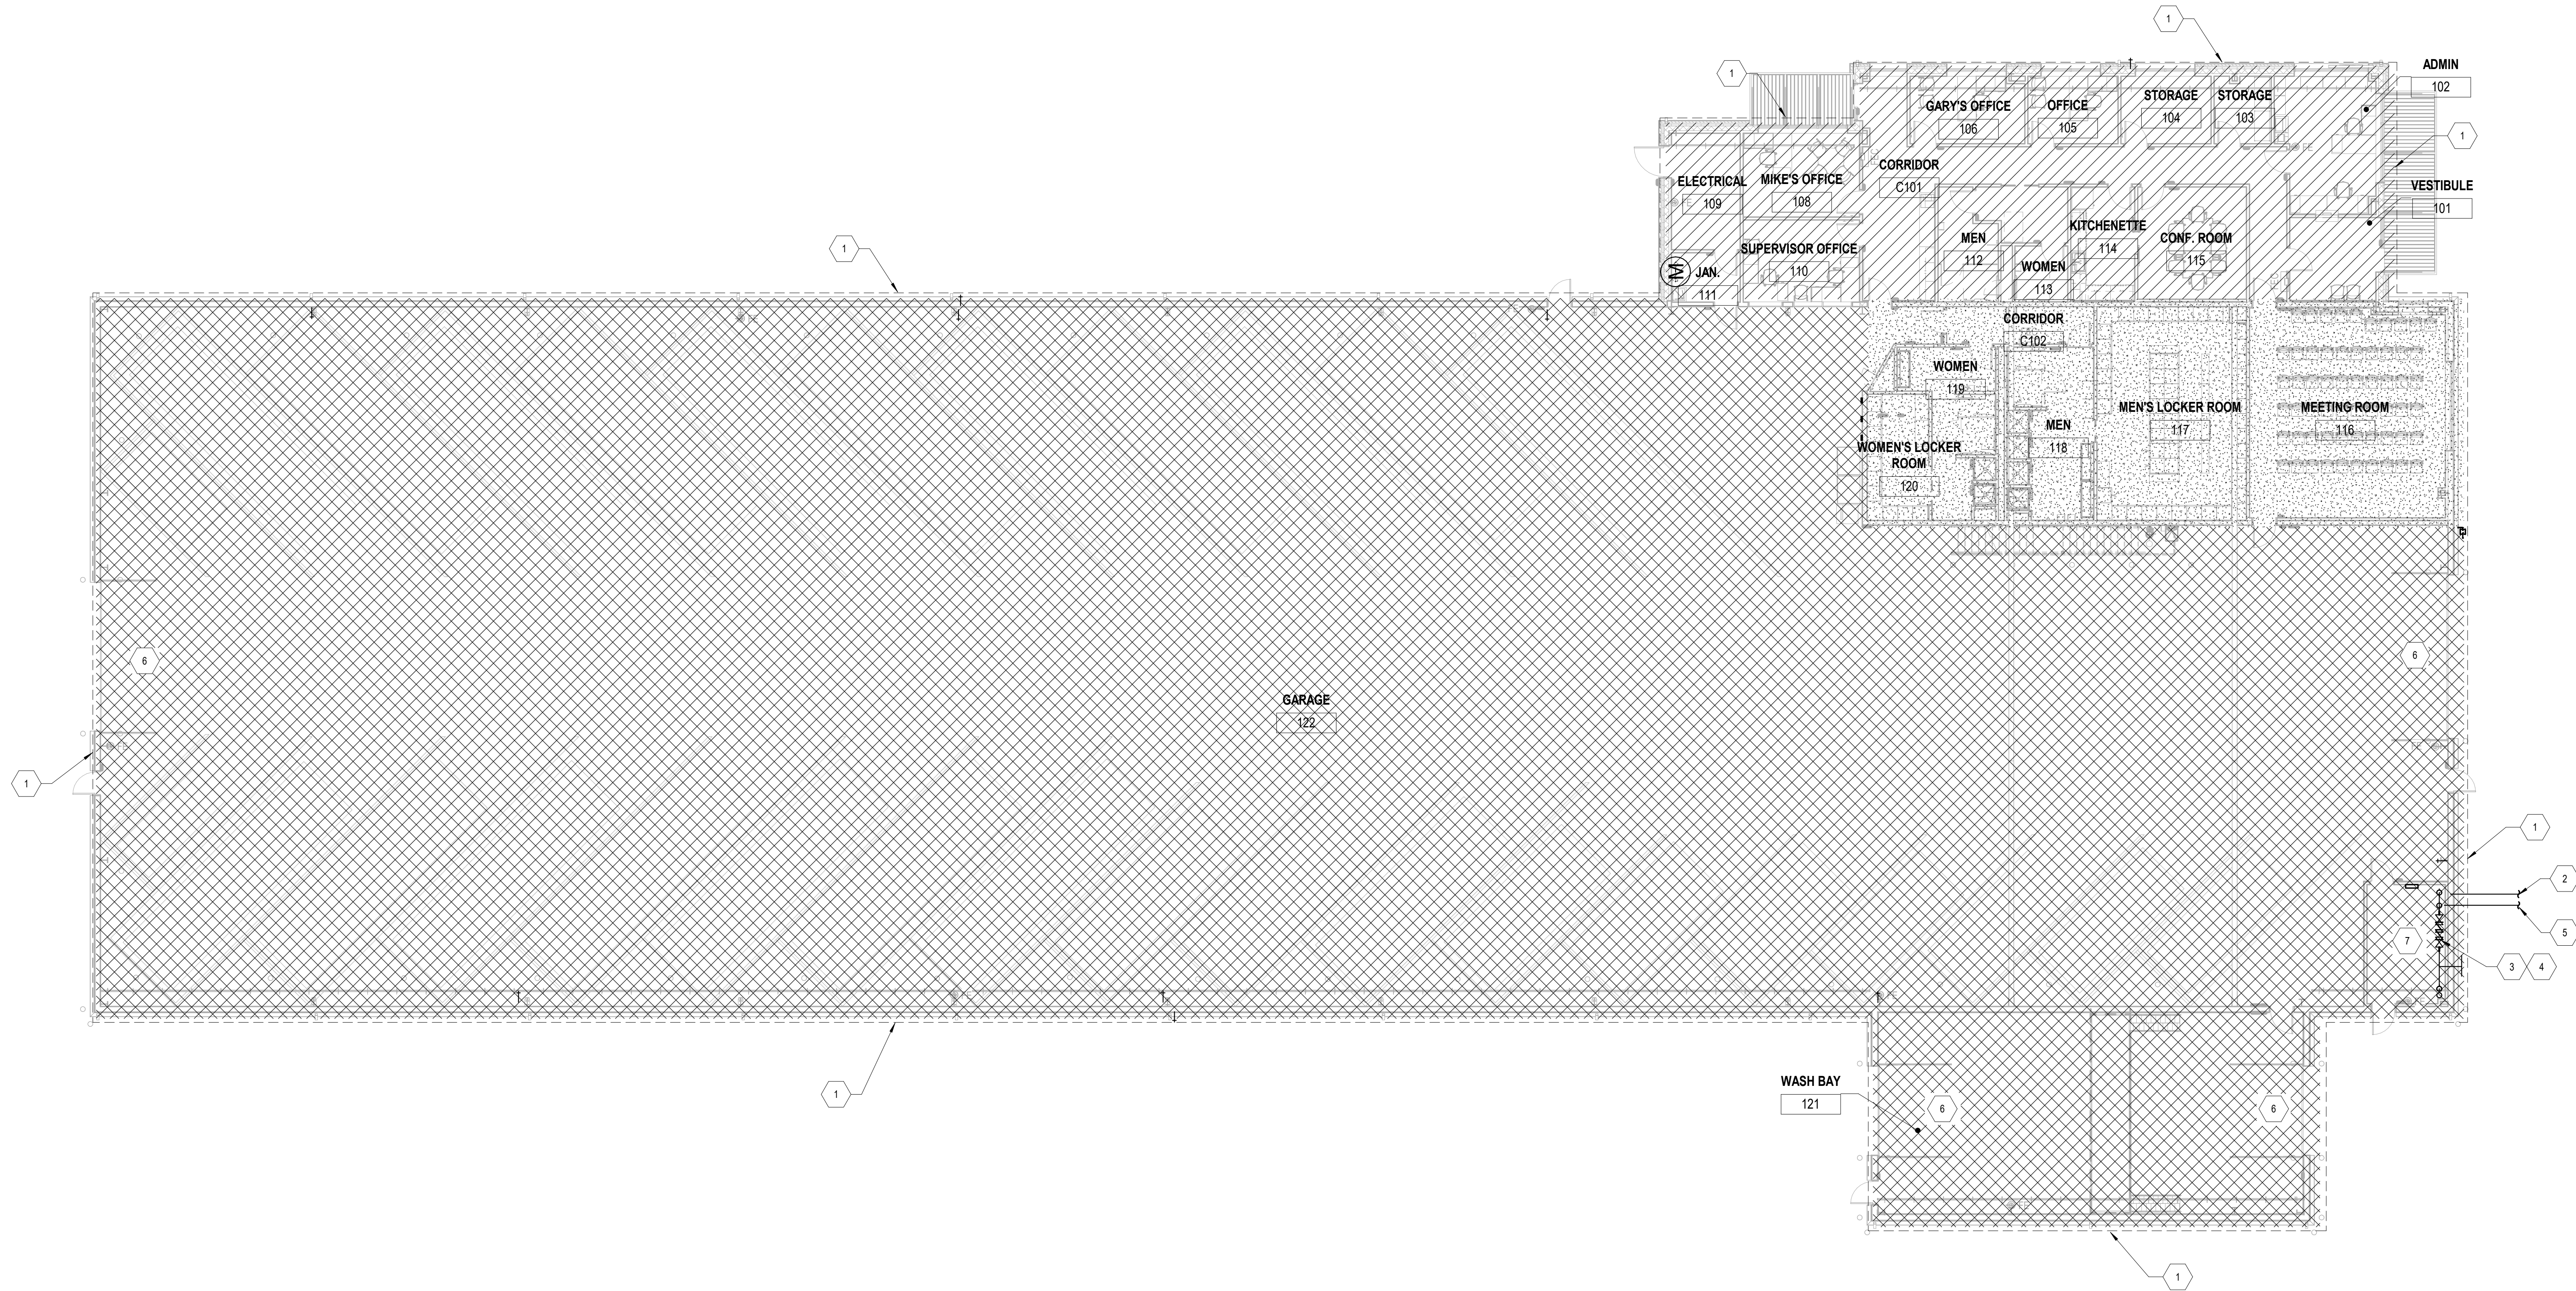

B3 FIRST FLOOR OVERALL FIRE SUPPRESSION PLAN
3/32" = 1'-0"

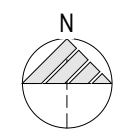

GENERAL NOTES

- THIS DRAWING IS FOR REFERENCE PURPOSES ONLY. A LICENSED FIRE PROTECTION CONTRACTOR SHALL DESIGN AND INSTALL A WET PIPE SPRINKLER SYSTEM IN COMPLIANCE WITH N.F.P.A. 13, THE STATE PLUMBING CODE, AND ALL OTHER APPLICABLE CODES AND ORDINANCES. FLUSH AND COMMISSION SYSTEM, AND OBTAIN ALL FINAL APPROVALS FROM THAT STATE AND LOCAL AUTHORITIES.
- PROVIDE DESIGN BUILD SYSTEM TO MEET REQUIREMENTS SHOWN. PREPARE HYDRAULIC CALCULATIONS AND DESIGN DRAWINGS. OBTAIN ALL PERMITS, INSPECTIONS AND APPROVALS.
- FIRE PROTECTION CONTRACTOR SHALL SIZE PIPING AND HYDRAULICALLY CALCULATE PER N.F.P.A. 13.
- ALL MATERIAL SHALL BE UL AND/OR FM APPROVED AND SHALL BE INSTALLED PER N.F.P.A. 13.
- PROVIDE AND INSTALL CONCEALED SPRINKLER TYPES WITH WHITE FINISH IN ALL AREAS WITH FINISHED CEILINGS AND UPRIGHT SPRINKLER HEADS FOR AREAS WITHOUT CEILINGS.
- SPRINKLER HEADS THAT ARE LOCATED IN THE ACOUSTICAL PANELS OF THE CEILING GRID SHALL BE IN THE CENTER OF THE PANEL. THE EXACT LOCATION OF THE SPRINKLER HEADS SHALL BE DETERMINED AFTER CEILING GRID IS INSTALLED. DO NOT USE THE CEILING GRID PLANS TO DETERMINE THE LOCATION OF THE SPRINKLER HEADS.
- ALL ELECTRICAL CIRCUITS REQUIRED FOR EACH FIRE DETECTION SYSTEM, WATER FLOW ALARM AND VALVE SUPERVISION WIRING SHALL BE CHECKED BY THE FIRE PROTECTION CONTRACTOR TO ENSURE PROPER OPERATION. SPRINKLER SUPERVISORY DEVICES WILL BE COMPATIBLE WITH THE ALARM EQUIPMENT PANEL. COORDINATE WITH FIRE ALARM CONTRACTOR.

PLAN KEYNOTES


- PROVIDE AND INSTALL AUTOMATIC SPRINKLER LINES AND SPRINKLER HEADS WITHIN DASHED OUTLINED AREA, UNLESS NOTED OTHERWISE. AUTOMATIC SPRINKLER SYSTEM SHALL BE HYDRAULICALLY CALCULATED AND SIZED PER N.F.P.A. 13. COORDINATE WITH ARCHITECTURAL REFLECTED CEILING PLANS AND DESIGN FOR STEEL JOIST CONSTRUCTION.
- NEW 6" FIRE MAIN, COORDINATE WITH CIVIL PLANS FOR CONTINUATION.
- NEW FIRE PUMP ROOM, ASSE 1048 BACKFLOW PREVENTER PURCHASED FROM CANTON WATER DEPARTMENT, AND FIRE PUMP TO BOOSTER RESIDUAL PRESSURE TO 45 PSI MINIMUM. FIELD COORDINATE EXACT LOCATION PRIOR TO START OF ANY WORK.
- FIRE ALARM PANEL IN FIRE PUMP ROOM, COORDINATE EXACT LOCATION WITH ELECTRICAL PLANS.
- SEE CIVIL FOR REMOTE FIRE DEPARTMENT CONNECTION. COORDINATE EXACT LOCATION WITH FIRE DEPARTMENT.
- PROVIDE SPRINKLER PROTECTION BELOW GARAGE DOOR TRACK TO PROVIDE FULL COVERAGE WHEN DOOR IS IN THE OPEN POSITION. PROVIDE SUPPLEMENTAL SUPPORT FRAMING FOR THE PIPING.
- PROVIDE SPRINKLERS BELOW FIRE PUMP ROOM CEILING.

FLOW TEST DATA - FOR REFERENCE

DATE: 08-31-2021
MAIN SIZE: 6"
LOCATION: REGENT NE
STATIC: 58 PSI
RESIDUAL: 35 PSI AT 980 GPM

FIRE SYMBOL LEGEND

SYMBOL	DESCRIPTION
	WET PIPE SPRINKLER SYSTEM LIGHT HAZARD.
	BELOW MEZZANINE: WET PIPE SPRINKLER SYSTEM LIGHT HAZARD. ABOVE MEZZANINE: WET PIPE SPRINKLER SYSTEM ORDINARY HAZARD GROUP II.
	WET PIPE SPRINKLER SYSTEM ORDINARY HAZARD GROUP II.

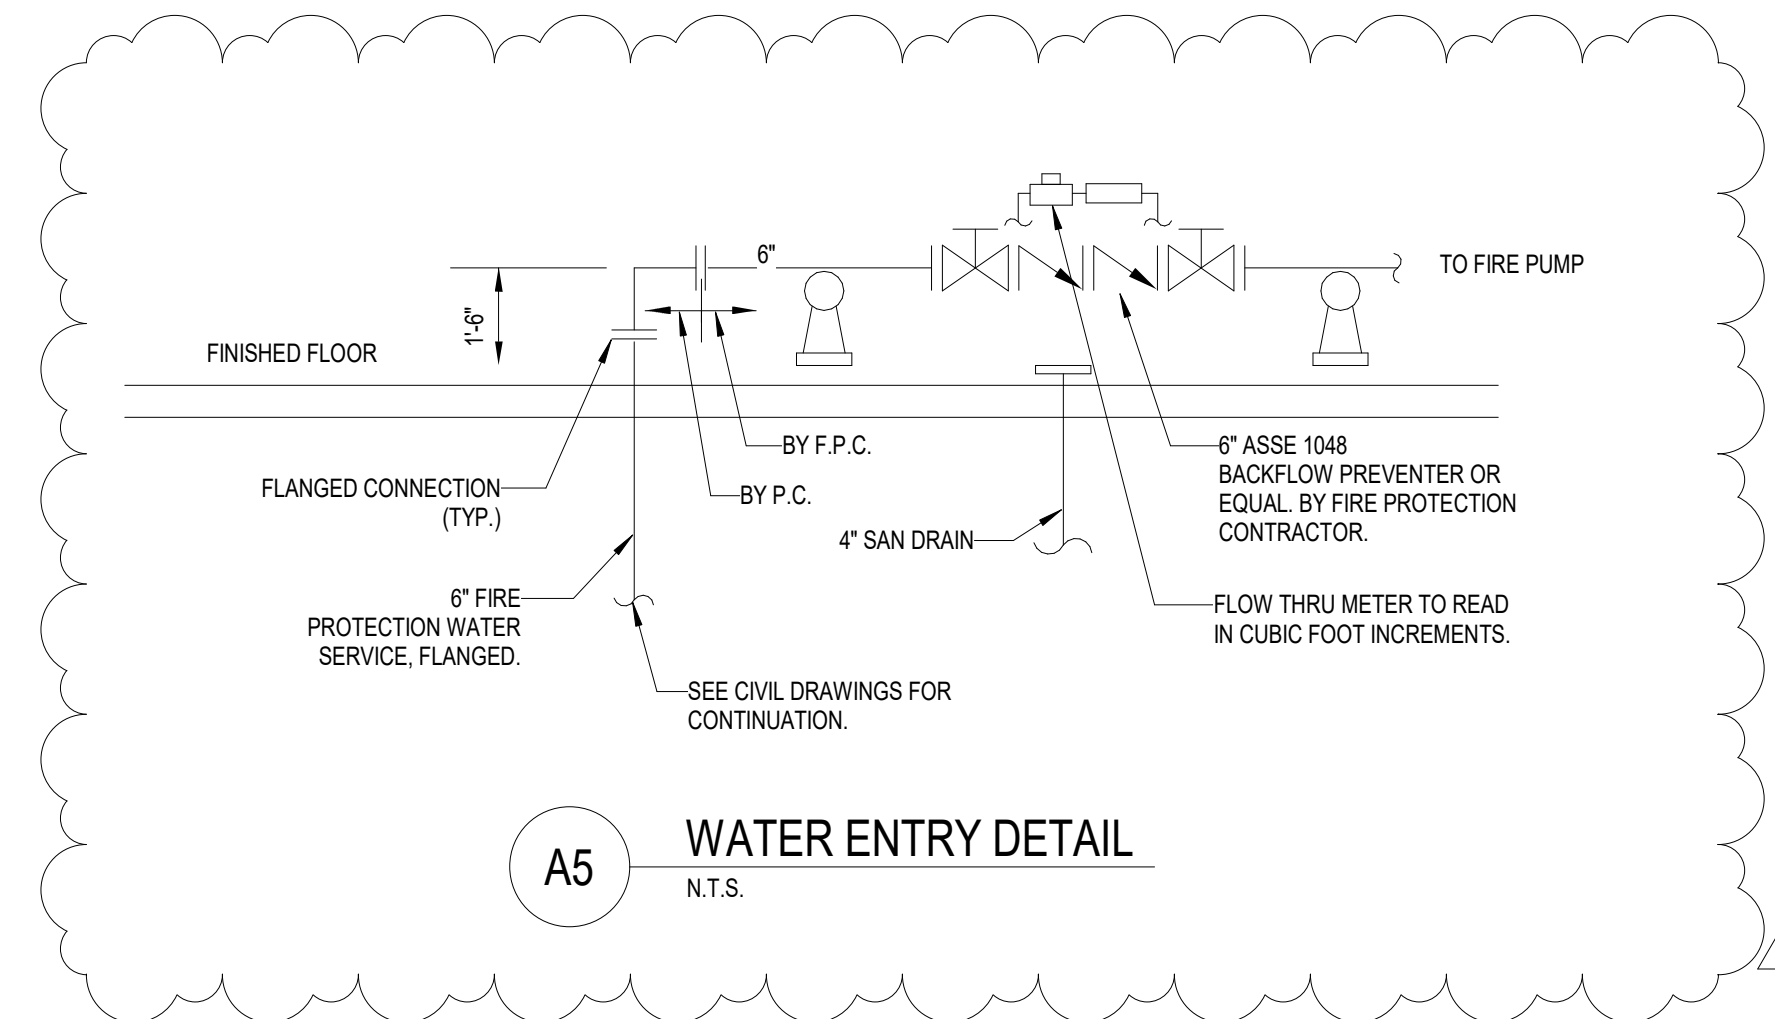

DESCRIPTION
CANTON WATER DEPARTMENT REVISIONS
ADDENDUM 01

DATE
02/15/23
02/02/23

REV
1
2

NOT FOR
CONSTRUCTION

SANITATION BUILDING PROJECT GP1376
2801 REGENT AVE. N.E.
CANTON, OH 44705

FIRE PROTECTION

PERMIT	DATE:
BID	02/06/2023
CONSTRUCTION	02/06/2023
RECORDED	02/06/2023
PROJECT MANAGER	DESIGNER
RG	BRF

JOB NO.
2020377.05

FP-101

FAN MOTOR			DESIGN BASE HEATING SECTION			# OF STAGES	DESIGN (MC/MCOP)	RTU WEIGHT	REMARKS
BASE	ELECTRICAL		INPUT MBH	OUTPUT MBH	EAT DEG F				
HP	VOLTAGE	PHASE							
3.5	480	3	240	194.4	60.0	2	3240	1265	1,2,3,4

ENVIRONMENTAL AIR CONDITIONING UNIT SCHEDULE												
TAG	MANUFACTURER	MODEL NUMBER	NOMINAL CAPACITY (TONS)	MIN. REQUIRED CAPACITY		SUPPLY AIR CFM	ELECTRICAL	HEAT AT 17 DEG F	FLA	MCA	WEIGHT (LBS)	REMARKS
				TOTAL MMBH	SENSIBLE MMBH							
AC-1	mitsubishi	MSZ-FS18NA	1.5	21000	14400	300	208/160	12.800	0.65	1.0	34	1.2
AC-2	mitsubishi	MSZ-WR24NA	2.0	22600	20250	500	208/160	18.500	0.67	1.0	34	1.2

CONDENSING UNIT SCHEDULE								
TAG	SERVICE	MANUFACTURER	MODEL NUMBER	MCA	MOCp	VOLTS/PH/Hz	WEIGHT	REMARKS
CU-1	TECH ROOM	MITSUBISHI	MUZ-FS18NAH	18	20	208/1/60	118	1,2,3
CU-2	ELECTRICAL ROOM	MITSUBISHI	MUZ-WR2ANA	14	15	208/1/60	118	1,2,3

EXHAUST FAN SCHEDULE								
TAG	MANUFACTURER	MODEL NUMBER	CFM	E.S.P. (IN. WC)	MOTOR (FLA)	ELECTRICAL	ACTIVATED	REMARKS
EF-1	GREENHECK	G-100-VG	825	0.75	3.8	120/180	SCHEDULE	1.2
EF-2	GREENHECK	AER-24-03-0321	6600	0.5	3.0	460/900	SWITCH/SENSOR	3
EF-3	GREENHECK	AER-24-03-0321	6600	0.5	3.0	460/900	SWITCH/SENSOR	3
EF-4	GREENHECK	SE16-42-1	1200	0.5	9.8	120/180	SWITCH/SENSOR	3
EF-5	GREENHECK	AER-24-03-0321	6600	0.5	3.0	460/900	SWITCH/SENSOR	3
EF-6	GREENHECK	SE1-12-42-0.5	1800	0.25	3.8	120/180	SWITCH/SENSOR	2.3.4

VAV SCHEDULE													
TAG	NUMBER	MAKE	MODEL	PRIMARY INLET SIZE	DESIGN COOLING AIRFLOW CFM	MIN. COOLING AIRFLOW CFM	DESIGN HEATING AIRFLOW CFM	EAT	LAT	KW	STA GES	DISCH GE	RADIAT ED NC
VAV	1	TRANE	VCEF	8"	425	210	210	55	92.8	2.5	2	16	20
VAV	2	TRANE	VCEF	10"	750	350	750	55	92.9	9.0	2	19	15
VAV	3	TRANE	VCEF	8"	210	480	210	55	92.8	2.5	2	22	22
VAV	4	TRANE	VCEF	6"	200	120	120	55	94.5	1.1	1	16	17
VAV	5	TRANE	VCEF	10"	825	470	468	55	93.4	6.5	3	20	16
VAV	6	TRANE	VCEF	10"	640	150	440	55	94.5	8.0	3	16	20
VAV	7	TRANE	VCEF	8"	400	170	170	55	92.2	2.1	1	18	20

LOUVER SCHEDULE							
MARK	MANUFACTURER	MODEL NUMBER	CFM	HxW	FREE AREA (ft ²)	PRESSURE DROP	REMARKS
LV-1	RUSKIN	ELF3E75DX	6600	66x42	11.24	0.06	1
LV-2	RUSKIN	ELF3E75DX	6600	66x42	11.24	0.06	1
LV-3	RUSKIN	ELF3E75DX	1900	36x24	3.16	0.06	1
LV-4	RUSKIN	ELF3E75DX	6600	66x42	11.24	0.06	1
LV-5	RUSKIN	ELF3E75DX	1200	36x24	3.16	0.02	1

NOTES:

1. FURNISH WITH STANDARD REFLECTORS, AND REMOTE THERMOSTAT.
2. FIELD MODIFY REFLECTORS FOR U-BEND TUBING SECTION. REFLECTORS SHALL COMPLETELY COVER THE ENDS OF THE TUBE TO PROTECT WALL.

ELECTRIC UNIT HEATER SCHEDULE									
TAG	LOCATION	MPG	MODEL	CFM	KW	MOTOR SPEC		WEIGHT	NOTES
						WATTS	VOLTAGE		
EUH-1	JANITOR CLOSET	BERKO	HUH524TA	270	9.0	8	208/160	24	1,2
EUH-2	FIRE PUMP ROOM	BERKO	HUH524TA	270	9.0	8	208/160	24	1,2

DATE:	
PERMIT	02/06/2023
BID	02/06/2023
CONSTRUCTION	--/------
RECORDED	--/------
PROJECT MANAGER	DESIGNER
RG	BRF

JOB NO.
2020377.05

M-601

2/28/2023 10:22:47 AM


A

B


C

D


E

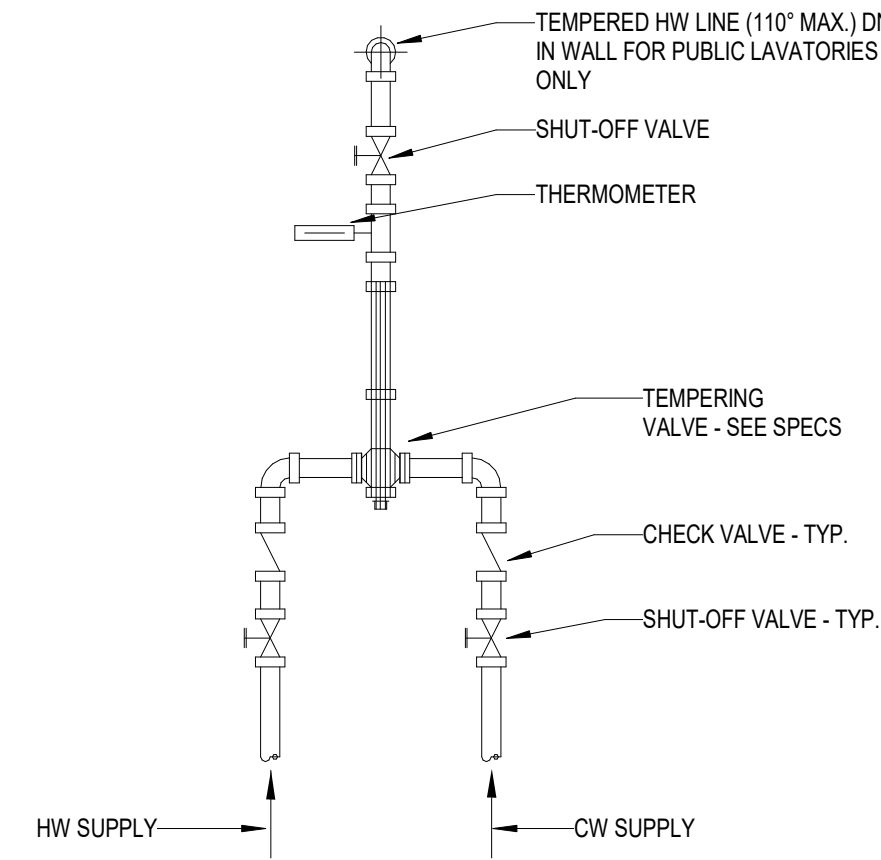


D1 TEMPERING VALVE FOR LAVATORIES
N.T.S.

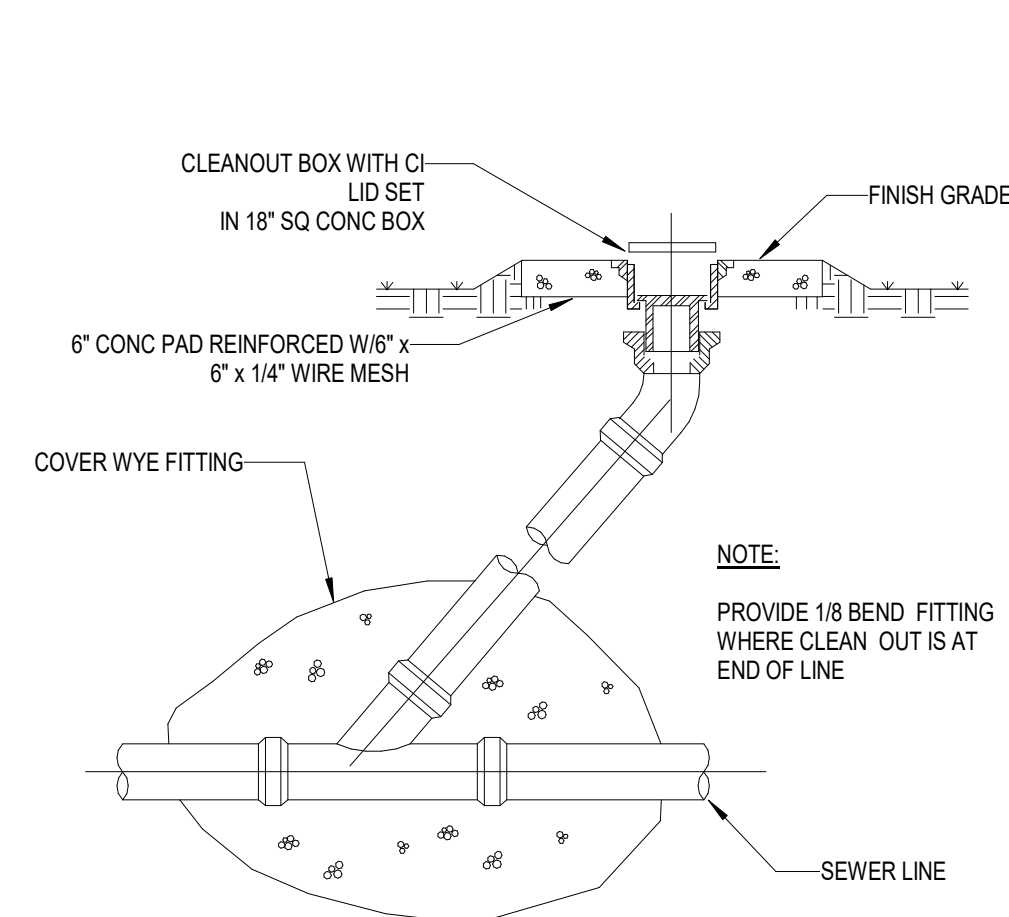


C1 EXTERIOR CLEANOUT
N.T.S.

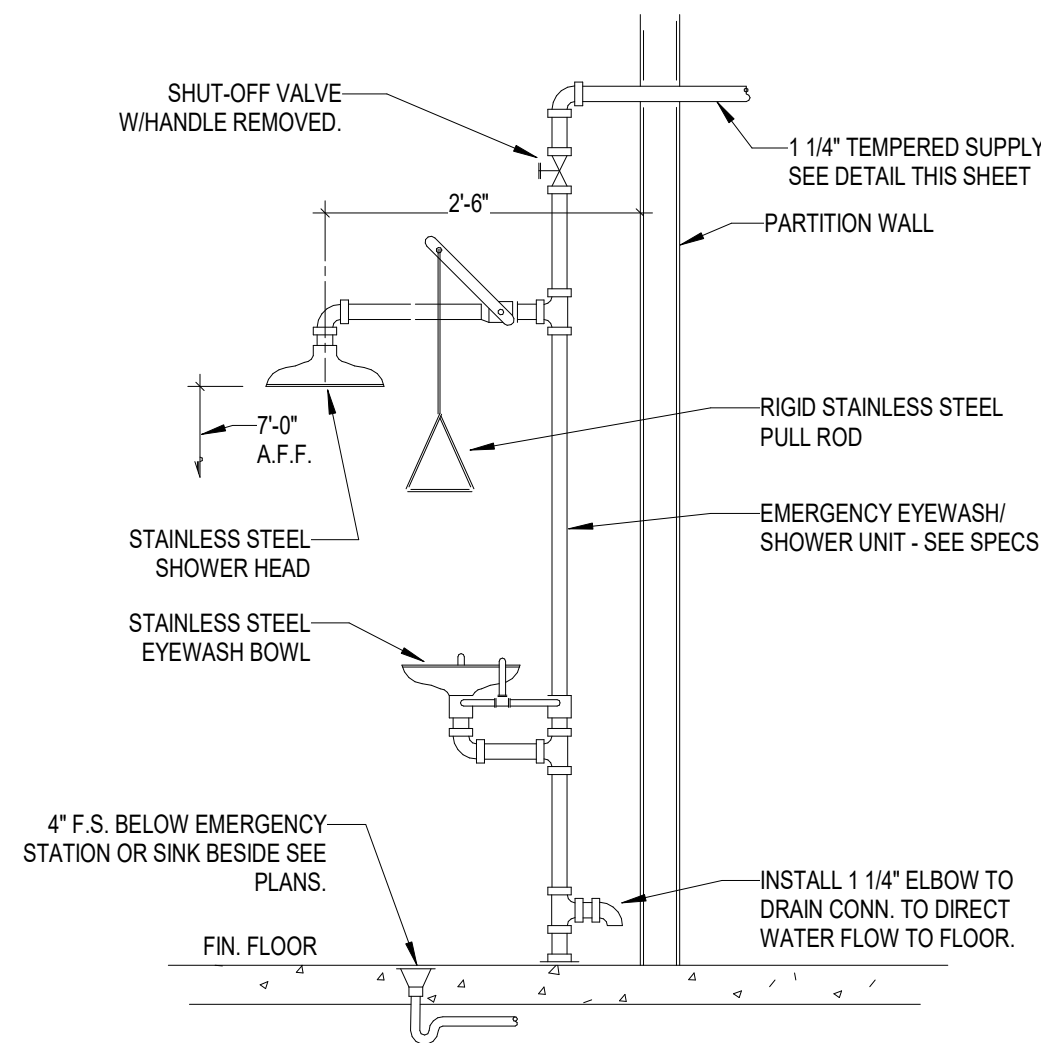


C2 EMERGENCY EYEWASH-SHOWER DETAIL
N.T.S.

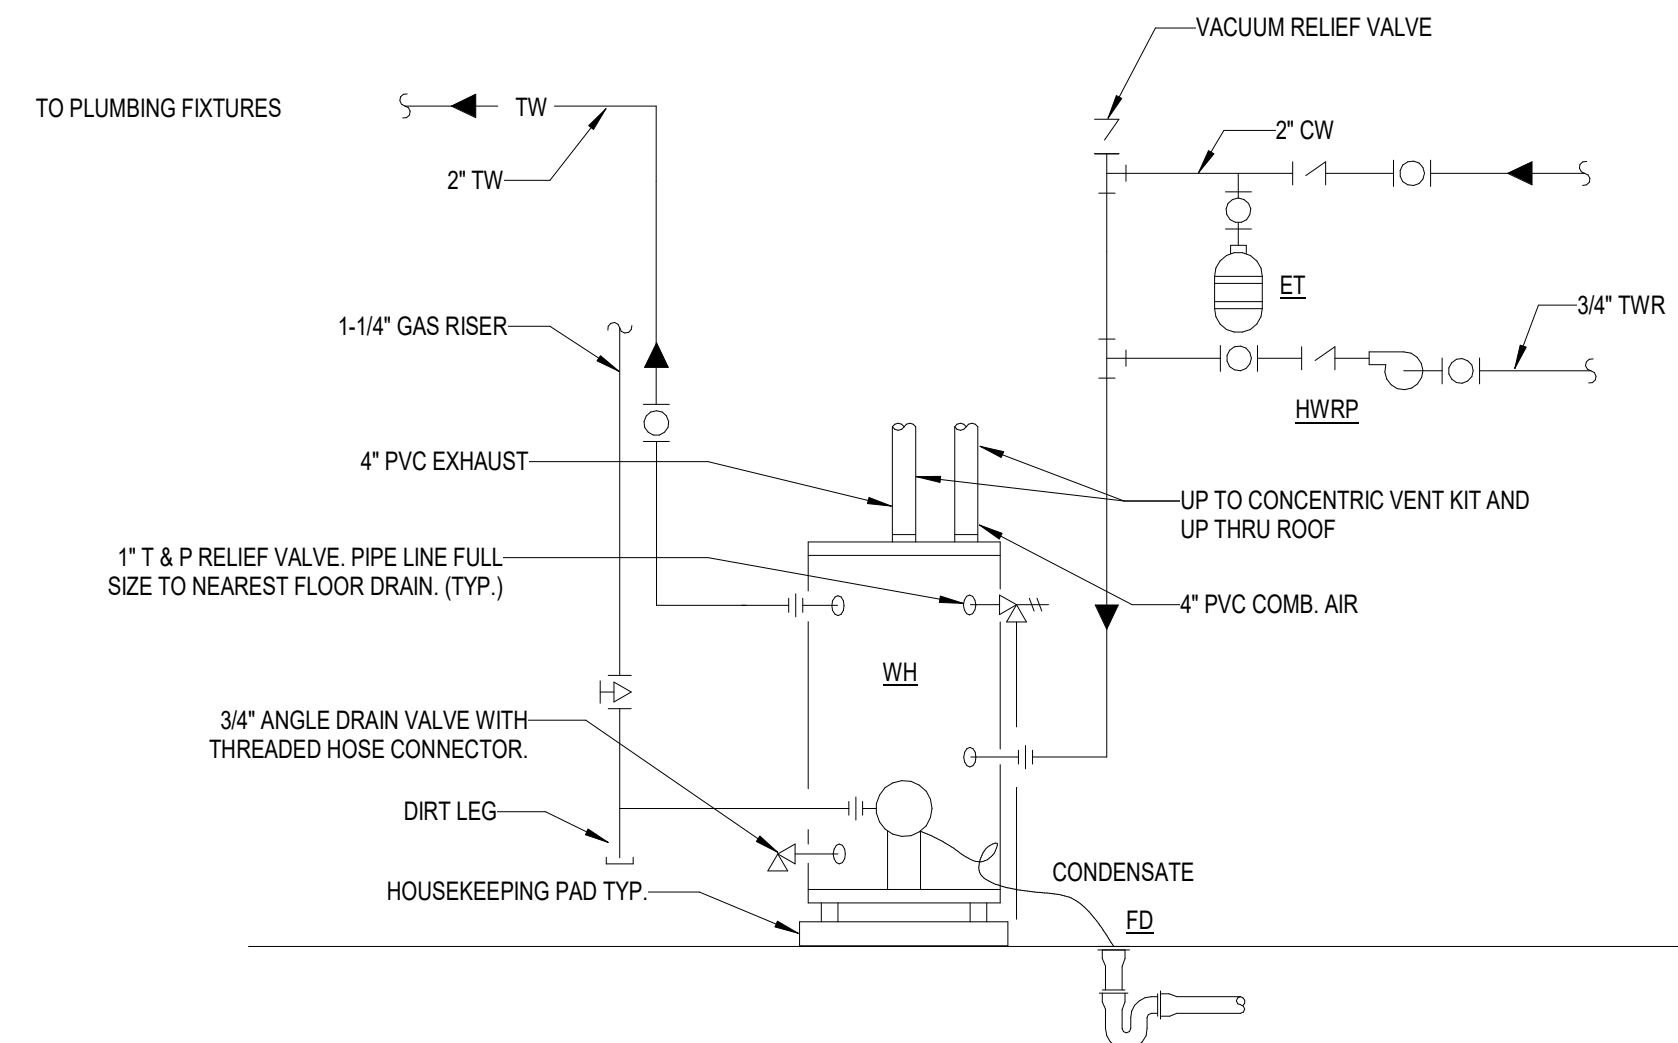


D4 WATER HEATER DETAIL
N.T.S.

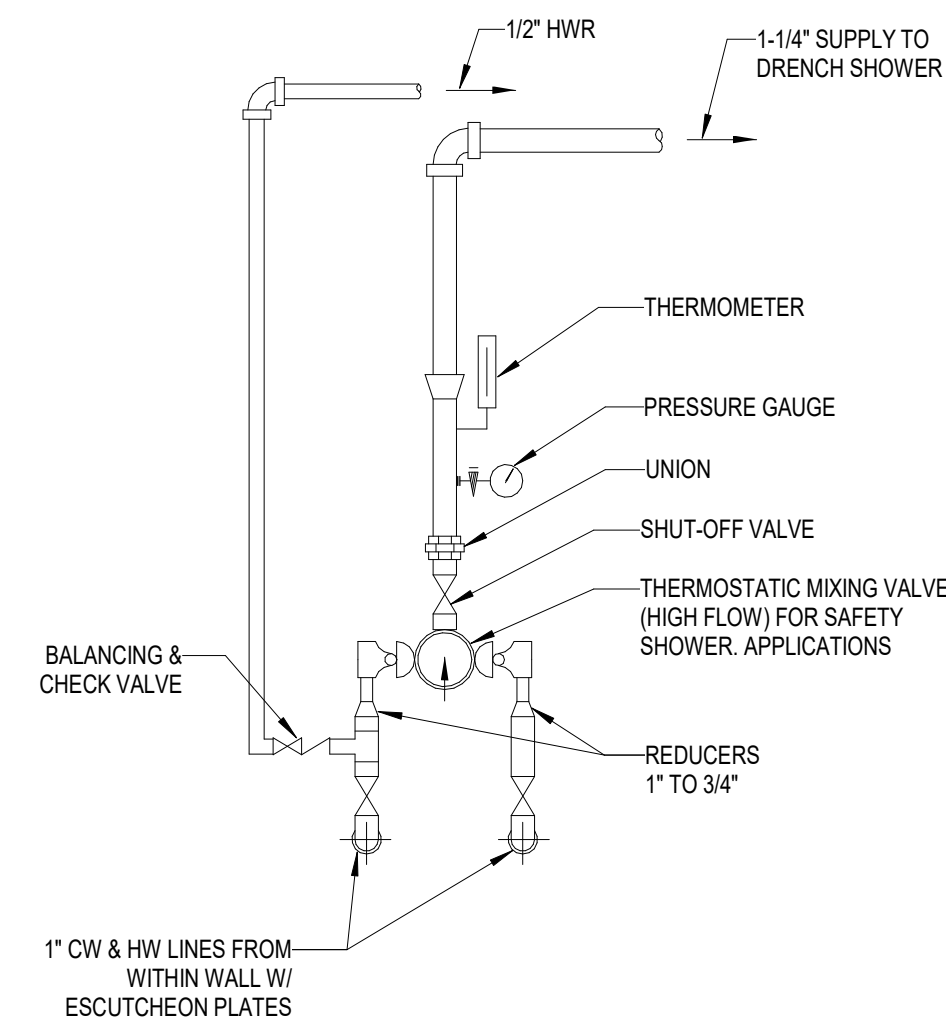

C4 TEMPERING VALVE ARRANGEMENT FOR SAFETY SHOWER
N.T.S.

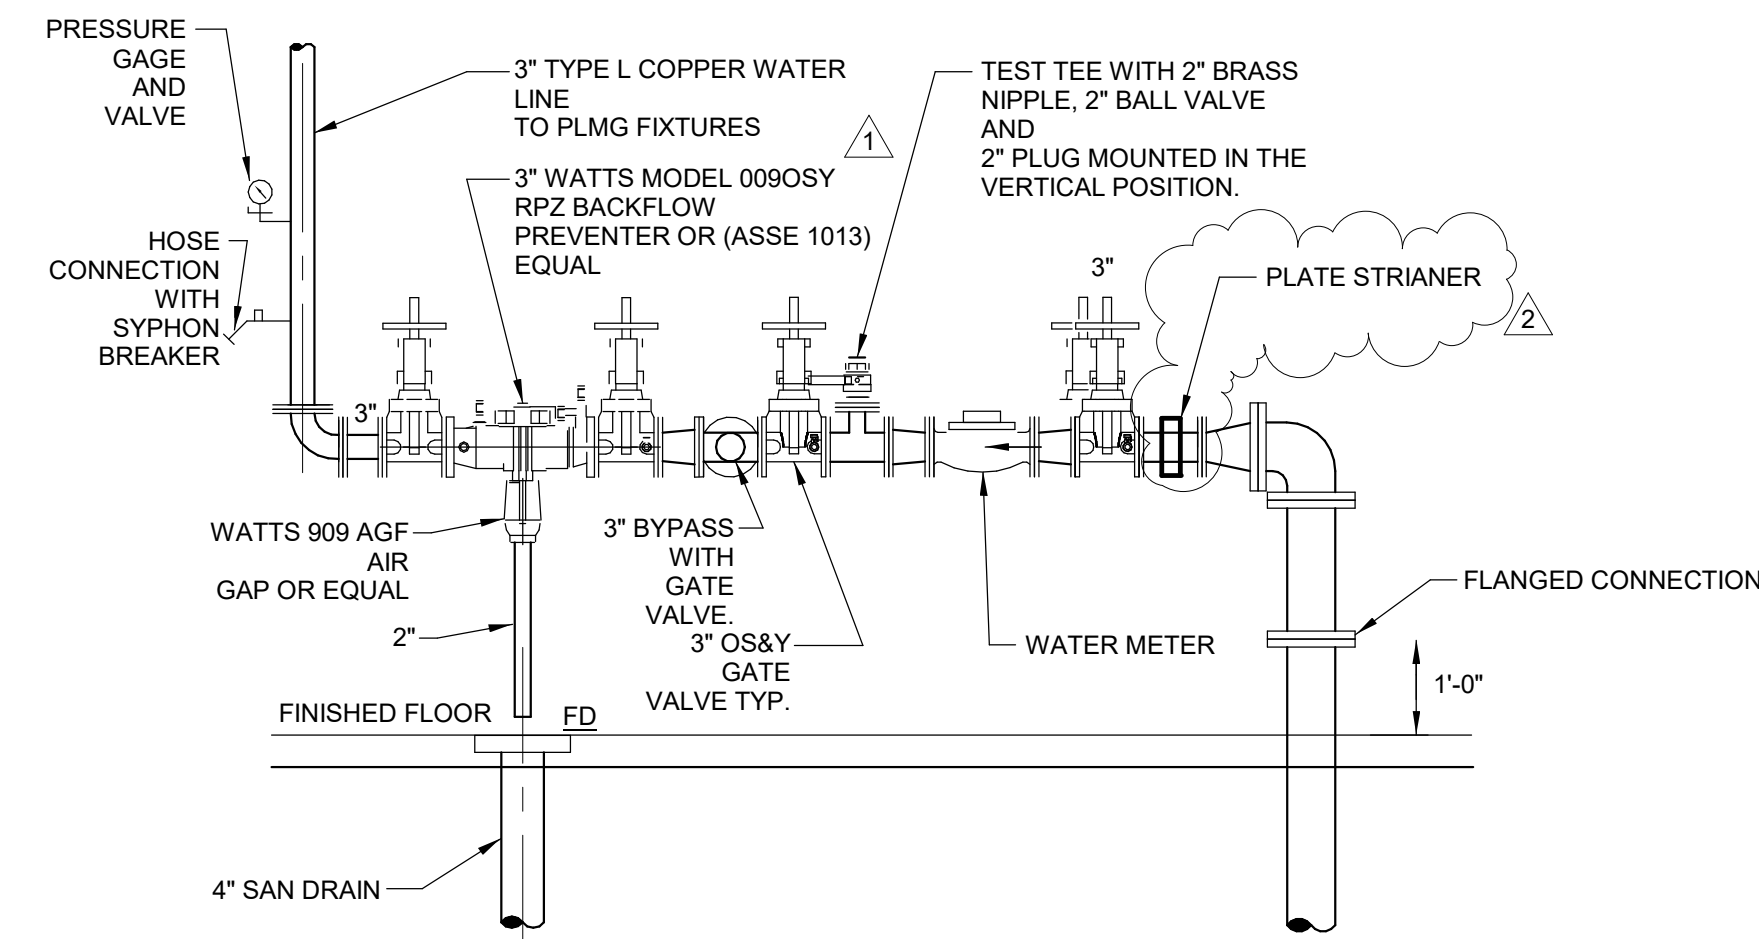


C6 WATER ENTRY
N.T.S.

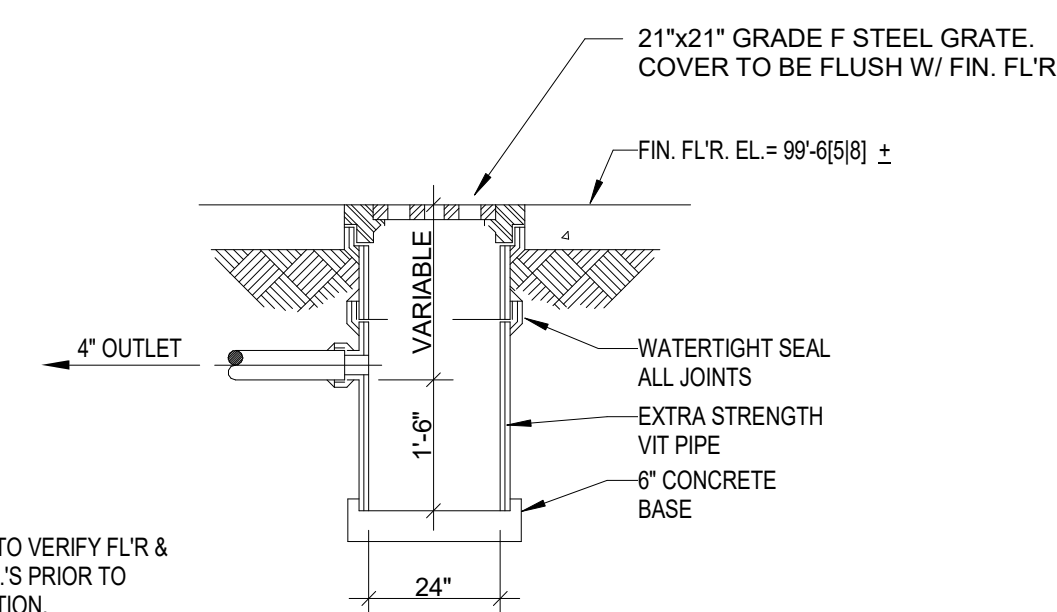


- NOTES:
- CONTR. TO VERIFY FLR & PIPE HW EL'S PRIOR TO CONSTRUCTION.
 - VIT PIPE NOT TO BE EXPOSED AT FLR.
 - SEE PLAN DWG. FOR EXACT PIPE CONNECTION ORIENTATION.


D6 GARAGE CATCH BASIN
N.T.S.

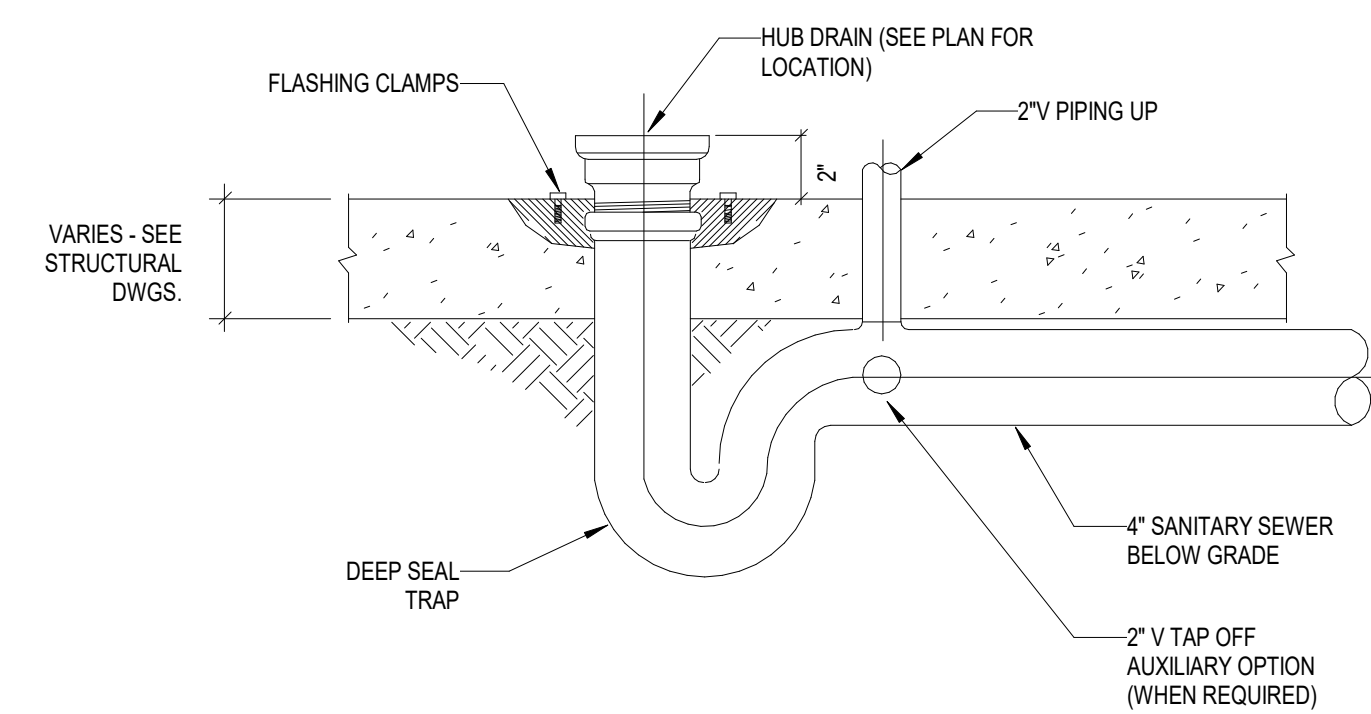

A1 HUB DRAIN
N.T.S.

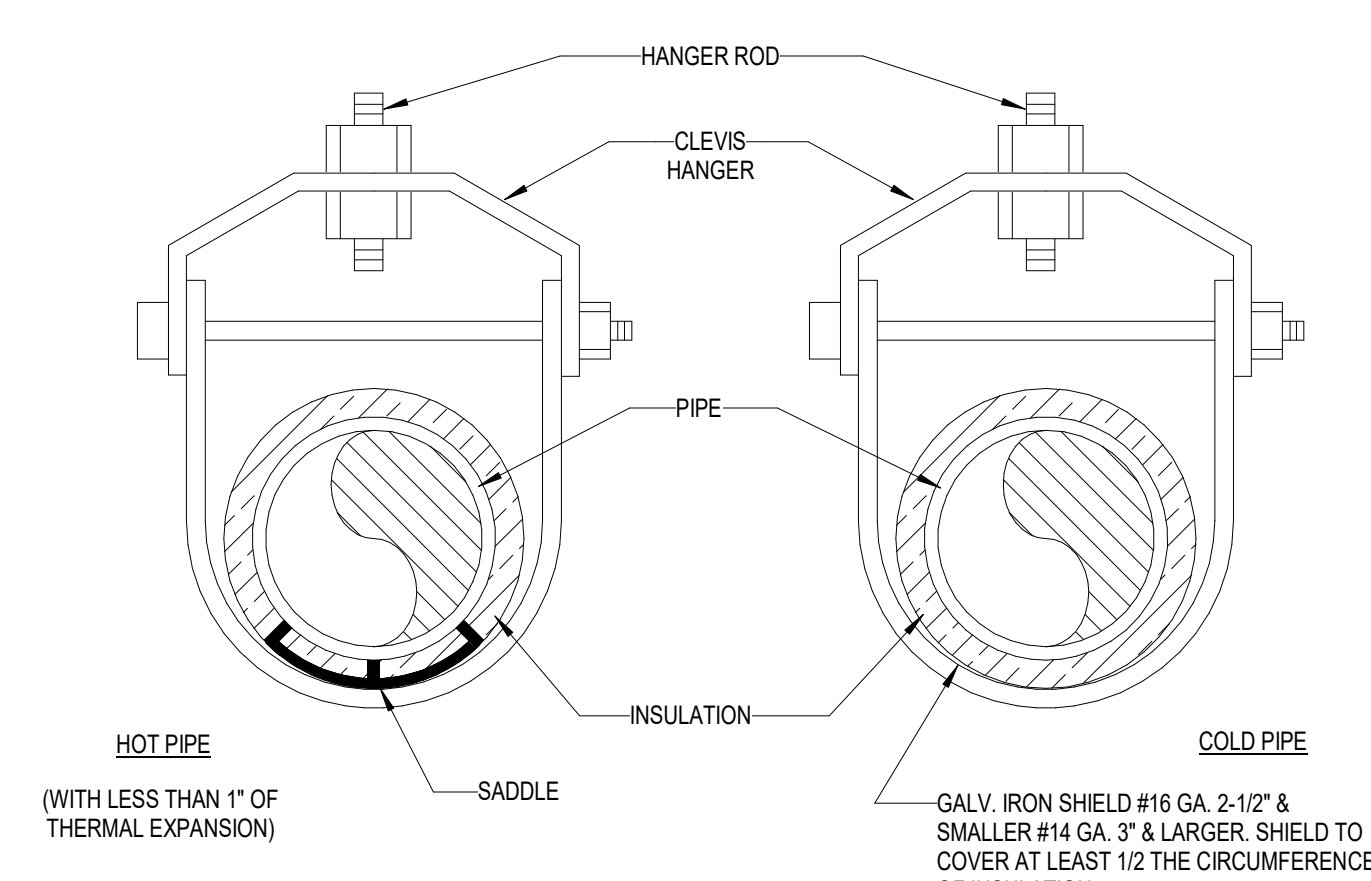

A4 PIPE HANGERS FOR INSULATED PIPES (TYPICAL)
N.T.S.

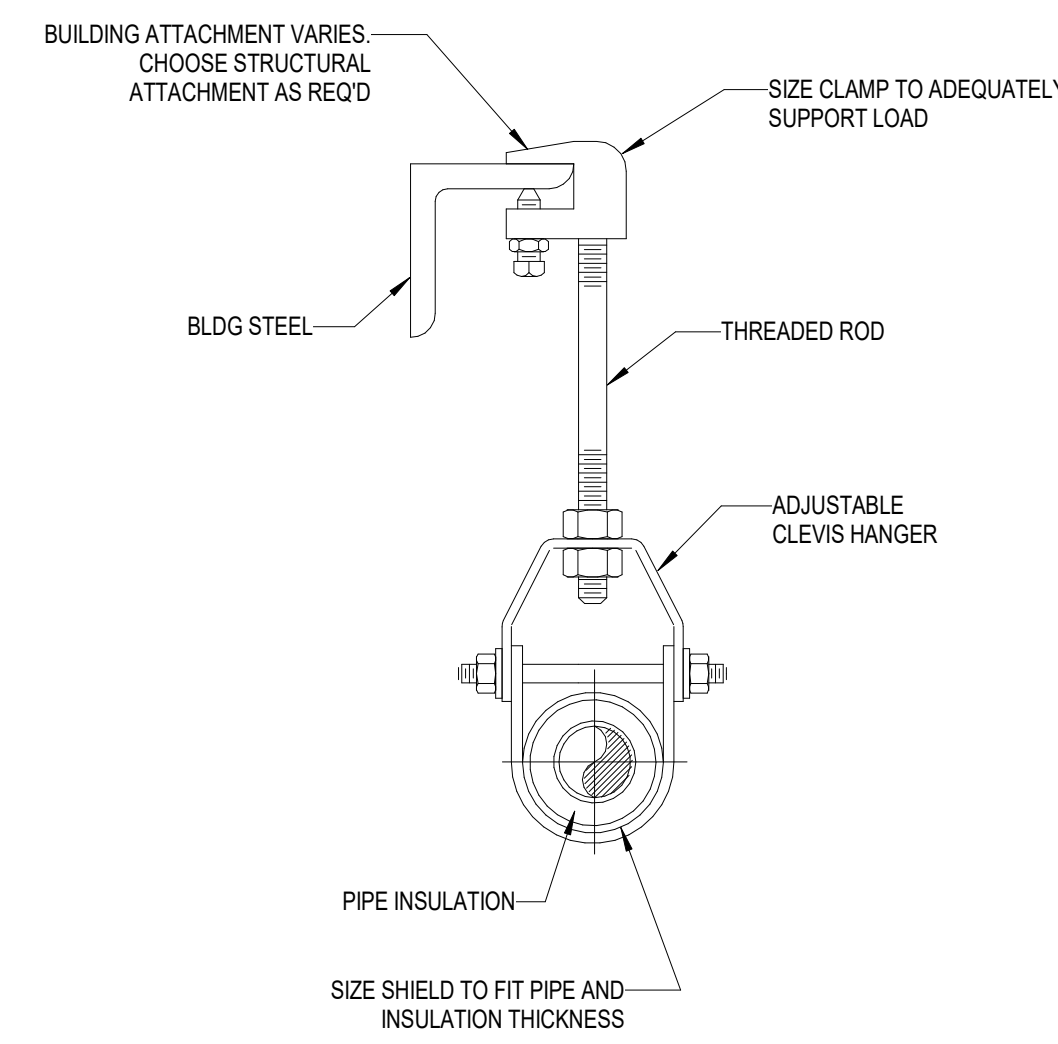

A6 PIPE HANGER DETAIL
N.T.S.

SANITATION BUILDING PROJECT GP1376
2801 REGENT AVE. N.E.
CANTON, OH 44705

PLUMBING DETAILS

DATE:	
PERMIT	02/06/2023
BID	02/06/2023
CONSTRUCTION	---
RECORDED	---
PROJECT MANAGER	DESIGNER
RG	BRF

JOB NO.
2020377.05

P-501

DESCRIPTION
CANTON WATER DEPARTMENT REVISIONS
ADDENDUM 01



DATE
02/15/23
02/02/23

REV
1
2



A2 **GAS SERVICE**
N.T.S.

P-703

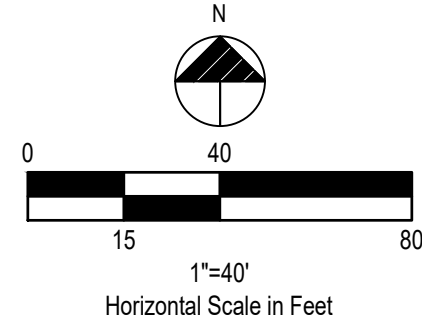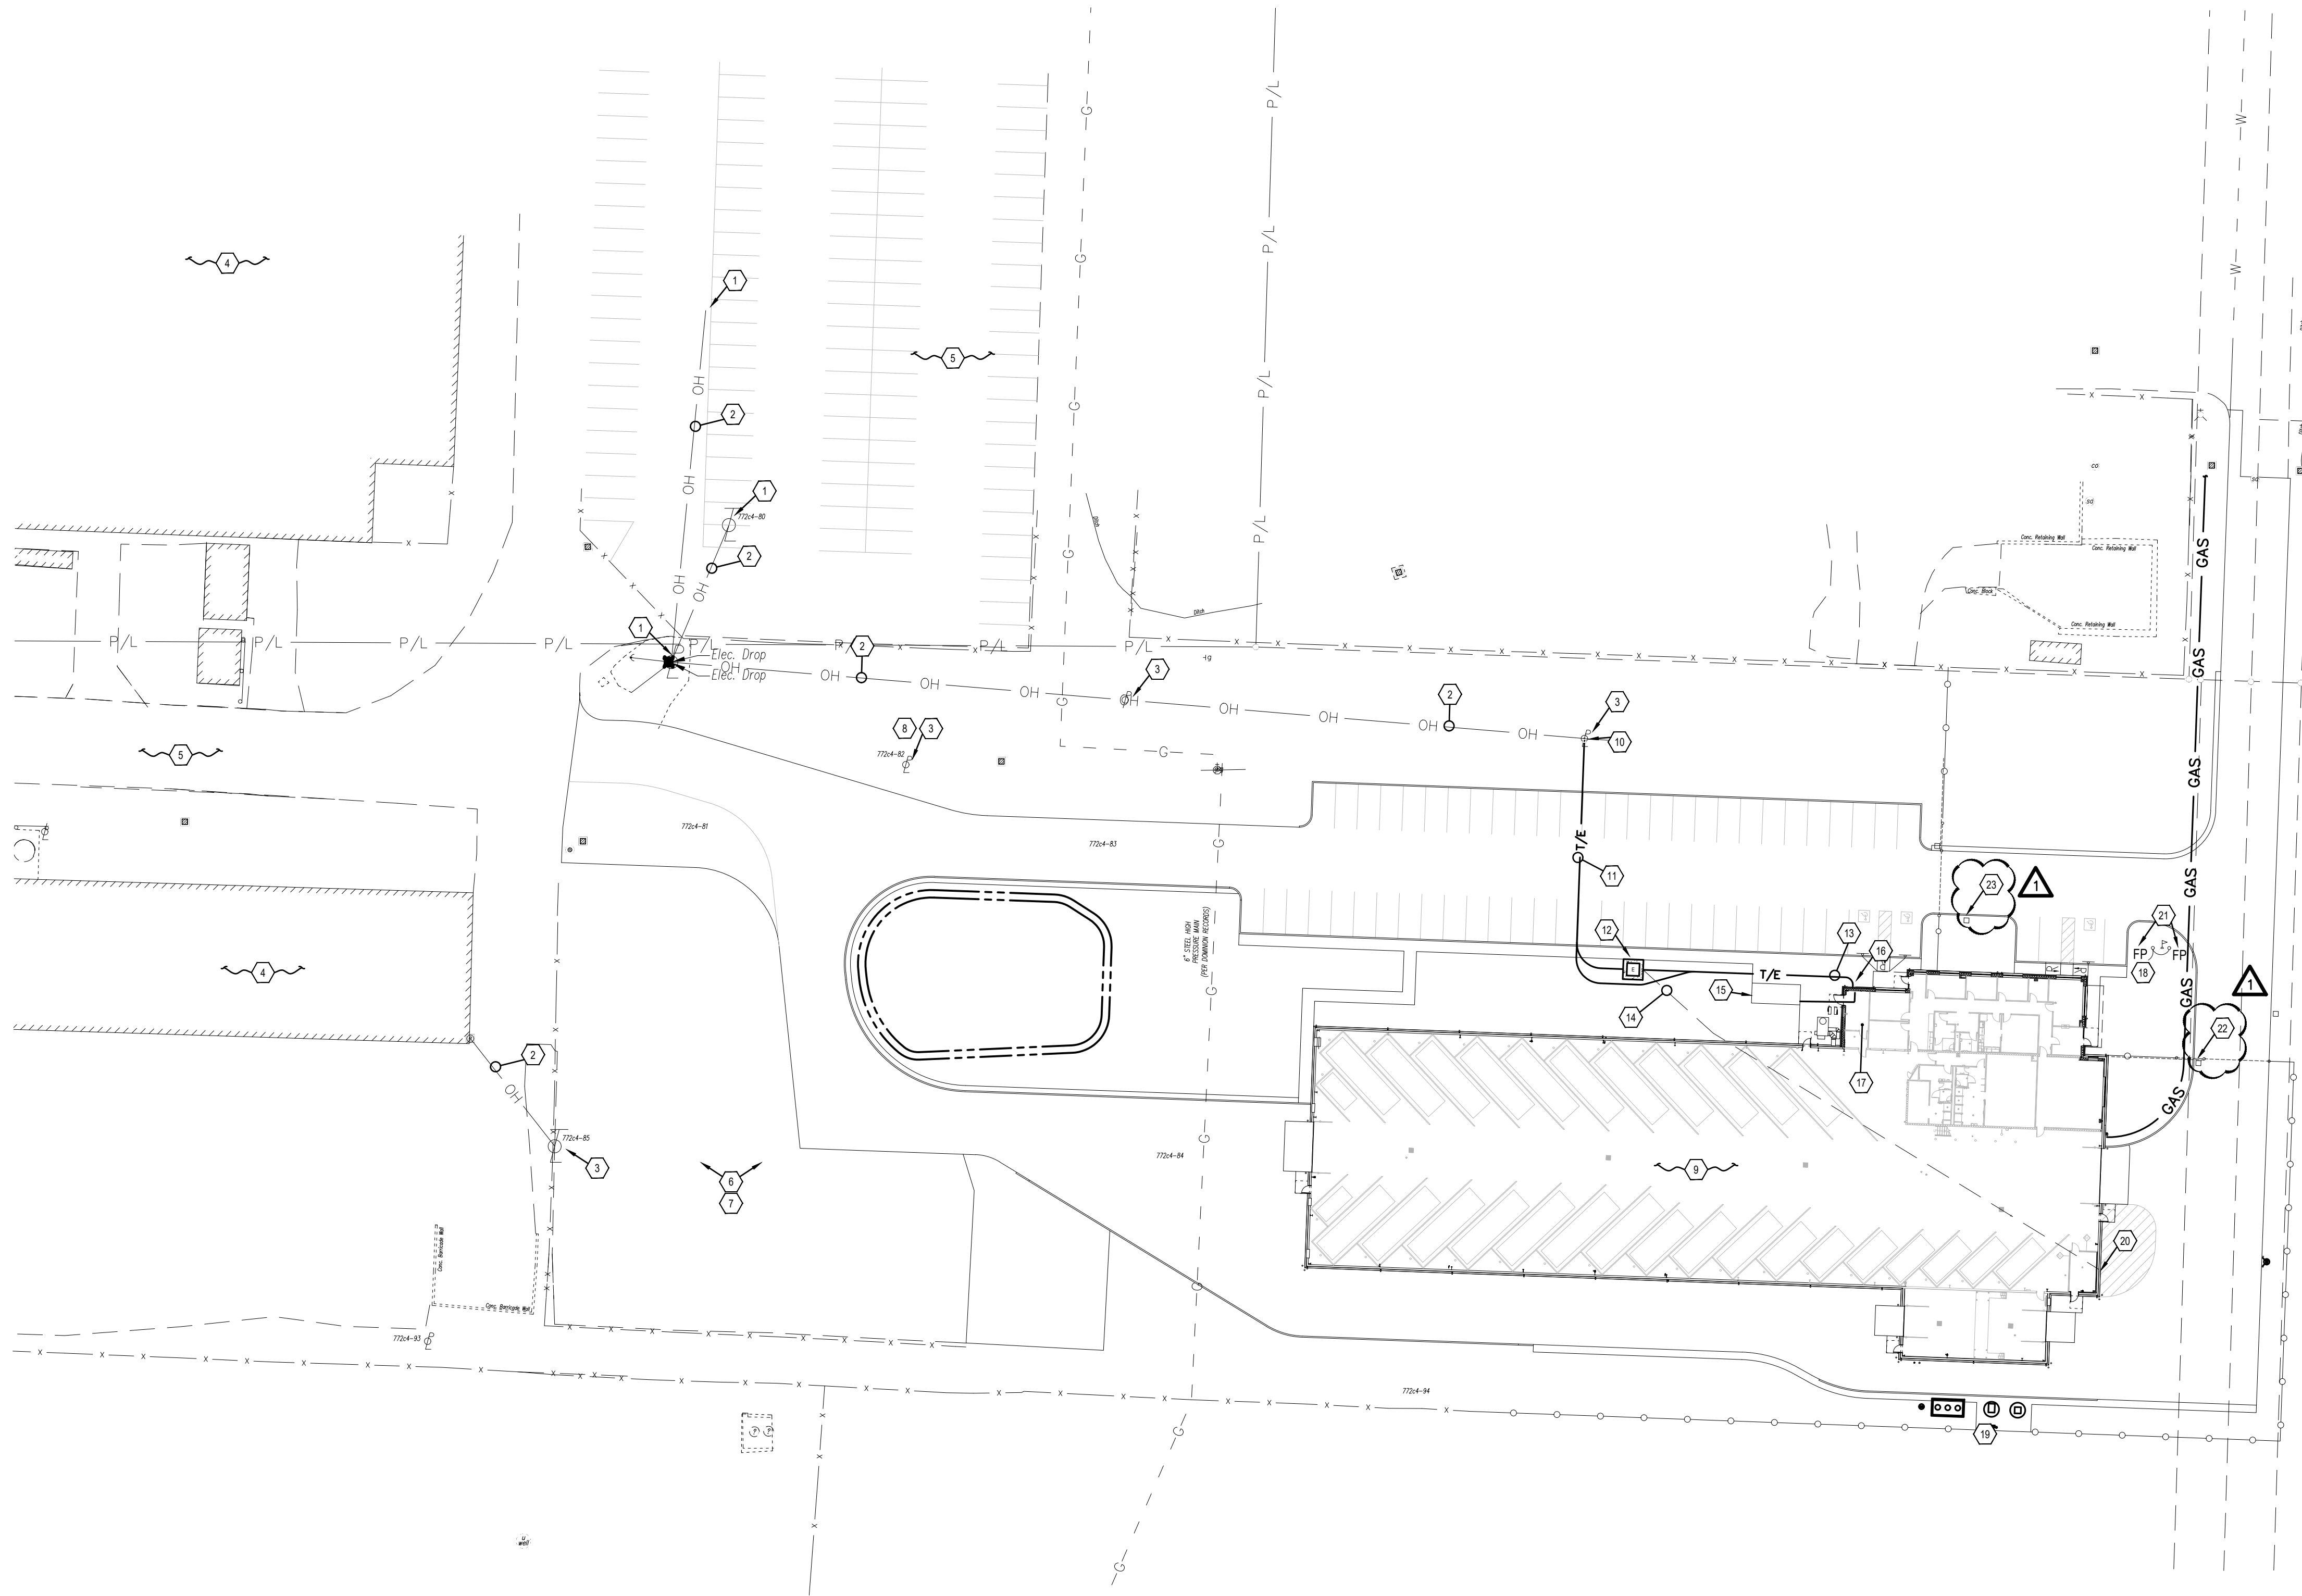

UTILITIES SHOWN ON SURVEY WERE LOCATED
BASED ON FIELD MARKING PROVIDED BY OUPS
REQUEST #A207700537 AND #A207700538.

REGENT AVENUE

GENERAL NOTES

- PHASING - SEE PROJECT MANUAL FOR SPECIFIC PHASING INSTRUCTIONS.
- COORDINATE SHUT-DOWN OF ANY UTILITY IN ADVANCE WITH THE OWNER.
- E.C. SHALL SEAL OPENINGS WATERPROOF OR FIREPROOF TO RATING OF STRUCTURE PENETRATED. FILL ALL OPENINGS WITH MATERIALS AS DIRECTED BY THE ARCHITECT AND FINISH TO MATCH SURROUNDING AREAS. ALL OPENINGS REQUIRED SHALL BE APPROVED BY THE ARCHITECT PRIOR TO DEMOLITION OR CORE DRILLING.
- ALL CONDUIT PENETRATIONS THROUGH FIRE RATED WALLS, FLOORS, OR SHAFTS SHALL BE SEALED IN ACCORDANCE WITH SPECIFICATIONS.
- PROVIDE AN UPDATED, TYPED PANEL BOARD LEGEND FOR EACH AFFECTED PANEL.
- ROUTING OF ALL SURFACE MOUNTED EXPOSED CONDUIT IN UNFINISHED AREAS (OR WHERE NOTED ON THE DRAWINGS) SHALL BE COORDINATED WITH EXISTING CONDITIONS.
- THE PHASE "PROVIDED BY" USED WITHIN THESE DOCUMENTS SHALL EXPLICITLY REPRESENT "FURNISHED AND INSTALLED BY".
- ALL WIRING SHALL BE INSTALLED IN CONDUIT. ALL CONDUIT SHALL BE A MINIMUM OF 3/4".
- ALL CONDUCTORS SHALL BE COPPER.
- CIRCUITS SHALL BE REARRANGED AS REQUIRED TO MAINTAIN THE MOST BALANCED LOADS ON EACH PHASE WITHIN EACH PANEL. E.C. SHALL PROVIDE A TYPED PANEL BOARD SCHEDULE AND INSTALL IT ON INSIDE COVER OF EACH PANEL.
- DRAWINGS ARE DIAGNOSTIC AND INDICATE GENERAL ARRANGEMENT ONLY. COORDINATE INSTALLATION WITH OTHER TRADES TO VERIFY THE ACTUAL SPACE CONDITIONS, HEADROOM, ETC. THAT IS TO BE MAINTAINED. NO ADDITIONAL PAYMENT WILL BE APPROVED FOR FAILURE TO COMPLY.
- WIRE SIZE OF BRANCH CIRCUITS SHALL BE ADJUSTED TO COMPENSATE FOR VOLTAGE DROP BASED UPON ACTUAL CONDUIT ROUTING. E.C. SHALL MAINTAIN VOLTAGE DROP AS RECOMMENDED BY NEC (NOT TO EXCEED 3%).
- ALL WIRING SHALL BE #12 WITH GROUND WIRE UON (INCREASE TO #10 FOR CIRCUITS OVER 15 FT).
- ALL BRANCH CIRCUITS SHALL BE PROVIDED WITH A SEPARATE NEUTRAL CONDUCTOR. NEUTRALS SHALL NOT BE SHARED. PER 2017 NEC 210.4 (B).
- CONTRACTOR TO ROUTE TRENCHING & EXCAVATING TO MINIMIZE DAMAGE TO EXISTING LANDSCAPING.
- CONTRACTOR TO REMOVE EXCESS EXCAVATION MATERIALS FROM SITE.
- EXISTING LIGHTS TO BE OPERATIONAL AT END OF EACH DAY. PROVIDE TEMPORARY PROVISIONS AS REQUIRED.
- AREA IS HEAVY WITH PIPING UTILITIES, ETC. ADJUST DEPTH AND ROUTE OF NEW CONDUIT AND TRENCHING AS REQUIRED TO AVOID CONFLICTS.

CONSTRUCTION KEYNOTES

- UTILITY POLE TO REMAIN.
- OVERHEAD UTILITY LINES TO REMAIN.
- WOODEN POLE WITH FLOOD LIGHT TO REMAIN.
- BUILDING TO REMAIN.
- PAVING TO REMAIN.
- REFER TO DEMO SITE PLAN FOR WORK ON AEP LIGHT POLES.
- SEE CODED NOTE #6 FOR OVERHEAD LINES TO RELOCATED POLES.
- REFEED FLOOD LIGHT.
- PROPOSED NEW BUILDING.
- EXISTING POLE USE AS PROPOSED NEW UNDERGROUND SERVICE DROP LOCATION. COORDINATE WITH POWER COMPANY.
- PROPOSED NEW UNDERGROUND SERVICE LATERAL. COORDINATE WITH POWER COMPANY.
- PROPOSED NEW PADMOUNT WITH TAPS FOR BUILDING SERVICE AND FIRE PUMP. COORDINATE WITH POWER COMPANY.
- PROPOSED NEW BUILDING SERVICE ENTRANCE. REFER TO RISER DIAGRAM.
- PROPOSED NEW FIRE PUMP SERVICE ENTRANCE. REFER TO RISER DIAGRAM.
- PROPOSED GENERATOR. REFER TO RISER DIAGRAM.
- PROPOSED NEW METER/CABINET. REFER TO RISER DIAGRAM.
- PROPOSED MAIN ELECTRICAL ROOM. REFER TO FLOOR PLANS.
- CONNECT TO EXTERIOR WALL PACK LIGHTING CIRCUIT. #12's, 34"C. REFER TO LIGHTING PLANS.
- PUMP STATION (60,000 GPD CAPACITY). REFER TO RISER DIAGRAM.
- PROPOSED NEW FIRE PUMP METER/CABINET. REFER TO RISER DIAGRAM.
- FLAGPOLE LIGHT. REFER TO LIGHT FIXTURE SCHEDULE.
- MOTORIZED GATE (120V/10). 2-#10, 1-#100, 3-#4"C.
- FUTURE MOTORIZED GATE. PROVIDE 1" CONDUIT WITH PULLWIRE TO ELEC ROOM AND CAP.

DESCRIPTION

ADENDUM 01

DATE

03/02/2023

REV

1

SANITATION BUILDING PROJECT - GP 1376
2801 REGENT AVE NE,
CANTON, OHIO 44705


ELECTRICAL SITE PLAN - NEW

ISSUED FOR:	
PERMIT	02/09/2023
BID	02/09/2023
CONSTRUCTION	in progress
RECORD	in progress

PROJECT MANAGER	DESIGNER
MLH	EDC

JOB NO.
2020377.05


ES101

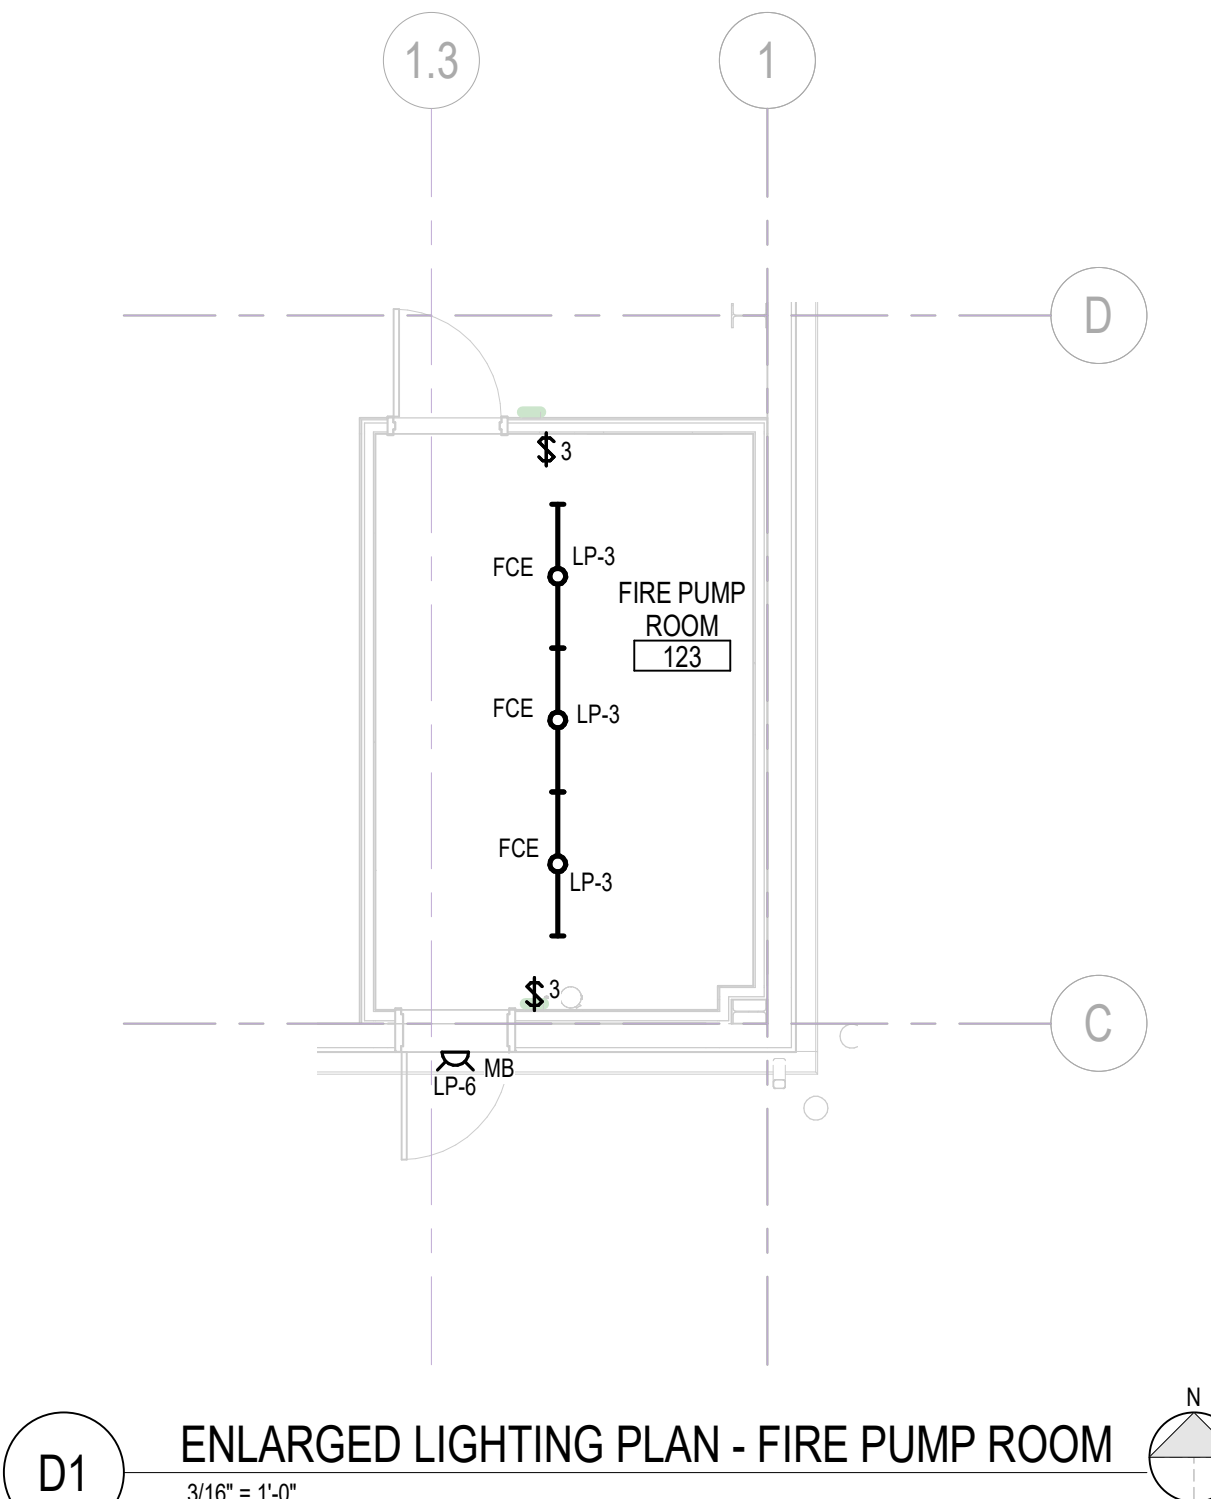

D1 ENLARGED LIGHTING PLAN - FIRE PUMP ROOM
3/16\"/>



C4 ENLARGED LIGHTING - OFFICES
3/16\"/>

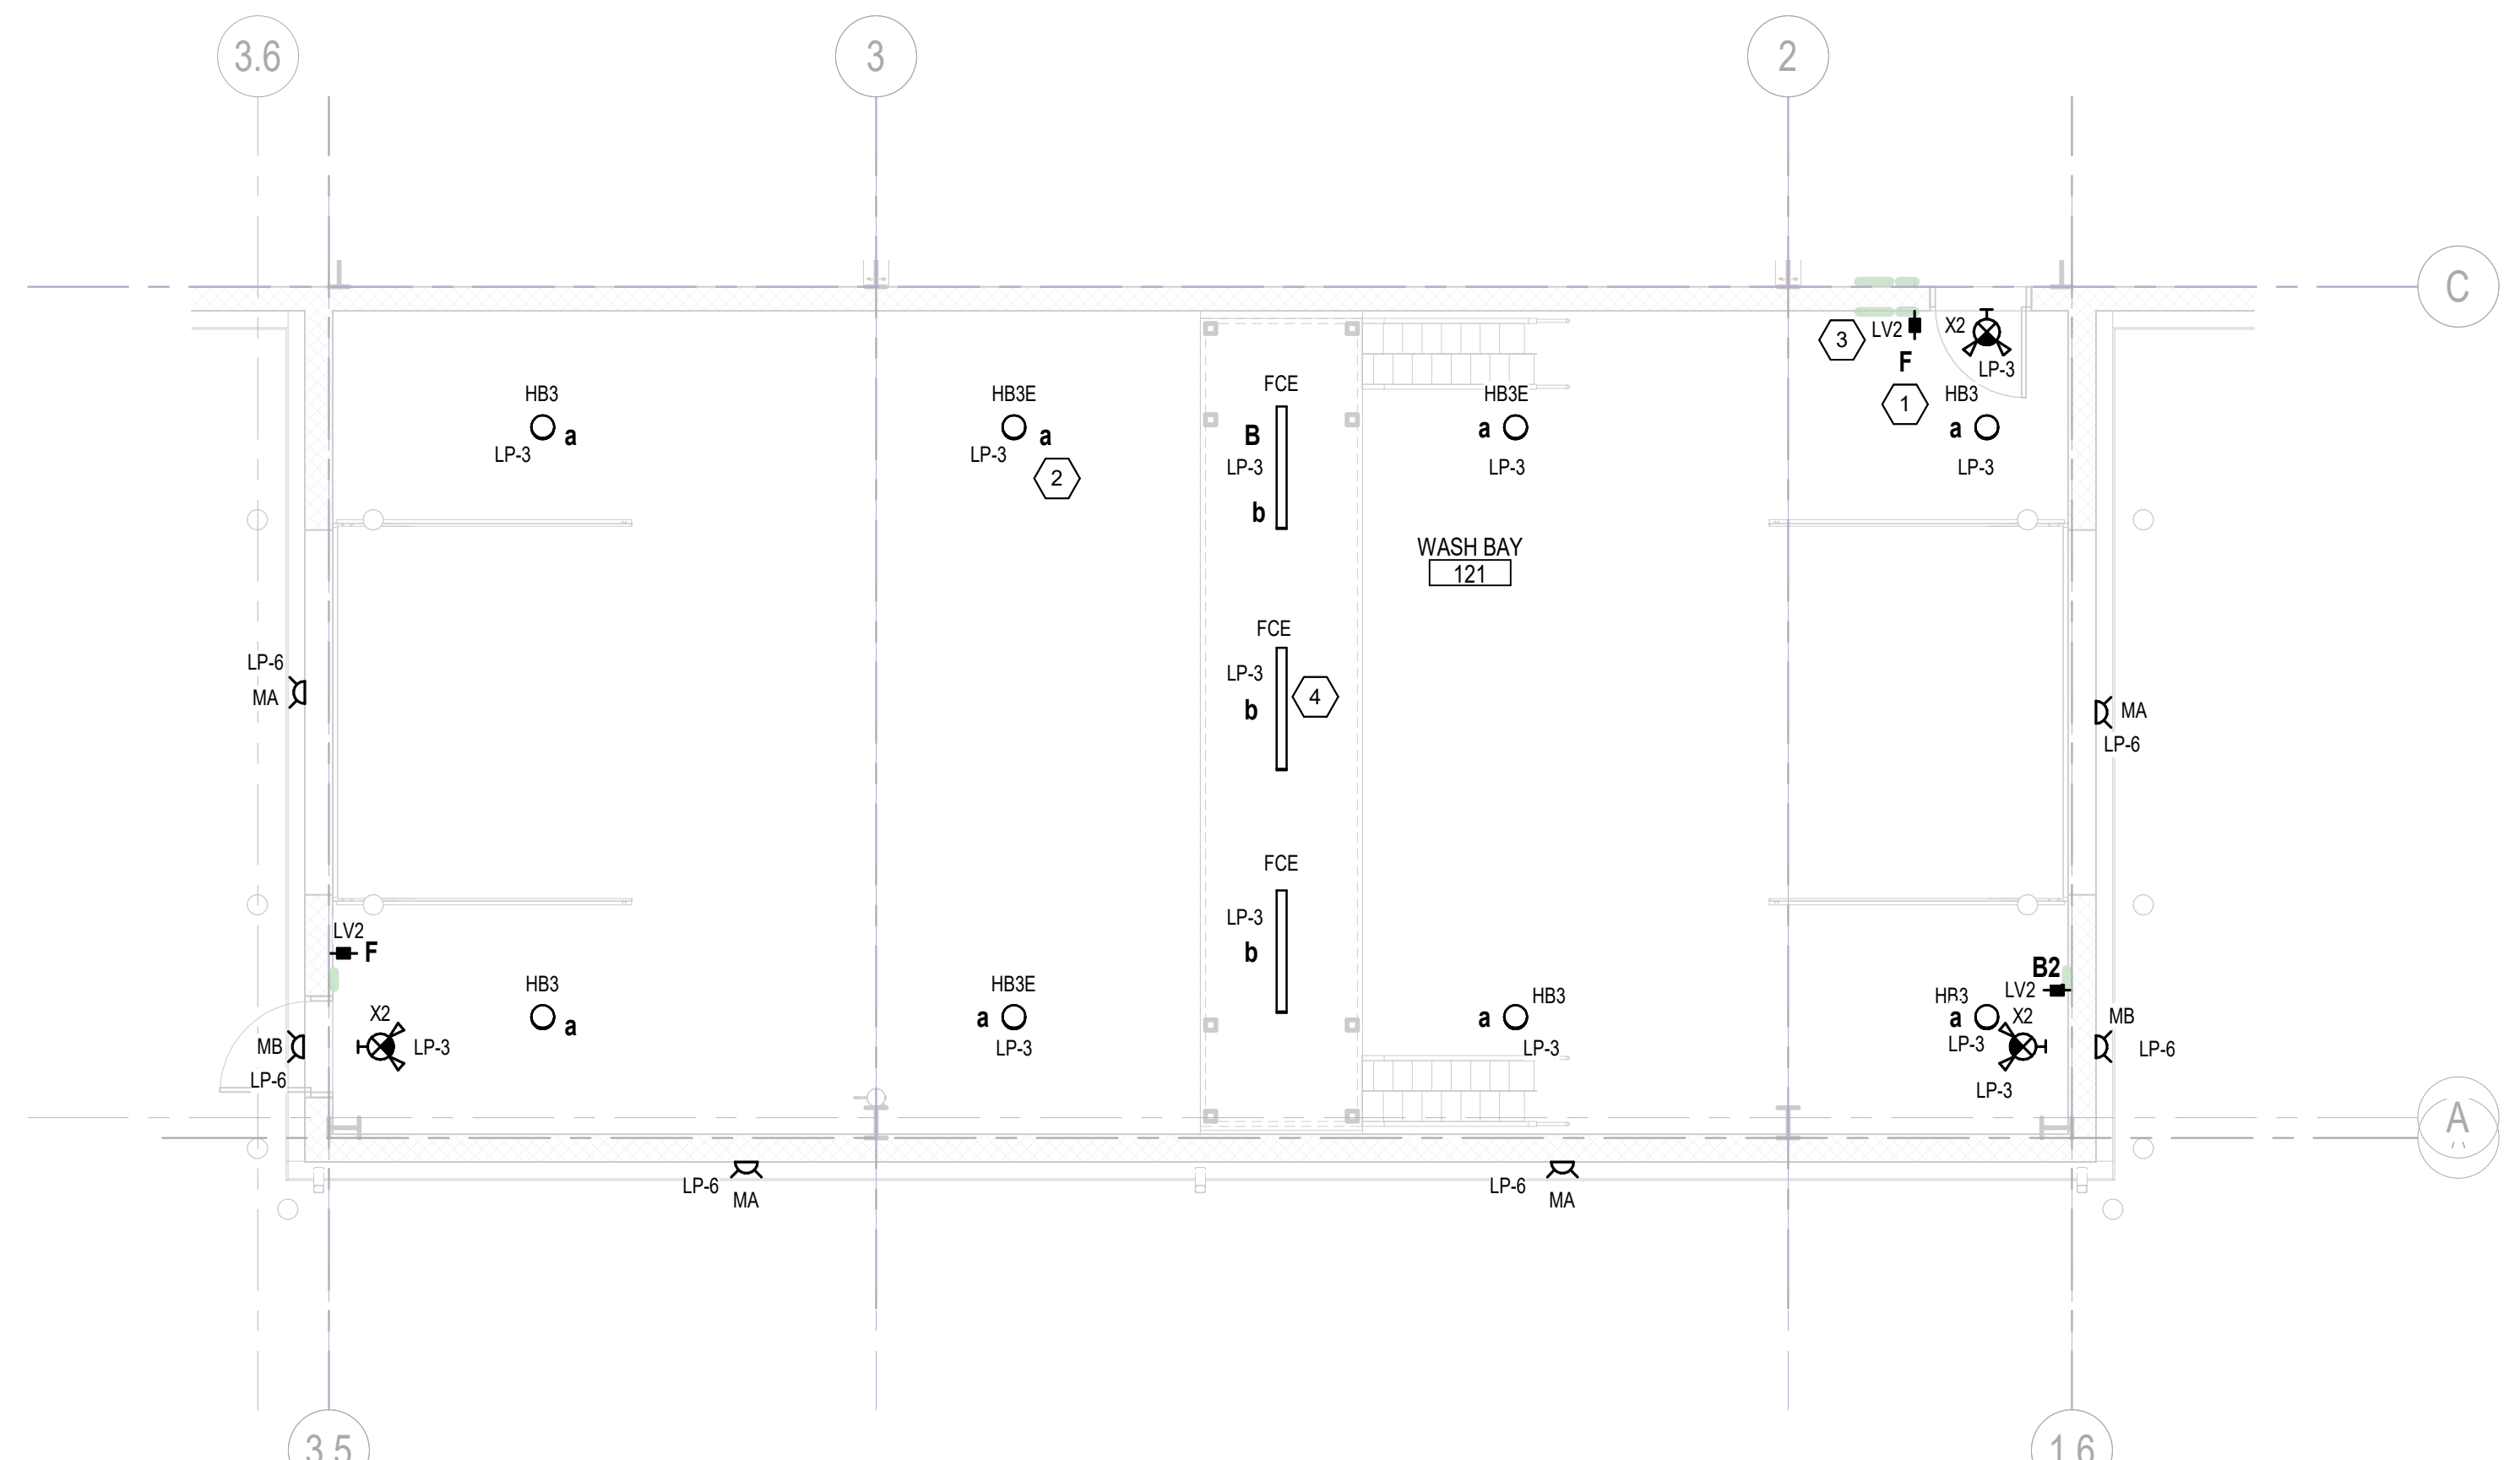

A4 ENLARGED LIGHTING PLAN - WASH BAY
3/16\"/>

INTERIOR LIGHTING CONTROL SCHEME

DESIGNATION	DESCRIPTION
C	ONE ZONE; FULL DIMMING, VACANCY SENSOR, MANUAL ON OPERATION, RECEPTACLE CONTROL.
D	ON/OFF; OCCUPANCY SENSOR WALL SWITCH.
F*	CONNECTED TO OVERALL LIGHTING CONTROL SYSTEM FOR TIME OF DAY OPERATION; PROVIDE SEPARATE CONTROL OF EACH ZONE AND LOCAL DUAL BUTTON FOR ALL 'ON/OFF' CONTROL AT SPACE ENTRIES FOR MANUAL OPERATION/OVERRIDE. F* - (*) INDICATES SEPARATE CONTROL ZONE.
G*	CONNECTED TO OVERALL LIGHTING CONTROL SYSTEM FOR TIME OF DAY OPERATION; PROVIDE SEPARATE CONTROL OF EACH ZONE AND LOCAL SINGLE BUTTON FOR ALL 'ON/OFF' CONTROL AT SPACE ENTRIES FOR MANUAL OPERATION/OVERRIDE. G* - (*) INDICATES SEPARATE CONTROL ZONE.
H	2-ZONES; FULL DIMMING, VACANCY SENSOR, MANUAL ON OPERATION. CONNECTED TO OVERALL LIGHTING CONTROL SYSTEM FOR TIME OF DAY OPERATION; PROVIDE SEPARATE CONTROL OF EACH ZONE AND LOCAL DUAL BUTTON FOR ALL 'ON/OFF' CONTROL AT SPACE ENTRIES FOR MANUAL OPERATION/OVERRIDE. H - (*) INDICATES SEPARATE CONTROL ZONE.

GENERAL NOTES

- PHASING - SEE PROJECT MANUAL FOR SPECIFIC PHASING INSTRUCTIONS. COORDINATE SHUT-DOWN OF ANY UTILITY IN ADVANCE WITH THE OWNER.
- ALL CONDUIT PENETRATIONS THROUGH FIRE RATED WALLS, FLOORS, OR SHAFTS SHALL BE SEALED IN ACCORDANCE WITH SPECIFICATIONS.
- PROVIDE A NEW BLANK COVERPLATE OVER ALL UNUSED BACKBOXES.
- DRAWINGS ARE DIAGRAMATIC AND INDICATE GENERAL ARRANGEMENT ONLY. COORDINATE INSTALLATION WITH OTHER TRADES TO VERIFY THE ACTUAL SPACE CONDITIONS, HEADROOM, ETC. THAT IS TO BE MAINTAINED. NO ADDITIONAL PAYMENT WILL BE APPROVED FOR FAILURE TO COMPLY.
- WIRE ALL EXIT SIGNS AND EMERGENCY BATTERY PACKS AHEAD OF LOCAL SWITCHING.

PLAN KEYNOTES

- UPPER CASE LETTER DENOTES CONTROL SCHEME, TYP. REFER TO INTERIOR LIGHTING CONTROL SCHEME.
- LOWER CASE LETTER DENOTES SWITCHING ZONE WITHIN SPECIFIC ROOM. TYP.
- OVERRIDE SWITCH. NUMBER INDICATES QTY OF BUTTONS FOR MANUAL OPERATION. TYP.
- FIGURE PROVIDED WITH EMERGENCY BATTERY DRIVER. CONNECT AHEAD OF LOCAL SWITCHING. TYP.
- LIGHTING ZONE TOUCH PAD.
- TIME OF DAY MODULE.
- LIGHTING CONTROL PANEL.
- LIGHTING MOUNTED UNDER STAIR LANDING. CONTROL WITH GARAGE ZONE 1.
- CONTROL WITH GARAGE ZONE 2.

DESCRIPTION	ADDENDUM 01
DATE	3/2/2023
REV	1



SANITATION BUILDING PROJECT GP1376
2801 REGENT AVE. N.E.
CANTON, OH 44705

ENLARGED LIGHTING PLANS - OFFICES, WASH BAY, FIRE PUMP ROOM

PERMIT	DATE:
BID	02/06/2023
CONSTRUCTION	---
RECORDED	---
PROJECT MANAGER	DESIGNER
RG	DC

JOB NO.
2020377.05

E-102

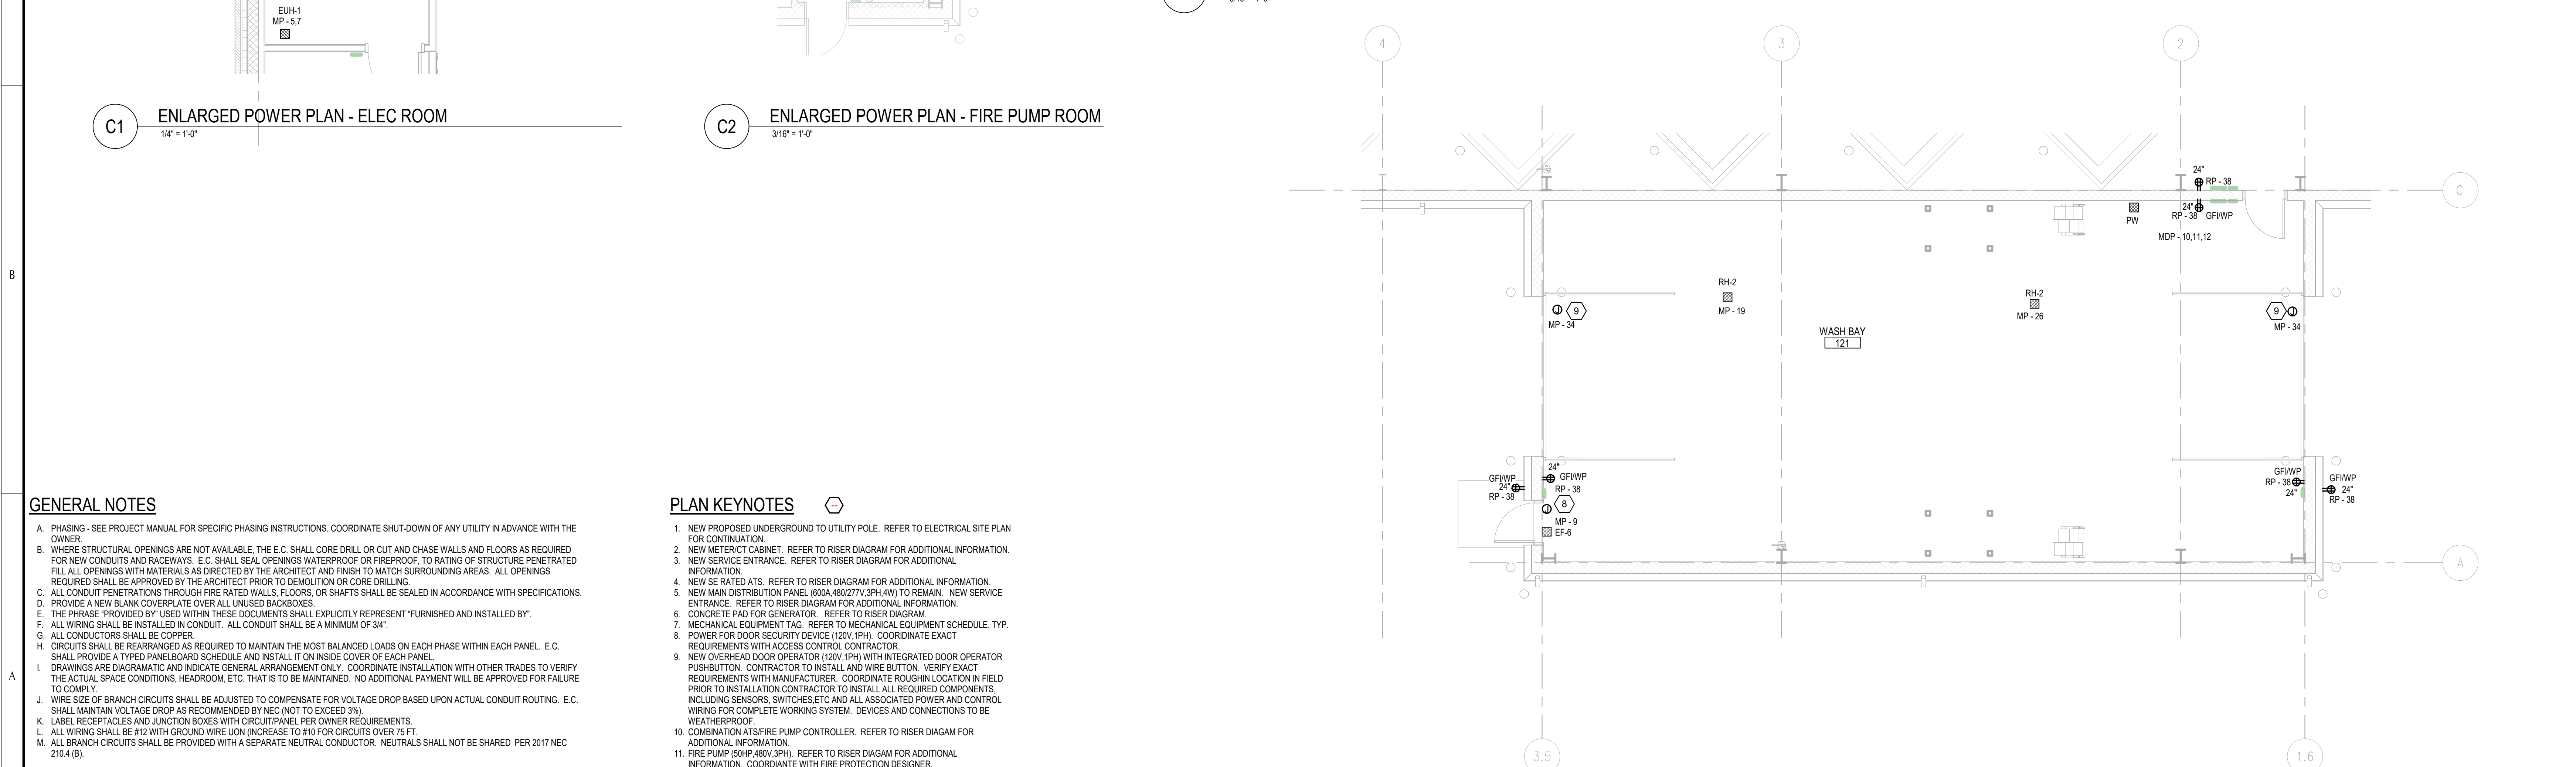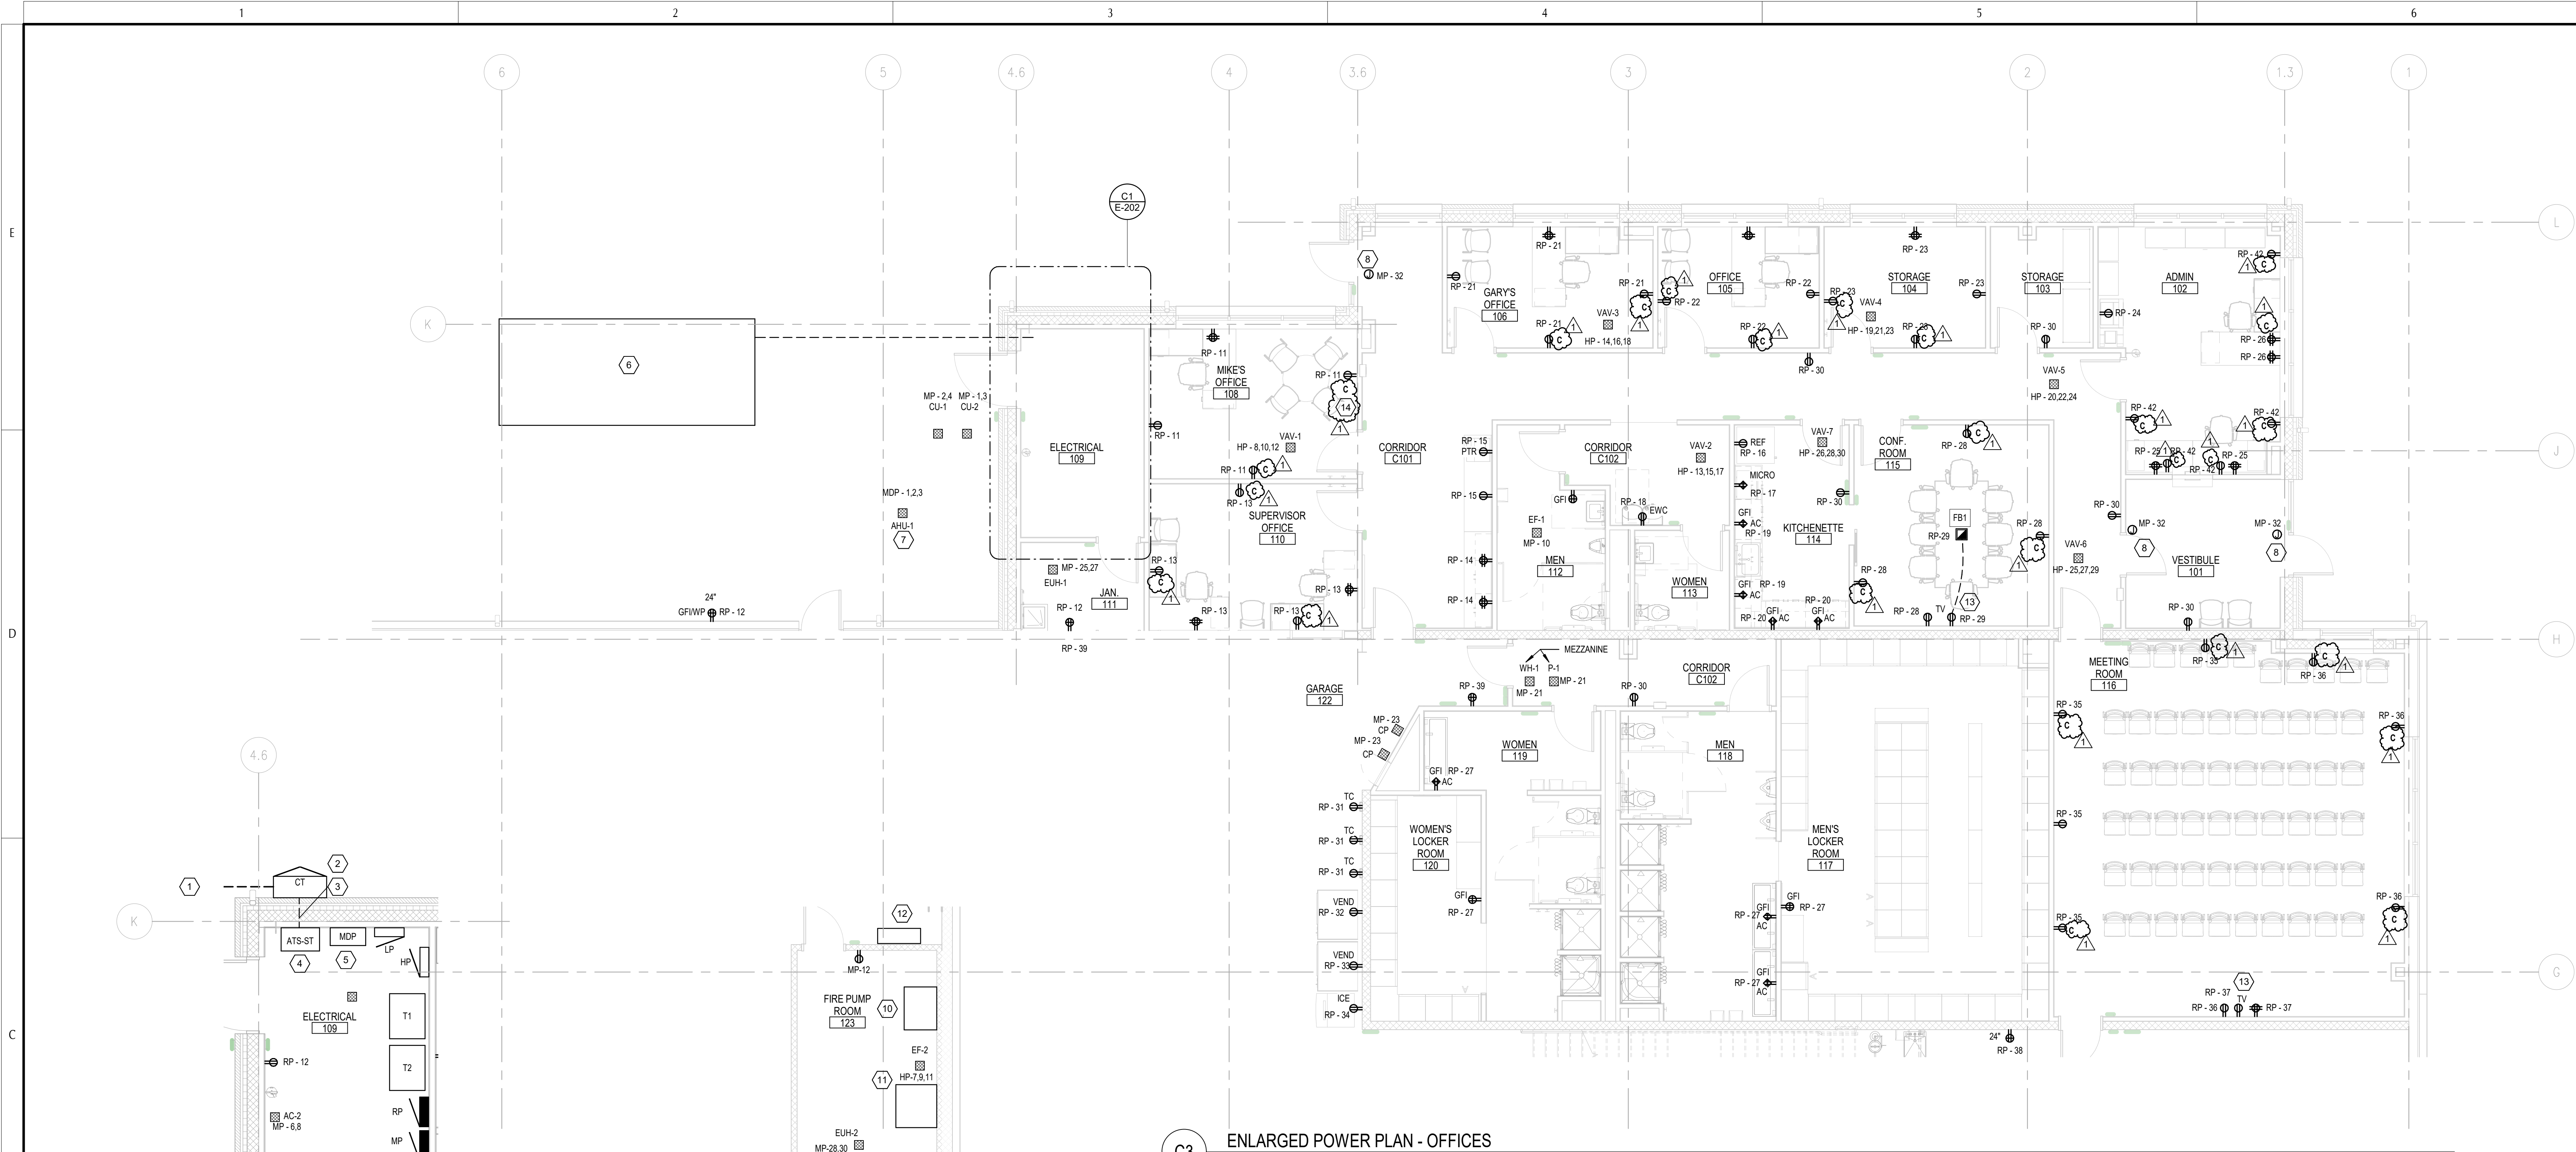

- GENERAL NOTES**
- A. PHASING - SEE PROJECT MANUAL FOR SPECIFIC PHASING INSTRUCTIONS. COORDINATE SHUT-DOWN OF ANY UTILITY IN ADVANCE WITH THE OWNER.
- B. WHERE STRUCTURAL OPENINGS ARE NOT AVAILABLE, THE E.C. SHALL CORE DRILL OR CUT AND CHASE WALLS AND FLOORS AS REQUIRED FOR NEW CONDUITS AND RACEWAYS. E.C. SHALL SEAL OPENINGS WATERPROOF OR FIREPROOF, TO RATING OF STRUCTURE PENETRATED. FILL ALL OPENINGS WITH MATERIALS AS DIRECTED BY THE ARCHITECT AND FINISH TO MATCH SURROUNDING AREAS. ALL OPENINGS REQUIRED SHALL BE APPROVED BY THE ARCHITECT PRIOR TO DEMOLITION OR CORE DRILLING.
- C. ALL CONDUIT PENETRATIONS THROUGH FIRE RATED WALLS, FLOORS, OR SHAFTS SHALL BE SEALED IN ACCORDANCE WITH SPECIFICATIONS.
- D. PROVIDE A NEW BLANK COVERPLATE OVER ALL UNUSED BACKBOXES.
- E. THE PHRASE "PROVIDED" BY USED WITHIN THESE DOCUMENTS SHALL EXPLICITLY REPRESENT "FURNISHED AND INSTALLED BY".
- F. ALL WIRING SHALL BE INSTALLED IN CONDUIT. ALL CONDUIT SHALL BE A MINIMUM OF 3/4".
- G. ALL CONDUCTORS SHALL BE COPPER.
- H. CIRCUITS SHALL BE REARRANGED AS REQUIRED TO MAINTAIN THE MOST BALANCED LOADS ON EACH PHASE WITHIN EACH PANEL. E.C. SHALL PROVIDE A TYPED PANELBOARD SCHEDULE AND INSTALL IT ON INSIDE COVER OF EACH PANEL.
- I. DRAWINGS ARE DIAGRAMATIC AND INDICATE GENERAL ARRANGEMENT ONLY. COORDINATE INSTALLATION WITH OTHER TRADES TO VERIFY THE ACTUAL SPACE CONDITIONS, HEADROOM, ETC. THAT IS TO BE MAINTAINED. NO ADDITIONAL PAYMENT WILL BE APPROVED FOR FAILURE TO COMPLY.
- J. WIRE SIZE OF BRANCH CIRCUITS SHALL BE ADJUSTED TO COMPENSATE FOR VOLTAGE DROP BASED UPON ACTUAL CONDUIT ROUTING. E.C. SHALL MAINTAIN VOLTAGE DROP AS RECOMMENDED BY NEC (NOT TO EXCEED 3%).
- K. LABEL RECEPTACLES AND JUNCTION BOXES WITH CIRCUIT/PANEL PER OWNER REQUIREMENTS.
- L. ALL WIRING SHALL BE #12 WITH GROUND WIRE UN (INCREASE TO #10 FOR CIRCUITS OVER 75 FT.
- M. ALL BRANCH CIRCUITS SHALL BE PROVIDED WITH A SEPARATE NEUTRAL CONDUCTOR. NEUTRALS SHALL NOT BE SHARED PER 2017 NEC 210.4(B).
- PLAN KEYNOTES**
1. NEW PROPOSED UNDERGROUND TO UTILITY POLE. REFER TO ELECTRICAL SITE PLAN FOR CONTINUATION.
2. NEW METER/CT CABINET. REFER TO RISER DIAGRAM FOR ADDITIONAL INFORMATION.
3. NEW SERVICE ENTRANCE. REFER TO RISER DIAGRAM FOR ADDITIONAL INFORMATION.
4. NEW SE RATED ATS. REFER TO RISER DIAGRAM FOR ADDITIONAL INFORMATION.
5. NEW MAIN DISTRIBUTION PANEL (800A, 480/277V, 3PH, 4W) TO REMAIN. NEW SERVICE ENTRANCE. REFER TO RISER DIAGRAM FOR ADDITIONAL INFORMATION.
6. CONCRETE PAD FOR GENERATOR. REFER TO RISER DIAGRAM.
7. MECHANICAL EQUIPMENT TAG. REFER TO MECHANICAL EQUIPMENT SCHEDULE, TYP.
8. POWER FOR DOOR SECURITY DEVICE (120V, 1PH). COORDINATE EXACT REQUIREMENTS WITH ACCESS CONTROL CONTRACTOR.
9. NEW OVERHEAD DOOR OPERATOR (120V, 1PH) WITH INTEGRATED DOOR OPERATOR PUSHBUTTON. CONTRACTOR TO INSTALL AND WIRE BUTTON. VERIFY EXACT REQUIREMENTS WITH MANUFACTURER. COORDINATE ROUGH-IN LOCATION IN FIELD PRIOR TO INSTALLATION CONTRACTOR TO INSTALL ALL REQUIRED COMPONENTS, INCLUDING SENSORS, SWITCHES ETC AND ALL ASSOCIATED POWER AND CONTROL WIRING FOR COMPLETE WORKING SYSTEM. DEVICES AND CONNECTIONS TO BE WEATHERPROOF.
10. COMBINATION ATS/FIRE PUMP CONTROLLER. REFER TO RISER DIAGRAM FOR ADDITIONAL INFORMATION.
11. FIRE PUMP (50HP, 480V, 3PH). REFER TO RISER DIAGRAM FOR ADDITIONAL INFORMATION. COORDINATE WITH FIRE PROTECTION DESIGNER.
12. BOOSTER PUMP WITH CONTROL PANEL. REFER TO RISER DIAGRAM FOR ADDITIONAL INFORMATION. COORDINATE WITH FIRE PROTECTION DESIGNER.
13. COORDINATE OUTLET HEIGHT WITH TV MOUNTING HEIGHT. MATCH TV CONNECTOR HEIGHT TO OUTLET HEIGHT.
14. LETTER DENOTES CONTROL ZONE. ASSOCIATED WITH LIGHTING CONTROL CIRCUIT FOR AUTOMATIC RECEPTACLE CONTROL. FOR ENERGY CODE COMPLIANCE. TYP. PROVIDE LABEL ON RECEPTACLE PLATE NOTING RECEPTACLE IS AUTOMATICALLY CONTROLLED.

DESCRIPTION	
ADDENDUM 01	
DATE	3/2/2023
REV	1


SANITATION BUILDING PROJECT GP1376
2801 REGENT AVE. N.E.
CANTON, OH 44705

ENLARGED POWER PLAN - OFFICES

DATE:	
PERMIT	02/06/2023
BID	02/06/2023
CONSTRUCTION	---
RECORDED	---
PROJECT MANAGER	DESIGNER
RG	DC

JOB NO.
2020377.05

E-202

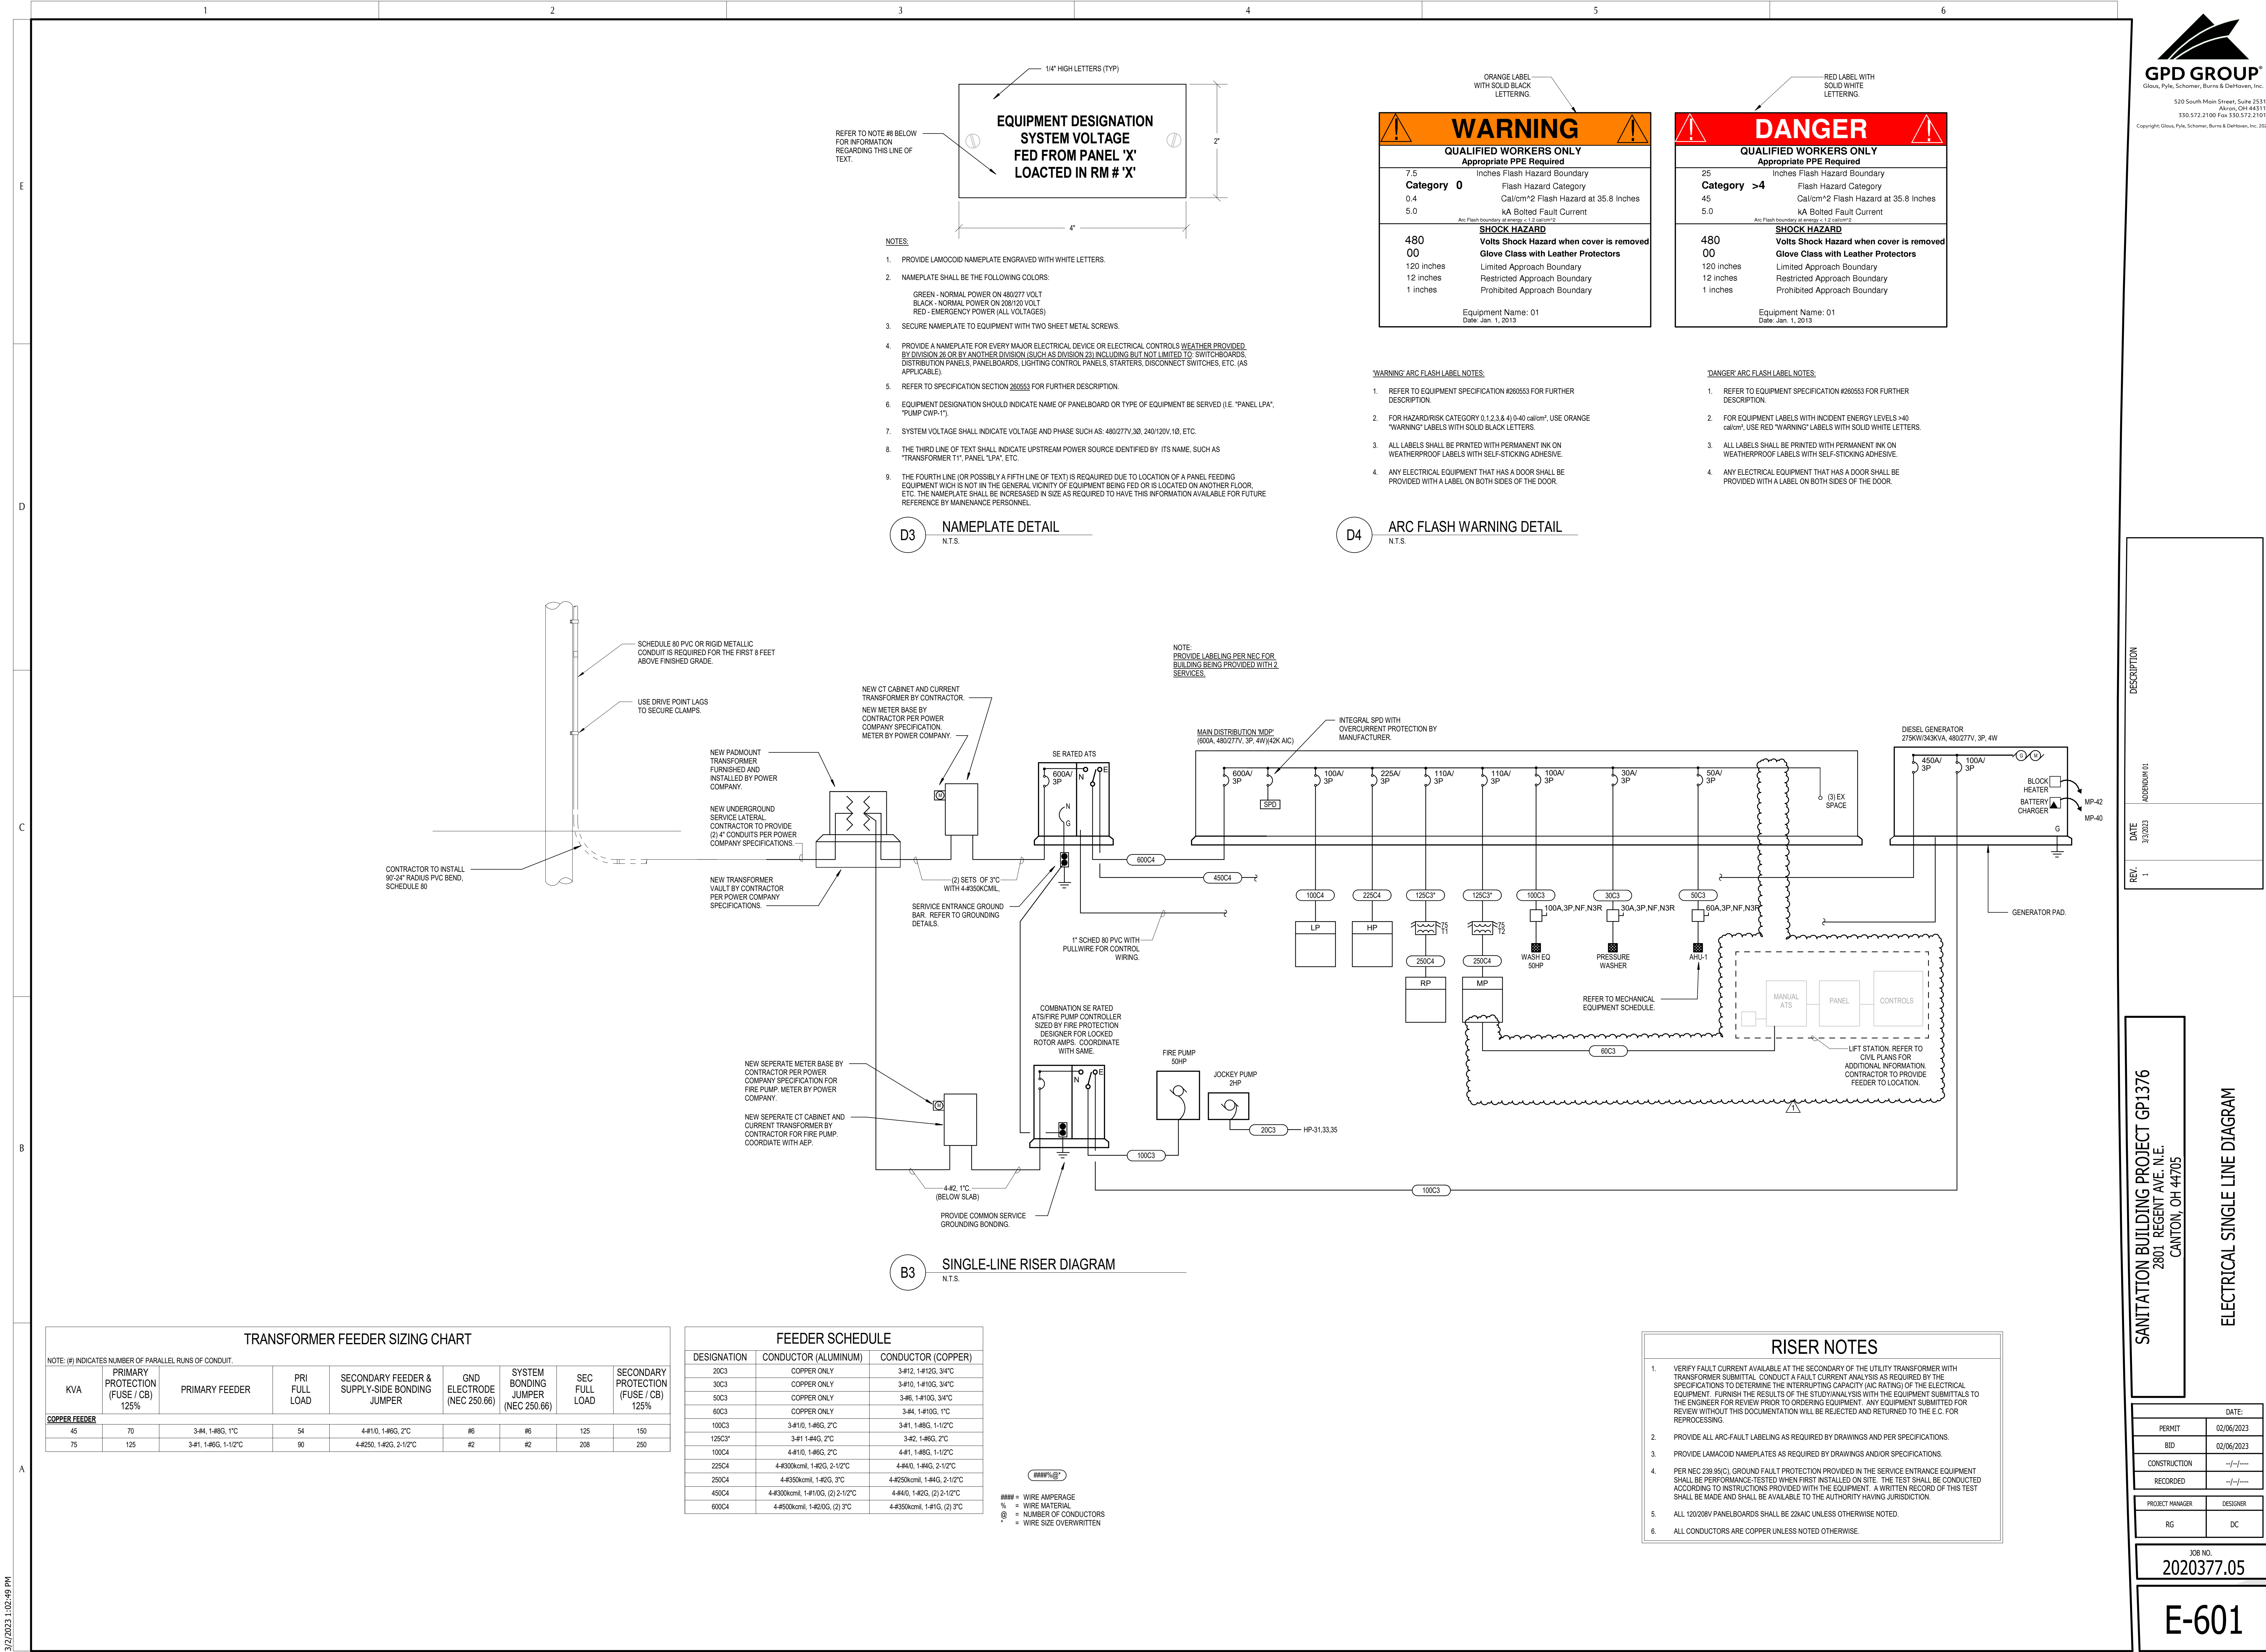

GPD GROUP
Glaus, Pyle, Schomer, Burns & DeHoven, Inc.
520 South Main Street, Suite 2531
Akron, OH 44311
330.572.2100 Fax 330.572.2101
Copyright: Glaus, Pyle, Schomer, Burns & DeHoven, Inc. 2023

DESCRIPTION
A00000101

DATE
3/2/2023

REV
1

SANITATION BUILDING PROJECT GP1376
2801 REGENT AVE. N.E.
CANTON, OH 44705

ELECTRICAL SINGLE LINE DIAGRAM

DATE:
02/06/2023

PERMIT
02/06/2023

BID
02/06/2023

CONSTRUCTION
02/06/2023

RECORDED
02/06/2023

PROJECT MANAGER
RG

DESIGNER
DC

JOB NO.
2020377.05

E-601

DIST. PANEL: MDP						A.I.C. RATING: 42 KAIC				
LOCATION: ELECTRICAL 109						VOLTS: 480/277 Wye				
SUPPLY FROM:						PHASES: 3				
MOUNTING: SURFACE						WIRES: 4				
ENCLOSURE: N1						MAINS TYPE: MCB				
						MAINS RATING: 600 A				
						MCB RATING: 600 A				
CKT	CIRCUIT DESCRIPTION					TRIP	POLES	A	B	C
1								11080 VA		
2	AHU-1					50 A	3		11080 VA	
3										11080 VA
4								10440 VA		
5	T1, 120 V/208 V, Three Phase, 4 Wires, Wye					110 A	3		13360 VA	
6										10060 VA
7								24644 VA		
8	T2, 120 V/208 V, Three Phase, 4 Wires, Wye					110 A	3		23268 VA	
9										22556 VA
10								5540 VA		
11	PRESSURE WASHER					30 A	3		5540 VA	
12										5540 VA
13								18005 VA		
14	WASH EQUIPMENT					100 A	3		18005 VA	
15										18005 VA
16								46010 VA		
17	HP					225 A	3		17760 VA	
18										17760 VA
19								7951 VA		
20	LP					100 A	3		7816 VA	
21										2658 VA
22	SPACE					--	--	0 VA		
23	SPACE					--	--		0 VA	
24	SPACE					--	--			0 VA
25	SPACE					--	--	0 VA		
26	SPACE					--	--		0 VA	
27	SPACE					--	--			0 VA
28	SPACE					--	--	0 VA		
29	SPACE					--	--		0 VA	
30	SPACE					--	--			0 VA
31	SPACE					--	--	0 VA		
32	SPACE					--	--		0 VA	
33	SPACE					--	--			0 VA
34	SPACE					--	--	0 VA		
35	SPACE					--	--		0 VA	
36	SPACE					--	--			0 VA
37	SPACE					--	--	0 VA		
38	SPACE					--	--		0 VA	
39	SPACE					--	--			0 VA
40	SPACE					--	--	0 VA		
41	SPACE					--	--		0 VA	
42	SPACE					--	--			0 VA
						TOTAL LOAD:		123670 VA	96828 VA	
						TOTAL AMPS:		451 A	354 A	322 A
LOAD CLASSIFICATION						CONNECTED LOAD	DEMAND FACTOR	ESTIMATED DEMAND	PANEL TOTALS	
HVAC						68527 VA	100.00%	68527 VA		
Lighting						20025 VA	100.00%	20025 VA	TOTAL CONN. LOAD: 309757 VA	
Power						32990 VA	100.00%	32990 VA	TOTAL DEMAND LOAD: 297827 VA	
Receptacle						33860 VA	64.77%	21630 VA	TOTAL CONN. CURRENT: 373 A	
Heating						83600 VA	100.00%	83600 VA	TOTAL DEMAND CURRENT: 358 A	
Equipment						70635 VA	100.00%	70635 VA		
Water Heater						120 VA	100.00%	120 VA		

BRANCH PANEL: HP																								
LOCATION: ELECTRICAL 109						VOLTS: 480/277 Wye						A.I.C. RATING: 42 KAIC												
SUPPLY FROM: MDP						PHASES: 3						MAINS TYPE: MLO												
MOUNTING: SURFACE						WIRES: 4						MAINS RATING: 225 A												
ENCLOSURE: NEMA 1																								
NOTES	CKT	CIRCUIT DESCRIPTION					TRIP	POLES	A		B		C		POLES	TRIP	CIRCUIT DESCRIPTION					CKT	NOTES	
	3	EF-5					20 A	3	831	831						3	20 A	EF-3					4	
	5												831	831									6	
	7								831	833													8	
	9	EF-2					20 A	3			831	833				3	15 A	VAV-1					10	
	11												831	833									12	
	13																						14	
	15	VAV-2					20 A	3	3000	833		3000	833			3	15 A	VAV-3					16	
	17													3000	833								18	
	19								500	2167													20	
	21	VAV-4					15 A	3			500	2167				3	15 A	VAV-5					22	
	23												500	2167									24	
	25								6667	1267													26	
	27	VAV-6					15 A	3			6667	1267				3	15 A	VAV-7					28	
	29												6667	1267									30	
	31								28250	0						1	20 A	SPARE					32	
	33	JOCKEY PUMP					20 A	3			0	0				1	20 A	SPARE					34	
	35												0	0	0	1	20 A	SPARE					36	
	37	SPARE					20 A	1	0	0						1	20 A	SPARE					38	
	39	SPARE					20 A	1			0	0				1	20 A	SPARE					40	
	41	SPARE					20 A	1					0	0	0	1	20 A	SPARE					42	
TOTAL LOAD:								46010 VA		17760 VA		17760 VA												
TOTAL AMPS:								166 A		64 A		64 A												
LOAD CLASSIFICATION								CONNECTED LOAD		DEMAND FACTOR		ESTIMATED DEMAND		PANEL TOTALS										
HVAC								7479 VA		100.00%		7479 VA												
Power								28250 VA		100.00%		28250 VA		TOTAL CONN. LOAD: 81529 VA										
														TOTAL DEMAND LOAD: 81529 VA										
														TOTAL CONN. CURRENT: 98 A										
														TOTAL DEMAND CURRENT: 98 A										

BRANCH PANEL: LP															
LOCATION: ELECTRICAL 109						VOLTS: 480/277 Wye						A.I.C. RATING: 42 KAIC			
SUPPLY FROM: MDP						PHASES: 3						MAINS TYPE: MLO			
MOUNTING: SURFACE						WIRES: 4						MAINS RATING: 100 A			
ENCLOSURE: NEMA 1															
NOTES	CKT	CIRCUIT DESCRIPTION	TRIP	POLES	A	B	C	POLES	TRIP	CIRCUIT DESCRIPTION	CKT	NOTES			
	1	MEZZ AND CENTER GARAGE LTG	20 A	1	3316	4635		1	20 A	GARAGE LTG ROWS 1 AND 2	2				
	3	GARAGE LTG ROW 5	20 A	1		4666	3150	1	20 A	GARAGE LTG ROW 4	4				
	5	OFFICE LIGHTING	20 A	1			3208	1050	1	20 A	EXT WALL PACK	6			
	7	SPARE	20 A	1	0	0		--	--	SPACE	8	--			
	9	SPARE	20 A	1		0	0	--	--	SPACE	10	--			
	11	SPARE	20 A	1			0	0	--	--	SPACE	12	--		
	13	SPARE	20 A	1	0	0		--	--	SPACE	14	--			
	15	SPARE	20 A	1		0	0	--	--	SPACE	16	--			
	17	SPARE	20 A	1			0	0	--	--	SPACE	18	--		
	19	SPARE	20 A	1	0	0		--	--	SPACE	20	--			
	21	SPARE	20 A	1		0	0	--	--	SPACE	22	--			
	23	SPARE	20 A	1			0	0	--	--	SPACE	24	--		
	25	SPARE	20 A	1	0	0		--	--	SPACE	26	--			
	27	SPARE	20 A	1		0	0	--	--	SPACE	28	--			
	29	SPARE	20 A	1			0	0	--	--	SPACE	30	--		
TOTAL LOAD:					7951 VA	7816 VA	4258 VA								
TOTAL AMPS:					31 A	30 A	15 A								
LOAD CLASSIFICATION			CONNECTED LOAD	DEMAND FACTOR	ESTIMATED DEMAND		PANEL TOTALS								
Lighting			20025 VA	100.00%	20025 VA		TOTAL CONN. LOAD: 20025 VA								
							TOTAL DEMAND LOAD: 20025 VA								
							TOTAL CONN. CURRENT: 24 A								
							TOTAL DEMAND CURRENT: 24 A								



2020377.05

**CITY OF CANTON
SANITATION BUILDING – GP 1376
PRE-BID MEETING
Monday, February 28, 2023 @ 10:00 AM**

Meeting Minutes

- **Introduction**
 - Design Professionals; Russell Gayheart, Project Manager, Steve Heckman, Architect and Michael Hogston, Civil Engineer
 - Owner represented by:
 - Jim Benekos, City Engineer
 - Matt Bailey, Canton
 - AK Fullmer, Canton
 - Jim DiMarzio, Canton
 - Andy Roth, Director of Purchasing
 - Katie Wise, Assistant Director of Purchasing
- **Distribution of Bid Documents**
 - Drawings and Project Manual – Available for viewing at City of Canton - Vendor Registry.
- **Bid Due**
 - **Monday, March 13, 2023, at 2:00pm** local time (publicly opened). Bids due to the Attention of Purchasing/Bids located at 218 Cleveland Avenue SW, Canton, OH 44702
 - **Bids are due at the 4th floor. Bids will be opened on the 6th floor @ 2pm**
- **Proposals**
 - Comply with City of Canton - Front End documents for Bid Submission Requirements.
- **Scope of Work & Bid Packages**
 - Bid Package No. A – Sanitation Building – A/E Estimate (including allowances):
\$8,325,346
- **Scope Review**
 - Unit Prices and Bidders Sheet are included with the BID form.
 - NOI has been approved.
 - Plans have been submitted for plan approval to City of Canton - Building Department
 - Construction testing – by Owner-engaged testing agency – GPD Group
- **Contractor Questions/Comments**
 - All questions/comments prior to the bid due date are to be directed to City of Canton and Russell Gayheart.
 - No questions received after 2:00 pm on Monday, March 6, 2023, will be answered.
 - Written/email questions only. (email: purchasing@cantonohio.gov and rgayheart@gpdgroup.com)
- **Addenda**
 - No addendum will be issued within 72 hours (excluding Saturdays, Sundays, and legal holidays) immediately preceding the bid due date.
 - If an addendum is issued, it will be issued to City of Canton – Vendor Registry.



- **Project Schedule**

- Base Bid Package –Sanitation Building
 - Anticipated Starting Date: June 15, 2023
 - Substantial Completion Date: September 15, 2024
 - Contract Closeout Date: October 15, 2024

- **Owner Considerations:**

- Prevailing Wage and PLA is required for this project. The City of Canton has a Prevailing Wage Coordinator: Cheryl Southwell

- **Clarification:**

- All existing site accessories; i.e. dumpsters, bleachers, vehicles, etc. near the project site will be removed/relocated by the City prior to construction commencement.
 - The City noted that the site for the Sanitation Building is over an aquifer and that no large storage tanks are permitted on site which includes fuel. Fuel shall be limited to 5 gallon (or smaller) for diesel fuel and storage tanks.

- **Questions/Answers from Pre-Bid Meeting**

- Do you have the AEP contact information?
**RESPONSE: Yes. Michael Burnell. mrburnell@aep.com
Order Number: 074861234
Account Number: 07222053709**
 - Do you know what the existing salt dome foundation depth is?
RESPONSE: See response in Addendum #1.
 - What is the total SF of building?
RESPONSE: 35,900
 - Where is the Access Control and monitoring shown on the drawings? Is there information for the gate power?
RESPONSE: T-102 and TSU shows the access control for man-doors and gate information. Door Hardware specification also shows the access control hardware.
 - Could you please clarify the plan detail on TSU? This is inconsistent with the sheet keynotes. Which is correct?
RESPONSE: Sheet Keynote is correct. (2) 4" Conduits are required.
 - Where is the electrical information for the Pump Station?
RESPONSE: This is required to be a complete system (including electrical). The Electrical requirements are shown on C-133.
 - Who pays for the Permit Fees?
RESPONSE: City of Canton will waive city building department fees. Permits are still required but the fee is waived. All City inspections shall be coordinated by the contractor.



The Sanitary permit fee (Owned by the County) has been paid by the City of Canton already. The permit will need to be signed by the licensed drainlayer and scheduled 48 hours in advance, before installation of the sewer may commence. Inspections shall be coordinated by the contractor.

END OF MEETING MINUTES

SANITATION BUILDING

PR2 - BID

01/28/2023

JIM BENEROS

CANTON

Russell Garthart

GPD Group

Bob Slaga

GPD Group

Star Heckman

GPD GROUP

Michael Hegston

GPD Group

Craig Davidson

CRAIG DAVIDSON

Michael Miller

Action Contractors mmiller@actioncontractors.com

BILL GROTH

ABBOTT ELECTRIC

BILLG@ABBOTTELECTRIC.COM

Katie Wise

City of Canton

Kathryn.wise@cantonohio.gov

Andy Roth City of Canton

andrew.roth@cantonohio.gov

Chris

Hare

Wood

Electric

HARE@WOODELECTRIC.NET

Russ Thomas

Sales

rthomas@protechsecurity.com

Art Morrison

Protech Security

330-433-2700

ART@PROTECHSECURITY.COM

330-220-2700 X 217

DAVID SNYDER

DUNLOP & JOHNSTON

dsnyder@dunlopandjohnston.com

Steve Miller

Stanley Miller Const

330.434.2229

sarah.miller@smillerconst.com

J.R. RIVARDI

City

JR.RIVARDI@CANTONOHIO.GOV

A.K. Fuller

city

Adam.Fuller@cantonohio.gov

Aaron Brown

IBEW

ABROWN@IBEW540.ORG

Matt Bailey

City

matthew.bailey@cantonohio.gov

Jerry Dureux

ECOTECT

JDUREUX@SMWLU33.ORG

Tom Schmidt

Comfort Systems USA

thomas.schmidt@comfortsystemsusa.com

JIM DIMARZIO

CITY OF CANTON - SEWER

james.dimarzio@cantonohio.gov

ERIC BINSLEY

MASSILLON CONST. & Supply

ebinsley@usmcs.com

Mike Haddle

Mike Coates Const

m.haddle@mikecoatesconstruction.com

Jeff Taylor

Vendrick Construction

ESTIMATING@VENDRICKCONSTRUCTION.COM

Melanie Kruger

Standard Pkg's, Htg

mkruger@standardpandh.com

Seth Morrison


Protech Security

seth@protechsecurity.com

William Sherer II


Ironworkers Union

will.sherer@iwo500.org

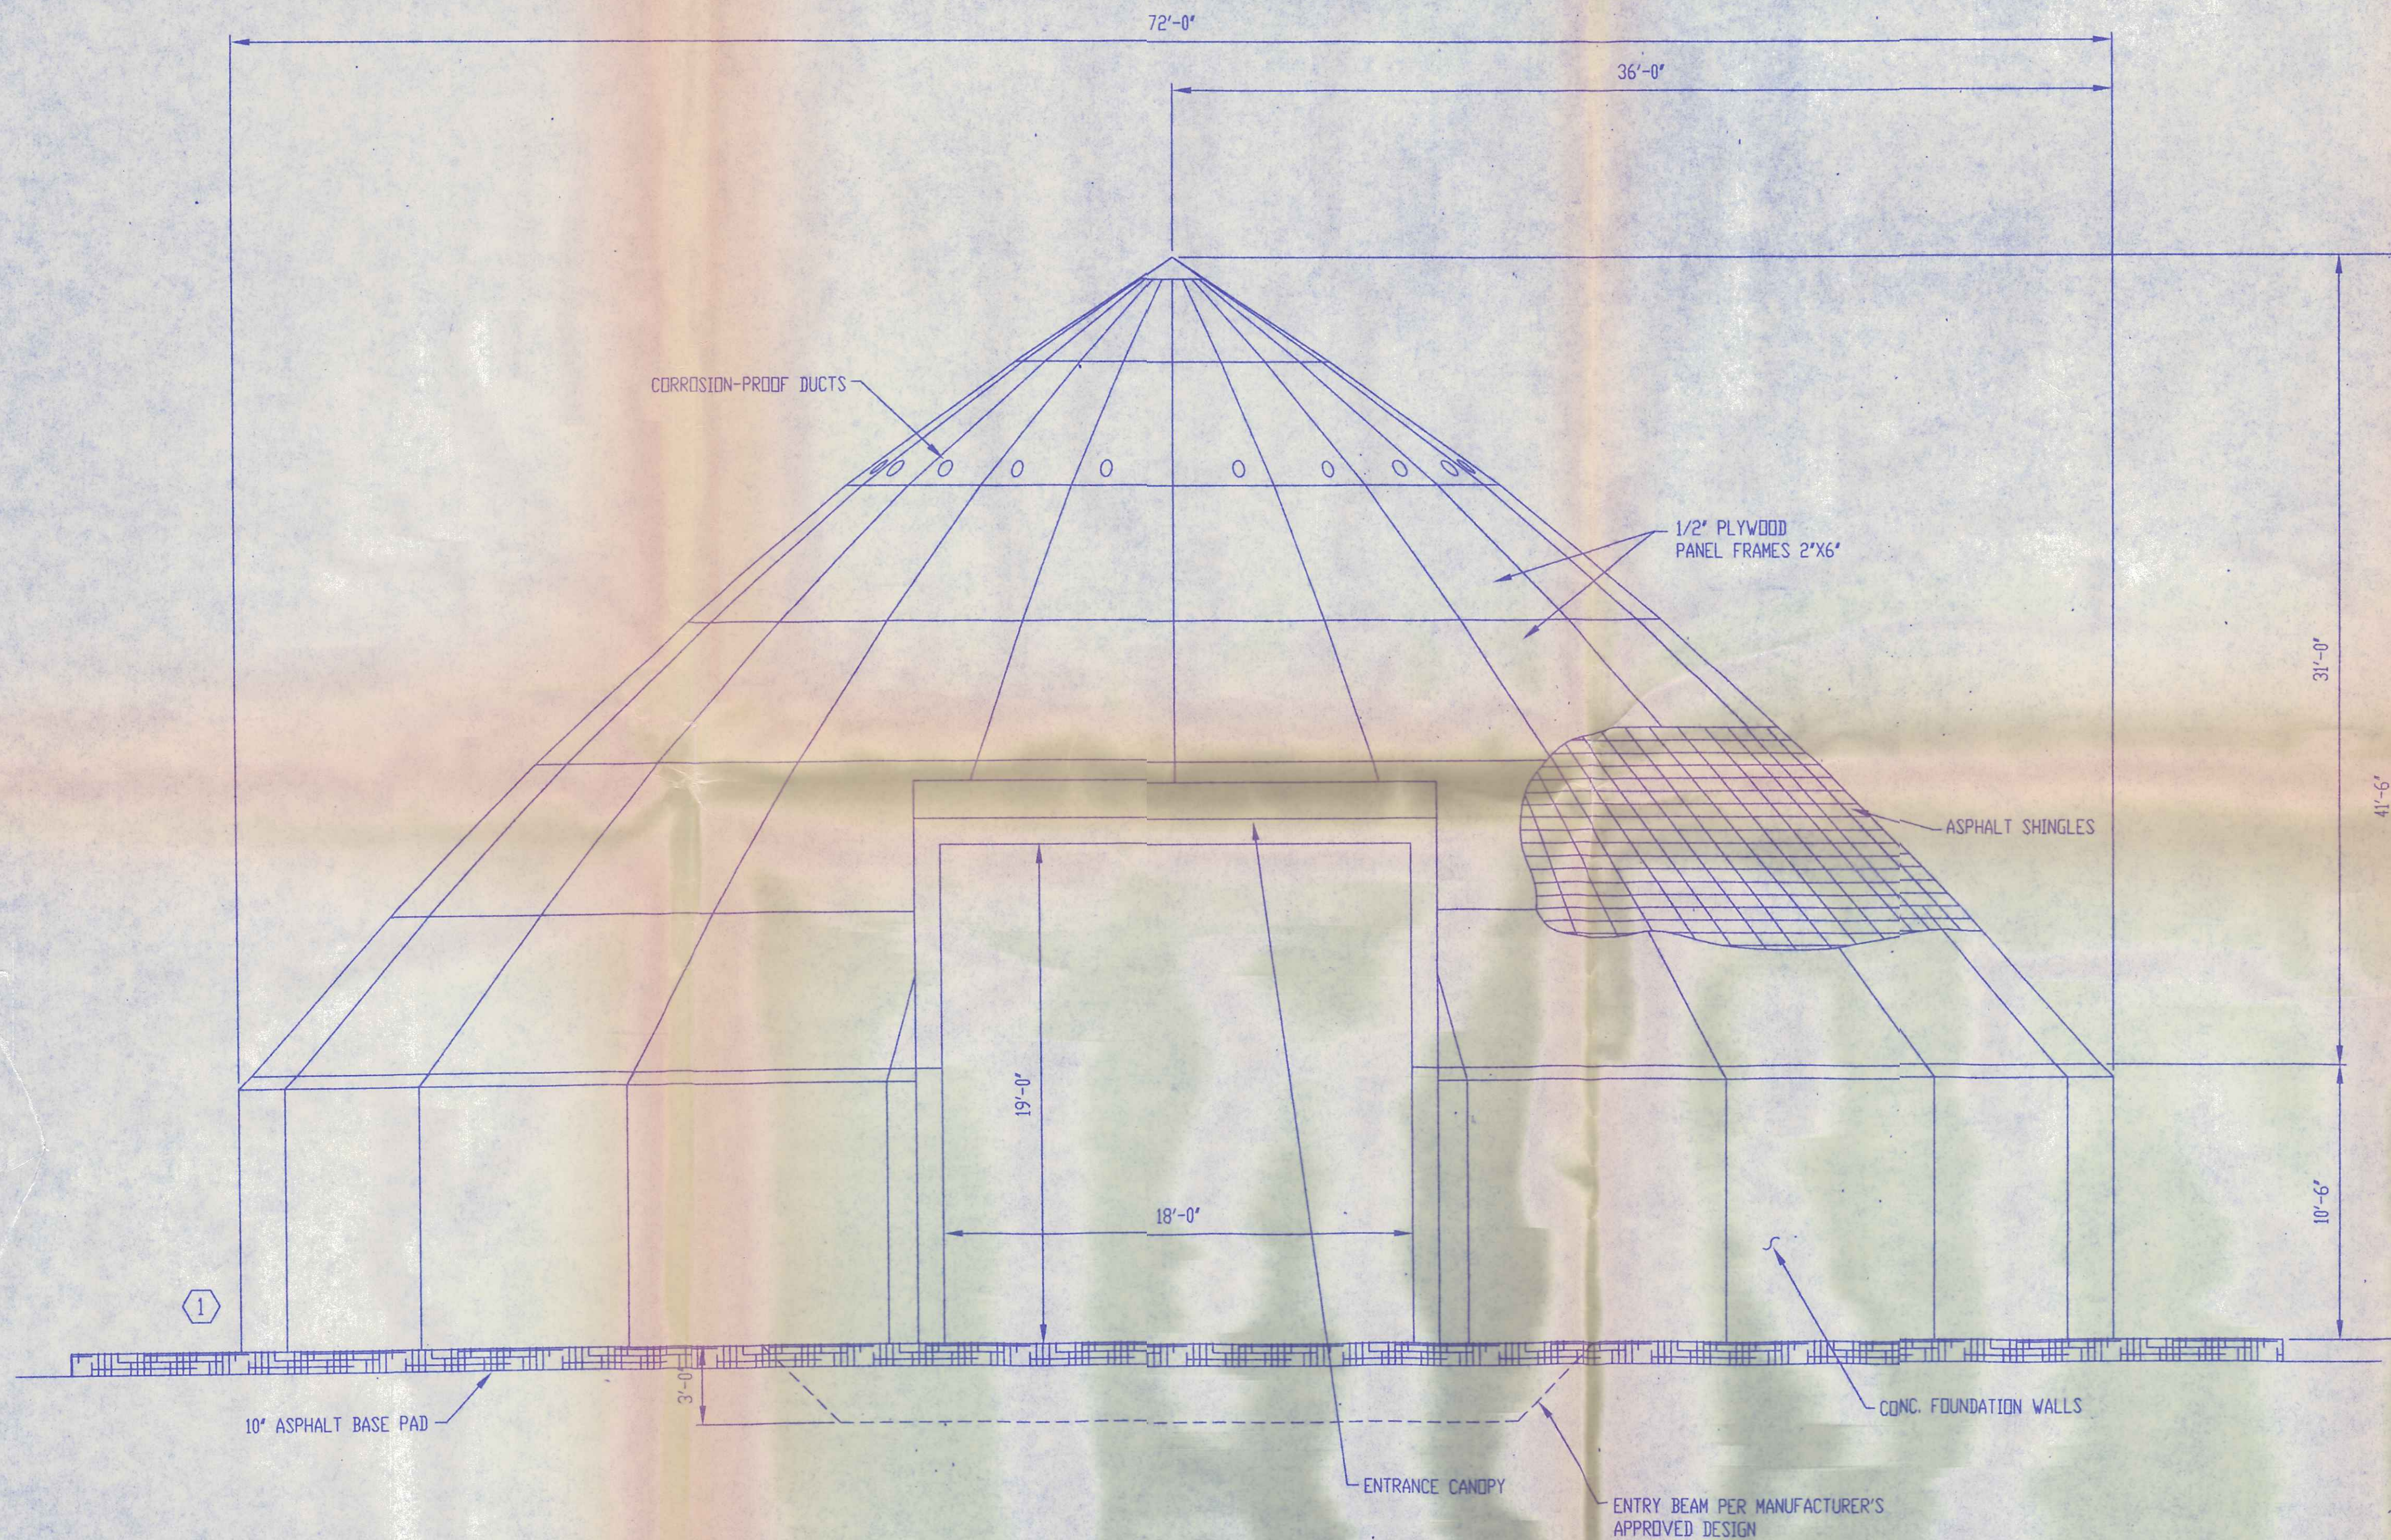

FOUNDATION WALL OPTIONS

- 1 RING WALL ON TOP OF FLOATING ASPHALT SLAB.
- 2 CONCRETE FOOTERS FOR RING WALL WITH ASPHALT PAVEMENT.
- 3 CONCRETE FOOTERS FOR RING WALL WITH CONCRETE PAVEMENT.

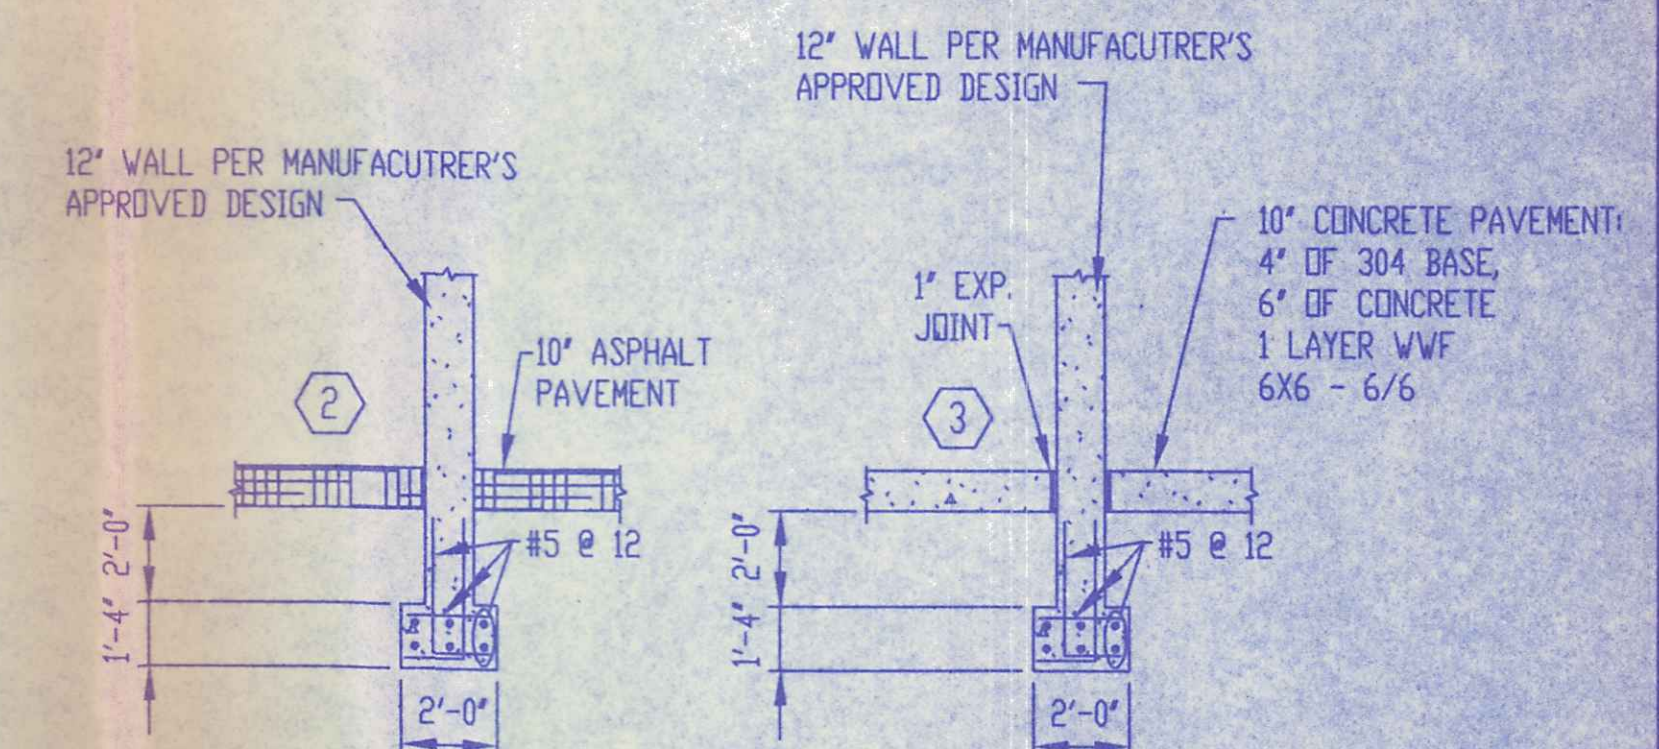

NOTE: 10" ASPHALT PAVEMENT TO CONSIST OF
6" OF 304 AGGREGATE BASE, 4" OF 404 ASPHALT SURFACE

ELEVATION

NO.	REVISION DATA	DATE	BY	APP'D



FLOYD BROWNE ASSOCIATES, INC.
CONSULTING ENGINEER
MARION, OHIO

DATE AUGUST 1993
SCALE 1/4" = 1'-0"

JOB NO. 3055.12
DWG. NO. 93364
CAD NO. SADD1

DESIGN DWS
DRAWN EEM

CHECKED *JWK*
APPROVED *EEM*

CITY OF CANTON, OHIO

SALT STORAGE BUILDING

SECTIONS