

**ADDENDUM NO. 01**

**PROPOSED RENOVATIONS TO FOOTBALL/SOCCER FIELDS AT HOWARD HIGH SCHOOL, OOLTEWAH HIGH SCHOOL AND SODDY-DAISY HIGH SCHOOL  
HAMILTON COUNTY, TN**

**GENERAL**

The following items covering changes in the bidding requirements shall apply to and become a part of the requirements thereof.

Receipt of this Addendum shall be acknowledged by inserting this number and date in the space provided on the Bid Form. Failure to do so may result in disqualification of the Bidder. This addendum consists of 28 pages, including drawings:

**ADDITIONAL INFORMATION DOCUMENTS**

The following document(s):

- Pre-Bid/Proposal Meeting Agenda
- Pre-Bid/Proposal Meeting Minutes
- Pre-Bid/Proposal Sign-In Sheet

are being provided with this addendum for informational purposes only. The documents listed above are not, and will not, be considered as part of the Contract Documents.

**QUESTIONS**

- 1Q. Can the combined set of drawings be distributed as 3 separate sets?  
1R. Yes, separate sets will be distributed under separate cover.

**MISCELLANEOUS**

No Items

**SPECIFICATIONS**

- ITEM 1                      Section 00 06 13.13 – Performance Bond  
Add Section in entirety
- ITEM 2                      Section 00 06 13.16 – Payment Bond  
Add Section in entirety
- ITEM 3                      Section 32 18 14 – Infilled Synthetic Turf Systems  
Revise Paragraph – 1.1A  
Insert “monofilament/slit film dual fiber,” in between “install” and “a tufted”  
in the first sentence.
- ITEM 4                      Section 32 18 14 – Infilled Synthetic Turf Systems  
Revise Paragraph – 1.9C line items within the Minimum Synthetic Turf  
Properties:

Property	Standard	Dual Fiber Specification
Yarn Denier (primary fiber)	ASTM D 1577	7,200 mono/5200 slit
Yarn Thickness (microns)	ASTM D 3218	300 mono/100 slit

ITEM 5

Section 32 18 14 – Infilled Synthetic Turf Systems

Add Paragraph – 1.11 – Fabric Color

Fabric color shall be selected from manufacturer’s standard colors. There will be 2 shades of green to be utilized within the football field surface. Areas noted are from both end zones.

Light Green – End Zone to 5-yard line, 15-yard to 25-yard line, 35-yard to 45-yard line

Dark Green – 5-yard to 15-yard line, 25-yard to 35-yard line, 45-yard to 45-yard line

**DRAWINGS**

ITEM 1

OHS – Sheet C0.21 – Added note for existing sign.

ITEM 2

OHS – Sheet C2.01 – Additional information related to the proposed restriping for ADA parking spaces and improved access.

ITEM 3

OHS – Sheet C7.01 thru C7.03 – Revised details.

ITEM 4

HHS – Sheets QC-1 thru QC-3 – Quick Coupler plans and details.

**Bidder Must Acknowledge Receipt of this Addendum on Bid/Proposal Form**

March 19, 2024

Barge Design Solutions, Inc.  
1110 Market Street, Suite 200  
Chattanooga, TN 37202

## Pre-Proposal Conference Agenda

October 30, 2018

- Project:** **Proposed Renovations of Football/Soccer Fields at Howard High School, Ooltewah High School and Soddy-Daisy High School**  
Hamilton County Department of Education  
HCDE RFP#24-55  
Barge #38505-00
- Purpose of Meeting:** Pre-Proposal Conference
- Introductions:** Joseph Sawyer, ASLA, PLA, Barge  
Andy Highlander, PE, Barge
- Bid Opening:** 2:00 PM, April 2, 2024 at the  
Hamilton County Procurement Department  
455 N. Highland Park Avenue, Chattanooga, 37408
- Bid Documents:** Bid Documents have been released to the Bidders and have been made available thru the HCS Vendor Registry, [www.vendorregistry.com](http://www.vendorregistry.com). Verify Bid Documents are complete (Bid Envelope, Project Manual, Drawings, Bid Security and Addenda). Bidders are solely responsible for misinterpretations resulting from using an incomplete set of documents.
- Additional Information:** None
- Bid Preparation:** Bidders shall carefully examine the site and Bid Documents to obtain firsthand knowledge of the existing conditions and work proposed. The Contractor will not be given extra payment for conditions which can be determined by examining the site and Bid Documents.
- Contractor's Attestation:** The Owner prohibits the use of the services of an illegal immigrant and the Attestation Form Regarding Personnel Used in Contract Performance must be completed for the initial contract agreement and with each monthly Application for Payment.

Pre-Bid Conference Agenda  
March 18, 2024  
Proposed Field Renovations  
Barge #38505-00

Interpretations &  
Clarifications:

All requests for interpretations or clarifications must be made in writing to Graham Hartness, [graham.hartness@bargedesign.com](mailto:graham.hartness@bargedesign.com) prior to March 25, 2024, 5 PM EDT. No changes are binding and no interpretations or clarifications are reliable unless confirmed in writing by Addendum.

Submission of Bid:

Please refer to Request for Proposal document in the Project Manual for all bid requirements. Make proposals on an unaltered Bid/Proposal Form provided by HCS in the Bid Package. When submitting bids please make sure that the official Bid Form contained in the Bid Envelope is included in the Bid Envelope and that both documents are completely filled out.

Submit Bid/Proposal Form with attachments and Bid Security enclosed and sealed in a sealed envelope. If the Bidder will perform the work with their own forces fill in the Bidder's name as the Subcontractor. If no work is required for a category write "NR" (none required) or "NA" (not applicable) in the space provided.

Provide State Contractor license number, expiration date and applicable classifications for Bidder and the listed Subcontractors.

Along with the Bid/Proposal Form, a Bid Security in the amount of 5% of the total bid amount, including any alternates is required. The Bid Security shall be in the form of a Bid Bond or certified/cashier's check made payable to Hamilton County Department of Education and shall have current power of attorney for Attorney-in-Fact attached.

Bidders are solely responsible for ensuring that bids/proposals are received by the time and at the place identified for receipt of bids. Bids which are received late will be returned unopened. Mailed bids shall be marked "Bid Envelope Enclosed" clearly on the mailing envelope.

Conditional or qualified bids will not be accepted.

Pre-Bid Conference Agenda  
March 18, 2024  
Proposed Field Renovations  
Barge #38505-00

Bid Structure: Lump Sum.

Contract Time: Anticipated Contract Notice to Proceed: 5/1/24  
Substantial Completion: 101 Days  
Final Completion 10 Days

Project Scope: Howard HS project includes, but is not limited to:

- Earthwork – excavating existing natural grass field
- Preservation of existing field subdrainage
- Removal of existing irrigation heads, valves, boxes and controller (property of HCS)
- Capping existing irrigation system at designated location and retaining remaining existing irrigation piping and wiring as is.
- Storm drainage
- Sports Fields – geotextile fabric, stone base, synthetic turf
- Grass seeding disturbed areas

Ooltewah HS project includes but is not limited to:

- Earthwork – excavating existing natural grass field
- Demolition of existing high jump, discus pad, portion of asphalt path
- Storm drainage
- Sports Fields – geotextile fabric, concrete curbing stone base, synthetic turf.
- Track and Field – new high jump, long jump, triple jump within the field area. New shot put pad and landing area, discus pad and nets in a to be determined area at the existing practice field.
- ADA improvements – re-stripping existing parking lot for 6 new ADA parking spaces. New sidewalk and handrail along the south and southeast portion of the field.
- Grass seeding disturbed areas

Soddy-Daisy HS project includes but is not limited to:

- Earthwork – excavating existing natural grass field
- Removal of existing subdrainage
- Storm drainage

Pre-Bid Conference Agenda  
March 18, 2024  
Proposed Field Renovations  
Barge #38505-00

- Sports Fields – geotextile fabric, stone base, synthetic turf
- New goalposts
- Grass seeding disturbed areas

Insurance and Bonds: Please refer to Article 11 of the General Conditions of the Contract included in the Project Manual for the insurance requirements of this Project Manual for the insurance requirements of this project related to Builders Risk and Contractor’s Pollution Liability Insurance.

Changes to the Work: Change Order Requests shall be submitted prior to proceeding with any Change Order associated work.

Storm Water Pollution

Prevention Plan: Each field has been submitted to the respective local and state agency having jurisdiction.

Site Access: Howard High School – Access to the field will be from the east by way of the driveway accessing the County Pump Station that is adjacent to the field.

Ooltewah High School – Access off of the entry dire to the property and through a service gate.

Soddy-Daisy High School – Access off of the parking lot east of the field and through a service gate.

Safe pedestrian and vehicular movement during the life of construction will need to be maintained.

Contractor parking will be allowed in designated parking areas only.

Site Visitation: The Bidders are requested to visit each site to become familiar with the conditions under which the work is to be performed and to correlate all observations with the requirements of the Bid/Proposal

Substitution Requests: Any substitution request must be made prior to March 25, 20204 and must be prepared in accordance with Sections 01 25 00.

Discussion:

**SIGN-IN SHEET**

 Date: 3/18/24

 Solicitation #, Name: 24.55 FIELD RENOVATIONS @ HOWARD COLLEMAN ST, SOLWAY-DRAISCH

 Meeting Type: Pre-Proposal/BID Location: Ooltewah HS

 HCS Representative: Justin Witt / Steve Hodgson

Company Name	Company Address (Address, Ste/Rm, City, State, Zip)	Company Phone	E-mail Address	Company Representative
HEWAS	12000 W PARMER LN CEDAR PARK, TX	919-801-5952	JREDOVIAN@HEWASCONSTRUCTION.COM	JIMMY REDOVIAN
James Manning		Ooltewah HS	manning-james@hcd.org	
HCDE		423-322-1440	witt-justin@hcde.org	JUSTIN WITT
HCDE			Baker_Crystal@hcde.org	Crystal Baker
HCDE			Hodgson-Steve@HCDE.org	Steve Hodgson
BASELINE SPORTS	3400 HENSON RD. KNOXVILLE, TN	423-334-5542	CHADS@BASELINEILC.COM	CHAD SMALLER
Baseline Sports	"	423-593-8284	stew@baselineilc.com	Steve Clift
Act Global		330-388-7814	C.robb@actglobal.com	Jake Storm
ARK		423-605-0328	Tim.Arkpa@twhg@gmail.com	Tim Moore
Sprinturf		630 542 1091	wsxton@sprinturf.com	Will Sexton





## MEETING NOTES

**Date of Meeting:** March 18, 2024

**Project:** Proposed Renovation of Football/Soccer Fields at Howard High School, Ooltewah High School and Soddy-Daisy High School  
Hamilton County, TN

**Subject:** Pre-Proposal/Bid Meeting

**Meeting Location:** Ooltewah High School Football Field

**Barge Project No.:** 38505-00

---

**PARTICIPANTS:** HCS – Justin Witt, Tim James, Steven Hodgen, Crystal Clark  
Ooltewah HS – James Manning, Donnie Mullins  
Barge – Andy Highlander, Graham Hartness, Joe Sawyer  
Hellas – Jimmy Redovian  
Baseline Sports – Steve Clift, Chad Smallen  
ACT Global – Jake Storm  
Ark Painting – Tim Monroe  
SprintTurf – Will Sexton  
Pillar Construction – Will Gaither  
AstroTurf – Garrett Bare  
Shaw Sports Turf – Jake McIntosh

**Copy to:** Participants

---

### ITEMS DISCUSSED:

Meeting began at 10:00 AM Eastern.

1. Joe Sawyer began the meeting with introductions of the HCS staff and design team representatives.
2. Joe Sawyer began with a brief review of the agenda items and discussed in more detail the items below:
  - a. Bid documents have been released and they are available from the HCS Vendor Registry.
  - b. The first addendum will be released within the next couple of days.
  - c. The sites are available for proposers to walk. All visitors must check-in at the school office prior to walking the field.
  - d. All bidder questions must be received by email to Steven Hodgen @ [doe\\_purchasing@hcde.org](mailto:doe_purchasing@hcde.org) prior to 5 PM Eastern, March 25, 2024.

- e. Justin emphasized the bid process is not a low bid reward. There is a committee that will review the proposals and a decision will be made on what is best for HCS.
  - f. Justin also noted that the Bid/Proposal Form is included, and the project is a Lump Sum cost. There are provisions for additive alternates and deductive alternates to be made. These alternates will only be considered after contractor selection has been made. All addenda must be acknowledged.
  - g. Bids will be opened on 4/2 at 2 PM in the office of the Hamilton County Schools, Chattanooga. It was noted that the official address is 3074 Hickory Valley Road, Chattanooga, 37421.
  - h. The contract is expected to be let out 5/1/24 for Ooltewah HS and Soddy-Daisy HS. The contract for Howard HS will be let out 5/8/24. Final completion is 111 days.
  - i. Substitution requests will be evaluated as long as the formal substitution request process outlined in the bid documents is followed.
  - j. Howard HS and Soddy-Daisy HS have been preliminarily approved by City of Chattanooga (Howard) and Hamilton County (Soddy-Daisy). TDEC is forthcoming on the Notice of Coverage.
  - k. Excavated sod is for the contractor to use at their cost and discretion.
3. Joe reviewed the scope of each project:
- a. Howard – Connect field to existing perimeter slot drain, retain existing subdrainage, abandon existing irrigation with exception of heads, valves, boxes and controller (these are property of HCS), goalposts to be removed, protected and re-paced.
  - b. Ooltewah – new perimeter curb, new track/field events, deeper stone base due to stormwater requirements, ADA improvements in the parking lot next to the tennis courts and the sidewalk connecting to the Visitor grandstand. What was not discussed was the placement of the shot put pad and landing zone and discus pad and nets to be placed at the west end of the football practice field that is NE and downhill of the main field. There is limited access to this area.
  - c. Soddy-Daisy – Connect field to existing perimeter slot drain, remove existing subdrainage, replace goalposts, protect existing track/field events.

Renovation of Football/Soccer Fields  
Pre-Bid/Proposal Conference Notes  
Page - 3

Meeting adjourned at approximately 10:30 AM Eastern

These notes represent my understanding of items discussed and conclusions reached. Participants are requested to review these items and advise of necessary corrections or revisions.



**Signed:**

Joseph Sawyer, PLA, ASLA

**Date:** March 19, 2024

Attachments:

Meeting Sign-in Sheet  
Meeting Agenda

CONTRACTOR (name and address):

SURETY (name and address of principal place of business):

OWNER (name and address):

CONSTRUCTION CONTRACT

Effective Date of the Agreement: \_\_\_\_\_

Amount:

Description: Proposed Renovation of Football/Soccer Fields at Howard High School, Ooltewah High School and Soddy-Daisy High School

BOND

Bond Number: \_\_\_\_\_

Date (not earlier than the Effective Date of the Agreement of the Construction Contract): \_\_\_\_\_

Amount:

Surety and Contractor, intending to be legally bound hereby, subject to the terms set forth below, do each cause this Performance Bond to be duly executed by an authorized officer, agent, or representative.

CONTRACTOR AS PRINCIPAL

SURETY

\_\_\_\_\_ (seal)

Contractor's Name and Corporate Seal

\_\_\_\_\_ (seal)

Surety's Name and Corporate Seal

By: \_\_\_\_\_

Signature

By: \_\_\_\_\_

Signature (attach power of attorney)

Print Name

Print Name

Title

Title

Attest: \_\_\_\_\_

Signature

Attest: \_\_\_\_\_

Signature

Title

Title

Notes: (1) Provide supplemental execution by any additional parties, such as joint venturers. (2) Any singular reference to Contractor, Surety, Owner, or other party shall be considered plural where applicable.

1. The Contractor and Surety, jointly and severally, bind themselves, their heirs, executors, administrators, successors, and assigns to the Owner for the performance of the Construction Contract, which is incorporated herein by reference.
2. If the Contractor performs the Construction Contract, the Surety and the Contractor shall have no obligation under this Bond.
3. If there is no Owner Default under the Construction Contract, the Surety's obligation under this Bond shall arise after Owner terminates for cause in accordance with General Conditions Paragraph 15.02.
4. Failure on the part of the Owner to comply with the notice requirement in General Conditions Paragraph 15.02 shall not constitute a failure to comply with a condition precedent to the Surety's obligations, or release the Surety from its obligations, except to the extent the Surety demonstrates actual prejudice.
5. When the Owner has satisfied the conditions of Paragraph 3, the Surety shall promptly and at the Surety's expense take the following action:
  - 5.1 Waive its right to perform and complete, to arrange for completion, or to obtain a new contractor, and with reasonable promptness under the circumstances:
    - 5.1.1 After investigation, determine the amount for which it may be liable to the Owner and, as soon as practicable after the amount is determined, make payment to the Owner; or
    - 5.1.2 Deny liability in whole or in part and notify the Owner, citing the reasons for denial.
6. Subject to the commitment by the Owner to pay the Balance of the Contract Price, the Surety is obligated, without duplication for:
  - 6.1 the responsibilities of the Contractor for correction of defective work and completion of the Construction Contract;
  - 6.2 additional legal, design professional, and delay costs resulting from the Contractor's Default; and
  - 6.3 liquidated damages caused by delayed performance or non-performance of the Contractor.
7. The Surety's liability is limited to the amount of this Bond.
8. The Surety shall not be liable to the Owner or others for obligations of the Contractor that are unrelated to the Construction Contract, and the Balance of the Contract Price shall not be reduced or set off on account of any such unrelated obligations. No right of action shall accrue on this Bond to any person or entity other than the Owner or its heirs, executors, administrators, successors, and assigns.
9. The Surety hereby waives notice of any change, including changes of time, to the Construction Contract or to related subcontracts, purchase orders, and other obligations.
10. Any proceeding, legal or equitable, under this Bond may be instituted in any court of competent jurisdiction in the location in which the work or part of the work is located and shall be instituted within two years after a declaration of Contractor Default or within two years after the Contractor ceased working or within two years after the Surety refuses or fails to perform its obligations under this Bond, whichever occurs first. If the provisions of this paragraph are void or prohibited by law, the minimum periods of limitations available to sureties as a defense in the jurisdiction of the suit shall be applicable.
11. Notice to the Surety, the Owner, or the Contractor shall be mailed or delivered to the address shown on the page on which their signature appears.
12. When this Bond has been furnished to comply with a statutory or other legal requirement in the location where the construction was to be performed, any provision in this Bond conflicting with said statutory or legal requirement shall be deemed deleted herefrom and provisions conforming to such statutory or other legal requirement shall be deemed incorporated herein. When so furnished, the intent is that this Bond shall be construed as a statutory bond and not as a common law bond.
13. Definitions
  - 13.1 Balance of the Contract Price: The total amount payable by the Owner to the Contractor under the Construction Contract after all proper adjustments have been made including allowance for the Contractor for any amounts received or to be received by the Owner in settlement of insurance or other claims for damages to which the Contractor is entitled, reduced by all valid and proper payments made to or on behalf of the Contractor under the Construction Contract.
  - 13.2 Construction Contract: The agreement between the Owner and Contractor identified on the cover page, including all Contract Documents and changes made to the agreement and the Contract Documents.
  - 13.3 Contractor Default: Failure of the Contractor, which has not been remedied or waived, to perform or otherwise to comply with a material term of the Construction Contract.
  - 13.4 Owner Default: Failure of the Owner, which has not been remedied or waived, to pay the Contractor as required under the Construction Contract or to perform and complete or comply with the other material terms of the Construction Contract.
  - 13.5 Contract Documents: All the documents that comprise the agreement between the Owner and Contractor.

This document was prepared in part from material (EJCDC C-610 Performance Bond) which is copyrighted as indicated below:

Copyright © 2010 National Society of Professional Engineers  
1420 King Street, Alexandria, VA 22314-2794  
(703) 684-2882  
[www.nspe.org](http://www.nspe.org)

American Council of Engineering Companies  
1015 15th Street N.W., Washington, DC 20005  
(202) 347-7474  
[www.acec.org](http://www.acec.org)

American Society of Civil Engineers  
1801 Alexander Bell Drive, Reston, VA 20191-4400  
(800) 548-2723  
[www.asce.org](http://www.asce.org)

Associated General Contractors of America  
2300 Wilson Boulevard, Suite 400, Arlington, VA 22201-3308  
(703) 548-3118  
[www.agc.org](http://www.agc.org)

The copyright for this EJCDC document is owned jointly by the four EJCDC sponsoring organizations and held in trust for their benefit by NSPE

CONTRACTOR (name and address):

SURETY (name and address of principal place of business):

OWNER (name and address):

Hamilton County Schools  
3074 Hickory Valley Road  
Chattanooga, TN 37421

CONSTRUCTION CONTRACT

Effective Date of the Agreement: \_\_\_\_\_

Amount:

Description (name and location): **Proposed Renovation of Football/Soccer Fields at Howard High School, Ooltewah High School and Soddy-Daisy High School**

BOND

Bond Number:

Date (not earlier than the Effective Date of the Agreement of the Construction Contract): \_\_\_\_\_

Amount:

Surety and Contractor, intending to be legally bound hereby, subject to the terms set forth below, do each cause this Payment Bond to be duly executed by an authorized officer, agent, or representative.

CONTRACTOR AS PRINCIPAL

SURETY

\_\_\_\_\_  
Contractor's Name and Corporate Seal (seal)

\_\_\_\_\_  
Surety's Name and Corporate Seal (seal)

By: \_\_\_\_\_  
Signature

By: \_\_\_\_\_  
Signature (attach power of attorney)

\_\_\_\_\_  
Print Name

\_\_\_\_\_  
Print Name

\_\_\_\_\_  
Title

\_\_\_\_\_  
Title

Attest: \_\_\_\_\_  
Signature

Attest: \_\_\_\_\_  
Signature

\_\_\_\_\_  
Title

\_\_\_\_\_  
Title

**Notes: (1) Provide supplemental execution by any additional parties, such as joint venturers. (2) Any singular reference to Contractor, Surety, Owner, or other party shall be considered plural where applicable.**





1. The Contractor and Surety, jointly and severally, bind themselves, their heirs, executors, administrators, successors, and assigns to the Owner to pay for labor, materials, and equipment furnished for use in the performance of the Construction Contract, which is incorporated herein by reference, subject to the following terms.
2. If the Contractor promptly makes payment of all sums due to Claimants, and defends, indemnifies, and holds harmless the Owner from claims, demands, liens, or suits by any person or entity seeking payment for labor, materials, or equipment furnished for use in the performance of the Construction Contract, then the Surety and the Contractor shall have no obligation under this Bond.
3. If there is no Owner Default under the Construction Contract, the Surety's obligation to the Owner under this Bond shall arise after the Owner has promptly notified the Contractor and the Surety (at the address described in Paragraph 13) of claims, demands, liens, or suits against the Owner or the Owner's property by any person or entity seeking payment for labor, materials, or equipment furnished for use in the performance of the Construction Contract, and tendered defense of such claims, demands, liens, or suits to the Contractor and the Surety.
4. When the Owner has satisfied the conditions in Paragraph 3, the Surety shall promptly and at the Surety's expense defend, indemnify, and hold harmless the Owner against a duly tendered claim, demand, lien, or suit.
5. The Surety's obligations to a Claimant under this Bond shall arise after the following:
  - 5.1 Claimants who do not have a direct contract with the Contractor,
    - 5.1.1 have furnished a written notice of non-payment to the Contractor, stating with substantial accuracy the amount claimed and the name of the party to whom the materials were, or equipment was, furnished or supplied or for whom the labor was done or performed, within ninety (90) days after having last performed labor or last furnished materials or equipment included in the Claim; and
    - 5.1.2 have sent a Claim to the Surety (at the address described in Paragraph 13).
  - 5.2 Claimants who are employed by or have a direct contract with the Contractor have sent a Claim to the Surety (at the address described in Paragraph 13).
6. If a notice of non-payment required by Paragraph 5.1.1 is given by the Owner to the Contractor, that is sufficient to satisfy a Claimant's obligation to furnish a written notice of non-payment under Paragraph 5.1.1.
7. When a Claimant has satisfied the conditions of Paragraph 5.1 or 5.2, whichever is applicable, the Surety shall promptly and at the Surety's expense take the following actions:
  - 7.1 Send an answer to the Claimant, with a copy to the Owner, within sixty (60) days after receipt of the Claim, stating the amounts that are undisputed and the basis for challenging any amounts that are disputed; and
  - 7.2 Pay or arrange for payment of any undisputed amounts.
  - 7.3 The Surety's failure to discharge its obligations under Paragraph 7.1 or 7.2 shall not be deemed to constitute a waiver of defenses the Surety or Contractor may have or acquire as to a Claim, except as to undisputed amounts for which the Surety and Claimant have reached agreement. If, however, the Surety fails to discharge its obligations under Paragraph 7.1 or 7.2, the Surety shall indemnify the Claimant for the reasonable attorney's fees the Claimant incurs thereafter to recover any sums found to be due and owing to the Claimant.
8. The Surety's total obligation shall not exceed the amount of this Bond, plus the amount of reasonable attorney's fees provided under Paragraph 7.3, and the amount of this Bond shall be credited for any payments made in good faith by the Surety.
9. Amounts owed by the Owner to the Contractor under the Construction Contract shall be used for the performance of the Construction Contract and to satisfy claims, if any, under any construction performance bond. By the Contractor furnishing and the Owner accepting this Bond, they agree that all funds earned by the Contractor in the performance of the Construction Contract are dedicated to satisfy obligations of the Contractor and Surety under this Bond, subject to the Owner's priority to use the funds for the completion of the work.
10. The Surety shall not be liable to the Owner, Claimants, or others for obligations of the Contractor that are unrelated to the Construction Contract. The Owner shall not be liable for the payment of any costs or expenses of any Claimant under this Bond, and shall have under this Bond no obligation to make payments to or give notice on behalf of Claimants, or otherwise have any obligations to Claimants under this Bond.
11. The Surety hereby waives notice of any change, including changes of time, to the Construction Contract or to related subcontracts, purchase orders, and other obligations.

12. No suit or action shall be commenced by a Claimant under this Bond other than in a court of competent jurisdiction in the state in which the project that is the subject of the Construction Contract is located or after the expiration of one year from the date (1) on which the Claimant sent a Claim to the Surety pursuant to Paragraph 5.1.2 or 5.2, or (2) on which the last labor or service was performed by anyone or the last materials or equipment were furnished by anyone under the Construction Contract, whichever of (1) or (2) first occurs. If the provisions of this paragraph are void or prohibited by law, the minimum period of limitation available to sureties as a defense in the jurisdiction of the suit shall be applicable.
13. Notice and Claims to the Surety, the Owner, or the Contractor shall be mailed or delivered to the address shown on the page on which their signature appears. Actual receipt of notice or Claims, however accomplished, shall be sufficient compliance as of the date received.
14. When this Bond has been furnished to comply with a statutory or other legal requirement in the location where the construction was to be performed, any provision in this Bond conflicting with said statutory or legal requirement shall be deemed deleted herefrom and provisions conforming to such statutory or other legal requirement shall be deemed incorporated herein. When so furnished, the intent is that this Bond shall be construed as a statutory bond and not as a common law bond.
15. Upon requests by any person or entity appearing to be a potential beneficiary of this Bond, the Contractor and Owner shall promptly furnish a copy of this Bond or shall permit a copy to be made.
16. **Definitions**
- 16.1 **Claim:** A written statement by the Claimant including at a minimum:
1. The name of the Claimant;
  2. The name of the person for whom the labor was done, or materials or equipment furnished;
  3. A copy of the agreement or purchase order pursuant to which labor, materials, or equipment was furnished for use in the performance of the Construction Contract;
  4. A brief description of the labor, materials, or equipment furnished;
  5. The date on which the Claimant last performed labor or last furnished materials or equipment for use in the performance of the Construction Contract;
  6. The total amount earned by the Claimant for labor, materials, or equipment furnished as of the date of the Claim;
  7. The total amount of previous payments received by the Claimant; and
8. The total amount due and unpaid to the Claimant for labor, materials, or equipment furnished as of the date of the Claim.
- 16.2 **Claimant:** An individual or entity having a direct contract with the Contractor or with a subcontractor of the Contractor to furnish labor, materials, or equipment for use in the performance of the Construction Contract. The term Claimant also includes any individual or entity that has rightfully asserted a claim under an applicable mechanic's lien or similar statute against the real property upon which the Project is located. The intent of this Bond shall be to include without limitation in the terms of "labor, materials, or equipment" that part of the water, gas, power, light, heat, oil, gasoline, telephone service, or rental equipment used in the Construction Contract, architectural and engineering services required for performance of the work of the Contractor and the Contractor's subcontractors, and all other items for which a mechanic's lien may be asserted in the jurisdiction where the labor, materials, or equipment were furnished.
- 16.3 **Construction Contract:** The agreement between the Owner and Contractor identified on the cover page, including all Contract Documents and all changes made to the agreement and the Contract Documents.
- 16.4 **Owner Default:** Failure of the Owner, which has not been remedied or waived, to pay the Contractor as required under the Construction Contract or to perform and complete or comply with the other material terms of the Construction Contract.
- 16.5 **Contract Documents:** All the documents that comprise the agreement between the Owner and Contractor.
17. If this Bond is issued for an agreement between a contractor and subcontractor, the term Contractor in this Bond shall be deemed to be Subcontractor and the term Owner shall be deemed to be Contractor.

This document was prepared in part from material (EJCDC C-615 Payment Bond) which is copyrighted as indicated below:

Copyright © 2010 National Society of Professional Engineers  
1420 King Street, Alexandria, VA 22314-2794  
(703) 684-2882  
[www.nspe.org](http://www.nspe.org)

American Council of Engineering Companies  
1015 15th Street N.W., Washington, DC 20005  
(202) 347-7474  
[www.acec.org](http://www.acec.org)

American Society of Civil Engineers  
1801 Alexander Bell Drive, Reston, VA 20191-4400  
(800) 548-2723  
[www.asce.org](http://www.asce.org)

Associated General Contractors of America  
2300 Wilson Boulevard, Suite 400, Arlington, VA 22201-3308  
(703) 548-3118  
[www.agc.org](http://www.agc.org)


The copyright for this EJCDC document is owned jointly by the four EJCDC sponsoring organizations and held in trust for their benefit by NSPE

**SURVEY LEGEND**

- 520----- CONTOUR LINE (MAJOR)
- 519----- CONTOUR LINE (MINOR)
- OH----- OVERHEAD POWER LINE
- SA----- SANITARY SEWER LINE
- ST----- STORM SEWER LINE
- G----- NATURAL GAS LINE
- W----- WATER LINE
- Ø UTILITY POLE
- ↑ GUY WIRE
- ⊙ SANITARY SEWER MANHOLE
- ⊙ STORM SEWER MANHOLE
- ⊙ CATCH BASIN
- ⊙ SANITARY CLEANOUT
- ⊙ FIRE HYDRANT
- ⊙ WATER METER
- ⊙ WATER VALVE

**SURVEY NOTES**

1. NORTH ORIENTATION BASED ON TENNESSEE STATE GRID, NORTH AMERICAN DATUM 1983 (NAD 83), NO DATUM ADJUSTMENT APPLIED TO COORDINATES AS SHOWN HEREON.
2. CONTOURS AND ELEVATIONS BASED ON LOCAL GPS, CONTINUOUS OPERATING REFERENCE.
3. STATION (C.O.R.S.) NORTH AMERICAN VERTICAL DATUM 1988 (NAVD 88).
4. CONTOURS AND ELEVATIONS BASED ON RANDOM GROUND SHOTS.
5. THIS MAP AND SURVEY SUBJECT TO ANY RIGHTS-OF-WAY, EASEMENTS, RESTRICTIONS, AGREEMENTS, ZONING AND ANY OTHER MATTERS OF TITLE THAT MAY EXIST.
6. PRIOR TO THE START OF ANY CONSTRUCTION AND/OR DIGGING ACTIVITIES CONTACT UTILITY COMPANIES AND/OR A UTILITY MARKING CONTRACTOR TO MARK ANY UNDERGROUND UTILITIES THAT MAY BE LOCATED ON OR NEAR THIS SITE.

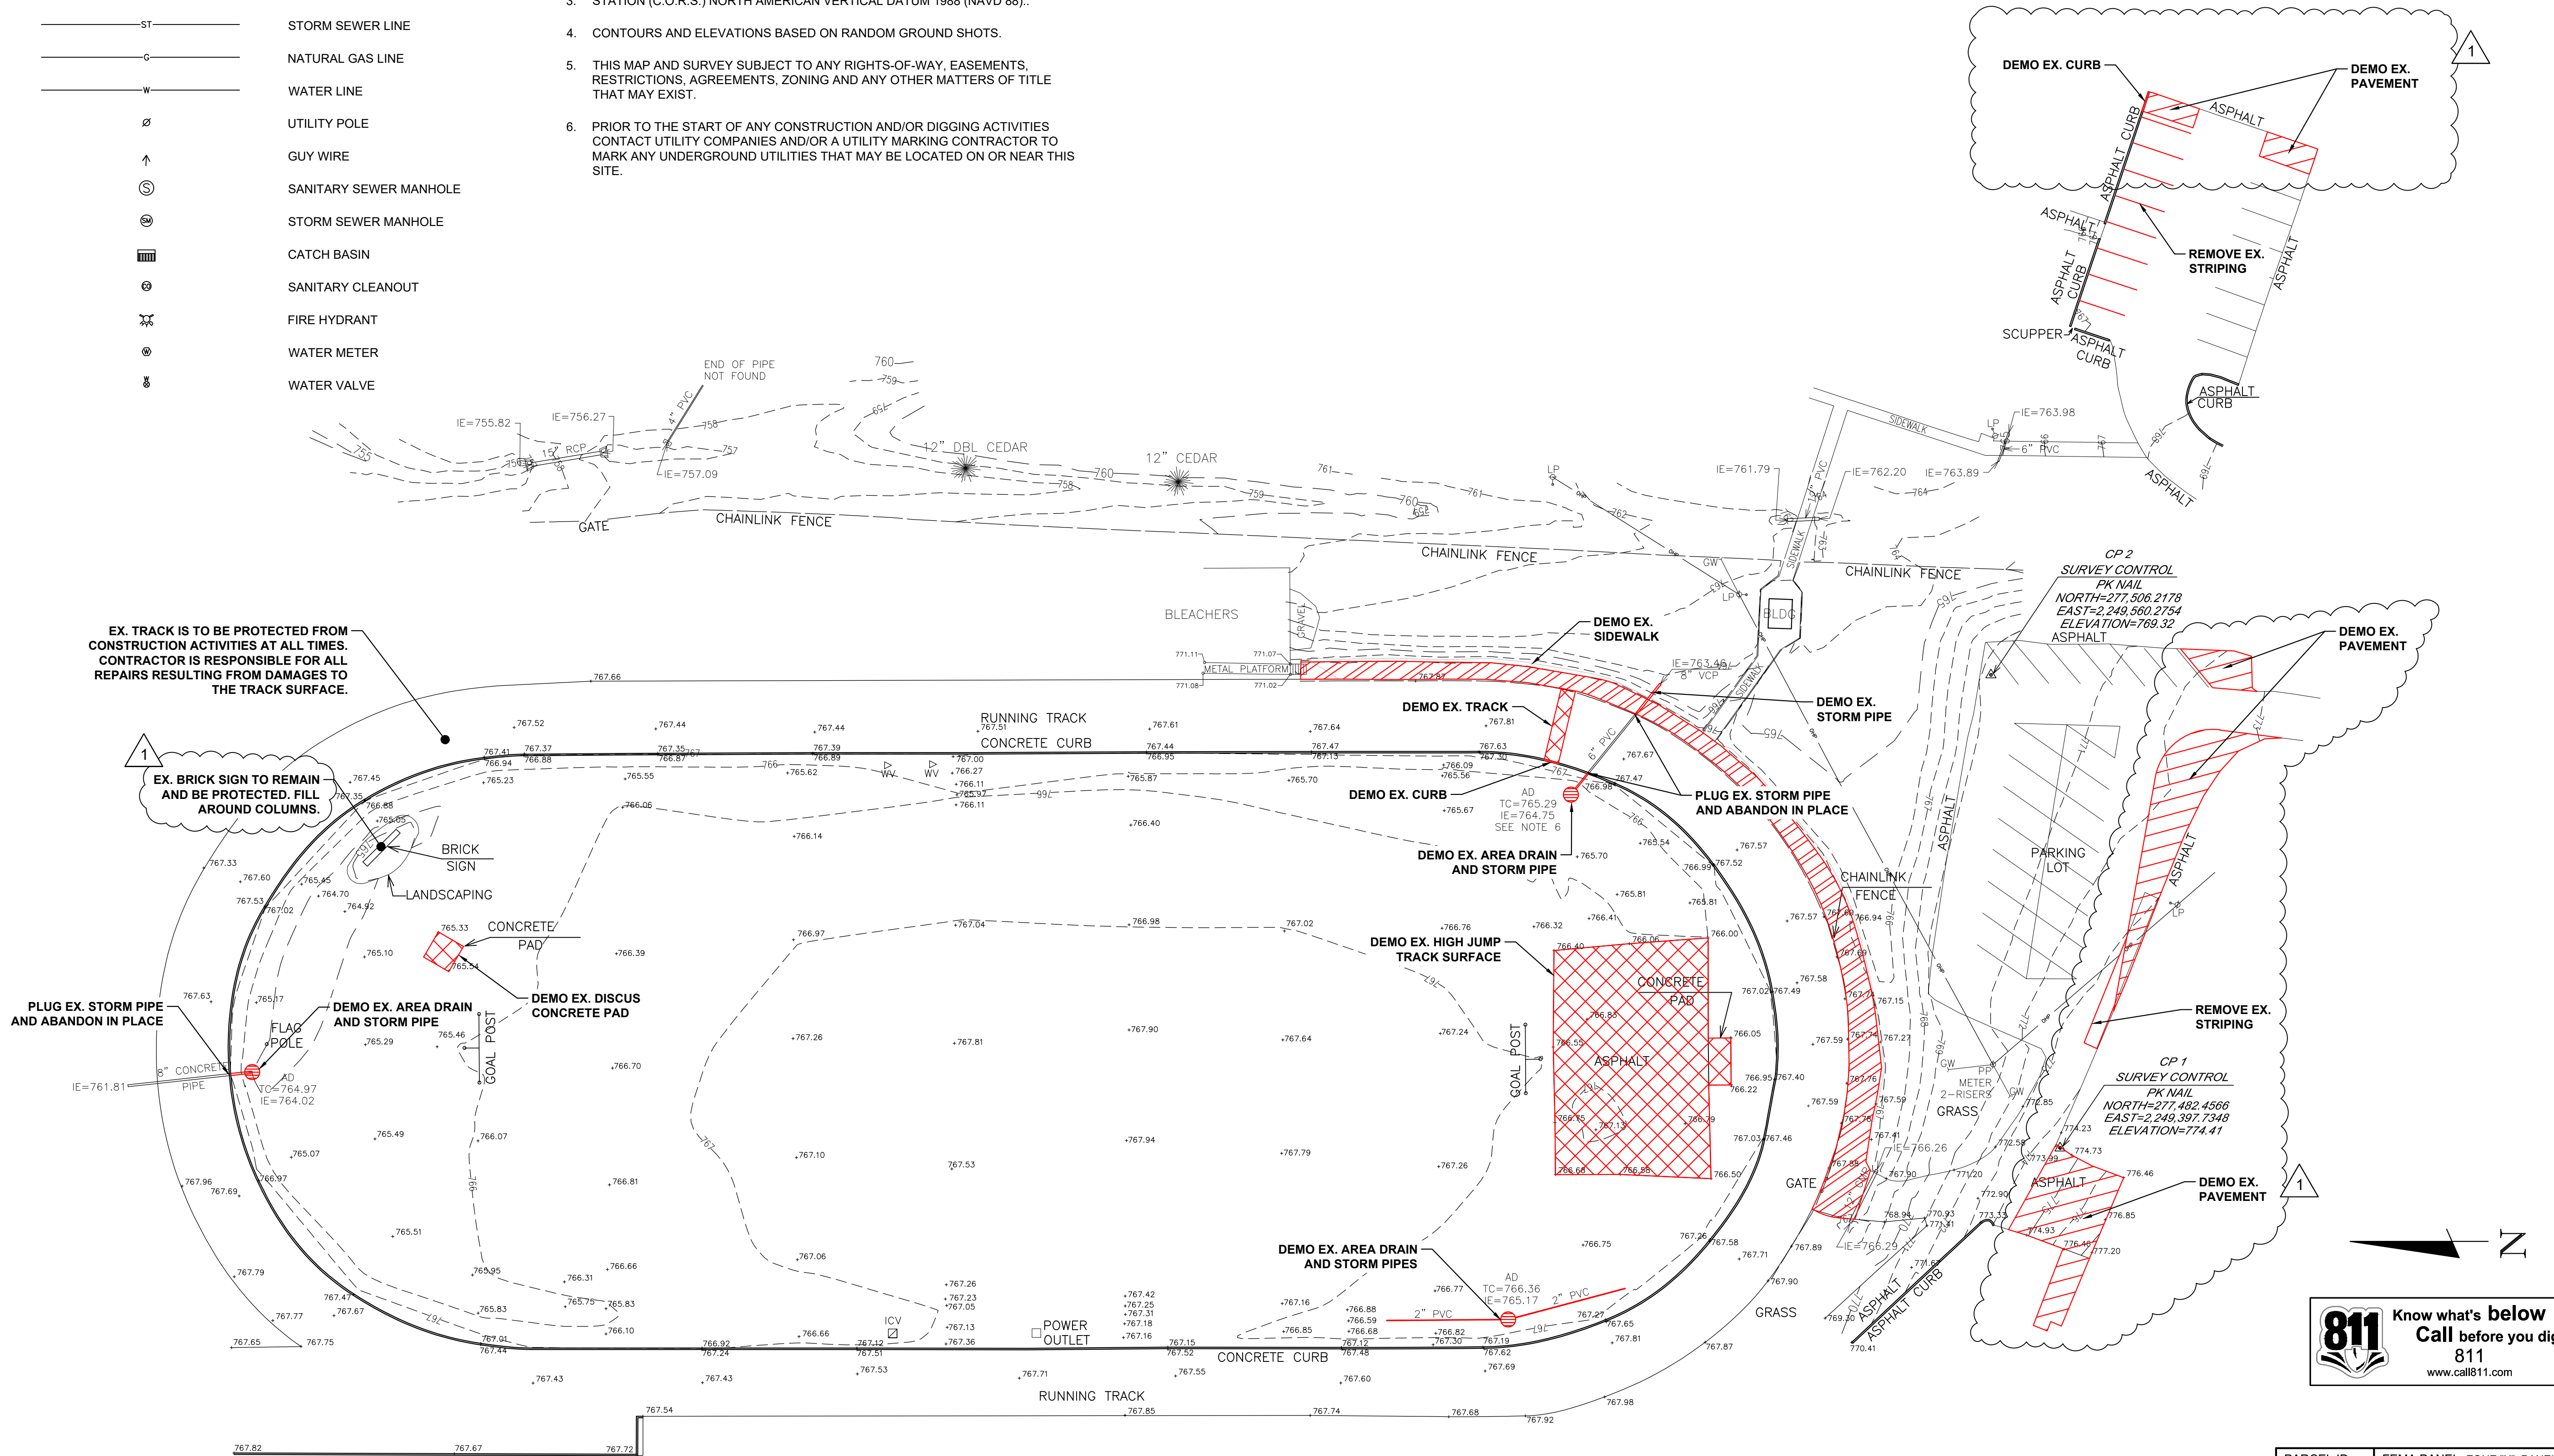


EX. TRACK IS TO BE PROTECTED FROM CONSTRUCTION ACTIVITIES AT ALL TIMES. CONTRACTOR IS RESPONSIBLE FOR ALL REPAIRS RESULTING FROM DAMAGES TO THE TRACK SURFACE.

EX. BRICK SIGN TO REMAIN AND BE PROTECTED. FILL AROUND COLUMNS.

**811** Know what's below  
Call before you dig.  
811  
www.call811.com

PARCEL ID: 123-007.01	FEMA PANEL: ZONE "X", PANEL NO. 47065C-0379G, 0381G, & 0383G, 2/3/16.
DATUM: TNSPC (NAD83) NAVD 1988	BENCHMARK: TAG BOLT ON HYDRANT # 15722. ELEV. 522.30'

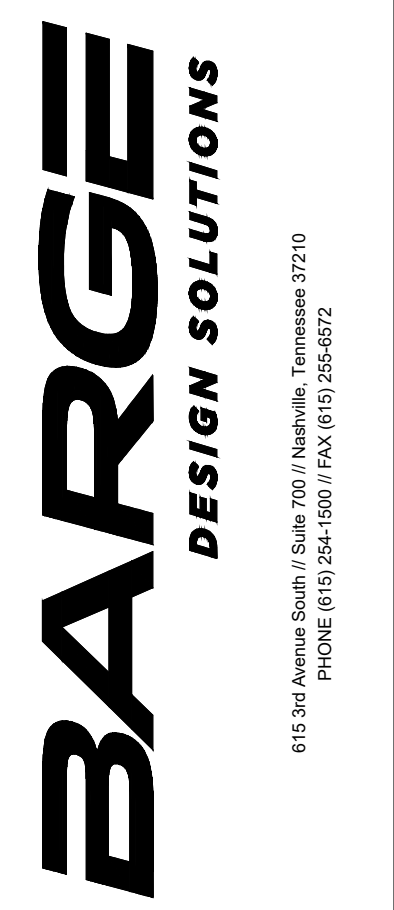

**EXISTING CONDITIONS**  
HAMILTON COUNTY SCHOOLS  
OOLTEWAH HIGH SCHOOL FOOTBALL/SOCCER  
FIELD RENOVATION  
HAMILTON COUNTY, TN

REV.	CHK.	DATE	DESCRIPTION
0	ASH	03/19/2024	ISSUED FOR BID
1	ECM	03/19/2024	ADDENDUM #1

**C0.21**  
FILE NO. 38505-00

USER:AGHIGHLANDER  
FILE:R:\38505\3850500\CAD\CIVIL\HSPLOT1\3850500-OHS-C0.21.dwg  
SAVED: 3/19/2024  
PLOTTED: 3/19/2024



### FINISHED GRADE & LAYOUT PLAN

HAMILTON COUNTY SCHOOLS  
**OOLTEWAH HIGH SCHOOL FOOTBALL/SOCCER FIELD RENOVATION**  
 HAMILTON COUNTY, TN



REVISION INFORMATION	
NO.	DESCRIPTION
0	ISSUED FOR BID
1	ADDENDUM #1

**C2.01**

FILE NO. 38505-00

### GRADING AND DRAINAGE NOTES

- SEE SHEET C0.01 FOR ADDITIONAL GRADING AND DRAINAGE NOTES.
- CONTRACTOR TO FIELD VERIFY LOCATIONS OF EXISTING UTILITIES PRIOR TO START OF CONSTRUCTION.
- CONTRACTOR TO CONSTRUCT FINISHED GRADE TO BE FLUSH WITH EXISTING STORM STRUCTURE CASTINGS. CONTRACTOR TO ENSURE SLOPES DRAIN TO EX. STORM STRUCTURES.
- PRIOR TO FINAL ACCEPTANCE BY THE CITY ENGINEER AND/OR ISSUANCE OF ANY CERTIFICATE OF OCCUPANCY, THE OWNER OR OWNERS AGENT SHALL:
  - SUBMIT AN INVENTORY OF THE CONSTRUCTED STORMWATER DRAINAGE SYSTEM, WHETHER PUBLIC OR PRIVATE, TO THE CITY OF CHATTANOOGA IN ELECTRONIC FORMAT. ELECTRONIC AS-BUILT DRAWINGS IN TENNESSEE STATE PLANE COORDINATES SHALL BE SUBMITTED IN AUTOCAD AND PDF FORMAT SHALL SHOW PLAINLY THE APPROVED AND CONSTRUCTED LAYOUT OF THE STORMWATER SYSTEMS. THE AS-BUILT DRAWING(S) SHALL INCLUDE ALL STORMWATER FEATURES, WHETHER NEW OR EXISTING, INCLUDING THE OUTFALL TO THE CITY DRAINAGE SYSTEM
  - COMPLY WITH ALL PERMANENT LANDSCAPE REQUIREMENTS AND SCHEDULE A LANDSCAPE INSPECTION WITH THE CITY OF CHATTANOOGA'S STORMWATER INSPECTOR. AN APPOINTMENT MAY BE MADE BY CALLING THE STORMWATER INSPECTOR A MINIMUM OF 2 BUSINESS DAYS BEFORE THE DESIRED INSPECTION APPOINTMENT.
  - ALL EROSION AND SEDIMENT CONTROL PRACTICES MUST COMPLY WITH THE CURRENT EDITION OF THE TN EROSION AND SEDIMENT CONTROL MANUAL, THE CITY OF CHATTANOOGA BMP MANUAL, AND THE TDEC CONSTRUCTION GENERAL PERMIT (IF APPLICABLE).

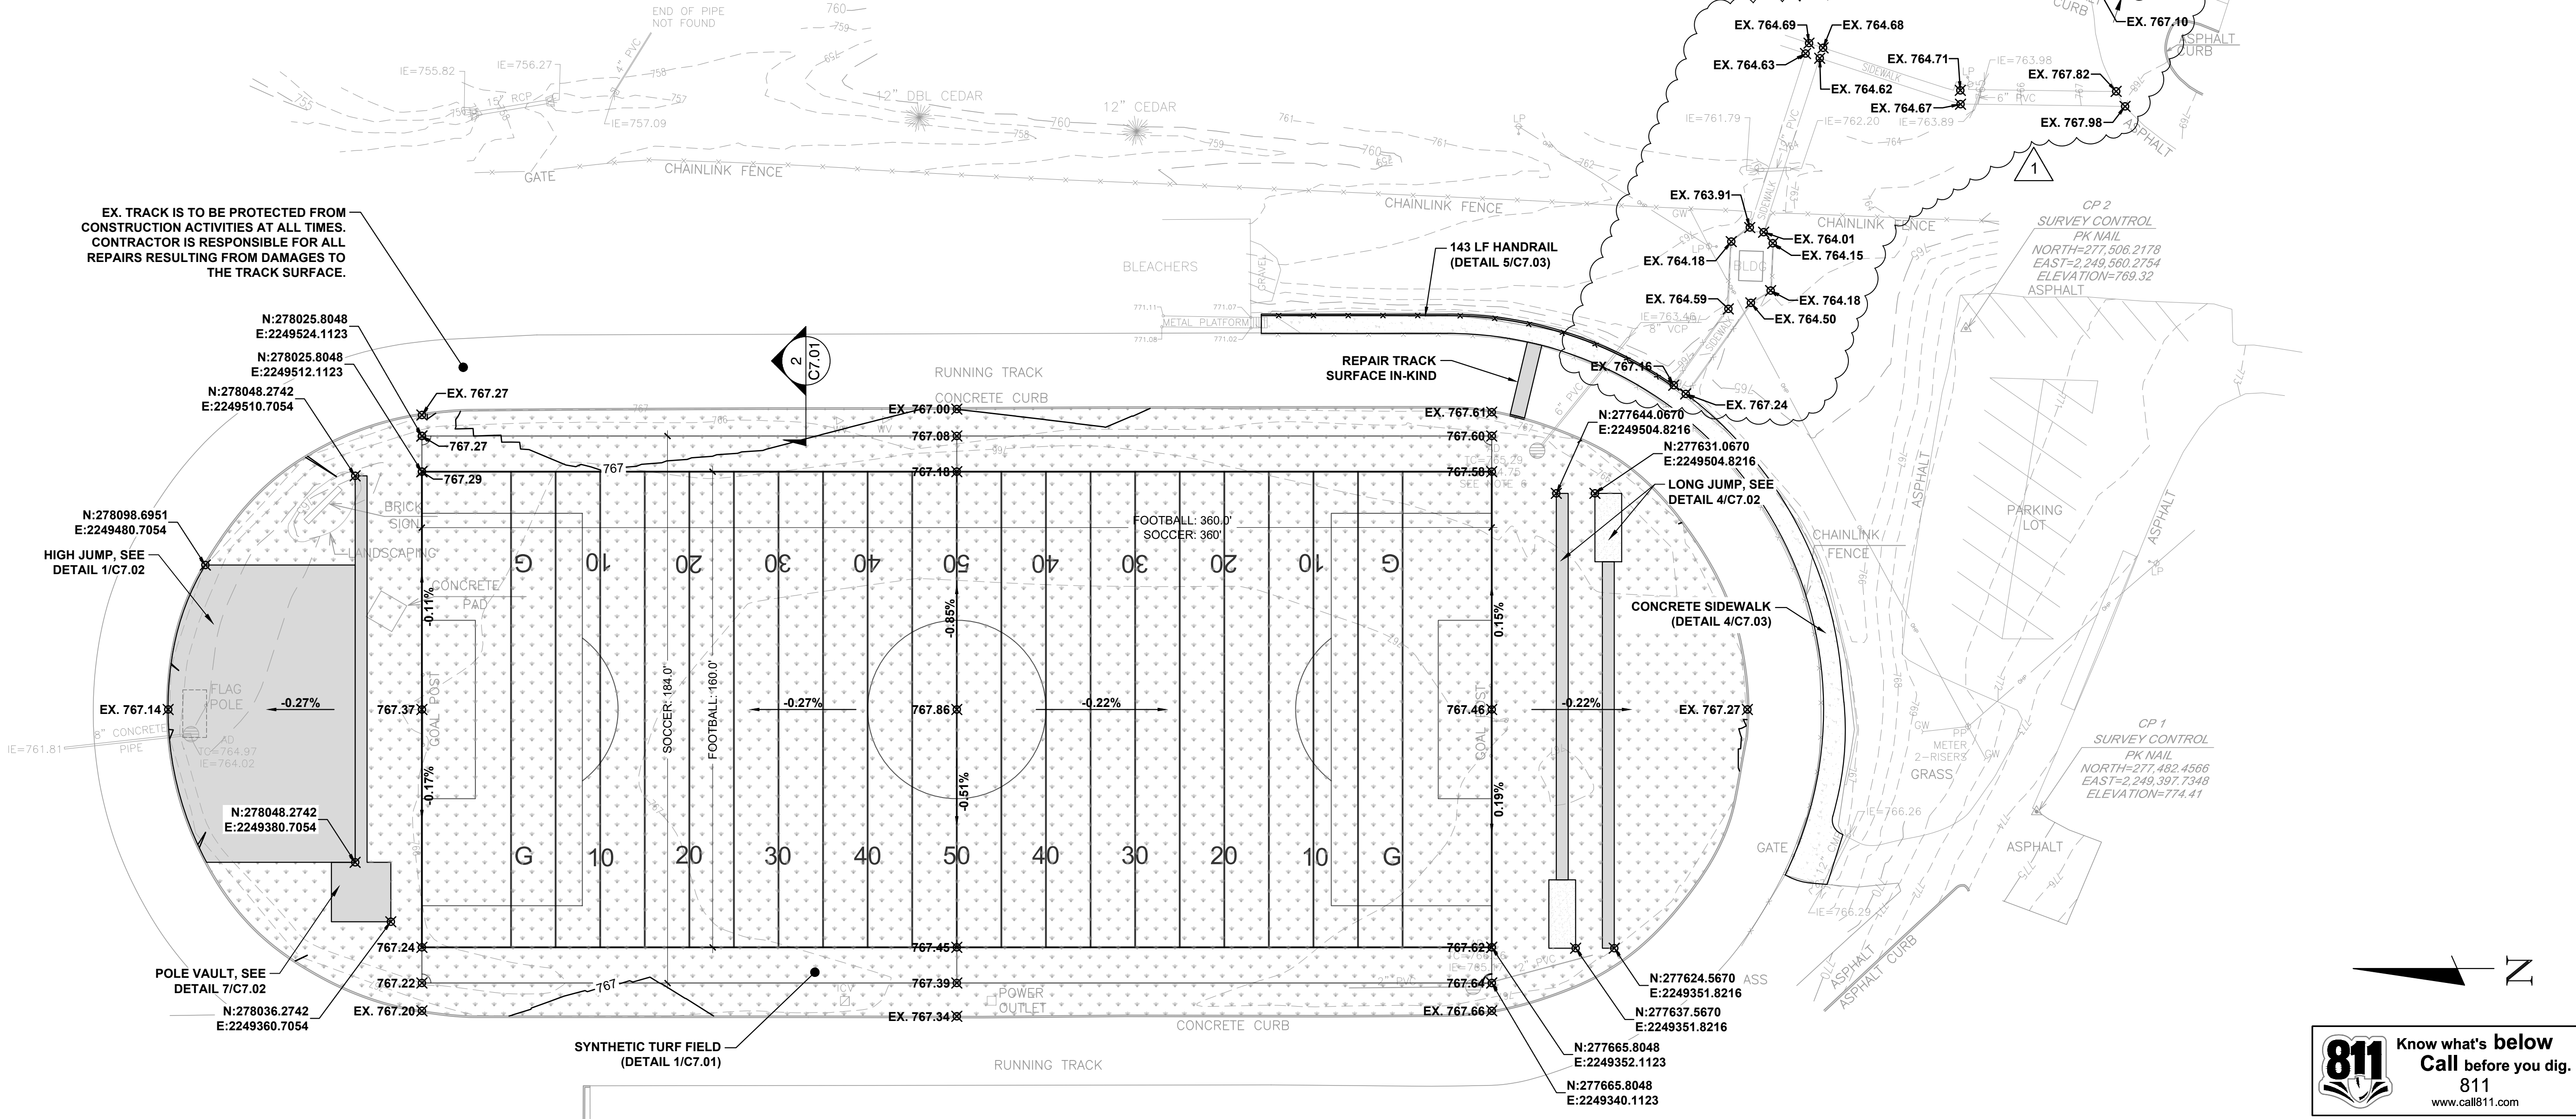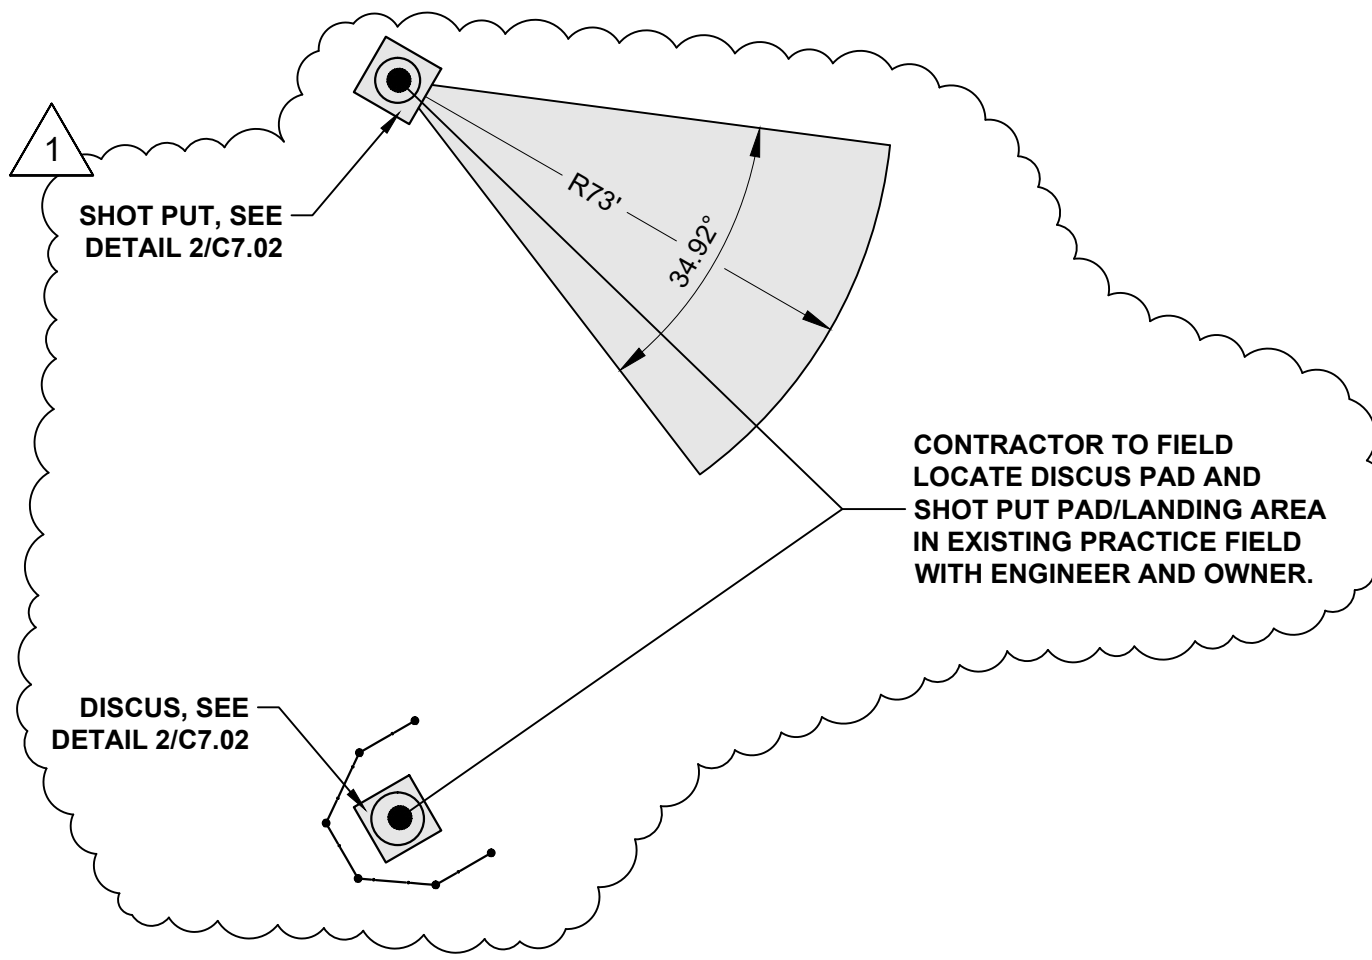


**811** Know what's below  
 Call before you dig.  
 811  
 www.call811.com


PARCEL ID: 123-007.01  
 FEMA PANEL: ZONE "X", PANEL NO. 47065C-0379G.0381G, & 0383G, 2/3/16.

DATUM: TNSPC (NAD83)  
 NAVD 1988  
 BENCHMARK: TAG BOLT ON HYDRANT # 15722. ELEV. 522.30'




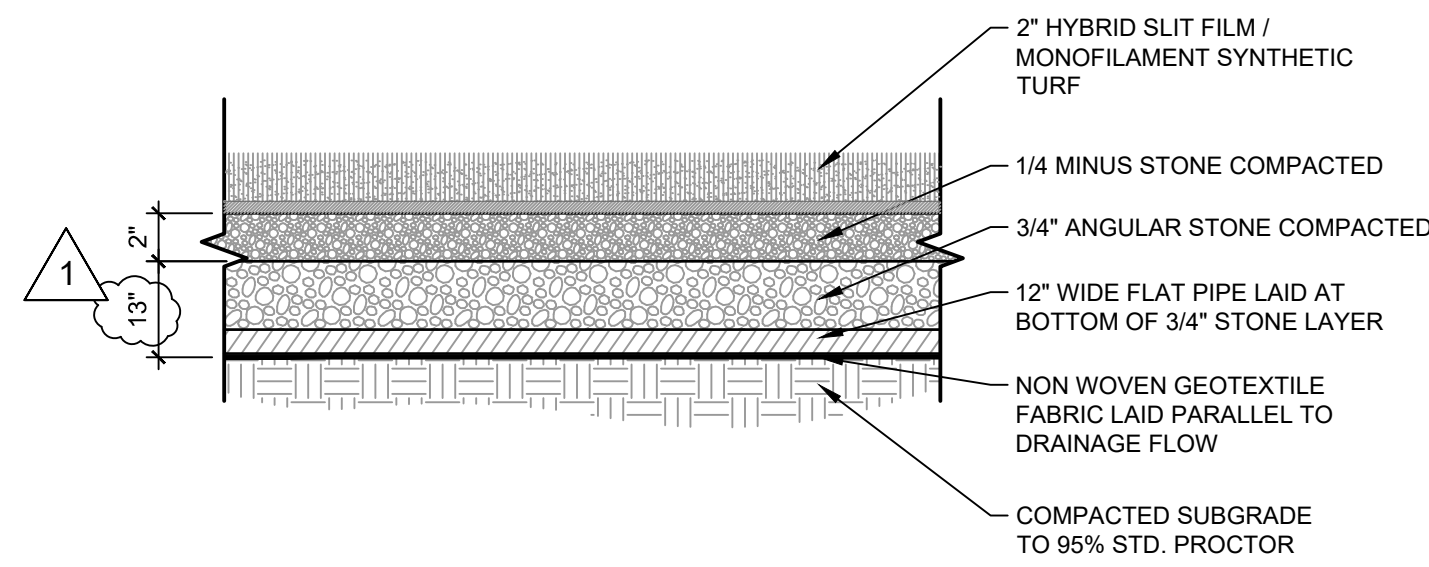


**1 SYNTHETIC TURF CROSS SECTION**  
 C7.01 1 1/2" = 1'-0"

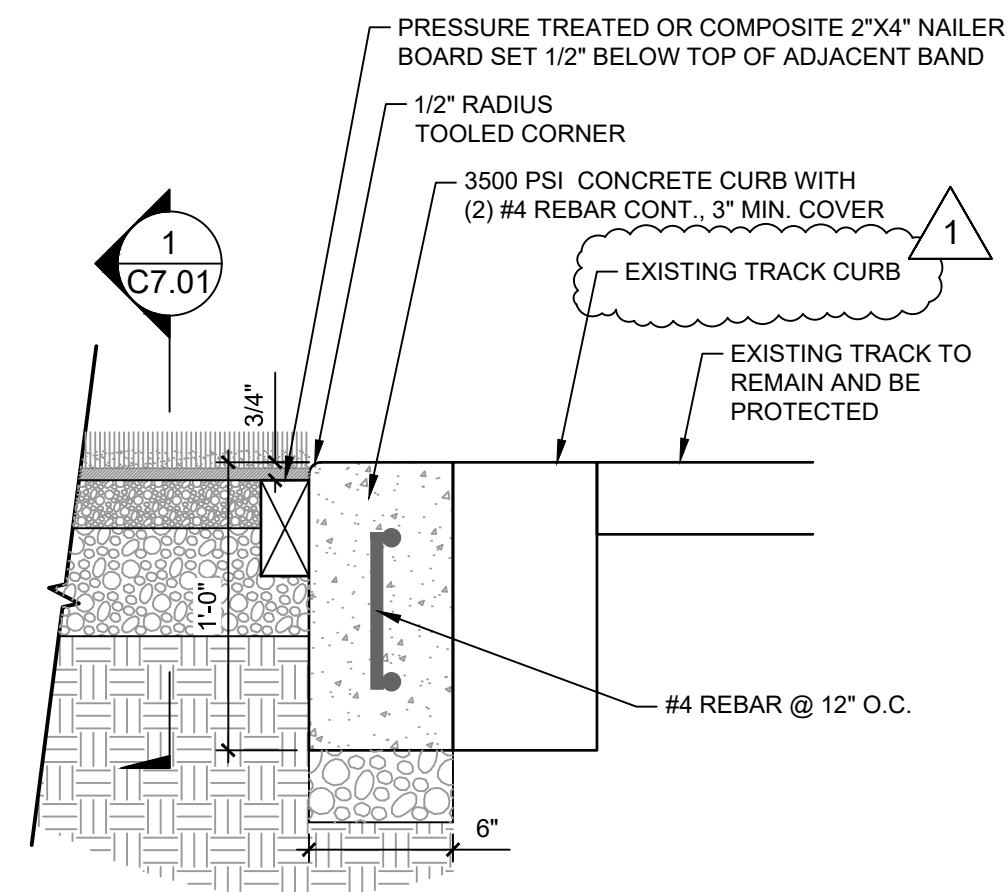

**2 CONCRETE EDGE BAND SYNTHETIC TURF / EXISTING TRACK**  
 C7.01 1 1/2" = 1'-0"

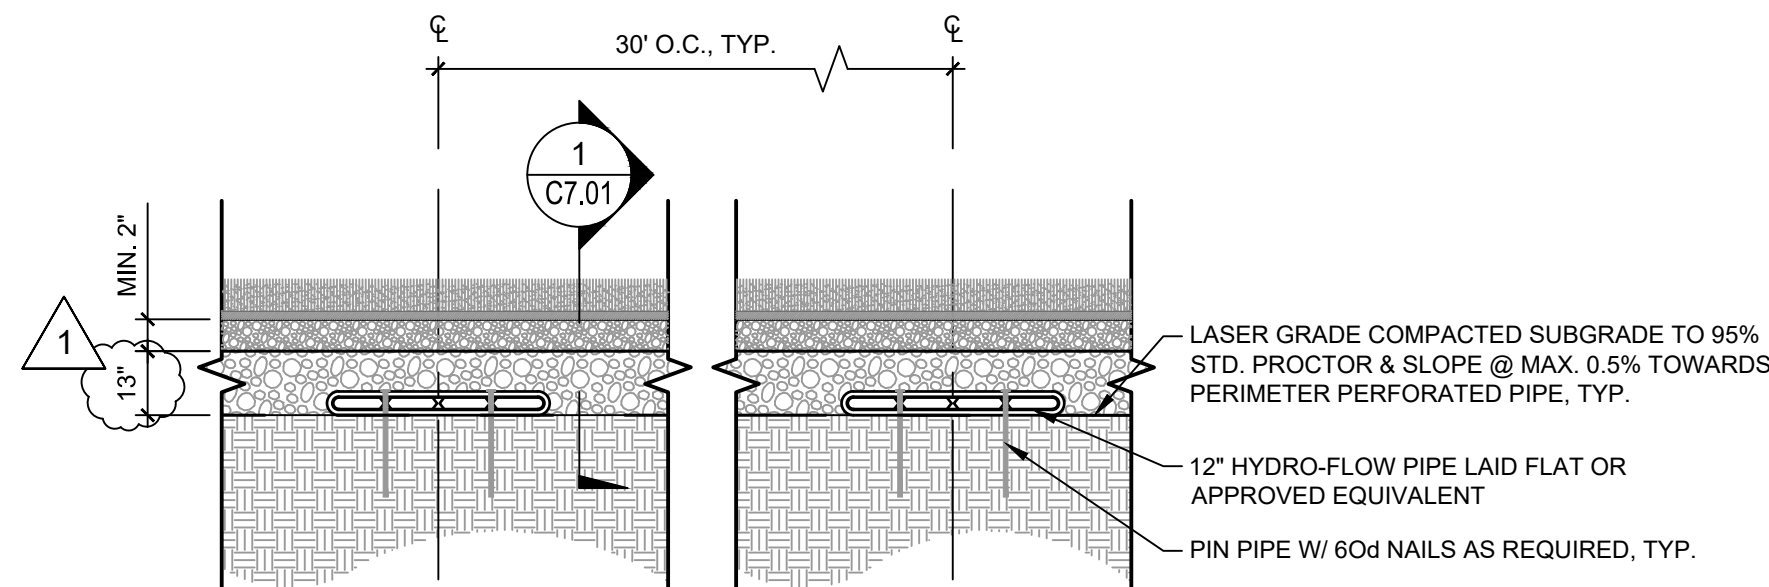

**3 TYPICAL TURF FIELD SUBDRAINAGE DETAIL**  
 C7.01 1" = 1'-0"

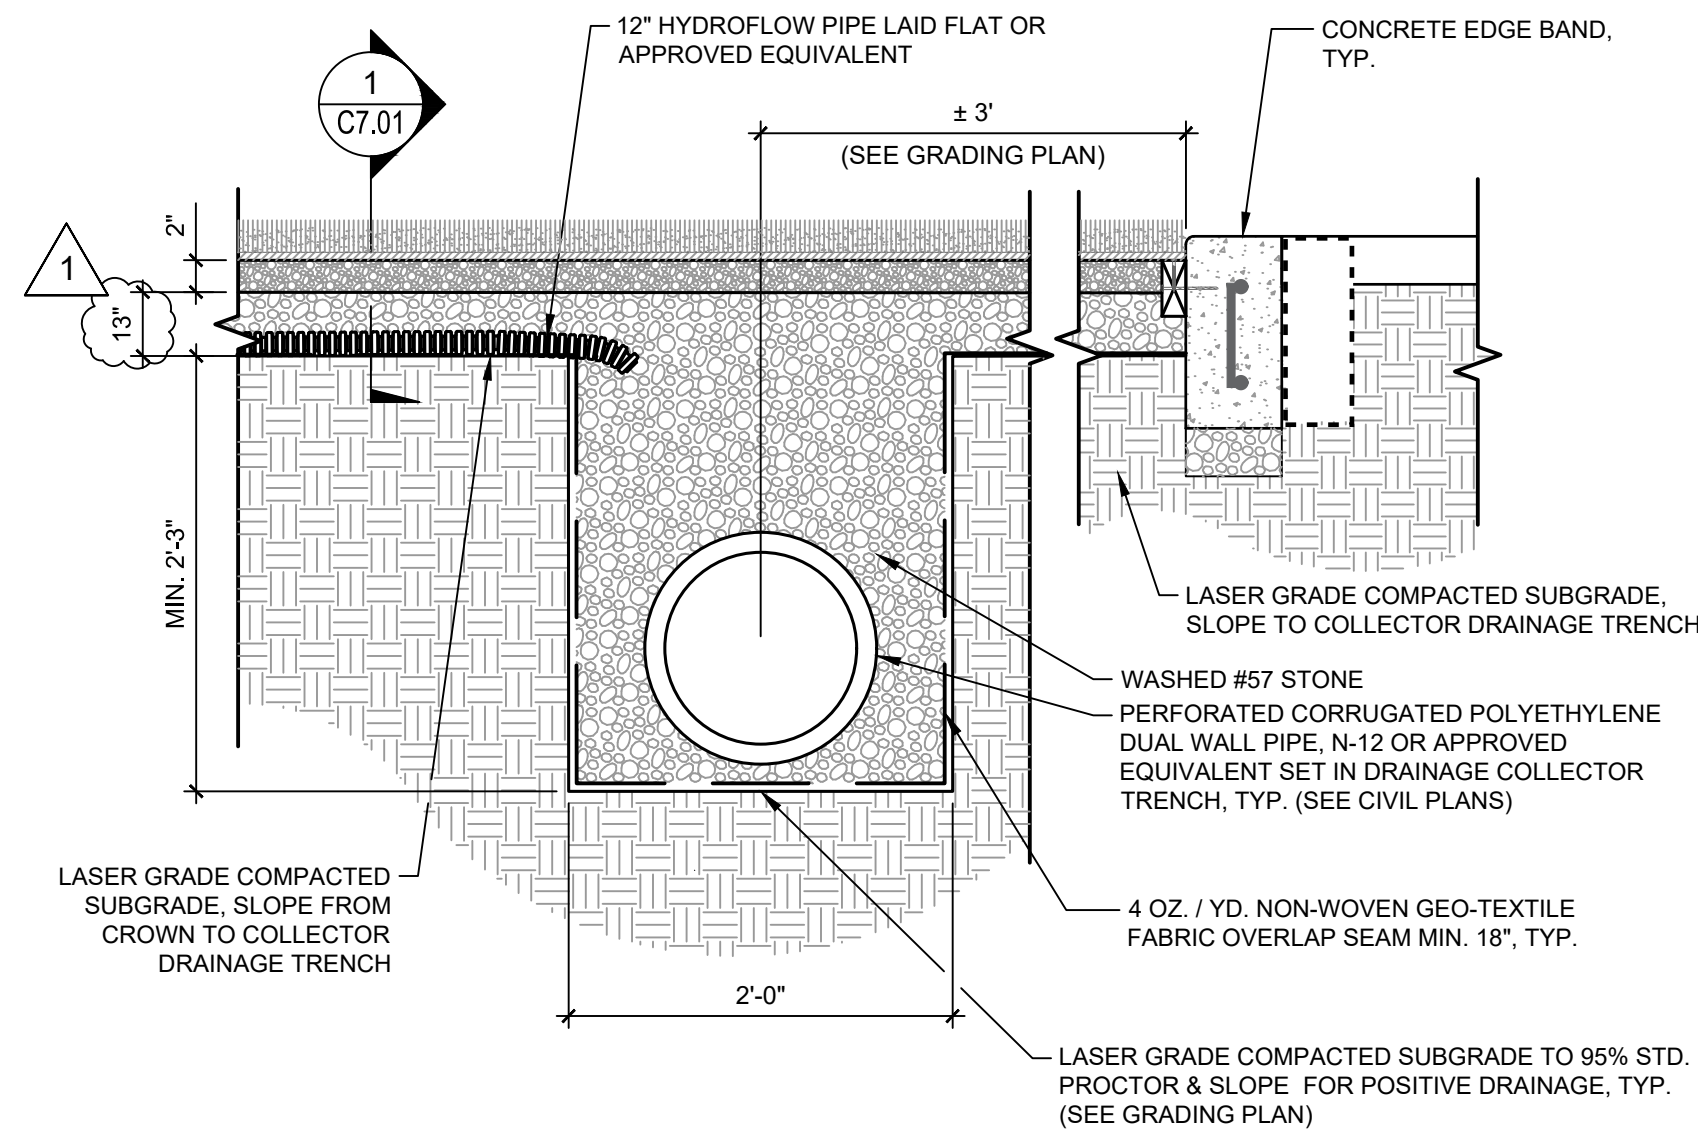


**4 SYNTHETIC TURF FIELD DRAINAGE COLLECTION**  
 C7.01 1" = 1'-0"

NOTE:  
 • SUBGRADE DRAINAGE SYSTEM SHOWN IS A MINIMUM REQUIREMENT. CONTRACTOR SHALL INSTALL SUBGRADE DRAINAGE SYSTEM AS RECOMMENDED BY THE MANUFACTURER OF THE SYNTHETIC TURF. DRAINAGE SHALL BE TIED INTO CIVIL ENGINEER'S DRAINAGE SYSTEM.  
 • \*FOR PERMEABLE APPLICATION: MIRAFI 140N OR APPROVED EQUIVALENT. FOR SILTY/CLAY SUBGRADES W/ FINES CONTENT <35% AND A PI <20: MIRAFI 500X OR APPROVED EQUIVALENT.



**SITE DETAILS**  
 HAMILTON COUNTY SCHOOLS  
 OOLTEWAH HIGH SCHOOL FOOTBALL/SOCCER  
 FIELD RENOVATION  
 HAMILTON COUNTY, TN


REVISION INFORMATION		DATE	DESCRIPTION
REV.	CHK.	DATE	DESCRIPTION
0	ECM	03/19/2024	ISSUED FOR BID
1	ECM	03/19/2024	ADDENDUM #1

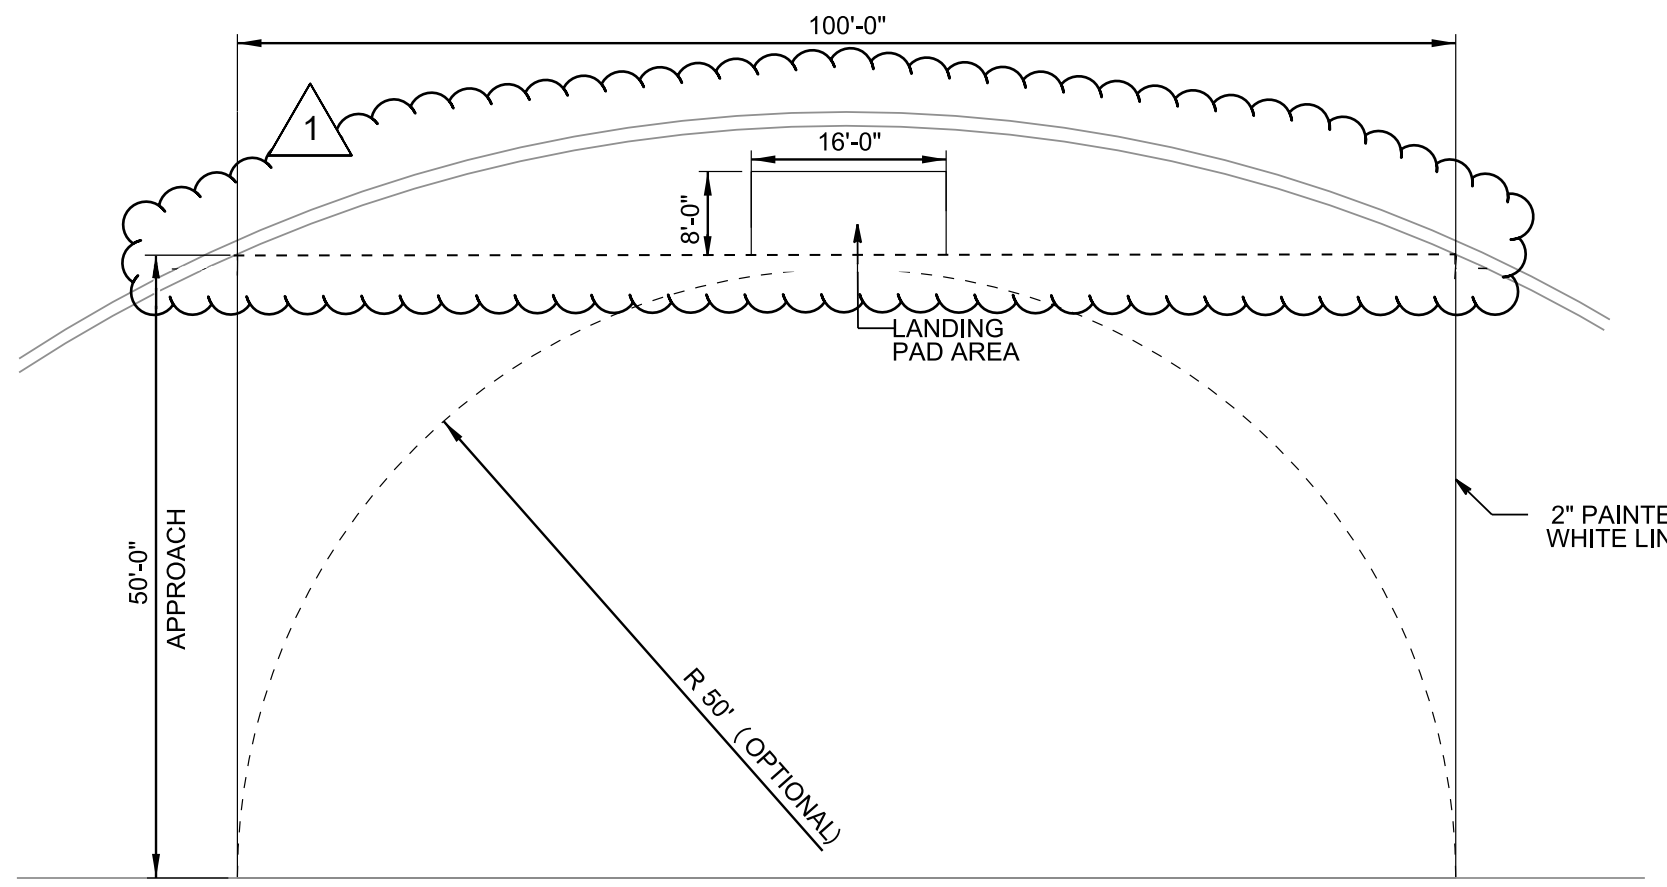

**GENERAL NOTES:**

- HIGH JUMP SHALL MEET NFSSHA (NATIONAL FEDERATION OF STATE HIGH SCHOOL ASSOCIATIONS) FIELD EVENT STANDARDS.


**1 HIGH JUMP DIAGRAM**  
C7.02 NTS

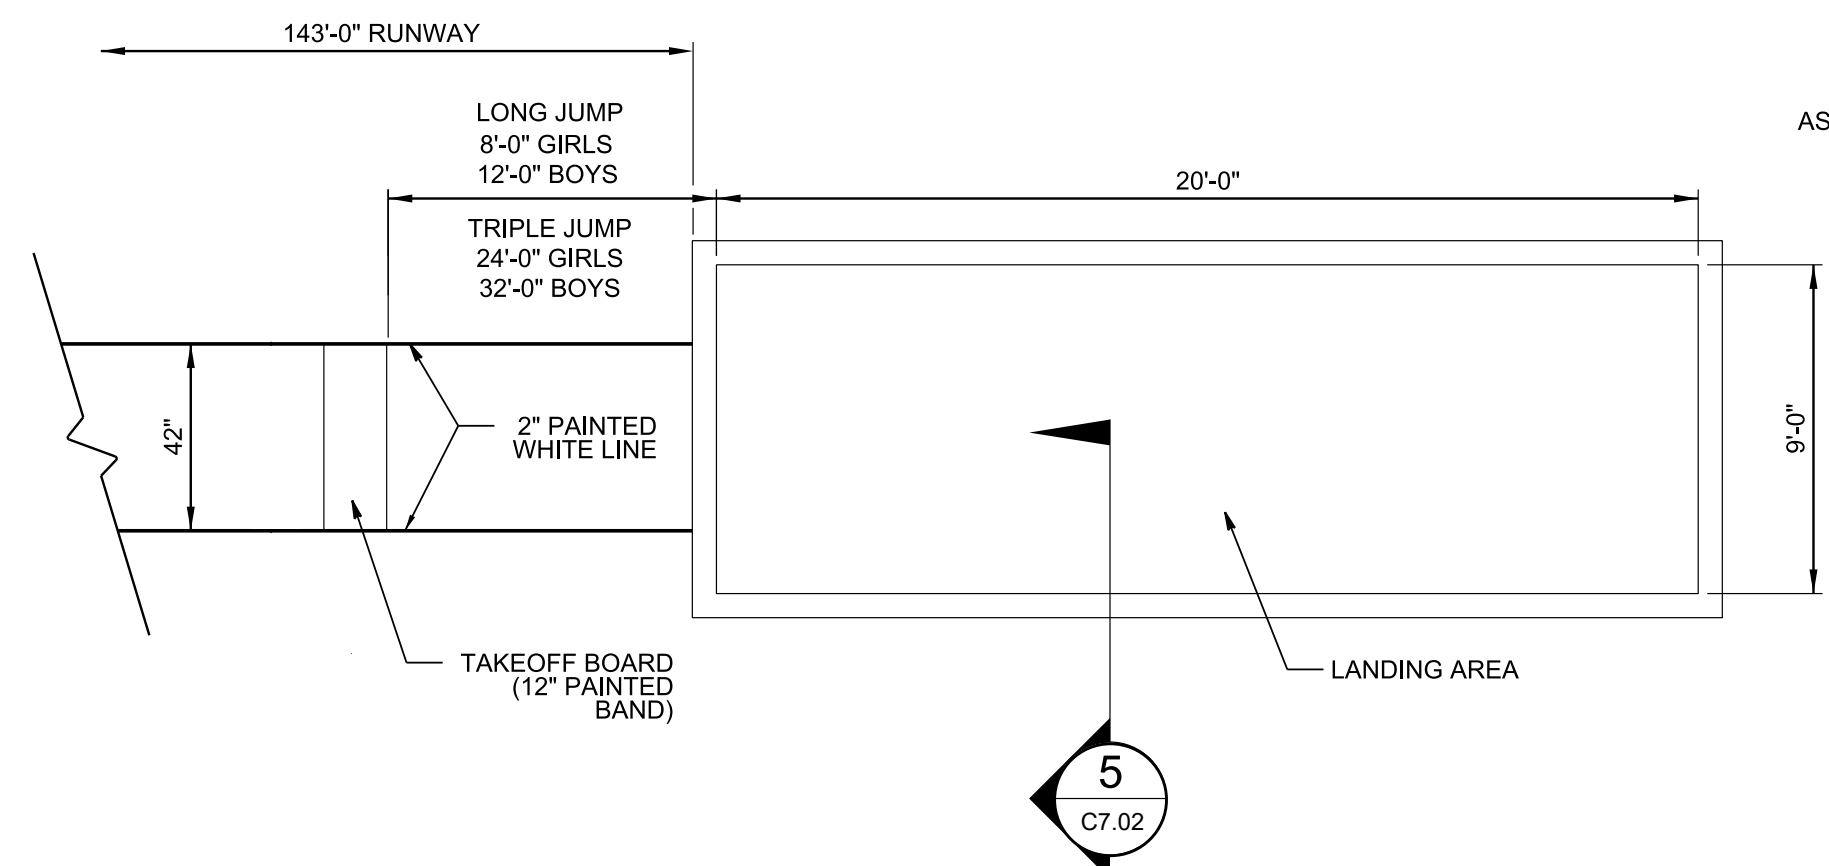


**GENERAL NOTES:**

- LONG JUMP/TRIPLE JUMP SHALL MEET NFSSHA (NATIONAL FEDERATION OF STATE HIGH SCHOOL ASSOCIATIONS) FIELD EVENT STANDARDS.
- ALL MARKINGS FOR BOYS LONG JUMP/TRIPLE JUMP SHALL BE PAINTED WHITE.
- ALL MARKINGS FOR GIRLS LONG JUMP/TRIPLE JUMP SHALL BE PAINTED YELLOW.


**4 LONG JUMP/TRIPLE JUMP DETAILED PLAN**  
C7.02 NTS

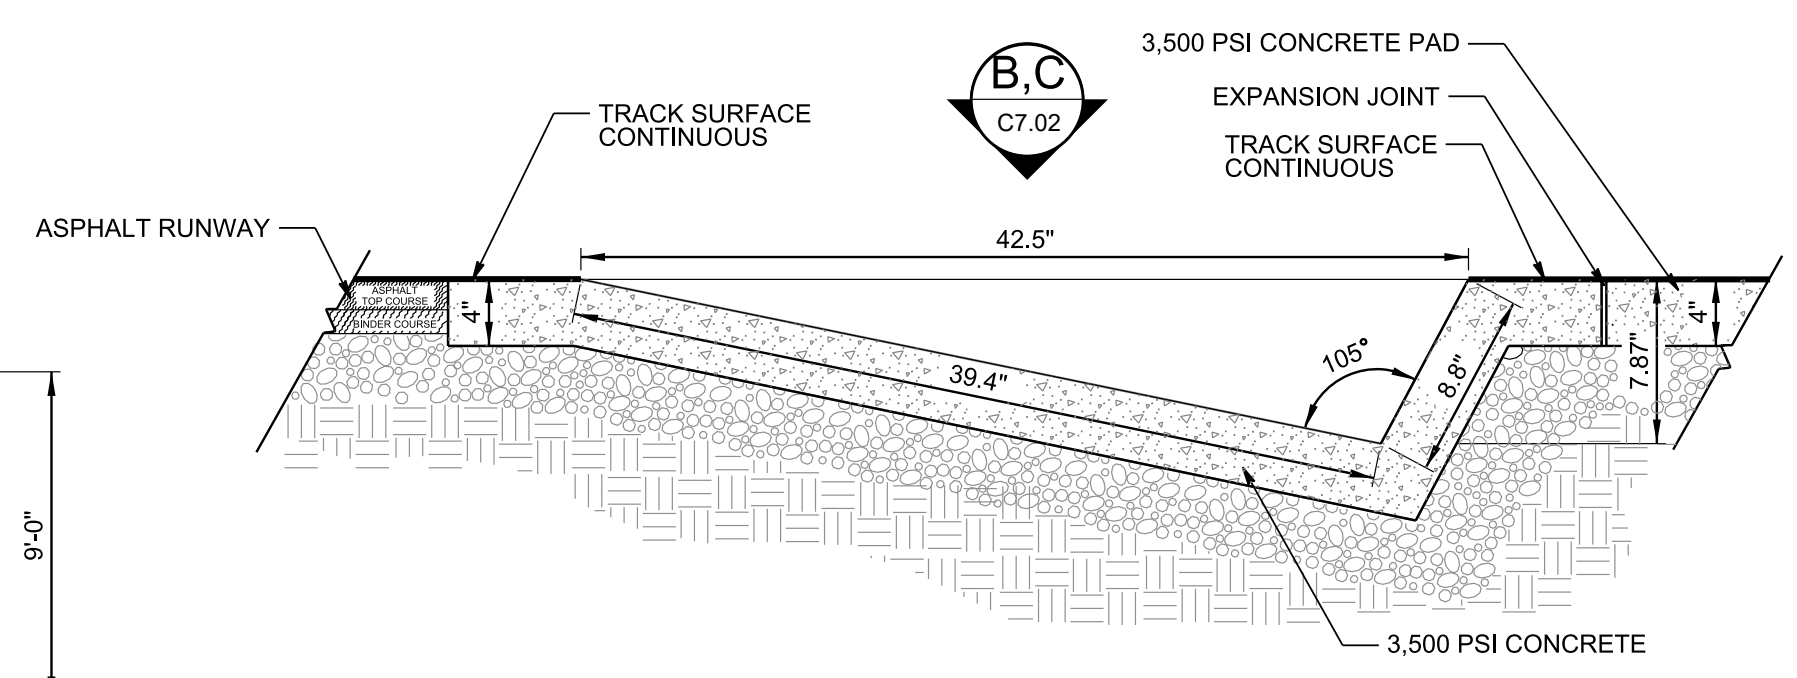

**A STOPBOARD SECTION**

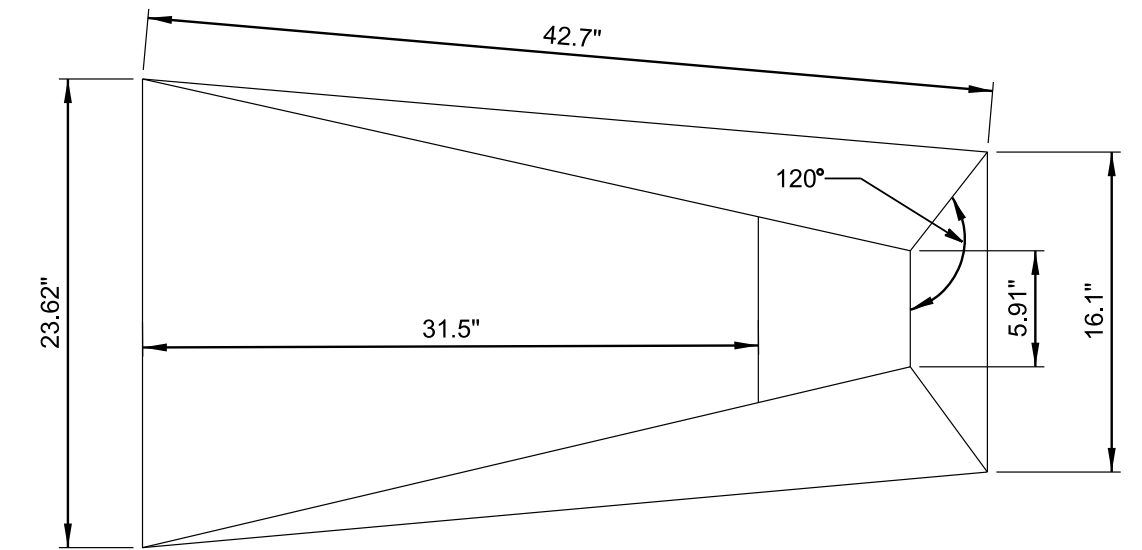


**B STOPBOARD PLAN**

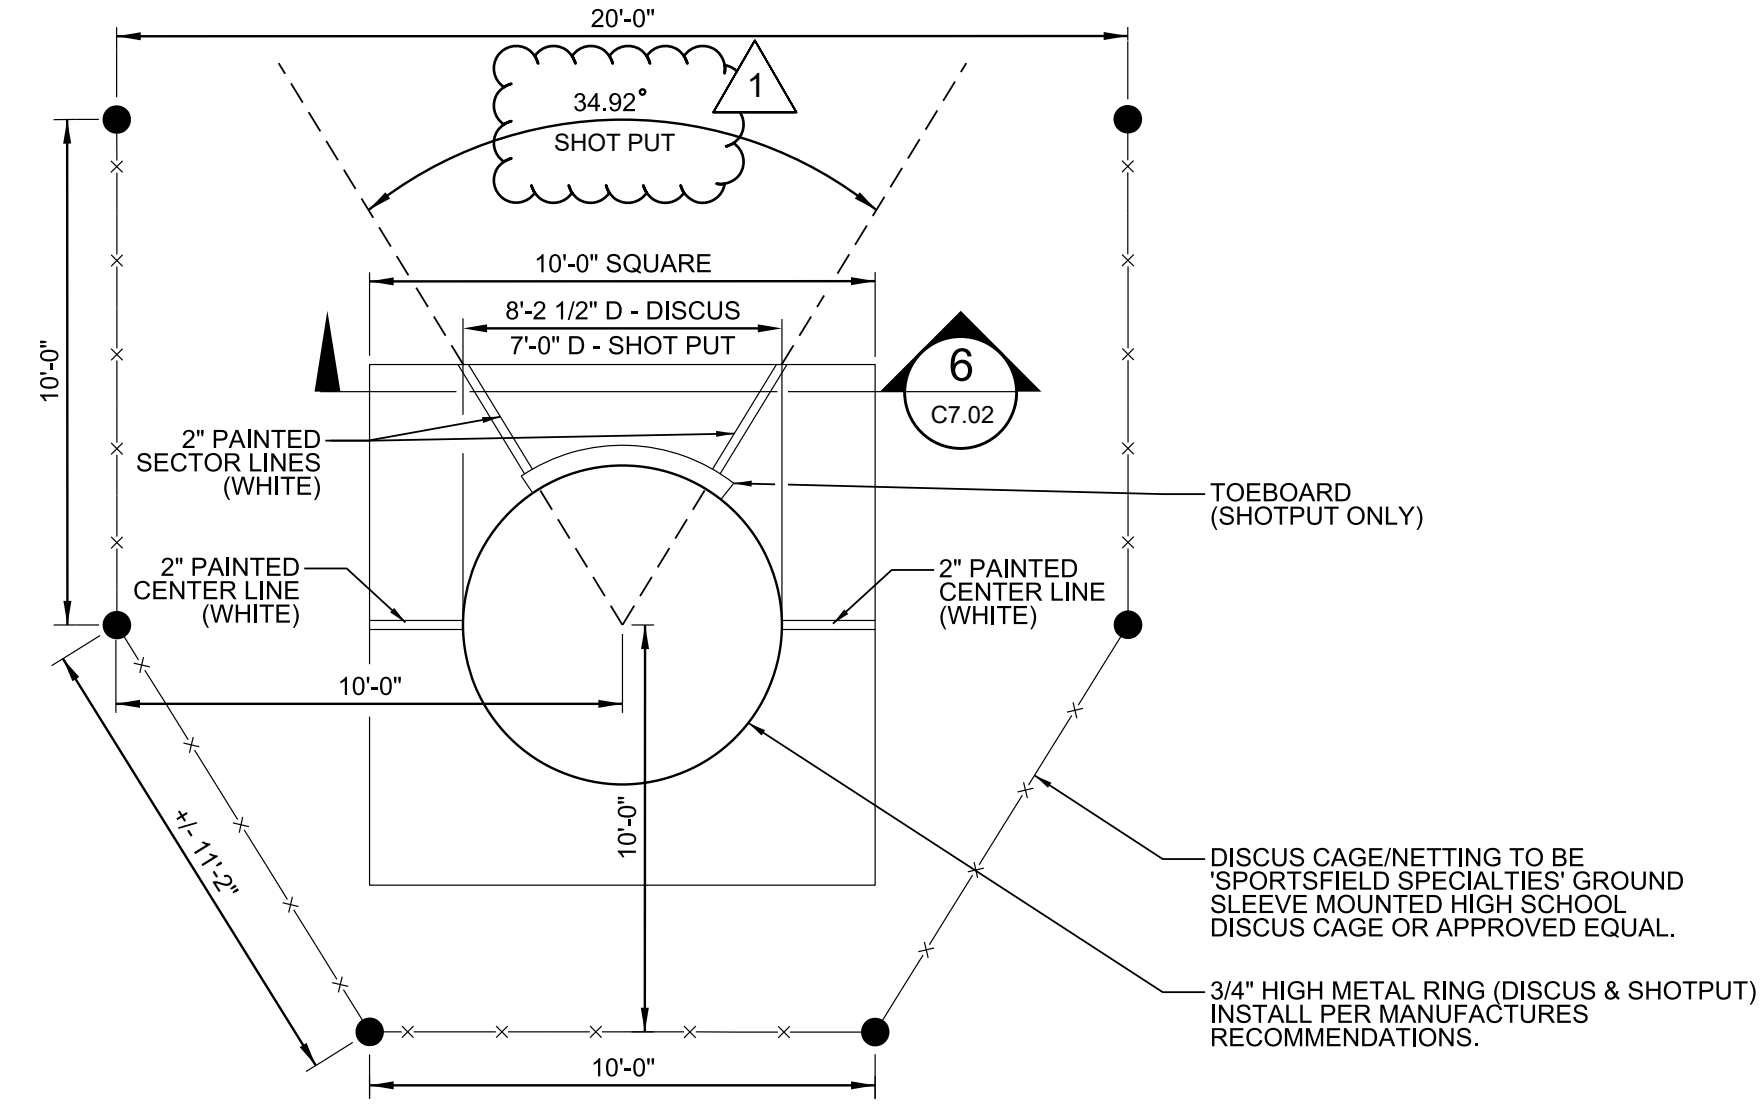

**GENERAL NOTES:**

- DISCUS/SHOT PUT SHALL MEET NFSSHA (NATIONAL FEDERATION OF STATE HIGH SCHOOL ASSOCIATIONS) FIELD EVENT STANDARDS.


**2 DISCUS/SHOT PUT PAD & FENCING DETAIL**  
C7.02 NTS

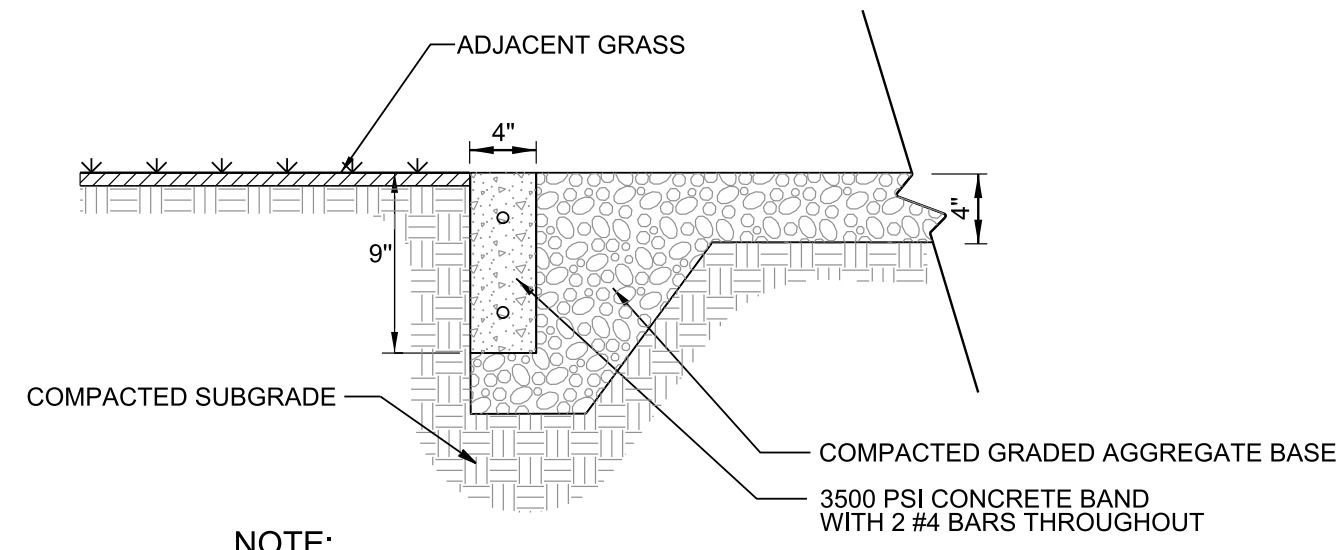

**NOTE:**


- SHOT PUT AGGREGATE DEPTH AND SURFACE AREA TO MEET NHFS FIELD EVENT STANDARDS.

**3 SHOT PUT LANDING AREA SECTION**  
C7.02 NTS

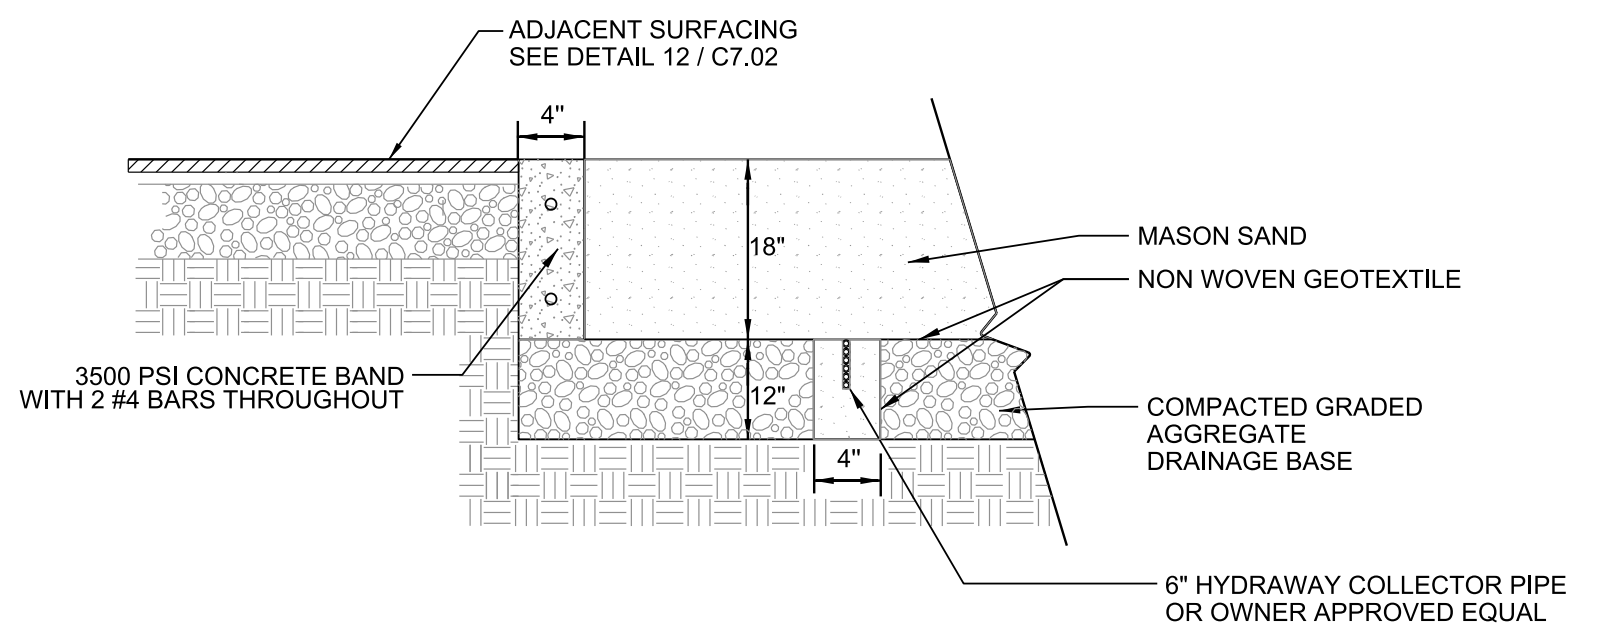


**INSTALL HYDROWAY IN THE CENTER OF THE TRENCH. BACKFILL MATERIAL SHOULD BE A VERY COARSE SAND. MIN. RECOMMENDED SLOPE 1%.**

**5 LONG JUMP LANDING SECTION**  
C7.02 NTS

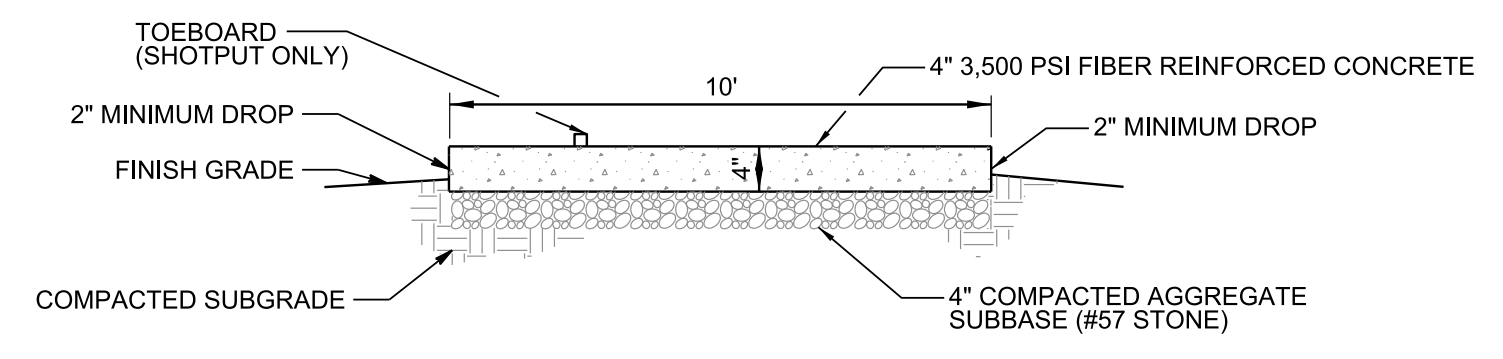

**6 DISCUS/SHOT PUT PAD SECTION**  
C7.02 NTS

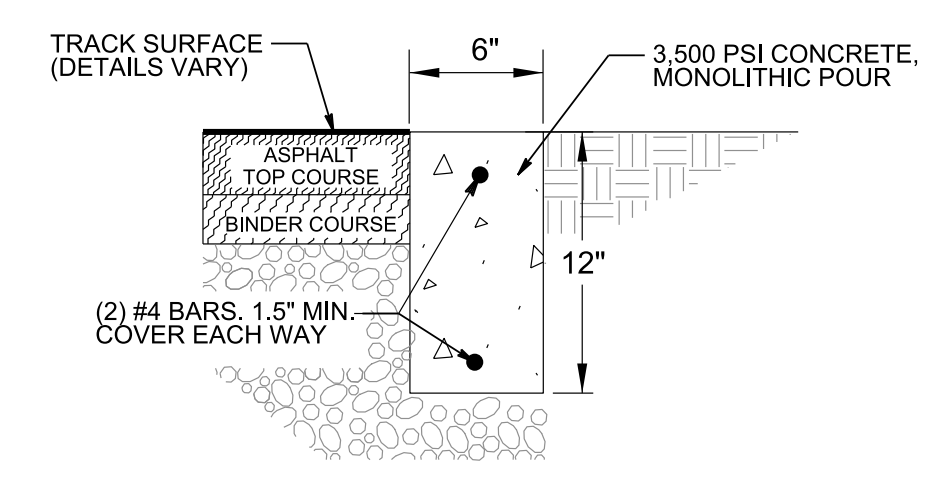


**D RUNWAY SECTION**

**GENERAL NOTES:**

- POLE VAULT SHALL MEET NFSSHA (NATIONAL FEDERATION OF STATE HIGH SCHOOL ASSOCIATIONS) FIELD EVENT STANDARDS.
- STOP BOARD TO BE INSTALLED PER MANUFACTURERS SPECIFICATIONS.


**7 POLE VAULT DIAGRAM**  
C7.02 NTS

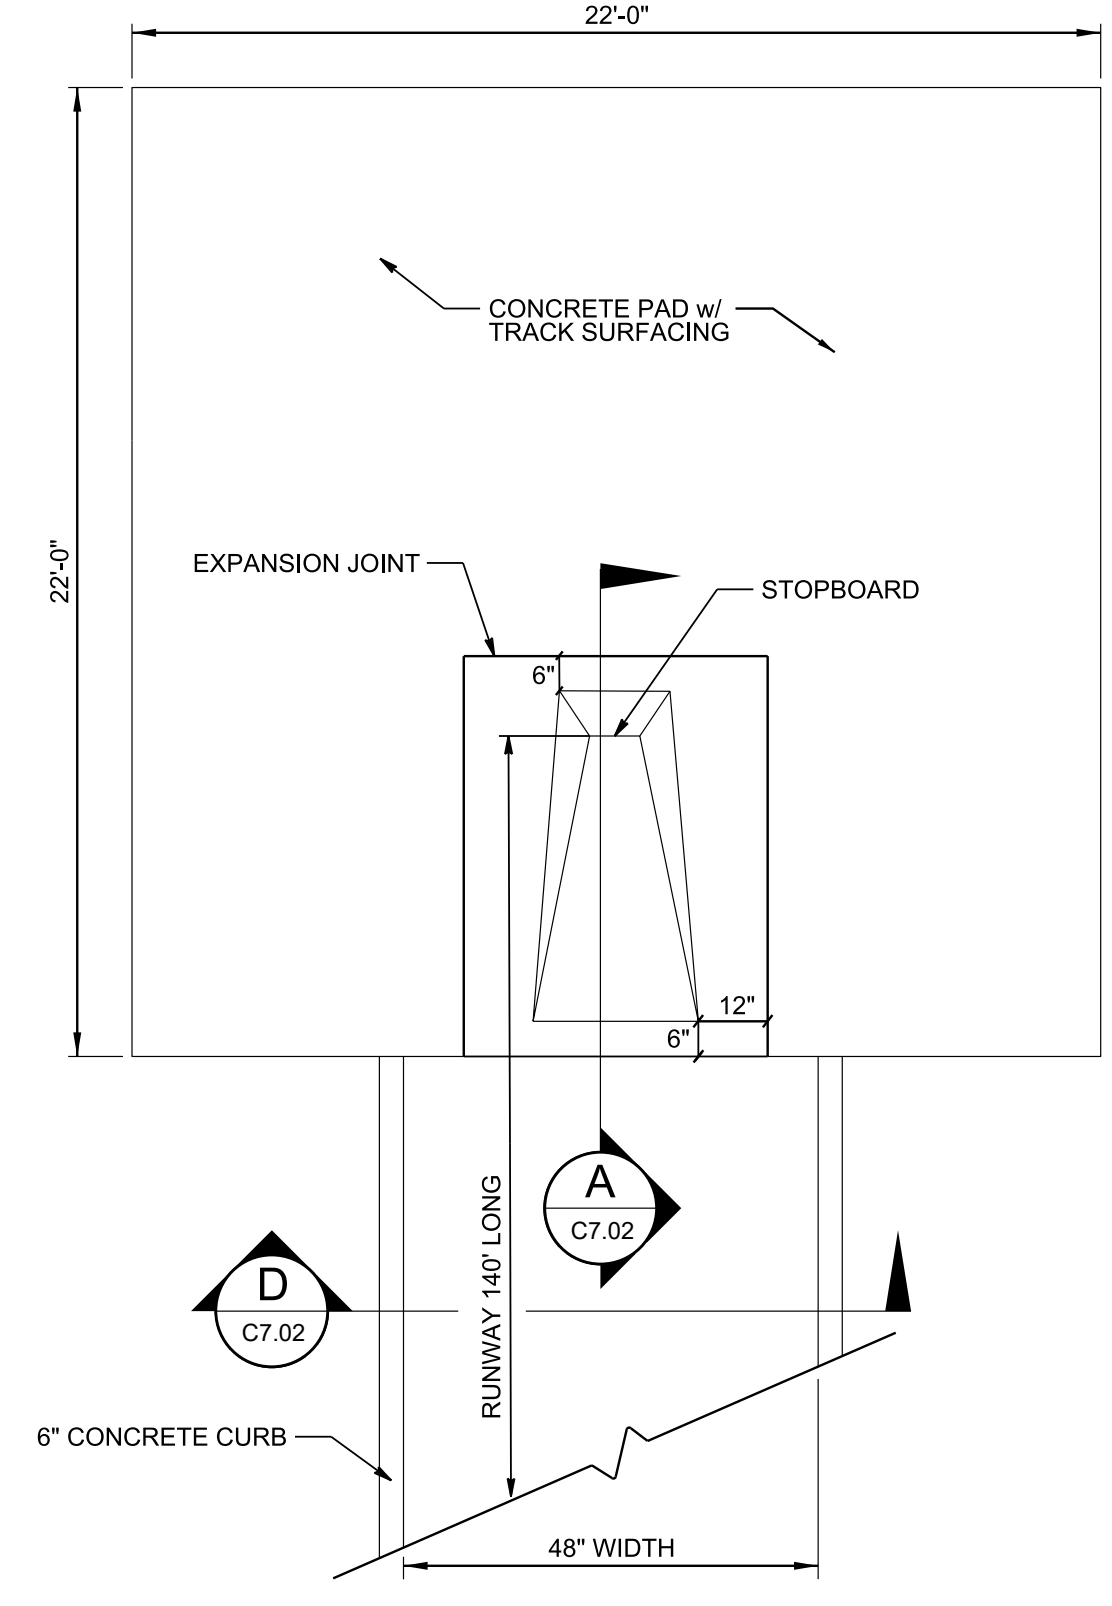

**C OVERALL PLAN**

REV.	CHK.	DATE	DESCRIPTION
0	ECM	03/19/2024	ISSUED FOR BID
1	ECM	03/19/2024	ADDENDUM #1




2 SIGN C7.03 ACCESSIBLE  
 2 SIGN C7.03 VAN ACCESSIBLE (SEE PLAN)

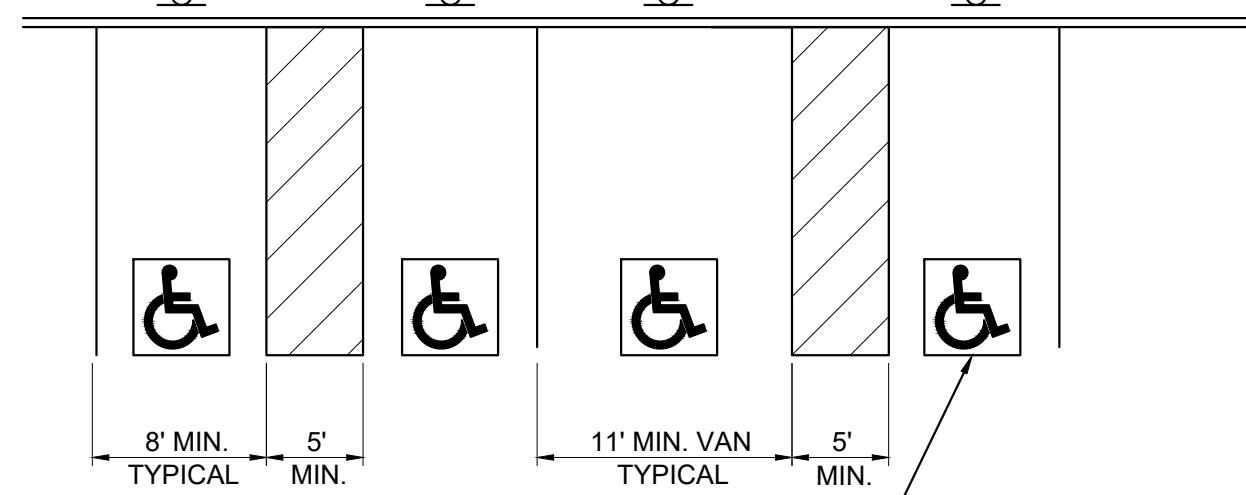

3 DETAIL C7.03


NOTE: 1.75% MAXIMUM SLOPE IN PARKING AREA, ALL DIRECTIONS

- NOTES:
- SEE SITE PLAN FOR COMPLETE LAYOUT
  - THESE DETAILS ARE FOR REFERENCE AND DIMENSION CONTROL ONLY
  - ALL DIMENSIONS ARE TO CENTER LINE OF STRIPE UNLESS OTHERWISE NOTED
  - STROKE WIDTH SHALL BE 4"
  - INTERNATIONAL SYMBOL OF ACCESSIBILITY TO BE PAINTED WHITE WITH A BLUE BACKGROUND AND OPTIONAL WHITE BORDER

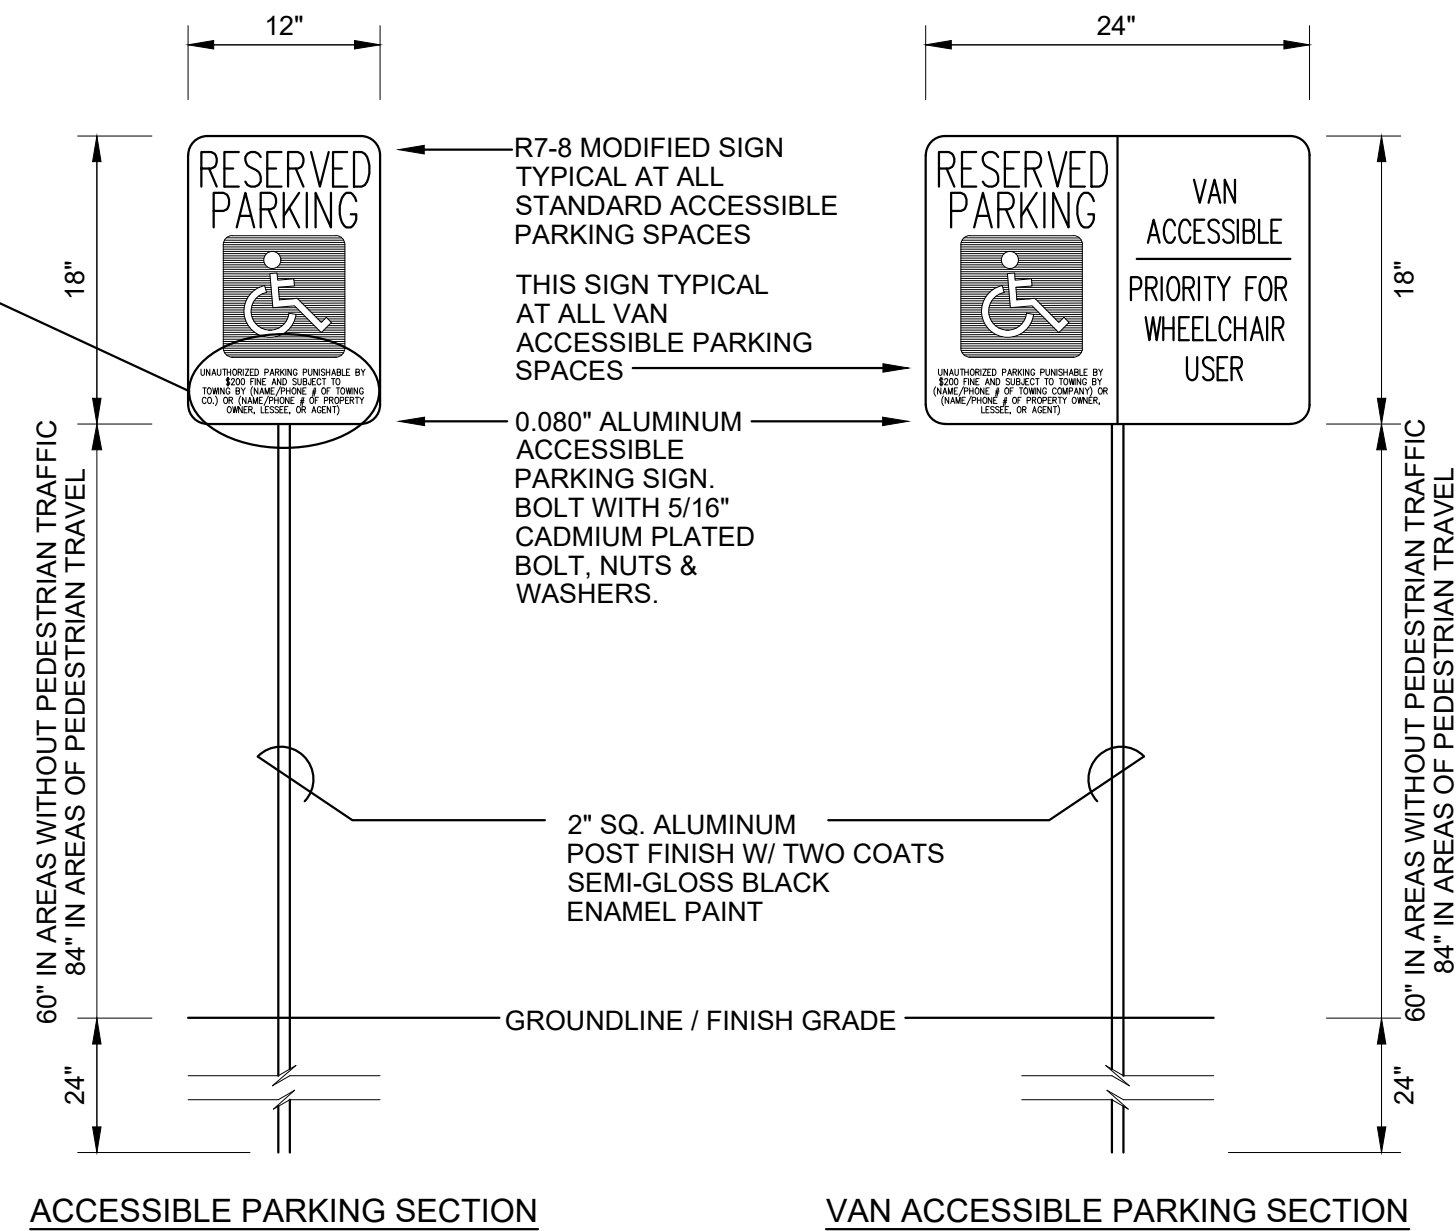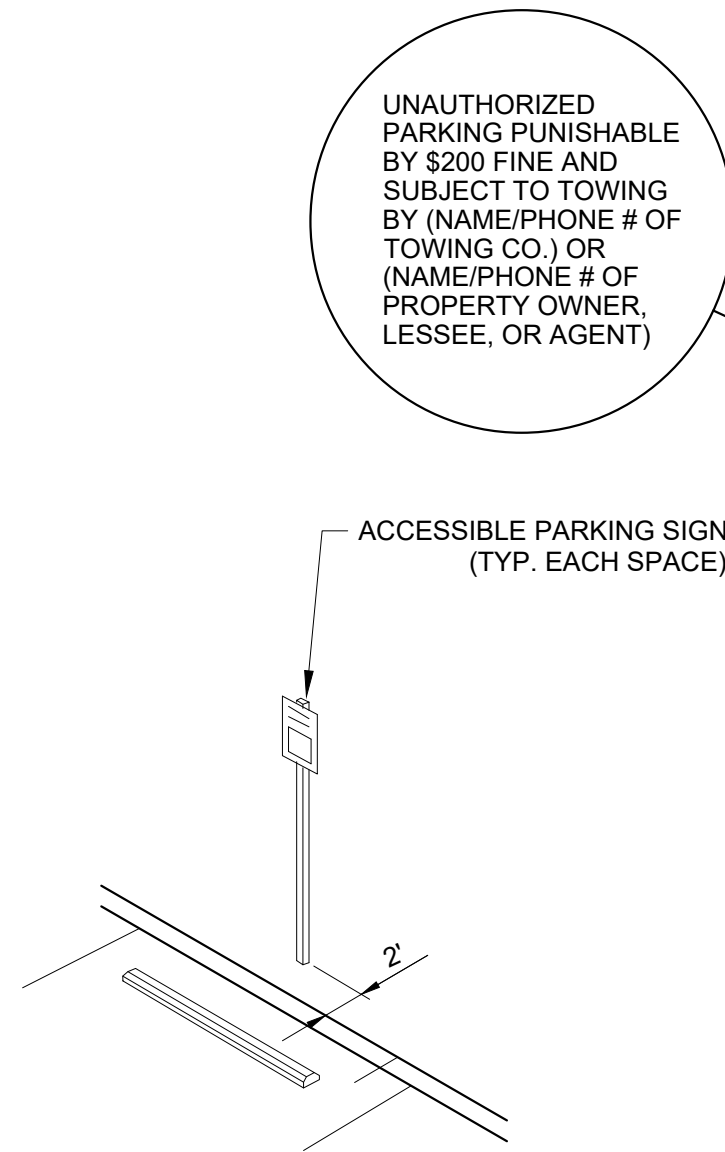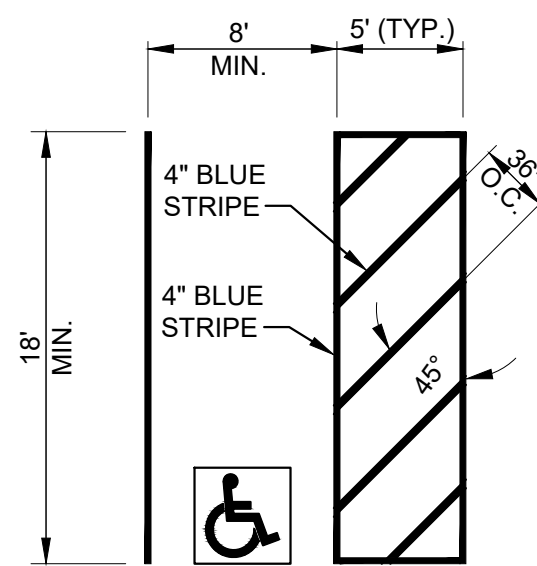


- NOTES:
- REFERENCE: M.U.T.C.D. AND TENNESSEE CODE ANNOTATED § 55-21-108(a)

2 ACCESSIBLE PARKING SIGNS C7.03 SCALE: NTS

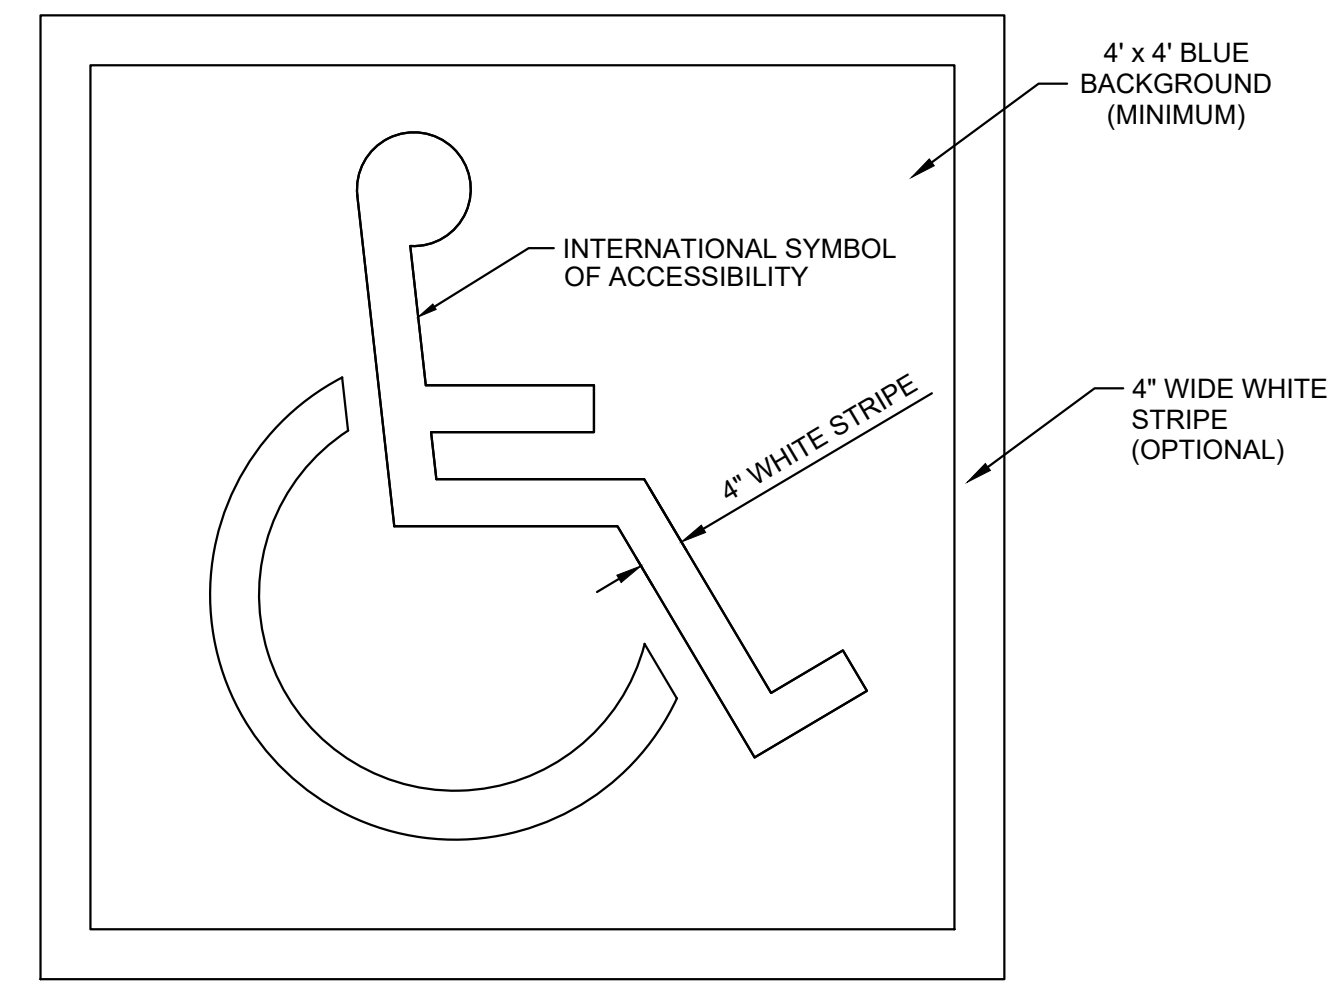


3 ACCESSIBLE PARKING PAVEMENT MARKING C7.03 SCALE: NTS

1 ACCESSIBLE PARKING DETAIL C7.03 SCALE: NTS

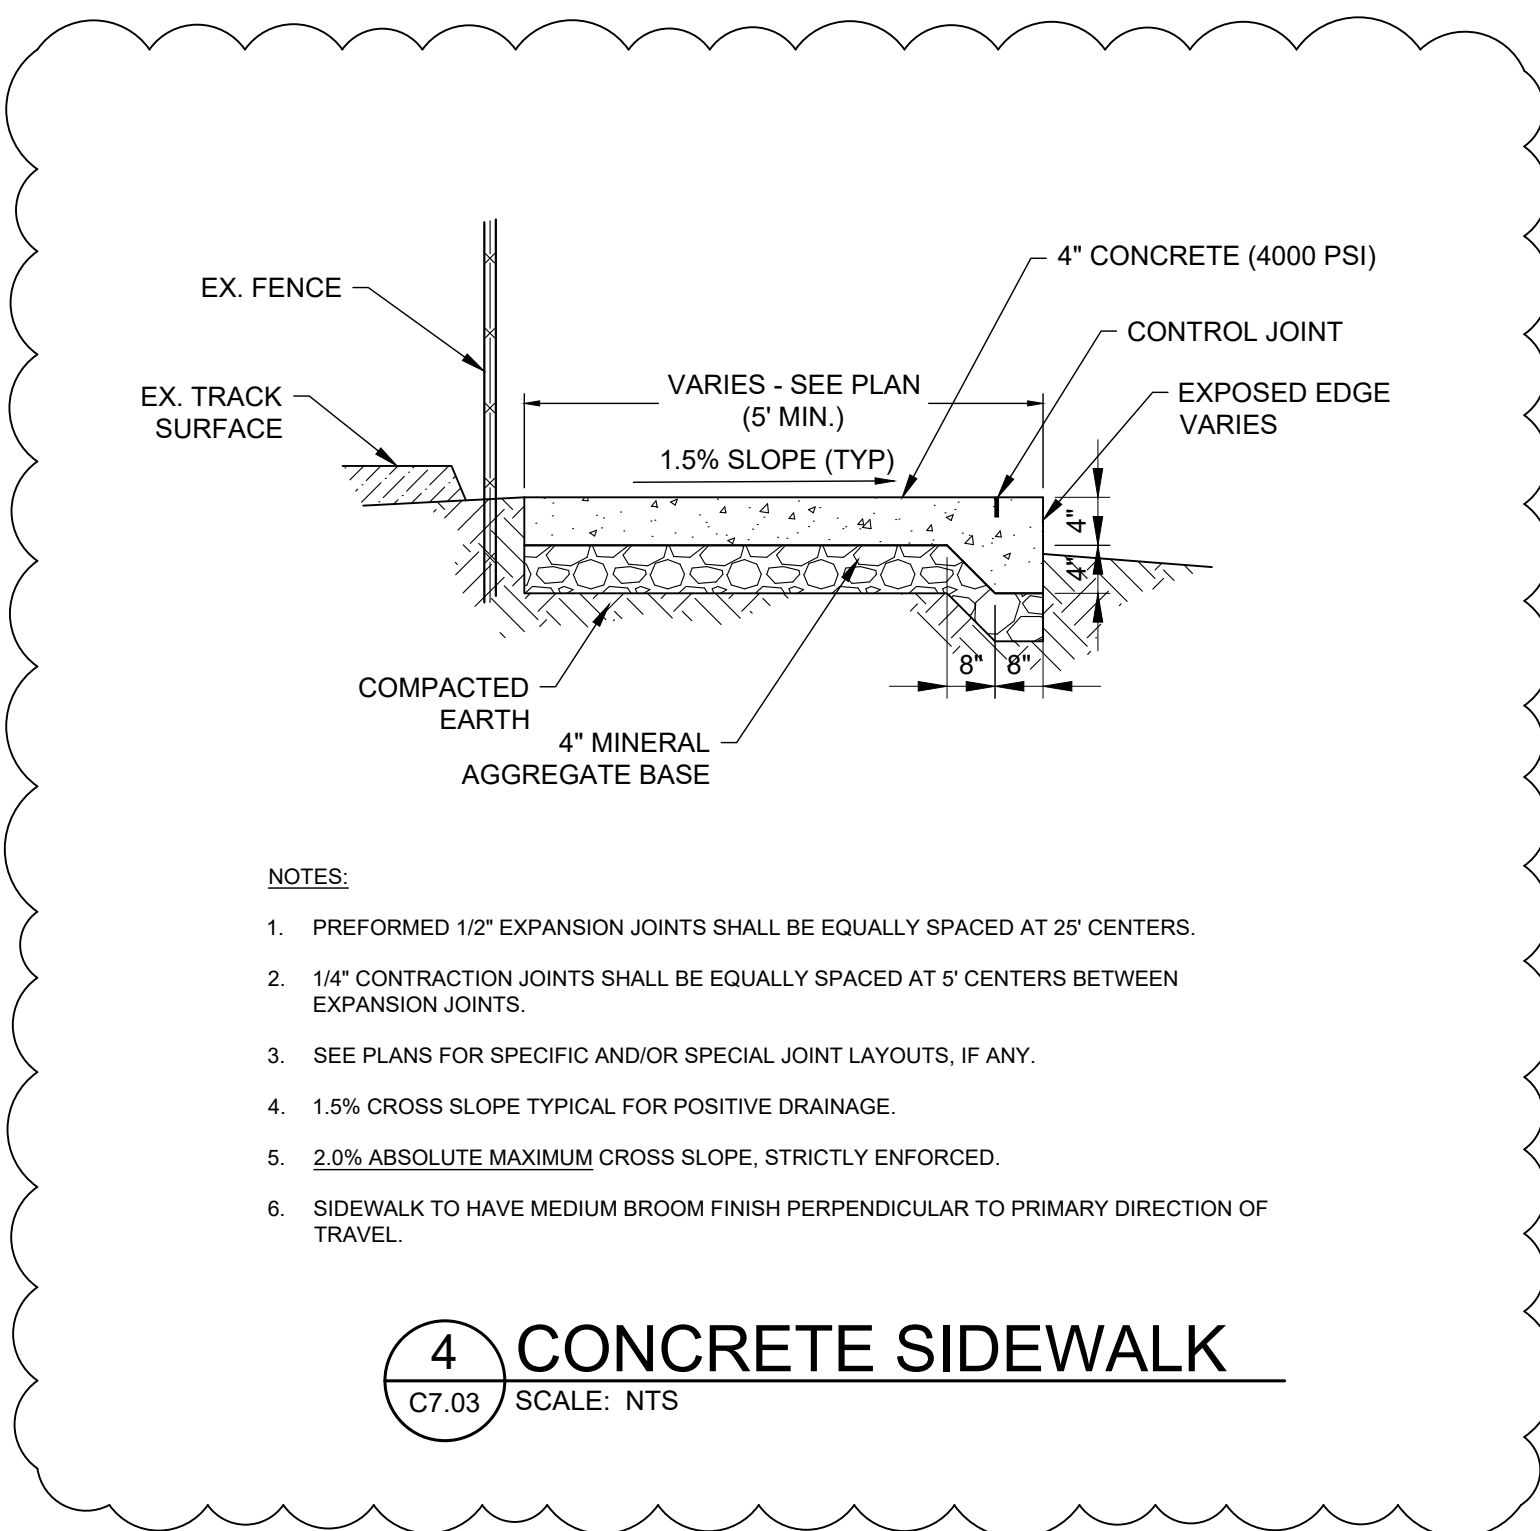


- NOTES:
- PREFORMED 1/2" EXPANSION JOINTS SHALL BE EQUALLY SPACED AT 25' CENTERS.
  - 1/4" CONTRACTION JOINTS SHALL BE EQUALLY SPACED AT 5' CENTERS BETWEEN EXPANSION JOINTS.
  - SEE PLANS FOR SPECIFIC AND/OR SPECIAL JOINT LAYOUTS, IF ANY.
  - 1.5% CROSS SLOPE TYPICAL FOR POSITIVE DRAINAGE.
  - 2.0% ABSOLUTE MAXIMUM CROSS SLOPE, STRICTLY ENFORCED.
  - SIDEWALK TO HAVE MEDIUM BROOM FINISH PERPENDICULAR TO PRIMARY DIRECTION OF TRAVEL.

4 CONCRETE SIDEWALK C7.03 SCALE: NTS

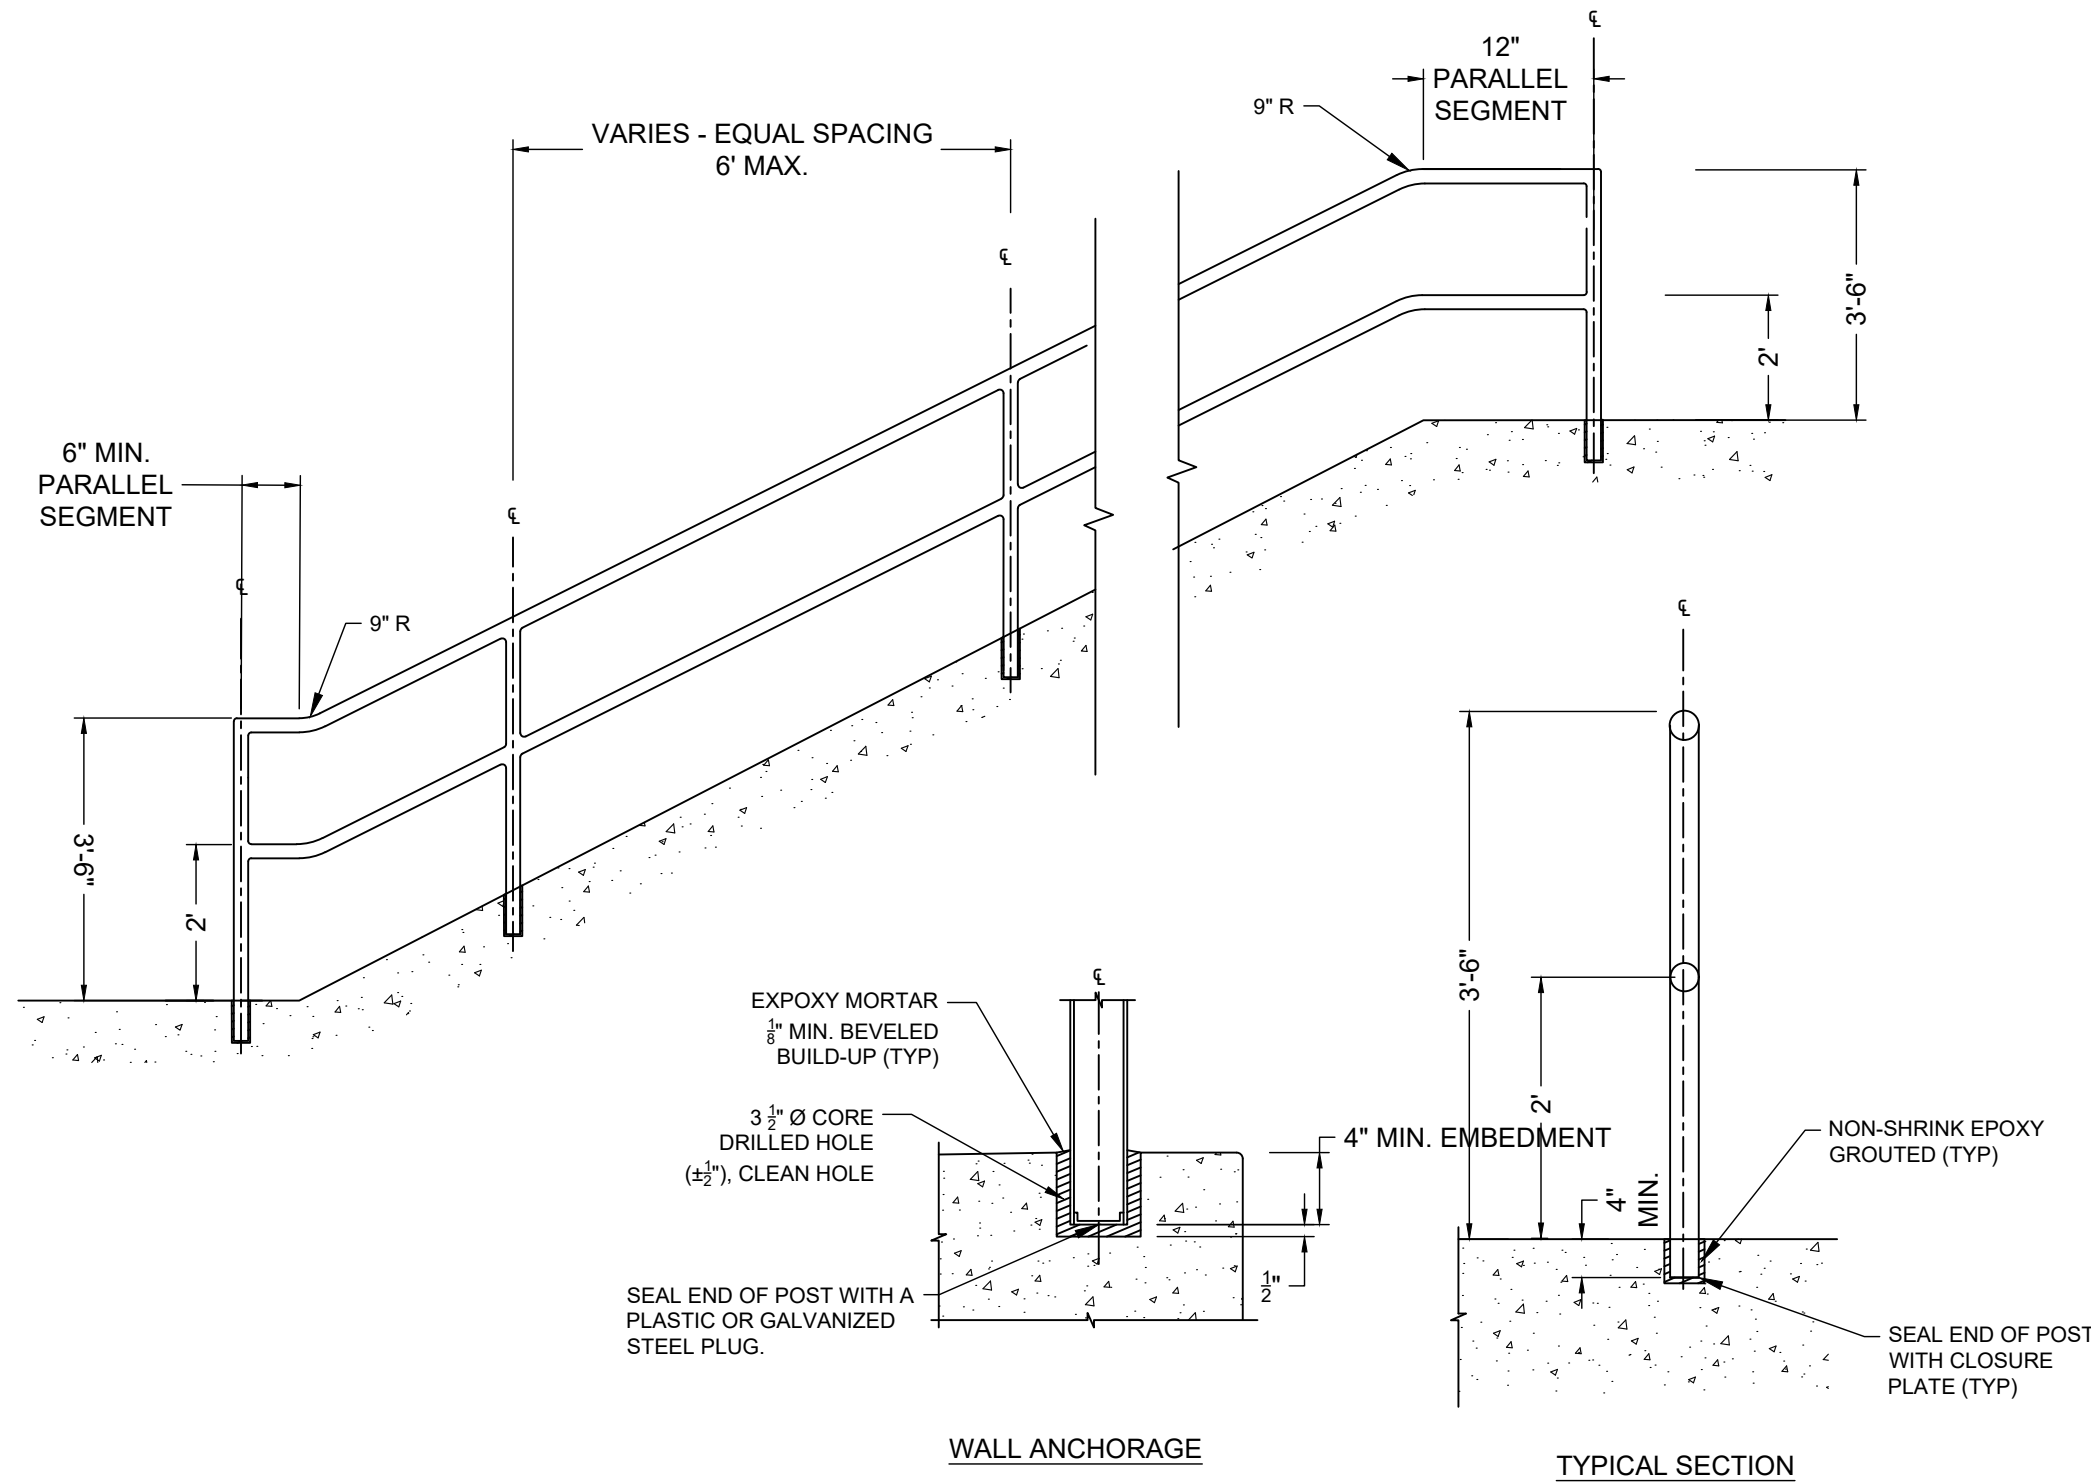


5 SAFETY RAILING C7.03 SCALE: NTS

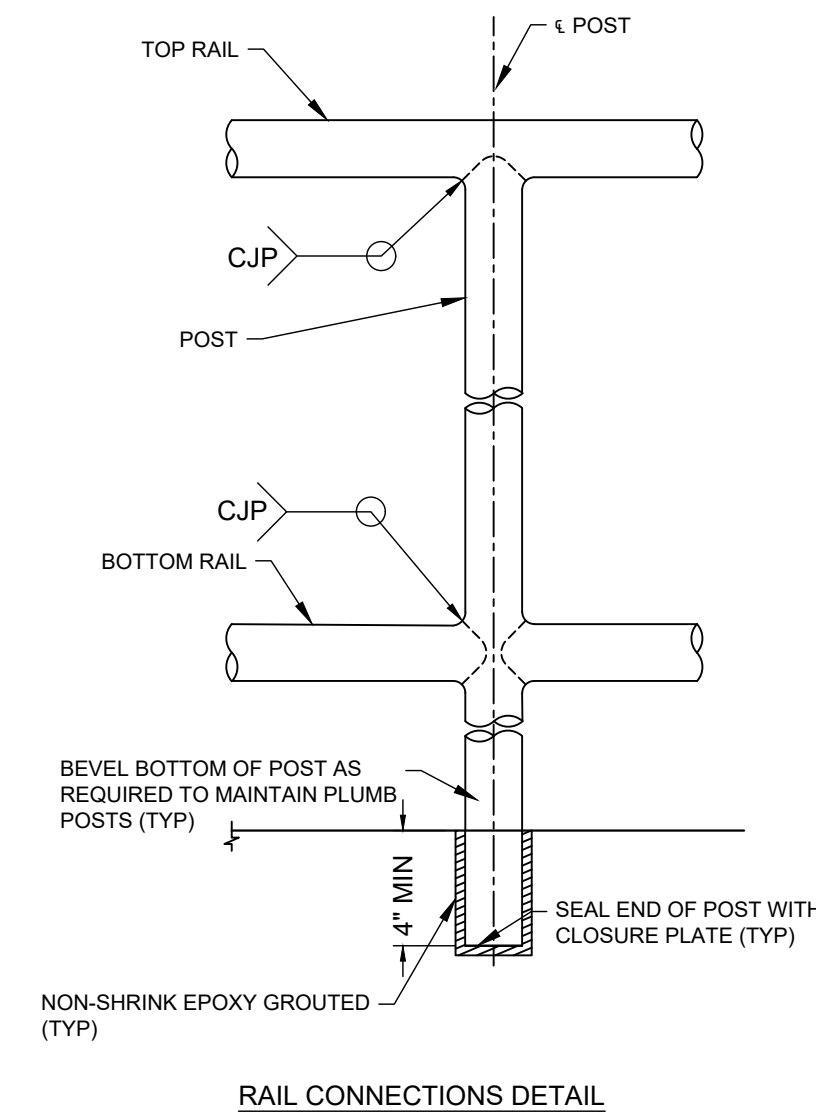

RAILING MEMBER DIMENSION TABLE	
MEMBER	DESIGNATION
POSTS	1.5" NPS (SCH. 80)
RAILS	1.5" NPS (SCH. 40)
RAIL JOINT/SPLICE SLEEVES	1" NPS (SCH. 40)

NOTE: ALL RAILING MEMBERS TO BE PAINTED BLACK.

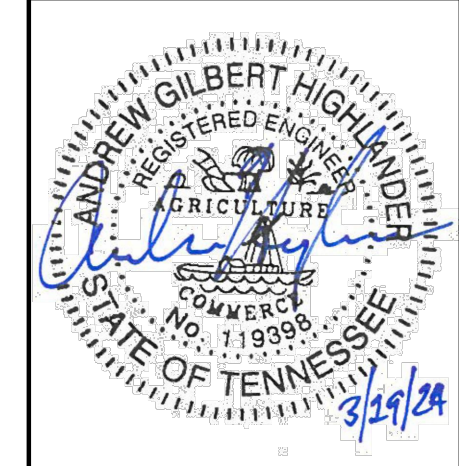

**SITE DETAILS**  
 HAMILTON COUNTY SCHOOLS  
 OOLTEWAH HIGH SCHOOL FOOTBALL/SOCCER  
 FIELD RENOVATION  
 HAMILTON COUNTY, TN

REVISION INFORMATION	
REV.	DESCRIPTION
0	ISSUED FOR BID
1	ADDENDUM #1




**C7.03**

FILE NO. 38505-00



## QUICK COUPLER ADDITION

HAMILTON COUNTY SCHOOLS  
 HOWARD HIGH SCHOOL FOOTBALL/SOCCER  
 FIELD RENOVATION  
 HAMILTON COUNTY, TN

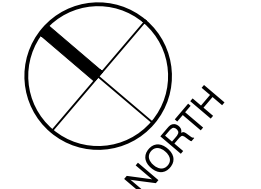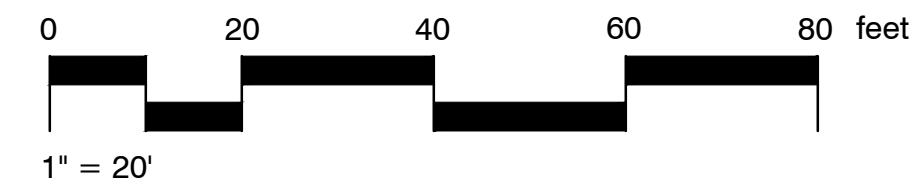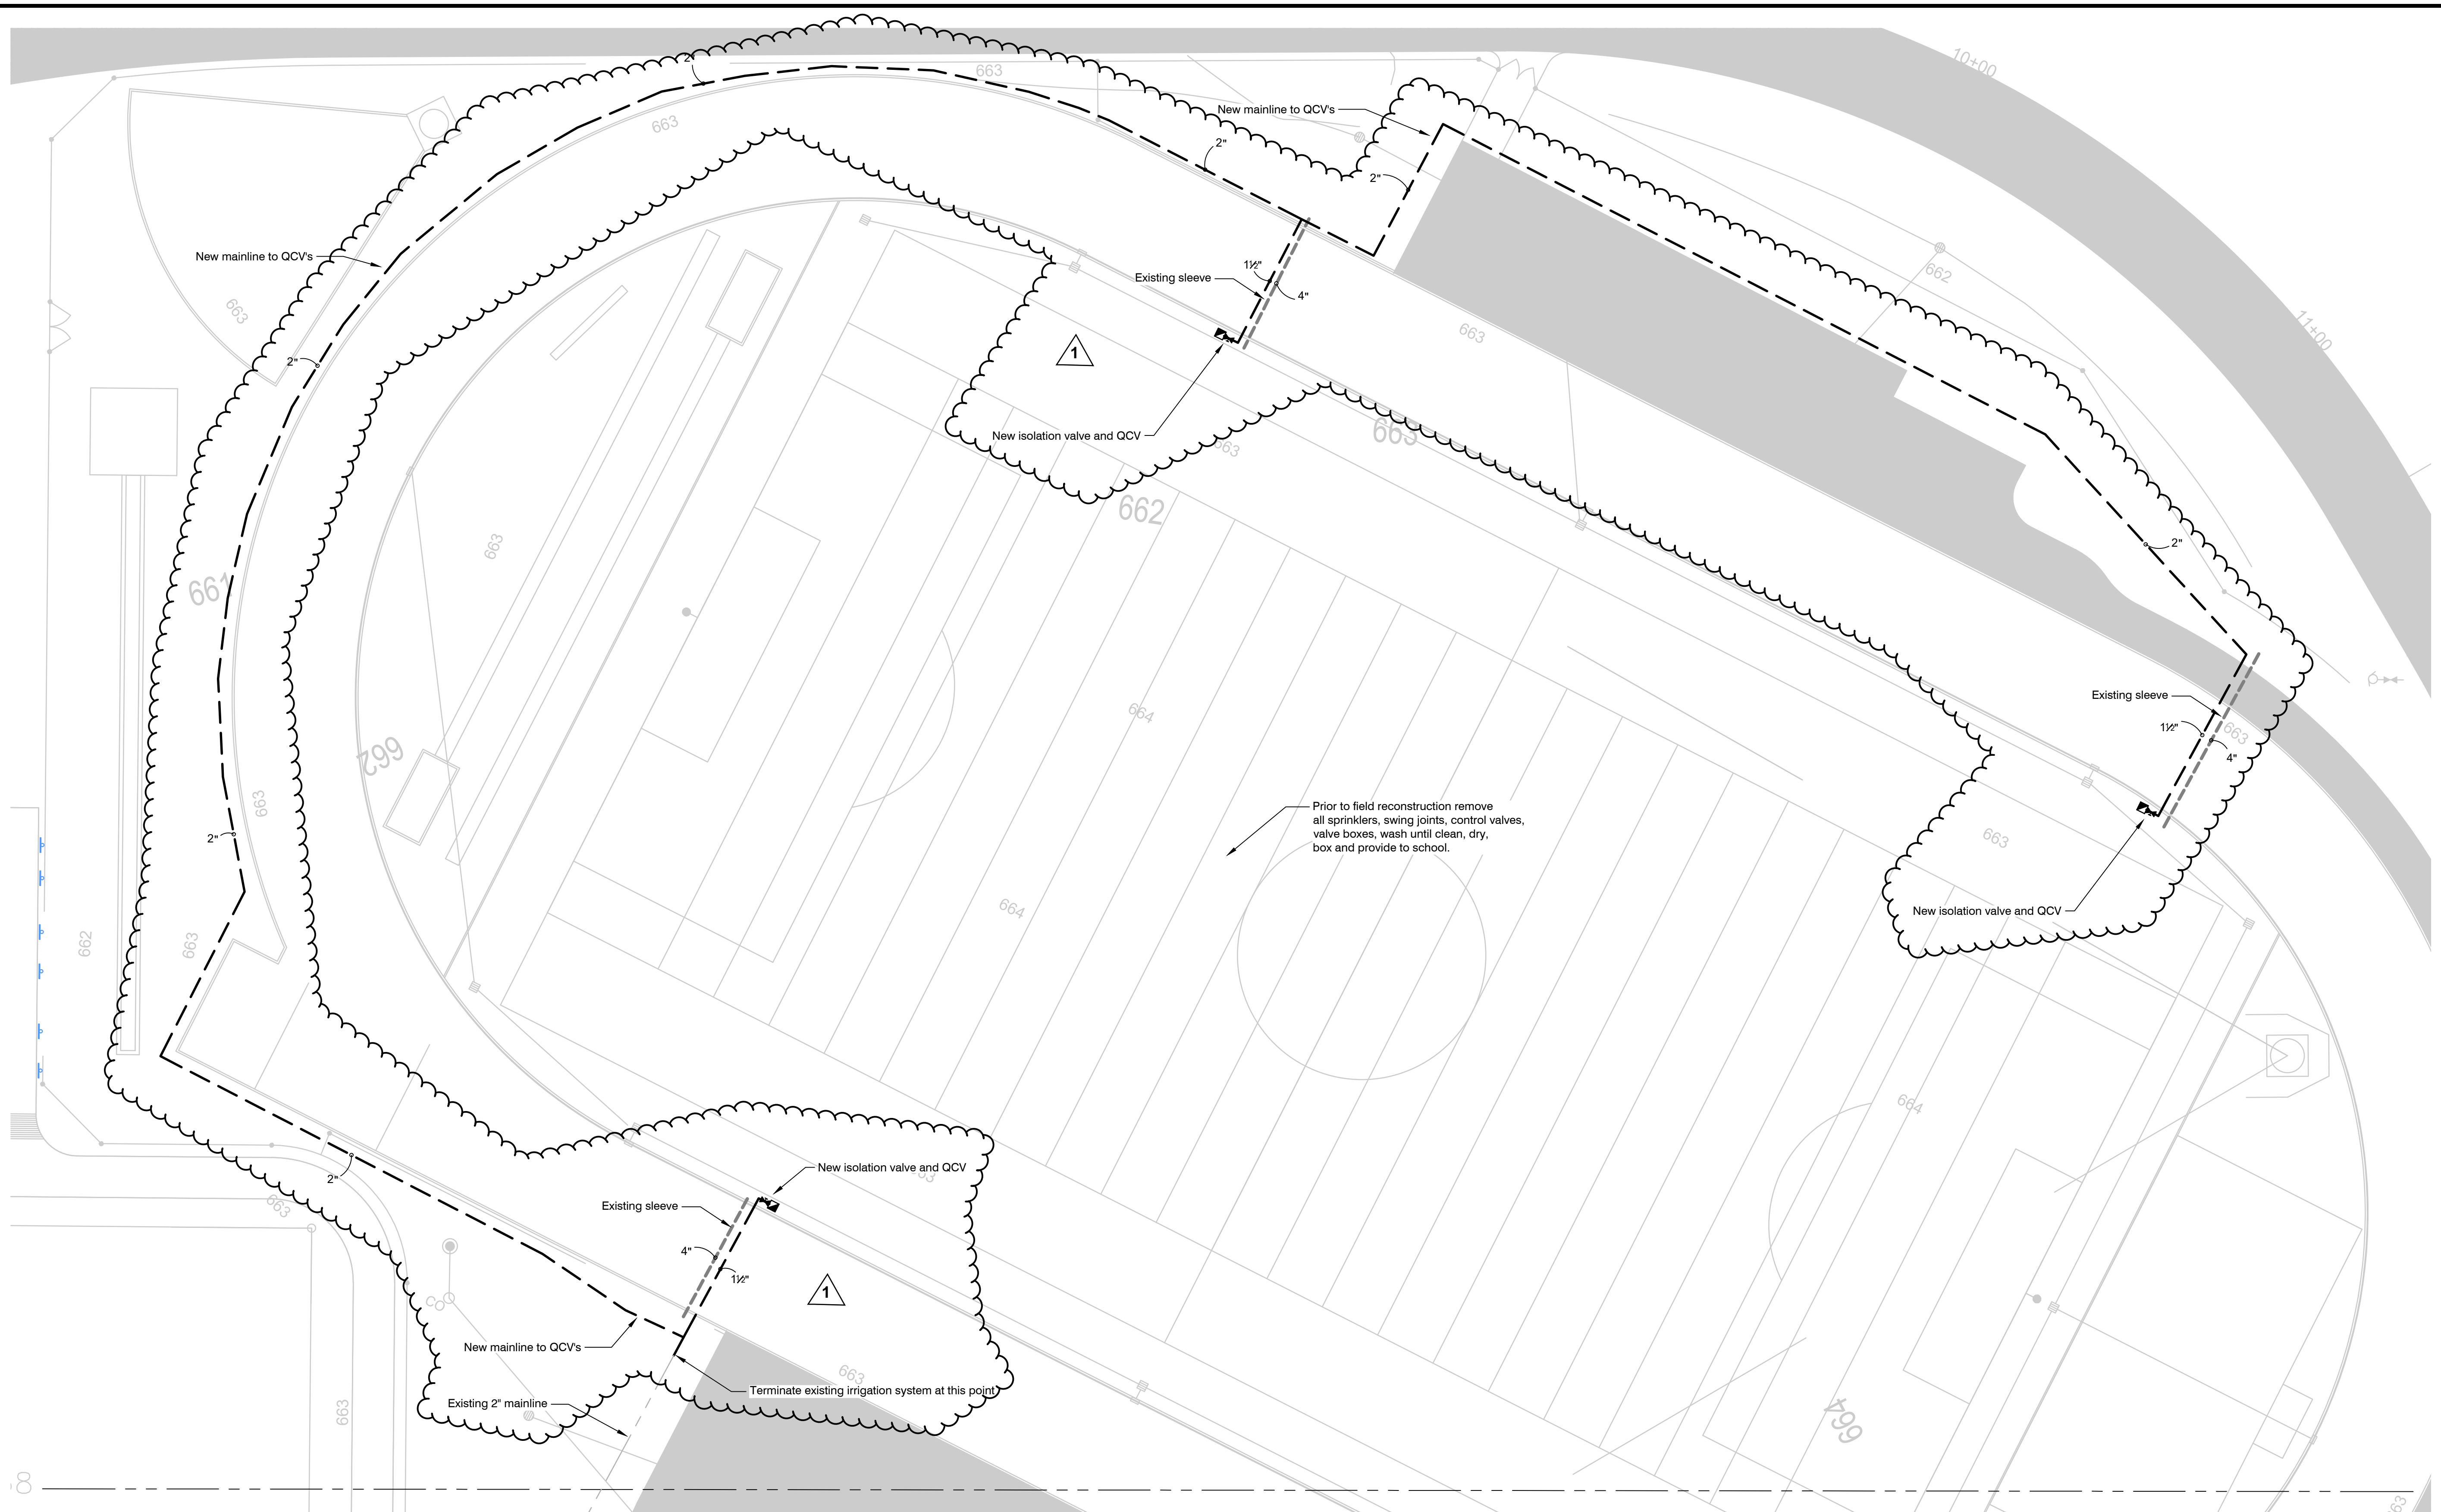


**811** Know what's below  
 Call before you dig.  
 811  
 www.call811.com

DATUM: TNSPC (NAD83)  
 NAVD 1988

FEMA PANEL: ZONE "X", PANEL NO. 47037C0243H, 4/5/17.

REV.	CHK.	DATE	DESCRIPTION
0	MDG	03/19/2024	ASSEMBLE FOR BID
1	MDG	03/19/2024	ASSEMBLE FOR PT.

**QC-1**  
 FILE NO. 38505-00


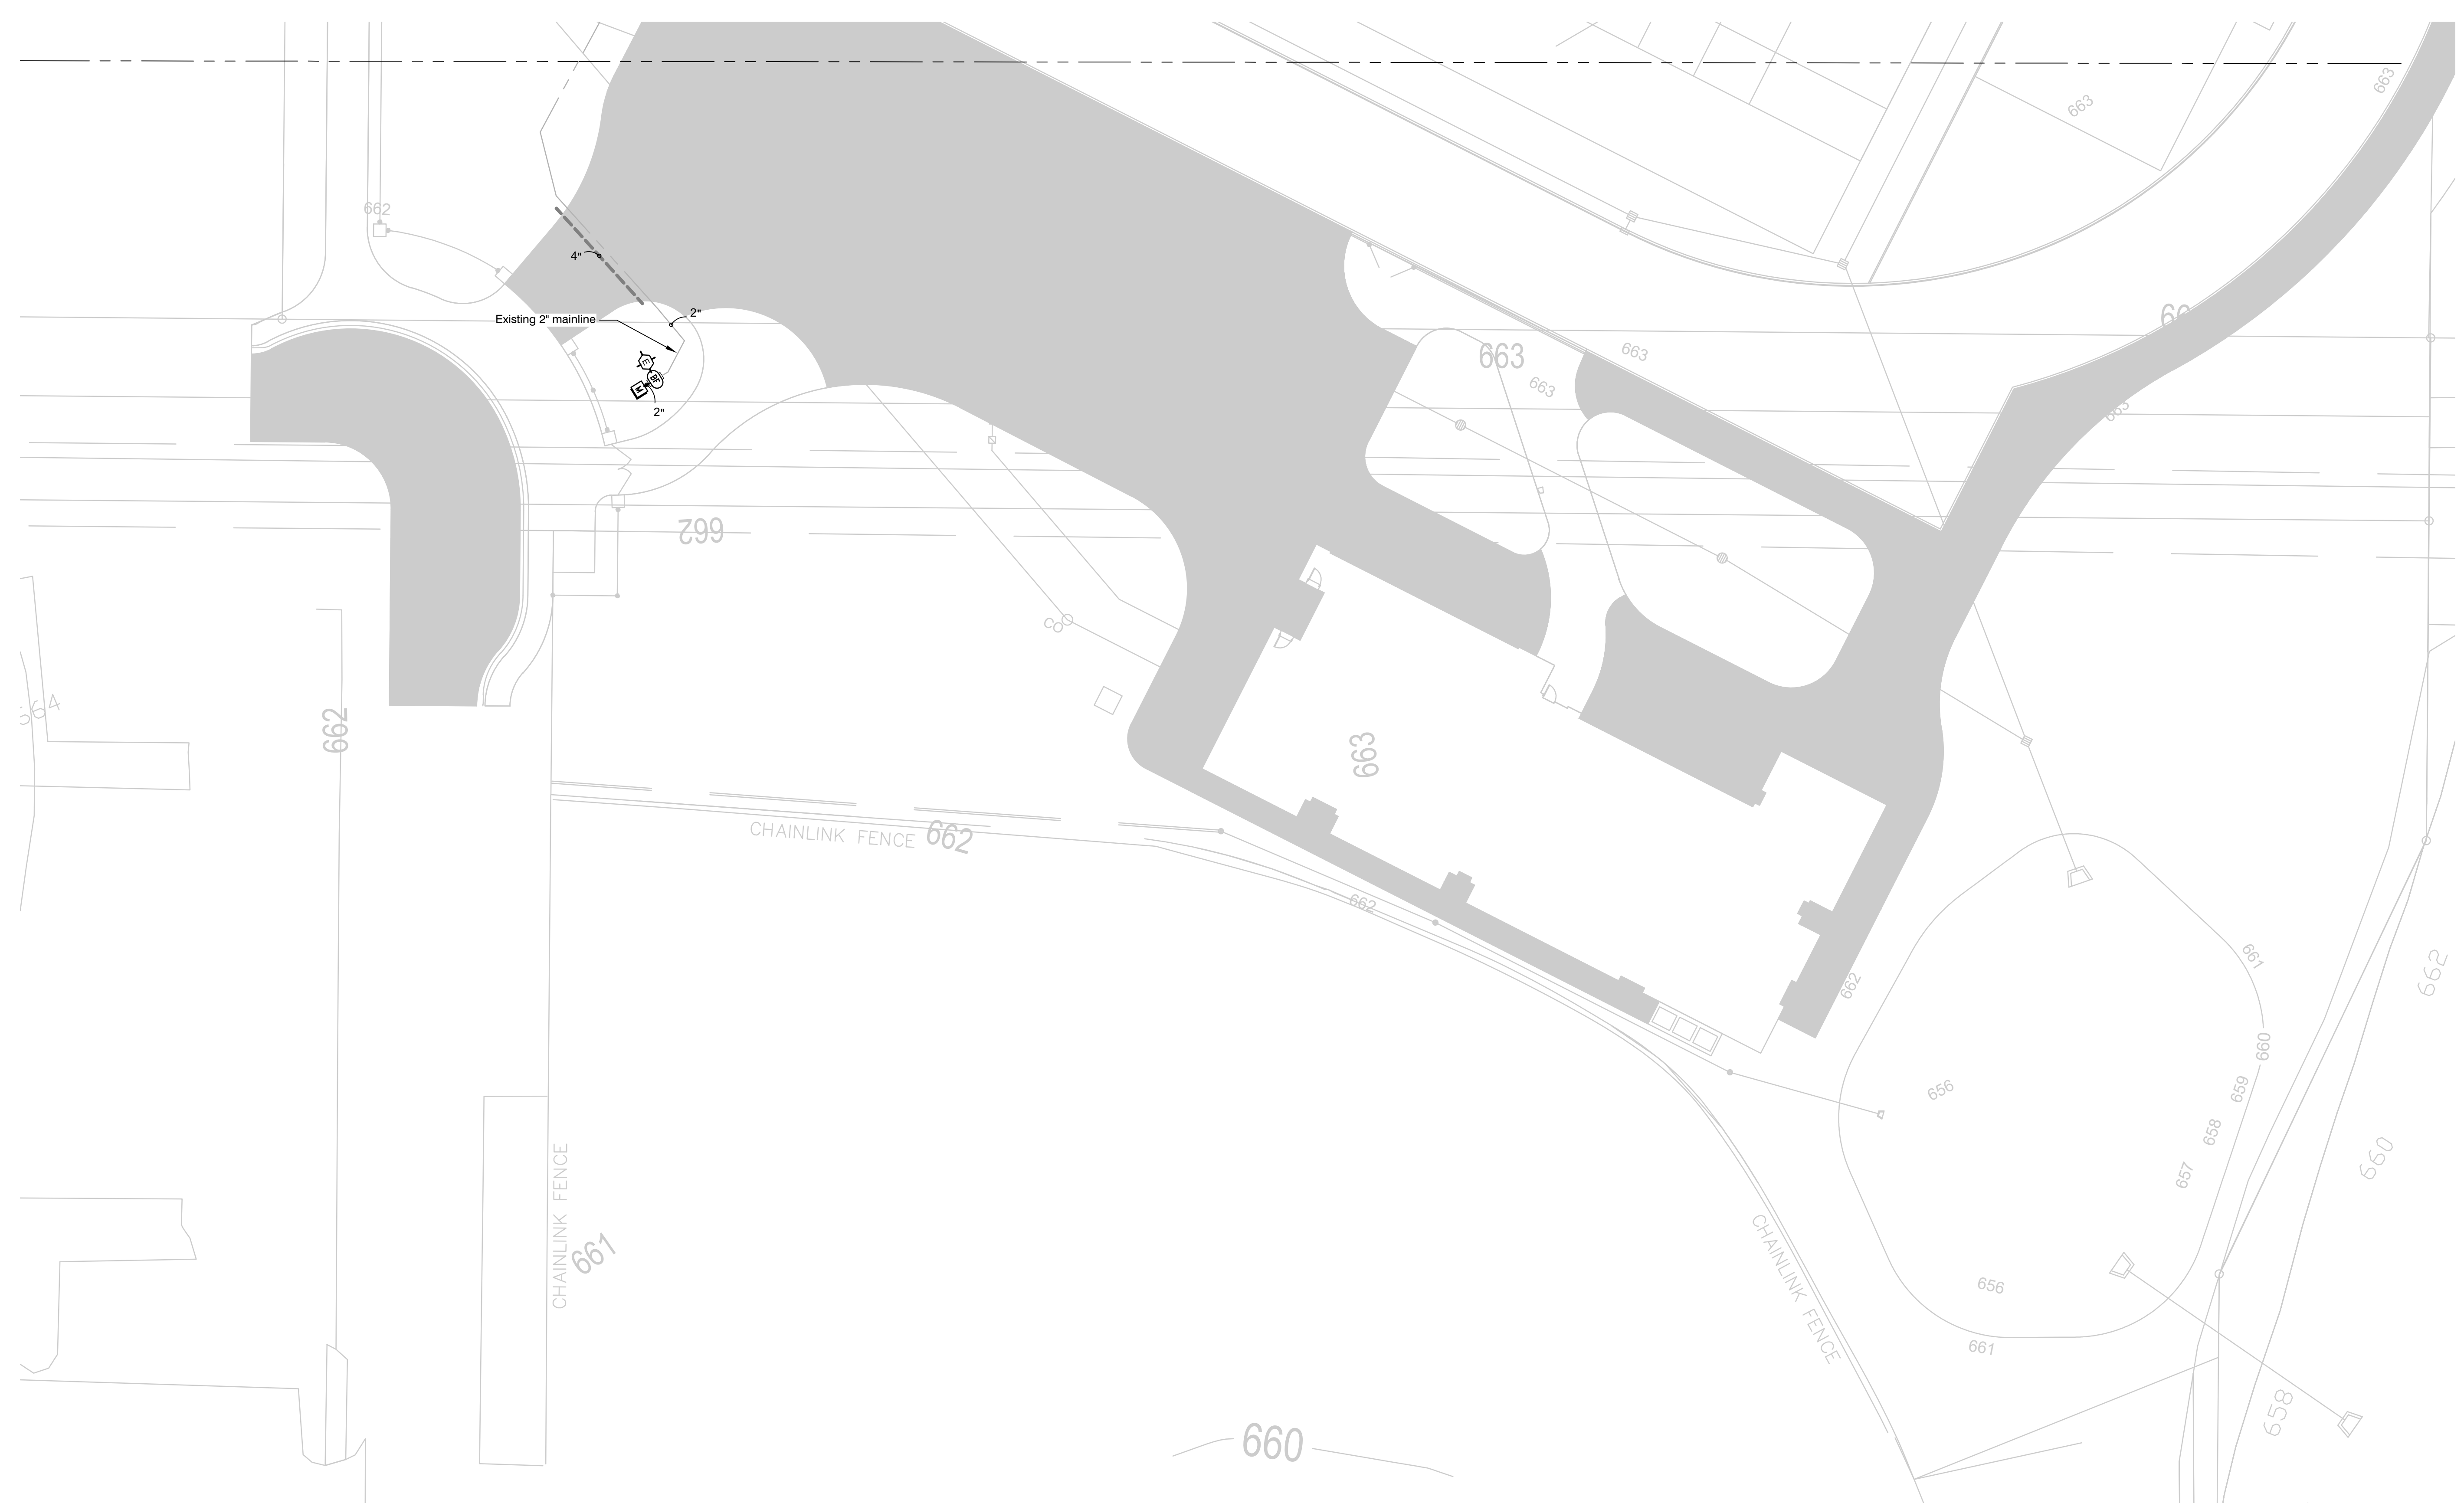


**QUICK COUPLER ADDITION**

HAMILTON COUNTY SCHOOLS  
**HOWARD HIGH SCHOOL FOOTBALL/SOCCER  
FIELD RENOVATION**  
HAMILTON COUNTY, TN

REVISION INFORMATION	
REV.	DESCRIPTION
0	ISSUED FOR BID
1	ADDENDUM #1




**QC-2**  
FILE NO. 38505-00

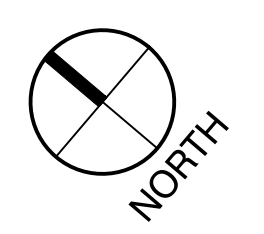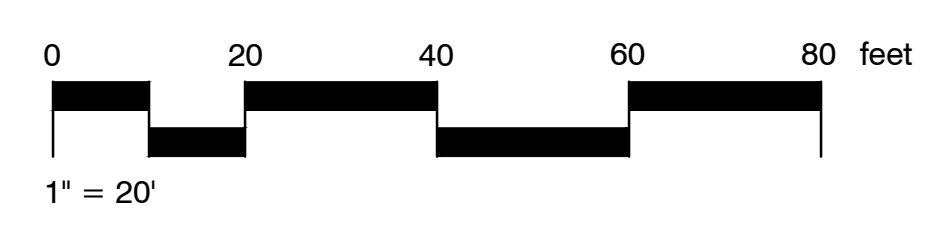

**811** Know what's below  
Call before you dig.  
811  
www.call811.com

DATUM:  
TNSPC (NAD83)  
NAVD 1988

FEMA PANEL:  
ZONE "X", PANEL NO.  
47037C0243H, 4/5/17.

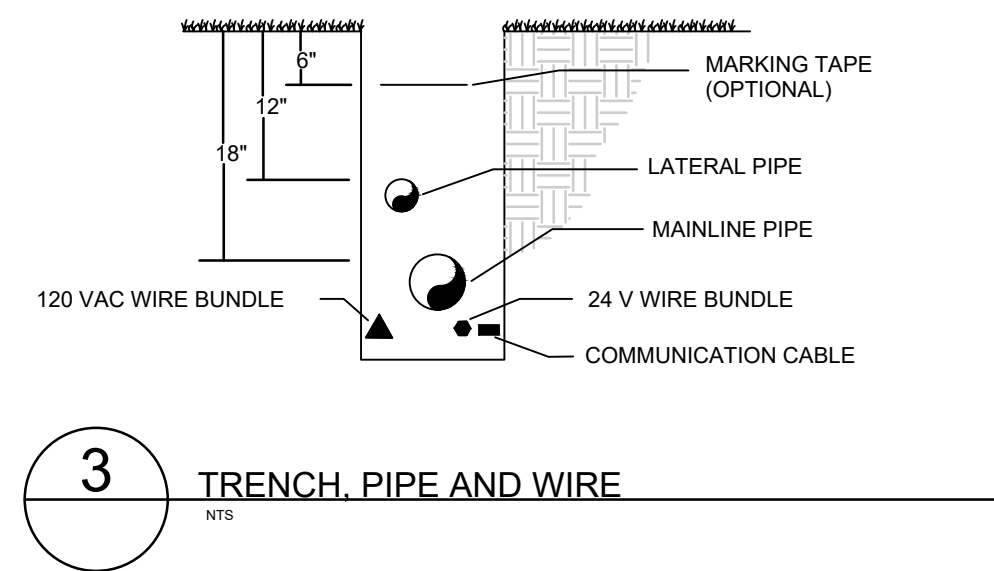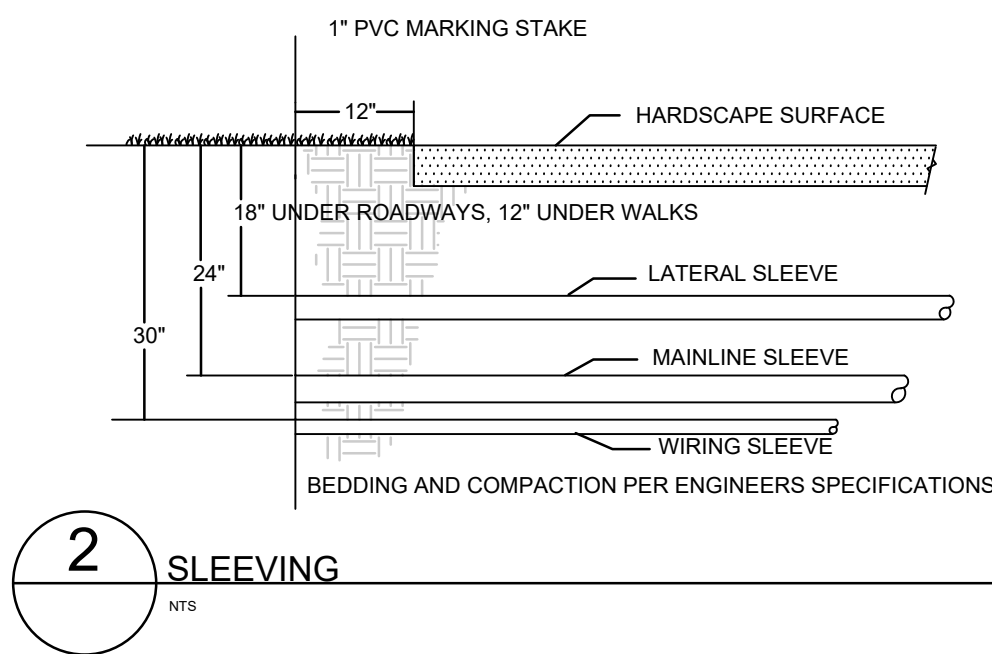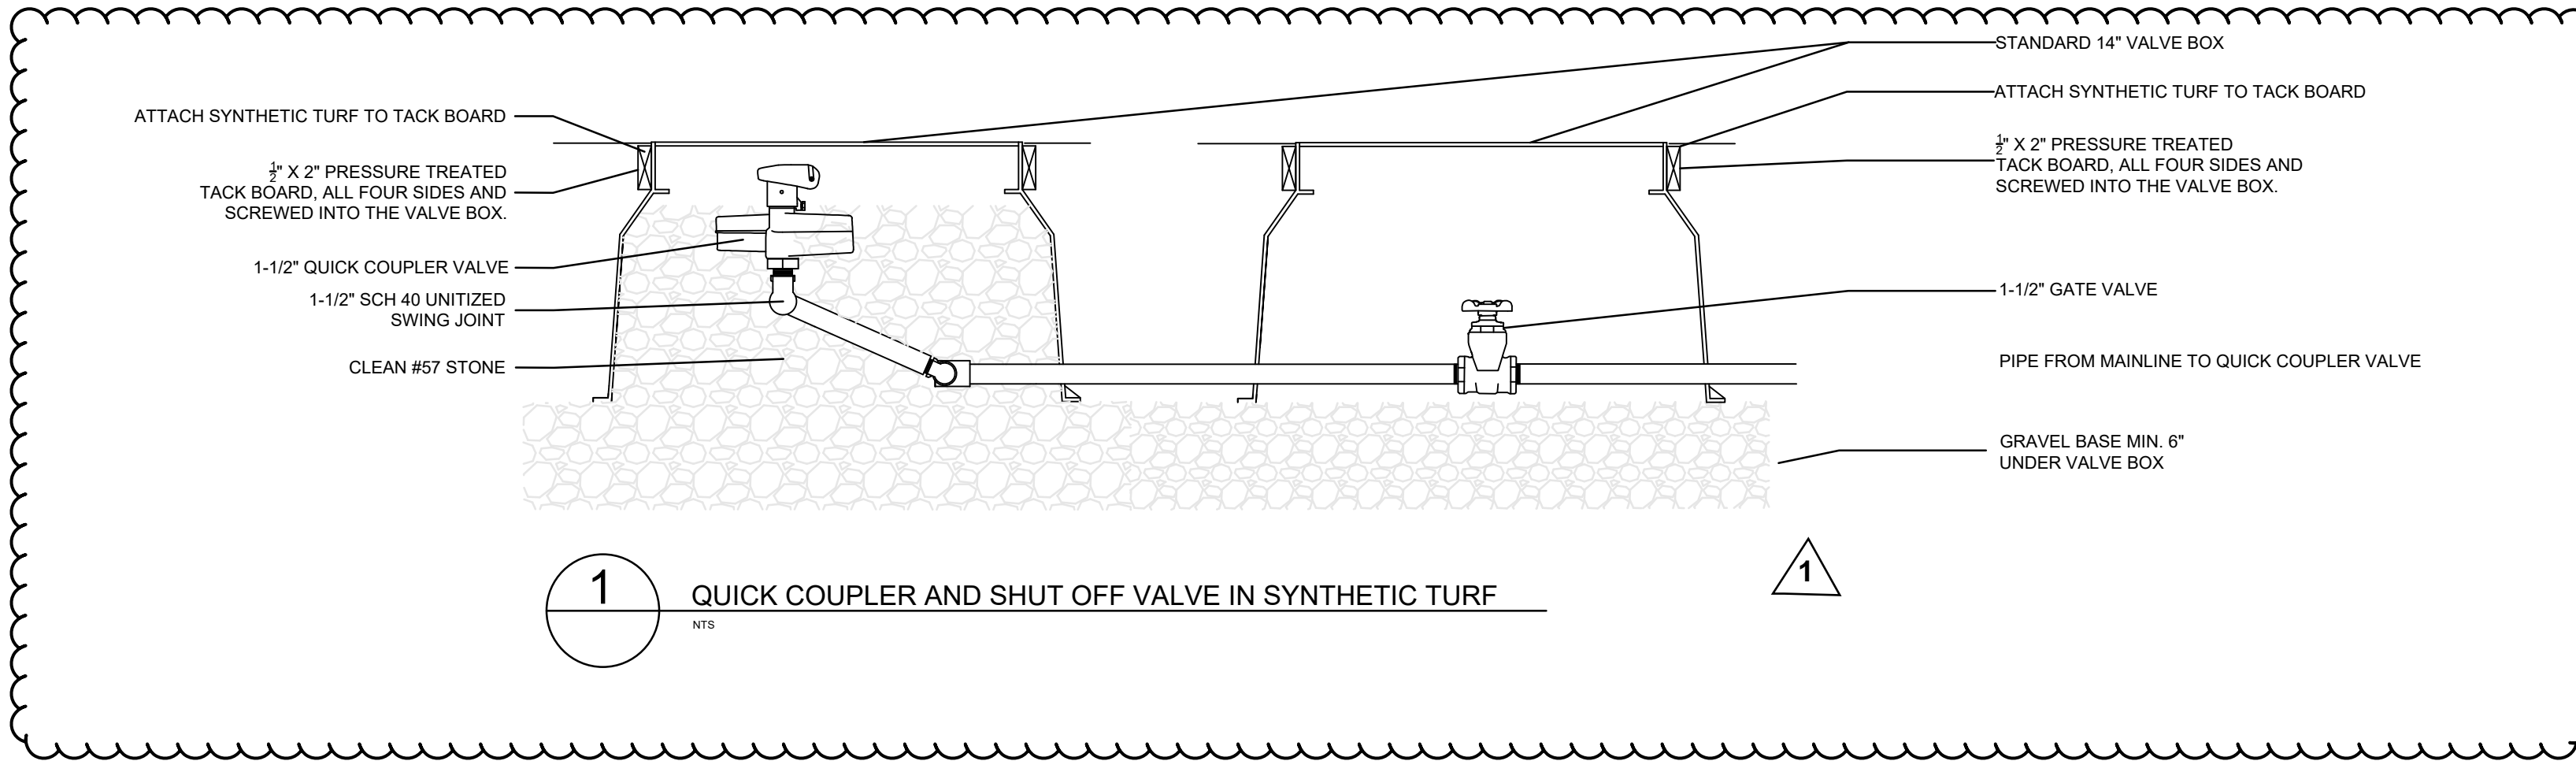

## IRRIGATION SCHEDULE

SYMBOL	MANUFACTURER/MODEL/DESCRIPTION
■	Hunter HQ-44LRC-AW 1" Quick coupler valve, yellow rubber locking cover, red brass and stainless steel, with 1" NPT inlet, 2-piece body. Acme Key with Anti-Rotation Wings.
⊗	Nibco T-113 Class 125 bronze gate shut off valve with wheel handle, same size as mainline pipe diameter at valve location. Size Range - 1/4" - 3"
---	Irrigation Mainline: PVC Class 200 SDR 21 1 1/2"
---	Irrigation Mainline: PVC Class 200 SDR 21 2"
---	Pipe Sleeve: PVC Schedule 40 4"

## GENERAL NOTES

- ALL TRENCHING TO BE OUTSIDE OF TREE DRIP LINE, IF TRENCHING TO BE DONE WITHIN TREE DRIP LINE FOLLOW TREE PRESERVATION GUIDELINES FOR THE PROJECT OR LOCAL MUNICIPALITY
- MAINLINE TO HAVE MINIMUM OF 18" OF COVER AND A MINIMUM OF 18" OFF OF THE HARDSCAPE
- LATERALS TO HAVE MINIMUM OF 12" OF COVER AND A MINIMUM OF 12" OFF OF THE HARDSCAPE
- NO ROCKS, BOULDERS OR SHARP OBJECTS TO BE IN TRENCH BACKFILL
- ALL PIPE TO BE INSTALLED AS PER MANUFACTURERS SPECIFICATIONS
- SPRINKLERS AND RELATED EQUIPMENT TO BE INSTALLED AS PER DETAILS
- CONTROL WIRE TO BE 14 GA UL APPROVED, SINGLE CONDUCTOR, PE JACKETED
- WIRE SPLICES TO BE DONE AS PER DETAILS
- ALL WIRE SPLICES OUTSIDE OF CONTROL VALVE BOX TO BE IN 10" VALVE BOX
- WIRE TO BE COLOR CODED, RED FOR POWER AND WHITE FOR COMMON
- CONTRACTOR SHALL INSTALL MANUFACTURERS GROUNDING EQUIPMENT ON BOTH THE POWER AND OUTPUT SIDES
- CONTRACTOR SHALL PROVIDE EXPANSION COILS AT EACH WIRE CONNECTION BY WRAPPING WIRE AROUND 3/4" PIPE 12 TIMES
- AT EACH CHANGE IN MAINLINE DIRECTION CONTRACTOR TO INSTALL A 30" LOOP OF EXTRA WIRE
- WIRE TO BE BUNDLED WITH ZIP-TIE EVERY 15'
- SPRINKLERS ARE TO BE ADJUSTED TO AVOID OVER-SPRAY INTO NON-IRRIGATED AREAS
- ELECTRIC CONTROL VALVES ARE TO BE INSTALLED IN VALVE BOXES AS FOLLOWS  
14" RECTANGULAR FOR EACH ELECTRIC CONTROL VALVE  
JUMBO VALVE BOX FOR DRIP ZONE KIT
- SPRINKLERS TO BE INSTALLED 12" FROM FOUNDATIONS AND 2" FROM HARDSCAPE
- CONTRACTOR TO ADD RISER EXTENSIONS TO SPRINKLERS IF REQUIRED TO MAINTAIN PROPER COVERAGE
- ALL PIPING TO BE FLUSHED PRIOR TO INSTALLATION OF SPRINKLERS
- ALL VALVES, QUICK COUPLER VALVES, WIRE SPLICES TO BE IN LANDSCAPED BEDS WHEREVER POSSIBLE
- CONTRACTOR IS RESPONSIBLE FOR OBTAINING PROPER COVERAGE OF AREA TO BE IRRIGATED, MAKE ADJUSTMENTS AS NECESSARY
- CONTRACTOR SHALL EXERCISE CARE NOT TO DAMAGE EXISTING UTILITIES REPAIRING ANY DAMAGES AT HIS OWN COST
- PLAN IS DIAGRAMMATIC TO IMPROVE CLARITY ALL IRRIGATION EQUIPMENT TO BE INSTALLED WITHIN PROPERTY LINES AND LANDSCAPED AREAS
- ANY DISCREPANCIES BETWEEN THE PLAN AND THE SITE TO BE REFERRED TO THE OWNERS REPRESENTATIVE PRIOR TO CONSTRUCTION
- CONTRACTOR TO PROVIDE 1 YEAR WARRANTY OF ALL PRODUCTS AND WORKMANSHIP TO INCLUDE WINTERIZATION AND SPRING START-UP
- CONTRACTOR TO PROVIDE OWNER AND OR LANDSCAPE ARCHITECT RECORD DRAWING PRIOR TO SUBSTANTIAL COMPLETION
- INSTALLATION OF IRRIGATION SLEEVES IS THE IRRIGATION CONTRACTORS RESPONSIBILITY IRRIGATION CONTRACTOR TO COORDINATE WITH GENERAL CONTRACTOR SLEEVE INSTALLATION PRIOR TO PAVEMENT INSTALLATION
- CLEANUP AND DISPOSE OF ALL DEBRIS, WASTE AND EXCESS CONSTRUCTION MATERIALS LEAVE AREA NEAT, CLEAN AND READY FOR OWNERS USE PROVIDE CLEAN PAVEMENT SURFACES INCLUDING AREAS OF PUBLIC R.O.W.

IRRIGATION SCHEDULE, NOTES, DETAILS

HAMILTON COUNTY SCHOOLS  
HOWARD HIGH SCHOOL FOOTBALL/SOCCER  
FIELD RENOVATION  
HAMILTON COUNTY, TN

REVISION INFORMATION

REV.	DR.	CHK.	DATE	DESCRIPTION
0	MDC	AGH	03/13/2024	ISSUED FOR BID
1	MDC	JBS	03/19/2024	ADDENDUM #1

**811** Know what's below  
Call before you dig.  
811  
www.call811.com

DATUM:  
TNSPC (NAD83)  
NAVD 1988

FEMA PANEL:  
ZONE "X", PANEL NO.  
47037C0243H, 4/5/17.

QC-3

FILE NO. 38505-00