

# LEWIS GROUP ARCHITECTS

## Addendum

*Project Number:*

**LGA Project No. 25018**

*Client / Project Title:*

**Roane County School District  
Midway High School Roof Replacement**

*Addendum Number:*

**Addendum Two (02)**

*Date:*

**Friday, August 29, 2025**

*Addendum Compiled By:*

**Peter Giddings, Project Architect, Lewis Group Architects – pgiddings@lewisgroup.net**

*Overview:*

To prime contractors and all others to whom drawings have been issued. Acknowledge receipt of this Addendum in the space provided on the Bid Form. Failure to do so may subject the Bidder to disqualification. This addendum forms a part of the Contract Documents dated 8/15/2025.

*Prior Addenda:*

Addendum 01- 08/26/2025

This addendum supplements and modifies the Contract Documents as follows:

### QUESTIONS

- A. Please clarify if the needed wood nailers should be F.R.T. or just pressure treated. Both are referenced in the specs.

**Answer: All new wood to be F.R.T.**

- B. In places where the fascia board is rotting away does this need to be F.R.T. or just pressure treated?

**Answer: All new wood to be F.R.T per details on Sheet A5.21.**

- C. Clarify the roofing system: 07 54 23-5 2.2C&D indicated 2 layers of base Iso mechanically attached, a single layer of cover board adhered, with a fully adhered membrane. Installation spec 07 54 23-8&9 and drawing details for each type of deck on the roof vary significantly from this base design.

**Answer: See attached for revised Specification Section 07 54 23. Intent is detailed on 7/A5.21. Tapered board to be located between uniform thickness board and coverboard.**

- D. Clarify on the Retrofit over metal roof: Specs indicate a mechanically attached roof membrane, however the drawing detail shows both mechanical and fully adhered.

**Answer: See attached for revised Sheet A5.11 with revised detail 4/A5.11. Intent is to mechanically attach the retrofit**



**system to the existing metal roof and heat-weld the laps to deliver a monolithic surface.**

- E. Lastly, does the requested roof access ladders need to have any specific coatings, paint, or a set of specifications to follow.

**Answer: See attached Specification Section 05 51 33.**

## **CHANGES TO THE DRAWINGS**

- A. Sheet A5.11, ROOF PLAN AND NOTES, dated 08/15/2025.
1. Remove Sheet A5.11 dated 08/15/2025 in its entirety and insert entire revised Sheet A5.11 dated 8/29/2025.
  2. Revised Roof Plan to show where soffit renovations are located. Added Keynote 531 to address the soffit renovations.
  3. Revised detail 4/A5.11.
  4. Added General Notes 8, 9, and 10.
- B. Sheet A5.21, ROOF DETAILS, dated 08/15/2025.
1. Remove Sheet A5.21 dated 08/15/2025 in its entirety and insert entire revised Sheet A5.21 dated 8/29/2025.
  2. Revised detail 11/A5.21.
  3. Revised detail 12/A5.21.
  4. Revised detail 13/A5.21.

## **CHANGES TO THE SPECIFICATIONS**

- A. Specification Section 00 01 10, TABLE OF CONTENTS, dated 08/15/2025.
1. Remove Specification Section 00 01 10 dated 08/15/2025 in its entirety and insert entire revised Specification Section 00 01 10 dated 8/29/2025.
  2. Added Specification Section 05 51 33 to the Table of Contents.
- B. Specification Section 05 51 33, FIXED VERTICAL LADDERS, dated 08/15/2025.
1. Insert entire new Specification Section 05 51 33 dated 8/29/2025.
- C. Specification Section 07 54 23, THERMOPLASTIC MEMBRANE ROOFING, dated 08/15/2025.
1. Remove Specification Section 07 54 23 dated 08/15/2025 in its entirety and insert entire revised Specification Section 07 54 23 dated 8/29/2025.
  2. Revised Section 1.8 to add the new note 'A'. All other notes advanced one letter.
  3. Revised Section 2.2, Subsection C and D as indicated.
  4. Revised Section 3.3, Subsection C, Item 1b as indicated.
  5. Revised Section 3.4 to add the new note 'A'. All other notes advanced one letter.

**ATTACHMENTS**

Specification Sections: 3

Drawing Sheets: 2

**END OF ADDENDUM / ATTACHMENTS FOLLOW**

## SECTION 00 01 10 - TABLE OF CONTENTS

### DIVISION 00 - PROCUREMENT AND CONTRACTING REQUIREMENTS

00 00 00	Project Manual Cover
00 01 07	Seals Page
00 01 10	Table of Contents
00 01 15	List of Contract Drawings
00 11 15.1	Advertisement for Bid (Owner Document)
00 11 15.2	Roane County Purchasing General Terms & Conditions (Owner Document)
00 11 15.3	Roane County Regulation Compliance (Owner Document)
00 11 15.4	Roane County Non-Discrimination, Non-Debarment & Lobbying Affidavit (Owner Document)
00 11 15.5	Roane County Iran Divestment Act Compliance (Owner Document)
00 11 15.6	Roane County Non-Boycott of Israel Affidavit (Owner Document)
00 11 15.7	Roane County Purchasing Vendor Information Form (Owner Document)
00 11 15.8	Roane County Purchasing Signatory Authority Form (Owner Document)
00 11 15.9	Roane County Drug-Free Workplace Affidavit (Owner Document)
00 11 15.10	Roane County Statement of Compliance Certificate Illegal Immigrants (Owner Document)
00 11 15.11	Roane County Regulation Compliance Affidavit (Owner Document)
00 11 15.12	Roane County Bid Envelope Cover (Owner Document)
00 21 13	Instructions to Bidders
00 30 00	Available Project Information
00 30 00.1	Exhibit A (Separate Document)
00 41 00	Bid Form
00 61 13	Performance and Payment Bonds
00 63 25	Substitution Request Form
00 72 00	General Conditions
00 73 00	Supplementary Conditions

### DIVISION 01 - GENERAL REQUIREMENTS

01 11 00	Summary of the Work
01 21 00	Allowances
01 29 00	Payment Procedures
01 30 00	Administrative Requirements
01 31 10	Weather Delays
01 32 00	Project Meetings
01 33 00	Submittal Procedures
01 40 00	Quality Requirements
01 42 00	References
01 50 00	Temporary Facilities and Controls
01 60 00	Materials and Equipment
01 63 00	Substitutions
01 73 29	Cutting and Patching
01 77 00	Project Closeout

### DIVISION 02 - EXISTING CONDITIONS

02 41 19	Selective Demolition
----------	----------------------

### DIVISION 03 - CONCRETE

Not Used

**DIVISION 04- MASONRY**

Not Used

**DIVISION 05 - METALS**

**05 51 33** Fixed Vertical Ladders

**DIVISION 06 - WOOD, PLASTICS, AND COMPOSITES**

06 10 53 Miscellaneous Rough Carpentry

**DIVISION 07 - THERMAL AND MOISTURE PROTECTION**

07 54 23 Thermoplastic Membrane Roofing

07 62 00 Sheet Metal Flashing and Trim

07 71 00 Roof Specialties

07 72 00 Roof Accessories

07 92 00 Joint Sealants

**DIVISION 08 - OPENINGS**

Not Used

**DIVISION 09 - FINISHES**

09 96 00 High-Performance Coatings

**END OF SECTION**

## SECTION 05 51 33 - FIXED VERTICAL LADDERS

### PART 1 - GENERAL

#### 1.1 SUMMARY

- A. Section Includes: Heavy duty fixed vertical ladders
- B. Related Sections
  - 1. Section 00 63 25 - Substitution Request Form
  - 2. Section 01 25 00 - Substitution Procedures
  - 3. Section 01 33 00 - Submittal Procedures
  - 4. Section 01 60 00 - Product Requirements

#### 1.2 REFERENCES

- A. ANSI A14.3
- B. OSHA 1910.23
- C. OSHA 1910.28
- D. OSHA 1910.29

#### 1.3 SUBMITTALS

- A. Submit under provisions of Section 01 33 00.
- B. Manufacturer's data sheets on each product to be used, including:
  - 1. Preparation instructions and recommendations.
  - 2. Storage and handling requirements and recommendations.
  - 3. Shop Drawings: Plan and section of ladder installation.

#### 1.4 QUALITY ASSURANCE

- A. Take field measurements prior to fabrication. Record field measurements on Shop Drawings

#### 1.5 DELIVERY, STORAGE, AND HANDLING

- A. Store products in manufacturer's unopened packaging until ready for installation.
- B. Store products inside under cover until installation. If stored outside, store under a tarp or suitable cover.

## 1.6 WARRANTY

- A. Limited Warranty: Five years against defective material and workmanship, covering parts only, no labor or freight. Defective parts, if deemed so by the manufacturer, will be replaced at no charge, freight excluded, upon inspection at manufacturer's plant which warrants same.

## PART 2 - PRODUCTS

### 2.1 MANUFACTURERS

- A. Manufacturer: Precision Ladders, LLC,  
  
Morristown, Tennessee 37816-2279  
  
Telephone: 800-225-7814  
  
[www.PrecisionLadders.com](http://www.PrecisionLadders.com)
- B. Requests for substitutions will be considered in accordance with the provisions of Section 00 63 25, 01 25 00, and 01 60 00.

### 2.2 ALUMINUM FIXED VERTICAL LADDER

- A. Provide Model Components:
  - 1. Ladder Stringer: 2-1/2-inch by 1-1/16-inch by 1/8-inch (64 mm by 27 mm by 3 mm) extruded 6005-T5 aluminum channel. Pitch: 90 degrees.
  - 2. Ladder Tread: 2-1/4-inch by 3/4-inch by 1/4-inch (57 mm by 19 mm by 6 mm) extruded 6005-T5 aluminum with deeply serrated top surface.
  - 3. Ladder Mounting Bracket: 8-1/2-inch by 2-inch by 3-inch by 1/4-inch thick (216 mm by 51 mm by 76 mm by 6 mm) aluminum angle. Standard mill finish on aluminum ladders.
  - 4. Capacity: Unit shall support a 1,500 lb (680 kg) loading without failure.
  - 5. Walk-Thru:
    - a. Handrails: 1-1/4-inch (32 mm) aluminum square tube with rounded edges.
    - b. Mounting Brackets: 4-inch by 4-inch by 1/4-inch (102 mm by 102 mm by 6 mm) aluminum.
    - c. Side Rails: 42-inch (1067 mm) side rail extension for through ladder exits.
  - 6. Rest Platform:
    - a. Bar grating.
    - b. Platform Size: 30" inches by 48 inches (762 mm by 1219 mm) standard.
    - c. Toe Boards. 6005 T-5 aluminum.
    - d. Handrails: 1-1/4-inch (32 mm) aluminum square tube 42-inches (1067 mm) high.

2.3 FABRICATION

- A. Completely fabricate ladder ready for installation before shipment to the site.

PART 3 - EXECUTION

3.1 EXAMINATION

- A. If substrate preparation is the responsibility of another installer, notify Architect of unsatisfactory preparation before proceeding.
- B. Examine materials upon arrival at site. Notify the carrier and manufacturer of any damage.

3.2 INSTALLATION

- A. Install in accordance with approved submittals.

3.3 PROTECTION

- A. Protect installed products until completion of project.
- B. Touch-up, repair or replace damaged products before Substantial Completion.

3.4 SCHEDULE

- A. Provide the following ladder as manufactured by Precision Ladders, LLC.
  - 1. Model FL-XX Fixed Ladder

**END OF SECTION**

## SECTION 07 54 23 - THERMOPLASTIC MEMBRANE ROOFING

### PART 1 - GENERAL

#### 1.1 SUMMARY

##### A. Section Includes:

1. Full removal to deck of existing roof layers including insulation and roof accessories.
2. Replacing roof with fully adhered thermoplastic roofing membrane
3. Insulation, flat and tapered.
4. Flashings.
5. Roofing stack boots
6. Roofing expansion joints
7. Walkway pads.

##### B. Related Sections

1. Section 00 63 25 - Substitution Request Form
2. Section 01 33 00 - Submittal Procedures
3. Section 01 40 00 - Quality Requirements
4. Section 01 63 00 - Substitution Procedures
5. Section 06 10 53 - Miscellaneous Carpentry
6. Section 07 62 00 - Sheet Metal Flashing and Trim
7. Section 07 71 00 - Roof Specialties
8. Section 07 72 00 - Roof Accessories
9. Section 07 90 00 - Sealants

#### 1.2 REFERENCE STANDARDS

##### A. American Society for Testing Materials (ASTM)

1. ASTM C1177/C1177M - Standard Specification for Glass Mat Gypsum Substrate for Use as Sheathing
2. ASTM C1289 - Standard Specification for Faced Rigid Cellular Polyisocyanurate Thermal Insulation Board
3. ASTM D6878/D6878M - Standard Specification for Thermoplastic Polyolefin Based Sheet Roofing

##### B. Factory Mutual Global

1. FM DS 1-28 - Wind Design
2. 4450 Class 1 Insulated Steel Deck Roofs
3. 4470 Single-Ply, Polymer -Modified Bitumen Sheet, Built Up Roof (BUR) and Liquid Applied Roof Assemblies for Use in Class 1 And Noncombustible Roof Deck Construction

##### C. National Roofing Contractors Association (NCRA)

1. NRCA (RM) - The NRCA Roofing Manual
2. NRCA (WM) - The NRCA Waterproofing Manual

### 1.3 PERFORMANCE REQUIREMENTS

- A. Construct the roof to ensure water is removed completely within 48 hours.
- B. FMG Listing: Provide roofing membrane, base flashings, and component materials that comply with requirements in FMG 4450 and FMG 4470.
  - 1. Fire/Windstorm Classification: Class 1A-90
  - 2. Hail Resistance: SH

### 1.4 ADMINISTRATIVE REQUIREMENTS

- A. Preinstallation Meeting: Convene one week before starting work of this section.
  - 1. Review preparation and installation procedures and coordinating and scheduling required with related work.
  - 2. Contractor, its project manager, job superintendent and all major subcontractors shall be present. Owner's representative, Architect and Engineer will be present.

### 1.5 SUBMITTALS

- A. Refer to Section 01 33 00 for submittal procedures.
- B. Product Data: Provide data indicating membrane materials, flashing materials, insulation, surfacing, and fasteners.
- C. Samples for Verification: Submit two samples 6 by 6 inches in size illustrating insulation.
- D. Shop Drawings:
  - 1. Submit drawings that indicate joint or termination detail conditions and conditions of interface with other materials.
  - 2. Submit a detailed tapered insulation plan.
  - 3. Submit detailed drawing of custom details.
- E. Manufacturer's Installation Instructions: Indicate membrane seaming precautions and perimeter conditions requiring special attention.
- F. Manufacturer's Certificate: Certify that products meet or exceed specified requirements.
- G. Manufacturer's Qualification Statement.
- H. Manufacturer's Field Reports: Indicate procedures followed, ambient temperatures, humidity, wind velocity during application, and supplementary instructions given.
- I. Installer's Qualification Statement
- J. Testing Firm's Qualification Statement

- K. Warranty: Submit manufacturer warranty and ensure forms have been completed in Owner's name and registered with manufacturer.

#### 1.6 QUALITY ASSURANCE

- A. Perform work in accordance with NRCA Roofing and Waterproofing Manual, SMACNA, manufacturer's recommendations and the specifications.
- B. Manufacturer Qualifications: Company specializing in manufacturing the products specified in this section with a minimum of five years of documented experience.
- C. Installer Qualifications: Company specializing in performing the work of this section with at least five years of documented experience.
  - 1. Approved by roof system manufacturer.
- D. Applicator for PMMA liquid flashing to have minimum two years successful experience with the product as specified.
- E. Fire-Test Characteristics: Provide membrane roofing materials that have been tested according to the following:
  - 1. Exterior Fire-Test Exposure: Class A ANSI/UL 790
  - 2. Fire-Resistance Ratings: ASTM E 119
- F. Pre-Installation Conference: Conduct conference two weeks before the roofing is scheduled to begin. Invite the Owner, Architect, and roof membrane Manufacturer's Product Representative, and manufacturer representative for roof insulation, and other affected trades.  
Review the following topics:
  - 1. Structural loading limitations of roof deck during and after roofing.
  - 2. Base flashings, special roofing details, roof drainage, roof penetrations, equipment curbs,
  - 3. Temporary protection requirements for roofing system during and after installation.
  - 4. Roof observation and repair procedures after roofing installation.
  - 5. Schedule
  - 6. Weather conditions
  - 7. Long lead items
  - 8. Product delays
  - 9. Manpower and Equipment

#### 1.7 DELIVERY, STORAGE, AND HANDLING

- A. Deliver materials in manufacturer's original containers, dry and undamaged, with seals and labels intact.
- B. Store materials in weather protected environment, clear of ground and moisture.

- C. Ensure storage and staging of materials does not exceed static and dynamic load-bearing capacities of roof decking.
- D. Protect foam insulation from direct exposure to sunlight.
- E. Roof insulation must be stored away from all sources of ignition and excessively high temperatures.
- F. Any insulation materials found to be wet or have been wet may not be used on the Project. They must be removed from the jobsite and replaced with acceptable materials at no cost to the Owner or delay of the Project.

#### 1.8 FIELD CONDITIONS

- A. Prior to roof removal and demolition activities, the Contractor is required to water test all existing roof drains, and/or underground drainage systems and notify the Architect if any are found to be obstructed or restricted. Proceeding with roof removal activity shall indicate Contractor's acceptance that all drain lines are clear and free flowing.**
- B. Do not expose materials vulnerable to water or sun damage in quantities greater than can be weatherproofed the same day.
- C. Do not apply roofing membrane during unsuitable weather per Manufacturer's requirements.
- D. Do not apply the roofing membrane when ambient temperature is below 40°F.
- E. Do not apply roofing membrane to damp or frozen deck surface or when precipitation is expected or occurring.
- F. Schedule applications so that no partially completed sections of roof are left exposed at end of workday.

#### 1.9 WARRANTY

- A. See Section 01 77 00 - Project Closeout for additional warranty requirements.
- B. Correct defective work prior to Date of Substantial Completion.
- C. System Warranty: Provide manufacturer's no dollar limit (NDL) system warranty.
  - 1. Warranty Term: 20 years.
  - 2. Warranty shall include all materials and workmanship installed by the approved Installer without exceptions for non-compliant materials, techniques, or details.
  - 3. The Roofing Contractor and Manufacturer shall be jointly and severally responsible during the initial two (2) year period; and if the Roofing Contractor is unable or unwilling to perform warranty repairs, the Manufacturer shall be fully responsible. Thereafter, for the full term of the

Warranty, the Manufacturer shall be fully responsible for all materials and workmanship by the Roofing Contractor.

4. Exceptions are not Permitted:
  - a. Damage due to roof traffic.
  
- D. Roof System Installer Warranty: The roof system installer shall warrant for a minimum period of two (2) years from the Date of Substantial Completion that the roof system, as installed, is free from defects in materials and installation workmanship, to include the roof membrane, flashing, insulation, accessories, attachments, and sheet metal installation integral to a complete watertight roof system assembly. The roof system installer is responsible for correction of defective workmanship and replacement of damaged and affected materials. The roof system installer is jointly and severally responsible with the Roof System Manufacturer for all costs associated with the repair or replacement work during the initial two-year period.

## PART 2 - PRODUCTS

### 2.1 MANUFACTURERS

- A. Thermoplastic Polyolefin (TPO) Membrane Roofing Materials:
  1. GAF; Everguard TPO: [www.gaf.com](http://www.gaf.com)
  2. Carlisle SynTec; Sure-Weld TPO: [www.carlisle-syntec.com](http://www.carlisle-syntec.com).
  3. Holcim Elevate; UltraPly TPO: [www.holcimelevate.com](http://www.holcimelevate.com).
  4. Johns Manville; JM TPO: [www.jm.com](http://www.jm.com).
  
- B. Insulation
  1. GAF; EnergyGuard ISO & ISO HD
  2. Carlisle SynTec; SecurShield Insulation Polyiso: [www.carlisle-syntec.com](http://www.carlisle-syntec.com).
  3. Holcim Elevate; Isogard GL & Isogard HD: [www.holcimelevate.com](http://www.holcimelevate.com).
  4. Johns Manville; Flat & Tapered ENGRY 3: [www.jm.com](http://www.jm.com).
  
- C. Liquid Applied Flashing System - Seamless, layered, fleece reinforced, catalyzed polymethyl methacrylate (PMMA) resin; approved for use with specified roof system.
  1. Polymethyl Methacrylate Flashing Membrane (PMMA) Flashing Membrane
    - a. Rapid curing, polymethyl methacrylate (PMMA) liquid resin with an embedded polyester reinforcement fabric used for monolithic waterproofing flashing membranes.
      - 1) VOC content: 4.2 g/L
      - 2) To be selected by Architect
    - b. Products and manufacturers which may be incorporated into the work are:
      - 1) Siplast Parapro 123 Flashing System (Basis of Design)
  
- D. Substitutions: Under provisions of Section 01 63 00.

## 2.2 ROOFING - UNBALLASTED APPLICATIONS

- A. Thermoplastic Membrane Roofing, Single ply membrane, fully adhered, over insulation.
- B. Roofing Assembly Requirements:
  - 1. Insulation Thermal Value (R), minimum: R-30 per IECC; provide insulation of thickness required.
- C. Acceptable Insulation Types - Constant Thickness Application:
  - 1. Minimum 2 layers of polyisocyanurate board.
  - 2. **Over metal deck: Mechanically fasten bottom layer of polyisocyanurate board. Adhere top layer of polyisocyanurate board and cover with single layer of adhered high density polyisocyanurate board.**
  - 3. **Over tectum deck: Mechanically fasten vented base sheet to tectum deck. Adhere both layers of polyisocyanurate board and cover with single layer of adhered high density polyisocyanurate board.**
- D. Acceptable Insulation Types - Tapered Application:
  - 1. **Over metal deck: Uniform thickness polyisocyanurate board per 2.2C.2 covered with adhered tapered polyisocyanurate board and single layer of adhered high density polyisocyanurate board.**
  - 2. **Over tectum deck: Uniform thickness polyisocyanurate board per 2.2C.3 covered with adhered tapered polyisocyanurate board and single layer of adhered high density polyisocyanurate board.**

## 2.3 MEMBRANE ROOFING AND ASSOCIATED MATERIALS

- A. Membrane Roofing Materials:
  - 1. TPO: Thermoplastic polyolefin (TPO) complying with ASTM D6878/D6878M, sheet contains reinforcing fabrics or scrims.
    - a. Thickness: 60 mil, 0.060-inch, nominal.
  - 2. Sheet Width: Factory fabricated into largest sheets possible.
  - 3. Color: White.
- B. Seaming Materials: As recommended by membrane manufacturer.
- C. Membrane Fasteners: As recommended and approved by membrane manufacturer.
- D. Flexible Flashing Material: Same material as membrane.

## 2.4 INSULATION

- A. Polyisocyanurate Board Insulation: Rigid cellular foam, complying with ASTM C1289, Type I, Class I, kraft paper both major faces and with the following characteristics:
  - 1. Compressive Strength: 20 psi

2. Board Size: 48 by 96 inch.
3. Tapered Board: Slope as indicated; minimum thickness 1/2 inch; fabricate of fewest layers possible.
4. Thermal Resistance: Minimum R-value of R-30 as required by 2018 IECC. The Project assumes a typical 5.2-inch thickness.

## 2.5 COVERBOARD

- A. High Density Polyisocyanurate Cover Board: Rigid cellular foam, complying with ASTM C1289, Type II, Class 4, polymer bonded glass fiber mat both faces and with the following characteristics:
  1. Compressive Strength: 80 psi
  2. Board Size: 48 by 48 inch or 48 by 96 inch.
  3. Thermal Resistance: Minimum R-value of R-2.5 per 0.5”.

## 2.6 ACCESSORIES

- A. Stack Boots: Prefabricated flexible boot and collar for pipe stacks through membrane; same material as membrane.
- B. Insulation Joint Tape: Glass fiber reinforced type as recommended by insulation manufacturer, compatible with roofing materials; 6 inches wide; self-adhering.
- C. Insulation Fasteners: Appropriate for the purpose intended and approved by roofing manufacturer.
  1. Length as required for thickness of insulation material and penetration of deck substrate with metal washers.
- D. Membrane Adhesive: As recommended by membrane manufacturer.
- E. Surface Conditioner for Adhesives: Compatible with membrane and adhesives.
- F. Thinners and Cleaners: As recommended by adhesive manufacturer, compatible with membrane.
- G. Insulation Adhesive: As recommended by insulation manufacturer.
- H. Sealants: As recommended by membrane manufacturer.
- I. Walkway Pads: Suitable for maintenance traffic, contrasting color or otherwise visually distinctive from roof membrane.
  1. Composition: Roofing membrane manufacturer's standard.

## PART 3 - EXECUTION

### 3.1 EXAMINATION

- A. Verify that surfaces and site conditions are ready to receive work.

- B. Verify deck is supported and secure.
- C. Verify deck is clean and smooth, flat, free of depressions, waves, or projections, properly sloped and suitable for installation of roof system.
- D. Verify deck surfaces are dry and free of snow or ice.
- E. Verify that roof openings, curbs, and penetrations through roof are solidly set, and nailing strips are in place.
- F. Verify proper function of drainage systems. Beginning work indicates acceptance of existing conditions as properly functioning.

### 3.2 INSTALLATION

- A. Perform work in accordance with manufacturer's instructions, NRCA (RM), and NRCA (WM) applicable requirements.
- B. Do not apply roofing membrane during unsuitable weather per Manufacturer's requirements.
- C. Do not apply roofing membrane when ambient temperature is outside the temperature range recommended by manufacturer.
- D. Do not apply roofing membrane to damp or frozen deck surface or when precipitation is expected or occurring.
- E. Do not expose materials vulnerable to water or sun damage in quantities greater than can be weatherproofed the same day.
- F. Coordinate this work with installation of associated counterflashings installed by other sections as work of this section proceeds.
- G. Prevent materials from entering and clogging roof drains and conductors and from spilling or migrating onto surfaces of other construction. Remove roof-drain plugs when no work is taking place or when rain is forecast.
- H. Install night seal at end of each workday or when rain is forecast. Provide temporary seals to prevent water from entering completed sections of roofing system. Ensure stagger and offset of underlying insulation to prevent thermal breaks. Remove and discard temporary seals before beginning work on adjoining roofing.

### 3.3 INSTALLATION - INSULATION, UNDER MEMBRANE

- A. Install vapor retarder to deck surface with adhesive in accordance with manufacturer's instructions.
  - 1. Extend vapor retarder under cant strips and blocking to deck edge.
  - 2. Install flexible flashing from vapor retarder to air seal material of wall construction, lap and seal to provide continuity of the air barrier plane.

Exception: If the roof system manufacturer does not require the vapor retarder for the new roof system warranty, the vapor retarder can be excluded from the roof system.

- B. Ensure vapor retarder is clean and dry, continuous, and ready for application of insulation.
- C. Attachment of Insulation:
  - 1. Over existing metal deck:
    - a. Mechanically fasten first layer of insulation to deck in accordance with roofing manufacturer's instructions.
    - b. Embed second layer if insulation into full bed of adhesive in accordance with roofing and insulation manufacturers' instructions.**
    - c. Embed coverboard of insulation into full bed of adhesive in accordance with roofing and insulation manufacturers' instructions.
  - 2. Over existing tectum:
    - a. Mechanically fasten vented base sheet to tectum.
    - b. Embed both layers of insulation to vented base sheet into full bed of adhesive in accordance with roofing and insulation manufacturers' instructions
    - c. Embed coverboard of insulation into full bed of adhesive in accordance with roofing and insulation manufacturers' instructions.
- D. Lay subsequent layers of insulation with joints staggered minimum 6 inches from joints of preceding layer.
- E. Place tapered insulation to the required slope pattern in accordance with manufacturer's instructions.
- F. On metal deck, place boards parallel to flutes with insulation board edges bearing on deck flutes.
- G. Lay boards with edges in moderate contact without forcing. Cut insulation to fit neatly to perimeter blocking and around penetrations through roof.
- H. At roof drains, use tapered boards to slope down to roof drains over a distance of 24 inches.
- I. Insulation attachment pattern to increase at perimeters and corners per FM1-28 and FM1-29. Perimeter and corner to be defined no less than 4'-0". This applies to inside and outside corners.
- J. Verify proper drainage of insulation composite prior to applications of membrane. Ponding water is not acceptable. Water must drain within 48 hours.
- K. Do not install more insulation than what can be covered with membrane in same day.

### 3.4 INSTALLATION - MEMBRANE

- A. **Prior to installation of the roof membrane, the Contractor is required to verify that adequate and proper drainage has been provided. Ponding will not be accepted.**
- B. Roll out membrane, free from wrinkles or tears. Place sheet into place without stretching.
- C. Shingle joints on sloped substrate in direction of drainage.
- D. Fully Adhered Application: Apply adhesive to substrate at rate of manufacturer recommended gal/square. Fully embed membrane in adhesive except in areas directly over or within 3 inches of expansion joints. Fully adhere one roll before proceeding to adjacent rolls.
- E. Overlap edges and ends and seal seams by contact adhesive, minimum 3 inches. Seal permanently waterproof. Install uniform bead of sealant to joint edge.
- F. At intersections with vertical surfaces:
  - 1. Extend membrane over cant strips and up a minimum of 4 inches onto vertical surfaces.
  - 2. Fully adhere flexible flashing over membrane and up to nailing strips.
- G. Around roof penetrations, seal flanges and flashings with flexible flashing.
- H. Install roofing expansion joints where indicated. Make joints watertight.
- I. Coordinate installation of roof drains and sumps and related flashings.
- J. Extend membrane under coping or gravel stop minimum 1" below outside face of nailer.

### 3.5 INSTALLATION - MEMBRANE RETROFIT OVER METAL ROOF

- A. PREPARATION
  - 1. Suitable roofs for recover shall be free of dust, dirt, debris, and any contaminants that may adversely affect the performance of the new roof. Areas of substantial deck deflection or membrane imperfections shall be corrected prior to installing any new roofing.
  - 2. All applicable code requirements must be met for recover over an existing roofing system.
  - 3. Pull tests must be performed by roof fastener manufacturer.
  - 4. It is the responsibility of the roofing contractor to determine the fitness of an existing metal panel roof system that will be serving as a substrate for a specific roofing system installation.
- B. INSTALLATION

1. Flute Fill: Fill all flutes with a loose applied base layer of insulation. Insulation must be of equal height as metal ribs, seams or flutes to allow for subsequent layers to be applied without interference. Minimal fastening should be performed to avoid movement of the boards
2. Upper Layers: Mechanically fasten upper layers of insulation using fasteners specifically designed and sized for fastening roof insulation to specified deck.
3. Install cover board over insulation with joints staggered from joints of insulation in accordance with manufacturer's instructions.
4. Install membrane and flashings in accordance with roofing system manufacturer's instructions.
5. Mechanically Attached Membranes: Roll membrane out perpendicular to metal deck ribs.
6. Accurately align roof membrane and maintain uniform side and end laps of minimum dimensions required by manufacturer. Shingle joints on sloped substrates in direction of drainage where possible.
7. Install membrane and mechanical attachment devices in accordance with manufacturer's instructions. Attach securely at terminations, penetrations, and perimeter of roofing.
8. Seams: Clean seam areas, overlap roof membrane, and hot-air weld side and end laps of roof membrane and sheet flashings. Test lap edges with probe to verify seam weld continuity in accordance with manufacturer's technical bulletins.
9. Extend membrane under edge metal system and secure to outside face of wall.
10. Around roof penetrations, roof edges, seal flanges and flashings with flexible flashing.

### 3.6 FIELD QUALITY CONTROL

- A. Owner will provide testing services in accordance with Section 01 40 00 - Quality Requirements. Contractor to provide temporary construction and materials for testing.
- B. Provide daily on-site attendance of roofing and insulation manufacturer's representative during installation of this work.
- C. Submit Manufacturer's Representative detailed report of conditions to the Architect within 24 hours. Document weather, temperature highs and lows, manpower, and equipment.

### 3.7 CLEANING

- A. In areas where finished surfaces are soiled by work of this section, consult manufacturer of surfaces for cleaning advice and comply with their documented instructions.
- B. Repair or replace defaced or damaged finishes caused by work of this section.

- D. Remove demolished materials from the site; dispose in legal manner.

### 3.8 PROTECTION

- A. Protect installed roofing and flashings from construction operations.
- B. Where traffic must continue over finished roof membrane, protect surfaces using durable materials.
- C. Correct deficiencies in work in accordance with guarantee requirements. Repair or replace defaced or damaged finishes caused by work of this section.

### END OF SECTION



DATE: 08/15/2025  
 PROJECT NO: 25018  
 BID NO: 2026-02-177

**PROJECT REVISIONS**

#	DATE	DESCRIPTION
1	08/17/2025	ADD-02


THIS DRAWING IS THE PROPERTY OF THE LEWIS GROUP ARCHITECTS, INC. AND IS TO BE USED ONLY FOR THE PROJECT AND SITE SPECIFICALLY IDENTIFIED HEREIN. THIS DRAWING IS NOT TO BE REPRODUCED OR COPIED IN ANY MANNER WITHOUT THE WRITTEN CONSENT OF THE LEWIS GROUP ARCHITECTS, INC. AND SHALL NOT BE REPRODUCED OR COPIED IN ANY MANNER WITHOUT THE WRITTEN CONSENT OF THE LEWIS GROUP ARCHITECTS, INC. IF IT IS TO BE RETURNED UPON REQUEST.

**GENERAL ROOF PLAN NOTES**

- REMOVE EXISTING ROOF MEMBRANE OR OTHER ROOFING MATERIAL, INSULATION, AND OTHER ROOFING ACCESSORIES TO EXISTING DECK OR SUBSTRATE. INSPECT THE EXISTING DECK CONDITION FOR MOISTURE AND/OR STRUCTURAL FAILURE. NOTIFY ARCHITECT IMMEDIATELY AND DOCUMENT CONDITIONS. INSTALL NEW ROOF MEMBRANE OVER 1/2" HD COVERBOARD OVER NEW RIGID INSULATION OVER EXISTING DECK, ANCHOR ROOFING AND INSULATION PER MANUFACTURER'S RECOMMENDATIONS. TARGET AVERAGE R-VALUE OF R-30 PER IECC 2018.
- REMOVE EXISTING HVAC UNITS. FLASH PER ROOFING MANUFACTURER'S STANDARD DETAILS BEFORE REINSTALLING HVAC EQUIPMENT. PROVIDE CRICKETS AS SHOWN ON THE ROOF PLAN. PROVIDE CURB EXTENSIONS AS REQUIRED TO ACHIEVE 6" MINIMUM HEIGHT ABOVE FINISH ROOF SURFACE. CONFIRM PROPER WEATHERTIGHTNESS IS ACHIEVED.
- FIELD VERIFY ROOF DRAIN SIZES AND PIPING CONTINUATION.
- FLASH, COUNTERFLASH, AND SEAL ALL PENETRATIONS PER STANDARD WORKMANLIKE PRACTICE AND ALL ROOF MANUFACTURER'S RECOMMENDATIONS AND STANDARD DETAILS.
- DETAILS SHOWN ARE REPRESENTATIVE IN NATURE AND SHALL BE REVISED AS REQUIRED BY ROOFING MANUFACTURER AS TO ACHIEVE FULLY SPECIFIED WARRANTY - SUBMIT REVISIONS TO ARCHITECT FOR APPROVAL.
- CONTRACTOR TO REPLACE MISSING OR BROKEN ROOF DRAIN COVERS.
- CONTRACTOR TO FIELD VERIFY ALL EXISTING CONDITIONS, PENETRATIONS, AND DIMENSIONS. IF CONDITIONS ARE PRESENT THAT ARE NOT SHOWN ON PLANS, TREAT IN SIMILAR MANNER AS DETAILS SHOWN.
- CONTRACTOR SHALL PROVIDE AND INSTALL CONDENSATE DRAINS FROM EACH ROOFTOP HVAC UNIT WHICH HAS AN EXTERNAL CONDENSATE DISCHARGE ONTO THE ROOF SURFACE. EACH DRAIN SHALL EXTEND TO THE NEAREST PRIMARY ROOF DRAIN OR OFF THE ROOF SURFACE.
- CONTRACTOR TO PROVIDE SPLASHPANS WHERE A DOWNSPOUT DISCHARGES ONTO A ROOF SURFACE. CONTRACTOR TO PROVIDE SPLASHPANS WHERE A DOWNSPOUT DISCHARGES AT GRADE. CONTRACTOR TO FILL AND COMPACT WHERE EXISTING DOWNSPOUTS HAVE ERODED A DIVET AT GRADE.
- CONTRACTOR TO PAINT ALL GAS LINES SAFETY YELLOW. THIS INCLUDED ANY GAS LINE ONE THE ROOF OR ON THE EXTERIOR WALLS.

**ROOF LEGEND**






- FLAT INSULATION OVER SLOPED STRUCTURE
- NEW TAPERED INSULATION OVER EXISTING FLAT STRUCTURE
- N.L.C.
- BUILDING EXPANSION JOINT

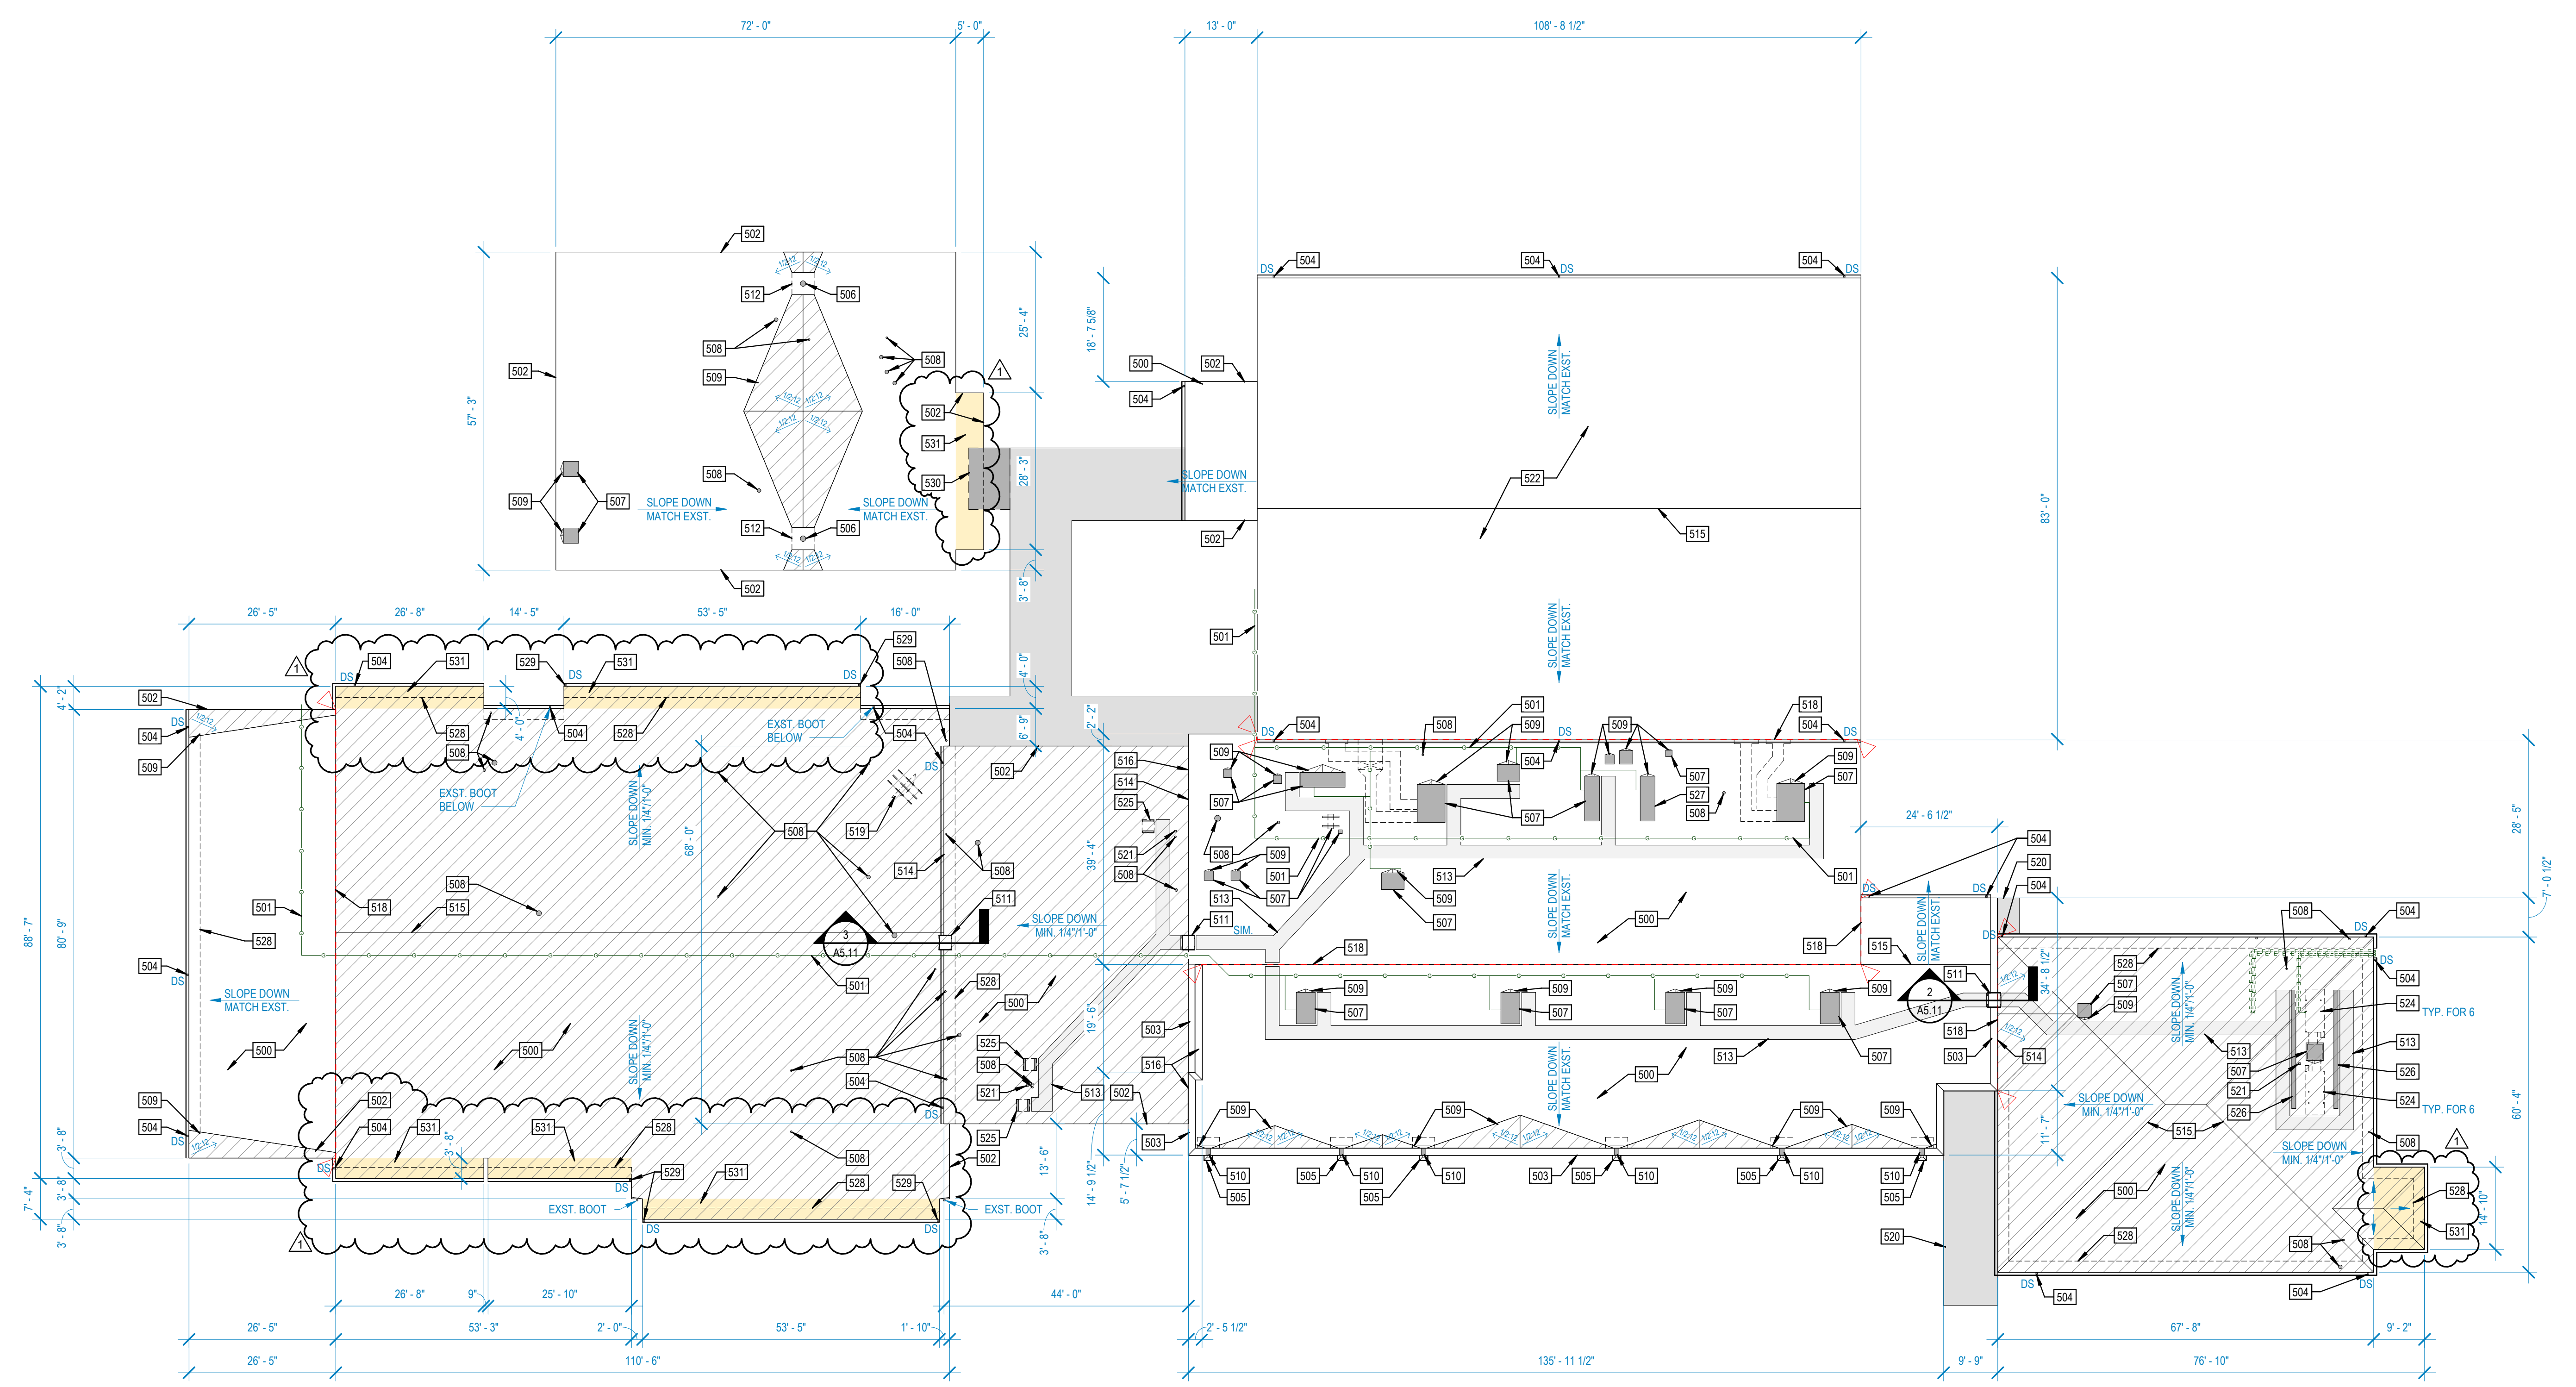


**ROOF PLAN AND NOTES**  
 SCALE: 1/16" = 1'-0"  
 1 A5.11

**ROOF PLAN KEYNOTES**


- 500 REMOVE EXISTING ROOF MEMBRANE OR OTHER ROOFING MATERIAL, INSULATION, AND OTHER ROOFING ACCESSORIES TO EXISTING DECK OR SUBSTRATE. INSPECT THE EXISTING DECK CONDITION FOR MOISTURE AND/OR STRUCTURAL FAILURE - NOTIFY ARCHITECT IMMEDIATELY AND DOCUMENT CONDITIONS - INSTALL NEW ROOF MEMBRANE OVER 1/2" HD COVERBOARD OVER NEW RIGID INSULATION OVER EXISTING DECK - ANCHOR ROOFING AND INSULATION PER MANUFACTURER'S RECOMMENDATIONS - TARGET AVERAGE R-VALUE OF R-30 PER IECC 2018
- 501 EXISTING GAS SUPPLY LINE TO REMAIN - PIPE SUPPORTS AND BASES TO BE REPLACED - SUPPORTS AND BASES SPACED AT 8'-0" O.C. MAX. - EXISTING RUSTED GAS LINE TO BE CLEANED, SCRAPPED, AND PAINTED WITH NEW HIGH PERFORMANCE COATING - COLOR, SAFETY YELLOW - SEE DETAIL 10A5.21
- 502 NEW CONTINUOUS PREFINISHED METAL GRAVELSTOP W/ ALL ACCESSORIES AS REQUIRED FOR PROPER INSTALLATION - SEE DETAIL 12A5.21
- 503 NEW PREFINISHED METAL GUTTER AND DOWNSPOUTS - SEE DETAIL 13A5.21 FOR GUTTER SIZING - SEE DETAIL 11A5.21 FOR DOWNSPOUT SIZING
- 504 NEW PREFINISHED METAL CONDUCTOR HEAD AND DOWNSPOUT - SEE DETAIL 11A5.21 - MATCH EXISTING LOCATIONS - DOWNSPOUT TO ALIGN W/ EXISTING STORM SEWER ACCESS WHERE AVAILABLE - DOWNSPOUT SIZE TO BE 3.5" X 4"
- 505 EXISTING ROOF DRAIN - REMOVE DRAIN FOR INSTALLATION OF MEMBRANE AND REINSTALL EXISTING - SEE DETAIL 14A5.21 - REPLACE MISSING OR DAMAGED ROOF DRAIN COVERS
- 506 EXISTING ROOF CURB TO REMAIN - REMOVE EXISTING EQUIPMENT AND INSPECT 2x CURB AND NALLERS - REPLACE AS REQUIRED - INSTALL FLASHING AND REINSTALL EXISTING EQUIPMENT - SEE DETAIL 21A5.21
- 507 EXISTING PIPE PENETRATION TO REMAIN - INSTALL NEW PIPE BOOT - SEE DETAIL 31A5.21
- 508 NEW CRICKET
- 509 EXISTING THRU-WALL SCUPPER W/ NEW SLEEVE, FLASHING, AND NEW MEMBRANE - SEE DETAIL 14A5.21
- 510 NEW LADDER - SEE DETAILS 2.3A5.11
- 511 NEW LADDER - SEE DETAILS 2.3A5.11
- 512 NEW SLUMP AREA
- 513 NEW ROOF WALK PADS
- 514 SIGNIFICANT CHANGE IN ROOF ELEVATION
- 515 RIDGE
- 516 EXISTING CONNECTION OF ADDITION - FILL GAP W/ RIGID INSULATION - APPLY NEW FLASHING UP BRICK 8" MIN. TO TERMINATION BAR - SEE DETAILS 16.17A5.21
- 518 NEW EXPANSION JOINT COVER NOTED W/ RED DASH LINE - SEE DETAILS 5.6A5.21
- 519 EXISTING ROOF-MOUNTED DISH, FRAME, BLOCKS, AND ELECTRICAL SUPPLY TO BE REMOVED
- 520 EXISTING CANOPY - N.L.C.
- 521 EXISTING PITCH POCKET TO BE REMOVED - INSTALL NEW LIQUID APPLIED FLASHING - SEE DETAIL 9A5.21
- 522 EXISTING METAL ROOF TO RECEIVE TPO RETROFIT - SEE DETAIL 41A5.11
- 524 EXISTING MECHANICAL UNIT SUPPORT - INSTALL NEW LIQUID APPLIED FLASHING - SEE DETAIL 8A5.21
- 525 EXISTING EXPOSED WOOD SUPPORT TO BE REMOVED - REPLACE W/ NEW PRE-MANUFACTURED CURB - REINSTALL EXISTING EQUIPMENT - SEE DETAIL 12A5.21
- 526 EXISTING ROOF-MOUNTED TRANSITION TO REMAIN - SEE DETAIL 9A5.21
- 527 OWNER TO REPLACE EXISTING MECHANICAL EQUIPMENT AND CONNECTION TO GAS LINE PRIOR TO THE ROOF REPLACEMENT PROJECT - PROCEED WITH KEYNOTE 507
- 528 AT 24" FROM GUTTER, INCREASE SLOPE TO 1/2" IN 4'
- 529 NEW PREFINISHED METAL GUTTER AND DOWNSPOUTS - SEE DETAIL 13A5.21 FOR GUTTER SIZING - SEE DETAIL 11A5.21 FOR DOWNSPOUT SIZING - CONNECT NEW DOWNSPOUT TO EXISTING STORM SEWER CONNECTION - MATCH ANGLE OF AWNING WHEN APPLICABLE
- 530 EXISTING PORTION OF CANOPY TO BE REMOVED
- 531 YELLOW FIELD INDICATES EXISTING PL WOOD SOFFIT TO BE RENOVATED - SCRAPE AND CLEAN ALL EXPOSED METAL - PREPARE ALL OTHER SOFFIT SURFACES TO RECEIVE A NEW FINISH PER MANUF. REQUIREMENTS - APPLY HIGH-PERFORMANCE COATING - COLOR TO MATCH NEW EDGE METAL

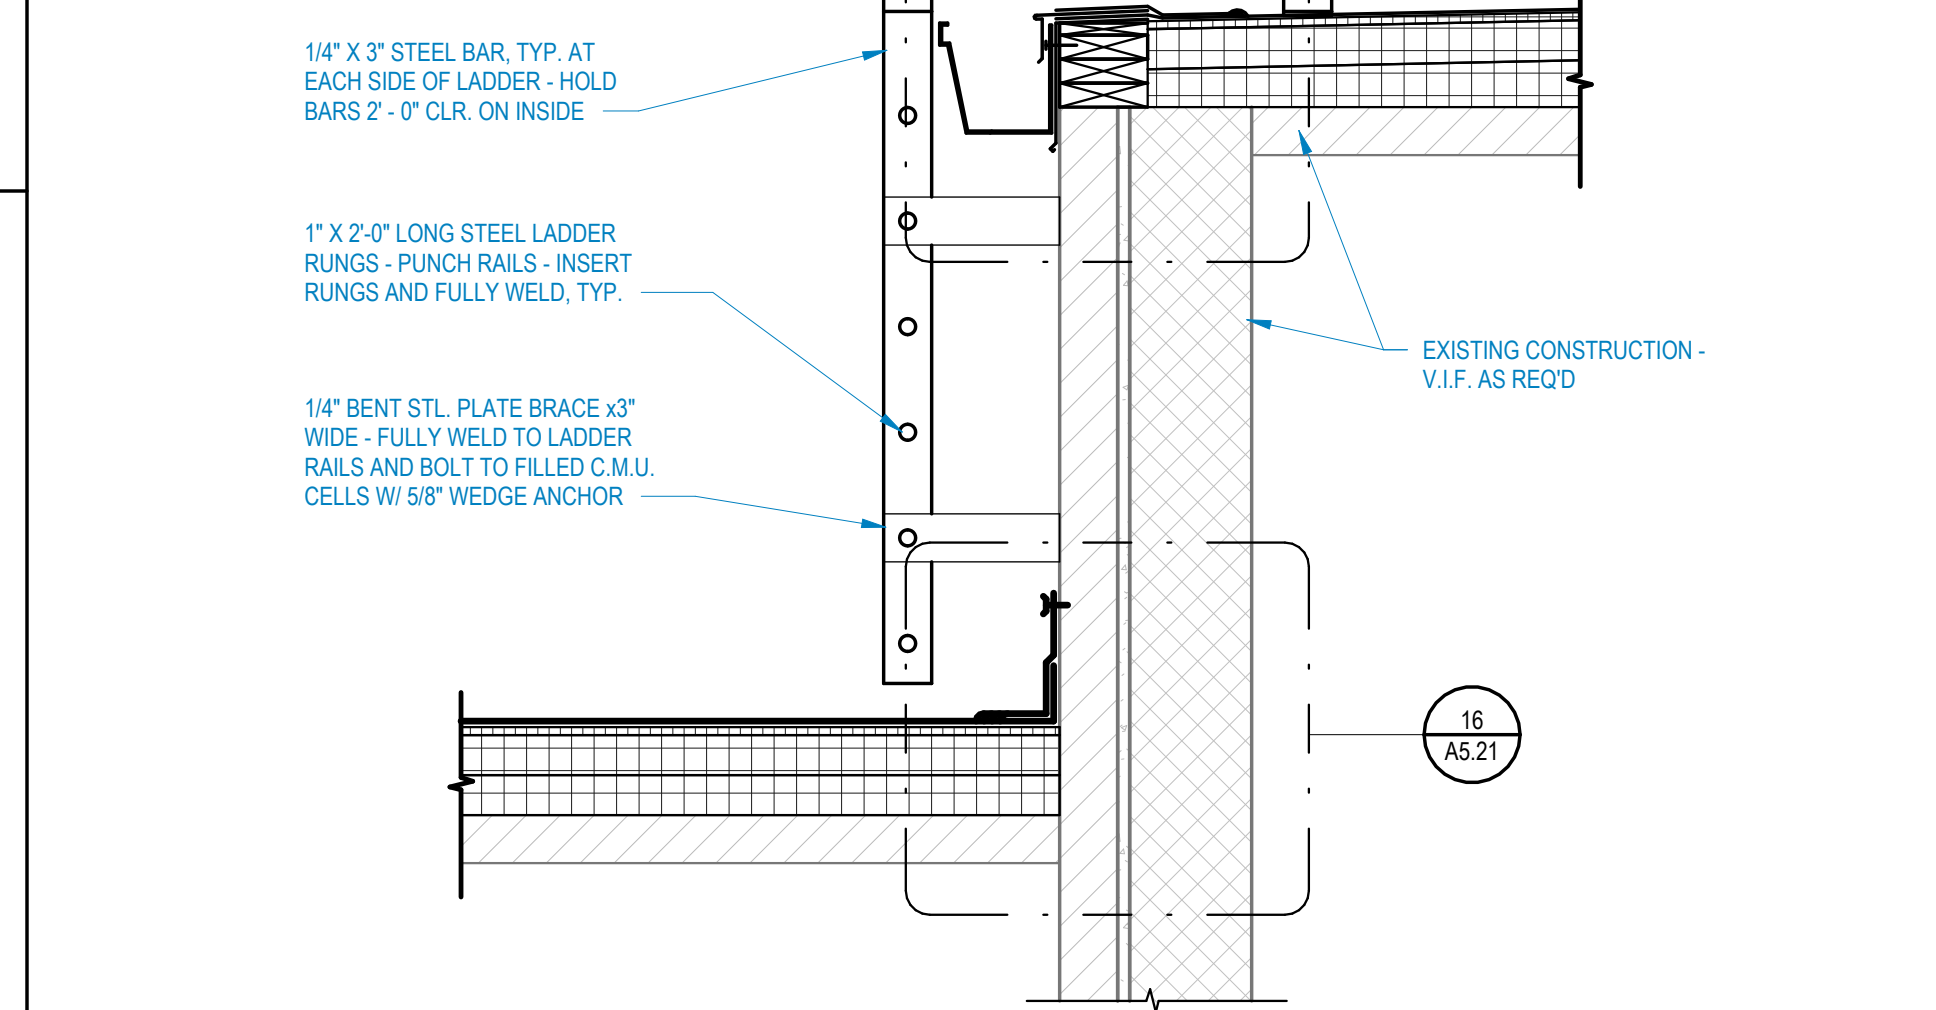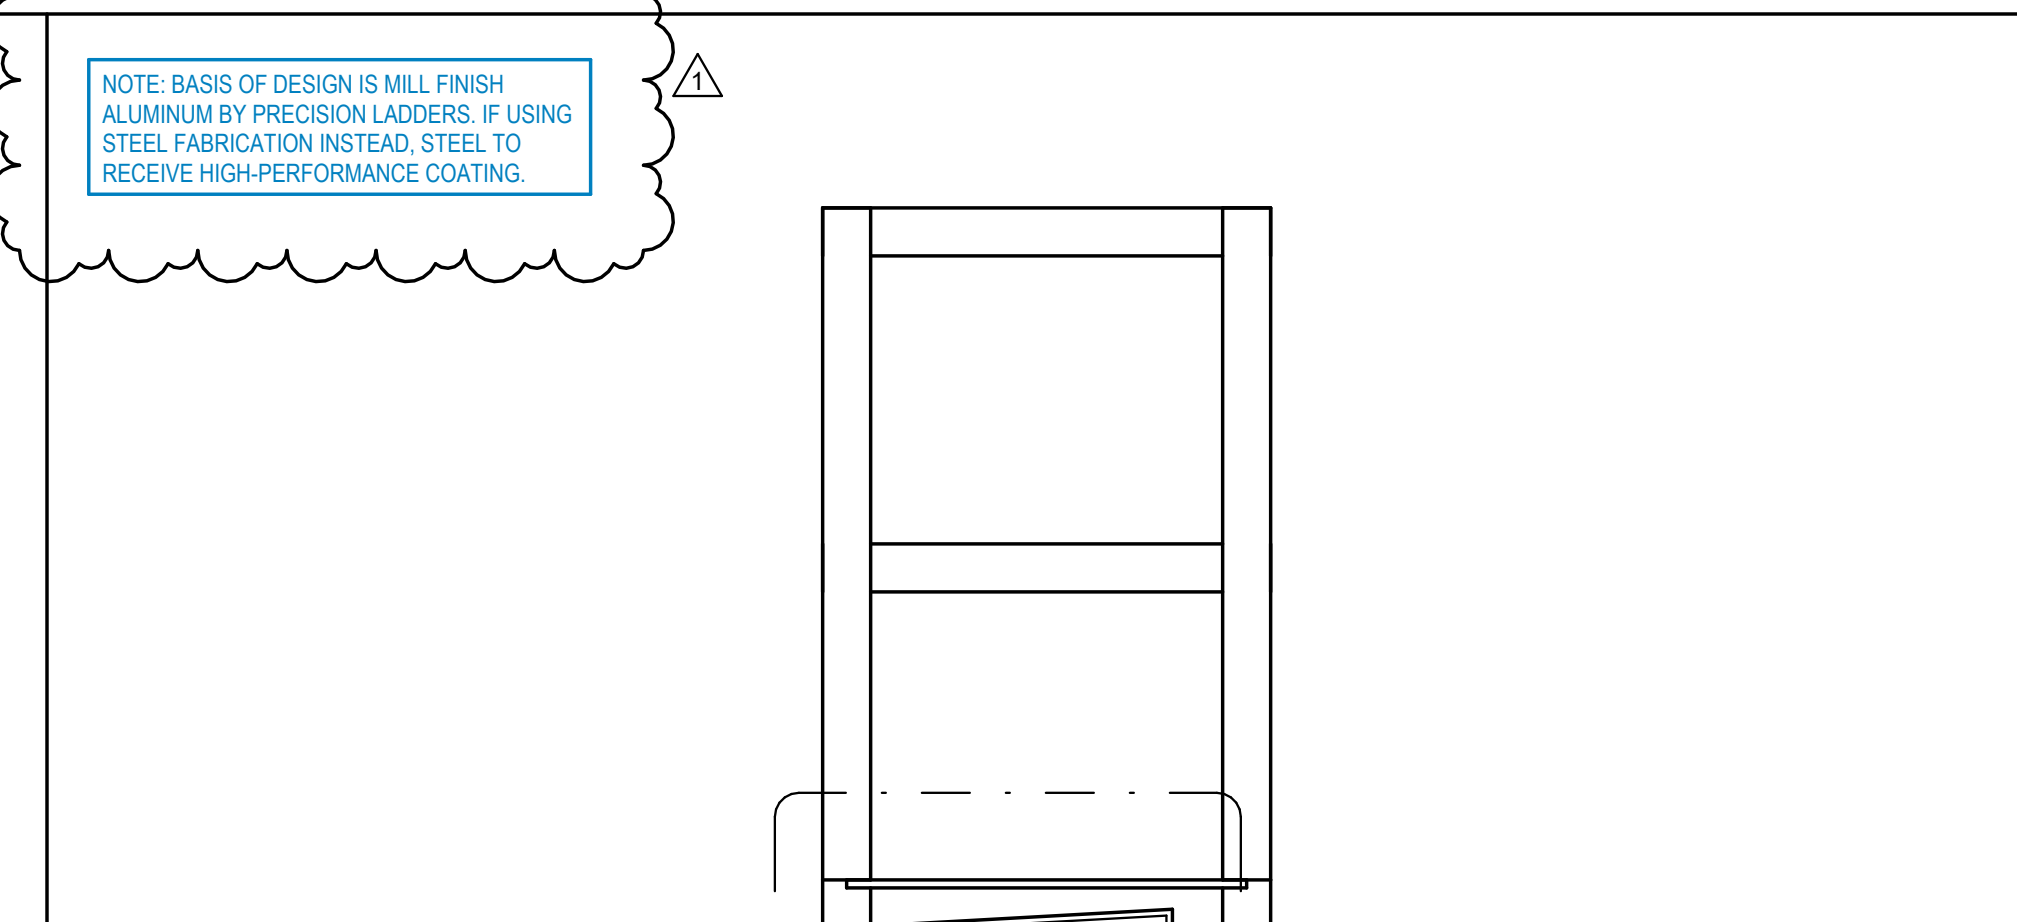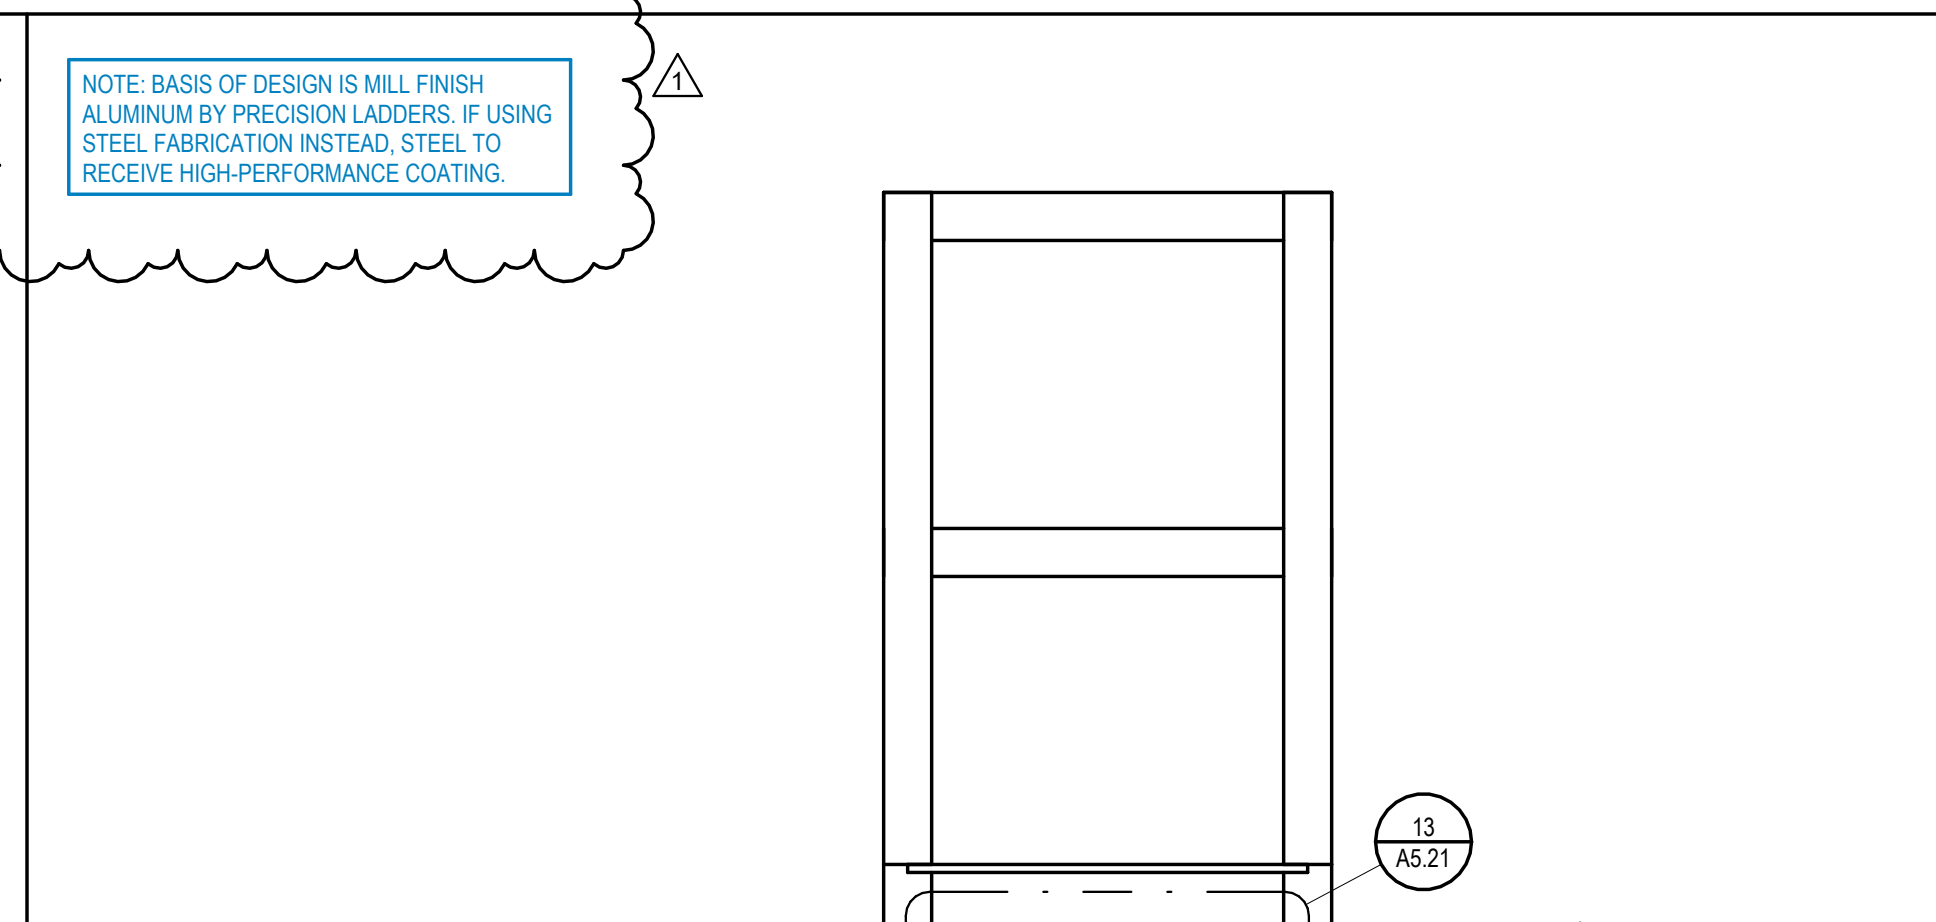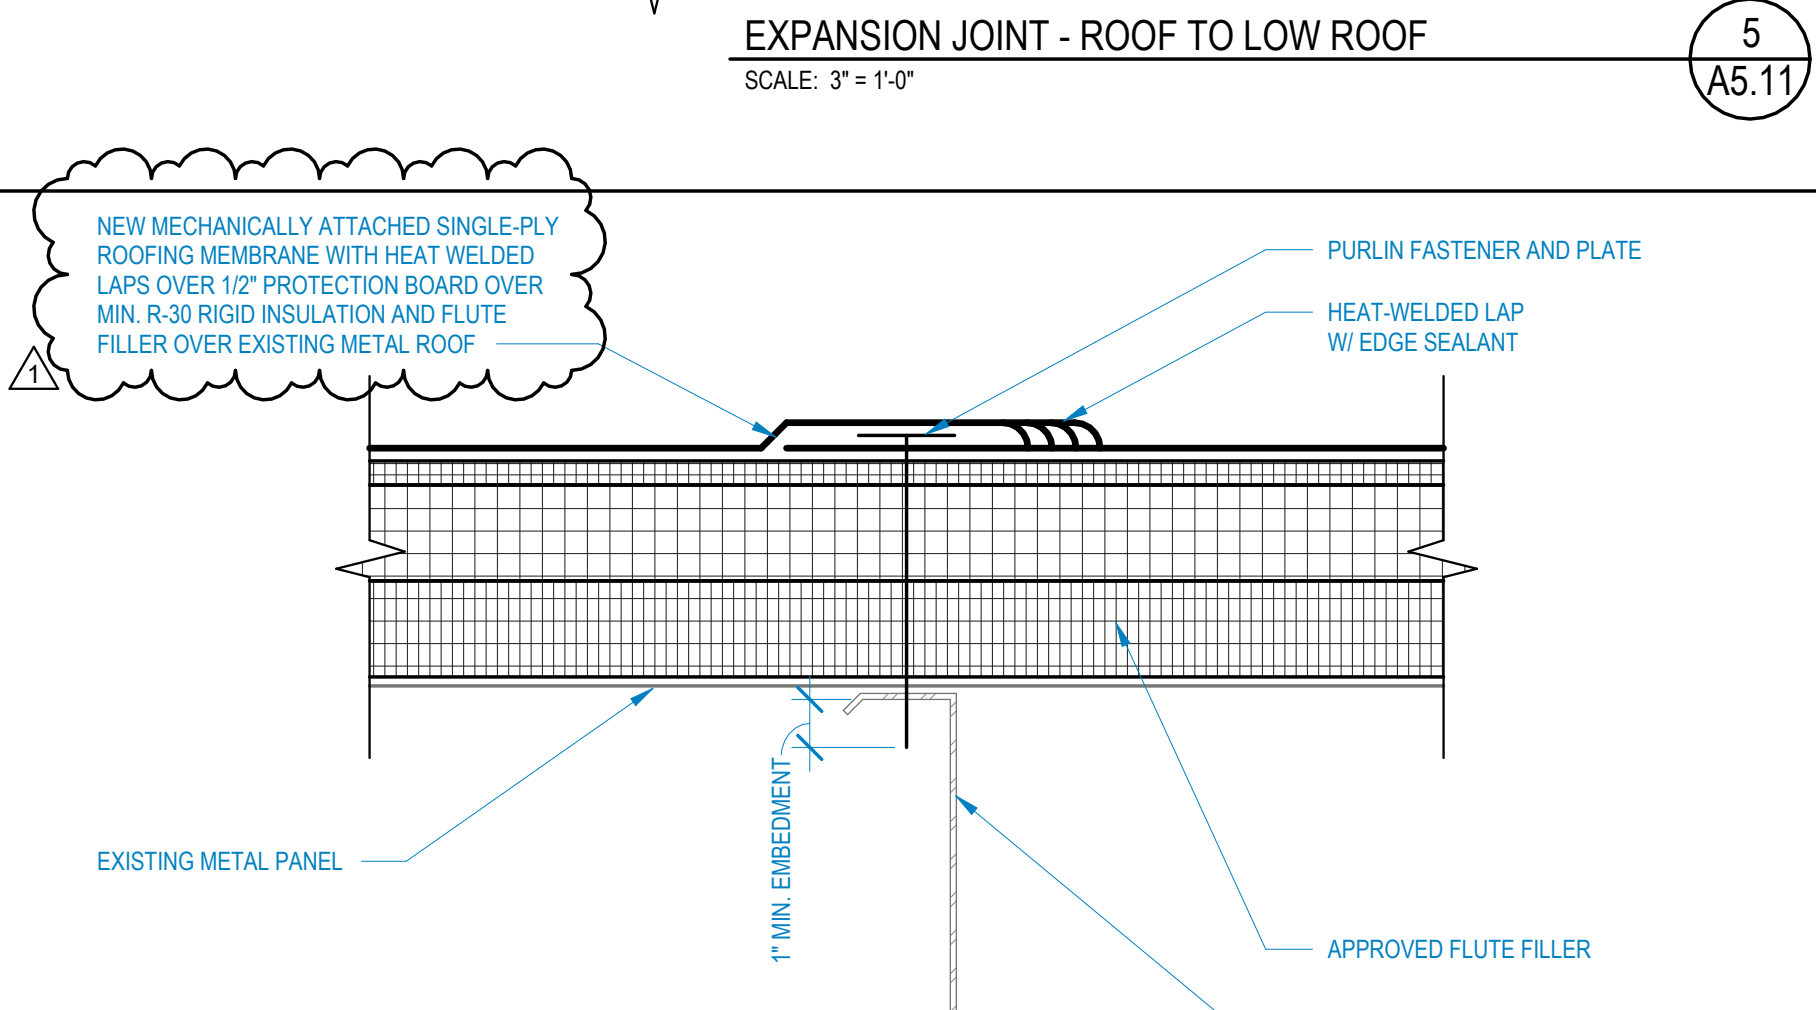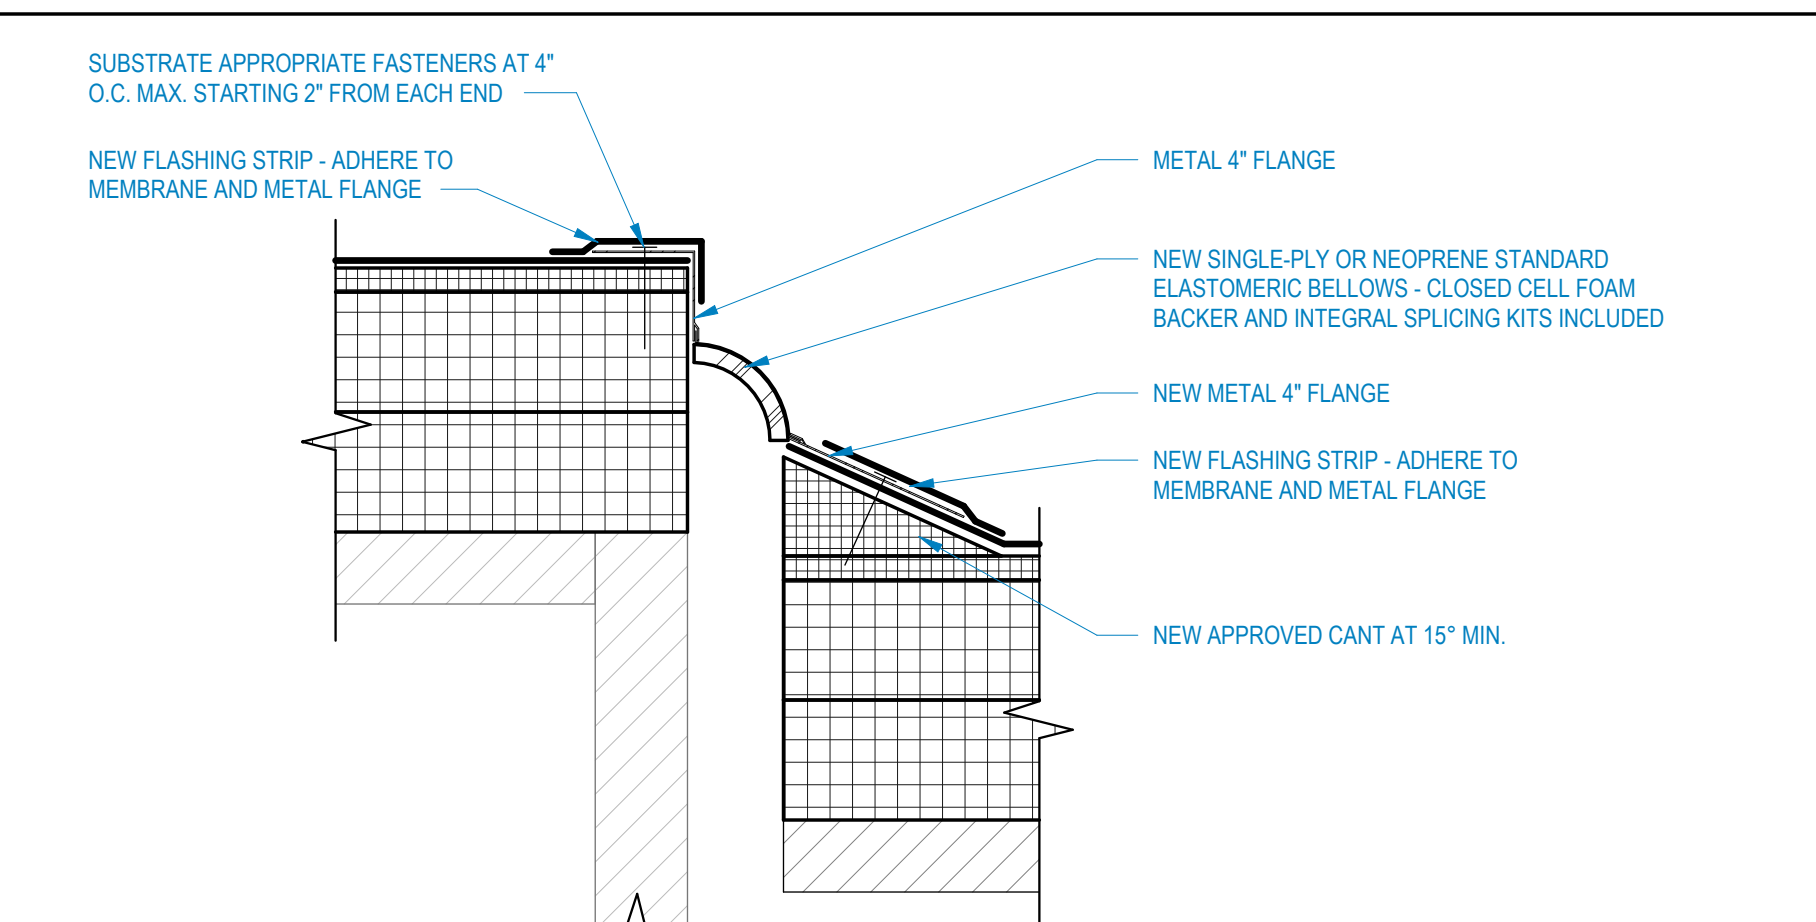


**ROOF PLAN AND NOTES**  
 SCALE: 1/16" = 1'-0"  
 1 A5.11

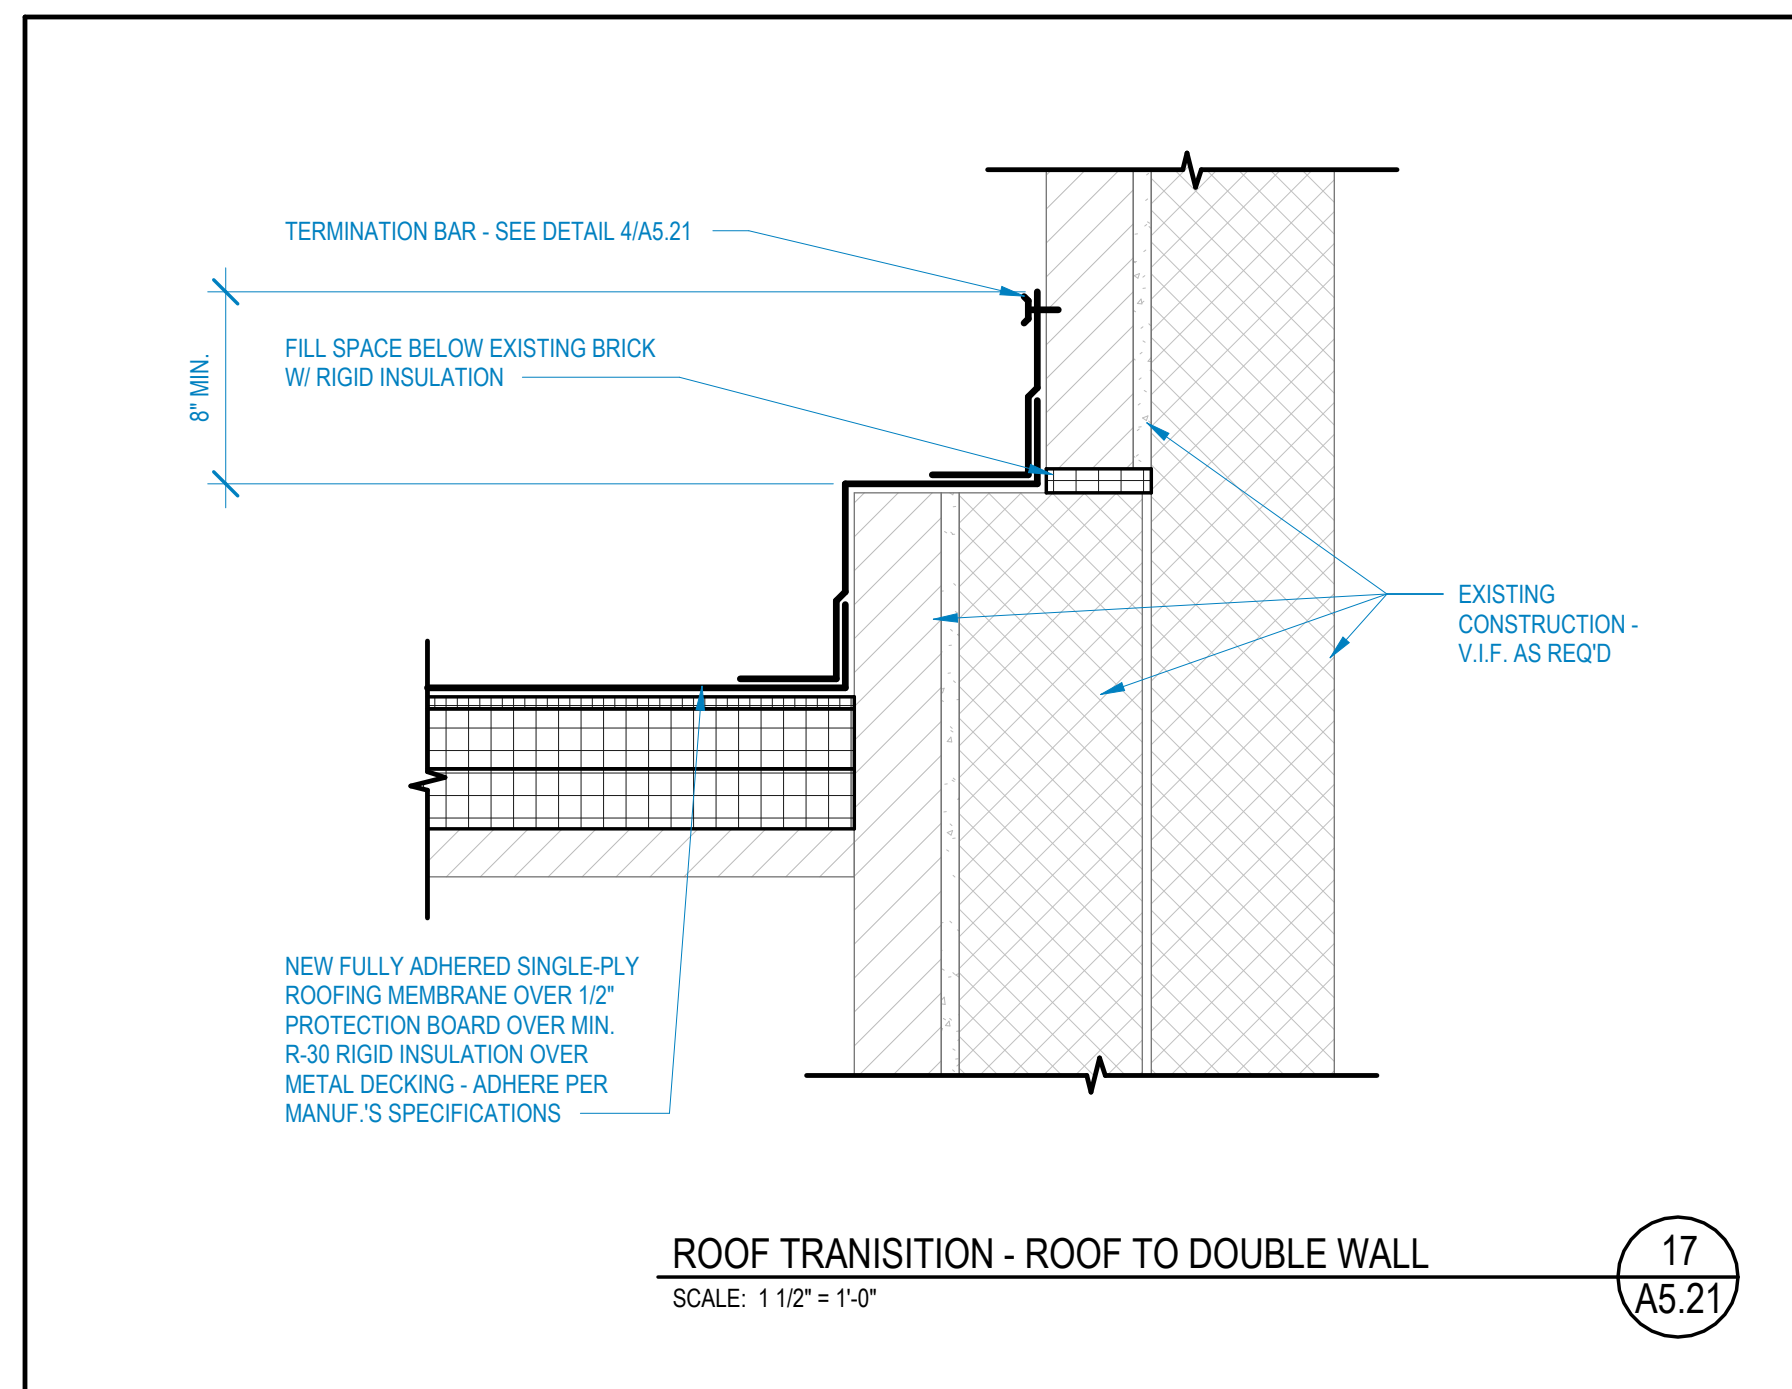


ROOF TRANSITION - ROOF TO DOUBLE WALL  
SCALE: 1 1/2" = 1'-0" (17) A5.21

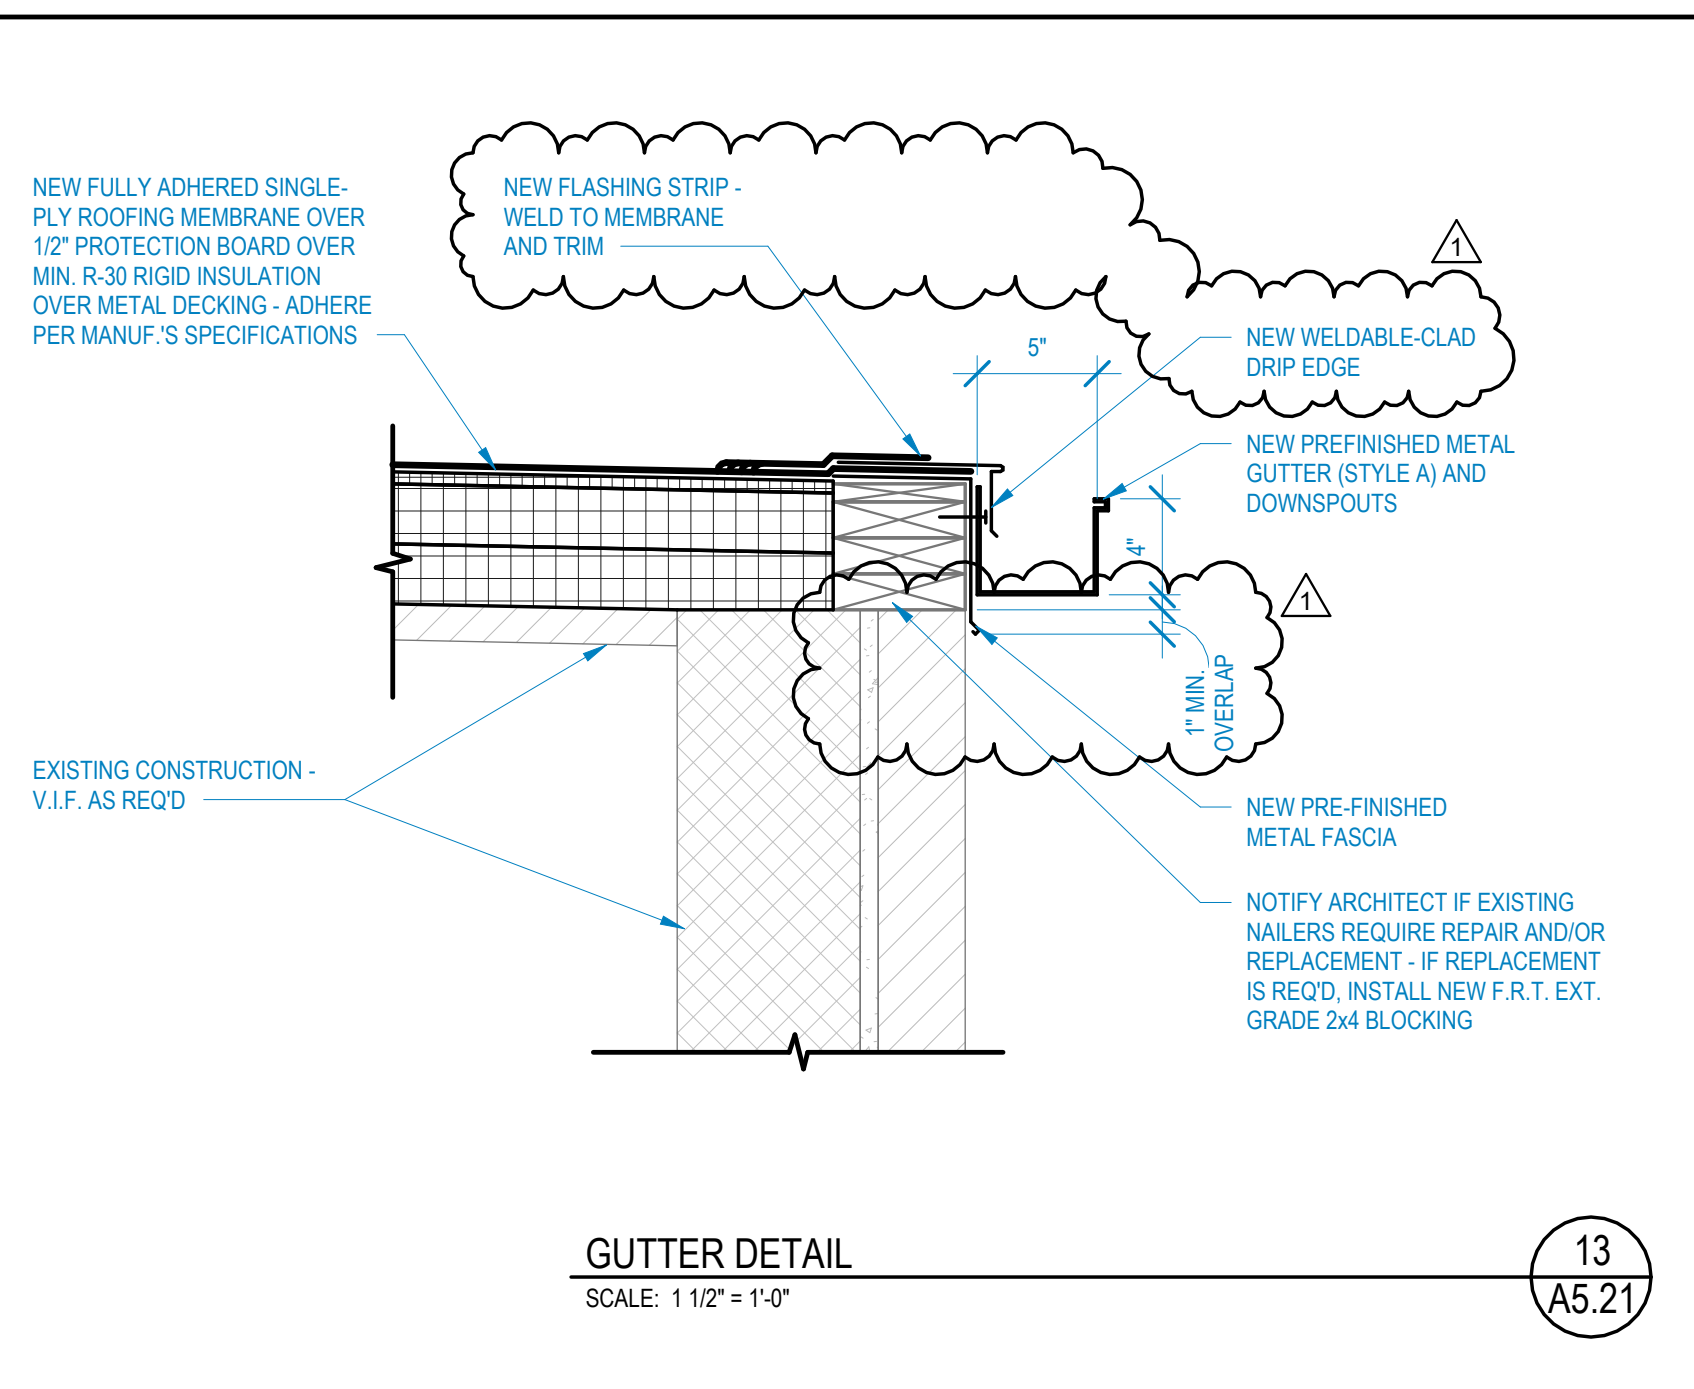


GUTTER DETAIL  
SCALE: 1 1/2" = 1'-0" (13) A5.21

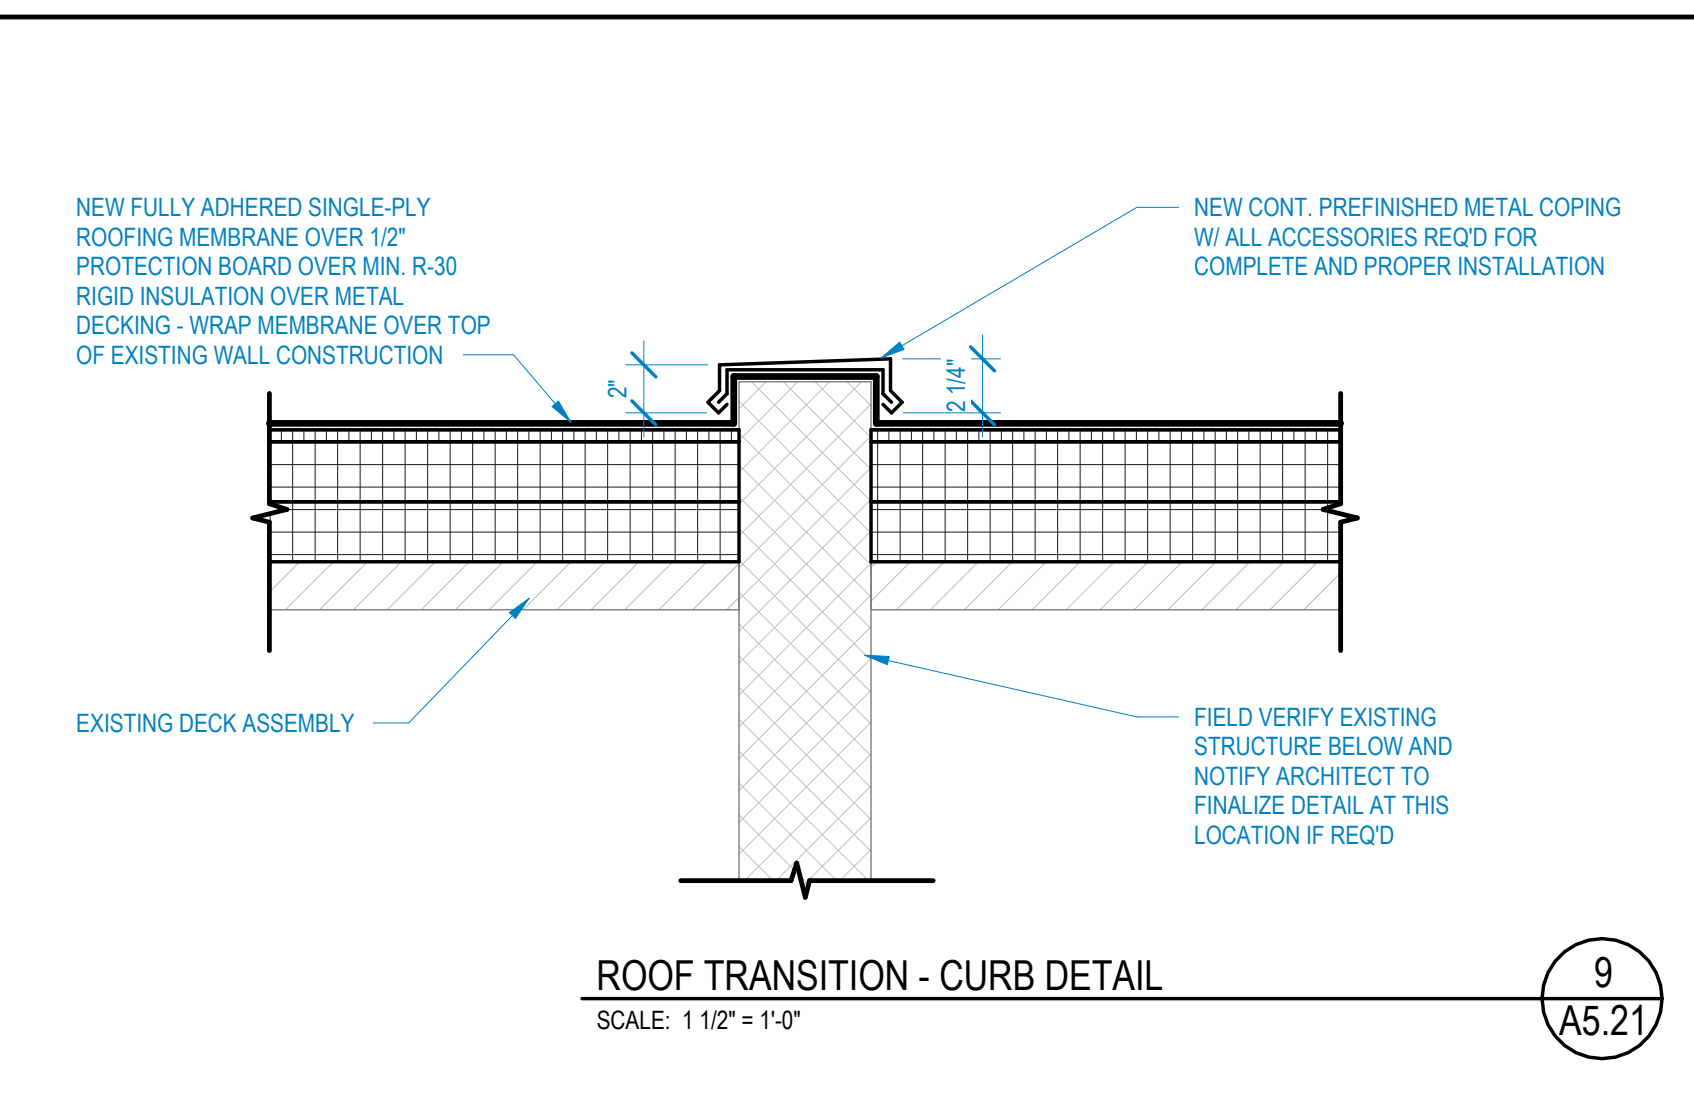


ROOF TRANSITION - CURB DETAIL  
SCALE: 1 1/2" = 1'-0" (9) A5.21

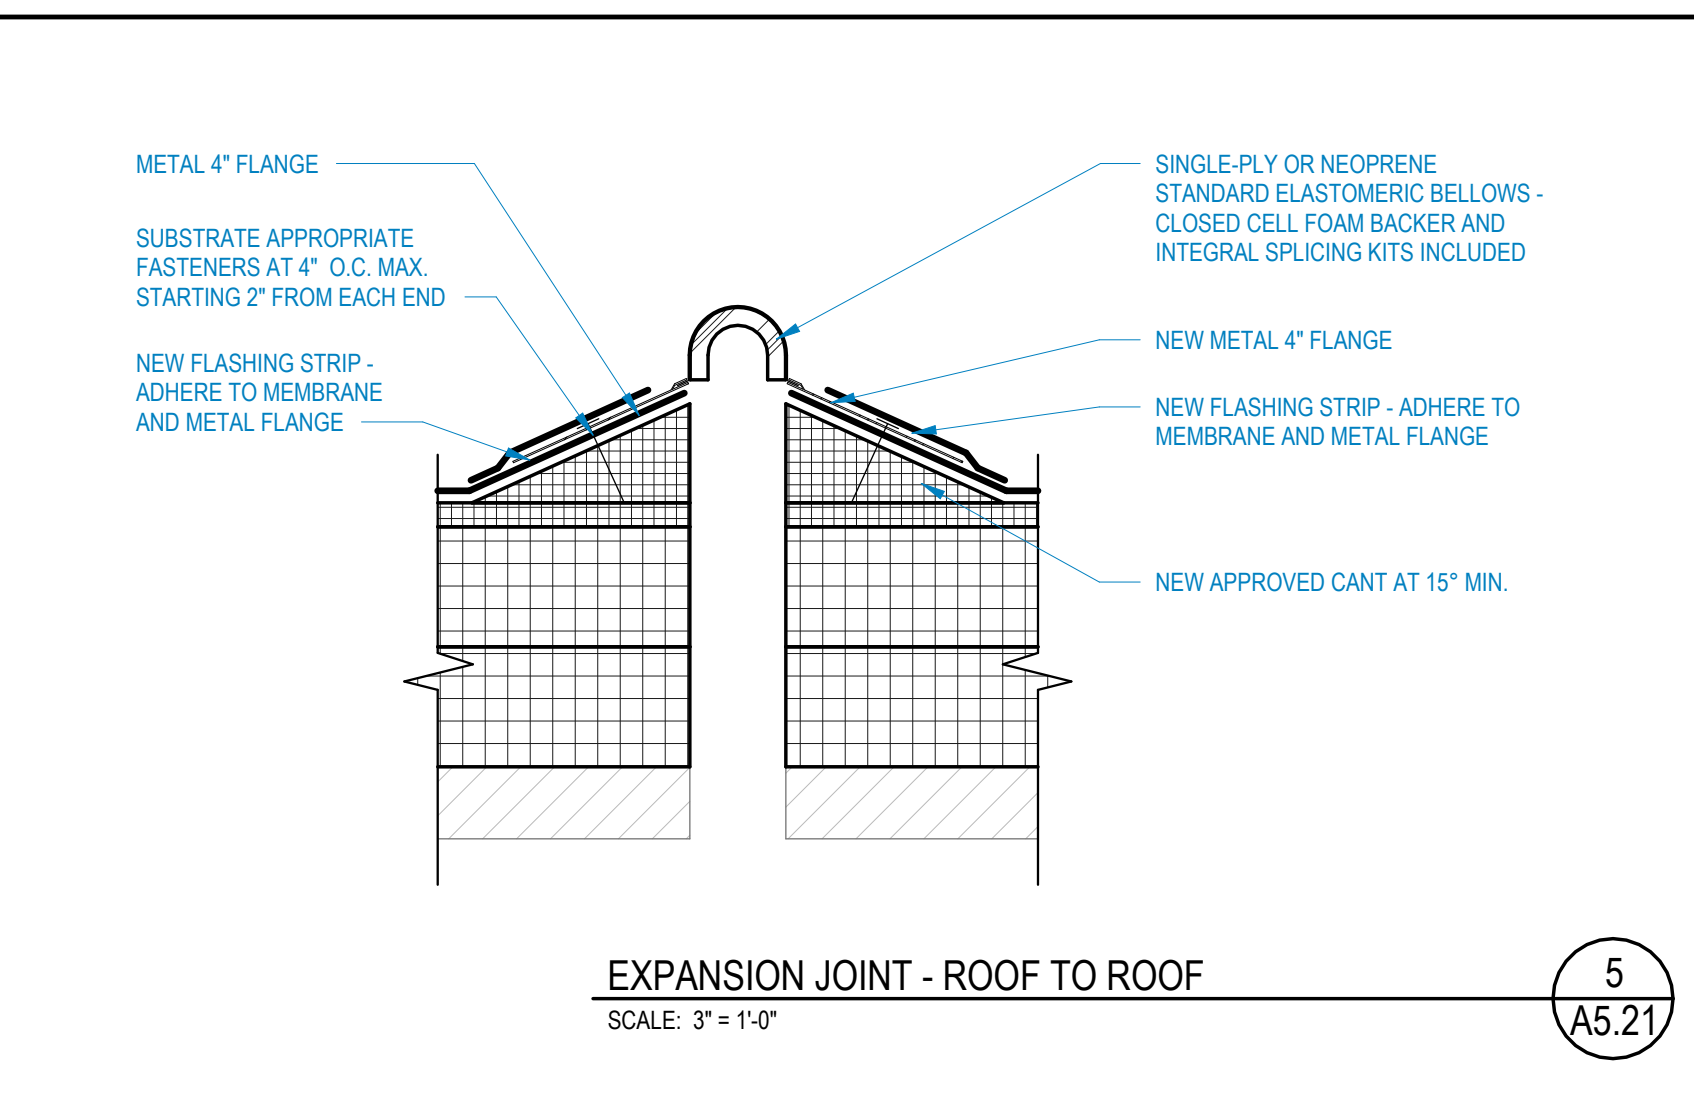


EXPANSION JOINT - ROOF TO ROOF  
SCALE: 3\"/>

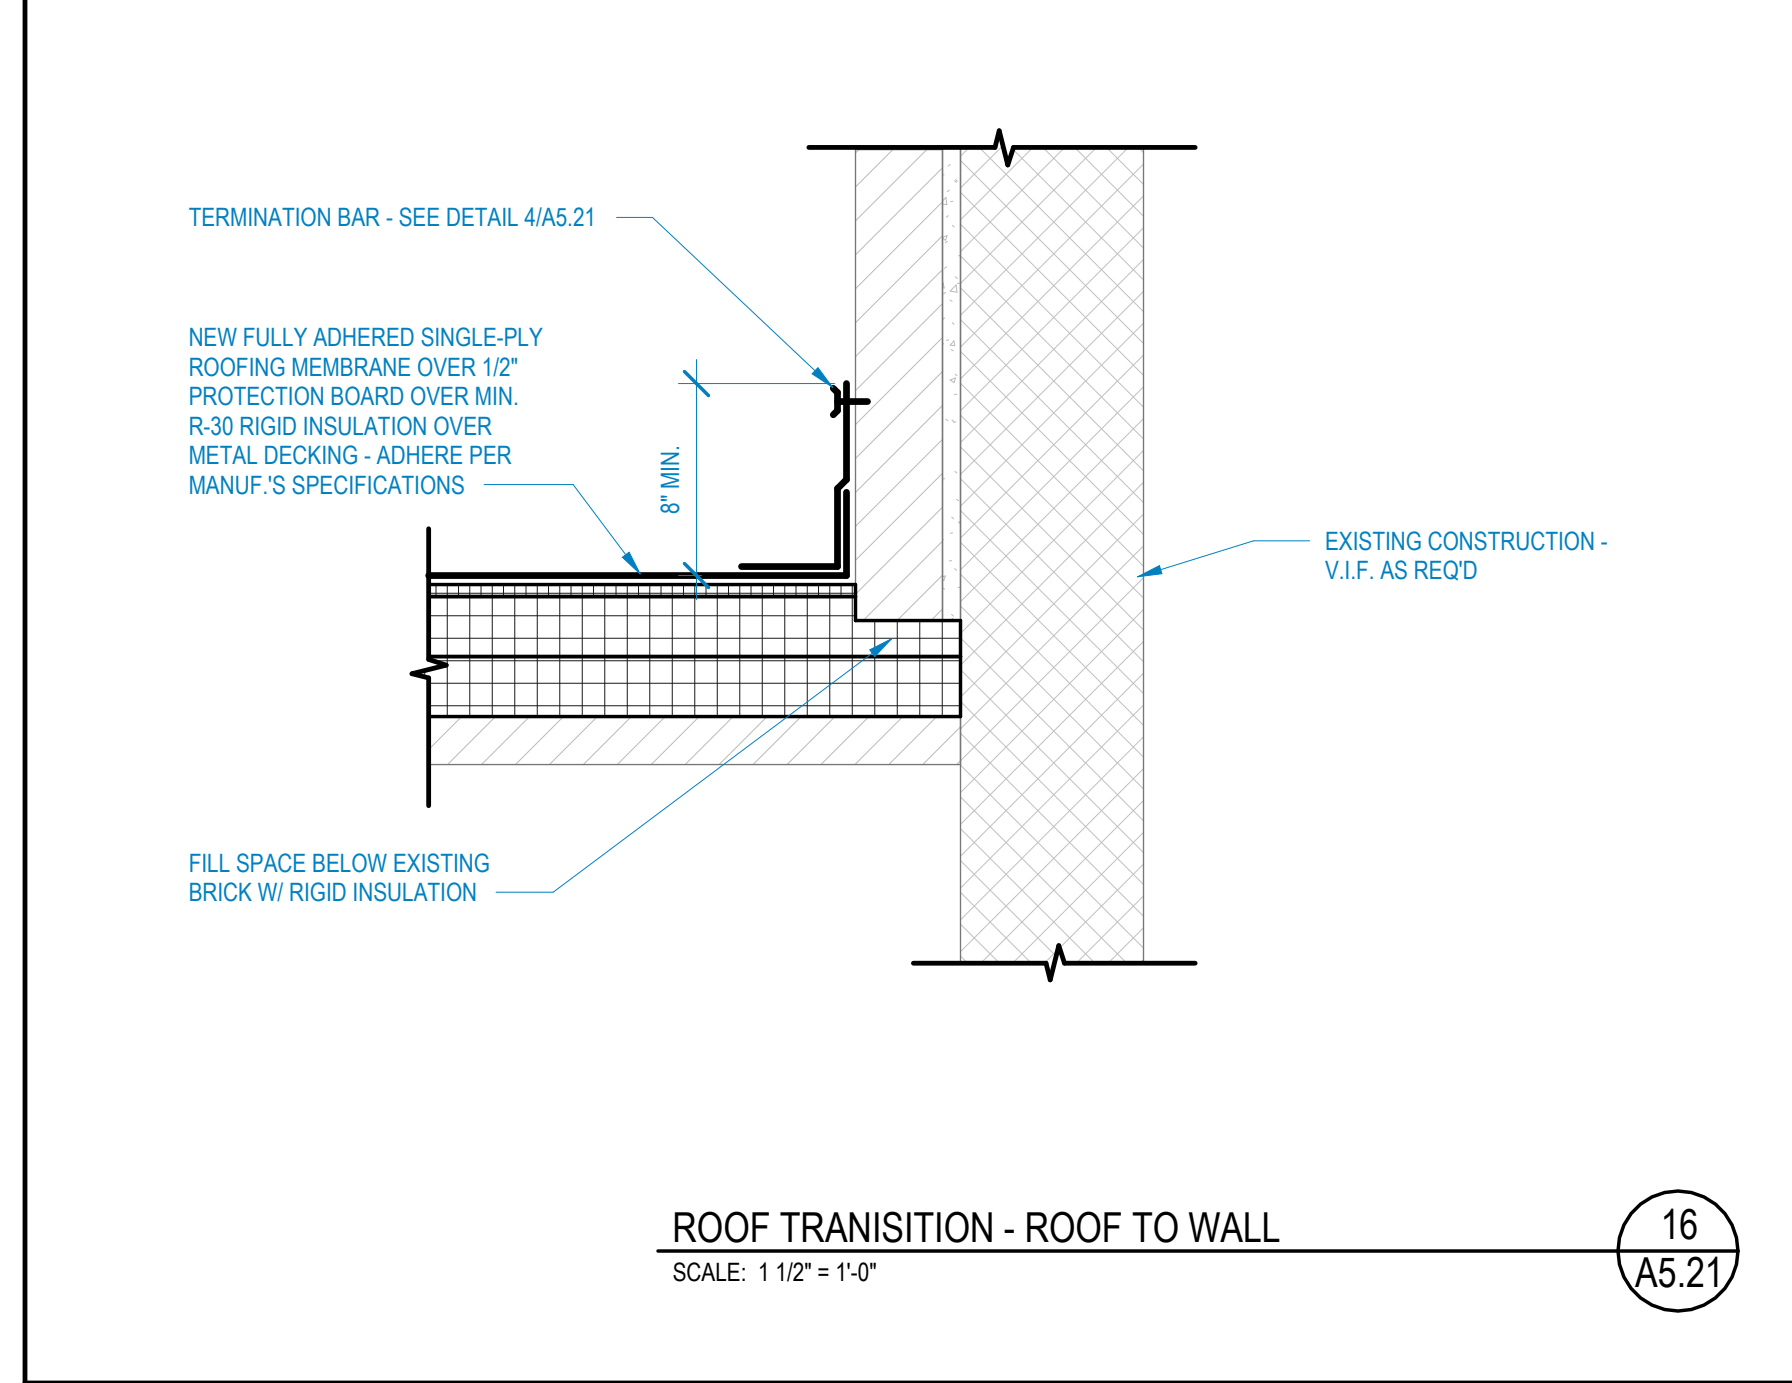


ROOF TRANSITION - ROOF TO WALL  
SCALE: 1 1/2" = 1'-0" (16) A5.21

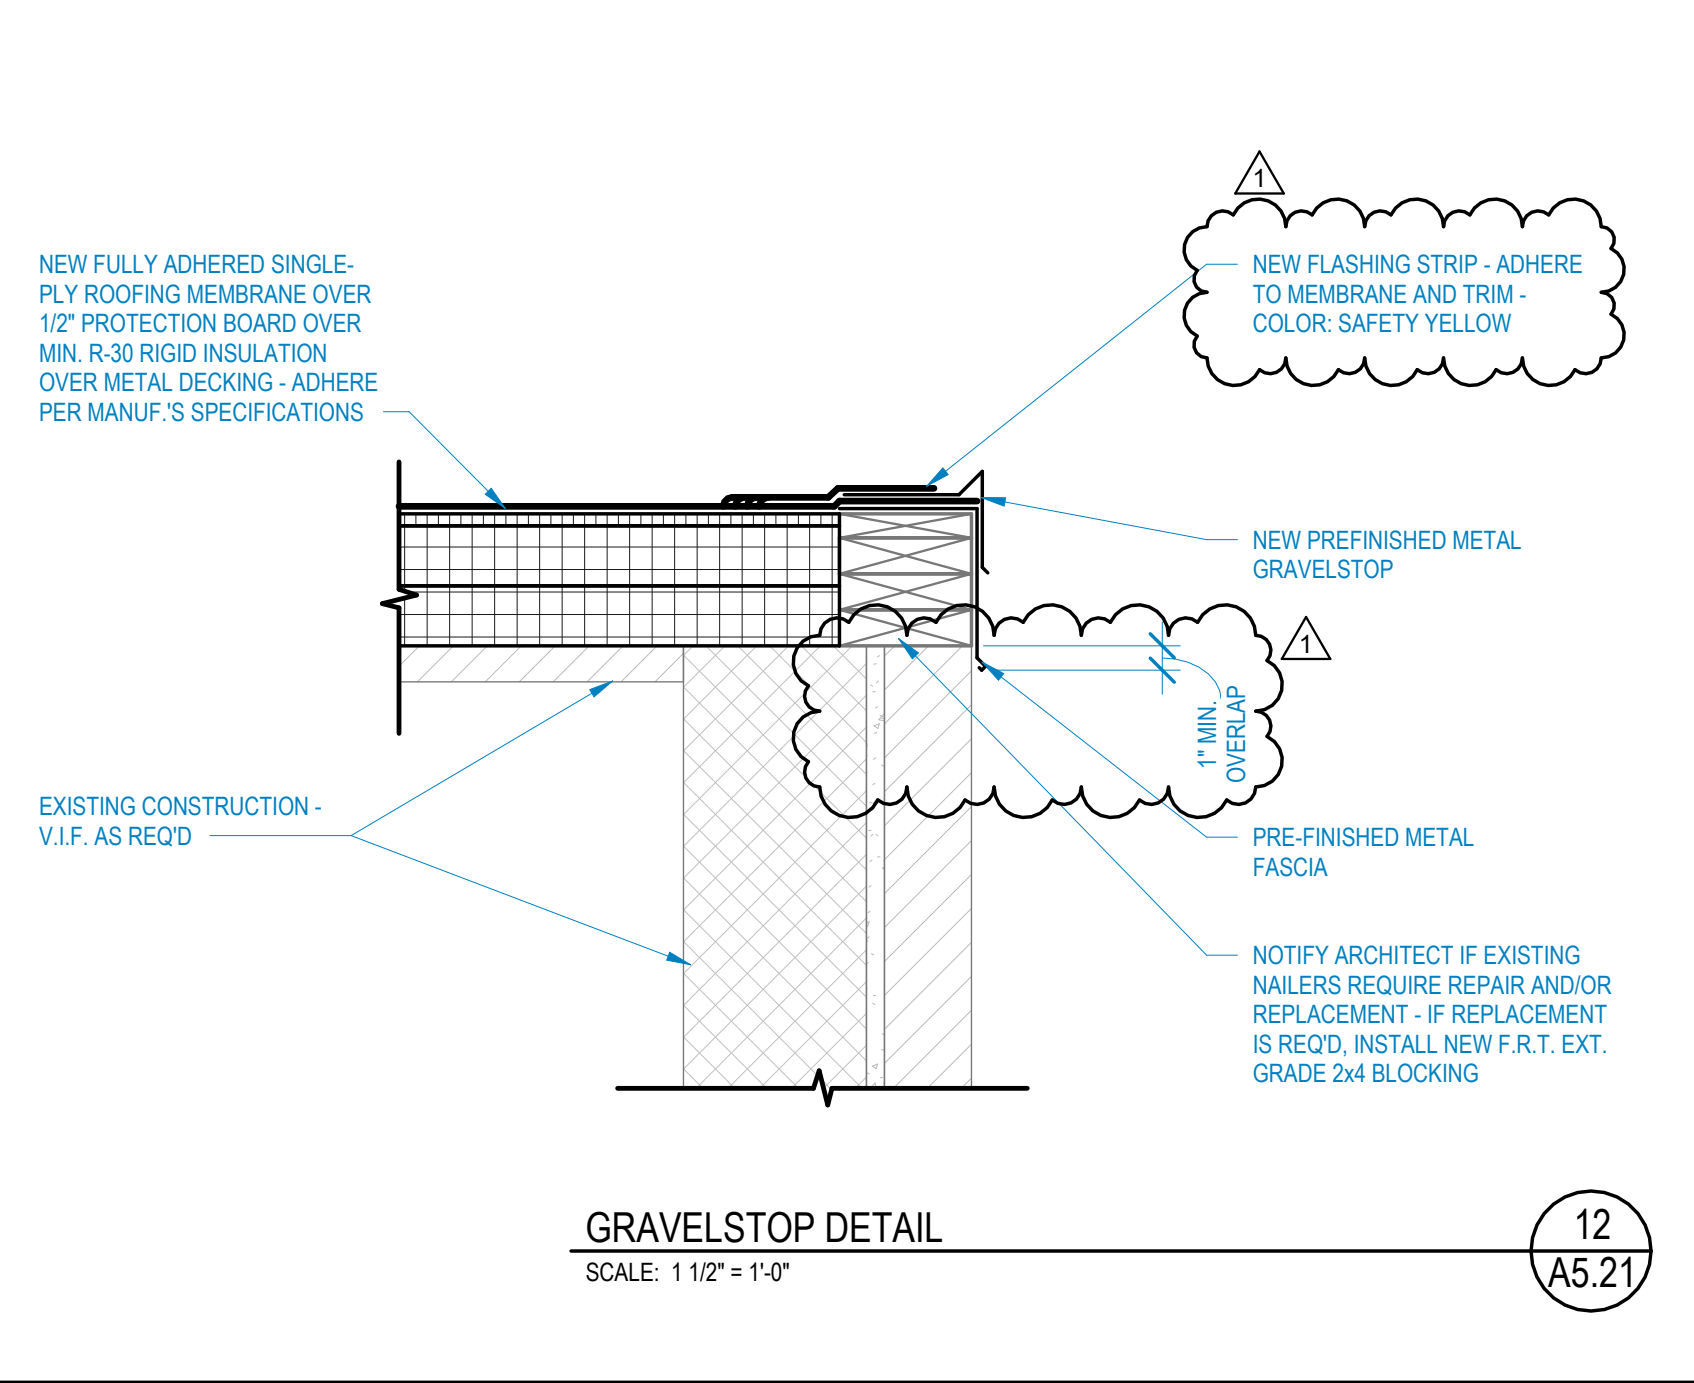


GRAVELSTOP DETAIL  
SCALE: 1 1/2" = 1'-0" (12) A5.21

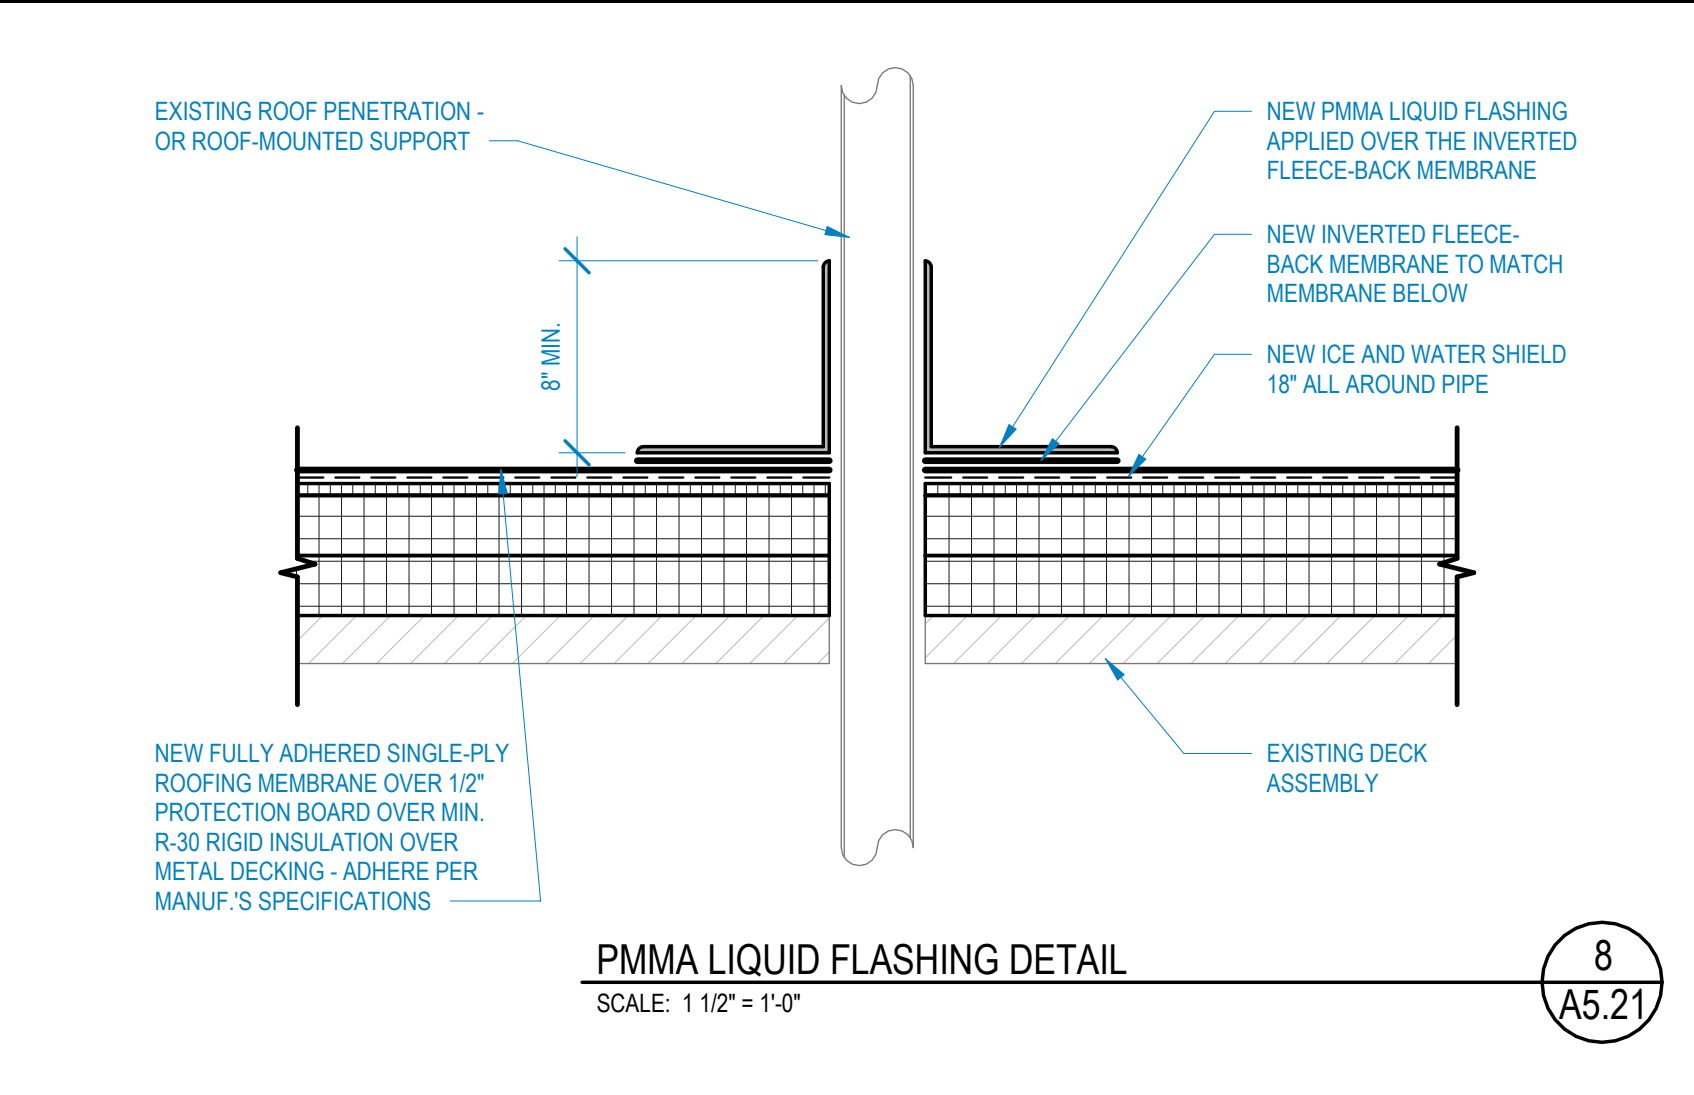


PMMA LIQUID FLASHING DETAIL  
SCALE: 1 1/2" = 1'-0" (8) A5.21

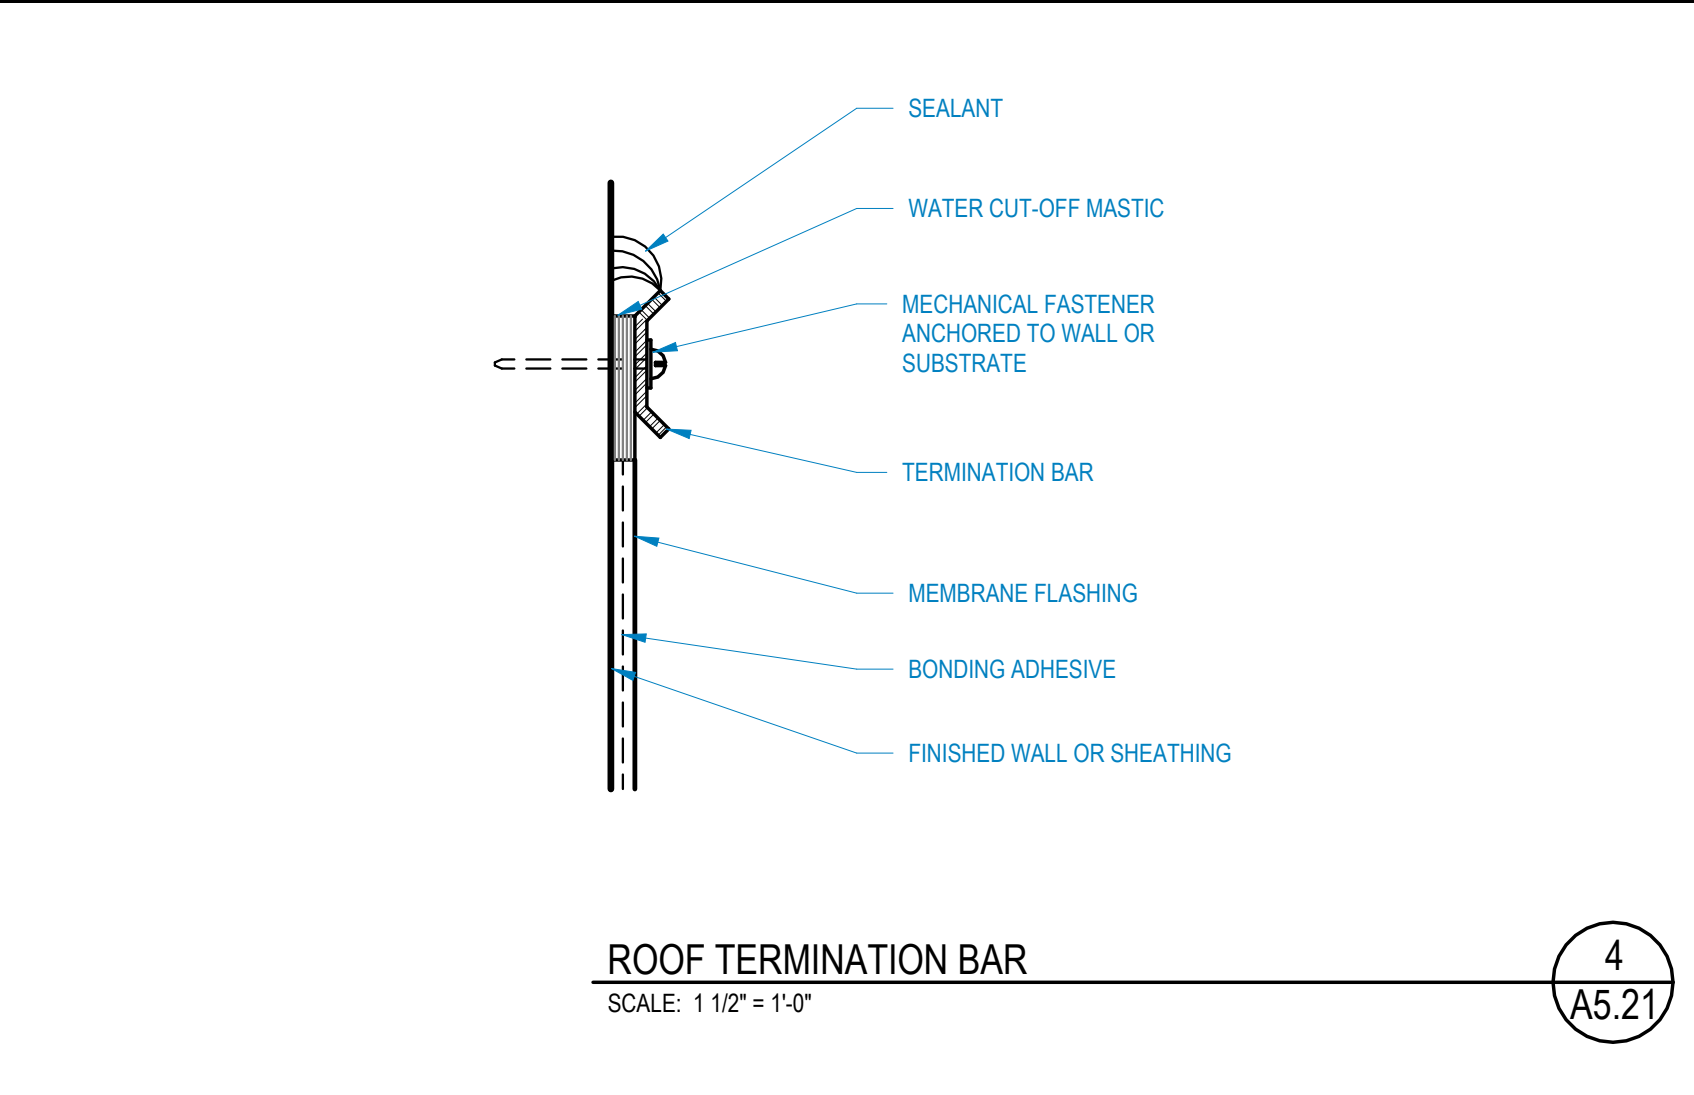


ROOF TERMINATION BAR  
SCALE: 1 1/2" = 1'-0" (4) A5.21

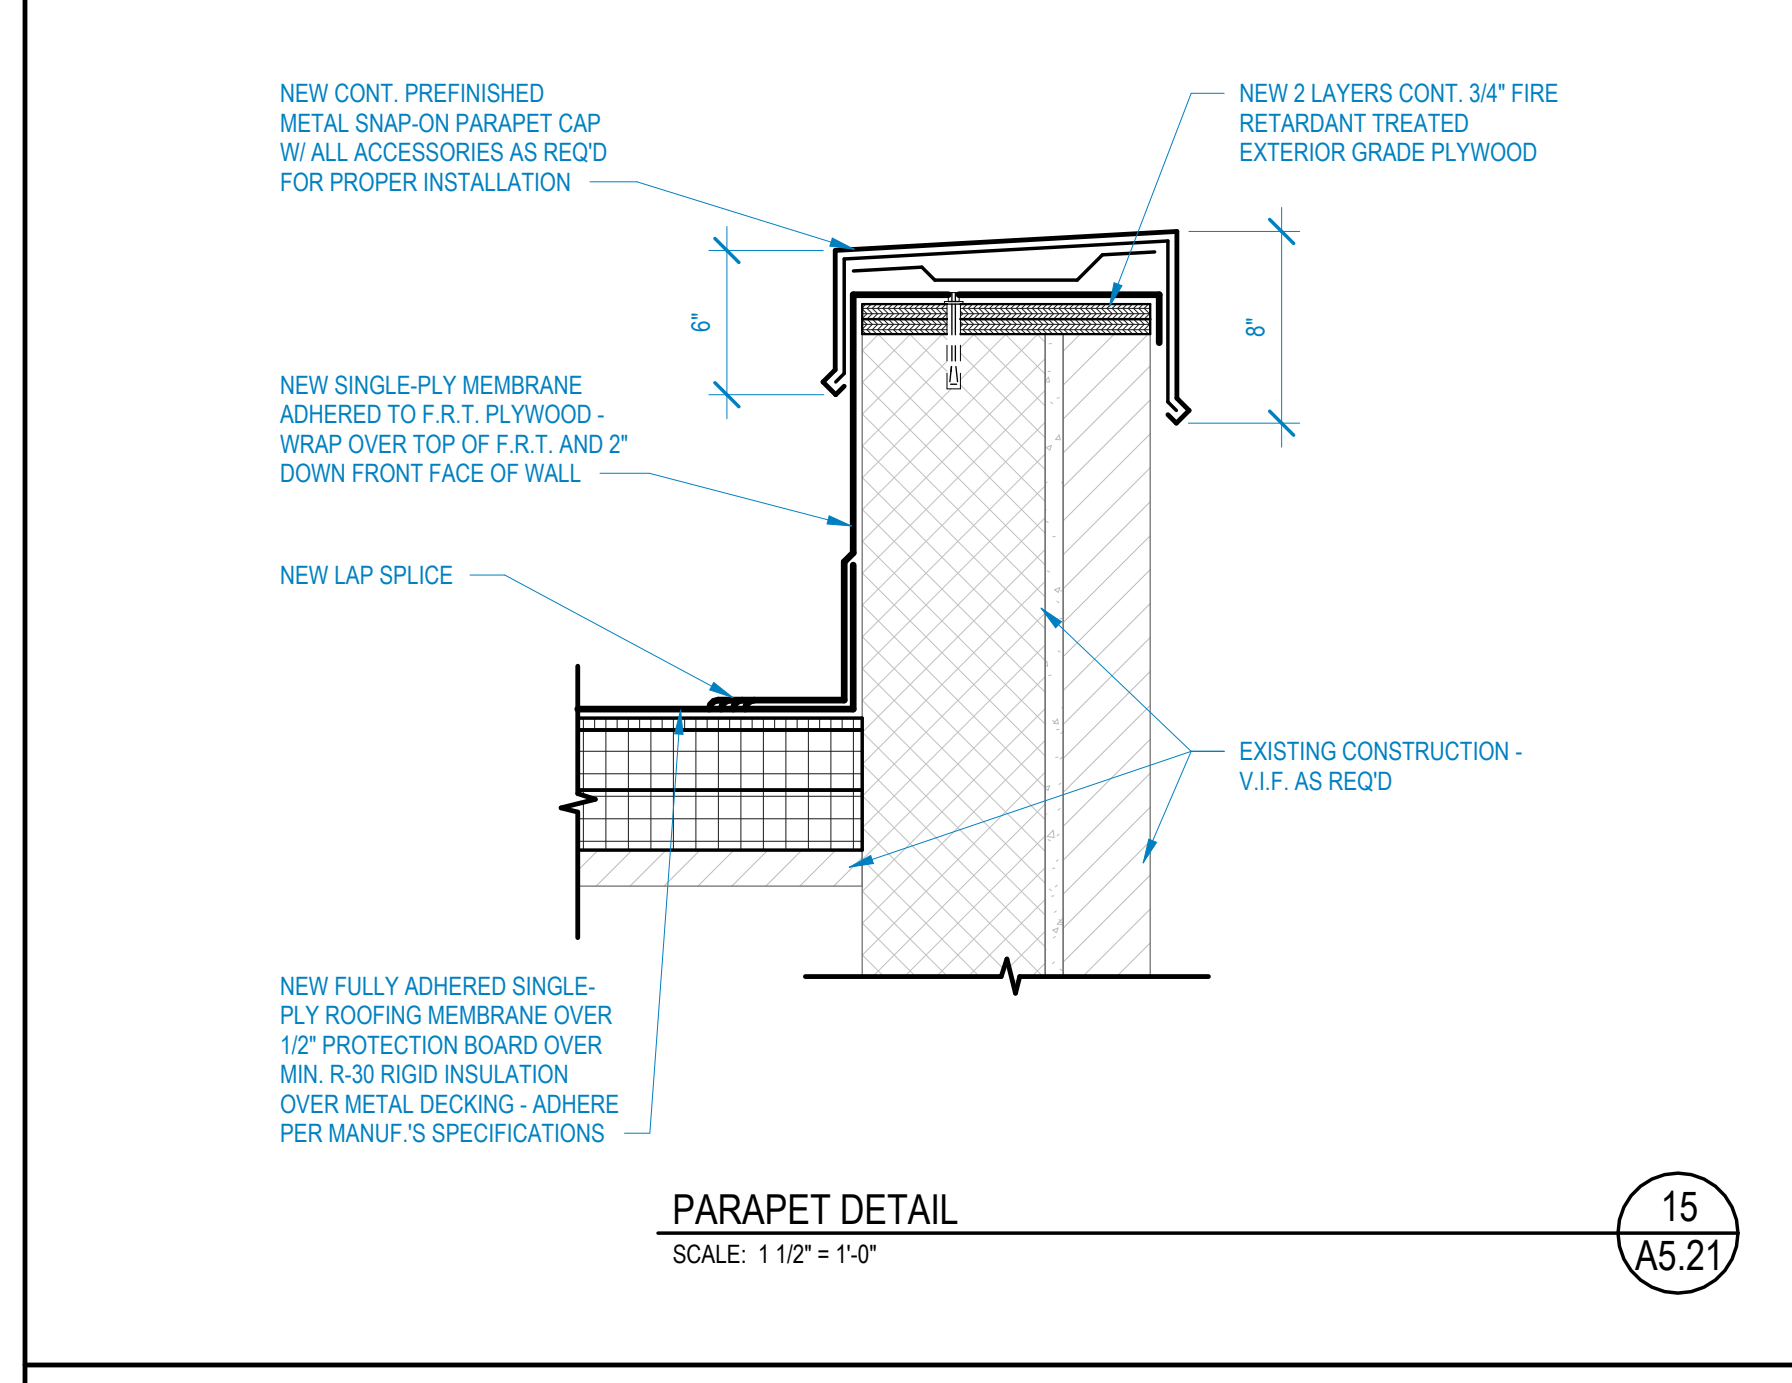


PARAPET DETAIL  
SCALE: 1 1/2" = 1'-0" (15) A5.21

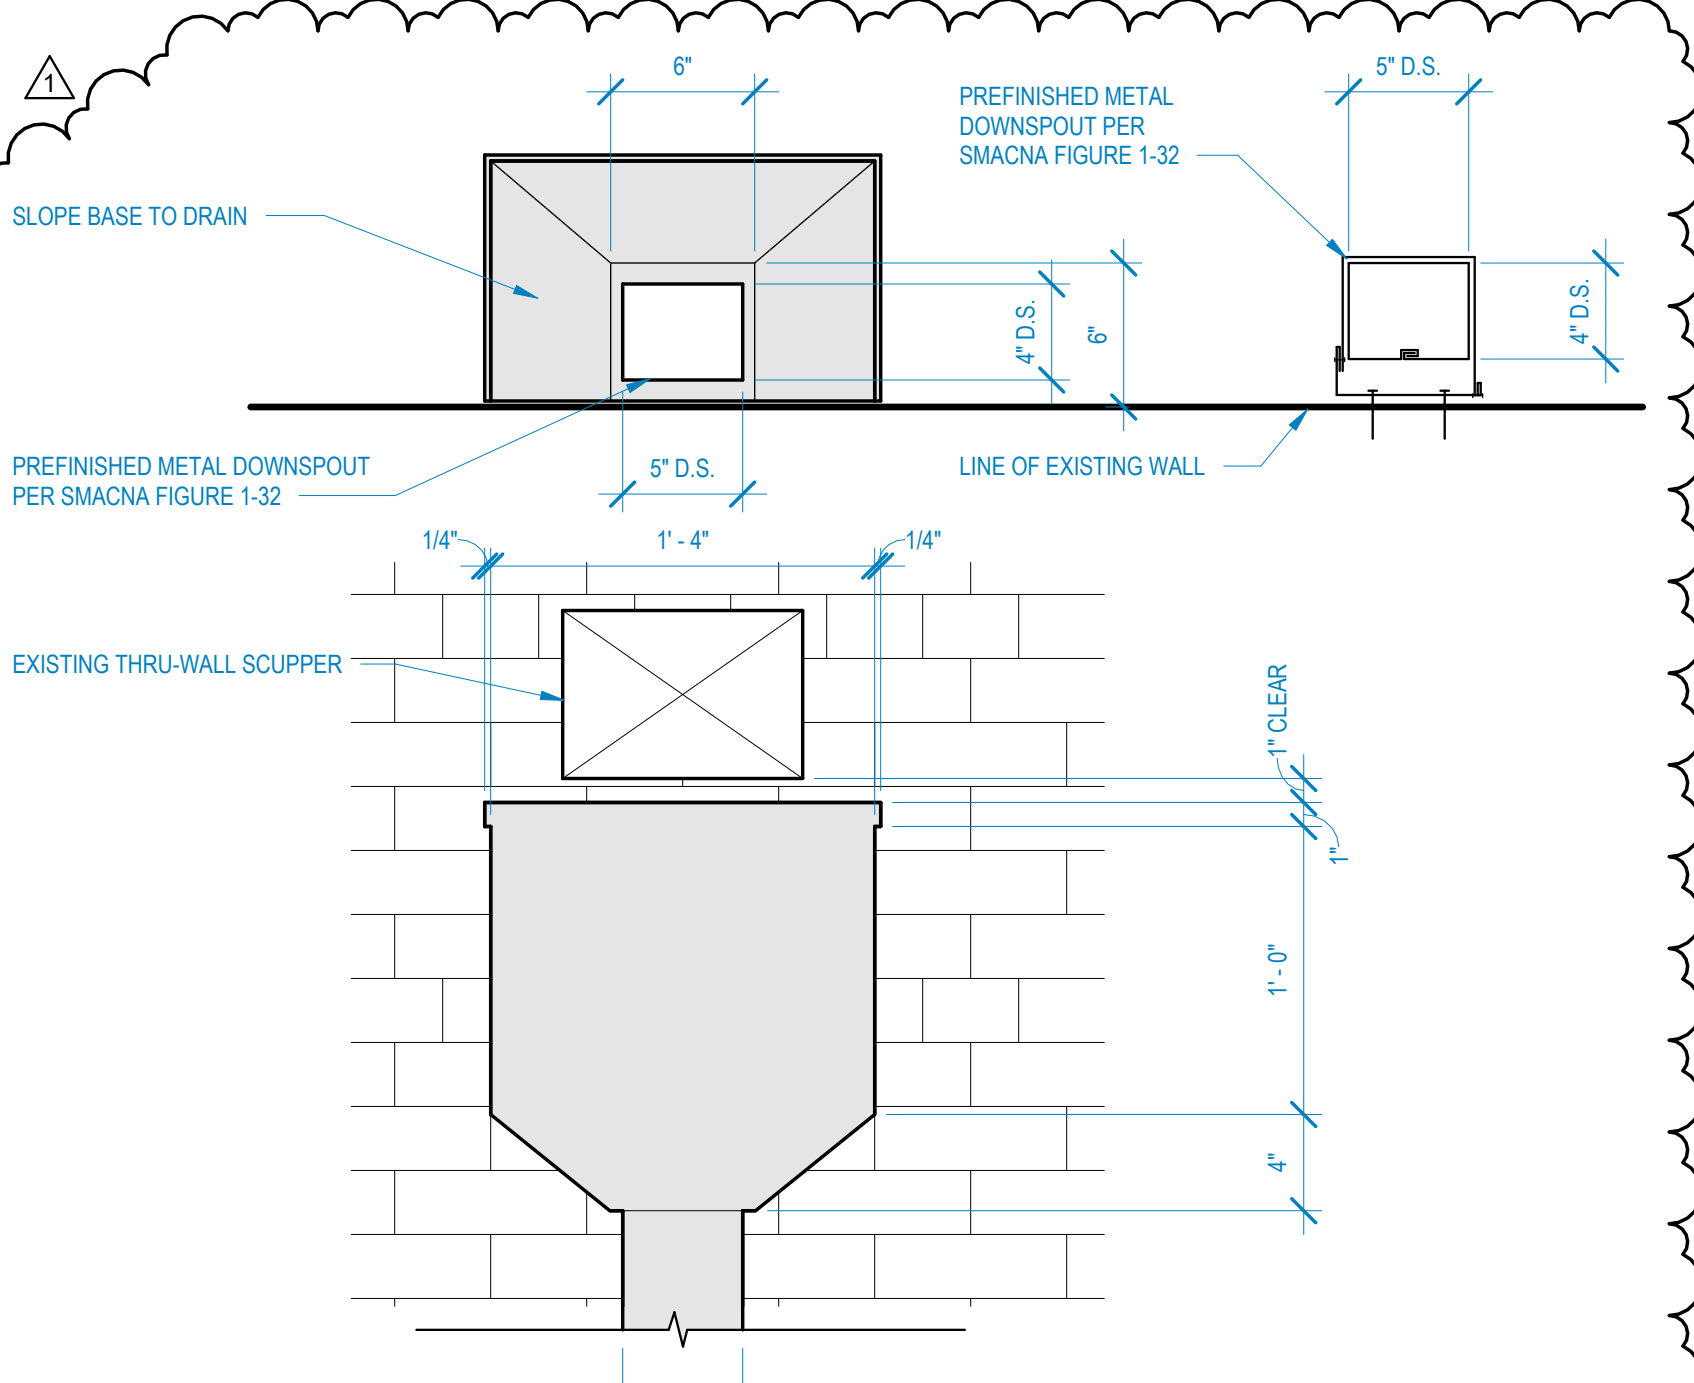


CONDUCTOR HEAD DETAIL  
SCALE: 1 1/2" = 1'-0" (11) A5.21

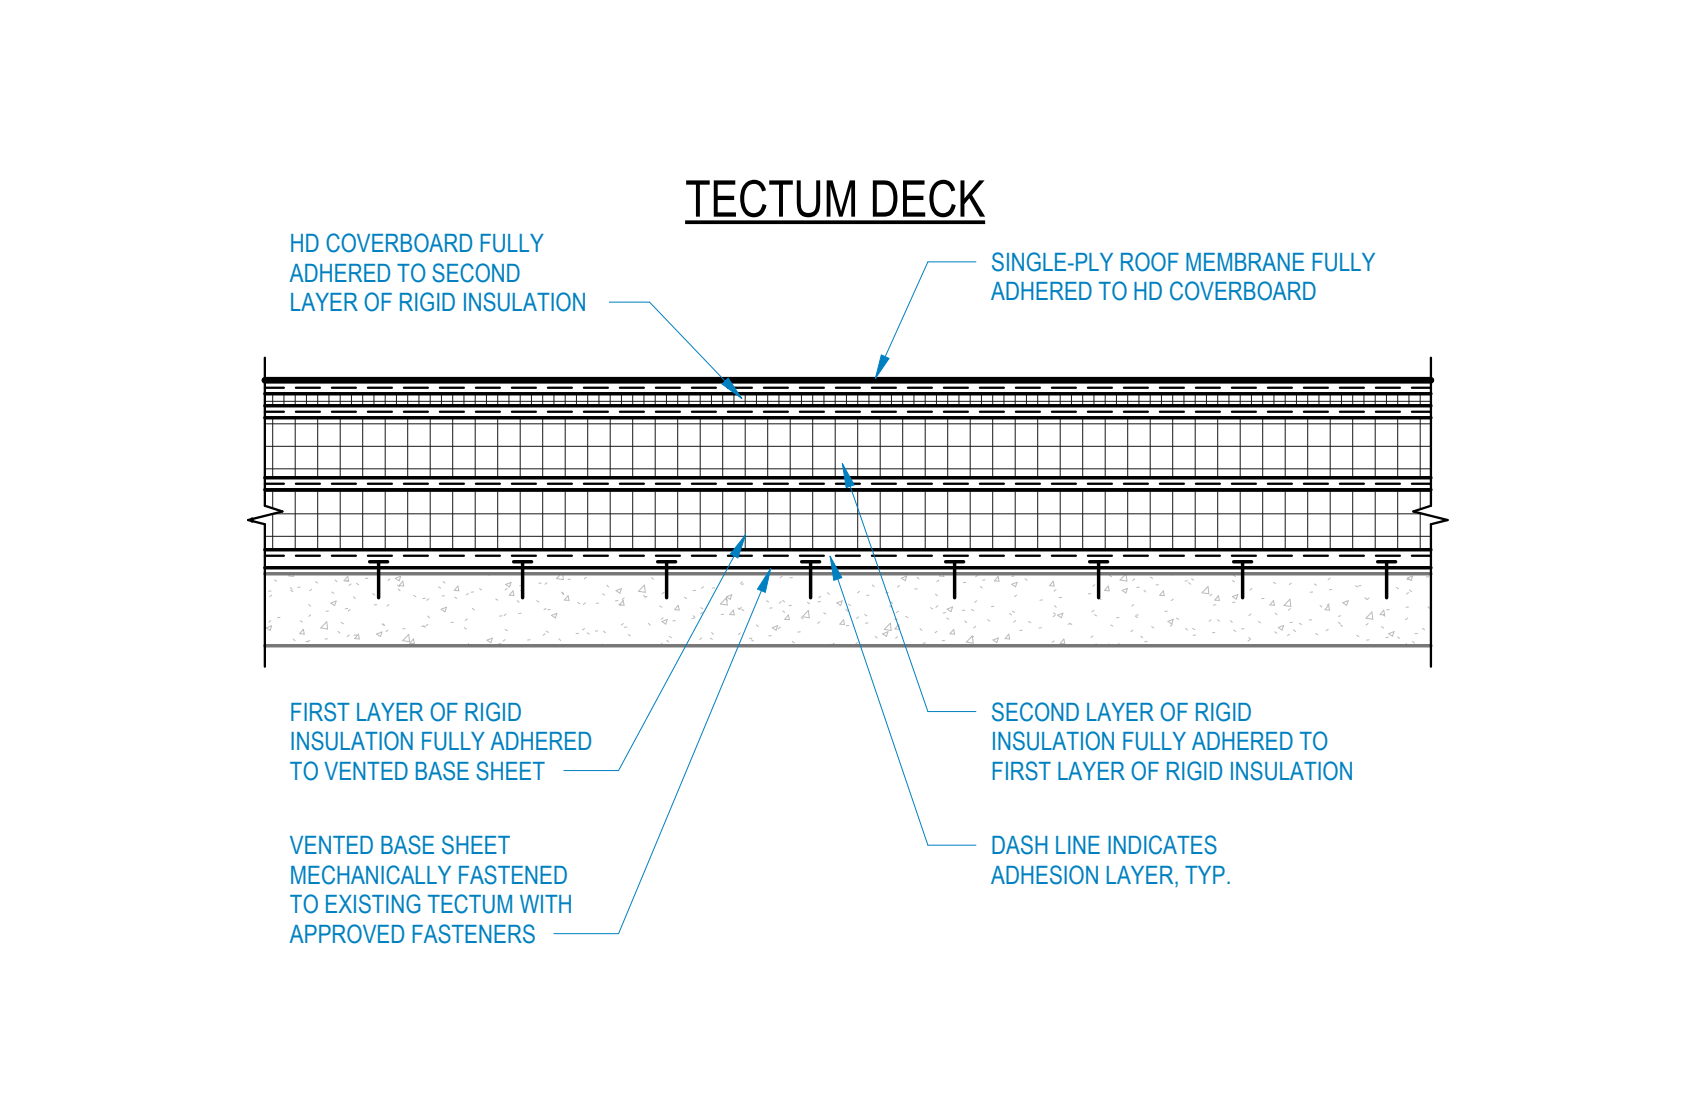


ROOF LAYER INSTALLATION DETAIL  
SCALE: 1 1/2" = 1'-0" (7) A5.21

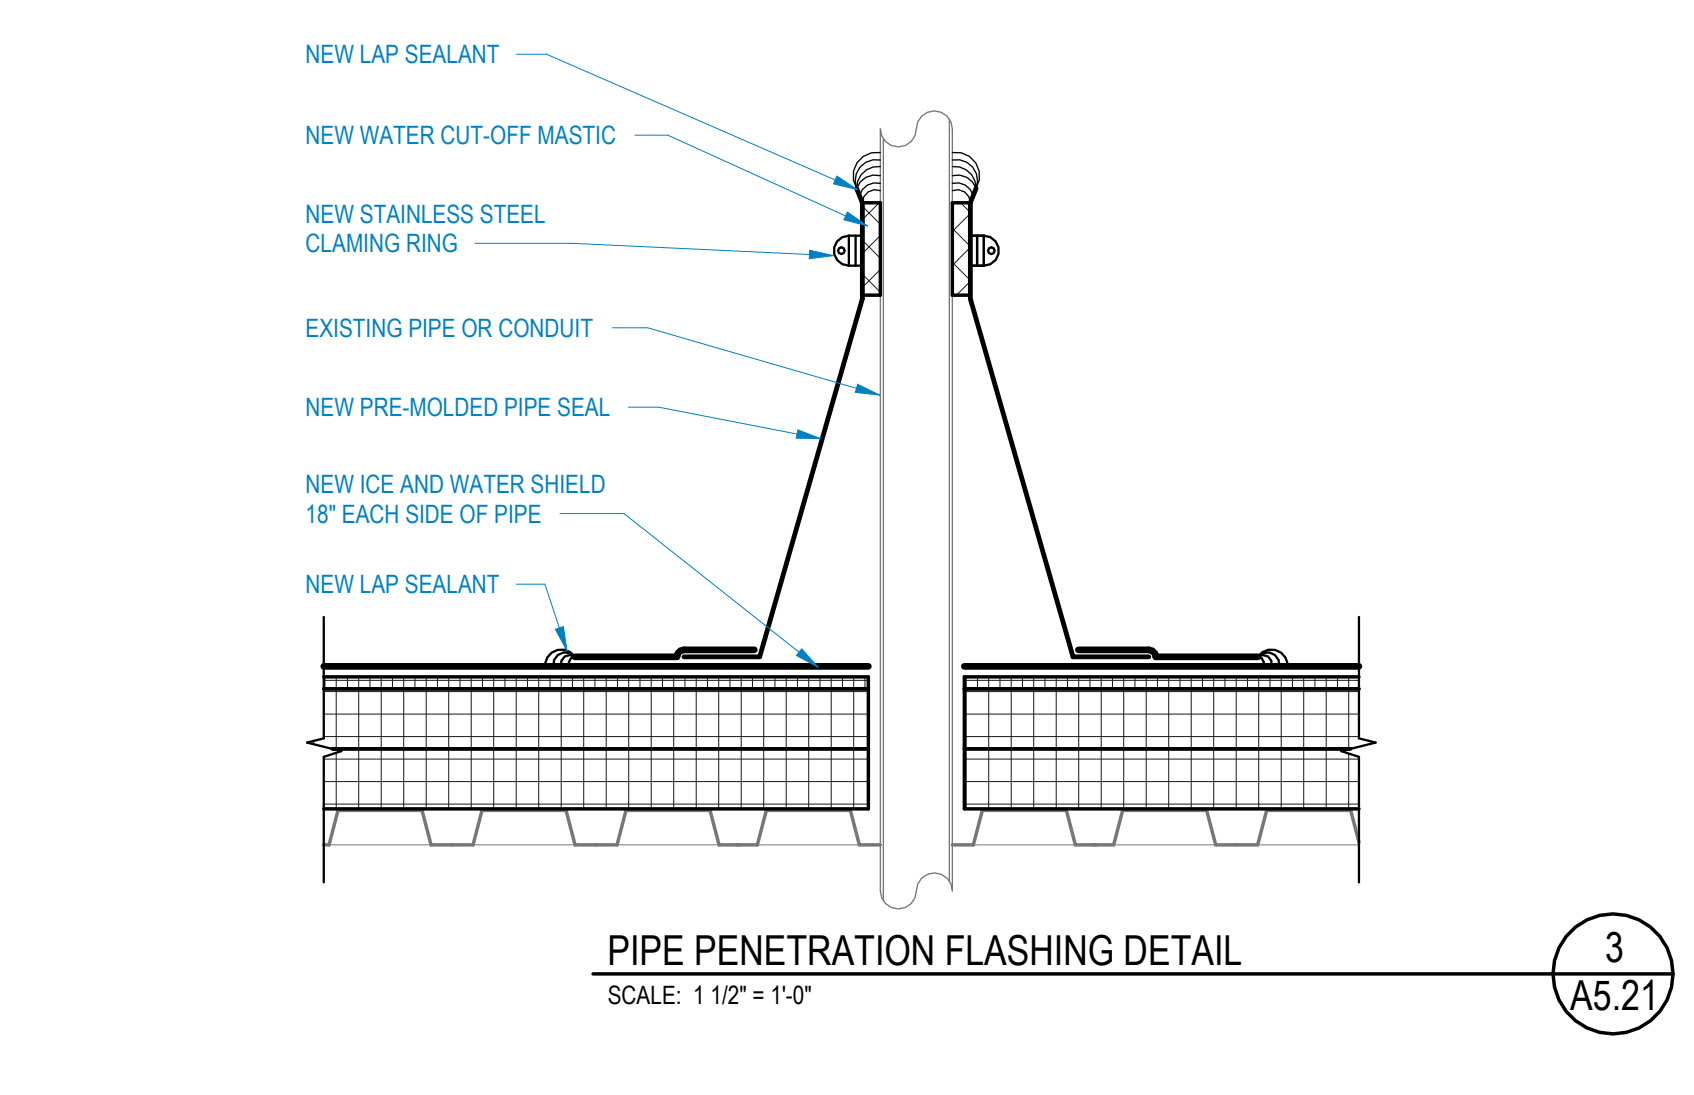


PIPE PENETRATION FLASHING DETAIL  
SCALE: 1 1/2" = 1'-0" (3) A5.21

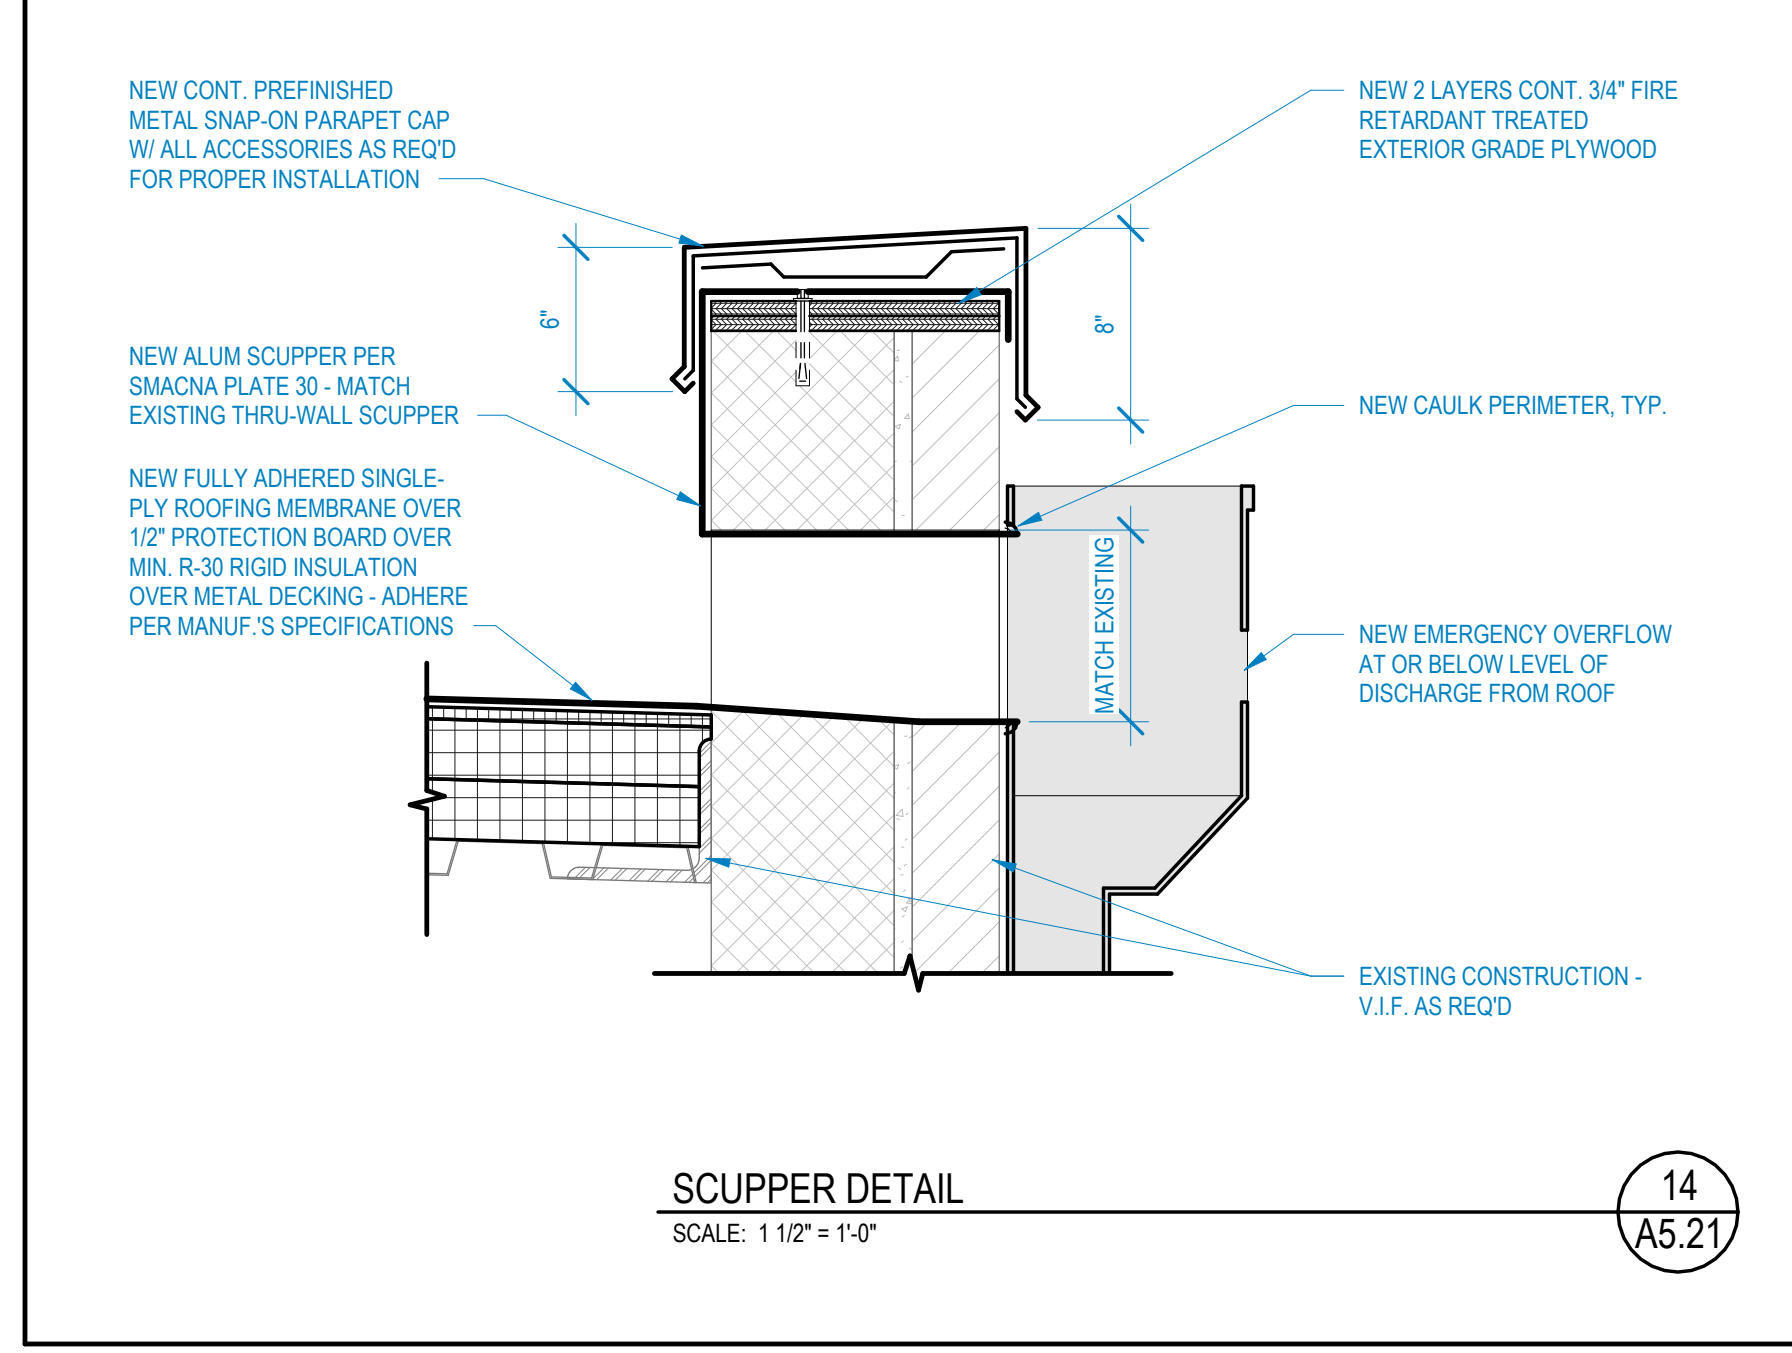


SCUPPER DETAIL  
SCALE: 1 1/2" = 1'-0" (14) A5.21

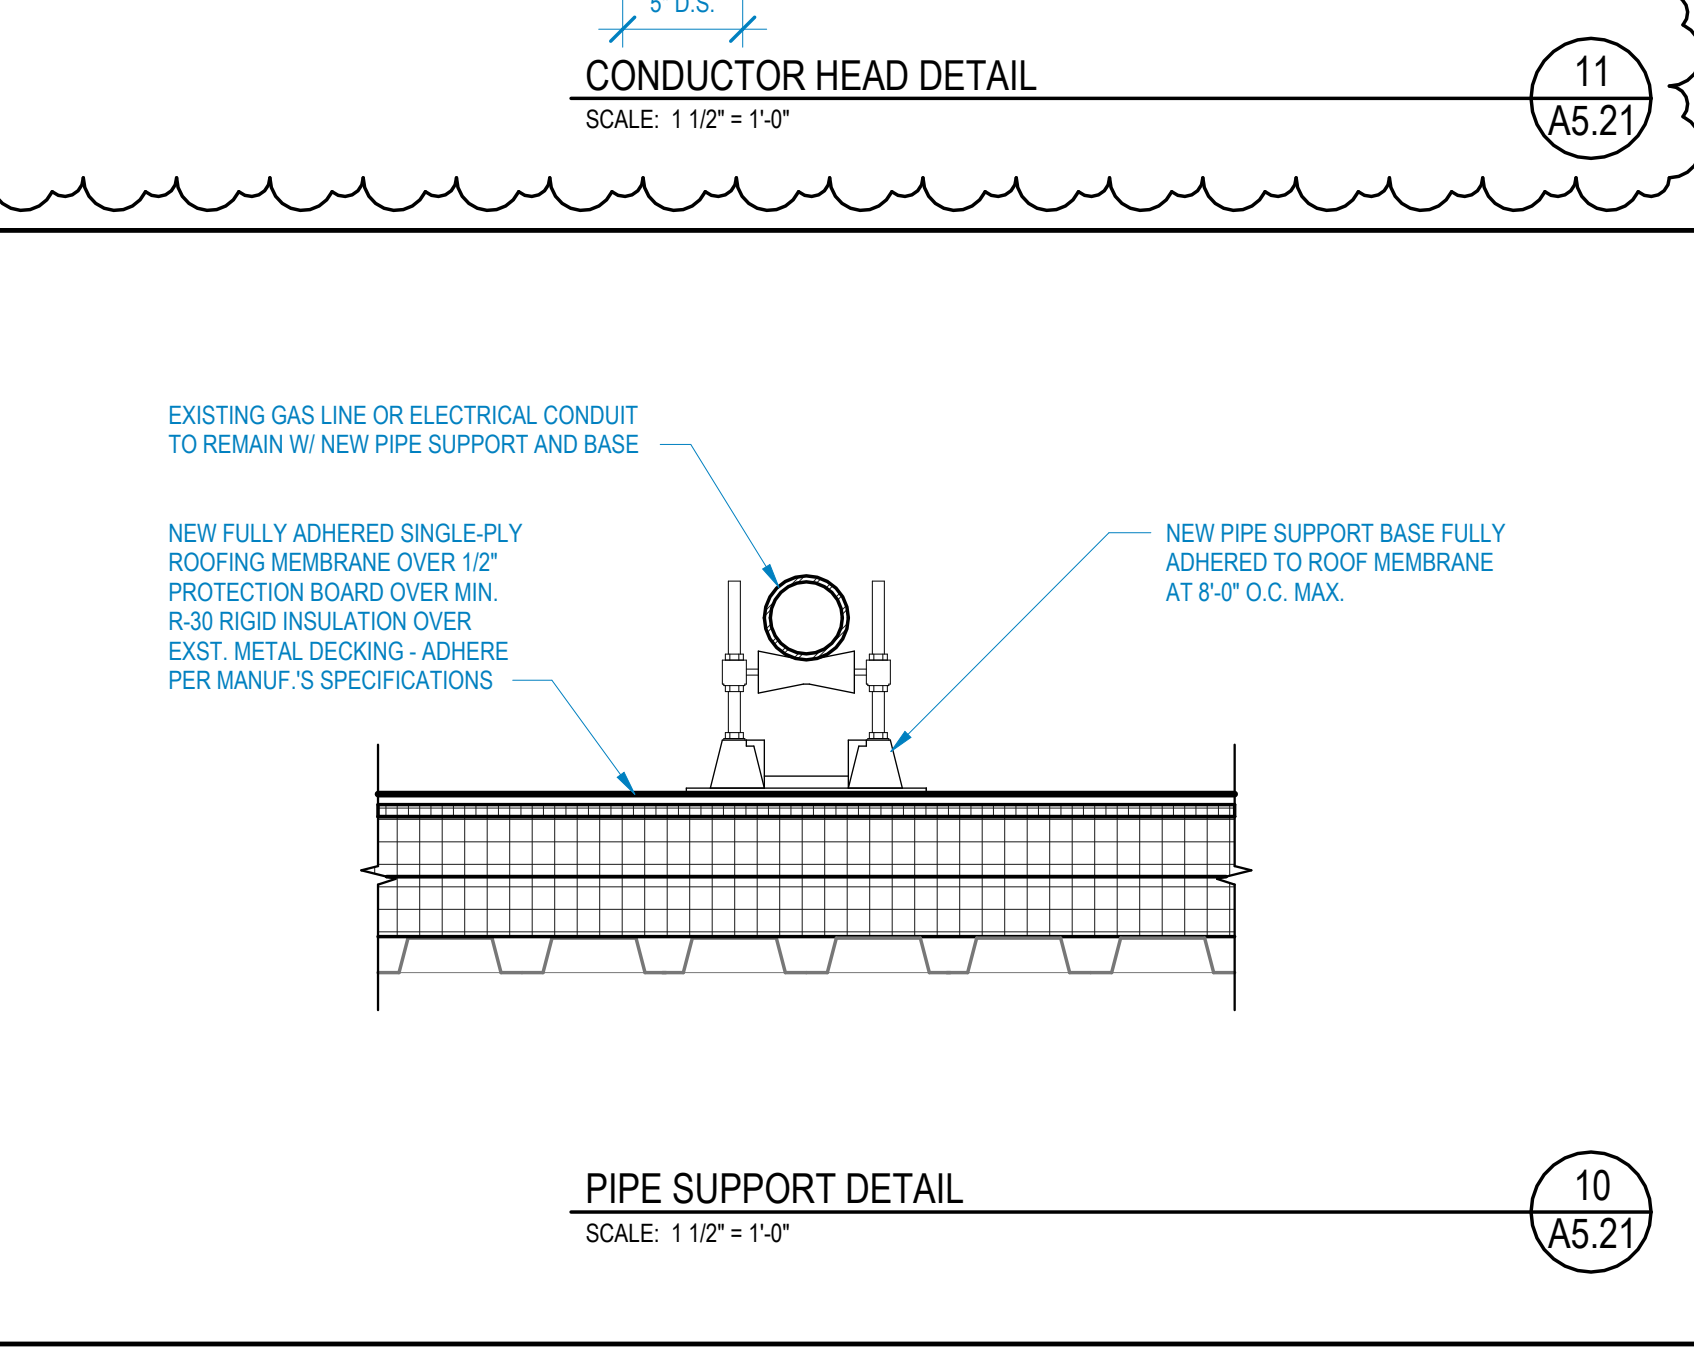


PIPE SUPPORT DETAIL  
SCALE: 1 1/2" = 1'-0" (10) A5.21

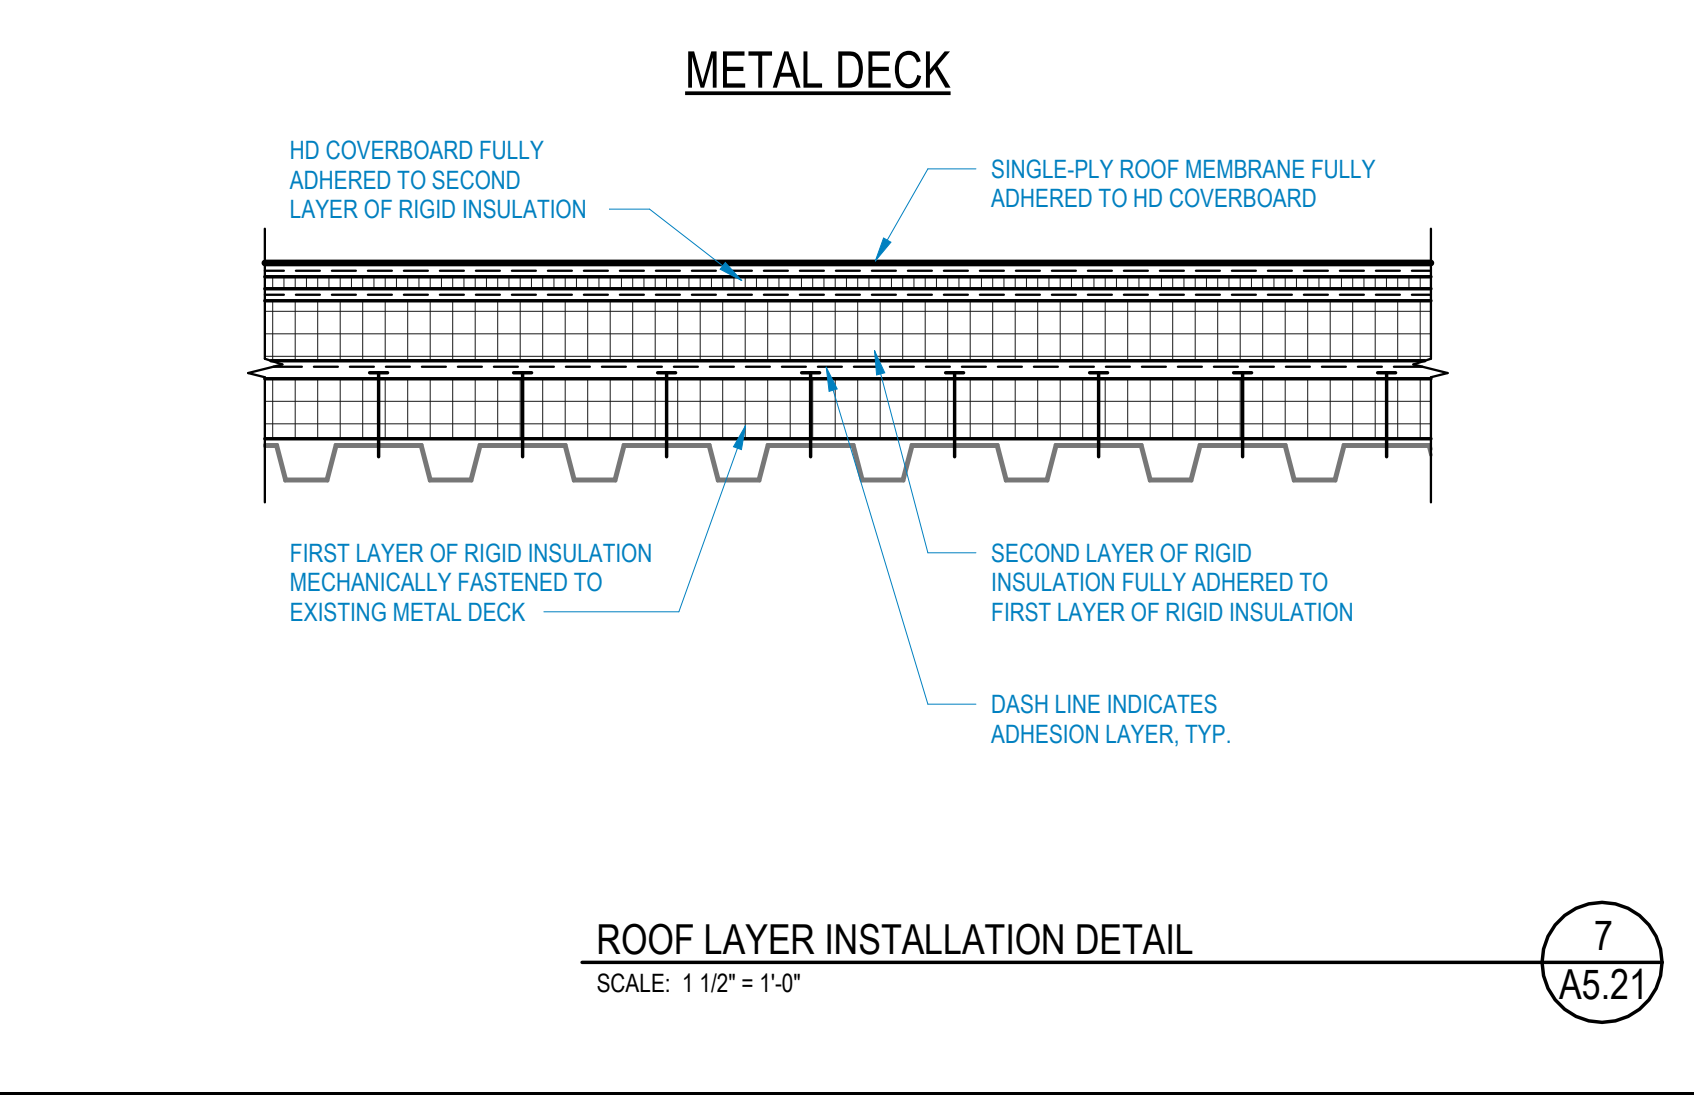


ROOF LAYER INSTALLATION DETAIL  
SCALE: 1 1/2" = 1'-0" (7) A5.21

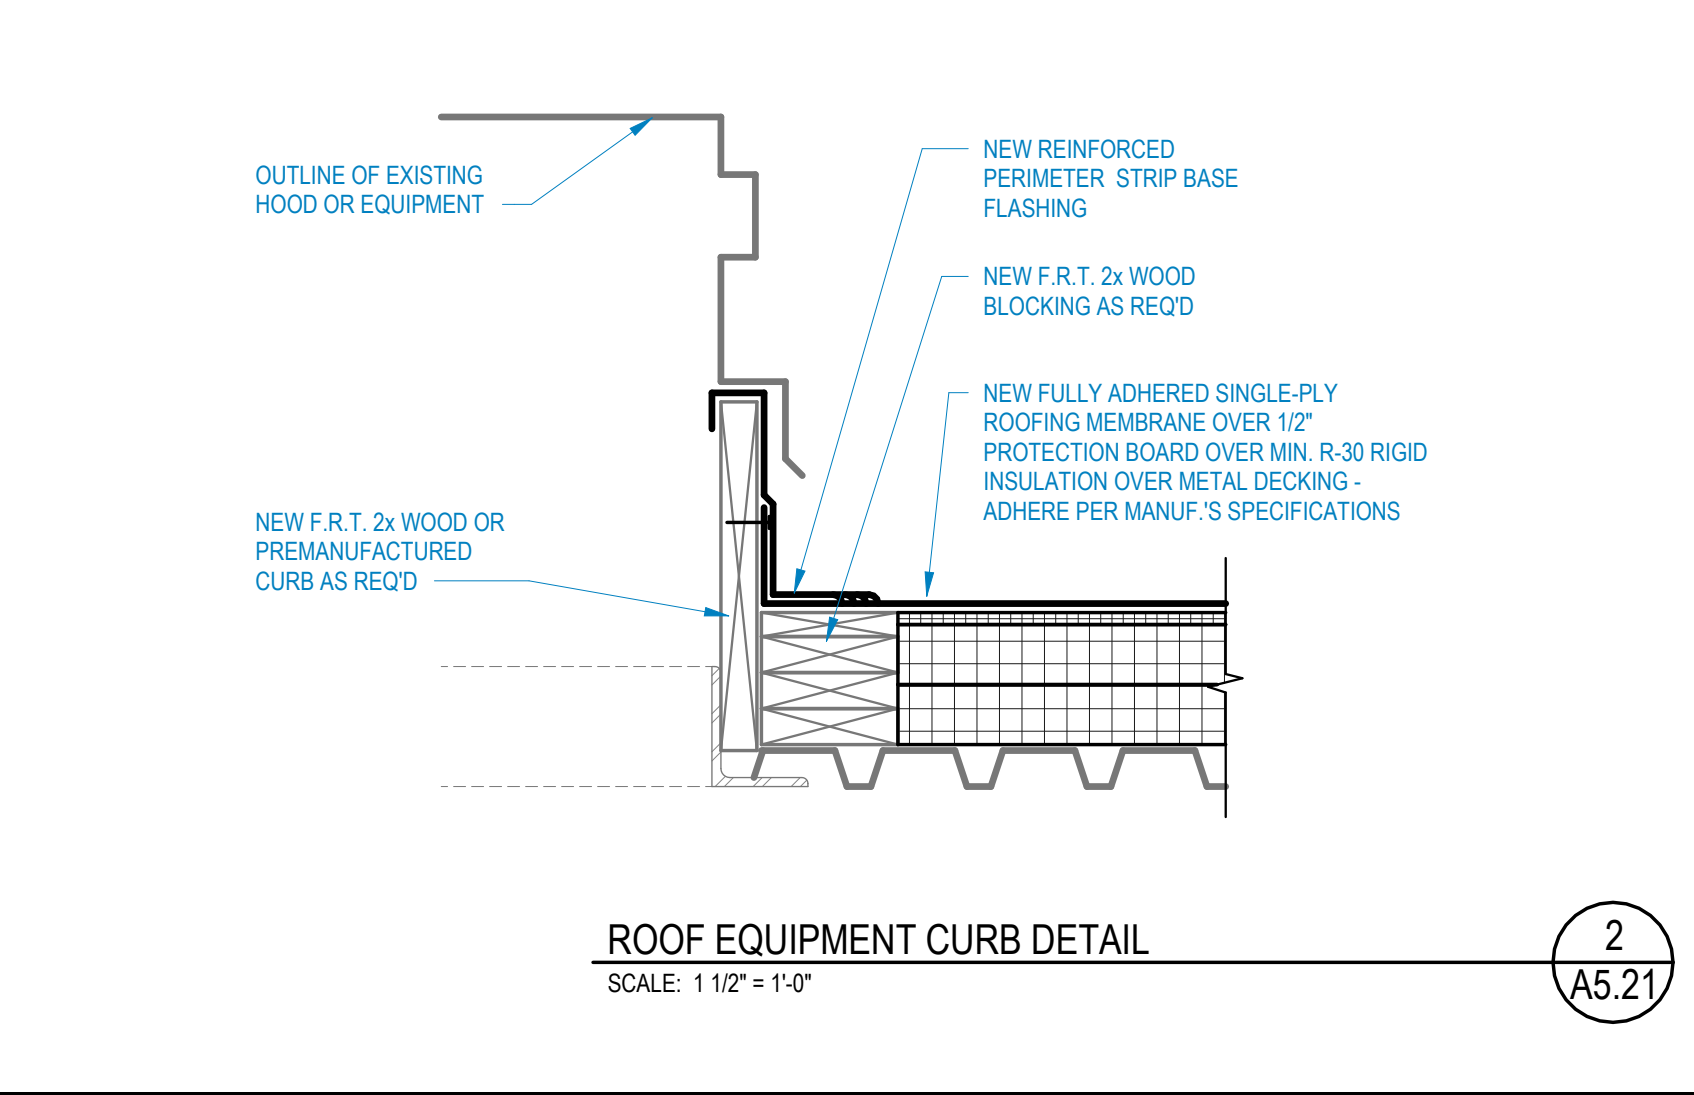


ROOF EQUIPMENT CURB DETAIL  
SCALE: 1 1/2" = 1'-0" (2) A5.21

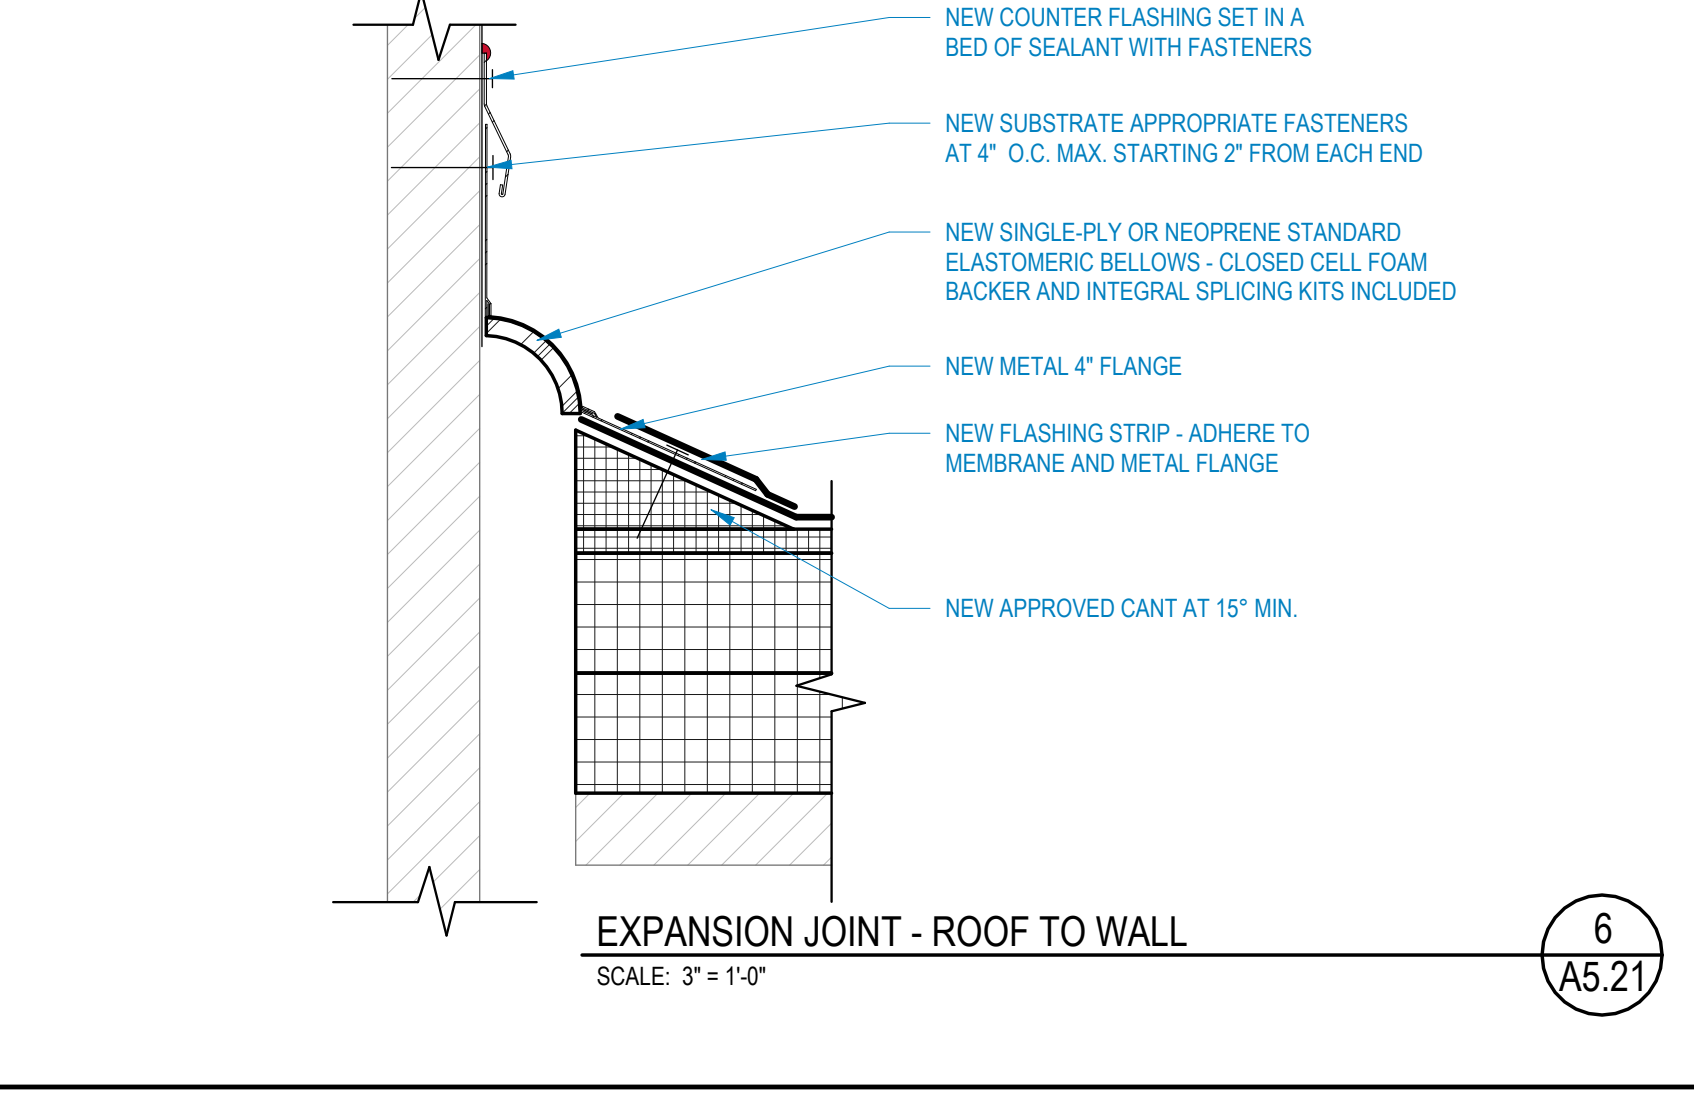

EXPANSION JOINT - ROOF TO WALL  
SCALE: 3\"/>

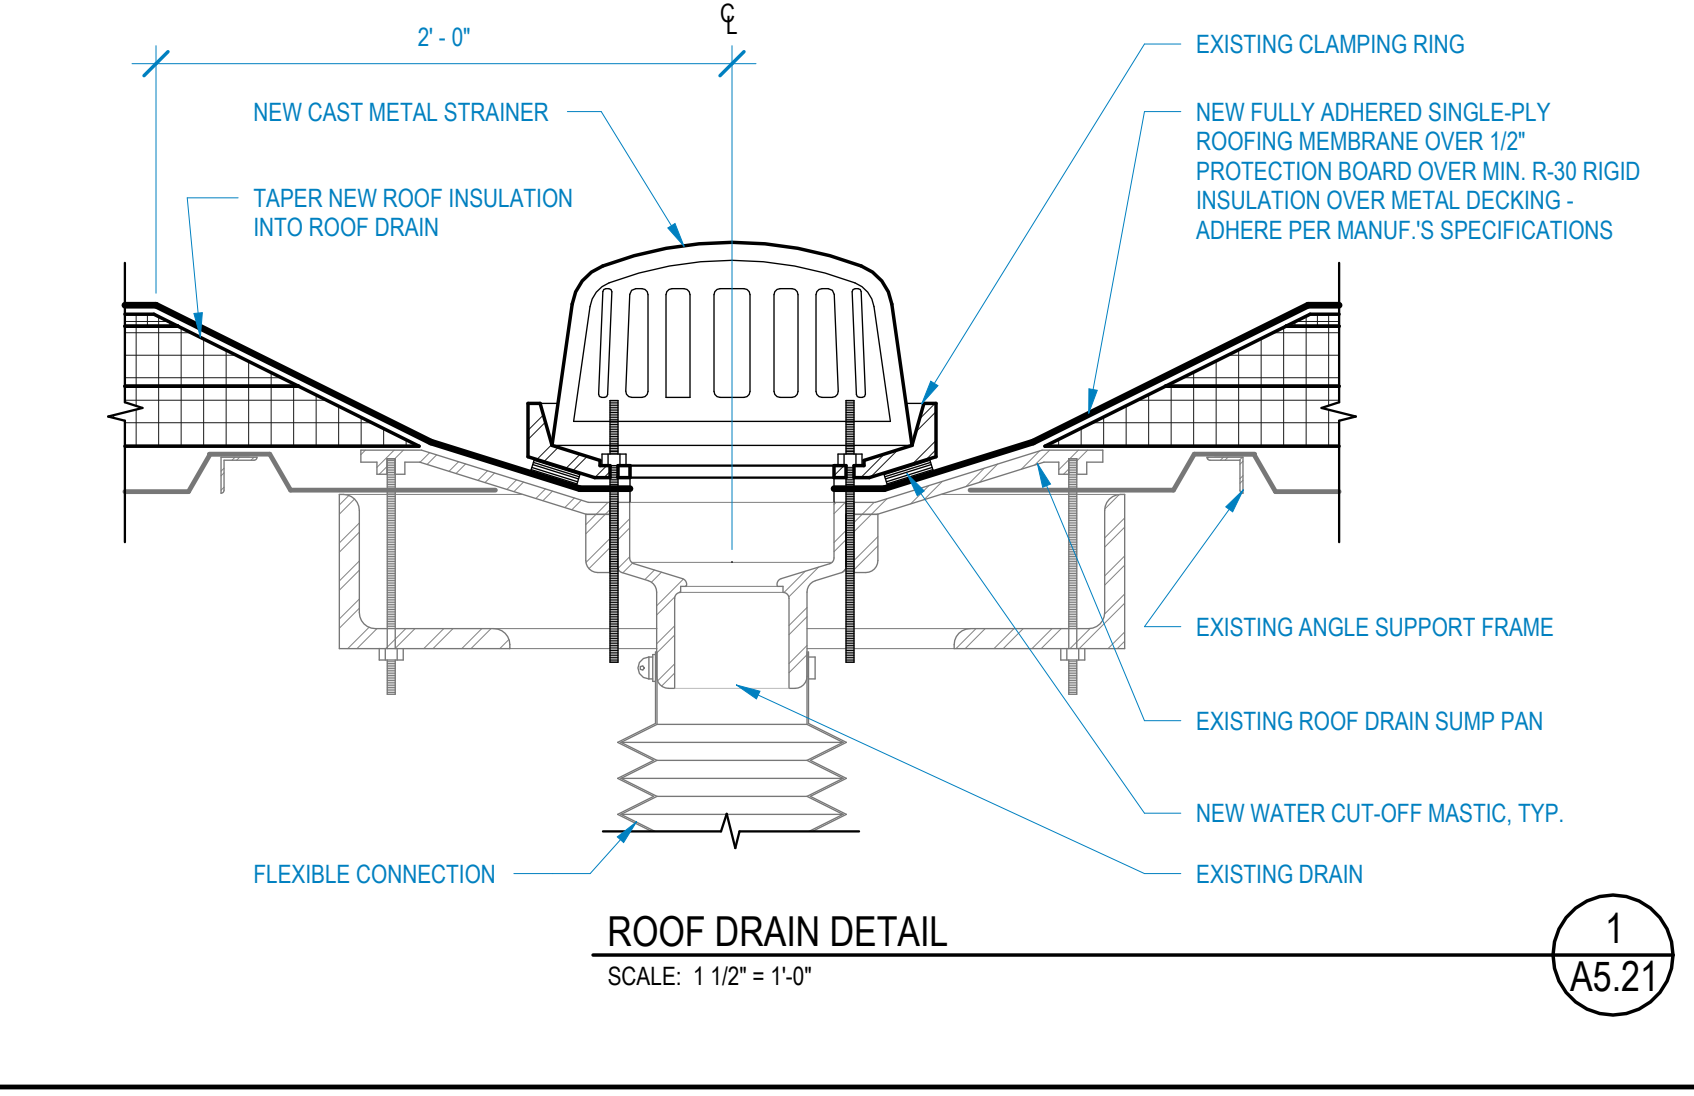

ROOF DRAIN DETAIL  
SCALE: 1 1/2" = 1'-0" (1) A5.21

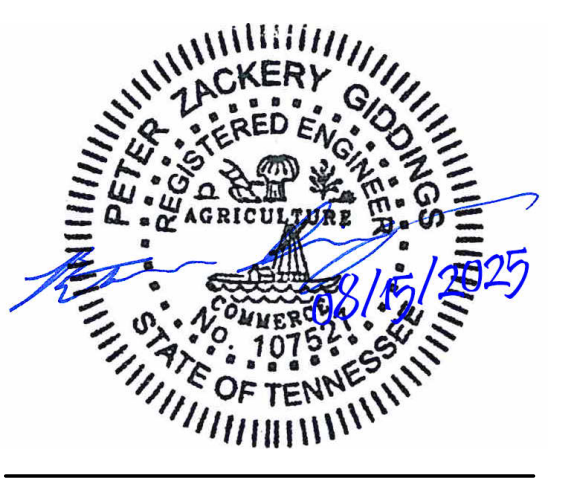

DATE: 08/15/2025  
PROJECT NO: 25018  
BID NO: 2026-02-177

PROJECT REVISIONS		
#	DATE	DESCRIPTION
1	08/27/2025	ADD-02

THIS DRAWING IS THE PROPERTY OF THE LEWIS GROUP ARCHITECTS, INC. AND IS TO BE USED ONLY FOR THE PROJECT AND SITE SPECIFICALLY IDENTIFIED HEREIN. THIS DRAWING IS NOT TO BE USED ON ANY OTHER PROJECT WITHOUT THE PROJECT FOR WHICH IT IS MADE. EXERCISED OR NOT. THIS DRAWING AND ITS CONTENTS ARE THE SOLE POSSESSION OF THE LEWIS GROUP ARCHITECTS, INC. AND SHALL NOT BE UPLOADED IN ANY MANNER WITHOUT THEIR FULL CONSENT. IT IS TO BE RETURNED UPON REQUEST.