SHEET NO.	SHEET LIST SHEET NAME	CURRENT REVISION DATE	CURRENT REVISION DESCRIPTION
0.0 0.1	COVER SHEET DRAWING INDEX	R1 - 5/06/20 R2 - 5/26/20	PLANS REVIEW COMMENTS ADDENDUM 1
02.0 - CIVIL 0001 0100	GENERAL SITE NOTES EXISTING SITE CONDITIONS	R1 - 5/06/20 R1 - 5/06/20	PLANS REVIEW COMMENTS PLANS REVIEW COMMENTS
C200 C300	SITE LAYOUT PLAN SITE GRADING PLAN	R1 - 5/06/20 R1 - 5/06/20	PLANS REVIEW COMMENTS PLANS REVIEW COMMENTS
C400 C500 C800	SITE DRAINAGE PLAN SITE UTILITY PLAN DETAILS	R1 - 5/06/20 R1 - 5/06/20 R1 - 5/06/20	PLANS REVIEW COMMENTS PLANS REVIEW COMMENTS PLANS REVIEW COMMENTS
C801	DETAILS DETAILS	R1 - 5/06/20 R1 - 5/06/20	PLANS REVIEW COMMENTS PLANS REVIEW COMMENTS
C803 C804 C900	DETAILS DETAILS INITIAL EPSC PLAN	R1 - 5/06/20 R1 - 5/06/20 R1 - 5/06/20	PLANS REVIEW COMMENTS PLANS REVIEW COMMENTS PLANS REVIEW COMMENTS
C901 C902 C903	FINAL EPSC PLAN EPSC DETAILS EPSC DETAILS	R1 - 5/06/20 R1 - 5/06/20 R1 - 5/06/20	PLANS REVIEW COMMENTS PLANS REVIEW COMMENTS PLANS REVIEW COMMENTS
03.0 - LANDSCA L0.1		R2 - 5/26/20	ADDENDUM 1
L1.1 L1.2 L2.1	LANDSCAPE LAYOUT & MATERIALS PLAN LANDSCAPE PLANTING PLAN ENTRY MONUMENT ENLARGEMENTS & DETAILS	R2 - 5/26/20 R2 - 5/26/20 R2 - 5/26/20	ADDENDUM 1 ADDENDUM 1 ADDENDUM 1
L2.2 L2.3	LANDSCAPE WALL AND FENCE DETAILS LANDSCAPE WALL AND FENCE DETAILS	R2 - 5/26/20	ADDENDUM 1
L2.4 L2.5 L2.6	LANDSCAPE AMENITY DETAILS LANDSCAPE PLANTING DETAILS LANDSCAPE PLANTING DETAILS	R2 - 5/26/20 R2 - 5/26/20	ADDENDUM 1 ADDENDUM 1
04.0 - PROJECT G0.1	GENERAL NOTES ABBREVATIONS, SYMBOLS, GENERAL NOTES AND DETAILS	R1 - 5/06/20	PLANS REVIEW COMMENTS
G1.0 G1.1 G1.2	WALL LEGEND ACCESSIBLE NOTES AND DETAILS ARCHITECTURAL SITE PLAN	R1 - 5/06/20 R1 - 5/06/20 R2 - 5/26/20	PLANS REVIEW COMMENTS PLANS REVIEW COMMENTS ADDENDUM 1
G1.3 G1.4	ARCHITECTURAL SITE SECTIONS MULTIFAMILY - ADDRESSING	R1 - 5/06/20 R1 - 5/06/20	PLANS REVIEW COMMENTS PLANS REVIEW COMMENTS
G1.5 G2.1 G2.2	TOWNHOMES - ADDRESSING UL ASSEMBLIES - U376 UL ASSEMBLIES - U305	R1 - 5/06/20	PLANS REVIEW COMMENTS
G2.3 G2.4	UL ASSEMBLIES - L506 UL ASSEMBLIES - L528		
G2.5 G2.6 G2.7	UL ASSEMBLIES - X701 UL ASSEMBLIES - U344 UL ASSEMBLIES - U905	R1 - 5/06/20 R1 - 5/06/20 R1 - 5/06/20	PLANS REVIEW COMMENTS PLANS REVIEW COMMENTS PLANS REVIEW COMMENTS
G2.8 04.1 - B1 - MF -	UL ASSEMBLIES - U301 GENERAL	R1 - 5/06/20	PLANS REVIEW COMMENTS
MF.A0.1 MF.A0.2 MF.A0.3	BUILDING 1 - PROJECT INFORMATION CODE ANALYSIS EXIT ANALYSIS	R1 - 5/06/20 R1 - 5/06/20 R1 - 5/06/20	PLANS REVIEW COMMENTS PLANS REVIEW COMMENTS PLANS REVIEW COMMENTS
MF.G0.0 MF.G0.1	MULTIFAMILY NET USABLE AREA PLANS MULTIFAMILY - GROSS LIVING AREA PLAN	R1 - 5/06/20 R1 - 5/06/20	PLANS REVIEW COMMENTS PLANS REVIEW COMMENTS
MF.LS1.0 MF.LS1.1 MF.LS1.2	LIFE SAFETY PLAN - LEVEL 00 LIFE SAFETY PLAN - LEVEL 01 (PARKING) LIFE SAFETY PLAN - LEVEL 02	R1 - 5/06/20 R1 - 5/06/20 R1 - 5/06/20	PLANS REVIEW COMMENTS PLANS REVIEW COMMENTS PLANS REVIEW COMMENTS
MF.LS1.3 MF.LS1.4	LIFE SAFETY PLAN - LEVEL 03 LIFE SAFETY PLAN - LEVEL 04	R1 - 5/06/20 R1 - 5/06/20	PLANS REVIEW COMMENTS PLANS REVIEW COMMENTS
MF.LS1.5 04.2 - B1 - MF MF.A1.0	LIFE SAFETY PLAN - LEVEL 05 ARCHITECTURAL FLOOR PLAN - LEVEL 00	R1 - 5/06/20 R2 - 5/26/20	PLANS REVIEW COMMENTS ADDENDUM 1
MF.A1.1A MF.A1.1B	FLOOR PLAN - LEVEL 00 FLOOR PLAN - LEVEL 01 FLOOR PLAN - LEVEL 01	R1 - 5/06/20 R1 - 5/06/20	PLANS REVIEW COMMENTS PLANS REVIEW COMMENTS
MF.A1.2 MF.A1.3 MF.A1.4	FLOOR PLAN - LEVEL 02 FLOOR PLAN - LEVEL 03 FLOOR PLAN - LEVEL 04	R1 - 5/06/20 R1 - 5/06/20 R1 - 5/06/20	PLANS REVIEW COMMENTS PLANS REVIEW COMMENTS PLANS REVIEW COMMENTS
MF.A1.5 MF.A1.6	FLOOR PLAN - LEVEL 04 FLOOR PLAN - LEVEL 05 FLOOR PLAN - ROOF LEVEL	R1 - 5/06/20 R1 - 5/06/20	PLANS REVIEW COMMENTS PLANS REVIEW COMMENTS
MF.A2.0 MF.A2.1 MF.A2.2	REFLECTED CEILING PLAN - LEVEL 00 REFLECTED CEILING PLAN - LEVEL 01 REFLECTED CEILING PLAN - LEVEL 02-05	R1 - 5/06/20 R1 - 5/06/20 R1 - 5/06/20	PLANS REVIEW COMMENTS PLANS REVIEW COMMENTS PLANS REVIEW COMMENTS
MF.A3.1 MF.A3.2	BUILDING ELEVATIONS BUILDING ELEVATIONS	R2 - 5/26/20 R2 - 5/26/20	ADDENDUM 1 ADDENDUM 1
MF.A3.3 MF.A3.4 MF.A3.5	BUILDING ELEVATIONS BUILDING ELEVATIONS AXONOMETRIC VIEWS	R2 - 5/26/20 R2 - 5/26/20 R1 - 5/06/20	ADDENDUM 1 ADDENDUM 1 PLANS REVIEW COMMENTS
MF.A4.1 MF.A4.2	BUILDING SECTIONS BUILDING SECTIONS	R1 - 5/06/20 R1 - 5/06/20	PLANS REVIEW COMMENTS PLANS REVIEW COMMENTS
MF.A4.3 MF.A4.4 MF.A4.5	WALL SECTIONS WALL SECTIONS	R1 - 5/06/20 R1 - 5/06/20 R1 - 5/06/20	PLANS REVIEW COMMENTS PLANS REVIEW COMMENTS PLANS REVIEW COMMENTS
MF.A4.6 MF.A4.7	DETAILS DETAILS	R1 - 5/06/20 R1 - 5/06/20	PLANS REVIEW COMMENTS PLANS REVIEW COMMENTS
MF.A4.8 MF.A4.9 MF.A4.10	DETAILS DETAILS TYPICAL DETAILS	R1 - 5/06/20 R1 - 5/06/20 R1 - 5/06/20	PLANS REVIEW COMMENTS PLANS REVIEW COMMENTS PLANS REVIEW COMMENTS
MF.A4.11 MF.A5.1	TYPICAL DETAILS ENLARGED STAIR PLANS AND SECTIONS	R1 - 5/06/20 R1 - 5/06/20	PLANS REVIEW COMMENTS PLANS REVIEW COMMENTS
MF.A5.2 MF.A5.3 MF.A5.4	DETAILS - STAIRS DETAILS - STAIRS ENLARGED ELEVATOR PLAN AND HOISTWAY	R1 - 5/06/20 R1 - 5/06/20 R1 - 5/06/20	PLANS REVIEW COMMENTS PLANS REVIEW COMMENTS PLANS REVIEW COMMENTS
MF.A5.5 MF.A6.1	DETAILS - ELEVATOR DOOR SCHEDULES AND ELEVATIONS	R1 - 5/06/20 R1 - 5/06/20	PLANS REVIEW COMMENTS PLANS REVIEW COMMENTS
MF.A6.2 MF.A6.3	WINDOW ELEVATIONS DETAILS - WINDOW ASSEMBLIES DETAILS - WINDOW ASSEMBLIES	R1 - 5/06/20 R1 - 5/06/20	PLANS REVIEW COMMENTS PLANS REVIEW COMMENTS PLANS PEVIEW COMMENTS
MF.A6.4 MF.A6.5 MF.A6.6	DETAILS - WINDOW ASSEMBLIES STOREFRONT ELEVATIONS DETAILS - STOREFRONT ASSEMBLIES	R1 - 5/06/20 R1 - 5/06/20 R1 - 5/06/20	PLANS REVIEW COMMENTS PLANS REVIEW COMMENTS PLANS REVIEW COMMENTS
MF.A7.0 MF.A7.1	OVERALL FINISH FLOOR PLAN 00 OVERALL FINISH FLOOR PLAN - LEVEL 01 OVERALL FINISH FLOOR PLAN - LEVELS 02 - 05	R1 - 5/06/20 R1 - 5/06/20	PLANS REVIEW COMMENTS PLANS REVIEW COMMENTS PLANS REVIEW COMMENTS
MF.A7.2 MF.A7.3 MF.A7.4	OVERALL FINISH FLOOR PLAN - LEVELS 02 - 05 ENLARGED PLAN & INTERIOR ELEVATIONS - COMMUNITY ROOM ENLARGED PLAN & RCP - ENTRIES AND AMENITY ROOM	R1 - 5/06/20 R1 - 5/06/20 R1 - 5/06/20	PLANS REVIEW COMMENTS PLANS REVIEW COMMENTS PLANS REVIEW COMMENTS
MF.A7.5 MF.A7.6	FINISH PLAN AND ELEVATIONS - ENTRIES AND AMENITY ROOM ENLARGED PLAN & INTERIOR ELEVATIONS - FITNESS ROOM	R1 - 5/06/20 R1 - 5/06/20	PLANS REVIEW COMMENTS PLANS REVIEW COMMENTS
MF.A7.7 MF.A7.8 MF.A7.9	ENLARGED PLANS AND ELEVATIONS - UNIT A ENLARGED PLANS AND ELEVATIONS - UNIT B ENLARGED PLANS AND ELEVATIONS - UNIT C	R1 - 5/06/20 R1 - 5/06/20 R1 - 5/06/20	PLANS REVIEW COMMENTS PLANS REVIEW COMMENTS PLANS REVIEW COMMENTS
MF.A7.10 MF.A7.11 MF.A7.12	ENLARGED PLANS AND ELEVATIONS - UNIT D ENLARGED PLANS AND ELEVATIONS - UNIT E ENLARGED PLANS AND ELEVATIONS - UNIT F	R1 - 5/06/20 R1 - 5/06/20 R1 - 5/06/20	PLANS REVIEW COMMENTS PLANS REVIEW COMMENTS PLANS REVIEW COMMENTS
MF.A7.12 MF.A7.13 MF.A7.14	ENLARGED PLANS AND ELEVATIONS - UNIT G ENLARGED PLANS AND ELEVATIONS - UNIT H	R1 - 5/06/20 R1 - 5/06/20 R1 - 5/06/20	PLANS REVIEW COMMENTS PLANS REVIEW COMMENTS PLANS REVIEW COMMENTS
MF.A7.15 MF.A7.16 MF A7 17	ENLARGED PLANS AND ELEVATIONS - UNIT J ENLARGED PLANS AND ELEVATIONS - ADA UNIT 103 ENLARGED PLANS AND ELEVATIONS - ADA UNIT 208	R1 - 5/06/20 R1 - 5/06/20 R1 - 5/06/20	PLANS REVIEW COMMENTS PLANS REVIEW COMMENTS PLANS REVIEW COMMENTS
MF.A7.17 MF.A7.18 MF.A7.19	ENLARGED PLANS AND ELEVATIONS - ADA UNIT 208 ENLARGED PLANS AND ELEVATIONS - ADA UNIT 311 INTERIOR ROOM FINISH LEGEND & FINISH NOTES	R1 - 5/06/20 R1 - 5/06/20 R2 - 5/26/20	PLANS REVIEW COMMENTS PLANS REVIEW COMMENTS ADDENDUM 1
MF.A7.20 MF.A7.21 MF.A7.22	TYPICAL UNIT MILLWORK & CASEWORK DETAILS TYPICAL MILLWORK & CASEWORK DETAILS - BUILDING 1 GAZEBO DETAILS	R1 - 5/06/20 R1 - 5/06/20 R1 - 5/06/20	PLANS REVIEW COMMENTS PLANS REVIEW COMMENTS PLANS REVIEW COMMENTS
MF.A7.22 04.3 - B1 - MF - : MF.S1.100		N 1 - 3/Ub/20	LANS REVIEW COMMENTS
MF.S1.101 MF.S1.102	FOUNDATION PLAN LEVEL 01 - FLOOR FRAMING PLAN		
MF.S1.103 MF.S1.104 MF.S1.105	LEVEL 02 - FLOOR FRAMING PLAN / LOWER ROOF LEVEL 03 - FLOOR FRAMING PLAN LEVEL 04 - FLOOR FRAMING PLAN		
MF.S1.106 MF.S1.107	LEVEL 05 - LOW ROOF FRAMING PLAN UPPER ROOF FRAMING PLAN		
MF.S2.100 MF.S2.101 MF.S2.102	STRUCTURAL DETAILS STRUCTURAL DETAILS STRUCTURAL DETAILS		
MF.S2.103 MF.S2.104	STRUCTURAL DETAILS STRUCTURAL DETAILS		
04.4 - B1 - MF - 1 MF - M1.0 MF - M1.1	MECHANICAL BLDG 1A - LEVEL 00 (PARKING) - HVAC BLDG 1A - LEVEL 01 (LOBBY) - HVAC	R1 - 5/06/20 R1 - 5/06/20	PLANS REVIEW COMMENTS PLANS REVIEW COMMENTS
MF - M1.1 MF - M1.2 MF - M1.3	BLDG 1A - LEVEL 02 - HVAC BLDG 1A - LEVEL 03 - HVAC	R1 - 5/06/20 R1 - 5/06/20	PLANS REVIEW COMMENTS PLANS REVIEW COMMENTS
MF - M1.1 MF - M1.2	BLDG 1A - LEVEL 01 (LOBBY) - HVAC BLDG 1A - LEVEL 02 - HVAC	R1 - 5/06/20 R1 - 5/06/20	PLANS REVIEW COMN

MF - M2.0 MF - M2.1 04.5 - B1 - MF - P MF - P1.0 MF - P1.1 MF - P1.2 MF - P1.3 MF - P1.4 MF - P1.5 MF - P1.6 MF - P2.1 MF - P2.2	BLDG 1A - LEVEL 00 - UNDERGROUND PLUMBING BLDG 1A - LEVEL 00 - WASTE AND VENT BLDG 1A - LEVEL 01 - WASTE & VENT	R1 - 5/06/20 R1 - 5/06/20 R1 - 5/06/20 R1 - 5/06/20	PLANS REVIEW COMMENTS PLANS REVIEW COMMENTS
MF - M1.6 MF - M2.0 MF - M2.1 04.5 - B1 - MF - P MF - P1.0 MF - P1.1 MF - P1.2 MF - P1.3 MF - P1.4 MF - P1.5 MF - P1.6 MF - P2.1 MF - P2.2	BLDG 1A - ROOF - HVAC SCHEDULES & DETAILS - HVAC DETAILS - HVAC LUMBING BLDG 1A - LEVEL 00 - UNDERGROUND PLUMBING BLDG 1A - LEVEL 00 - WASTE AND VENT BLDG 1A - LEVEL 01 - WASTE & VENT	R1 - 5/06/20 R1 - 5/06/20 R1 - 5/06/20	PLANS REVIEW COMMENTS PLANS REVIEW COMMENTS
04.5 - B1 - MF - P MF - P1.0 MF - P1.1 MF - P1.2 MF - P1.3 MF - P1.4 MF - P1.5 MF - P1.6 MF - P2.1 MF - P2.2	LUMBING BLDG 1A - LEVEL 00 - UNDERGROUND PLUMBING BLDG 1A - LEVEL 00 - WASTE AND VENT BLDG 1A - LEVEL 01 - WASTE & VENT	R1 - 5/06/20	
MF - P1.1 MF - P1.2 MF - P1.3 MF - P1.4 MF - P1.5 MF - P1.6 MF - P2.1 MF - P2.2	BLDG 1A - LEVEL 00 - WASTE AND VENT BLDG 1A - LEVEL 01 - WASTE & VENT	R1 - 5/06/20	
MF - P1.3 MF - P1.4 MF - P1.5 MF - P1.6 MF - P2.1 MF - P2.2		- v/ub/70	PLANS REVIEW COMMENTS PLANS REVIEW COMMENTS
MF - P1.6 MF - P2.1 MF - P2.2	BLDG 1A - LEVEL 02 - WASTE & VENT BLDG 1A - LEVEL 03 - WASTE & VENT	R1 - 5/06/20 R1 - 5/06/20	PLANS REVIEW COMMENTS PLANS REVIEW COMMENTS
MF - P2.2	BLDG 1A - LEVEL 04 - WASTE & VENT BLDG 1A - LEVEL 05 - WASTE & VENT	R1 - 5/06/20 R1 - 5/06/20	PLANS REVIEW COMMENTS PLANS REVIEW COMMENTS
MF - P2.3	BLDG 1A - LEVEL 00 - SERVICES BLDG 1A - LEVEL 01 - SERVICES		
MF - P2.4	BLDG 1A - LEVEL 02 - SERVICES BLDG 1A - LEVEL 03 - SERVICES		
MF - P2.6	BLDG 1A - LEVEL 04 - SERVICES BLDG 1A - LEVEL 05 - SERVICES LEGEND, SCHEDULES & DETAILS - PLUMBING	R1 - 5/06/20	PLANS REVIEW COMMENTS
MF - P3.2	FIRE STOPPING DETAILS RISER DIAGRAMS	R1 - 5/06/20	PLANS REVIEW COMMENTS
	RISER DIAGRAMS RISER DIAGRAMS	R1 - 5/06/20 R1 - 5/06/20	PLANS REVIEW COMMENTS PLANS REVIEW COMMENTS
04.6 - B1 - MF - F	RISER DIAGRAMS IRE PROTECTION	R1 - 5/06/20	PLANS REVIEW COMMENTS
MF - FP1.2	BLDG 1A - LEVEL 00 - FIRE PROTECTION BLDG 1A - LEVEL 01 - FIRE PROTECTION		
MF - FP1.4	BLDG 1A - LEVEL 02 - FIRE PROTECTION BLDG 1A - LEVEL 03 - FIRE PROTECTION BLDG 1A - LEVEL 04 - FIRE PROTECTION		
MF - FP1.6	BLDG 1A - LEVEL 05 - FIRE PROTECTION CALCS AND DETAILS - FIRE PROTECTION		
MF - FP2.3	DETAILS - FIRE PROTECTION FIRE STOPPING DETAILS		
. ~ ~ ~ ~ ~ ~ ~ ~ ~ ~ ~ ~ ~ ~ ~ ~ ~ ~ ~	SITE PLAN - ELECTRICAL		A DENDUM 1
MF-E1.0	SITE PLAN - LIGHTING CALCULATIONS BLDG 1A - LEVEL 00 - LIGHTING BLDG 1A - LEVEL 01 - LIGHTING	R2 - 5/26/20	ADDENDUM 1
MF-E1.2	BLDG 1A - LEVEL 02 - LIGHTING BLDG 1A - LEVEL 02 - LIGHTING BLDG 1A - LEVEL 03 - LIGHTING		
MF-E1.4	BLDG 1A - LEVEL 04 - LIGHTING BLDG 1A - LEVEL 05 - LIGHTING		
MF-E2.1	BLDG-1A - LEVEL 00 - POWER BLDG 1A - LEVEL 01 - POWER	R1 - 5/06/20	PLANS REVIEW COMMENTS
MF-E2.3	BLDG 1A - LEVEL 02 - POWER BLDG 1A - LEVEL 03 - POWER BLDG 1A - LEVEL 04 - POWER	R1 - 5/06/20 R1 - 5/06/20	PLANS REVIEW COMMENTS PLANS REVIEW COMMENTS PLANS PEVIEW COMMENTS
MF-E2.5	BLDG 1A - LEVEL 04 - POWER BLDG 1A - LEVEL 05 - POWER BLDG 1A - ROOF LEVEL - POWER	R1 - 5/06/20 R1 - 5/06/20	PLANS REVIEW COMMENTS PLANS REVIEW COMMENTS
MF-E3.0	BLDG 1A - LEVEL 00 - COMMUNICATIONS BLDG 1A - LEVEL 01 - COMMUNICATIONS	R1 - 5/06/20	PLANS REVIEW COMMENTS
MF-E3.2 MF-E3.3	BLDG 1A - LEVEL 02 - COMMUNICATIONS BLDG 1A - LEVEL 03 - COMMUNICATIONS	R1 - 5/06/20 R1 - 5/06/20	PLANS REVIEW COMMENTS PLANS REVIEW COMMENTS
MF-E3.5	BLDG 1A - LEVEL 04 - COMMUNICATIONS BLDG 1A - LEVEL 05 - COMMUNICATIONS	R1 - 5/06/20 R1 - 5/06/20	PLANS REVIEW COMMENTS PLANS REVIEW COMMENTS
MF-E4.1	LEGEND_SCHEDULES_DETAILS ELECTRICAL DETAILS PANISH BOARDS	R1 - 5/06/20 R1 - 5/06/20	PLANS REVIEW COMMENTS PLANS REVIEW COMMENTS
MF-E4.3	PANELBOARDS PANELBOARDS PANELBOARDS		
MF-E4.5	PANELBOARDS PANELBOARDS		
	PANELBOARDS FEEDER RISER DIAGRAM		
	BUILDING 2 - LIFE SAFETY PLANS	R1 - 5/06/20	PLANS REVIEW COMMENTS
06.1 - B2 - TH - A	BUILDING 2 - ACCESSIBILITY INFORMATION RCHITECTURAL BUILDING 2 - FIRST FLOOR PLAN	R1 - 5/06/20 R2 - 5/26/20	PLANS REVIEW COMMENTS ADDENDUM 1
TH2.A1.2	BUILDING 2 - SECOND FLOOR PLAN BUILDING 2 - THIRD FLOOR PLAN	R1 - 5/06/20 R1 - 5/06/20	PLANS REVIEW COMMENTS PLANS REVIEW COMMENTS
TH2.A3.1	BUILDING 2 - REFLECTED CEILLING PLAN, ROOF PLAN & NOTES BUILDING 2 - EXTERIOR ELEVATIONS	R2 - 5/26/20 R2 - 5/26/20	ADDENDUM 1 ADDENDUM 1
TH2.A4.1	BUILDING 2 - 3D VIEWS BUILDING 2 - BUILDING SECTIONS BUILDING 3 - MALL SECTIONS	R1 - 5/06/20 R2 - 5/26/20	PLANS REVIEW COMMENTS ADDENDUM 1
TH2.A4.3	BUILDING 2 - WALL SECTIONS BUILDING 2 - WALL SECTIONS BUILDING 2 - WALL SECTIONS	R2 - 5/26/20 R2 - 5/26/20 R2 - 5/26/20	ADDENDUM 1 ADDENDUM 1 ADDENDUM 1
06.2 - B2 - TH - S TH2.S1.1	TRUCTURAL BUILDING 2 - STRUCTURAL PLANS	R2 - 5/26/20	ADDENDUM 1
	BUILDING 2 - FIRST FLOOR PLAN -HVAC		
TH2.M1.3	BUILDING 2 - SECOND FLOOR PLAN - HVAC BUILDING 2 - THIRD FLOOR PLAN - HVAC		
06.4 - B2 - TH - P	BUILDING 2 - ROOF PLAN - HVAC LUMBING BUILDING 2 - FIRST FLOOR PLAN - PLUMBING	<u> </u>	1
06.5 - B2 - TH - F	IRE PROTECTION BUILDING 2 - FLOOR PLANS - FIRE PROTECTION		
	LECTRICAL BUILDING 2 - FIRST FLOOR PLAN - ELECTRICAL		
TH2.E1.3	BUILDING 2 - SECOND FLOOR PLAN - ELECTRICAL BUILDING 2 - THIRD FLOOR PLAN - ELECTRICAL		
07.0 - B3 - TH - LI TH3.LS1.0 07.1 - B3 - TH - A	BUILDING 3 - LIFE SAFETY PLANS		
TH3.A1.1	BUILDING 3 - FIRST FLOOR PLAN BUILDING 3 - SECOND FLOOR PLAN	R1 - 5/06/20 R1 - 5/06/20	PLANS REVIEW COMMENTS PLANS REVIEW COMMENTS
TH3.A3.1	BUILDING 3 - REFLECTED CEILLING PLAN, ROOF PLAN & NOTES BUILDING 3 - EXTERIOR ELEVATIONS	R1 - 5/06/20 R1 - 5/06/20	PLANS REVIEW COMMENTS PLANS REVIEW COMMENTS
TH3.A4.1	BUILDING 3 - 3D VIEWS BUILDING 3 - BUILDING SECTIONS BUILDING 3 - WALL SECTIONS	R1 - 5/06/20 R1 - 5/06/20	PLANS REVIEW COMMENTS PLANS REVIEW COMMENTS
TH3.A4.3	BUILDING 3 - WALL SECTIONS BUILDING 3 - WALL SECTIONS BUILDING 3 - WALL SECTIONS	R2 - 5/26/20 R2 - 5/26/20 R2 - 5/26/20	ADDENDUM 1 ADDENDUM 1
	Building 3 - Wall Sections	R2 - 5/26/20	ADDENDUM 1
TH3.S1.1 07.3 - B3 - TH - <i>N</i>	BLDG.3 STRUCTURAL PLANS IECHANICAL	R2 - 5/26/20	ADDENDUM 1
TH3.M1.2	BUILDING 3 - FIRST FLOOR PLAN - HVAC BUILDING 3 - SECOND FLOOR PLAN - HVAC		
07.4 - B3 - TH - P	BUILDING 3 - ROOF PLAN - HVAC LUMBING BUILDING 3 - FLOOR PLANS - PLUMBING	1	
07.5 - B3 - TH - FI TH3.FP1.1	IRE PROTECTION BUILDING 3 - FLOOR PLANS - FIRE PROTECTION		
	BUILDING 3 - FIRST FLOOR PLAN - LIGHTING & COMMUNICATIONS		
TH3.E1.3	BUILDING 3 - FIRST FLOOR PLAN - POWER BUILDING 3 - SECOND FLOOR PLAN - LIGHTING & COMMUNICATIONS BUILDING 3 - SECOND FLOOR PLAN - POWER		
08.0 - B4 - TH - LI	BUILDING 3 - SECOND FLOOR PLAN - POWER IFE SAFETY BUILDING 4 - LIFE SAFETY PLANS	R1 - 5/06/20	PLANS REVIEW COMMENTS
	BUILDING 4 - ACCESSIBILITY INFORMATION	R1 - 5/06/20	PLANS REVIEW COMMENTS PLANS REVIEW COMMENTS
	BUILDING 4 - FIRST FLOOR PLAN BUILDING 4 - SECOND FLOOR PLAN	R1 - 5/06/20 R1 - 5/06/20	PLANS REVIEW COMMENTS PLANS REVIEW COMMENTS
	BUILDING 4 - THIRD FLOOR PLAN BUILDING 4 - REFLECTED CEILLING PLAN, ROOF PLAN & NOTES	R1 - 5/06/20 R1 - 5/06/20	PLANS REVIEW COMMENTS PLANS REVIEW COMMENTS
TH4.A1.2 TH4.A1.3 TH4.A2.1	DI III DINIC 4 EVTEDIOD ELEVATIONIC	R1 - 5/06/20	PLANS REVIEW COMMENTS
TH4.A1.2 TH4.A1.3 TH4.A2.1 TH4.A3.1 TH4.A3.2	BUILDING 4 - EXTERIOR ELEVATIONS BUILDING 4 - 3D VIEWS	5/00/20	
TH4.A1.2 TH4.A1.3 TH4.A2.1 TH4.A3.1 TH4.A3.2 TH4.A4.1 TH4.A4.2	BUILDING 4 - 3D VIEWS BUILDING 4 - BUILDING SECTIONS BUILDING 4 - WALL SECTIONS	3/00/20	
TH4.A1.2 TH4.A1.3 TH4.A2.1 TH4.A3.1 TH4.A3.2 TH4.A4.1 TH4.A4.2 TH4.A4.3	BUILDING 4 - 3D VIEWS BUILDING 4 - BUILDING SECTIONS BUILDING 4 - WALL SECTIONS BUILDING 4 - WALL SECTIONS BUILDING 4 - WALL SECTIONS	5/00/20	
TH4.A1.2 TH4.A1.3 TH4.A2.1 TH4.A3.1 TH4.A3.2 TH4.A4.1 TH4.A4.2 TH4.A4.3 TH4.A4.4 08.2 - B4 - TH - ST	BUILDING 4 - 3D VIEWS BUILDING 4 - BUILDING SECTIONS BUILDING 4 - WALL SECTIONS BUILDING 4 - WALL SECTIONS BUILDING 4 - WALL SECTIONS	R2 - 5/26/20 R2 - 5/26/20	ADDENDUM 1 ADDENDUM 1

SHEET NO.	SHEET NAME	CURRENT REVISION DATE	CURRENT REVISION DESCRIPTION
TH4.M1.4 08.4 - B4 - TH - F TH4.P1.1	BUILDING 4 - ROOF PLAN - HVAC		
08.5 - B4 - TH - F TH4.FP1.1 08.6 - B4 - TH - E	BUILDING 4 - FLOOR PLANS - FIRE PROTECTION		
TH4.E1.1 TH4.E1.2	BUILDING 4 - FIRST FLOOR PLAN - LIGHTING & COMMUNICATIONS BUILDING 4 - FIRST FLOOR PLAN - POWER		
TH4.E1.3 TH4.E1.4 TH4.E1.5	BUILDING 4 - SECOND FLOOR PLAN - LIGHTING & COMMUNICATIONS BUILDING 4 - SECOND FLOOR PLAN - POWER BUILDING 4 - THIRD FLOOR PLAN - LIGHTING & COMMUNICATIONS		
TH4.E1.6 09.0 - B5 - TH - L TH5.LS1.0	BUILDING 4 - THIRD FLOOR PLAN - POWER IFE SAFETY BUILDING 5 - LIFE SAFETY PLANS	R1 - 5/06/20	PLANS REVIEW COMMENTS
09.1 - B5 - TH - <i>F</i> TH5.A1.1 TH5.A1.2	BUILDING 5 - FIRST FLOOR PLAN BUILDING 5 - SECOND FLOOR PLAN	R1 - 5/06/20 R1 - 5/06/20	PLANS REVIEW COMMENTS PLANS REVIEW COMMENTS
TH5.A2.1 TH5.A3.1 TH5.A3.2	BUILDING 5 - REFLECTED CEIILING PLAN, ROOF PLAN & NOTES BUILDING 5 - EXTERIOR ELEVATIONS BUILDING 5 - 3D VIEWS	R1 - 5/06/20 R1 - 5/06/20	PLANS REVIEW COMMENTS PLANS REVIEW COMMENTS
TH5.A4.1 TH5.A4.2 TH5.A4.3	BUILDING 5 - BUILDING SECTIONS BUILDING 5 - WALL SECTIONS BUILDING 5 - WALL SECTIONS	R1 - 5/06/20 R2 - 5/26/20 R2 - 5/26/20	PLANS REVIEW COMMENTS ADDENDUM 1 ADDENDUM 1
TH5.A4.4 09.2 - B5 - TH - S TH5.S1.1	BUILDING 5 - WALL SECTIONS TRUCTURAL BUILDING 5 - STRUCTURAL PLANS	R2 - 5/26/20 R2 - 5/26/20	ADDENDUM 1 ADDENDUM 1
09.3 - B5 - TH - <i>N</i> TH5.M1.1 TH5.M1.2	MECHANICAL BUILDING 5 - FIRST FLOOR PLAN - HVAC BUILDING 5 - SECOND FLOOR PLAN - HVAC		
TH5.M1.3 09.4 - B5 -TH - P TH5.P1.1	BUILDING 5 - ROOF PLAN - HVAC LUMBING BUILDING 5 - FLOOR PLANS - PLUMBING		
09.5 - B5 - TH - F TH5.FP1.1 09.6 - B5 - TH - E	IRE PROTECTION BUILDING 5 - FLOOR PLANS - FIRE PROTECTION LECTRICAL		
TH5.E1.1 TH5.E1.2 10.0 - B6 - TH - L	FIRST FLOOR PLAN - ELECTRICAL SECOND FLOOR PLAN - ELECTRICAL		
TH6.LS1.0	BUILDING 6 - LIFE SAFETY PLANS ARCHITECTURAL BUILDING 6 - FIRST FLOOR PLAN	R1 - 5/06/20	PLANS REVIEW COMMENTS PLANS REVIEW COMMENTS
TH6.A1.1 TH6.A1.2 TH6.A2.1 TH6.A3.1	BUILDING 6 - FIRST FLOOR PLAN BUILDING 6 - SECOND & THIRD FLOOR PLAN BUILDING 6 - REFLECTED CEILLING PLAN, ROOF PLAN & NOTES BUILDING 6 - EXTERIOR ELEVATIONS	R1 - 5/06/20 R1 - 5/06/20 R2 - 5/26/20 R1 - 5/06/20	PLANS REVIEW COMMENTS PLANS REVIEW COMMENTS ADDENDUM 1 PLANS REVIEW COMMENTS
TH6.A3.2 TH6.A4.1	BUILDING 6 - 3D VIEWS BUILDING 6 - BUILDING SECTIONS	R1 - 5/06/20	PLANS REVIEW COMMENTS
TH6.A4.2 TH6.A4.3 TH6.A4.4	BUILDING 6 - WALL SECTIONS BUILDING 6 - WALL SECTIONS BUILDING 6 - WALL SECTIONS	R2 - 5/26/20 R2 - 5/26/20 R2 - 5/26/20	ADDENDUM 1 ADDENDUM 1
TH6.A4.5 10.2 - B6 - TH - S TH6.S1.1	BUILDING 6 - STRUCTURAL PLANS	R2 - 5/26/20 R2 - 5/26/20	ADDENDUM 1
10.3 - B6 - TH - <i>N</i> TH6.M1.1 TH6.M1.2	BUILDING 6 - FIRST FLOOR PLAN - HVAC BUILDING 6 - SECOND FLOOR PLAN - HVAC		
TH6.M1.3 TH6.M1.4 10.4 - B6 - TH - F	BUILDING 6 - THIRD FLOOR PLAN - HVAC BUILDING 6 - ROOF PLAN - HVAC PLUMBING		
	BUILDING 6 - FLOOR PLANS - PLUMBING FIRE PROTECTION BUILDING 6 - FLOOR PLANS - FIRE PROTECTION		
10.6 - B6 - TH - E TH6.E1.1 TH6.E1.2	FIRST FLOOR PLAN - ELECTRICAL SECOND FLOOR PLAN - ELECTRICAL		
TH6.E1.3 11.0 - B7 - TH - L TH7.LS1.0	THIRD FLOOR PLAN - ELECTRICAL IFE SAFETY BUILDING 7 - LIFE SAFETY PLANS		
11.1 - B7 - TH - <i>F</i> TH7.A1.1 TH7.A1.2	BUILDING 7 - FIRST FLOOR PLAN BUILDING 7 - SECOND & THIRD FLOOR PLAN	R1 - 5/06/20 R1 - 5/06/20	PLANS REVIEW COMMENTS PLANS REVIEW COMMENTS
TH7.A2.1 TH7.A3.1 TH7.A3.2	BUILDING 7 - REFLECTED CEIILING PLAN, ROOF PLAN & NOTES BUILDING 7 - EXTERIOR ELEVATIONS BUILDING 7 - 3D VIEWS	R2 - 5/26/20 R1 - 5/06/20	ADDENDUM 1 PLANS REVIEW COMMENTS
TH7.A4.1 TH7.A4.2 TH7.A4.3	BUILDING 7 - BUILDING SECTIONS BUILDING 7 - WALL SECTIONS BUILDING 7 - WALL SECTIONS	R1 - 5/06/20 R1 - 5/06/20 R1 - 5/06/20	PLANS REVIEW COMMENTS PLANS REVIEW COMMENTS PLANS REVIEW COMMENTS
TH7.A4.4 11.2 - B7 - TH - S TH7.S1.1	BUILDING 7 - WALL SECTIONS TRUCTURAL BUILDING 7 - STRUCTURAL PLANS	R2 - 5/26/20 R2 - 5/26/20	ADDENDUM 1 ADDENDUM 1
11.3 - B7 - TH - <i>N</i> TH7.M1.1 TH7.M1.2	BUILDING 7 - FIRST FLOOR PLAN - HVAC BUILDING 7 - SECOND FLOOR PLAN - HVAC		
TH7.M1.3 TH7.M1.4 11.4 - B7 - TH - F	BUILDING 7 - THIRD FLOOR PLAN - HVAC BUILDING 7 - ROOF PLAN - HVAC PLUMBING		
	BUILDING 7 - FLOOR PLANS - PLUMBING TRE PROTECTION BUILDING 7 - FLOOR PLANS - FIRE PROTECTION		
11.6 - B7 - TH - E TH7.E1.1 TH7.E1.2	LECTRICAL FIRST FLOOR PLAN - ELECTRICAL SECOND FLOOR PLAN - ELECTRICAL		
TH7.E1.3 12.0 - B8 - TH - L TH8.LS1.0	THIRD FLOOR PLAN - ELECTRICAL IFE SAFETY BUILDING 8 - LIFE SAFETY PLANS	R1 - 5/06/20	PLANS REVIEW COMMENTS
12.1 - B8 - TH - <i>F</i> TH8.A1.1 TH8.A1.2	ARCHITECTURAL BUILDING 8 - FIRST FLOOR PLAN BUILDING 8 - SECOND FLOOR PLAN	R1 - 5/06/20 R1 - 5/06/20	PLANS REVIEW COMMENTS PLANS REVIEW COMMENTS
TH8.A2.1 TH8.A3.1 TH8.A3.2	BUILDING 8 - REFLECTED CEIILING PLAN, ROOF PLAN & NOTES BUILDING 8 - EXTERIOR ELEVATIONS BUILDING 8 - 3D VIEWS	R1 - 5/06/20 R1 - 5/06/20	PLANS REVIEW COMMENTS PLANS REVIEW COMMENTS
TH8.A4.1 TH8.A4.2 TH8.A4.3	BUILDING 8 - BUILDING SECTIONS BUILDING 8 - WALL SECTIONS BUILDING 8 - WALL SECTIONS	R2 - 5/26/20 R2 - 5/26/20 R2 - 5/26/20	ADDENDUM 1 ADDENDUM 1 ADDENDUM 1
TH8.A4.4 TH8.A4.6 12.2 - B8 - TH - S	BUILDING 8 - WALL SECTIONS BUILDING 8 - WALL SECTIONS TRUCTURAL	R2 - 5/26/20 R2 - 5/26/20	ADDENDUM 1 ADDENDUM 1
TH8.S1.1 12.3 - B8 - TH - <i>N</i> TH8.M1.1	BUILDING 8 - STRUCTURAL PLANS MECHANICAL BUILDING 8 - FIRST FLOOR PLAN - HVAC	R2 - 5/26/20	ADDENDUM 1
TH8.M1.2 TH8.M1.3 12.4 - B8 - TH - F	BUILDING 8 - SECOND FLOOR PLAN - HVAC BUILDING 8 - ROOF PLAN - HVAC		
TH8.P1.1	BUILDING 8 - FLOOR PLANS - PLUMBING TRE PROTECTION BUILDING 8 - FLOOR PLANS - FIRE PROTECTION		
12.6 - B8 - TH - E TH8.E1.1 TH8.E1.2			
TH8.E1.3 TH8.E1.4 13.0 - B9 - TH - L	SECOND FLOOR PLAN - COMMUNICATIONS & LIGHTING SECOND FLOOR PLAN - POWER		
TH9.LS1.0 13.1 - B9 - TH - <i>F</i>	BUILDING 9 - LIFE SAFETY PLANS ARCHITECTURAL	R1 - 5/06/20	PLANS REVIEW COMMENTS PLANS REVIEW COMMENTS
TH9.A1.1 TH9.A1.2 TH9.A2.1	BUILDING 9 - FIRST FLOOR PLAN BUILDING 9 - SECOND & THIRD FLOOR PLAN BUILDING 9 - REFLECTED CEILLING PLAN, ROOF PLAN & NOTES BUILDING 9 - EXTERIOR ELEVATIONS	R1 - 5/06/20 R1 - 5/06/20 R1 - 5/06/20	PLANS REVIEW COMMENTS PLANS REVIEW COMMENTS
TH9.A3.1 TH9.A3.2 TH9.A4.1	BUILDING 9 - EXTERIOR ELEVATIONS BUILDING 9 - 3D VIEWS BUILDING 9 - BUILDING SECTIONS	R1 - 5/06/20 R1 - 5/06/20	PLANS REVIEW COMMENTS PLANS REVIEW COMMENTS
TH9.A4.2 TH9.A4.3 TH9.A4.4	BUILDING 9 - WALL SECTIONS BUILDING 9 - WALL SECTIONS BUILDING 9 - WALL SECTIONS	R2 - 5/26/20 R2 - 5/26/20 R2 - 5/26/20	ADDENDUM 1 ADDENDUM 1 ADDENDUM 1
A DO THE	BLDG. 9 STRUCTURAL PLANS	R2 - 5/26/20	ADDENDUM 1

CHEET NO	CHEET NAME	CURRENT REVISION	CURRENT REVISION
SHEET NO.	SHEET NAME	DATE	DESCRIPTION
TH9.M1.4 13.4 - B9 - TH - I	BUILDING 9 - ROOF PLAN - HVAC		
13.4 - 89 - 1H - 1 TH9.P1.1	BUILDING 9 - FLOOR PLANS - PLUMBING		
	FIRE PROTECTION		
TH9.FP1.1	BUILDING 9 - FLOOR PLANS - FIRE PROTECTION		
13.6 - B9 - TH - I	ELECTRICAL	1	
TH9.E1.1	FIRST FLOOR PLAN - ELECTRICAL		
TH9.E1.2	SECOND FLOOR PLAN - ELECTRICAL		
TH9.E1.3	THIRD FLOOR PLAN - ELECTRICAL		
	- GENERAL DETAILS		
TH.G1.1	TOWNHOMES DOOR & WINDOW ELEVATIONS, DTLS., NOTES	R1 - 5/06/20	PLANS REVIEW COMMENTS
TH.G1.2	TOWNHOMES DOOR DETAILS	R1 - 5/06/20	PLANS REVIEW COMMENTS
TH.G1.3	TOWNHOME WINDOW DETAILS	D	
TH.G1.4	TOWNHOME WINDOW DETAILS	R1 - 5/06/20	PLANS REVIEW COMMENTS
TH.G1.5	TOWNHOMES WINDOW DETAILS	R2 - 5/26/20	ADDENDUM 1
TH.G2.1	ENLARGED EXTERIOR STAIR PLANS		
TH.G2.2 TH.G2.3	ENLARGED EXTERIOR STAIR SECTIONS AND DETAILS ENLARGED INTERIOR EGRESS STAIR PLANS - BUILDING 2	R1 - 5/06/20	PLANS REVIEW COMMENTS
TH.G2.4			
TH.G2.4 TH.G2.5	ENLARGED INTERIOR EGRESS STAIR SECTIONS - BUILDING 2 ENLARGED INTERIOR EGRESS STAIR - BUILDING 4	R1 - 5/06/20 R1 - 5/06/20	PLANS REVIEW COMMENT: PLANS REVIEW COMMENT:
TH.G2.5	ENLARGED INTERIOR EGRESS STAIR - BUILDING 4 ENLARGED INTERIOR EGRESS STAIR - BUILDING 5	R1 - 5/06/20	PLANS REVIEW COMMENTS
TH.G2.6 TH.G2.7	ENLARGED INTERIOR EGRESS STAIR - BUILDING 5 ENLARGED INTERIOR EGRESS STAIR PLANS - BUILDING 6	R1 - 5/06/20	PLANS REVIEW COMMENTS
TH.G2.7	ENLARGED INTERIOR EGRESS STAIR PLANS - BUILDING 6 ENLARGED INTERIOR EGRESS STAIR SECTIONS - BUILDING 6	R1 - 5/06/20	PLANS REVIEW COMMENTS
TH.G2.8 TH.G2.9	ENLARGED INTERIOR EGRESS STAIR SECTIONS - BUILDING 6 ENLARGED INTERIOR EGRESS STAIR PLANS - BUILDING 7	K1 - 3/00/20	I LAINS KLVIEVV COMMENT
TH.G2.9 TH.G2.10	ENLARGED INTERIOR EGRESS STAIR PLANS - BUILDING 7 ENLARGED INTERIOR EGRESS STAIR SECTIONS - BUILDING 7		
TH.G2.10	ENLARGED INTERIOR EGRESS STAIRS - BUILDING 9		
TH.G2.11	ENLARGED INTERIOR EGRESS STAIR DETAILS		
TH.G2.13	ENLARGED INTERIOR STAIR PLANS -WINDERS IN TOWNHOMES 3, 4, 9		
TH.G2.14	ENLARGED INTERIOR STAIR PLANS - WINDERS IN TOWNHOME 8		
TH.G2.15	ENLARGED INTERIOR STAIR DETAILS		
TH.G3.1	TYPICAL ROOF DETAILS	R1 - 5/06/20	PLANS REVIEW COMMENTS
TH.G4.1	FIBER CEMENT PANEL - TYPICAL DETAILS	R1 - 5/06/20	PLANS REVIEW COMMENTS
TH.G4.2	TYPICAL FIRE PARTITION & WALL DETAILS	R2 - 5/26/20	ADDENDUM 1
TH.G5.1	ENLARGED FLOOR PLANS & INTERIOR ELEVATIONS - ACCESSIBLE UNIT PLAN 'J1'	R2 - 5/26/20	ADDENDUM 1
TH.G5.2	ENLARGED FLOOR PLANS & INTERIOR ELEVATIONS - UNIT NAME 'J2'	R2 - 5/26/20	ADDENDUM 1
TH.G5.3	ENLARGED FLOOR PLAN & INTERIOR ELEVATIONS - ACCESSIBLE UNIT 'K1'	R2 - 5/26/20	ADDENDUM 1
TH.G5.4	ENLARGED FLOOR PLANS & INTERIOR ELEVATIONS - UNIT NAME 'K2'	R2 - 5/26/20	ADDENDUM 1
TH.G5.5	ENLARGED FLOOR PLANS & INTERIOR ELEVATIONS - UNIT NAME 'L'	R2 - 5/26/20	ADDENDUM 1
TH.G5.6	ENLARGED FLOOR PLANS & INTERIOR ELEVATIONS - UNIT NAME 'M'	R2 - 5/26/20	ADDENDUM 1
TH.G5.7	ENLARGED FLOOR PLANS & INTERIOR ELEVATIONS - UNIT NAME 'N'	R2 - 5/26/20	ADDENDUM 1
TH.G5.8	ENLARGED FLOOR PLANS INTERIOR ELEVATIONS - ACCESSIBLE UNIT 'O'		ADDENDUM 1
TH.G5.9	ENLARGED FLOOR PLANS & INTERIOR ELEVATIONS - UNIT NAME 'P'	R2 - 5/26/20	ADDENDUM 1
TH.G5.10	ENLARGED FLOOR PLANS & INTERIOR ELEVATIONS - UNIT NAME 'Q'	R2 - 5/26/20	ADDENDUM 1
TH.G5.11	ENLARGED UNIT FLOOR PLANS & INTERIOR ELEVATIONS - UNIT NAMES 'R' AND 'S'	R2 - 5/26/20	ADDENDUM 1
TH.G5.12	ENLARGED FLOOR PLANS & INTERIOR ELEVATIONS - UNIT TYPE 'T'	R2 - 5/26/20	ADDENDUM 1
TH.G5.13	ENLARGED FLOOR PLANS & INTERIOR ELEVATIONS - TYPE 'U'	R2 - 5/26/20	ADDENDUM 1
TH.G6.1	DUMPSTER ENCLOSURE DETAILS	R1 - 5/06/20	PLANS REVIEW COMMENTS
	AL STRUCTURAL	111 3/00/20	TEXT CONTINE
TH.S1.0	STRUCTURAL NOTES	R2 - 5/26/20	ADDENDUM 1
TH.S2.1	STRUCTURAL DETAILS	R2 - 5/26/20	ADDENDUM 1
16 - TH GENERA	AL MECHANICAL		
THM.M2.1	SCHEDULES - HVAC		
THM.M2.2	DETAILS - HVAC		
17 - TH GENERA	AL PLUMBING	1	
THP.P2.1	PLUMBING SCHEDULES AND DETAILS		
THP.P3.1	PLUMBING RISERS		
THP.P3.2	PLUMBING RISERS		
THP.P3.3	PLUMBING RISERS		
18 - TH GENERA	AL FP		
THFP.FP2.1	FIRE PROTECTION DETAILS		
19 - TH GENERA			
THE.E1.1	SITE PLAN - LIGHTING		
THE.E2.1	LEGEND		
THE.E2.2	DETAILS		
THE.E2.3	BUILDING 2 PANELBOARDS & FEEDER DIAGRAM		
THE.E2.4	BUILDING 3 PANELBOARDS & FEEDER DIAGRAM		
THE.E2.5	BUILDING 4 PANELBOARDS & FEEDER DIAGRAM		
THE.E2.6	BUILDING 4 PANELBOARDS & FEEDER DIAGRAM		
THE.E2.7	BUILDING 5 PANELBOARDS & FEEDER DIAGRAM		
THE.E2.8	BUILDING 6 PANELBOARDS & FEEDER DIAGRAM		
	DUILDING 7 DANIELDOADDC 0 FFFDFD DIACDAAA		
THE.E2.9	BUILDING 7 PANELBOARDS & FEEDER DIAGRAM		
	BUILDING 8 PANELBOARDS & FEEDER DIAGRAM BUILDING 9 PANELBOARDS & FEEDER DIAGRAM		

KCDC KNOXVILLE'S COMMUNITY DEVELOPMENT CORPORATION AUSTIN HOMES REDEVELOPMENT PHASE 1A MULTI-FAMILY - BUILDING 1 BURGE DRIVE AND OLD VINE BLVD.

2240 Sutherland Avenue Tel 865.671.9060
Suite 105
Knoxville, TN 37919
United States

Gensler

11 East Madison Street Suite 300 Chicago, IL 60602 United States Tel 312.456.0123 Fax 312.456.0124

PERMIT SET

AUSTIN HOMES - PHASE 1A

Project Number 05/06/2020 193076

Description DRAWING INDEX

GENERAL NOTES:

- 1. EXISTING CONDITIONS ARE COMPILED FROM A SURVEY ISSUED BY CIVIL & ENVIRONMENTAL CONSULTANTS, INC. (CEC) ON DECEMBER 09, 2019 TO THE DESIGN TEAM.
- 2. THE CONTRACTOR SHALL VERIFY SITE INFORMATION, INCLUDING PROPERTY LINES, LIMITS OF WORK, EASEMENTS, BUILDINGS, ROADWAY CURB AND/OR GUTTERS, UTILITIES, DUCT BANKS, AND OTHER INFORMATION THAT MAY AFFECT THE SCOPE OF WORK INCLUDED ON THESE DRAWINGS. MORE SPECIFIC UTILITY INFORMATION IS INDICATED ON THE CIVIL ENGINEER DRAWINGS. CONTRACTOR SHALL REPORT ANY DISCREPANCY BETWEEN ACTUAL FIELD CONDITIONS AND WHAT IS SHOWN ON THE DRAWINGS TO THE OWNER'S REPRESENTATIVE IMMEDIATELY FOR DIRECTION ON HOW TO PROCEED
- 3. WHERE PLANS AND/OR SPECIFICATIONS ARE FOUND TO BE IN CONFLICT, OR WHERE VARIOUS ITEMS OF WORK ARE SEEN TO BE IN CONFLICT, THE CONTRACTOR SHALL IMMEDIATELY NOTIFY THE OWNER'S REPRESENTATIVE FOR DIRECTION PRIOR TO PROCEEDING WITH WORK.
- 4. THE CONTRACTOR SHALL BE RESPONSIBLE TO COORDINATE THE EFFORTS OF WORK WITH ALL TRADES THAT MAY COINCIDE WITH THE WORK IN THE LANDSCAPE DRAWINGS, AS APPLICABLE
- 5. ADVISE CONSTRUCTION AND OPERATIONS WITH THE PROJECT'S DESIGN CONSULTANTS FOR WORK INDICATED HEREIN. INFORM THE OWNER'S REPRESENTATIVE ON THE PREFERRED CONSTRUCTION SCHEDULE PRIOR TO THE WORK BEING PERFORMED. ADJUST CONSTRUCTION SCHEDULE ACCORDINGLY BASED ON A MUTUALLY-AGREEABLE TIMETABLE. NOTIF' THE OWNER'S REPRESENTATIVE IF CHANGE TO CONSTRUCTION SCHEDULE IS REQUIRED DUE TO DIFFERENCES IN ACTUAL CONSTRUCTION PROGRESS. INCLUDE THE PROJECT'S DESIGN CONSULTANTS AT PRE-INSTALLATION MEETINGS COVERING PORTIONS OF THE WORK THAT ARE RELATED. NOTIFY THE OWNER'S REPRESENTATIVE IF CHANGES TO CONSTRUCTION SCHEDULE ARE REQUIRED DUE TO DIFFERENCES IN ACTUAL CONSTRUCTION PROGRESS.
- 6. LIMIT OF WORK LINE IS NOTED ON DRAWINGS. CONTRACTOR IS RESPONSIBLE FOR ALL DAMAGE DUE TO OPERATIONS INSIDE AND OUTSIDE OF THE CONTRACT LIMIT LINE. ANY AREAS OUTSIDE THE LIMIT OF WORK THAT ARE DISTURBED SHALL BE RESTORED TO ITS ORIGINAL CONDITION AT NO ADDITIONAL COST TO THE OWNER. CONTRACTOR SHALL MEET LINE AND GRADE OF EXISTING CONDITIONS AT LIMIT OF WORK LINE.
- 7. THE CONTRACTOR SHALL ESTABLISH PERMANENT BENCH MARKS. MAINTAIN ALL ESTABLISHED BOUNDS AND BENCH MARKS AND REPLACE AS DIRECTED ANY WHICH ARE DESTROYED OR DISTURBED.
- 8. THE CONTRACTOR SHALL EMPLOY SPECIAL CARE IN SCHEDULING CONSTRUCTION SO AS TO MAINTAIN EXISTING VEHICULAR TRAFFIC PATTERNS, AND MINIMIZE DISRUPTION TO SURROUNDING PEDESTRIAN TRAFFIC. CONTRACTOR SHALL EMPLOY SPECIAL CARE TO PROTECT SAFETY OF PEDESTRIANS INSIDE AND OUTSIDE OF THE CONTRACT LIMIT LINE
- 9. LIMIT USE OF PREMISES TO WORK IN AREAS AS INDICATED. DO NOT DISTURB PORTIONS OF THE SITE BEYOND AREAS IN WHICH WORK IS INDICATED. KEEP DRIVEWAYS AND ENTRANCES SERVING PREMISES CLEAR AND AVAILABLE TO THE OWNER AND EMERGENCY VEHICLES AT ALL TIMES. DO NOT USE THESE AREAS FOR PARKING OR STORAGE OF MATERIALS SCHEDULE DELIVERIES TO MINIMIZE USE OF DRIVEWAYS AND ENTRANCES.
- 10. ALL REFUSE, DEBRIS, AND MISCELLANEOUS ITEMS TO BE REMOVED, THAT ARE NOT TO BE STOCKPILED FOR LATER USE ON THE PROJECT OR DELIVERED TO THE OWNER, SHALL BE LEGALLY DISPOSED OF OFF-SITE BY THE CONTRACTOR.
- 11. ALL POINTS OF CONSTRUCTION INGRESS AND EGRESS SHALL BE PROTECTED TO PREVENT TRACKING OF DEBRIS ONTO PUBLIC ROADS OR ABUTTING PROPERTY. ANY DEBRIS ON PUBLIC WAYS ORIGINATING FROM THE JOB SITE SHALL BE CLEANED BY THE CONTRACTOR.
- 12.CONTRACTOR SHALL REMOVE LITTER AND DEBRIS FROM THE PROJECT SITE AS REQUIRED TO KEEP SITE IN AN ORDERLY FASHION. DUST CONTROL MEASURES SHALL BE EXERCISED.
- 13. CARE SHALL BE TAKEN TO PRESERVE AND FULLY PROTECT THE INTEGRITY OF WATERPROOF MEMBRANE SYSTEMS WHERE THEY OCCUR ON SITE, AS APPLICABLE. CONTRACTOR SHALL REPAIR ANY AND ALL DAMAGE TO WATERPROOFING AT NO COST TO OWNER.
- 14. ALL ALTERATIONS TO THESE DRAWINGS MADE IN THE FIELD DURING CONSTRUCTION SHALL BE RECORDED BY THE CONTRACTOR ON "AS-BUILT DRAWINGS," AS SPECIFIED.

LAYOUT NOTES:

- 1. DIMENSIONS AS NOTED ARE TAKEN PERPENDICULAR TO FACE OF BUILDING OR WALL, BACK OF CURB, OR OTHER FIXED SITE IMPROVEMENT. AS APPLICABLE, UNLESS OTHERWISE NOTED. DIMENSIONS TO CENTERLINES ARE AS INDICATED. WHERE DIMENSIONS ARE INDICATED AS "EQUAL". REFERENCED ITEMS SHALL BE SPACED EQUALLY. AS MEASURED TO THEIR RESPECTIVE CENTERLINES. INSTALL INTERSECTING ELEMENTS AT 90-DEGREES TO EACH OTHER UNLESS OTHERWISI NOTED. ALL LINES OF PAVING AND/OR FENCING SHALL BE PARALLEL UNLESS OTHERWISE NOTED. MAINTAIN HORIZONTA ALIGNMENT OF ADJACENT ELEMENTS AS NOTED ON THE DRAWINGS. DIMENSIONS TAKEN TO CENTERLINE OF BUILDING COLUMN SHALL MEAN THE FIRST ROW OF COLUMNS CLOSEST TO THE FACE OF THE BUILDING. SEE CIVIL SURVEY DRAWINGS FOR CORRESPONDING COLUMN LINES.
- 2. WRITTEN DIMENSIONS TAKE PRECEDENCE OVER SCALE. WHERE INDICATED, NOTES AND DETAILS ON SPECIFIC DRAWINGS TAKE PRECEDENCE OVER GENERAL NOTES AND TYPICAL DETAILS.
- 3. REFERENCE TO NORTH REFERS TO TRUE NORTH. REFERENCE TO SCALE IS FOR FULL-SIZED DRAWINGS; DO NOT SCALE FROM REDUCED DRAWINGS
- 4. CONTRACTOR SHALL COORDINATE LOCATIONS OF ALL SITE FURNISHINGS, LIGHT POLE FOOTINGS, AND PLANTERS IN THE FIELD WITH OWNER'S REPRESENTATIVE AND THE UNIVERSITY OF TENNESSEE FACILITY SERVICES PROJECT MANAGER PRICE TO INSTALLATION.
- 5. CONTRACTOR SHALL STAKE ALL PATHS AND SIDEWALKS IN THE FIELD FOR APPROVAL BY THE OWNER'S REPRESENTATIVE PRIOR TO INSTALLATION.
- 6. ANY ROADWAY DIMENSIONS AND CENTERLINE SHOWN WITHIN LANDSCAPE DRAWINGS ARE FOR LAYOUT COORDINATION ONLY, VERIFY ROADWAY LAYOUT INFORMATION WITH CIVIL ENGINEER'S DRAWINGS PRIOR TO INSTALLATION.
- 7. HOLD TOP ELEVATIONS OF WALLS, FENCES, ETC. LEVEL UNLESS OTHERWISE NOTED.
- 8. CONTRACTOR SHALL PROVIDE FIELD-CONSTRUCTED MOCKUP SAMPLES FOR EACH PAVING TYPE AND WALL TYPE AS INDICATED ON THE DRAWINGS FOR APPROVAL BY OWNER'S REPRESENTATIVE PRIOR TO CONSTRUCTION. REFER TO SPECIFICATIONS FOR ADDITIONAL REQUIREMENTS FOR EACH RESPECTIVE FIELD-CONSTRUCTED MOCKUP SAMPLE.

MATERIAL NOTES:

- 1. STORAGE AREAS FOR THE GENERAL CONTRACTOR'S EQUIPMENT AND MATERIALS SHALL BE LOCATED WITHIN THE LIMITS OF WORK AND / OR CONSTRUCTION STAGING AREA AND SHALL BE APPROVED BY THE OWNER'S REPRESENTATIVE.
- 2. CONTRACTOR SHALL REVIEW IRRIGATION PLANS FOR SLEEVE LOCATIONS TO BE SET UNDER PAVING AND OTHER LOCATIONS PRIOR TO CONSTRUCTION OF PAVING.
- 3. WHERE SLEEVING UNDER PAVING IS REQUIRED FOR SITE LIGHTS AND/OR UTILITIES, REFER TO RELEVANT CIVIL AND UTILITY DRAWINGS. THE CONTRACTOR SHALL COORDINATE THE LOCATION AND SIZING OF SLEEVES WITH THE PROJECT ENGINEER PRIOR TO INSTALLATION.
- 4. PROVIDE EXPANSION JOINTS AT ALL CURBS, WALLS, STEPS, LIGHT POLE BASES, PULL BOXES, MANHOLES, TRAFFIC CONTROLLER BOXES AND AS SHOWN ON PLAN.
- 5. CONCRETE SLABS AND RAMP OR STEP FOOTINGS SHALL BE DOWELED INTO ABUTTING WALLS, FOUNDATIONS, AND FOOTINGS USING SLEEVED SMOOTH REINFORCEMENT BARS OF THE SAME SIZE AND SPACING UNLESS OTHERWISE NOTED.

ARTICLE 12 - LANDSCAPE REQUIREMENTS CITY OF KNOXVILLE | ZONING CODE

12.4 LANDSCAPE DESIGN STANDARDS

A. MINIMUM PLANTING SIZES

B. SPECIES DIVERSITY

- 1. EVERGREEN TREES MUST HAVE A MINIMUM HEIGHT OF (8) EIGHT FEET.
- SHADE TREES MUST HAVE A MINIMUM (2) TWO-INCH CALIPER.
- 3. SINGLE STEM ORNAMENTAL TREES MUST HAVE A MINIMUM TRUNK SIZE OF (2.5) TWO AND ONE-HALF INCHES IN CALIPER.
- MULTIPLE STEM ORNAMENTAL TREES MUST HAVE A MINIMUM HEIGHT OF (8) EIGHT FEET.
- 4. EVERGREEN OR DECIDUOUS SHRUBS OF (18) EIGHTEEN INCHES IN HEIGHT.

PLANT DIVERSITY REQUIREMENTS

	TOTAL # OF	MAX. # O	F 1 SPECIES	MIN. # C	F SPECIES	
	PLANTS	REQUIRED	PROVIDED	REQUIRED	PROVIDED	
DECIDUOUS SHADE TREES	53	40% = 22	39% = 21	5	6	
ORNAMENTAL TREES	0	100% = 0	100% = 0	0	0	
EVERGREEN TREES	37	40% = 15	100% = 37	5	1	VARIANCE REQUESTED
SHRUBS	520	30% = 156	26% = 133	10	10	
GROUNDCOVER / PERENNIALS	4,073	15% = 611	47% = 1910	15	9	VARIANCE REQUESTED

12.5 PARKING LOT PERIMETER LANDSCAPE YARD

- A. FOR PARKING LOTS OF 10,000 SQUARE FEET OR MORE IN AREA, A PERIMETER YARD MUST BE AT LEAST TEN FEET WIDE, AS MEASURED FROM THE EDGE OF THE PARKING LOT TO THE RIGHT-OF-WAY OR, IF UTILITIES EXIST, TO THE UTILITY MAINTENANCE
- D. PARKING LOTS LOCATED ON PROPERTIES DEVELOPED UNDER A COMMON OR UNIFIED DEVELOPMENT PLAN AND/OR WHICH HAVE A SHARED ACCESS AGREEMENT ARE NOT REQUIRED TO PROVIDE THE PERIMETER SCREENING AREA ALONG COMMON PROPERTY LINES WHERE PARKING AREAS ABUT.
- E. AREAS OF OFF-STREET PARKING AREAS THAT ABUT AN ALLEY ARE NOT REQUIRED TO INSTALL A PERIMETER LANDSCAPE YARD
- ALONG THE ALLEY FRONTAGE.

SIZE PROVIDED: 12,200 SF ABUTS AN ALLEY

SITE LANDSCAPE REQUIREMENTS

B.4. PLANTER BOXES: (PLANT AREA × 0.3) | (EA.) | N/A

TABLE 12-2: BUFFER YARD REQUIREMENTS

NON-RESIDENTIAL USE LOCATED WITHIN RESIDENTIAL DISTRICT

PARKING LOT FOR MULTI-FAMILY UNITS WITHIN A RESIDENTIAL DISTRICT

FENCE AND ANY BERM CANNOT BE LESS THAN SIX FEET OR EXCEED EIGHT FEET.

NON-RESIDENTIAL DISTRICT ABUTS A RESIDENTIAL DISTRICT

a. MINIMUM WIDTH: TWENTY FEET.

FOR THE REMAINING AREA.

B. PLANT AREA: (FACADE L.F. \times 0.6)

B.2. SHADE TREES: (PLANT AREA ÷ 50)

B.3. PLANTED LIVE GROUNDCOVER:

(0.6 × (FRONTAGE – SHRUB AREA))

PER USE STANDARDS (ARTICLE 9)

EVERGREEN.

B. BUFFER YARD TYPES

2. CLASS B BUFFER

VARIANCE REQUESTED

12.8 BUFFER YARDS

DEVELOPMENT

B.1. SHRUBS: (PLANT AREA \div 3)

12.6 INTERIOR PARKING LOT LANDSCAPE

INTERIOR PARKING LOT LANDSCAPE IS REQUIRED FOR ALL NEW PARKING LOTS AND VEHICULAR USE AREAS OF 20,000 SQUARE FEET OR MORE IN AREA, AND FOR ANY EXPANSIONS OR IMPROVEMENTS OF EXISTING PARKING LOTS AND VEHICULAR USE AREAS OF 20,000 SQUARE FEET OR MORE.

C. A MINIMUM OF ONE SHADE TREE MUST BE PROVIDED IN EVERY PARKING LOT ISLAND OR LANDSCAPE AREA FOR SINGLE ROW PARKING LOT ISLANDS AND TWO SHADE TREES FOR DOUBLE ROW PARKING LOT ISLANDS. IN ADDITION TO THE REQUIRED SHADE TREES, A MINIMUM OF 60% OF THE AREA OF EVERY PARKING LOT ISLAND MUST BE PLANTED IN SHRUBS, LIVE GROUNDCOVER PERENNIALS, OR ORNAMENTAL GRASSES, UNLESS THE PARKING LOT ISLAND OR LANDSCAPE AREA IS DESIGNED TO FACILITATE PEDESTRIAN ACCESS THROUGH THE PARKING LOT AS APPROVED IN LANDSCAPE PLAN REVIEW. STONE, MULCH, OR OTHER PERMEABLE LANDSCAPE MATERIALS MAY BE USED FOR ANY REMAINING AREA.

SIZE PROVIDED: 12,200 SF

12.7 SITE LANDSCAPE

- B. WHERE MULTI-FAMILY AND NONRESIDENTIAL (INCLUDING MIXED-USE) DEVELOPMENTS ARE LOCATED TEN FEET OR MORE FROM A STREET LOT LINE AND NO PARKING IS LOCATED IN FRONT OF THE STRUCTURE OR DEVELOPMENT AND WHERE ANY FAÇADE ABUTS ANY PARKING AREA, FOUNDATION LANDSCAPE MUST BE PLANTED AS DESCRIBED BELOW. THIS PLANTING AREA IS REQUIRED ALONG 60% OF THE LINEAR FAÇADE AREA. THIS PERCENTAGE MAY BE REDUCED TO ACCOMMODATE ENTRY DESIGN AND OTHER BUILDING FUNCTIONAL OPERATIONS DURING LANDSCAPE PLAN REVIEW.
- ONE SHRUB FOR EVERY THREE FEET. SHRUB LOCATIONS WITHIN THE PLANTING AREA MAY BE VARIED. BUT THE TOTAL
- NUMBER OF SHRUBS MUST BE NO LESS THAN AS REQUIRED IN THIS SECTION. 2. SHADE TREES ARE REQUIRED IN THE AMOUNT OF ONE TREE EVERY 50 FEET. TWO ORNAMENTAL TREES MAY BE SUBSTITUTED FOR ONE SHADE TREE AND MUST BE SPACED ONE ORNAMENTAL TREE EVERY 25 FEET. TREE LOCATIONS WITHIN THE
- PLANTING AREA MAY BE VARIED, BUT THE TOTAL NUMBER OF TREES MUST BE NO LESS THAN AS REQUIRED IN THIS SECTION. 60% OF THE LANDSCAPE AREA OUTSIDE OF SHRUB AND TREE MASSES MUST BE PLANTED IN LIVE GROUNDCOVER, PERENNIALS, OR ORNAMENTAL GRASSES. STONE, MULCH, OR OTHER PERMEABLE LANDSCAPE MATERIALS MAY BE USED FOR

2,569

BUFFER YARD CLASS

CLASS A BUFFER

CLASS B BUFFER

CLASS A BUFFER

THE REMAINING AREA. 4. PLANTED POTS AND/OR PLANTER BOXES MAY BE USED TO SATISFY UP TO 30% OF THE TOTAL LANDSCAPE AREA

N. BURGE DR.

REQUIRED LANDSCAPE FOR BUFFER YARDS BETWEEN LAND USES AND/OR ZONING DISTRICTS WITHIN THE REAR AND/OR SIDE YARDS.

b. MINIMUM REQUIRED SHRUBS: ONE SHRUB EVERY THREE FEET. A MINIMUM OF 50% OF THE SHRUBS MUST BE

MINIMUM REQUIRED TREES: ONE EVERGREEN TREE FOR EVERY 20 FEET AND ONE SHADE TREE FOR EVERY 30 FEET.

PERENNIALS, OR ORNAMENTAL GRASSES. STONE, MULCH, OR OTHER PERMEABLE LANDSCAPE MATERIALS MAY BE USED

e. 60% OF THE LANDSCAPE AREA OUTSIDE OF SHRUB AND TREE MASSES MUST BE PLANTED IN LIVE GROUNDCOVER,

D. WHEN A WALL OR SOLID FENCE IS INCORPORATED INTO A BUFFER YARD, IT MUST BE A MINIMUM OF SIX FEET UP TO A MAXIMUM OF EIGHT FEET. WHEN A WALL OR SOLID FENCE IS COMBINED WITH A BERM, THE COMBINED HEIGHT OF THE WALL OR SOLID

| (L.F.) | 153

C. BUFFER YARDS ARE REQUIRED AS DESCRIBED IN TABLE 12-2: BUFFER YARD REQUIREMENTS

PLANTING NOTES:

N. ALLEY

UNIT REQ'D PROVIDED REQ'D PROVIDED

HARRIET TUBMAN BOULEVARD

2,417

0

DETERMINED IN THE STANDARDS OF ARTICLE 9

- 1. THE LOCATION OF ALL TREES SHALL BE STAKED AND VERIFIED IN THE FIELD WITH THE LANDSCAPE ARCHITECT AND OWNER'S REPRESENTATIVE. DUE TO THE PREVALENCE OF SUB-SURFACE UTILITIES TREE LOCATIONS MAY SHIFT. NO TREE SHALL BE PLANTED WITHOUT THE EXPLICIT APPROVAL OF THE LANDSCAPE ARCHITECT AND OWNER'S REPRESENTATIVE.
- 2. ALL NEW PLANT MATERIAL SHALL CONFORM TO THE MINIMUM GUIDELINES ESTABLISHED WITHIN THE AMERICAN STANDARD FOR NURSERY STOCK, LATEST EDITION, PUBLISHED BY THE AMERICAN NURSERY AND LANDSCAPE ASSOCIATION (ANSI Z-60.1).
- 3. ALL PLANTS SHALL BE CONTAINER GROWN OR BALLED & BURLAP UNLESS OTHERWISE NOTED ON PLANT SCHEDULE.
- 1. THE CONTRACTOR SHALL SUPPLY ALL NEW PLANT MATERIAL IN QUANTITIES SUFFICIENT TO COMPLETE THE PLANTING SHOWN ON THE DRAWINGS.
- 5. QUANTITIES SHOWN IN THE PLANT SCHEDULE ARE FOR REFERENCE ONLY. THE CONTRACTOR SHALL VERIFY AND SHALL BE RESPONSIBLE FOR THE PROVISION OF SUFFICIENT PLANT QUANTITIES TO MEET THE SPECIFIED PLANT SPACING REQUIREMENTS FOR EACH PLANT BED SHOWN IN THE PLANS.
- 6. ALL NEW TREES AND SPECIMEN SHRUBS SHALL BE TAGGED AND APPROVED BY THE OWNER'S REPRESENTATIVE PRIOR TO INSTALLATION.
- 7. NO TREES SHALL BE PLANTED BEFORE ACCEPTANCE OF ROUGH GRADING. TREES SHALL BEAR SAME RELATIONSHIP TO FINISH GRADE AS THEY BORE TO PREVIOUS GRADE. SEE TREE PLANTING DETAIL.
- 8. STAKE LOCATION OF ALL PROPOSED TREES, PLANTS, & METAL BED EDGES FOR APPROVAL BY THE OWNER'S REPRESENTATIVE PRIOR TO THE COMMENCEMENT OF PLANTING.
- 9. ALL EXISTING TREES TO REMAIN SHALL BE PROPERLY PROTECTED, PRUNED AND FERTILIZED PER THE SPECIFICATIONS.
- 10. ALL LAWN AREAS DISTURBED BY CONSTRUCTION OPERATIONS INSIDE & OUTSIDE THE LIMIT-OF-WORK SHALL RECEIVE FOUR INCHES OF TOPSOIL AND SOD AS SPECIFIED.
- 11.ALL PLANT BEDS ARE TO RECEIVE MULCH AS SPECIFIED. SEE MULCH DETAIL 2/L2.6 AND SPECIFICATIONS FOR ADDITIONAL INFORMATION.
- 12.ANY PROPOSED SUBSTITUTIONS OF PLANT SPECIES SHALL BE MADE WITH PLANTS OF EQUIVALENT OVERALL FORM, HEIGHT, BRANCHING HABIT, AND ONLY AS APPROVED BY THE OWNER'S REPRESENTATIVE.

N. PARKING LOT | S. PARKING LOT | W. DRIVE AISLE | E. DRIVE AISLE


3,838

721

13.PREPARE ALL PLANT BEDS WITH PLANTING SOIL TO A MINIMUM DEPTH MATCHING THE DETAILS SHOWN HEREIN. PLANTING SOIL SHALL BE CONTINUOUS THROUGHOUT ENTIRE PLANT BED.

	ABBREV	IATIONS:
	ADJ	ADJACENT (LAYOUT)
	ALIGN	ALIGN
	BS	BOTTOM OF STEP
	BW	BOTTOM OF WALL
		CAST-IN-PLACE (CONCRETE)
	CIVIL or C.E	CIVIL ENGINEER
	CL	CENTERLINE (LAYOUT)
	CONC	CENTERLINE (LAYOUT) CONCRETE
	DIA	_ DIAMETER (LAYOUT)
	ELEV	_ ELEVATION
	EJ	_ expansion joint (concrete)
	EQ.	EQUAL (LAYOUT)
	FG or F.G	FINISHED GRADE (PLANTING) FINISHED SURFACE (PAVING)
	FS or F.S	_ FINISHED SURFACE (PAVING)
	HP or H.P	HIGH POINT (GRADIENT) _ LANDSCAPE ARCHITECT
		_ LIMIT OF WORK
		_ LOW POINT (GRADIENT)
	MAX	
	MIN	MINIMUM
	NIC or N.I.C	NOT IN CONTRACT
	NIS or N.I.S.	NOTTO SCALE
	OC or O.C	_ on-center (layout)
	OD or O.D	OUTSIDE DIAMETER (LAYOUT)
	PA or P.A	PLANTING AREA
		PERFORATED
		POINT OF BEGINNING (LAYOUT
	PL	PROPERTY LINE
	R	_ RADIUS (LAYOUT)
	REF	REFERENCE OR REFER TO
	REINF.	_ REINFORCEMENT
	S.E	_ STRUCTURAL ENGINEER
	SPECS	_ CONTRACT SPECIFICATIONS
)	S/S	_ STAINLESS STEEL
(TBD	_ TO BE DETERMINED
)	TC	_ TOP OF CURB (ELEVATION)
,	TG	TOP OF GRATE (ELEVATION)
1	TS	_ TOP OF STEP (ELEVATION) TOP OF STRUCTURAL SLAB
•	TOSS TW	TOP OF STRUCTURAL SLAB TOP OF WALL (ELEVATION)
	TYP.	TYPICAL
	W/ or W-	WITH
	vv/ OI vv	vviii i

LAYOUT LEGEND:

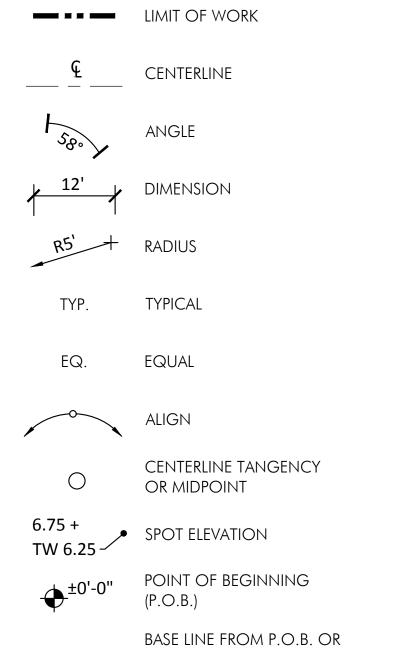

REFERENCE POINT

Tel 312.456.0123

Fax 312.456.0124

KNOXVILLE'S COMMUNITY

PHASE 1A

2240 Sutherland Avenue

Knoxville, TN 37919

United States

Suite 300

Chicago, IL 60602

United States

Suite 105

DEVELOPMENT CORPORATION

AUSTIN HOMES REDEVELOPMENT

BURGE DRIVE AND HARRIET TUBMAN ST.

№ 05/26/2020 ADDENDUM



Seal / Signature

05.06.2020


AUSTIN HOMES - PHASE 1A

Project Number 05/06/2020 123136 Description

LANDSCAPE NOTES & LEGENDS

L0.1

Scale

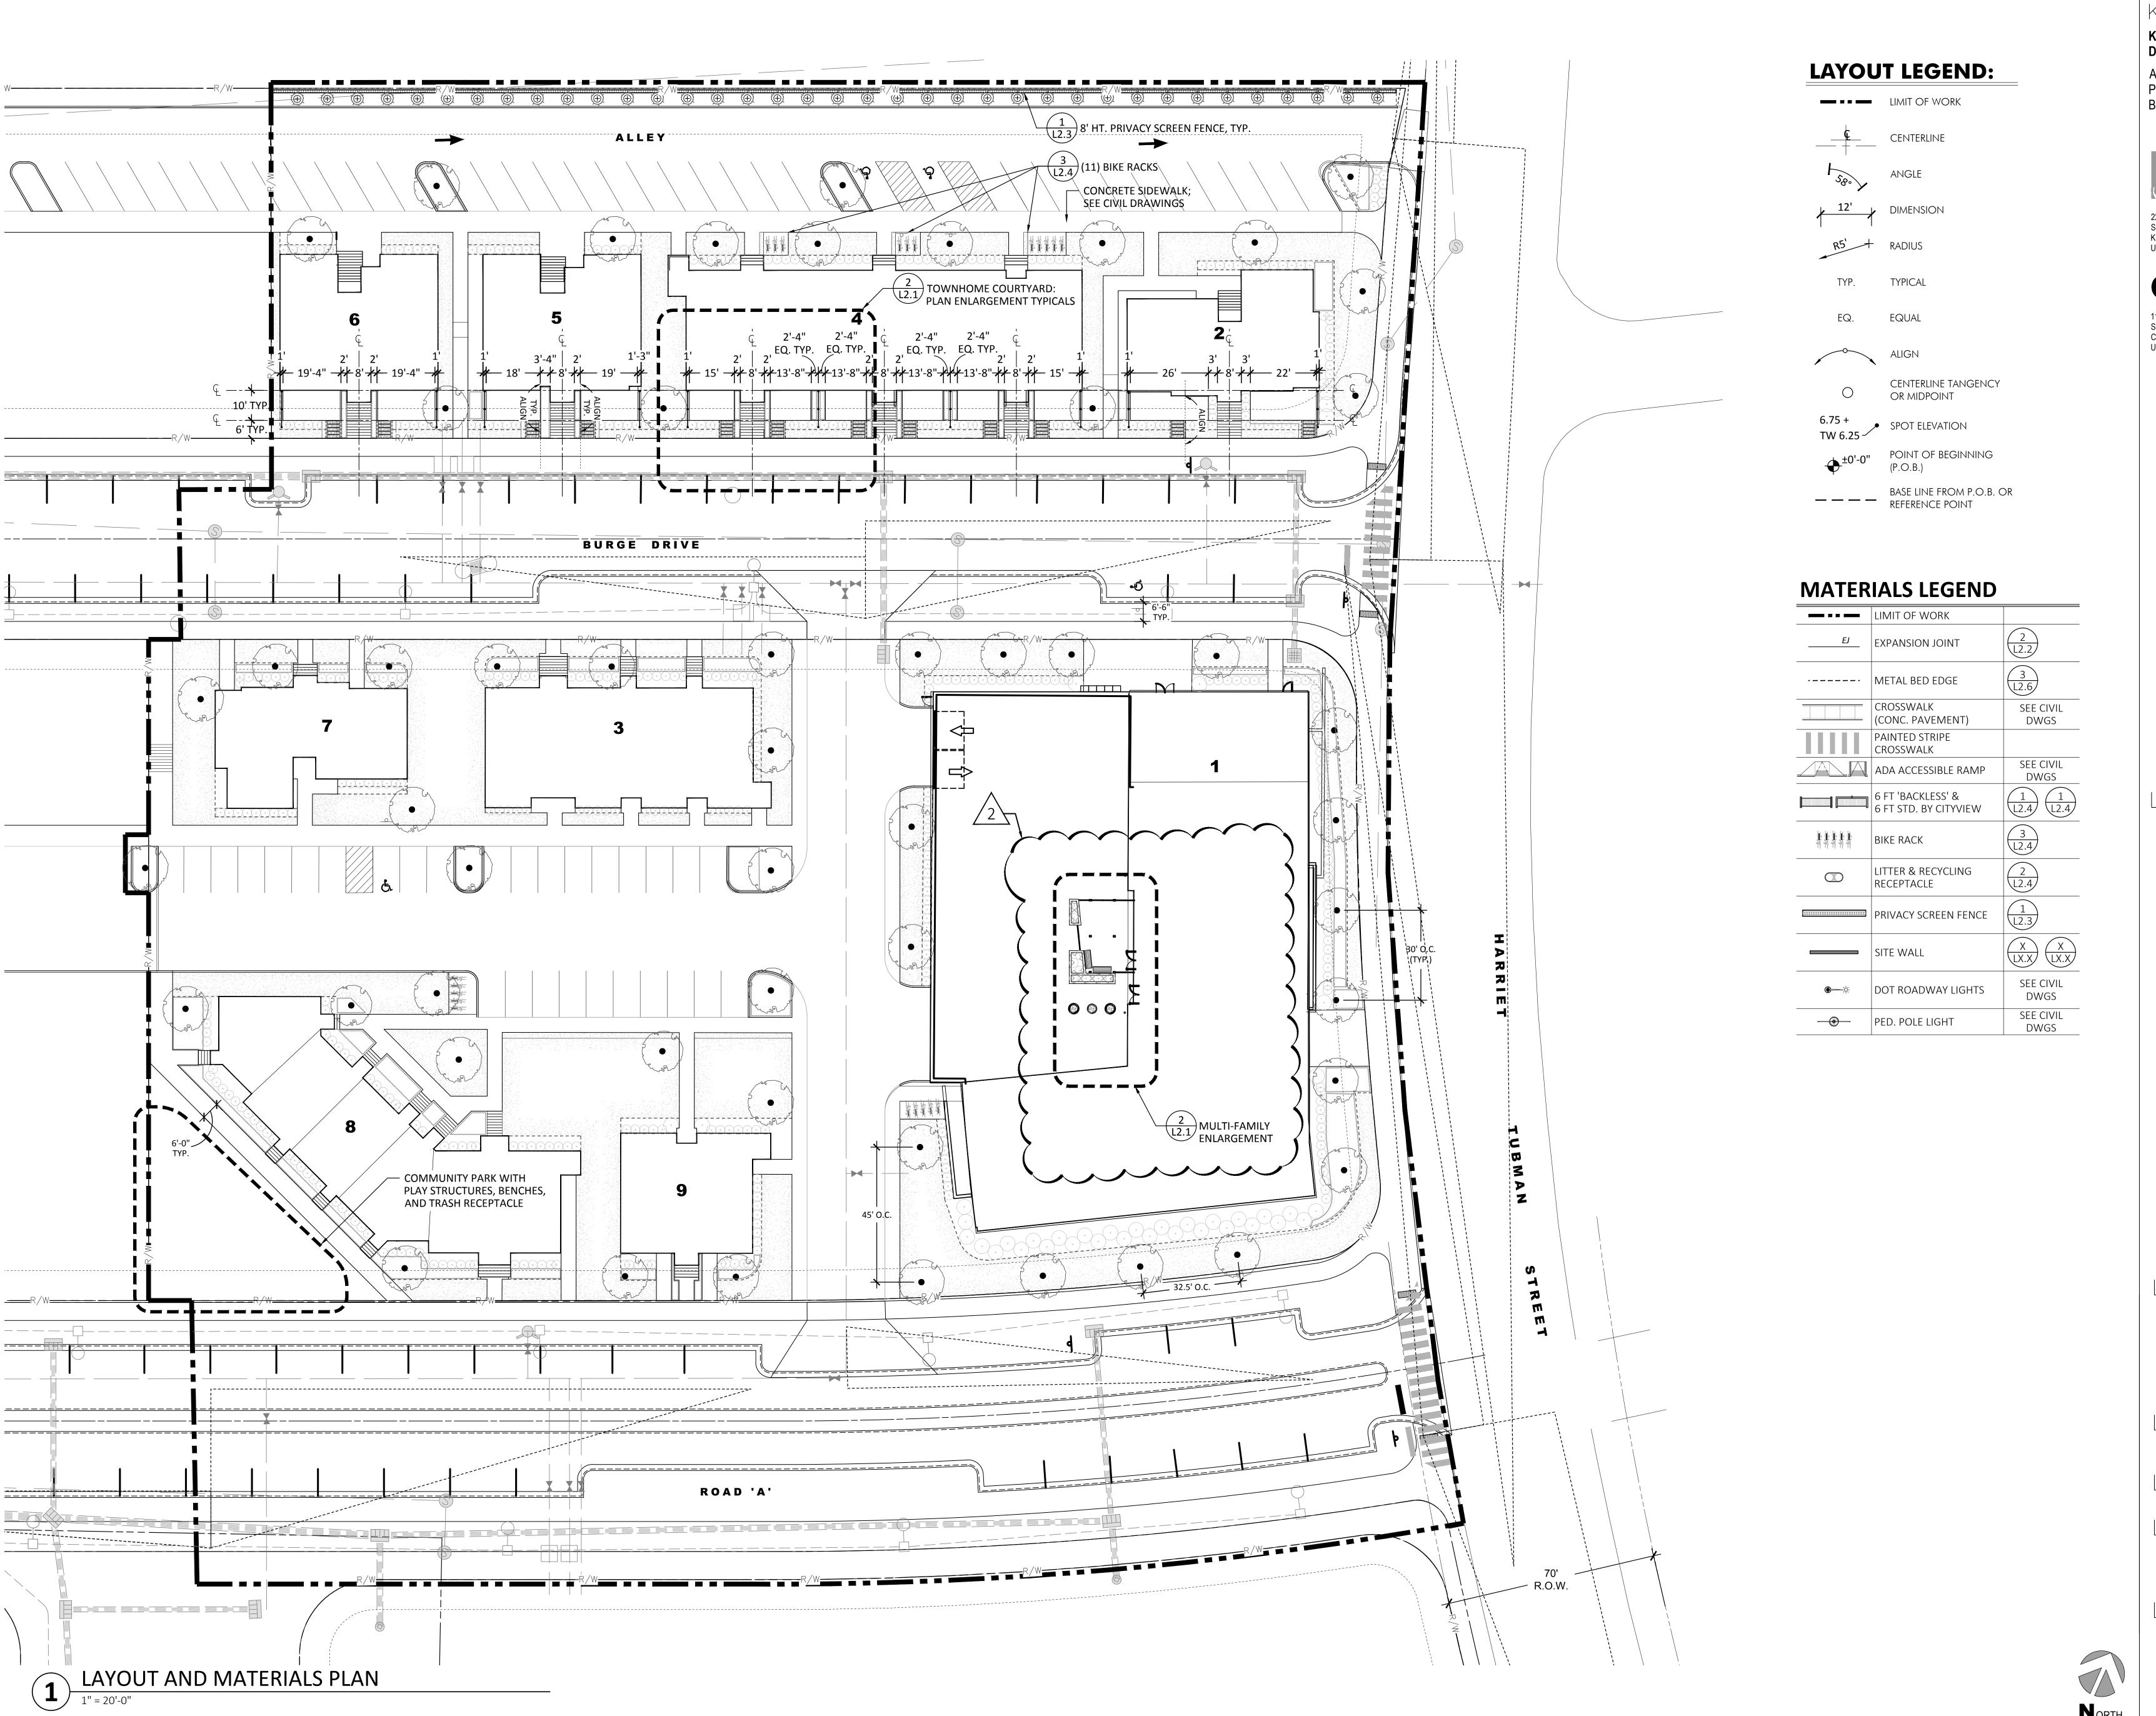

KNOXVILLE'S COMMUNITY **DEVELOPMENT CORPORATION AUSTIN HOMES REDEVELOPMENT** PHASE 1A BURGE DRIVE AND HARRIET TUBMAN ST.



2240 Sutherland Avenue Suite 105 Knoxville, TN 37919 United States Tel 865.671.9060


Gensler

11 East Madison Street Suite 300 Chicago, IL 60602 United States Tel 312.456.0123 Fax 312.456.0124

2 05/26/2020 ADDENDUM



Seal / Signature

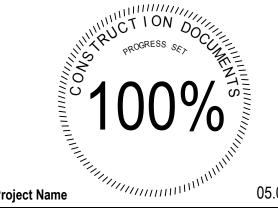


AUSTIN HOMES - PHASE 1A

Project Number

Description LANDSCAPE LAYOUT &

05/06/2020

MATERIALS PLAN

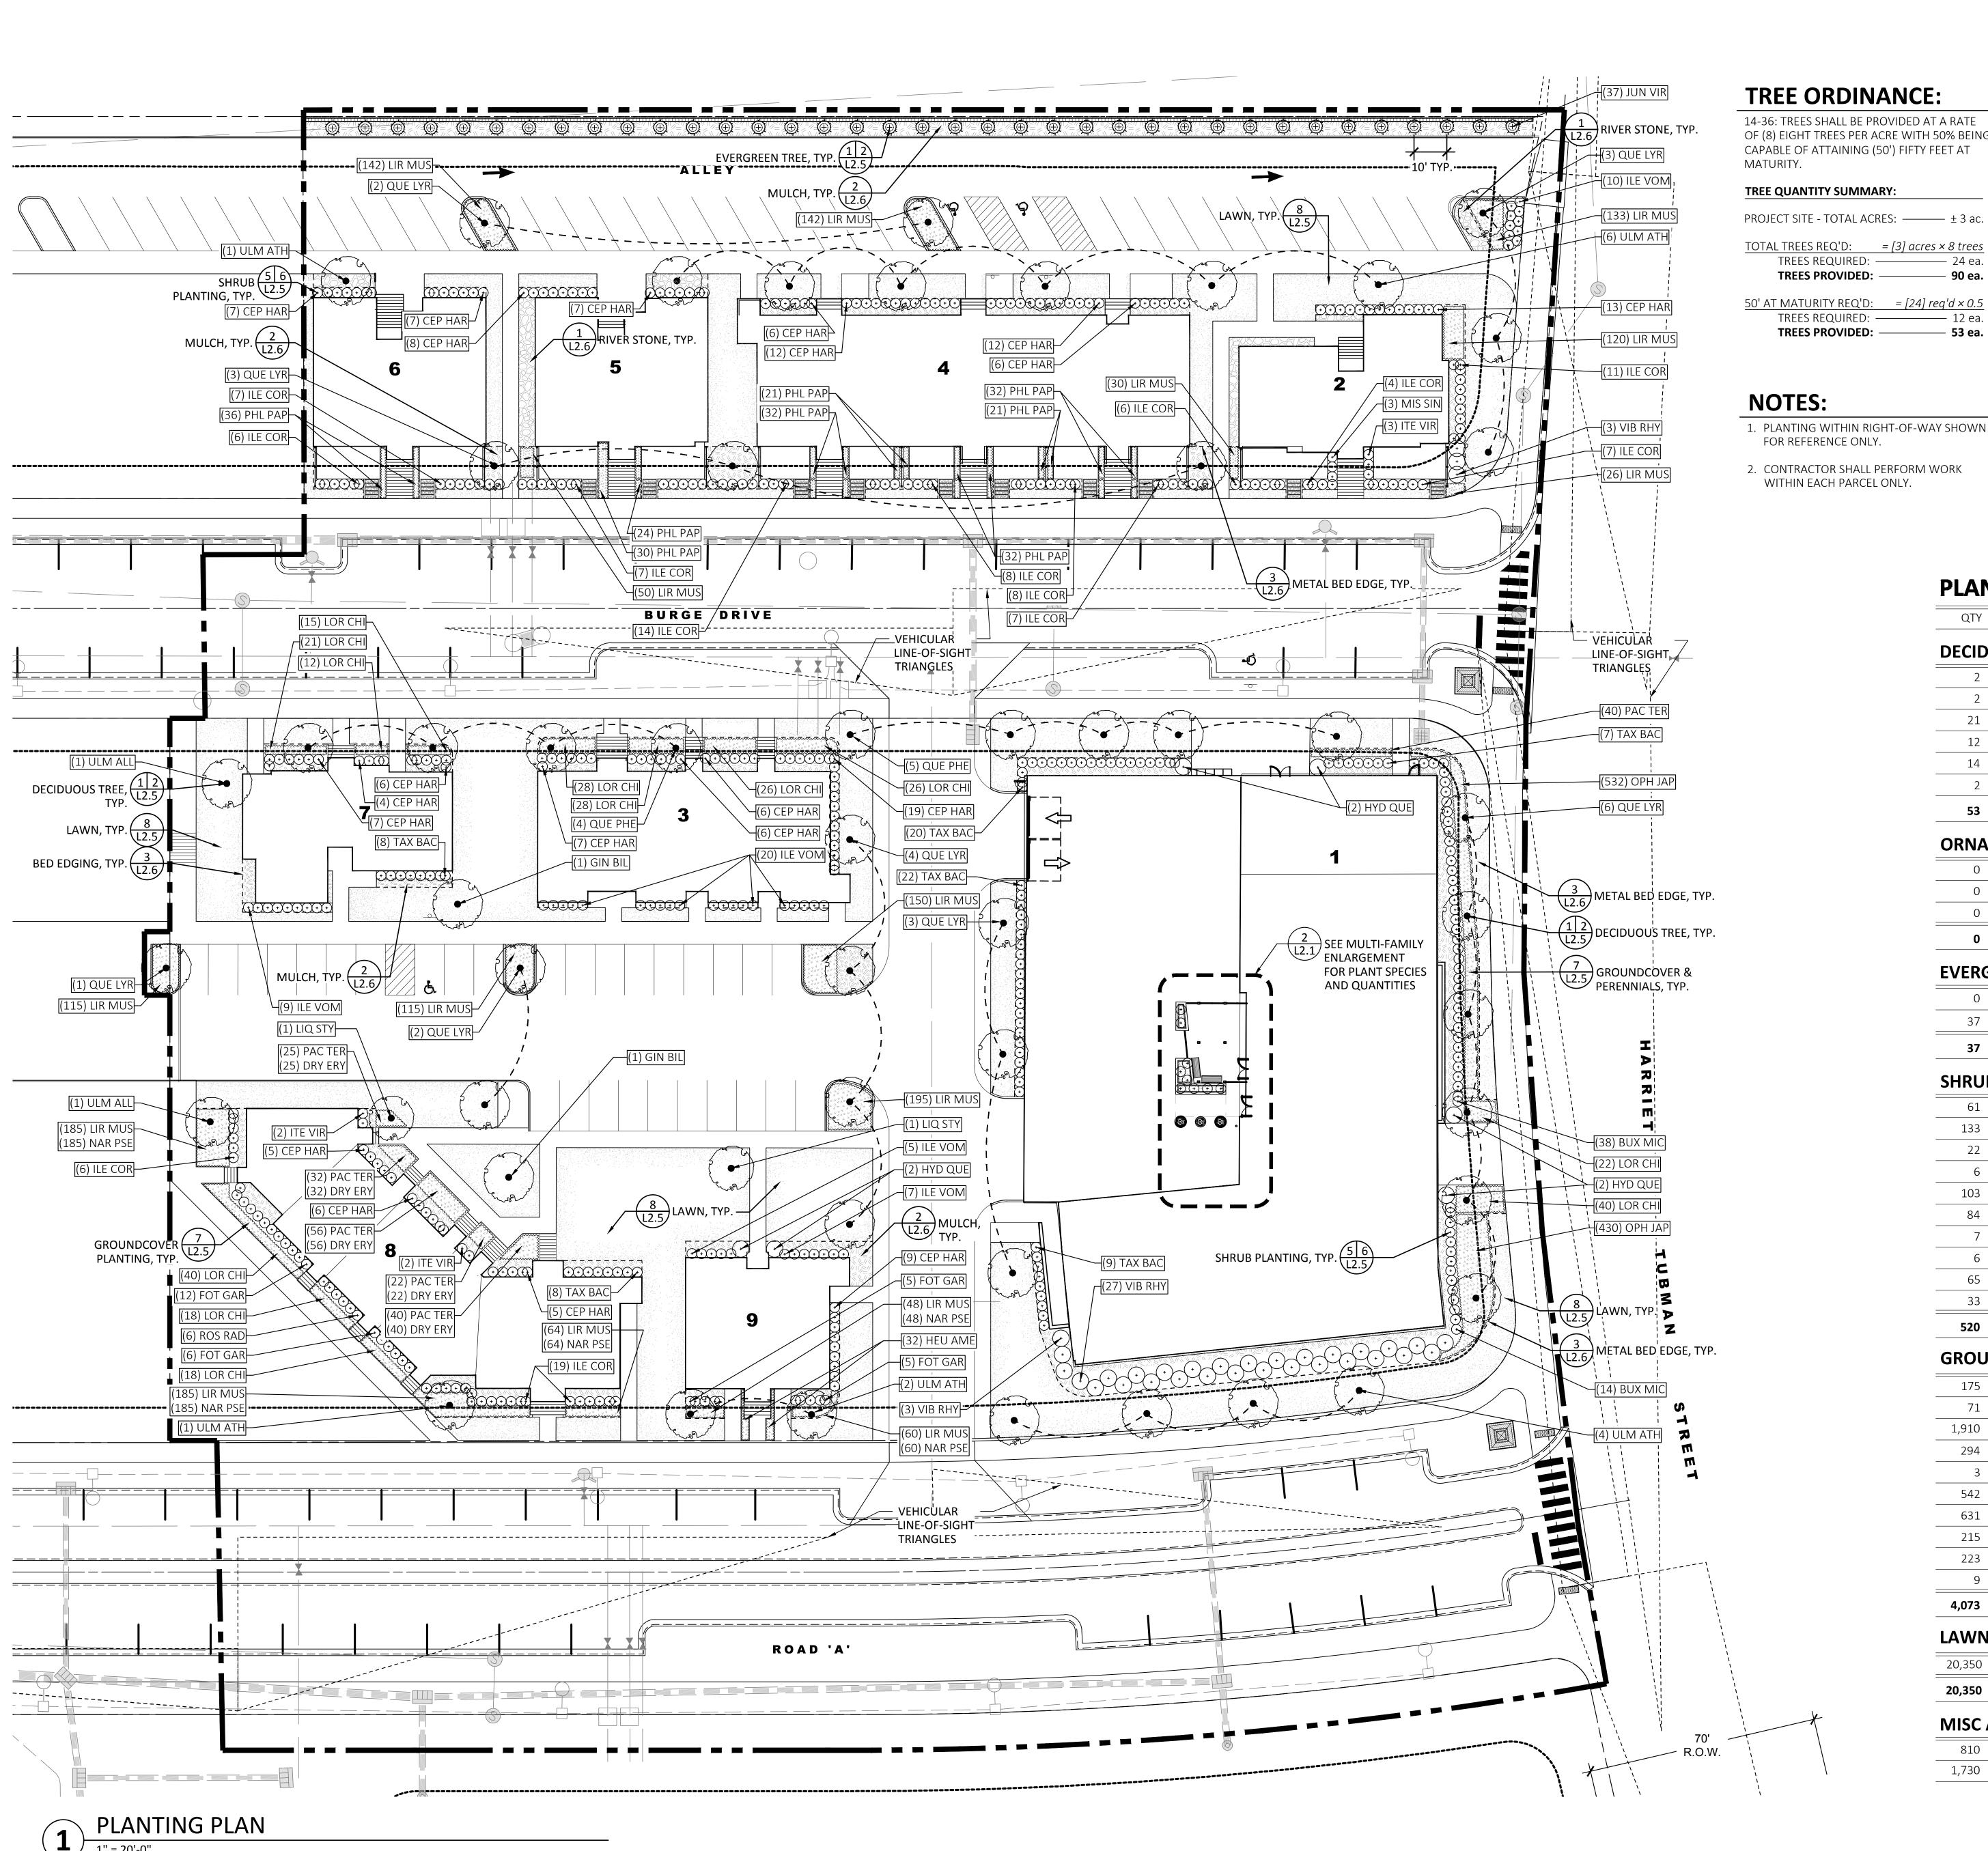

TREE ORDINANCE:

14-36: TREES SHALL BE PROVIDED AT A RATE OF (8) EIGHT TREES PER ACRE WITH 50% BEING CAPABLE OF ATTAINING (50') FIFTY FEET AT

PROJECT SITE - TOTAL ACRES: — ± 3 ac.

TREES REQUIRED: — 24 ea. TREES PROVIDED: — 90 ea. 50' AT MATURITY REQ'D: $= [24] req'd \times 0.5$ TREES REQUIRED: — 12 ea.

- 1. PLANTING WITHIN RIGHT-OF-WAY SHOWN
- 2. CONTRACTOR SHALL PERFORM WORK WITHIN EACH PARCEL ONLY.

PLANTING LEGEND

	I LAIVI	IIIO EEGEIID	
i	E No Co	DECIDUOUS / SHADE TREE	1 L2.5 L2.5
		ORNAMENTAL / FLOWERING TREE	1 L2.5 L2.5
	**************************************	EVERGREEN TREE	1 L2.5 L2.5
	+ +	SHRUBS	5 L2.5 6 L2.5
	V V V V V V V V V V	GROUNDCOVER & PERENNIALS	7 L2.5
		LAWN	8 L2.5
_		RIVER STONE	1 L2.6
		MULCH BED	2 L2.6

PLANT SPECIES

CALLOUT & QUANTITY

QTY	ABBREV.	SCIENTIFIC NAME
DECIDUO	OUS SHA	DE TREES
2 EA	GIN BIL	Ginkgo biloba 'Golden Globe'
2 EA	LIQ STY	Liquidambar Styraciflua 'Rotundiloba'
21 EA	QUE LYR	Quercus lyrata 'Highbeam'
12 EA	QUE PHE	Quercus phellos 'Hightower',
14 EA	ULM ATH	Ulmus parvifolia 'Emer I'

53 TOTAL

FVFRGRFFN TRFFS

0 TOTAL

O EA	ILE BRU	<i>Ilex x</i> 'Emily Bruner'
37 EA	JUN VIR	Juniperus virginiana 'Skyrocket'
'		

SHRUBS

61	EA	BUX MIC	Buxus microphylla japonica 'Winter Gem'
133	EA	CEP HAR	Cephalotaxus harringtonia 'Duke Gardens
22	EA	FOT GAR	Fothergilla gardenii 'Mt. Airy'
6	EA	HYD QUE	Hydrangea quercifolia 'Snowflake'
103	EA	ILE COR	<i>Ilex cornuta</i> 'Carissa'
84	EA	ILE VOM	<i>Ilex vomitoria</i> 'Stoke's Dwarf'
7	EA	ITE VIR	Itea virginica 'Henry's Garnette'
6	EA	ROS RAD	Rosa radrazz 'Knockout'
65	EA	TAX BAC	Taxus baccata 'Repandens'
33	EA	VIB RHY	Viburnum x rhytidophyllum

GROUNDCOVER / PERENNIALS / BULBS

		•
175 EA	DRY ERY	Dryopteris erythrosora 'Brilliance'
71 EA	HEU AME	Heuchera Americana 'Plum Pudding'
1,910 EA	LIR MUS	Liriope muscari 'Big Blue'
294 EA	LOR CHI	Loropetalum chinensis 'Jazz Hands Mini'
3 EA	MIS SIN	Miscanthus Sinensis 'Zebrinus'
542 EA	NAR PSE	Narcissus pseudonarcissus
631 EA	ОРН ЈАР	Ophiopogon japonicus 'Nanus'
215 EA	PAC TER	Pachysandra terminalis 'Green Sheen'
223 EA	PHL PAP	Phlox x hybrida 'Paparazzi Jagger'
9 EA	SCH SCO	Schizachyrium scoparium 'Standing Ovation

4,073 TOTAL

LAWN / TURF

TURF TYPE FESCUE SOD (SEE SPECS.)

MISC ACCESSORIES

810 SF	RIVER STONE MULCH (3"- 6" DIA.)
1,730 LF	BLACK METAL BED EDGING; SEE PLANS ANI

KNOXVILLE'S COMMUNITY

PHASE 1A

2240 Sutherland Avenue

Gensler

△ Date Description

△ 05/26/2020 ADDENDUM

Seal / Signature

Project Number

123136

Description

Knoxville, TN 37919

11 East Madison Street Suite 300 Chicago, IL 60602 United States

Suite 105

United States

DEVELOPMENT CORPORATION

AUSTIN HOMES REDEVELOPMENT

BURGE DRIVE AND HARRIET TUBMAN ST.

Tel 865.671.9060

Tel 312.456.0123 Fax 312.456.0124

	PLANI	ING LEGEND	
-		DECIDUOUS / SHADE TREE	1 L2.5 2 L2.5
		ORNAMENTAL / FLOWERING TREE	1 L2.5 2 L2.5
	Danker & State of the State of	EVERGREEN TREE	1 L2.5 2 L2.5
	+ + +	SHRUBS	5 L2.5 6 L2.5
	V V V V V V V V V V	GROUNDCOVER & PERENNIALS	7 L2.5
		LAWN	8 L2.5
_		RIVER STONE	1 L2.6
		MULCH BED	2 L2.6
		METAL BED EDGING	3 L2.6

PLANT SCHEDULE

XXX XXX

DECIDUC	OUS SHA	DE TREES
2 EA	GIN BIL	Ginkgo biloba 'Golden Globe'
2 EA	LIQ STY	Liquidambar Styraciflua 'Rotundiloba'
21 EA	QUE LYR	Quercus lyrata 'Highbeam'
12 EA	QUE PHE	Quercus phellos 'Hightower',
14 EA	ULM ATH	Ulmus parvifolia 'Emer I'
2 EA	ULM ALL	Ulmus parvifolia 'Emer II'

ORNAMENTAL TREES

O EA	CER CAN	Cercis Canadensis 'Forest Pansy'					
O EA	COR BRA	Cornus florida 'Cherokee Brave'					
O EA	COR PRI	Cornus florida 'Cherokee Princess'					

EVENGNI	ECIN INCE	3
O EA	ILE BRU	<i>Ilex x</i> 'Emily Bruner'
37 EA	JUN VIR	Juniperus virginiana 'Skyrocket'

61 E	ĒΑ	BUX MIC	Buxus microphylla japonica 'Winter Gem'
133 E	ĒΑ	CEP HAR	Cephalotaxus harringtonia 'Duke Gardens'
22 E	ĒΑ	FOT GAR	Fothergilla gardenii 'Mt. Airy'
6 E	ĒΑ	HYD QUE	Hydrangea quercifolia 'Snowflake'
103 E	ĒΑ	ILE COR	Ilex cornuta 'Carissa'
84 E	ΕΑ	ILE VOM	<i>Ilex vomitoria</i> 'Stoke's Dwarf'
7 E	ΞA	ITE VIR	Itea virginica 'Henry's Garnette'
6 E	ĒΑ	ROS RAD	Rosa radrazz 'Knockout'
65 E	ĒΑ	TAX BAC	Taxus baccata 'Repandens'
33 E	ĒΑ	VIB RHY	Viburnum x rhytidophyllum
520 1	тот	AL	

-	175 E	Α	DRY ERY	Dryopteris erythrosora 'Brilliance'
	71 E	Α	HEU AME	Heuchera Americana 'Plum Pudding'
	1,910 E	Α	LIR MUS	Liriope muscari 'Big Blue'
	294 E	Α	LOR CHI	Loropetalum chinensis 'Jazz Hands Mini'
	3 E	Α	MIS SIN	Miscanthus Sinensis 'Zebrinus'
	542 E	Α	NAR PSE	Narcissus pseudonarcissus
	631 E	Α	ОРН ЈАР	Ophiopogon japonicus 'Nanus'
-	215 E	Α	PAC TER	Pachysandra terminalis 'Green Sheen'
-	223 E	Α	PHL PAP	Phlox x hybrida 'Paparazzi Jagger'
-	9 E	A	SCH SCO	Schizachyrium scoparium 'Standing Ovation'
-				

20,350 TOTAL


810 SF	RIVER STONE MULCH (3"- 6" DIA.)
1,730 LF	BLACK METAL BED EDGING; SEE PLANS AND


AUSTIN HOMES - PHASE 1A

LANDSCAPE PLANTING PLAN


05.06.2020

05/06/2020

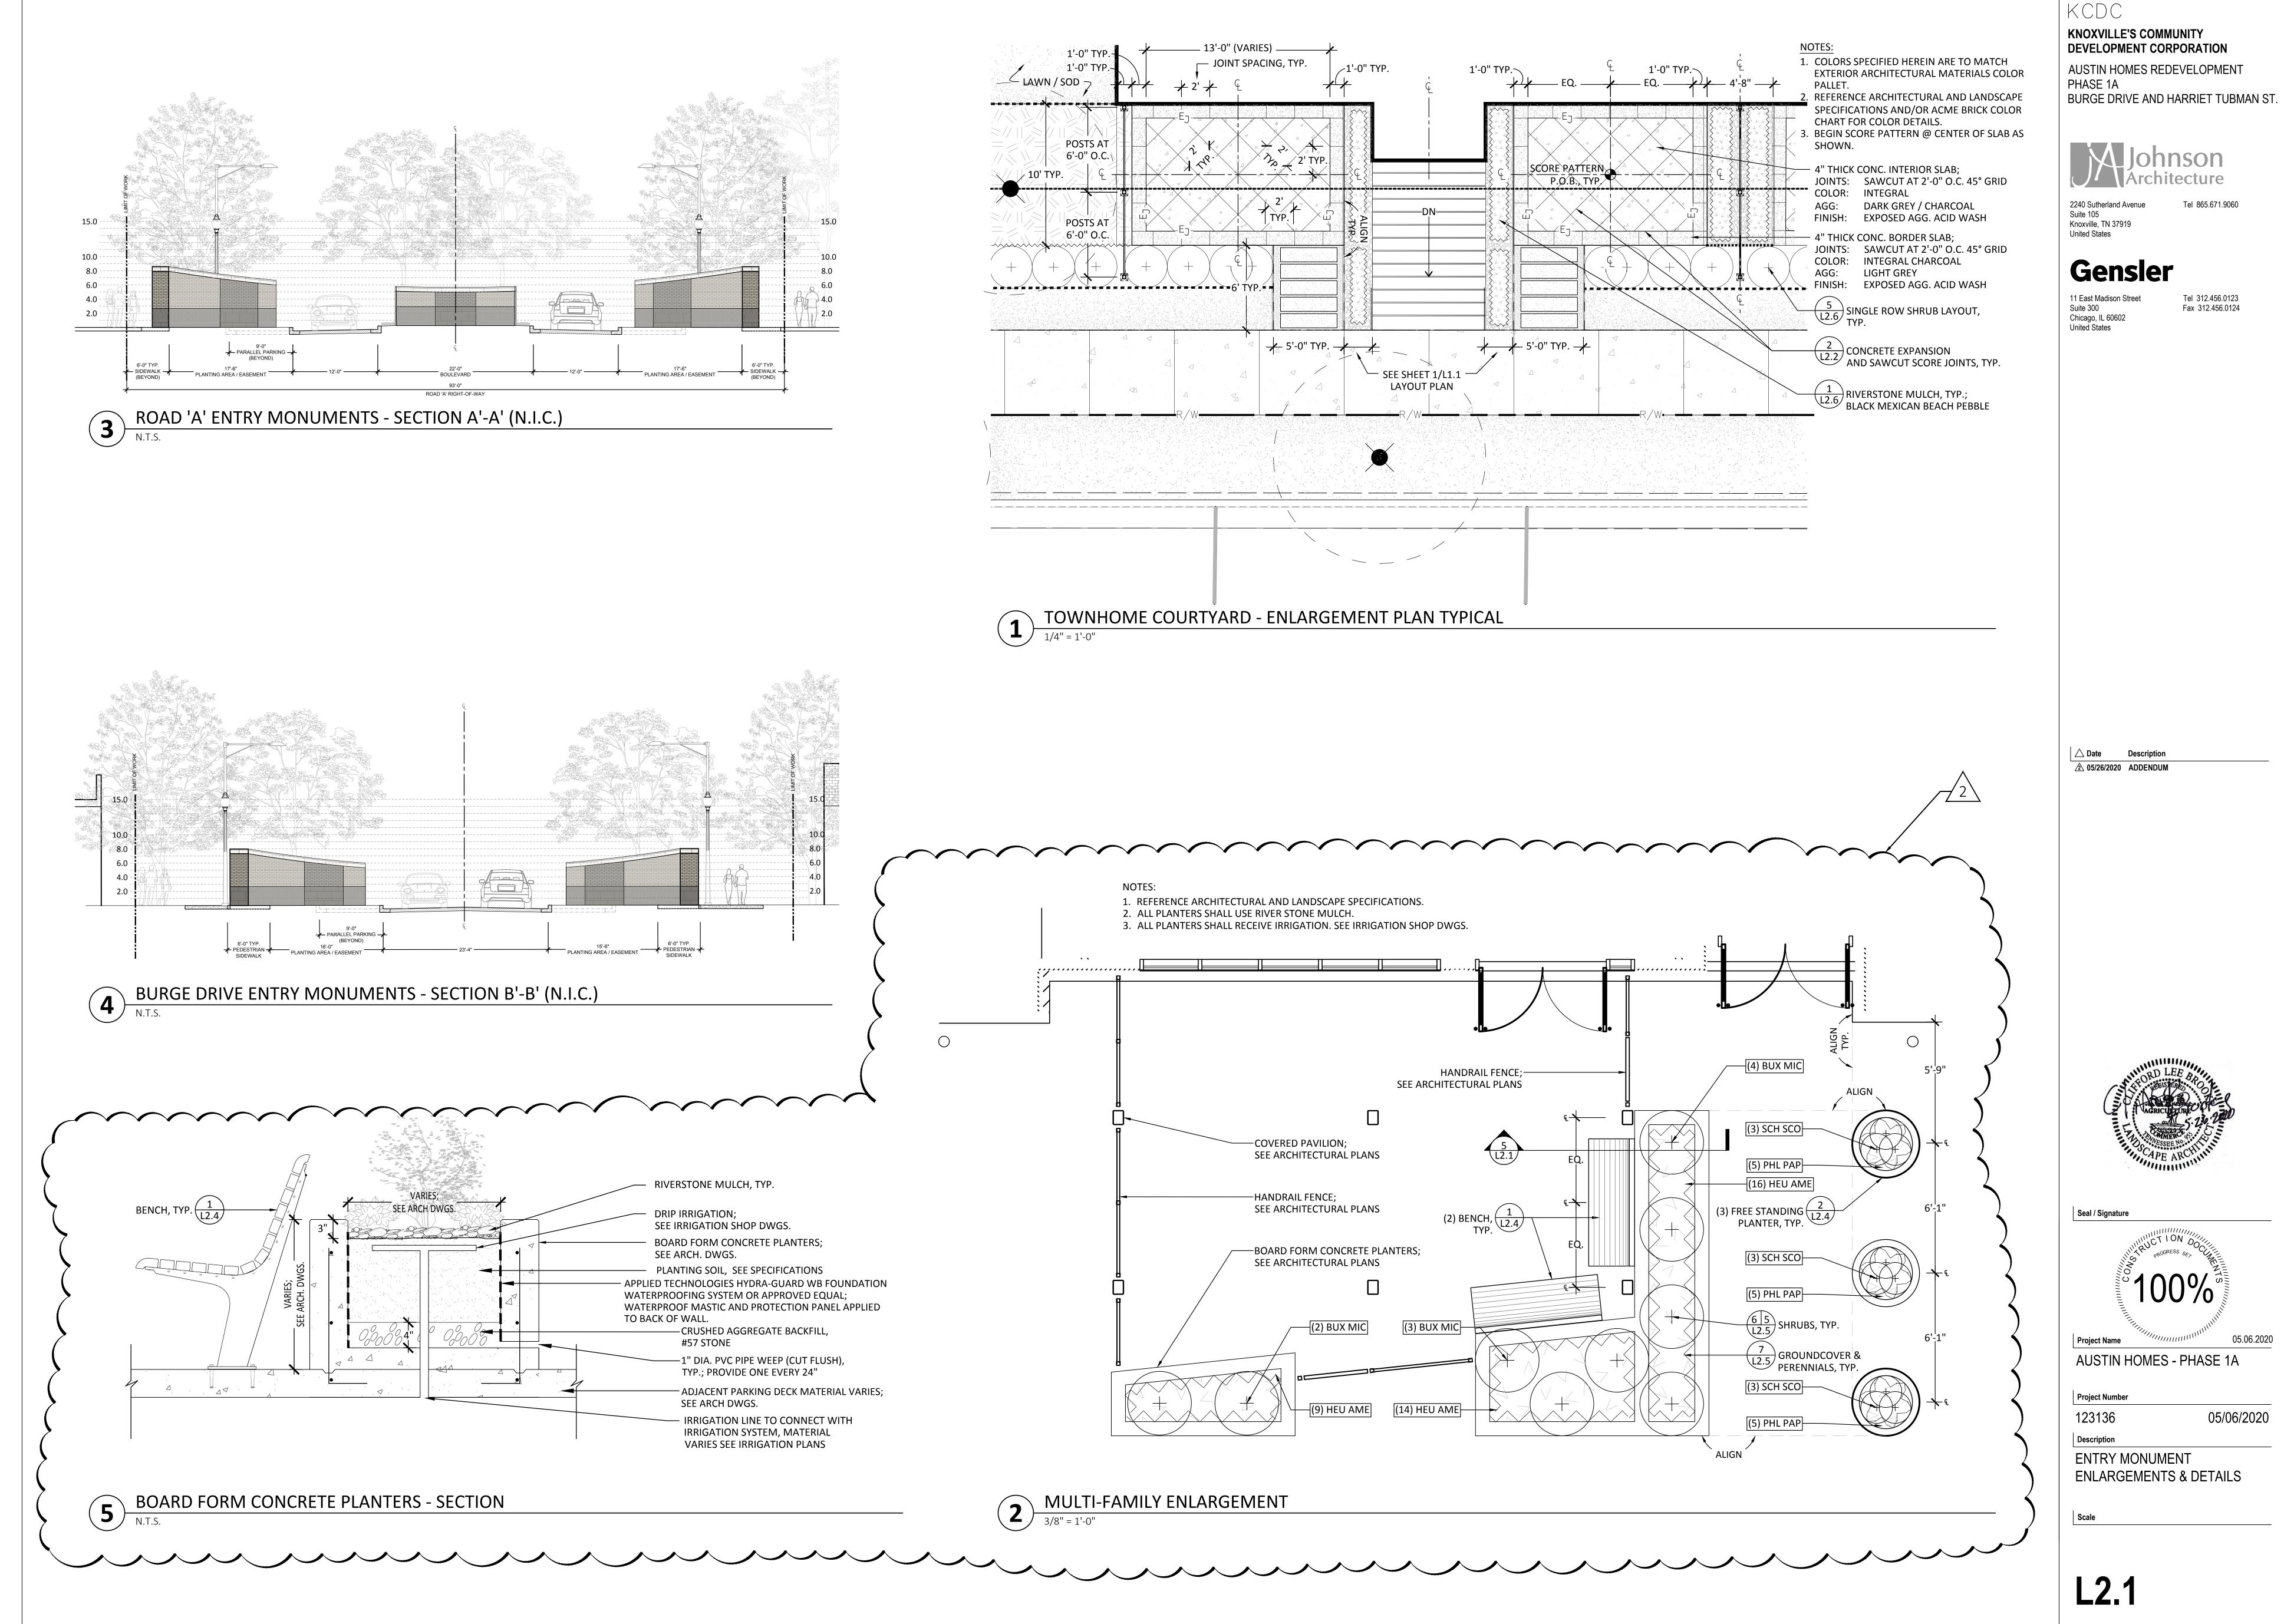

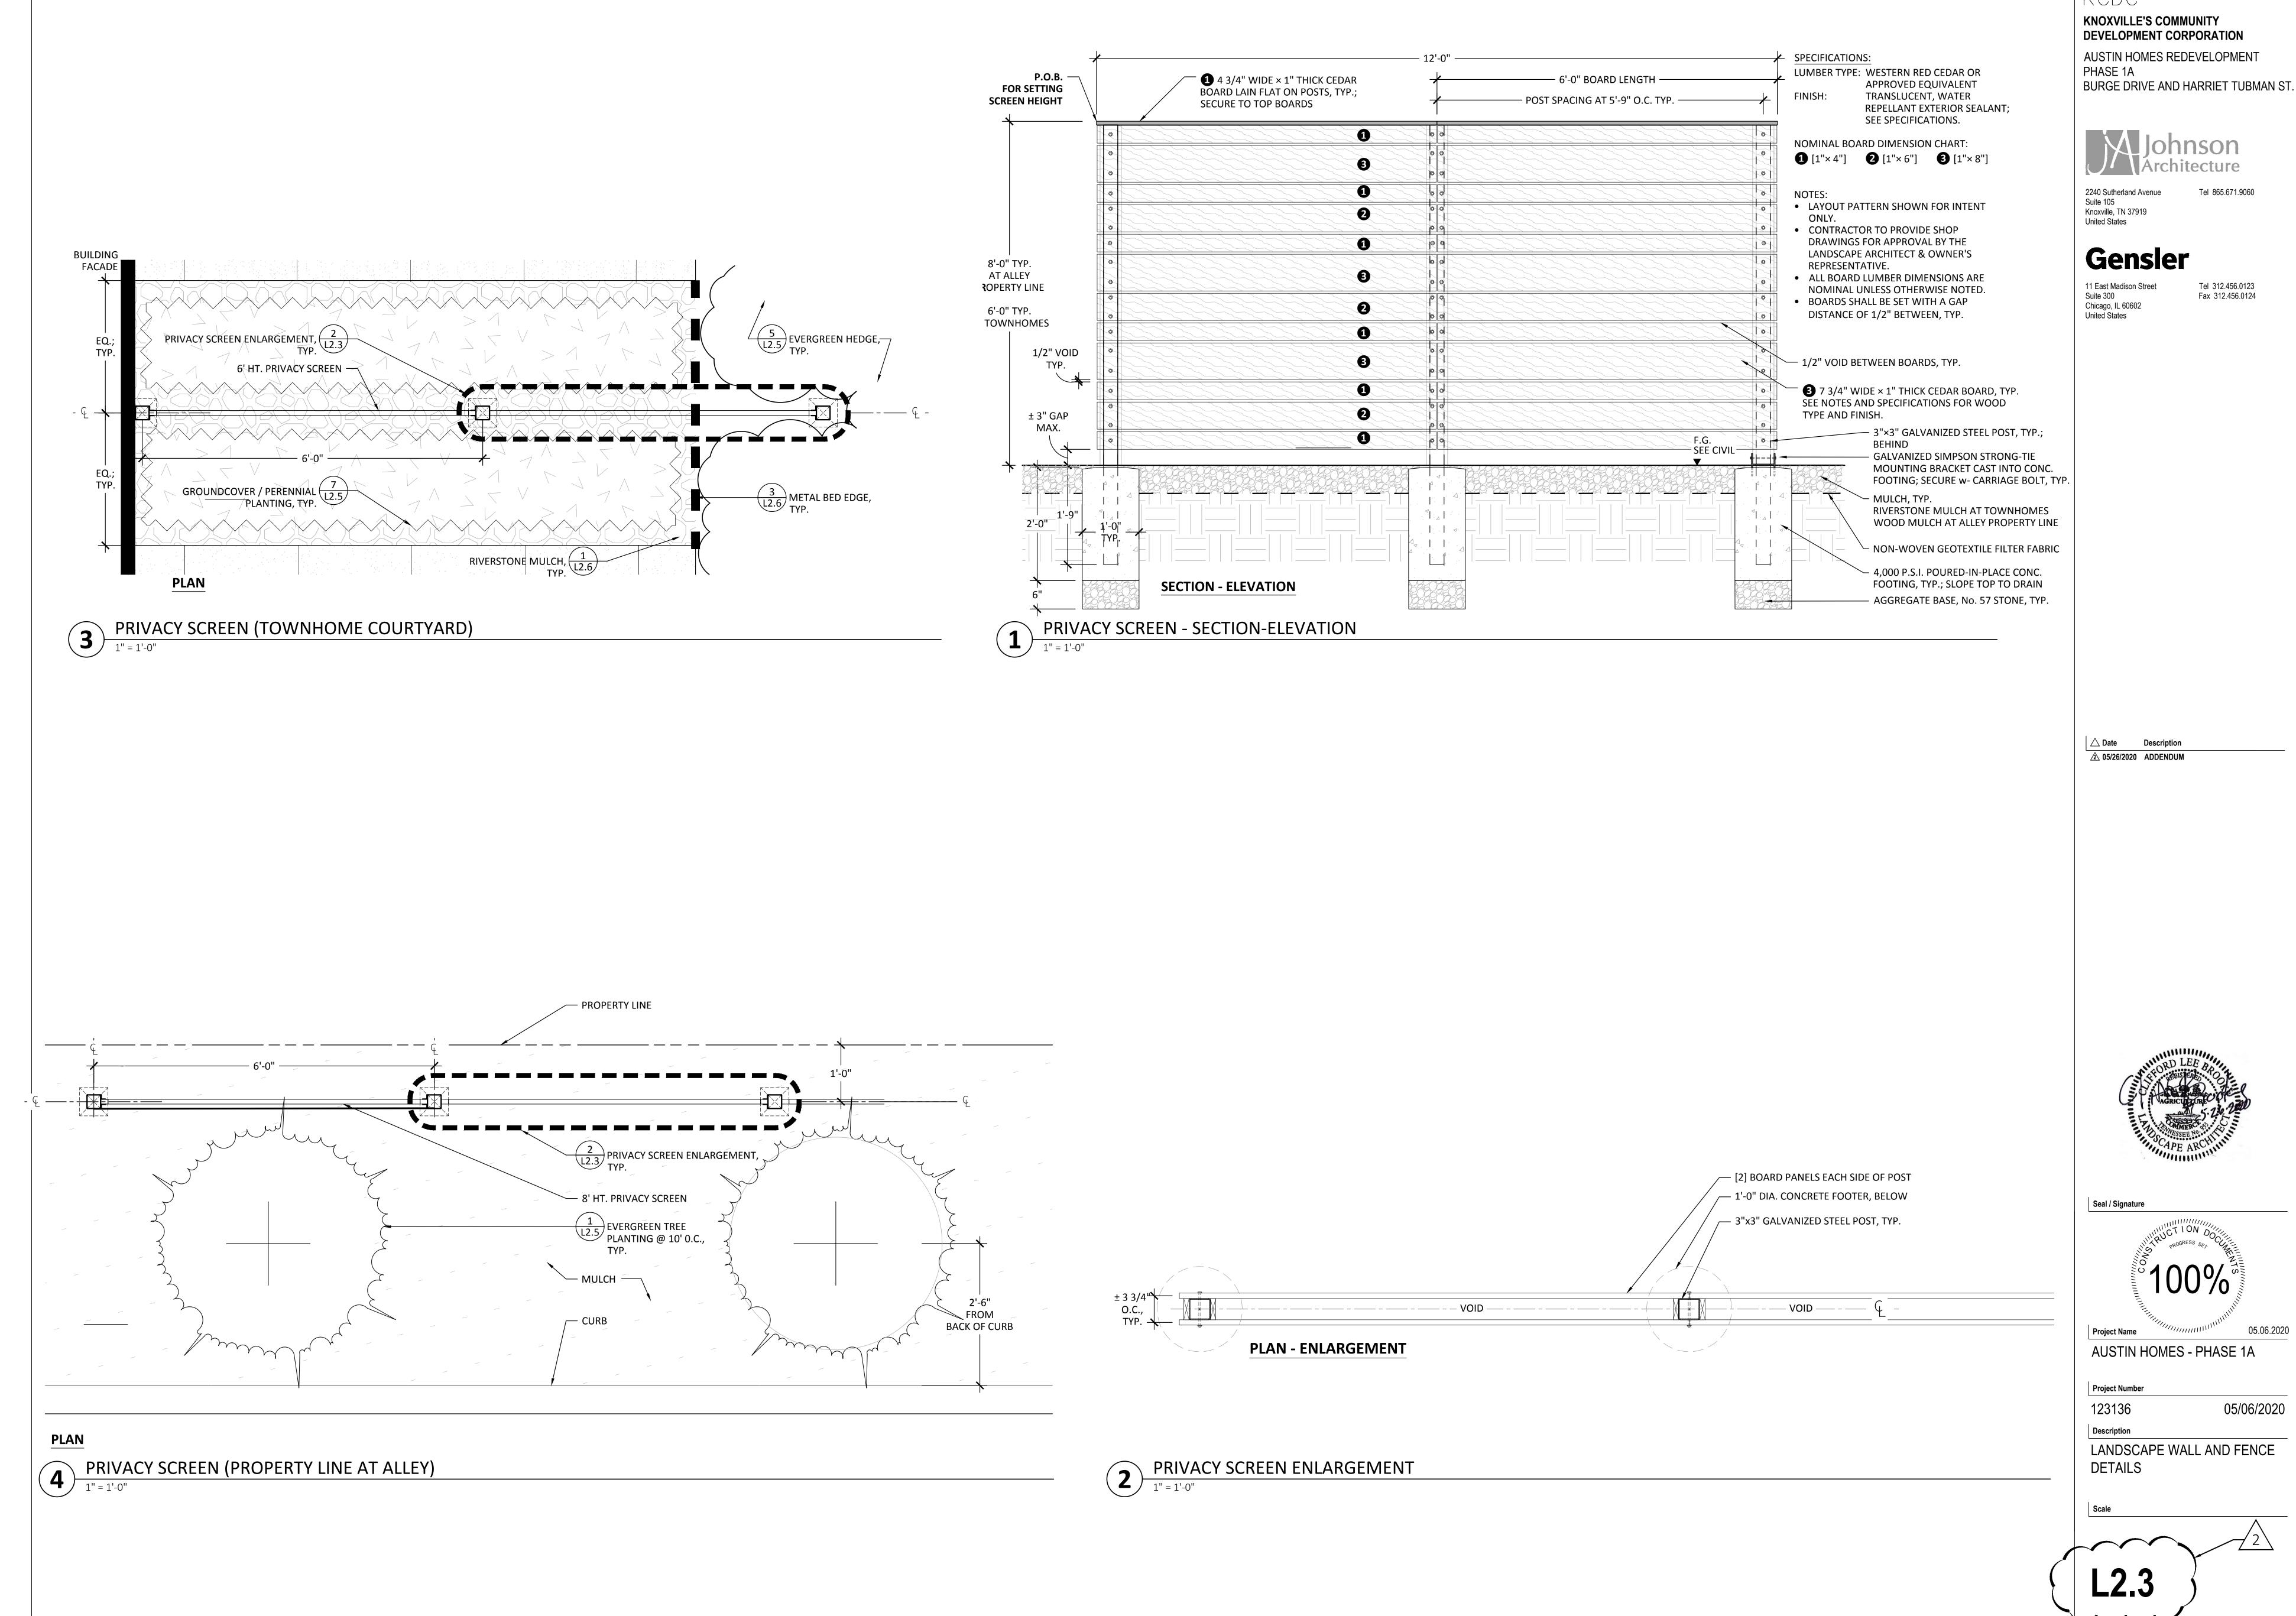

KCDC

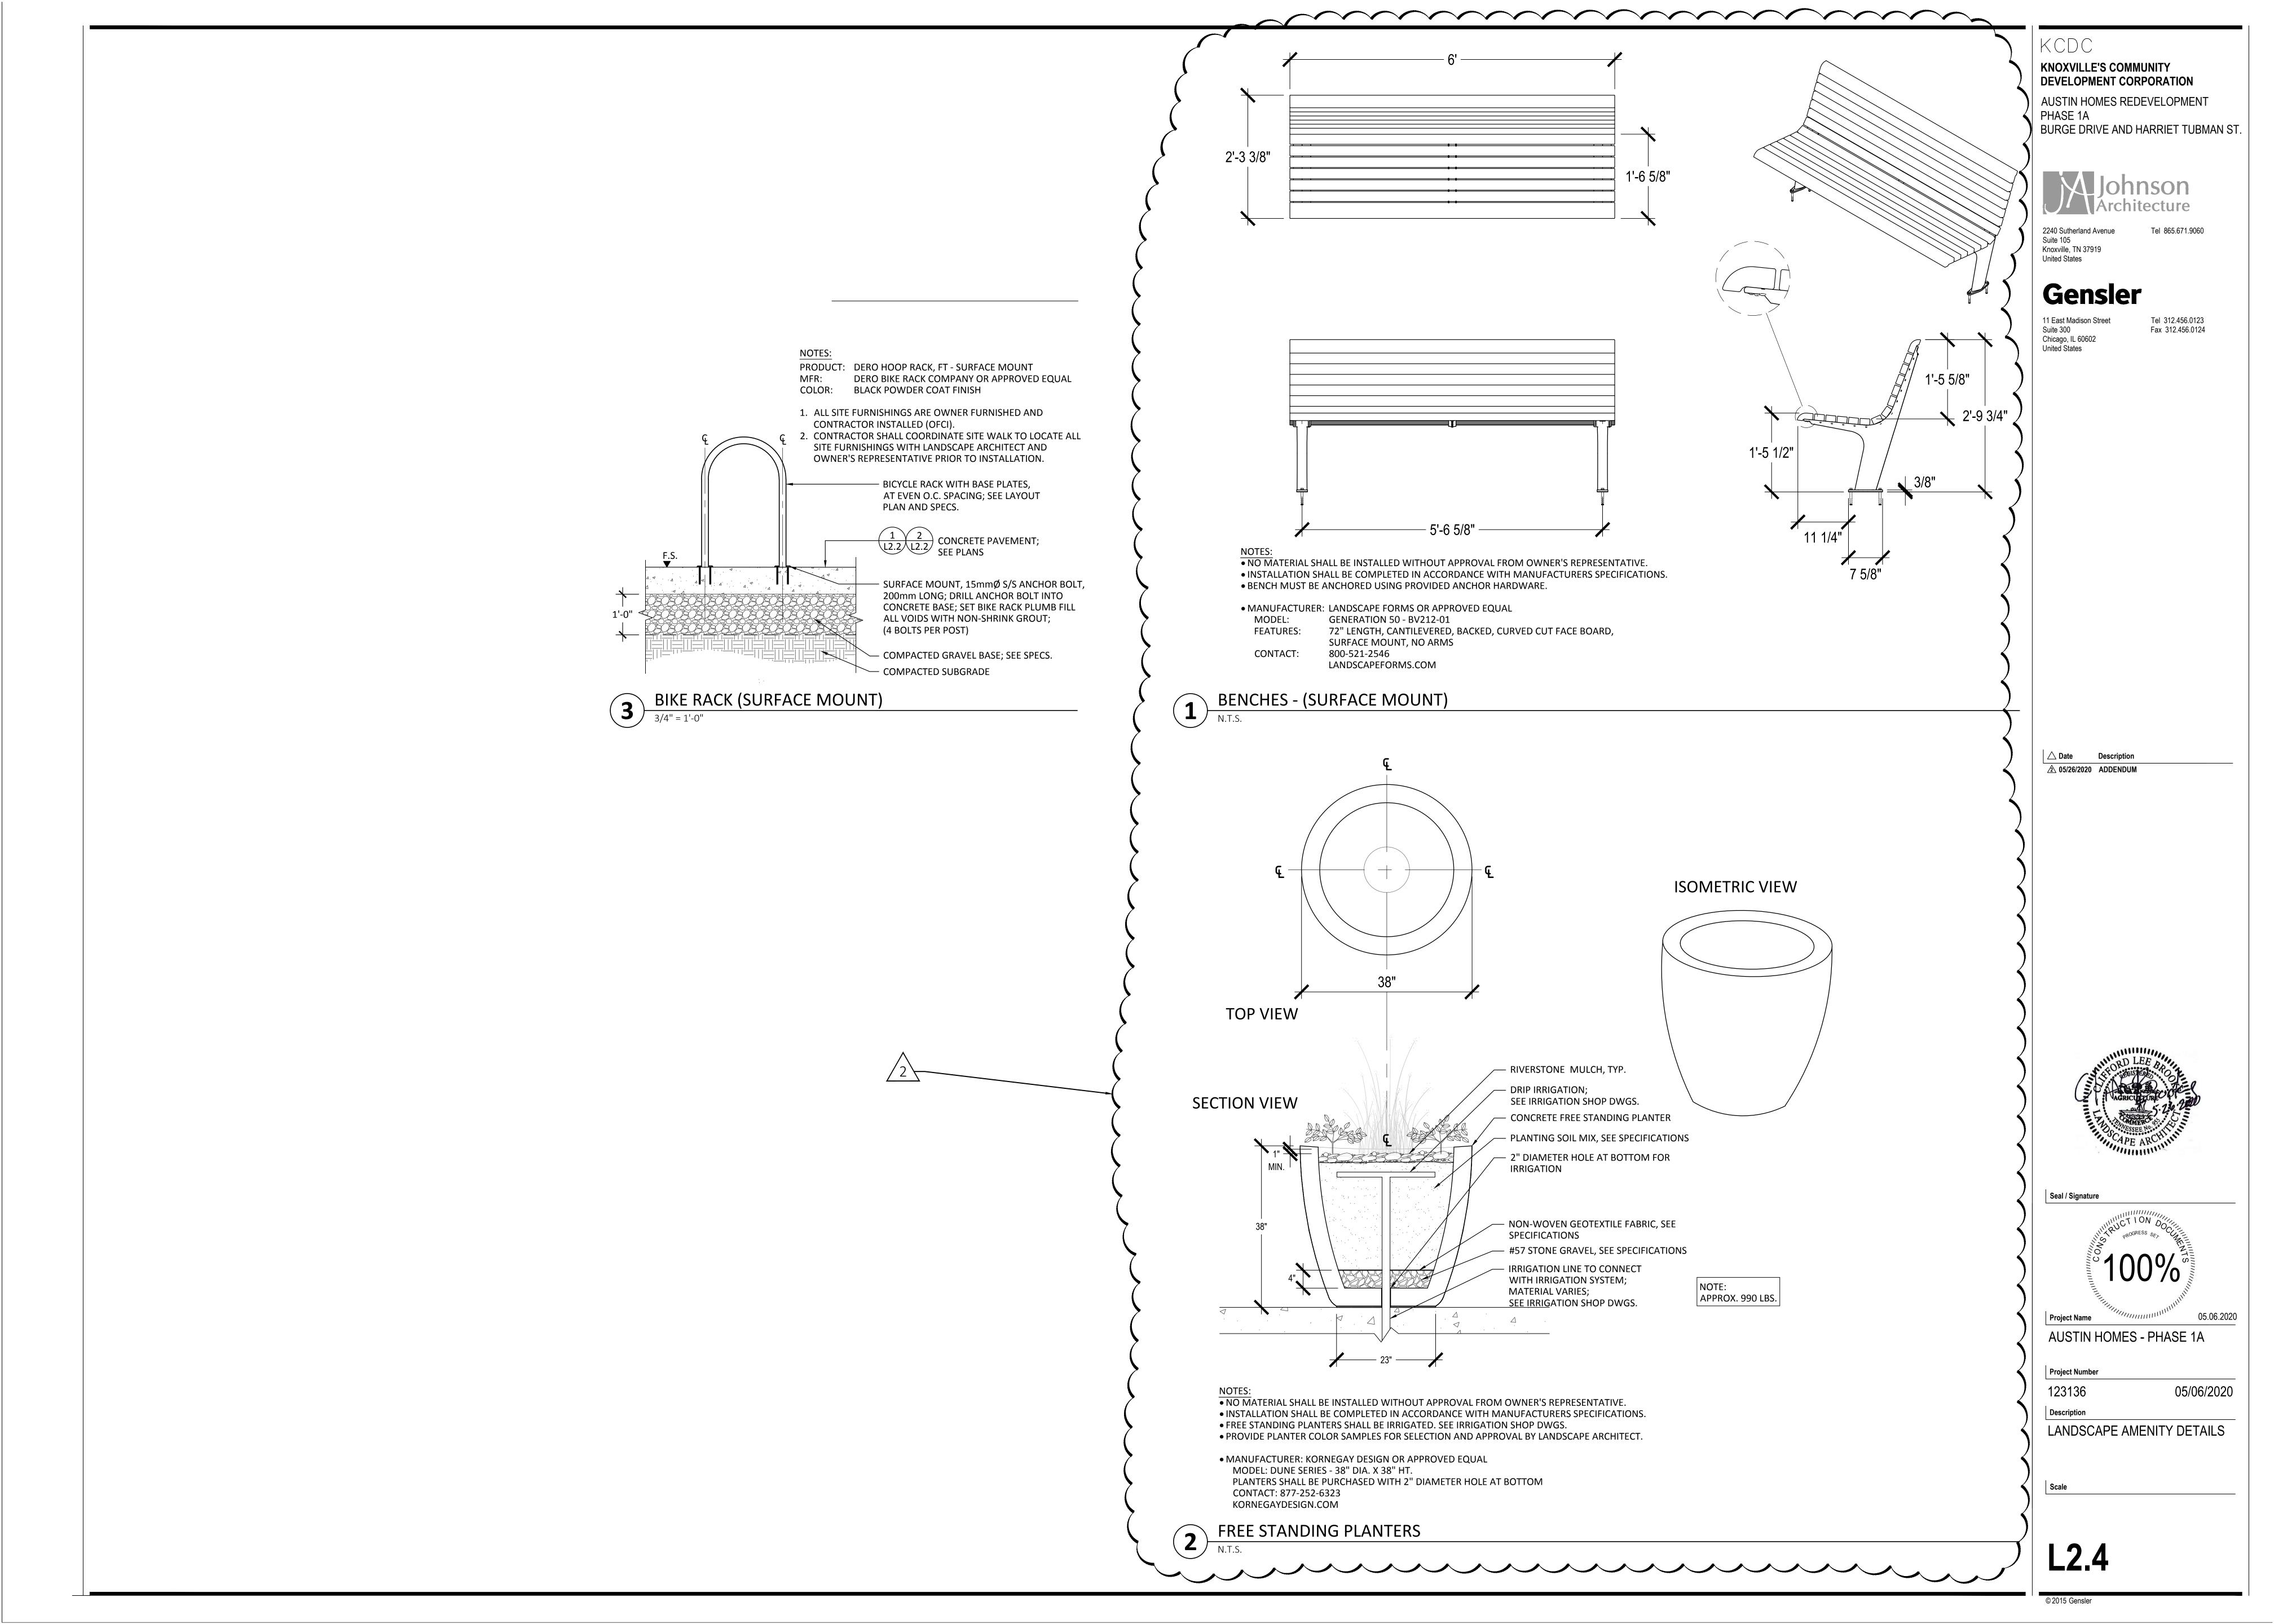

PLANT SCHEDULE (PHASE-1A PACKAGE) QTY ABBREV. COMMON NAME MIN. SIZE | SPACING | NOTES SCIENTIFIC NAME **DECIDUOUS SHADE TREES** | Ginkgo biloba 'Golden Globe' Golden Globe Ginkgo 3" CAL. 2 EA GIN BIL 2 EA LIQ STY 3" CAL. Liquidambar Styraciflua 'Rotundiloba' Round-Lobed Sweetgum 3" CAL. 21 EA QUE LYR | *Quercus lyrata* 'Highbeam Highbeam Overcup Oak 12 EA QUE PHE | *Quercus phellos* 'Hightower' Hightower Willow Oak 3" CAL. Athena Bosque Chinese Elm 14 EA | ULM ATH *Ulmus parvifolia* 'Emer I' 3" CAL. 3" CAL. 2 EA ULM ALL | *Ulmus parvifolia* 'Emer II' Allee Chinese Elm 53 TOTAL ORNAMENTAL TREES O EA CERCAN | Cercis Canadensis 'Forest Pansy' Forest Pansy Redbud 10' MIN. HT. 10' MIN. HT. | PLANTING | B&B; MULTI-STEM O EA COR BRA Cornus florida 'Cherokee Brave' Cherokee Brave Dogwood | PLANS O EA COR PRI | Cornus florida 'Cherokee Princess Cherokee Princess Dogwood 10' MIN. HT. 0 TOTAL **EVERGREEN TREES** | *Ilex x* 'Emily Bruner' Emily Bruner Holly B&B; FULL TO GROUND O EA | ILE BRU PLANTING B&B; FULL TO GROUND 37 EA JUN VIR Skyrocket Eastern Red Cedar | *Juniperus virginiana* 'Skyrocket PLANS 37 TOTAL **SHRUBS** 36" O.C. 24" HT.× 24" SPD. MIN. *Buxus microphylla japonica* 'Winter Gem' Winter Gem Boxwood #5 CONT. 133 EA CEP HAR Cephalotaxus harringtonia 'Duke Gardens' #5 CONT. 36" O.C. | 18" HT.× 24" SPD. MIN. Duke Gardens Yew 22 EA FOT GAR Fothergilla gardenii 'Mt. Airy 18" HT.× 12" SPD. MIN. Mt. Airy Fothergilla #5 CONT 36" O.C. 6 EA HYD QUE *Hydrangea quercifolia* 'Snowflake Snowflake Oakleaf Hydrangea | #7 CONT 72" O.C. 24" HT.× 24" SPD. MIN. 103 EA | ILE COR #5 CONT 36" O.C. 18" HT.× 18" SPD. MIN. *Ilex cornuta* 'Carissa' Carissa Holly #5 CONT 18" HT.× 18" SPD. MIN. 84 EA | ILE VOM | *Ilex vomitoria* 'Stoke's Dwarf' Stoke's Dwarf Yaupon Holly | *Itea virginica* 'Henry's Garnette' Henry's Garnette Sweetspire 7 EA | ITE VIR #5 CONT. 36" O.C. 24" HT.× 18" SPD. MIN. #5 CONT 36" O.C. 6 EA ROS RAD 18" HT.× 18" SPD. MIN. Rosa radrazz 'Knockout' Knockout Rose 65 EA TAX BAC Taxus baccata 'Repandens Repandens English Yew #5 CONT | 18" HT.× 24" SPD. MIN. 33 EA | VIB RHY | Viburnum x rhytidophyllum Leatherleaf Viburnum #7 CONT. 72" O.C. 30" HT.× 30" SPD. MIN. 520 TOTAL **GROUNDCOVER / PERENNIALS / BULBS** 18" O.C. 12" HT. MIN. | Dryopteris erythrosora 'Brilliance' #1 CONT. Brilliance Autumn Fern 71 EA HEU AME | *Heuchera Americana* 'Plum Pudding' Plum Pudding Coral Bells #1 CONT 18" O.C. 12" SPD. MIN. 1,910 EA | LIR MUS 12" O.C. 6" HT. MIN. Liriope muscari 'Big Blue' Big Blue Liriope #1 CONT 294 EA LOR CHI Loropetalum chinensis 'Jazz Hands Mini' Jazz Hands Mini Chinese Fringe-Flower #1 CONT. 24" O.C. 8" HT. MIN. 3 EA MIS SIN #3 CONT. 36" O.C. 18" HT. MIN. Miscanthus Sinensis 'Zebrinus' Zebra Grass 542 EA NAR PSE Narcissus pseudonarcissus Daffodils 12" O.C. 6" HT. MIN. #1 CONT. #1 CONT. 12" O.C. 631 EA OPH JAP Ophiopogon japonicus 'Nanus' **Dwarf Mondo Grass** 6" HT. MIN. Green Sheen Pachysandra 215 EA PACTER Pachysandra terminalis 'Green Sheen' #1 CONT. 18" O.C. 6" HT. MIN. Paparazzi Jagger Creeping Phlox #1 CONT. 18" O.C. 12" SPD. MIN. *Phlox x hybrida* 'Paparazzi Jagger 9 EA SCH SCO | Schizachyrium scoparium 'Standing Ovation' | Standing Ovation Little Bluestem

4,073 TOTAL

LAWN TURF

20,350 SF | SOD

20,350 TOTAL

810 SF


MISE ACCESSORIES

TURF TYPE FESCUE SOD (SEE SPECS.)

RIVER STONE MULCH (3"- 6" DIA.)

BLACK METAL BED EDGING; SEE PLANS AND SPECIFICATIONS

#1 CONT. | 36" O.C. | 12" HT. MIN. MIN

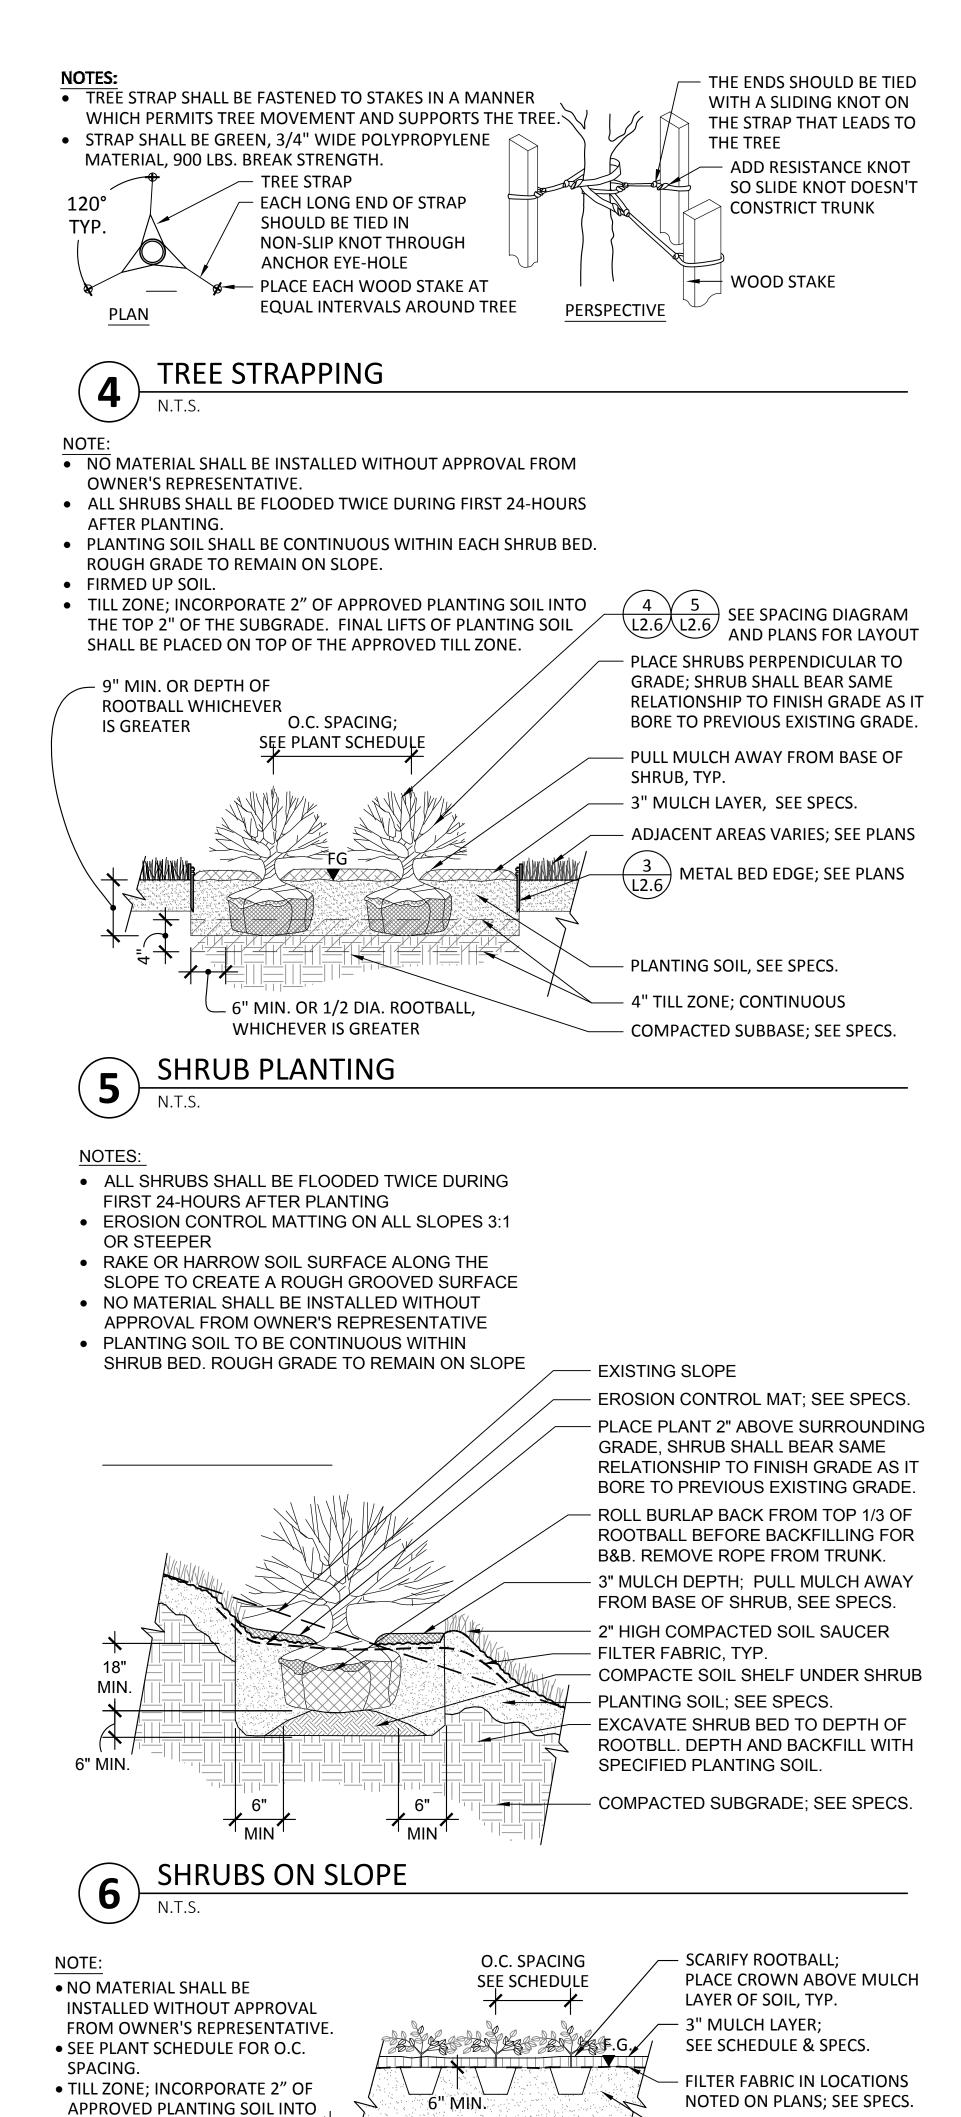

THE TOP 2" OF THE SUBGRADE.

• FINAL LIFTS OF PLANTING SOIL

SHALL BE PLACED ON TOP OF

SECTION

GROUNDCOVER / PERENNIAL PLANTING

SEE SPECIFICATIONS

SEED FOR LAWN, UNLESS

PLANTING SOIL, SEE SPECS.

SEE CIVIL DRAWINGS.

OF PLANTING SOIL

SEE SPECIFICATIONS

THE APPROVED TILL ZONE.

NO MATERIAL SHALL BE

INSTALLED WITHOUT APPROVAL

SOAK ALL LAWN TWICE IN FIRST

TILL ZONE; INCORPORATE 2" OF

FINAL LIFTS OF PLANTING SOIL

APPROVED TILL ZONE.


APPROVED PLANTING SOIL INTO THE TOP 2" OF THE SUBGRADE.


SHALL BE PLACED ON TOP OF THE


8 LAWN/SEED PLANTING
N.T.S.


24-HOURS AFTER INSTALL.

FROM OWNER'S REPRESENTATIVE.

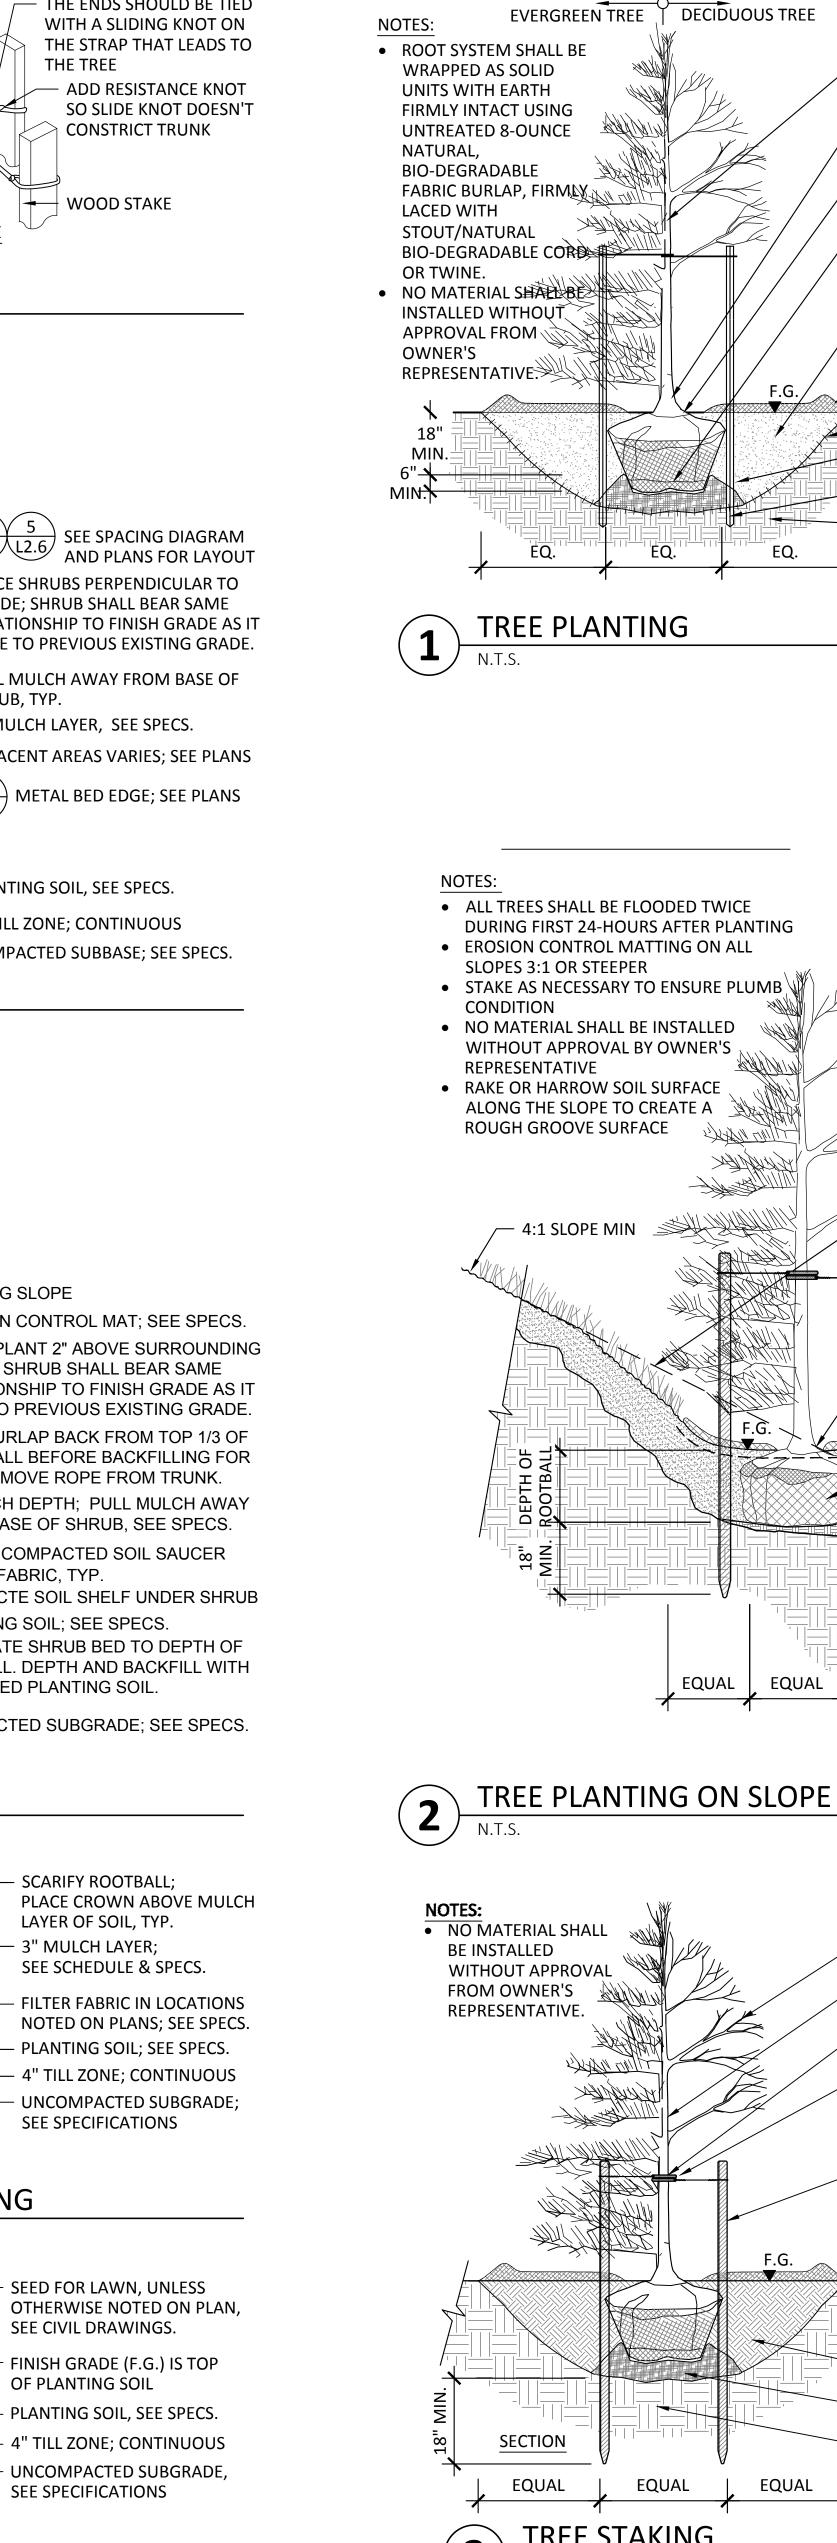


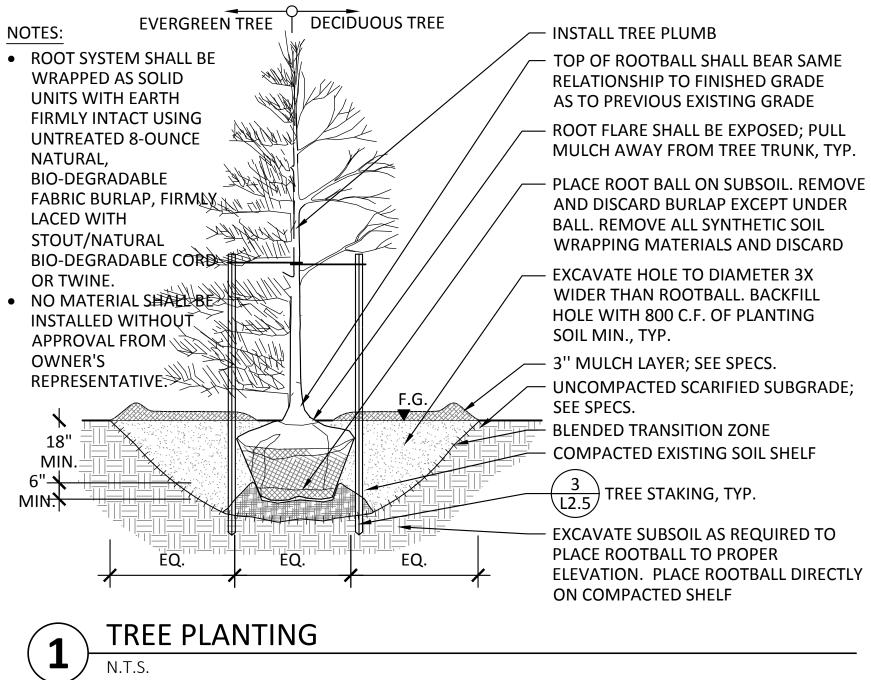

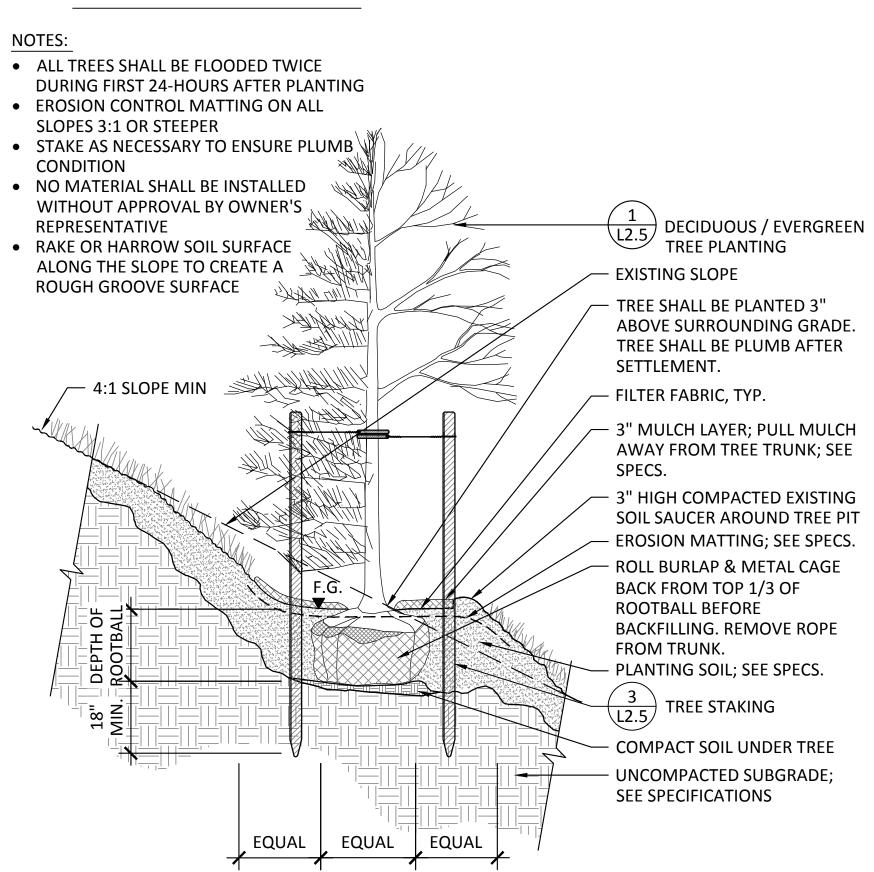

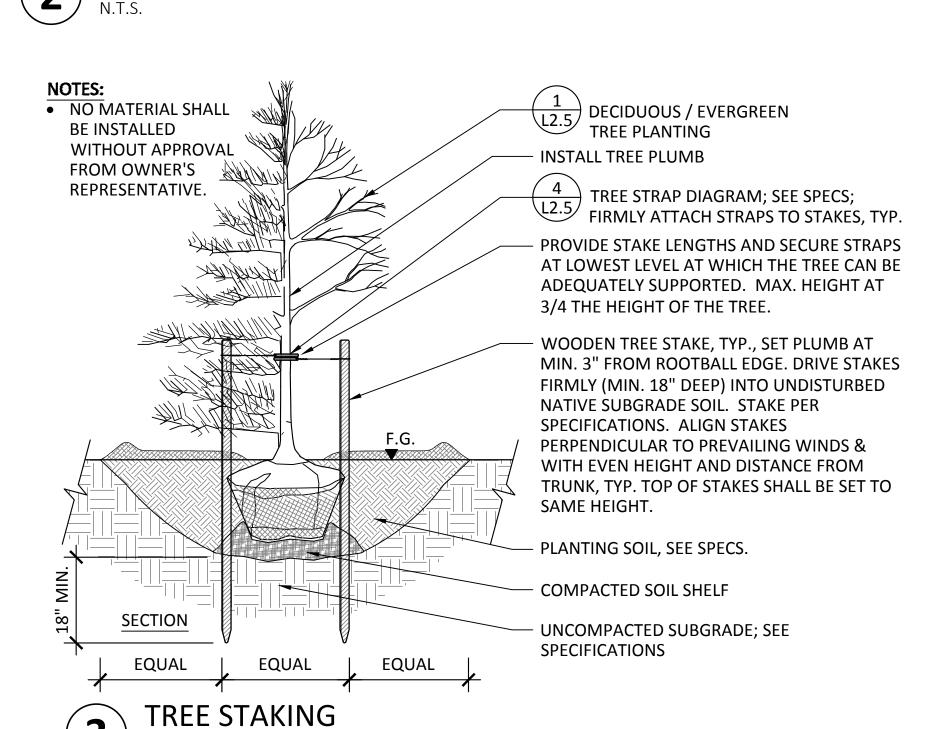

N.T.S.

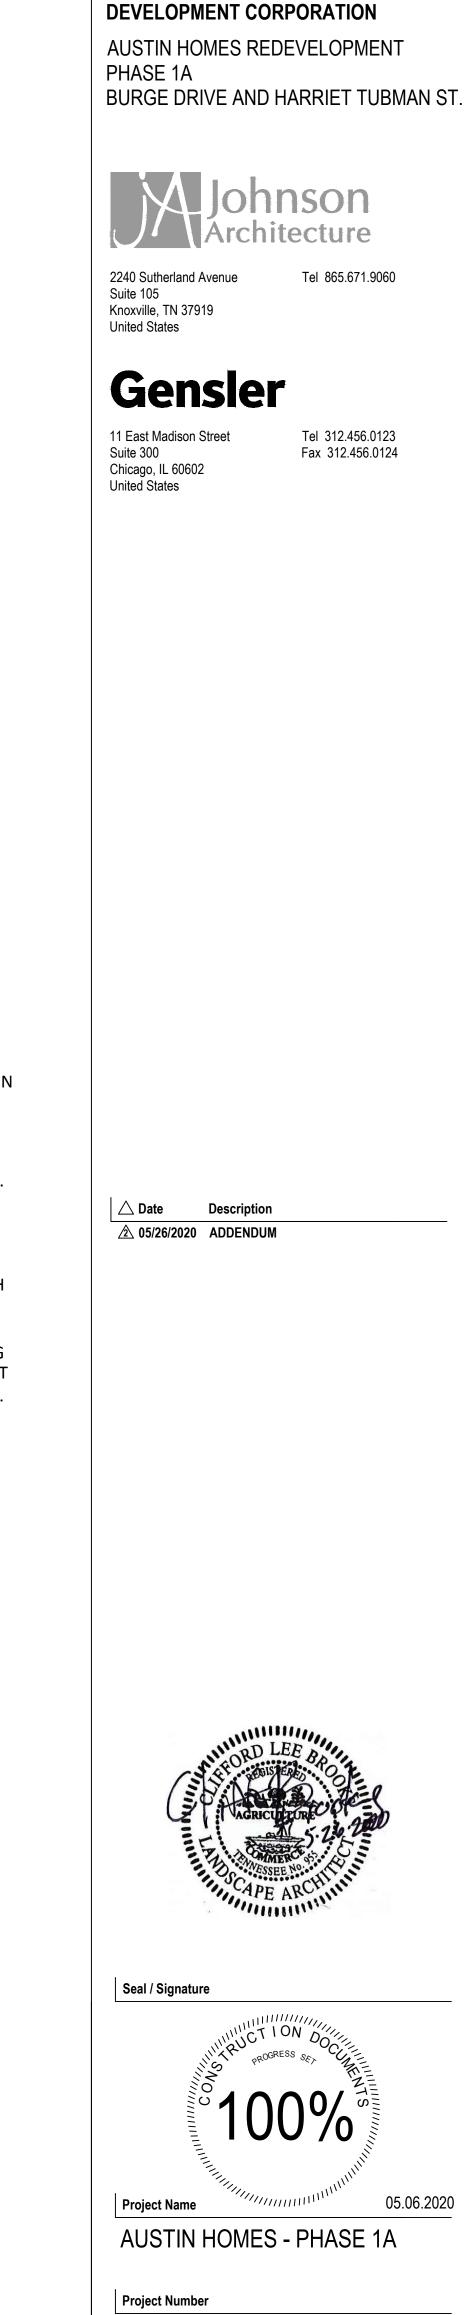


KNOXVILLE'S COMMUNITY

05/06/2020 123136

Description LANDSCAPE PLANTING DETAILS

Scale

L2.5

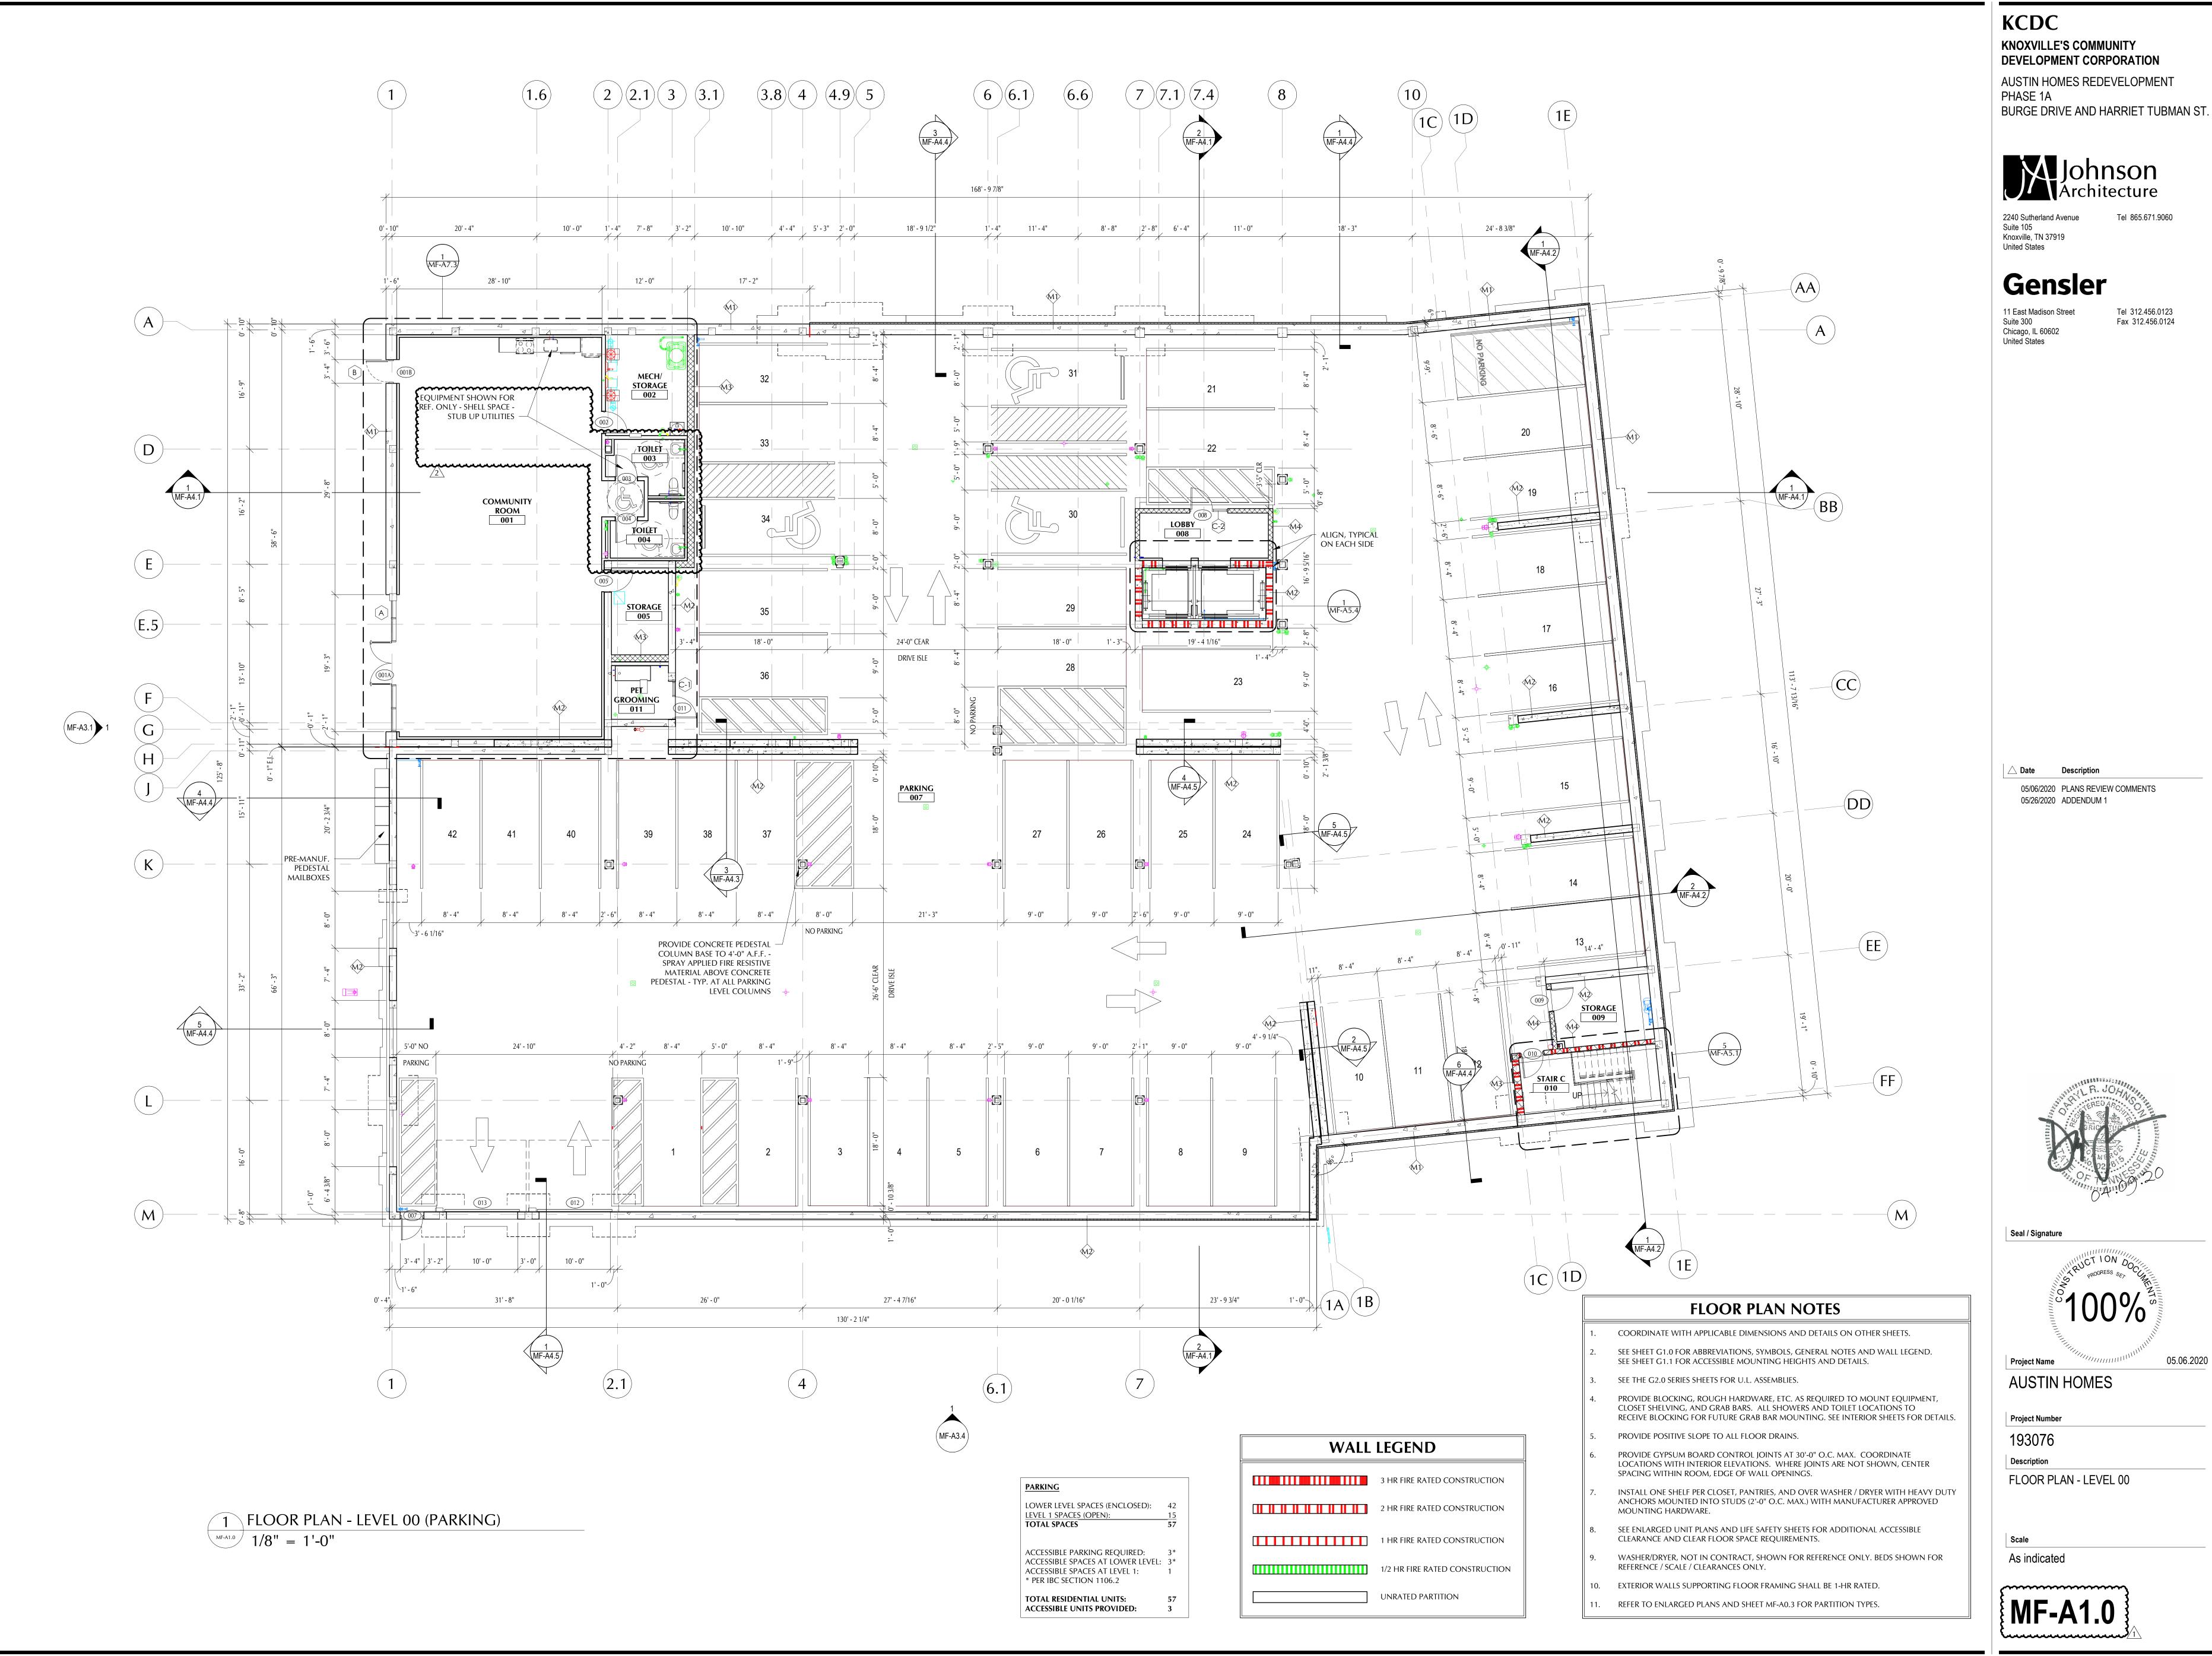

ELEVATION NOTES

- 1. CJ = CONTROL JOINT, SEE DETAIL XXXX
- 2. ICJ = INSIDE CONTROL JOINT, SEE DETAIL XXXX
- 3. CONTROL JOINTS TO BE ALIGNED WITH EDGE OF ADJACENT WINDOW OR DOOR FRAME AS SHOWN ON ELEVATIONS. LOCATE CONTROL JOINTS MAXIMUM 25'-0" O.C. WHERE NOT SHOWN. COORDINATE LOCATIONS WITH ARCHITECT.
- PROVIDE CONTROL JOINTS MINIMUM 2'-0" OFF EDGE OF OUTSIDE CORNER IF NOT SHOWN ALIGNED WITH FRAME. ALIGN DOWNSPOUT TO COVER CONTROL JOINTS WHERE APPLICABLE.
- PROVIDE HORIZONTAL CONTROL JOINTS AT LOCATIONS SHOWN ON ELEVATIONS. REFER TO STRUCTURAL DRAWINGS FOR DETAILS.
- VERTICAL CONTROL JOINT FILLER TO MATCH MASONRY COLOR. HORIZONTAL CONTROL JOINT FILLER TO MATCH GROUT COLOR.
- COORDINATE WITH APPLICABLE DIMENSIONS AND DETAILS ON OTHER SHEETS.
- DIMENSIONS ARE TO FACE OF MASONRY, COMPOSITE METAL PANEL, CURTAIN WALL OR EDGE OF OPENING UNLESS NOTED OTHERWISE.
- 10. COORDINATE DOWNSPOUT LOCATIONS WITH ROOF PLAN.
- 11. PROVIDE MASONRY VENEER EXPANSION JOINTS AT INSIDE CORNERS AND INTERSECTIONS WITH DISSIMILAR MATERIALS.

ZONING MATERIAL REQUIREMENTS

PER CITY OF KNOXVILLE ZONING CODE | ARTICLE 9 SECTION 9.3 PRINCIPLE USE STANDARDS (PROPERTY ZONED RN-6)

3. MULTI-FAMILY DWELLINGS REQUIRE A MINIMUM OF 20% TRANSPARENCY ON ANY FACADE FACING A STREET AND IS CALCULATED ON THE BASIS OF THE ENTIRE AREA OF THE FACADE.

5.a. THE FOLLOWING BUILDING MATERIALS ARE PROHIBITED ON ANY PART OF ANY FACADE: i. Plain concrete block

iii. EXTERIOR INSULATION FINISH SYSTEMS ON THE GROUND FLOOR

5.b. THE FOLLOWING BUILDING MATERIALS ARE PROHIBITED AS A PRIMARY SURFACE FINISH MATERIAL ON ANY FACADE, BUT MAY BE USED AS A DECORATIVE OR DETAIL ELEMENT FOR UP TO 15% OF THE FACADE:

- i. CORRUGATED METAL ii. ALUMINUM, STEEL, OR OTHER METAL SIDINGS
- iii. EXPOSED AGGREGATE (ROUGH FINISH) CONCRETE WALL PANELS

SOUTH FACING

BOULEVARD

2167.97

286.10

1206.83

0.00

0.00

5821.82

4614.99

20.73

17.24

BUILDING 1 - ZONING/ HUD MATERIAL CALCULATIONS 3/4" = 1'-0"

iv. T-111 COMPOSITE PLYWOOD SIDING v. VINYL SIDING

MATERIAL

GLAZING

FIBER CEMENT PANEL

ALUMINUM TRIM

OPAQUE DOOR SURFACE

STEEL SIDING - WOOD GRAIN LOOK

TOTAL ELEVATION SQ. FOOTAGE

TOTAL OPAQUE ELEVATION SQ. FT.

% OF TRANSPARENCY FACING R.O.W.

% OF BRICK MATERIAL OF OPAQUE MATERIAL

ELEVATION MATERIALS

MATERIAL

LEGEND

FCP1

FCP2

FCP3

FCP4

- BRICK VENEER; FIELD (BV1) ACME BRICK - MARBLE GRAY; MODULAR; HOLCIM SANTEE BLACK MORTAR BRICK VENEER; FIELD (BV2)
- ACME BRICK STEEL GRAY; MODULAR; HOLCIM FROSTY MORTAR BRICK VENEER; FIELD (BV3)
- GENERAL SHALE MISTYHOLLOW; MODULAR; HOLCIM SANTEE BLACK MORTAR BRICK VENEER, FIELD (BV4) GENERAL SHALE - MISTYHOLLOW; NORMAN; HOLCIM SANTEE BLACK MORTAR
- SMOOTH FACE CMU; ACCENT (CMU1) DOUBLE MONARCH BELDEN - GRAPHITE; VELOUR TEXTURE, HOLCIM SANTEE BLACK MORTAR
- FIBERGLASS WINDOWS WITH 1" INSULATED GLASS (FW1)
- FIBER CEMENT SIDING; SMOOTH FACE 6" LAP, MITERED AT CORNERS
- FIELD (FCS1) SW 9166 DRIFT OF MIST ACCENT (FCS2) - SW 7674 PEPPERCORN
- FIBER CEMENT PANEL (FCP1) EQUITONE TECTIVA TE90 FIBER CEMENT PANEL (FCP2) - EQUITONE TECTIVA - TE00 FIBER CEMENT PANEL (FCP3) - EQUITONE TECTIVA - TE10
- FIBER CEMENT PANEL (FCP4) EQUITONE TECTIVA TE20 FIBER CEMENT PANEL (FCP5) - EQUITONE TECTIVA - MA400
- LONGBOARD DARK CHERRY, 6" V-GROOVE
- 15. ALUMINUM WRAPPED HEADER TRIM (AT1) CHARCOAL GRAY

14. STEEL SIDING; WOOD GRAIN LOOK; ACCENT (SS1)

PREFINISHED METAL COPING (MC1) - BLACK

17. NOT IN USE.

- 18. INSULATED HOLLOW METAL DOOR (HM1) SW 6991 BLACK MAGIC
- 19. FIBERGLASS DOOR WITH HOLLOW METAL FRAME (FD1) STAINED DARK CHERRY
- 20. FASCIA BOARD; PAINTED (FB1) SW 6991 BLACK MAGIC
- PREFINISHED ALUMINUM GUTTER AND ROUND DOWNSPOUT (GD1) BLACK
- PREFINISHED HALF-ROUND GUTTER AND ROUND DOWNSPOUT (GD2) BLACK
- PREFINISHED ALUMINUM GUARD AND HANDRAIL SYSTEM (GH1) BLACK
- ARCHITECTURAL ASPHALT ROOF (AS1)
- PREFINISHED METAL LOUVER (ML1) CHARCOAL GRAY
- 26. CAST IN PLACE CONCRETE (CN-1); EXPOSED BOARDFORM 6" HORIZONTAL ORIENTATION

679.06

38.25

0.00

0.00

817.80

817.80

N/A

INSET AT EAST

60.00

292.50

0.00

0.00

0.00

0.00

352.50

N/A

TOTAL BRICK 8728.23

TOTAL ELEVATION SQ

FOOTAGE

33457.75

26767.11

PERFORATED METAL PANEL (PM1)

FACING BURGE | FACING BURGE

863.25

2954.85

BUILDING 1 - BUILDING SQ. FOOTAGES

TUBMAN

1067.71

822.53

24.44

22.45

1960.16

94.96

8187.60

N/A

28. ALUMINUM STOREFRONT SYSTEM, (AL1) - BLACK

2039.79

45.05

117.00

463.08

46.44

2711.36

2248.28

]	MC1 FCP1	SS1	FW1)	FCP2		FCP3						PARAPET 969' - 10"
		R P	R		R QI		BV4	MC1 SS	FCP4	FW1		
RQI		R P	R		R Q1		P	P	Q2			95/' - 2"
				FCP4								
R QI		R P	R		RQI	Q2	P	P	Q2			LEVEL 03 935' - 10"
RQI		R P			R Q1	Q2 2	P	P	Q2	Q2		10' - 8"
												LEVEL 02 925' - 2"
		R P	R		R QI	4 MF-A4.4		// // //	5 MF-A4.4		(CN1)	13'-4"
						Q Q	Q				PM1)	LEVEL 01 (LOBBY) 911' - 10"
												LEVEL 00 (PARKING) 901' - 4" COMMUNITY CENTER LEVEL
									_			COMMUNITY CENTER LEVEL 898' - 4"

1 BUILDING ELEVATION - NORTHWEST 1/8" = 1'-0"

KCDC KNOXVILLE'S COMMUNITY **DEVELOPMENT CORPORATION**

AUSTIN HOMES REDEVELOPMENT PHASE 1A BURGE DRIVE AND HARRIET TUBMAN ST.




Tel 865.671.9060 2240 Sutherland Avenue Knoxville, TN 37919

Tel 312.456.0123 Suite 300 Fax 312.456.0124 Chicago, IL 60602 United States

 ∆ Date Description 05/06/2020 PLANS REVIEW COMMENTS 05/26/2020 ADDENDUM 1



Seal / Signature

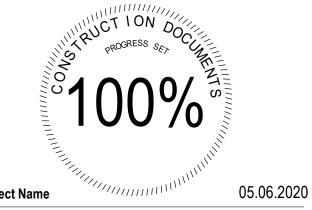

AUSTIN HOMES

Project Number 193076

BUILDING ELEVATIONS

As indicated



ELEVATION NOTES

- 1. CJ = CONTROL JOINT, SEE DETAIL XXXX
- 2. ICJ = INSIDE CONTROL JOINT, SEE DETAIL XXXX
- 3. CONTROL JOINTS TO BE ALIGNED WITH EDGE OF ADJACENT WINDOW OR DOOR FRAME AS SHOWN ON ELEVATIONS. LOCATE CONTROL JOINTS MAXIMUM 25'-0" O.C. WHERE NOT SHOWN. COORDINATE LOCATIONS WITH ARCHITECT.
- 4. PROVIDE CONTROL JOINTS MINIMUM 2'-0" OFF EDGE OF OUTSIDE CORNER IF NOT SHOWN ALIGNED WITH FRAME. ALIGN DOWNSPOUT TO COVER CONTROL JOINTS WHERE APPLICABLE.
- 5. PROVIDE HORIZONTAL CONTROL JOINTS AT LOCATIONS SHOWN ON ELEVATIONS. REFER TO STRUCTURAL DRAWINGS FOR DETAILS.
- 6. VERTICAL CONTROL JOINT FILLER TO MATCH MASONRY COLOR. HORIZONTAL CONTROL JOINT FILLER TO MATCH GROUT COLOR.
- 7. COORDINATE WITH APPLICABLE DIMENSIONS AND DETAILS ON OTHER SHEETS.
- 8. DIMENSIONS ARE TO FACE OF MASONRY, COMPOSITE METAL PANEL, CURTAIN WALL OR EDGE OF OPENING UNLESS NOTED OTHERWISE.
- 10. COORDINATE DOWNSPOUT LOCATIONS WITH ROOF PLAN.
- 11. PROVIDE MASONRY VENEER EXPANSION JOINTS AT INSIDE CORNERS AND INTERSECTIONS WITH DISSIMILAR MATERIALS.

ZONING MATERIAL REQUIREMENTS

PER CITY OF KNOXVILLE ZONING CODE | ARTICLE 9 SECTION 9.3 PRINCIPLE USE STANDARDS (PROPERTY ZONED RN-6)

3. MULTI-FAMILY DWELLINGS REQUIRE A MINIMUM OF 20% TRANSPARENCY ON ANY FACADE FACING A STREET AND IS CALCULATED ON THE BASIS OF THE ENTIRE AREA OF THE FACADE.

5.a. THE FOLLOWING BUILDING MATERIALS ARE PROHIBITED ON ANY PART OF ANY FACADE: i. Plain concrete block

ii. PLASTIC iii. EXTERIOR INSULATION FINISH SYSTEMS ON THE GROUND FLOOR

5.b. THE FOLLOWING BUILDING MATERIALS ARE PROHIBITED AS A PRIMARY SURFACE FINISH MATERIAL ON ANY FACADE, BUT MAY BE USED AS A DECORATIVE OR DETAIL ELEMENT FOR UP TO 15% OF THE FACADE: i. CORRUGATED METAL

ii. ALUMINUM, STEEL, OR OTHER METAL SIDINGS iii. EXPOSED AGGREGATE (ROUGH FINISH) CONCRETE WALL PANELS

iv. T-111 COMPOSITE PLYWOOD SIDING v. VINYL SIDING

% OF BRICK MATERIAL OF OPAQUE MATERIAL

ELEVATION MATERIALS

- BRICK VENEER; FIELD (BV1) ACME BRICK - MARBLE GRAY; MODULAR; HOLCIM SANTEE BLACK MORTAR
- BRICK VENEER; FIELD (BV2) ACME BRICK - STEEL GRAY; MODULAR; HOLCIM FROSTY MORTAR
- BRICK VENEER; FIELD (BV3) GENERAL SHALE - MISTYHOLLOW; MODULAR; HOLCIM SANTEE BLACK MORTAR BRICK VENEER, FIELD (BV4)
- GENERAL SHALE MISTYHOLLOW; NORMAN; HOLCIM SANTEE BLACK MORTAR
- SMOOTH FACE CMU; ACCENT (CMU1) DOUBLE MONARCH BELDEN - GRAPHITE; VELOUR TEXTURE, HOLCIM SANTEE BLACK MORTAR
- FIBERGLASS WINDOWS WITH 1" INSULATED GLASS (FW1)
- FIBER CEMENT SIDING; SMOOTH FACE 6" LAP, MITERED AT CORNERS FIELD (FCS1) - SW 9166 DRIFT OF MIST ACCENT (FCS2) - SW 7674 PEPPERCORN
- FIBER CEMENT PANEL (FCP1) EQUITONE TECTIVA TE90
- FIBER CEMENT PANEL (FCP2) EQUITONE TECTIVA TE00 FIBER CEMENT PANEL (FCP3) - EQUITONE TECTIVA - TE10 12. FIBER CEMENT PANEL (FCP4) - EQUITONE TECTIVA - TE20

13. FIBER CEMENT PANEL (FCP5) - EQUITONE TECTIVA - MA400

- 14. STEEL SIDING; WOOD GRAIN LOOK; ACCENT (SS1)
- LONGBOARD DARK CHERRY, 6" V-GROOVE 15. ALUMINUM WRAPPED HEADER TRIM (AT1) - CHARCOAL GRAY
- 16. PREFINISHED METAL COPING (MC1) BLACK


17. NOT IN USE.

- 18. INSULATED HOLLOW METAL DOOR (HM1) SW 6991 BLACK MAGIC
- 19. FIBERGLASS DOOR WITH HOLLOW METAL FRAME (FD1) STAINED DARK CHERRY
- 20. FASCIA BOARD; PAINTED (FB1) SW 6991 BLACK MAGIC
- 21. PREFINISHED ALUMINUM GUTTER AND ROUND DOWNSPOUT (GD1) BLACK 22. PREFINISHED HALF-ROUND GUTTER AND ROUND DOWNSPOUT (GD2) - BLACK
- 23. PREFINISHED ALUMINUM GUARD AND HANDRAIL SYSTEM (GH1) BLACK
- 24. ARCHITECTURAL ASPHALT ROOF (AS1)
- 25. PREFINISHED METAL LOUVER (ML1) CHARCOAL GRAY
- 26. CAST IN PLACE CONCRETE (CN-1); EXPOSED BOARDFORM 6" HORIZONTAL ORIENTATION
- 27. PERFORATED METAL PANEL (PM1)
- 28. ALUMINUM STOREFRONT SYSTEM, (AL1) BLACK

	BUILDII	NG 1 - BUILDI	NG SQ. FOOTA	GES			5
SOUTH FACING		FACING	NORTH 1-	NORTH 2 -			
BOULEVARD	WEST	TUBMAN	FACING BURGE	FACING BURGE	INSET AT WEST	INSET AT EAST	TOTAL BRICK
2167.97	2849.42	1067.71	442.85	2039.79	100.49	60.00	8728.23
2160.92	4689.67	5676.41	2248.00	45.05	679.06	292.50	
286.10	553.55	822.53	120.00	117.00	38.25	0.00	
1206.83	1960.16	2197.32	863.25	463.08	0.00	0.00	
0.00	0.00	0.00	144.00	0.00	0.00	0.00	TOTAL ELEVATION SQ
0.00	94.96	24.44	0.00	46.44	0.00	0.00	FOOTAGE
5821.82	10147.76	9788.41	3818.10	2711.36	817.80	352.50	33457.75
4614.99	8187.60	7591.09	2954.85	2248.28	817.80	352.50	26767.11
20.73	N/A	22.45	20	.31	N/A	N/A	
	2167.97 2160.92 286.10 1206.83 0.00 0.00 5821.82 4614.99	SOUTH FACING WEST 2167.97 2849.42 2160.92 4689.67 286.10 553.55 1206.83 1960.16 0.00 0.00 0.00 94.96 5821.82 10147.76 4614.99 8187.60	SOUTH FACING BOULEVARD WEST WEST TUBMAN 2167.97 2849.42 1067.71 2160.92 4689.67 5676.41 286.10 553.55 822.53 1206.83 1960.16 2197.32 0.00 0.00 0.00 0.00 94.96 24.44 5821.82 10147.76 9788.41 4614.99 8187.60 7591.09	SOUTH FACING BOULEVARD WEST 2167.97 FACING 2849.42 NORTH 1- 1067.71 NORTH 1- FACING BURGE 2160.92 4689.67 5676.41 2248.00 286.10 553.55 822.53 120.00 1206.83 1960.16 2197.32 863.25 0.00 0.00 144.00 0.00 94.96 24.44 0.00 5821.82 10147.76 9788.41 3818.10 4614.99 8187.60 7591.09 2954.85	BOULEVARD WEST TUBMAN FACING BURGE FACING BURGE 2167.97 2849.42 1067.71 442.85 2039.79 2160.92 4689.67 5676.41 2248.00 45.05 286.10 553.55 822.53 120.00 117.00 1206.83 1960.16 2197.32 863.25 463.08 0.00 0.00 144.00 0.00 0.00 94.96 24.44 0.00 46.44 5821.82 10147.76 9788.41 3818.10 2711.36 4614.99 8187.60 7591.09 2954.85 2248.28	SOUTH FACING BOULEVARD WEST TUBMAN NORTH 1- FACING BURGE NORTH 2- FACING BURGE INSET AT WEST 2167.97 2849.42 1067.71 442.85 2039.79 100.49 2160.92 4689.67 5676.41 2248.00 45.05 679.06 286.10 553.55 822.53 120.00 117.00 38.25 1206.83 1960.16 2197.32 863.25 463.08 0.00 0.00 0.00 0.00 144.00 0.00 0.00 0.00 94.96 24.44 0.00 46.44 0.00 5821.82 10147.76 9788.41 3818.10 2711.36 817.80 4614.99 8187.60 7591.09 2954.85 2248.28 817.80	SOUTH FACING BOULEVARD WEST TUBMAN FACING BURGE FACING BURGE NORTH 2 - FACING BURGE INSET AT WEST INSET AT EAST 2167.97 2849.42 1067.71 442.85 2039.79 100.49 60.00 2160.92 4689.67 5676.41 2248.00 45.05 679.06 292.50 286.10 553.55 822.53 120.00 117.00 38.25 0.00 1206.83 1960.16 2197.32 863.25 463.08 0.00 0.00 0.00 0.00 0.00 144.00 0.00 0.00 0.00 0.00 94.96 24.44 0.00 46.44 0.00 0.00 5821.82 10147.76 9788.41 3818.10 2711.36 817.80 352.50 4614.99 8187.60 7591.09 2954.85 2248.28 817.80 352.50

*GENERAL CONTRACTOR TO VERIFY REQUIRED QUANTITIES OF MATERIALS; FOR AHJ REFERENCE ONLY.



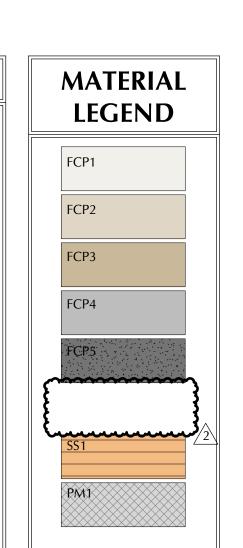

1 BUILDING ELEVATION - FACING HARRIET TUBMAN ST.

KCDC

KNOXVILLE'S COMMUNITY **DEVELOPMENT CORPORATION**

AUSTIN HOMES REDEVELOPMENT PHASE 1A BURGE DRIVE AND HARRIET TUBMAN ST.



Tel 865.671.9060 Suite 105 Knoxville, TN 37919

Gensler

Date Description
 Description

05/26/2020 ADDENDUM 1

05/06/2020 PLANS REVIEW COMMENTS

11 East Madison Street Suite 300 Chicago, IL 60602 United States

United States

Tel 312.456.0123 Fax 312.456.0124

05.06.2020

AUSTIN HOMES

Project Number

BUILDING ELEVATIONS

As indicated

ELEVATION NOTES

- 1. CJ = CONTROL JOINT, SEE DETAIL XXXX
- 2. ICJ = INSIDE CONTROL JOINT, SEE DETAIL XXXX
- 3. CONTROL JOINTS TO BE ALIGNED WITH EDGE OF ADJACENT WINDOW OR DOOR FRAME AS SHOWN ON ELEVATIONS. LOCATE CONTROL JOINTS MAXIMUM 25'-0" O.C.
- WHERE NOT SHOWN. COORDINATE LOCATIONS WITH ARCHITECT. 4. PROVIDE CONTROL JOINTS MINIMUM 2'-0" OFF EDGE OF OUTSIDE CORNER IF NOT SHOWN ALIGNED WITH FRAME. ALIGN DOWNSPOUT TO COVER CONTROL JOINTS
- PROVIDE HORIZONTAL CONTROL JOINTS AT LOCATIONS SHOWN ON ELEVATIONS. REFER TO STRUCTURAL DRAWINGS FOR DETAILS.
- VERTICAL CONTROL JOINT FILLER TO MATCH MASONRY COLOR. HORIZONTAL CONTROL JOINT FILLER TO MATCH GROUT COLOR.
- 7. COORDINATE WITH APPLICABLE DIMENSIONS AND DETAILS ON OTHER SHEETS.
- 8. DIMENSIONS ARE TO FACE OF MASONRY, COMPOSITE METAL PANEL, CURTAIN WALL OR EDGE OF OPENING UNLESS NOTED OTHERWISE.
- 10. COORDINATE DOWNSPOUT LOCATIONS WITH ROOF PLAN.
- 11. PROVIDE MASONRY VENEER EXPANSION JOINTS AT INSIDE CORNERS AND INTERSECTIONS WITH DISSIMILAR MATERIALS.

ZONING MATERIAL REQUIREMENTS

PER CITY OF KNOXVILLE ZONING CODE | ARTICLE 9 SECTION 9.3 PRINCIPLE USE STANDARDS (PROPERTY ZONED RN-6)

3. MULTI-FAMILY DWELLINGS REQUIRE A MINIMUM OF 20% TRANSPARENCY ON ANY FACADE FACING A STREET AND IS CALCULATED ON THE BASIS OF THE ENTIRE AREA OF THE FACADE.

- 5.a. THE FOLLOWING BUILDING MATERIALS ARE PROHIBITED ON ANY PART OF ANY FACADE:
- i. PLAIN CONCRETE BLOCK ii. PLASTIC
- iii. EXTERIOR INSULATION FINISH SYSTEMS ON THE GROUND FLOOR
- **5.b.** THE FOLLOWING BUILDING MATERIALS ARE PROHIBITED AS A PRIMARY SURFACE FINISH MATERIAL ON ANY FACADE, BUT MAY BE USED AS A DECORATIVE OR DETAIL ELEMENT FOR UP TO 15% OF THE FACADE:
- i. CORRUGATED METAL
- ii. ALUMINUM, STEEL, OR OTHER METAL SIDINGS iii. EXPOSED AGGREGATE (ROUGH FINISH) CONCRETE WALL PANELS
- iv. T-111 COMPOSITE PLYWOOD SIDING v. VINYL SIDING

ELEVATION MATERIALS

- BRICK VENEER; FIELD (BV1) ACME BRICK - MARBLE GRAY; MODULAR; HOLCIM SANTEE BLACK MORTAR
- BRICK VENEER; FIELD (BV2) ACME BRICK - STEEL GRAY; MODULAR; HOLCIM FROSTY MORTAR BRICK VENEER; FIELD (BV3)
- GENERAL SHALE MISTYHOLLOW; MODULAR; HOLCIM SANTEE BLACK MORTAR BRICK VENEER, FIELD (BV4) GENERAL SHALE - MISTYHOLLOW; NORMAN; HOLCIM SANTEE BLACK MORTAR
- SMOOTH FACE CMU; ACCENT (CMU1) DOUBLE MONARCH BELDEN - GRAPHITE; VELOUR TEXTURE, HOLCIM SANTEE BLACK MORTAR
- FIBERGLASS WINDOWS WITH 1" INSULATED GLASS (FW1)
- FIBER CEMENT SIDING; SMOOTH FACE 6" LAP, MITERED AT CORNERS FIELD (FCS1) - SW 9166 DRIFT OF MIST
- ACCENT (FCS2) SW 7674 PEPPERCORN

| 14. STEEL SIDING; WOOD GRAIN LOOK; ACCENT (SS1)

- FIBER CEMENT PANEL (FCP1) EQUITONE TECTIVA TE90 FIBER CEMENT PANEL (FCP2) - EQUITONE TECTIVA - TE00 FIBER CEMENT PANEL (FCP3) - EQUITONE TECTIVA - TE10
- FIBER CEMENT PANEL (FCP4) EQUITONE TECTIVA TE20 FIBER CEMENT PANEL (FCP5) - EQUITONE TECTIVA - MA400
- LONGBOARD DARK CHERRY, 6" V-GROOVE
- 15. ALUMINUM WRAPPED HEADER TRIM (AT1) CHARCOAL GRAY


16. PREFINISHED METAL COPING (MC1) - BLACK

- NOT IN USE. INSULATED HOLLOW METAL DOOR (HM1) - SW 6991 BLACK MAGIC
- FIBERGLASS DOOR WITH HOLLOW METAL FRAME (FD1) STAINED DARK CHERRY
- FASCIA BOARD; PAINTED (FB1) SW 6991 BLACK MAGIC
- PREFINISHED ALUMINUM GUTTER AND ROUND DOWNSPOUT (GD1) BLACK
- PREFINISHED HALF-ROUND GUTTER AND ROUND DOWNSPOUT (GD2) BLACK
- PREFINISHED ALUMINUM GUARD AND HANDRAIL SYSTEM (GH1) BLACK
- ARCHITECTURAL ASPHALT ROOF (AS1)
- PREFINISHED METAL LOUVER (ML1) CHARCOAL GRAY
- 26. CAST IN PLACE CONCRETE (CN-1); EXPOSED BOARDFORM 6" HORIZONTAL ORIENTATION
- 27. PERFORATED METAL PANEL (PM1)
- 28. ALUMINUM STOREFRONT SYSTEM, (AL1) BLACK

		BUILDI	NG 1 - BUILD	ING S Q. FOOTA	GE S			
	SOUTH FACING		FACING	NORTH 1-	NORTH 2 -			
MATERIAL	BOULEVARD	WEST	TUBMAN	FACING BURGE	FACING BURGE	INSET AT WEST	INSET AT EAST	TOTAL BRICK
RICK	2167.97	2849.42	1067.71	442.85	2039.79	100.49	60.00	8728.23
BER CEMENT PANEL	2160.92	4689.67	5676.41	2248.00	45.05	679.06	292.50	
TEEL SIDING - WOOD GRAIN LOOK	286.10	553.55	822.53	120.00	117.00	38.25	0.00	
LAZING	1206.83	1960.16	2197.32	863.25	463.08	0.00	0.00	
LUMINUM TRIM	0.00	0.00	0.00	144.00	0.00	0.00	0.00	TOTAL ELEVATION SQ
PAQUE DOOR SURFACE	0.00	94.96	24.44	0.00	46.44	0.00	0.00	FOOTAGE
OTAL ELEVATION SQ. FOOTAGE	5821.82	10147.76	9788.41	3818.10	2711.36	817.80	352.50	33457.75
OTAL OPAQUE ELEVATION SQ. FT.	4614.99	8187.60	7591.09	2954.85	2248.28	817.80	352.50	26767.11
OF TRANSPARENCY FACING R.O.W.	20.73	N/A	22.45	20	.31	N/A	N/A	
OF BRICK MATERIAL OF OPAQUE MATERIAL	17.24			0				

*GENERAL CONTRACTOR TO VERIFY REQUIRED QUANTITIES OF MATERIALS; FOR AHJ REFERENCE ONLY.

BUILDING 1 - ZONING/ HUD MATERIAL CALCULATION 3/4" = 1'-0"

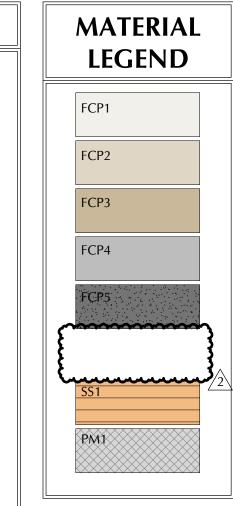



1 BUILDING ELEVATION - SOUTHEAST

KCDC KNOXVILLE'S COMMUNITY **DEVELOPMENT CORPORATION**

AUSTIN HOMES REDEVELOPMENT PHASE 1A BURGE DRIVE AND HARRIET TUBMAN ST.



Tel 865.671.9060 Suite 105 Knoxville, TN 37919 **United States**

Gensler

Suite 300 Chicago, IL 60602 United States Tel 312.456.0123 Fax 312.456.0124

05/06/2020 PLANS REVIEW COMMENTS

05/26/2020 ADDENDUM 1



Project Number

BUILDING ELEVATIONS

As indicated

MF-A3.3



1 BUILDING ELEVATION - NORTHEAST PARKING DECK 1/8" = 1'-0"

ELEVATION NOTES

- 1. CJ = CONTROL JOINT, SEE DETAIL XXXX
- 2. ICJ = INSIDE CONTROL JOINT, SEE DETAIL XXXX
- 3. CONTROL JOINTS TO BE ALIGNED WITH EDGE OF ADJACENT WINDOW OR DOOR FRAME AS SHOWN ON ELEVATIONS. LOCATE CONTROL JOINTS MAXIMUM 25'-0" O.C. WHERE NOT SHOWN. COORDINATE LOCATIONS WITH ARCHITECT.
- PROVIDE CONTROL JOINTS MINIMUM 2'-0" OFF EDGE OF OUTSIDE CORNER IF NOT SHOWN ALIGNED WITH FRAME. ALIGN DOWNSPOUT TO COVER CONTROL JOINTS WHERE APPLICABLE.
- PROVIDE HORIZONTAL CONTROL JOINTS AT LOCATIONS SHOWN ON ELEVATIONS. REFER TO STRUCTURAL DRAWINGS FOR DETAILS.
- VERTICAL CONTROL JOINT FILLER TO MATCH MASONRY COLOR. HORIZONTAL CONTROL JOINT FILLER TO MATCH GROUT COLOR.
- 7. COORDINATE WITH APPLICABLE DIMENSIONS AND DETAILS ON OTHER SHEETS.
- DIMENSIONS ARE TO FACE OF MASONRY, COMPOSITE METAL PANEL, CURTAIN WALL OR EDGE OF OPENING UNLESS NOTED OTHERWISE.
- 10. COORDINATE DOWNSPOUT LOCATIONS WITH ROOF PLAN.
- 11. PROVIDE MASONRY VENEER EXPANSION JOINTS AT INSIDE CORNERS AND INTERSECTIONS WITH DISSIMILAR MATERIALS.

ZONING MATERIAL REQUIREMENTS

PER CITY OF KNOXVILLE ZONING CODE | ARTICLE 9

SECTION 9.3 PRINCIPLE USE STANDARDS (PROPERTY ZONED RN-6)

- 3. MULTI-FAMILY DWELLINGS REQUIRE A MINIMUM OF 20% TRANSPARENCY ON ANY FACADE FACING A STREET AND IS CALCULATED ON THE BASIS OF THE ENTIRE AREA OF THE FACADE.
- 5.a. THE FOLLOWING BUILDING MATERIALS ARE PROHIBITED ON ANY PART OF ANY FACADE:
- i. Plain concrete block ii. PLASTIC
- iii. EXTERIOR INSULATION FINISH SYSTEMS ON THE GROUND FLOOR
- **5.b.** THE FOLLOWING BUILDING MATERIALS ARE PROHIBITED AS A PRIMARY SURFACE FINISH MATERIAL ON ANY FACADE, BUT MAY BE USED AS A DECORATIVE OR DETAIL ELEMENT FOR UP TO 15% OF THE FACADE: i. CORRUGATED METAL
 - ii. ALUMINUM, STEEL, OR OTHER METAL SIDINGS iii. EXPOSED AGGREGATE (ROUGH FINISH) CONCRETE WALL PANELS
 - iv. T-111 COMPOSITE PLYWOOD SIDING v. VINYL SIDING

ELEVATION MATERIALS

- BRICK VENEER; FIELD (BV1) ACME BRICK - MARBLE GRAY; MODULAR; HOLCIM SANTEE BLACK MORTAR BRICK VENEER; FIELD (BV2)
- ACME BRICK STEEL GRAY; MODULAR; HOLCIM FROSTY MORTAR BRICK VENEER; FIELD (BV3) GENERAL SHALE - MISTYHOLLOW; MODULAR; HOLCIM SANTEE BLACK MORTAR BRICK VENEER, FIELD (BV4)

GENERAL SHALE - MISTYHOLLOW; NORMAN; HOLCIM SANTEE BLACK MORTAR

- SMOOTH FACE CMU; ACCENT (CMU1) DOUBLE MONARCH
- BELDEN GRAPHITE; VELOUR TEXTURE, HOLCIM SANTEE BLACK MORTAR
- FIBERGLASS WINDOWS WITH 1" INSULATED GLASS (FW1) FIBER CEMENT SIDING; SMOOTH FACE 6" LAP, MITERED AT CORNERS
- ACCENT (FCS2) SW 7674 PEPPERCORN FIBER CEMENT PANEL (FCP1) - EQUITONE TECTIVA - TE90
- 10. FIBER CEMENT PANEL (FCP2) EQUITONE TECTIVA TE00

FIELD (FCS1) - SW 9166 DRIFT OF MIST

- 11. FIBER CEMENT PANEL (FCP3) EQUITONE TECTIVA TE10 12. FIBER CEMENT PANEL (FCP4) - EQUITONE TECTIVA - TE20
- 13. FIBER CEMENT PANEL (FCP5) EQUITONE TECTIVA MA400 14. STEEL SIDING; WOOD GRAIN LOOK; ACCENT (SS1)
- LONGBOARD DARK CHERRY, 6" V-GROOVE
- 15. ALUMINUM WRAPPED HEADER TRIM (AT1) CHARCOAL GRAY

16. PREFINISHED METAL COPING (MC1) - BLACK

- 18. INSULATED HOLLOW METAL DOOR (HM1) SW 6991 BLACK MAGIC
- 19. FIBERGLASS DOOR WITH HOLLOW METAL FRAME (FD1) STAINED DARK CHERRY
- 20. FASCIA BOARD; PAINTED (FB1) SW 6991 BLACK MAGIC
- 21. PREFINISHED ALUMINUM GUTTER AND ROUND DOWNSPOUT (GD1) BLACK
- 22. PREFINISHED HALF-ROUND GUTTER AND ROUND DOWNSPOUT (GD2) BLACK
- 23. PREFINISHED ALUMINUM GUARD AND HANDRAIL SYSTEM (GH1) BLACK
- 24. ARCHITECTURAL ASPHALT ROOF (AS1)
- 25. PREFINISHED METAL LOUVER (ML1) CHARCOAL GRAY
- 26. CAST IN PLACE CONCRETE (CN-1); EXPOSED BOARDFORM 6" HORIZONTAL ORIENTATION
- 27. PERFORATED METAL PANEL (PM1)
- 28. ALUMINUM STOREFRONT SYSTEM, (AL1) BLACK

	MATERIAL LEGEND	
	FCP1	
	FCP2	
	FCP3	
	FCP4	
سسا	FCPS	
ئ	SS1 PM1	_

BUILDING 1 - BUILDING SQ. FOOTAGES										
	SOUTH FACING		FACING	NORTH 1-	NORTH 2 -					
MATERIAL	BOULEVARD	WEST	TUBMAN	FACING BURGE	FACING BURGE	INSET AT WEST	INSET AT EAST	TOTAL BRICK		
BRICK	2167.97	2849.42	1067.71	442.85	2039.79	100.49	60.00	8728.23		
FIBER CEMENT PANEL	2160.92	4689.67	5676.41	2248.00	45.05	679.06	292.50			
STEEL SIDING - WOOD GRAIN LOOK	286.10	553.55	822.53	120.00	117.00	38.25	0.00			
GLAZING	1206.83	1960.16	2197.32	863.25	463.08	0.00	0.00			
ALUMINUM TRIM	0.00	0.00	0.00	144.00	0.00	0.00	0.00	TOTAL ELEVATION SO		
OPAQUE DOOR SURFACE	0.00	94.96	24.44	0.00	46.44	0.00	0.00	FOOTAGE		
TOTAL ELEVATION SQ. FOOTAGE	5821.82	10147.76	9788.41	3818.10	2711.36	817.80	352.50	33457.75		
TOTAL OPAQUE ELEVATION SQ. FT.	4614.99	8187.60	7591.09	2954.85	2248.28	817.80	352.50	26767.11		
% OF TRANSPARENCY FACING R.O.W.	20.73	N/A	22.45	20	.31	N/A	N/A			
% OF BRICK MATERIAL OF OPAQUE MATERIAL	17.24			ro	8					

4 BUILDING 1 - ZONING/ HUD MATERIAL CALCULATION 3/4" = 1'-0"

KCDC KNOXVILLE'S COMMUNITY **DEVELOPMENT CORPORATION**

AUSTIN HOMES REDEVELOPMENT PHASE 1A BURGE DRIVE AND HARRIET TUBMAN ST.



Tel 865.671.9060 Suite 105 Knoxville, TN 37919 United States

Gensler

11 East Madison Street Suite 300 Chicago, IL 60602 United States

Tel 312.456.0123 Fax 312.456.0124

05/06/2020 PLANS REVIEW COMMENTS

05/26/2020 ADDENDUM 1




Project Number

BUILDING ELEVATIONS

As indicated

MF-A3.4

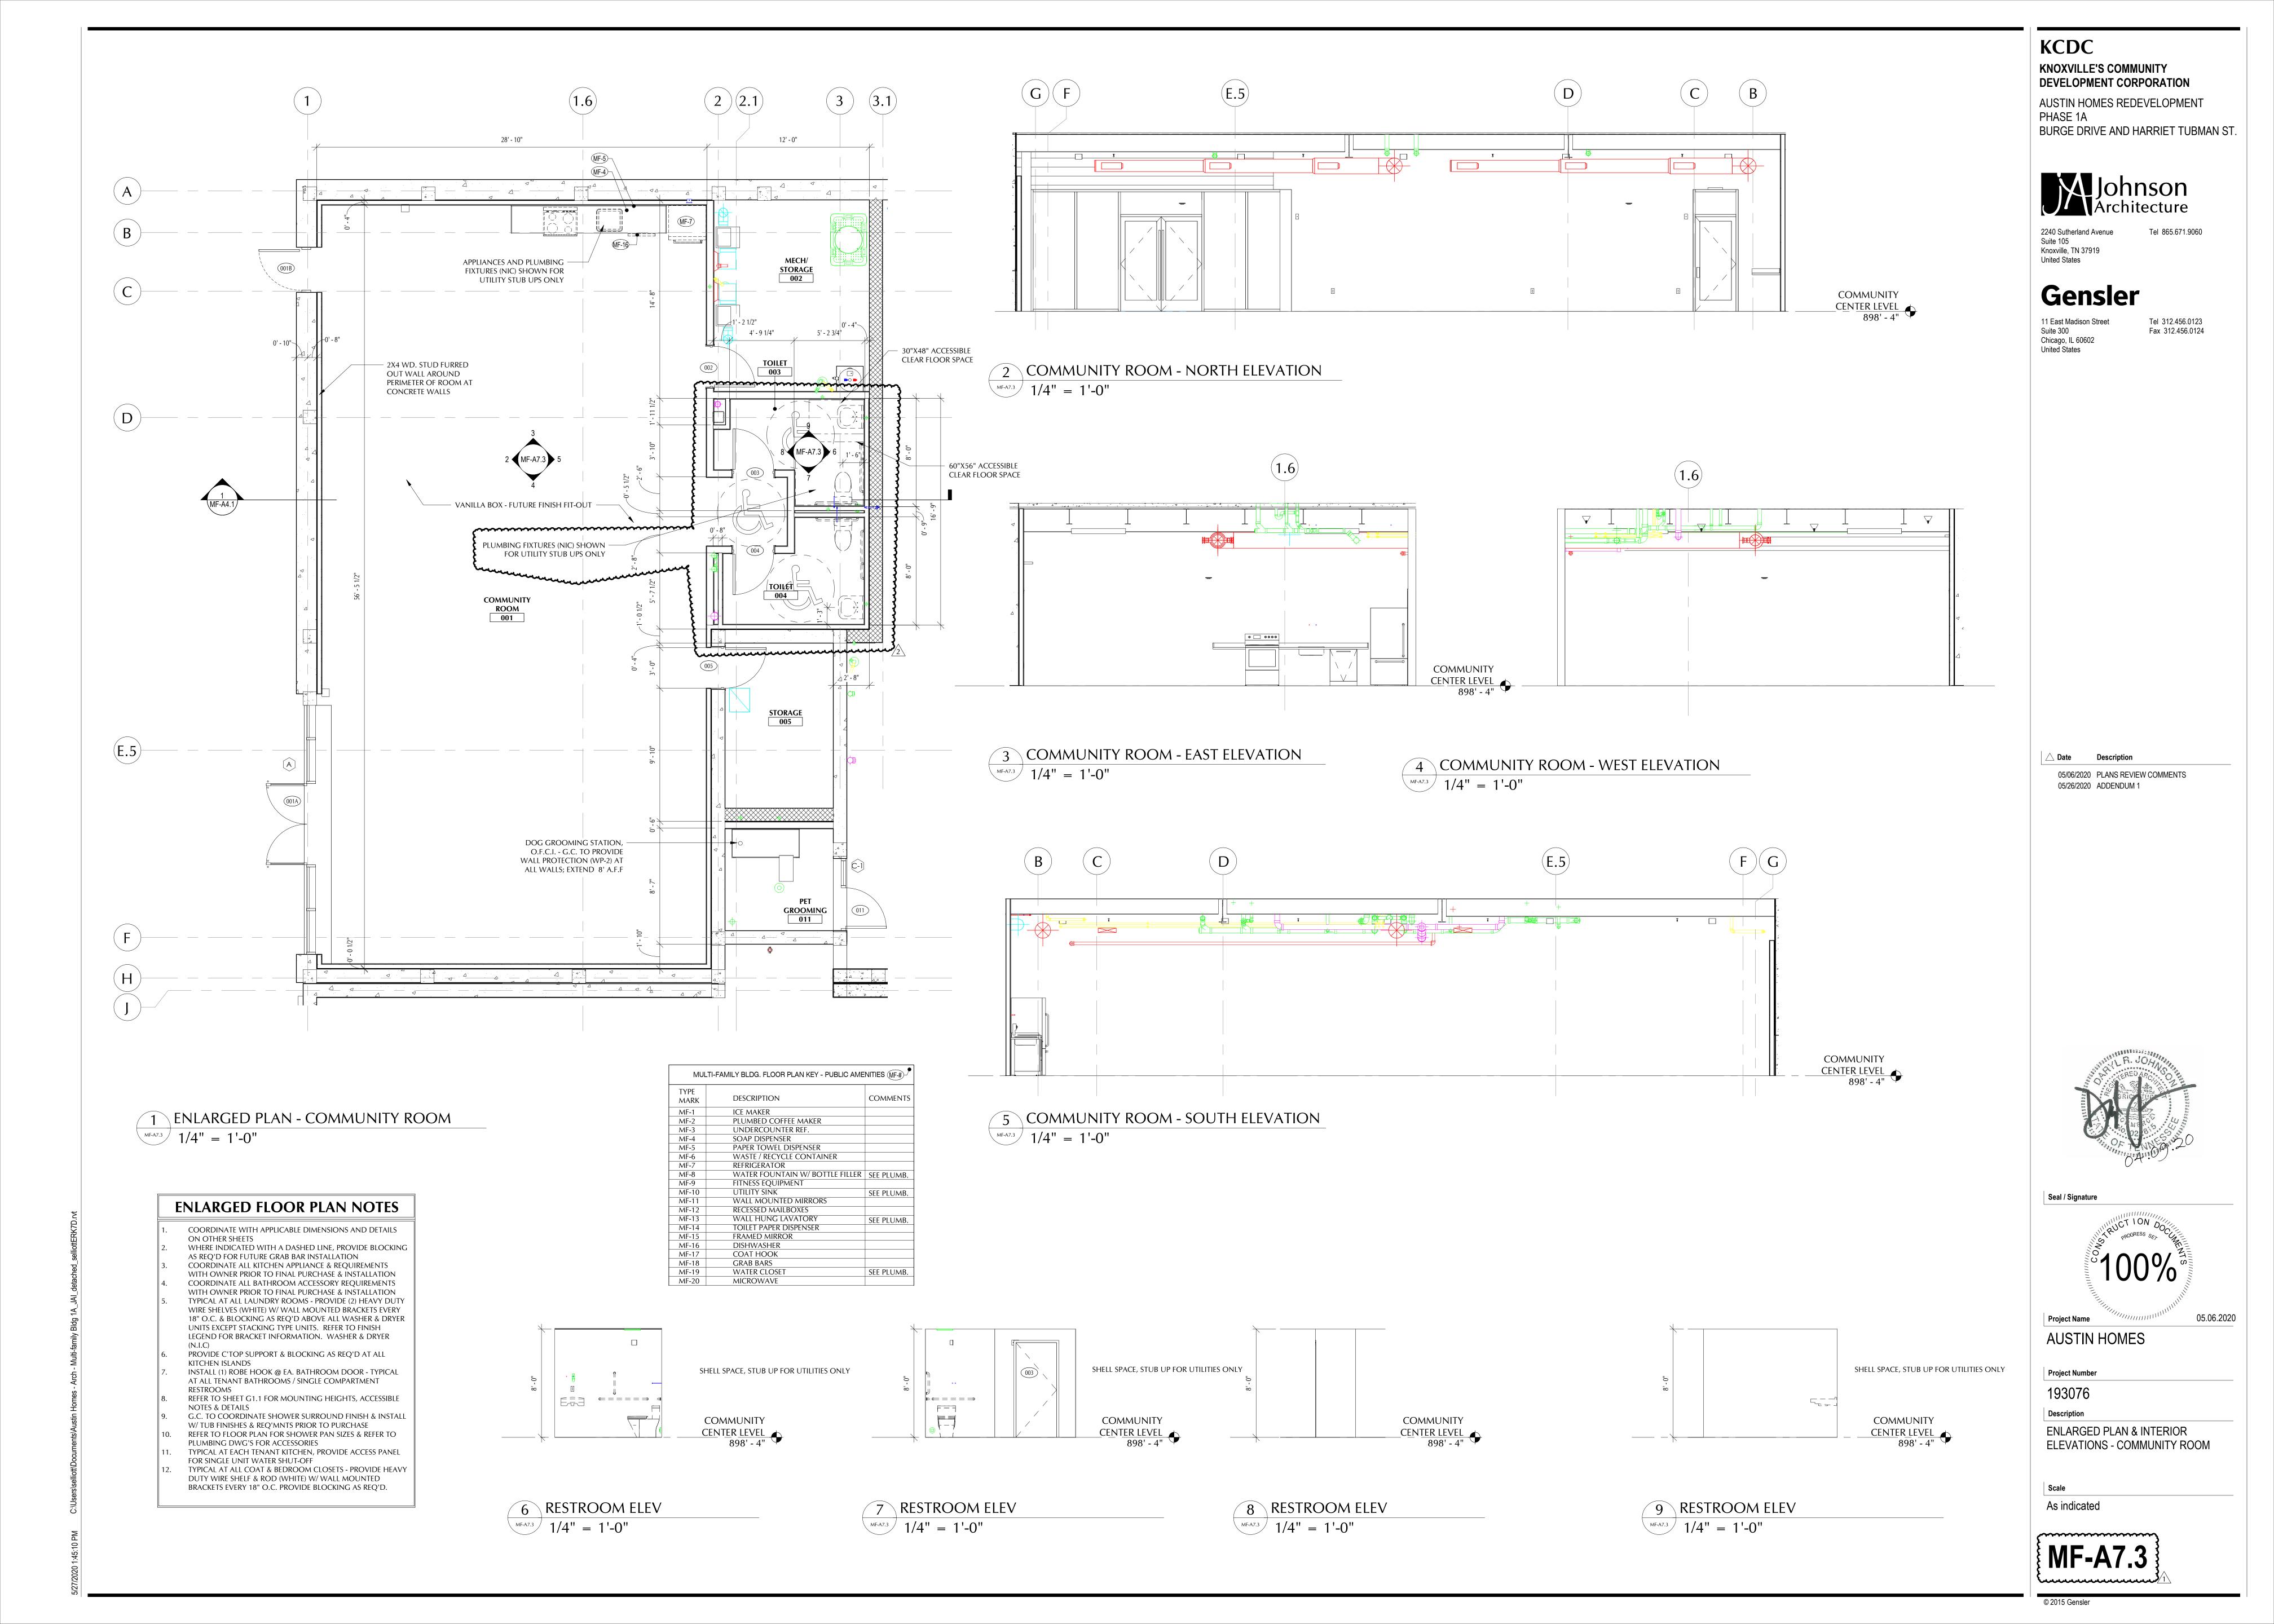

	INTERIOR FINISH LEGEND - STAIR TYPES																						
STAIR TYPE	LOCATION	CEILING FINISH	CEILING FINISH TYPE	WALL FINISH	WALL FINISH TYPE	LANDING Floor Material	LANDING FLOOR & NOSING FINISH TYPE	LANDING WALL BASE	LANDING WALL BASE FINISH TYPE	RISER MATERIAL	RISER FINISH TYPE	TREAD MATERIAL	TREAD FINISH TYPE	NOSING MATERIAL	NOSING FINISH TYPE	STRINGER FINISH	STRINGER FINISH TYPE	HANDRAIL FINISH	HANDRAIL FINISH TYPE	HANDRAIL BRACKET TYPE	GUARDRAIL FINISH	GUARDRAIL FINISH TYPE	NOTES:
#1	TOWNHOME INTERIOR TENANT STAIRWELL	GYPSUM BOARD	(GBC-1)	GYPSUM ROARD	(PNT-1)	WOOD W/ VINYL PLANK	(LVT-1) (SN- 2)	WOOD W/ Rubber	(RB-1)	PAINTED WOOD	(PNT-10)	WOOD W/ VINYL PLANK	(LVT-1)	VINYL	(SN-1)	PAINTED WOOD	(PNT-9)	STAINED WOOD	(WD-2) (STN- 1)	(HD-3)	PNT. GYP. BD. W/ CAPPED LOW WALL	(PNT-1) (WD-3)	
#2	TOWNHOME EGRESS STAIRWELLS	EXPOSED TO STRUCTURE	(EXP)	PAINTED GYPSUM ROARD	(PNT-1)	WOOD W/ RUBBER	(RF-1)	WOOD W/ VINYL	(VB-1)	WOOD W/ INTEGRATED RUBBER	(RF-1)	WOOD W/ RUBBER	(RF-1)	RUBBER	(RF-1)	PAINTED WOOD	(PNT-10)	PAINTED STEEL	(PNT-10)	(HD-3)	PNT. GYP. BD. W/ CAPPED LOW WALL	(PNT-1) (WD-3)	
	TOWNHOME EXTERIOR STAIRWAY																						
#A	MULTI-FAMILY - TYPE A	PAINTED GYPSUM ROARD	(GBC-1)	PAINTED GYPSUM BOARD	(PNT-1)	CONCRETE W/ VINYL PLANK	(LVT-4)	CONCRETE W/ VINYL	(VB-1)	PAINTED METAL	(PNT-10)	METAL PAN W/ RUBBER	(RF-2)	RUBBER	(RF-2)	PAINTED METAL	(PNT-10)	PAINTED METAL	(PNT-10)		PAINTED METAL	(PNT-10)	
#B	MULTI-FAMILY - TYPE B	EXPOSED TO STRUCTURE	(EXP)	PAINTED GYPSUM	(PNT-1)	VARIES		VARIES		VARIES		VARIES		VARIES		VARIES		PAINTED METAL	(PNT-10)		PAINTED METAL	(PNT-10)	

FINISH LEGEND COLOR KEY

APPLIES TO ALL BUILDING

LOCATIONS

APPLIES TO TOWNHOME

FINISHES ONLY

APPLIES TO MULTI-FAMILY

BUILDING FINISHES ONLY

		RC	OM F	INISH SCH	EDULE	E - LEVE	EL 0	0 (PARK	ING)	
NO.	ROOM N	NAME	(CEILING	٧	VALLS		BASE	FLOOR	NOTES
001	COMMUNITY RO		EXF		PNT-			VB-1	SC	
002	MECH/ STORAG	<u>E</u>	EXF		PNT-		_	VB-1	SC	
003	TOILET		GB(I / PNT-	_	TB-1	FT-1	
004	TOILET		GB(I / PNT-	\rightarrow	TB-1	FT-1	
005	STORAGE		EXF	P-1	PNT-	-1	'	VB-1	SC	
007	PARKING		EXF	P-2					CONC.	
800	LOBBY		GBO	C-2	PNT-	-1	I	RB-2	WOC	
009	STORAGE		EXF	P-1	PNT-	-1	,	VB-1	SC	
010	STAIR C		GBO	C-1	PNT-	-1	,	VB-1	RF-2	
011	PET GROOMING	;	EXF	P-1	WP-2	2		VB-1	SC*	
			RC	OOM FINISH	SCHE	EDULE	- LE	VEL 01		
NO. 100	ROOM N	IAME		EILING -2 / SWC	PNT-	WALLS 1		BASE TB-1	FLOOR FT-1	NOTES TOP-1, CAB-1, CAB
			_							TOP-1, CAB-1, CAI
105	CORRIDOR		GBC			1 / PNT		RB-2	LVT-2	
106	TOILET		GBC			/ PNT-		TB-1	FT-1	
107	TOILET		GBC			/ PNT-	1	TB-1	FT-1 / FT-2	
108	LEASING OFFIC	<u> </u>	ACT.		PNT-			RB-2	LVT-2	TOD 4 017 5
109	CONF. ROOM		ACT.		PNT-			RB-2	LVT-2	TOP-1, CAB-2
110	STOR.		ACT.		PNT-			RB-2	LVT-2	
111	PUBLIC LOBBY		_	-2 / SWC		1 / PNT	-5	TB-1	FT-1 / FT-2	
111A			MP-3		PNT-			RB-2	WOC	
	VESTIBULE		MP-3		PNT-			RB-2	WOC	
112	MAIL/RESIDENT	LOBBY	GBC		PNT-			TB-1	FT-1	TOP-1, CAB-2
113	PACKAGES		GBC	-2	PNT-	1		TB-1	FT-1	
114	ELECTRIC METE	ER ROOM	EXP.	-1	PNT-	1	_	VB-1	SC	
115	MECH.		EXP.	-1	PNT-	1	_	VB-1	SC	
116	MECHANICAL		EXP.	-1	PNT-	1		VB-1	SC	
117	BICYCLE ROOM		EXP.		PNT-			VB-1	SC	
118	FITNESS		EXP.		PNT-			VB-1	RBR	WD-4
119	BLDG STORAGE	- E/WKSHP	EXP.			1 / WP-	2	VB-1	SC	
120	CORRIDOR	- * **	EXP.		PNT-			VB-1	SC	
121	LOADING		EXP.		PNT-			VB-1	SC	
122	ELEC.		EXP.		PNT-			VB-1	SC	
123	STAIR A		GBC		PNT-			VB-1	RF-2	
124	STAIR B		GBC		PNT-			VB-1	RF-2	
125	STAIR C		GBC		PNT-			VB-1	RF-2	
			_							
126 127	RESIDENT STO		EXP.		PNT-			VB-1	SC SC	
	TRASH & RECY	JLE KUUM	EXP.		PNT-		1	VB-1		
128	TOILET		GBC			/ PNT-	I	TB-1	FT-1	
129	VESTIBULE		WP-3		PNT-			RB-2	WOC	
130	VESTIBULE		WP-3		PNT-			RB-2	WOC	
NO	BOOM	1AA45		OM FINISH			- LE		FLOOD	NOTEO
NO.	ROOM N	IAME		EILING		WALLS		BASE		NOTES
215	STAIR A		GBC		PNT-			VB-1	RF-2	
216	STAIR B		GBC		PNT-			VB-1	RF-2	
217	TRASH/RECYC		GBC		PNT-			VB-1	SC	
218	ELECT		GBC		PNT-	1		VB-1	SC	
219	CORRIDOR		GBC	-1	PNT-	1 / PNT	-4	RB-2	LVT-2	
			RC	OM FINISH	SCHE	EDULE -	- LE	VEL 03	_	
NO.	ROOM N	AME		EILING		WALLS		BASE		NOTES
315	STAIR A		GBC		PNT-	1		VB-1	RF-2	
316	STAIR B		GBC	-1	PNT-	1	_	VB-1	RF-2	
317	ELECT		GBC	-1	PNT-	1	_	VB-1	SC	
318	TRASH/RECY		GBC	-1	PNT-	1		VB-1	SC	
319	CORRIDOR		GBC	-1	PNT-	1 / PNT	-4	RB-2	LVT-2	
			RC	OOM FINISH	SCHE	EDULE	- LE	VEL 04		
NO.	ROOM NAME	CEILIN	G	WALL	S		BAS	SE	FLOOR	NOTES
415	STAIR A	GBC-1		PNT-1		VB-1			RF-2	
416	STAIR B	GBC-1		PNT-1		VB-1			RF-2	
417	ELECT	GBC-1		PNT-1		VB-1			SC	
418	TRASH/RECYC	GBC-1		PNT-1		VB-1			SC	
419	CORRIDOR	GBC-1		PNT-1 / PN	IT-4	RB-2			LVT-2	
			RC	OM FINISH	SCH	EDULE	- LE	VEL 05		
NO.	ROOM NAME	CEILING	}	WALLS	3	F	BASE	E	FLOOR	NOTES
515	STAIR A	GBC-1		PNT-1		VB-1	اں، ،را		RF-2	140120
516	STAIR B	GBC-1		PNT-1		VB-1			RF-2	
517	ELECT	GBC-1		PNT-1		VB-1			SC	
518	TRASH/RECYC			PNT-1 PNT-1		VB-1			SC SC	
518	CORRIDOR	GBC-1		PNT-1 / PN	T-4	RB-2			_VT-2	
_ ,0		I					ENA!		UNIT TYPES	
F	ROOM NAME	CEILIN		WALLS			BASI		FLOOR	NOTES
		GBC-1		PNT-1		RB-1			LVT-2	1
H.W.	ET	GBC-1		PNT-1		RB-1			LVT-2	
H.W.	ROOM	GBC-1		PNT-1		RB-1			LVT-2	
CLOS		GBC-1		PNT-1		RB-1			LVT-2	CAB-3
CLOS BEDR	IROOM	GBC-1		PNT-1		RB-1			LVT-2	- = -
CLOS BEDR BATH				PNT-1 / PN	IT-2	RB-1			LVT-2	TOP-1, CAB-1, CA
CLOS BEDR BATH LAUN	IDRY			prist I/EP		RB-1			LVT-2 LVT-2	. J. 1, OAD-1, OA
CLOS BEDR BATH LAUN KITCH	IDRY HEN	GBC-1		PNT₋1					_ v i ⁻∠	1
CLOS BEDR BATH LAUN KITCH	IDRY HEN G		~ ~	PNT-1	<u>~~</u> ~	RB-1			LVT-2	~~~~
CLOS BEDR BATH LAUN KITCH LIVIN MECH	IDRY HEN G HOMES	GBC-1 GBC-1	~~	PNT-1	~~~	RB-1	PE		LVT-2	CEE CTAIR TVO
CLOS BEDR BATH LAUN KITCH LIVIN MECH	IDRY HEN G	GBC-1	~~				RF	-1/5N-2	LVT-2	SEE STAIR TYP LEGEND
CLOS BEDR BATH LAUN KITCH LIVIN MECH TOWN EGRESS	IDRY HEN G HOMES 6 STAIR (TYPE #2) 6 STAIR VESTIBULE	GBC-1 GBC-1	~~~	PNT-1		RB-1			LVT-2	SEE STAIR TYP
BEDR BATH LAUN KITCH LIVING MECH TOWN EGRESS (TYPE #	IDRY HEN G HOMES 6 STAIR (TYPE #2) 6 STAIR VESTIBULE	GBC-1 GBC-1 GRC-1	YYY	PNT-1 PNT-1		RB-1 RB-1	LV	-1 / S N-2	HD-3 /WD-2	LEGEND SEE STAIR TYP LEGEND

				INTI	EKIOK F	INISH	1 LEGE	END - CEILINGS								
MATERIAL	ABB	. LOCATION		MA	NUF.	CO	LLECTION /	STYLE	COL	LOR / FINISI	H PRO	ODUCT #	SIZE / T	THICKNESS	NOTES:	
EXPOSED STRUCTUR	E EXP-	(MF) EGRESS STAIRS / BOH CO	PRRIDORS		ATIONAL OSE CORP.		ACOUSTICA APPLIED FIN		PAI	INT, (PNT-8)				FIN	ISH NOTE #P.7
	EXP-		GE				1119									
GYPSUM BOARD CEILING	GBC-	-1 GENERAL							PAI	INT, (PNT-3)					
	GBC-	2 (MF) MAIL/ELEV LOBBIES / PA	CKAGING						PAIN	NT, (PNT-1 0))					_
ACOUSTICAL CEILING	G ACT-	.1 (MF) GENERAL		APAACT	TRONG		/ 15/16" SQ.		WHIT	TE / SMOOT	гн	2822	2.4	1"x24"		
ACCUSTICAL CEILING		· , ,				W/ PRE	CONCEALE	VH. GRID D PANELS					24" x 48	3", 24" x 96"	FIN	SH NOTE #C 12
	ACT-	2 (MF) PUBLIC AREAS		ARMS	TRONG	1	PRELUDE XL SPENSION S			WHITE	<u> </u>	/ARIES		" x 96"	FINI	SH NOTE #G.12
SUSPENDED WOOD)				TROVE	WOO	ODWORKS	GRILLE,	TOF	Woor	AINI	2/ \5 -	12" x 96" x			CU NOTE ::
CEILING	SWC	(MF) LOBBY			TRONG		DOWEL ON	NLY	-	WOOD STA	709	2()DO	SLATS -5/8'	"W x 3-1/4"H 1- SPACING	FINI	SH NOTE #G.12
MATERIAL	ABB.	LOCATION			FACTURER		COLLECTIO			n i Color / Fin	ISH P	RODUCT #	INST	TALLATION		NOTES:
PAINT	PNT-1	GENERAL WALLS		SHERWIN	N WILLIAMS					REPOSE GR	AY	SW 7015				
	PNT-2			SHERWIN	N WILLIAMS				LE	EATHER BOL	JND	SW 6118				
	PNT-3	TENANT INT - DOORS, FRAI WINDOW SILLS (WD-1), WAL I CLG (GBC-1)		BENJAM	IN MOORE				CI	HANTILLY L	ACE	2121-70			REFER	O CEILING & MI: LEGEND
	PNT-4	(ME) PUBLIC CORRIDOR WAIN	SCOT &	SHERWIN	N WILLIAMS					SILHOUET	ГЕ	AF-655				
	PNT-5	(MF) PUBLIC ACCENTS		SHERWIN	N WILLIAMS					LINK GRA	Y	SW 6200				
	PNT-6	(MF) PUBLIC - H.M. DOORS & I	FRAMES	BENJAM	IN MOORE					SILHOUET	ГЕ	AF-655				
	PNT-7	(MF) EGRESS STAIR STEEL COMPONENTS	-	BENJAM	IN MOORE					SILHOUET	ГЕ	AF-655				
	PNT-8	`		SHERWIN	N WILLIAMS					IRON OR	E	SW 7069			REFER	O CEILING LEGE
	PNT-9	SURFACES (WD-3)		BENJAM	IN MOORE				CI	HANTILLY L	ACE	2121-70			STA	IR TYPE #1 & #2
	PNT-1	O (MF) ELEVATOR LOBBIES / PACK CORRIDOR CLG'S (GBC-2		SHERWIN	N WILLIAMS				Р	PUSSYWILLO	DW	SW 7643			REFER 1	O CEILING LEGE
	-	(TH) INTERIOR UNIT HAND!	RAILS		IN 1							**				
STAIN	STN-1	(WD-2)		-	IN MOORE	R FINIS	SHIEGE	ND - W	ALLS	TBD		TBD				
MATERIAL	ABB.	LOCATION	DESCRI		ANUFACTU			ON / STYLE	Т		PRODUCT	#	IZE /	INSTALLAT		NOTES:
WALL BASE			RUBE							OLOK		THI	CKNESS ' H / 1/8"	METHO	D	NOTES:
VVALL BASE	RB-1	TENANT UNITS (MF) TENANT CORRIDORS	RUBE		DHNSONITE/TAR DHNSONITE/TAR			EVEAL PROFILE		ONROCK	RWDC-F		' H / 1/8" H / 1/4"	W/ QUARTER R SHOE MOLD		
	VB-1	EGRESS STAIR LANDINGS / FITNESS	VIN)hnsonite/tar		TRADITIONA ROLL	AL PROFILE /		ONROCK	#29		4"H	SHOL MOLE		
	TB-1	(MF) PUBLIC LOBBY AREAS	TILE B	BASE AT	LAS CONCORD	E USA BU	ullnose / m. Tile (i			OR: FOG /	TBD		6"H	ROVIDE COORD TRIM PIEC		USE W/ GROUT (C
WALL TILE	WT-1	(MF) PUBLIC RESTROOMS	PORCE	LAIN AT	LAS CONCORDI	E USA	EXIST; COLO PORCELA			OR: FOG /	TBD	12"x	24" 9MM	VERTICAL ASI		USE WITH GROU (GRT)
					INITER	D FILT	CLITE	ENID	ISC							
					INTERIOI						001		ADI:CT			N. C.
MATERIAL	ABB.	LOCATION		IPTION	MANUFACT			COLLECTION / S		-	COLOR / FINI TANDARD CO	OR:		SIZE / THICKNES	5	NOTES:
WINDOW COVERINGS	WC-1	TENANT WINDOWS (PASE PID)		OD BUNDS	BUDGET BL		-	MER W/ UVA IN		OK S	TANDARD CO SMOOTH TEXT TANDARD CO	URE OR	TBD	2" SLAT	CONT	Ollbed botter
	WC-2 WC-3	TENANT WINDOWS (BASE BID') (MF) PUBLIC LOBBY SPACES		OD BLINDS SHADES	SWF CONT			mer W/ UVA IN PENNESS / DOL		OK .	TEXTURED FIN	ISH	TBD T300	2" SLAT		JAL PULL W/ VALANO
ELECTRICAL DEVICE DEVICE & COVER	ED1	TYPICAL THROUGHOUT ALL FACILITIES) PROJECT NUAL	_			STANDARD)		WHITE			_		_
	MB1		HOBIZOV.	TAL, FRONT											60 TEN	NT, 4 MAIL DROPS
MAILBOXES	MF-12	(MF) BUILDING #1	LOAD EXTERIOR	ING W/				R TO PROJECT							PARCEL (1) PEDE	STAL PER (2)
	MB2	(TH) BUILDING #2 - #9		MOUNTED			KEFER	R TO PROJECT I	MANU	, st.						NGS PER USPS STDS
TOILET ACCESSORIES	B-#	TYPICAL @ ALL RESTROOMS					REFER	r to project	MANU	AL						O ENLARGED FLOO Y LEGENDS
	_															
INTERIOR SIGNAGE		TYPICAL THROUGHOUT ALL FACILITIES					REFER	R TO PROJECT	MANU	AL					EXTERIO	R & INTERIOR
DOOR STOP		TENANT INTERIOR DOORS					REFER	r to project i	MANU	AL						
_				TV CT 1 T				TO PRO	44	1.0						
KITCHEN APPLIANCES	K-#	TYPICAL @ ALL KITCHENS		GY STAR NT, TYPICAL				TO PROJECT N GED PLAN KEY							OWNER	FURNISHED
FIRE EXTINGUISHER	FEC	TYPICAL @ TENANT KITCHENS		MOUNTED FCHEN SINK	ABC TYI	PE	REFER	R TO PROJECT	MANU	AL	TBD					
	_							SSIC, SQUARE & F		IC I E PAN						
SHOWER PAN BASE	B-10	TENANT BATHROOMS		R PAN W/ AL CURB	MINCEY MARBL	E MANUF.		DWG'S			WHITE, NON-S FINISH	SP-(V/	ARIES)-C/SF	36"x36", 30"x60'		PER WALL FINISH , NOTE #G.9, G.15
WALL MNT. MIRROR	MF-11	FITNESS ROOM		CIAL GRADE	FAB GLASS & N		1	ON TEMPEREI SAFETY BACK			CLEAR, FLA POLISHED ED			VARIES / 1/4"	1	DE CONCEALED TING CLIPS
			. UL		TERIOR F						- FIST ILU EL	-		INICT		. S CEII J
MATERIAL	ABB.	LOCATION TENANT UNIT- GEN FLOORING & (TH)	DESCRIPTIO FLOATING	G MAN	UFACTURER		COLLECTION PARK / FLOOR		F	COLOR /		PRODUCT #	SIZE / THICKNES 5.8"x37"	1/3 RANDO	M PRO	NOTES:
LUXURY VINYL PLANK	LVT-1	STAIR #1 TREADS & LANDINGS (MF) TENANT CORRIDORS & UNITS	FLOOR GLUE-DOV	MAN	NINGTON	CITYP	PARK / FLOOR NATURE'S	PATH		WINDSOR O		12372	6MM 6"x36"	STAGGEREI 1/3 RANDO	M PRO	vide underlayme vide underlayme
													2.5MM	STAGGERE		
STAIR NOSING	SN-1	(TH) INTERIOR STAIR TYPE #1	VINYL	NOV	/A FLOOR		ERSATRIM / VI			ONTARIOR	OAK / FOG	NOO021-SAM	1 2"X1"	DOWN W/ VI	-VE NE	FER TO STAIR FINISI LEGEND
	SN-2	(TH) EGRESS STAIR TYPE #2	VINYL	JOHSON	IITE / TARKETT		VINYL STAIR VISUALLY IM	nosing for 1 Mpaired	THE	COLOR: MO	DONROCK	VIRCN-29-A				FER TO STAIR FINIS LEGEND
CTAIDWELL SS.	DE :	TINESCO	BL:C1	, ,,,,,	UTC / T · S·····	STAIRTREA	AD W/ INTFG	RATED RISER /	#40	COLOR: MO	DONROCK	VIC.	c 1		RF	fer to stair finis
STAIRWELL SOLUTION	RF-1	(TH) EGRESS STAIR TYPE #1 (MF) EGRESS STAIR	RUBBER RUBBER		IITE / TARKETT	"BLACK"	" CO-EXTRUD EAD W/O RISI	ED VINYL INSE ER / #40 "BLAC	RT	TEXTURE: [DIAMOND DONROCK	VICN-29-N VICNN-29-TF	1/8" ga			LEGEND FER TO STAIR FINIS
	4	,, ESILES STAIN	,.ouck	75/150/		CO-	-EXTRUDED V	INYL INSERT		TEXTURE: [DIAMOND		,,o ga			LEGEND
PORCELAIN TILE	FT-1	(MF) LOBBY, TLTS, AMMENITY		ATALS CO	ONCORDE USA	EXIST; (COLOR BODY	PORCELAIN TIL	E C	COLOR: FOG /	MATTE FINISH		12"x24" 9MM	VERTICAL ASH	LAR US	E WITH GROUT (GR 1
WALK-OFF CARPET	WOC	(MF) ENTRY VESTIBULES	MODULAR 1	TILE M	OHAWK	TUFF	F STUFF II / ST	EP IN STYLE II		IRON	ORE	#983	24"x24"	QUARTER-TU	RN	
RUBBER SPORTS FLOOR	RBR	(MF) FITNESS ROOM	MODULAR 1	TILE MAA	ININGTON		RESET / MC	DDULAR		GRAY 1	TONES	#827	18"x18" /	MONOLITHI	С	
5 / EOOR		. ,		WAN			, IVIC	•		<i></i>		.521	3/8"			
SEALED CONCRETE	SC-1	MECH., ELEC., WATER METER, FIRE PUMP; STORAGE, BIKE, CORRIDOR	POURED		_		_			_		_				CONCRETE CURB @ METER & FLOOR DRA
PEDESTRIAN TRAFFIC																
TOPPING	PTT	LOADING ROOM	APPLIED													
CONCRETE "INFILL"		EXIT STAIRS													P	Y SEALED OR COLOR REASSEMBLED STEE
																TRIMCERS AND RAN
GROUT	GRT	(MF) TILED FLOORS & WALLS	USE W/ FT FT-2, WT	-1 LA	TICRETE		POXY POWE	_		ТВ	D					
				IN	TERIOR F	INISH	LEGENI	D - MILL	WO	RK						
MATERIAL	ABB.	LOCATION		DESCRIPTIO			ACTURER			N / STYLE		/ FINISH	PRODUC			NOTES:
COUNTERTOP	TOP-2	TYPICAL COUNTERTOP	CHAME	Z W/ 4" H BACK ERED NOSING	PROFILE R		S GRANITE &			LECTION JTEGRAL SINK		QUAY	TD-	1/2" TH		
	TOP-2	TENANT - VANITY TOP, TYPICAL	CULTURED) marble, inte	JUNAL SINK	MARBL		LEVEL #1 FIN	noH, IN	itegral sink	TI	BD	TBD	TBD		
CABINETS	CAB-1	UPPER CABINETS		ALED HINGES, D /ERS, STANDAR		ECHELON	CABINETS		RWICH NED W			RCH MAPLE TOFFEE				
	CAB-2	LOWER CABINETS	CONCEA	/ers, standar Ned Hinges, d /ers, standar	OOVETAIL	ECHELON		"NOR	RWICH		SPECIES	: BIRCH R: SLATE				
	CAB-3	TENANT VANITY CABINET	CONCEA	LED HINGES, E /ERS, STANDAR	OOVETAIL	ECHELON	CABINETS	"NOR	RWICH		SPECIES	: BIRCH R: SLATE				
								EBO: -	A 4 4 * *	E CT+						
HARWARE	HD-1	ALL CABINETS	CA	BINET DOOR P	ULL	ECHE	ELON	FROM CAB. PRO	MANUF DDUCT		' TI	BD	TBD	TBD		REFER TO INTERIOR
	HD-2	KITCHEN ISLAND C'TOP	C'TO	P SUPPORT BRA	ACKET (CENTERLINE	E BRACKETS	FRONT MOU HIDDE		PLUS BRACKE Equal	T BL	ACK	FMP	8"x6*		ELEVATIONS FOR ATIONS - MOUNT WALL STUD
	HD-3	(TH) INTERIOR STAIR RAILING		RAIL SUPPORT E		ТВ	BD		TBD		BL	ACK	TBD	TBD		
	HD-4	TENANT CLOSETS		DUTY" - WIRE SH HANGING ROD	I	ТВ	BD		TBD		WH	HITE	TBD	TBD	PR	OVIDE BLOCKING A REQUIRED
	WE.	(TLI) INTERIOR VIEWS		DAINITED	D.			DEEES -	DPC'-	T 844577	P.C.	(DNIT 2)				
	WD-1	(TH) INTERIOR WINDOW SILLS (TH) INTERIOR HAND RAIL		PAINTED WOOI D & STAINED V				REFER TO F		PROJ. MANUA		(PNT-3) (STN-1)				PAINT LEGEND FOR
	WD-3	(TH) INTERIOR STAIR COMPONENTS		PAINTED WOO						CT MANUAL		(PNT-9)			SEE P	'ain information aint & stair legen more informatio
_	WD-4	(MF) OPEN SHELVING, FITNESS		PAINTED WOO	D			PAINT	GRADE	WOOD	PAINT,	(PNT-8)				

INTERIOR FINISH LEGEND - CEILINGS

INTERIOR FINISH NOTES - GENERAL

- G.1 ALL INTERIOR FINISHES SHALL COMPLY WITH CHAPTER 8 OF THE 2018
- INTERNATIONAL BUILDING CODE AND NFPA 101, 2012 G.2 ALL INTERIOR FINISH MATERIALS SHALL BE INSTALLED ACCORDING TO
- MANUFACTURERS' RECOMMENDATIONS G.3 ALL INTERIOR FINISHES SHALL BE PROVIDED AS SPECIFIED. SUBSTITUTIONS SHALL
- COMPLY WITH SPECIFICATION SECTIONS 01.25.13 AND 01.25.33 G.4 PROVIDE 5% ATTIC STOCK FOR ALL INTERIOR MATERIALS, ONCE PUNCH LIST HAS
- BEEN COMPLETED G.5 GENERAL CONTRACTOR TO PROVIDE SAMPLE OF ALL STAINED WOOD FINISHES
- TO DESIGNER FOR APPROVAL PRIOR TO INSTALLATION G.6 GENERAL CONTRACTOR TO PROVIDE FULL SIZE SAMPLE OF WINDOW SHADE TO
- DESIGNER FOR APPROVAL PRIOR TO FABRICATION AND INSTALLATION
- G.7 PROVIDE UNPAINTED PLYWOOD-FACED WALLS, TYP. AT ALL ELECTRICAL ROOMS FOR DEVICE MOUNTING
- G.8 MATERIALS SHOWN WITH AN (*) SHALL COORDINATE WITH CORRESPONDING
- ALTERNATE G.9 PRIOR TO CONSTRUCTION, CONTRACTOR TO SUBMIT ALL SAMPLES TO
- ARCHITECT FOR REVIEW AND APPROVAL. G.10 NOT USED
- G.11 PROVIDE MOISTURE RESISTANT GYPSUM BOARD IN WET AREAS, TYPICAL

ENSURE A CLEAN & FINISHED INSTALLATION

- G.12 G.C. TO PROVIDE ALL MANUF. RECOMMENDED CEILING TRIM ACCESSORIES INCLUDING BUT NOT LIMITED TO TRIM, CLIPS, ACOUSTICAL BACKER ETC. TO
- G.13 REFER TO ENLARGED FLOOR PLAN & INTERIOR ELEVATIONS; TH GENERAL DETAILS, SHEET SERIES TH.G.2 & MF.A7 FOR INTERIOR FINISH & EQUIPMENT DETAILS & COORDINATION
- G.14 REFER TO MISC. FINISH LEGEND FOR ELECTRICAL DEVICE & SWITCH PLATE DETAILS
- G.15 G.C. TO COORDINATE SHOWER SURROUND FINISHES & INSTALLATION REQ'MNTS WITH BATHTUB AND SHOWER PAN PRODUCTS PRIOR TO PURCHASE. REFER TO PLUMBING DRAWINGS & MISC. FINISH LEGEND FOR MORE INFORMATION.

INTERIOR FINISH NOTES - PAINT

- **P.1** ALL GYP WALLS SHALL BE PAINTED WITH AN EGGSHELL FINISH, U.N.O.
- **P.2** ALL GYP CEILINGS SHALL BE PAINTED WITH A FLAT FINISH, U.N.O. P.3 ALL H.M. DOOR & FRAMES SHALL BE PAINTED WITH A SEMI-GLOSS FINISH,
- U.N.O.
- P.4 NOT USED P.5 NOT USED
- P.6 ALL GYPSUM WALL BOARD TO BE PAINTED PNT-1 U.N.O.
- P.7 PAINTING OF EXPOSED CEILING STRUCTURE SHALL INCLUDE ALL SUSPENDED ELEMENTS, INCLUDING BUT NOT LIMITED TO MECHANICAL DUCTS, ELECTRICAL CONDUIT, SUSPENSION CABLE AND OTHER STRUCTURAL ELEMENTS

INTERIOR FINISH NOTES - FLOORING

- **F.1** ALL FLOOR SURFACES SHALL BE PATCHED, LEVELED, SMOOTHED AND CLEAN, PRIOR TO FINISHED FLOOR MATERIAL INSTALLATION F.2 ALL CARPET SHALL BE CLASS "II"
- **F.3** ALL FLOORING MATERIALS ARE TO EXTEND BENEATH MILLWORK, TYPICAL.
- **F.4** PROVIDE CONTROL JOINTS, AS REQUIRED BY MANUFACTURERS'
- RECOMMENDATION F.5 ALL RUBBER BASE SHALL BE PROVIDED IN ROLL FORM. ALL SEAMS MUST OCCUR AT INSIDE CORNERS, IF POSSIBLE. PRE-FABRICATED OUTSIDE CORNERS AND 48"
- STRIPS ARE NOT ACCEPTABLE. **F.6** INCLUDE INLAID VISIBILITY MARKER/ABRASIVE INSERT AT STAIR NOSING, PER
- F.7 COORDINATE LOCATIONS OF FLOOR DRAINS AND SLOPE POURED FLOORING MATERIALS TO DRAIN GRADE REQUIREMENTS
- F.8 GENERAL CONTRACTOR TO PROVIDE TRANSITION STRIPS FOR SMOOTH TRANSITION FROM ALL FLOORING MATERIAL TYPE CHANGES
- **F.9** ALL EXPOSED TILE EDGES SHALL BE FINISHED WITH COORDINATING TILE ACCESSORIES (I.E. BULLNOSE) OR SCHLUTER TRIM
- **F.10** ALL GROUT SHALL BE EPOXY U.N.O. PROVIDE ALTERNATE PRICING FOR "POWER
- GROUT", BY TILE DESIGNATION, IN LIEU OF EPOXY GROUT F.11 PROVIDE CONTROL JOINTS, AS REQUIRED BY MANUFACTURERS'
- RECOMMENDATION F.12 CONTRACTOR SHALL PROVIDE APPROPRIATE SEAM SEALANT FOR ALL
- CARPET TRANSITIONS.
- F.13 CONTRACTOR SHALL PROVIDE APPROPRIATE GROUT & SEALANT FOR ALL FLOOR & WALL TILE APPLICATIONS.
- F.14 PROVIDE COORDINATING ACCESSORIES & TRIM PER MANUF. RECOMMENDED STANDARDS & COORDINATE WITH OWNER PRIOR TO INSTALLATION.

INTERIOR FINISH NOTES - MILLWORK

- M.1 COORDINATE WITH APPLICABLE DIMENSIONS AND DETAILS ON OTHER SHEETS M.2 NOTES AND DETAILS ARE TYPICALLY APPLICABLE TO SIMILAR ITEMS ELSEWHERE
- ON THE SHEET M.3 FIELD-VERIFY ALL CASEWORK DIMENSIONS PRIOR TO FABRICATION
- M.4 PROVIDE FILLER PANELS, WHERE REQUIRED, A MAXIMUM OF 3" IN WIDTH
- M.5 PROVIDE RECESSED PULL HARDWARE AT ALL CASEWORK CABINETS. UNLESS NOTED OTHERWISE. LOCATE PULLS AT TOP HORIZONTAL EDGE OF DRAWERS AND INSIDE VERTICAL EDGE OF DOORS. FINISH SELECTED FROM MANUF.

STANDARD OPTIONS. VERIFY WITH ARCH. PRIOR TO INSTALLATION.


- M.6 PROVIDE 4" BACKSPLASH, UNLESS OTHERWISE NOTED. RETURN BACKSPLASH AT WALL TYP.
- M.7 PROVIDE FINISHED SURFACES AT ALL EXPOSED SURFACES AND EDGES, PLASTIC
- LAMINATE UNLESS OTHERWISE NOTED M.8 COORDINATE ALL CASEWORK WITH OWNER-FURNISHED EQUIPMENT AS
- REQUIRED M.9 PROVIDE CORD-DROP GOMMETS AS REQUIRED FOR EQUIPMENT OR AS
- DIRECTED BY THE OWNER M.10 PROVIDE 1-INCH RADIUS AT EXPOSED TOP CORNERS UNLESS OTHERWISE NOTED
- M.11 ALL CABINETS SHALL BE REVEAL OVERLAY CONSTRUCTION
- M.12 CASEWORK CONTRACTOR SHALL BE RESPONSIBLE FOR THE COMPLETE INSTALLATION OF CASEWORK.
- M.13 TYPICAL BRACKET FOR WORKSURFACE SUPPORTS, INSTALLED PER MANUF.
- RECOMMENDATIONS
- M.14 PROVIDE ADEQUATE BLOCKING IN WALLS TO SUPPORT ALL HANGING CABINETRY AND UNDER COUNTER SUPPORTS.
- M.15 CONTRACTOR TO VERIFY ALL DIMENSIONS IN FIELD PRIOR TO FABRICATION
- M.16 NOT USED M.17 NOT USED
- M.18 COORDINATE INSTALLATION OF ELECTRICAL COMMUNICATIONS OUTLETS WITH RESPECTIVE TRADES
- M.19 WALL CABINETS ARE 14" DEEP, AND BASE CABINETS 24" DEEP WITH A 25"
- COUNTERTOP AND 4" BACKSPLASH UNLESS NOTED OTHERWISE
- M.20 PROVIDE SCHEDULED BASE MATERIAL AT ALL CABINETS UNLESS NOTED OTHERWISE
- M.21 NOT USED M.22 ALL JOINTS IN SOLID SURFACE AND QUARTZ COUNTERTOPS SHALL BE IDENTIFIED ON SHOP DRAWINGS, FOR REVIEW AND APPROVAL BY THE DESIGN TEAM, PRIOR TO FABRICATION

∠ Date Description

05/26/2020 ADDENDUM 1

05/06/2020 PLANS REVIEW COMMENTS

Seal / Signature

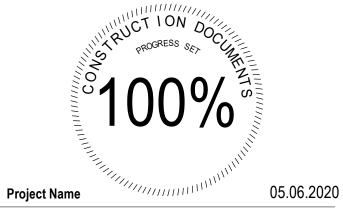

AUSTIN HOMES

Project Number

193076

Description INTERIOR ROOM FINISH LEGEND & FINISH NOTES

As indicated

© 2015 Gensler

Tel 865.671.9060

Tel 312.456.0123

Fax 312.456.0124

KCDC

PHASE 1A

2240 Sutherland Avenue

Gensler

11 East Madison Street

Chicago, IL 60602

United States

Knoxville, TN 37919

United States

Suite 105


Suite 300


KNOXVILLE'S COMMUNITY

DEVELOPMENT CORPORATION


AUSTIN HOMES REDEVELOPMENT


BURGE DRIVE AND HARRIET TUBMAN ST.

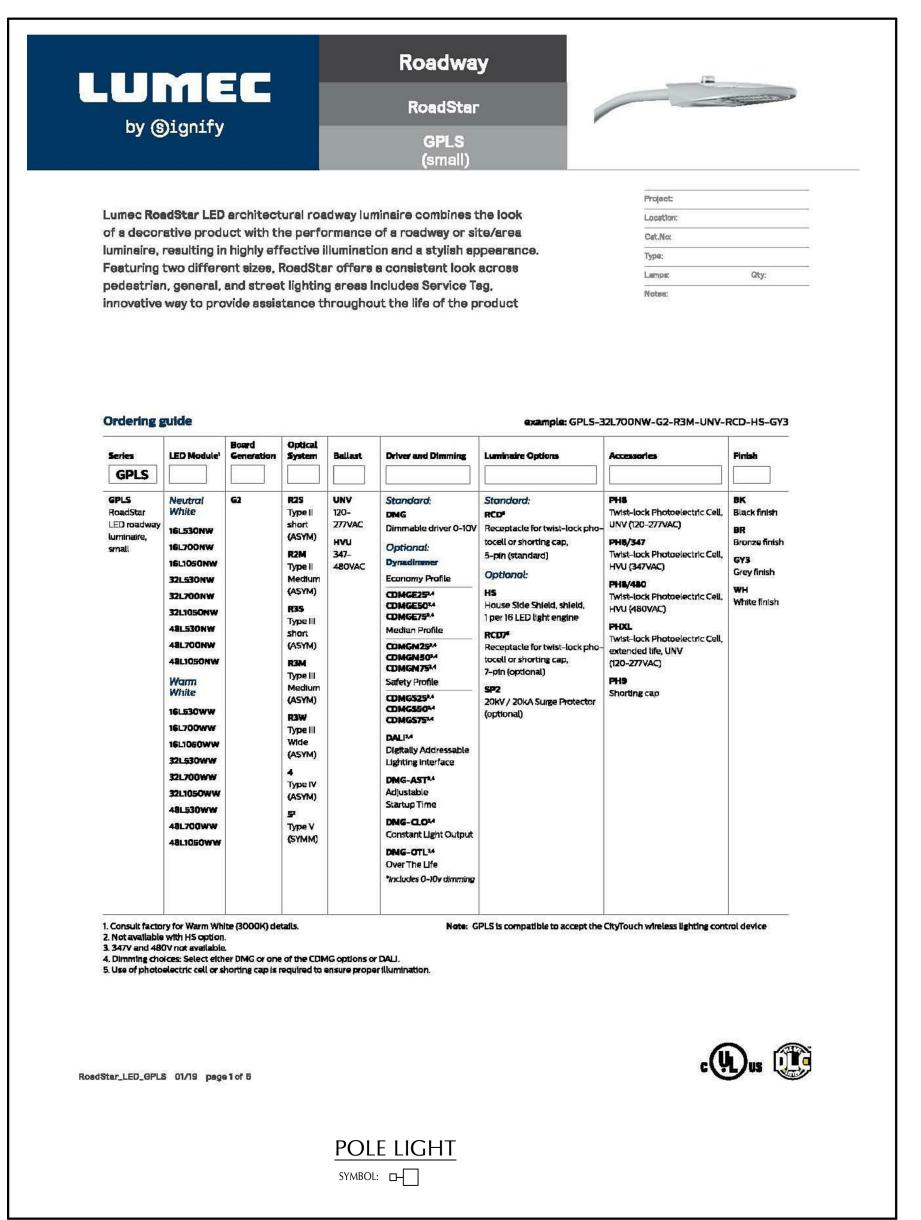

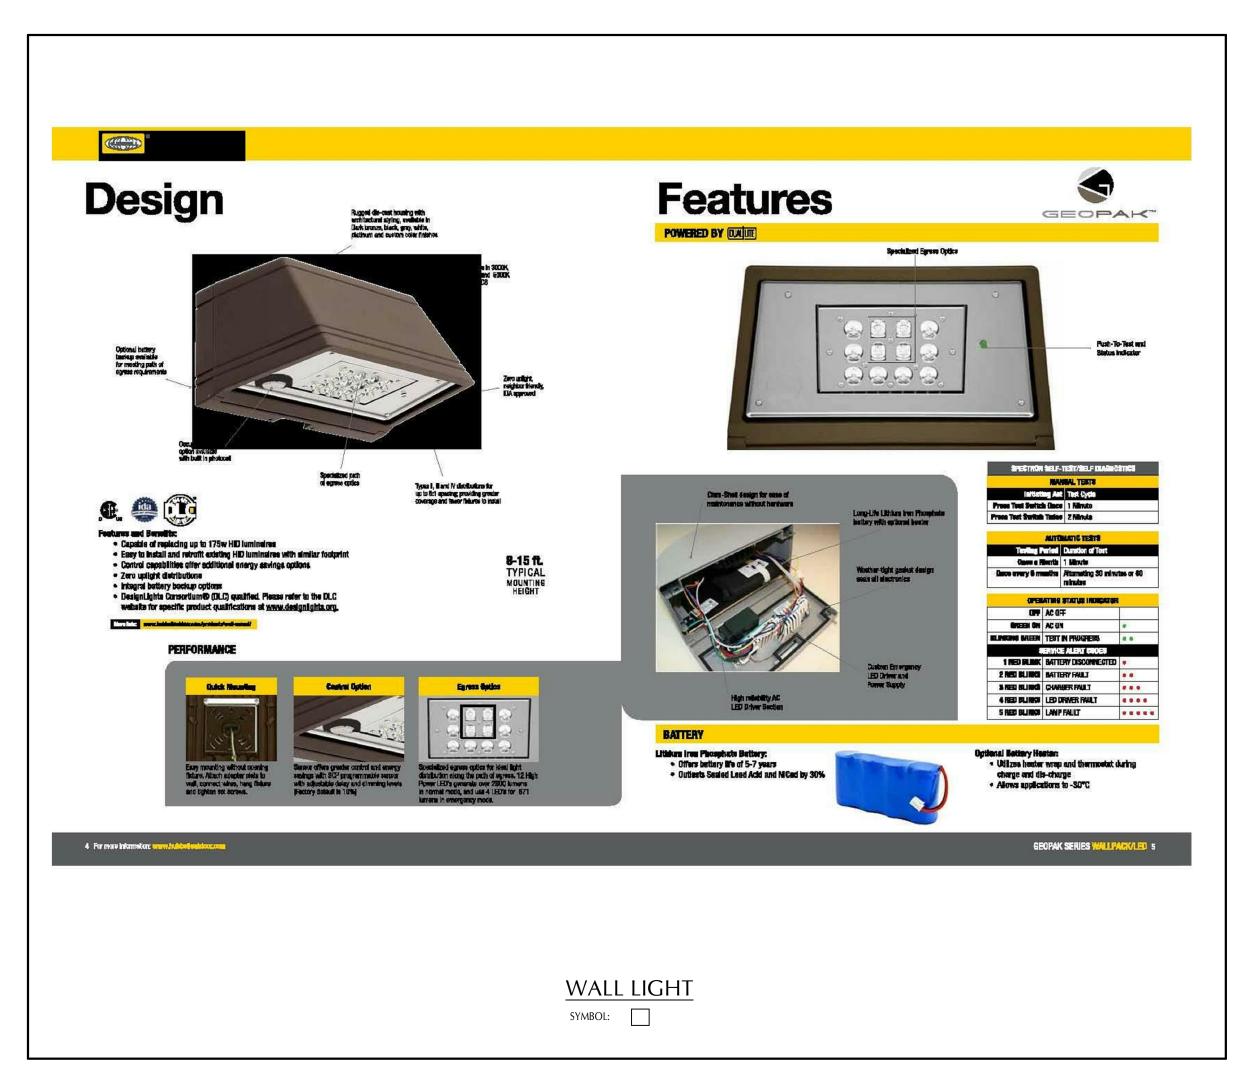



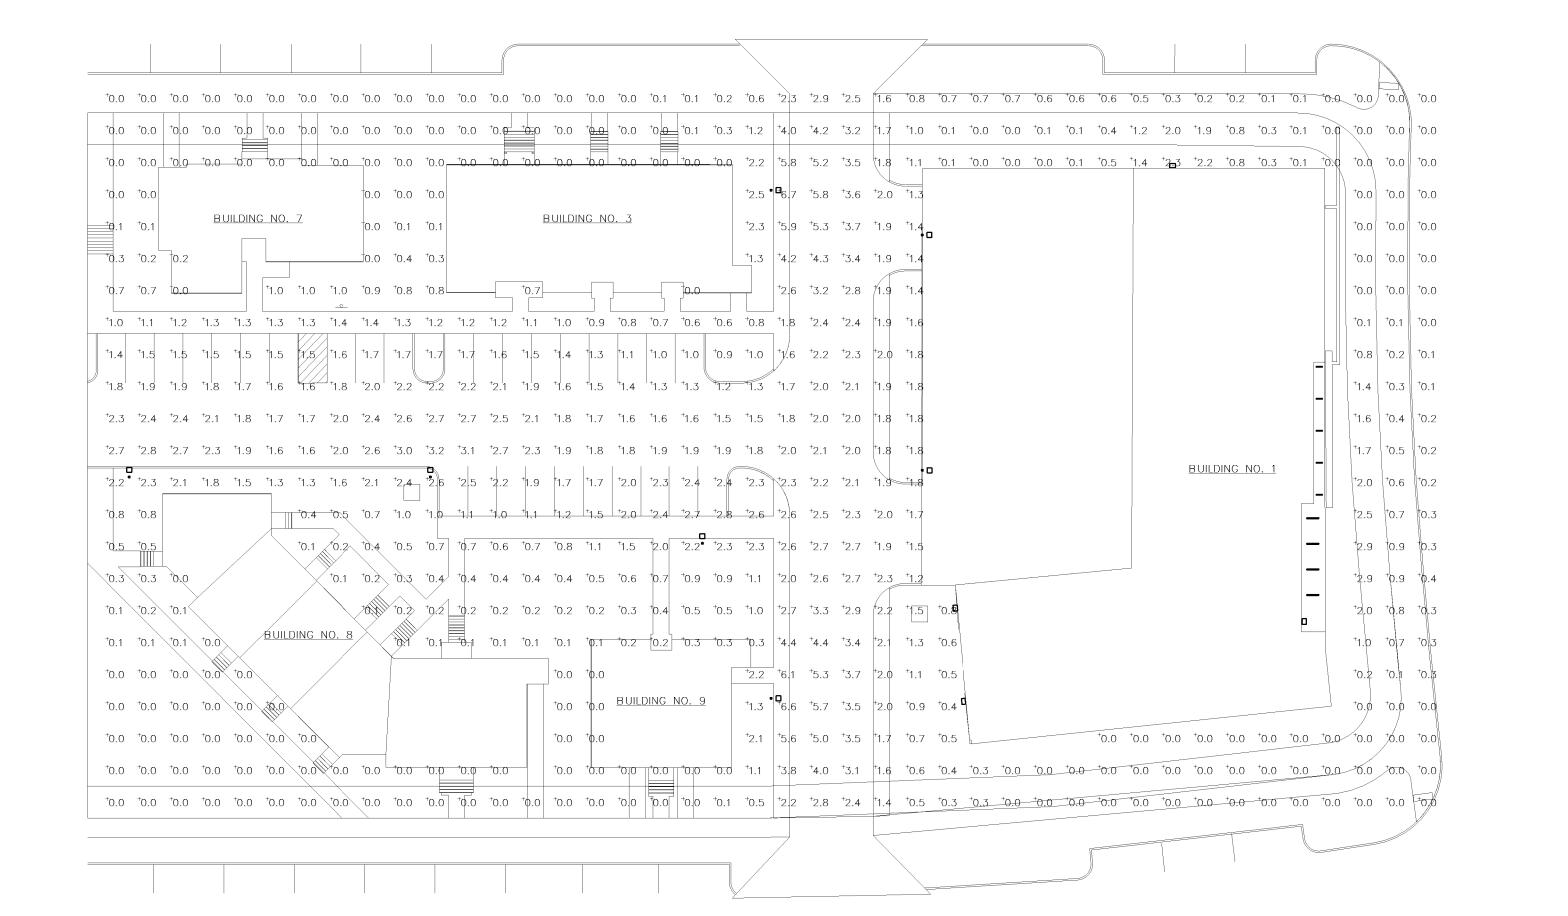

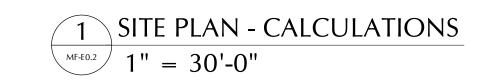

KCDC

KNOXVILLE'S COMMUNITY DEVELOPMENT CORPORATION AUSTIN HOMES REDEVELOPMENT PHASE 1A BURGE DRIVE AND HARRIET TUBMAN ST.




2240 Sutherland Avenue Tel 865.671.9060 Suite 105 Knoxville, TN 37919 United States

Gensler

Tel 312.456.0123 11 East Madison Street Suite 300 Fax 312.456.0124 Chicago, IL 60602 **United States**

1 5-26-2020 REVISION 2

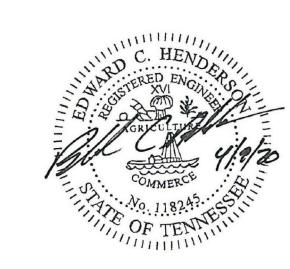

Seal / Signature




Austin Homes Multi - Family

Project Number 20502

Description SITE PLAN - LIGHTING CALCULATIONS


1" = 30'-0"

MF-E0.2

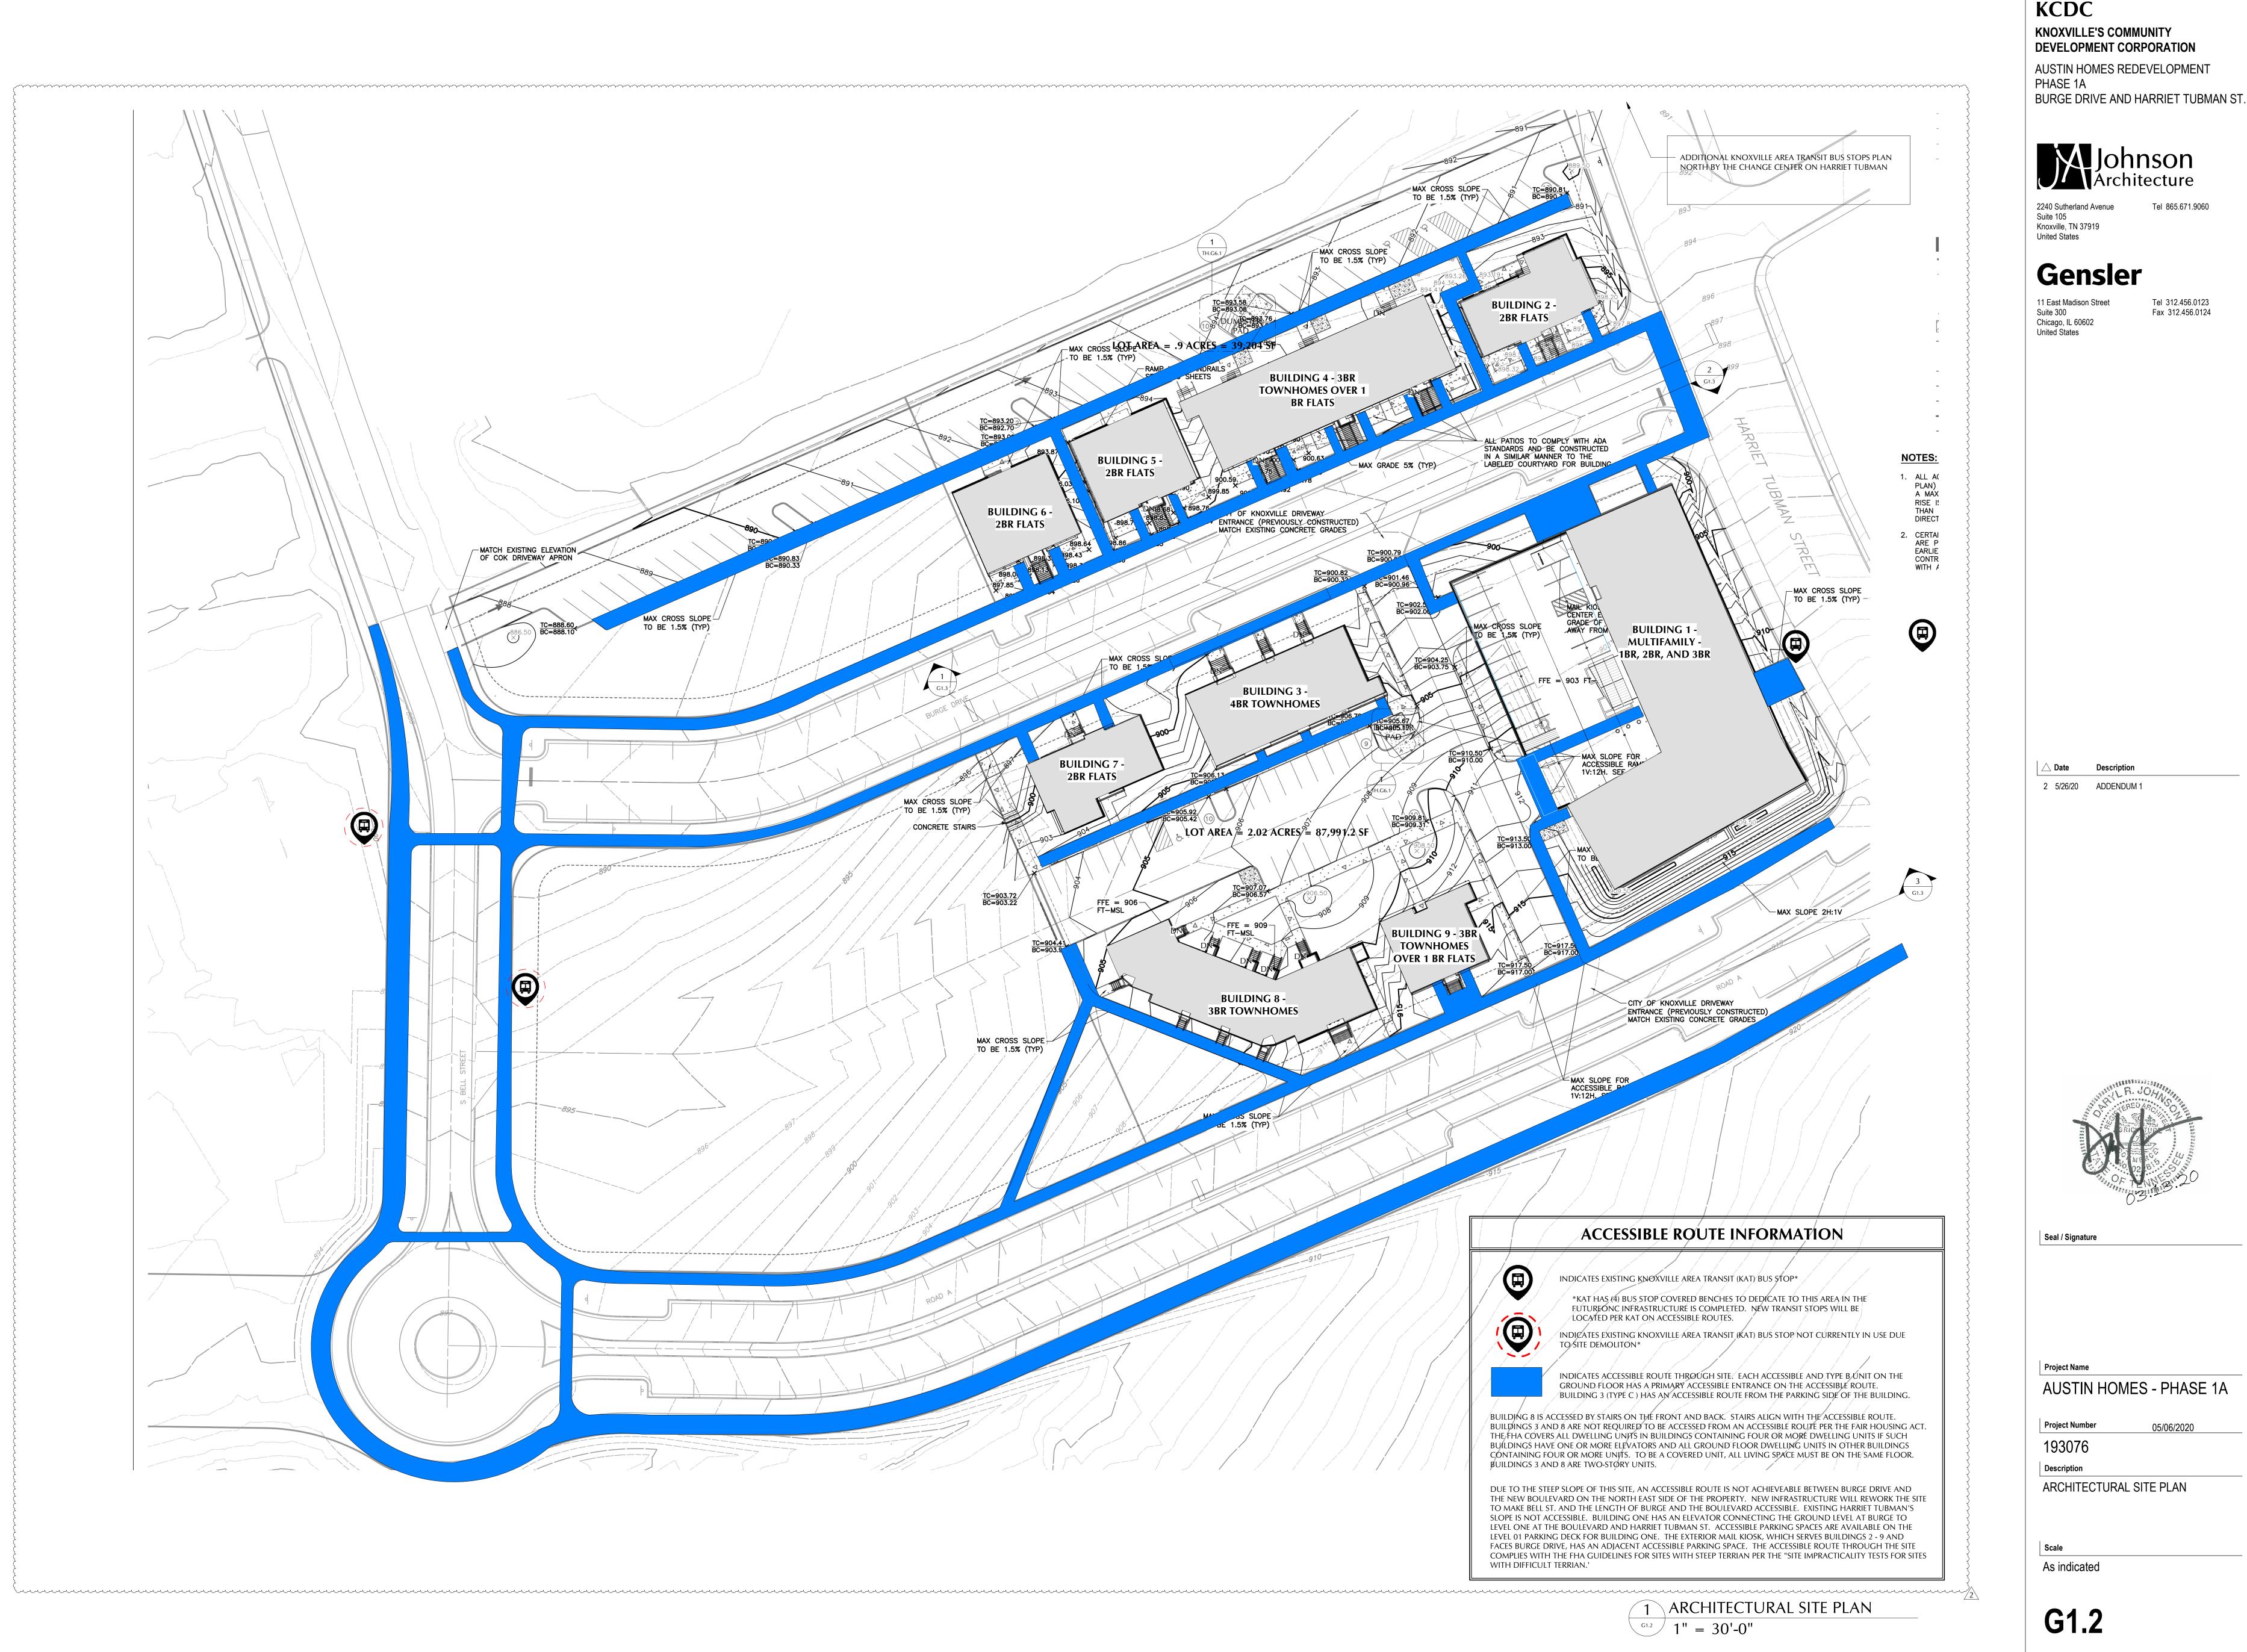


KCDC

KNOXVILLE'S COMMUNITY **DEVELOPMENT CORPORATION**

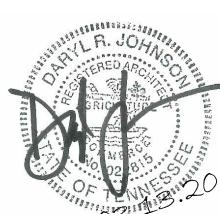

AUSTIN HOMES - PHASE 1A

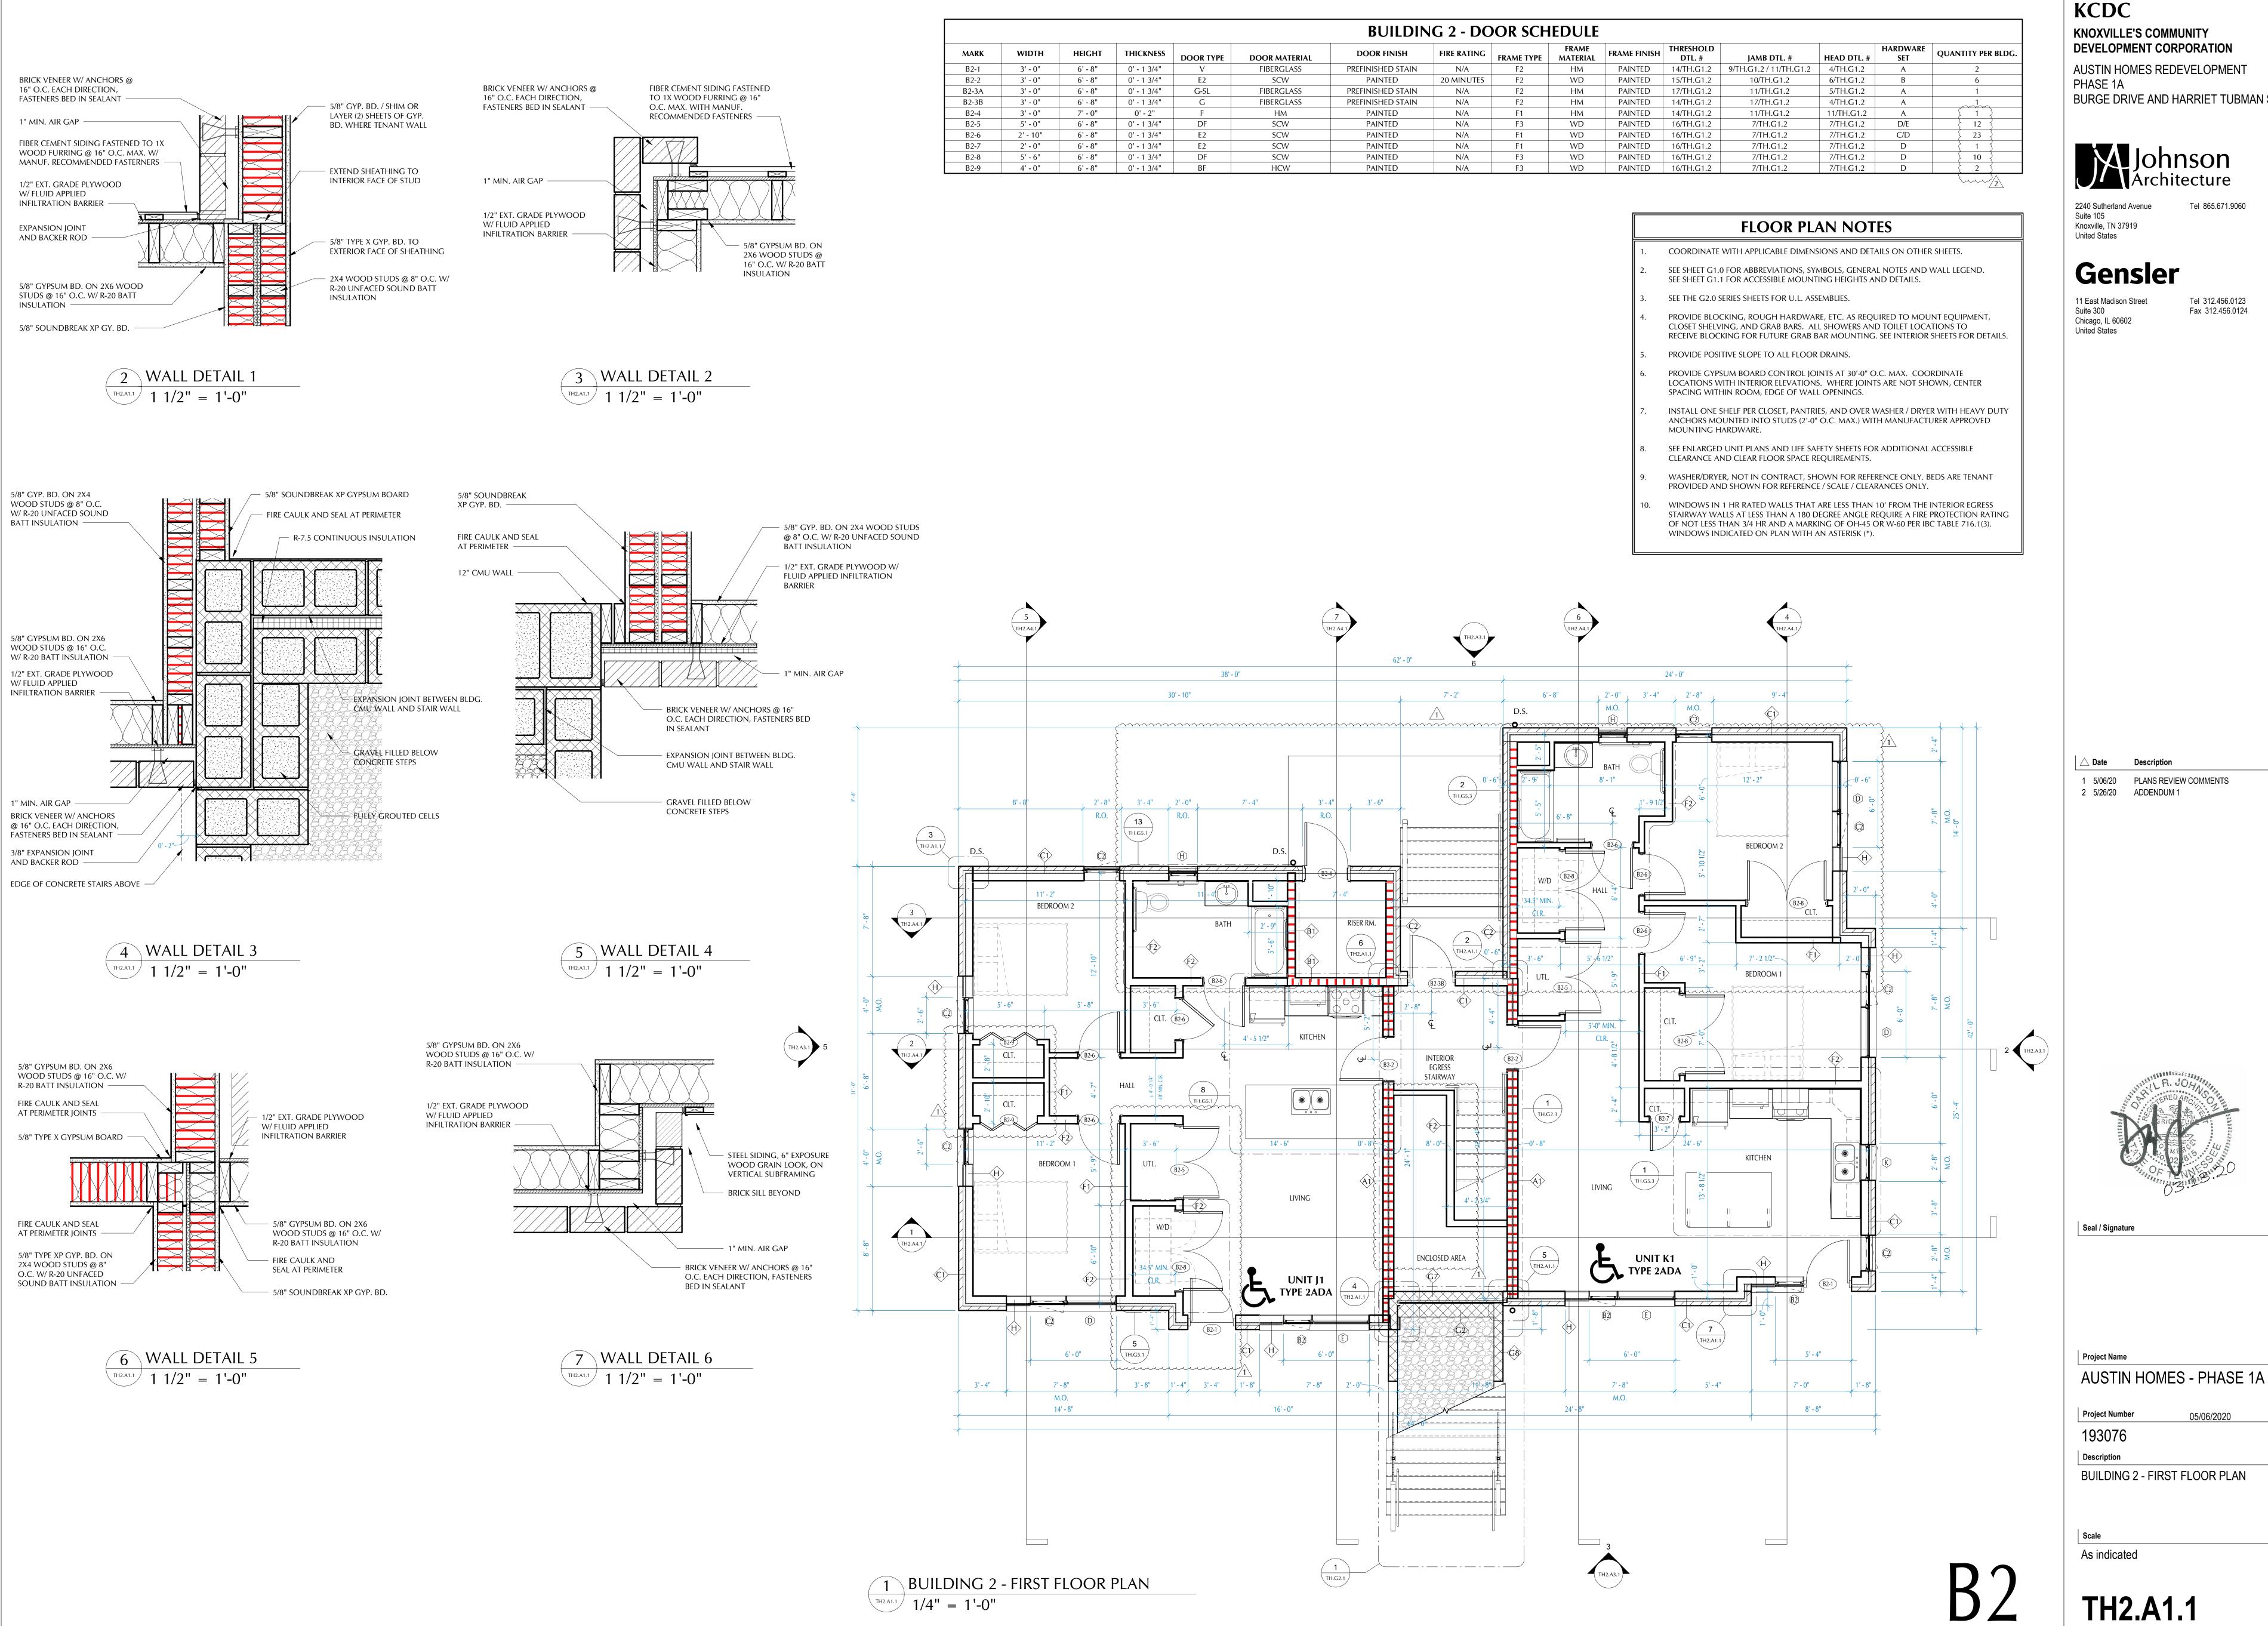

KNOXVILLE'S COMMUNITY

BURGE DRIVE AND HARRIET TUBMAN ST.



Tel 865.671.9060

Tel 312.456.0123 Fax 312.456.0124

- 1. PRIOR TO INSTALLING DOWNSPOUTS, COORDINATE WITH ARCHITECT FOR EXACT LOCATIONS WITH BUILT CONDITIONS. LOCATIONS INDICATED ARE SUBJECT TO CHANGE AND TO BE COORDINATED WITH DOORS, WINDOWS, ENTRANCE STOOPS, ETC.
- PROVIDE PRE-FINISHED ALUMINUM GUTTERS AND DOWNSPOUTS AT SHOWN LOCATIONS EXCEPT WHERE INDICATED ON SITE PLAN TO BE TIED INTO STORM SEWER.
- 3. CONT. PRE-FIN. ALUM. GUTTERS W/ SUPPORTS @ 3'-0" O.C. TYP., GUTTERS TO BE 0.027". COLOR TO BE SELECTED BY OWNER AND ARCHITECT. A. FRONT 'STREET SIDE' ENTRANCE ROOFS TO HAVE 6" HALF ROUND GUTTERS
- 4. PRE-FINISHED ALUMINUM DOWNSPOUTS W/ STRAP SUPPORTS @ 5'-0" O.C. VERT., TYP., MIN. OF 2 STRAPS PER DOWNSPOUT. DOWNSPOUTS TO BE 0.032". COLOR TO BE SELECTED BY OWNER AND ARCHITECT. A. ALL DOWNSPOUTS TO BE 3" ROUND DOWNSPOUTS

B. ALL OTHER GUTTERS TO BE 6" BOX STYLE GUTTERS

- ALL DOWNSPOUTS TO BE TIED INTO UNDERGROUND STORM WATER SYSTEM. COORDINATE WITH CIVIL PLANS FOR STORMWATER PIPING WITH DOWNSPOUT LOCATIONS. PROVIDE CONNECTION BOOT AS REQUIRED TO CONNECT TO UNDERGROUND STORM WATER SYSTEM.
- DOWNSPOUTS FROM UPPER ROOFS SPILLING ON LOWER ROOF LEVELS TO HAVE A SPLASH PAD UNDER DOWNSPOUT.
- PROVIDE VENTS THROUGH ROOF AS INDICATED FOR PLUMBING SYSTEMS. LOCATIONS TO BE NO CLOSER THAN 5'-0" TO PARAPET CONDITION AND NO CLOSER THAN 10'-0" TO ANY AIR INTAKE.
- 8. VENT PIPE, ROOF PENETRATIONS AND REFRIGERANT LINES NOT SHOWN FOR CLARITY.
- VERIFY EXACT NUMBER & LOCATION OF ALL VENT PIPES, ROOF PENETRATIONS & REFRIGERANT LINES IN FIELD. PROVIDE SELF-ADHERING FLASHING AROUND ALL ROOF PENETRATIONS.
- 10. PROVIDE ALL ROOF ACCESSORIES INCLUDING FLASHING BOOTS, COUNTER FLASHING, DRIP EDGES, COPING, AND ALL OTHER ACCESSORIES REQUIRED TO PROVIDE A WATER TIGHT ROOF SYSTEM THAT WILL MEET THE ROOF WARRANTY REQUIREMENTS.
- FOR ROOF PITCHES 4:12 OR GREATER, INSTALL 30# FELT AS UNDERLAYMENT OVER SHEATHING WITH AN ICE AND WATER SHIELD TO EXTEND 18" FROM ALL EDGES. ICE & WATER SHIELD TO BE AT ALL VALLEYS 36" WIDE. FOR ROOF PITCHES LESS THAN 4:12, INSTALL ICE AND WATER SHIELD AS UNDERLAYMENT CONTINUOUSLY FROM RIDGE TO EAVE AND FROM EDGE TO EDGE.
- 12. GROUNDS TO BE CLEANED OR DEBRIS AND NAILS DAILY PRIOR TO LEAVING SITE.
- 13. PROVIDE CONT. STEP FLASHING @ ALL SLOPED WALL/ROOF CONNECTION, TYP.
- 14. 1011.13 GUARDS. WHERE THE ROOF HATCH OPENING IS LOCATED WITHIN 10 FEET OF THE ROOF EDGE, SUCH ROOF ACCESS OR ROOF EDGE SHALL BE PROTECTED BY GUARDS INSTALLED IN ACCORDANCE WITH IBC 2018, SECTION 1015.
- 15. 1015.6 MECHANICAL EQUIPMENT, SYSTEMS AND DEVICES. | 1015.7 ROOF ACCESS. GUARDS SHALL BE PROVIDED WHERE VARIOUS COMPONENTS THAT REQUIRE SERVICE ARE LOCATED WITHIN 10 FEET OF A ROOF EDGE. THE GUARD SHALL EXTEND NOT LESS THAN 30 INCHES BEYOND EACH END OF SUCH COMPONENTS. THE GUARD SHALL BE CONSTRUCTED SO AS TO PREVENT THE PASSAGE OF A SPHERE 21 INCHES IN DIAMETER. BASIS OF DESIGN - KEEGUARD SAFETY RAIL SYSTEM; SEE IMAGE 18/TH.G3.1
- 16. AT ALL ROOFTOP EQUIPMENT, ROOF HATCHES, ETC., PROVIDE TAPERED RIGID INSULATION SADDLE TO SLOPE AWAY AND AROUND FOR POSITIVE WATER FLOW.
- PROVIDE ROOF WALK PADS AS REQUIRED TO ACCESS ALL ROOFTOP EQUIPMENT AND PENETRATIONS FROM ROOF HATCH. SEE WALKPAD DETAIL.

o D.S.	ROUND DOWNSPOUT
	DASHED LINE INDICATES EXTENDING ROOF MEMBRANE UP WALL A MINIMUM OF 8" OR PER MANUFACTURER'S SPECIFICATIONS. REFER TO TYPICAL ROOF DETAIL SHEET FOR TERMINATION DETAILS. • AT BRICK - MEMBRANE TO EXTEND UP THE EXTERIOR FACE OF BRICK W/ TERMINATION BAR AND COUNTERFLASHING IN THE GROUT JOINT OF BRICK, WITH SEALANT. • AT SIDING - MEMBRANE TO EXTEND UNDER EXTERIOR SHEATHING W/ COUNTERFLASHING.
	CRICKET PLACED ON HIGH SIDE FOR POSITIVE DRAINAGE AROUND OBJECT (OR) IN LOW SIDE OF CORNER TO CREATE POSITIVE DRAINAGE
	PROTECTION WALK PAD. PLACE AROUND PERIMETER OF ROOF HATCH

BLDG 2 - ROOF DRAIN CALCS

MAIN "FLAT" ROOF (SPLIT IN 3 AREAS FOR DRAINAGE CALCS) • AREA 1: 647 SF • AREA 2: 333 SF • AREA 3: 922 SF

ENTRANCE ROOF OVERHANGS • AREA 4: 49 SF • AREA 5: 132 SF + AREA 2 = 465 SF

REFER TO FIGURE 1106.1 (EASTERN UNITED STATES) KNOXVILLE, TENNESSEE FALLS APPROX. ON THE 3.25" (ROUNDED UP TO 4.0" PER ENGINEERS RECOMMENDATION)

RAINFALL CONVERSION DATA

AREA 5:

4.0" RAINFALL = .0416 G.P.M. PER S.F. (MULTIPLIER TO USE) 647 SF x .0416 = 26.9 gpm• AREA 2: 333 SF x .0416 = 13.9 gpm AREA 3: 922 SF x .0416 = 38.4 gpm AREA 4: 49 SF x .0416 = 2.0 gpm

FIGURE 1106.3 (VERTICAL LEADER SIZING) • 3" ROUND DOWNSPOUTS ARE SHOWN TO MEET SIZE AND QUANTITY REQUIREMENTS


465 SF x .0416 = 19.3 gpm

FIGURE 1106.6 (HORIZONTAL GUTTER SIZING) • STREET ENTRANCE CANOPY = 5" HALF ROUND GUTTER AT 1/8" SLOPE SHOWN TO MEET SIZE AND SLOPE REQUIREMENTS

ALL OTHER ROOFS = 5" BOX GUTTER AT 1/4" SLOPE SHOWN TO MEET SIZE AND SLOPE REQUIREMENTS

** CALCULATIONS TAKEN FROM INTERNATIONAL PLUMBING CODE 2018, SECTION 1105 & 1106 FOR ROOF DRAINS, SIZE OF CONDUCTORS, LEADERS AND STORM DRAINS


**CONTRACTOR TO VERIFY SQUARE FOOTAGES FOR PRICING. AREAS SHOWN ARE FOR CODE DRAINAGE CALCULATIONS ONLY.

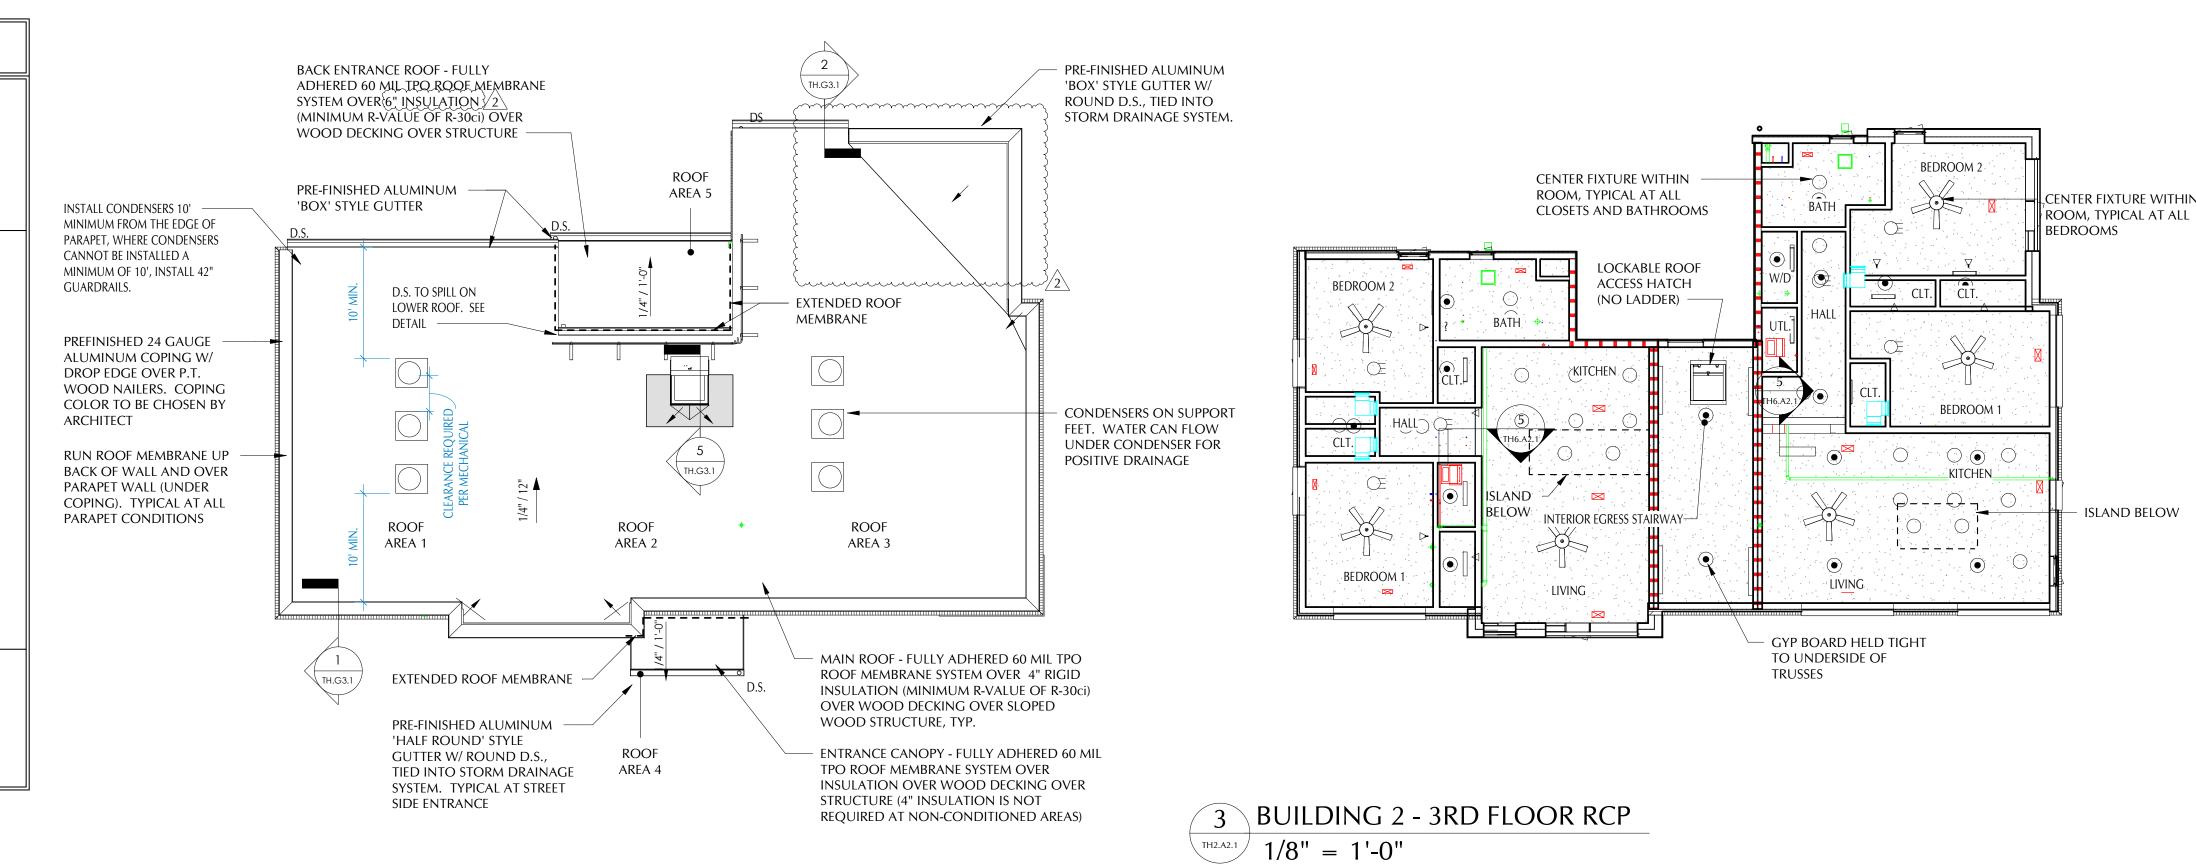


4 BUILDING 2 - ROOF PLAN


REFLECTED CEILING PLAN NOTES

- 1. THE CONTRACTOR SHALL CAREFULLY STUDY AND COMPARE THE REFLECTED CEILING PLANS WITH THE ELECTRICAL LIGHTING PLANS, MECHANICAL PLANS, AND FIRE PROTECTION PLANS. GENERAL CONTRACTOR SHALL REPORT TO THE ARCHITECT ANY ERROR, INCONSISTENCY OR OMISSION THAT IS DISCOVERED.
- ALL SOFFITS AND CEILING HEIGHTS INDICATED SHALL BE MEASURED FROM BOTTOM OF FINISH MATERIAL TO FINISH FLOOR ELEVATION DIRECTLY BELOW.
- 3. ALL DIMENSIONS SHOWN ON REFLECTED CEILING PLANS ARE FINISHED DIMENSIONS.
- THE CONTRACTOR SHALL VERIFY THAT ACCESS PANELS OF APPROPRIATE SIZE AND TYPE ARE INSTALLED IN GYPSUM BOARD CEILING ASSEMBLIES, SOFFITS, AND IN OTHER NON-ACCESSIBLE TYPE AREAS WHERE ACCESS, SERVICE OR ADJUSTMENT TO MECHANICAL, PLUMBING OR ELECTRICAL ITEMS MAY BE REQUIRED. ACCESS PANELS SHALL BE FIRE RATED EQUAL TO ANY RATING OF THE CEILING OR SOFFIT IN WHICH THEY OCCUR.
- ONLY CEILING MOUNTED EXIT LIGHTING IS SHOWN ON THE REFLECTED CEILING PLANS. SEE ELECTRICAL DRAWINGS FOR LOCATIONS OF WALL MOUNTED EXIT LIGHTING.
- 6. SEE THE ELECTRICAL DRAWINGS AND / OR THE COMMUNICATIONS DRAWINGS FOR
- LOCATIONS OF CEILING MOUNTED SMOKE DETECTORS, SPEAKERS, FIRE ALARM DEVICES, ETC. 7. CONTRACTOR TO COORDINATE WITH ARCHITECT AND OWNER ALL FIXTURE SELECTIONS AND FINISHES PRIOR TO INSTALLATION.
- 8. COORDINATE WITH APPLICABLE NOTES AND DIMENSIONS ON OTHER SHEETS.
- EXTEND GYPSUM BOARD WALL CONSTRUCTION TO UNDERSIDE OF ROOF / FLOOR DECK IN AREAS WITHOUT FINISHED CEILINGS TYPICAL.
- 10. SEE FIRE PROTECTION SHEETS FOR SPRINKLER HEAD LOCATIONS.
- 11. PROVIDE STRUCTURAL SUPPORT FOR CEILING MOUNTED EQUIPMENT AS REQUIRED.
- 12. ALL GYPSUM BOARD CEILINGS IN WET AREAS SHALL BE MOISTURE RESISTANT GYPSUM BOARD 13. PROVIDE CEILING CONTROL JOINTS AS INDICATED. ALL CEILINGS OVER 900 SF TO RECEIVE PERIMETER RELIEF JOINTS.
- 14. ALL CEILINGS IN WET AREAS TO BE MOISTURE RESISTANT GYP. BOARD.
- 15. ALL CEILINGS IN LIVING UNITS TO BE HELD TIGHT TO UNDERSIDE OF STRUCTURE UNLESS NOTED OTHERWISE.
- 16. COORDINATE LOCATIONS OF FIRE ALARMS, SMOKE DETECTORS WITH LIGHT FIXTURES, HVAC DIFFUSERS / RETURNS AND SPRINKLER HEADS.
- 17. CENTER SINGLE LIGHT FIXTURES IN LIVING UNIT WITH ROOM, UNLESS NOTED OTHERWISE.
- 18. REFER TO ELECTRICAL PLAN FOR ATTIC LIGHTING.
- 19. FLOOR/ CEILING ASSEMBLIES TO MEET A MINIMUM STC RATING OF 50. TYPE X GYPSUM BOARD REOUIRED FOR ALL CEILINGS BETWEEN UNITS.

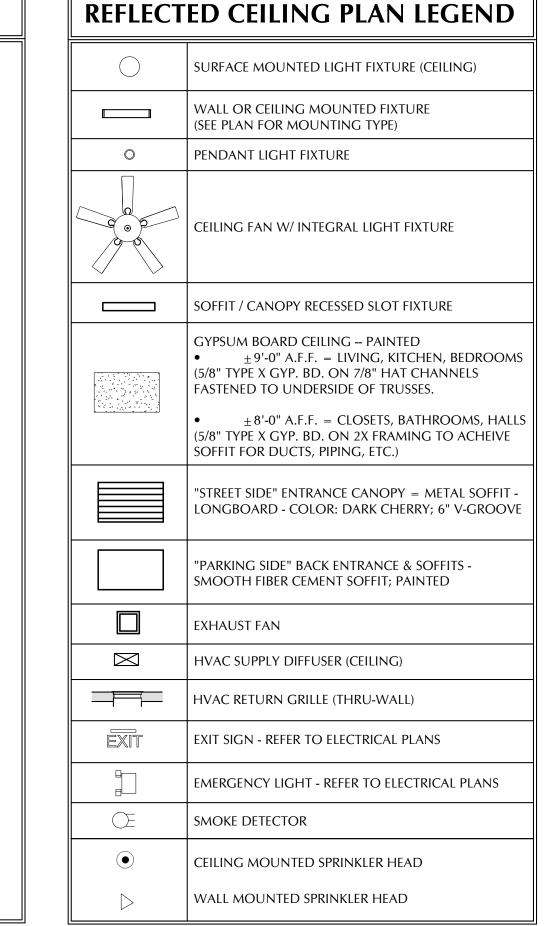

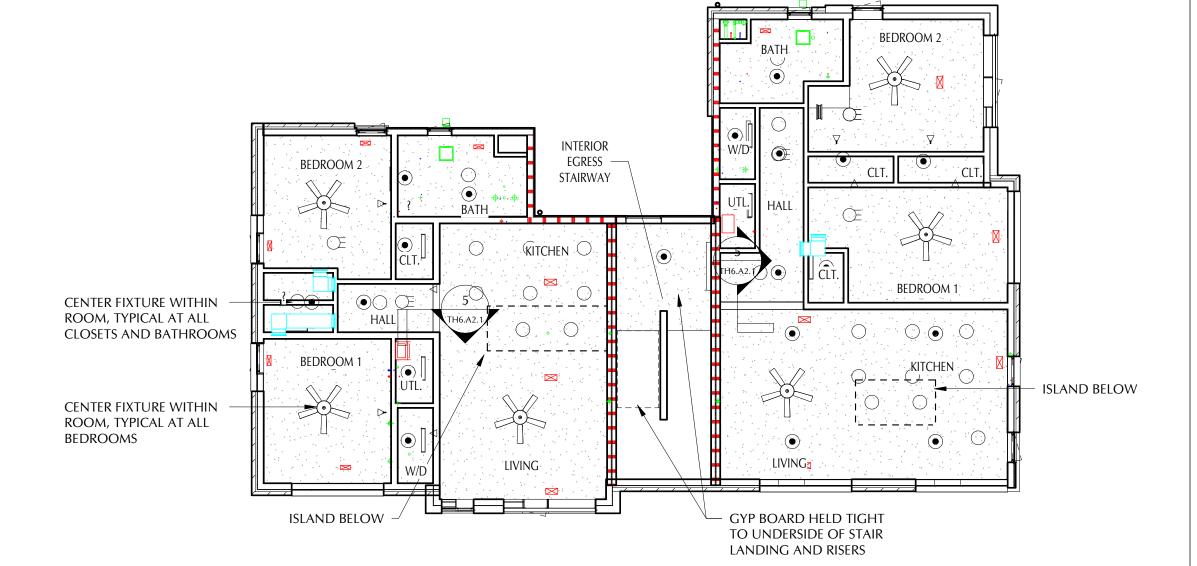

BUILDING 2 - 2ND FLOOR RCP 1/8" = 1'-0"

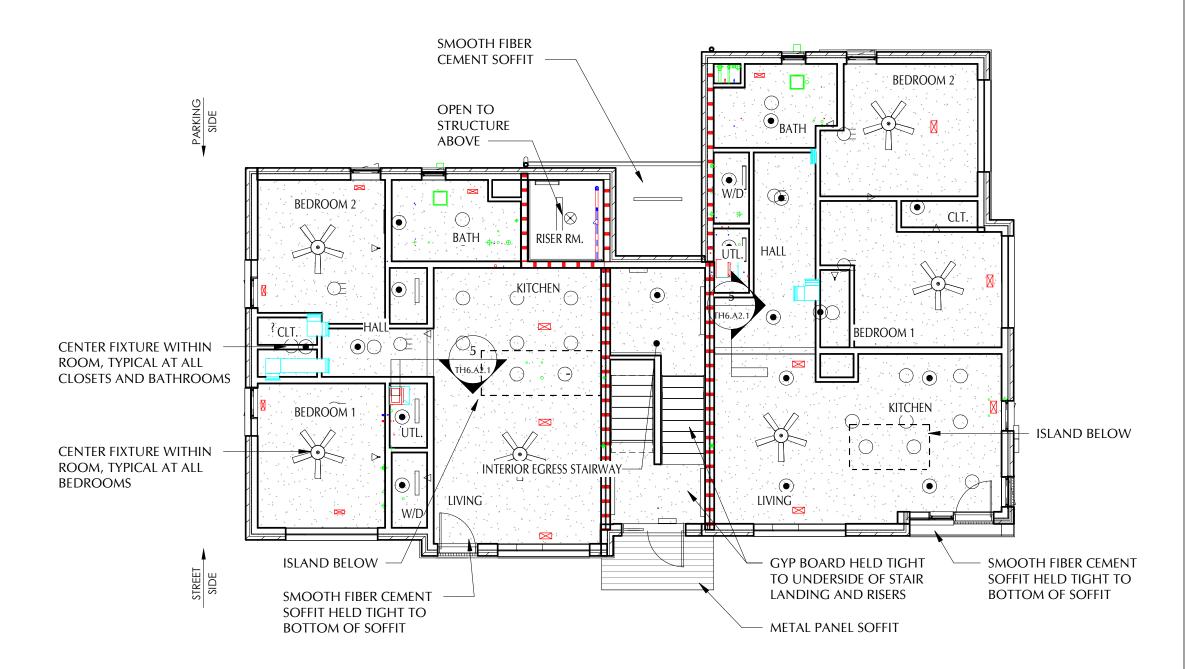

BUILDING 2 - 1ST FLOOR RCP 1/8" = 1'-0"

KCDC KNOXVILLE'S COMMUNITY DEVELOPMENT CORPORATION

PHASE 1A

United States

AUSTIN HOMES REDEVELOPMENT

BURGE DRIVE AND HARRIET TUBMAN ST.

Tel 865.671.9060 2240 Sutherland Avenue Suite 105 Knoxville, TN 37919

11 East Madison Street Suite 300 Chicago, IL 60602 United States

Fax 312.456.0124

Tel 312.456.0123

Date Description 2 5/26/20 ADDENDUM 1



Seal / Signature


AUSTIN HOMES - PHASE 1A Project Number 05/06/2020

193076 Description

BUILDING 2 - REFLECTED CEILING PLAN, ROOF PLAN & NOTES

As indicated

TH2.A2.1

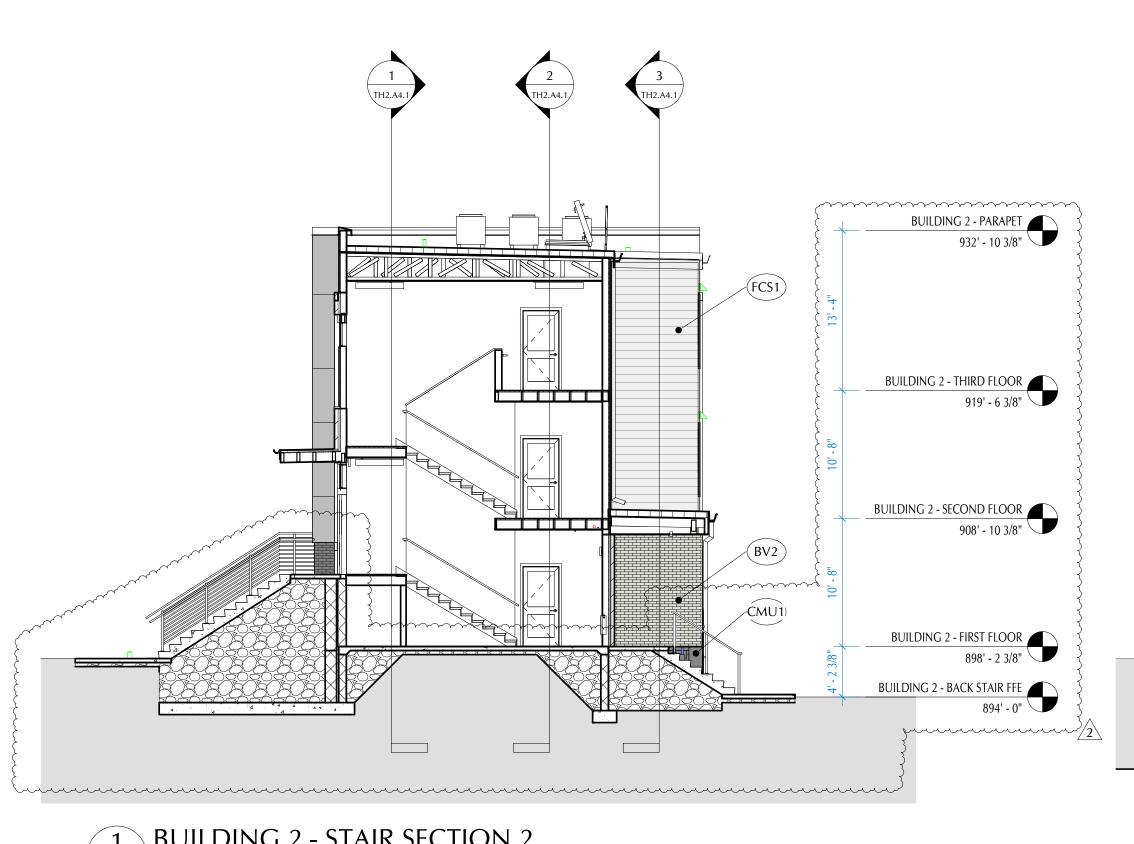


FCP2 BUILDING 2 - PARAPET 932' - 10 3/8" FCP1 SS1 BV2 (AT1)-(FB1)-(GD2)-BUILDING 2 - SECOND FLOOR 919' - 6 3/8" GH1 BUILDING 2 - FIRST FLOOR 908' - 10 3/8" BUILDING 2 - FIRST FLOOR 898' - 2 3/8" BUILDING 2 - BACK STAIR FFE 894' - 0"

1/8" = 1'-0"



1 BUILDING 2 - STAIR SECTION 2 1/8" = 1'-0"

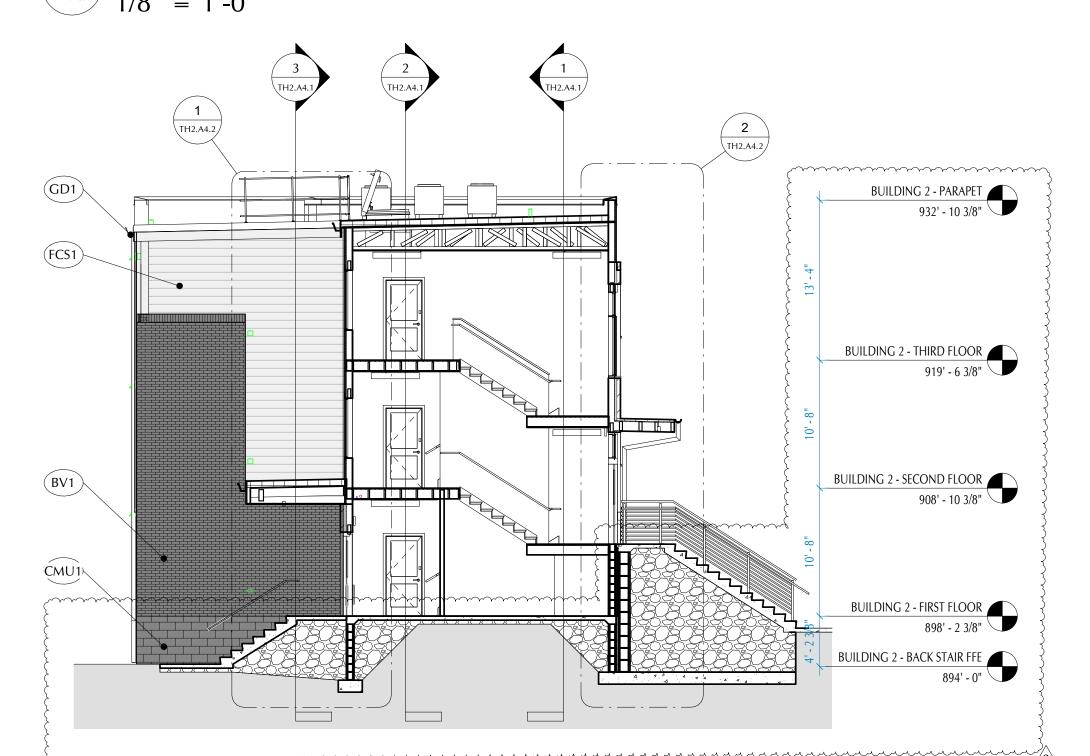

BUILDING 2 - PARAPET 932' - 10 3/8" BUILDING 2 - THIRD FLOOR 919' - 6 3/8" BUILDING 2 - SECOND FLOOR 908' - 10 3/8" BV3

-CMU1

5 BUILDING 2 - WEST ELEVATION 1/8" = 1'-0"

2 BUILDING 2 - EAST ELEVATION

1/8" = 1'-0"

AT1 BUILDING 2 - FIRST FLOOR BUILDING 2 - BACK STAIR FFE

6 BUILDING 2 - BACK ELEVATION 1/8" = 1'-0"

4 BUILDING 2 - STAIR SECTION 1

ELEVATION NOTES

- 1. CJ = CONTROL JOINT, SEE DETAIL 6/TH.G4.2
- 2. ICJ = INSIDE CONTROL JOINT, SEE DETAIL 7/TH.G4.2
- CONTROL JOINTS TO BE ALIGNED WITH EDGE OF ADJACENT WINDOW OR DOOR FRAME AS SHOWN ON ELEVATIONS. LOCATE CONTROL JOINTS MAXIMUM 25'-0" O.C. WHERE NOT SHOWN. COORDINATE LOCATIONS WITH ARCHITECT.

SHOWN ALIGNED WITH FRAME. ALIGN DOWNSPOUT TO COVER CONTROL JOINTS WHERE APPLICABLE.

PROVIDE CONTROL JOINTS MINIMUM 2'-0" OFF EDGE OF OUTSIDE CORNER IF NOT

- PROVIDE HORIZONTAL CONTROL JOINTS AT LOCATIONS SHOWN ON ELEVATIONS. REFER TO STRUCTURAL DRAWINGS FOR DETAILS.
- VERTICAL CONTROL JOINT FILLER TO MATCH MASONRY COLOR. HORIZONTAL CONTROL JOINT FILLER TO MATCH GROUT COLOR.
- COORDINATE WITH APPLICABLE DIMENSIONS AND DETAILS ON OTHER SHEETS.
- DIMENSIONS ARE TO FACE OF MASONRY, FIBER CEMENT PANEL, CURTAIN WALL OR EDGE OF OPENING UNLESS NOTED OTHERWISE.
- 10. COORDINATE DOWNSPOUT LOCATIONS WITH ROOF PLAN.
- PROVIDE MASONRY VENEER EXPANSION JOINTS AT INSIDE CORNERS AND INTERSECTIONS WITH DISSIMILAR MATERIALS.

MATERIAL REQUIREMENTS

PER CITY OF KNOXVILLE ZONING CODE | ARTICLE 9 SECTION 9.3 PRINCIPLE USE STANDARDS (PROPERTY ZONED RN-6)

3. MULTI-FAMILY DWELLINGS REQUIRE A MINIMUM OF 20% TRANSPARENCY ON ANY FACADE FACING A STREET AND IS CALCULATED ON THE BASIS OF THE ENTIRE AREA OF THE

5.a. THE FOLLOWING BUILDING MATERIALS ARE PROHIBITED ON ANY PART OF ANY FACADE: i. PLAIN CONCRETE BLOCK

- ii. PLASTIC iii. EXTERIOR INSULATION FINISH SYSTEMS ON THE GROUND FLOOR
- **5.b.** THE FOLLOWING BUILDING MATERIALS ARE PROHIBITED AS A PRIMARY SURFACE FINISH MATERIAL ON ANY FACADE, BUT MAY BE USED AS A DECORATIVE OR DETAIL ELEMENT FOR UP TO 15% OF THE FACADE: i. CORRUGATED METAL
- ii. ALUMINUM, STEEL, OR OTHER METAL SIDINGS iii. EXPOSED AGGREGATE (ROUGH FINISH) CONCRETE WALL PANELS iv. T-111 COMPOSITE PLYWOOD SIDING v. VINYL SIDING

ELEVATION MATERIALS

- BRICK VENEER; FIELD (BV1) MODULAR ACME BRICK - MARBLE GRAY; HOLCIM SANTEE BLACK MORTAR
- BRICK VENEER; FIELD (BV2) MODULAR ACME BRICK - STEEL GRAY; HOLCIM FROSTY MORTAR
- BRICK VENEER; FIELD (BV3) MODULAR GENERAL SHALE - MISTYHOLLOW; HOLCIM SANTEE BLACK MORTAR
- SMOOTH FACE CMU; ACCENT (CMU1) DOUBLE MONARCH BELDEN - GRAPHITE; VELOUR TEXTURE, HOLCIM SANTEE BLACK MORTAR
- FIBERGLASS WINDOWS WITH 1" INSULATED GLASS (FW1) BLACK FRAME
- FIBER CEMENT SIDING; SMOOTH FACE 6" LAP, MITERED AT CORNERS
- FIELD (FCS1) SW 9166 DRIFT OF MIST ACCENT (FCS2) - SW 7674 PEPPERCORN
- FIBER CEMENT PANEL (FCP1) EQUITONE TECTIVA TE90 FIBER CEMENT PANEL (FCP2) - EQUITONE TECTIVA - TE00 FIBER CEMENT PANEL (FCP3) - EQUITONE TECTIVA - TE10 FIBER CEMENT PANEL (FCP4) - EQUITONE TECTIVA - TE20

FIBER CEMENT PANEL (FCP5) - EQUITONE TECTIVA - MA400

- STEEL SIDING; WOOD GRAIN LOOK; ACCENT (SS1) LONGBOARD DARK CHERRY, 6" V-GROOVE
- ALUMINUM WRAPPED HEADER TRIM (AT1) CHARCOAL GRAY
- PREFINISHED METAL COPING (MC1) BLACK
- PREFINISHED METAL PANEL (MP1) ALPOLIC, AZZ ZINC
- INSULATED HOLLOW METAL DOOR (HM1) SW 6991 BLACK MAGIC
- 18. FIBERGLASS DOOR WITH HOLLOW METAL FRAME (FD1) STAINED DARK CHERRY
- FIBER CEMENT FASCIA BOARD; SMOOTH; PAINTED (FB1) SW 6991 BLACK MAGIC 1x10 AT PITCHED GABLES, SIZE ACCORDINGLY ELSEWHERE
- 20. PREFINISHED ALUMINUM GUTTER AND ROUND DOWNSPOUT (GD1) BLACK PREFINISHED HALF-ROUND GUTTER AND ROUND DOWNSPOUT (GD2) - BLACK
- PREFINISHED ALUMINUM GUARD AND HANDRAIL SYSTEM (GH1) BLACK ARCHITECTURAL ASPHALT ROOF (AS1) - COLOR TO BE SELECTED BY ARCHITECT
- PREFINISHED METAL LOUVER (ML1) CHARCOAL GRAY

BUILDING 2 - MATERIAL SQ. FOOTAGES										
	SOUTH - STREET		EAST - STREET		BACK ENTRY	BACK ENTRY	TOTAL BRICK			
MATERIAL	FACING	WEST	FACING	NORTH	WEST	EAST	TOTAL BRICK			
BRICK	905.69	782.09	619.30	438.78	149.32	0.00	2895.18			
FIBER CEMENT PANEL	516.42	186.42	441.25	222.93	26.25	0.00				
FIBER CEMENT SIDING	0.00	0.00	0.00	1048.49	369.73	224.92				
STEEL SIDING - WOOD GRAIN LOOK	140.17	49.50	84.71	0.00	0.00	0.00				
GLAZING	439.78	82.50	356.28	163.36	0.00	0.00				
ALUMINUM TRIM	70.25	11.98	35.94	25.31	0.00	0.00				
CONCRETE STEPS	50.00	0.00	0.00	0.00	0.00	0.00	TOTAL ELEVATION			
OPAQUE DOOR SURFACE	71.61	0.00	0.00	40.40	0.00	0.00	SQ FOOTAGE			
TOTAL ELEVATION SQ. FOOTAGE	2193.92	1112.49	1537.48	1939.27	545.30	224.92	7553.38			
TOTAL OPAQUE ELEVATION SQ. FT.	1754.14	1029.99	1181.20	1775.91	545.30	224.92	6511.46			
% OF TRANSPARENCY FACING R.O.W.	20.05		23.17							
% OF BRICK MATERIAL OF OPAQUE MATERIAL	44.46									

*GENERAL CONTRACTOR TO VERIFY REQUIRED QUANTITIES OF MATERIALS; FOR AHJ REFERENCE ONLY.

7 BUILDING 2 - ZONING/ HUD MATERIAL CALCULATIONS 3/4" = 1'-0"

GD1

FW1

KCDC KNOXVILLE'S COMMUNITY DEVELOPMENT CORPORATION

AUSTIN HOMES REDEVELOPMENT PHASE 1A BURGE DRIVE AND HARRIET TUBMAN ST.



Tel 865.671.9060 Suite 105 Knoxville, TN 37919 United States

Gensler

11 East Madison Street Suite 300 Chicago, IL 60602 United States

Tel 312.456.0123 Fax 312.456.0124

∠ Date Description 1 5/06/20 PLANS REVIEW COMMENTS 2 5/26/20 ADDENDUM 1

BUILDING 2 - PARAPET

BUILDING 2 - THIRD FLOOR

BUILDING 2 - SECOND FLOOR

BUILDING 2 - FIRST FLOOR

BUILDING 2 - BACK STAIR FFE

932' - 10 3/8"

919' - 6 3/8"

908' - 10 3/8"

898' - 2 3/8"

894' - 0"




Seal / Signature

AUSTIN HOMES - PHASE 1A

Project Number 05/06/2020 193076

BUILDING 2 - EXTERIOR ELEVATIONS

As indicated

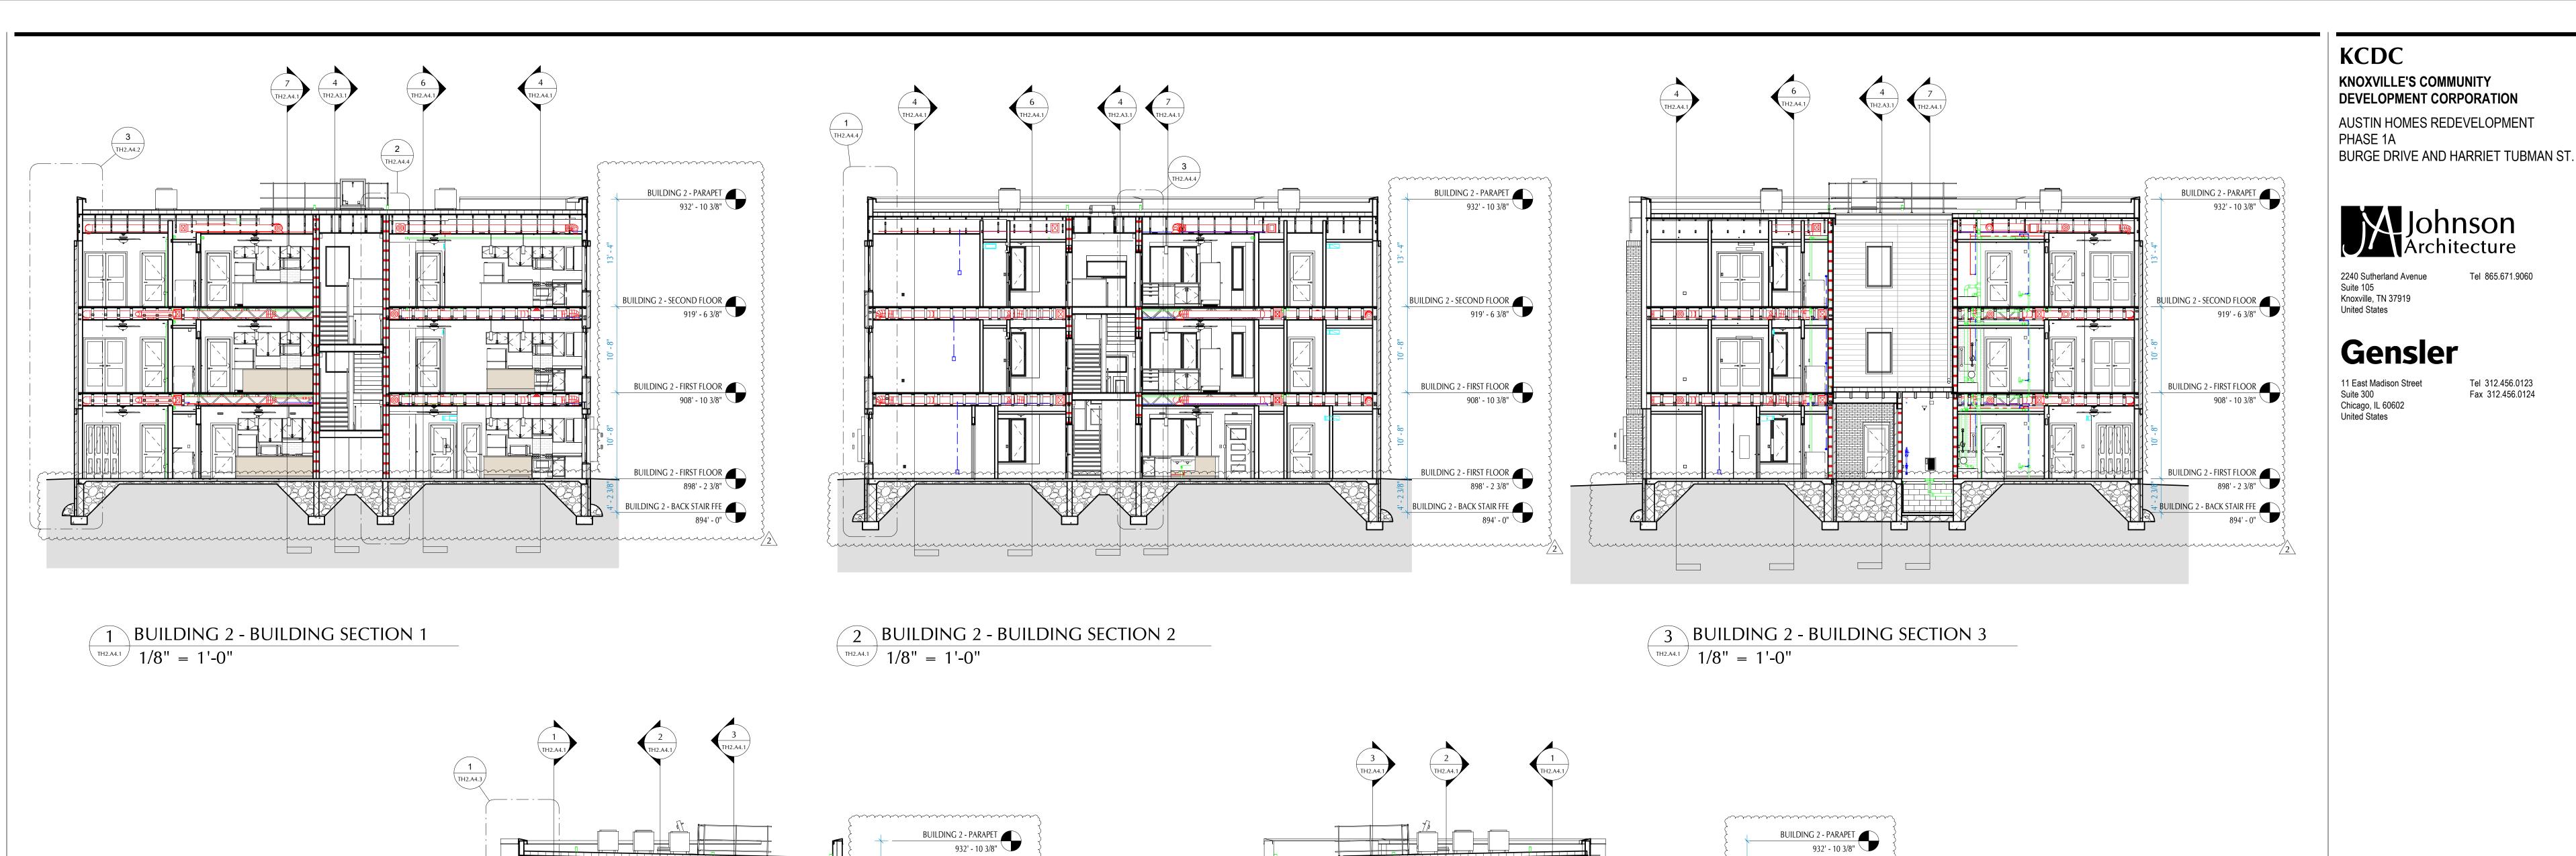


BUILDING 2 - THIRD FLOOR 919' - 6 3/8"


BUILDING 2 - SECOND FLOOR
908' - 10 3/8"


BUILDING 2 - FIRST FLOOR 898' - 10 3/8"

BUILDING 2 - BACK STAIR FFE 894' - 0"

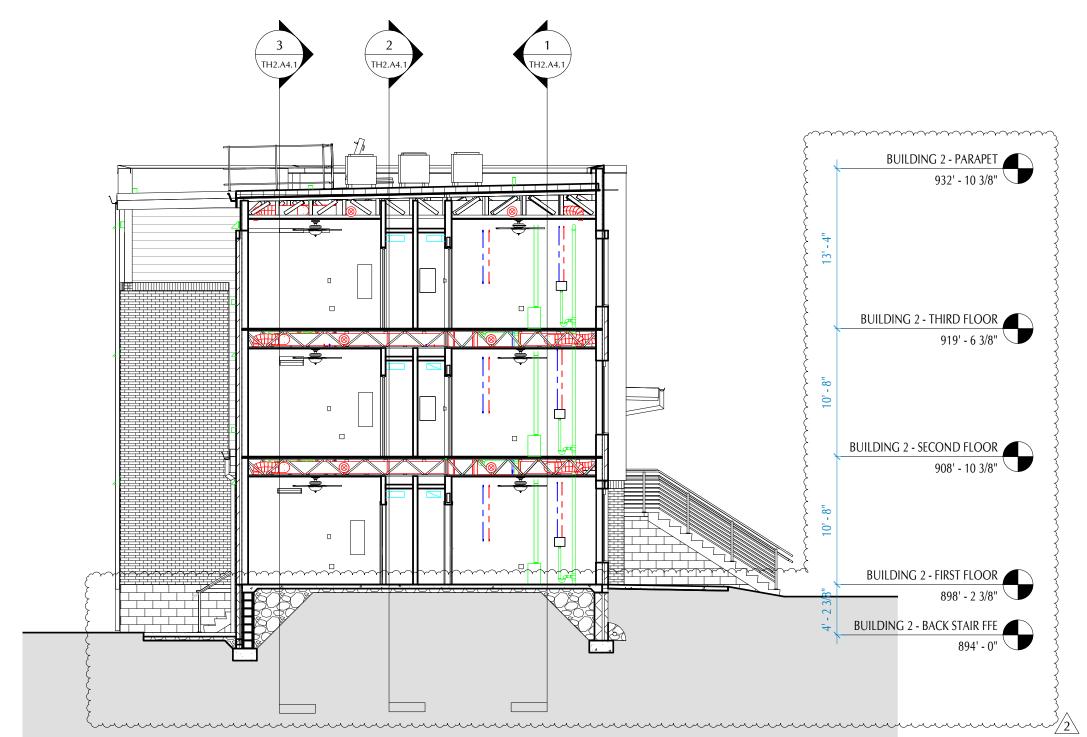


 $\frac{4}{1/8"} = 1'-0"$ BUILDING 2 - BUILDING SECTION 4

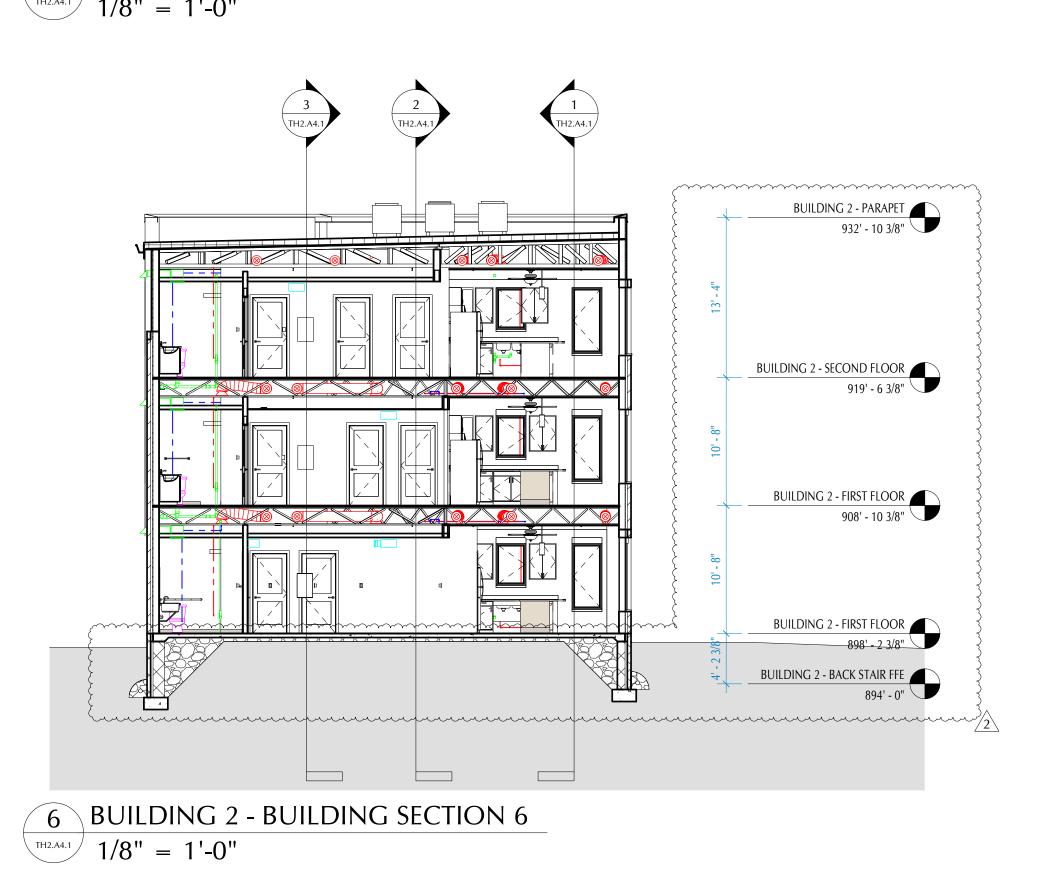

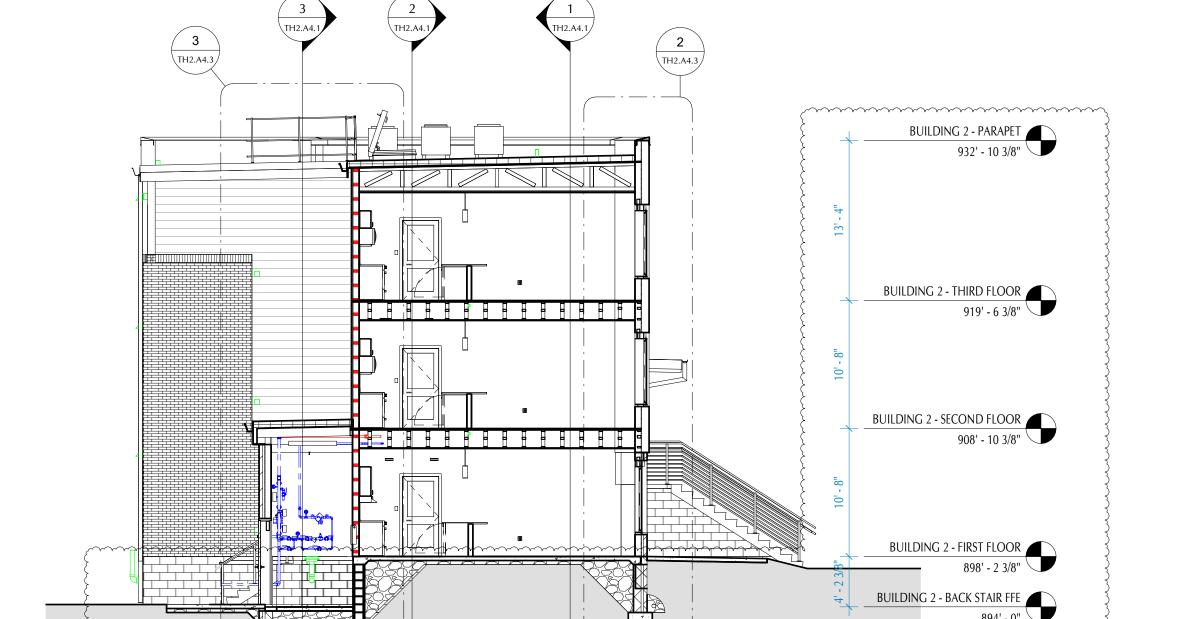

7 BUILDING 2 - BUILDING SECTION 7 TH2.A4.1 1/8" = 1'-0"

5 BUILDING 2 - BUILDING SECTION 5 1/8" = 1'-0"

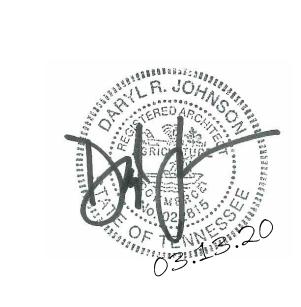

2 5/26/20 ADDENDUM 1

Tel 865.671.9060

Tel 312.456.0123

Fax 312.456.0124

Seal / Signature


AUSTIN HOMES - PHASE 1A


Project Number 05/06/2020 193076


BUILDING 2 - BUILDING SECTIONS

1/8" = 1'-0"


TH2.A4.1

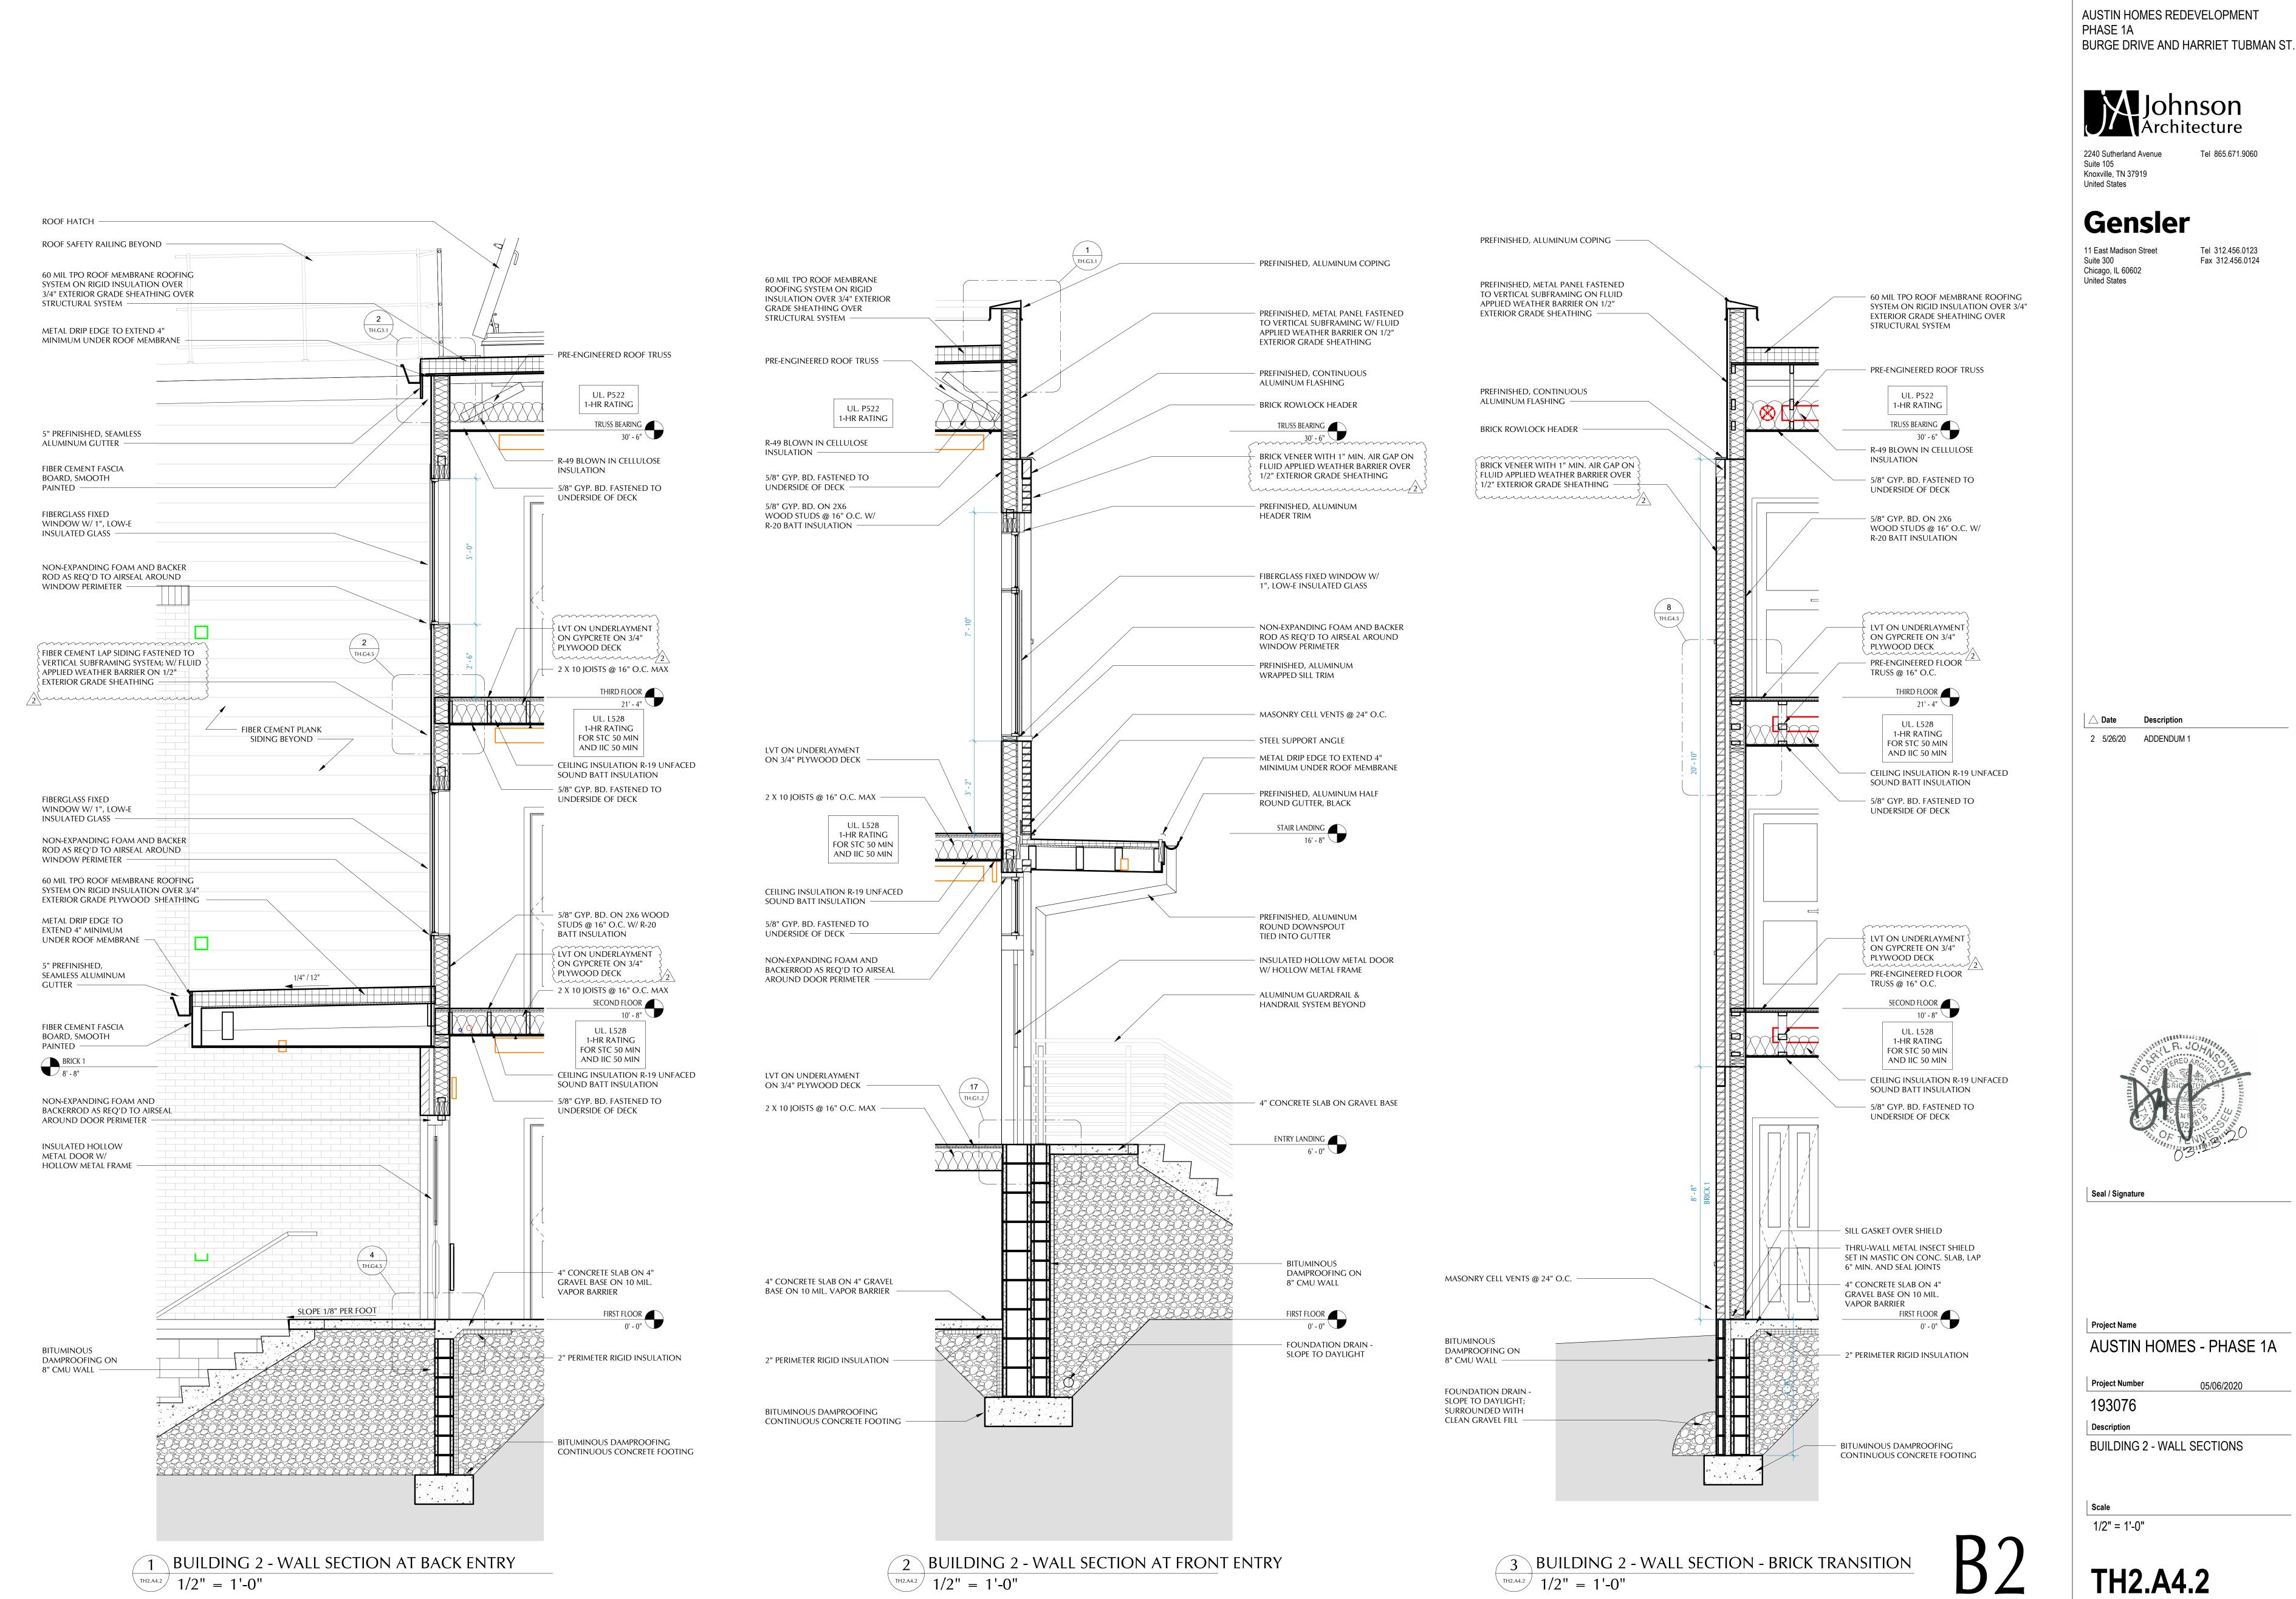

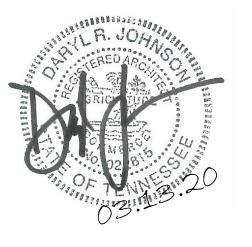

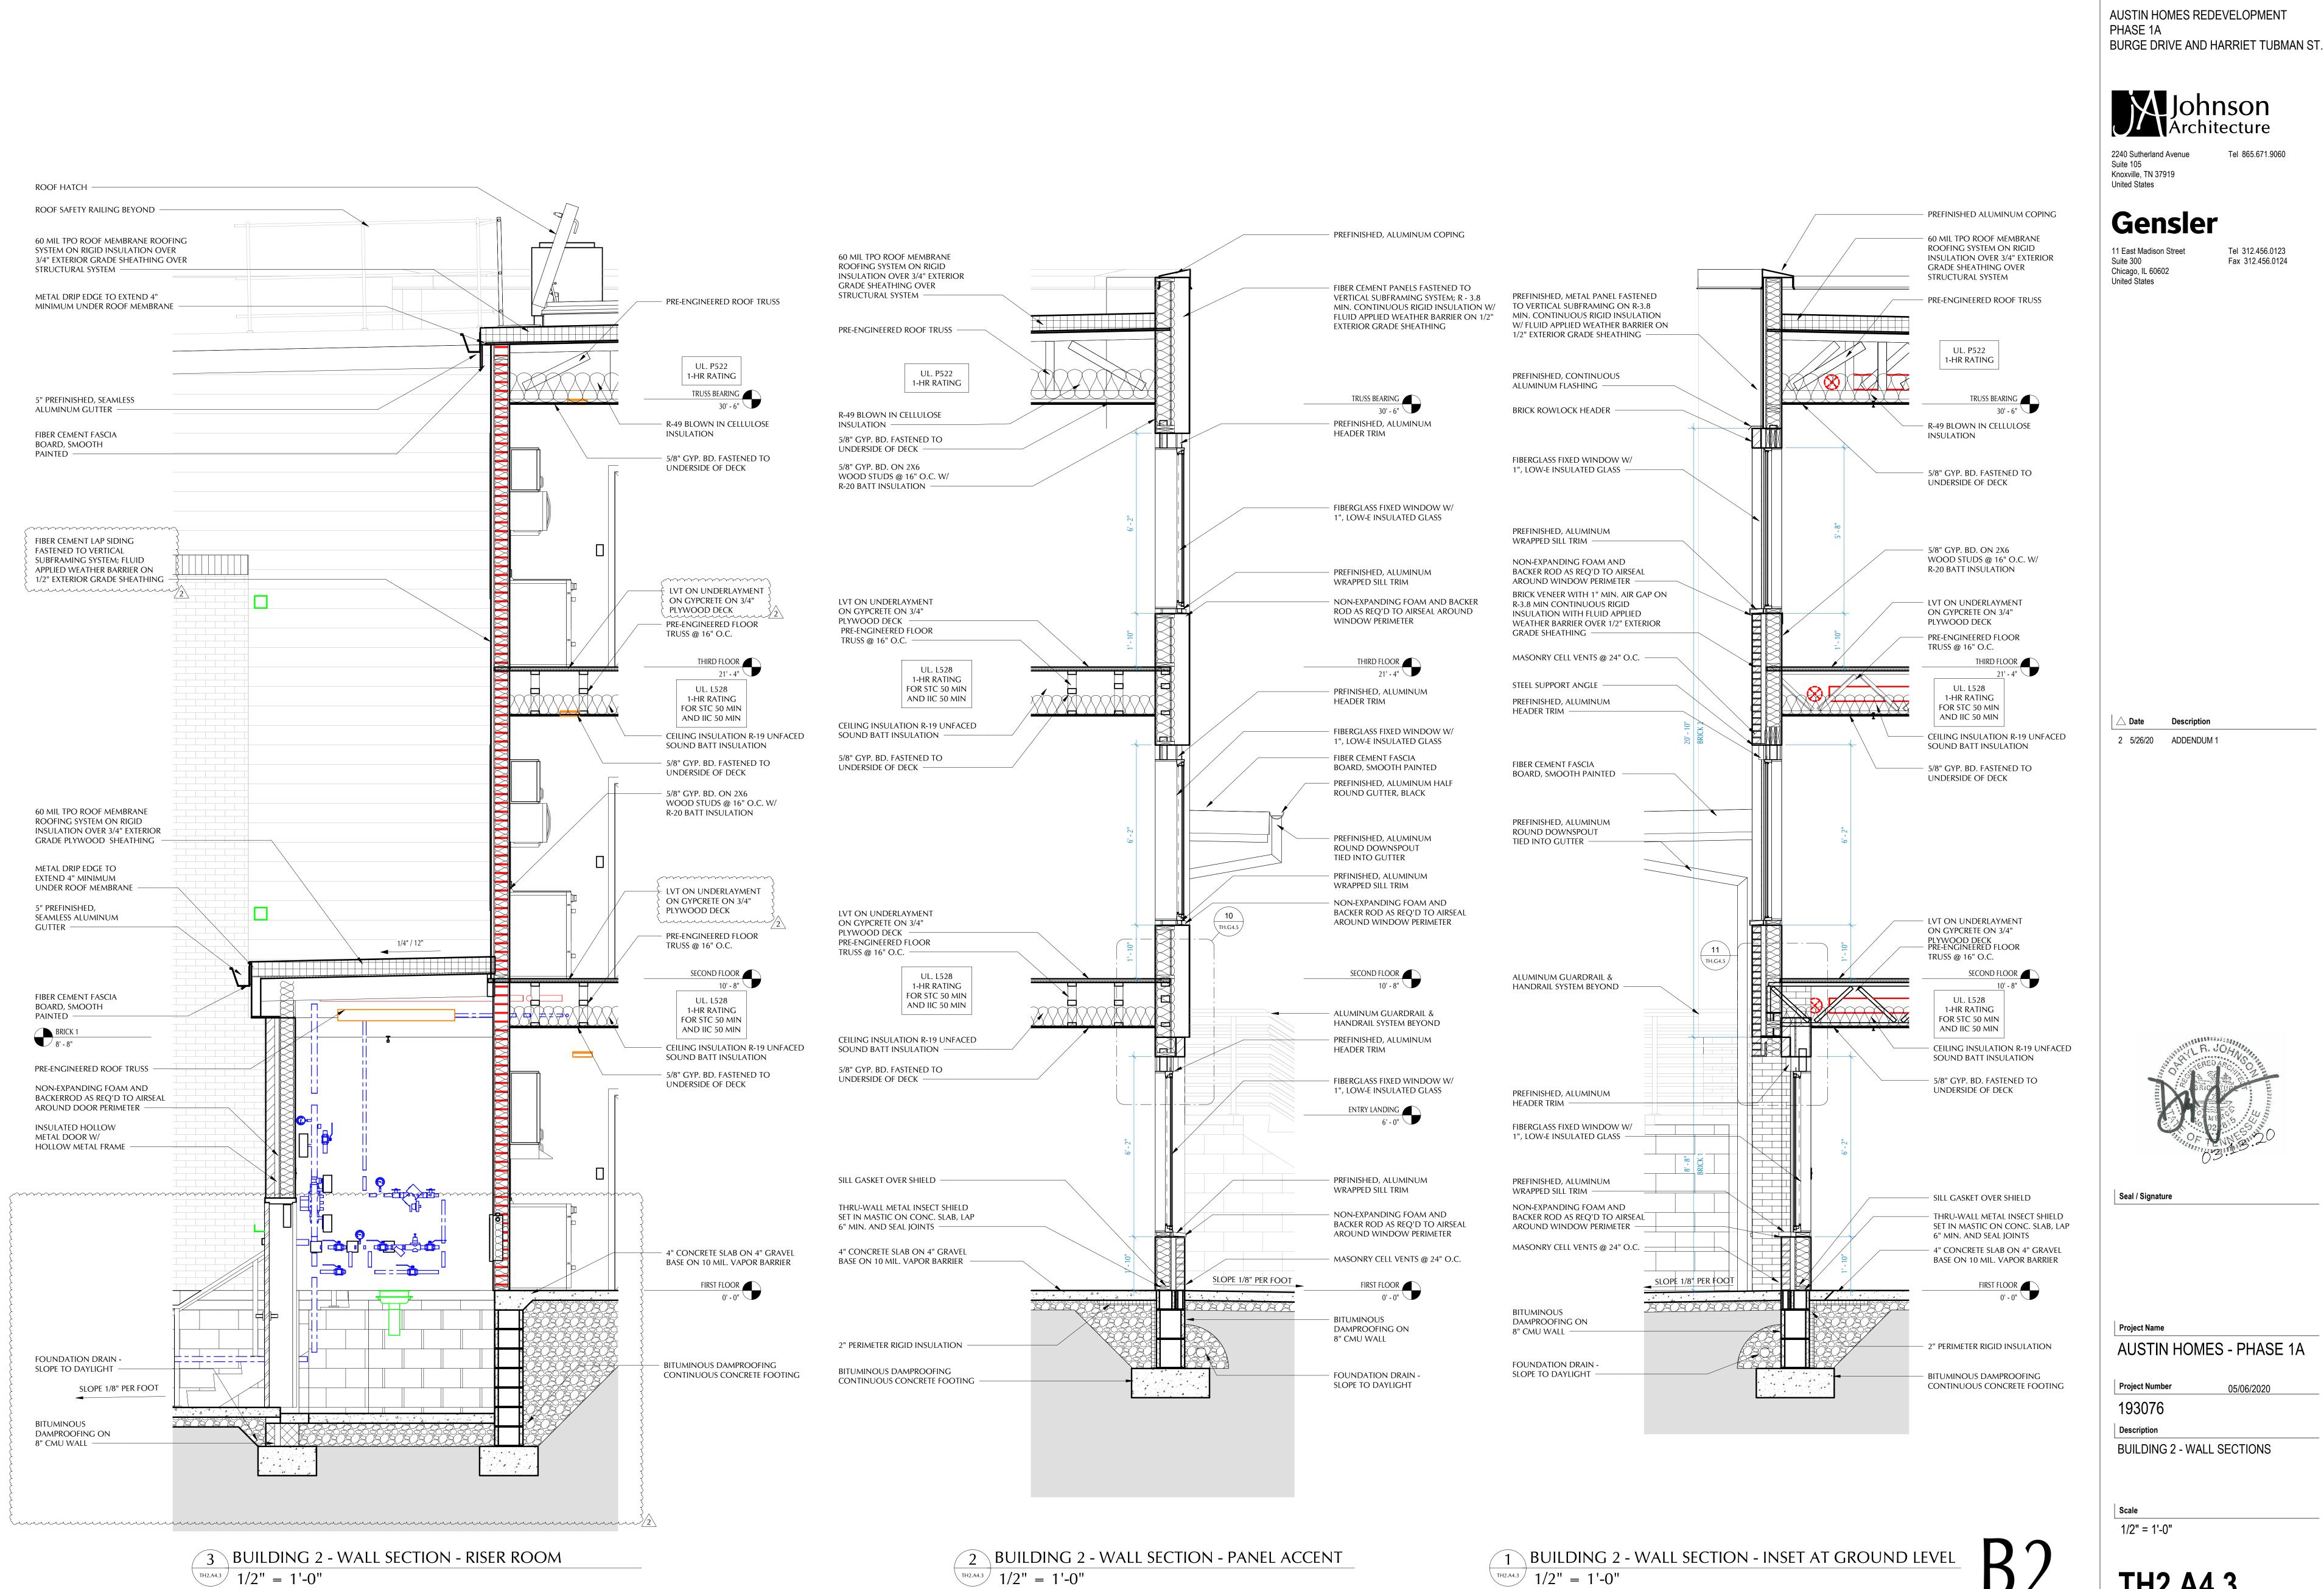

TH2.A4.3

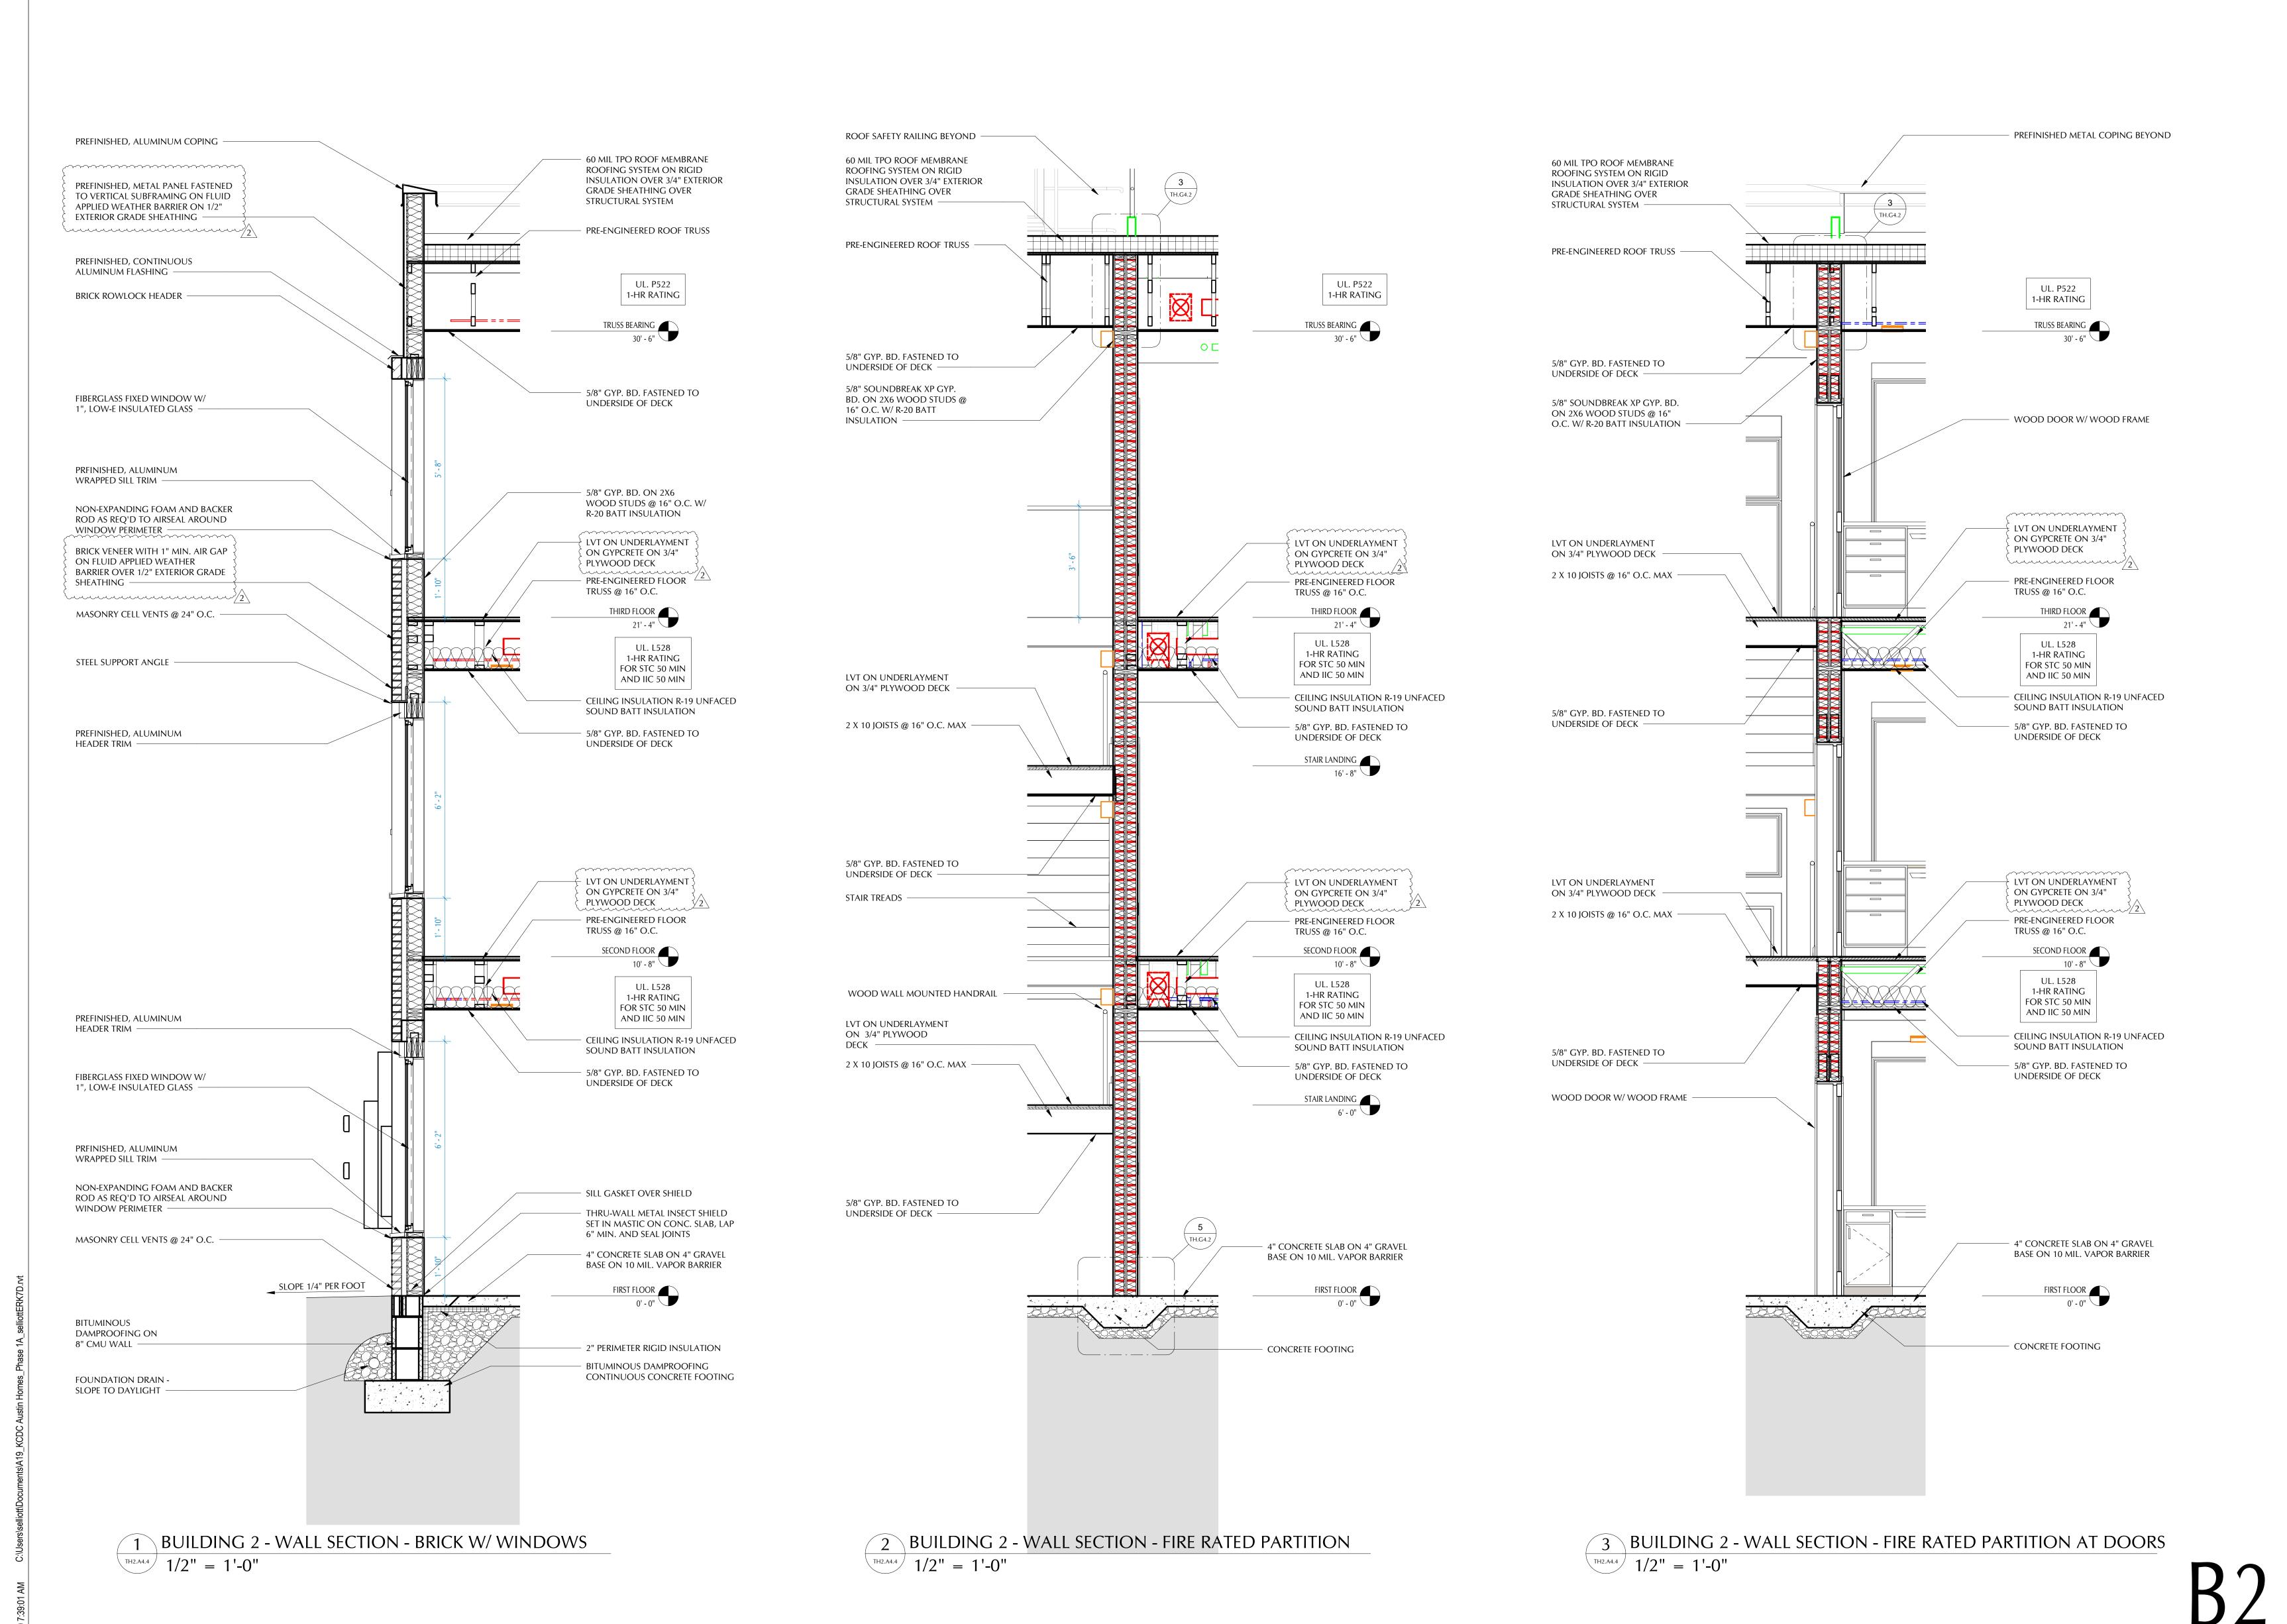

AUSTIN HOMES REDEVELOPMENT
PHASE 1A
BURGE DRIVE AND HARRIET TUBMAN ST.



2240 Sutherland Avenue Tel 865.67 Suite 105 Knoxville, TN 37919 United States

ensler

11 East Madison Street Tel 312.456.0123
Suite 300 Fax 312.456.0124
Chicago, IL 60602
United States

∆ Date Description

2 5/26/20 ADDENDUM 1



Seal / Signature

Project Name

AUSTIN HOMES - PHASE 1A

Project Number 05/06/2020

Project Number 05/06/2020

193076


Description


BUILDING 2 - WALL SECTIONS

Scale

1/2" = 1'-0"

TH2.A4.4

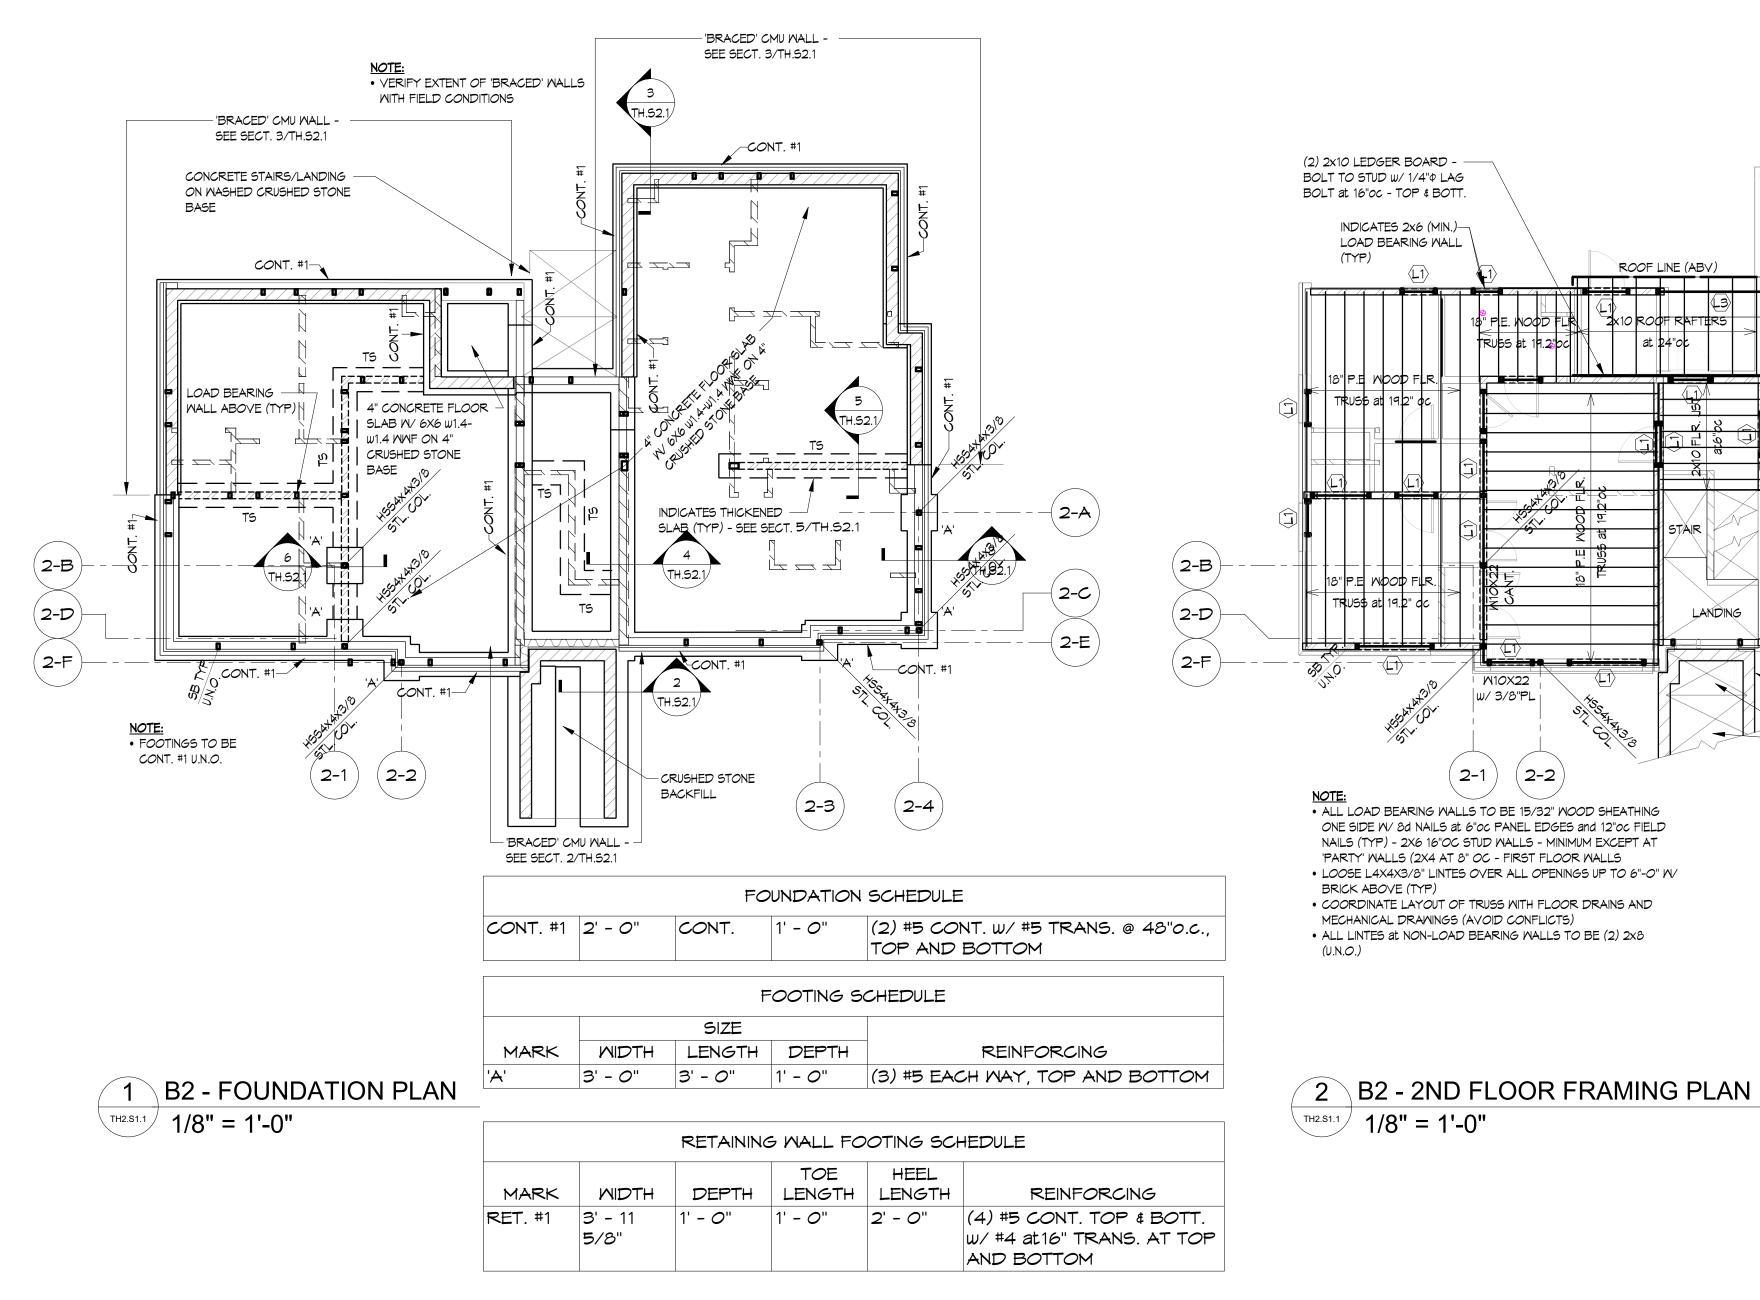

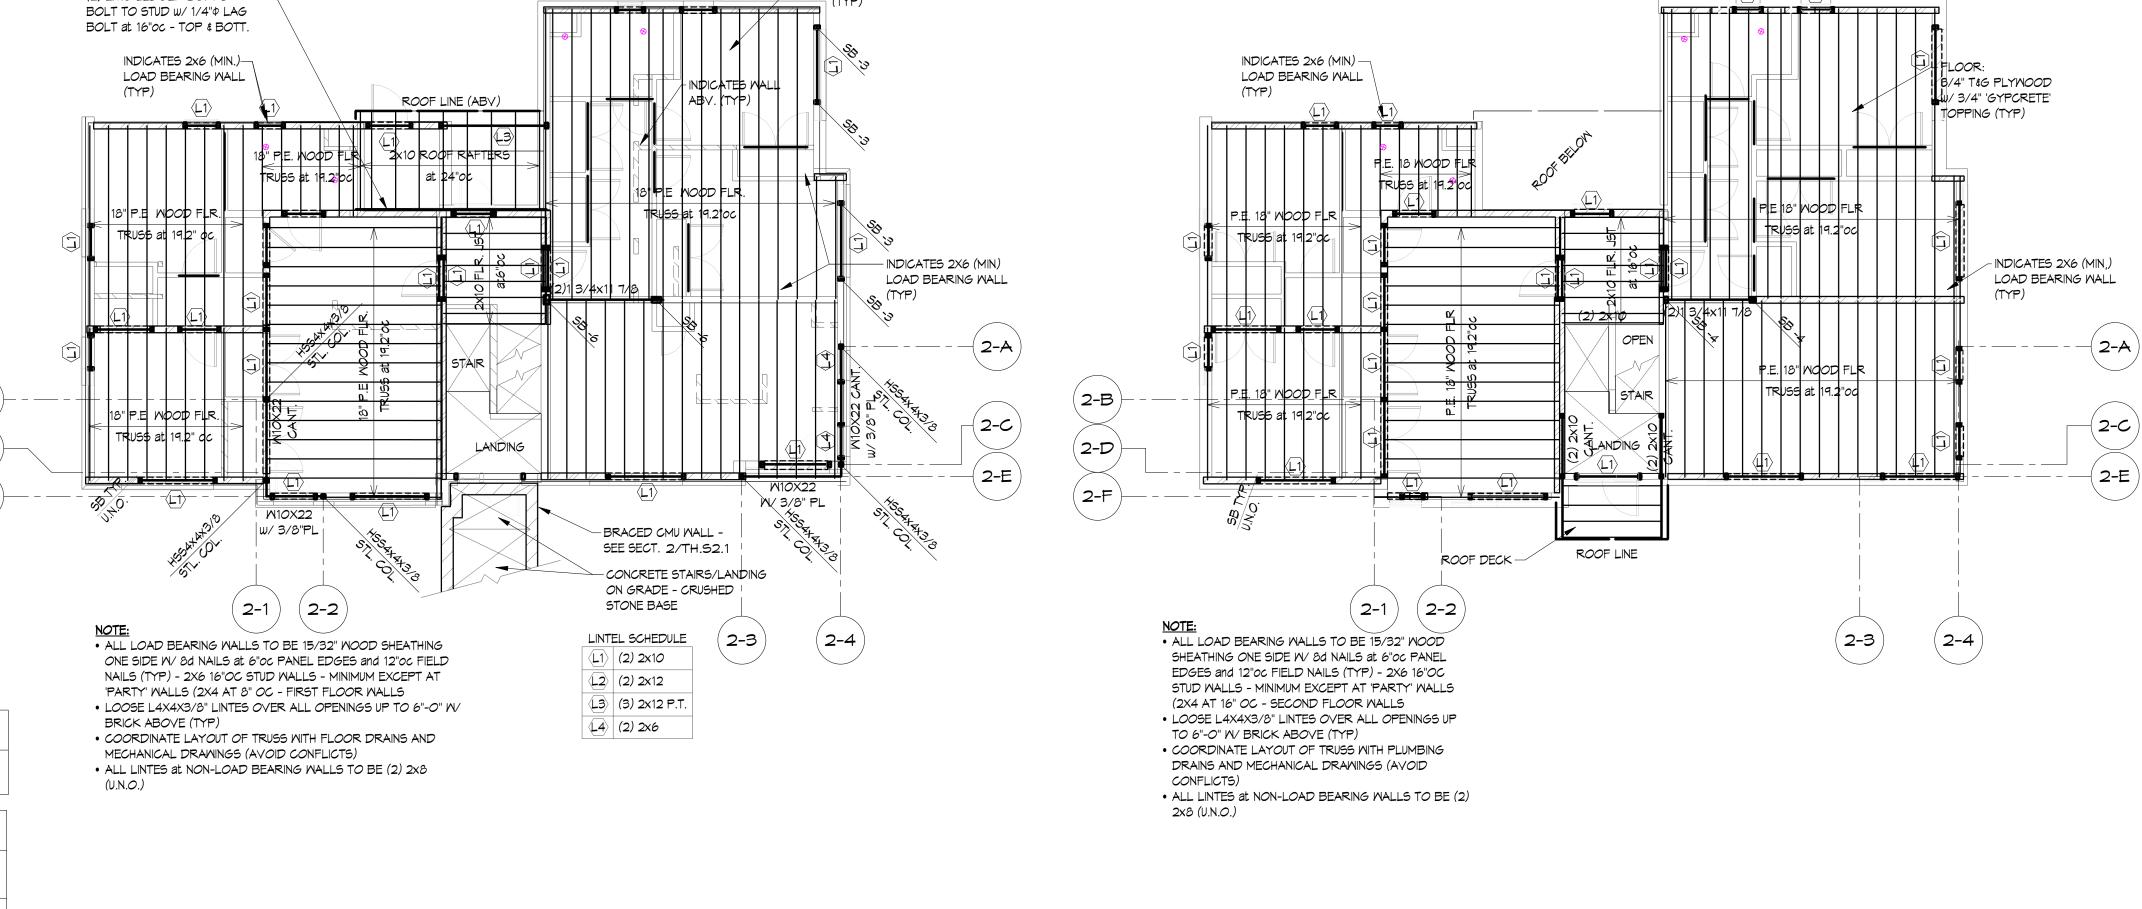

3 B2 - 3RD FLR FRAMING PLAN

TH2.S1.1 1/8" = 1'-0"

_FLOOR: 3/4" T&G PLYWOOD

W/ 3/4" 'GYPCRETE'

2 5.22.2020 Revision 2 REVISION /2 = • REVISED FOUNDATION/FRAMING BASED ON REVISED GRADING PLAN. MINOR REVISIONS TO UNIT FRAMING PLANS FOR ADA COMPLIANCE

KCDC

901 N Boardway

Knoxville, TN 37917

Tel: 865-403-1100

2240 Sutherland Avenue

Gensler

11 East Madison Street

502 Union Avenue

Knoxville, TN 37902 United States

Tel 865.524.777

Knoxville, TN 37919 United States

Suite 105

Suite 300 Chicago, IL 60602

Corporation

Knoxville Community Development

Tel 865.671.9060

Tel 312.456.0123 Fax 312.456.0124



Seal / Signature

Project Name **AUSTIN HOMES - PHASE 1A**

Project Number


BLDG B2 STRUCTURAL PLANS

As indicated

TH2.S1.1

4 B2 - ROOF FRAMING PLAN

TH2.S1.1 1/8" = 1'-0"

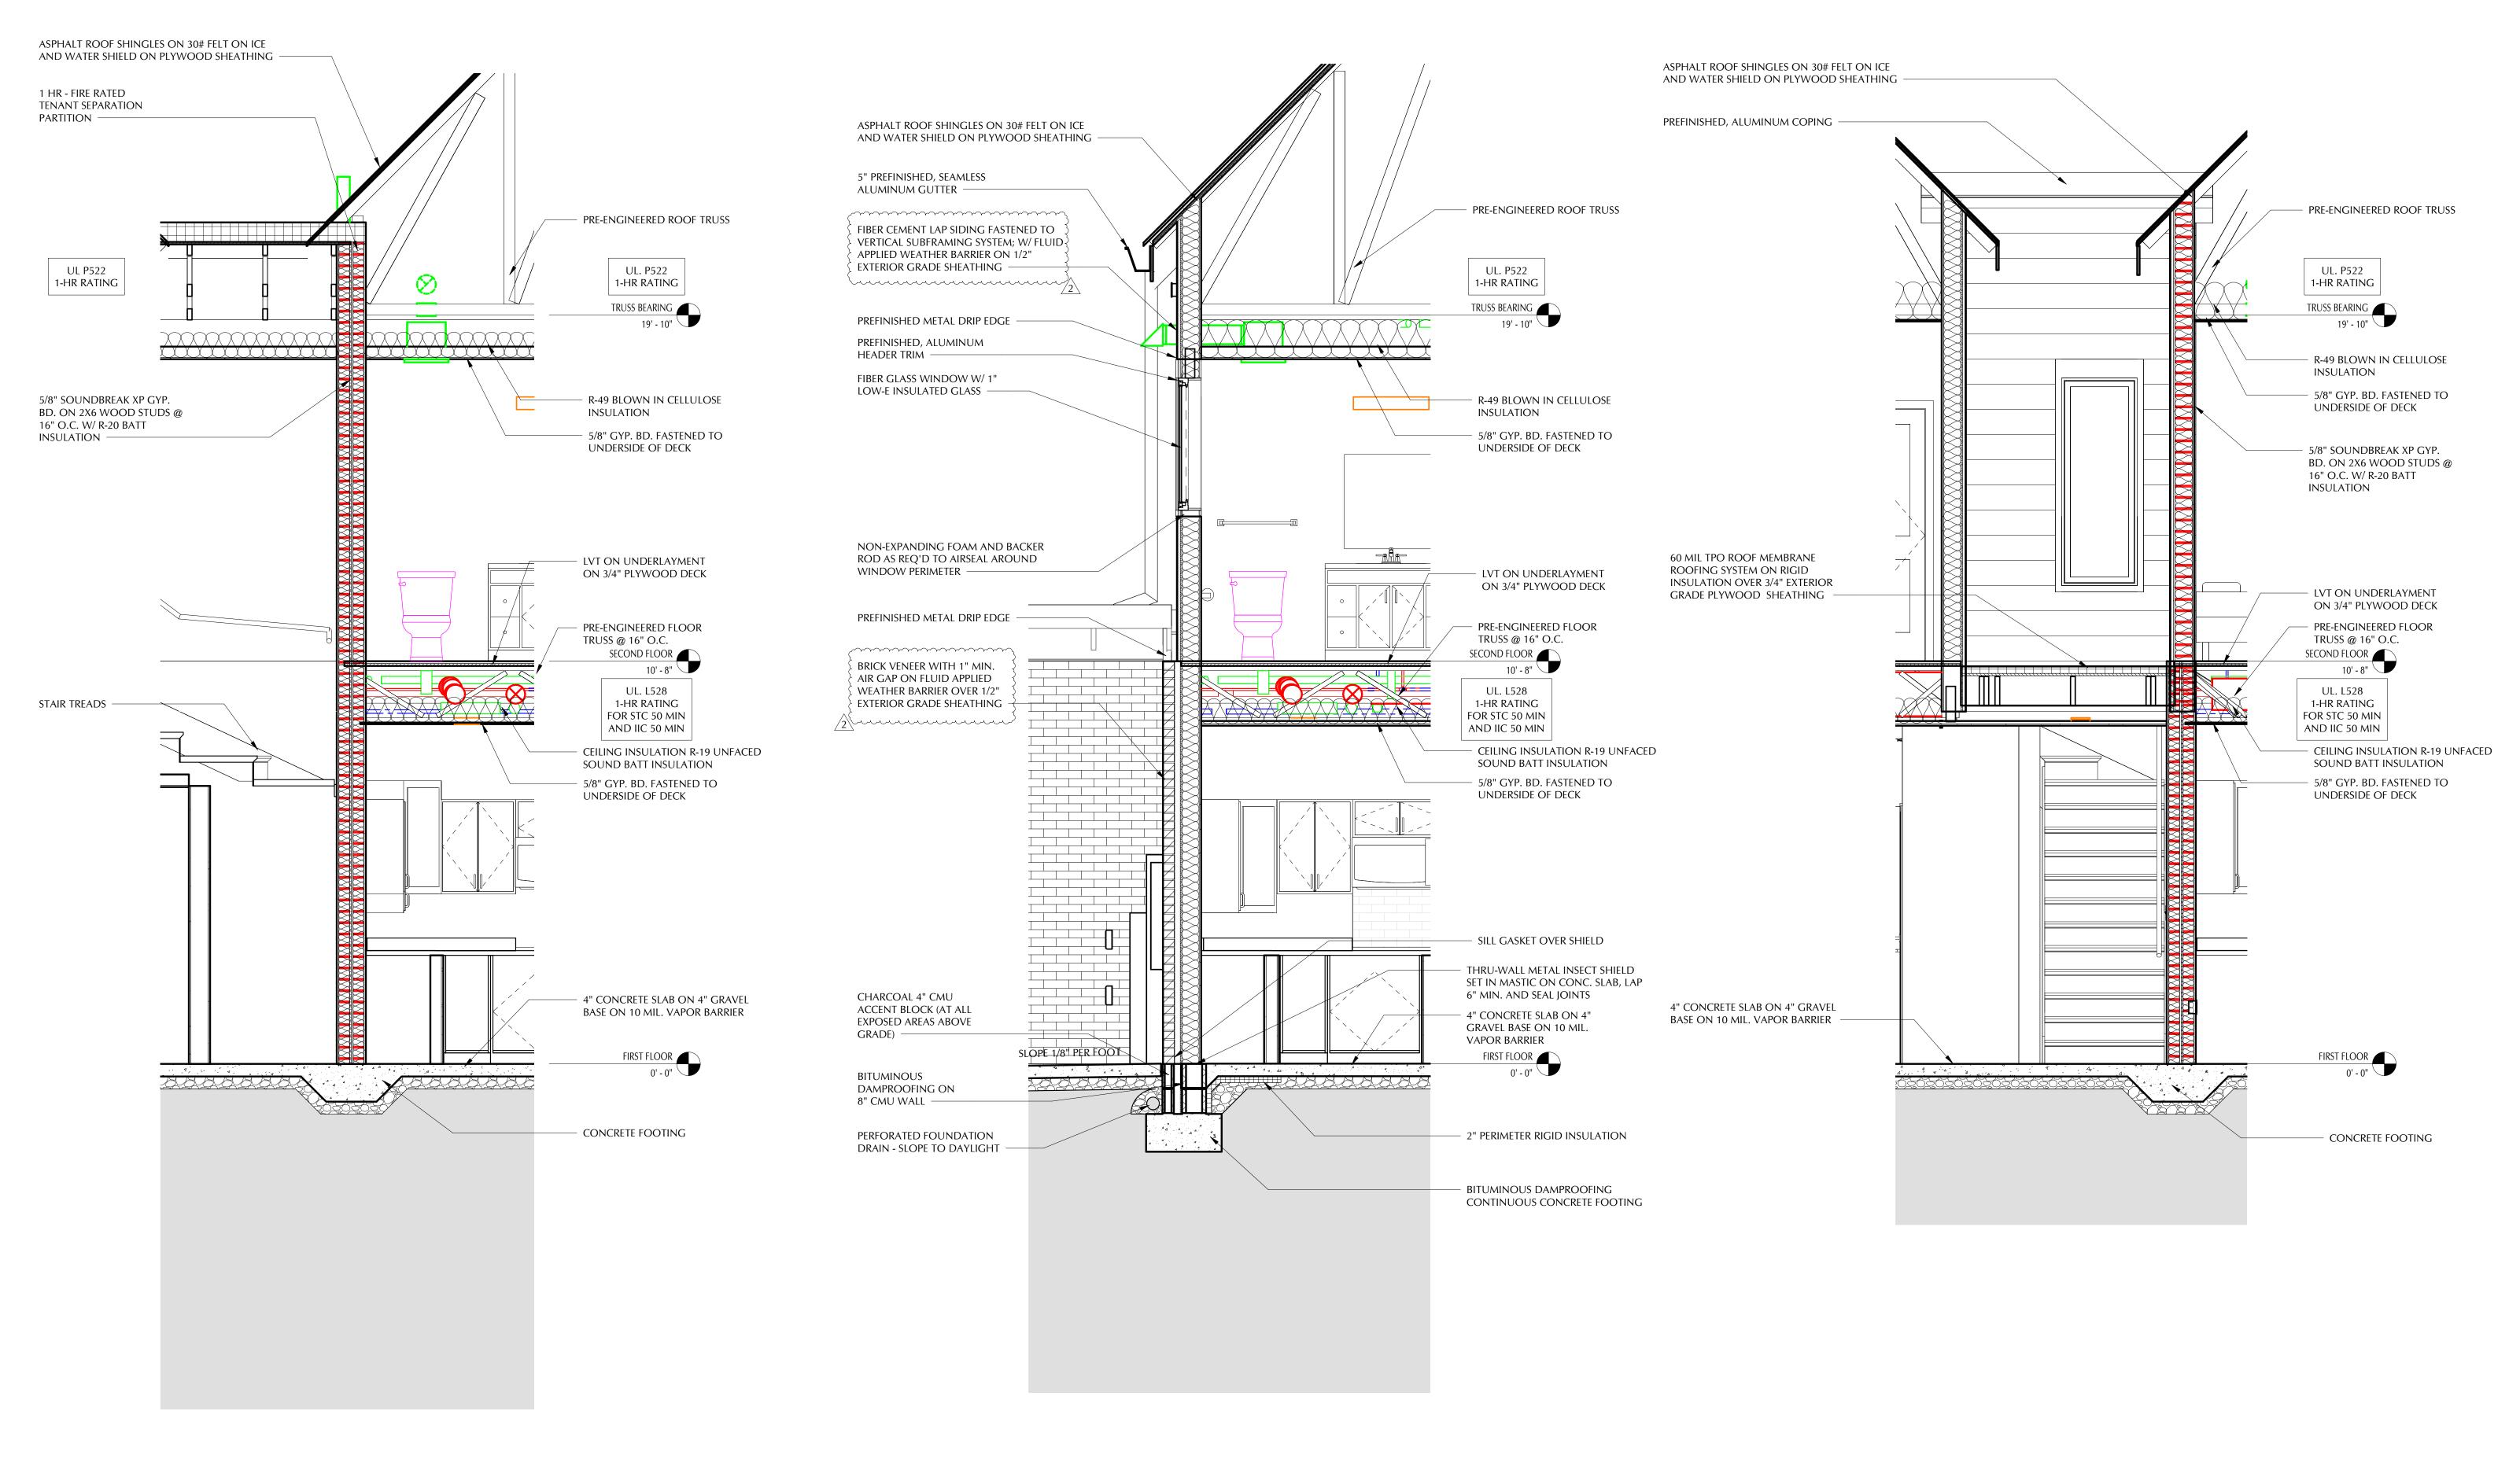

1 BUILDING 3 - WALL SECTION 1 1/2" = 1'-0"

BUILDING 3 - WALL SECTION 2 1/2" = 1'-0"

3 BUILDING 3 - WALL SECTION 3 1/2" = 1'-0"

KCDC KNOXVILLE'S COMMUNITY **DEVELOPMENT CORPORATION**

AUSTIN HOMES REDEVELOPMENT PHASE 1A BURGE DRIVE AND HARRIET TUBMAN ST.



2240 Sutherland Avenue Tel 865.671.9060 Suite 105 Knoxville, TN 37919 **United States**

Suite 300

11 East Madison Street Tel 312.456.0123 Fax 312.456.0124 Chicago, IL 60602 United States

 ∆ Date Description 2 5/26/20 ADDENDUM 1



Seal / Signature


AUSTIN HOMES - PHASE 1A


Project Number 05/06/2020


193076

BUILDING 3 - WALL SECTIONS

1/2" = 1'-0"

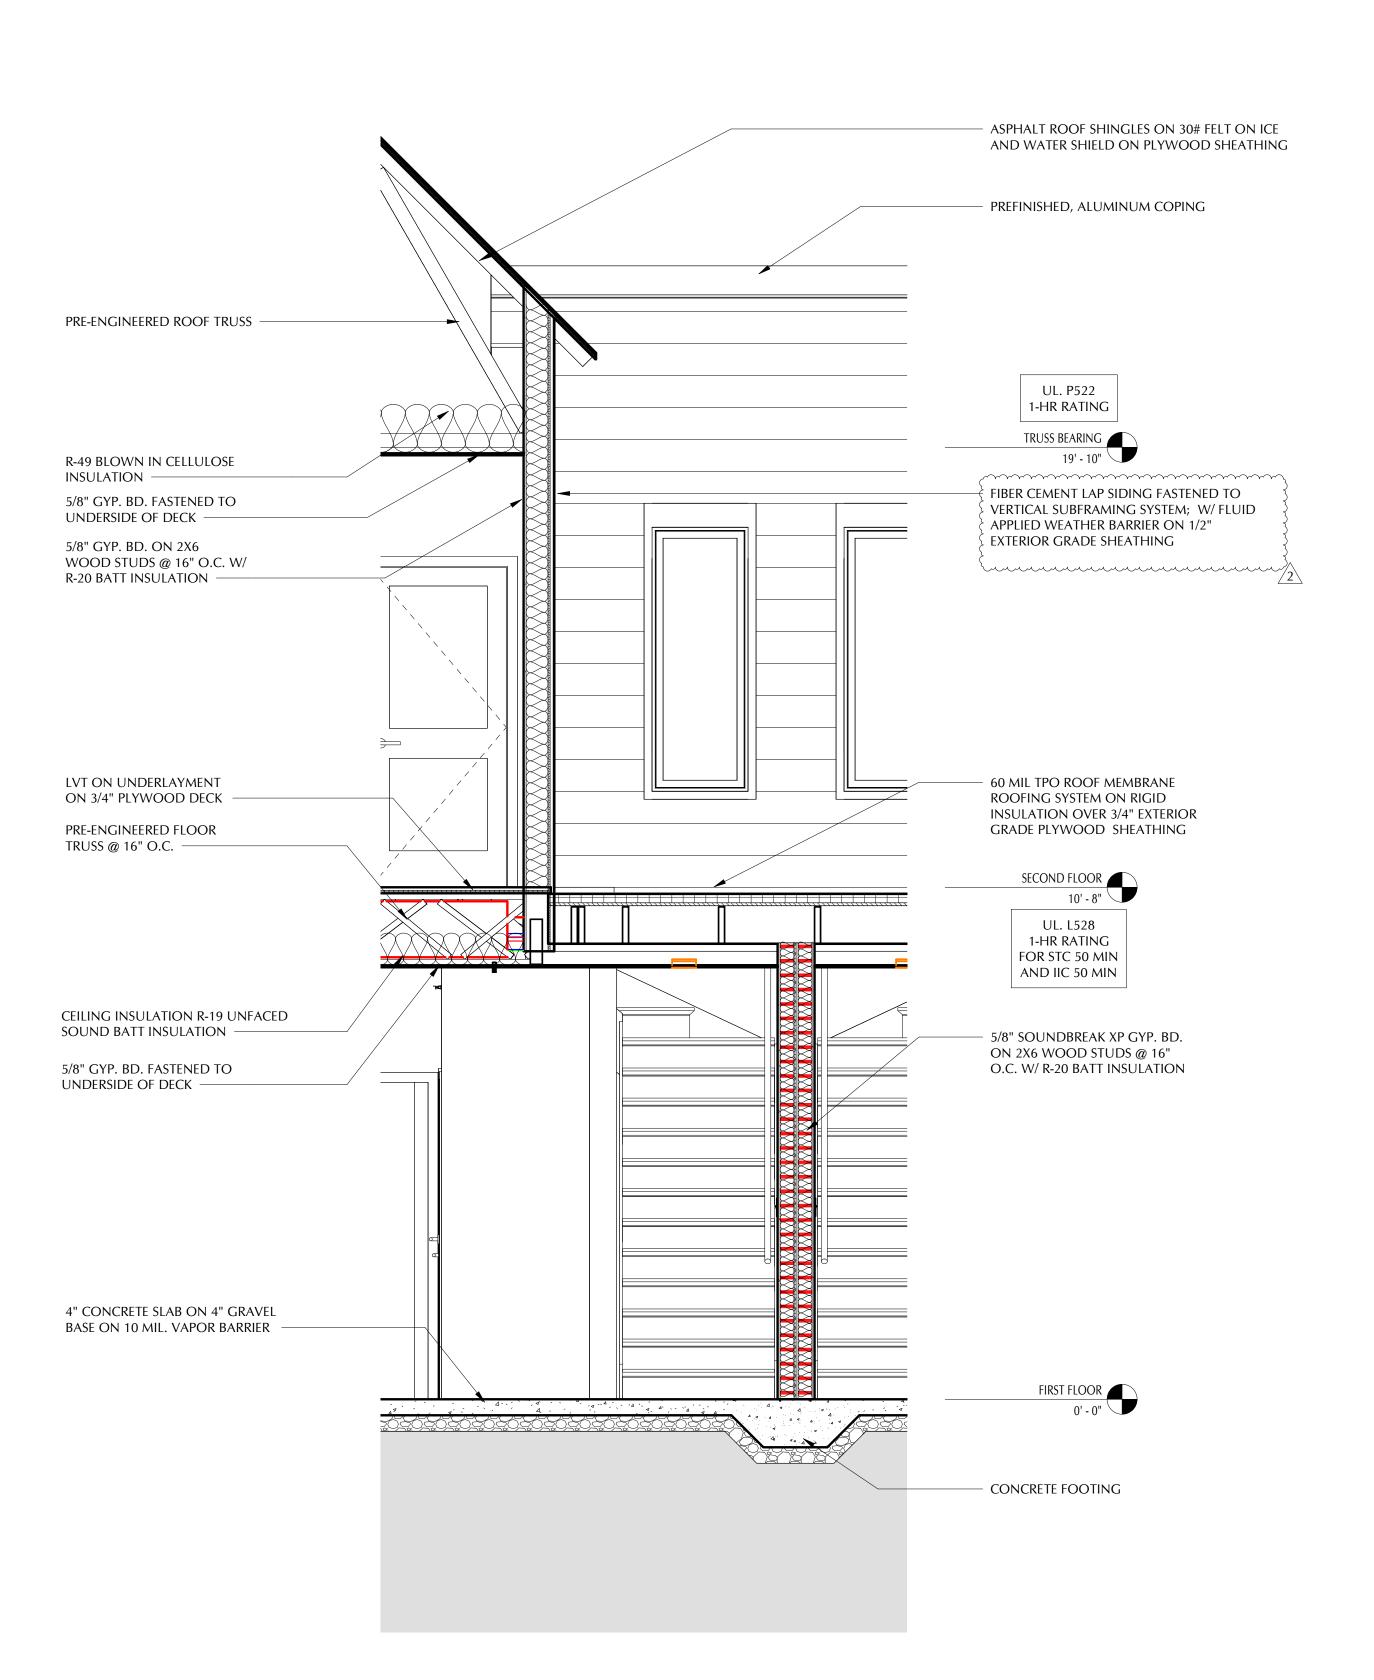

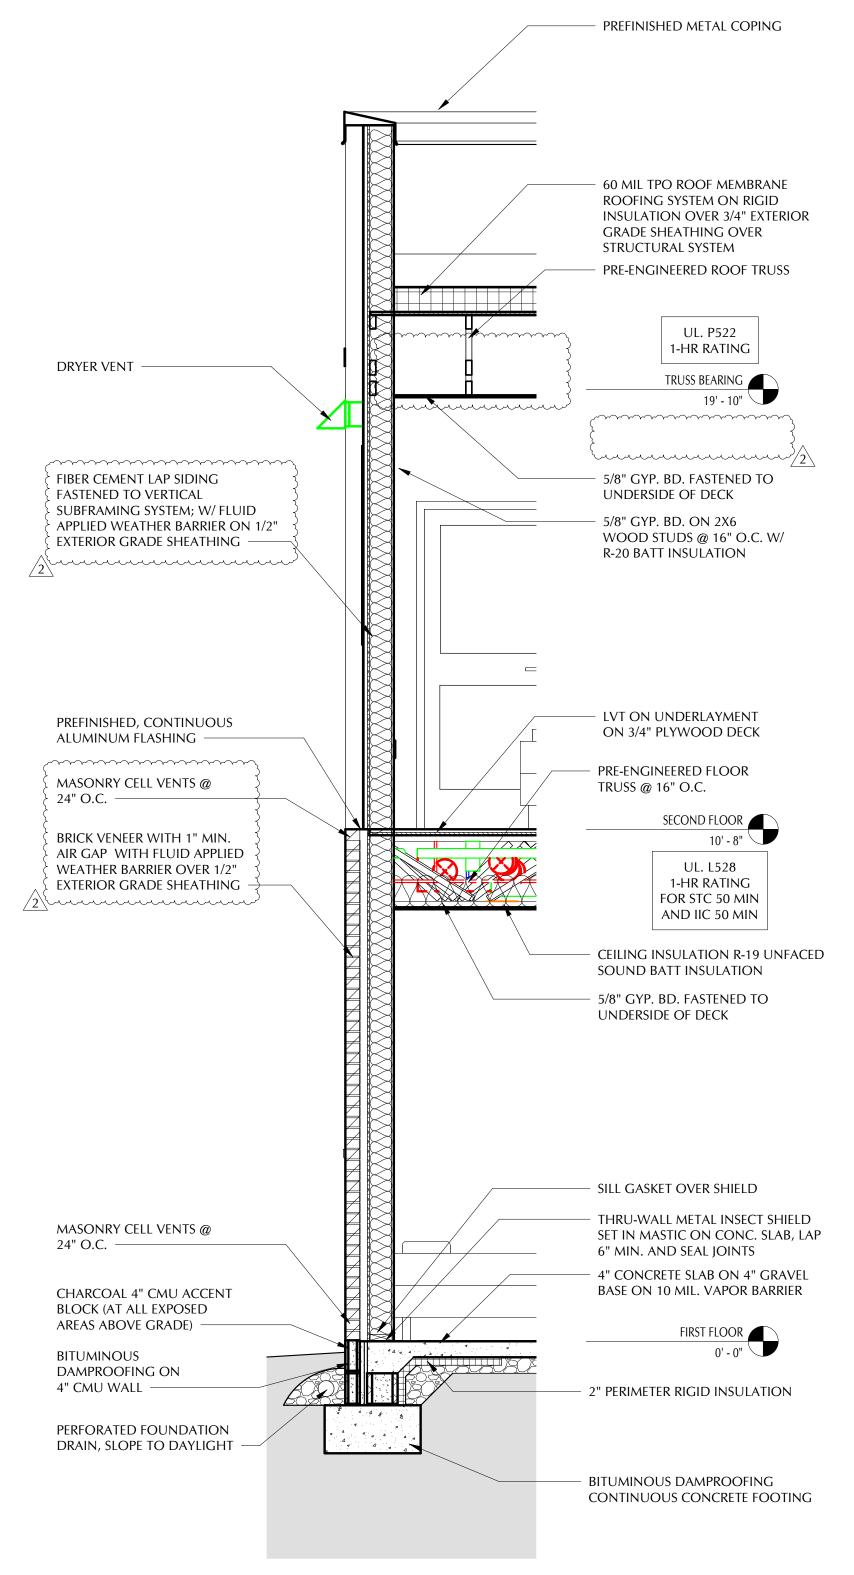

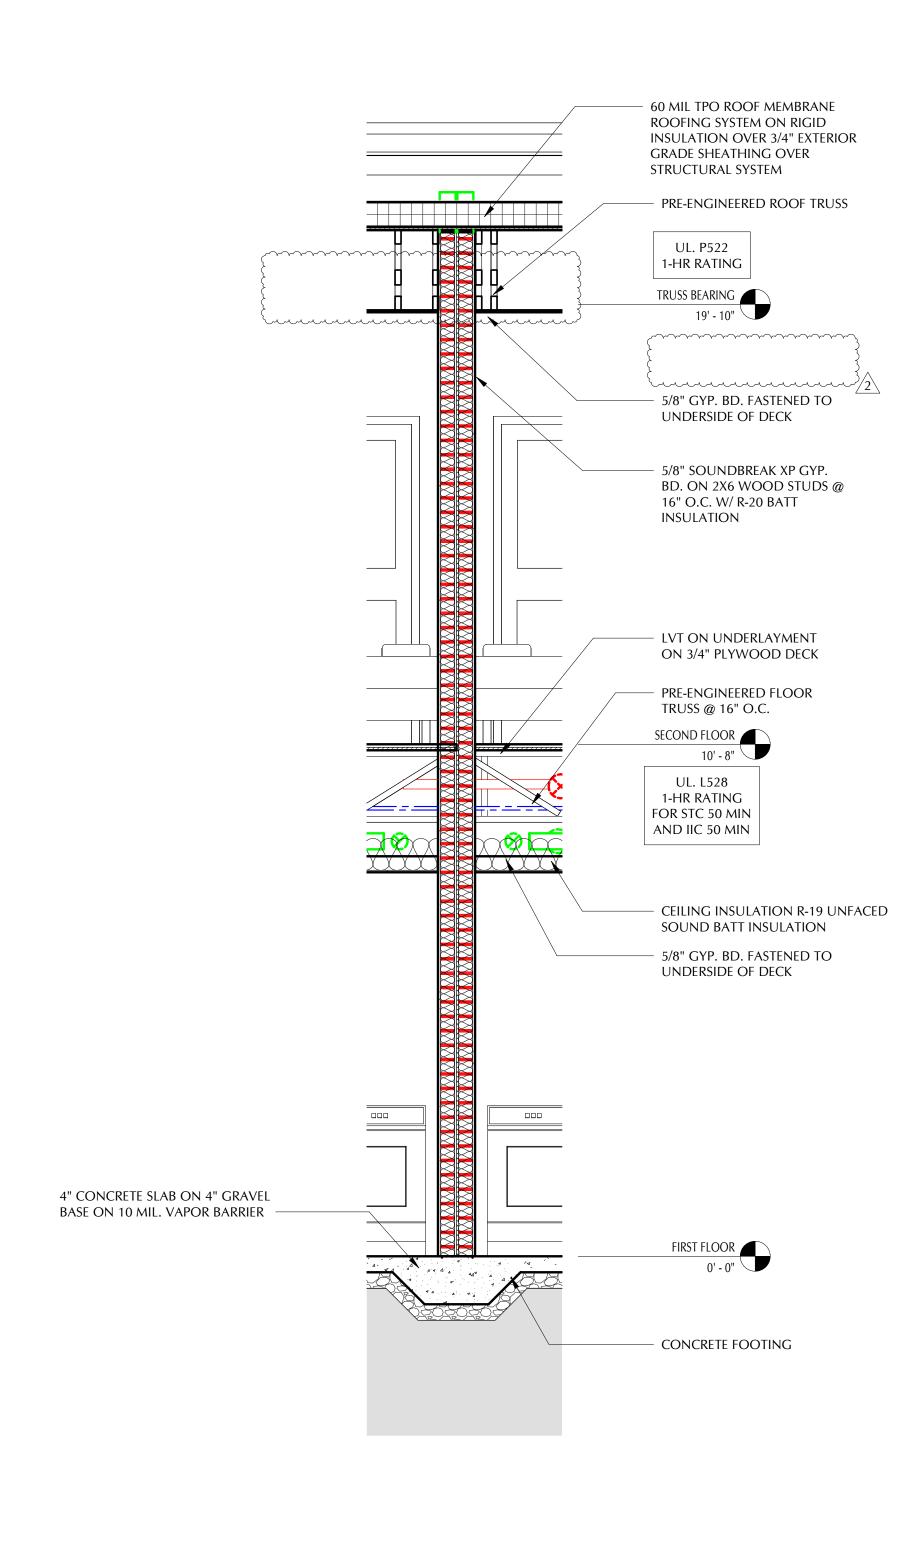

1 BUILDING 3 - WALL SECTION 4

BUILDING 3 - WALL SECTION 5 1/2" = 1'-0"

3 BUILDING 3 - WALL SECTION 6 1/2" = 1'-0"

KCDC

KNOXVILLE'S COMMUNITY
DEVELOPMENT CORPORATION

AUSTIN HOMES REDEVELOPMENT PHASE 1A BURGE DRIVE AND HARRIET TUBMAN ST.

Johnson Architecture

2240 Sutherland Avenue Tel 865.671.9060
Suite 105
Knoxville, TN 37919
United States

ensler

11 East Madison Street Suite 300 Chicago, IL 60602 United States

Tel 312.456.0123

Fax 312.456.0124



| Seal / Signature

Project Name

AUSTIN HOMES - PHASE 1A

Project Number 05/06/2020


193076

Description

BUILDING 3 - WALL SECTIONS

Scale 1/2" = 1'-0"

TH3 **Δ4** 3

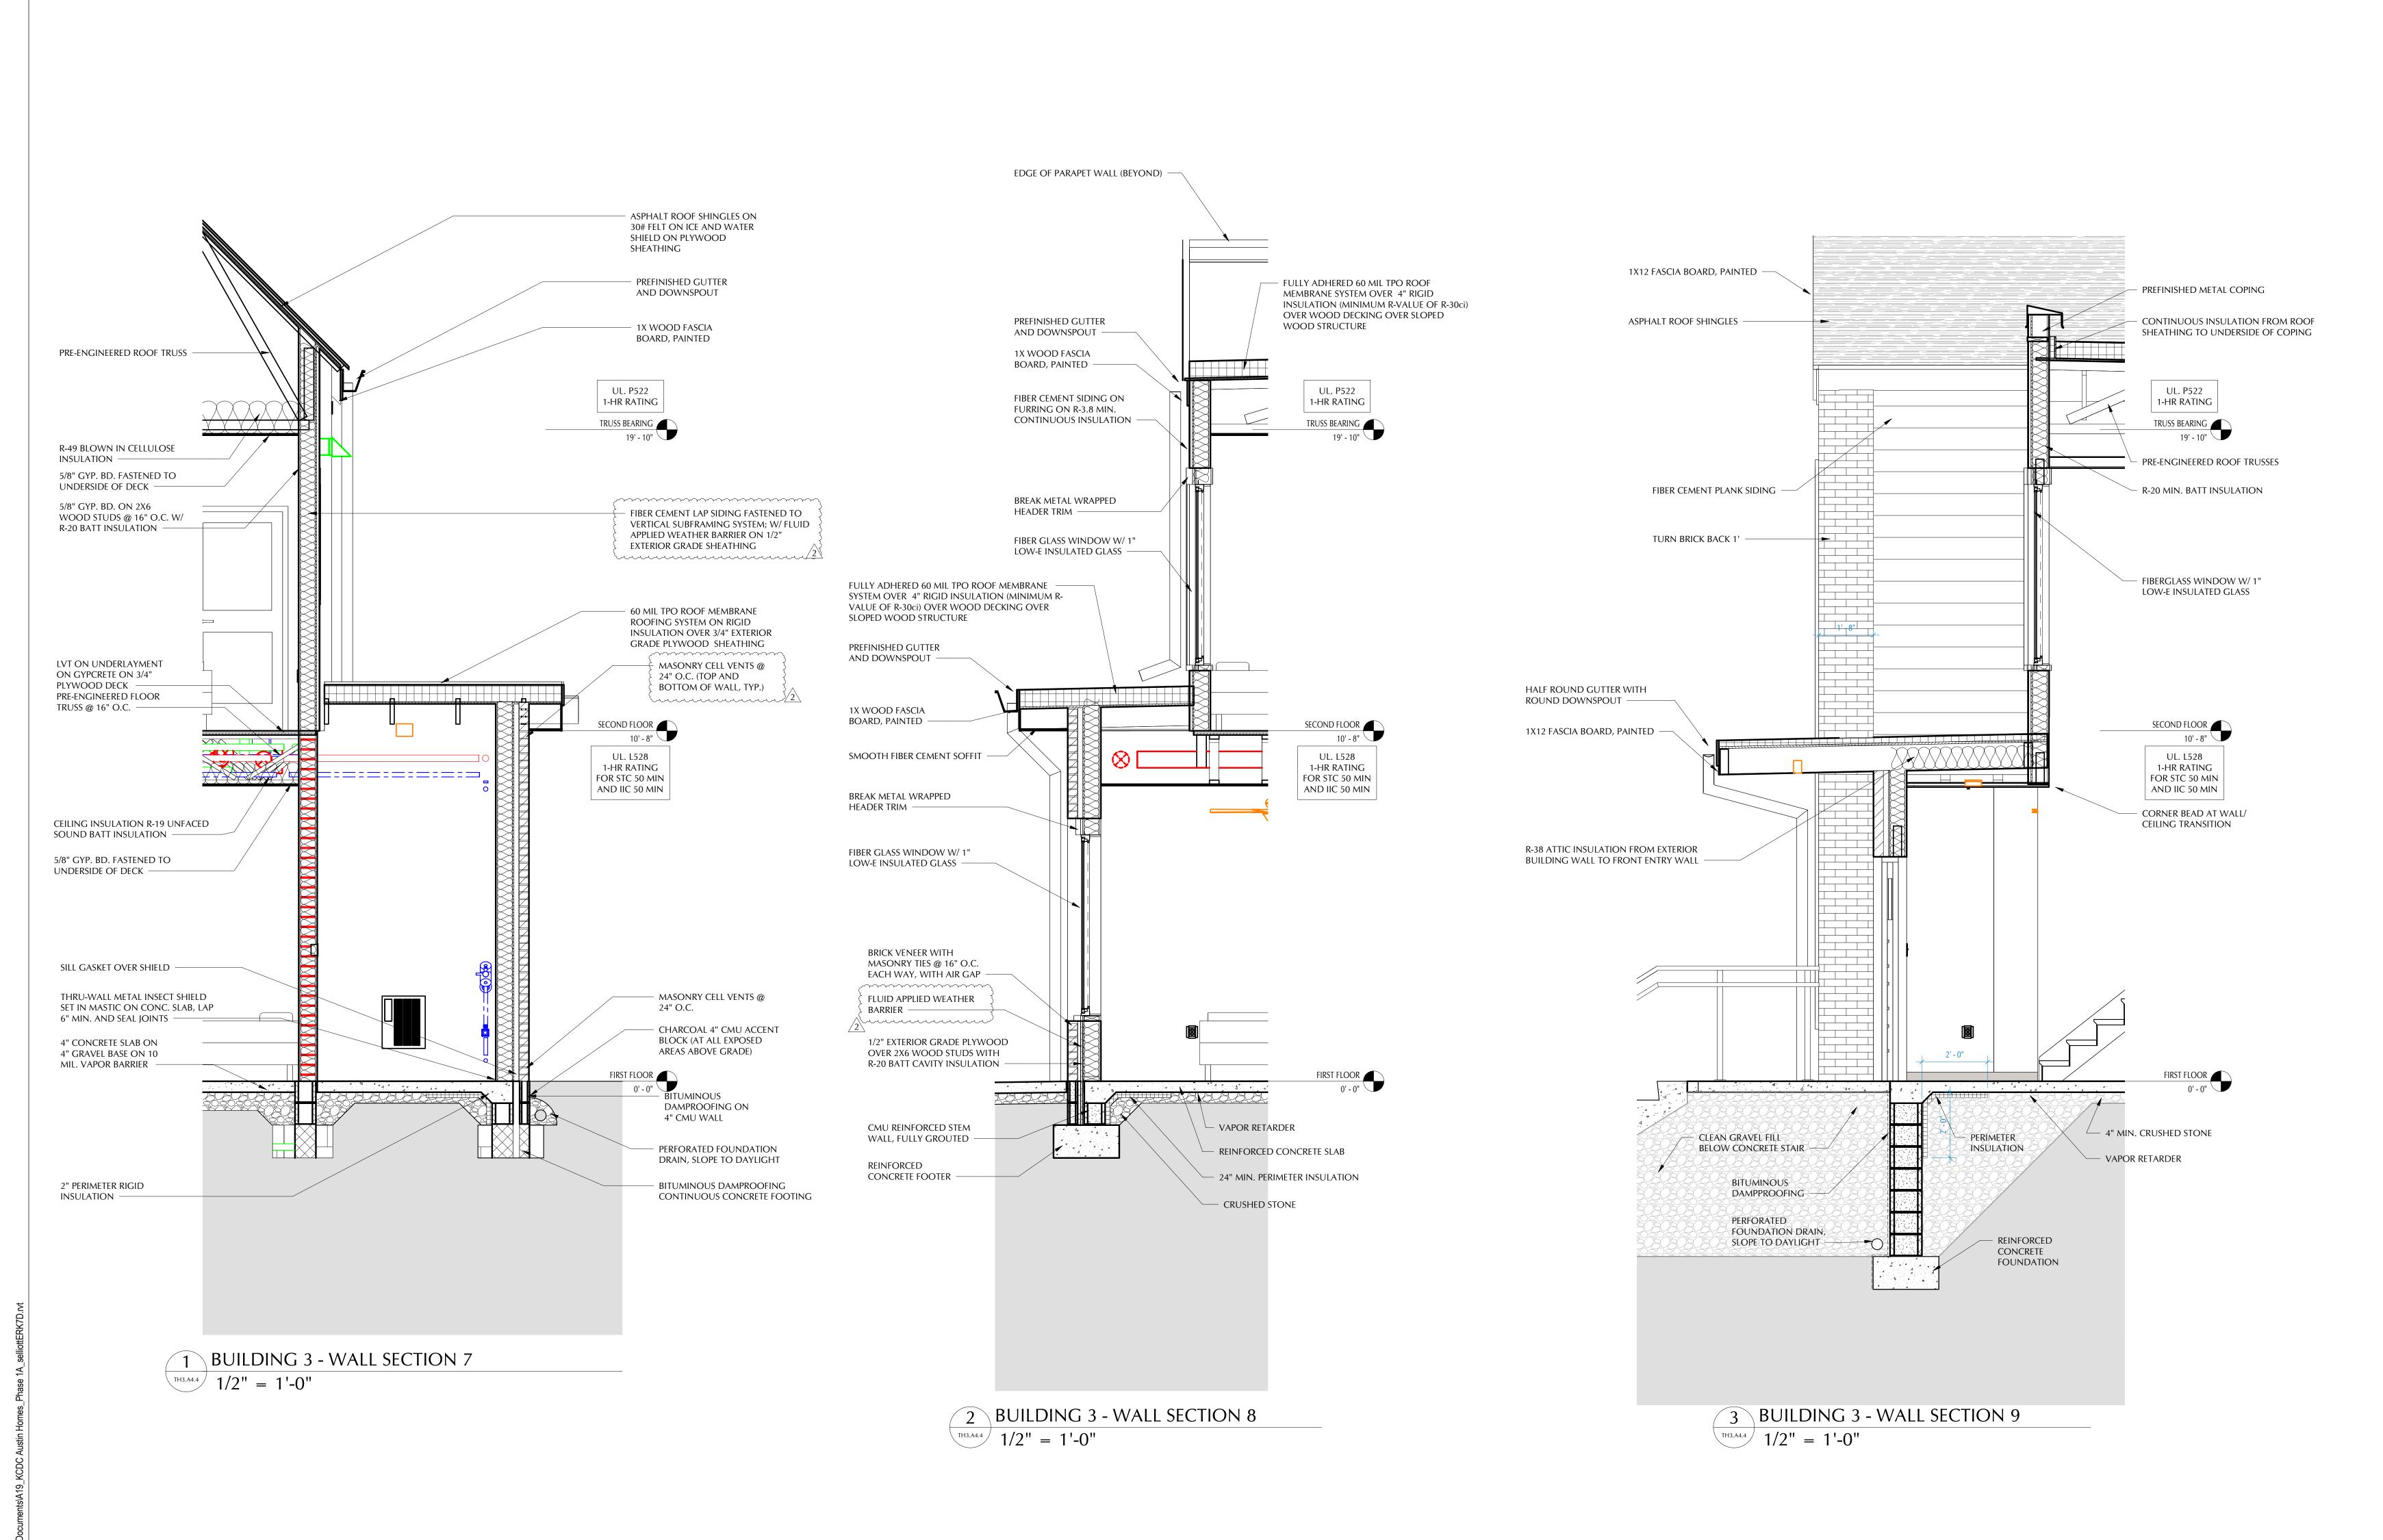

KCDC

KNOXVILLE'S COMMUNITY **DEVELOPMENT CORPORATION**

AUSTIN HOMES REDEVELOPMENT PHASE 1A BURGE DRIVE AND HARRIET TUBMAN ST.




2240 Sutherland Avenue Suite 105 Knoxville, TN 37919 **United States**

11 East Madison Street Suite 300 Chicago, IL 60602 United States

Tel 312.456.0123

Fax 312.456.0124

 ∆ Date Description 1 5/06/20 PLANS REVIEW COMMENTS 2 5/26/20 ADDENDUM 1

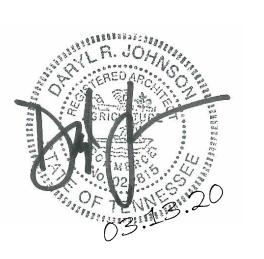

Seal / Signature

AUSTIN HOMES - PHASE 1A

05/06/2020


193076

Project Number

BUILDING 3 - WALL SECTIONS

1/2" = 1'-0"

TH3.A4.4

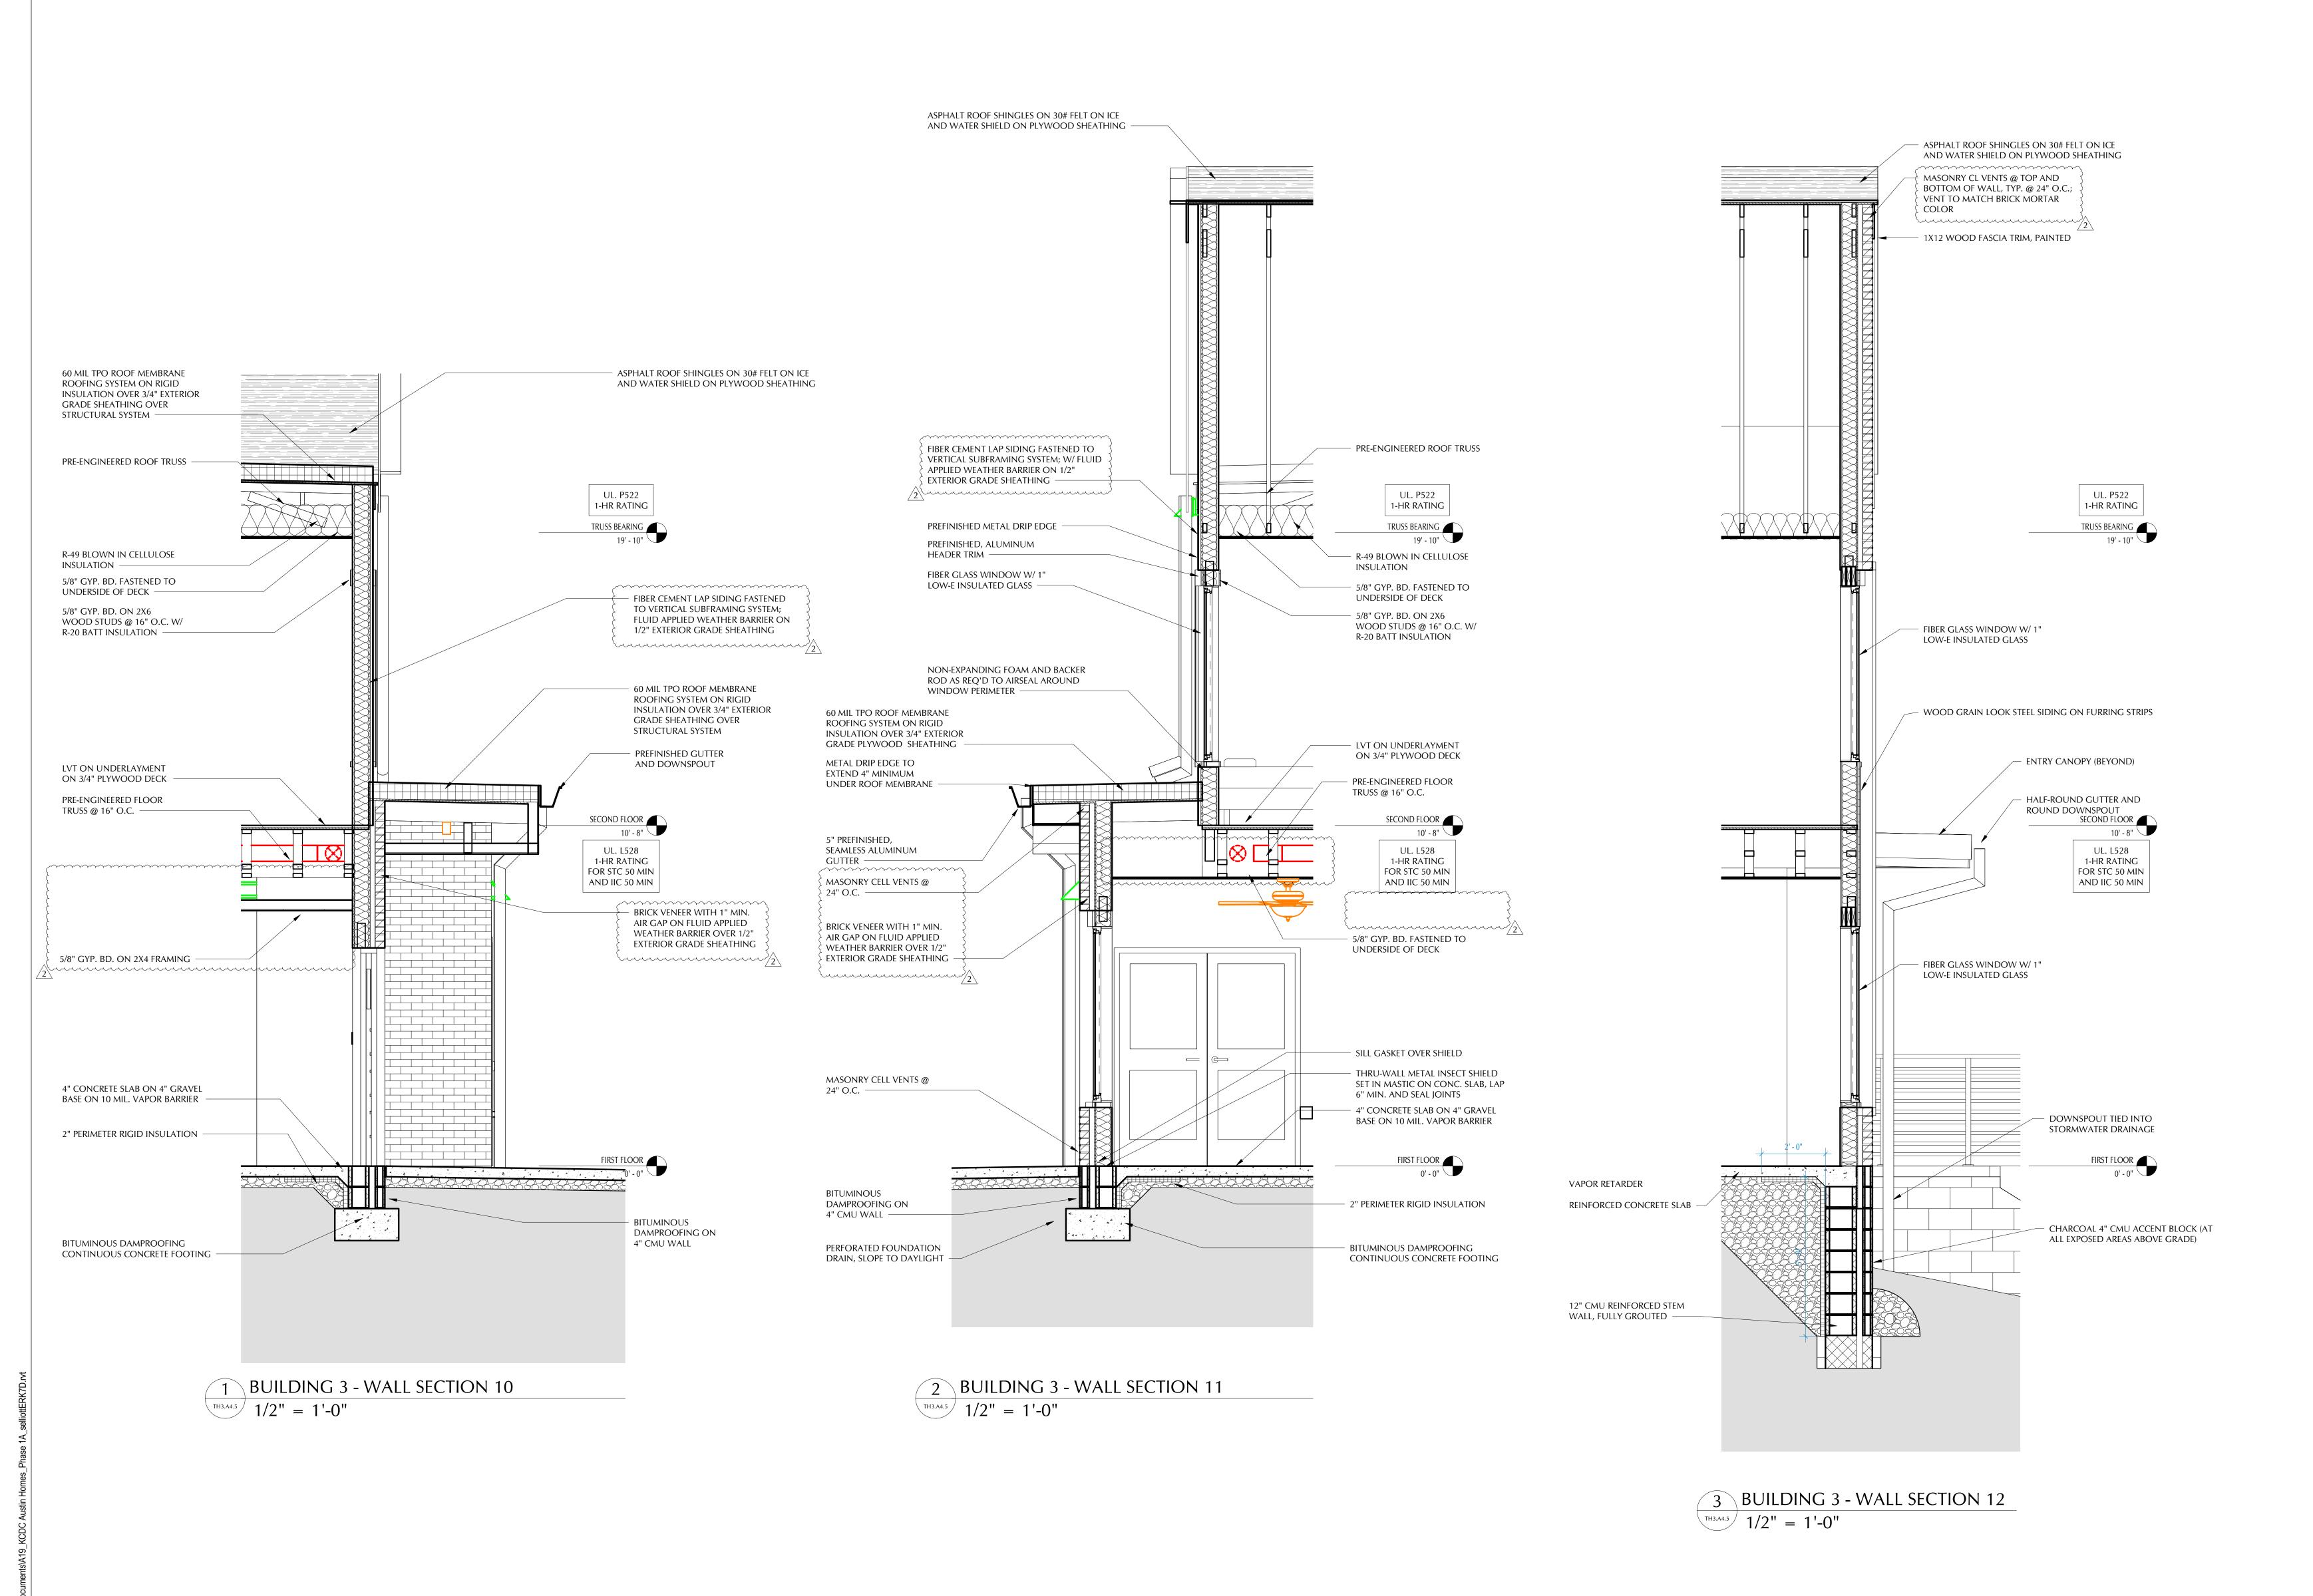

AUSTIN HOMES REDEVELOPMENT PHASE 1A BURGE DRIVE AND HARRIET TUBMAN ST.



2240 Sutherland Avenue Tel 865.671.9060 Suite 105 Knoxville, TN 37919 **United States**

11 East Madison Street Suite 300 Chicago, IL 60602 United States

Tel 312.456.0123 Fax 312.456.0124

 ∆ Date Description 1 5/06/20 PLANS REVIEW COMMENTS 2 5/26/20 ADDENDUM 1



Seal / Signature

AUSTIN HOMES - PHASE 1A


05/06/2020 193076

BUILDING 3 - WALL SECTIONS


1/2" = 1'-0"


Project Number

TH3.A4.5

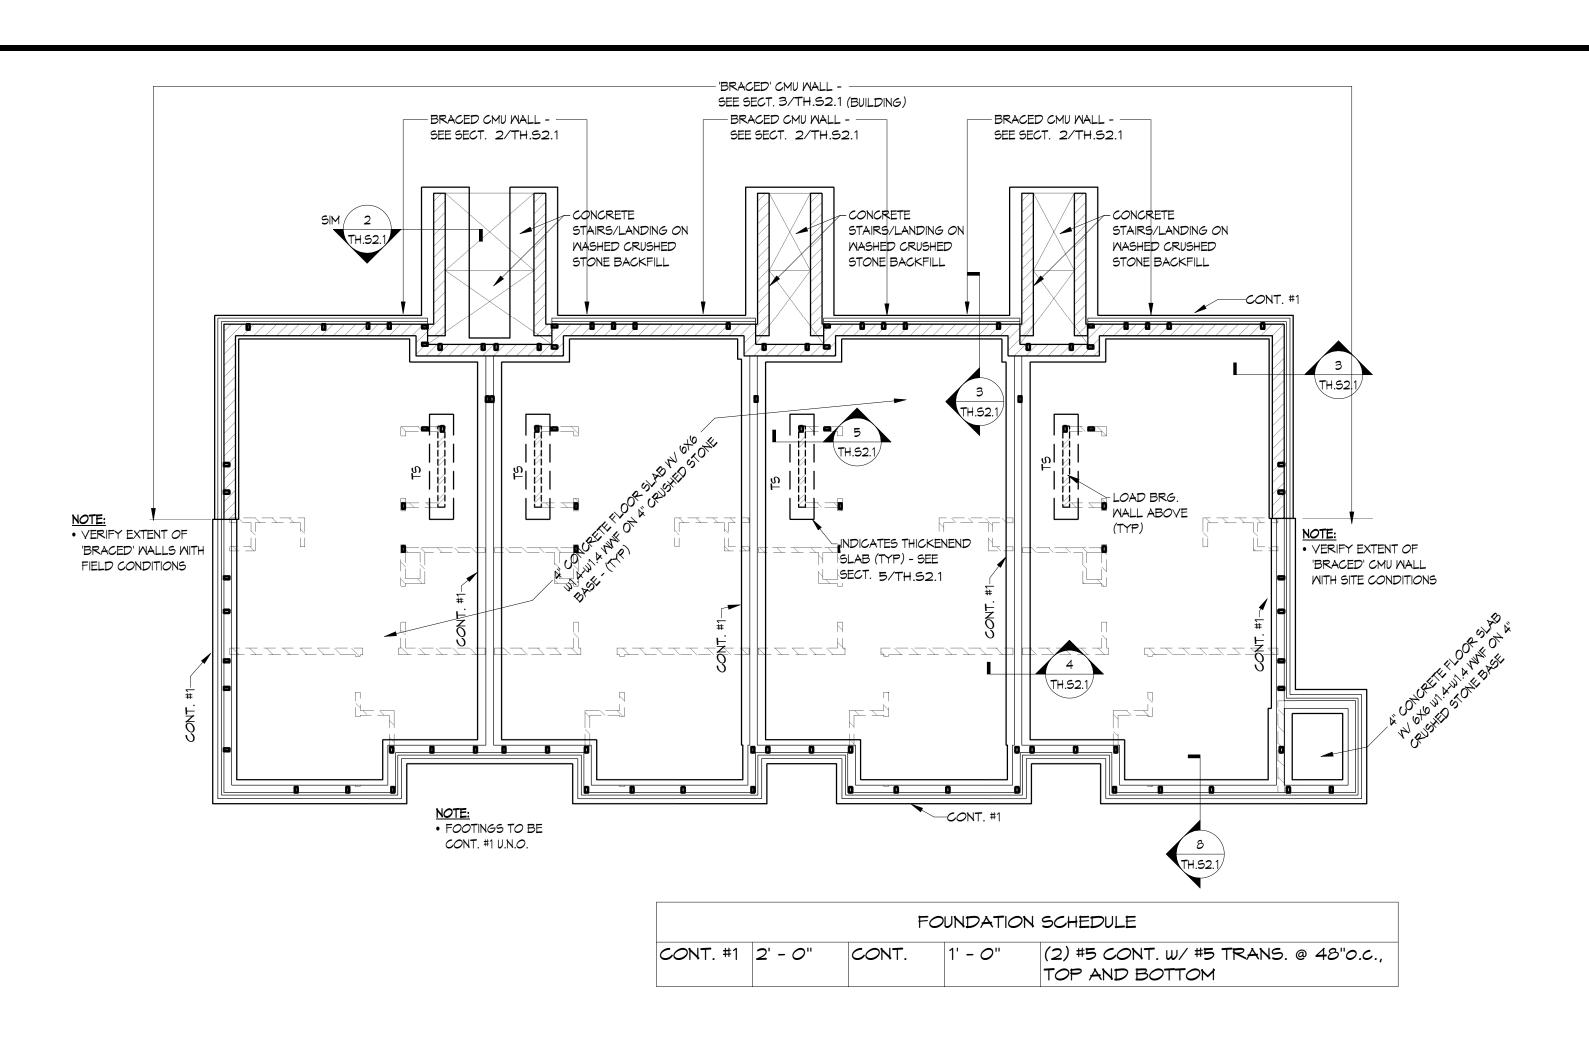

1 B3 - 0-FOUNDATION PLAN TH3.S1.1 1/8" = 1'-0"

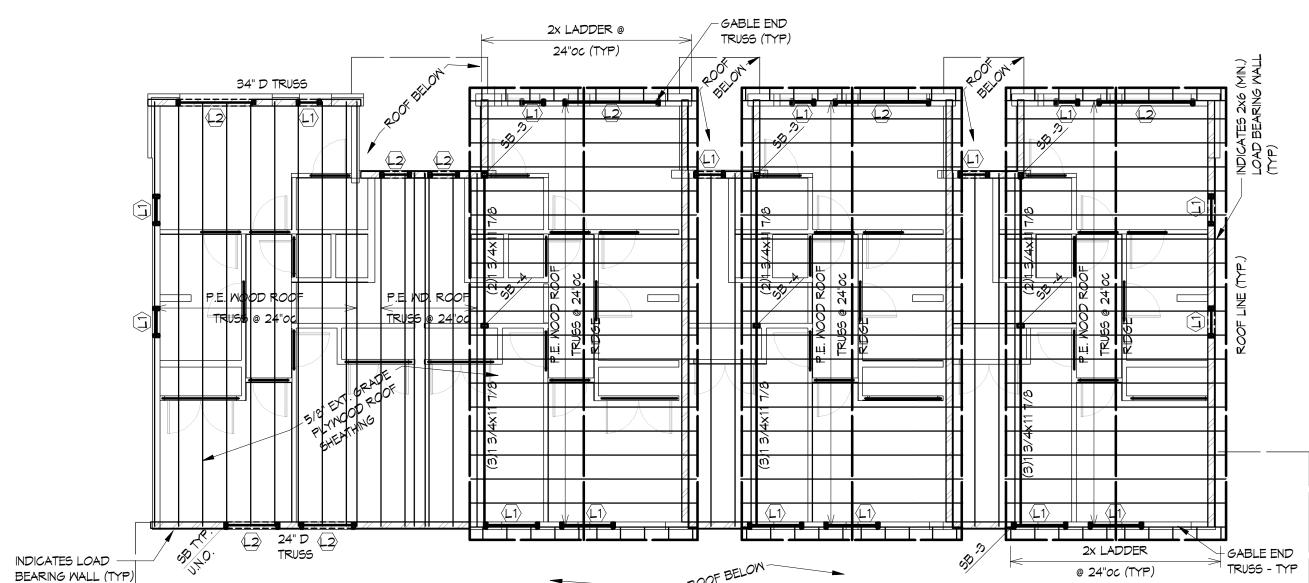

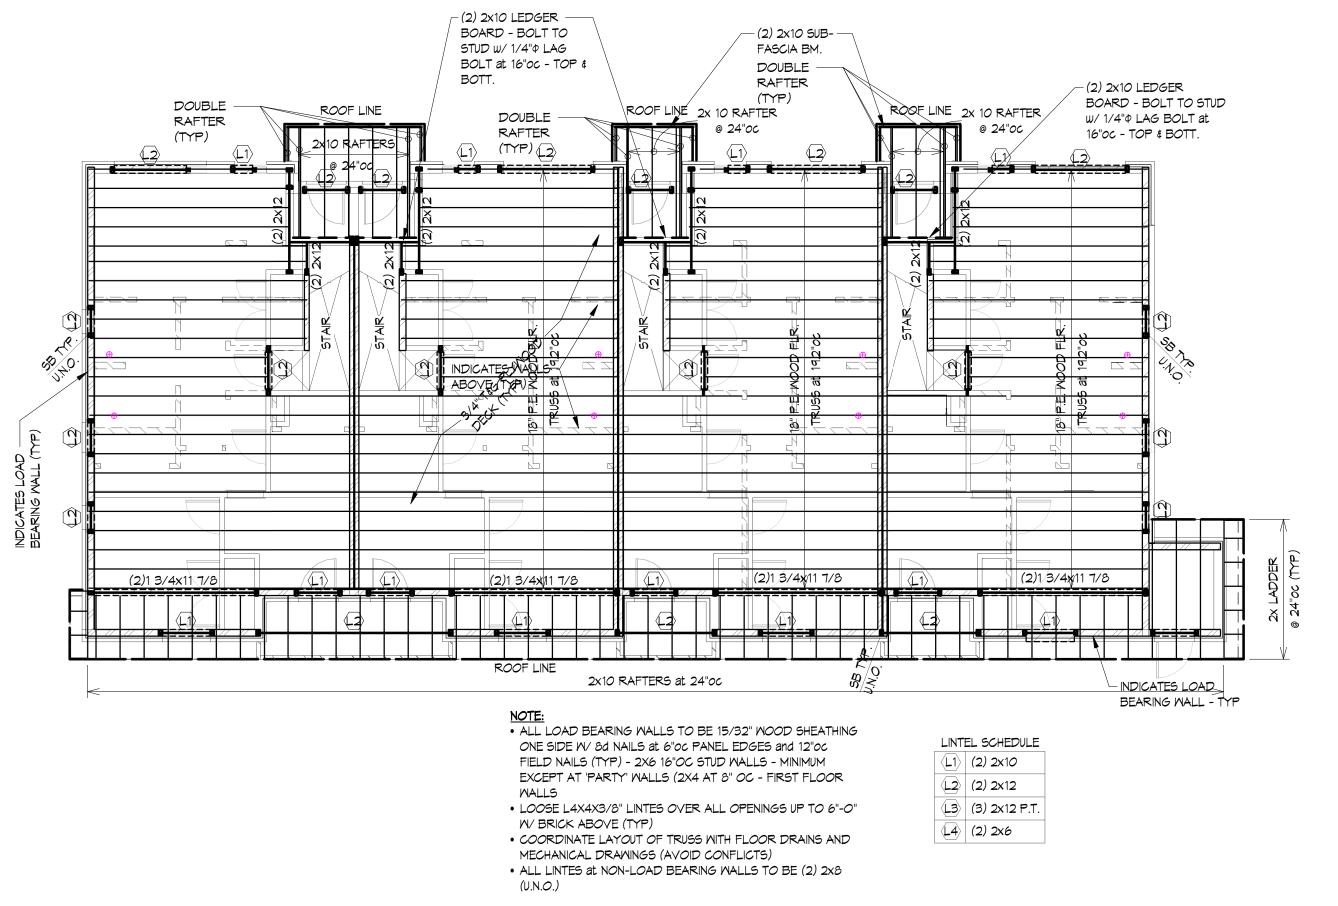

2 B3 - 2ND FLOOR FRAMING PLAN

REVISION 2 = • REVISED FOUNDATION/FRAMING BASED ON REVISED GRADING PLAN. MINOR REVISIONS TO UNIT FRAMING PLANS FOR ADA COMPLIANCE

> PARTNERS 502 Union Avenue Knoxville, TN 37902 **United States** Tel 865.524.777

Tel 865.671.9060

Tel 312.456.0123 Fax 312.456.0124

KCDC

Corporation

901 N Boardway

Knoxville, TN 37917

Tel: 865-403-1100

2240 Sutherland Avenue

Gensler

Suite 105 Knoxville, TN 37919

11 East Madison Street

Suite 300 Chicago, IL 60602 United States


United States

Knoxville Community Development

 ∆ Date Description 2 5.22.2020 Revision 2



Seal / Signature

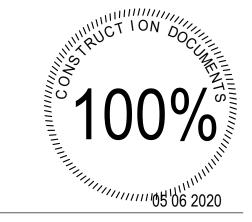


Project Name **AUSTIN HOMES - PHASE 1A**


Project Number


193076

BLDG 3 STRUCTURAL PLAN

As indicated

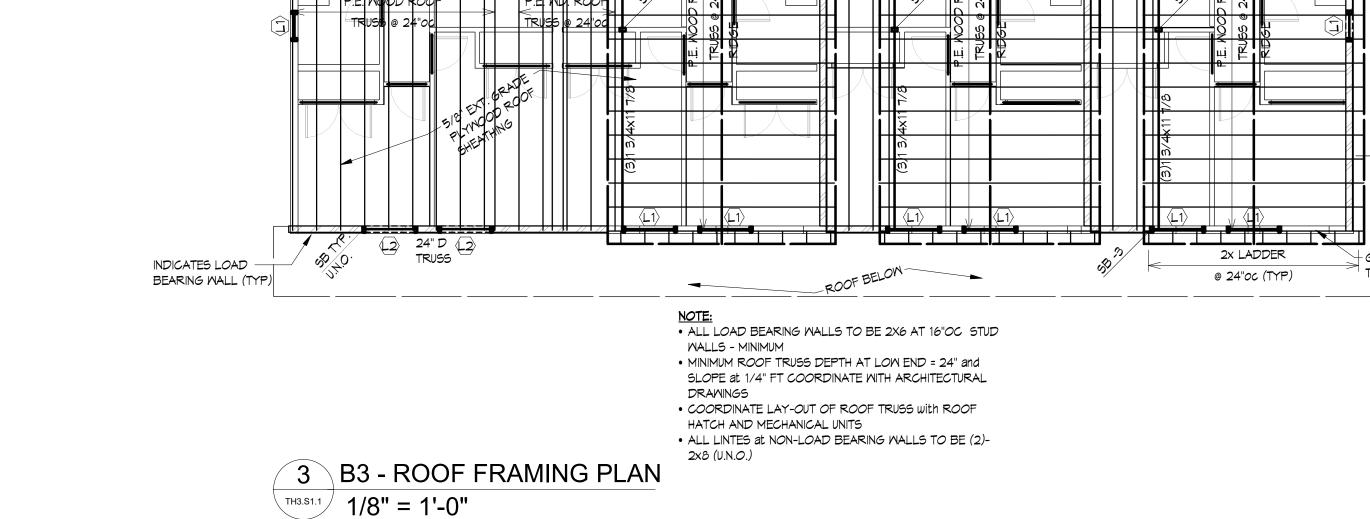

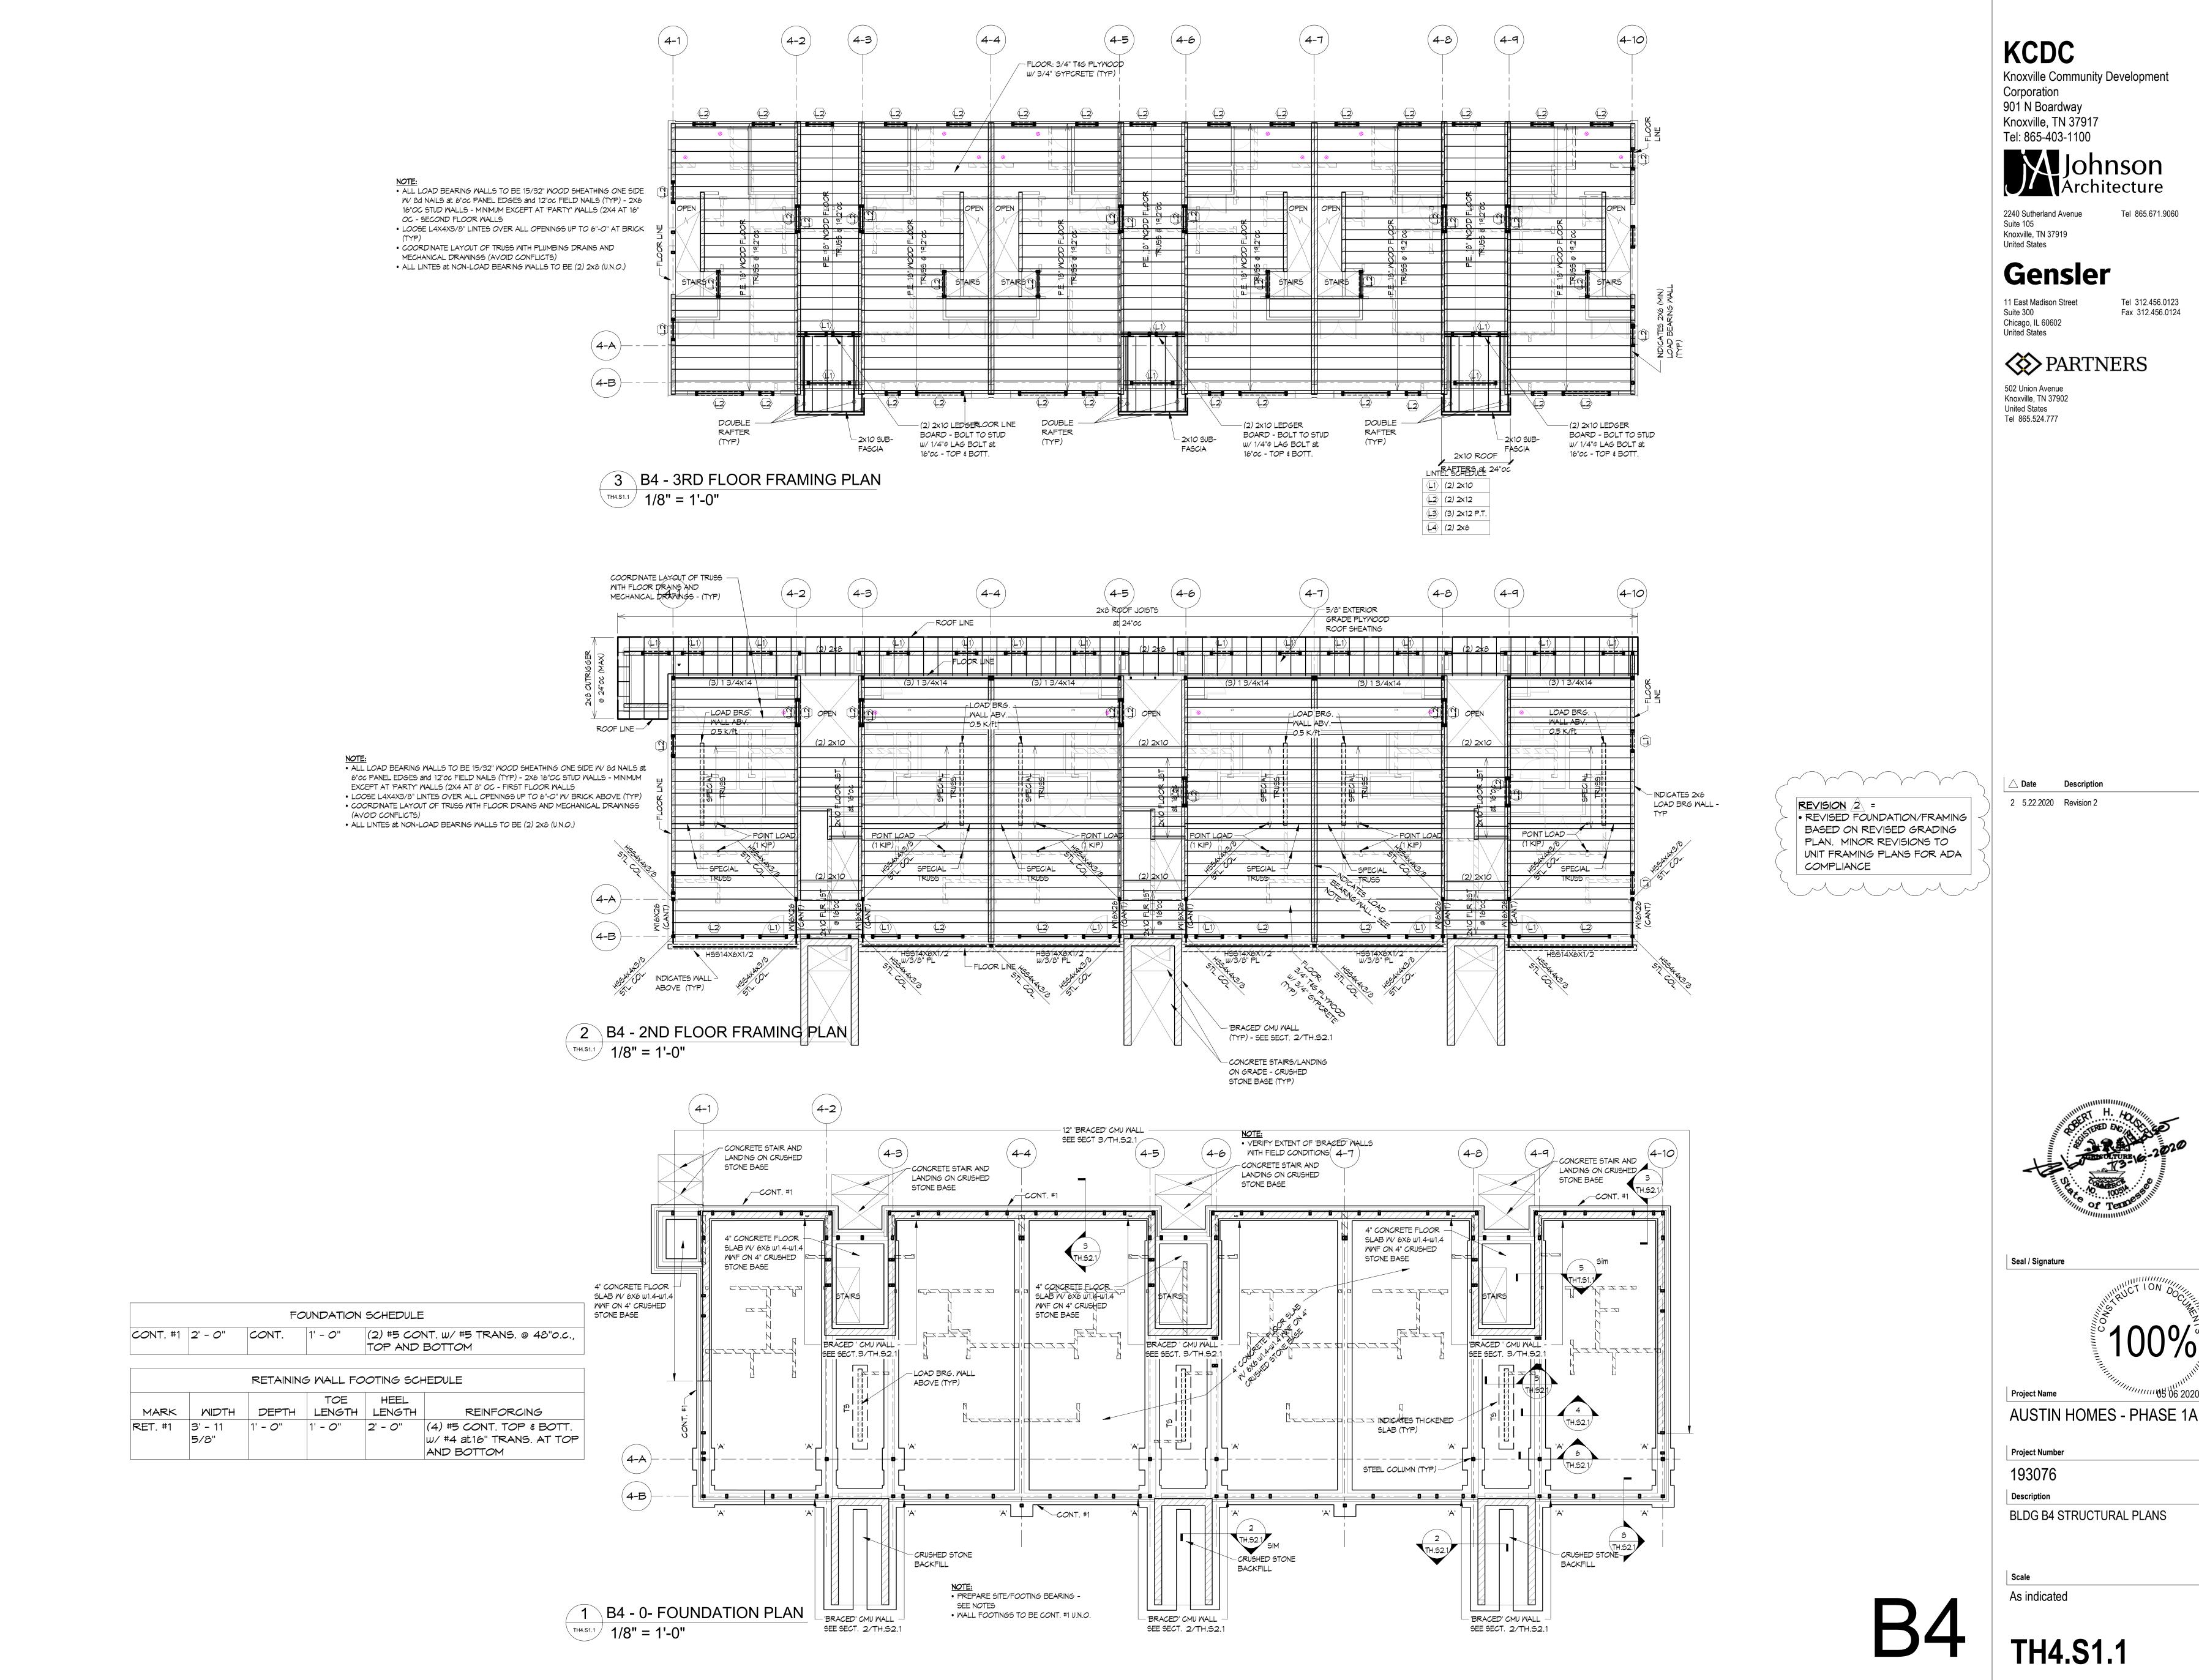

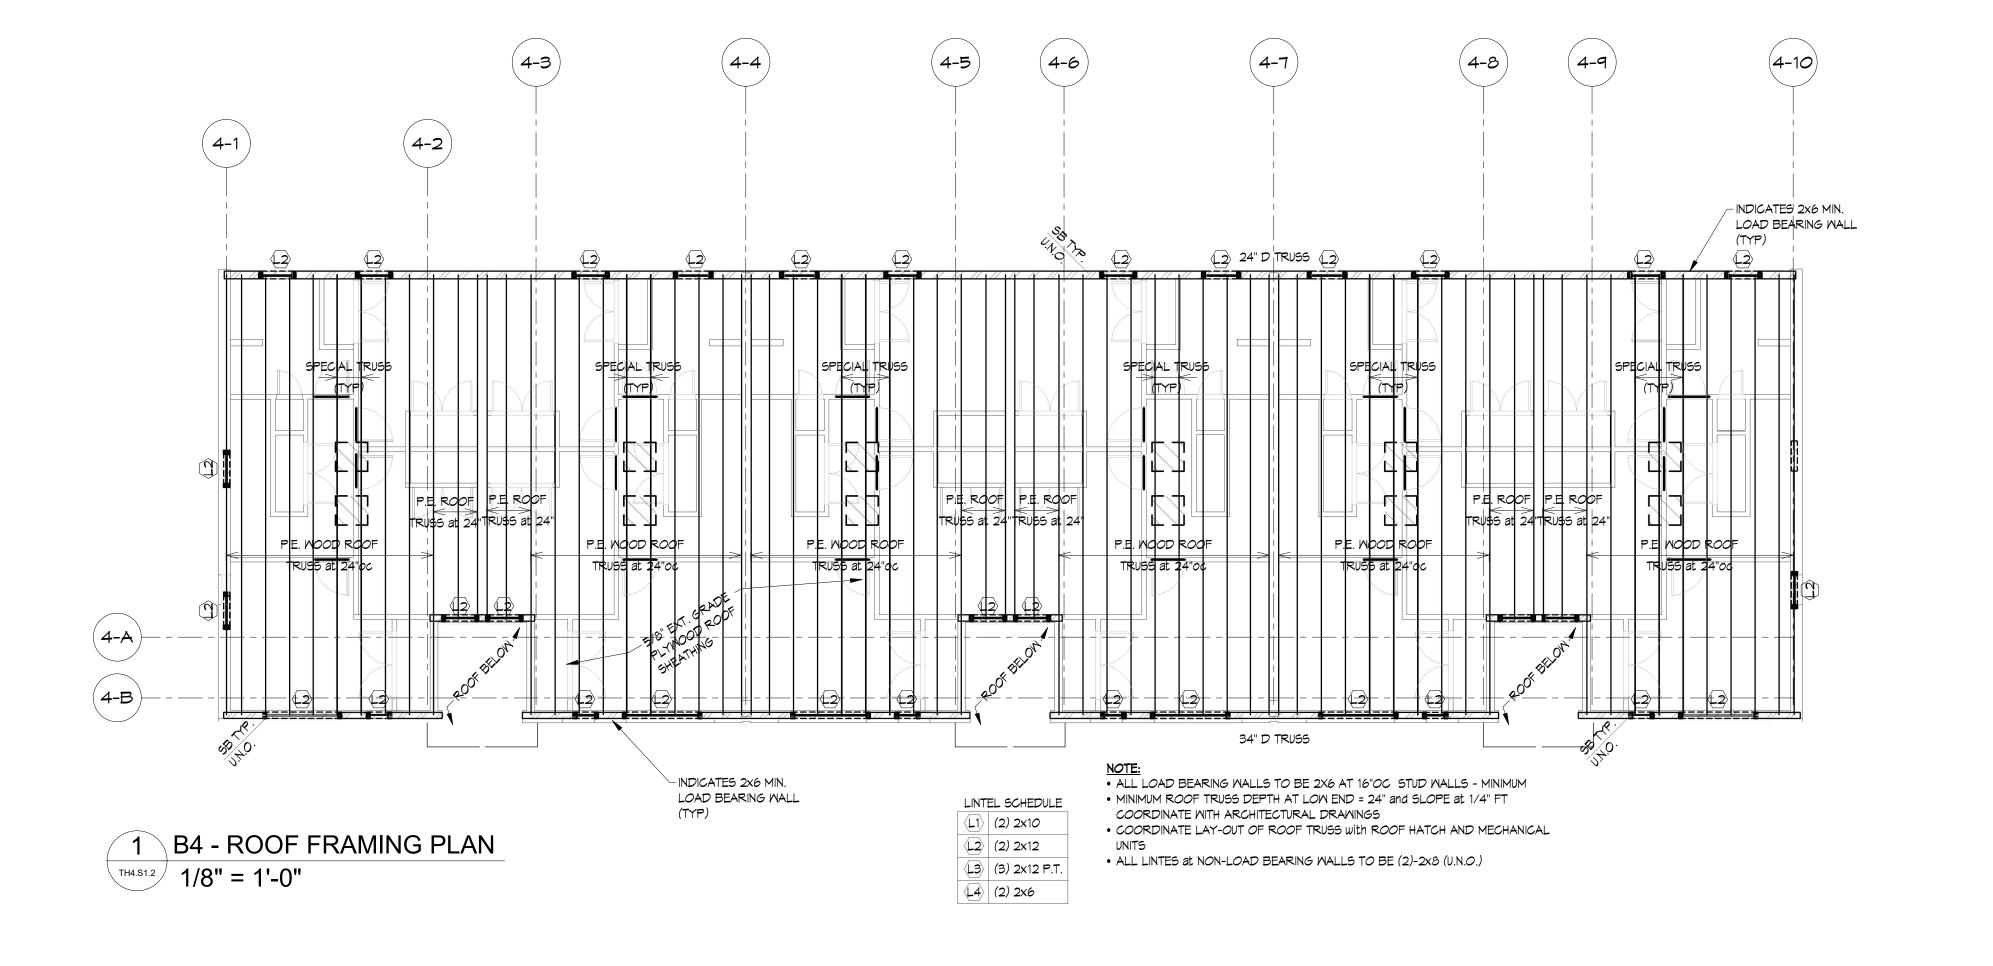

KCDC

Knoxville Community Development Corporation 901 N Boardway Knoxville, TN 37917



2240 Sutherland Avenue Suite 105 Knoxville, TN 37919 United States Tel 865.671.9060

Gensler

11 East Madison Street Suite 300 Chicago, IL 60602 United States




Tel 312.456.0123 Fax 312.456.0124

502 Union Avenue Knoxville, TN 37902 United States Tel 865.524.777

∑ Date Description 2 5.22.2020 Revision 2 REVISION 2 =

• REVISED FOUNDATION/FRAMING
BASED ON REVISED GRADING
PLAN. MINOR REVISIONS TO
UNIT FRAMING PLANS FOR ADA

COMPLIANCE

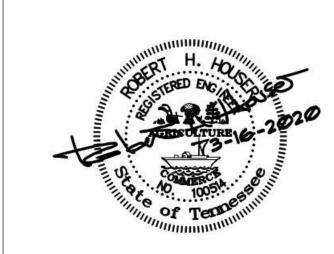

Seal / Signature

小ゆり06 2020

AUSTIN HOMES - PHASE 1A


Project Number

Project Name

193076

BLDG B4 STRUCTURAL PLANS

As indicated

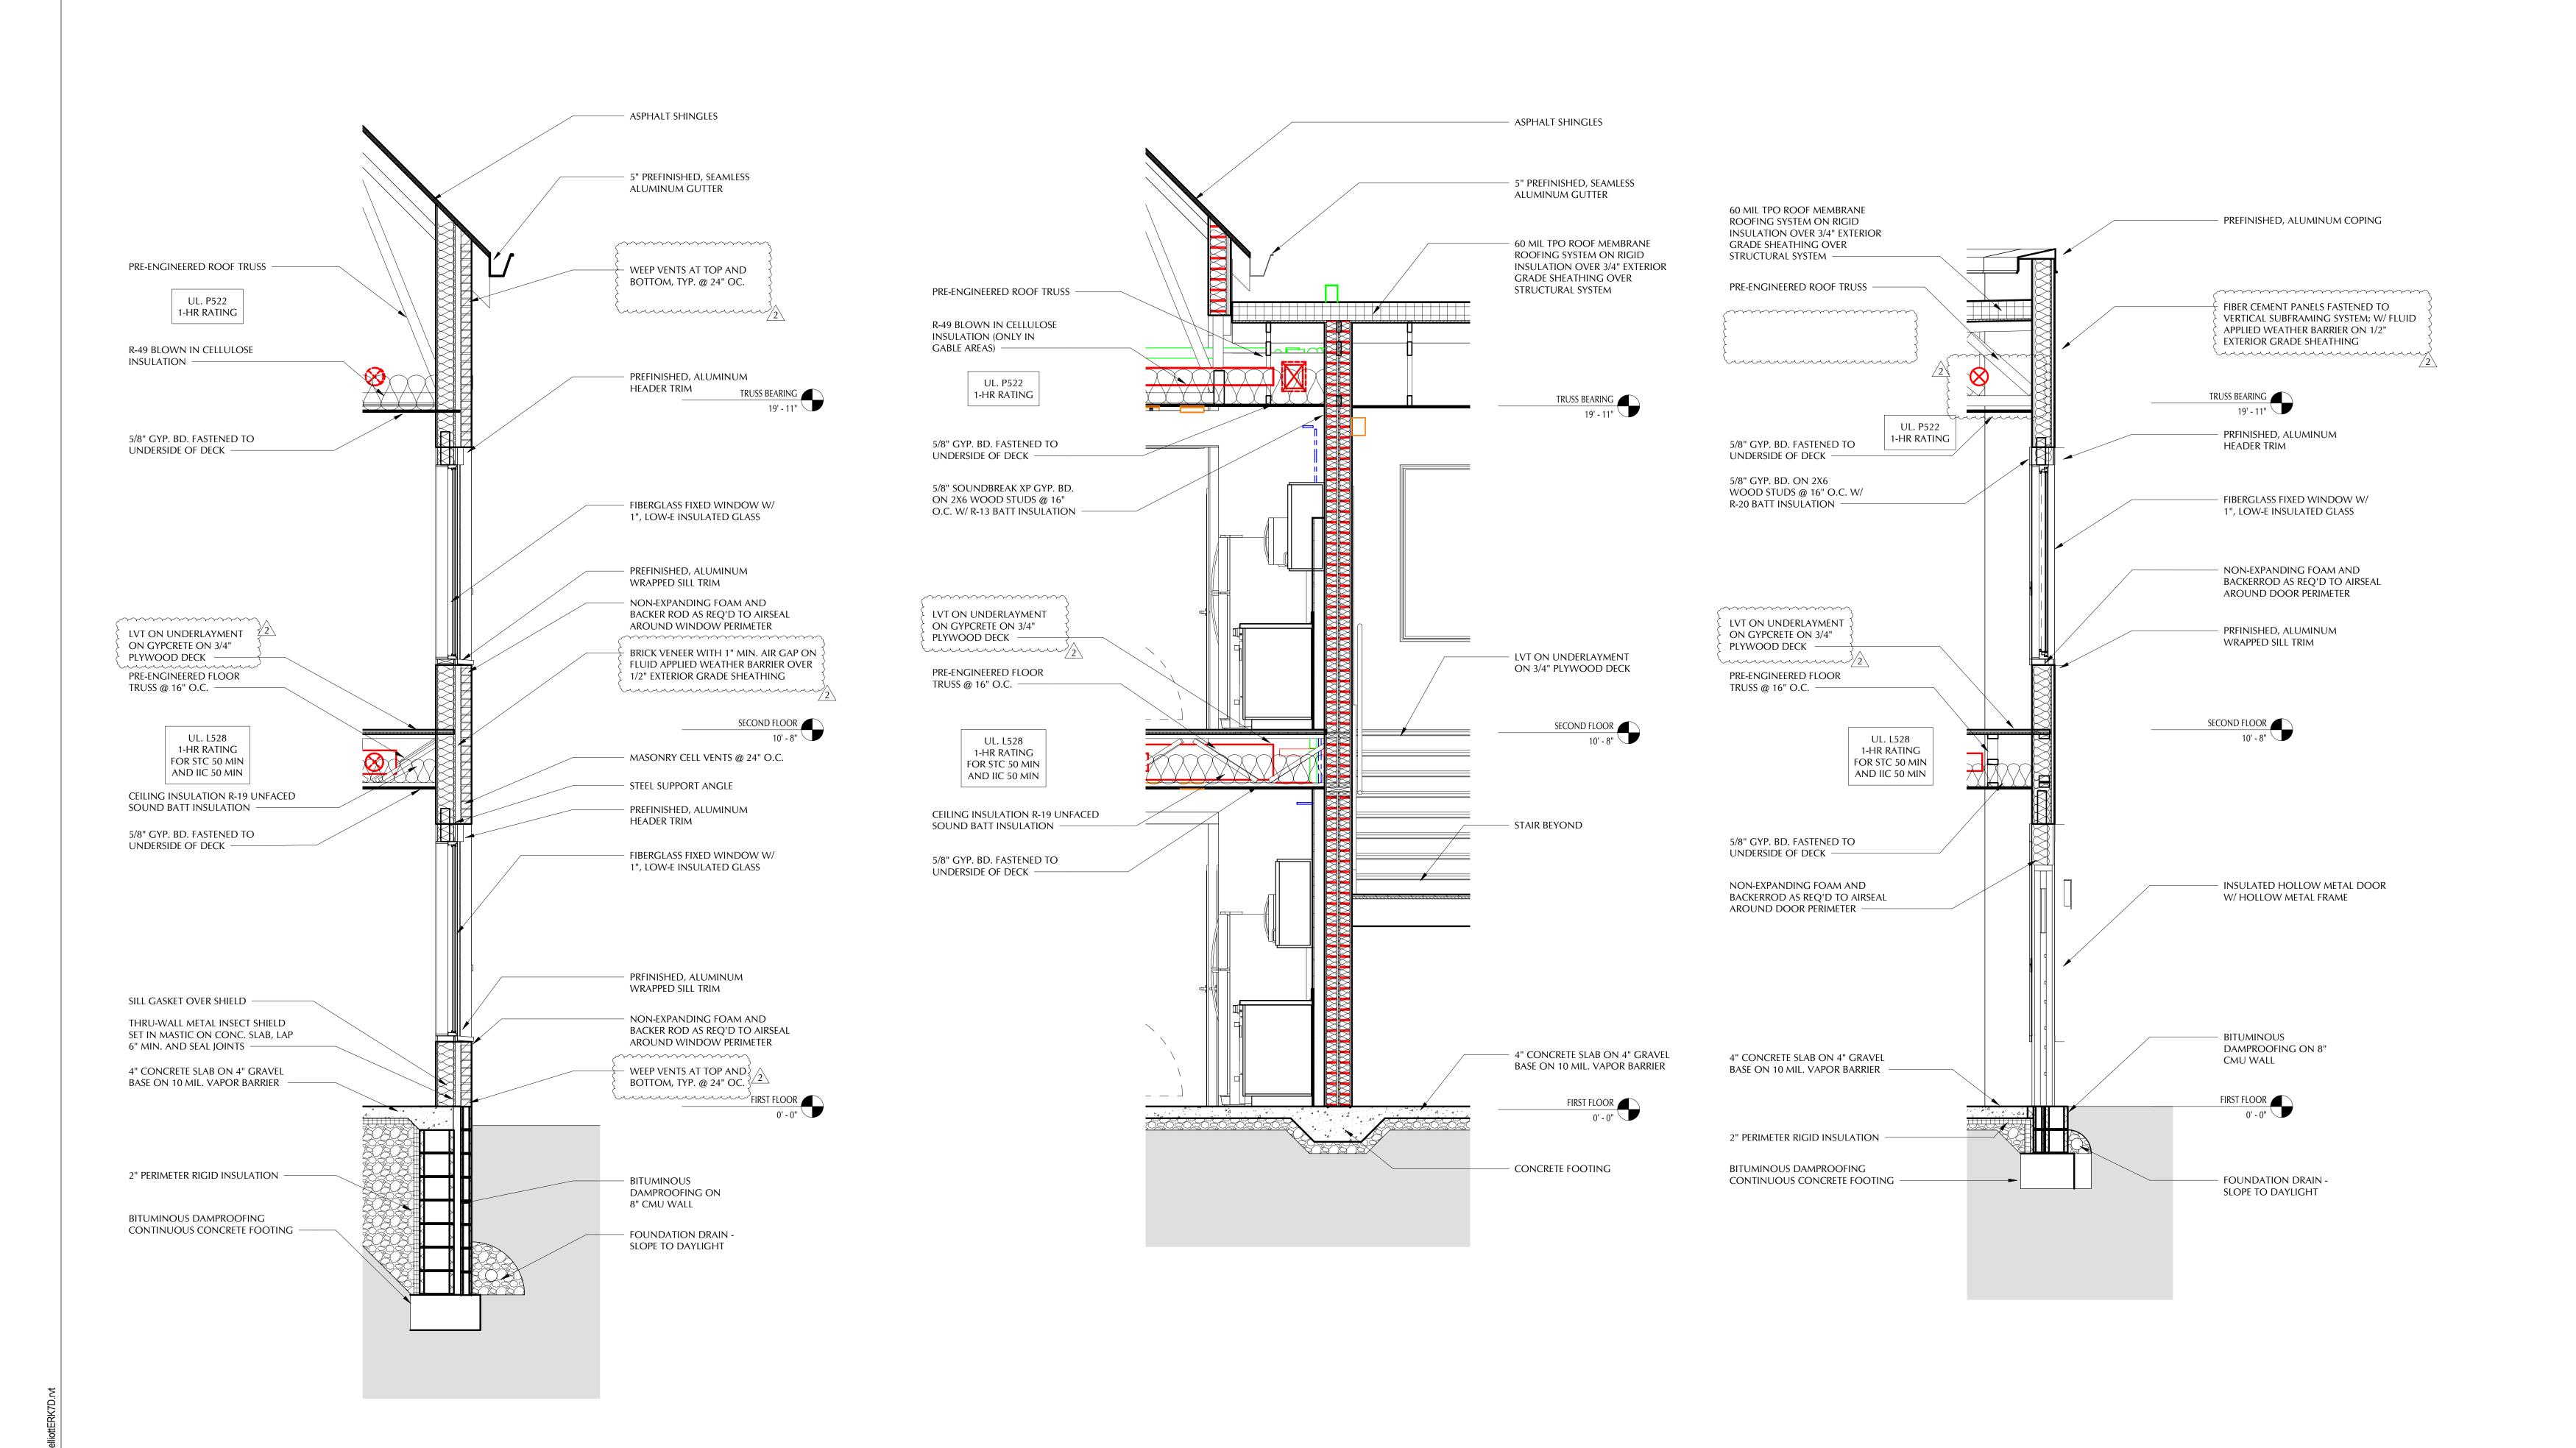

BUILDING 5 - WALL SECTION 2 1/2" = 1'-0"

1 BUILDING 5 - WALL SECTION 1 1/2'' = 1'-0''

Suite 105 Knoxville, TN 37919 **United States** 11 East Madison Street Tel 312.456.0123 Suite 300 Fax 312.456.0124 Chicago, IL 60602 United States ∆ Date Description 1 5/06/20 PLANS REVIEW COMMENTS 2 5/26/20 ADDENDUM 1 Seal / Signature **AUSTIN HOMES - PHASE 1A** Project Number 05/06/2020 193076 BUILDING 5 - WALL SECTIONS 1/2" = 1'-0"

3 BUILDING 5 - WALL SECTION 3 1/2" = 1'-0"

© 2015 Gensler

AUSTIN HOMES REDEVELOPMENT PHASE 1A BURGE DRIVE AND HARRIET TUBMAN ST.


Tel 865.671.9060 2240 Sutherland Avenue


KNOXVILLE'S COMMUNITY

DEVELOPMENT CORPORATION

KCDC

TH5.A4.2

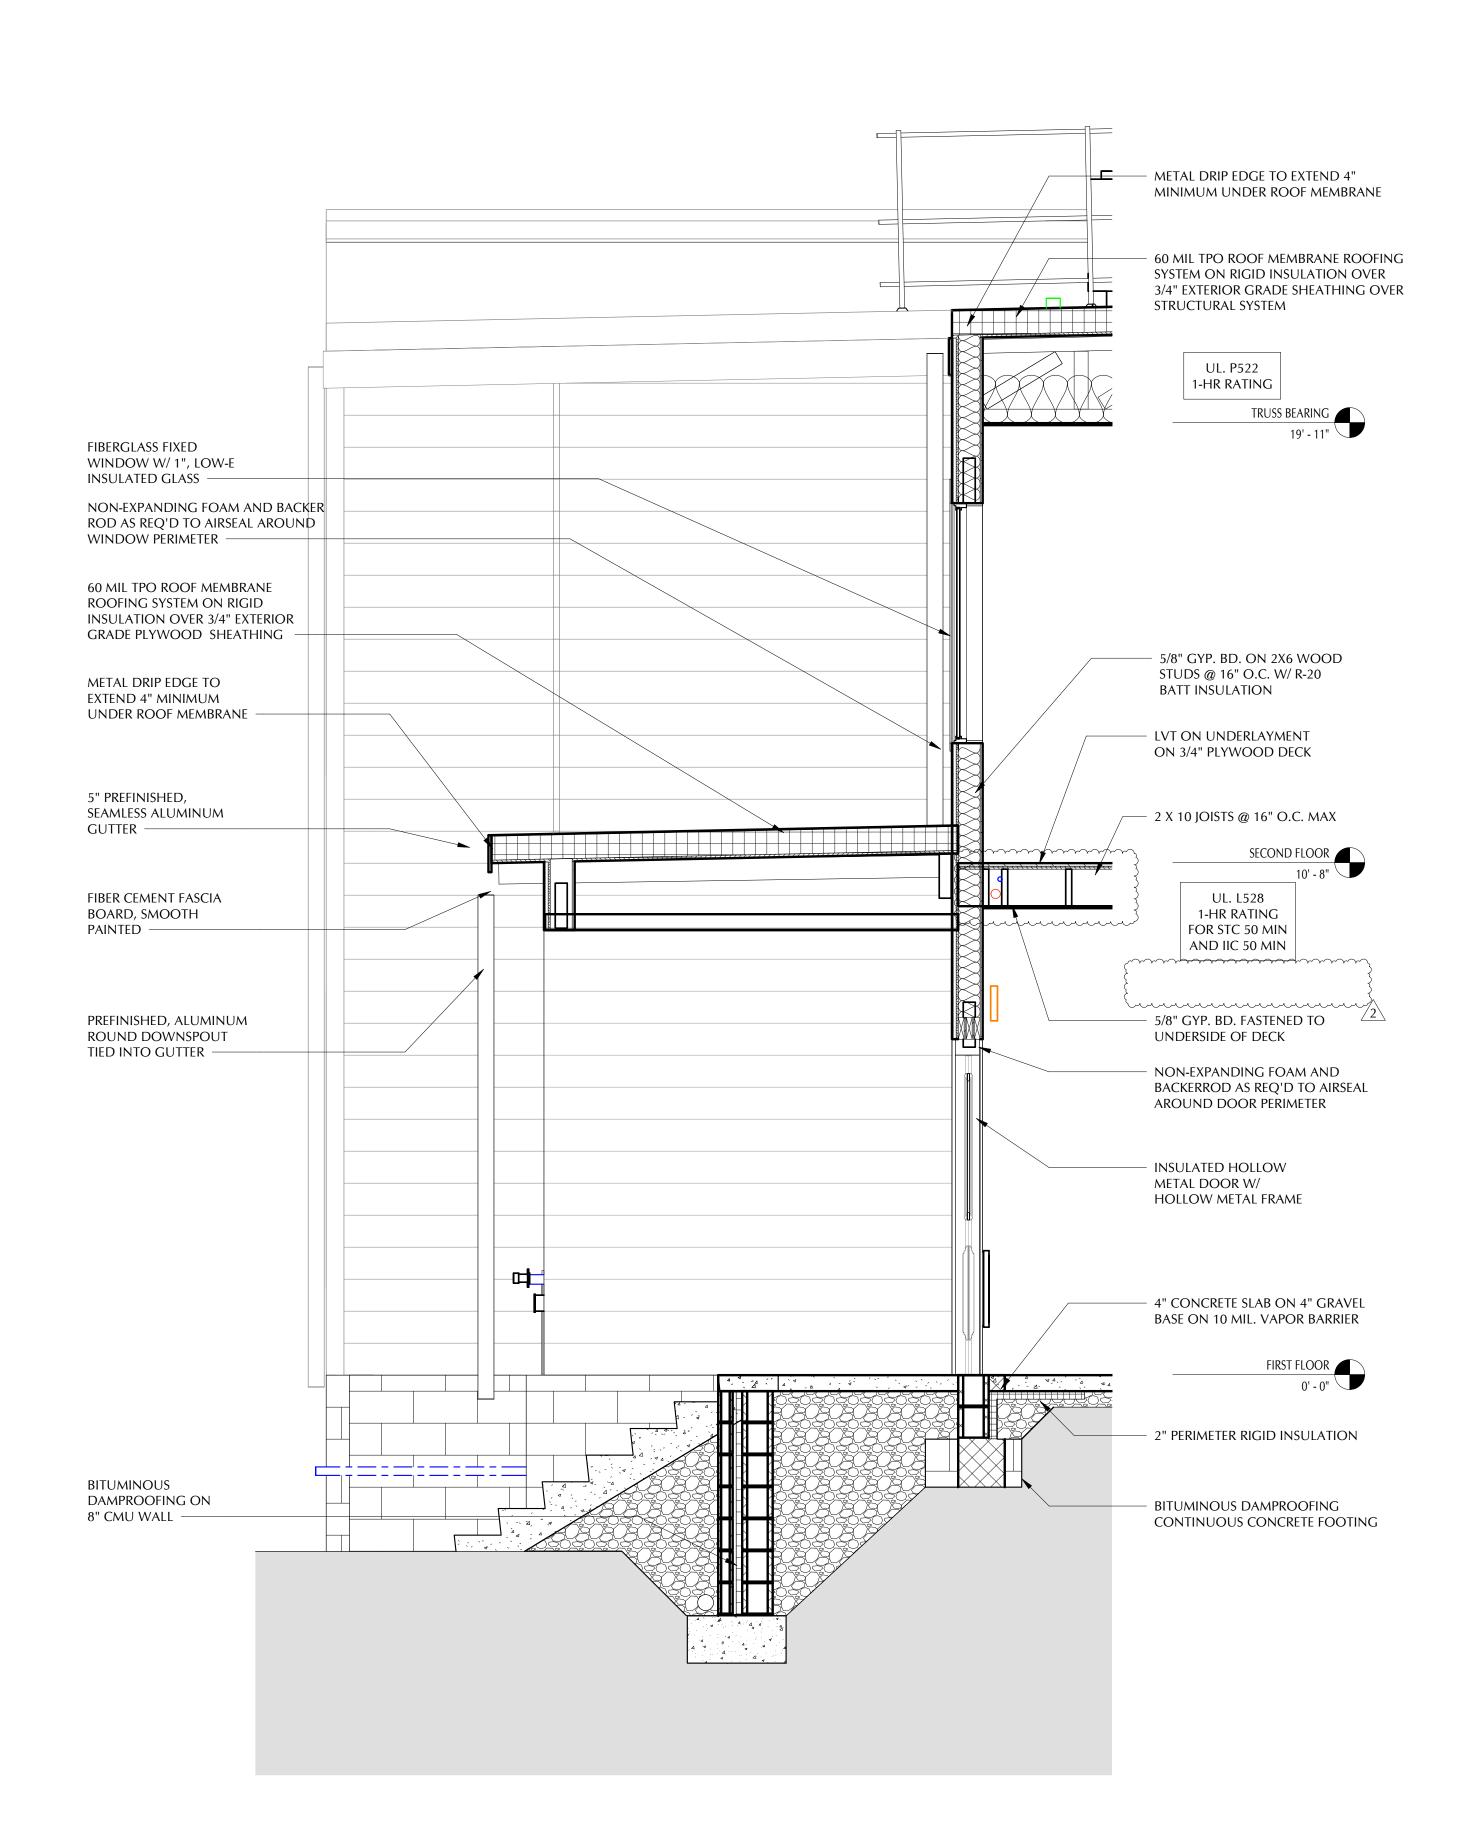

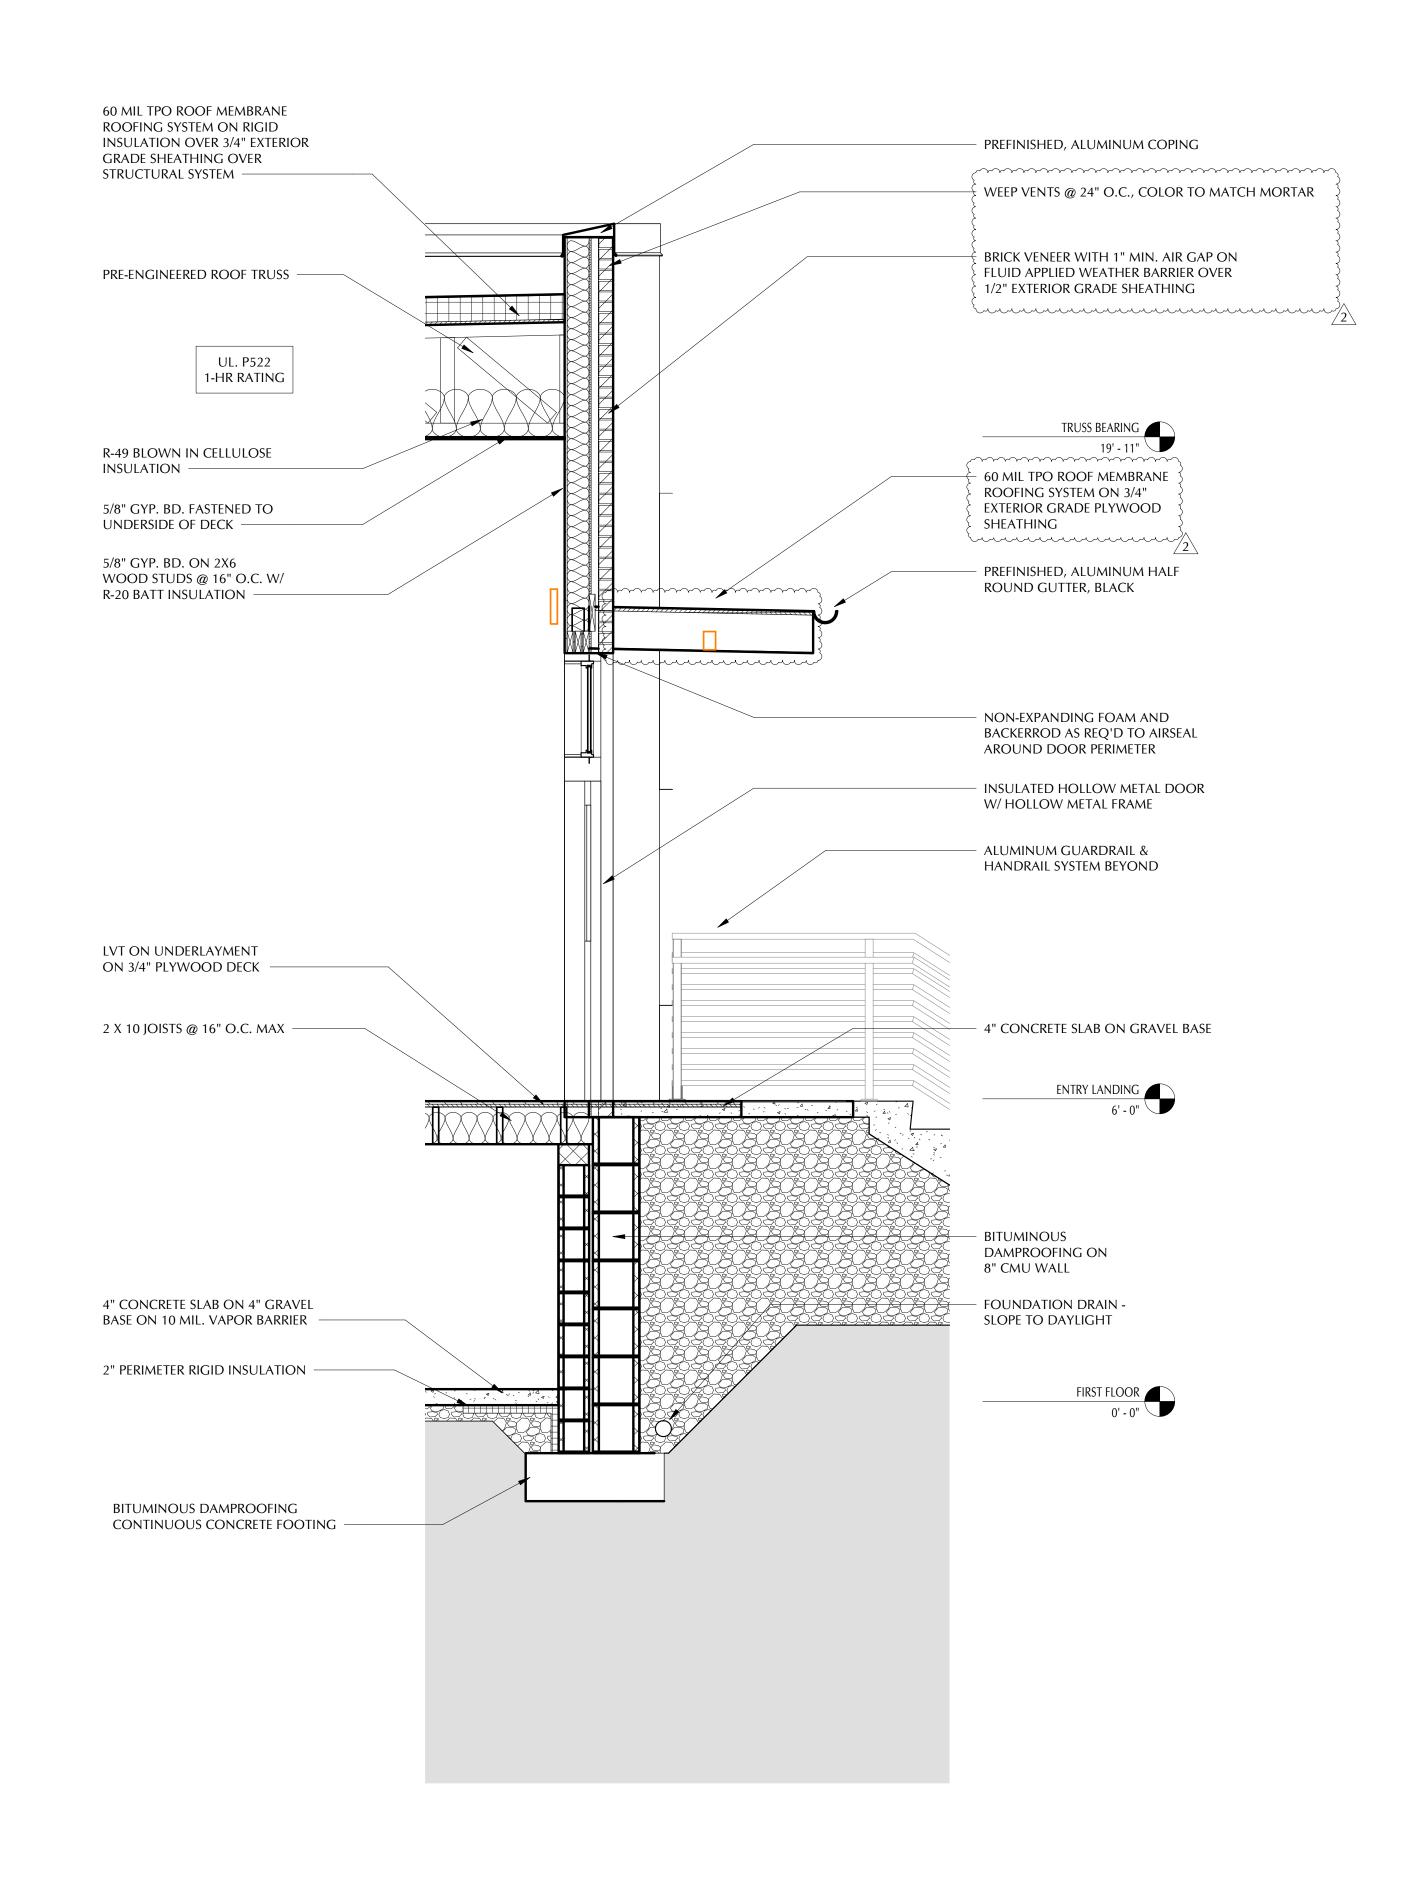

BUILDING 5 - WALL SECTION 4 1/2" = 1'-0"

BUILDING 5 - WALL SECTION 5 1/2" = 1'-0"

KCDC KNOXVILLE'S COMMUNITY **DEVELOPMENT CORPORATION**

AUSTIN HOMES REDEVELOPMENT PHASE 1A BURGE DRIVE AND HARRIET TUBMAN ST.



2240 Sutherland Avenue Tel 865.671.9060 Suite 105 Knoxville, TN 37919 United States

11 East Madison Street Suite 300 Chicago, IL 60602 United States

Tel 312.456.0123 Fax 312.456.0124

1 5/06/20 PLANS REVIEW COMMENTS 2 5/26/20 ADDENDUM 1



Seal / Signature


AUSTIN HOMES - PHASE 1A

05/06/2020


Project Number 193076

BUILDING 5 - WALL SECTIONS

1/2" = 1'-0"

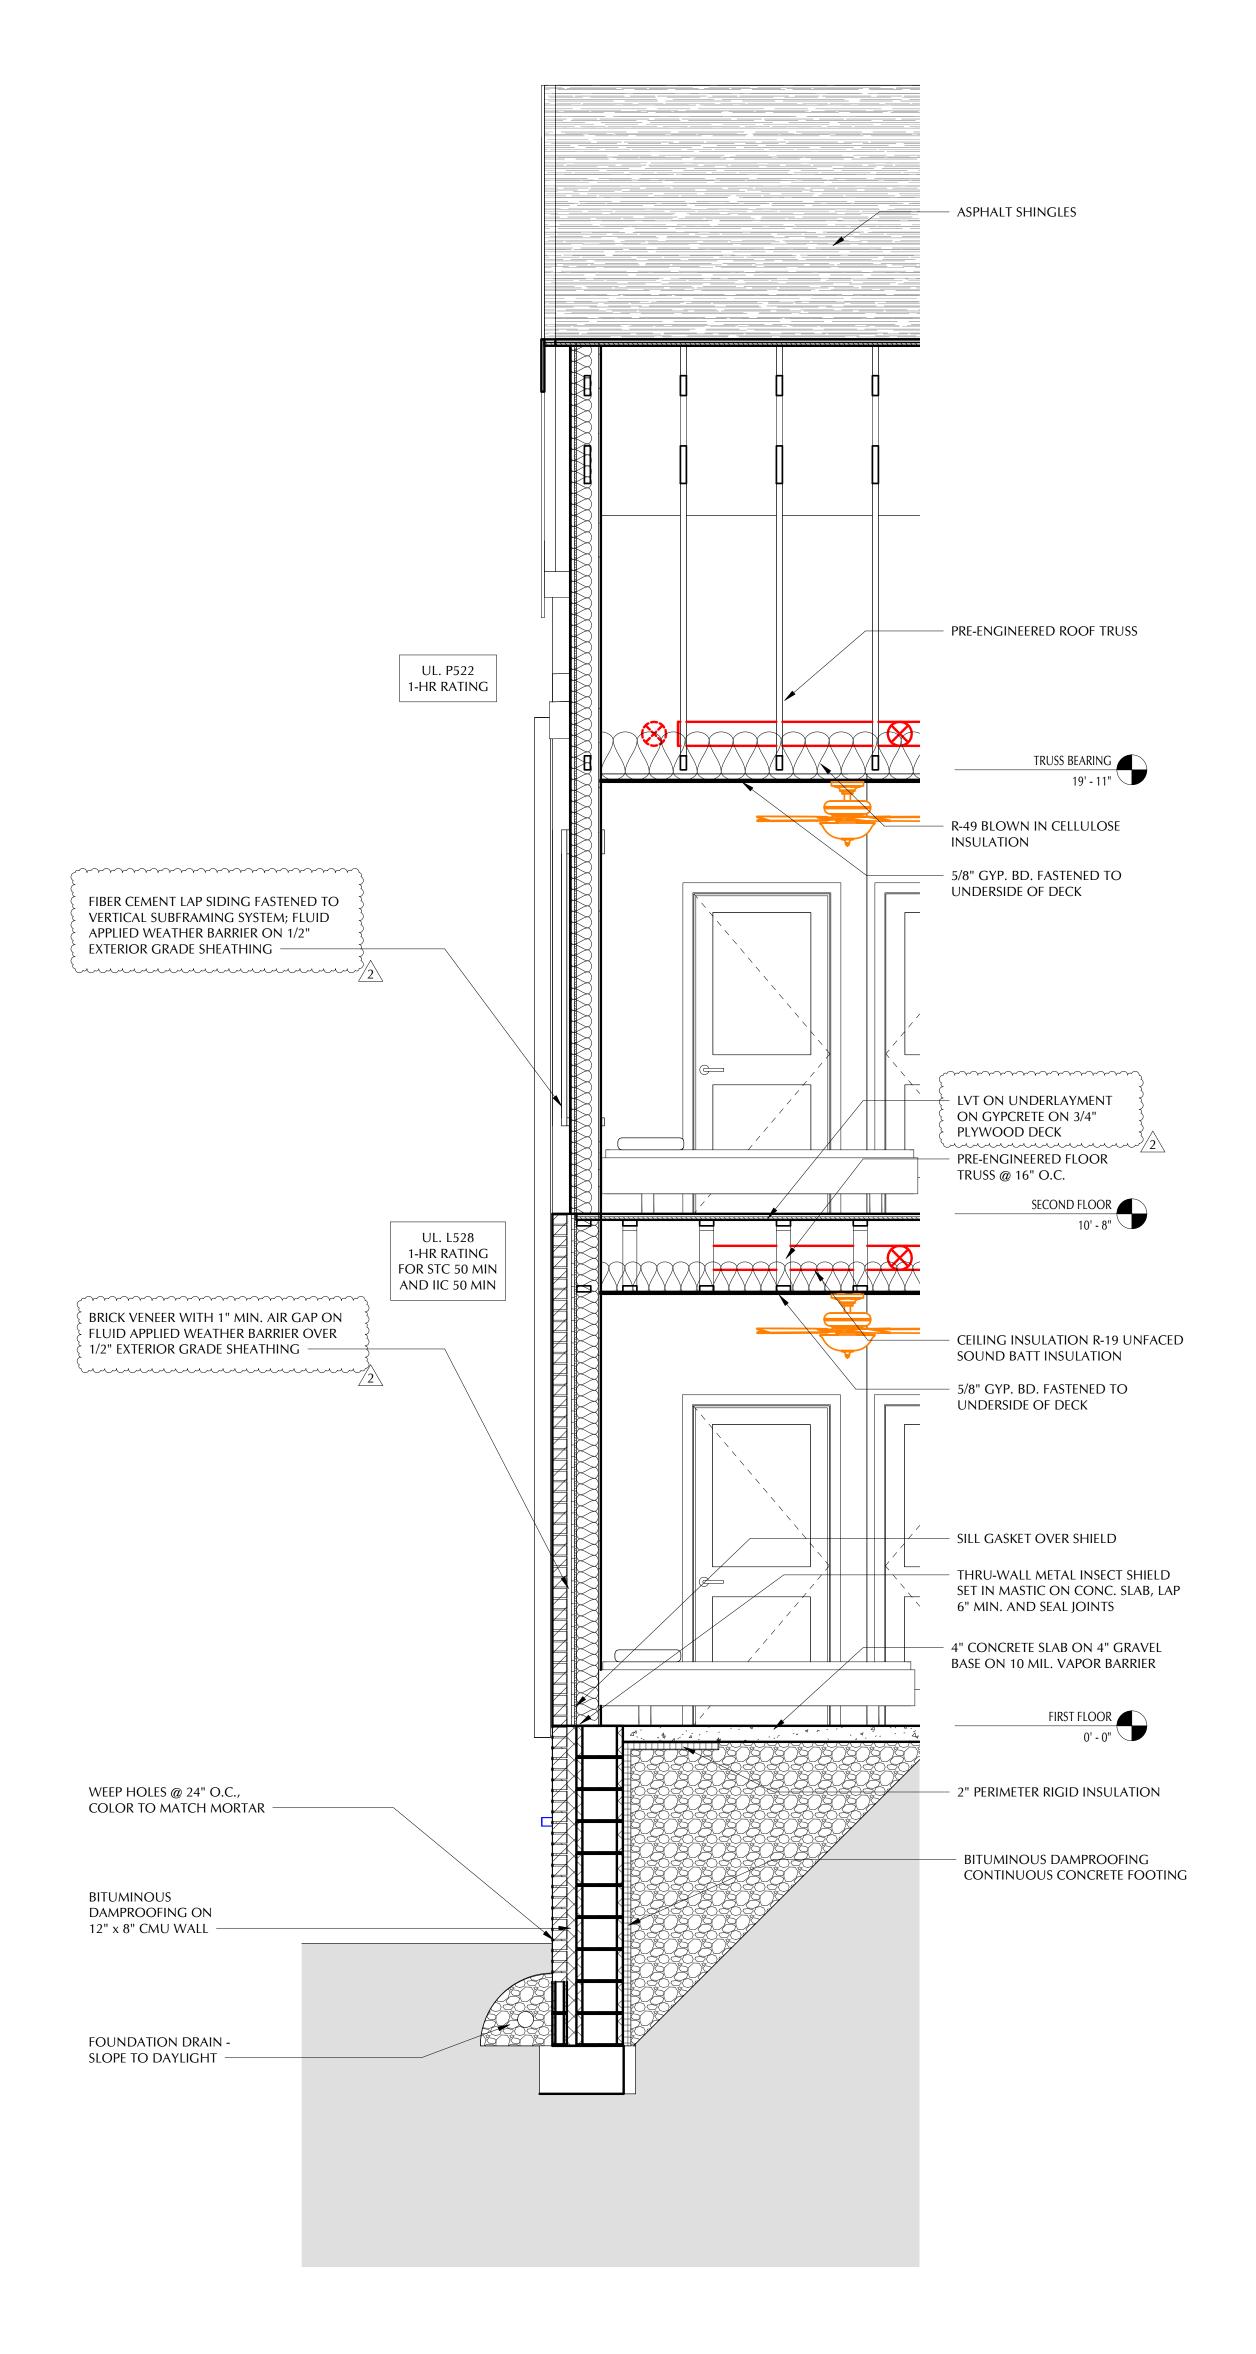

BUILDING 5 - WALL SECTION 6 1/2" = 1'-0"

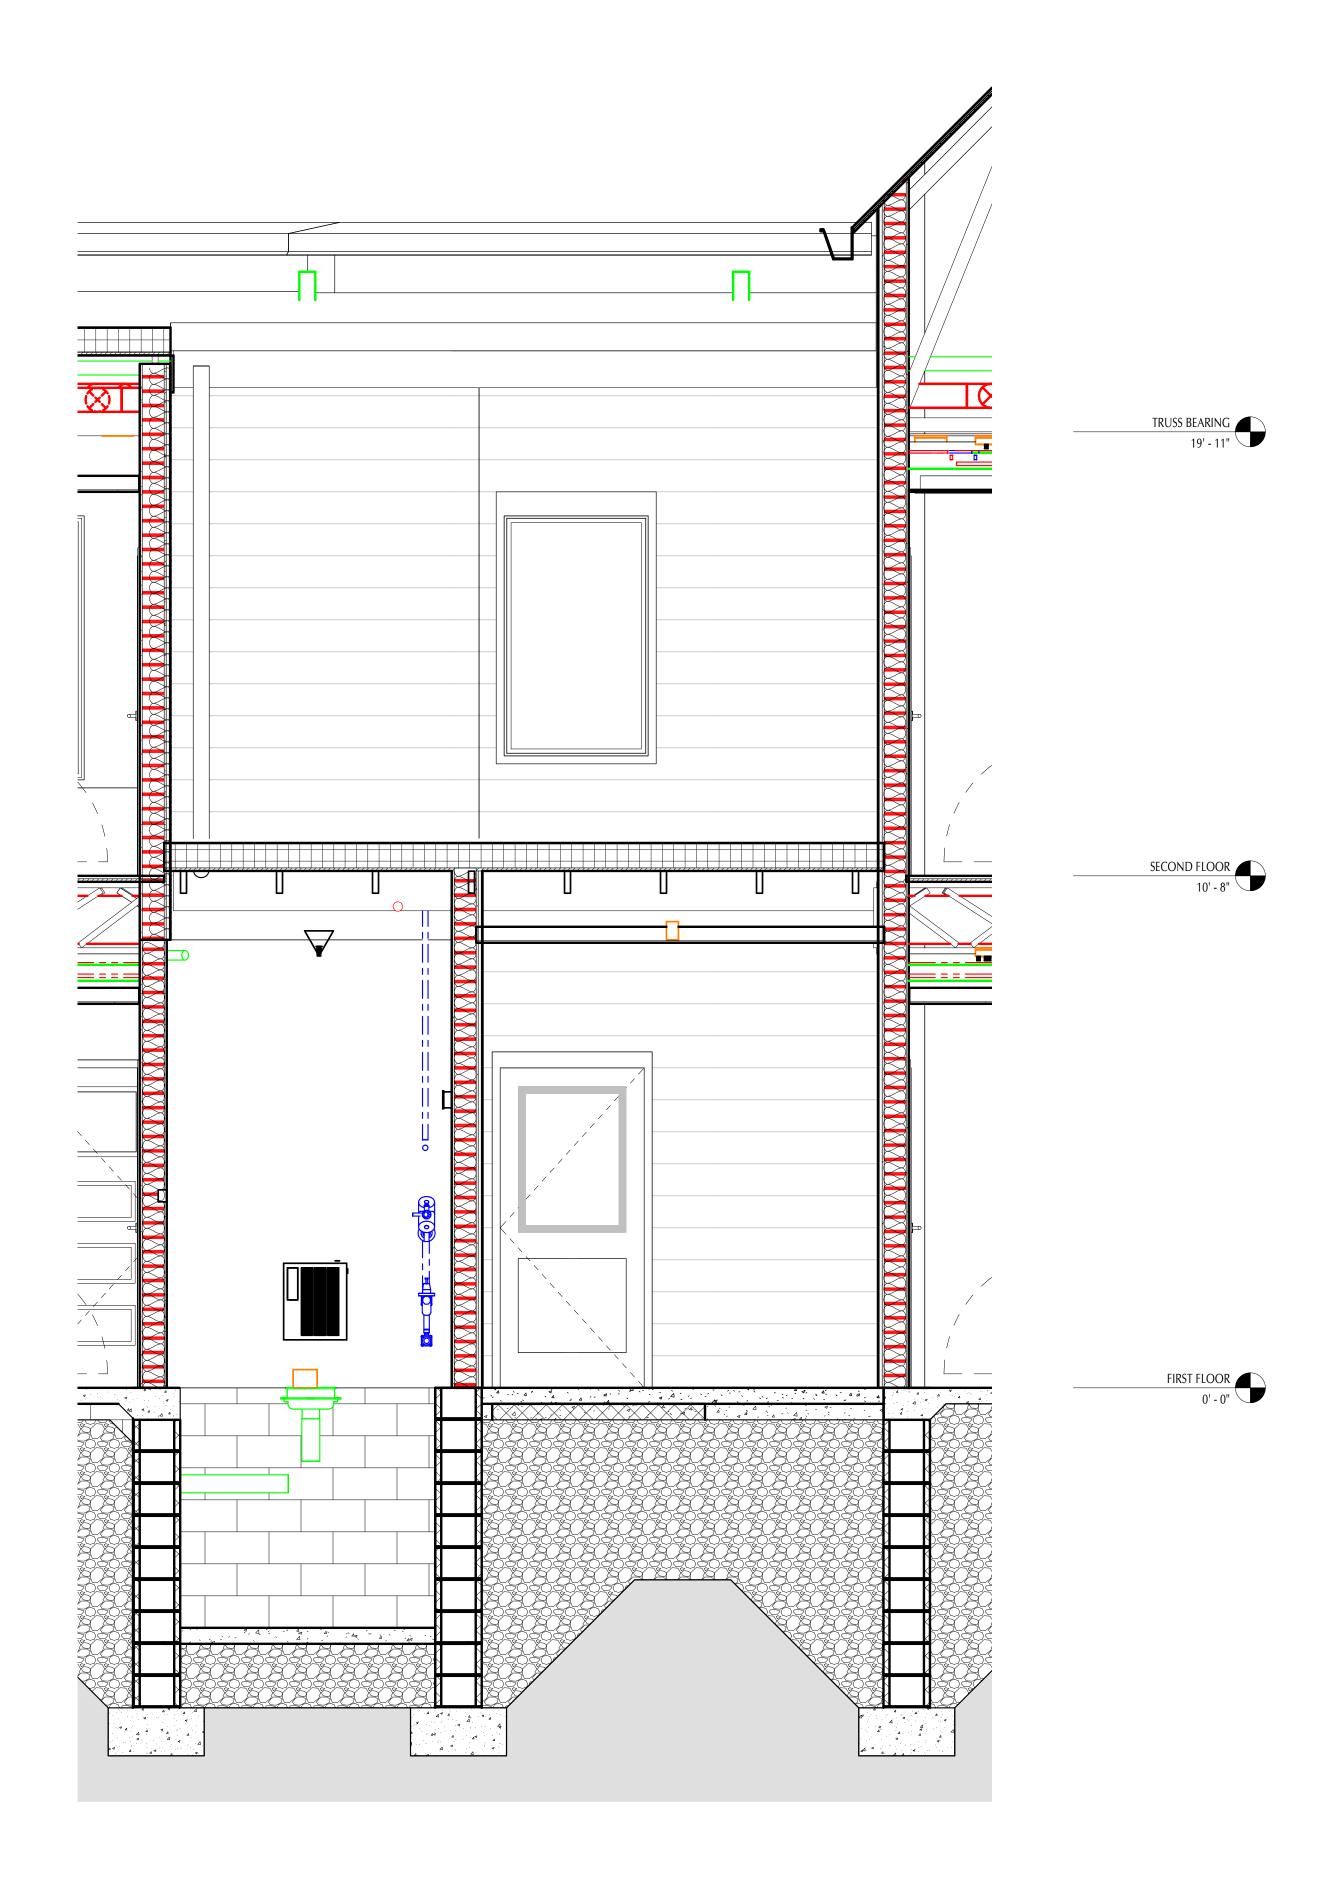

BUILDING 5 - WALL SECTION 7 1/2" = 1'-0"

KCDC
KNOXVILLE'S COMMUNITY

AUSTIN HOMES REDEVELOPMENT
PHASE 1A
BURGE DRIVE AND HARRIET TUBMAN ST.

DEVELOPMENT CORPORATION



2240 Sutherland Avenue Tel 865.671 Suite 105 Knoxville, TN 37919 United States

Gensler

11 East Madison Street Tel 312.456.0123
Suite 300 Fax 312.456.0124
Chicago, IL 60602
United States

2 5/26/20 ADDENDUM 1



Seal / Signature

Project Name

AUSTIN HOMES - PHASE 1A

05/06/2020

Project Number


BUILDING 5 - WALL SECTIONS

Scale 1/2" = 1'-0"


<u>_____</u>


TH5.A4.4

B5

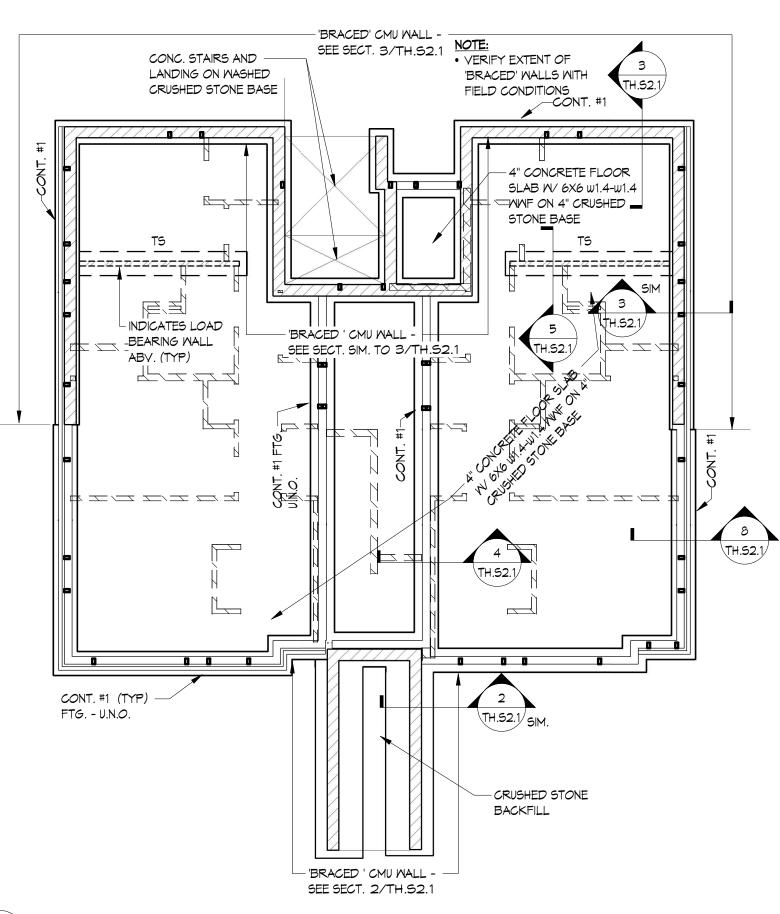


RETAINING WALL FOOTING SCHEDULE										
MARK	MIDTH	DEPTH	TOE LENGTH	HEEL LENGTH	REINFORCING					
RET. #1	3' - 11 5/8"	1' - 0"	1' - 0"	2' - 0"	(4) #5 CONT. TOP & BOTT. w/ #4 at16" TRANS. AT TOP AND BOTTOM					

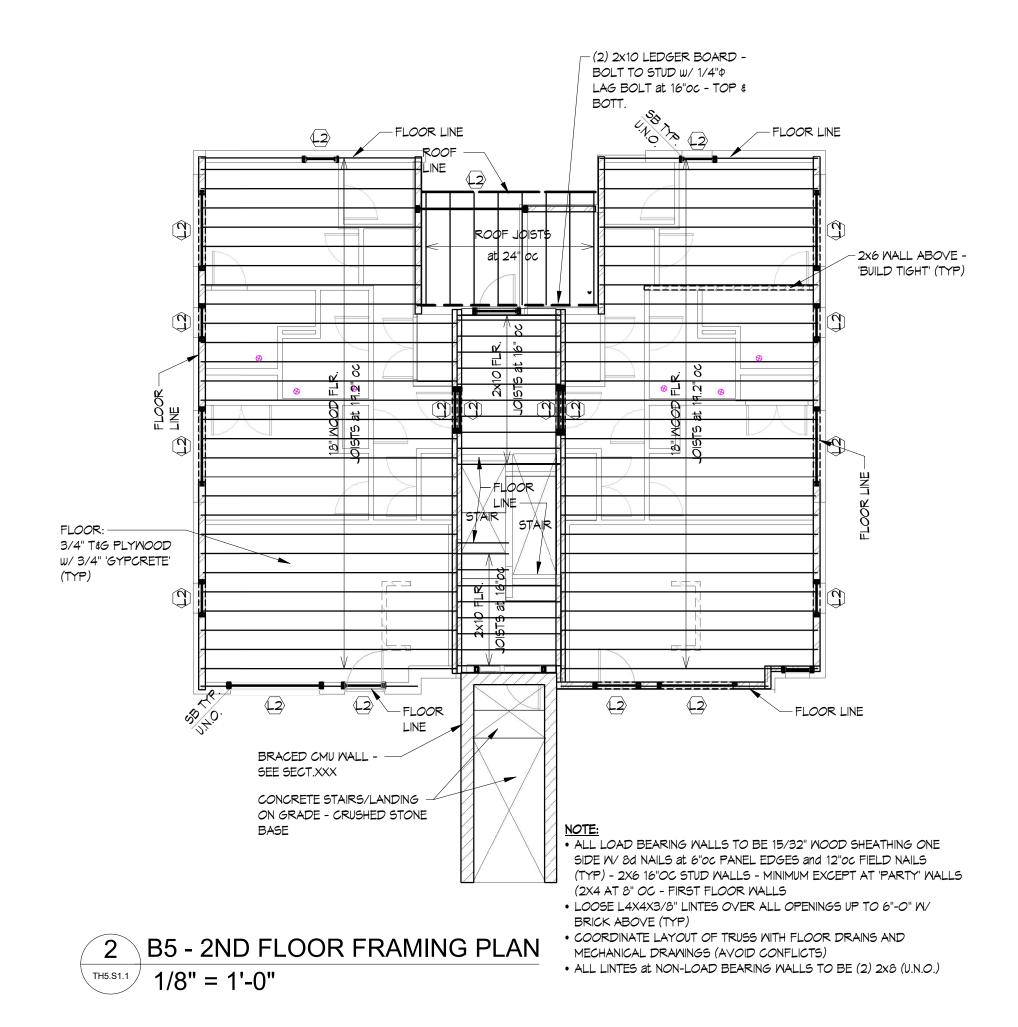

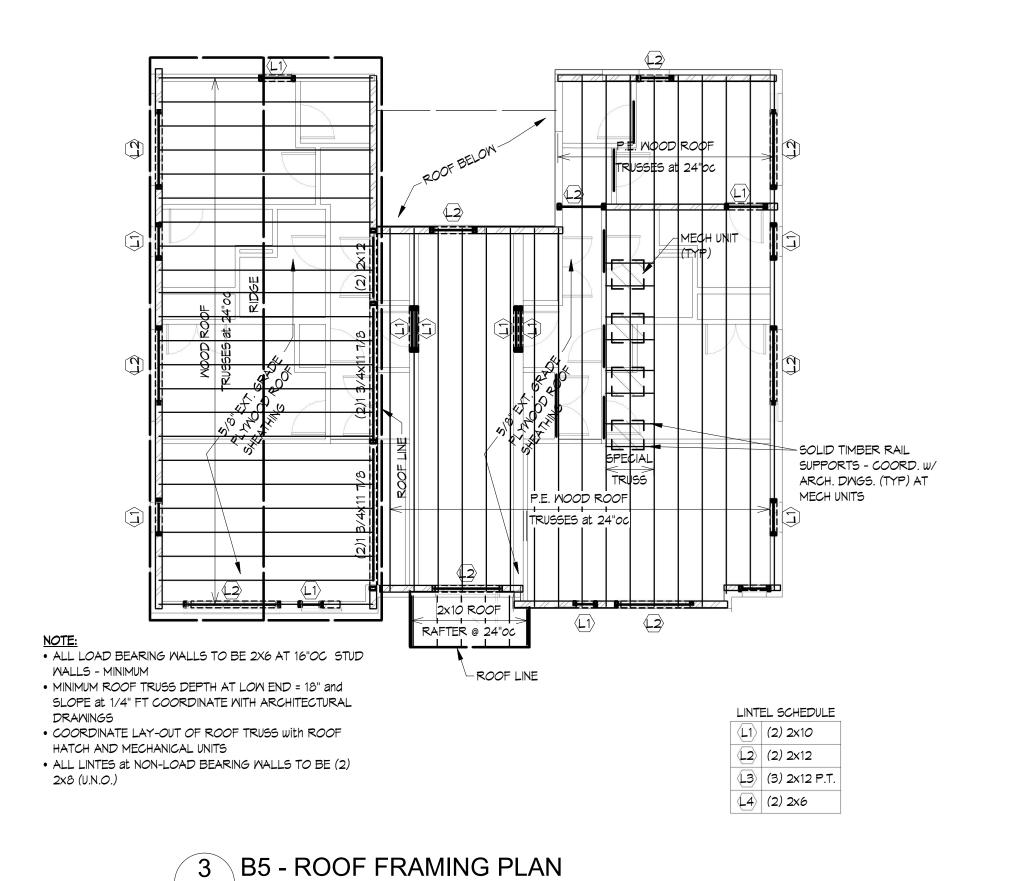

TH5.S1.1 1/8" = 1'-0"

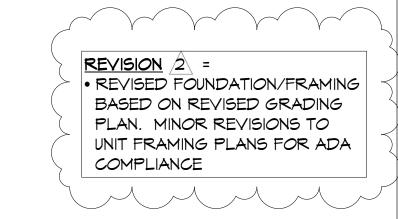

KCDC

Knoxville Community Development Corporation 901 N Boardway Knoxville, TN 37917 Tel: 865-403-1100

2240 Sutherland Avenue Tel 865.671.9060 Suite 105 Knoxville, TN 37919 United States

Tel 312.456.0123 Fax 312.456.0124

Gensler

11 East Madison Street Suite 300 Chicago, IL 60602 United States

> PARTNERS

502 Union Avenue Knoxville, TN 37902 United States Tel 865.524.777

2 5.22.2020 Revision 2

Seal / Signature

小ゆり06 2020


Project Name **AUSTIN HOMES - PHASE 1A**

Project Number

193076

BLDG 5 STRUCTURAL PLANS

As indicated

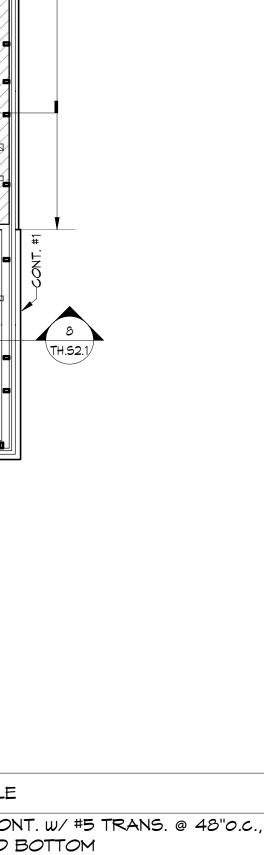

1 B5 - 0-FOUNDATION PLAN

·				FO	UNDATION	SCHEDULE
	(CONT. #1	2' - 0"	CONT.		(2) #5 CONT. W/ #5 TRANS. @ 48"O.C., TOP AND BOTTOM

		RETAINING WALL FOOTING SCHEDULE								
MARK	MIDTH	DEPTH	TOE LENGTH	HEEL LENGTH	REINFORCING					
RET. #1	3' - 11 5/8"	1' - 0"	1' - 0"	2' - 0"	(4) #5 CONT. TOP & BOTT. W/ #4 at16" TRANS. AT TOP AND BOTTOM					

- PRIOR TO INSTALLING DOWNSPOUTS, COORDINATE WITH ARCHITECT FOR EXACT LOCATIONS WITH BUILT CONDITIONS. LOCATIONS INDICATED ARE SUBJECT TO CHANGE AND TO BE COORDINATED WITH DOORS, WINDOWS, ENTRANCE STOOPS, ETC.
- PROVIDE PRE-FINISHED ALUMINUM GUTTERS AND DOWNSPOUTS AT SHOWN LOCATIONS EXCEPT WHERE INDICATED ON SITE PLAN TO BE TIED INTO STORM SEWER.
- CONT. PRE-FIN. ALUM. GUTTERS W/ SUPPORTS @ 3'-0" O.C. TYP., GUTTERS TO BE 0.027". COLOR TO BE SELECTED BY OWNER AND ARCHITECT. A. FRONT 'STREET SIDE' ENTRANCE ROOFS TO HAVE 6" HALF ROUND GUTTERS B. ALL OTHER GUTTERS TO BE 6" BOX STYLE GUTTERS
- PRE-FINISHED ALUMINUM DOWNSPOUTS W/ STRAP SUPPORTS @ 5'-0" O.C. VERT., TYP., MIN. OF 2 STRAPS PER DOWNSPOUT. DOWNSPOUTS TO BE 0.032". COLOR TO BE SELECTED BY OWNER AND ARCHITECT. A. ALL DOWNSPOUTS TO BE 3" ROUND DOWNSPOUTS
- ALL DOWNSPOUTS TO BE TIED INTO UNDERGROUND STORM WATER SYSTEM. COORDINATE WITH CIVIL PLANS FOR STORMWATER PIPING WITH DOWNSPOUT LOCATIONS. PROVIDE CONNECTION BOOT AS REQUIRED TO CONNECT TO UNDERGROUND STORM WATER SYSTEM.
- DOWNSPOUTS FROM UPPER ROOFS SPILLING ON LOWER ROOF LEVELS TO HAVE A SPLASH PAD
- PROVIDE VENTS THROUGH ROOF AS INDICATED FOR PLUMBING SYSTEMS. LOCATIONS TO BE NO CLOSER THAN 5'-0" TO PARAPET CONDITION AND NO CLOSER THAN 10'-0" TO ANY AIR
- 8. VENT PIPE, ROOF PENETRATIONS AND REFRIGERANT LINES NOT SHOWN FOR CLARITY.
- VERIFY EXACT NUMBER & LOCATION OF ALL VENT PIPES, ROOF PENETRATIONS & REFRIGERANT LINES IN FIELD. PROVIDE SELF-ADHERING FLASHING AROUND ALL ROOF PENETRATIONS.
- PROVIDE ALL ROOF ACCESSORIES INCLUDING FLASHING BOOTS, COUNTER FLASHING, DRIP EDGES, COPING, AND ALL OTHER ACCESSORIES REQUIRED TO PROVIDE A WATER TIGHT ROOF SYSTEM THAT WILL MEET THE ROOF WARRANTY REQUIREMENTS.
- 11. FOR ROOF PITCHES 4:12 OR GREATER, INSTALL 30# FELT AS UNDERLAYMENT OVER SHEATHING WITH AN ICE AND WATER SHIELD TO EXTEND 18" FROM ALL EDGES. ICE & WATER SHIELD TO BE AT ALL VALLEYS 36" WIDE. FOR ROOF PITCHES LESS THAN 4:12, INSTALL ICE AND WATER SHIELD AS UNDERLAYMENT CONTINUOUSLY FROM RIDGE TO EAVE AND FROM EDGE TO EDGE.
- 12. GROUNDS TO BE CLEANED OR DEBRIS AND NAILS DAILY PRIOR TO LEAVING SITE.
- 13. PROVIDE CONT. STEP FLASHING @ ALL SLOPED WALL/ROOF CONNECTION, TYP.
- 14. 1011.13 GUARDS. WHERE THE ROOF HATCH OPENING IS LOCATED WITHIN 10 FEET OF THE ROOF EDGE, SUCH ROOF ACCESS OR ROOF EDGE SHALL BE PROTECTED BY GUARDS INSTALLED IN ACCORDANCE WITH IBC 2018, SECTION 1015.
- 15. 1015.6 MECHANICAL EQUIPMENT, SYSTEMS AND DEVICES. | 1015.7 ROOF ACCESS. GUARDS SHALL BE PROVIDED WHERE VARIOUS COMPONENTS THAT REQUIRE SERVICE ARE LOCATED WITHIN 10 FEET OF A ROOF EDGE. THE GUARD SHALL EXTEND NOT LESS THAN 30 INCHES BEYOND EACH END OF SUCH COMPONENTS. THE GUARD SHALL BE CONSTRUCTED SO AS TO PREVENT THE PASSAGE OF A SPHERE 21 INCHES IN DIAMETER. BASIS OF DESIGN - KEEGUARD SAFETY RAIL SYSTEM; SEE IMAGE 18/TH.G3.1
- 16. AT ALL ROOFTOP EOUIPMENT, ROOF HATCHES, ETC., PROVIDE TAPERED RIGID INSULATION SADDLE TO SLOPE AWAY AND AROUND FOR POSITIVE WATER FLOW.
- 17. PROVIDE ROOF WALK PADS AS REQUIRED TO ACCESS ALL ROOFTOP EQUIPMENT AND PENETRATIONS FROM ROOF HATCH. SEE WALKPAD DETAIL.

o D.S. ----

ROUND DOWNSPOUT

DASHED LINE INDICATES EXTENDING ROOF MEMBRANE UP WALL A MINIMUM OF 8" OR PER MANUFACTURER'S SPECIFICATIONS. REFER TO TYPICAL ROOF DETAIL SHEET FOR TERMINATION DETAILS. AT BRICK - MEMBRANE TO EXTEND UP THE EXTERIOR FACE OF BRICK W/

TERMINATION BAR AND COUNTERFLASHING IN THE GROUT JOINT OF AT SIDING - MEMBRANE TO EXTEND UNDER EXTERIOR SHEATHING W/ COUNTERFLASHING.

CRICKET PLACED ON HIGH SIDE FOR POSITIVE DRAINAGE AROUND OBJECT (OR) IN LOW SIDE OF CORNER TO CREATE POSITIVE DRAINAGE

PROTECTION WALK PAD. PLACE AROUND PERIMETER OF ROOF HATCH

THE CONTRACTOR SHALL CAREFULLY STUDY AND COMPARE THE REFLECTED CEILING PLANS WITH THE ELECTRICAL LIGHTING PLANS, MECHANICAL PLANS, AND FIRE PROTECTION PLANS. GENERAL CONTRACTOR SHALL REPORT TO THE ARCHITECT ANY ERROR, INCONSISTENCY OR OMISSION THAT IS DISCOVERED.

REFLECTED CEILING PLAN NOTES

- ALL SOFFITS AND CEILING HEIGHTS INDICATED SHALL BE MEASURED FROM BOTTOM OF FINISH MATERIAL TO FINISH FLOOR ELEVATION DIRECTLY BELOW.
- ALL DIMENSIONS SHOWN ON REFLECTED CEILING PLANS ARE FINISHED DIMENSIONS.
- THE CONTRACTOR SHALL VERIFY THAT ACCESS PANELS OF APPROPRIATE SIZE AND TYPE ARE INSTALLED IN GYPSUM BOARD CEILING ASSEMBLIES, SOFFITS, AND IN OTHER NON-ACCESSIBLE TYPE AREAS WHERE ACCESS, SERVICE OR ADJUSTMENT TO MECHANICAL, PLUMBING OR ELECTRICAL ITEMS MAY BE REQUIRED. ACCESS PANELS SHALL BE FIRE RATED EQUAL TO ANY RATING OF THE CEILING OR SOFFIT IN WHICH THEY OCCUR.
- ONLY CEILING MOUNTED EXIT LIGHTING IS SHOWN ON THE REFLECTED CEILING PLANS. SEE ELECTRICAL DRAWINGS FOR LOCATIONS OF WALL MOUNTED EXIT LIGHTING.
- SEE THE ELECTRICAL DRAWINGS AND / OR THE COMMUNICATIONS DRAWINGS FOR LOCATIONS OF CEILING MOUNTED SMOKE DETECTORS, SPEAKERS, FIRE ALARM DEVICES, ETC.
- CONTRACTOR TO COORDINATE WITH ARCHITECT AND OWNER ALL FIXTURE SELECTIONS AND FINISHES PRIOR TO INSTALLATION.
- 8. COORDINATE WITH APPLICABLE NOTES AND DIMENSIONS ON OTHER SHEETS.
- EXTEND GYPSUM BOARD WALL CONSTRUCTION TO UNDERSIDE OF ROOF / FLOOR DECK IN
- AREAS WITHOUT FINISHED CEILINGS TYPICAL. 10. SEE FIRE PROTECTION SHEETS FOR SPRINKLER HEAD LOCATIONS.
- 11. PROVIDE STRUCTURAL SUPPORT FOR CEILING MOUNTED EQUIPMENT AS REQUIRED.
- 12. ALL GYPSUM BOARD CEILINGS IN WET AREAS SHALL BE MOISTURE RESISTANT GYPSUM BOARD 13. PROVIDE CEILING CONTROL JOINTS AS INDICATED. ALL CEILINGS OVER 900 SF TO RECEIVE PERIMETER RELIEF JOINTS.
- 14. ALL CEILINGS IN WET AREAS TO BE MOISTURE RESISTANT GYP. BOARD.
- 15. ALL CEILINGS IN LIVING UNITS TO BE HELD TIGHT TO UNDERSIDE OF STRUCTURE UNLESS NOTED OTHERWISE.
- COORDINATE LOCATIONS OF FIRE ALARMS, SMOKE DETECTORS WITH LIGHT FIXTURES, HVAC DIFFUSERS / RETURNS AND SPRINKLER HEADS.
- 17. CENTER SINGLE LIGHT FIXTURES IN LIVING UNIT WITH ROOM, UNLESS NOTED OTHERWISE.
- 18. REFER TO ELECTRICAL PLAN FOR ATTIC LIGHTING.
- 19. FLOOR/ CEILING ASSEMBLIES TO MEET A MINIMUM STC RATING OF 50. TYPE X GYPSUM BOARD REQUIRED FOR ALL CEILINGS BETWEEN UNITS.

BLDG 6 - ROOF DRAIN CALCS

MAIN "FLAT" ROOF (SPLIT IN 3 AREAS FOR DRAINAGE CALCS) AREA 1: 848 SF • AREA 2: 443 SF • AREA 3: 837 SF

ENTRANCE ROOF OVERHANGS • AREA 4: 151 SF + AREA 2 = 594 SF• AREA 5: 52 SF

FIGURE 1106.1 (EASTERN UNITED STATES) KNOXVILLE, TENNESSEE FALLS APPROX. ON THE 3.25" (ROUNDED UP TO 4.0" PER ENGINEERS RECOMMENDATION)

RAINFALL CONVERSION DATA 4.0" RAINFALL = .0416 G.P.M. PER S.F. (MULTIPLIER TO USE)

- 848 SF x .0416 = 35.3 gpm• AREA 2: 443 SF x .0416 = 18.4 gpm837 SF x .0416 = 34.8 gpm594 SF x .0416 = 24.7 gpm AREA 4: AREA 5: 52 SF x .0416 = 2.2 gpm
- FIGURE 1106.3 (VERTICAL LEADER SIZING) 3" ROUND DOWNSPOUTS ARE SHOWN TO MEET SIZE AND QUANTITY REQUIREMENTS
- FIGURE 1106.6 (HORIZONTAL GUTTER SIZING) • STREET ENTRANCE CANOPY = 5" HALF ROUND GUTTER AT 1/8" SLOPE SHOWN TO MEET SIZE AND SLOPE REQUIREMENTS
- ALL OTHER ROOFS = 5" BOX GUTTER AT 1/4" SLOPE SHOWN TO MEET SIZE AND SLOPE REQUIREMENTS
- ** CALCULATIONS TAKEN FROM INTERNATIONAL PLUMBING CODE 2018, SECTION 1105 & 1106 FOR ROOF DRAINS, SIZE OF CONDUCTORS, LEADERS AND STORM DRAINS

REFLECTED CEILING PLAN LEGEND

SURFACE MOUNTED LIGHT FIXTURE (CEILING)

WALL OR CEILING MOUNTED FIXTURE

CEILING FAN W/ INTEGRAL LIGHT FIXTURE

SOFFIT / CANOPY RECESSED SLOT FIXTURE

(5/8" TYPE X GYP. BD. ON 7/8" HAT CHANNELS

 \pm 9'-0" A.F.F. = LIVING, KITCHEN, BEDROOMS

 \pm 8'-0" A.F.F. = CLOSETS, BATHROOMS, HALLS

(5/8" TYPE X GYP. BD. ON 2X FRAMING TO ACHEIVE

"STREET SIDE" ENTRANCE CANOPY = METAL SOFFIT -

LONGBOARD - COLOR: DARK CHERRY; 6" V-GROOVE

"PARKING SIDE" BACK ENTRANCE & SOFFITS

SMOOTH FIBER CEMENT SOFFIT; PAINTED

HVAC SUPPLY DIFFUSER (CEILING)

HVAC RETURN GRILLE (THRU-WALL)

EXIT SIGN - REFER TO ELECTRICAL PLANS

CEILING MOUNTED SPRINKLER HEAD

WALL MOUNTED SPRINKLER HEAD

EMERGENCY LIGHT - REFER TO ELECTRICAL PLANS

EXHAUST FAN

SMOKE DETECTOR

GYPSUM BOARD CEILING -- PAINTED


FASTENED TO UNDERSIDE OF TRUSSES.


SOFFIT FOR DUCTS, PIPING, ETC.)


(SEE PLAN FOR MOUNTING TYPE)


PENDANT LIGHT FIXTURE

**CONTRACTOR TO VERIFY SQUARE FOOTAGES FOR PRICING. AREAS SHOWN ARE FOR CODE DRAINAGE CALCULATIONS ONLY.

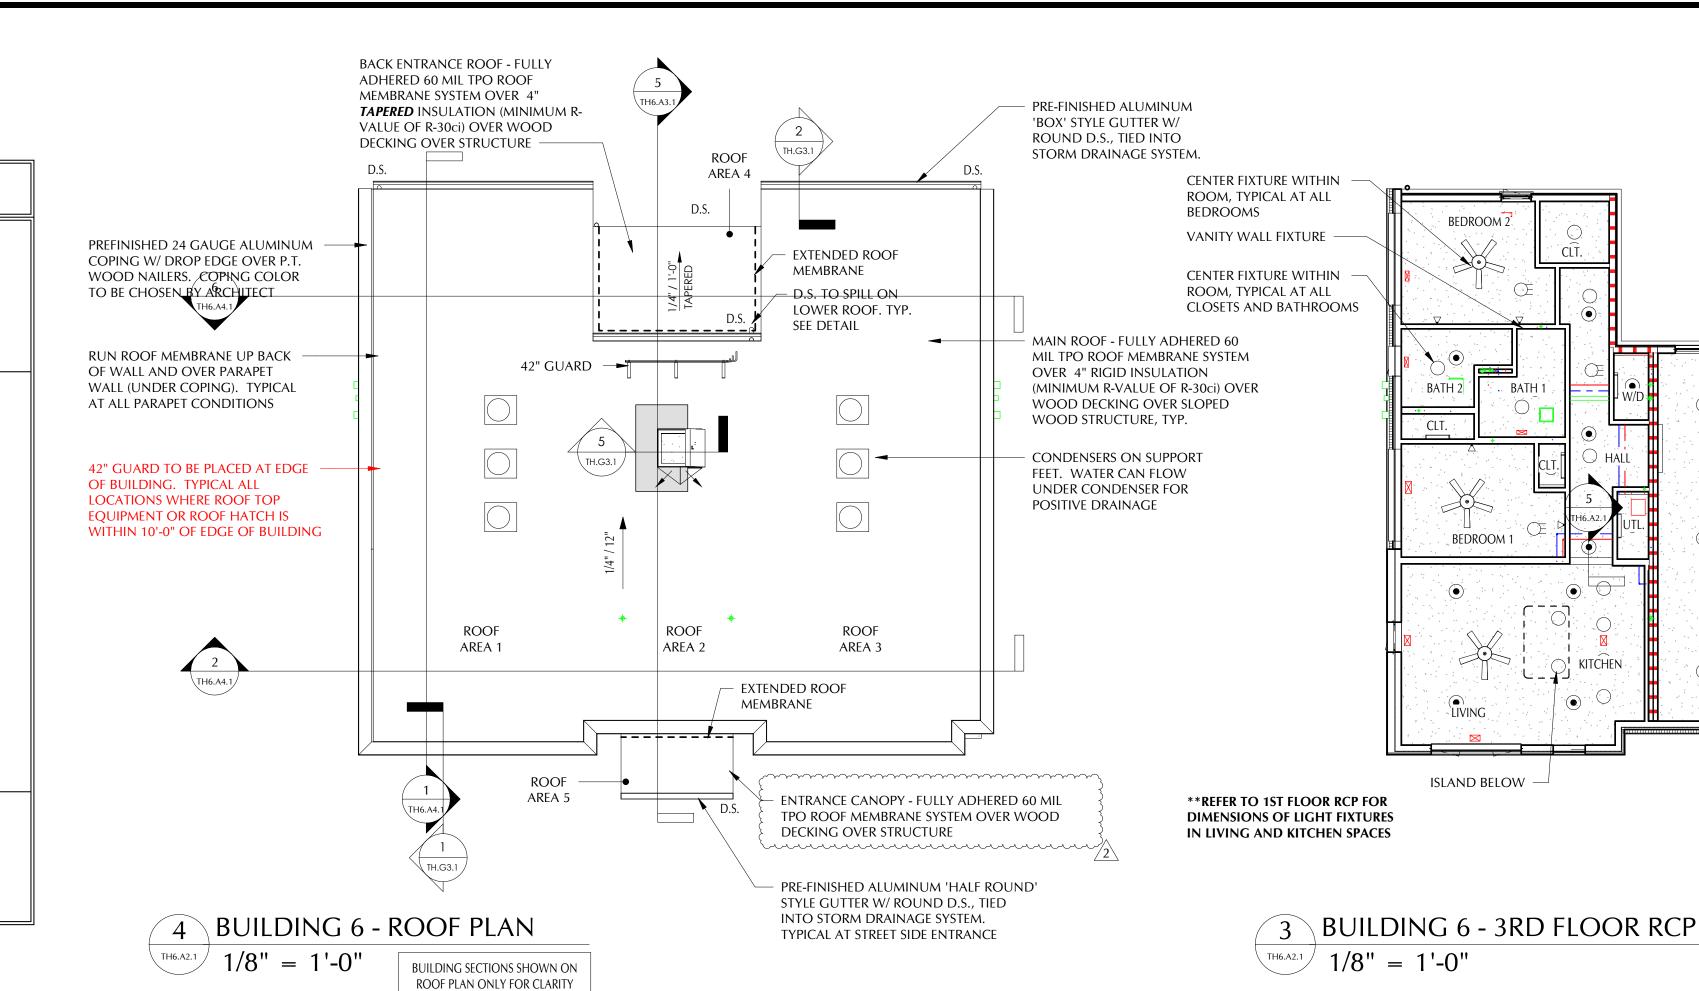

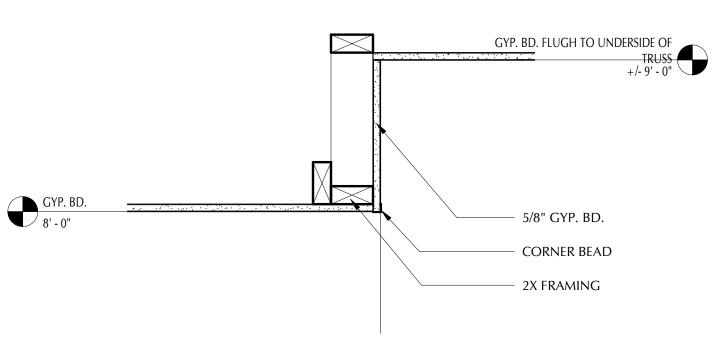

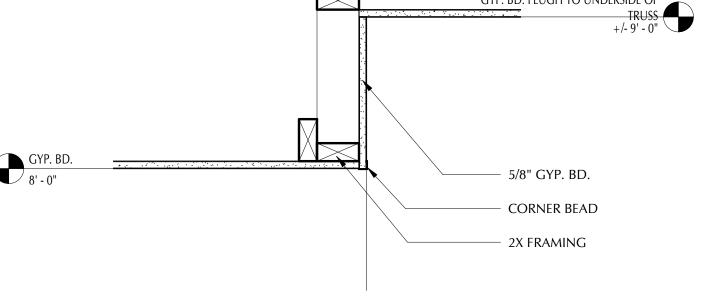

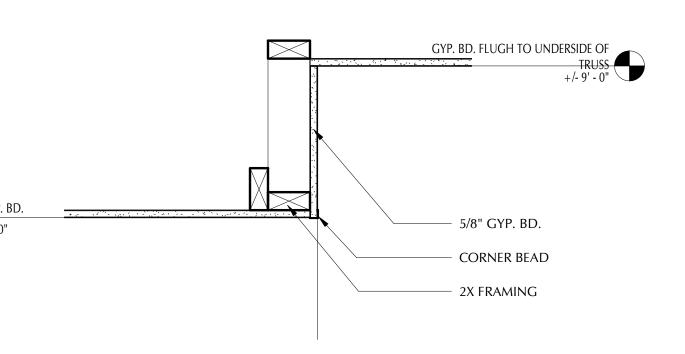

CENTER FIXTURE WITHIN ROOM, TYPICAL AT ALL CLOSETS AND BATHROOMS VANITY WALL FIXTURE CENTER FIXTURE WITHIN ROOM, TYPICAL AT ALL BEDROOMS BEDROOM 1 BEDROOM 1-٠٠. KITCHEN المنظرية ب

BEDROOM 1.-


GYP BOARD HELD TIGHT

TRUSSES

TO UNDERSIDE OF STAIR

ISLAND BELOW - GYP BOARD HELD TIGHT **REFER TO 1ST FLOOR RCP FOR TO UNDERSIDE OF STAIR **DIMENSIONS OF LIGHT FIXTURES** LANDING AND RISERS IN LIVING AND KITCHEN SPACES

BEDROOM 2

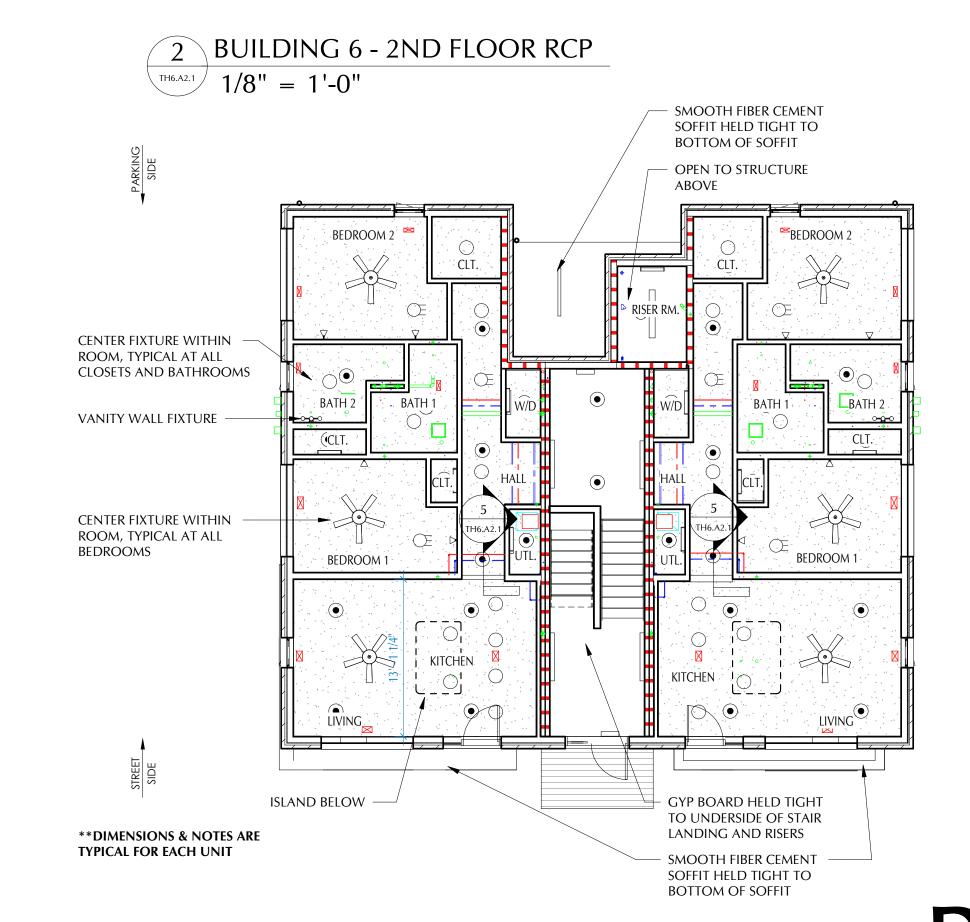

1 BUILDING 6 - 1ST FLOOR RCP

11 East Madison Street Tel 312.456.0123 Suite 300 Fax 312.456.0124 Chicago, IL 60602 United States Date Description 2 5/26/20 ADDENDUM 1 Seal / Signature **AUSTIN HOMES - PHASE 1A**

KNOXVILLE'S COMMUNITY DEVELOPMENT CORPORATION

KCDC

AUSTIN HOMES REDEVELOPMENT PHASE 1A BURGE DRIVE AND HARRIET TUBMAN ST.



2240 Sutherland Avenue Suite 105 Knoxville, TN 37919 United States

BUILDING 6 - REFLECTED CEILLING PLAN, ROOF PLAN & NOTES As indicated

Project Number

193076

Description

05/06/2020

TH6.A2.1

KCDC KNOXVILLE'S COMMUNITY **DEVELOPMENT CORPORATION**

AUSTIN HOMES REDEVELOPMENT PHASE 1A BURGE DRIVE AND HARRIET TUBMAN ST.




Tel 312.456.0123

Fax 312.456.0124

Tel 865.671.9060 2240 Sutherland Avenue Suite 105 Knoxville, TN 37919 **United States**

11 East Madison Street Suite 300 Chicago, IL 60602 United States

 ∆ Date Description 1 5/06/20 PLANS REVIEW COMMENTS 2 5/26/20 ADDENDUM 1

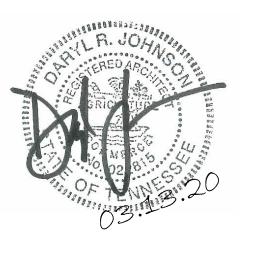

Seal / Signature


AUSTIN HOMES - PHASE 1A


05/06/2020

Project Number 193076

BUILDING 6 - WALL SECTIONS


1/2" = 1'-0"

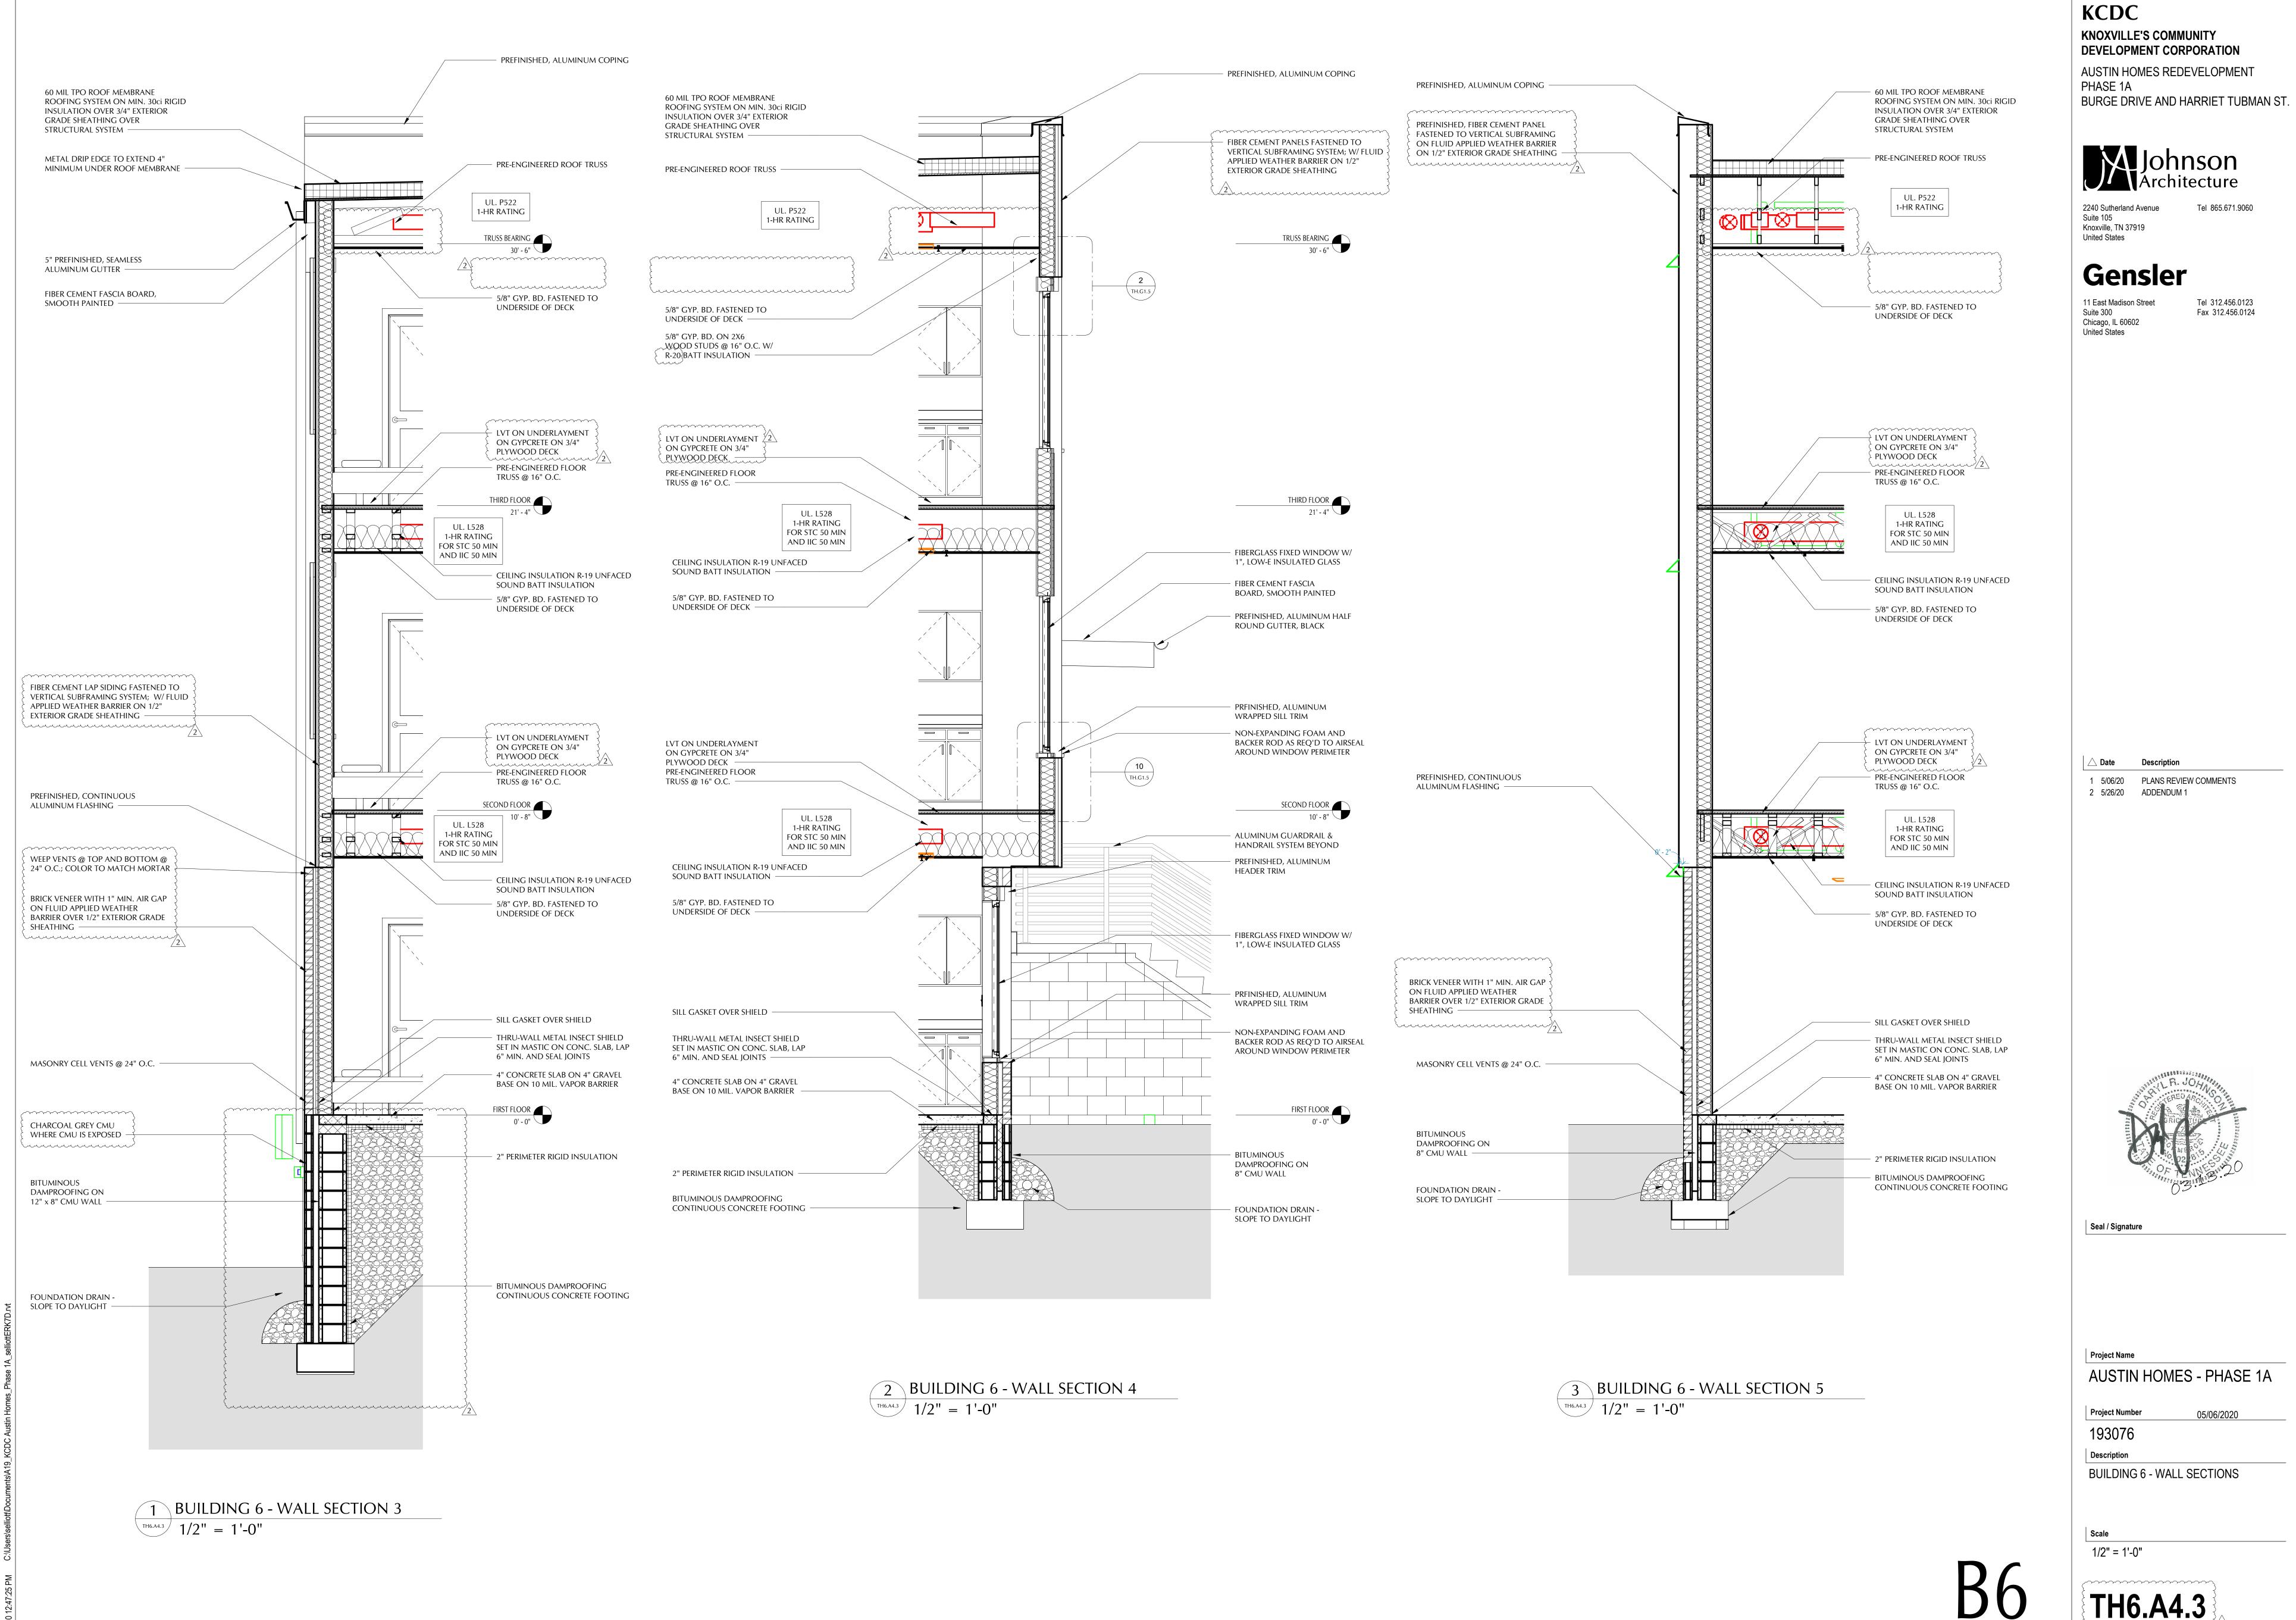

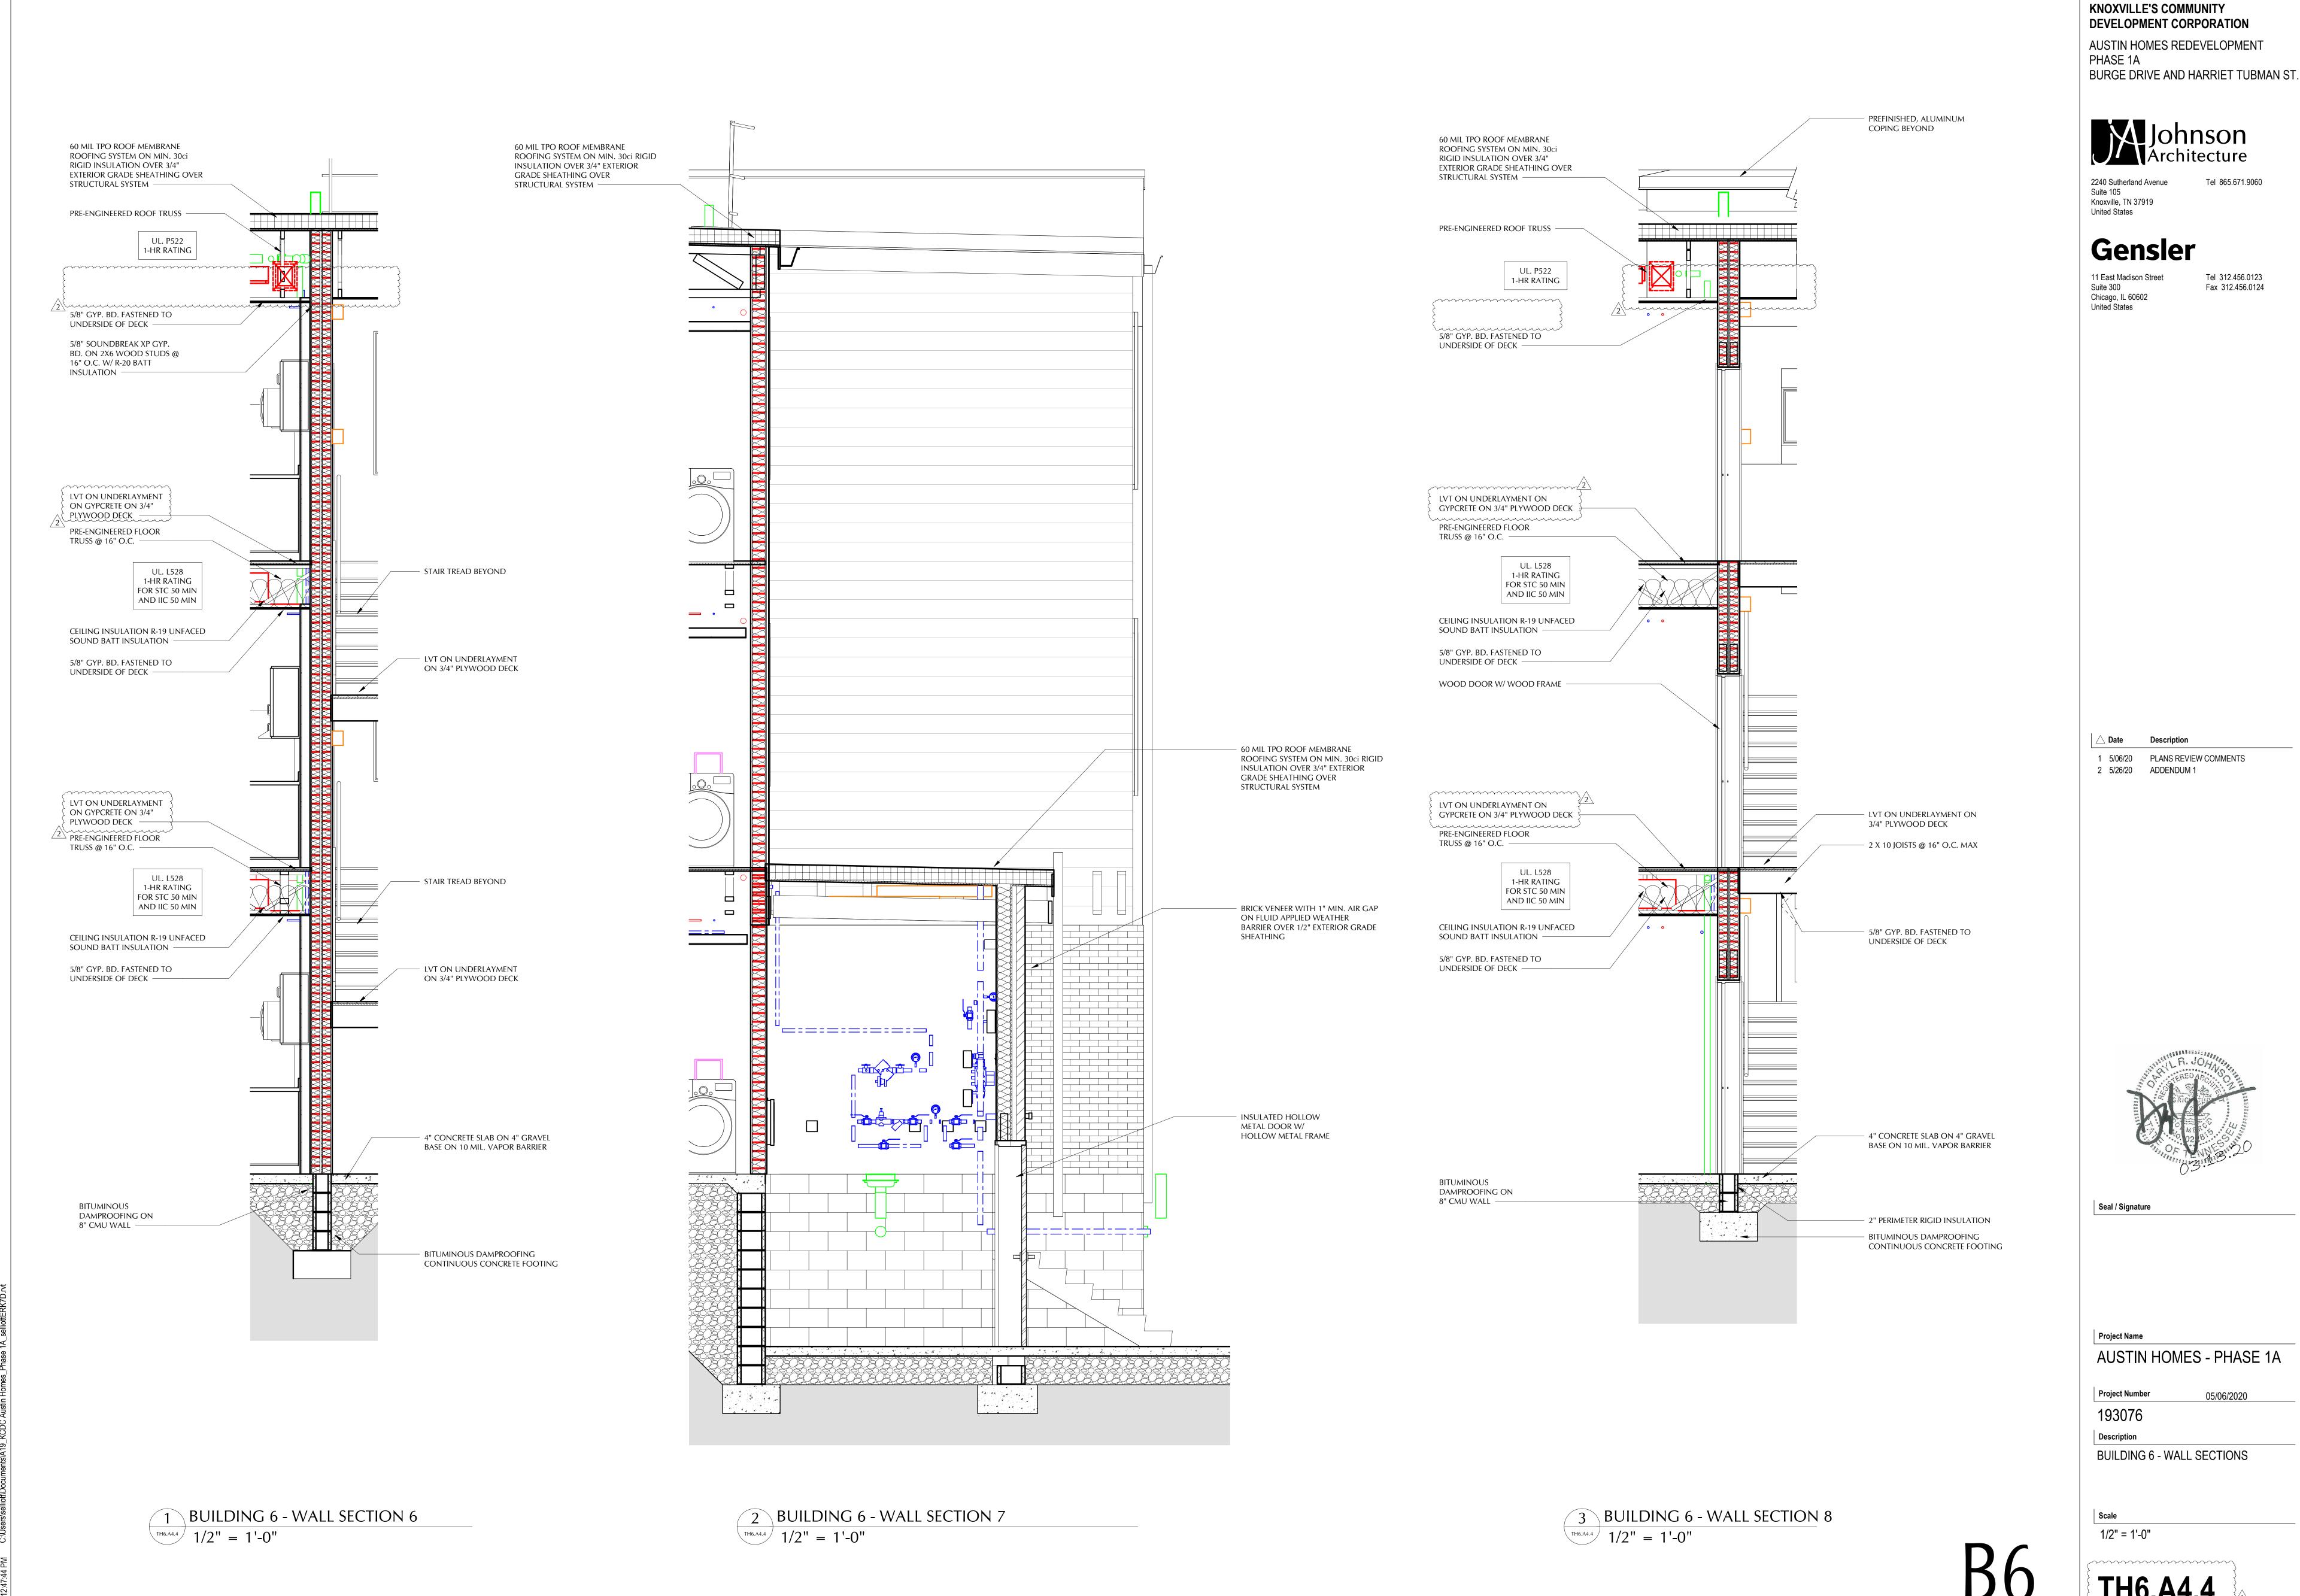


KCDC

AUSTIN HOMES REDEVELOPMENT

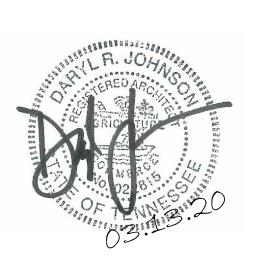

TH6.A4.4

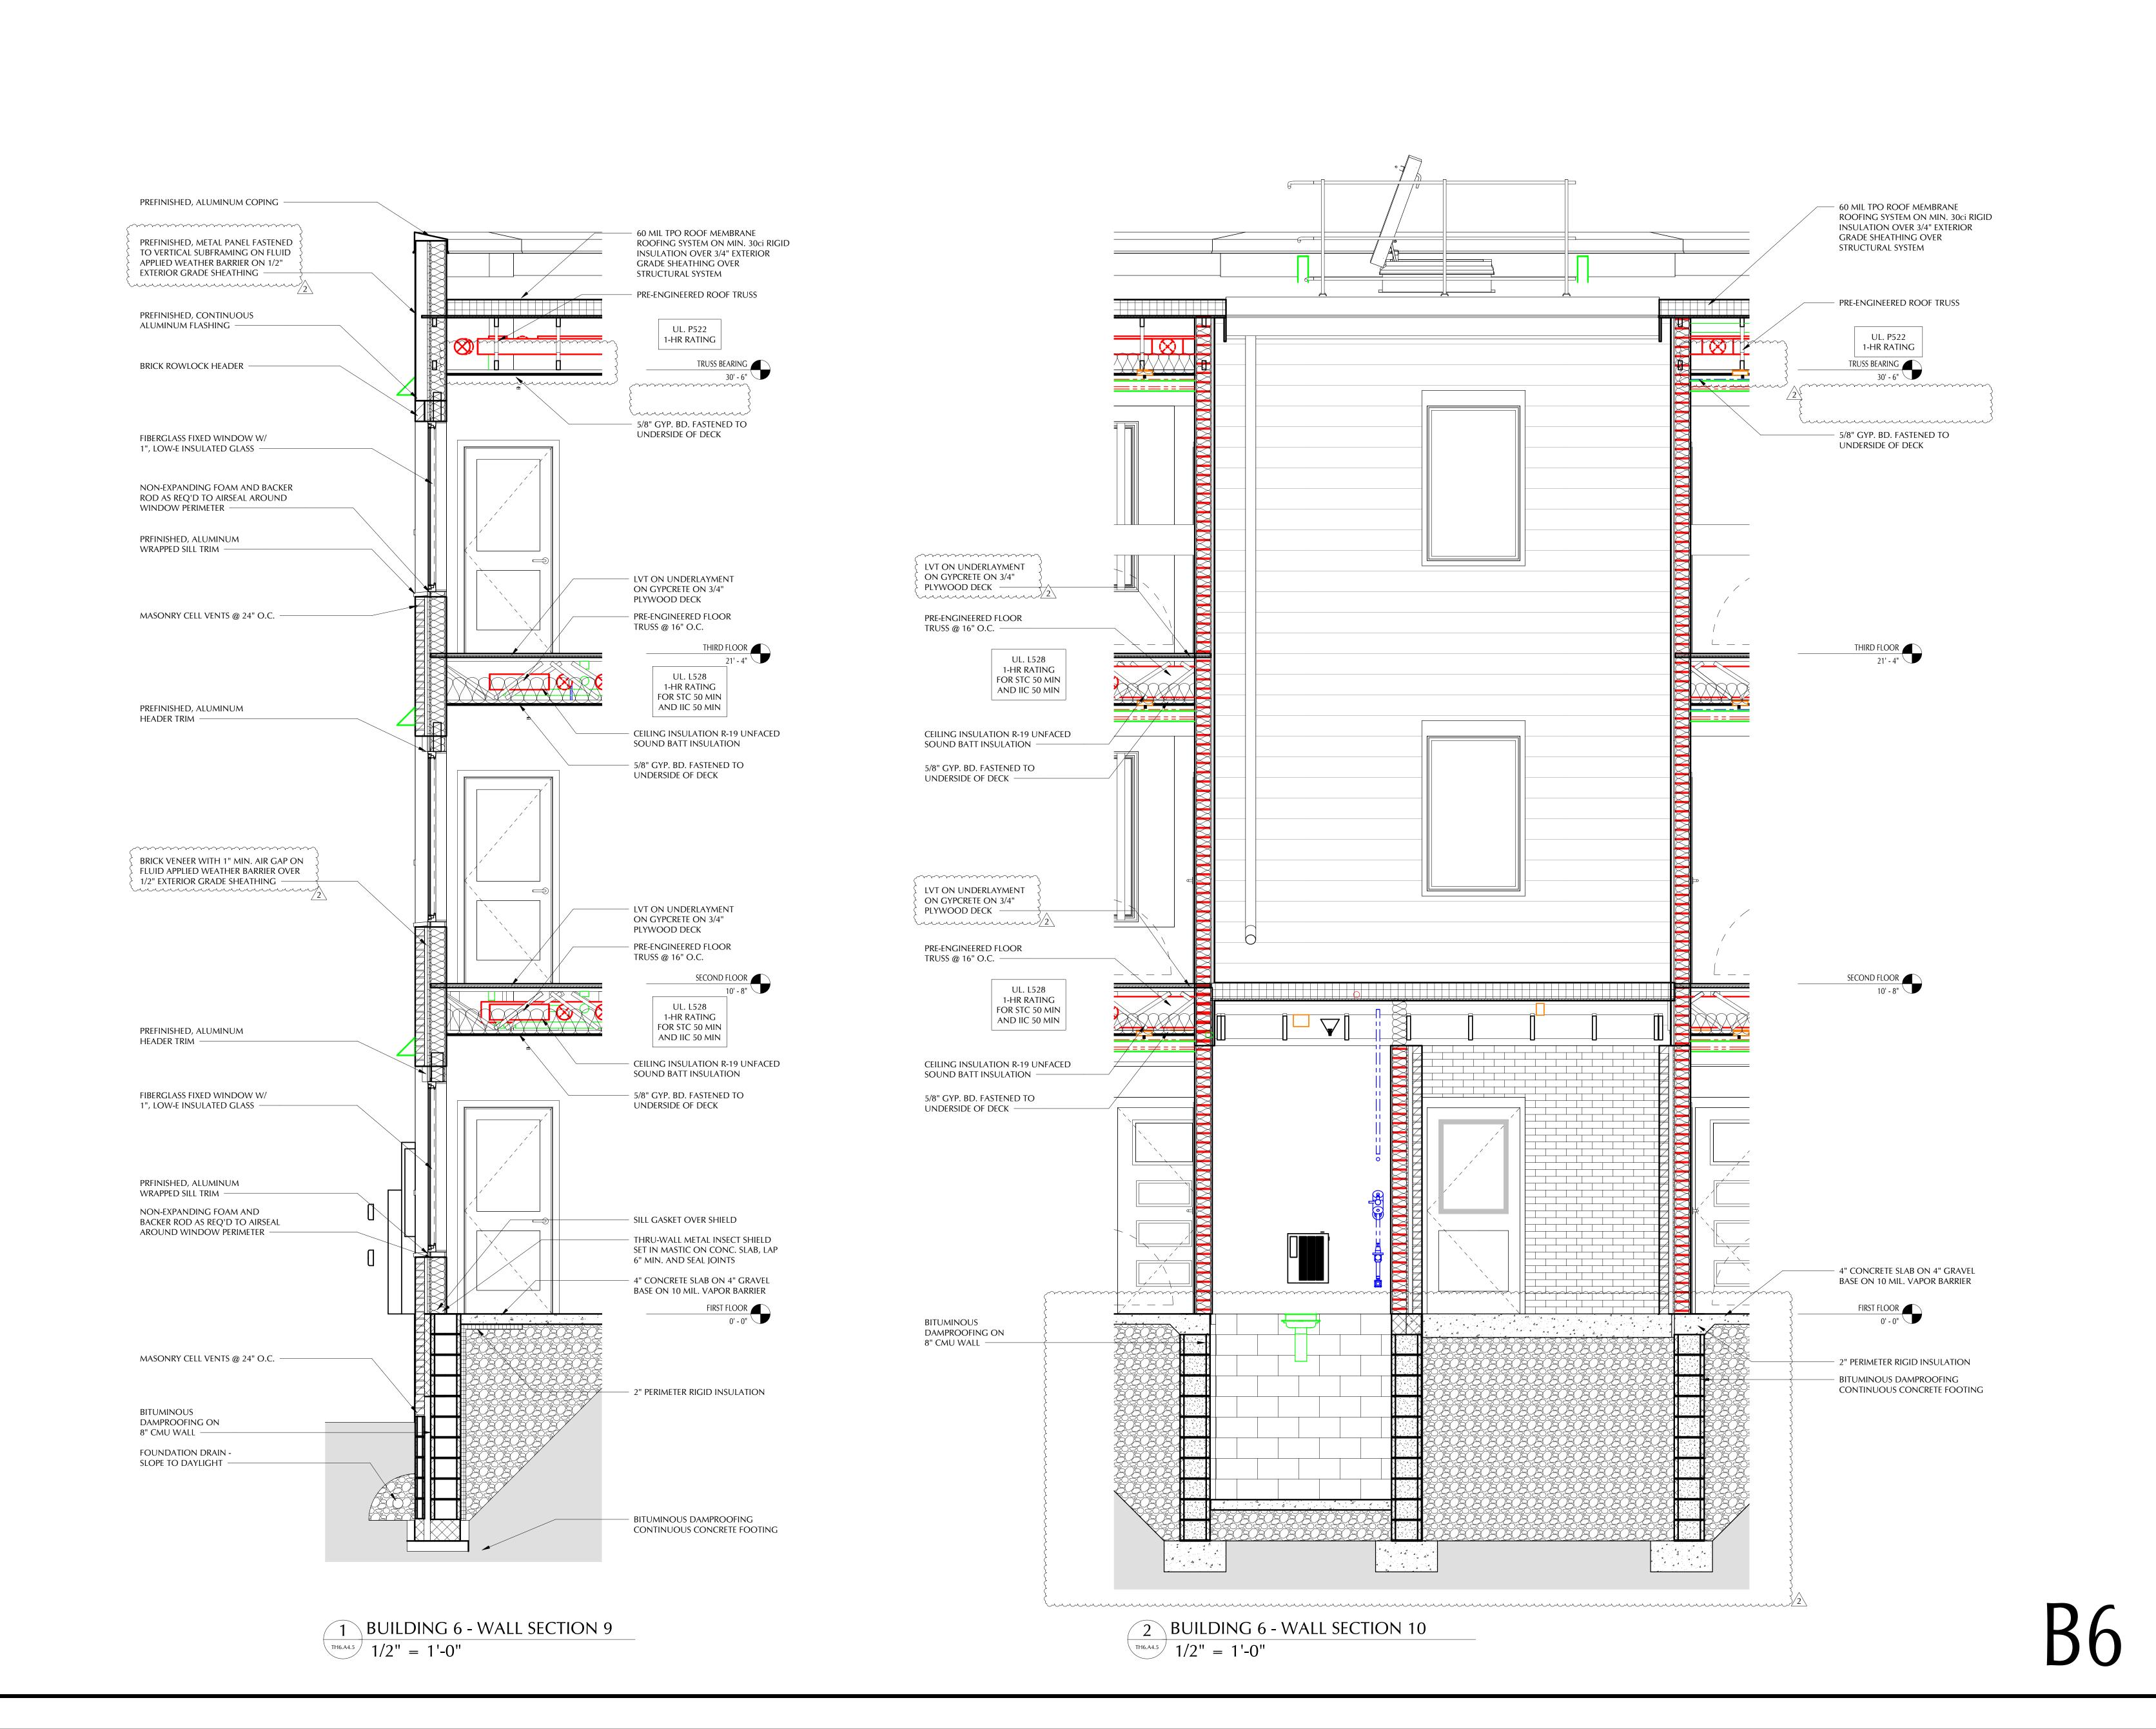

KCDC KNOXVILLE'S COMMUNITY **DEVELOPMENT CORPORATION**

AUSTIN HOMES REDEVELOPMENT PHASE 1A BURGE DRIVE AND HARRIET TUBMAN ST.




2240 Sutherland Avenue Tel 865.671.9060 Suite 105 Knoxville, TN 37919 **United States**

11 East Madison Street Tel 312.456.0123 Suite 300 Fax 312.456.0124 Chicago, IL 60602 United States

1 5/06/20 PLANS REVIEW COMMENTS

2 5/26/20 ADDENDUM 1

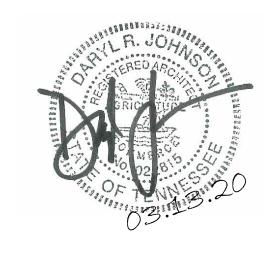

Seal / Signature


AUSTIN HOMES - PHASE 1A

Project Number 05/06/2020 193076

BUILDING 6 - WALL SECTIONS

1/2" = 1'-0"


TH6.A4.5

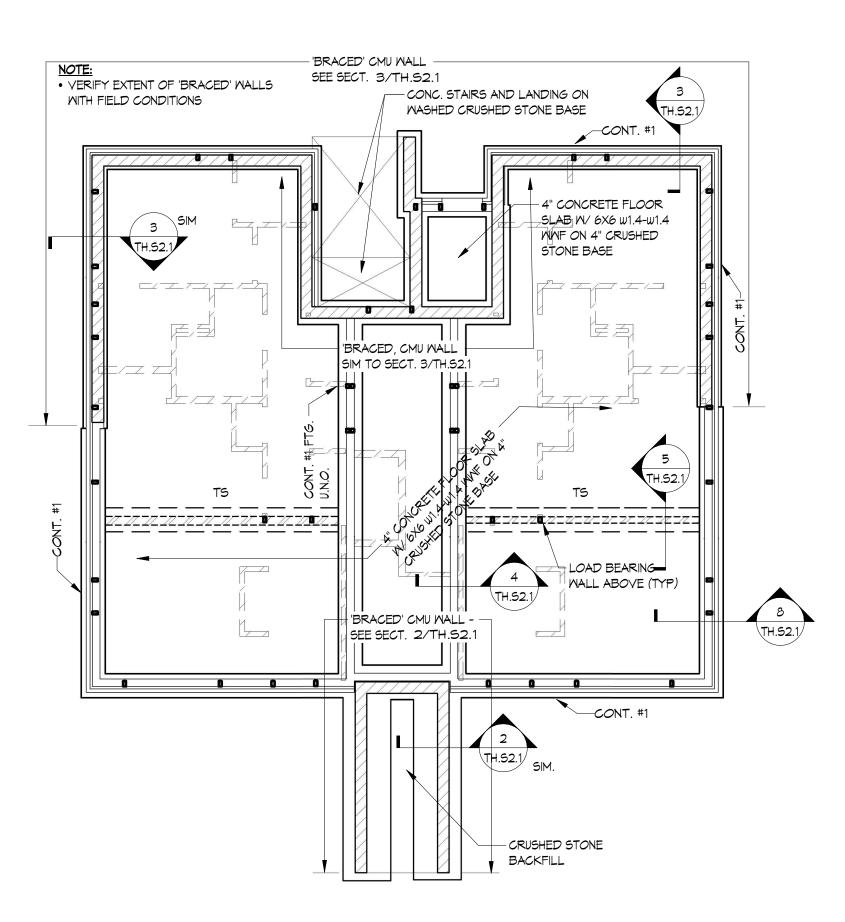


B6 - 0-FOUNDATION PLAN

		FC	PUNDATION	SCHEDULE
CONT. #1	2' - 0"	CONT.	1' - 0"	(2) #5 CONT. W/ #5 TRANS. @ 48"O.C., TOP AND BOTTOM


RETAINING WALL FOOTING SCHEDULE					
MARK	MIDTH	DEPTH	TOE LENGTH	HEEL LENGTH	REINFORCING
RET. #1	3' - 11 5/8"	1' - 0"	1' - 0"	2' - 0"	(4) #5 CONT. TOP & BOTT. w/ #4 at16" TRANS. AT TOP AND BOTTOM

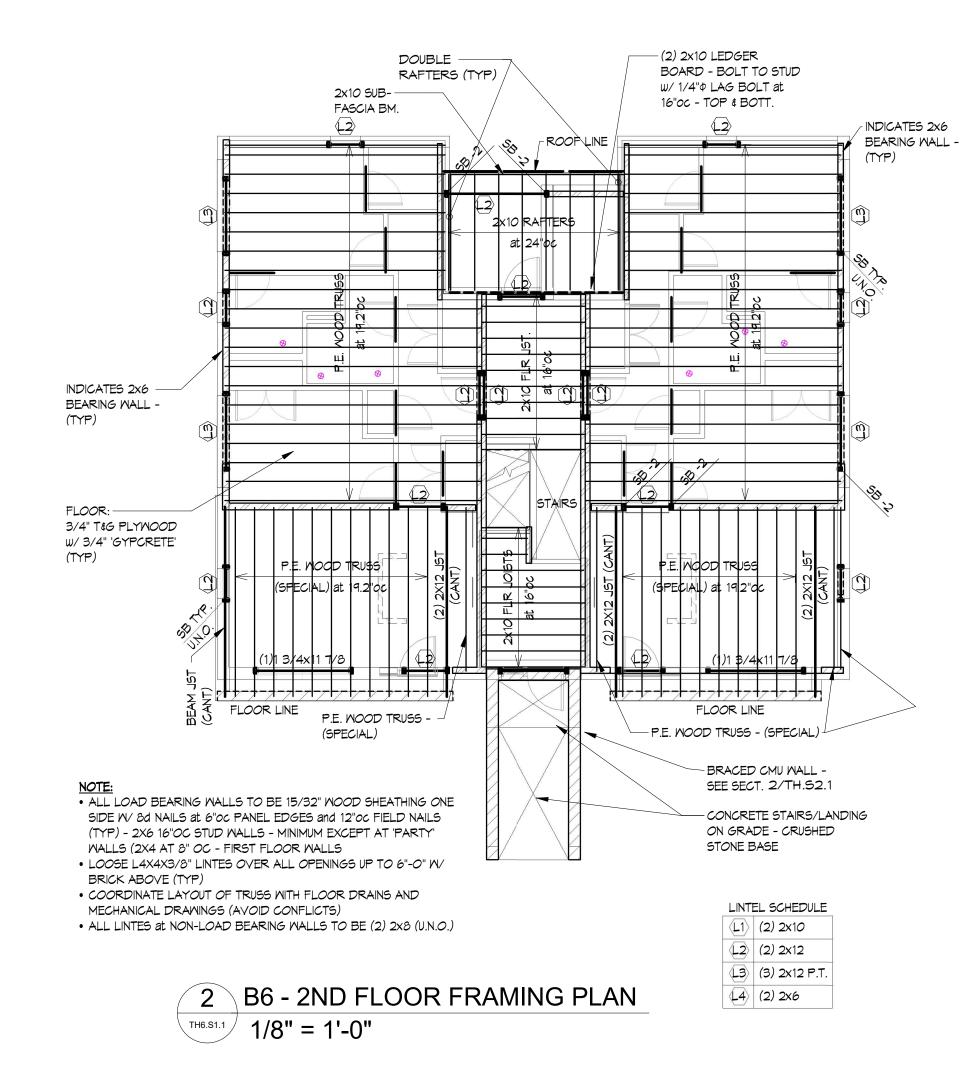

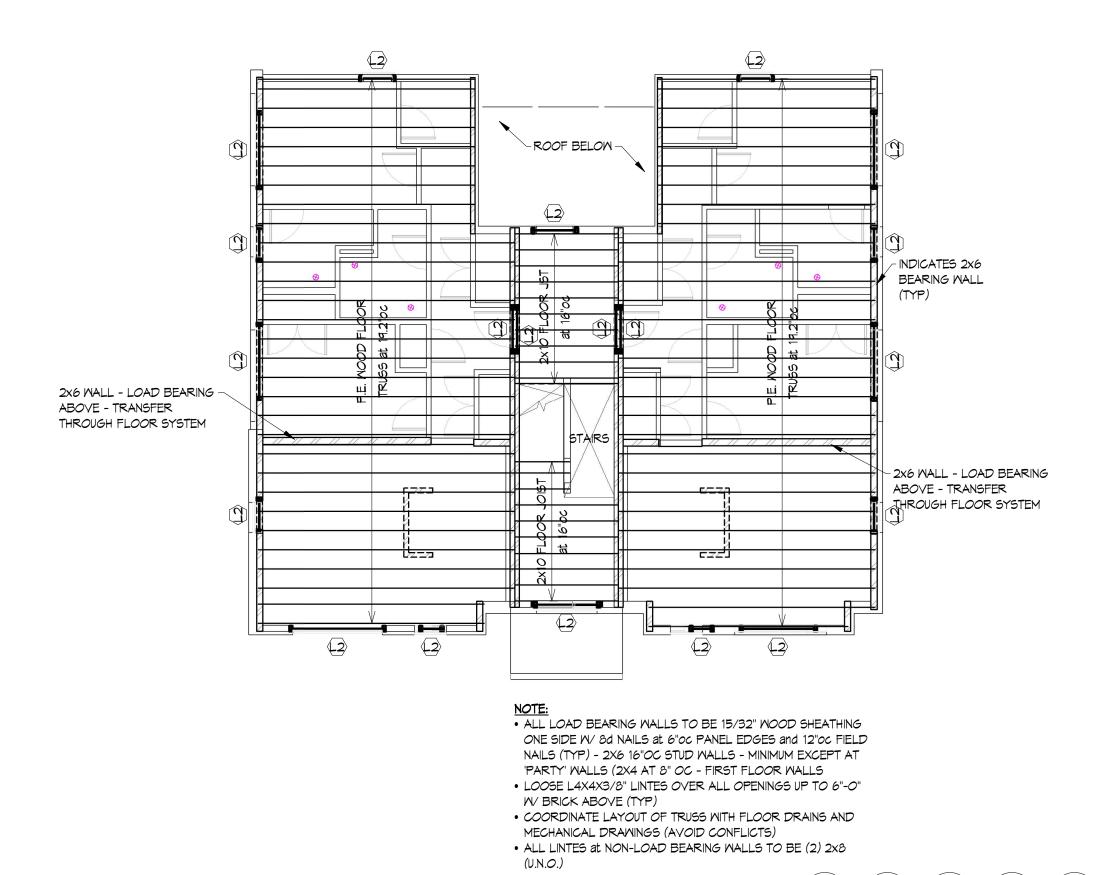

3 B6 - 3RD FLOOR FRAMING PLAN TH6.S1.1 1/8" = 1'-0"

REVISION 2 = REVISED FOUNDATION/FRAMING BASED ON REVISED GRADING PLAN. MINOR REVISIONS TO UNIT FRAMING PLANS FOR ADA COMPLIANCE

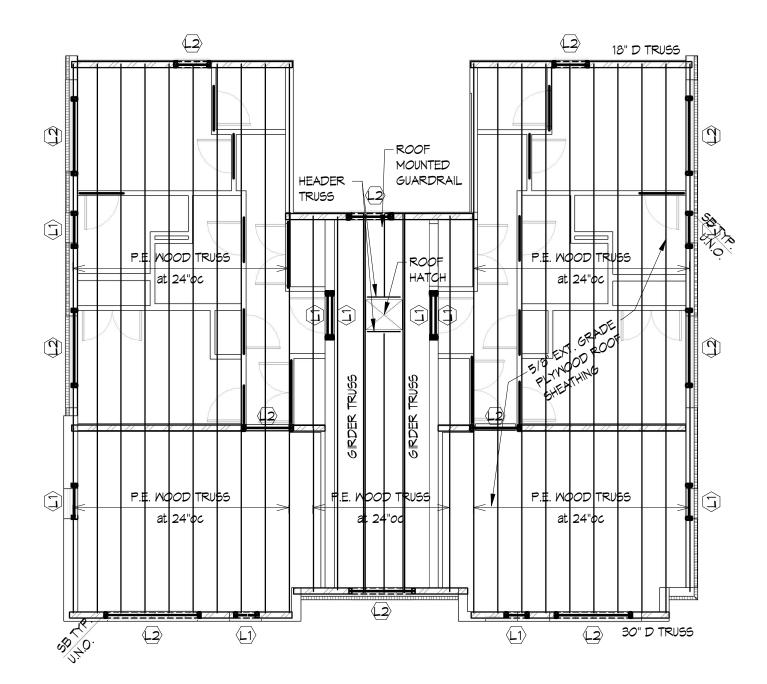

NOTE:

• ALL LOAD BEARING WALLS TO BE 2X6 AT 16"OC STUD WALLS - MINIMUM

• MINIMUM ROOF TRUSS DEPTH AT LOW END = 18" and SLOPE at 1/4" FT COORDINATE WITH ARCHITECTURAL DRAWINGS

• COORDINATE LAY-OUT OF ROOF TRUSS with ROOF HATCH AND MECHANICAL UNITS

• ALL LINTES at NON-LOAD BEARING WALLS TO BE (2) 2X8 (U.N.O.)

4 B6 - ROOF FRAMING PLAN TH6.S1.1 1/8" = 1'-0"

KCDC

Knoxville Community Development Corporation 901 N Boardway Knoxville, TN 37917



Tel 865.671.9060 2240 Sutherland Avenue Suite 105 Knoxville, TN 37919

Gensler

United States

11 East Madison Street Suite 300 Tel 312.456.0123 Fax 312.456.0124 Chicago, IL 60602 United States

> PARTNERS

502 Union Avenue Knoxville, TN 37902 **United States** Tel 865.524.777

 □ Date Description 2 5.22.2020 Revision 2



Seal / Signature

小ゆり06 2020

AUSTIN HOMES - PHASE 1A

Project Number

193076

BLDG 6 STRUCTURAL PLANS

As indicated

- PRIOR TO INSTALLING DOWNSPOUTS, COORDINATE WITH ARCHITECT FOR EXACT LOCATIONS WITH BUILT CONDITIONS. LOCATIONS INDICATED ARE SUBJECT TO CHANGE AND TO BE COORDINATED WITH DOORS, WINDOWS, ENTRANCE STOOPS, ETC.
- PROVIDE PRE-FINISHED ALUMINUM GUTTERS AND DOWNSPOUTS AT SHOWN LOCATIONS EXCEPT WHERE INDICATED ON SITE PLAN TO BE TIED INTO STORM SEWER.
- CONT. PRE-FIN. ALUM. GUTTERS W/ SUPPORTS @ 3'-0" O.C. TYP., GUTTERS TO BE 0.027". COLOR TO BE SELECTED BY OWNER AND ARCHITECT. A. FRONT 'STREET SIDE' ENTRANCE ROOFS TO HAVE 6" HALF ROUND GUTTERS B. ALL OTHER GUTTERS TO BE 6" BOX STYLE GUTTERS
- 4. PRE-FINISHED ALUMINUM DOWNSPOUTS W/ STRAP SUPPORTS @ 5'-0" O.C. VERT., TYP., MIN. OF 2 STRAPS PER DOWNSPOUT. DOWNSPOUTS TO BE 0.032". COLOR TO BE SELECTED BY OWNER AND ARCHITECT. A. ALL DOWNSPOUTS TO BE 3" ROUND DOWNSPOUTS
- ALL DOWNSPOUTS TO BE TIED INTO UNDERGROUND STORM WATER SYSTEM. COORDINATE WITH CIVIL PLANS FOR STORMWATER PIPING WITH DOWNSPOUT LOCATIONS. PROVIDE CONNECTION BOOT AS REQUIRED TO CONNECT TO UNDERGROUND STORM WATER SYSTEM.
- 6. DOWNSPOUTS FROM UPPER ROOFS SPILLING ON LOWER ROOF LEVELS TO HAVE A SPLASH PAD UNDER DOWNSPOUT.
- PROVIDE VENTS THROUGH ROOF AS INDICATED FOR PLUMBING SYSTEMS. LOCATIONS TO BE NO CLOSER THAN 5'-0" TO PARAPET CONDITION AND NO CLOSER THAN 10'-0" TO ANY AIR
- 8. VENT PIPE, ROOF PENETRATIONS AND REFRIGERANT LINES NOT SHOWN FOR CLARITY.
- VERIFY EXACT NUMBER & LOCATION OF ALL VENT PIPES, ROOF PENETRATIONS & REFRIGERANT LINES IN FIELD. PROVIDE SELF-ADHERING FLASHING AROUND ALL ROOF PENETRATIONS.
- 10. PROVIDE ALL ROOF ACCESSORIES INCLUDING FLASHING BOOTS, COUNTER FLASHING, DRIP EDGES, COPING, AND ALL OTHER ACCESSORIES REQUIRED TO PROVIDE A WATER TIGHT ROOF SYSTEM THAT WILL MEET THE ROOF WARRANTY REQUIREMENTS.
- 11. FOR ROOF PITCHES 4:12 OR GREATER, INSTALL 30# FELT AS UNDERLAYMENT OVER SHEATHING WITH AN ICE AND WATER SHIELD TO EXTEND 18" FROM ALL EDGES. ICE & WATER SHIELD TO BE AT ALL VALLEYS 36" WIDE. FOR ROOF PITCHES LESS THAN 4:12, INSTALL ICE AND WATER SHIELD AS UNDERLAYMENT CONTINUOUSLY FROM RIDGE TO EAVE AND FROM EDGE TO EDGE.
- 12. GROUNDS TO BE CLEANED OR DEBRIS AND NAILS DAILY PRIOR TO LEAVING SITE. 13. PROVIDE CONT. STEP FLASHING @ ALL SLOPED WALL/ROOF CONNECTION, TYP.
- 14. 1011.13 GUARDS. WHERE THE ROOF HATCH OPENING IS LOCATED WITHIN 10 FEET OF THE ROOF EDGE, SUCH ROOF ACCESS OR ROOF EDGE SHALL BE PROTECTED BY GUARDS INSTALLED IN ACCORDANCE WITH IBC 2018, SECTION 1015.
- 15. 1015.6 MECHANICAL EQUIPMENT, SYSTEMS AND DEVICES. | 1015.7 ROOF ACCESS. GUARDS SHALL BE PROVIDED WHERE VARIOUS COMPONENTS THAT REQUIRE SERVICE ARE LOCATED WITHIN 10 FEET OF A ROOF EDGE. THE GUARD SHALL EXTEND NOT LESS THAN 30 INCHES BEYOND EACH END OF SUCH COMPONENTS. THE GUARD SHALL BE CONSTRUCTED SO AS TO PREVENT THE PASSAGE OF A SPHERE 21 INCHES IN DIAMETER. BASIS OF DESIGN - KEEGUARD SAFETY RAIL SYSTEM; SEE IMAGE 18/TH.G3.1
- 16. AT ALL ROOFTOP EQUIPMENT, ROOF HATCHES, ETC., PROVIDE TAPERED RIGID INSULATION SADDLE TO SLOPE AWAY AND AROUND FOR POSITIVE WATER FLOW.
- 17. PROVIDE ROOF WALK PADS AS REQUIRED TO ACCESS ALL ROOFTOP EQUIPMENT AND PENETRATIONS FROM ROOF HATCH. SEE WALKPAD DETAIL.

ROUND DOWNSPOUT

DASHED LINE INDICATES EXTENDING ROOF MEMBRANE UP WALL A MINIMUM OF 8" OR PER MANUFACTURER'S SPECIFICATIONS. REFER TO TYPICAL ROOF DETAIL ----

- SHEET FOR TERMINATION DETAILS. AT BRICK - MEMBRANE TO EXTEND UP THE EXTERIOR FACE OF BRICK W/ TERMINATION BAR AND COUNTERFLASHING IN THE GROUT JOINT OF BRICK, WITH SEALANT.
- AT SIDING MEMBRANE TO EXTEND UNDER EXTERIOR SHEATHING W/ COUNTERFLASHING.

CRICKET PLACED ON HIGH SIDE FOR POSITIVE DRAINAGE AROUND OBJECT (OR) IN LOW SIDE OF CORNER TO CREATE POSITIVE DRAINAGE

PROTECTION WALK PAD. PLACE AROUND PERIMETER OF ROOF HATCH

	THE CONTRACTOR SHALL CAREFULLY STUDY AND COMPARE THE REFLECTED CEILING PLANS
•	THE CONTRACTOR SHALL CARLI OLLI STODI AND COMPARE THE REFLECTED CLILING FLANS
	WITH THE ELECTRICAL LIGHTING PLANS, MECHANICAL PLANS, AND FIRE PROTECTION PLANS.
	WITH THE ELECTRICAL LIGHTING PLANS, MECHANICAL PLANS, AND FIRE PROTECTION PLANS.
	GENERAL CONTRACTOR SHALL REPORT TO THE ARCHITECT ANY ERROR, INCONSISTENCY OR
	GENERAL CONTRACTOR SHALL REPORT TO THE ARCHITECT ANT ERROR, INCONSISTENCT OR
	OMISSION THAT IS DISCOVERED.
	OMISSION THAT IS DISCOVERED.

REFLECTED CEILING PLAN NOTES

- 2. ALL SOFFITS AND CEILING HEIGHTS INDICATED SHALL BE MEASURED FROM BOTTOM OF FINISH MATERIAL TO FINISH FLOOR ELEVATION DIRECTLY BELOW.
- 3. ALL DIMENSIONS SHOWN ON REFLECTED CEILING PLANS ARE FINISHED DIMENSIONS.
- THE CONTRACTOR SHALL VERIFY THAT ACCESS PANELS OF APPROPRIATE SIZE AND TYPE ARE INSTALLED IN GYPSUM BOARD CEILING ASSEMBLIES, SOFFITS, AND IN OTHER NON-ACCESSIBLE TYPE AREAS WHERE ACCESS, SERVICE OR ADJUSTMENT TO MECHANICAL, PLUMBING OR ELECTRICAL ITEMS MAY BE REQUIRED. ACCESS PANELS SHALL BE FIRE RATED EQUAL TO ANY RATING OF THE CEILING OR SOFFIT IN WHICH THEY OCCUR.
- ONLY CEILING MOUNTED EXIT LIGHTING IS SHOWN ON THE REFLECTED CEILING PLANS. SEE
- ELECTRICAL DRAWINGS FOR LOCATIONS OF WALL MOUNTED EXIT LIGHTING. SEE THE ELECTRICAL DRAWINGS AND / OR THE COMMUNICATIONS DRAWINGS FOR
- LOCATIONS OF CEILING MOUNTED SMOKE DETECTORS, SPEAKERS, FIRE ALARM DEVICES, ETC. 7. CONTRACTOR TO COORDINATE WITH ARCHITECT AND OWNER ALL FIXTURE SELECTIONS AND FINISHES PRIOR TO INSTALLATION.
- 8. COORDINATE WITH APPLICABLE NOTES AND DIMENSIONS ON OTHER SHEETS.
- EXTEND GYPSUM BOARD WALL CONSTRUCTION TO UNDERSIDE OF ROOF / FLOOR DECK IN AREAS WITHOUT FINISHED CEILINGS TYPICAL.
- 10. SEE FIRE PROTECTION SHEETS FOR SPRINKLER HEAD LOCATIONS.
- 11. PROVIDE STRUCTURAL SUPPORT FOR CEILING MOUNTED EQUIPMENT AS REQUIRED.
- 12. ALL GYPSUM BOARD CEILINGS IN WET AREAS SHALL BE MOISTURE RESISTANT GYPSUM BOARD 13. PROVIDE CEILING CONTROL JOINTS AS INDICATED. ALL CEILINGS OVER 900 SF TO RECEIVE
- PERIMETER RELIEF JOINTS. 14. ALL CEILINGS IN WET AREAS TO BE MOISTURE RESISTANT GYP. BOARD.
- 15. ALL CEILINGS IN LIVING UNITS TO BE HELD TIGHT TO UNDERSIDE OF STRUCTURE UNLESS NOTED OTHERWISE.
- 16. COORDINATE LOCATIONS OF FIRE ALARMS, SMOKE DETECTORS WITH LIGHT FIXTURES, HVAC DIFFUSERS / RETURNS AND SPRINKLER HEADS.
- 17. CENTER SINGLE LIGHT FIXTURES IN LIVING UNIT WITH ROOM, UNLESS NOTED OTHERWISE.
- 18. REFER TO ELECTRICAL PLAN FOR ATTIC LIGHTING.
- 19. FLOOR/ CEILING ASSEMBLIES TO MEET A MINIMUM STC RATING OF 50. TYPE X GYPSUM BOARD REQUIRED FOR ALL CEILINGS BETWEEN UNITS.

BLDG 7 - ROOF DRAIN CALCS

MAIN "FLAT" ROOF (SPLIT IN 3 AREAS FOR DRAINAGE CALCS) AREA 2: 328 SF AREA 3: 644 SF

ENTRANCE ROOF OVERHANGS AREA 4: 132 SF + AREA 2 = 460 SF AREA 5: 49 SF

FIGURE 1106.1 (EASTERN UNITED STATES) KNOXVILLE, TENNESSEE FALLS APPROX. ON THE 3.25"

(ROUNDED UP TO 4.0" PER ENGINEERS RECOMMENDATION) RAINFALL CONVERSION DATA 4.0" RAINFALL = .0416 G.P.M. PER S.F. (MULTIPLIER TO USE) 924 SF x .0416 = 38.4 gpm

AREA 2: 328 SF x .0416 = 13.6 gpmAREA 3: 644 SF x .0416 = 26.8 gpmAREA 4: 460 SF x .0416 = 19.1 gpmAREA 5: 49 SF x .0416 = 2.0 gpm

FIGURE 1106.3 (VERTICAL LEADER SIZING) 3" ROUND DOWNSPOUTS ARE SHOWN TO MEET SIZE AND QUANTITY REQUIREMENTS

FIGURE 1106.6 (HORIZONTAL GUTTER SIZING) • STREET ENTRANCE CANOPY = 5" HALF ROUND GUTTER AT 1/8" SLOPE SHOWN TO MEET SIZE AND SLOPE REQUIREMENTS

ALL OTHER ROOFS = 5" BOX GUTTER AT 1/4" SLOPE SHOWN TO MEET SIZE AND SLOPE REQUIREMENTS

** CALCULATIONS TAKEN FROM INTERNATIONAL PLUMBING CODE 2018, SECTION 1105 & 1106 FOR ROOF DRAINS, SIZE OF CONDUCTORS, LEADERS AND STORM DRAINS

**CONTRACTOR TO VERIFY SQUARE FOOTAGES FOR PRICING. AREAS SHOWN ARE FOR CODE DRAINAGE CALCULATIONS ONLY.

REFLECTED CEILING PLAN LEGEND

SURFACE MOUNTED LIGHT FIXTURE (CEILING)

WALL OR CEILING MOUNTED FIXTURE (SEE PLAN FOR MOUNTING TYPE)

CEILING FAN W/ INTEGRAL LIGHT FIXTURE

SOFFIT / CANOPY RECESSED SLOT FIXTURE

(5/8" TYPE X GYP. BD. ON 7/8" HAT CHANNELS

 \pm 9'-0" A.F.F. = LIVING, KITCHEN, BEDROOMS

 \pm 8'-0" A.F.F. = CLOSETS, BATHROOMS, HALLS

(5/8" TYPE X GYP. BD. ON 2X FRAMING TO ACHEIVE

'STREET SIDE" ENTRANCE CANOPY = METAL SOFFIT -

'PARKING SIDE" BACK ENTRANCE & SOFFITS -

SMOOTH FIBER CEMENT SOFFIT; PAINTED

HVAC SUPPLY DIFFUSER (CEILING)

HVAC RETURN GRILLE (THRU-WALL)

EXIT SIGN - REFER TO ELECTRICAL PLANS

CEILING MOUNTED SPRINKLER HEAD

WALL MOUNTED SPRINKLER HEAD

EMERGENCY LIGHT - REFER TO ELECTRICAL PLANS

LONGBOARD - COLOR: DARK CHERRY; 6" V-GROOVE

GYPSUM BOARD CEILING -- PAINTED


FASTENED TO UNDERSIDE OF TRUSSES.

SOFFIT FOR DUCTS, PIPING, ETC.)

EXHAUST FAN

SMOKE DETECTOR


PENDANT LIGHT FIXTURE

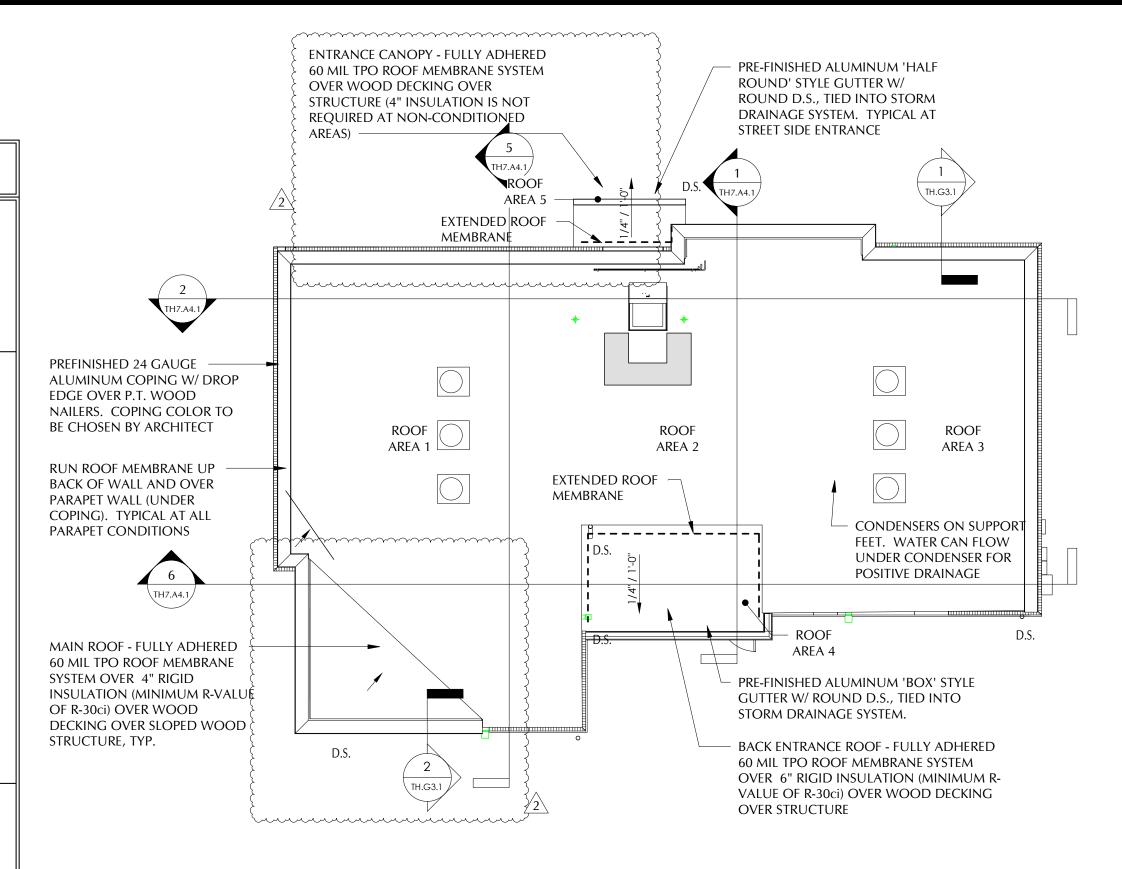

BUILDING SECTIONS SHOWN ON


ROOF PLAN ONLY FOR CLARITY

4 BUILDING 7 - ROOF PLAN

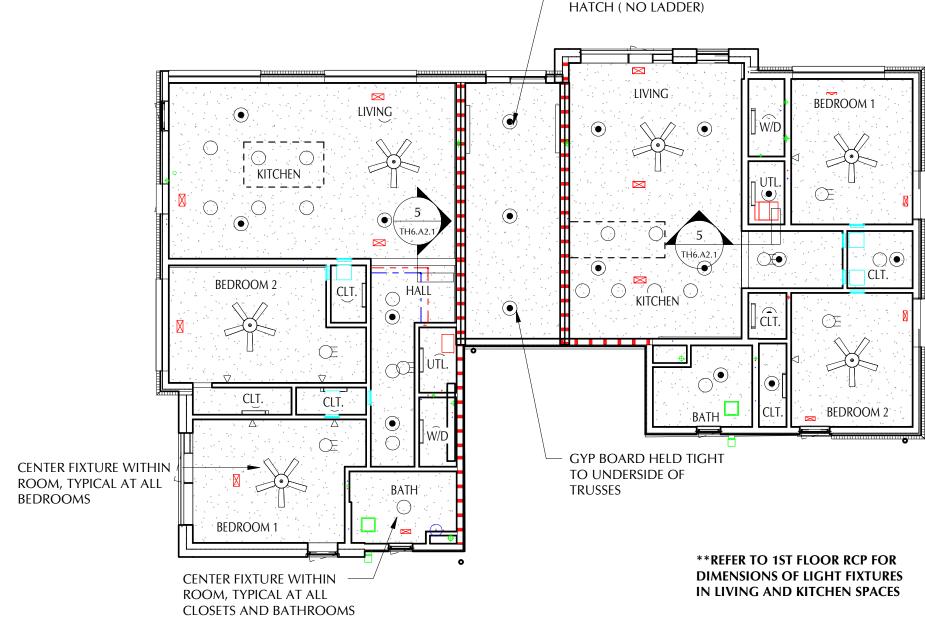


LOCKABLE ROOF ACCESS

3 BUILDING 7 - 3RD FLOOR RCP 1/8" = 1'-0"

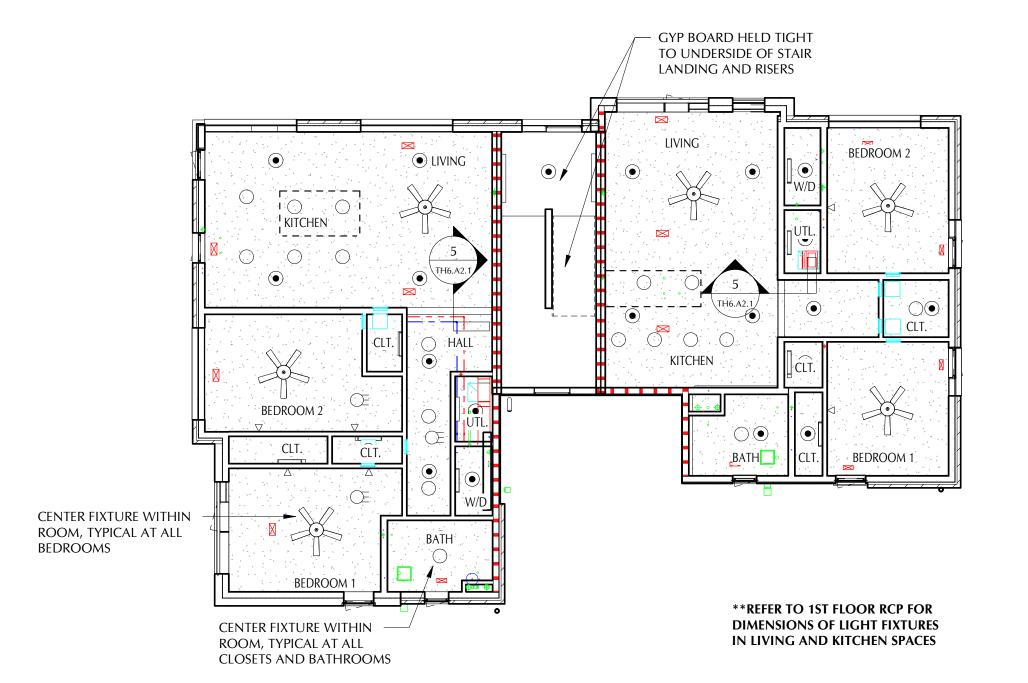

2 BUILDING 7 - 2ND FLOOR RCP

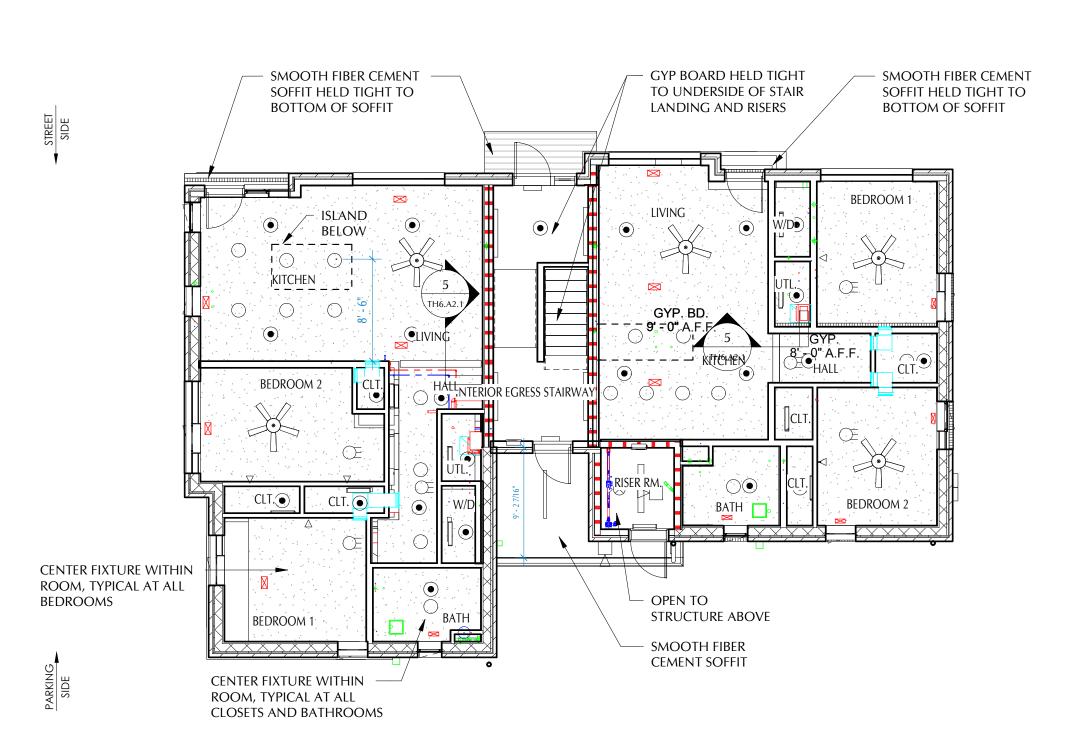

1 BUILDING 7 - 1ST FLOOR RCP

KCDC KNOXVILLE'S COMMUNITY DEVELOPMENT CORPORATION AUSTIN HOMES REDEVELOPMENT

PHASE 1A

BURGE DRIVE AND HARRIET TUBMAN ST.



2240 Sutherland Avenue Suite 105 Knoxville, TN 37919 United States

11 East Madison Street Suite 300 Chicago, IL 60602 United States

Fax 312.456.0124

Tel 312.456.0123

Description 2 5/26/20 ADDENDUM 1



Seal / Signature

AUSTIN HOMES - PHASE 1A


05/06/2020


Project Number 193076

Description BUILDING 7 - REFLECTED CEILING PLAN, ROOF PLAN & NOTES

As indicated

TH7.A2.1

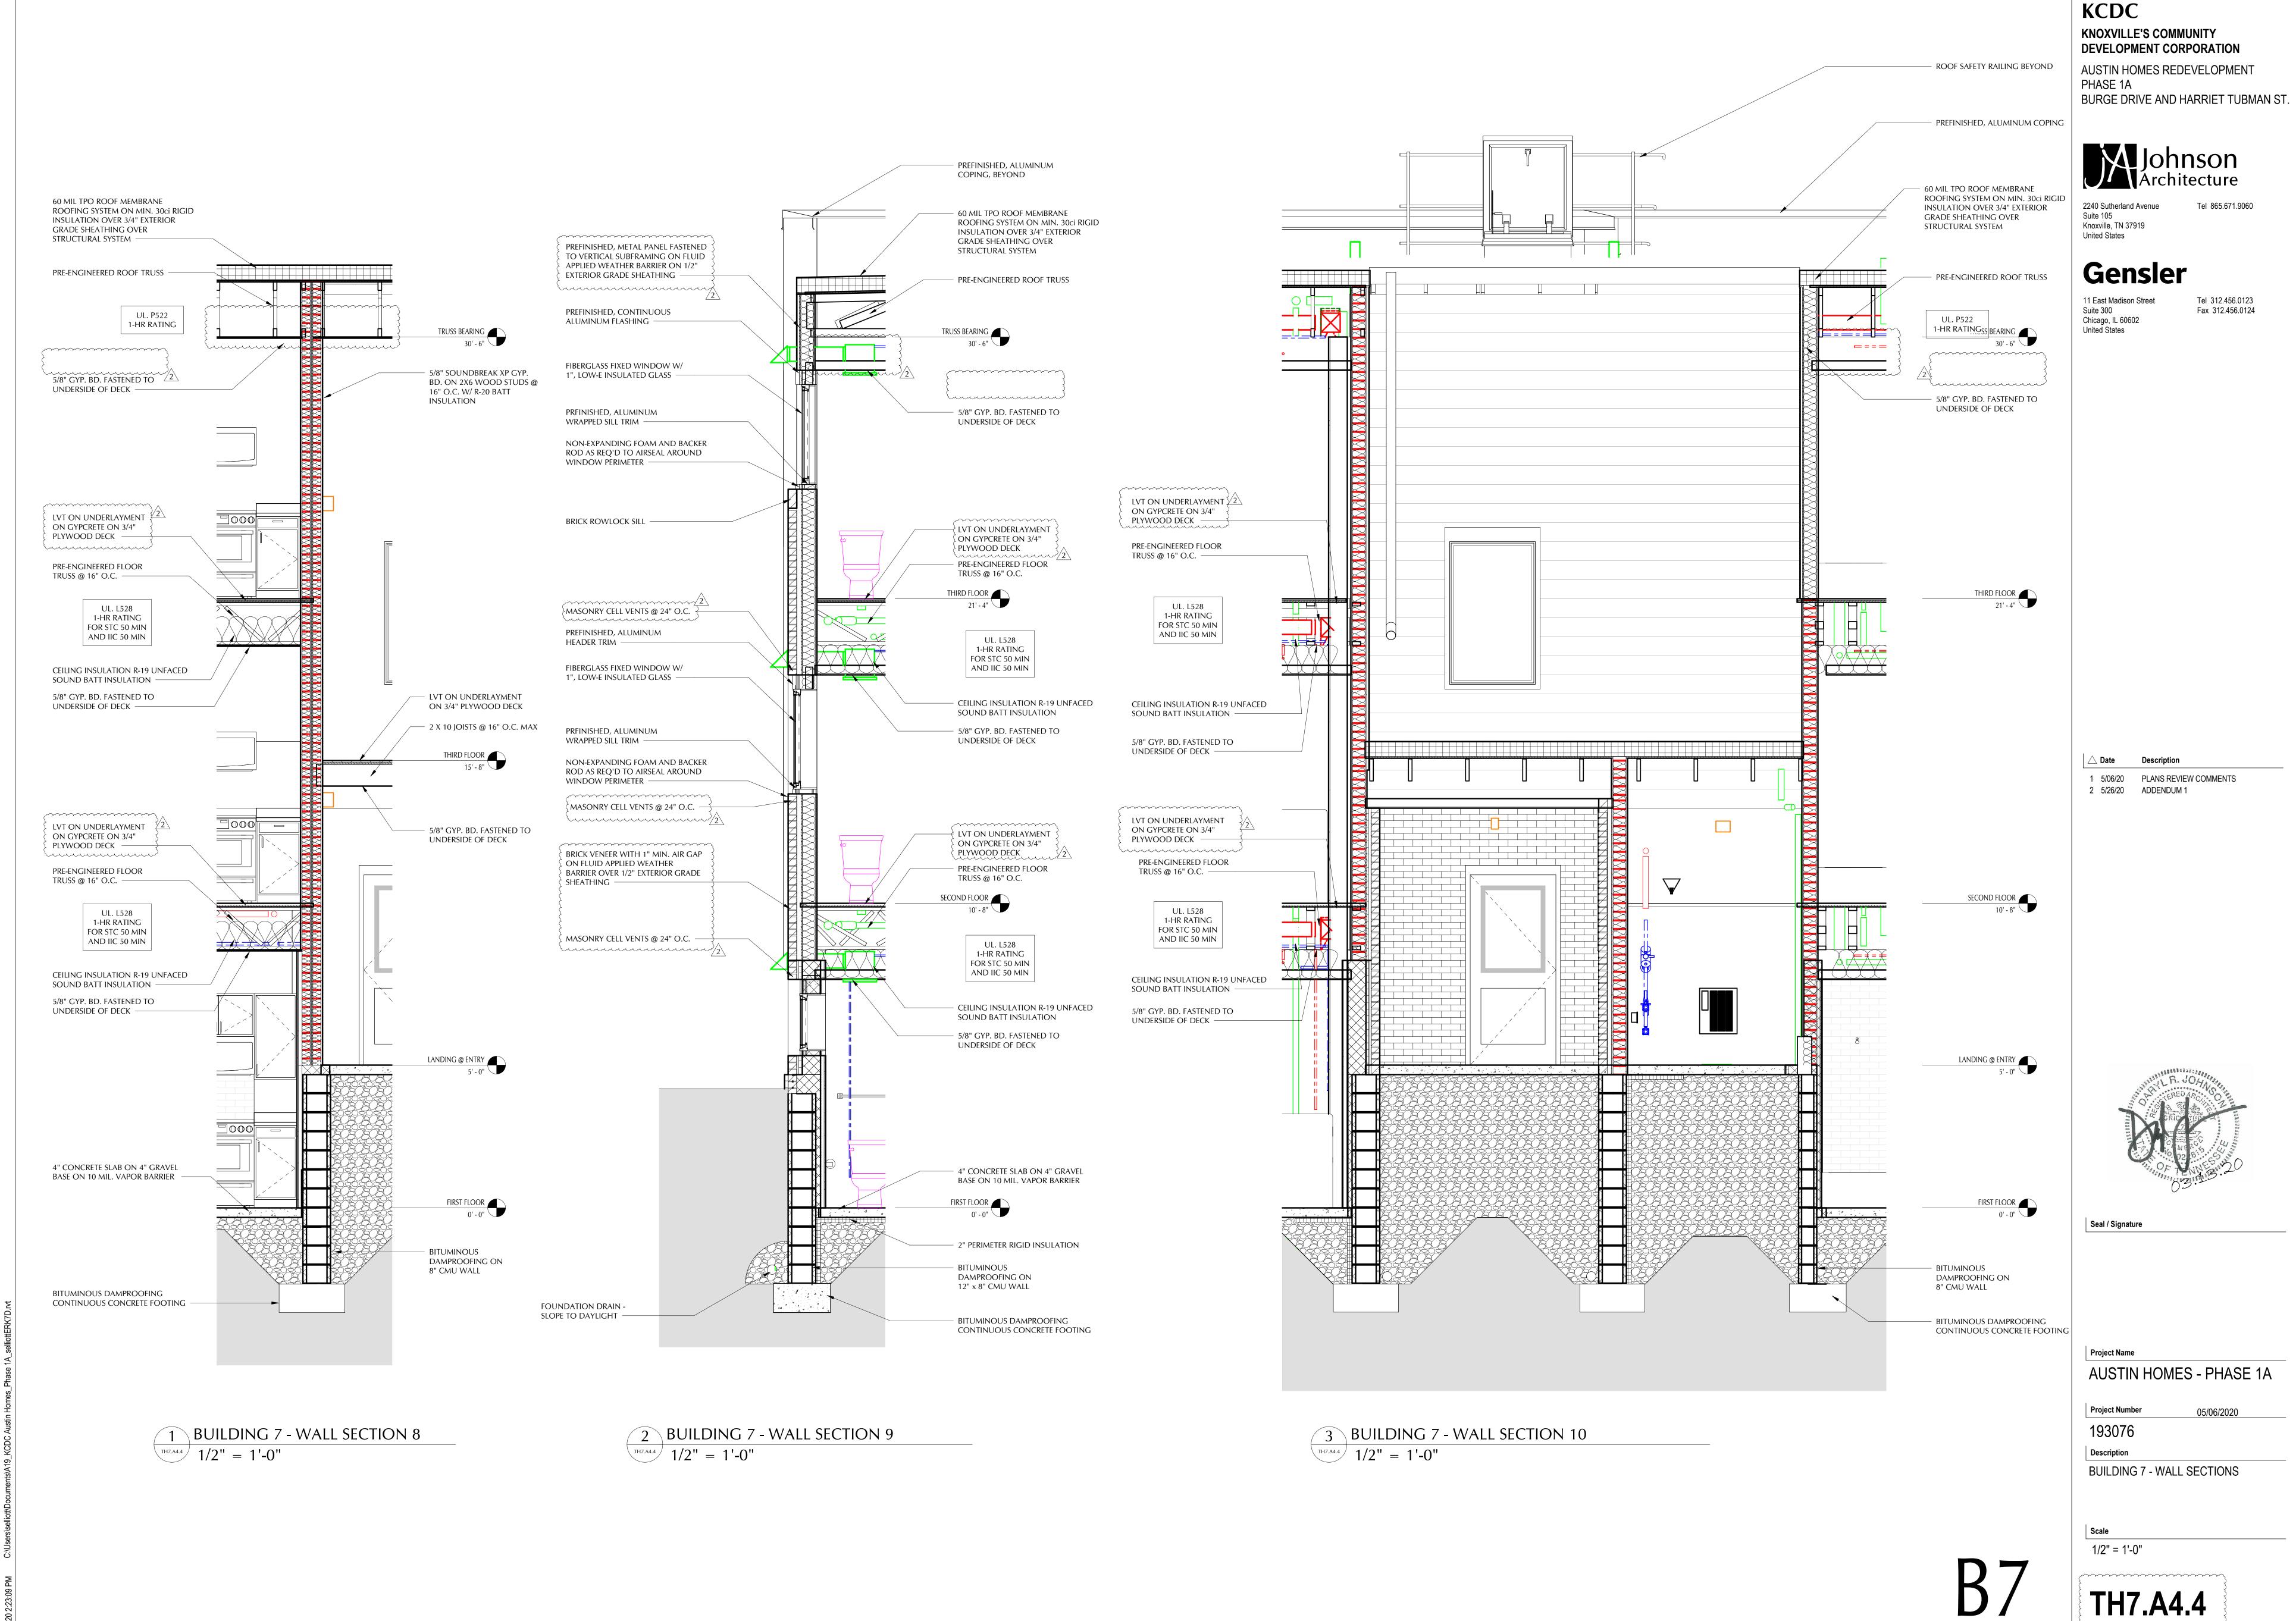

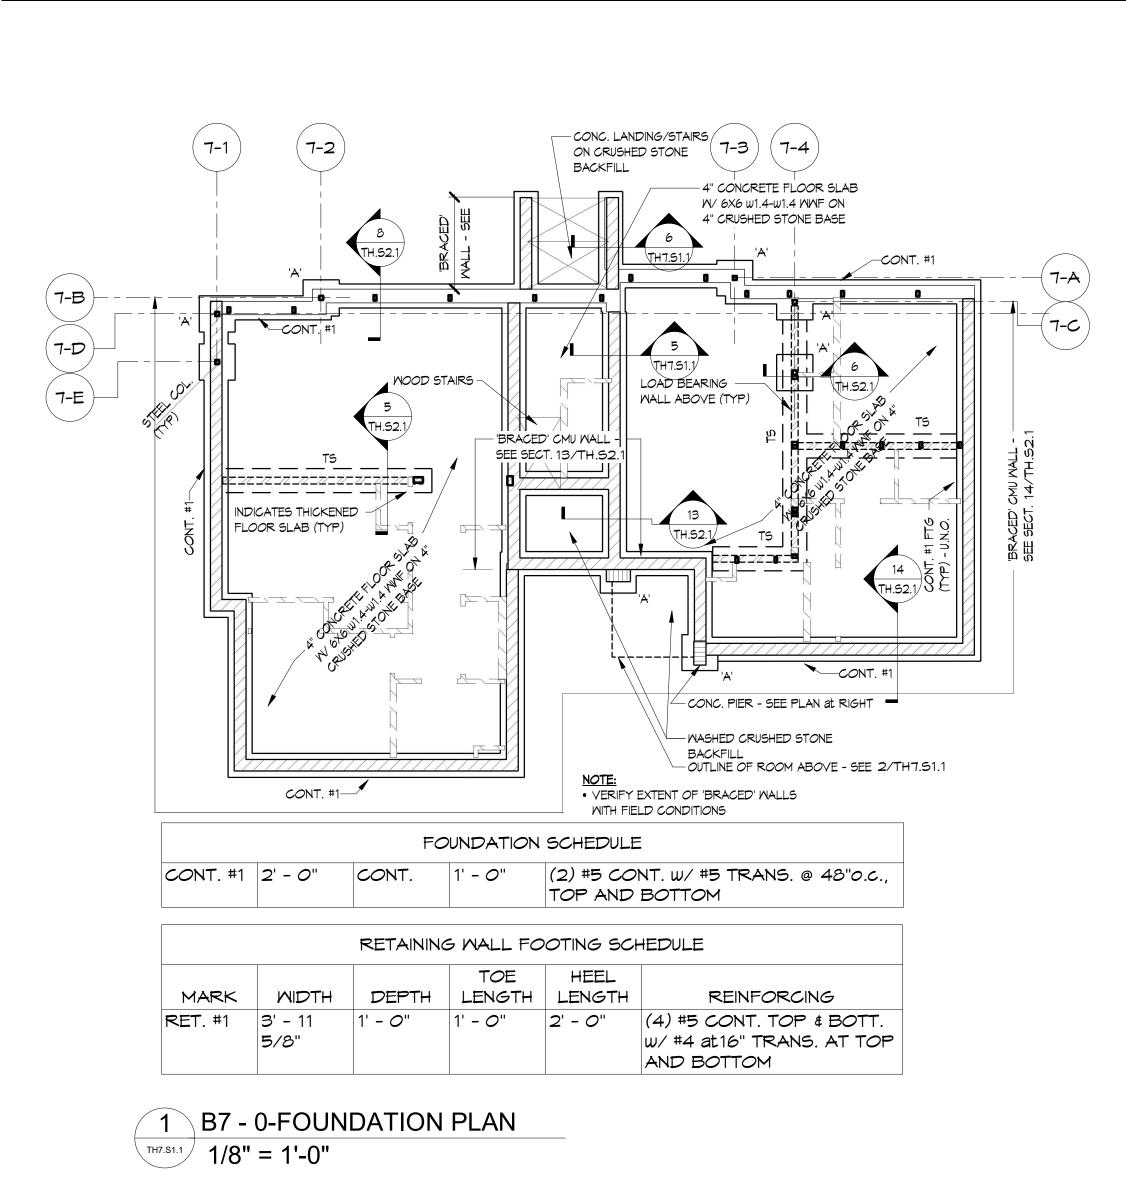

(7-2)

4 B7 - ROOF FRAMING PLAN

TH7.S1.1 1/8" = 1'-0"

(7-1)

(7-B)

(7-D)

(7-E)

(7-3)

P.E. MOOD ROOF
TRUSS at 24"oc

• ALL LOAD BEARING WALLS TO BE 2X6 AT 16"OC STUD

• MINIMUM ROOF TRUSS DEPTH AT LOW END = 24" and SLOPE at 1/4" FT COORDINATE WITH ARCHITECTURAL

• COORDINATE LAY-OUT OF ROOF TRUSS with ROOF


• ALL LINTES at NON-LOAD BEARING WALLS TO BE (2)

HATCH AND MECHANICAL UNITS

HEADER TRUSS


-GIRDER TRUSS


- ROOF BELOW -

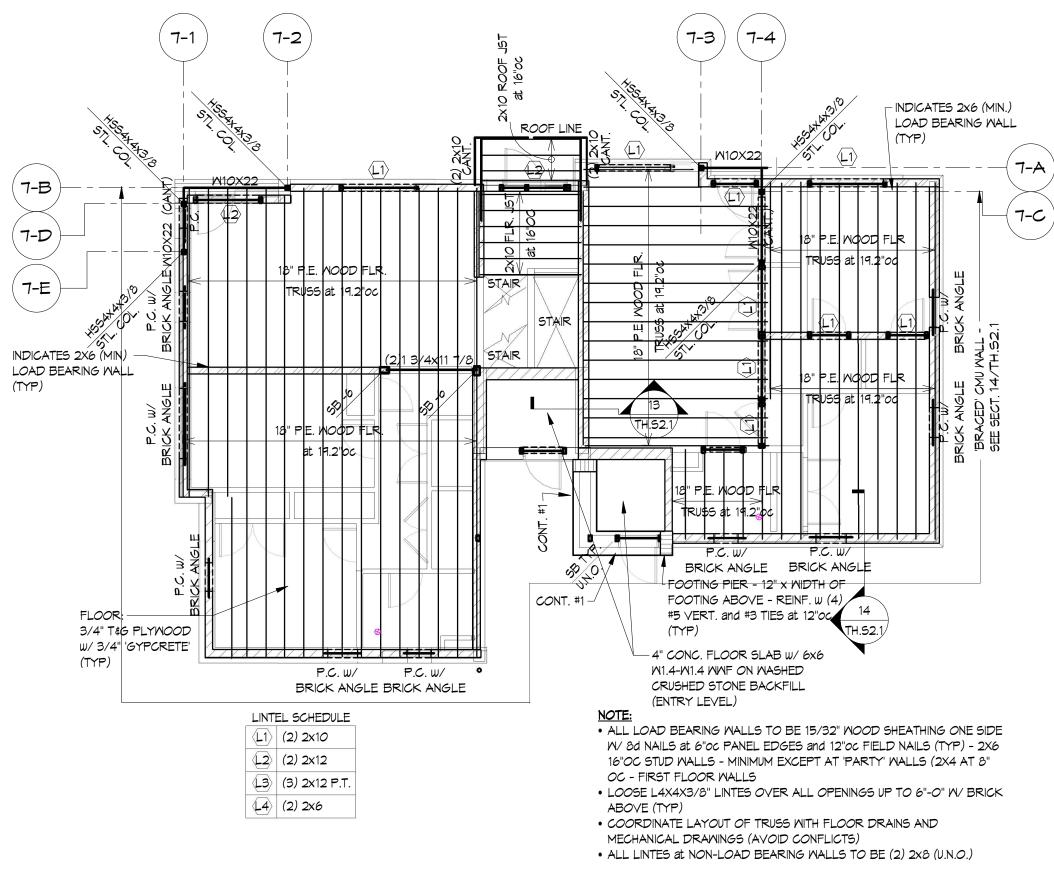


2 B7 - 2ND FLOOR FRAMING PLAN

1/8" = 1'-0"

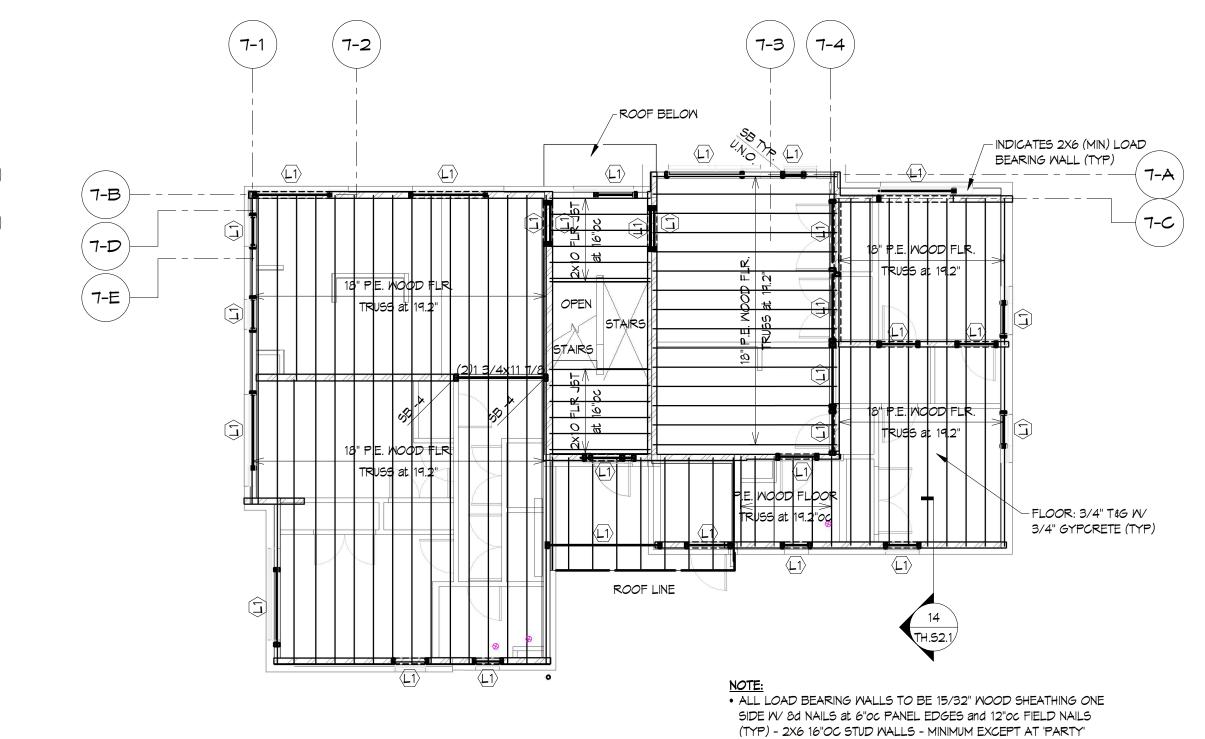

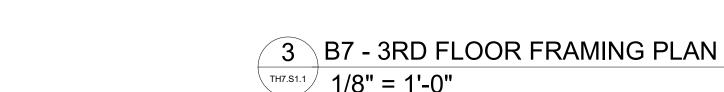

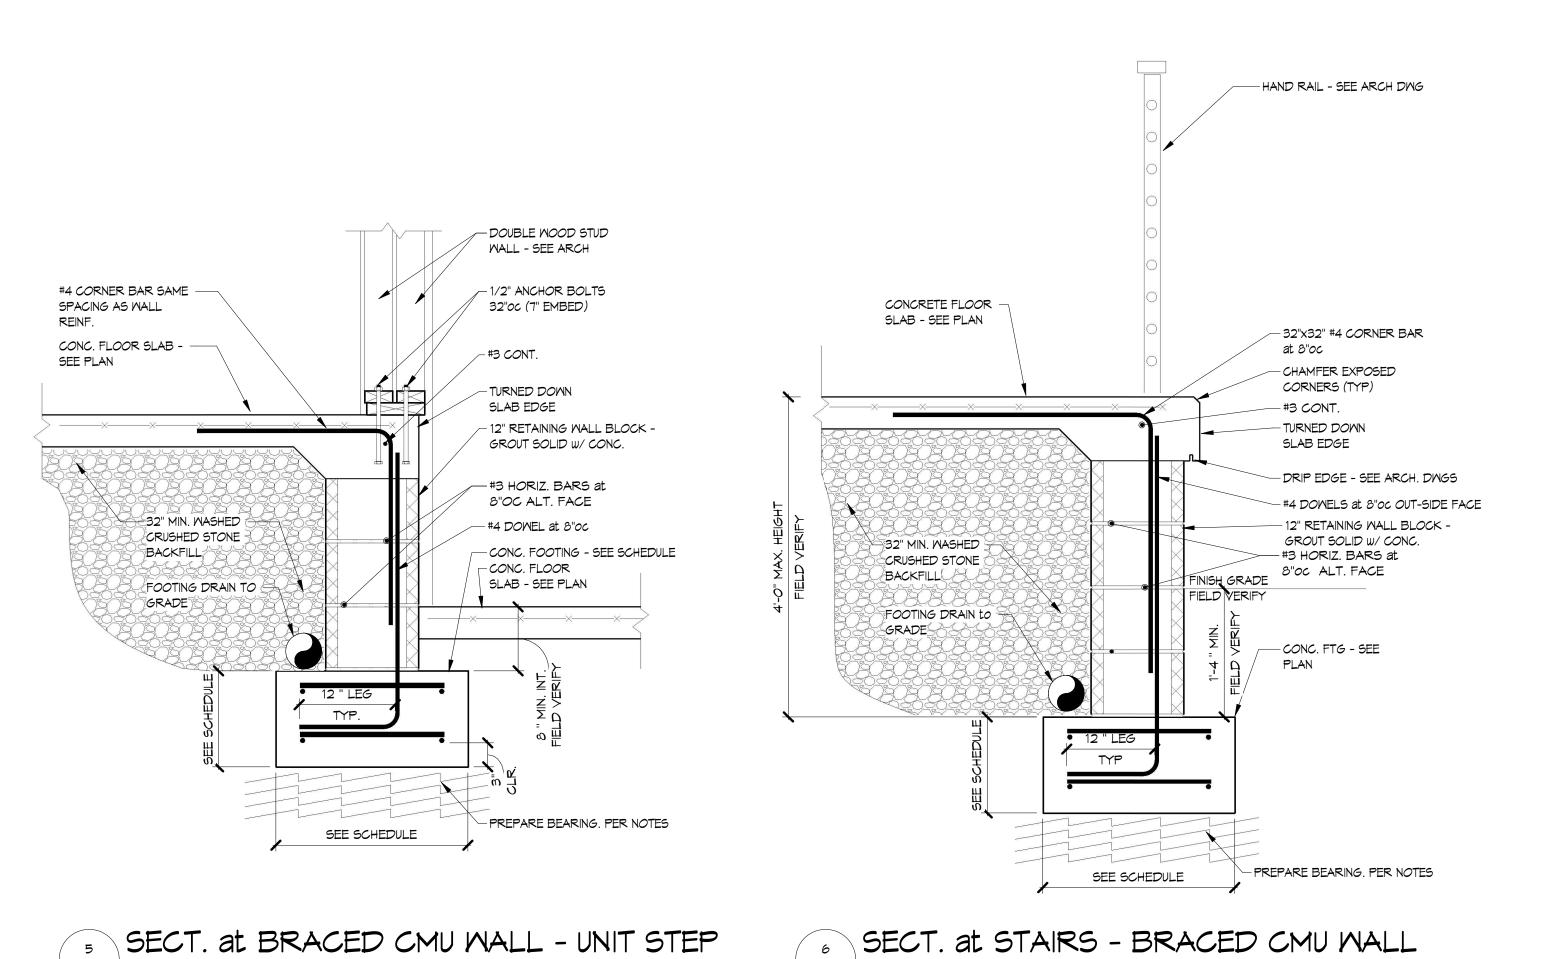

REVISION 2 = • REVISED FOUNDATION/FRAMING BASED ON REVISED GRADING PLAN. MINOR REVISIONS TO UNIT FRAMING PLANS FOR ADA COMPLIANCE

MALLS (2X4 AT 8" OC - FIRST FLOOR WALLS

BRICK ABOVE (TYP)

• LOOSE L4X4X3/8" LINTES OVER ALL OPENINGS UP TO 6"-O" W

MECHANICAL DRAWINGS (AVOID CONFLICTS)

• ALL LINTES at NON-LOAD BEARING WALLS TO BE (2) 2x8 (U.N.O.)

• COORDINATE LAYOUT OF TRUSS WITH FLOOR DRAINS AND

∆ Date Description 2 5.22.2020 Revision 2

KCDC

901 N Boardway

Knoxville, TN 37917

Tel: 865-403-1100

2240 Sutherland Avenue

Gensler

> PARTNERS

11 East Madison Street

Chicago, IL 60602 United States

502 Union Avenue Knoxville, TN 37902

United States Tel 865.524.777

Knoxville, TN 37919

United States

Suite 105

Suite 300

Corporation

Knoxville Community Development

Tel 865.671.9060

Tel 312.456.0123

Fax 312.456.0124



Seal / Signature

小ゆら06 2020


Project Name

AUSTIN HOMES - PHASE 1A


Project Number 193076

BLDG 7 STRUCTURAL PLANS


As indicated

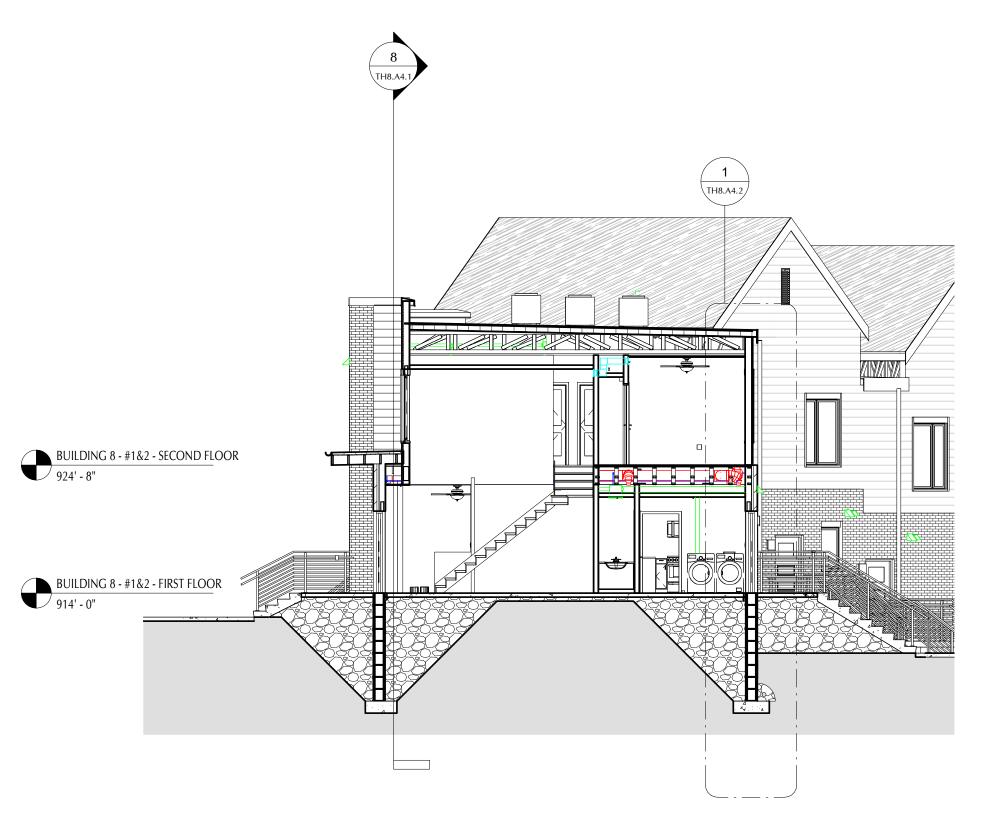


1 BUILDING 8 - BUILDING SECTION 1 1/8" = 1'-0"

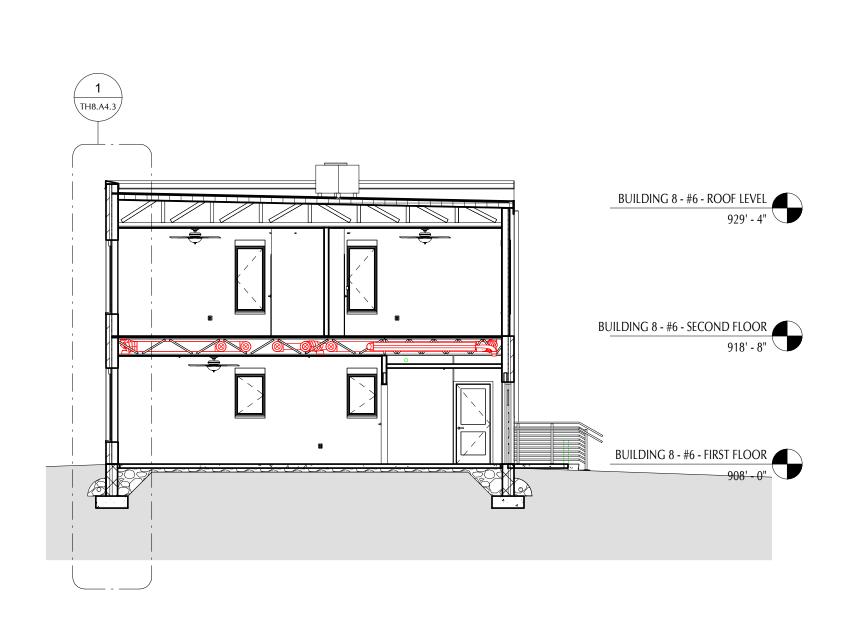


4 BUILDING 8 - BUILDING SECTION 4 TH8.A4.1 1/8" = 1'-0"

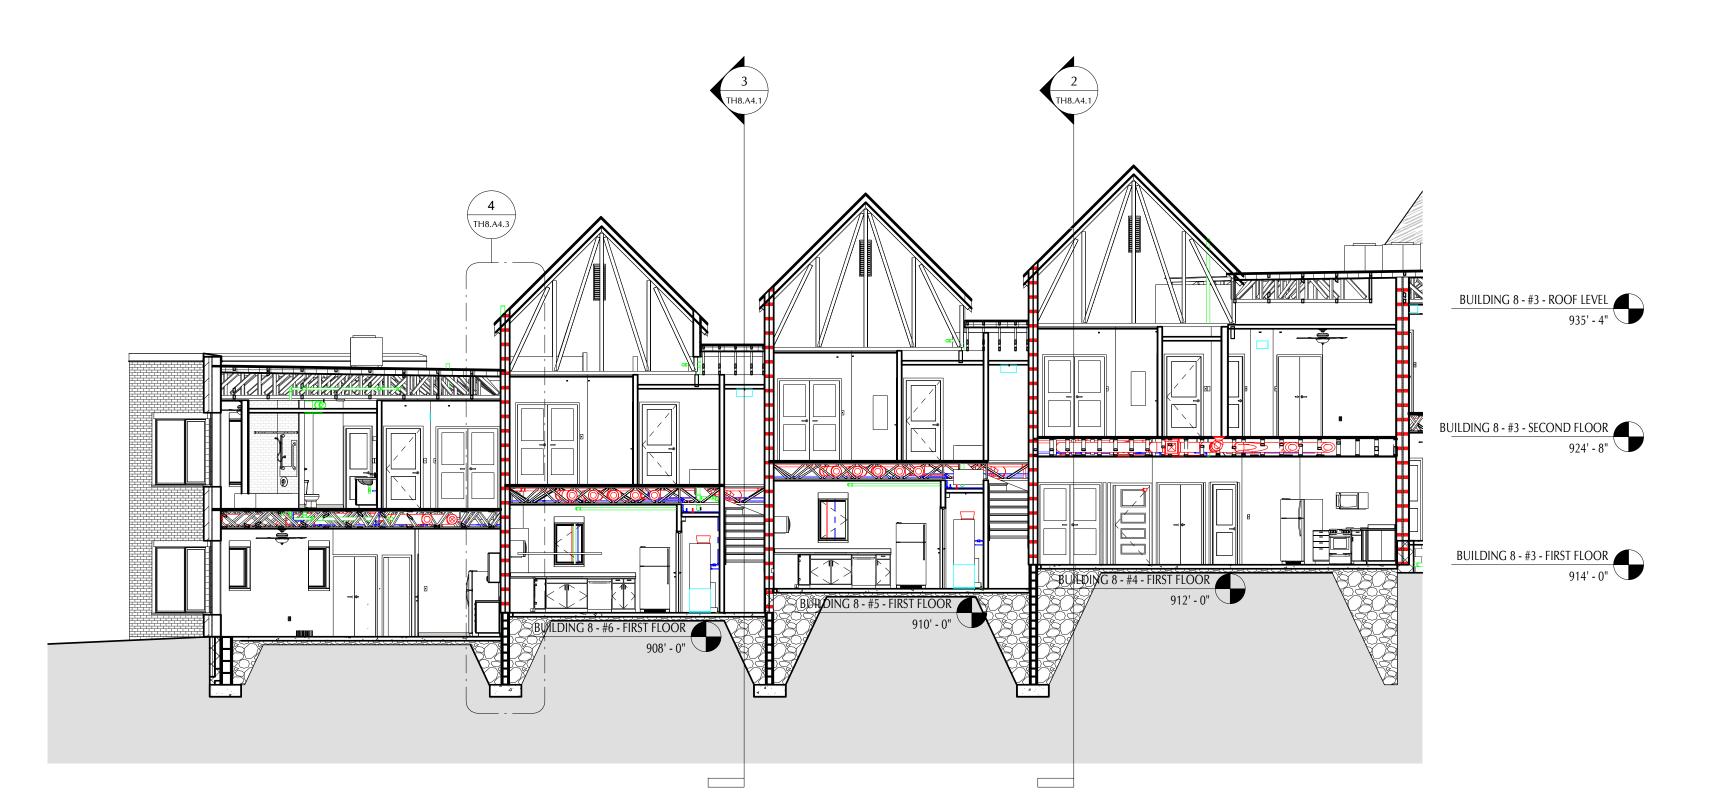


7 BUILDING 8 - BUILDING SECTION 7 1/8" = 1'-0"

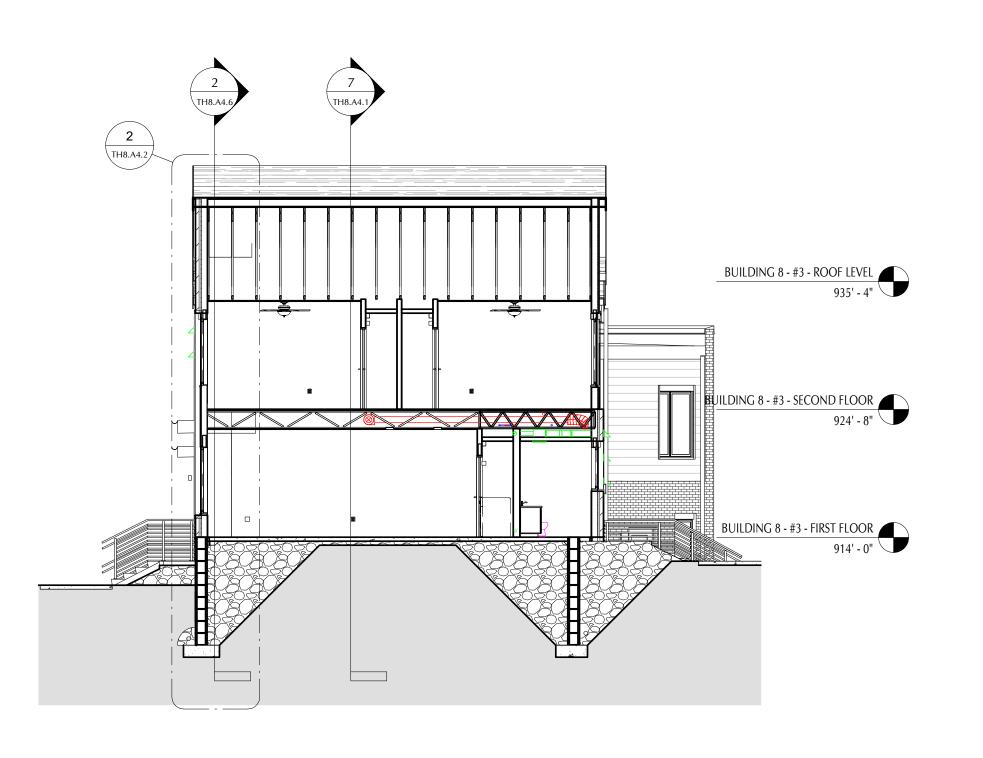


BUILDING 8 - BUILDING SECTION 2 1/8" = 1'-0"

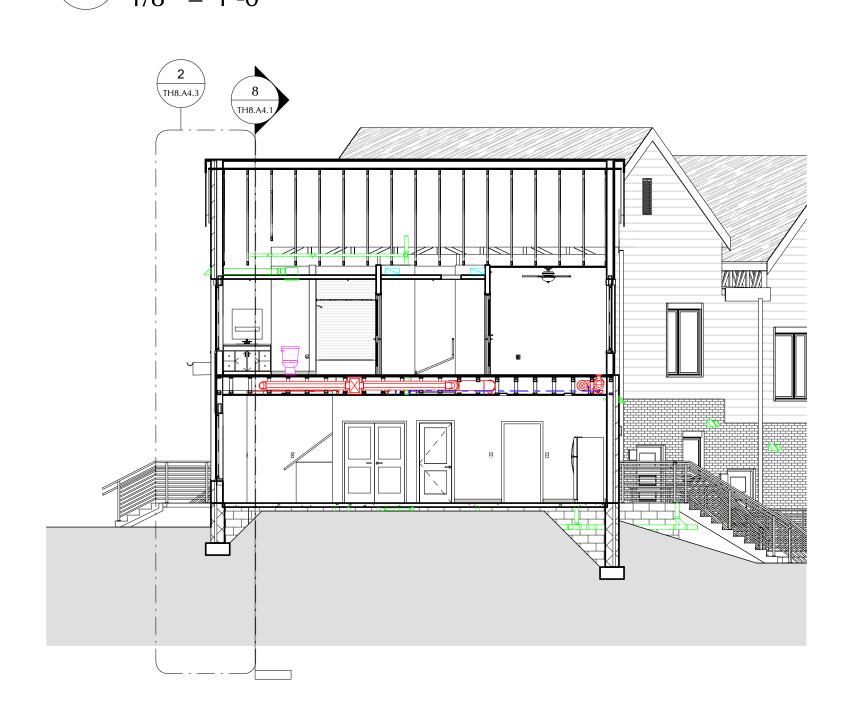


5 BUILDING 8 - BUILDING SECTION 5 TH8.A4.1 1/8" = 1'-0"

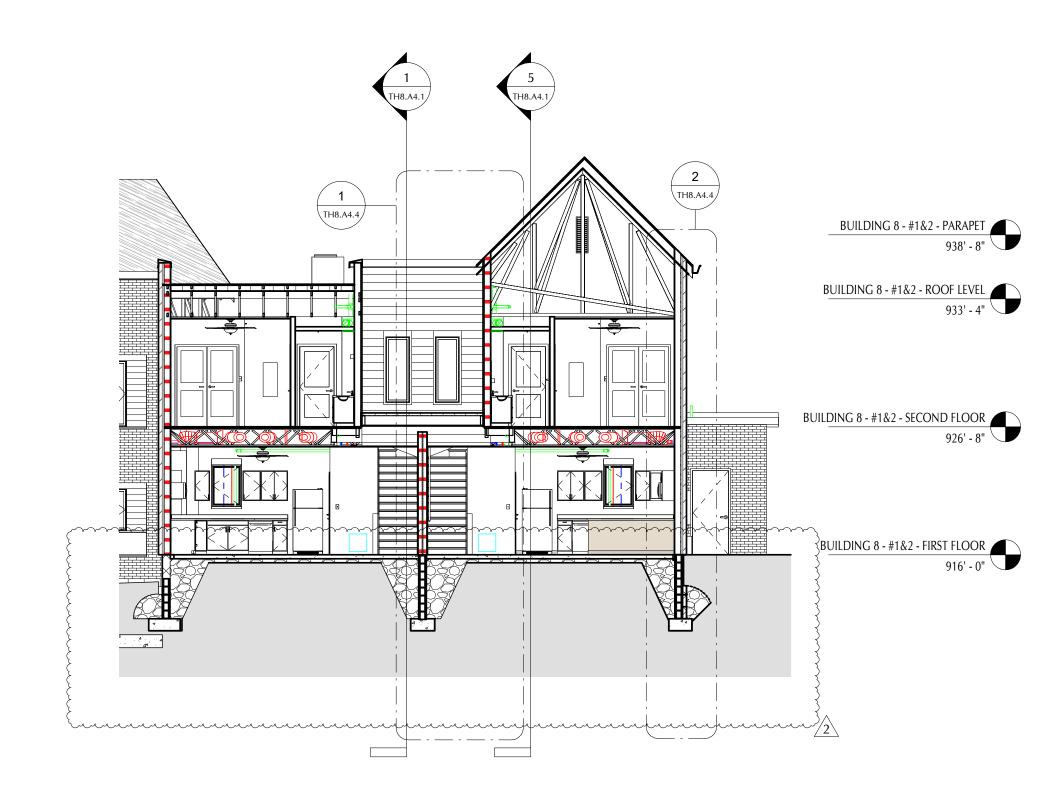

8 BUILDING 8 - BUILDING SECTION 8 1/8" = 1'-0"

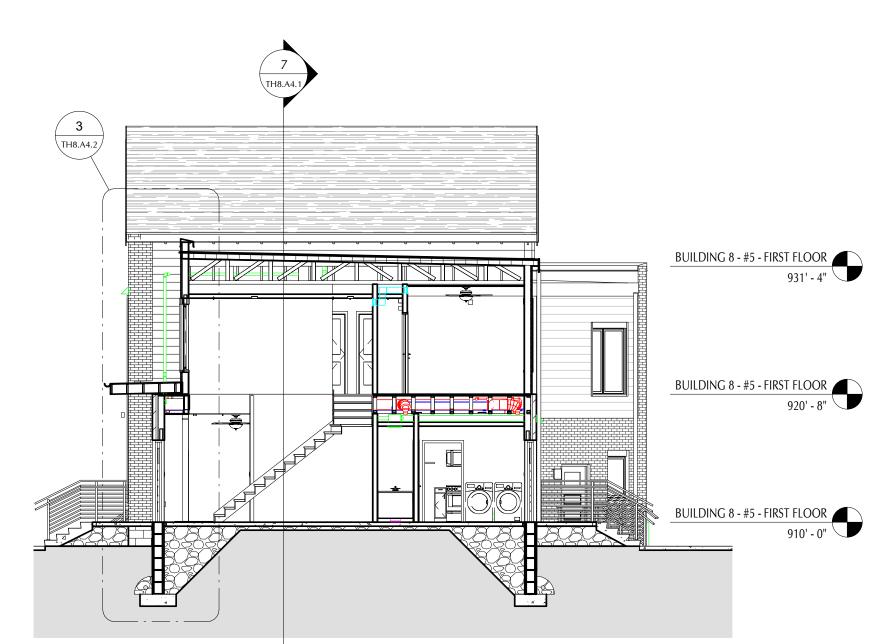

3 BUILDING 8 - BUILDING SECTION 3 1/8" = 1'-0"

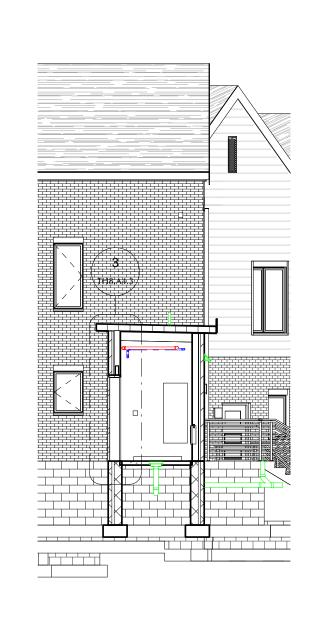

6 BUILDING 8 - BUILDING SECTION 6 1/8" = 1'-0"



KCDC KNOXVILLE'S COMMUNITY **DEVELOPMENT CORPORATION**

AUSTIN HOMES REDEVELOPMENT PHASE 1A BURGE DRIVE AND HARRIET TUBMAN ST.




2240 Sutherland Avenue Suite 105 Knoxville, TN 37919 United States

Gensler

11 East Madison Street Suite 300 Chicago, IL 60602 United States Tel 312.456.0123 Fax 312.456.0124

1 5/06/20 PLANS REVIEW COMMENTS 2 5/26/20 ADDENDUM 1

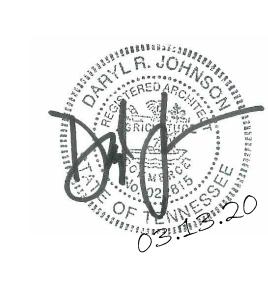

Seal / Signature


Project Name AUSTIN HOMES - PHASE 1A

Project Number 05/06/2020 193076

BUILDING 8 - BUILDING SECTIONS

1/8" = 1'-0"

TH8.A4.1

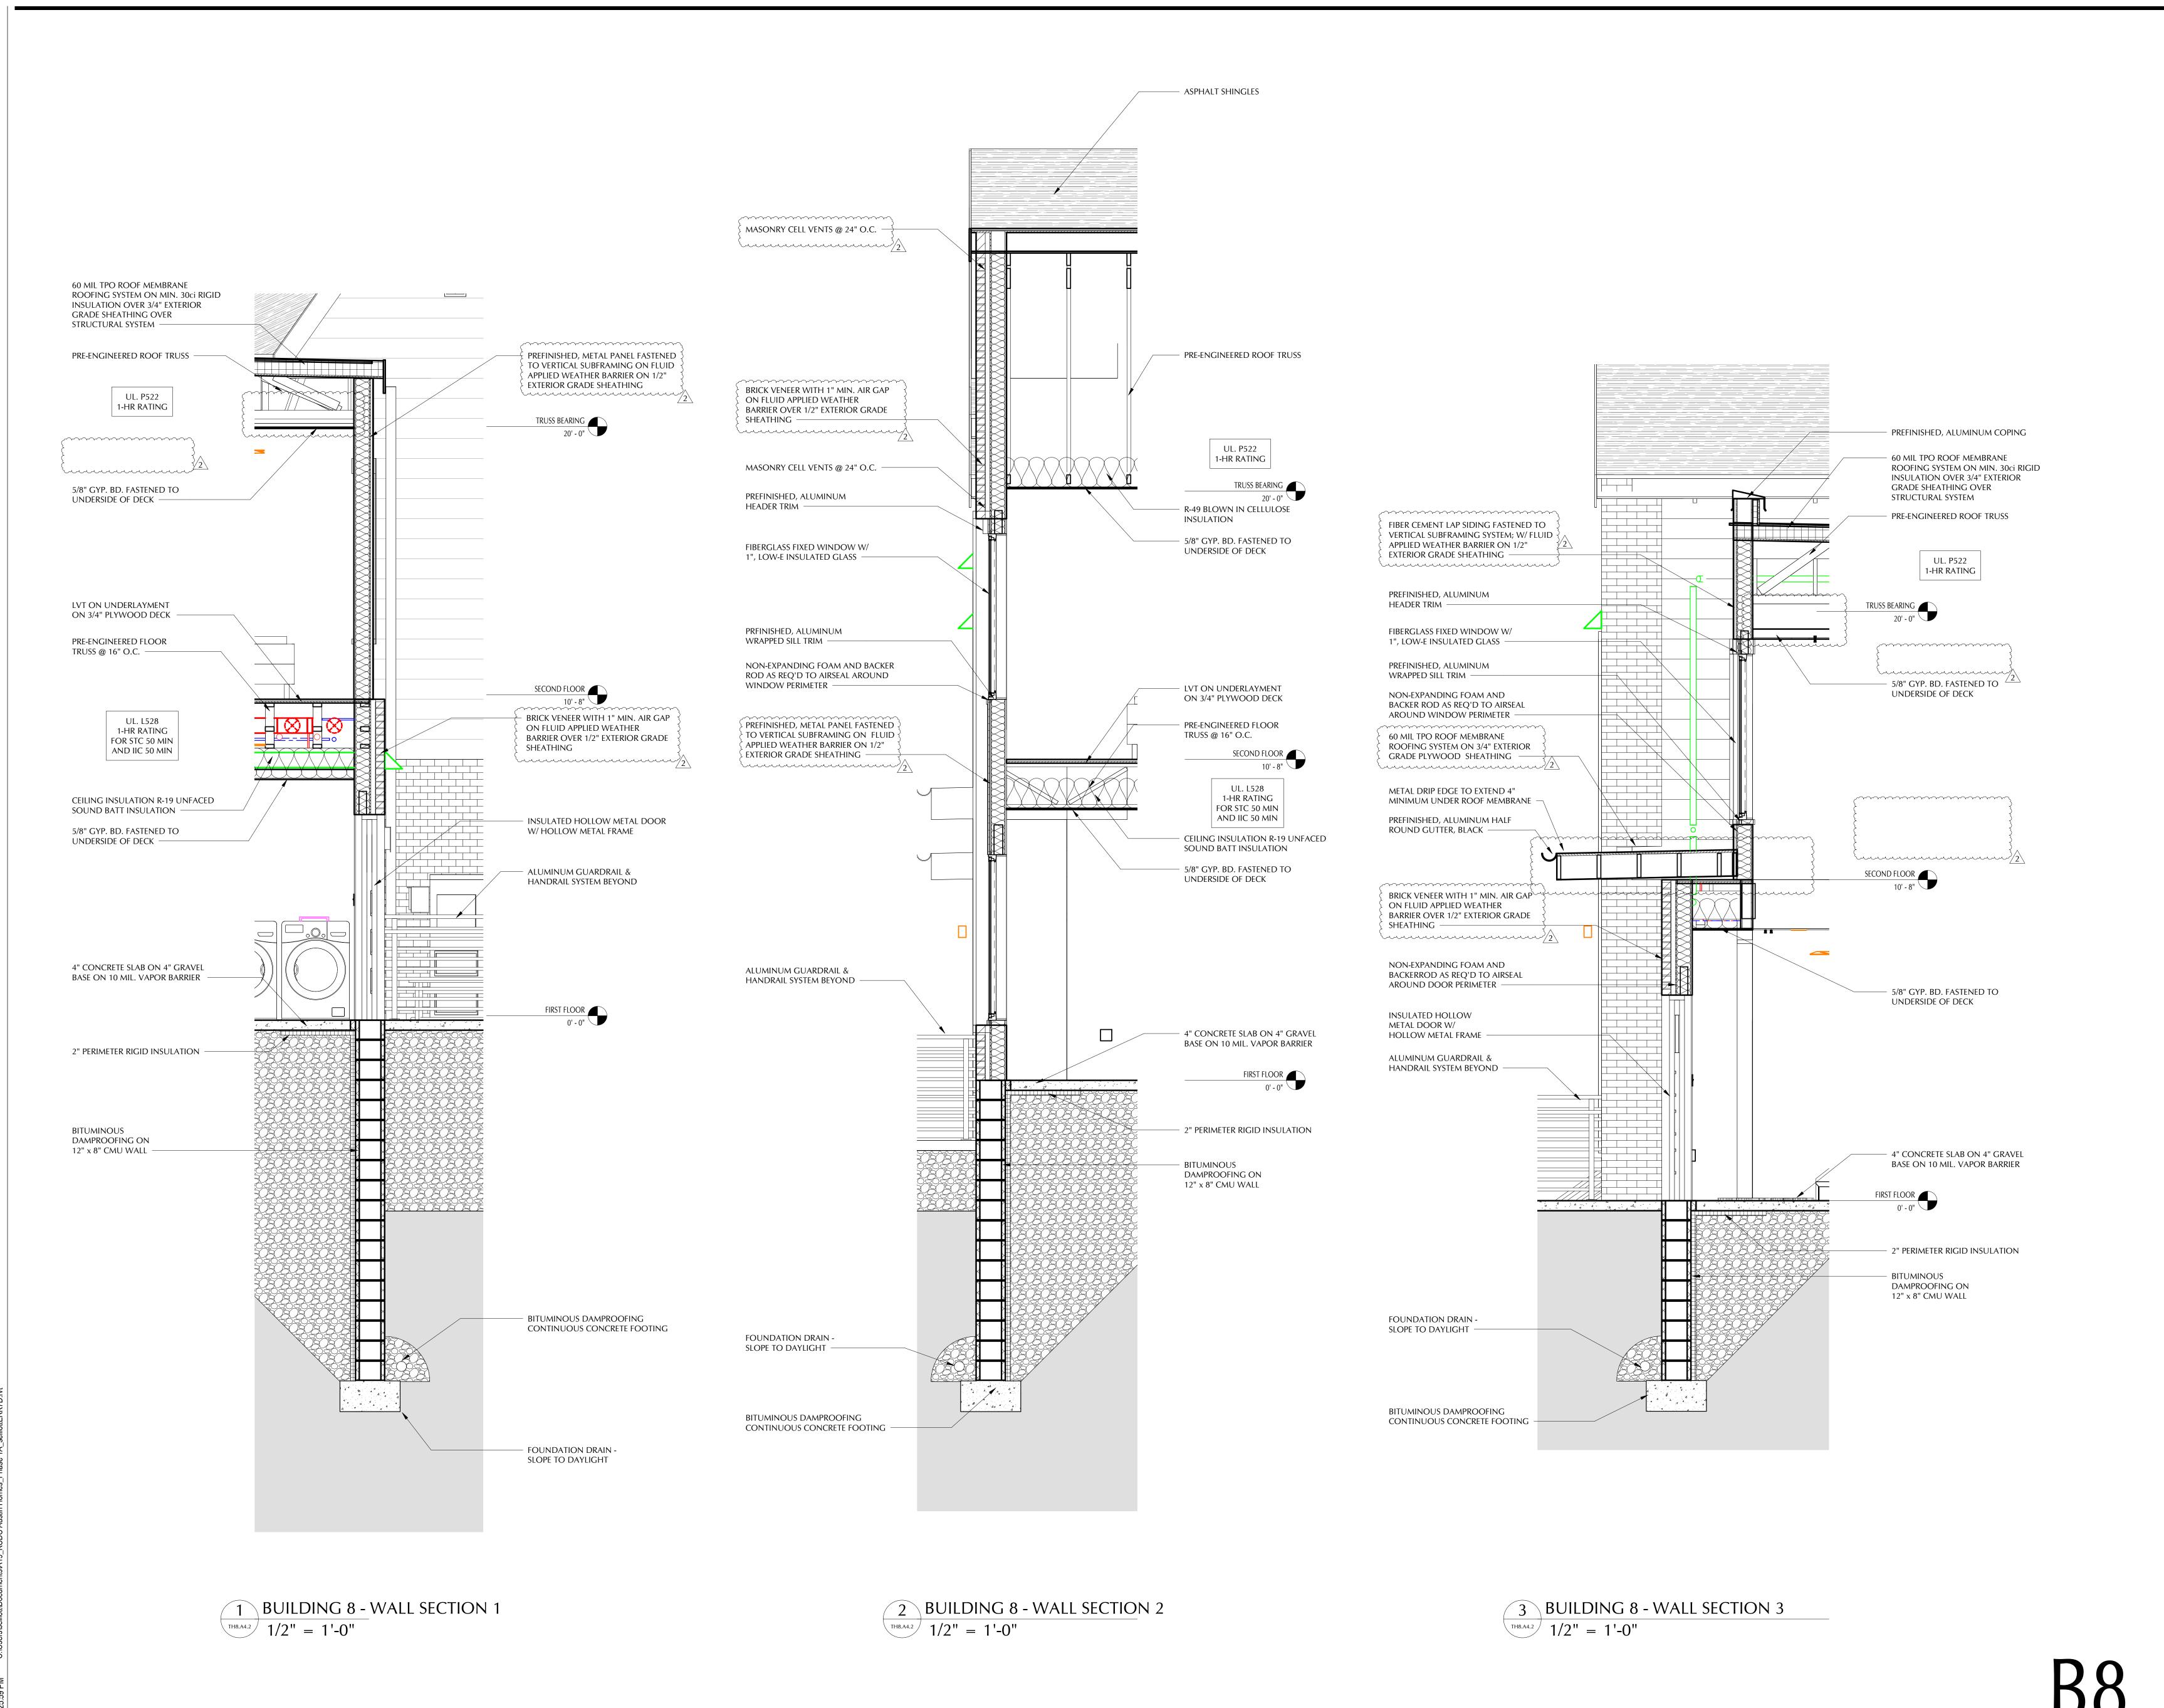

KCDC
KNOXVILLE'S COMMUNITY
DEVELOPMENT CORPORATION

AUSTIN HOMES REDEVELOPMENT
PHASE 1A
BURGE DRIVE AND HARRIET TUBMAN ST.

Johnson Architecture

Tel 312.456.0123


Fax 312.456.0124

2240 Sutherland Avenue Tel 865.671.9060
Suite 105
Knoxville, TN 37919
United States

ensler

11 East Madison Street Suite 300 Chicago, IL 60602 United States

Date Description
 1 5/06/20 PLANS REVIEW COMMENTS
 2 5/26/20 ADDENDUM 1

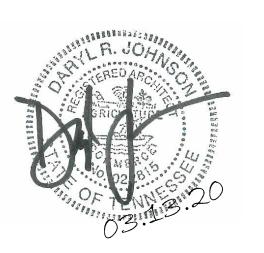

Seal / Signature

AUSTIN HOMES - PHASE 1A

7.00111.11011120 1111.102

05/06/2020


193076


Project Number

BUILDING 8 - WALL SECTIONS

1/2" = 1'-0"

TH8.A4.2

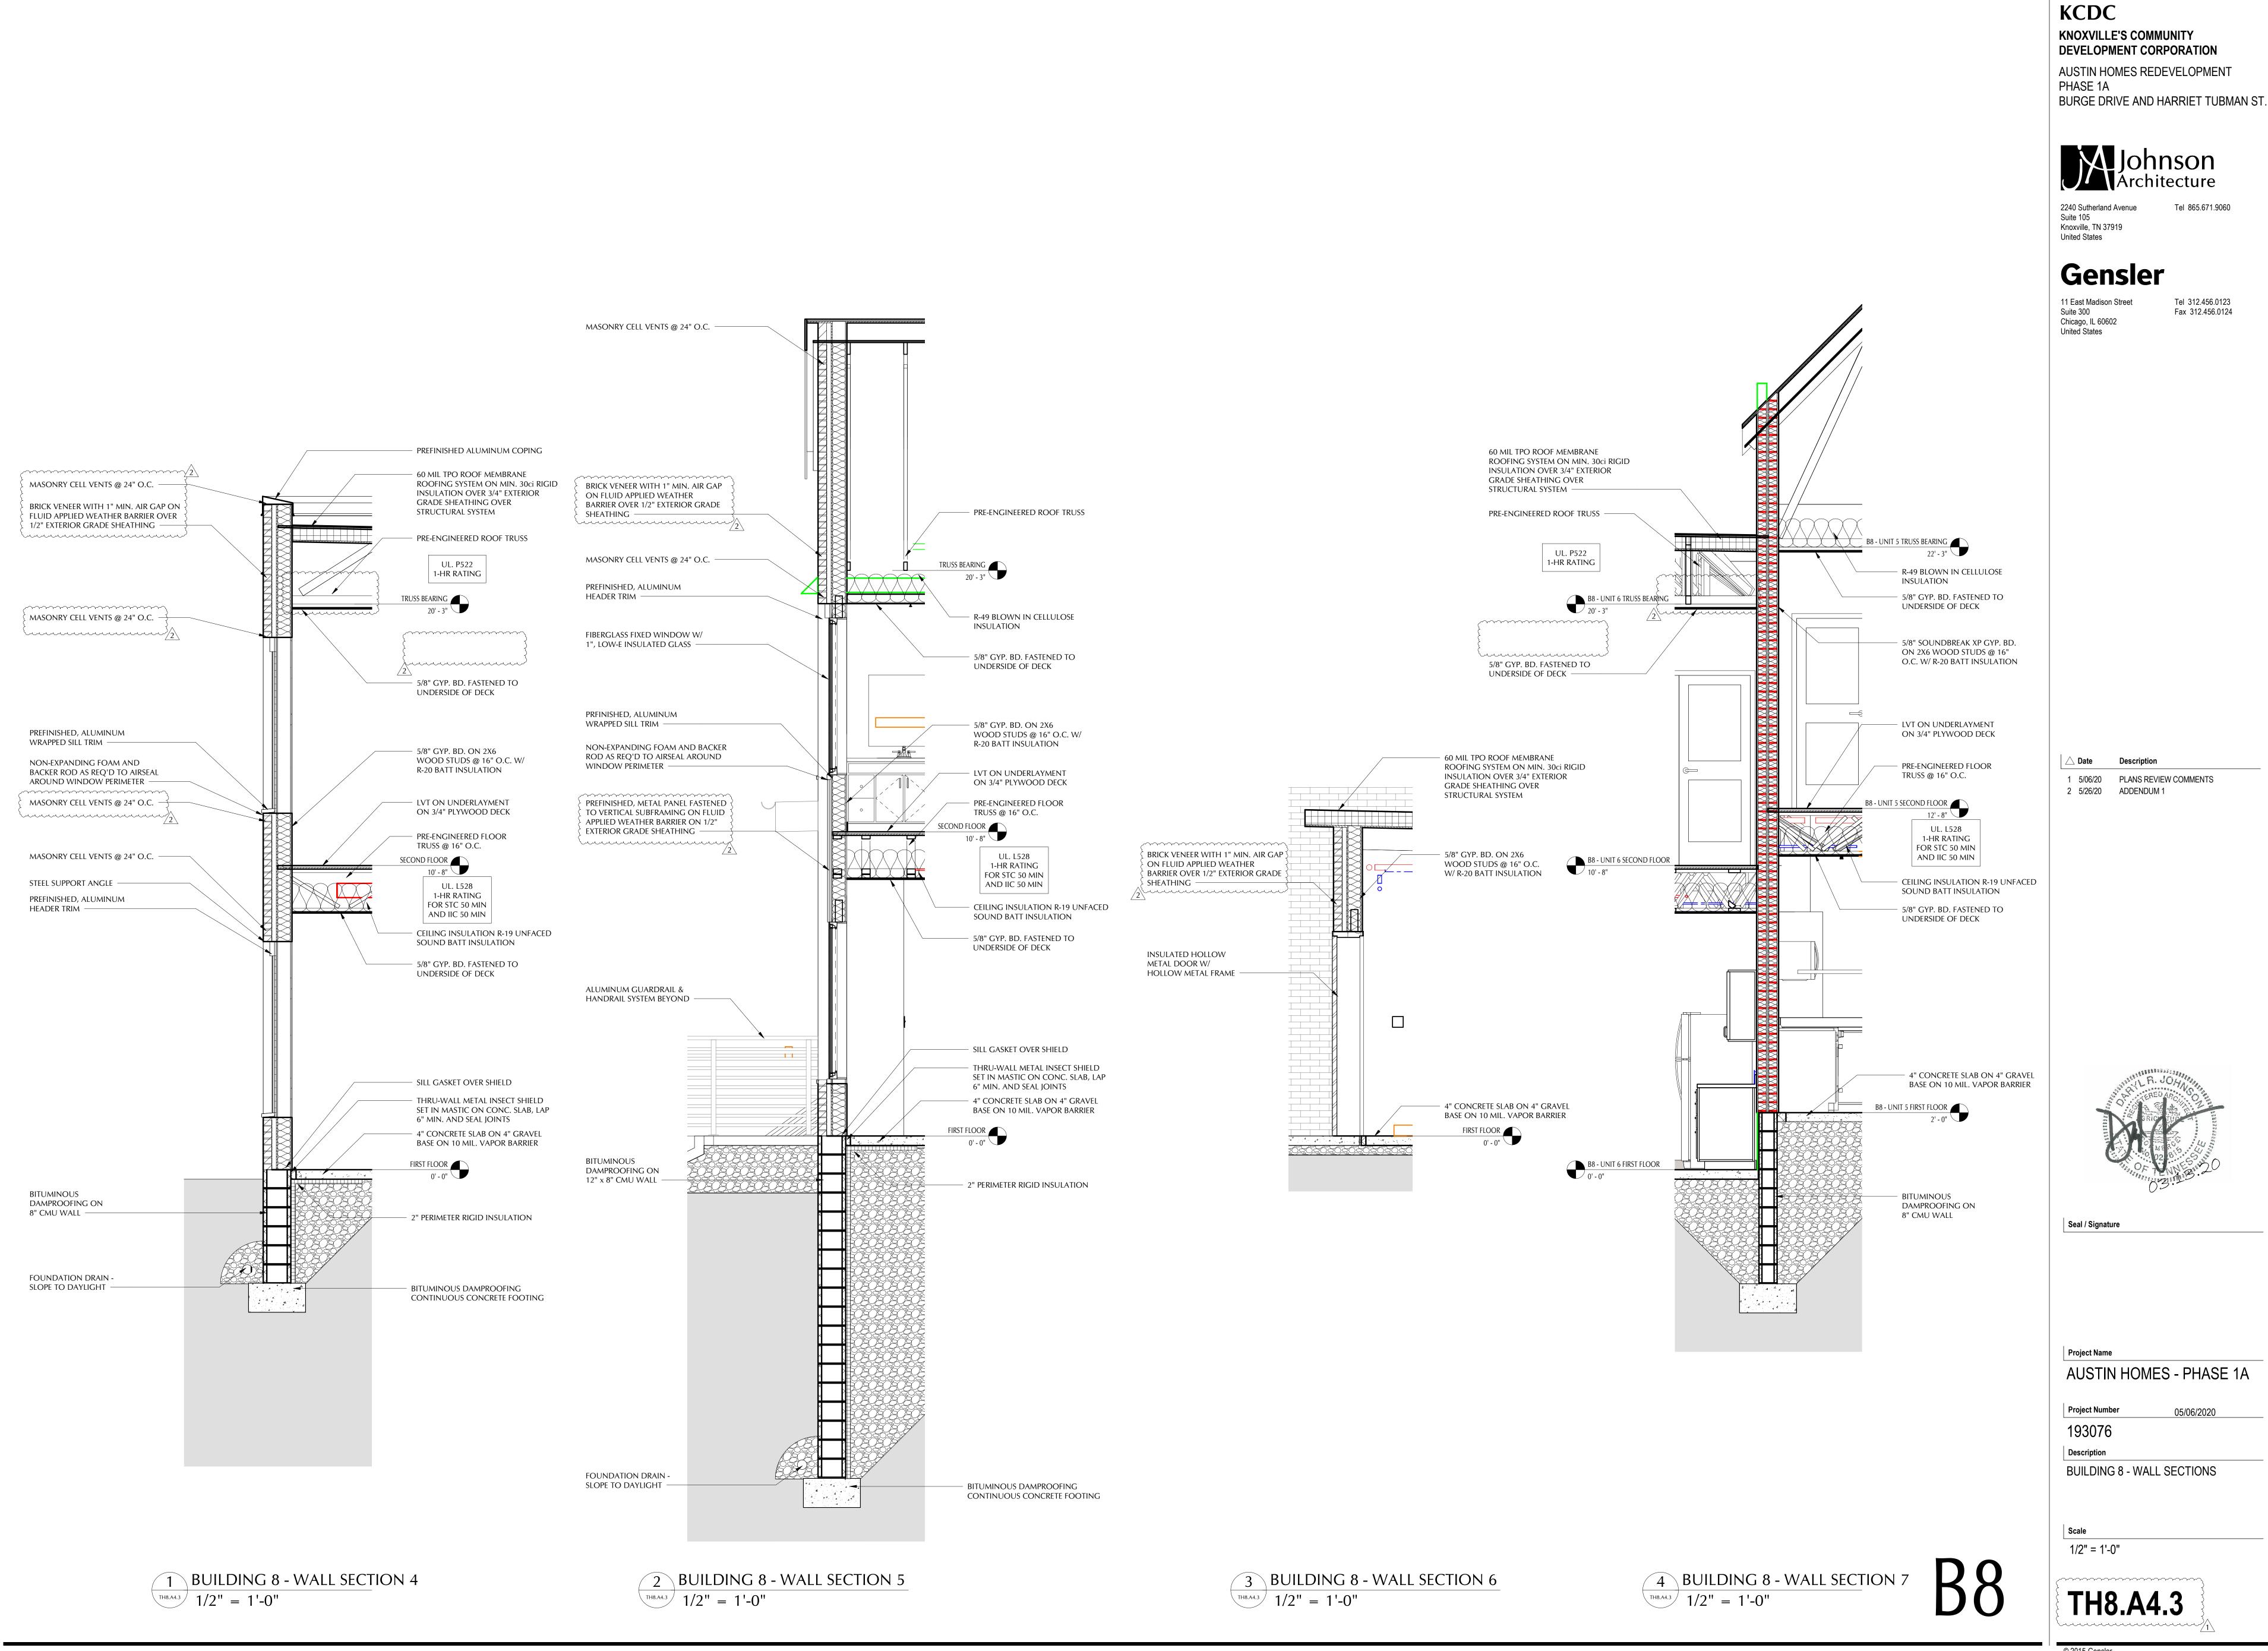

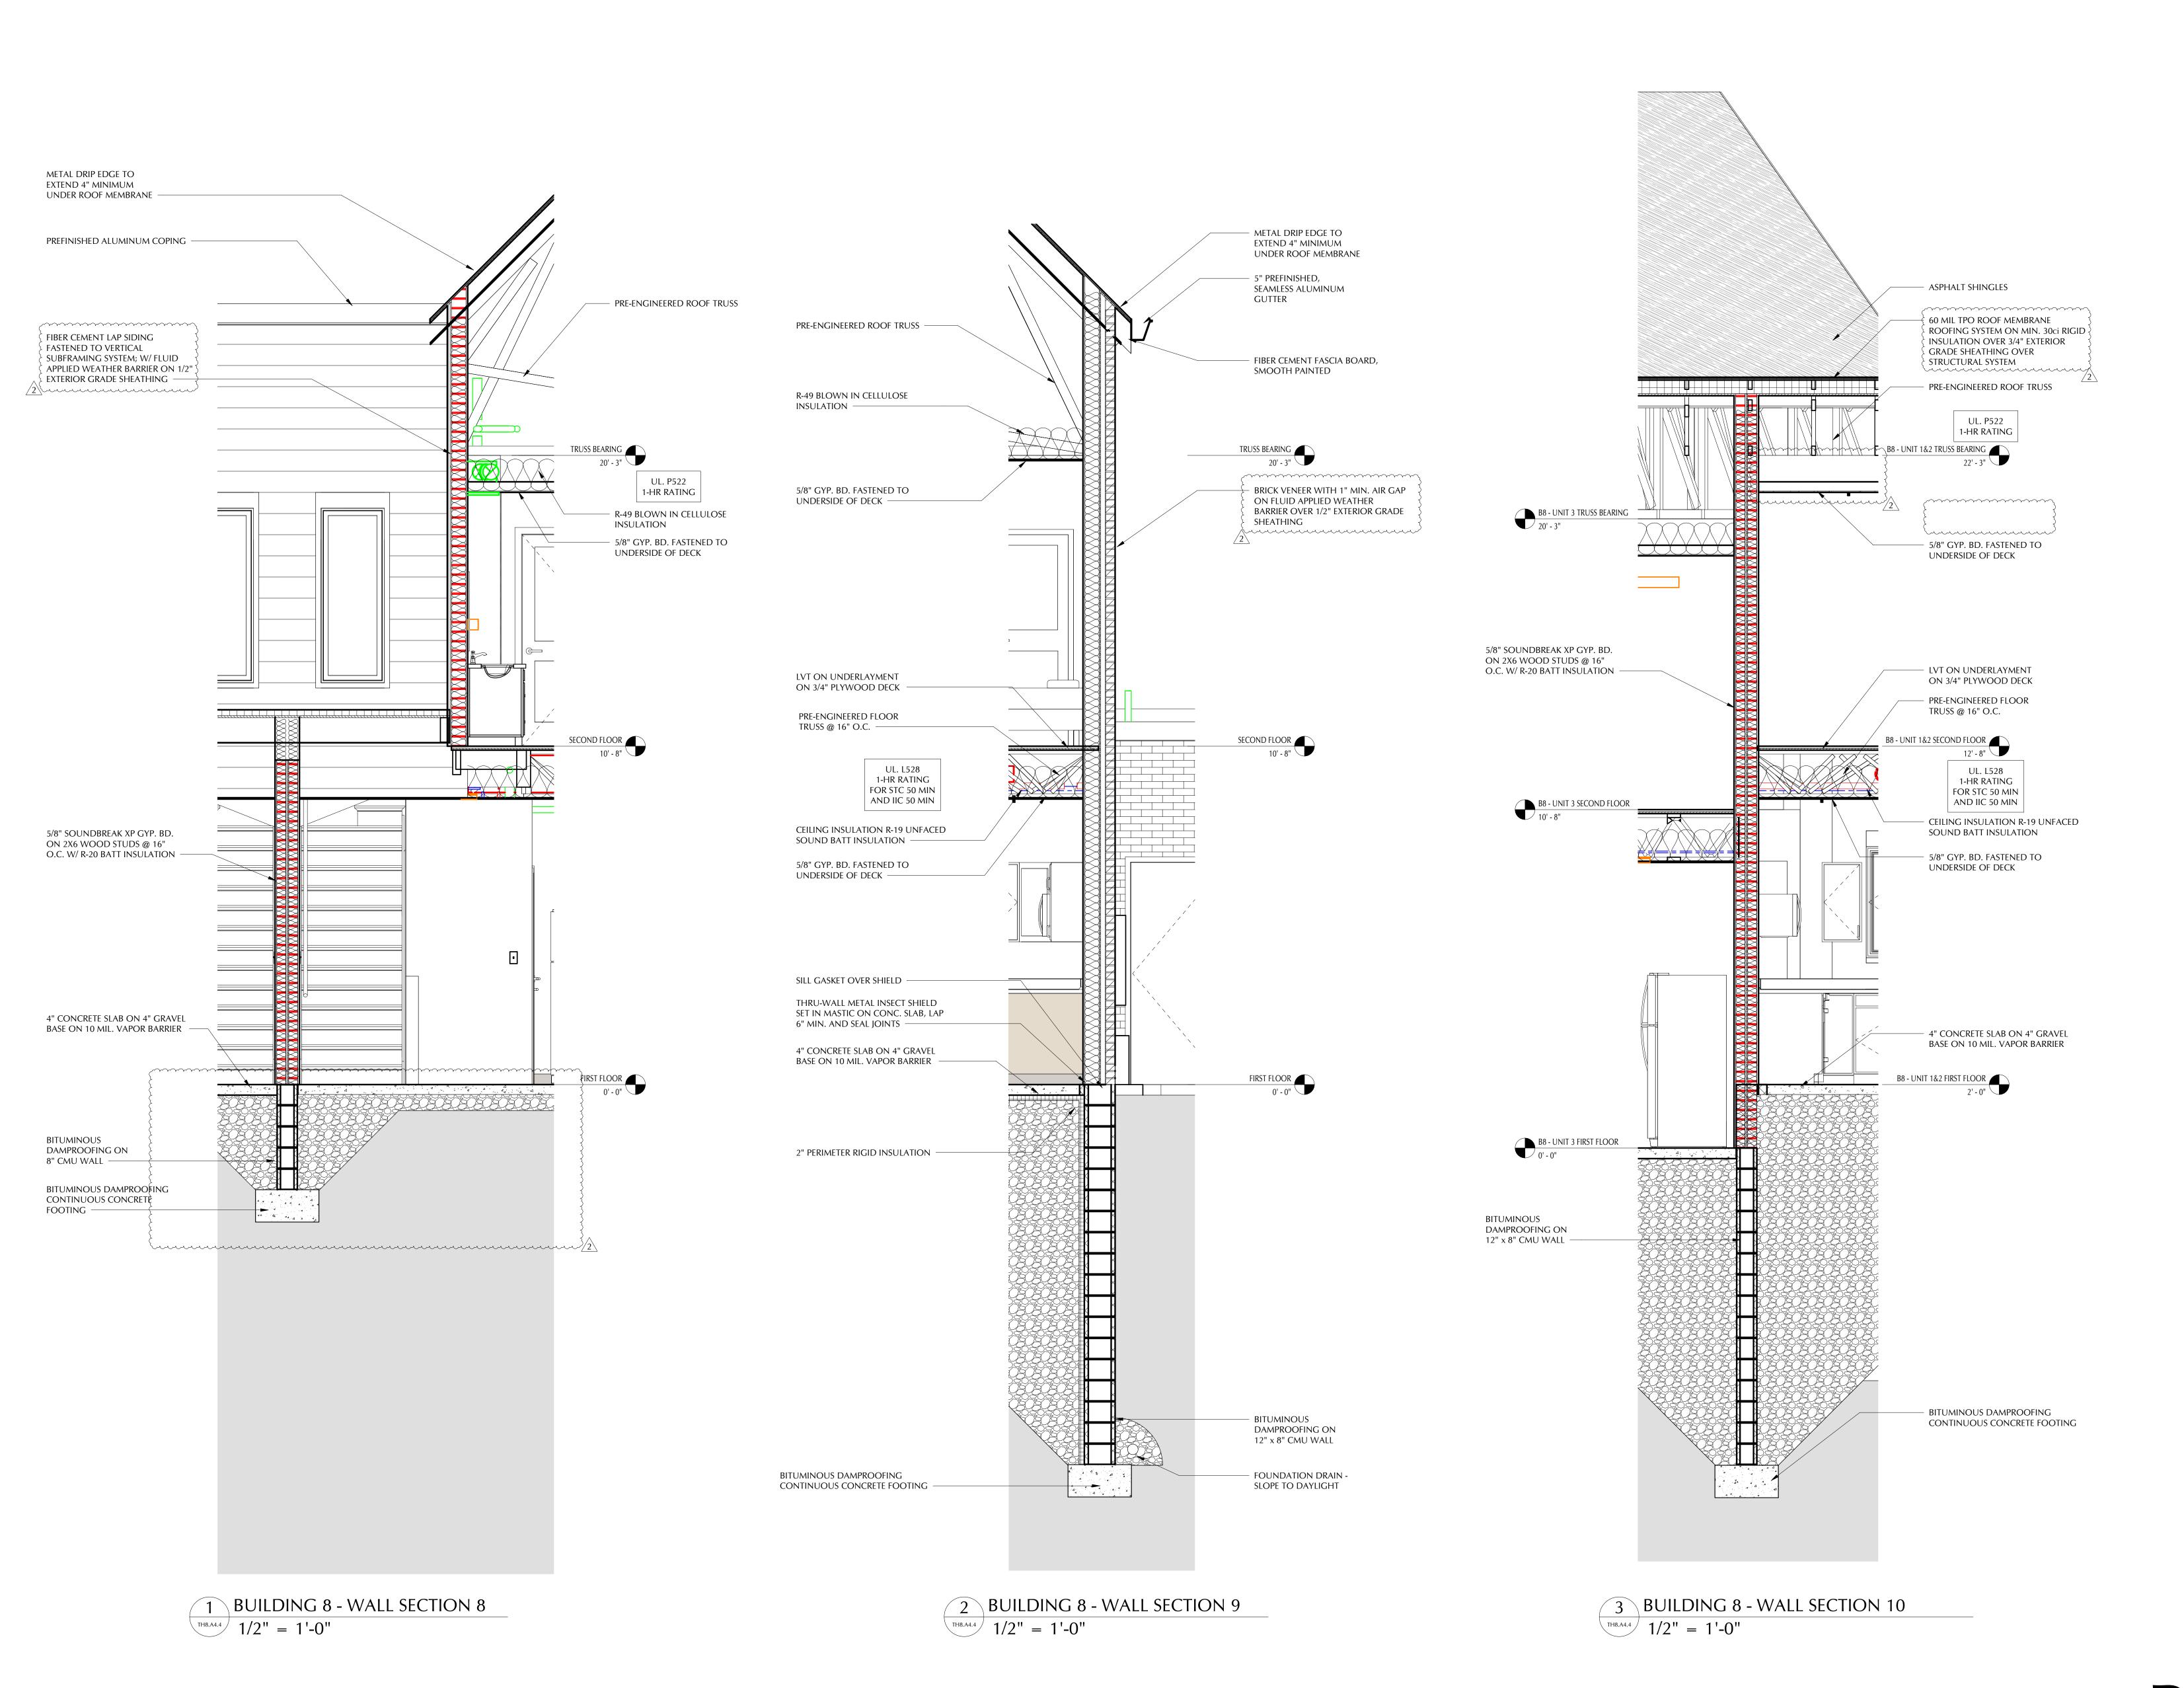

KCDC

KNOXVILLE'S COMMUNITY

DEVELOPMENT CORPORATION

AUSTIN HOMES REDEVELOPMENT
PHASE 1A
BURGE DRIVE AND HARRIET TUBMAN ST.



2240 Sutherland Avenue Tel 865.671.9060
Suite 105
Knoxville, TN 37919
United States

iensler


11 East Madison Street Suite 300 Chicago, IL 60602 United States

Fax 312.456.0124

Tel 312.456.0123

Description

1 5/06/20 PLANS REVIEW COMMENTS
2 5/26/20 ADDENDUM 1

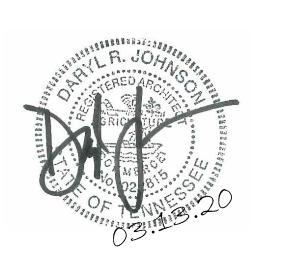

Seal / Signature

AUSTIN HOMES - PHASE 1A

05/06/2020

Project Number
193076

BUILDING 8 - WALL SECTIONS

Scale 1/2" = 1'-0"

TH8.A4.4

KCDC KNOXVILLE'S COMMUNITY **DEVELOPMENT CORPORATION**

AUSTIN HOMES REDEVELOPMENT PHASE 1A BURGE DRIVE AND HARRIET TUBMAN ST.



2240 Sutherland Avenue Suite 105 Knoxville, TN 37919

United States

11 East Madison Street Suite 300 Chicago, IL 60602 United States

Tel 312.456.0123

Fax 312.456.0124

 Date Description
 1 5/06/20 PLANS REVIEW COMMENTS 2 5/26/20 ADDENDUM 1




Seal / Signature


AUSTIN HOMES - PHASE 1A

Project Number 05/06/2020 193076 BUILDING 8 - WALL SECTIONS

1/2" = 1'-0"


TH8.A4.6 1/2" = 1'-0"

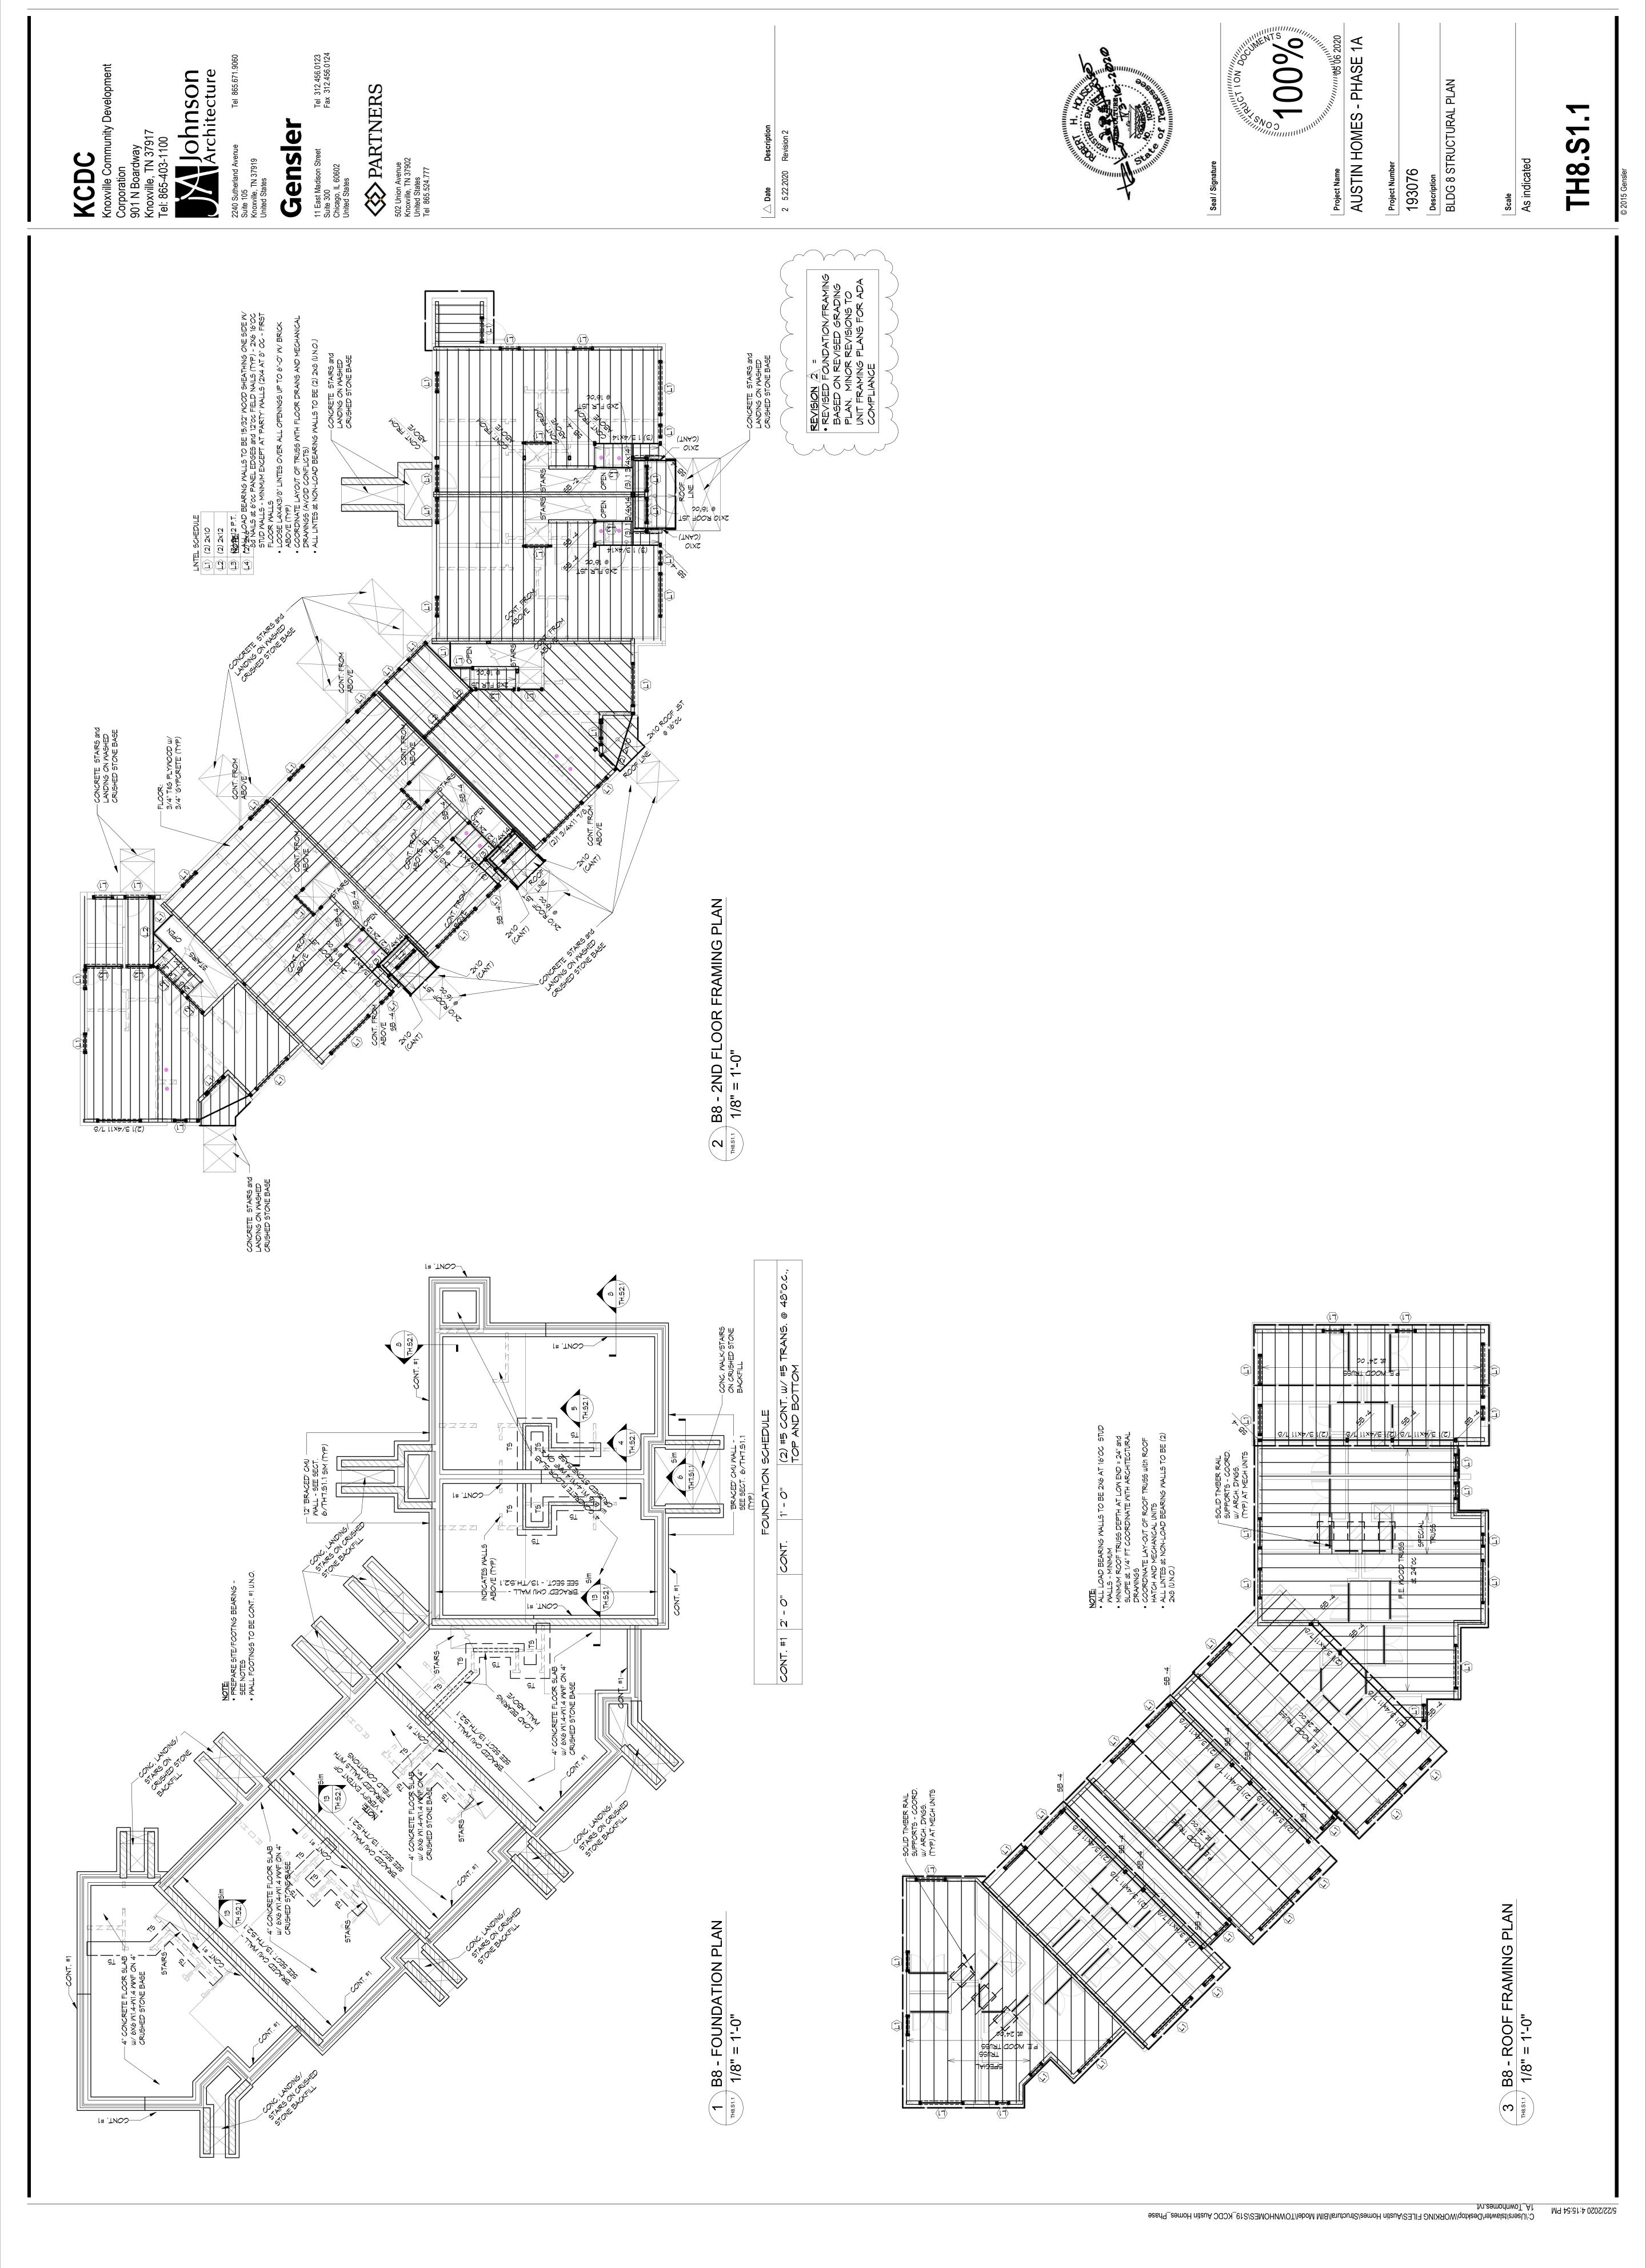

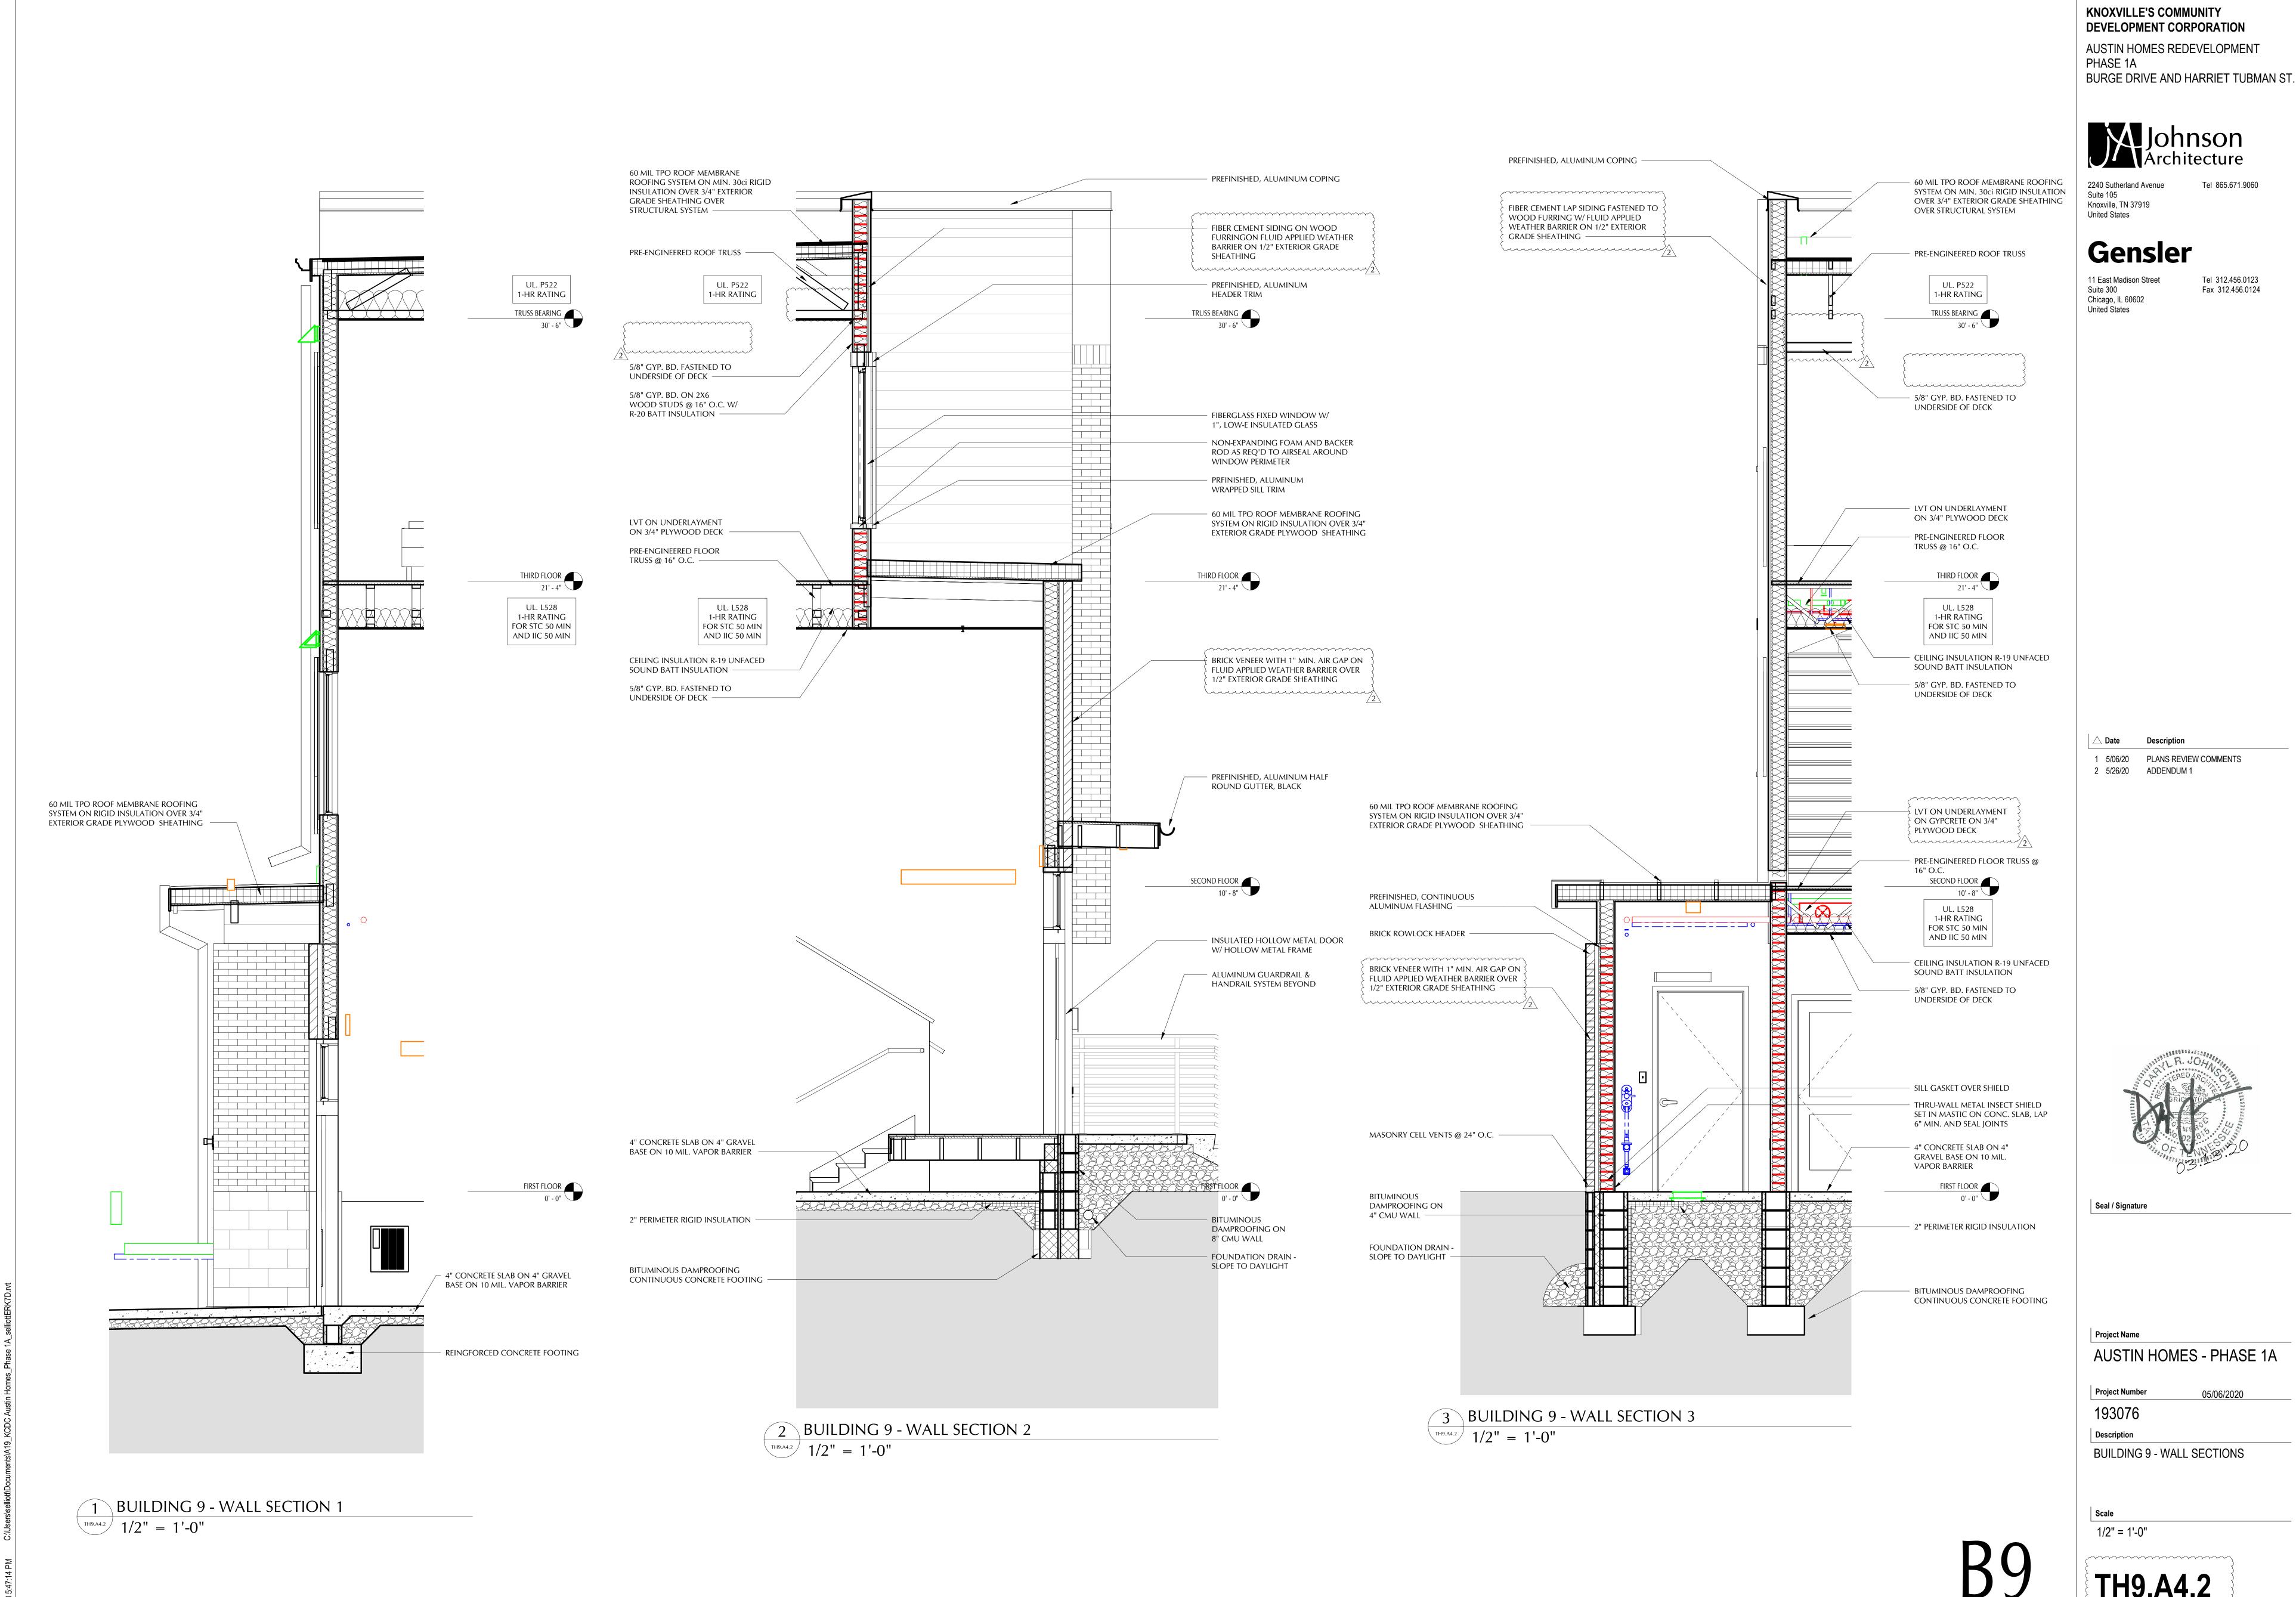



KCDC


TH9.A4.2

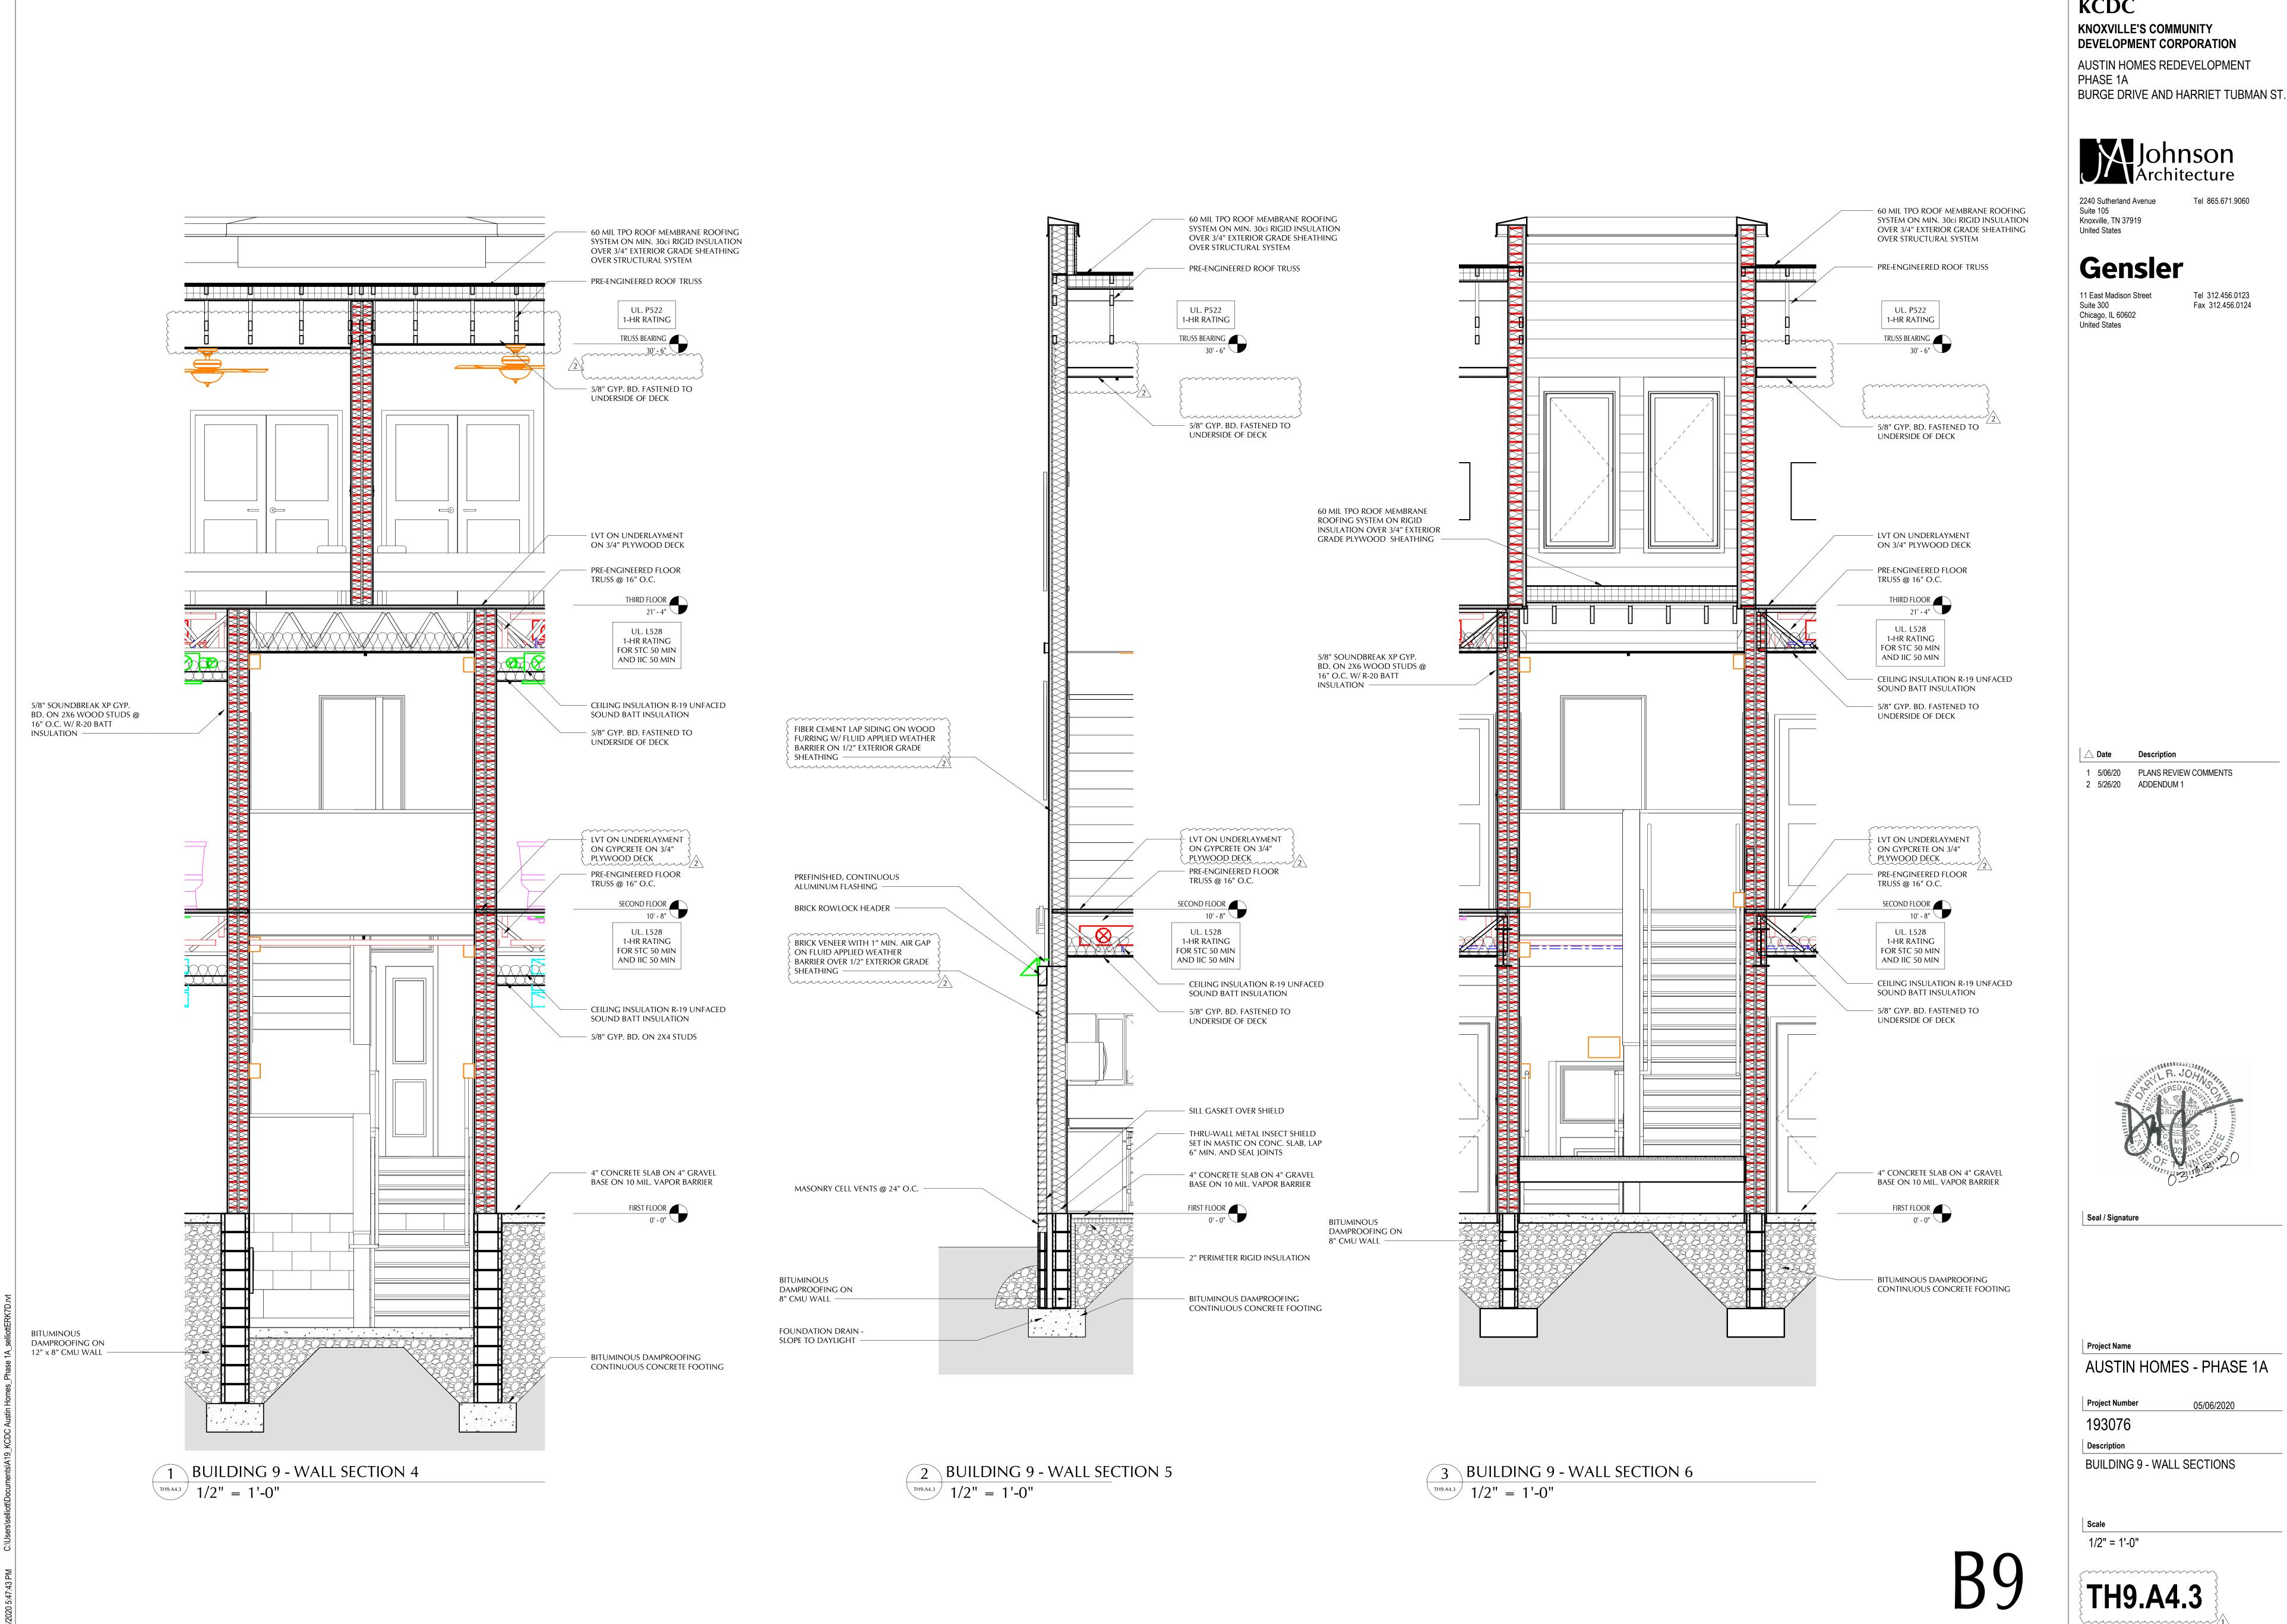

KCDC

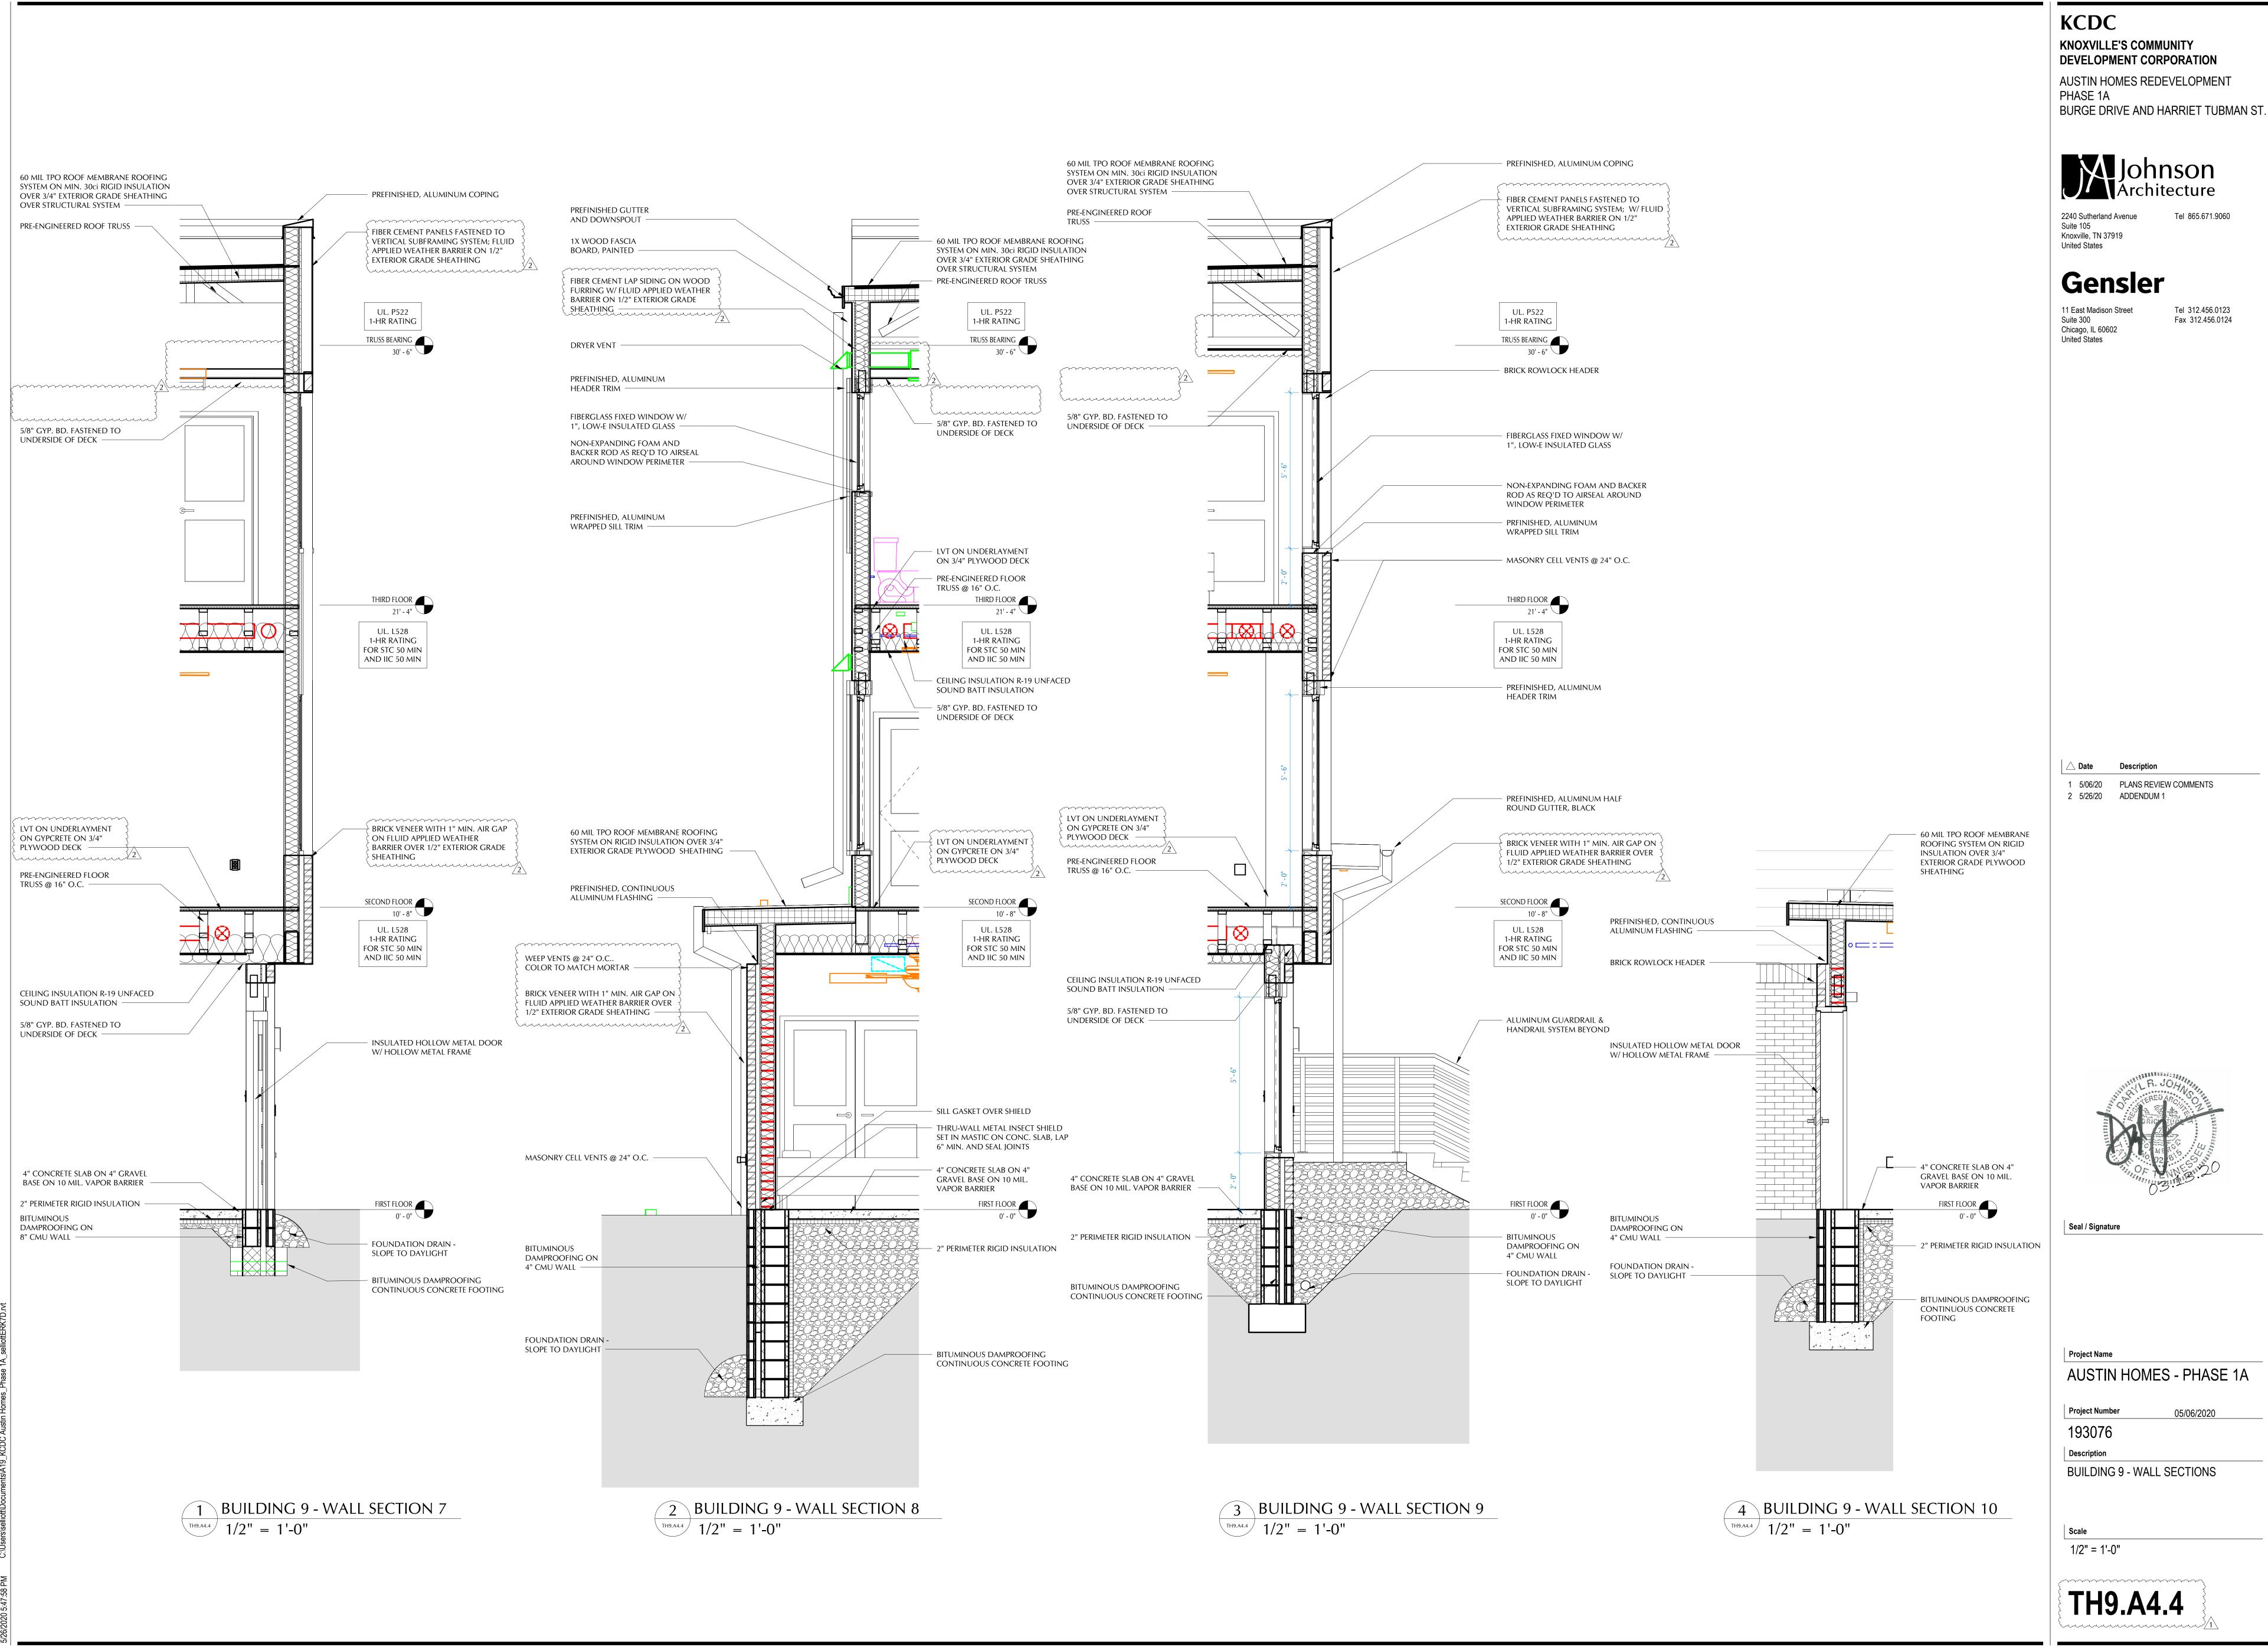

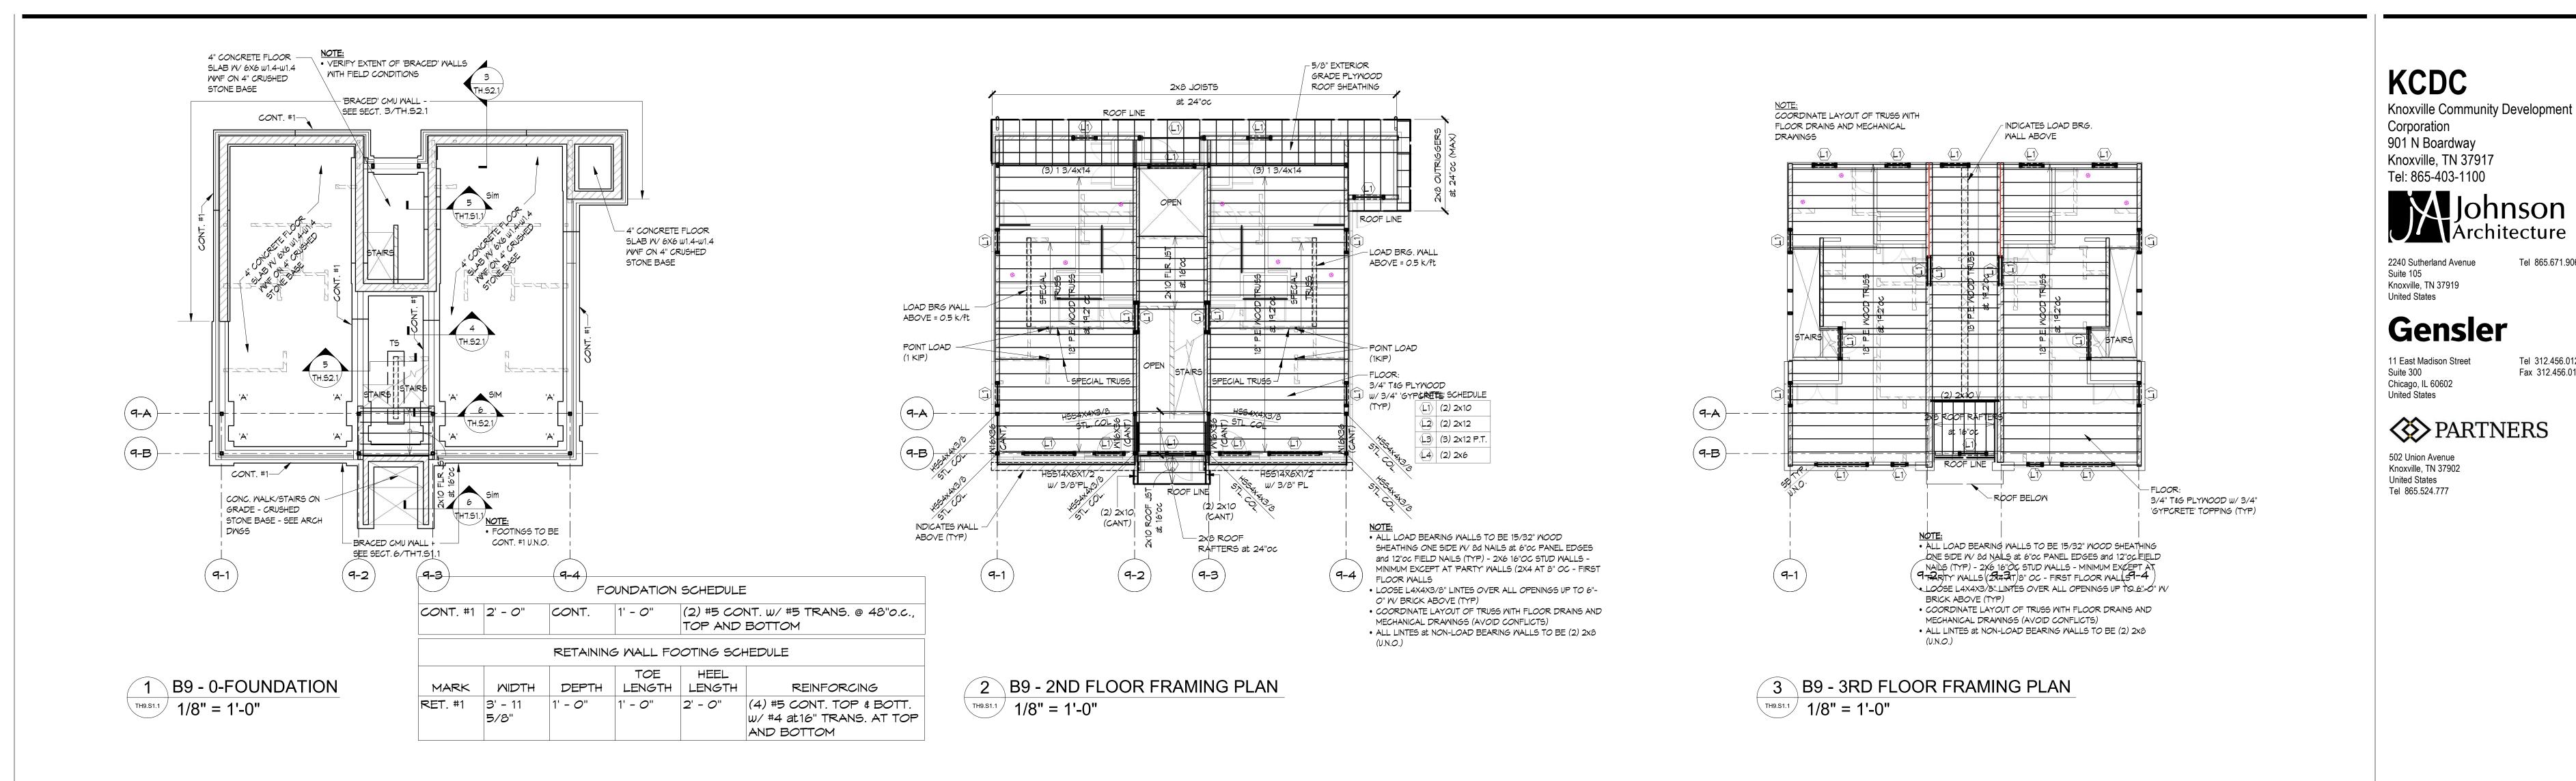

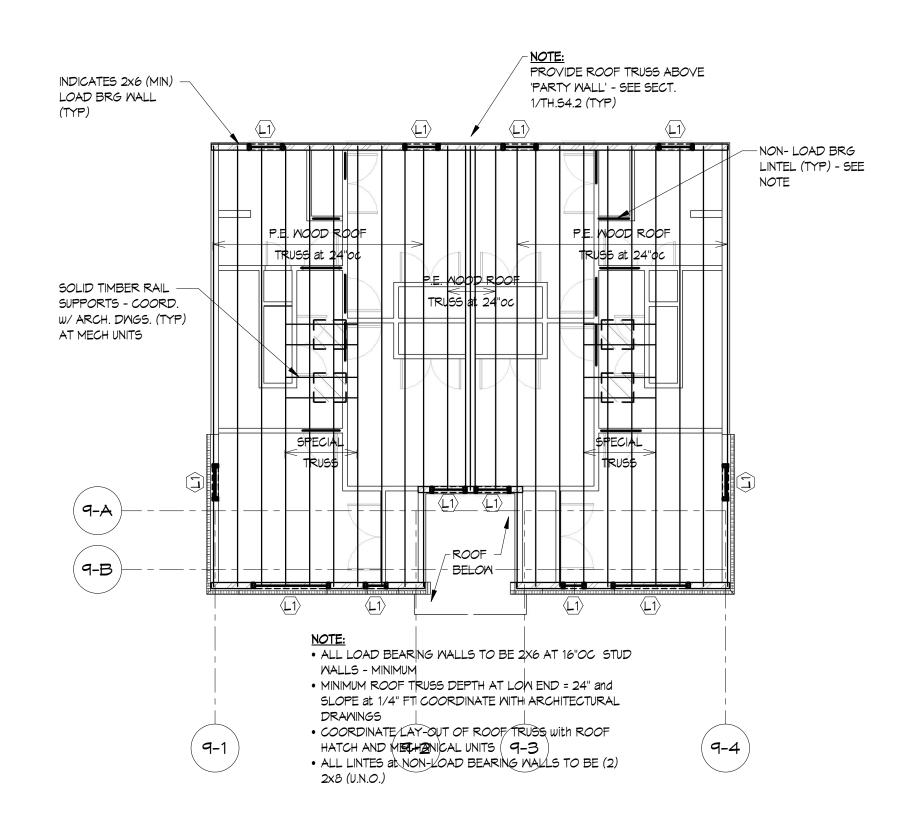

B9 - ROOF FRAMING PLAN

TH9.S1.1 $1/8" = \overline{1'-0"}$


REVISION 2 = • REVISED FOUNDATION/FRAMING BASED ON REVISED GRADING PLAN. MINOR REVISIONS TO UNIT FRAMING PLANS FOR ADA COMPLIANCE

 ∆ Date Description 2 5.22.2020 Revision 2

Tel 865.671.9060

Tel 312.456.0123

Fax 312.456.0124

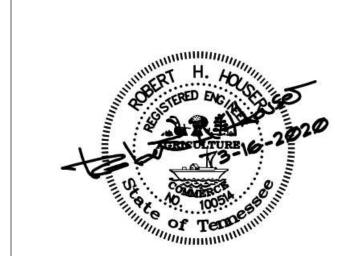

Seal / Signature

小ゆり06 2020


Project Name **AUSTIN HOMES - PHASE 1A**

Project Number


BLDG 9 STRUCTURAL PLAN

As indicated


TH9.S1.1

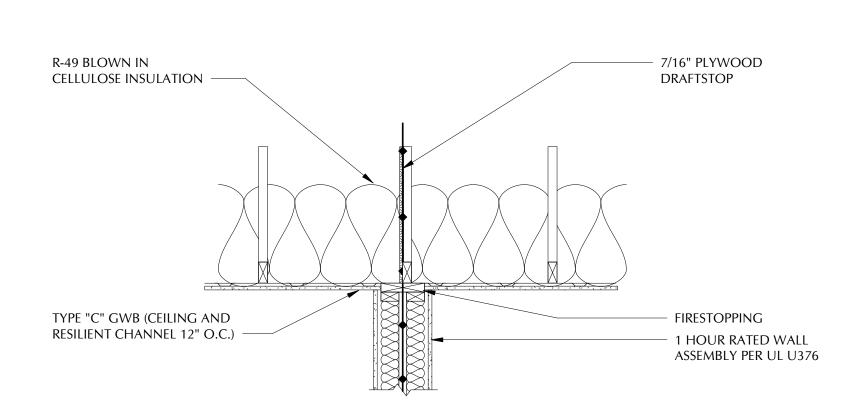


$\begin{array}{c} 1 \text{ SECTION 2 PARTY WALL} \\ \hline 3/4" = 1'-0" \end{array}$

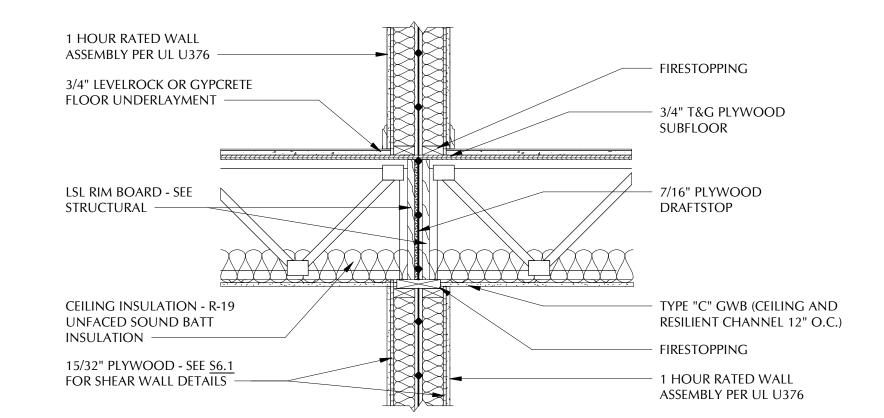




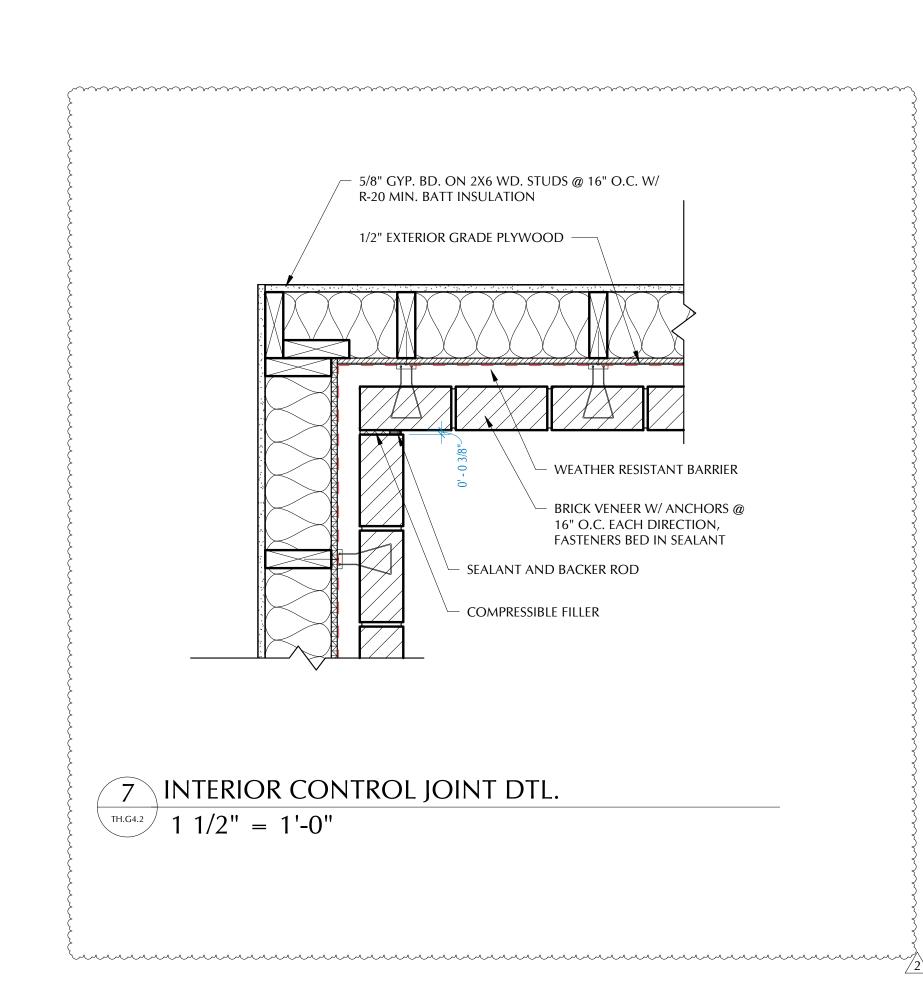


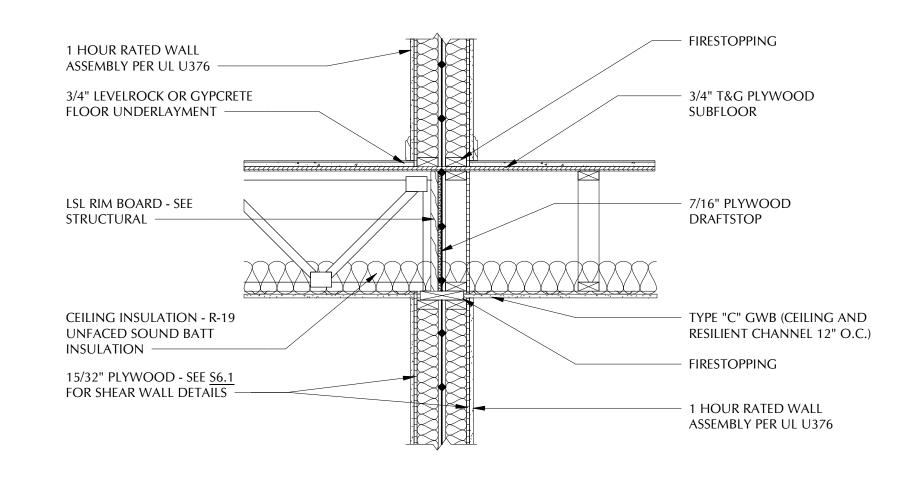




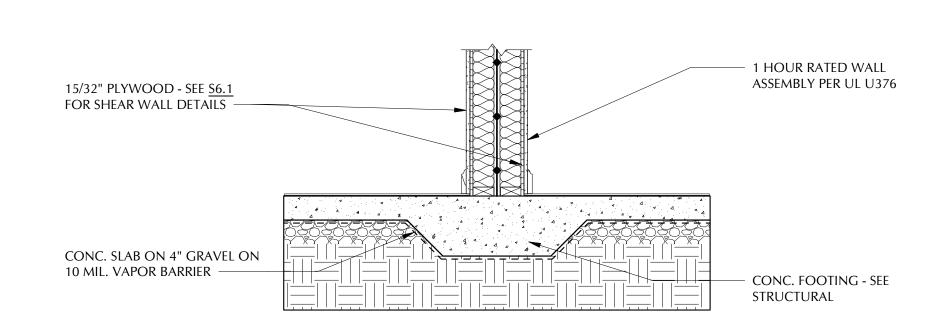

5 SECTION AT PARTY WALL @ FLOOR

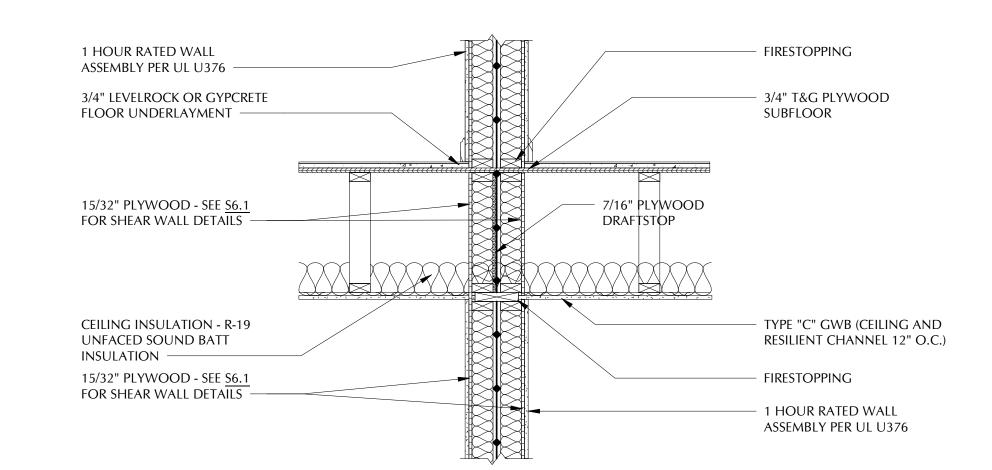



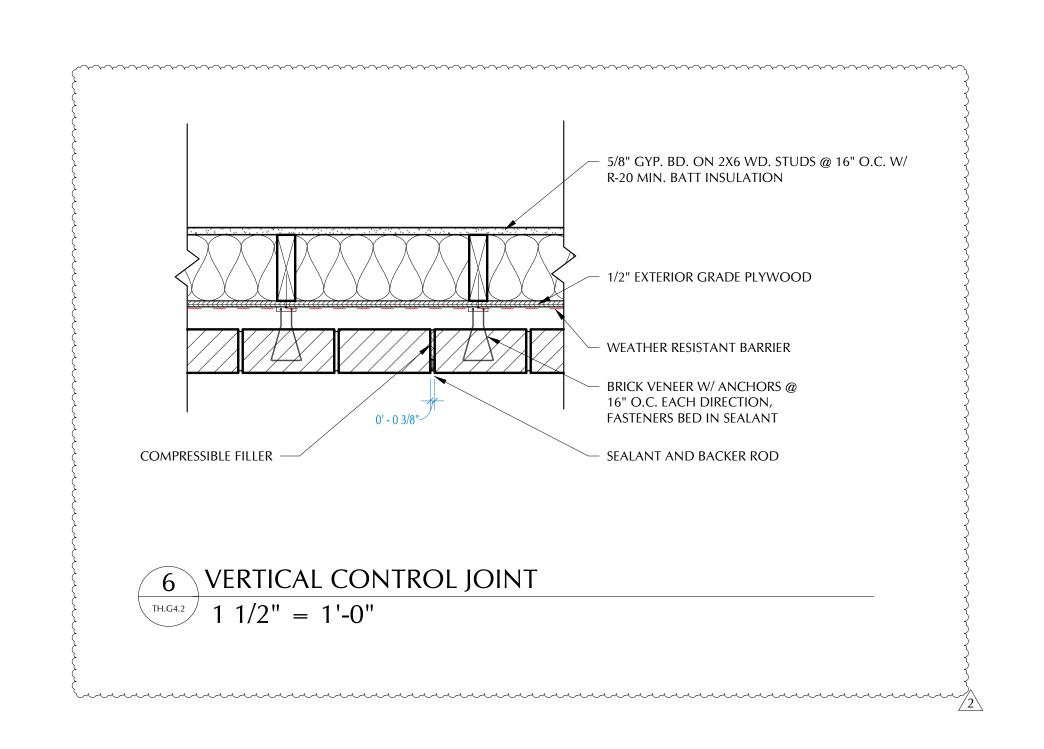

KCDC KNOXVILLE'S COMMUNITY **DEVELOPMENT CORPORATION**

AUSTIN HOMES REDEVELOPMENT PHASE 1A BURGE DRIVE AND HARRIET TUBMAN ST.



Tel 865.671.9060 2240 Sutherland Avenue Suite 105 Knoxville, TN 37919 United States

11 East Madison Street Suite 300 Chicago, IL 60602 United States

Tel 312.456.0123 Fax 312.456.0124

∆ Date Description

2 5/26/20 ADDENDUM 1



Seal / Signature

AUSTIN HOMES - PHASE 1A


05/06/2020


Project Number 193076


TYPICAL FIRE PARTITION & WALL **DETAILS**


As indicated

TH.G4.2

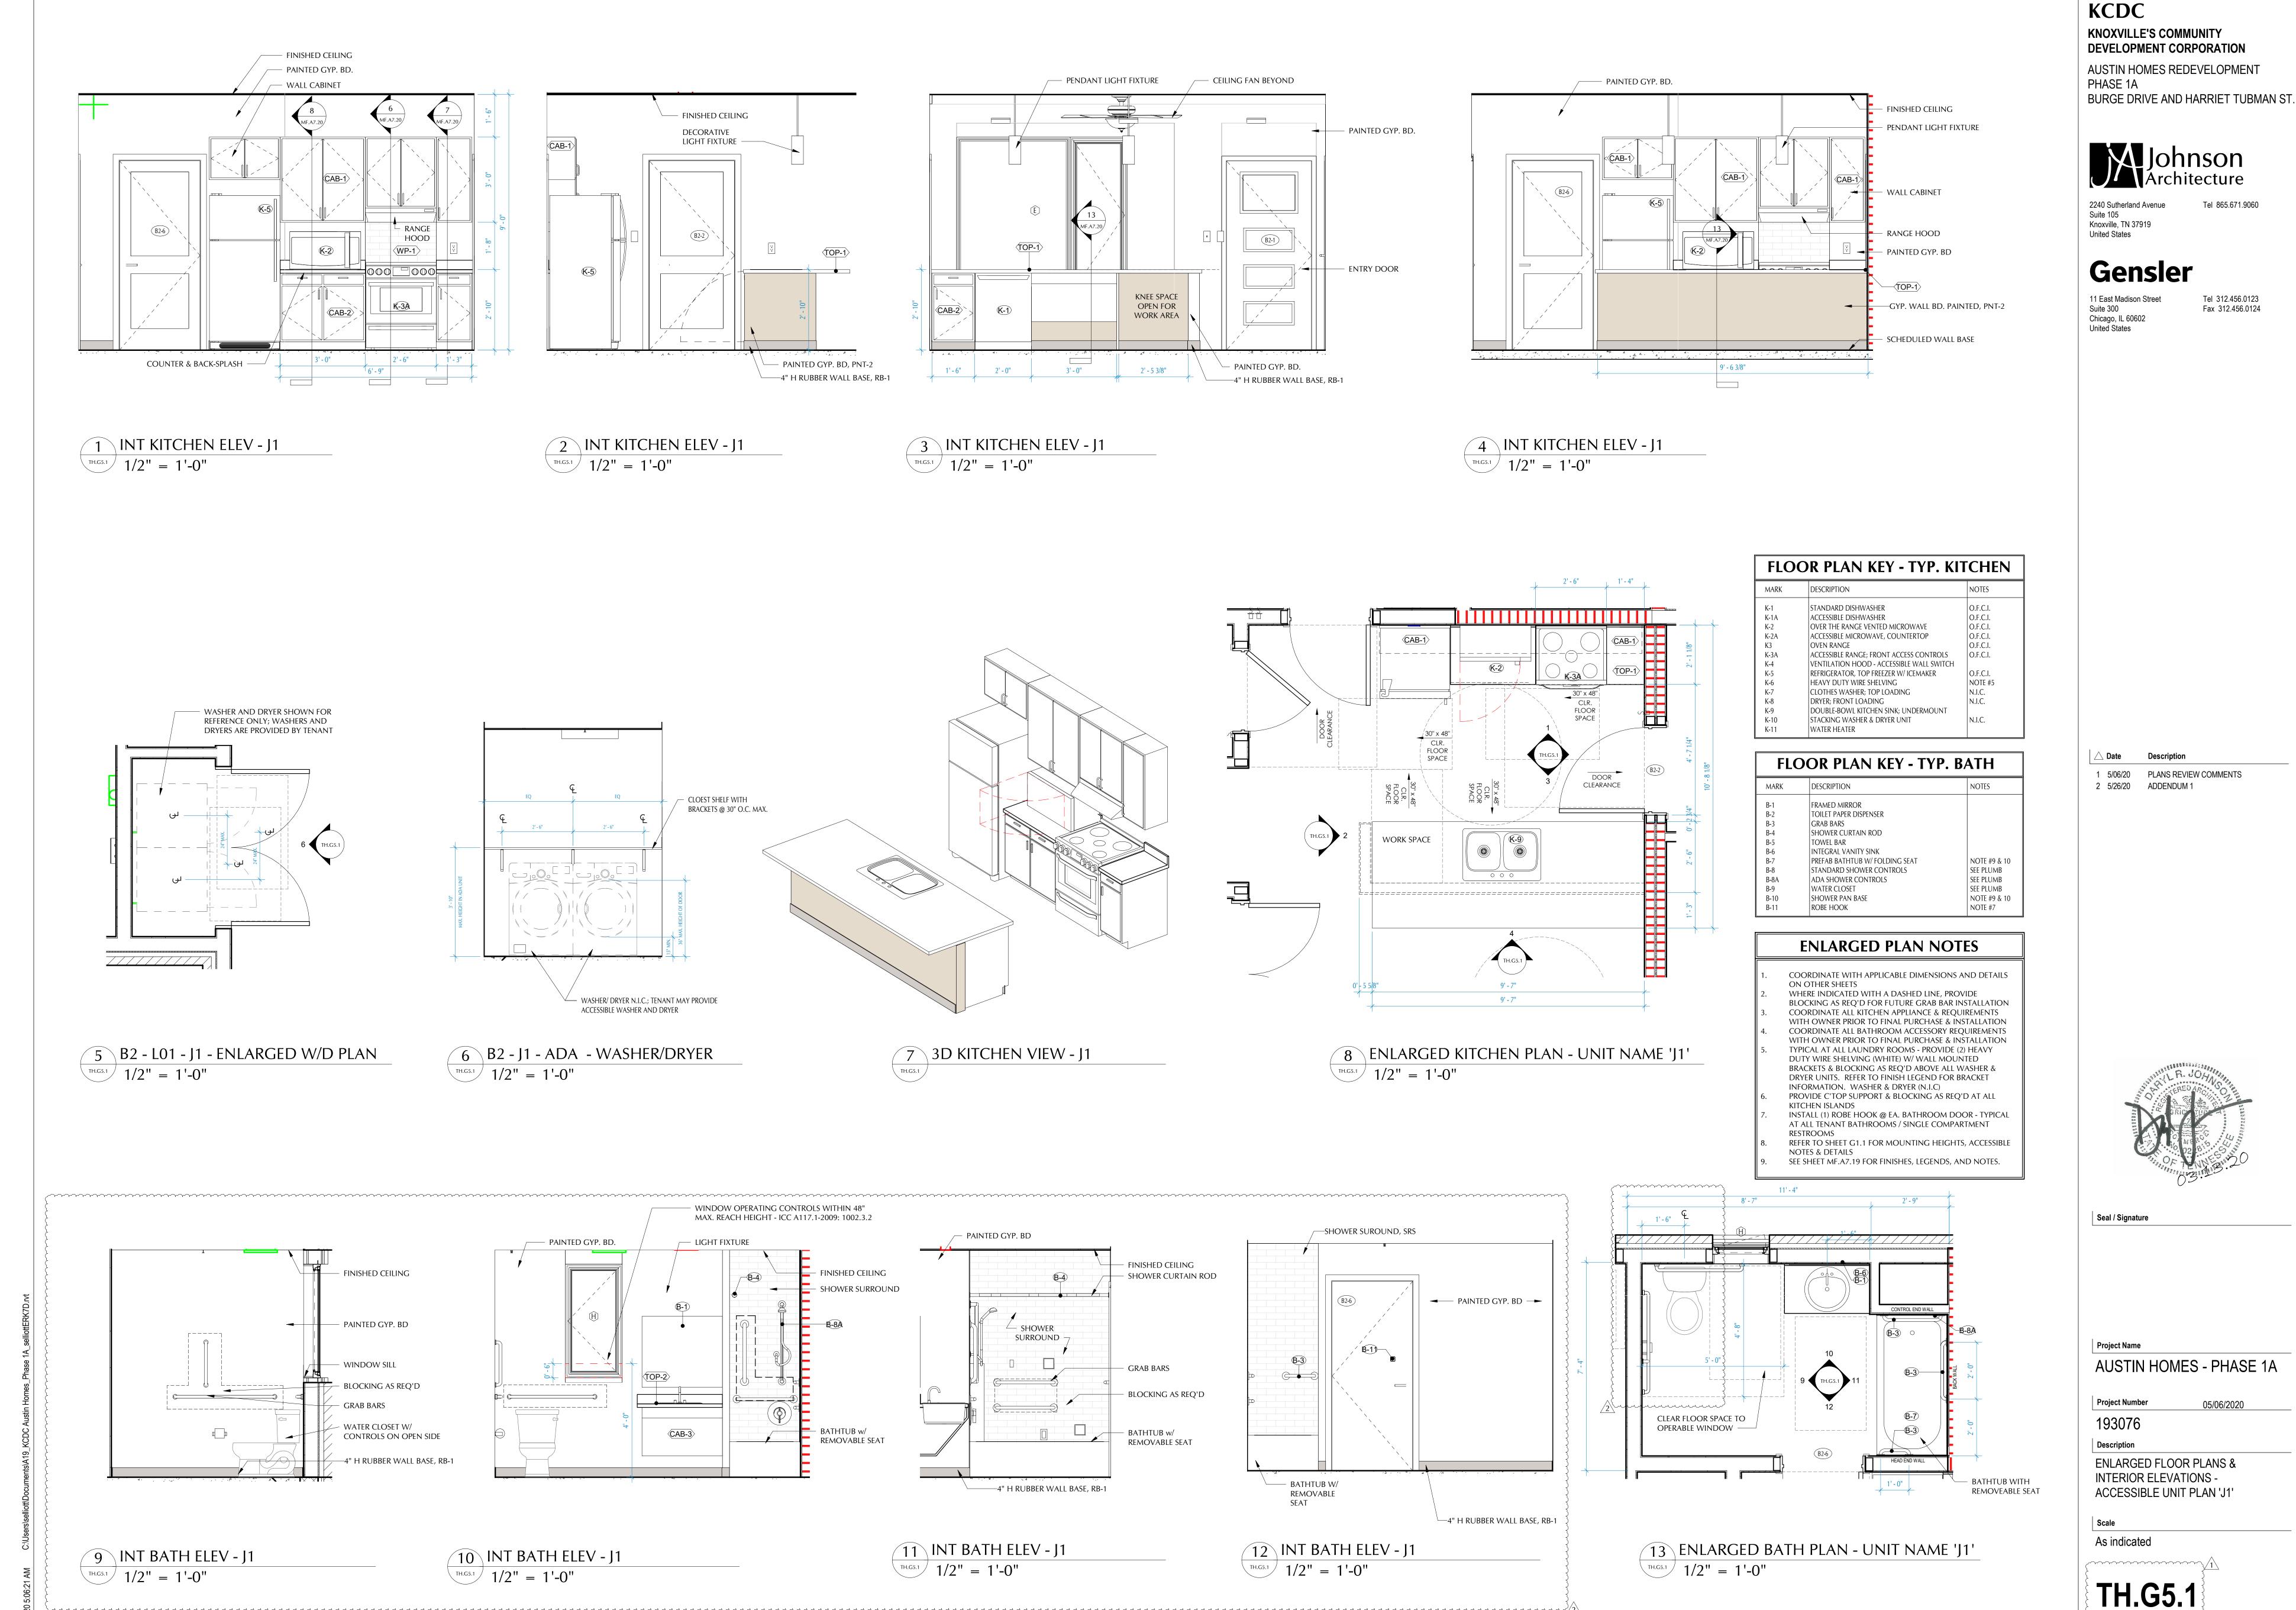

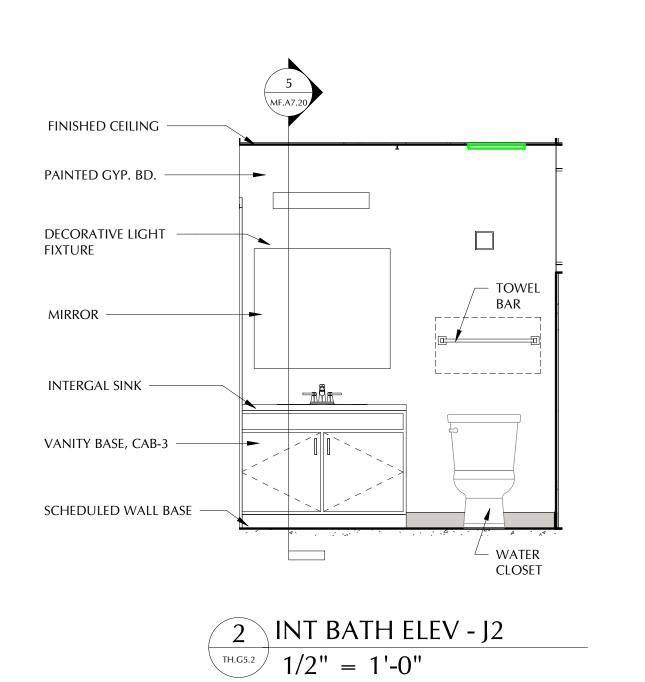


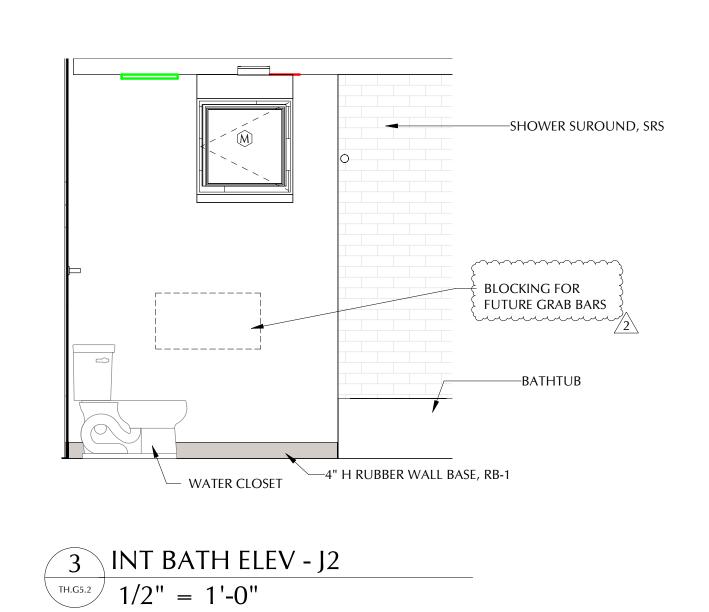

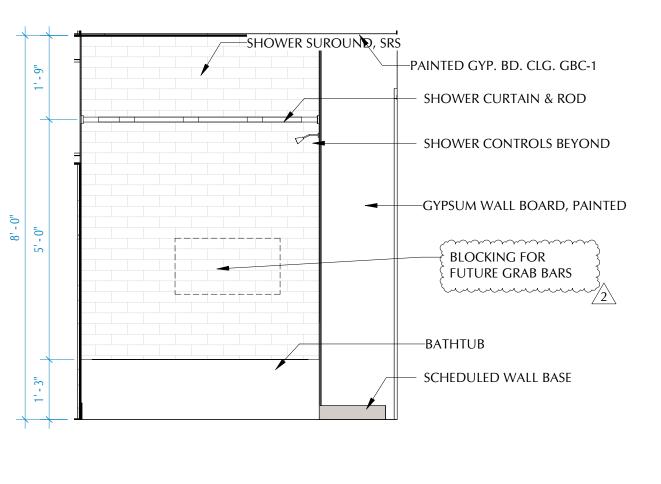

4 INT BATH ELEV - J2

TH.G5.2 1/2" = 1'-0"

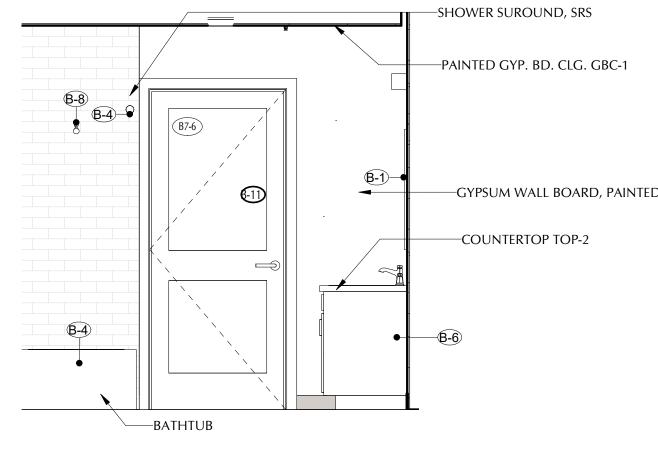

5 INT BATH ELEV - J2 1/2" = 1'-0"

MARK	DESCRIPTION	NOTES
K-1	STANDARD DISHWASHER	O.F.C.I.
K-1A	ACCESSIBLE DISHWASHER	O.F.C.I.
K-2	OVER THE RANGE VENTED MICROWAVE	O.F.C.I.
K-2A	ACCESSIBLE MICROWAVE, COUNTERTOP	O.F.C.I.
K3	OVEN RANGE	O.F.C.I.
K-3A	ACCESSIBLE RANGE; FRONT ACCESS CONTROLS	O.F.C.I.
K-4	VENTILATION HOOD - ACCESSIBLE WALL SWITCH	
K-5	REFRIGERATOR, TOP FREEZER W/ ICEMAKER	O.F.C.I.
K-6	HEAVY DUTY WIRE SHELVING	NOTE #5
K-7	CLOTHES WASHER; TOP LOADING	N.I.C.
K-8	DRYER; FRONT LOADING	N.I.C.
K-9	DOUBLE-BOWL KITCHEN SINK; UNDERMOUNT	
K-10	STACKING WASHER & DRYER UNIT	N.I.C.
K-11	WATER HEATER	

KII	WATERTIEATER	
FLO	OOR PLAN KEY - TYP	. BATH
MARK	DESCRIPTION	NOTES
B-1	FRAMED MIRROR	
B-2	TOILET PAPER DISPENSER	
B-3	GRAB BARS	
B-4	SHOWER CURTAIN ROD	
B-5	TOWEL BAR	
B-6	INTEGRAL VANITY SINK	
B-7	PREFAB BATHTUB W/ FOLDING SEAT	NOTE #9 & 10
B-8	STANDARD SHOWER CONTROLS	SEE PLUMB
B-8A	ADA SHOWER CONTROLS	SEE PLUMB
B-9	WATER CLOSET	SEE PLUMB
B-10	SHOWER PAN BASE	NOTE #9 & 10
B-11	ROBE HOOK	NOTE #7



KNOXVILLE'S COMMUNITY

DEVELOPMENT CORPORATION

KCDC

ZZ 10 Gathonana / Wondo	
Suite 105	
Knoxville, TN 37919	
United States	
CADCIAR	


Gensiei


11 East Madison Street	Tel 312.456.0123
Suite 300	Fax 312.456.012
Chicago, IL 60602	
United States	
United States	


ENLARGED PLAN NOTES

- COORDINATE WITH APPLICABLE DIMENSIONS AND DETAILS ON OTHER SHEETS WHERE INDICATED WITH A DASHED LINE, PROVIDE
- BLOCKING AS REQ'D FOR FUTURE GRAB BAR INSTALLATION COORDINATE ALL KITCHEN APPLIANCE & REQUIREMENTS WITH OWNER PRIOR TO FINAL PURCHASE & INSTALLATION COORDINATE ALL BATHROOM ACCESSORY REQUIREMENTS
- WITH OWNER PRIOR TO FINAL PURCHASE & INSTALLATION TYPICAL AT ALL LAUNDRY ROOMS - PROVIDE (2) HEAVY DUTY WIRE SHELVING (WHITE) W/ WALL MOUNTED BRACKETS & BLOCKING AS REQ'D ABOVE ALL WASHER & DRYER UNITS. REFER TO FINISH LEGEND FOR BRACKET INFORMATION. WASHER & DRYER (N.I.C)
- PROVIDE C'TOP SUPPORT & BLOCKING AS REQ'D AT ALL KITCHEN ISLANDS INSTALL (1) ROBE HOOK @ EA. BATHROOM DOOR - TYPICAL AT ALL TENANT BATHROOMS / SINGLE COMPARTMENT
- RESTROOMS REFER TO SHEET G1.1 FOR MOUNTING HEIGHTS, ACCESSIBLE **NOTES & DETAILS**

SEE SHEET MF.A7.19 FOR FINISHES, LEGENDS, AND NOTES.

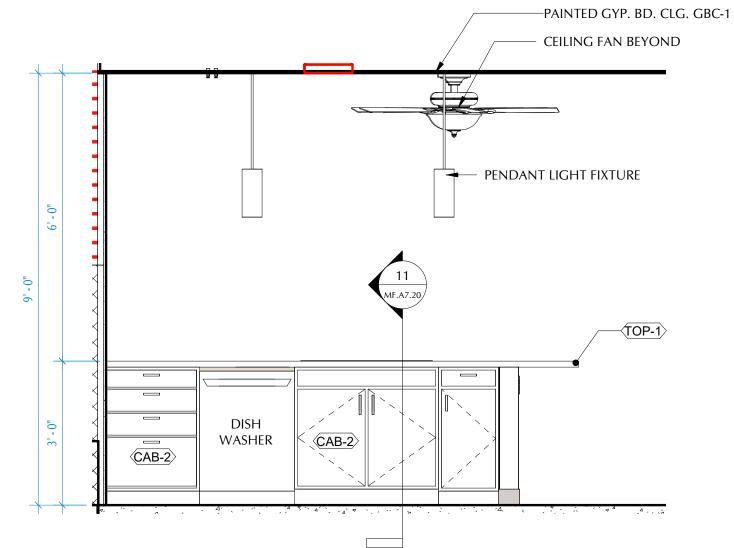

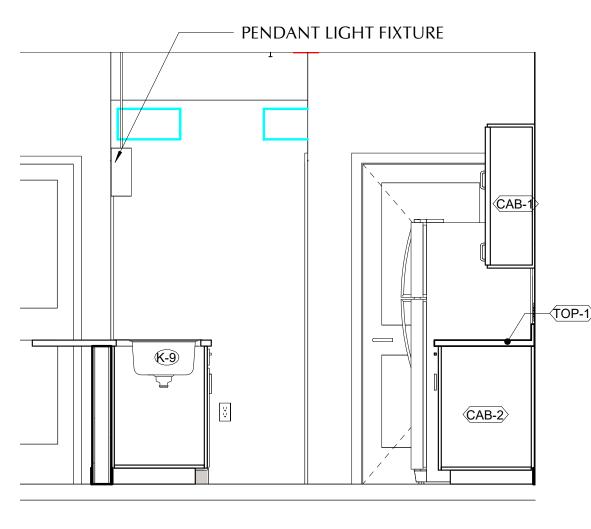

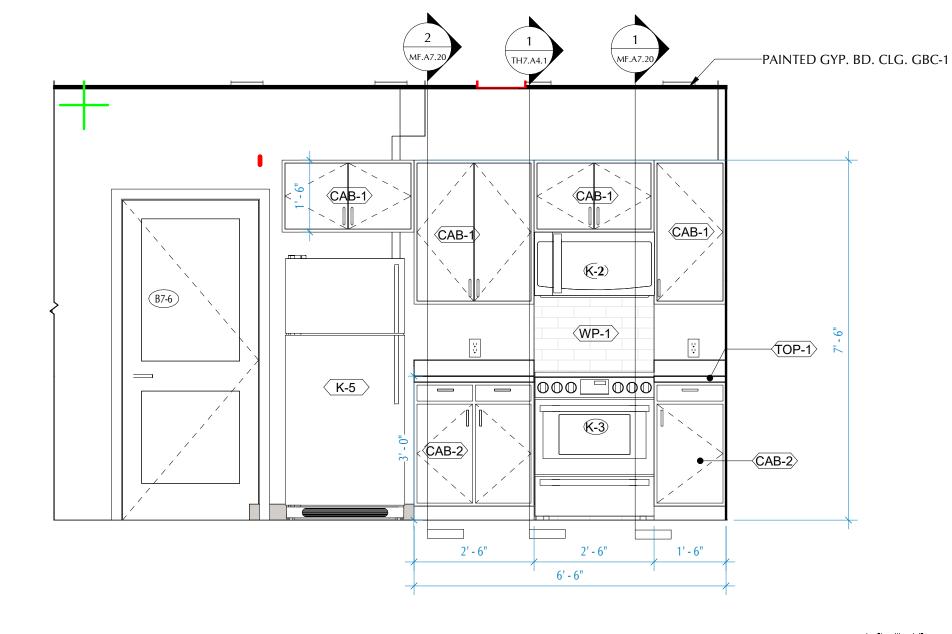












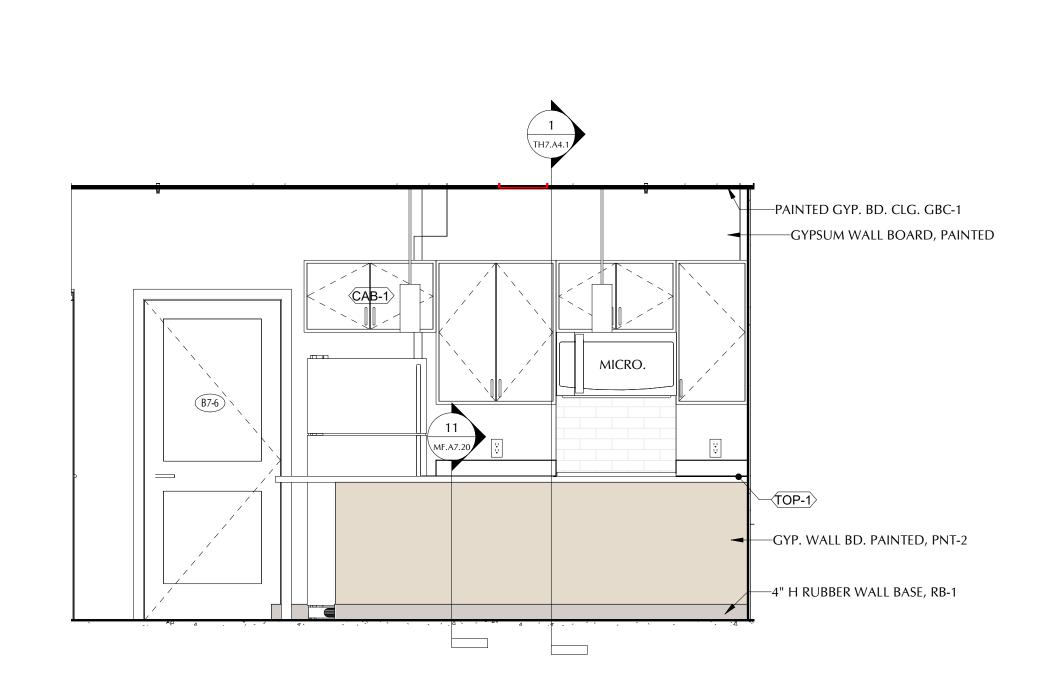

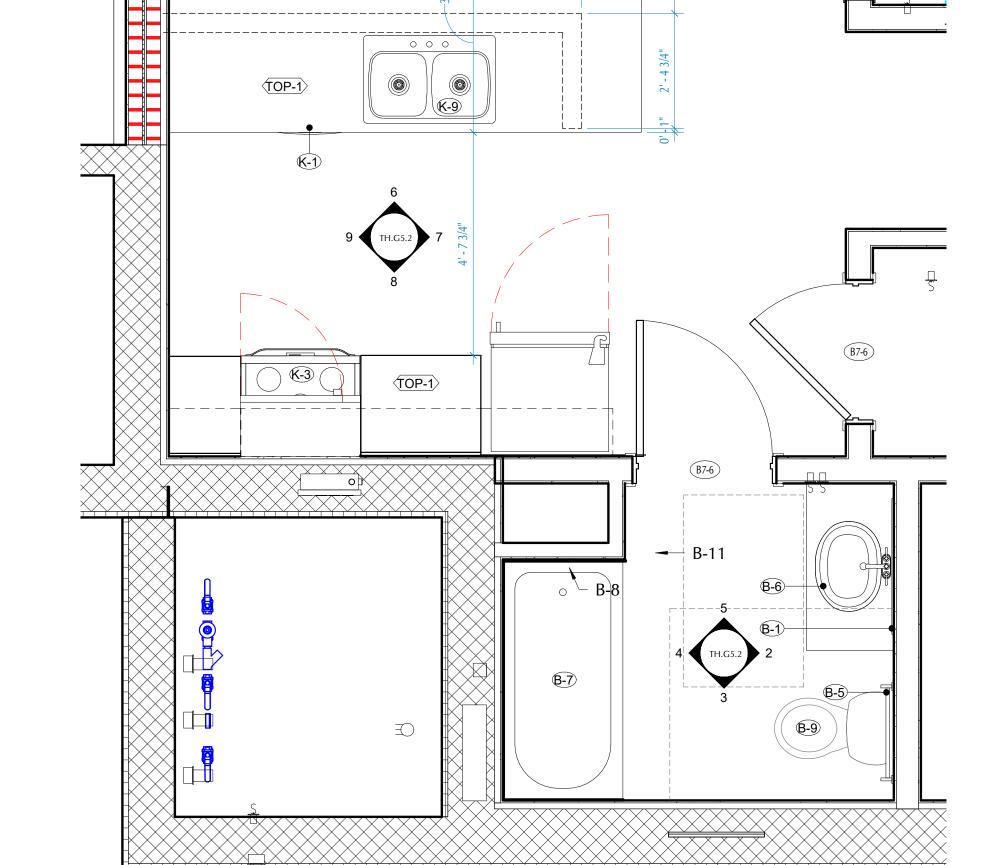

1 ENLARGED KITCHEN & BATH PLAN - J2 1/2" = 1'-0"

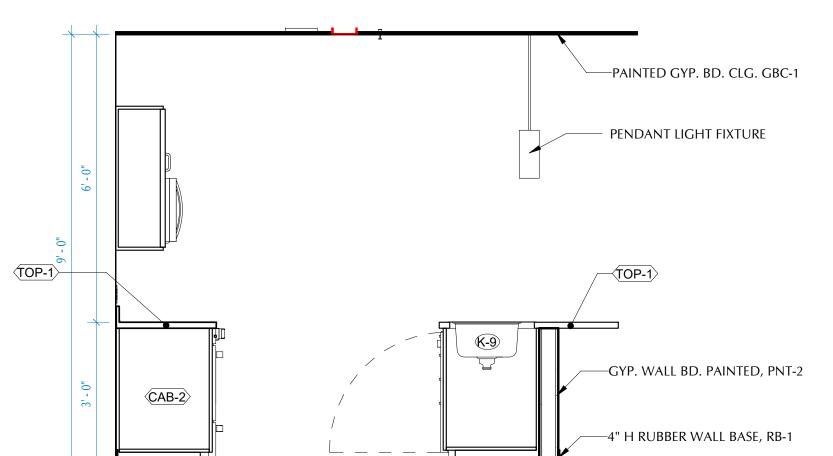

9 INT KITCHEN ELEV - J2 1/2" = 1'-0"

10 INT KITCHEN ELEV - J2

1/2" = 1'-0"

TH.G5.2 © 2015 Gensler

Seal / Signature

Project Number

193076


As indicated

AUSTIN HOMES - PHASE 1A

ENLARGED FLOOR PLANS &

INTERIOR ELEVATIONS - UNIT NAME

05/06/2020

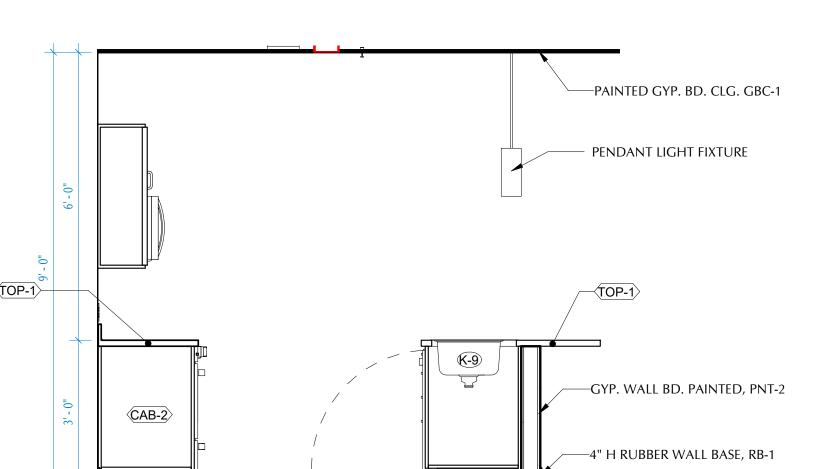

FLOOR PLAN KEY - TYP. BATH			
MARK	DESCRIPTION	NOTES	
B-1 B-2 B-3 B-4 B-5 B-6 B-7 B-8 B-8A B-9 B-10 B-11	FRAMED MIRROR TOILET PAPER DISPENSER GRAB BARS SHOWER CURTAIN ROD TOWEL BAR INTEGRAL VANITY SINK PREFAB BATHTUB W/ FOLDING SEAT STANDARD SHOWER CONTROLS ADA SHOWER CONTROLS WATER CLOSET SHOWER PAN BASE ROBE HOOK	NOTE #9 & 10 SEE PLUMB SEE PLUMB SEE PLUMB NOTE #9 & 10 NOTE #7	

FLO	OR PLAN KEY - TYP. KI	TCHEN
MARK	DESCRIPTION	NOTES
K-1	STANDARD DISHWASHER	O.F.C.I.
K-1A	ACCESSIBLE DISHWASHER	O.F.C.I.
K-2	OVER THE RANGE VENTED MICROWAVE	O.F.C.I.
K-2A	ACCESSIBLE MICROWAVE, COUNTERTOP	O.F.C.I.
K3	OVEN RANGE	O.F.C.I.
K-3A	ACCESSIBLE RANGE; FRONT ACCESS CONTROLS	O.F.C.I.
K-4	VENTILATION HOOD - ACCESSIBLE WALL SWITCH	
K-5	REFRIGERATOR, TOP FREEZER W/ ICEMAKER	O.F.C.I.
K-6	HEAVY DUTY WIRE SHELVING	NOTE #5
K-7	CLOTHES WASHER; TOP LOADING	N.I.C.
K-8	DRYER; FRONT LOADING	N.I.C.
K-9	DOUBLE-BOWL KITCHEN SINK; UNDERMOUNT	
K-10	STACKING WASHER & DRYER UNIT	N.I.C.
K-11	WATER HEATER	
	I .	1

ENLARGED PLAN NOTES

COORDINATE WITH APPLICABLE DIMENSIONS AND DETAILS ON OTHER SHEETS WHERE INDICATED WITH A DASHED LINE, PROVIDE BLOCKING AS REQ'D FOR FUTURE GRAB BAR INSTALLATION COORDINATE ALL KITCHEN APPLIANCE & REQUIREMENTS WITH OWNER PRIOR TO FINAL PURCHASE & INSTALLATION COORDINATE ALL BATHROOM ACCESSORY REQUIREMENTS WITH OWNER PRIOR TO FINAL PURCHASE & INSTALLATION TYPICAL AT ALL LAUNDRY ROOMS - PROVIDE (2) HEAVY DUTY WIRE SHELVING (WHITE) W/ WALL MOUNTED BRACKETS & BLOCKING AS REQ'D ABOVE ALL WASHER & DRYER UNITS. REFER TO FINISH LEGEND FOR BRACKET INFORMATION. WASHER & DRYER (N.I.C) PROVIDE C'TOP SUPPORT & BLOCKING AS REQ'D AT ALL KITCHEN ISLANDS INSTALL (1) ROBE HOOK @ EA. BATHROOM DOOR - TYPICAL AT ALL TENANT BATHROOMS / SINGLE COMPARTMENT RESTROOMS

NOTES & DETAILS


B-4

REFER TO SHEET G1.1 FOR MOUNTING HEIGHTS, ACCESSIBLE

GRAB BARS; INSTALL BLOCKING

- BATHTUB W/ REMOVABLE SEAT

SEE SHEET MF.A7.19 FOR FINISHES, LEGENDS, AND NOTES.

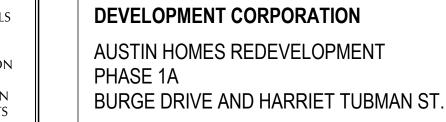

KNOXVILLE'S COMMUNITY

KCDC

Tel 865.671.9060 2240 Sutherland Avenue Suite 105 Knoxville, TN 37919 **United States**


Gensler

∆ Date Description


2 5/26/20 ADDENDUM 1


1 5/06/20 PLANS REVIEW COMMENTS


11 East Madison Street Tel 312.456.0123 Fax 312.456.0124

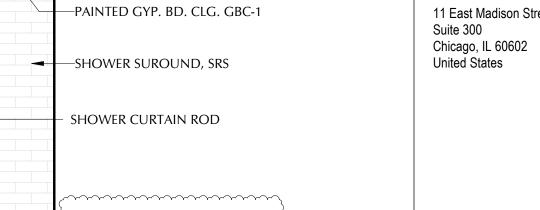

6-11

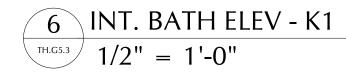


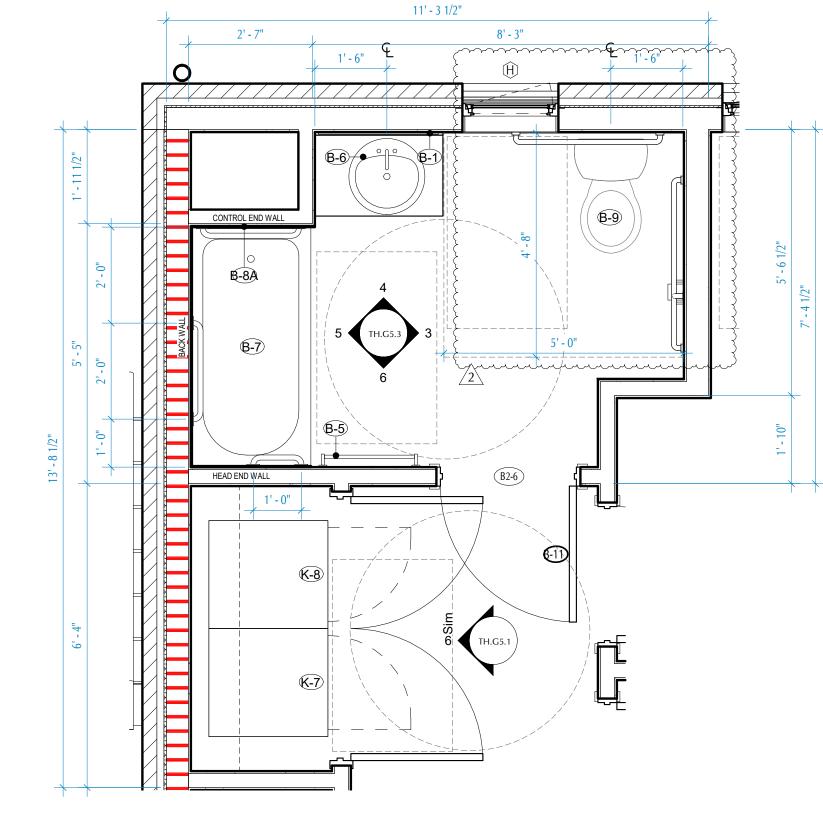


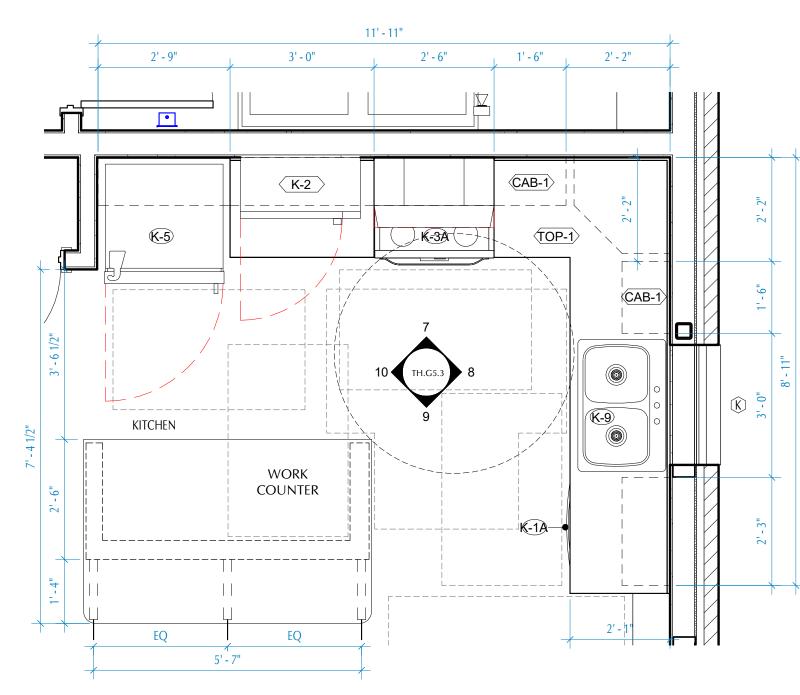


1 ENLARGED KITCHEN PLAN - UNIT NAME 'K1' TH.G5.3 1/2" = 1'-0"


2 ENLARGED BATH PLAN - UNIT NAME 'K1' TH.G5.3 1/2" = 1'-0"

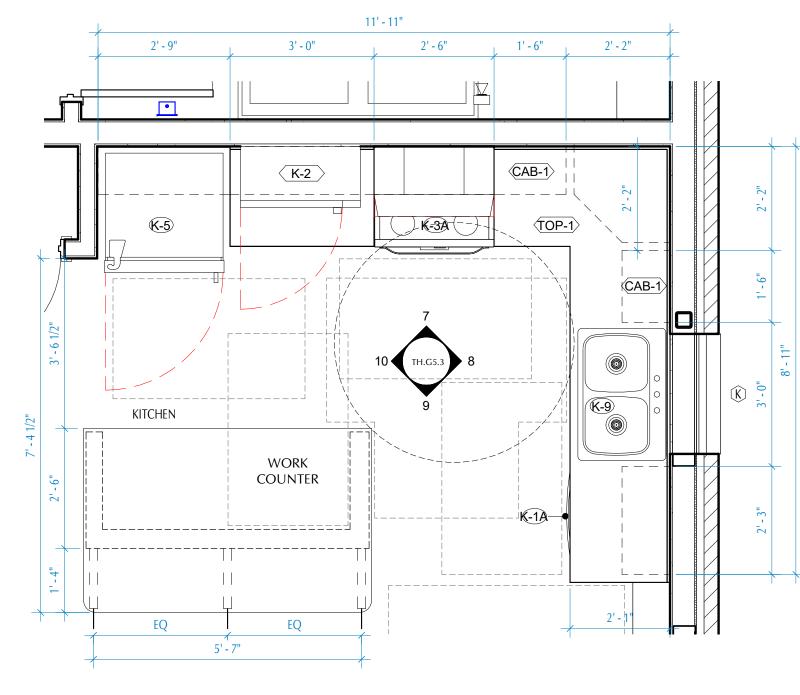

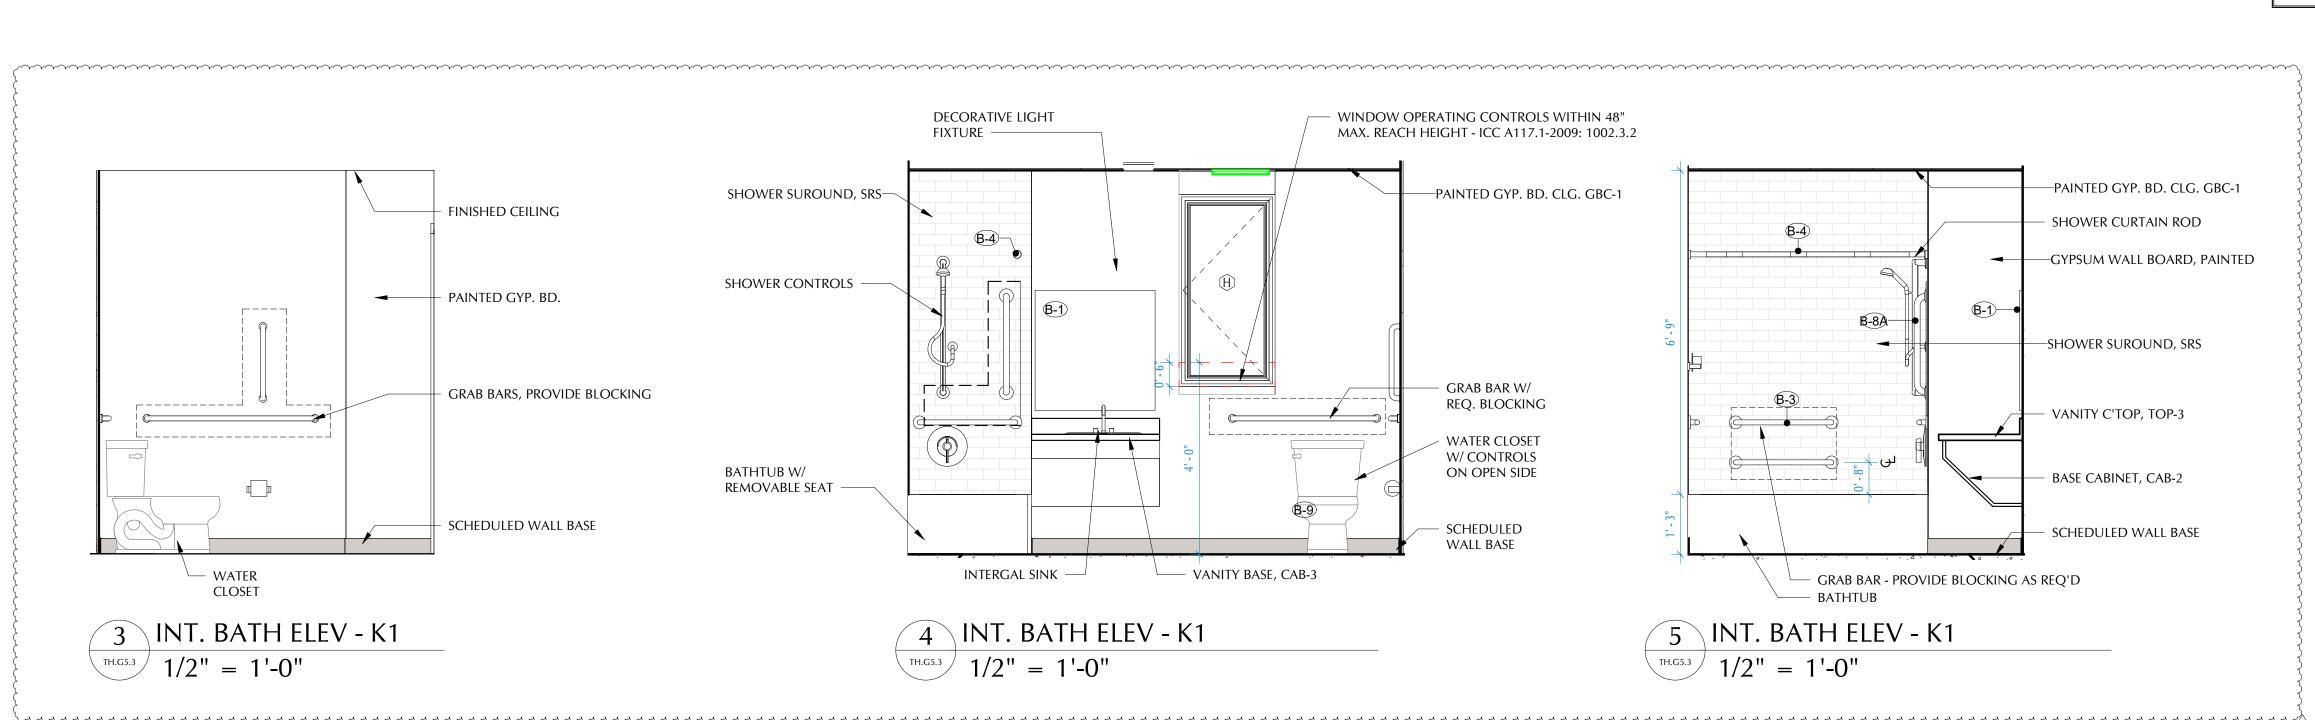


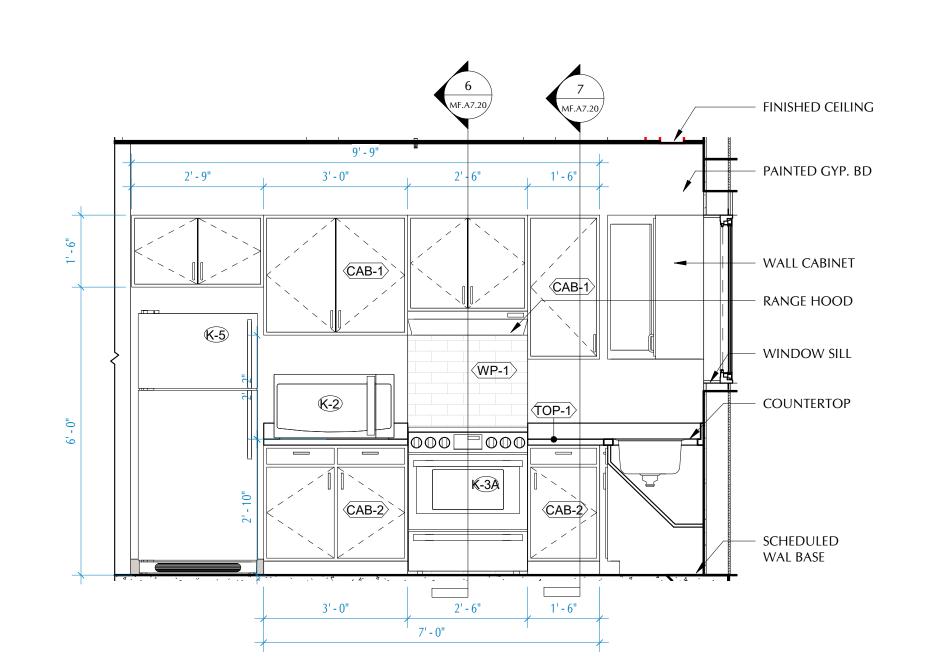


7 INT. KITCHEN ELEV - K1 1/2" = 1'-0"

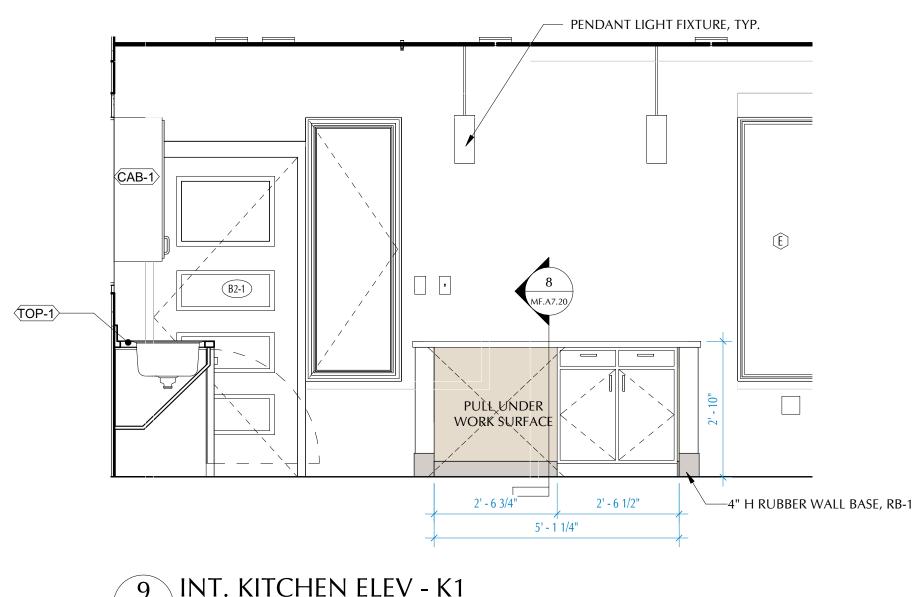

9 INT. KITCHEN ELEV - K1 1/2" = 1'-0"

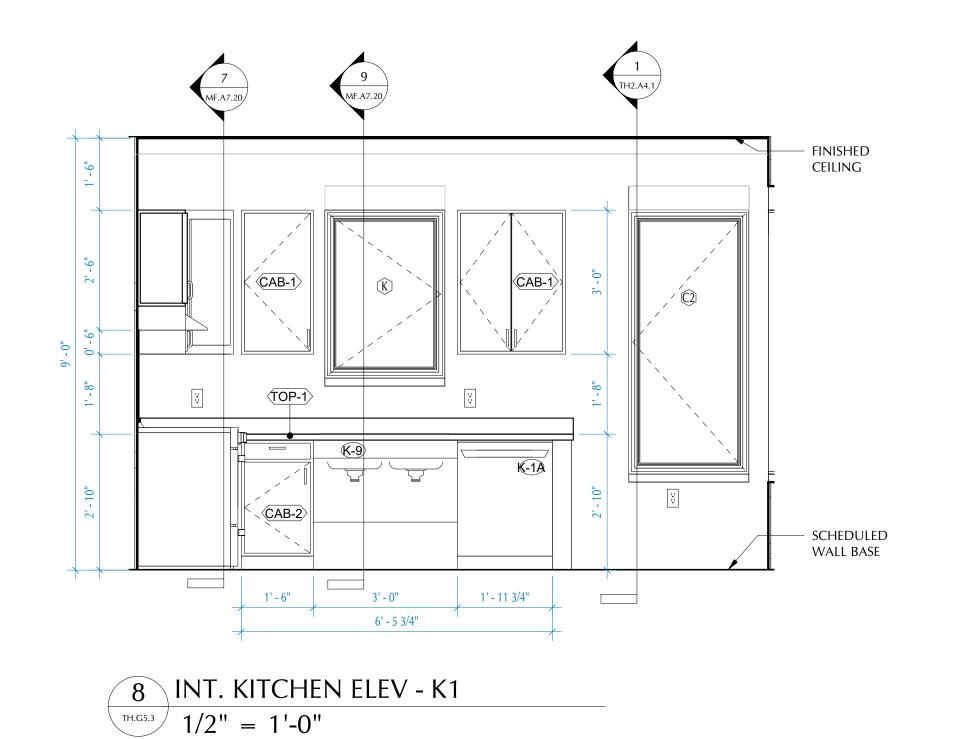

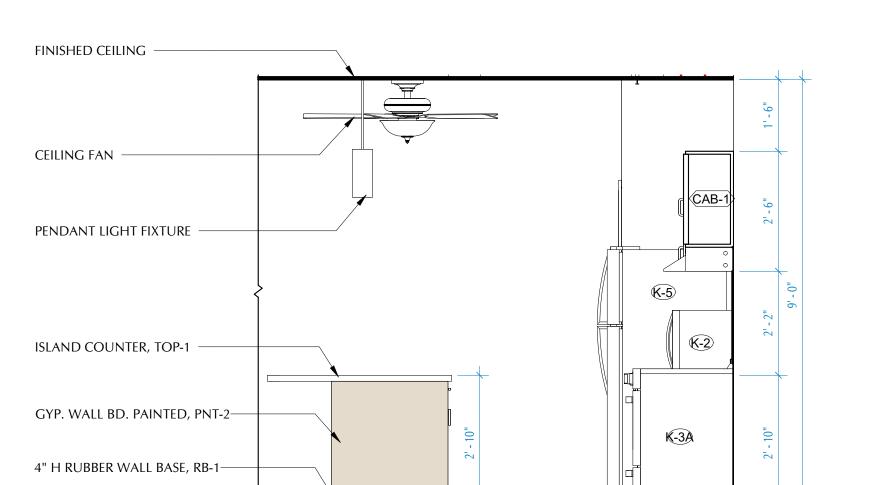

10 INT. KITCHEN ELEV - K1 1/2" = 1'-0"

TH.G5.3

As indicated

Seal / Signature

Project Name

Project Number

193076


Description

AUSTIN HOMES - PHASE 1A

ENLARGED FLOOR PLAN & INTERIOR

ELEVATIONS - ACCESSIBLE UNIT 'K1'

05/06/2020

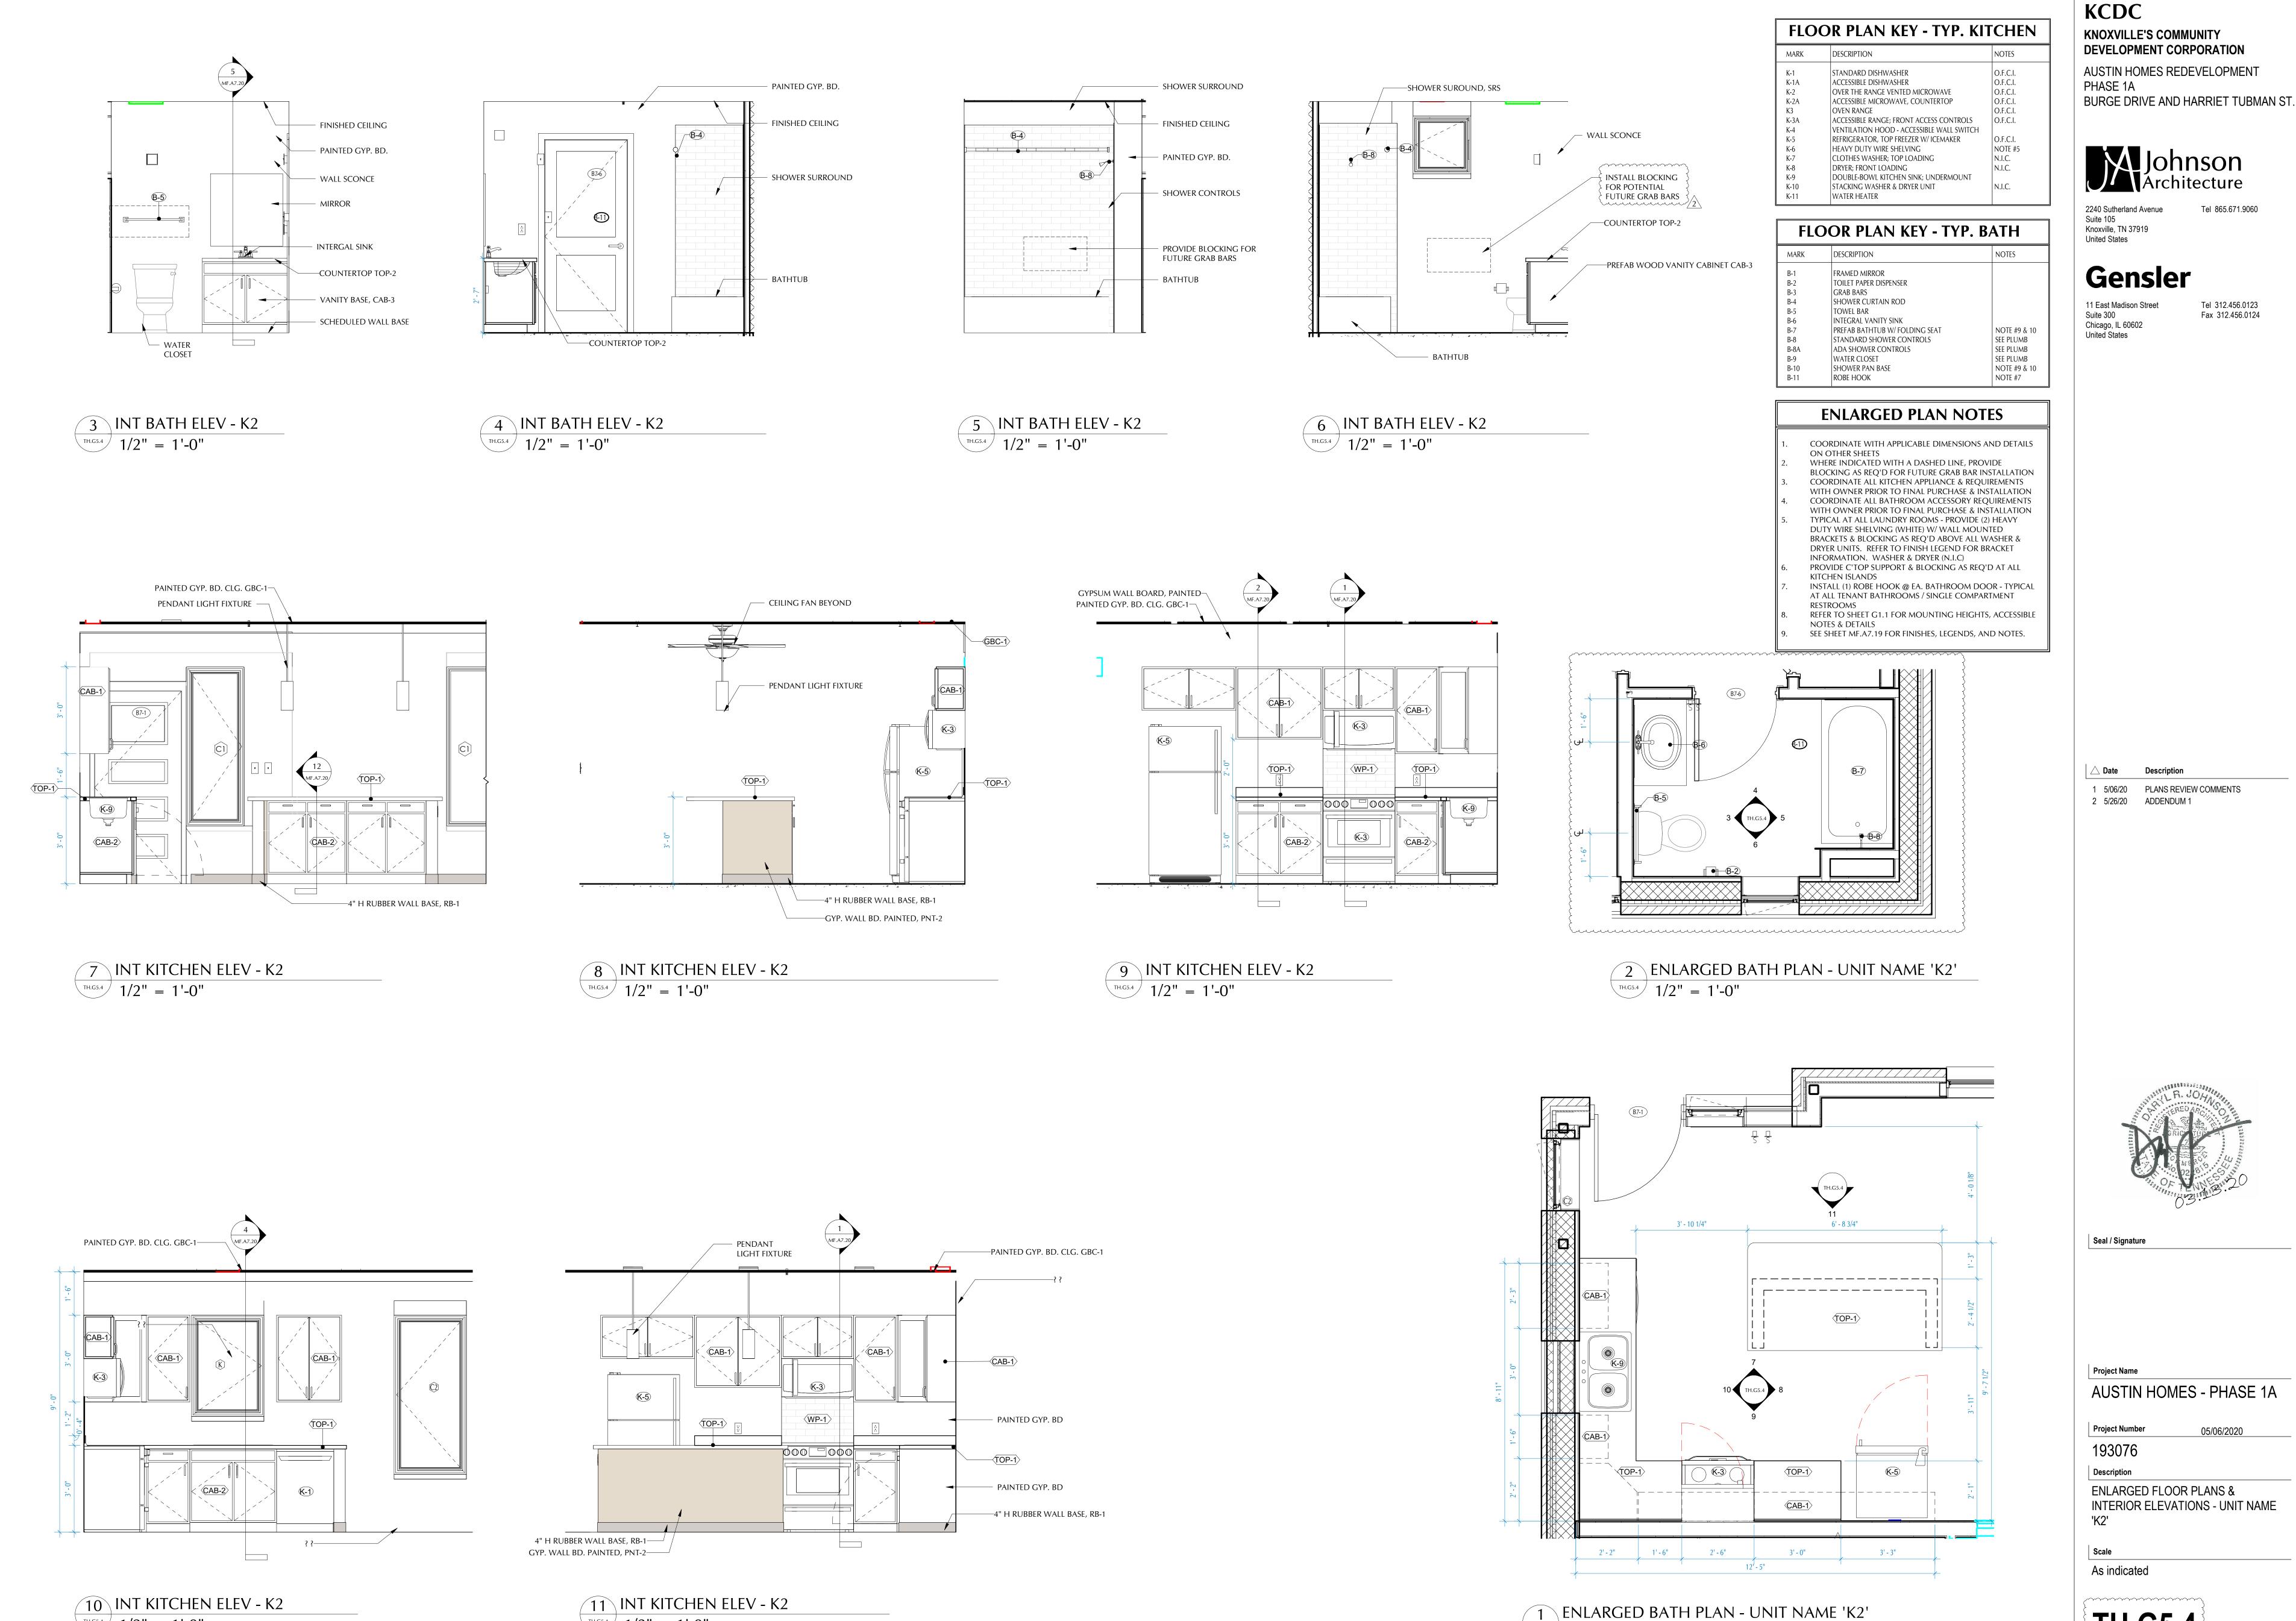

1/2" = 1'-0"

TH.G5.4 1/2" = 1'-0"

© 2015 Gensler

`````\\_`\\_``\

KNOXVILLE'S COMMUNITY

AUSTIN HOMES REDEVELOPMENT




Tel 865.671.9060


Tel 312.456.0123 Fax 312.456.0124

ENLARGED FLOOR PLANS & INTERIOR ELEVATIONS - UNIT NAME

TH.G5.4

1/2" = 1'-0"

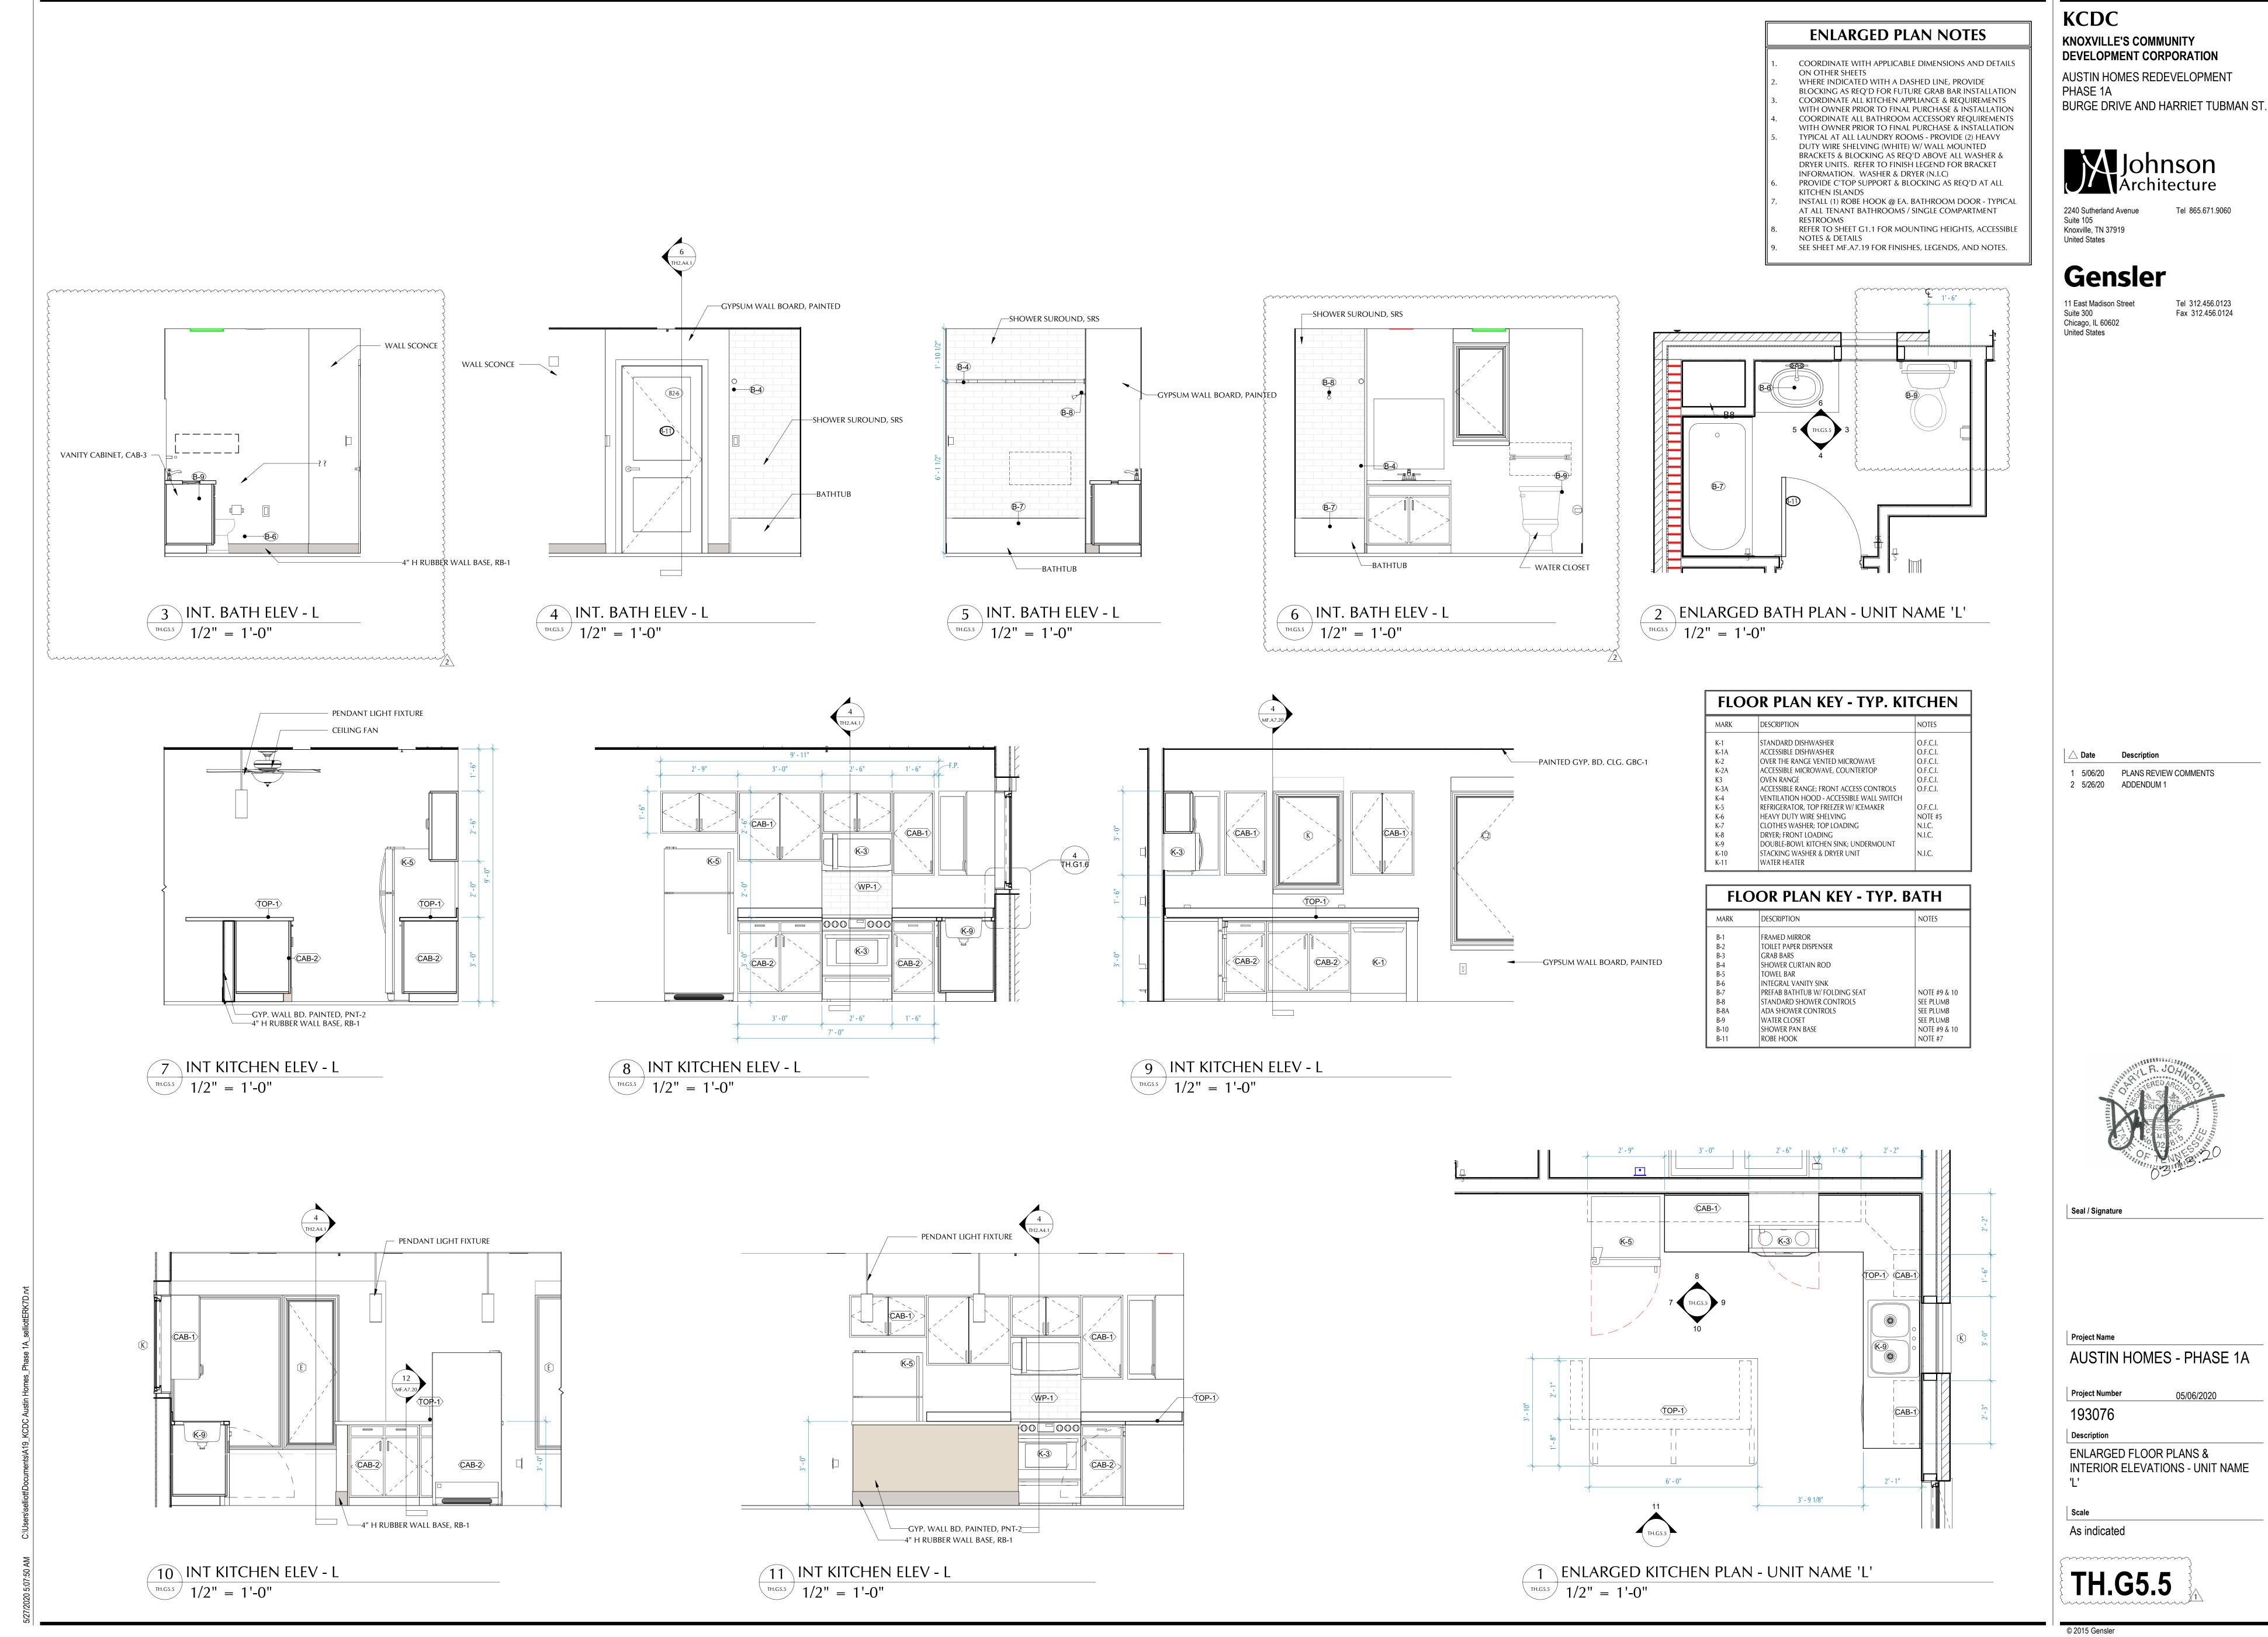

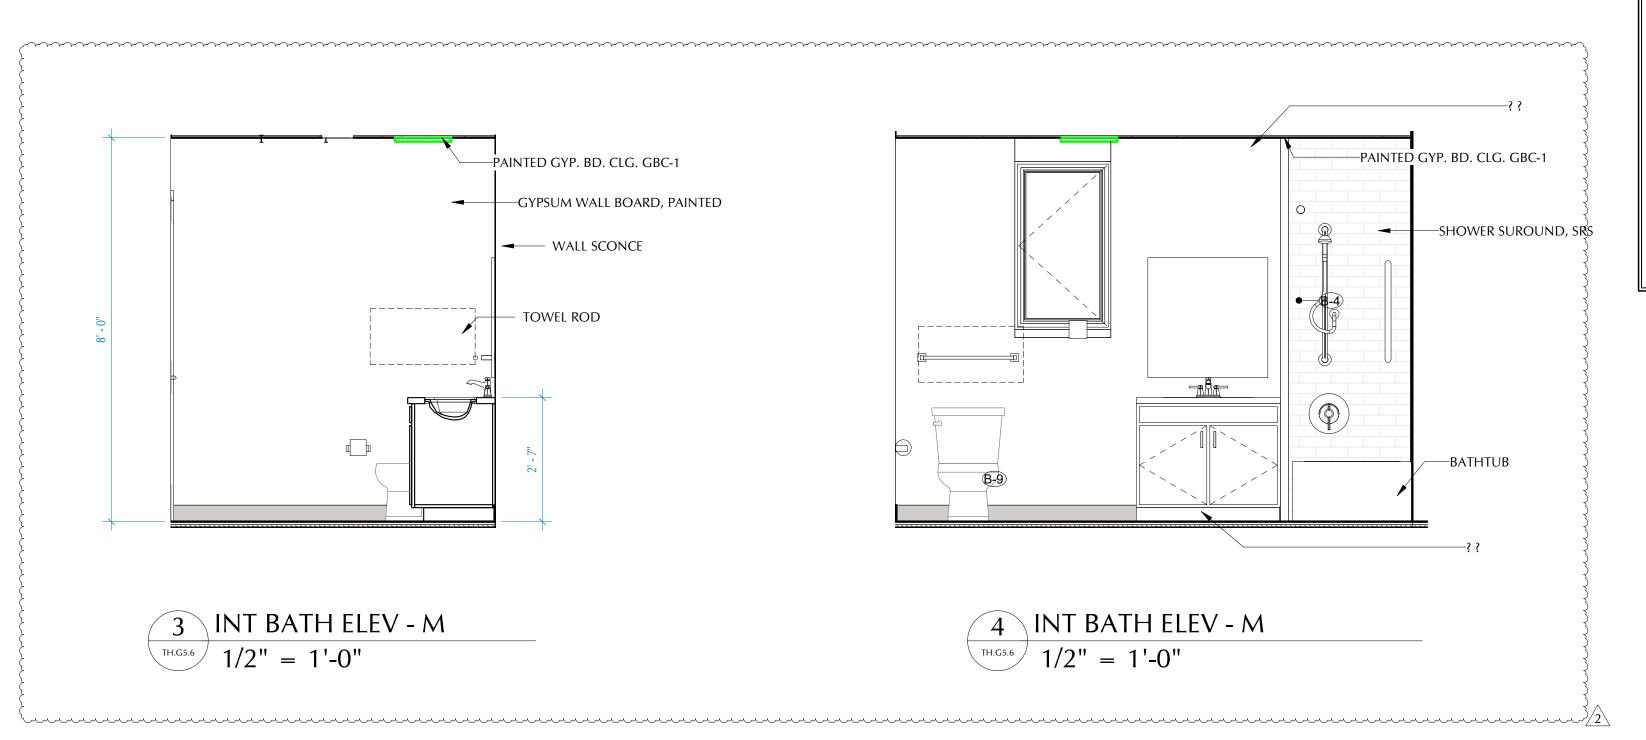

\\_\_BATHTUB

6 INT BATH ELEV - M 1/2" = 1'-0"

—PAINTED GYP. BD. CLG. GBC-1

—BATHTUB

—SHOWER SUROUND, SRS

# ENLARGED PLAN NOTES

COORDINATE WITH APPLICABLE DIMENSIONS AND DETAILS ON OTHER SHEETS
 WHERE INDICATED WITH A DASHED LINE, PROVIDE BLOCKING AS REQ'D FOR FUTURE GRAB BAR INSTALLATION
 COORDINATE ALL KITCHEN APPLIANCE & REQUIREMENTS WITH OWNER PRIOR TO FINAL PURCHASE & INSTALLATION
 COORDINATE ALL BATHROOM ACCESSORY REQUIREMENTS WITH OWNER PRIOR TO FINAL PURCHASE & INSTALLATION
 TYPICAL AT ALL LAUNDRY ROOMS - PROVIDE (2) HEAVY DUTY WIRE SHELVING (WHITE) W/ WALL MOUNTED BRACKETS & BLOCKING AS REQ'D ABOVE ALL WASHER & DRYER UNITS. REFER TO FINISH LEGEND FOR BRACKET INFORMATION. WASHER & DRYER (N.I.C)
 PROVIDE C'TOP SUPPORT & BLOCKING AS REQ'D AT ALL

KITCHEN ISLANDS
INSTALL (1) ROBE HOOK @ EA. BATHROOM DOOR - TYPICAL
AT ALL TENANT BATHROOMS / SINGLE COMPARTMENT
RESTROOMS
REFER TO SHEET G1.1 FOR MOUNTING HEIGHTS, ACCESSIBLE


REFER TO SHEET G1.1 FOR MOUNTING HEIGHTS, ACCESSIBLE NOTES & DETAILS
SEE SHEET MF.A7.19 FOR FINISHES, LEGENDS, AND NOTES.

# FLOOR PLAN KEY - TYP. KITCHEN

MARK	DESCRIPTION	NOTES
K-1	STANDARD DISHWASHER	O.F.C.I.
K-1A	ACCESSIBLE DISHWASHER	O.F.C.I.
K-2	OVER THE RANGE VENTED MICROWAVE	O.F.C.I.
K-2A	ACCESSIBLE MICROWAVE, COUNTERTOP	O.F.C.I.
K3	OVEN RANGE	O.F.C.I.
K-3A	ACCESSIBLE RANGE; FRONT ACCESS CONTROLS	O.F.C.I.
K-4	VENTILATION HOOD - ACCESSIBLE WALL SWITCH	
K-5	REFRIGERATOR, TOP FREEZER W/ ICEMAKER	O.F.C.I.
K-6	HEAVY DUTY WIRE SHELVING	NOTE #5
K-7	CLOTHES WASHER; TOP LOADING	N.I.C.
K-8	DRYER; FRONT LOADING	N.I.C.
K-9	DOUBLE-BOWL KITCHEN SINK; UNDERMOUNT	
K-10	STACKING WASHER & DRYER UNIT	N.I.C.
K-11	WATER HEATER	

## FLOOR PLAN KEY - TYP. BATH

MARK	DESCRIPTION	NOTES
B-1	FRAMED MIRROR	
B-2	TOILET PAPER DISPENSER	
B-3	GRAB BARS	
B-4	SHOWER CURTAIN ROD	
B-5	TOWEL BAR	
B-6	INTEGRAL VANITY SINK	
B-7	PREFAB BATHTUB W/ FOLDING SEAT	NOTE #9 & 10
B-8	STANDARD SHOWER CONTROLS	SEE PLUMB
B-8A	ADA SHOWER CONTROLS	SEE PLUMB
B-9	WATER CLOSET	SEE PLUMB
B-10	SHOWER PAN BASE	NOTE #9 & 10
B-11	ROBE HOOK	NOTE #7

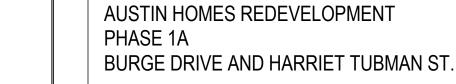

KNOXVILLE'S COMMUNITY

DEVELOPMENT CORPORATION

**KCDC** 

Johnson Architecture

Architecture

2240 Sutherland Avenue


Tel 865.671.9060

# Gensler


Suite 105 Knoxville, TN 37919

**United States** 

11 East Madison Street Tel 312.456.0123
Suite 300 Fax 312.456.0124
Chicago, IL 60602
United States

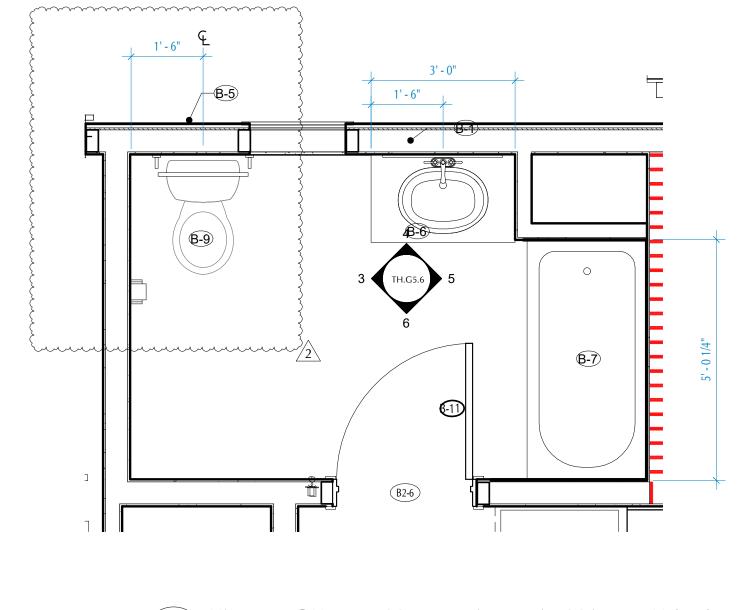




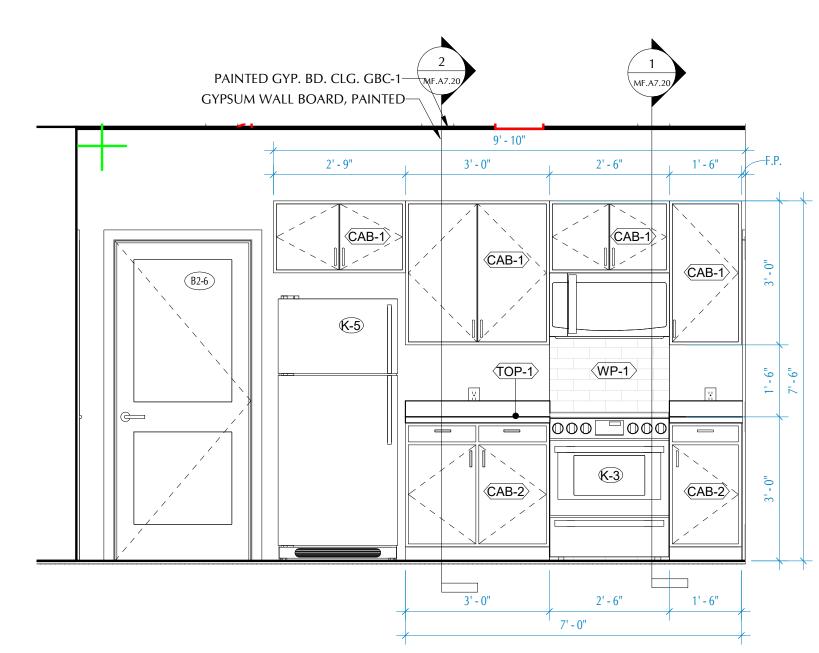


 $\frac{5}{1/2"} = 1'-0"$ 



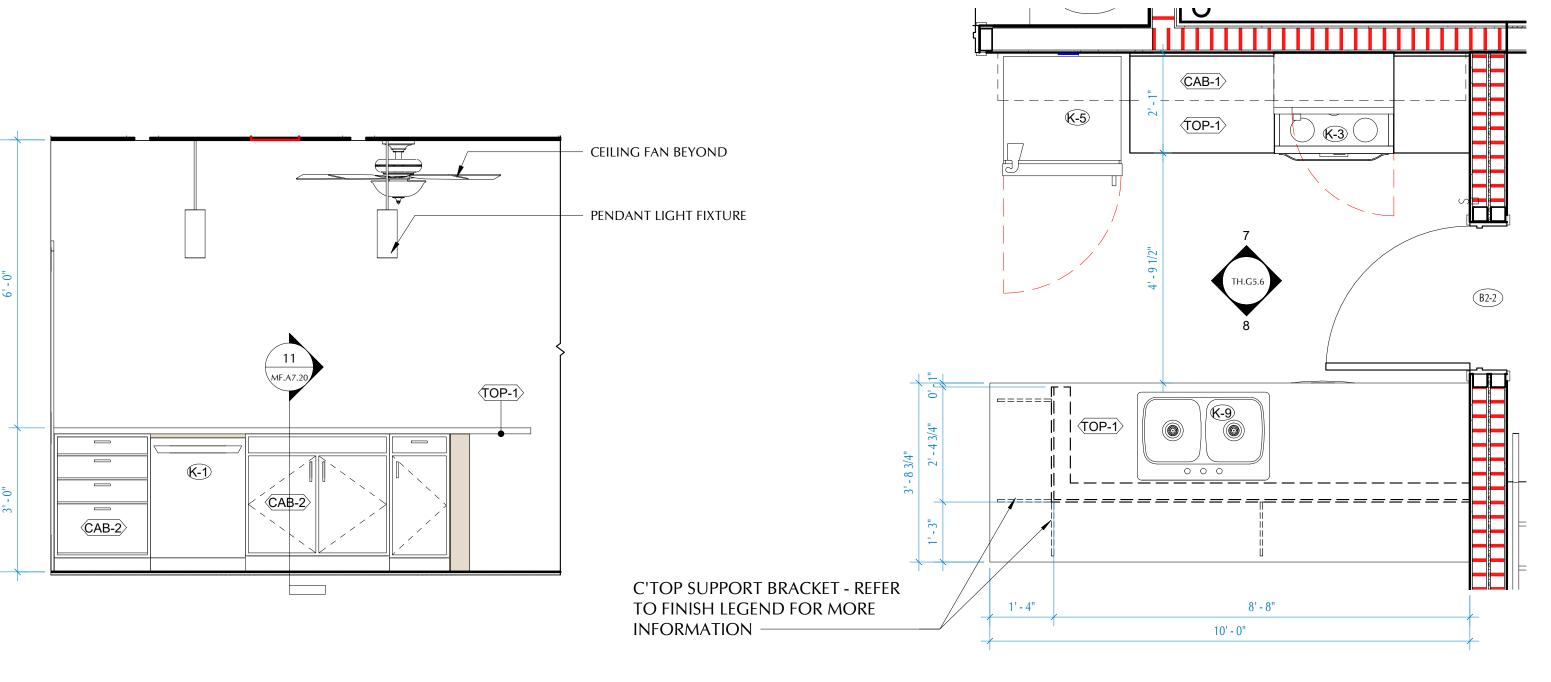



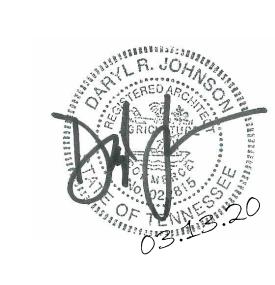

2 5/26/20 ADDENDUM 1

1 5/06/20 PLANS REVIEW COMMENTS

Seal / Signature


F	Project Name			
-	AUSTIN	HOMES -	PHASE	1/


Project Number 05/06/2020
193076
Description

ENLARGED FLOOR PLANS &
INTERIOR ELEVATIONS - UNIT NAME
'M'

Scale
As indicated

TH.G5.6

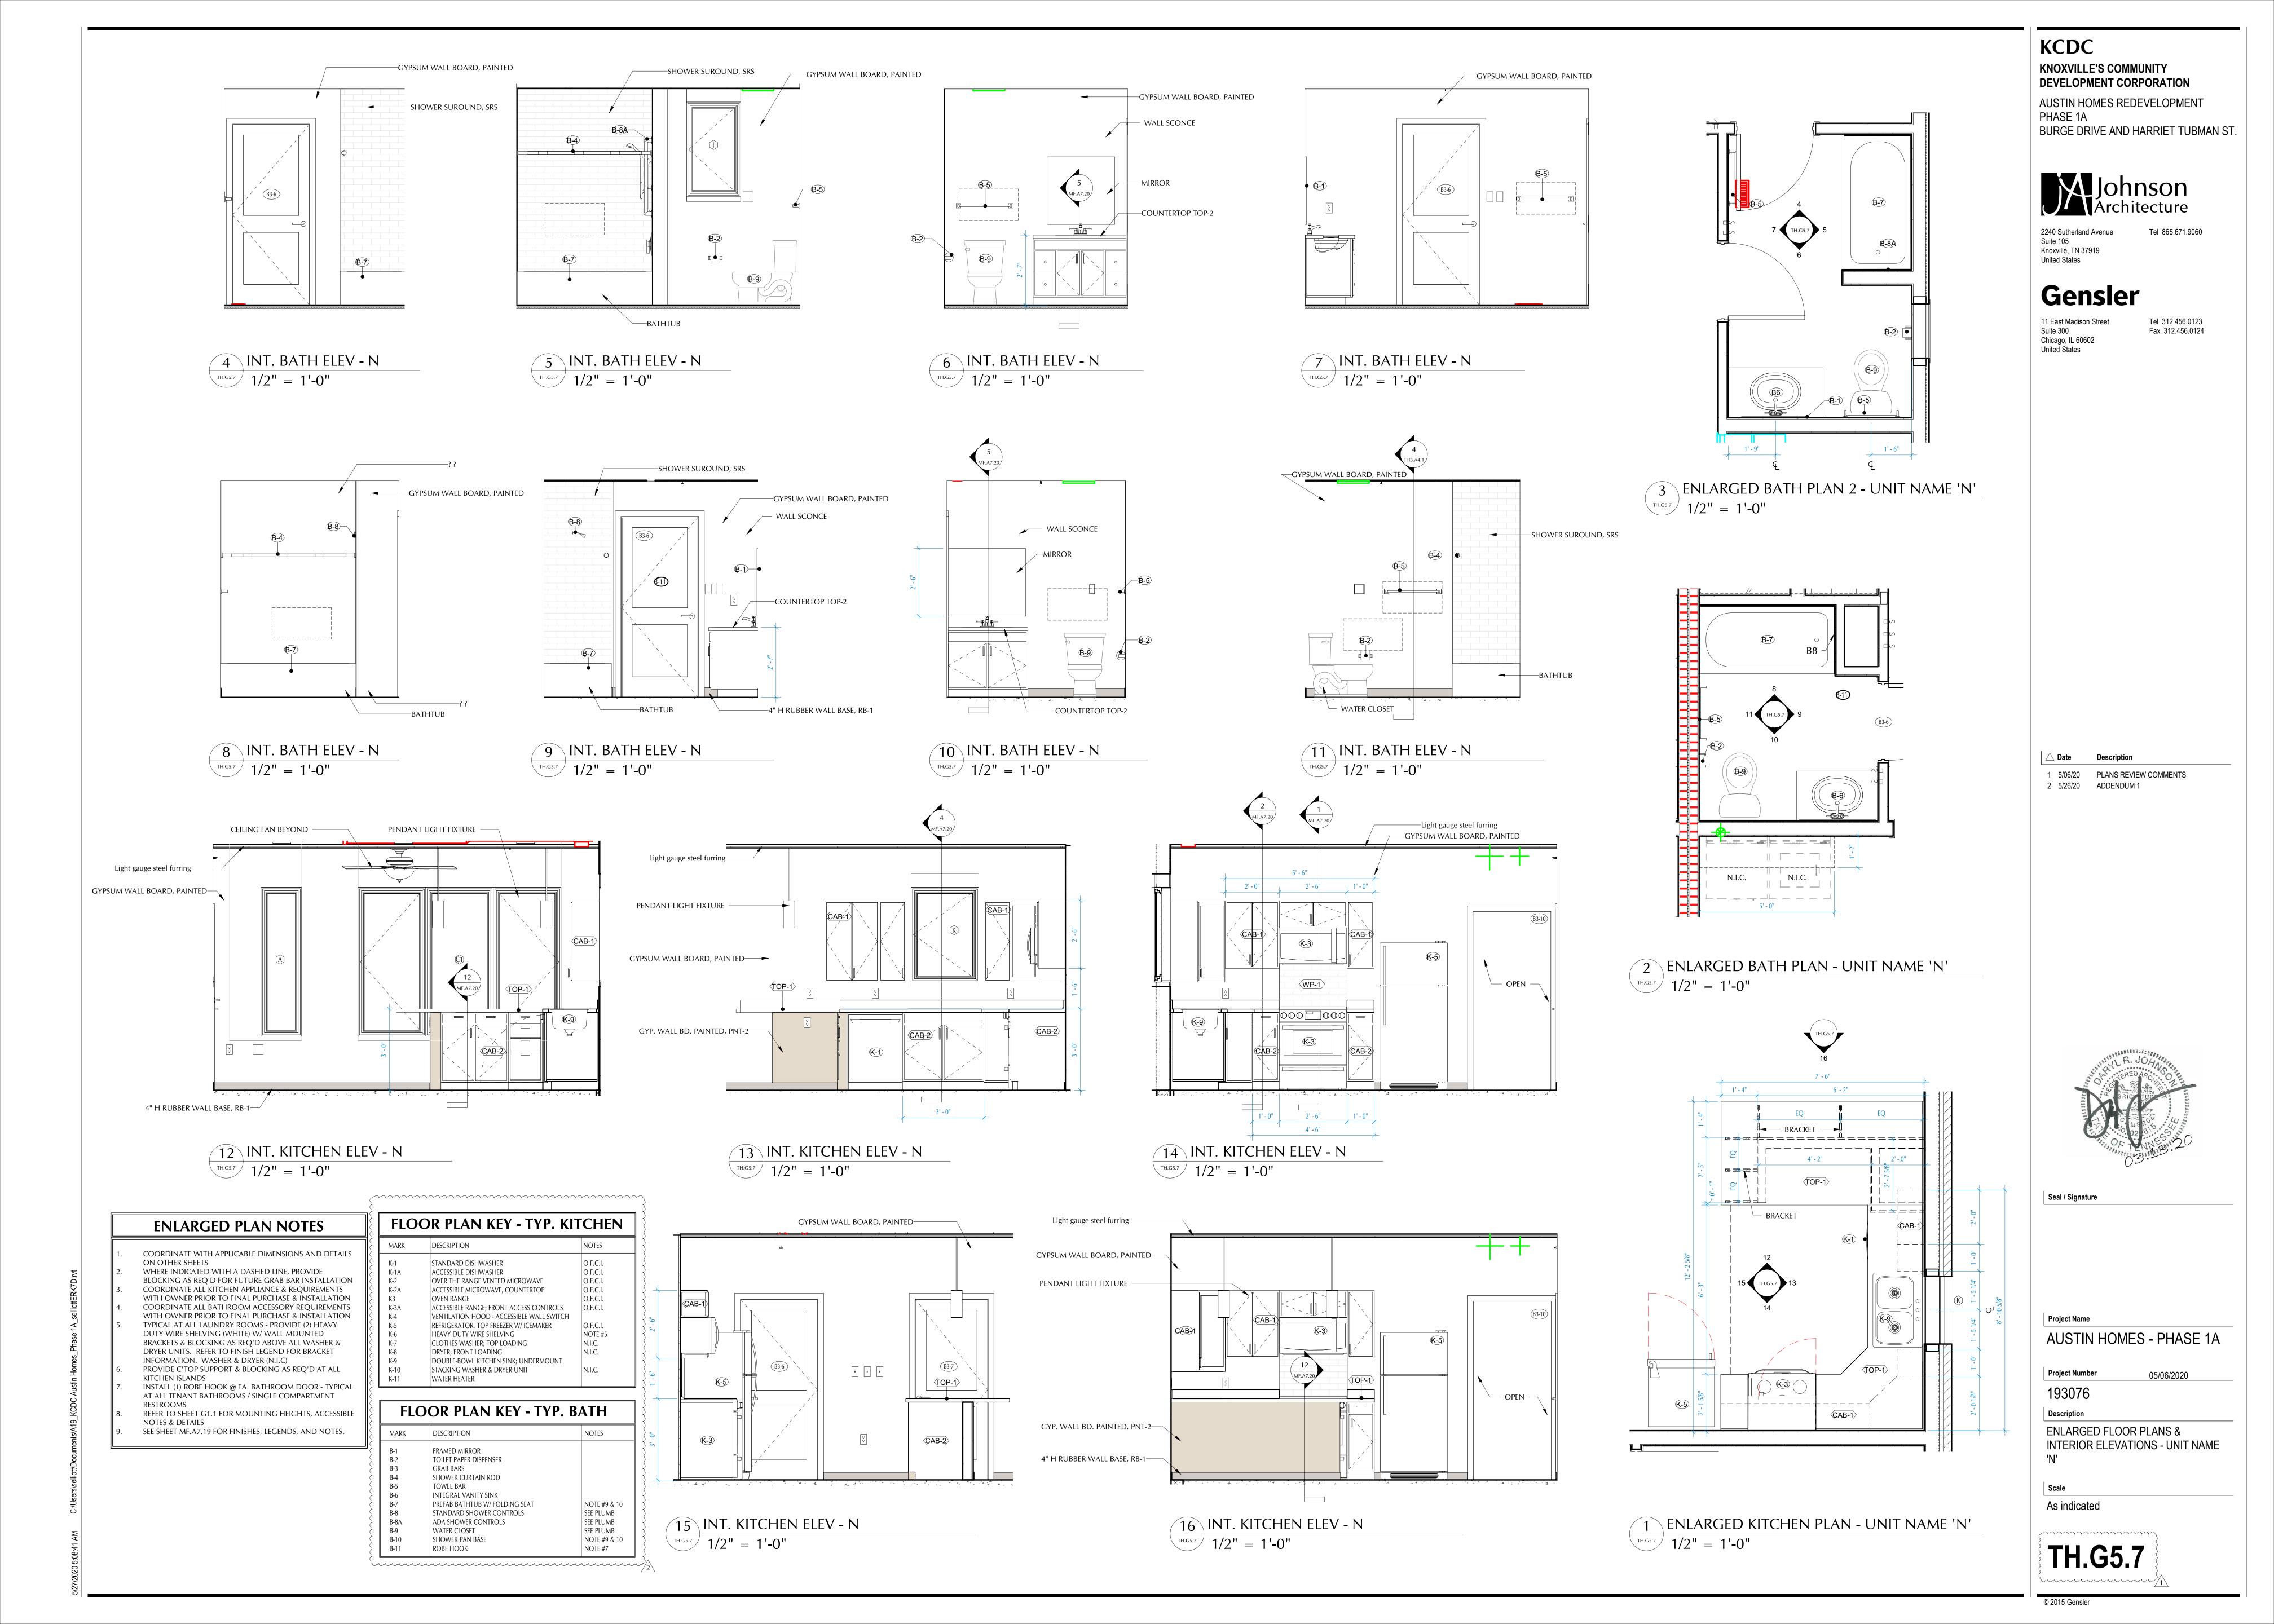


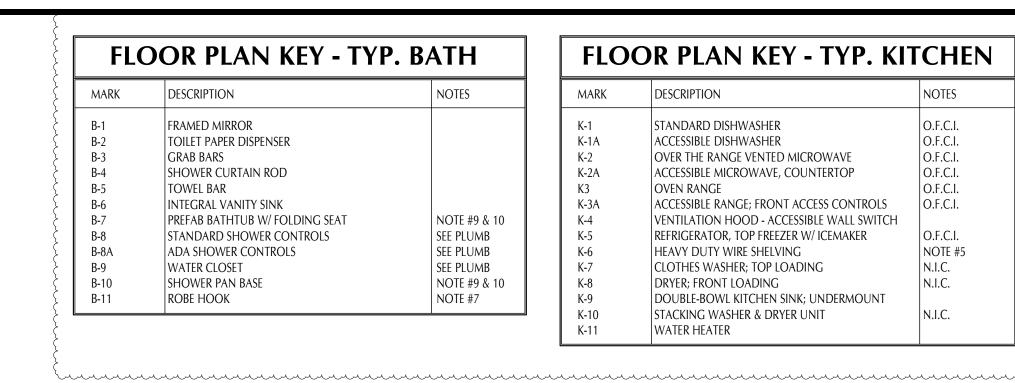

FLOOR PLAN KEY - TYP. KITCHEN		
MARK	DESCRIPTION	NOTES
K-1	STANDARD DISHWASHER	O.F.C.I.
K-1A	ACCESSIBLE DISHWASHER	O.F.C.I.
K-2	OVER THE RANGE VENTED MICROWAVE	O.F.C.I.
K-2A	ACCESSIBLE MICROWAVE, COUNTERTOP	O.F.C.I.
K3	OVEN RANGE	O.F.C.I.
K-3A	ACCESSIBLE RANGE; FRONT ACCESS CONTROLS	O.F.C.I.
K-4	VENTILATION HOOD - ACCESSIBLE WALL SWITCH	
K-5	REFRIGERATOR, TOP FREEZER W/ ICEMAKER	O.F.C.I.
K-6	HEAVY DUTY WIRE SHELVING	NOTE #5
K-7	CLOTHES WASHER; TOP LOADING	N.I.C.
K-8	DRYER; FRONT LOADING	N.I.C.
K-9	DOUBLE-BOWL KITCHEN SINK; UNDERMOUNT	
K-10	STACKING WASHER & DRYER UNIT	N.I.C.
K-11	WATER HEATER	

# **ENLARGED PLAN NOTES**

COORDINATE WITH APPLICABLE DIMENSIONS AND DETAILS ON OTHER SHEETS WHERE INDICATED WITH A DASHED LINE, PROVIDE BLOCKING AS REQ'D FOR FUTURE GRAB BAR INSTALLATION COORDINATE ALL KITCHEN APPLIANCE & REQUIREMENTS WITH OWNER PRIOR TO FINAL PURCHASE & INSTALLATION COORDINATE ALL BATHROOM ACCESSORY REQUIREMENTS WITH OWNER PRIOR TO FINAL PURCHASE & INSTALLATION TYPICAL AT ALL LAUNDRY ROOMS - PROVIDE (2) HEAVY DUTY WIRE SHELVING (WHITE) W/ WALL MOUNTED BRACKETS & BLOCKING AS REQ'D ABOVE ALL WASHER & DRYER UNITS. REFER TO FINISH LEGEND FOR BRACKET INFORMATION. WASHER & DRYER (N.I.C) PROVIDE C'TOP SUPPORT & BLOCKING AS REQ'D AT ALL KITCHEN ISLANDS INSTALL (1) ROBE HOOK @ EA. BATHROOM DOOR - TYPICAL AT ALL TENANT BATHROOMS / SINGLE COMPARTMENT RESTROOMS REFER TO SHEET G1.1 FOR MOUNTING HEIGHTS, ACCESSIBLE NOTES & DETAILS SEE SHEET MF.A7.19 FOR FINISHES, LEGENDS, AND NOTES.

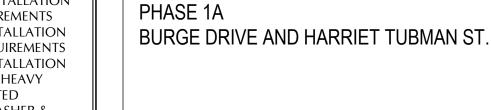

2240 Sutherland Avenue

**KCDC** 

KNOXVILLE'S COMMUNITY

**DEVELOPMENT CORPORATION** 

AUSTIN HOMES REDEVELOPMENT

## Suite 105 Knoxville, TN 37919 United States

Gensler

□ Date Description


2 5/26/20 ADDENDUM 1

1 5/06/20 PLANS REVIEW COMMENTS


11 East Madison Street Suite 300

Tel 312.456.0123 Fax 312.456.0124 Chicago, IL 60602 United States


Tel 865.671.9060

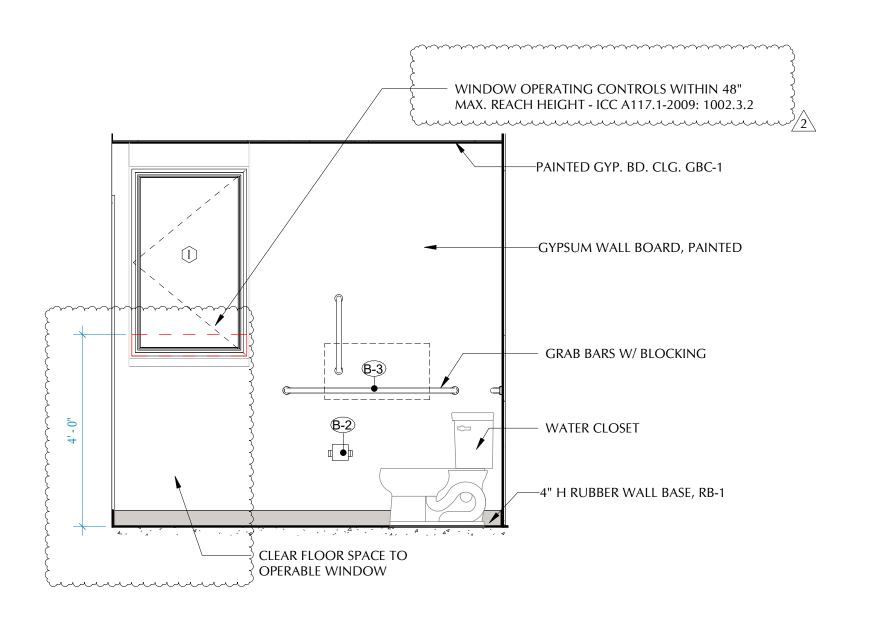




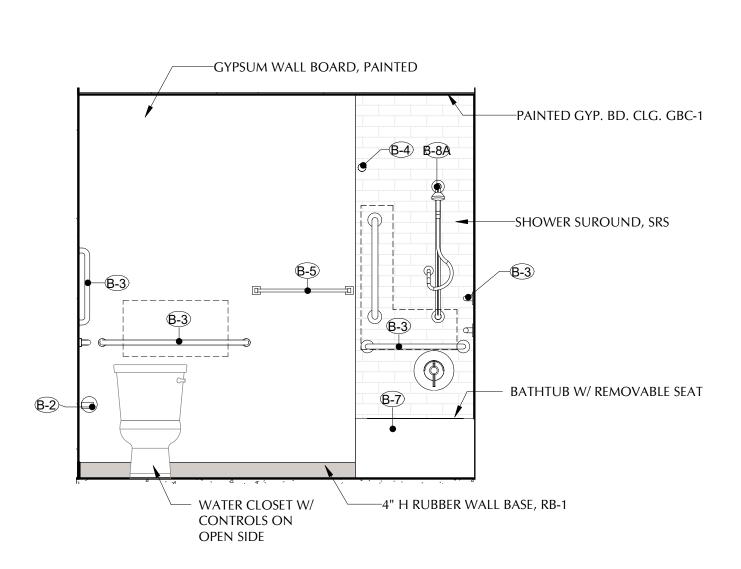


3 INT. BATH ELEV - O

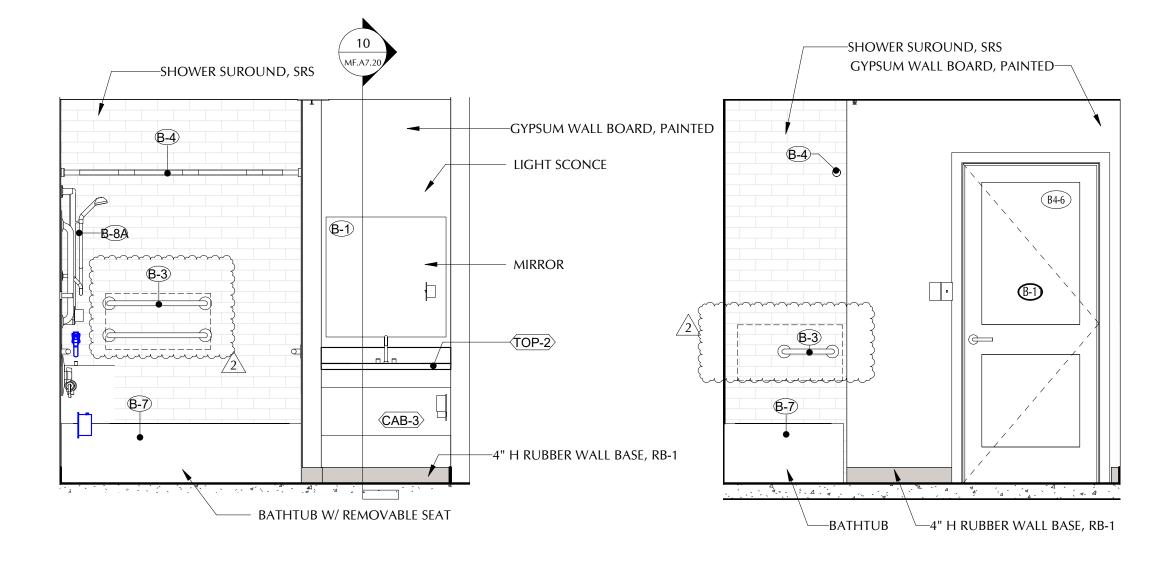


4 INT. BATH ELEV - O

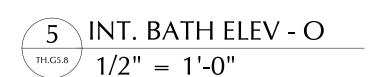


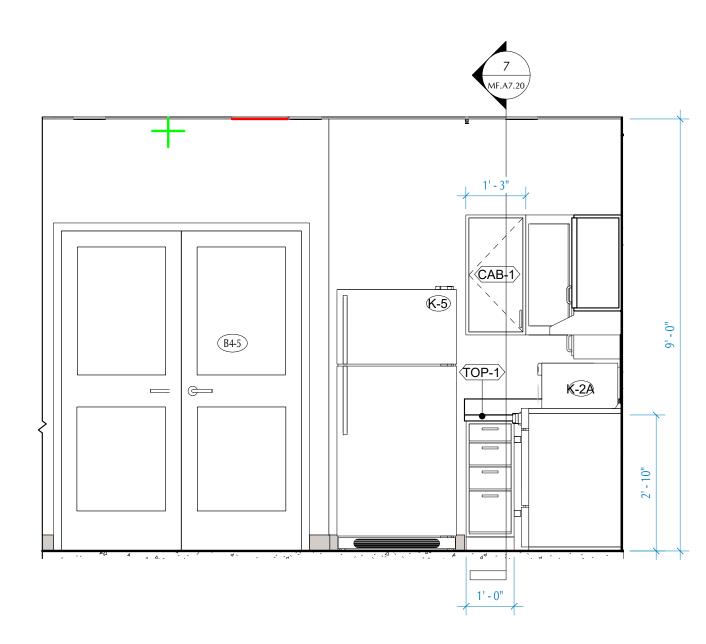





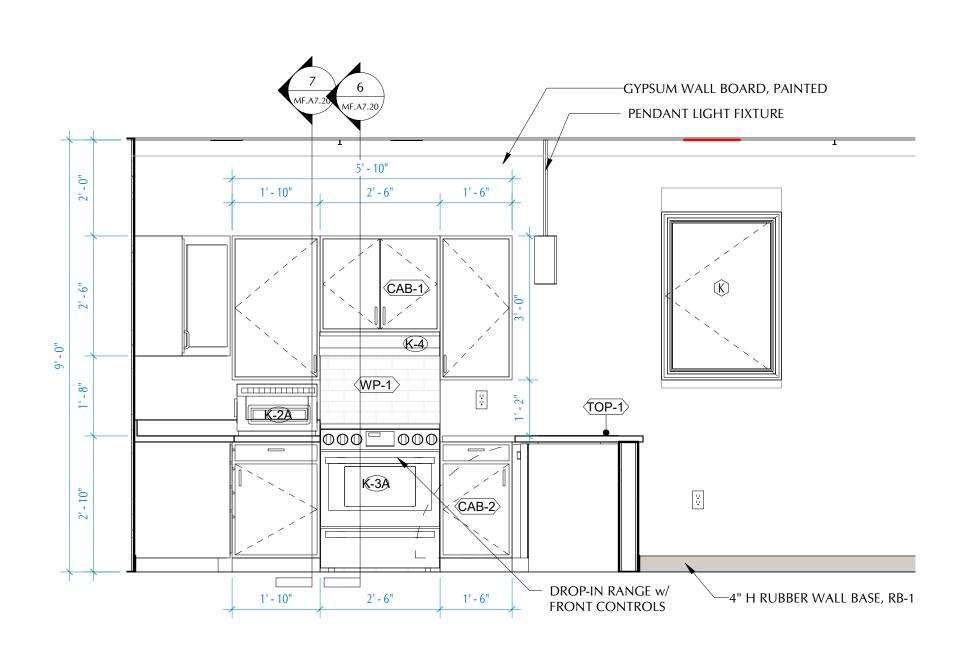

7 INT. KITCHEN ELEV - O TH.G5.8 1/2" = 1'-0"

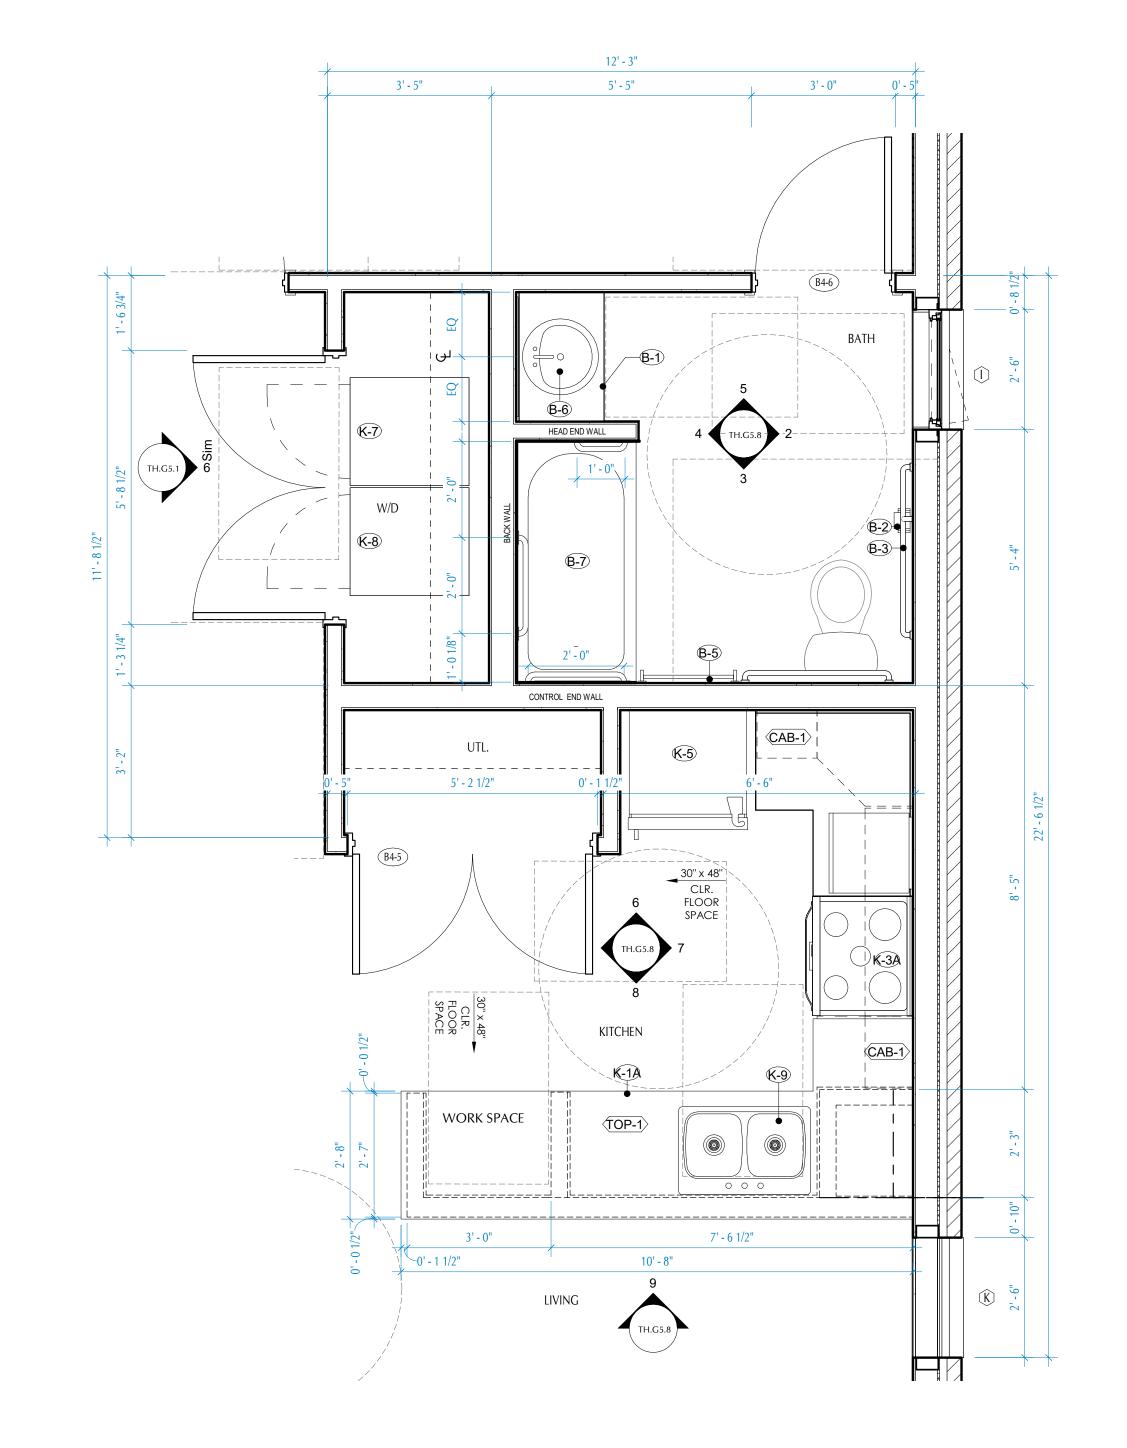

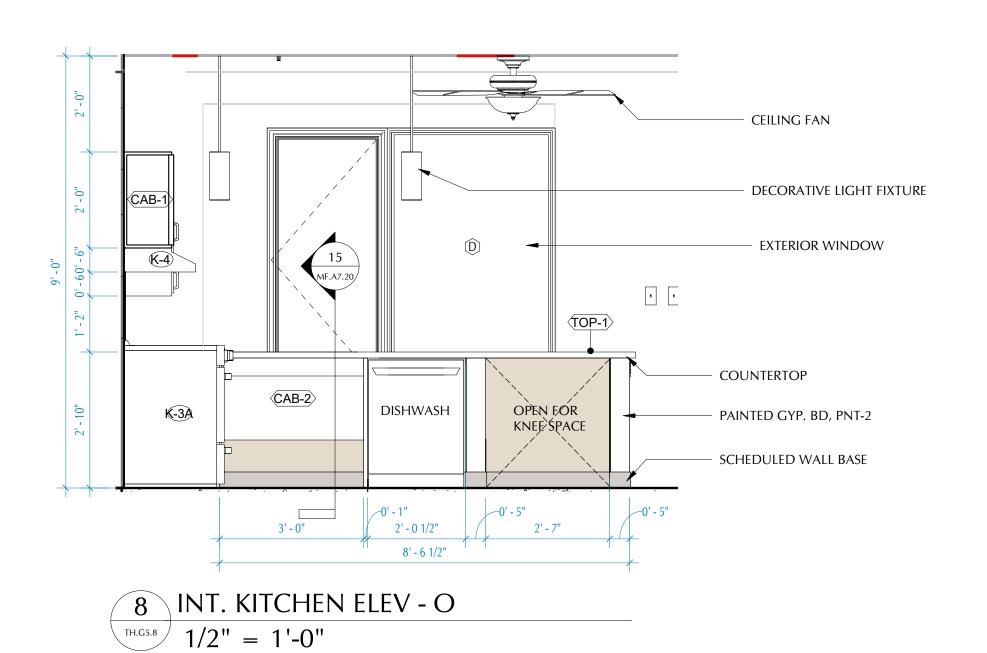

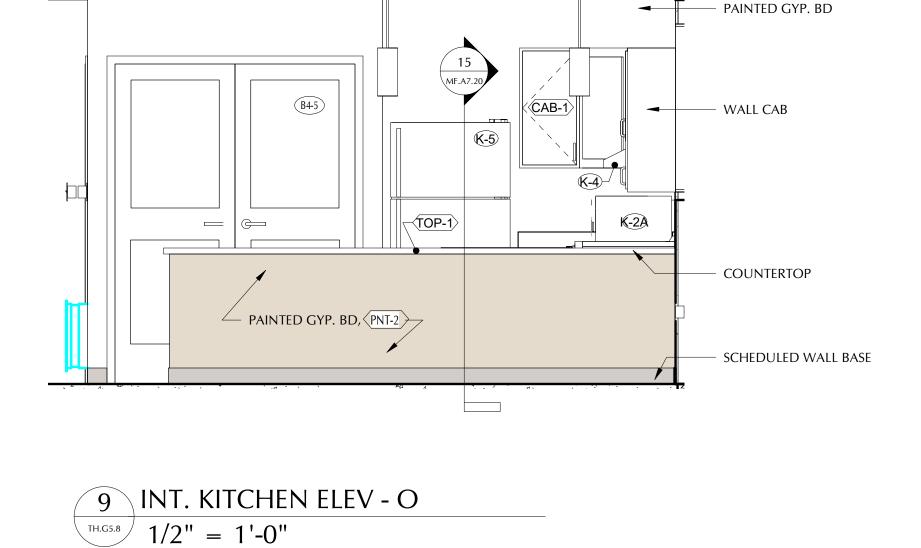

FINISHED CEILING

1 ENLARGED KIT. PLAN - ACCESSIBLE UNIT 'O' TH.G5.8 1/2" = 1'-0"

TH.G5.8

© 2015 Gensler

As indicated

Seal / Signature

Project Name

Project Number

193076


Description


AUSTIN HOMES - PHASE 1A

ENLARGED FLOOR PLANS INTERIOR


**ELEVATIONS - ACCESSIBLE UNIT 'O'** 


05/06/2020

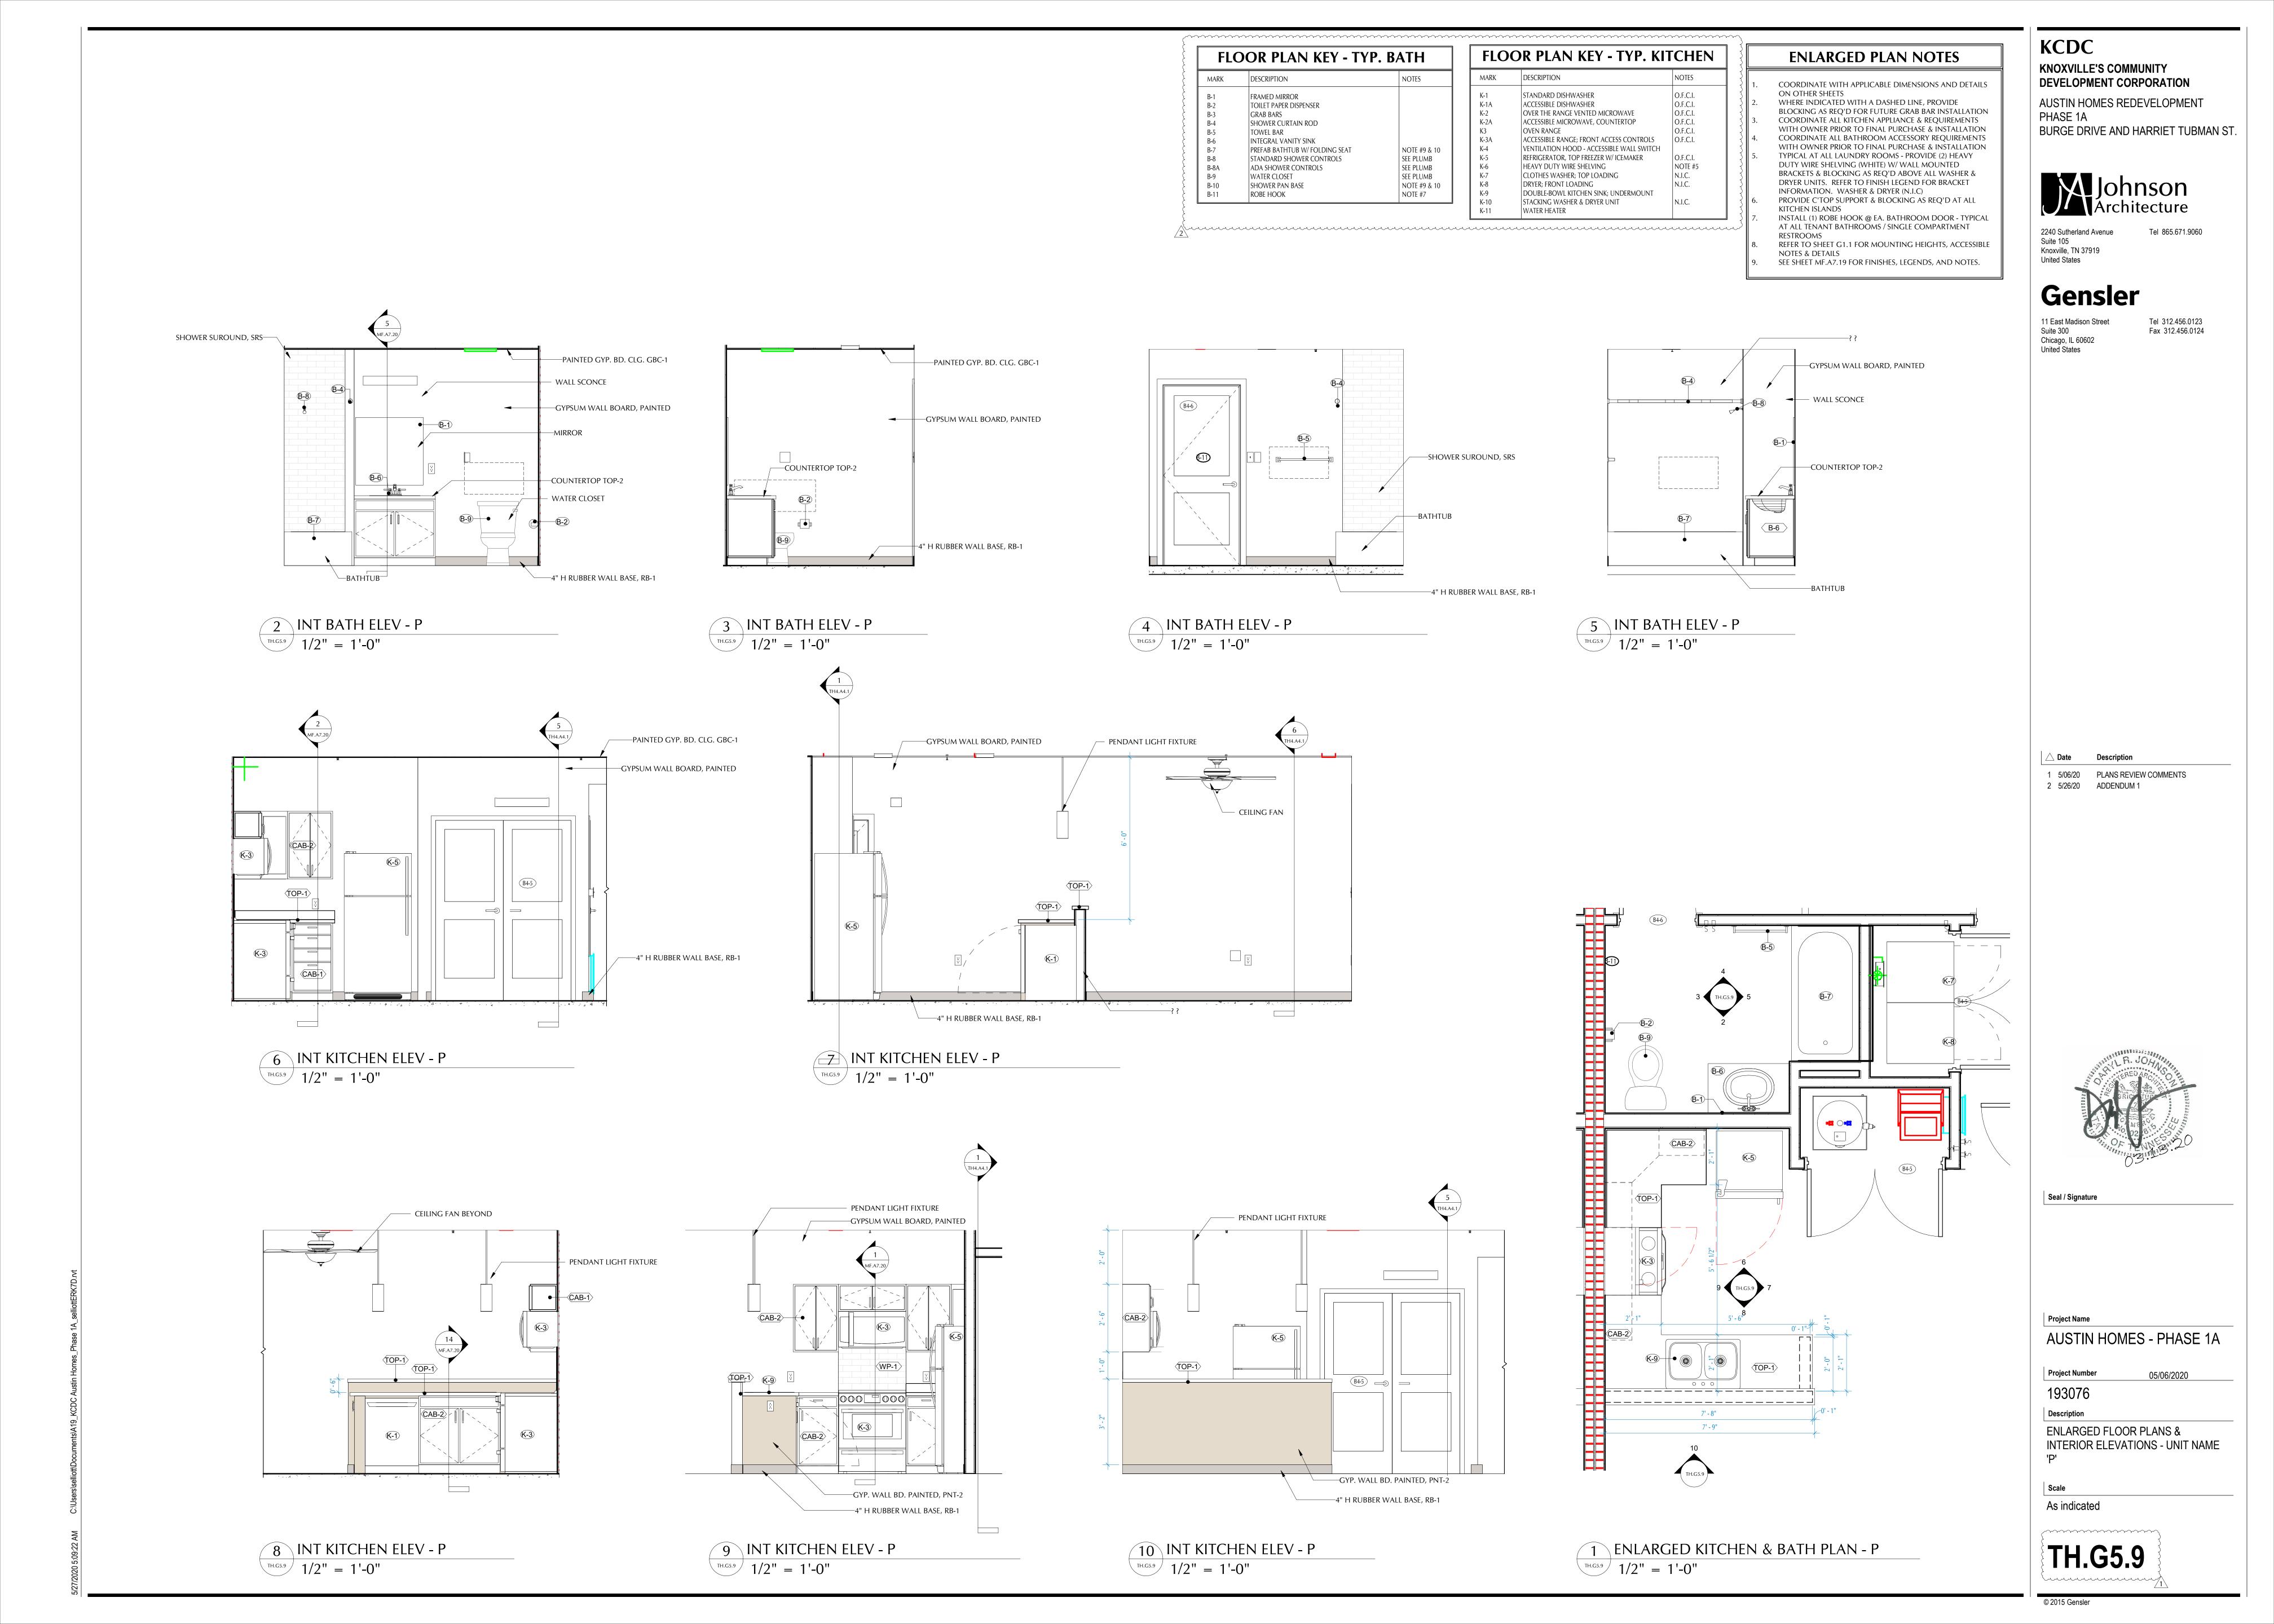

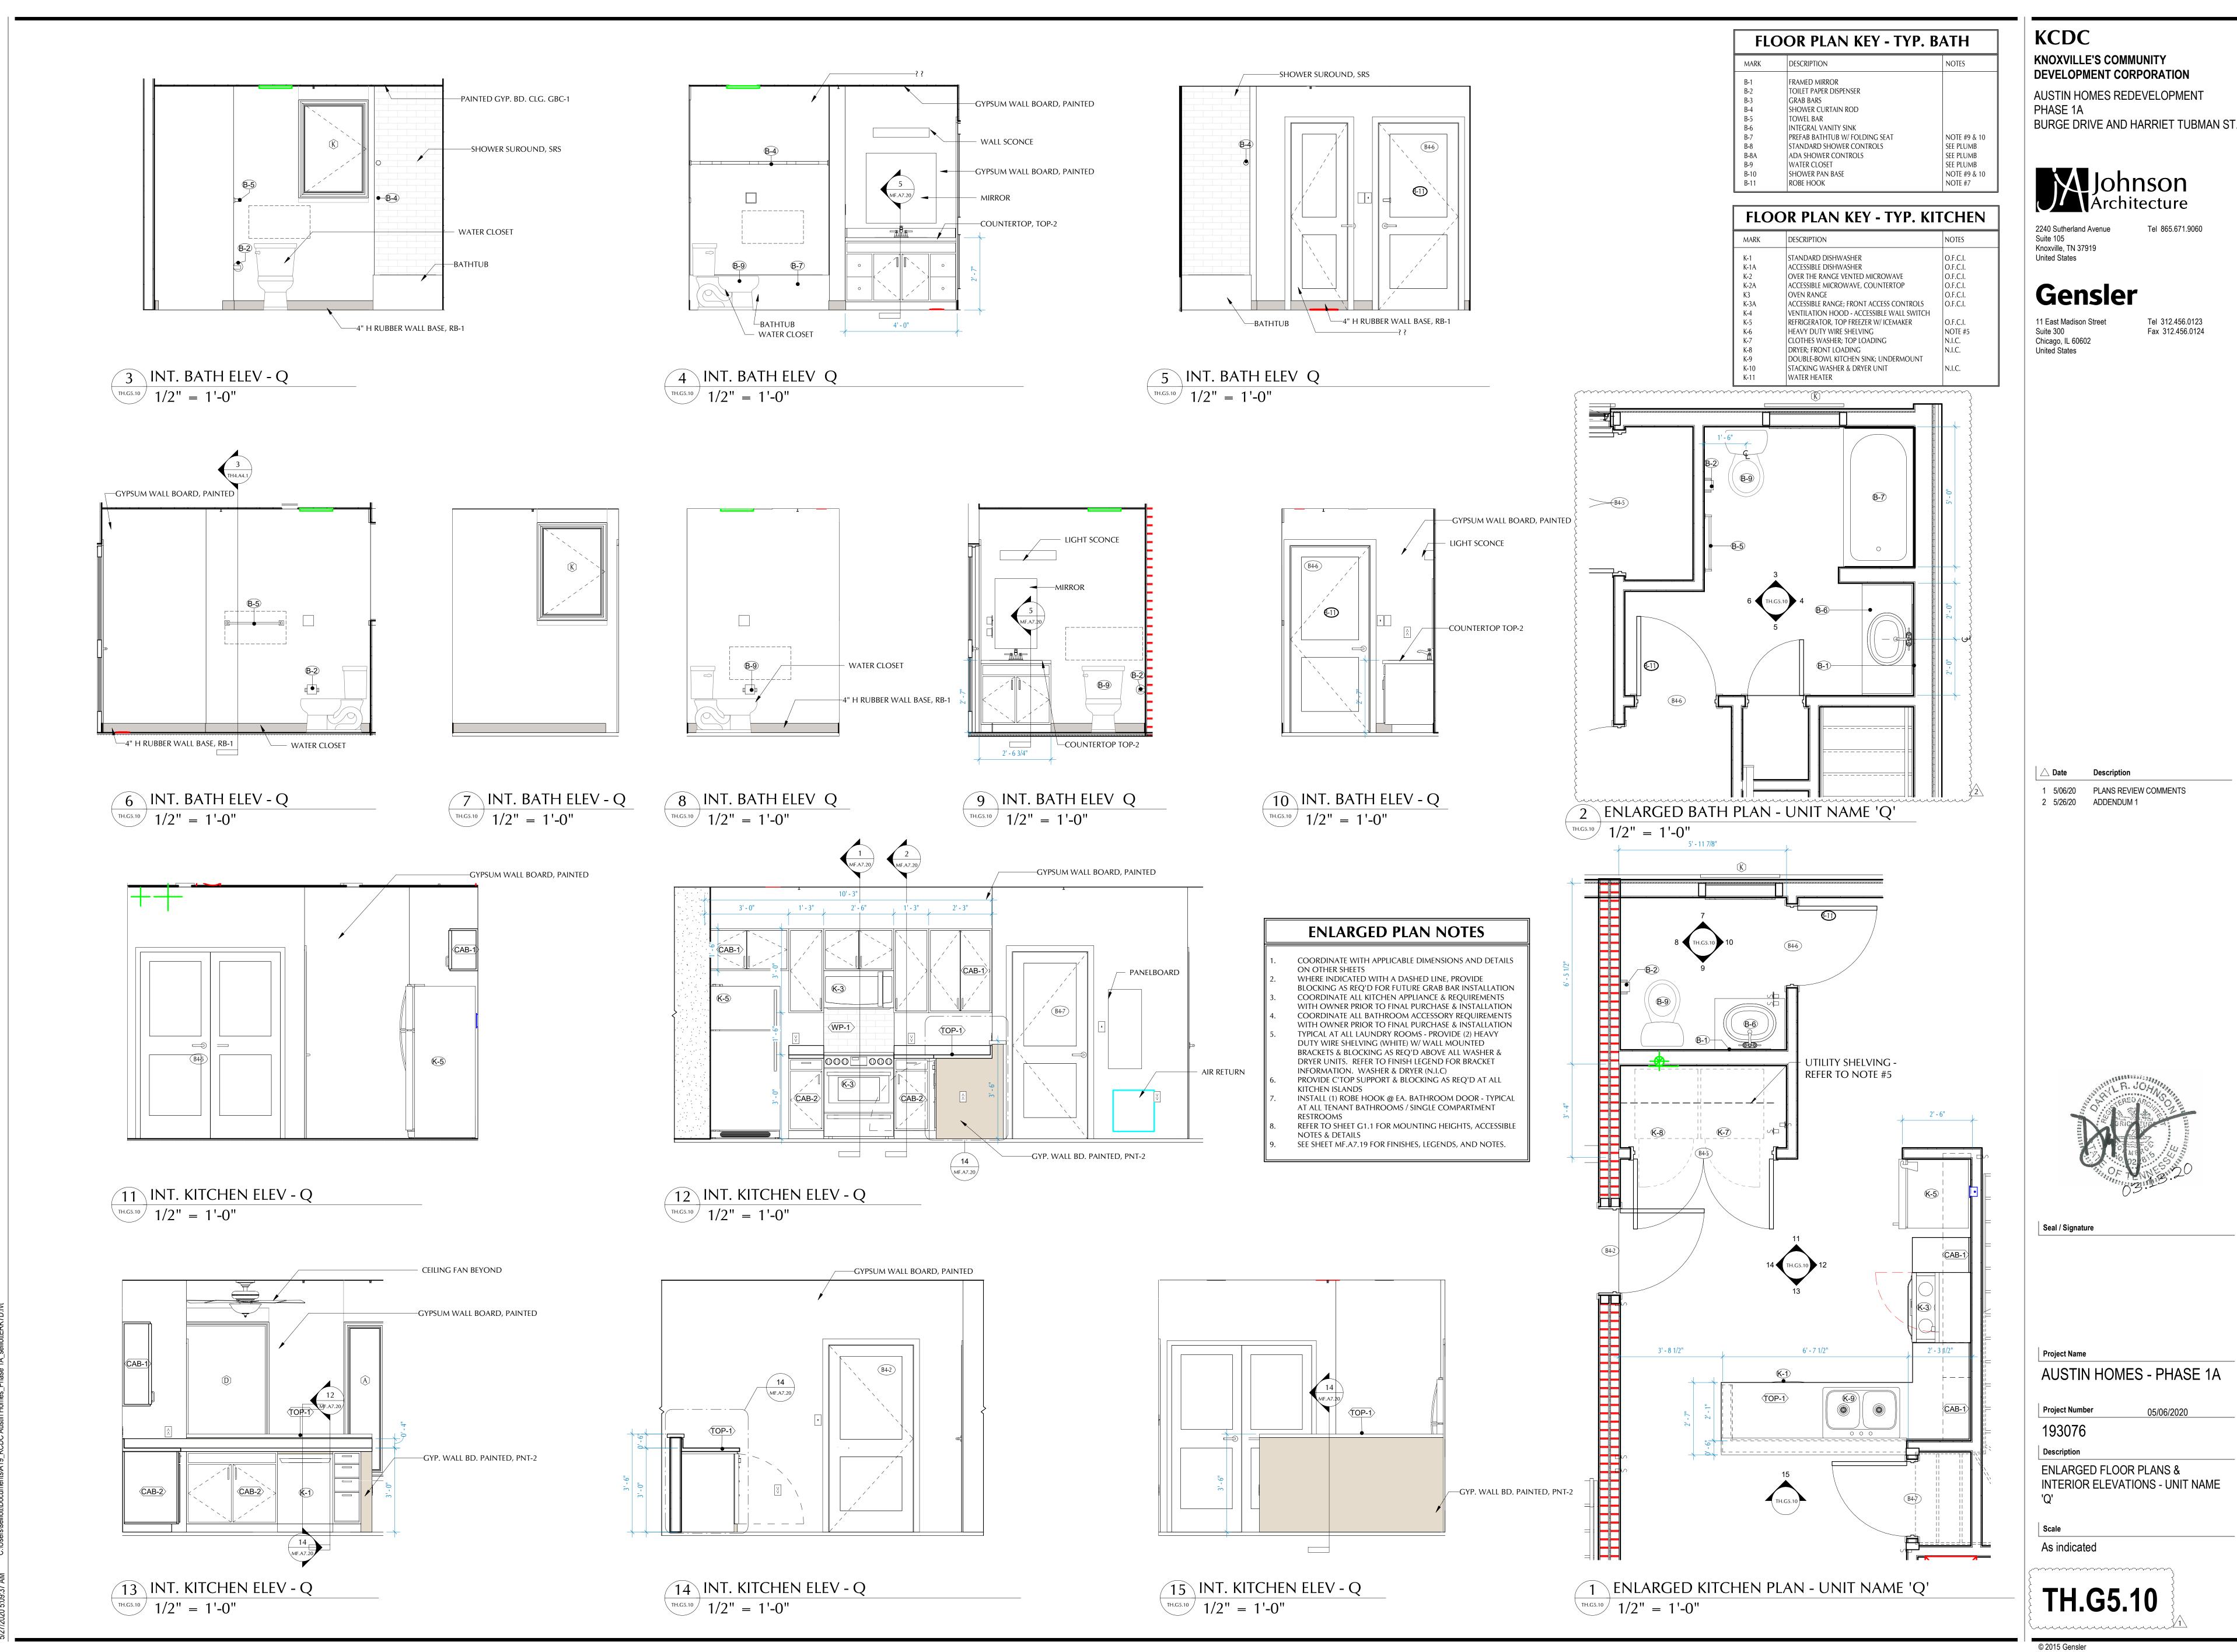

2000 T 2000 T

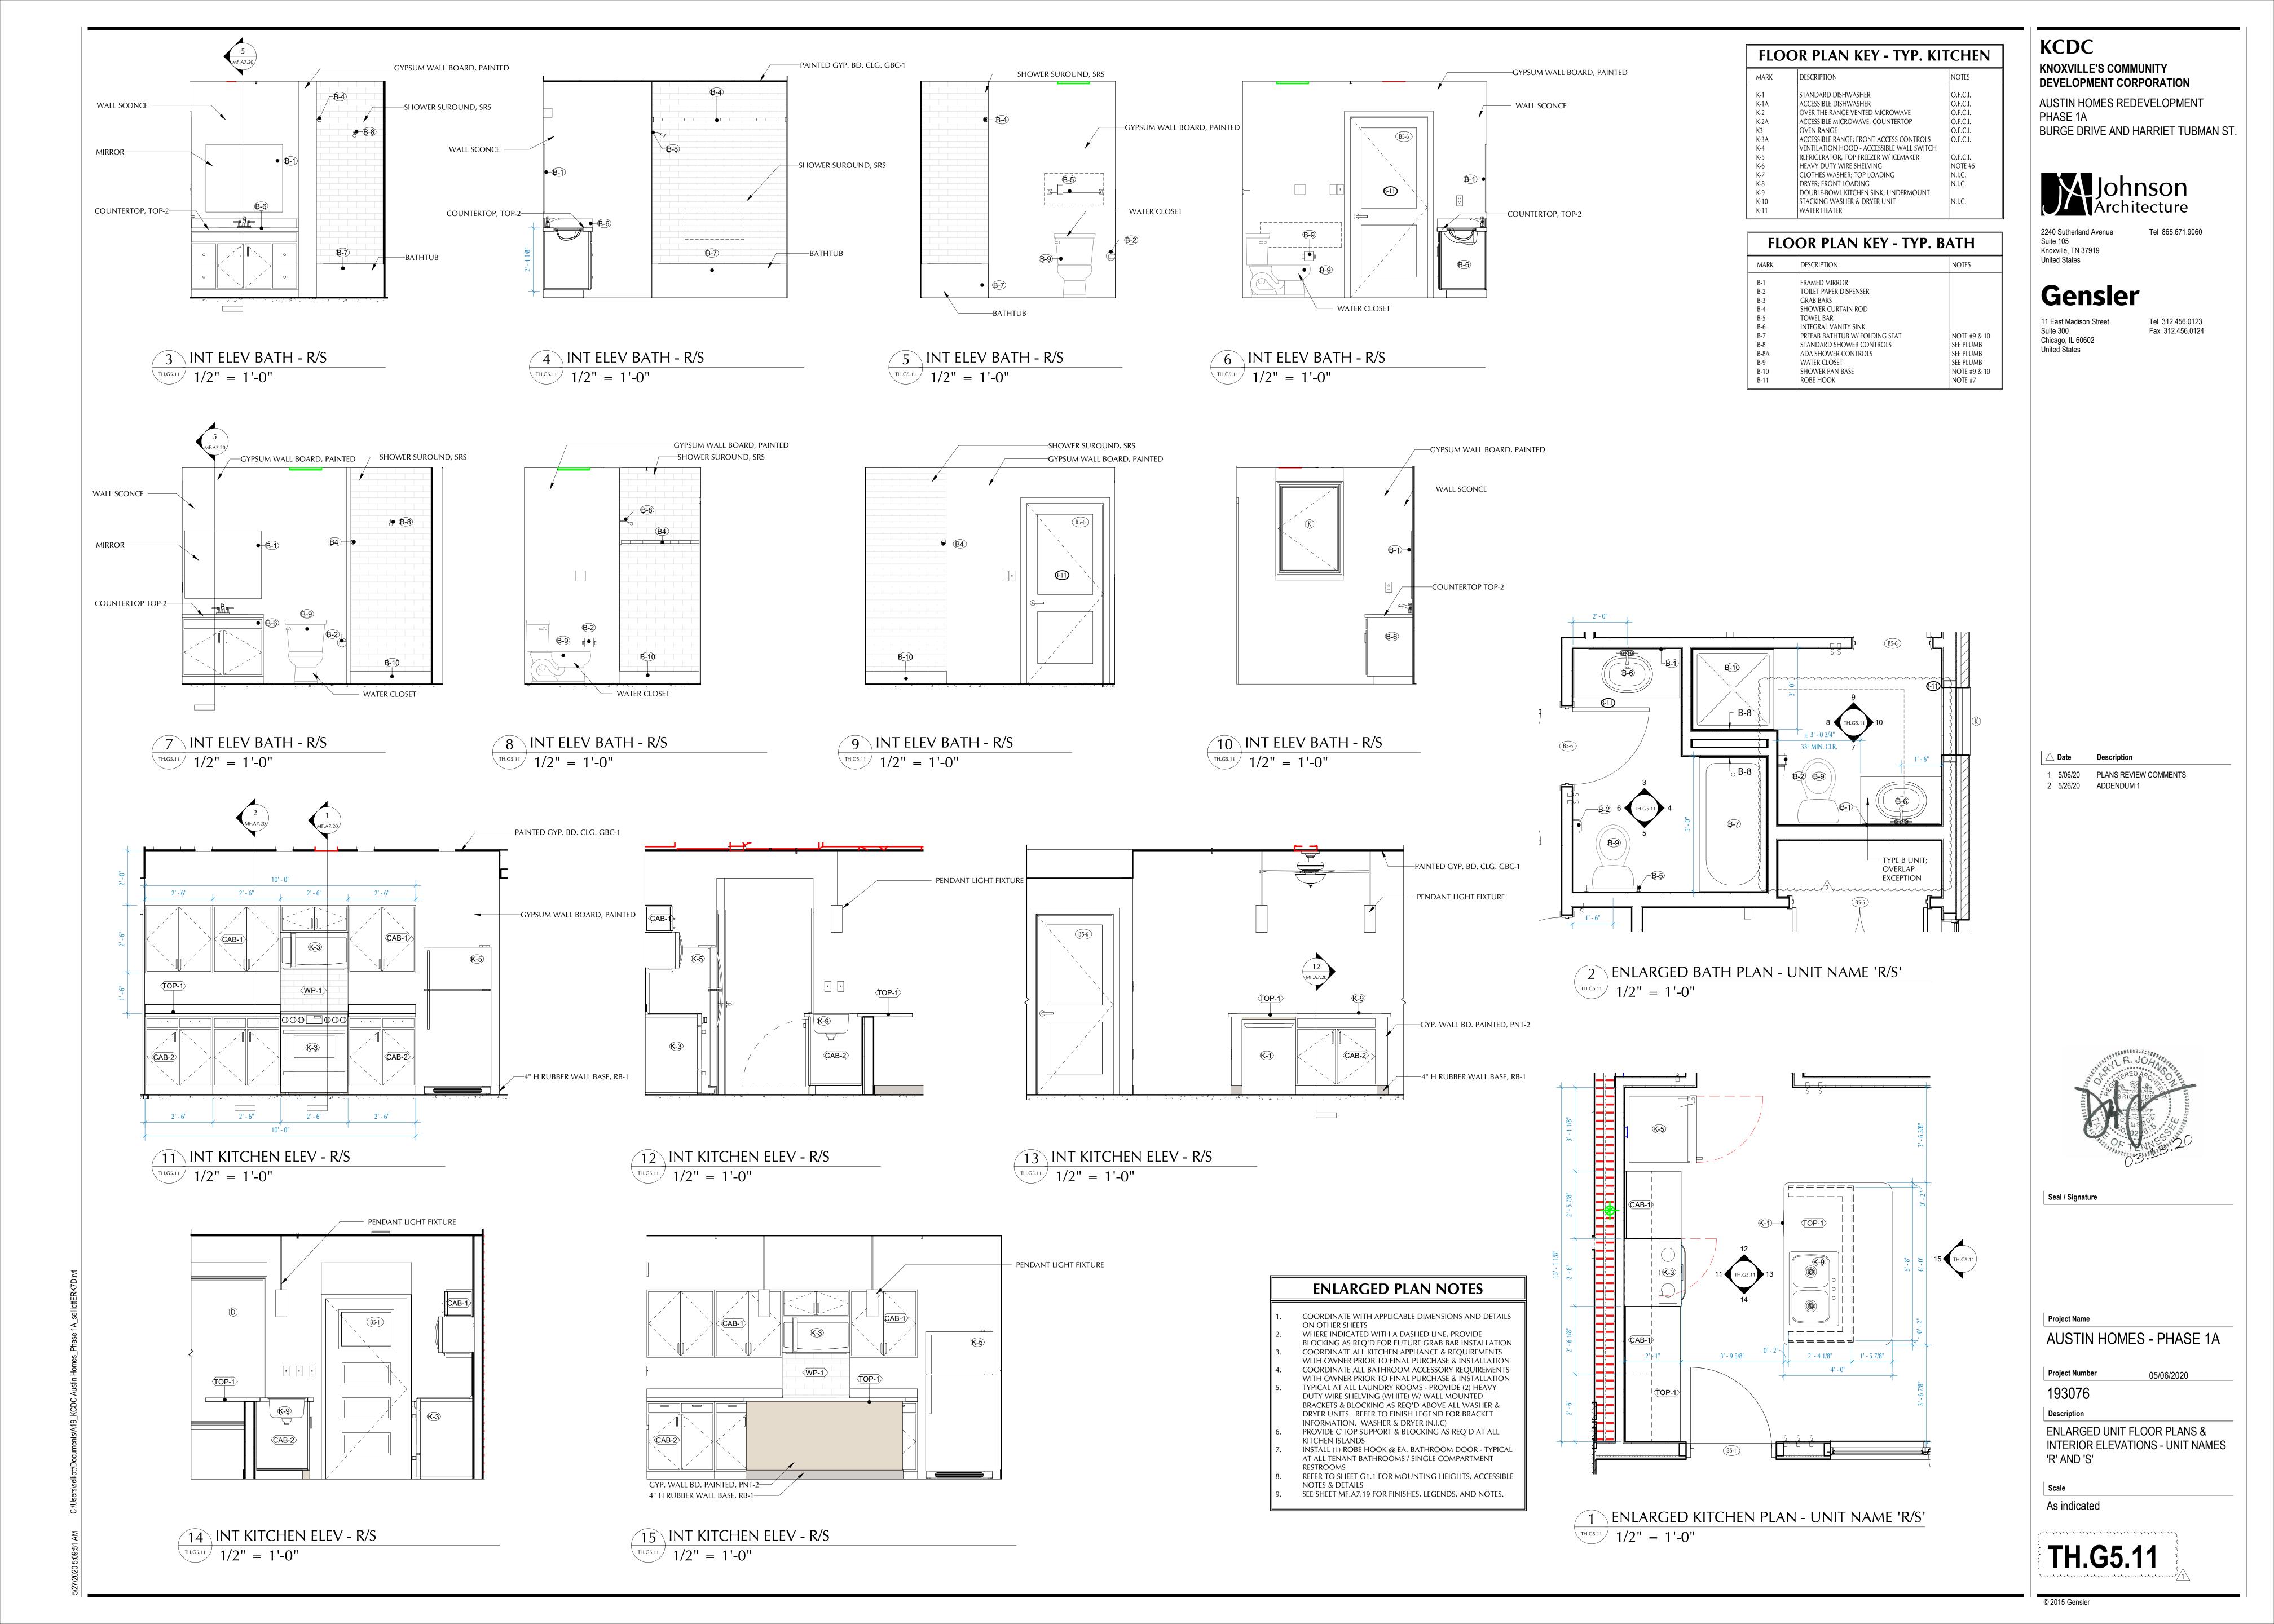

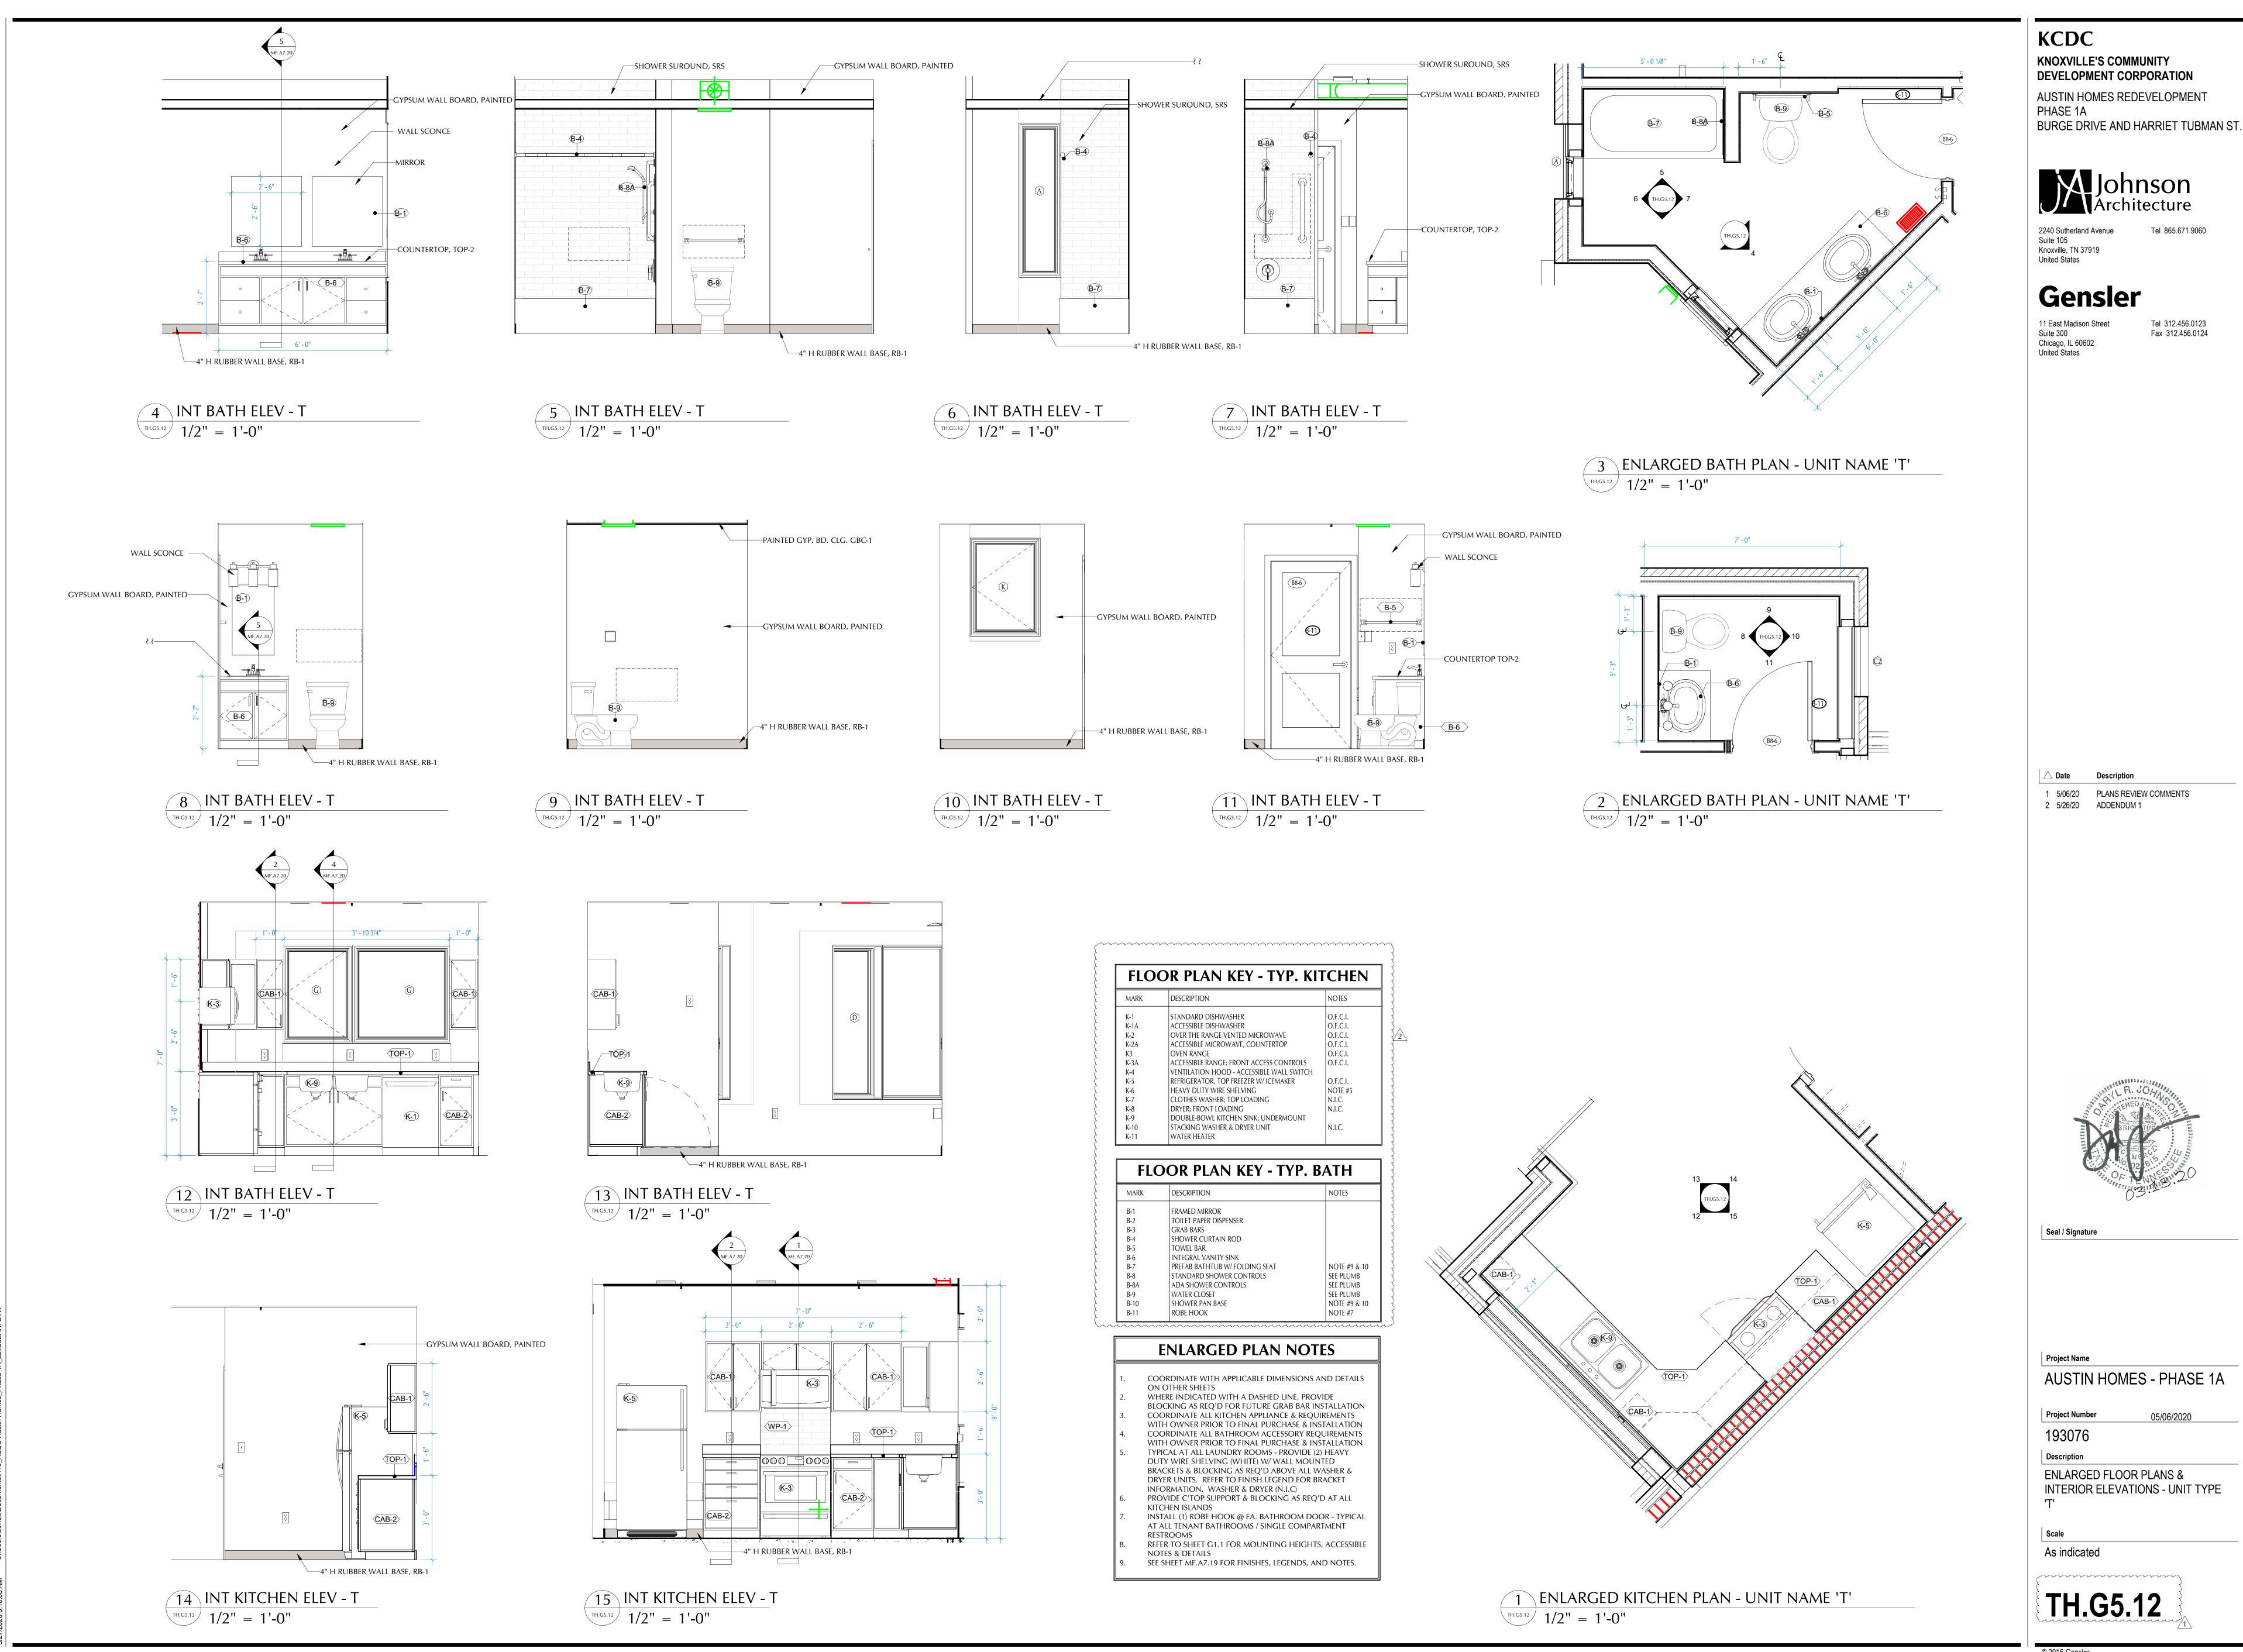


AUSTIN HOMES REDEVELOPMENT



Tel 865.671.9060

Tel 312.456.0123 Fax 312.456.0124

INTERIOR ELEVATIONS - UNIT TYPE

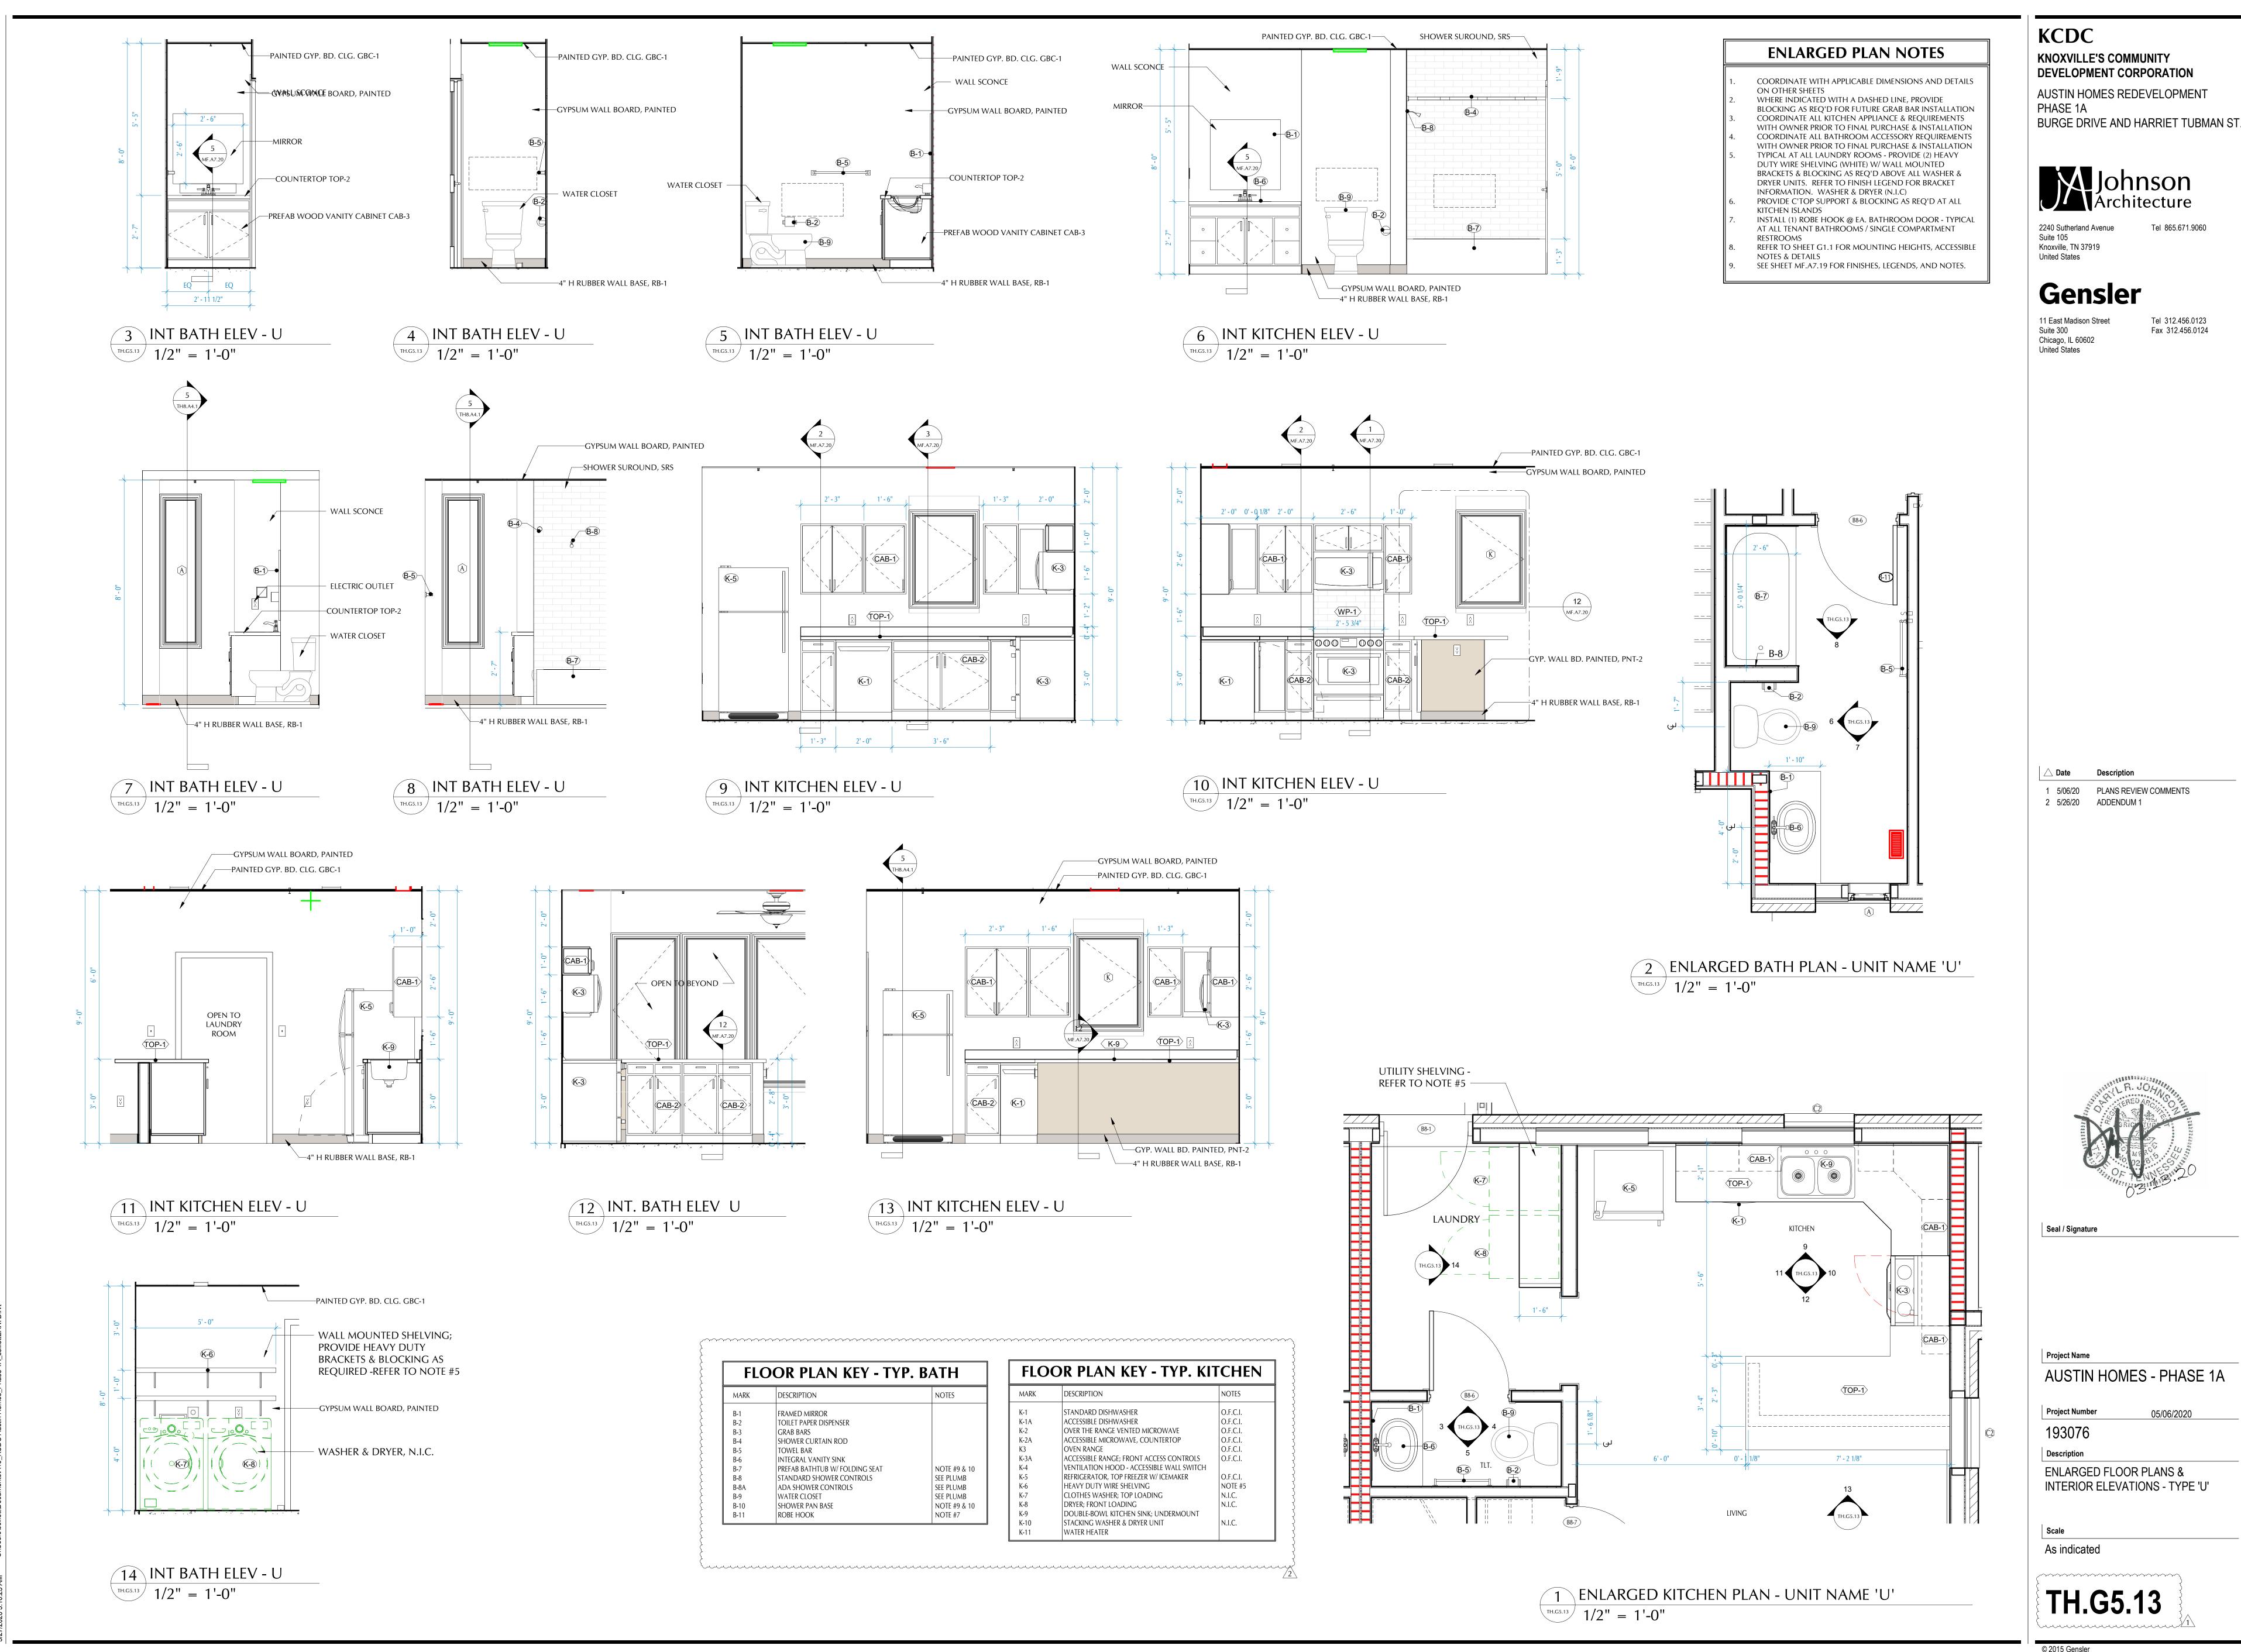

16. Unless noted or detailed otherwise, all reinforcing steel to be lapped a minimum of a

17. Provide a contraction joint in all concrete slabs on grade at 150 sq./ft., unless

19. Provide vertical control joints in block/brick at 20'-0" o.c. (max) unless noted

22. Unless noted otherwise, extend continuous footing reinforcing through mat footing.

class B tension splice.

bond beam (i.e., bond beams to be continuous)

plates for handrails, horizontal connection plates, etc.

level). Grout cells solid at reinforcing.

noted otherwise.

c. channels, plates, angles, misc. steel: A36 Fy=36 ksi Structural steel to be designed, fabricated, erected, etc. as per AISC Manual of Steel fabricator, category Std. 2. Details shown are typical, similar details apply to similar conditions, unless noted 3. Connections not indicated on the drawings are to be designed by the fabricator. All connections for non-composite beams to be standard shear connections unless detailed 4. All connections to be bearing type, with A325, 3/4" diameter bolts, unless detailed otherwise. 5. Shop drawings: A. Structural steel 1. Submit shop drawings of structural steel prior to fabrication of same. Refer to specifications for submittal process. 2. Drawings to be original documents, not a reproduction of contract drawings. 3. Steel shop drawings are to be submitted as a complete set. Partial submittals will not be accepted unless previously approved by architect/engineer. 4. Coordinate structural steel drawings prior to submittal/ fabrication. See note C3. 5. All erection drawings to indicate sizes of members as well as piece marks. B. Coordination mechanical engineer and all other disciplines to verify all dimensions, openings, by engineer does not relieve contractor of responsibility for this coordination. 6. Coordinate exact location of column center lines and dimensions with architectural drawings. Notify architect/engineer of any discrepancies prior to construction. 7. Verify with architect, mechanical, and electrical drawings for angles, railings, stair details, and other misc. metals not shown on structural drawings. 8. Unless noted or detailed on drawings, the following shall apply: a. Steel columns to be:  $HSS 4 \times 4 \times 3/8$ " b. Steel beams to be: W10 X 22 c. Column cap plates to be 3/4" thick x size required. d. Column base plates to be 1" thick x (see plan) e. Anchor bolts to be 3/4" diameter with double nuts and washers at top for leveling and nut head at bottom. Weld nut head to rod. Provide 4-1/2" projection f. Unless detailed otherwise, all anchor bolts are to extend into concrete footings such that bottom of bolt is a maximum of 4" from bottom of footing. 9. Bolts for connection of angles, channels, etc. bolted to masonry or concrete construction 10. All column to base plate and column to cap plate connections to be 5/16" min. fillet weld all around unless noted otherwise. Welds to be as per AISC table J2.4. 11. Steel supplier/contractor to coordinate cap plate, shear angles, beam elevations, bolt locations, etc. with architect's drawings and details of window heads, jambs, flashing, 12. All anchor bolts to be installed utilizing a base plate template with concrete being cast around anchor bolts. Anchor bolts shall be installed prior to concrete placement. 13. Provide  $6" \times 3/8" \times$  (width required by wall thickness) steel angle to support brick veneer at all openings unless noted otherwise. 14. All welded construction shall comply with AMS code for procedures, appearance, quality of welds, and methods used in welding work. All field welds to be inspected by testing agency for compliance with AMS standards. 15. Coordinate steel coatings with fire rating requirements (paint may or may not be required). Coordinate fire resistance coating thickness with UL rating as indicated on architectural drawings. Adjust thickness of coating where required as indicated in the underwriters laboratories fire resistance directory. 16. Where handrails are indicated to be embedded in structural concrete, provide a steel sleeve with four 1/2" diameter x 4: long headed anchors embedded in concrete. Grout handrail into sleeve. Coordinate with architectural drawings. 17. Where wood nailers are indicated on top of steel beams, provide 1/2" diameter threaded studs at 32" o.c. welded to top flange. PRE-ENGINEERED WOOD TRUSS SYSTEM NOTES 1. Mood truss system to be manufactured by a truss system supplier who is a member of the Truss Plate Institute or who uses metal connection plates from a manufacturer who is a member of the Truss Plate Institute. 2. Design requirements Truss system is to be designed by a registered engineer in the state where the system is to be used. All bracing required for truss members shall be designed and noted by truss designer. If roof sheathing and/or purlins are used as bracing for top and bottom chords, truss designer to verify that the necessary resistance is provided for the truss member bracing. Any additional bracing or nailing/screwing of the sheathing/purlins shall be noted by the truss designer. The following criteria shall be included in the truss engineer's design. a. Design loads Roof truss system 1. Live load top chord: . . . 20 psf 2. Dead load top chord: . . . 13 psf 3. Dead load bottom chord:. . 12 psf 4. Wind load: . . . . . . . . 115 mph 5. Seismic loads: see "Seismic Design Data 6. Snow loads and drift loads per ASCE - 7 Floor truss system Total load of 70 psf, see plan if higher load is required. b. All lumber to be minimum size of  $2 \times 4$  and to be Southern Pine #2 KD, unless noted otherwise c. Maximum spacing of trusses shall be 24" o.c. for roofs and 19.2" o.c. for d. Review all contract documents including mechanical, electrical, plumbing, architectural, structural, etc. to ascertain loads from equipment, openings for ducts, etc. and provide modifications to trusses if required to support e. Provide specially designed trusses for hips, valleys, concentrated loads from partitions, headers, etc. f. At areas where trusses require headers to adjacent trusses, provide headers as determined by acceptable engineering design. g. All connections of trusses to girder trusses, trusses to beams, trusses to headers, bracing connections, etc. are to be designed by truss system designing engineer. h. Truss connections to continuous nailers to be made with "Simpson Strong-Tie" (or equal) framing anchors. All anchors to be installed as per manufacturer's specifications. i. Trusses to be designed such that they apply no horizontal loads to support members under dead and live loads. j. All recommendations as to bracing, quality control, and design shall be as specified in Truss Plate Institute specifications and related articles or as determined by truss engineer (see above). Minimum size bracing to be 2x4. Connect to truss with two (2) 16d nails unless design indicates larger members and stronger connections are required. k. The above design criteria are intended as absolute minimum standards. Truss system designing engineer is to coordinate and apply these and all other requirements for truss system to meet proper engineering and building code standards for this specific project. l. Trusses shall bear on the walls as noted on drawings. If trusses designed as 18. Provide 1/2" expansion joint material at areas where slab on grade is adjacent to walls. multi-span members, maximum shipping length shall be 50'. Intent is that a truss be simple span or simple span with cantilevered ends. otherwise. Coordinate locations with Architect if drawings show other spacing. Contractor m. If supplier provides cap trusses to be placed on base trusses, purlins (minimum size 2 x 4) shall be at 24" maximum, unless closer spacing is required by truss to provide layout to architect for approval prior to construction. Do not extend through designer. Connect cap and base truss at each panel point of base truss or 20. All masonry foundation walls to have #4 dowel out of footing and vertical reinforcement at 48" o.c. closer if required by designer. Connections to be designed by supplier with metal connectors. unless noted otherwise. Dowels to have 12" hook and 24" projection (Extend dowel to floor 3. Shop drawings 21. Unless noted otherwise, provide #3 hairpin anchor rod with 12" embedment at all embedded Provide shop drawings of wood truss system including all information required to complete truss system portion of project including the following: a. Provide layout plan of truss system showing spacing, bracing and marks referring to truss diagrams. Original contract documents are not to be reproduced mechanically for use as shop drawings. Shop drawings will not be reviewed without a layout plan. The intent of the layout plan is that it be coordinated and provided as a part of the truss system. If truss supplier does not provide a drawing by the truss engineer, a written statement shall be provided to the architect that the individual trusses are coordinated with the layout plan. (Note: layout as shown on contract documents is schematic and may be modified with consent of architect/engineer.) b. Provide stress diagrams and/or calculations for truss system components with seal of designing engineer. c. Indicate details of all connections in the shop drawing submittal. d. Please note that shop drawings will not be reviewed without a layout plan, connection details and designing engineer's seal. 4. Although web layout of trusses may be shown on plans, it is the responsibility of the truss designer to accept, approve or modify layout as required for design 5. Contractor and supplier to provide all labor and materials to complete truss system portion of project. 6. No qualifying statements or exceptions to plans or notes will be allowed. 7. Top chords of all trusses to be such that sheathing bears flat across chords. Provide beveled top chord or nailing strips as required. 8. Truss component close out a. General contractor is to have testing/inspection firm to review truss installation along with bracing installation during construction and upon completion. b. The following areas shall be addressed:

1. Individual truss location to be verified with layout plan

3. Connections of truss to truss and truss to structure

4. Plumbness of trusses 5. Review of connector plates

during installation.

6. Special lifting techniques if required

8. Hanger connections and fasteners

c. Report from inspector/testing agency

7. Truss lengths and proper bearing conditions

2. Bracing required by truss designer and/or engineer of record

1. Report from inspector/testing agency should be furnished periodically

2. Final report to be furnished upon completion of truss work.

STRUCTURAL STEEL NOTES

1. Structural steel to be as follows:

b. tube steel: A500B Fy=46 ksi

a. wide flange: A992 Fy=50 ksi

Construction, Allowable Stress Design, 15th edition. Contactor to employ a qualified fabricator who participates in the AISC quality certification program and is designated an AISC certified otherwise. Connections at each end of members to be proportioned for half (min.) the total allowable uniform load on the member as shown in the AISC table of allowable uniform load. 1. Prior to fabrication, contractor is to coordinate with steel supplier, elevator supplier, weights, etc. that affect steel configuration. Contractor is to coordinate special spacing, miscellaneous members and locations of equipment. Engineer cannot be responsible for exact location and layout of any equipment supplier's product. Review of shop drawings to be Hilti H.I.T.RE-500 Epoxy Adhesive Anchors or approved equal. See details for sizes, etc.

PRE-ENGINEERED WOOD TRUSS SYSTEM NOTES 1. Mood truss system to be manufactured by a truss system supplier who is a member of the Truss Plate Institute or who uses metal connection plates from a manufacturer who is a member of the Truss Plate Institute. <u>SEISMIC DESIGN DATA - INTERNATIONAL BUILDING CODE</u> 2. Design requirements Truss system is to be designed by a registered engineer in the state where Risk Category = 11 the system is to be used. All bracing required for truss members shall be designed and noted by truss designer. If roof sheathing and/or purlins are Seismic importance factor - I = 1.0 used as bracing for top and bottom chords, truss designer to verify that the necessary resistance is provided for the truss member bracing. Any additional Ss = 0.627 bracing or nailing/screwing of the sheathing/purlins shall be noted by the truss designer. The following criteria shall be included in the truss 51 *= 0.*134 engineer's design. a. Design loads Site class = D Roof truss system 1. Live load top chord: . . . 20 psf SDs = 0.543 2. Dead load top chord: . . . 13 psf 3. Dead load bottom chord:. . 12 psf SD1 = 0.209 4. Wind load: . . . . . . . . 115 mph 5. Seismic loads: see "Seismic Design Data" Seismic design category - D 6. Snow loads and drift loads per ASCE - 7 Floor truss system Basic seismic force resisting system - Light frame wood walls sheathed Total load of 70 psf, see plan if higher load is required. w/ wood structural panels rated b. All lumber to be minimum size of 2 x 4 and to be Southern Pine #2 KD, for shear resistance. unless noted otherwise. c. Maximum spacing of trusses shall be 24" o.c. for roofs and 19.2" o.c. for Cs = 0.083 d. Review all contract documents including mechanical, electrical, plumbing, R = 6-1/2architectural, structural, etc. to ascertain loads from equipment, openings for ducts, etc. and provide modifications to trusses if required to support Analysis procedure - Equivalent lateral force e. Provide specially designed trusses for hips, valleys, concentrated loads Design base shear = from partitions, headers, etc. Bldg. # 2 .... 11.5 kip f. At areas where trusses require headers to adjacent trusses, provide headers Bldg. # 3 ..... 15 kip as determined by acceptable engineering design. Bldg. # 4 .... 30 kip g. All connections of trusses to girder trusses, trusses to beams, trusses to Bldg. # 5 ..... 10 kip headers, bracing connections, etc. are to be designed by truss system Bldg. # 6 ..... 15 kip designing engineer. Bldg. # 7 .... 15 kip h. Truss connections to continuous nailers to be made with "Simpson Bldg. # 8 .... 35 kip Strong-Tie" (or equal) framing anchors. All anchors to be installed as per Bldg. # 9 ..... 15 kip manufacturer's specifications. i. Trusses to be designed such that they apply no horizontal loads to support MINIMUM SEISMIC REINFORCING members under dead and live loads. j. All recommendations as to bracing, quality control, and design shall be as AT MASONRY WALLS specified in Truss Plate Institute specifications and related articles or as determined by truss engineer (see above). Minimum size bracing to be 2x4. ALL C.M.U. WALLS TO BE REINFORCED AS FOLLOWS: (UNLESS Connect to truss with two (2) 16d nails unless design indicates larger members NOTED OTHERWISE) and stronger connections are required. k. The above design criteria are intended as absolute minimum standards. 8" C.M.U. MALLS: Truss system designing engineer is to coordinate and apply these and all other requirements for truss system to meet proper engineering and building # 4 VERTICAL BAR AT 48" OC GROUT CELL SOLID WITH code standards for this specific project. CONCRETE AT EACH BAR. I. Trusses shall bear on the walls as noted on drawings. If trusses designed as STANDARD "DUR-O-WAL" HORIZONTAL JOINT REINFORCEMENT multi-span members, maximum shipping length shall be 50'. Intent is that a truss be simple span or simple span with cantilevered ends. 8" BOND BEAM W/ (2) # 4 CONTINUOUS - GROUT SOLID W/ m. If supplier provides cap trusses to be placed on base trusses, purlins (minimum CONCRETE. (SEE CONCRETE NOTES) size  $2 \times 4$ ) shall be at 24" maximum, unless closer spacing is required by truss designer. Connect cap and base truss at each panel point of base truss or 12" C.M.U. WALLS: closer if required by designer. Connections to be designed by supplier with metal connectors. # 4 VERTICAL BAR AT 48" OC GROUT CELLS SOLID W/ 3. Shop drawings CONCRETE AT EACH BAR. Provide shop drawings of wood truss system including all information required STANDARD "DUR-O-WAL" HORIZONTAL JOINT REINF. to complete truss system portion of project including the following: a. Provide layout plan of truss system showing spacing, bracing and marks 8" BOND BEAM W/ (2) # 4 CONTINUOUS - GROUT SOLID W/ referring to truss diagrams. Original contract documents are not to be CONCRETE. (SEE CONCRETE NOTES) reproduced mechanically for use as shop drawings. Shop drawings will not be reviewed without a layout plan. The intent of the layout plan is that it be SEISMIC REINFORCED WALL NOTES coordinated and provided as a part of the truss system. If truss supplier does not provide a drawing by the truss engineer, a written statement shall be SEE DETAILS BELOW FOR ADDITIONAL REINFORCEMENT REQUIRED IN ALL REINFORCED WALLS. provided to the architect that the individual trusses are coordinated with the layout plan. (Note: layout as shown on contract documents is schematic PROVIDE DOWEL - (1) PER VERTICAL BAR - IN ALL and may be modified with consent of architect/engineer.) REINFORCED C.M.U. WALLS. (SEE CONCRETE NOTES) b. Provide stress diagrams and/or calculations for truss system components ALL MASONRY WALLS TO BE CONSTRUCTED WITH "FULL MORTAR BEDDING" AT ALL JOINTS. with seal of designing engineer. c. Indicate details of all connections in the shop drawing submittal. d. Please note that shop drawings will not be reviewed without a layout plan, ALL REINFORCED WALLS TO BE CONSTRUCTED W/ connection details and designing engineer's seal. TYPE M" MORTAR BELOW GRADE AND "TYPE M" OR 4. Although web layout of trusses may be shown on plans, it is the responsibility "TYPE S" MORTAR ABOVE GRADE AS PER ASTM, C270. of the truss designer to accept, approve or modify layout as required for design PROVIDE PRE-FABRICATED 'TEE'S AND 'ELL'S' AT ALL INTERSECTIONS. 5. Contractor and supplier to provide all labor and materials to complete truss system portion of project. 6. No qualifying statements or exceptions to plans or notes will be allowed. REINFORCING AS REINFORCING AS 7. Top chords of all trusses to be such that sheathing bears flat across chords. PER NOTES Provide beveled top chord or nailing strips as required. 8. Truss component close out a. General contractor is to have testing/inspection firm to review truss installation along with bracing installation during construction and upon (1) # 4 EACH CELL (1) # 4 EACH CELL completion. b. The following areas shall be addressed: REINFORCING AS 1. Individual truss location to be verified with layout plan PER NOTES 2. Bracing required by truss designer and/or engineer of record 3. Connections of truss to truss and truss to structure INTERSECTION END WALL 4. Plumbness of trusses 5. Review of connector plates (DOOR / WINDOW JAMBS) 6. Special lifting techniques if required (PLUS EACH SIDE OF 'CONTROL' AND 7. Truss lengths and proper bearing conditions 'EXPANSION' JOINTS) 8. Hanger connections and fasteners c. Report from inspector/testing agency TYPICAL PLAN DETAILS - SEISMIC 1. Report from inspector/testing agency should be furnished periodically durina installation. 2. Final report to be furnished upon completion of truss work. MOOD NOTES 1. All framing lumber to be #2 Southern Pine KD, as per SPIB grading rules unless noted otherwise. 2. Contractor shall use "Simpson Strong-Tie" (or equivalent) wood framing anchors, connectors, hangers, etc. for all wood to wood connections. All anchors, etc. to be installed in accordance with manufacturer's specifications. 3. Floor sheathing to be 3/4" T&G plywood. 4. Roof sheathing to be 5/8" exterior grade plywood. All roof framing diaphragms to be blocked along all panel edges. Minimum nailing pattern to be 6" o.c. at all edges and interior members. 5. Unless noted otherwise on plans, headers to be as follows: up to 6'-0": (2) 2x8 6'-0: to 10'-0": (2) 2×10 over 10'-0": (2) 2x12 6. Cutting, notching, bored holes in stud walls, rafters, etc. shall be done in accordance with International Building Code. 7. Ridge boards, where indicated on framing plans shall not be less than 1" in thickness, and not less in depth than cut end of rafters. Rafters shall be placed directly opposite each other and nailed to ridge board. 8. All wood built-up girders, beams, studs to sole plate, etc., to be connected as per International Building Code Fastening Schedule 9. At openings in exterior walls, a wall stud shall be at each side of the opening, with the ends of the header supported as follows, unless noted otherwise: a. For openings less than 3'-0" in width, each end of header shall rest on a single header stud or may be supported by framing anchors attached to b. For openings over 3'-0" to less than 6'-0", each end shall bear on single c. For opening more than 6'-0", in width, each end shall bear on double d. Any header supporting concentrated loads from beams above, each end shall bear on double header stud. 10. Where wood beams bear on stud walls, provide minimum, double or triple stud (depending on beam width) under beam bearing. 11. At openings in stud walls provide 1/2" (minimum) of cut / displaced studs as 'king studs' each jamb of opening.

Corporation Suite 105 Knoxville, TN 37919 **United States** 11 East Madison Street Suite 300 Chicago, IL 60602 United States 502 Union Avenue Knoxville, TN 37902 United States Tel 865.524.777 2 5.22.2020 Revision 2

CORNER

N.T.S.

**Knoxville Community Development** 901 N Boardway Knoxville, TN 37917

Tel 865.671.9060 2240 Sutherland Avenue

REVISION 2 = • REVISED FOUNDATION/FRAMING BASED ON REVISED GRADING PLAN. MINOR REVISIONS TO UNIT FRAMING PLANS FOR ADA COMPLIANCE

Seal / Signature

05 06 2020

**AUSTIN HOMES - PHASE 1A** 

**Project Number** 193076

Description STRUCTURAL NOTES

As indicated

TH.S1.0

© 2015 Gensler

Tel: 865-403-1100

# Gensler

Tel 312.456.0123 Fax 312.456.0124

