

Georgetown County, South Carolina

129 Screven Street, Suite 239
Post Office Drawer 421270
Georgetown, SC 29442-4200
(843) 545-3083 • Fax (843) 545-3500
E-Mail • purch@gtcounty.org
Website • <http://www.gtcounty.org>

ADDENDUM #3 TO BID #19-077

BID NUMBER: 19-077

ISSUE DATE: Wednesday, October 9, 2019

OPENING DATE: Wednesday, October 30, 2019

OPENING TIME: 3:30 PM (ET)

Bid Opening Location: Georgetown County Courthouse, Suite #239, (Purchasing Conference Room)

PROCUREMENT FOR: Waccamaw Library Parking Project



This addendum will amend **Bid #19-077, Waccamaw Library Parking Project** originally issued on Wednesday, October 9, 2019. This clarification is being provided to all known and registered correspondents in response to questions received. All addenda and original bid documents are also available online at: www.gtcounty.org, select Quick Links, “Bid Opportunities” and “Current Bids.”

Question 1:

Item #1 references and “attached Fence Addition Markup” that does not appear to be in the file.

Answer 1: Please see attached drawing

[THE REMAINDER OF THIS PAGE IS INTENTIONALLY LEFT BLANK]

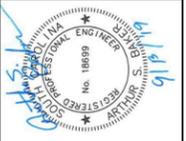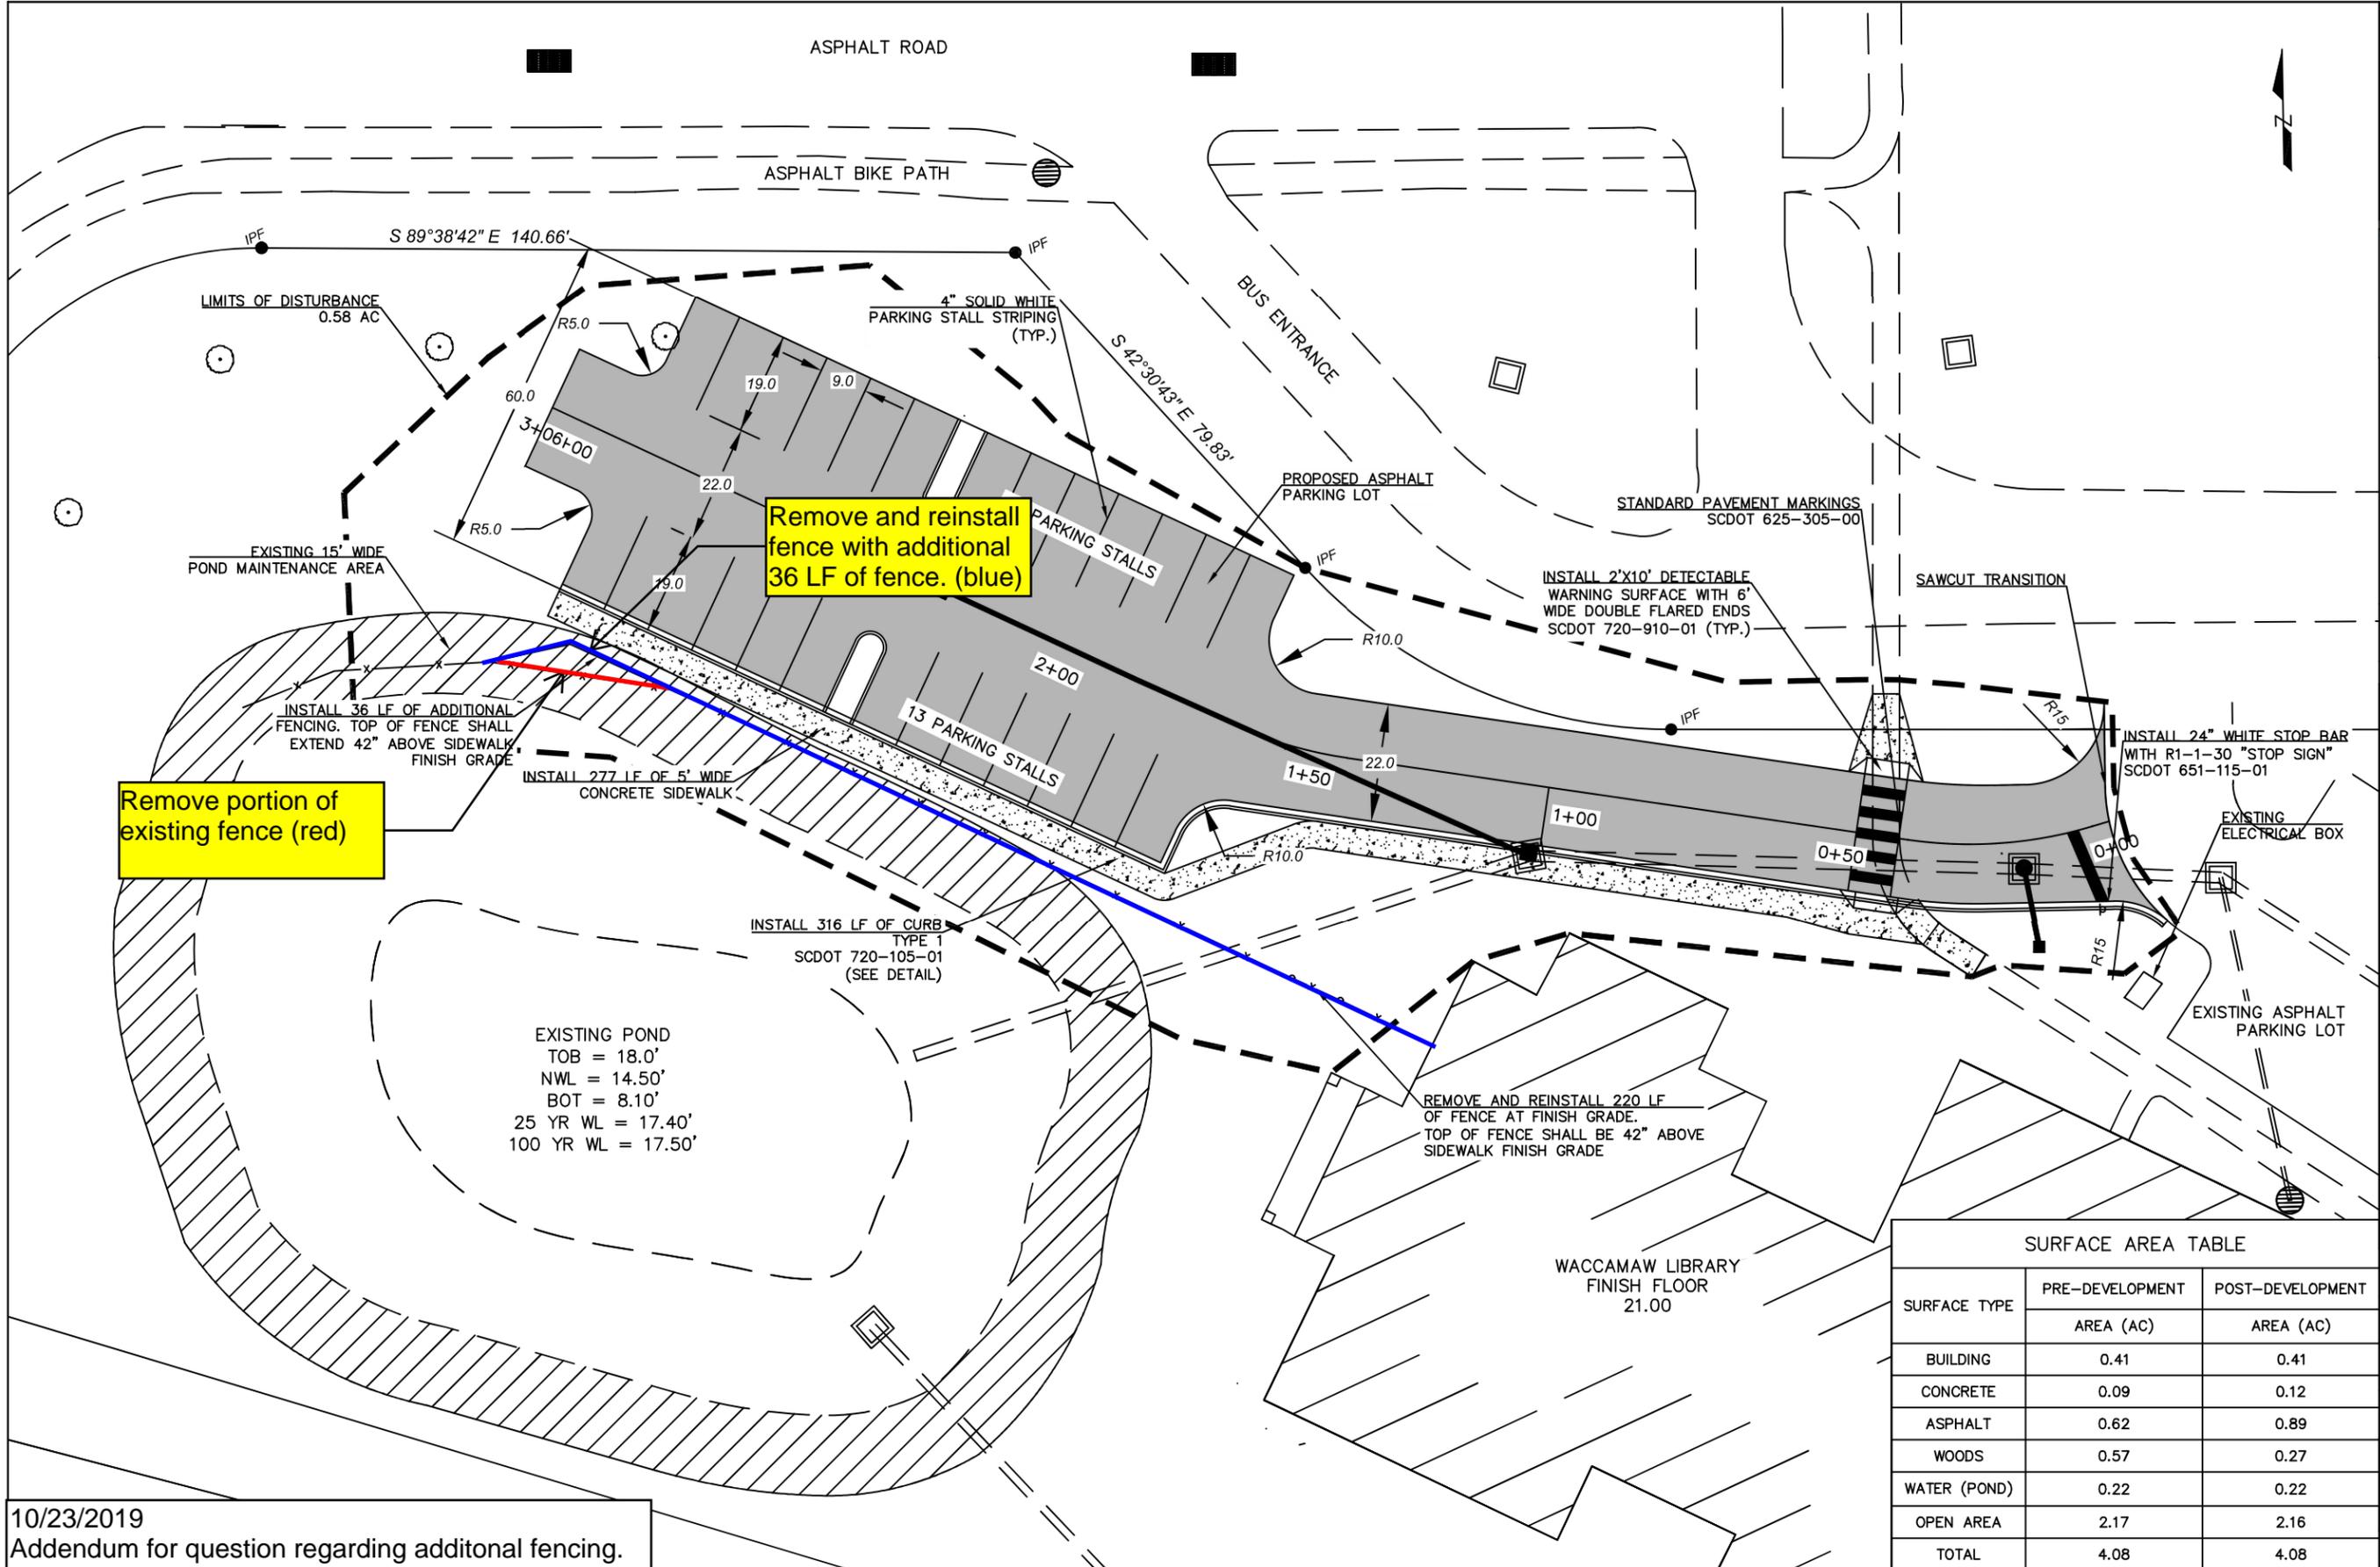

DESIGN DRAWINGS	
STORMWATER REVISION 1	
NO. 1	4/7/2019
NO. 2	9/13/2019

WACCAMAW LIBRARY-PARKING LOT EXPANSION
 GEORGETOWN COUNTY, SOUTH CAROLINA

SURFACE AREA TABLE		
SURFACE TYPE	PRE-DEVELOPMENT	POST-DEVELOPMENT
	AREA (AC)	AREA (AC)
BUILDING	0.41	0.41
CONCRETE	0.09	0.12
ASPHALT	0.62	0.89
WOODS	0.57	0.27
WATER (POND)	0.22	0.22
OPEN AREA	2.17	2.16
TOTAL	4.08	4.08

SCALE: 1:30
 DESIGNED BY: ASB
 DRAWN BY: MPM
 DATE: 9/13/2019
 SITE PLAN
 SHEET NO: C-04

10/23/2019
 Addendum for question regarding additional fencing.



ADDENDUM ACKNOWLEDGEMENT

Bid #19-034

**Non Engineered Road Repair, Resurfacing, Sealing and Marking, IDIQ
Mandatory Submittal Form**

To be returned with the final proposal submission to Georgetown County.

COMPANY NAME: _____

Addendum #1 Received Date: _____ Initialed By: _____

Addendum #2 Received Date: _____ Initialed By: _____

Addendum #3 Received Date: _____ Initialed By: _____

Addendum #4 Received Date: _____ Initialed By: _____

Addendum #5 Received Date: _____ Initialed By: _____

Addendum #6 Received Date: _____ Initialed By: _____

If your Bid submission has already been mailed, acknowledgment may be provided by faxing this form to (843)545-3500, or attaching a digital scan and sending by e-mail.

[THE REMAINDER OF THIS PAGE IS INTENTIONALLY LEFT BLANK]