

Georgetown County, South Carolina

129 Screven Street, Suite 239
Post Office Drawer 421270
Georgetown, SC 29442-4200
(843) 545-3083 • Fax (843) 545-3500
E-Mail • purch@gtcounty.org
Website • <http://www.gtcounty.org>

ADDENDUM #1 TO BID #19-077

BID NUMBER: 19-077

ISSUE DATE: Wednesday, October 9, 2019

OPENING DATE: Wednesday, October 31, 2019

OPENING TIME: 3:30 PM (ET)

Bid Opening Location: Georgetown County Courthouse, Suite #239, (Purchasing Conference Room)

PROCUREMENT FOR: Waccamaw Library Parking Project

This addendum will amend **Bid #19-077, Waccamaw Library Parking Project** originally issued on Wednesday, October 9, 2019. This clarification is being provided to all known and registered correspondents in response to questions received. All addenda and original bid documents are also available online at: www.gtcounty.org, select Quick Links, “Bid Opportunities” and “Current Bids.”


Question 1:

On the Unit Price Schedule in Exhibit H there is an item listed as “#31 Parking Lot Lighting – 1 LS”, but there are not any references to any electrical items or lighting on the design plans. Nor is there any spec in the proposal book for this. Please advise whether or not this will be part of the project. If so, please provide design plans to enable us to provide pricing.

Answer 1: Please see attached drawing

1. The parking lot lighting will be a design-build item.
2. Please see the attached Parking Lot Illumination Map showing the area to be illuminated.
3. The contractor will be responsible for all lighting requirements such as:
 - a. Light pole/fixture installation
 - i. With concrete base as required
 - ii. Light pole/fixtures shall match existing parking lot lighting on site
 - iii. Flood light mounted to building may be utilized for sidewalk lamination
 - b. Underground electrical conduit
 - c. Connection to existing electrical panel inside the building.
 - i. Integration with existing parking lot lighting control (on/off/photocell)
 - d. Meet requirements of the IESNA Lighting Handbook requirements to include (but not limited to):
 - i. Horizontal/Vertical Illuminance
 - ii. Uniformity Criterion

[THE REMAINDER OF THIS PAGE IS INTENTIONALLY LEFT BLANK]

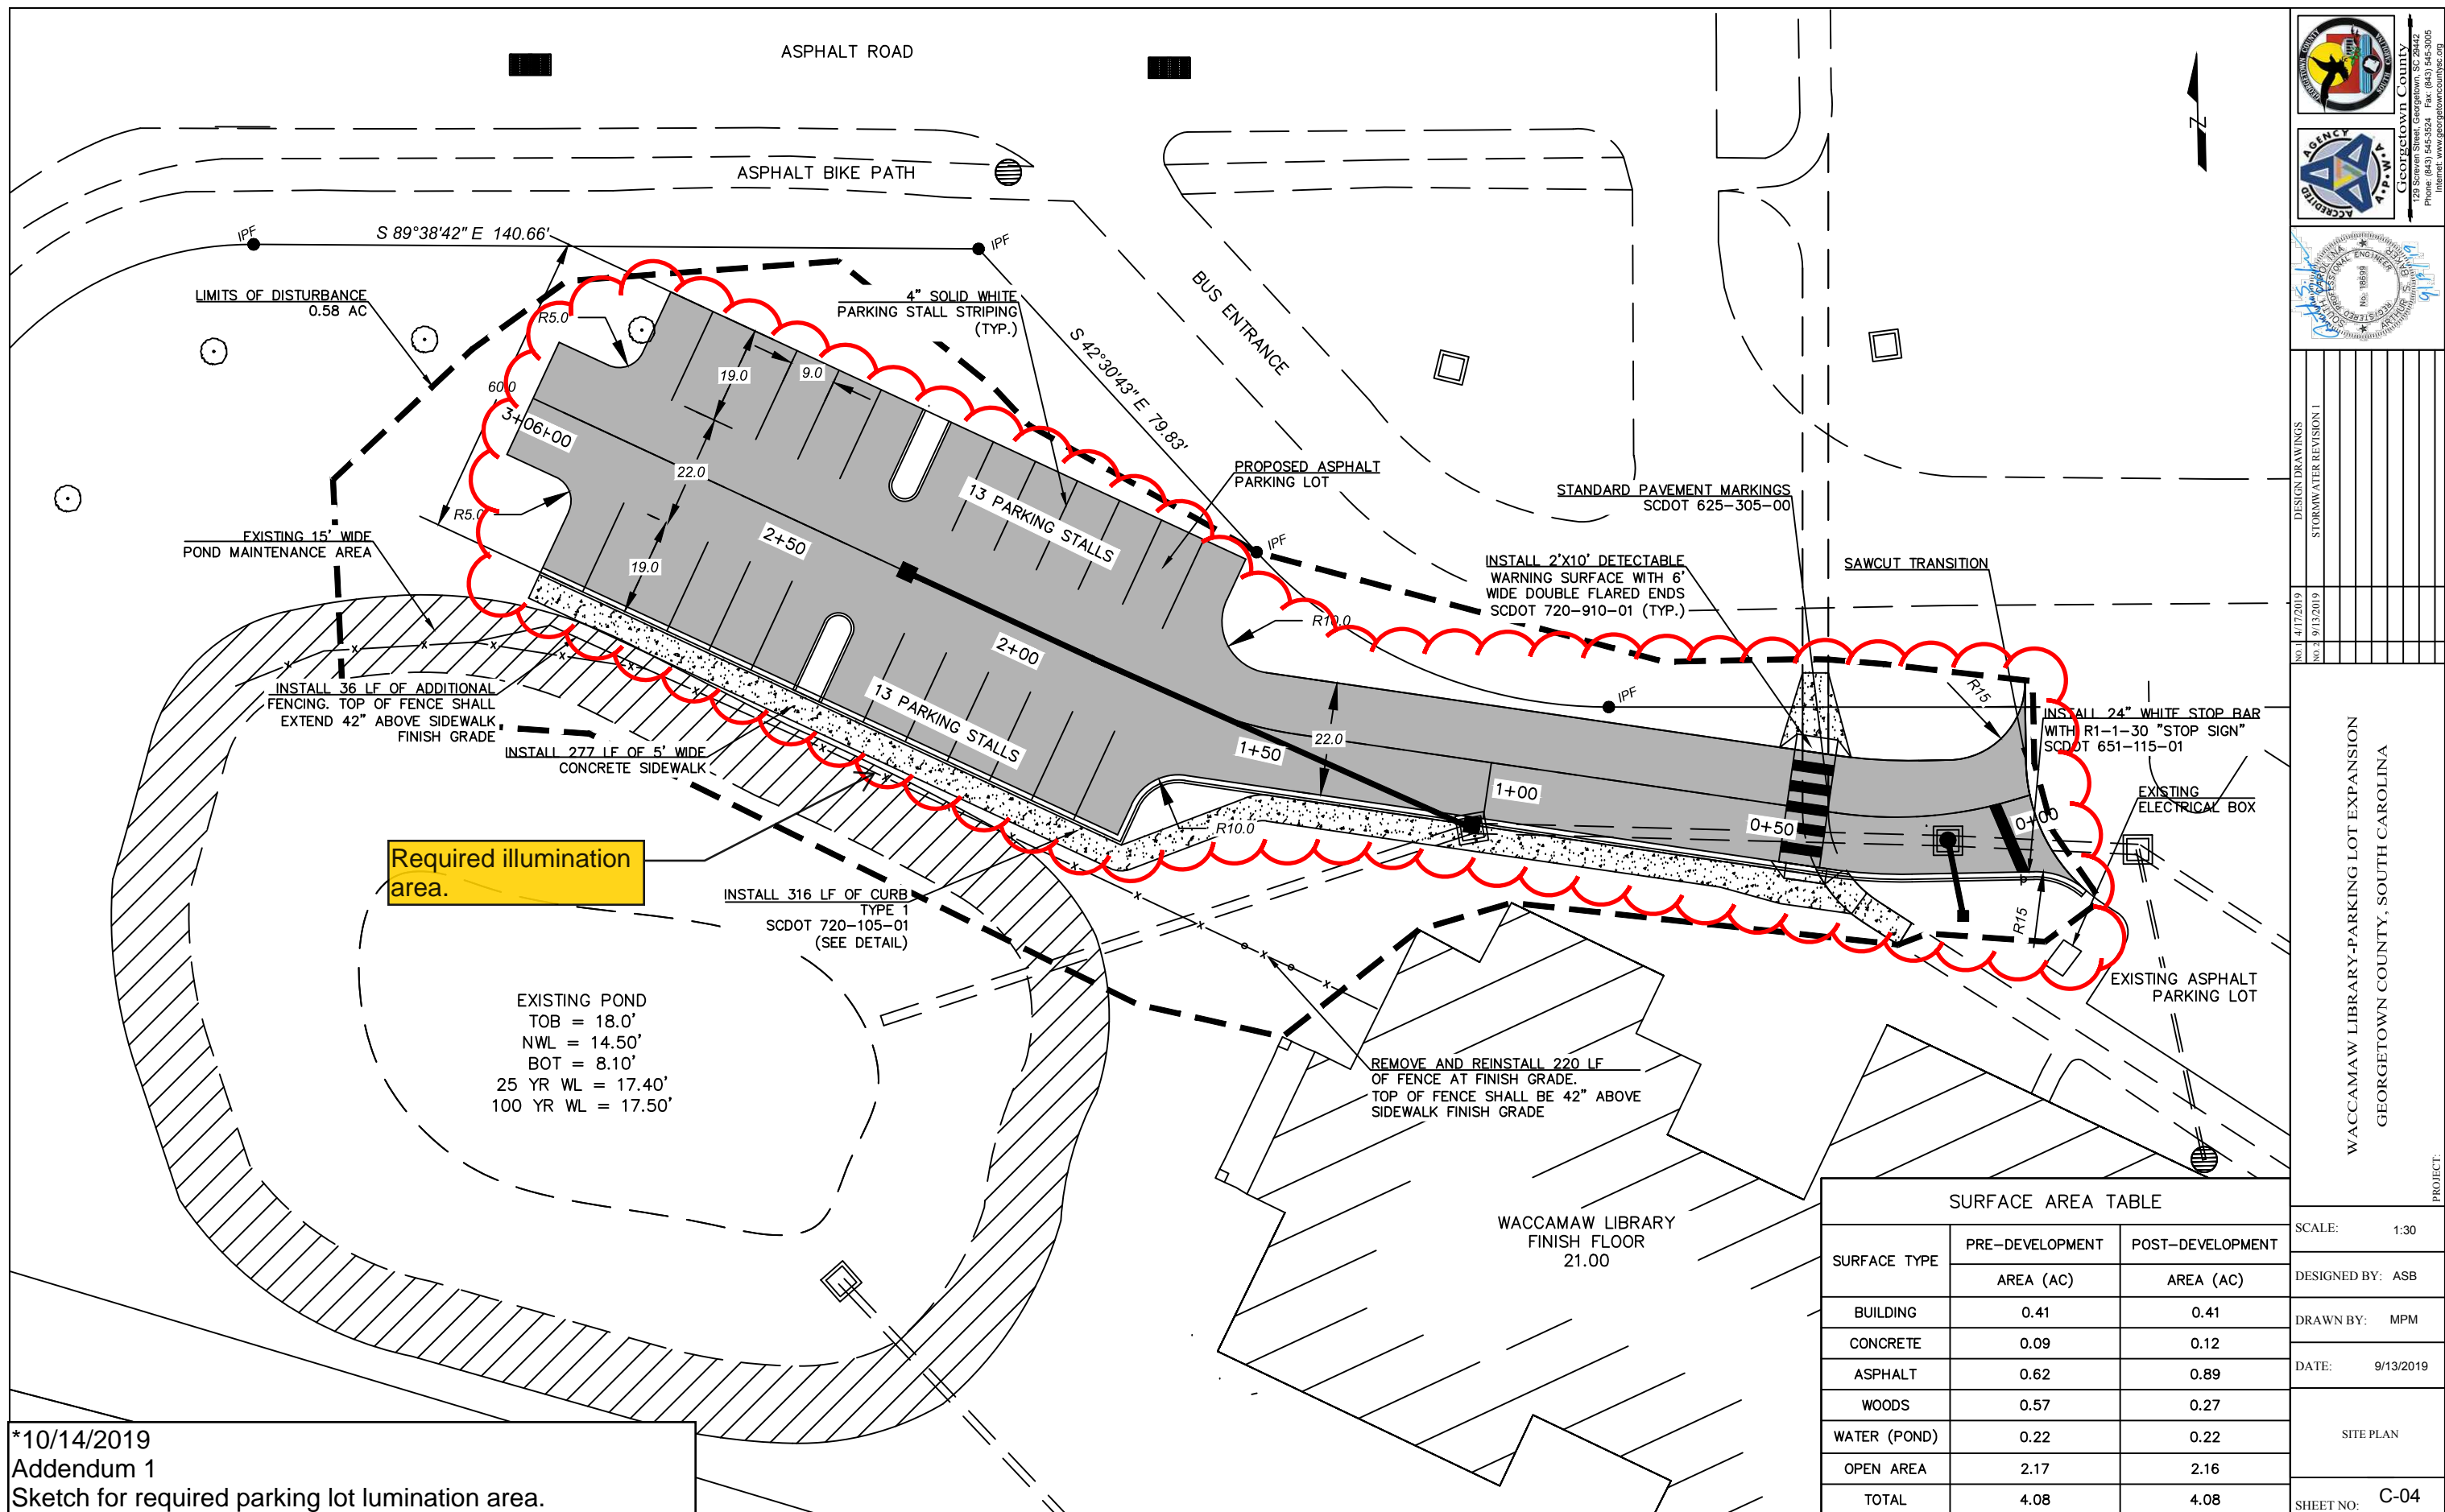


Required illumination area.

EXISTING POND
 TOB = 18.0'
 NWL = 14.50'
 BOT = 8.10'
 25 YR WL = 17.40'
 100 YR WL = 17.50'

SURFACE AREA TABLE		
SURFACE TYPE	PRE-DEVELOPMENT	POST-DEVELOPMENT
	AREA (AC)	AREA (AC)
BUILDING	0.41	0.41
CONCRETE	0.09	0.12
ASPHALT	0.62	0.89
WOODS	0.57	0.27
WATER (POND)	0.22	0.22
OPEN AREA	2.17	2.16
TOTAL	4.08	4.08

SCALE: 1:30
 DESIGNED BY: ASB
 DRAWN BY: MPM
 DATE: 9/13/2019
 SITE PLAN
 SHEET NO: C-04

*10/14/2019
 Addendum 1
 Sketch for required parking lot lumination area.

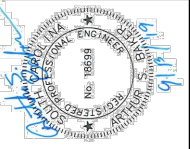

DESIGN DRAWINGS	
STORMWATER REVISION 1	
No. 1: 4/17/2019	
No. 2: 9/13/2019	

WACCAMAW LIBRARY-PARKING LOT EXPANSION
 GEORGETOWN COUNTY, SOUTH CAROLINA



ADDENDUM ACKNOWLEDGEMENT

Bid #19-077

Waccamaw Library Parking Project **Mandatory Submittal Form**

To be returned with the final proposal submission to Georgetown County.

COMPANY NAME: _____

- Addendum #1 Received Date: _____ Initialed By: __
- Addendum #2 Received Date: _____ Initialed By: __
- Addendum #3 Received Date: _____ Initialed By: __
- Addendum #4 Received Date: _____ Initialed By: __
- Addendum #5 Received Date: _____ Initialed By: __
- Addendum #6 Received Date: _____ Initialed By: __

If your Bid submission has already been mailed, acknowledgment may be provided by faxing this form to (843)545-3500, or attaching a digital scan and sending by e-mail.

[THE REMAINDER OF THIS PAGE IS INTENTIONALLY LEFT BLANK]