



CITY OF BATTLE CREEK

ADDENDUM # 1

IFB# 2020-14B

TITLE: Airport Janitorial Service

ADDENDUM ISSUED: August 23, 2019

NOTE! City Hall now has Security on the 1st floor. Please allow extra time to get through Security when dropping off your bid.

The following questions were asked and answers follow each question:

1. When does the current contract end?
 - a. 10/31/2019. The new contract 2020-014B starts 11/1/2019.

2. Can you provide photograph pictures of the tower?
 - a. Go to web site address <http://www.battlecreekmi.gov/230/Bid-Proposal-Solicitations>. Then click on Bid & Proposal Solicitations link, then click on Airport Janitorial scroll to the bottom and under documents you will see the link titled ACTC Photos.

3. What is the square footage of the carpet and tile in the tower?
 - a. See Attachment A

4. What is the square footage of the carpet and tile Administrative building?
 - b. See Attachment B


The **due** date and time **remain** the same.

This addendum must be acknowledged or your bid may be deemed non-responsive.


Attachment A

ATCT


First Floor

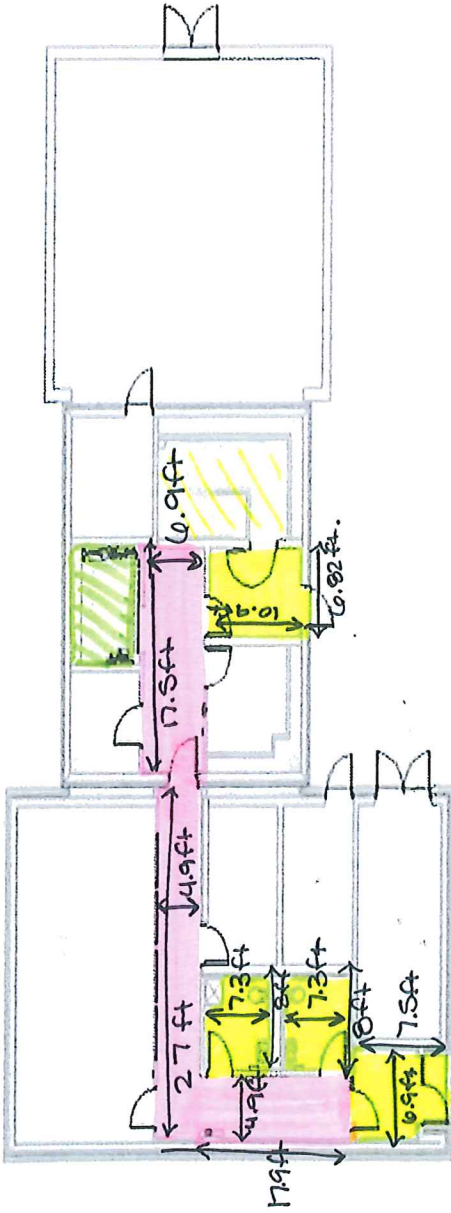


Second Floor

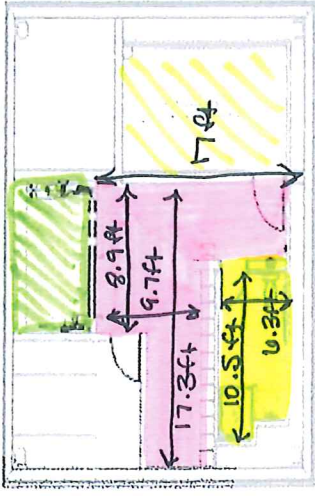


Third Floor

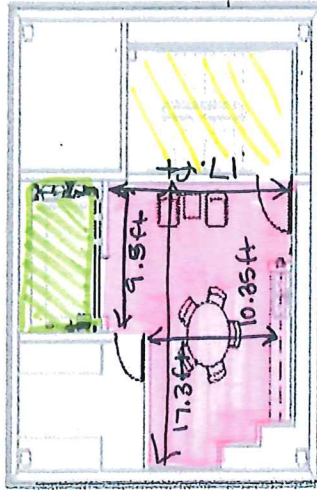

Fourth Floor

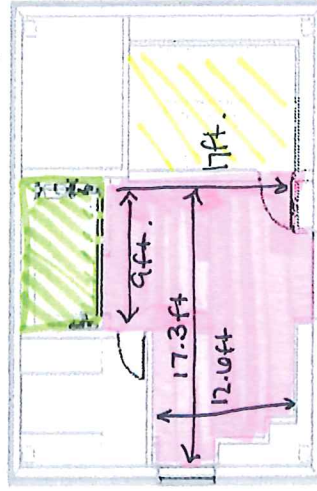

Fifth Floor

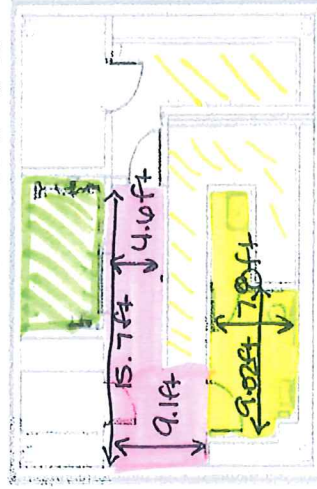


- Yellow areas: Tile floor
- Pink areas: Carpet
- Green shaded: Elevator
- Yellow shaded: Stair well/Tile

Attachment B

Airport Admin Bldg.

86'

78'

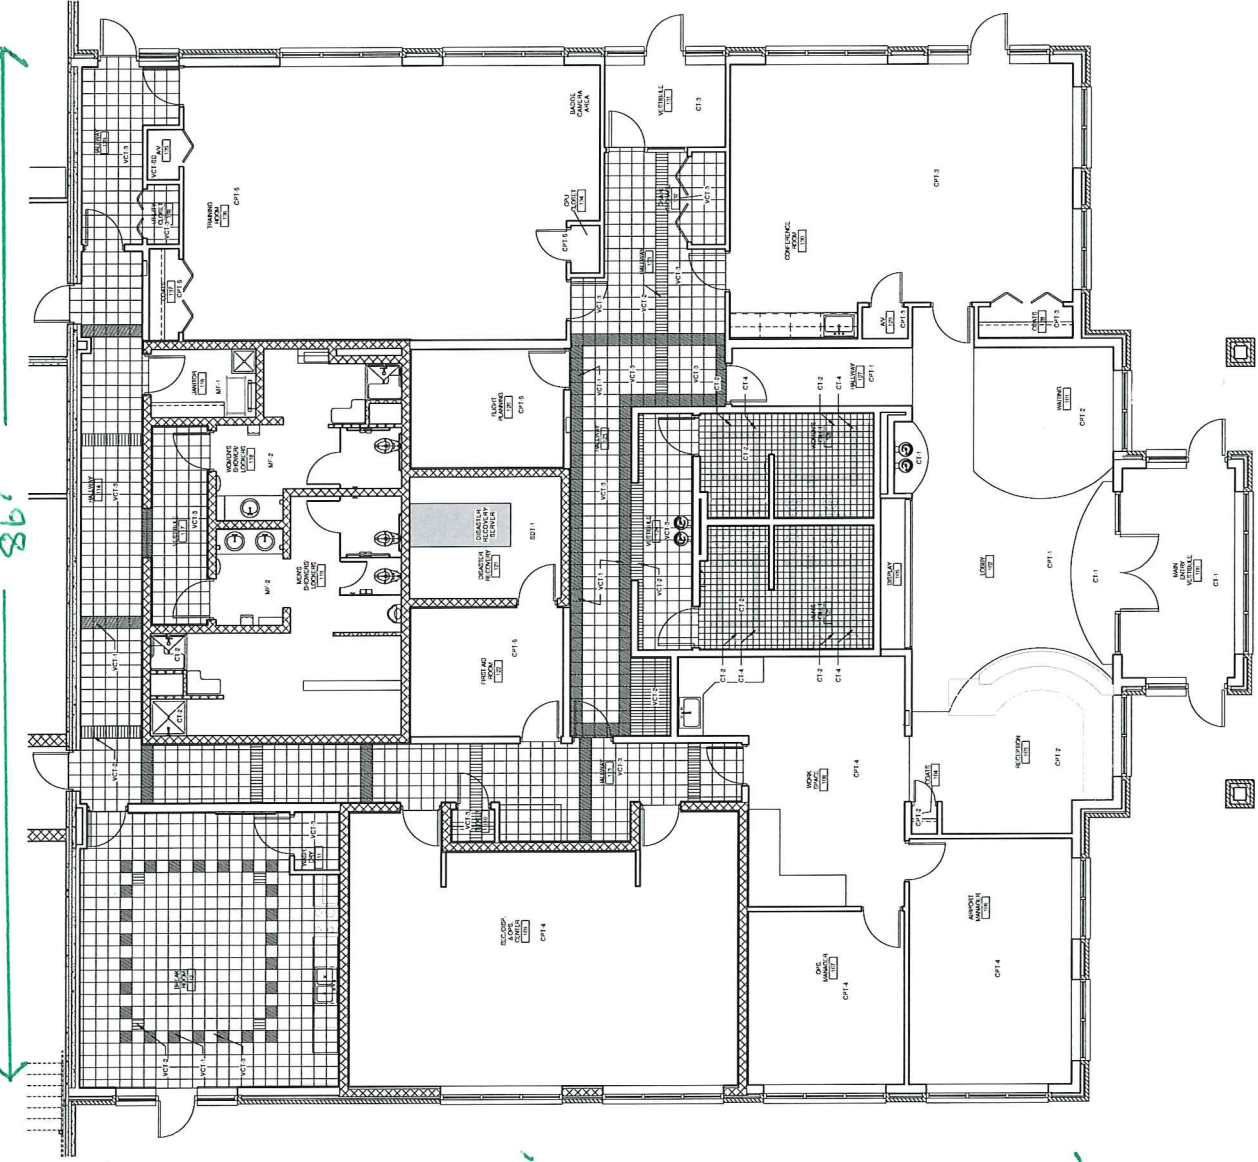

1 FLOOR FINISH PLAN 1/4" = 1'-0"



A-701

W.K. KELLOGG AIRPORT
 ADMINISTRATION, OPERATIONS & MAINTENANCE FACILITY

RECORD
 DRAWINGS

DATE: 02/28/00
 DRAWN BY: J. HARRIS
 CHECKED BY: J. HARRIS
 PROJECT NO.: 001

FLOOR FINISH PLAN
 AND TILE LAYOUT
 DETAILS

MEAD
 HUNT
 ARCHITECTS, INC.
 101 West End
 Raleigh, NC 27601
 Tel: 919.771.0171
 Fax: 919.771.0171
 www.meadhunt.com

NOTES:
 1. SEE GENERAL NOTES TO DRAWINGS.
 2. SEE SPECIFICATIONS FOR MATERIALS AND FINISHES.
 3. SEE ARCHITECT'S RECORD DRAWINGS FOR REVISIONS.

15551 SOUTH AIRPORT ROAD
 BATTLE CREEK, MI 49315
 W.K. KELLOGG AIRPORT
 ADMINISTRATION, OPERATIONS & MAINTENANCE FACILITY
 1. RECORD DRAWING