


SUMMARY OF PAY ITEMS

PAY ITEM NO.	DESCRIPTION	UNIT	PROJECT QUANTITY
ROADWAY PAY ITEMS			
101-1	MOBILIZATION/ DEMOBILIZATION	LS	1
102-1	MAINTENANCE OF TRAFFIC	LS	1
104-2	PREVENTION, CONTROL & ABATEMENT OF EROSION AND WATER POLLUTION	LS	1
110-1-1	CLEARING & GRUBBING	AC	86
110-7-1	MAILBOX F & I	EA	40
120-1	REGULAR EXCAVATION	CY	81,595
120-4	SUBSOIL EXCAVATION	CY	3,198
120-5	CHANNEL EXCAVATION	CY	890
120-6	EMBANKMENT	CY	128,124
160-4	TYPE "B" STABILIZATION	SY	123,552
285-709	OPTIONAL BASE (BASE GROUP 9)	SY	108,050
286-1	TURNOUT CONSTRUCTION	SY	2,320
327-70-01	MILLING EXISTING ASPHALT PAVEMENT (1" AVG. DEPTH)	SY	118
334-1-13	SUPERPAVE ASPHALT CONCRETE (SP-12.5) (TRAFFIC C) (2")	TN	11,959
337-7-82	ASPHALTIC CONCRETE FRICTION COURSE (FC-9.5) (TRAFFIC C) (1")	TN	5,980
339-1	MISCELLANEOUS ASPHALT PAVEMENT	TN	34
400-1-2	CLASS I CONCRETE (ENDWALL)	CY	13.4
400-2-2	CLASS II CONCRETE (ENDWALL)	CY	125.6
400-4-1	REINFORCED CONCRETE BOX CULVERT (12'X10')	LF	72
415-1-1	REINFORCING STEEL (ROADWAY)	LB	6,510
425-1-351	INLETS (CURB) (TYPE P-5) (<10')	EA	32
425-1-361	INLETS (CURB) (TYPE P-6) (<10')	EA	20
425-1-451	INLETS (CURB) (TYPE J-5) (<10')	EA	6
425-1-452	INLETS (CURB)(TYPE J-5) (>10')	EA	4
425-1-452A	INLETS (CURB)(TYPE J-5) (>10') (CONTROL STRUCTURE W/ INTERNAL WEIR)	EA	1
425-1-461	INLETS (CURB) (TYPE J-6) (<10')	EA	11
425-1-462	INLETS (CURB) (TYPE J-6) (>10')	EA	1
425-1-521	INLETS (DT BOT) (TYPE C) (<10')	EA	18
425-1-521A	INLETS (DT BOT)(TYPE C) (<10') (CONTROL STRUCTURE W/ EXTERNAL SKIMMER)	EA	3
425-1-531	INLETS (DT BOT) (TYPE C MOD.) (<10') (BACK OF SWK INLET)	EA	2
425-1-541	INLETS (DT BOT) (TYPE D) (<10')	EA	2
425-1-541A	INLETS (DT BOT)(TYPE D) (<10') (CONTROL STRUCTURE W/ EXTERNAL SKIMMER)	EA	5
425-1-543	INLETS (DT BOT) (TYPE D) (<10') (W/ J BOTTOM)	EA	2
425-1-559	INLETS (DT BOT) (TYPE E)(>10') (CONTROL STRUCTURE W/ INTERNAL WEIR)	EA	2
425-1-581	INLETS (DT BOT) (TYPE H) (<10') (CONTROL STRUCTURE W/ INTERNAL WEIR)	EA	1
425-1-713	INLETS (GUTTER) (VALLEY) (J-BOTTOM)	EA	1
425-1-910	INLETS (CLOSED FLUME)	EA	1
425-2-61	MANHOLES (P-8) (<10')	EA	3
425-2-71	MANHOLES (J-7) (<10') (CONFLICT STRUCTURE)	EA	1
425-2-72	MANHOLES (J-7) (>10')	EA	1
430-175-115	PIPE CULVERT (RCP) (ROUND) (15" SS)	LF	433
430-175-118	PIPE CULVERT (RCP) (ROUND) (18" SS)	LF	6,981
430-175-118A	PIPE CULVERT (CAP) (ROUND) (18" SS)	LF	120
430-175-124	PIPE CULVERT (RCP) (ROUND) (24" SS)	LF	2,387
430-175-124A	PIPE CULVERT (CAP) (ROUND) (24" SS)	LF	112
430-175-130	PIPE CULVERT (RCP) (ROUND) (30" SS)	LF	3,419
430-175-130A	PIPE CULVERT (CAP) (ROUND) (30" SS)	LF	62
430-175-136	PIPE CULVERT (RCP) (ROUND) (36" SS)	LF	2,640
430-175-136A	PIPE CULVERT (CAP) (ROUND) (36" SS)	LF	40
430-175-142	PIPE CULVERT (RCP) (ROUND) (42" SS)	LF	115
430-175-142A	PIPE CULVERT (CAP) (ROUND) (42" SS)	LF	40
430-175-148	PIPE CULVERT (RCP) (ROUND) (48" SS)	LF	240
430-175-148A	PIPE CULVERT (CAP) (ROUND) (48" SS)	LF	20
430-175-160	PIPE CULVERT (RCP) (ROUND) (60" SS)	LF	1,470
430-175-166	PIPE CULVERT (RCP) (ROUND) (66" SS)	LF	408

PAY ITEM NO.	DESCRIPTION	UNIT	PROJECT QUANTITY
ROADWAY PAY ITEMS			
430-175-215	PIPE CULVERT (ERCP) (12"X18" SS)	LF	60
430-175-218	PIPE CULVERT (ERCP) (14" X 23" SS)	LF	239
430-175-236	PIPE CULVERT (ERCP) (29" X 45" SS)	LF	374
430-964-3	PVC PIPE (8") (SCH 80)	LF	1,678
430-982-123	MITERED END SECTION (CONC.) (15" CD)	EA	7
430-982-125	MITERED END SECTION (CONC.) (18" CD)	EA	16
430-982-623	MITERED END SECTION (CONC.) (12"X18" CD)	EA	2
430-982-625	MITERED END SECTION (CONC.) (14"X23"CD)	EA	7
440-1-20	UNDERDRAIN	LF	815
440-1-60	ROCK DRAIN	LF	640
520-1-10	CONCRETE CURB & GUTTER (TYPE F)	LF	26,742
520-1-11	CONCRETE CURB & GUTTER (TYPE F) (MOD.)	LF	14,915
522-2	CONCRETE SIDEWALK , 6" THICK	SY	13,897
527-2	DETECTABLE WARNINGS	SF	187
530-3-4	RIPRAP, RUBBLE (F&I) (DITCH LINING)	TN	2,163
536-1-1	GUARDRAIL (ROADWAY)	LF	581
536-85-22	GUARDRAIL END ANCHORAGE ASSEMBLY (MELT)	EA	2
536-85-25	GUARDRAIL END ANCHORAGE ASSEMBLY (TYPE II)	EA	2
536-85-30	GUARDRAIL END ANCHORAGE ASSEMBLY (ET-2000)	EA	4
550-10-110A	FENCING (TYPE A) (5.0') (STANDARD)	LF	256
550-10-110B	FENCING (TYPE A) (4.0') (STANDARD)	LF	328
550-10-220	FENCING (TYPE B) (6.0') (STANDARD)	LF	661
550-10-222	FENCING (TYPE B) (6.0') (WITH VINYL COATING)	LF	4,563
550-10-410A	FENCING (WOOD) (4.0') (3 RAIL SPLIT RAIL)	LF	267
550-10-410B	FENCING (WOOD) (5.0') (3 RAIL SPLIT RAIL)	LF	696
550-60-213	FENCE GATE (TYPE B) (SINGLE) (16.0' OPENING)	EA	1
550-60-225	FENCE GATE (TYPE B) (DOUBLE) (24.0' OPENING)	EA	4
550-60-912	FENCE GATE (WOOD) (SINGLE) (10.0' OPENING)	EA	1
570-1-2A	PERFORMANCE TURF (SOD) (BAHIA)	SY	175,168
630-2-11A	CONDUIT (OPEN TRENCH) (F&I) (2")	LF	8,100
630-2-11B	CONDUIT (OPEN TRENCH) (F) (2")	LF	8,100
633-1-123	FIBER OPTIC CABLE (F & I) (UNDERGROUND) (49-96 FIBERS)	LF	9,100
633-2-31	FIBER OPTIC CONNECTION (SPLICE)	EA	1,728
633-2-32	FIBER OPTIC CONNECTION (TERMINATION)	EA	96
635-2-12	PULL AND SPLICE BOX (F&I) (17"X30") (PULL BOX)	EA	16
635-2-13	PULL AND SPLICE BOX (F&I) (30"X48") (SLACK BOX)	EA	3
999-1	CONSTRUCTION LAYOUT/ RECORD/ AS-BUILT DRAWINGS (BY REGISTERED SURVEYOR)	LS	1

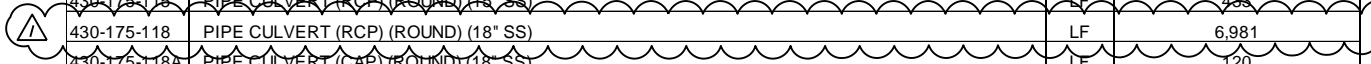

REVISIONS DATE BY DESCRIPTION 2/2021 RMP PLAN QUANTITY CORRECTION		 BRIAN A. GOOD, P.E. P.E. LICENSE NUMBER 56939 445 24th STREET, SUITE 200 VERO BEACH, FL 32960 (772) 794-4100 CERTIFICATE OF AUTHORIZATION# 00000696	INDIAN RIVER COUNTY BOARD OF COUNTY COMMISSIONERS 66th AVENUE ROADWAY WIDENING - PHASE IB 49th STREET TO 69th STREET	SUMMARY OF PAY ITEMS	SHEET NO. 11
					2/3/2021 2:22:18 PM c:\pwworking\kha\pwwprod\rebecca.pastir\dms97739\SUMQRD01.dgn

1505 I.R.C.O. Proj. No. THE OFFICIAL RECORD OF THIS SHEET IS THE ELECTRONIC FILE DIGITALLY SIGNED AND SEALED UNDER RULE 61G15-23.004, F.A.C.

