

Addendum 2

March 9, 2022

Addition and Renovation to: Norris Middle School
 5 Norris Square
 Norris, TN 37828

To: Prime contractors and all others to whom drawings and specifications have been issued. This Addendum forms part of the Contract Documents. It supplements and modifies them as follows:

A. Specifications:

- **Section 00 00 01 – Table of Contents_ADD2:** Updated to reflect changes and additional specs.
- **Section 00 41 13 – Bid Form_ADD2:** Added note regarding allowances.
- **Section 01 21 00 – Allowances_ADD2:** Added allowance for Emergency Responder Radio Antenna-Repeater System.
- **Section 04 20 00 – Unit Masonry_ADD2:** Owner-approved basis of design brick added to spec, which matches existing brick color and texture.
- **Section 07 46 05 – Aluminum Soffits_ADD2:** New section added.
- **Section 08 71 00 – Door Hardware_ADD2:** Updated hardware sets.

B. Drawings:

- **Sheet C001 – Civil Notes & Legend_REV02:** Removed note #11.
- **Sheet C500 – Site Utility Plan_REV02:** Rerouted fire line per bidder question.
- **Sheet A201 – Door Schedule, Window Types, and Details_ADD2:** Updated door hardware.
- **Sheet A301 – Roof Plan_ADD2:** Reference to new roof detail.
- **Sheet A302 – Roof Details_ADD2:** Added detail #3 at main entry canopy.
- **Sheet F301 – Millwork Elevations_ADD2:** Added section cuts to elevations.
- **Sheet F302 – Millwork-Add Alt_ADD2:** Added section cuts to elevations.
- **Sheet F401 – Interior Elevations_ADD2:** Corridor north and south elevations added, showing painted graphics.
- **Sheet FP101 – Floor Plan-Fire Protection_ADD2:** Rerouted fire line.
- **Sheet M202 – HVAC Controls_ADD2:** Added note regarding building HVAC controls.

C. **Clarifications:** See attached bidders' questions list and answers, and RFI's 1 and 2.

D. Attachments:

1. All specifications, drawings, and other attachments mentioned above.

END OF ADDENDUM

Job Number: 210042.04

February 22, 2022:

1. **ARCH** - Duo-Gard is listed by brand name in section 10 73 16 for the canopy system at the Norris Middle School. I reviewed the bid documents and noticed you are calling for a corrugated polycarbonate roof at the canopy. These panels are typically fastened directly through the panel and not a great solution for a canopy system under load. Proposed system is our Series 3100 sloped glazing system. This system includes 25mm thick cellular polycarbonate panels and aluminum glazing channels. Aluminum mullions will be spaced every 24" to 36" on center depending on loadings. This option will give you better performance and longevity over the corrugated panels.

An approximate cost for the Duo-Gard 3100 series system would be \$20.00 - \$22.00 per square foot. Includes 25mm thick cellular polycarbonate in clear or opal. Class 1 clear anodized finish on aluminum frame and mullions. PE calculations and stamped shop drawings. Fasteners for attachment to steel. Project management and engineering. Gutter not included in budget. Installation not included in budget.

Answer and drawings/specs included: The cost is too high at this time. No change in drawings or specs.

March 2, 2022:

2. **ARCH** - Door hardware set number 1 (08 71 00) calls for cylinders only, balance of hardware by hollow metal door supplier. This is common with aluminum storefront doors but hollow metal manufacturers do not provide hardware. Please advise.

Answer and drawings/specs included: See answer to Question #11.

March 3, 2022:

3. **ARCH** - Can we get more detail at the conventional framed main entry canopy cover, specifically the perimeter parapet wall framing. The structural drawings note metal stud parapets (9 & 11 / S502), however I don't see a section on the architectural drawings that notes wall sheathing, cladding, etc.

Answer and drawings/specs included: See Detail 10/A302.

4. **CIVIL** - Reference Sheet C001, utility note #11 calls for fire line to be ductile iron, however C500 utility plan #6 calls for PVC. Please verify the site fire line is to be C-900 PVC.

Answer and drawings/specs included: Note 11 on C001 has been removed and Sheet C001 has been revised. The fire line should be PVC C-900 as specified on the plans.

5. **CIVIL** - Reference Section 01 21 00 Allowances, Items F&G / Allowance 6 & 7 (#6 = geotextile fabric and #7 = compacted stone) note that allowances to be included in base bid are to be found in Section 31 20 00 Earth Moving. However, this section of specifications is on the plans and I have not been able to locate amounts to include. Please advise.

Answer and drawings/specs included: Allowance #6 shall be deleted. Allowance #7 is equal to 60 tons of compacted stone. See revised Section 01 21 00 – Allowances_ADD2.

March 4, 2022:

6. **ARCH** - The RCP notes flush seam aluminum soffit at two areas (entries), however there is a specifications for linear ceiling. Please confirm what system we are to include in our bid. If the intent is to use the linear ceiling (more expensive) product in the specification, can we get confirmation on which type & profile?

Answer and drawings/specs included: See new specification Section 07 46 05 – Aluminum Soffits.

7. **ARCH** - Is there an abatement report? If so, does it include both exterior and interior?

Answer and drawings/specs included: Find attached the Asbestos Management Plan as well as the latest yearly state surveillance report. Anderson County Management plan and yearly surveillance reports only cover the inside of the building envelope.

8. **ARCH** - The door hardware specified is not compatible with the doors that are specified. Can you take a look at this?

Answer and drawings/specs included: See answer to Question #11.

9. **ELECTRICAL** - E001: "Emergency Radio Responder" 1(a) States that the cost of testing needs to be included in the quote. This testing is used to determine if the system is even necessary. 2(a) Goes on to say that if the testing deems the system to be necessary then we are to furnish and install it.

We will include the costs for testing in our bid. Are we to include costs for the system in our bid? If so, can we use a provided allowance so everyone is bidding the same thing since it will need to be designed based on the testing that is not yet completed?

Testing shall be included in the base bid along with any required infrastructure in inaccessible areas. A contractor-provided allowance to be included for the remainder of the system build-out if required.

March 7, 2022:

10. **FIRE PROTECTION** - You cannot run a fire line under a building like it's shown on the FP drawings unless you want to Arch the footings, install valves and put this pipe in an open trench with a grate across it.

Answer and drawings/specs included: Fire line will be routed around the building to the sprinkler room. See sheets C500 and FP101.

11. **ARCH** - The openings specified in door hardware set 1 (08 71 00) are going to require additional hardware in order to function properly and meet egress requirements. We would like to

propose breaking hardware set number one into the five different sets (1A-1E) per the attachment.

Answer and drawings/specs included: Proposed hardware sets accepted. Please see updated specification 08 71 00 – Door Hardware, and Drawing sheet A201.

February 24, 2022

**Norris Middle School
Addition & Renovation
RFI No. 1**

lbeckwith@andersonTN.gov

1. **Reference: Allowances**
 - A. Will you be providing a quantity for Allowance #5, #6, #7 and an amount for Allowance #8?
2. **Reference Addendum #1 issued 2/22/22**
 - A. Indicates drawings changed. The revised drawings were not included in addendum #1 when issued. Please provide
3. **Reference: Specification Section 05 12 00.1.05B**
 - A. Does approval for use of a Steel Fabricator and Installer need to come before the bid, or if it can come after?

Thank you,
Debbie Eaker
deaker@pathcc.com

1. Allowance #5 - Reinforced Concrete Foundations: (#5) See drawing S001, Concrete Note #15.
Allowance #6 - Geotextile Fabric: Allowance was deleted.
Allowance #7 - Compacted Stone: Quantity 60 tons
Allowance #8 - Discretionary Fund: Amount is called out on the Bid Form, and in Section 01 10 00 - Summary.
2. Revised drawings were included in Addendum #1. See pages 18-34.
3. Before the bid.



Path Construction Company, Inc

125 East Algonquin Road
Arlington Heights, IL 60005

Tel: 847.398.7100

Fax: 847.398.7101

www.pathcc.com

February 24, 2022

**Norris Middle School
Addition & Renovation
RFI No. 2**

lbeckwith@andersonTN.gov

1. Page F401 it states "Painted Wall Graphics" can you provide what these graphics will be ? I can not locate any further information.

Thank you,
Debbie Eaker
deaker@pathcc.com

Please see attached revised drawing sheet F401 for wall graphics.

In Progress

PERIODIC SURVEILLANCE REPORT

LEA NAME Anderson County Schools

LEA NO. 010

SCHOOL NAME Anderson County High School

BUILDING NO. 11

BUILDING NAME _____

INSTRUCTIONS: AHERA regulations require a Periodic Surveillance be conducted every six months. Each school building containing ACBM must be inspected. Put the date in the appropriate column, fill in the HA#, Description of ACBM, and Area Inspected. If the ACBM has been removed, put the date removed in the appropriate column. Keep the original with your Management Plan.

			1 st Six months Date: 01/2020 Winter	2 nd Six months Date: Summer	
HA#	Description of ACBM	Area Inspected	ACBM Condition*	ACBM Condition*	Date Removed
03	White 12" x 12" floor tile with blue streaks and black mastic	Teacher depot in business building	N/C		
10	Black pliable window glazing	Downstairs older section classrooms of science/math building, exterior windows	N/C		
20	White mastic on fiberglass pipe wrap	Library ceiling plenum	N/C		
Note on HA 03:	Several chips and rough edges observed.				

*IF NO CHANGE IN CONDITION WRITE N/C

SURVEILLANCE INSPECTOR'S NAME (please print): _____ Emily M. Mollish _____

SURVEILLANCE INSPECTOR'S SIGNATURE:
(Surveillance Inspector is not required to be AHERA certified)

AHERA Accreditation Number/Date (if applicable): A-MP-68828-

TAHERA 9.0 (12/93)

In Progress

PERIODIC SURVEILLANCE REPORT

LEA NAME Anderson County Schools

LEA NO. 010

SCHOOL NAME Andersonville Elementary

BUILDING NO. 03

BUILDING NAME _____

INSTRUCTIONS:

AHERA regulations require a Periodic Surveillance be conducted every six months. Each school building containing ACBM must be inspected. Put the date in the appropriate column, fill in the HA#, Description of ACBM, and Area Inspected. If the ACBM has been removed, put the date removed in the appropriate column. Keep the original with your Management Plan.

			1 st Six months Date: 01/2021 Winter	2 nd Six months Date: Summer	
HA#	Description of ACBM	Area Inspected	ACBM Condition*	ACBM Condition*	Date Removed
01	9"x9" Gray and Pink Floor Tile	Classroom 26	N/C		
02	9"x9" Brown and Black Floor Tile	Classrooms 18, 19, 20, and 27	N/C		
03	9"x9" Gray and Red Floor Tile	Under Existing Floor Tile	N/C		
04	1'x1' Tan and White Floor Tile	Under Existing Floor Tile	N/C		
07	9"x9" Black and Pink Floor Tile	Under Existing Floor Tile	N/C		
Note on HA 01:	Room 26: Small cracks at whiteboard, rear chalk board, cracked tile at sink, and staining observed between tiles.				
Note on HA 02:	Room 18: Small chip at the sink.				
Other Notes:	Book Room: Bubbles at desk and half missing floor Tile at window, patch at windows. Room 19: Patch at windows				

*IF NO CHANGE IN CONDITION WRITE N/C

SURVEILLANCE INSPECTOR'S NAME (please print): Emily M. Mollish

SURVEILLANCE INSPECTOR'S SIGNATURE:
(Surveillance Inspector is not required to be AHERA certified)

AHERA Accreditation Number/Date (if applicable): A-MP-68828-

TAHERA 9.0 (12/93)

In Progress

PERIODIC SURVEILLANCE REPORT

LEA NAME Anderson County Schools

LEA NO. 010

SCHOOL NAME Briceville Elementary

BUILDING NO. 01

BUILDING NAME _____

INSTRUCTIONS: AHERA regulations require a Periodic Surveillance be conducted every six months. Each school building containing ACBM must be inspected. Put the date in the appropriate column, fill in the HA#, Description of ACBM, and Area Inspected. If the ACBM has been removed, put the date removed in the appropriate column. Keep the original with your Management Plan.

			1 st Six months Date: 01/2021 Winter	2 nd Six months Date: Summer	
HA#	Description of ACBM	Area Inspected	ACBM Condition*	ACBM Condition*	Date Removed
02	Brown 9"x9" Floor Tile with Brown Streaks	Entire School Except Cafeteria, Main Office, Hallways, and Classrooms 9, 13, 14, 15	N/C		
Note:	Room 1: Missing Floor Tiles at the sink. Room 2: Small chip at the sink, patched and cracked tiles at window. Chips at front whiteboard.				
	Room 3: One small chip at window. Room 4: One small chip at whiteboard, patched tile and circle drawn on floor.				
	Room 5: Cracked and missing tile on both sides of sink and chips at the whiteboard. Room 6: One half tile missing at the sink. Small chips in corner at front door				
	Room 7: Patched tiles at sink and water stained/damaged tile at rear desk, one new chip at window Room 8: One small chip at the sink.				
	Room 11: Small cracks at the rear corner at the sink, small cracks at the front whiteboard. Loose at sink, cracks at rear corkboard Room 12: One half tile missing in front of sink. Chip at sink, chips at windows				

*IF NO CHANGE IN CONDITION WRITE N/C

SURVEILLANCE INSPECTOR'S NAME (please print): Emily M. Mollish

SURVEILLANCE INSPECTOR'S SIGNATURE:
(Surveillance Inspector is not required to be AHERA certified)

AHERA Accreditation Number/Date (if applicable): A-MP-68828-

TAHERA 9.0 (12/93)

Classroom 1: chips at front whiteboard
Classroom 2: same
Classroom 3: partial missing tile at sink

In Progress

Classroom 4: same
Classroom 11: same

DRAFT

In Progress

PERIODIC SURVEILLANCE REPORT

LEA NAME Anderson County Schools

LEA NO. 010

SCHOOL NAME Claxton Elementary

BUILDING NO. 20

BUILDING NAME _____

INSTRUCTIONS: AHERA regulations require a Periodic Surveillance be conducted every six months. Each school building containing ACBM must be inspected. Put the date in the appropriate column, fill in the HA#, Description of ACBM, and Area Inspected. If the ACBM has been removed, put the date removed in the appropriate column. Keep the original with your Management Plan.

			1 st Six months Date: 01/2020 Winter	2 nd Six months Date: Summer	
HA#	Description of ACBM	Area Inspected	ACBM Condition*	ACBM Condition*	Date Removed
04	1'x1' Beige and Brown Floor Tile	Custodial Storage Across from Cafeteria	N/C		
15	Pipe Insulation	Enclosed pipe chase in custodial storage area across from cafeteria	N/C		
16	Pipe Fitting	Enclosed pipe chase in custodial storage area across from cafeteria	N/C		
18	Transite Board	Sidewalk	N/C		
19	9"x9" Brown, White and Gray Floor Tile	3 rd Grade Pod except Classrooms 16, 17	N/C		
Note:	Room 17: Cracks outside classroom. Loose Tiles under leak – non ACM Room 12: Cracks @ exterior door				

*IF NO CHANGE IN CONDITION WRITE N/C

SURVEILLANCE INSPECTOR'S NAME (please print): _____ Emily M. Mollish _____

SURVEILLANCE INSPECTOR'S SIGNATURE:
(Surveillance Inspector is not required to be AHERA certified)

AHERA Accreditation Number/Date (if applicable): A-MP-68828-

TAHERA 9.0 (12/93)

In Progress

PERIODIC SURVEILLANCE REPORT

LEA NAME Anderson County Schools

LEA NO. 010

SCHOOL NAME Clinton Middle School

BUILDING NO. 16

BUILDING NAME _____

INSTRUCTIONS: AHERA regulations require a Periodic Surveillance be conducted every six months. Each school building containing ACBM must be inspected. Put the date in the appropriate column, fill in the HA#, Description of ACBM, and Area Inspected. If the ACBM has been removed, put the date removed in the appropriate column. Keep the original with your Management Plan.

			1 st Six months Date: 01/2021 Winter	2 nd six months Date: Summer	
HA#	Description of ACBM	Area Inspected	ACBM Condition*	ACBM Condition*	Date Removed
5	9" x 9" Grey w/ Black & White Streaks Floor Tile	Guidance Office Under Vinyl Floor Tile	N/C		
6	9" x 9" Light Grey w/White Streaks Floor Tile	Under Existing Vinyl Floor Tile in classrooms	N/C		
7	9" x 9" Brown w/Pink, Beige, and Black Specks Floor Tile	Hallways in West Side of School under Floor Tile in Technology Classroom, In School Suspension, and Staff Lounge	N/C		
8	9" x 9" Beige w/Pink, White, and Gray Streaks Floor Tile	Under Existing Vinyl Floor Tile	N/C		
9	1' x 1' Blue Floor Tile	Under Existing Vinyl Floor Tile	N/C	Partial Abatement July 2020	
10	12" x 12" White w/Black & White Specks Floor Tile	Classrooms 25, 26, 27, 31, 32, 33 Under Existing Vinyl Floor Tile	N/C	Partial Abatement July 2020	
15	9" x 9" Black w/White Streaks Floor Tile	Band Room Under Carpeting	N/C		
16	1' x 1' Tan w/Brown & White Streaks Floor Tile	In Classrooms 1-13; 15-19; 20-24; 34-37; and Guidance, Office Under Existing Vinyl Floor Tile	N/C		
Note:	Hall at Room 18: One chip up ramp at library/auditorium. 12"x12" Floor Tile covers Asb. Tile. Library/Auditorium threshold has cracks.				
	Teacher's Lounge: One chip at threshold. 12"x12" Floor Tile covers Asb. Tile.				
	8 th Grade Hallway: Noticeable wear on 12"x12" Floor Tiles that cover Asb. Tile.				
	7 th Grade Lower Hallway: Under lockers - Loose 12"x12" Floor Tiles that cover Asb. Tile.				

*IF NO CHANGE IN CONDITION WRITE N/C

SURVEILLANCE INSPECTOR'S NAME (please print): Emily M. Mollish

SURVEILLANCE INSPECTOR'S SIGNATURE:
(Surveillance Inspector is not required to be AHERA certified)

AHERA Accreditation Number/Date (if applicable): A-MP-68828-

TAHERA 9.0 (12/93)

In Progress

Ridges in tile covering asb tile in auditorium hallway

Loose and cracking beige tiles outside classroom 15

Loose tiles outside Lewis classroom 38

Epoxy floor poured in hallway and classrooms across from main office where tile was removed in summer 2020

DRAFT

In Progress

PERIODIC SURVEILLANCE REPORT

LEA NAME Anderson County Schools

LEA NO. 010

SCHOOL NAME Dutch Valley Elementary

BUILDING NO. 09

BUILDING NAME _____

INSTRUCTIONS: AHERA regulations require a Periodic Surveillance be conducted every six months. Each school building containing ACBM must be inspected. Put the date in the appropriate column, fill in the HA#, Description of ACBM, and Area Inspected. If the ACBM has been removed, put the date removed in the appropriate column. Keep the original with your Management Plan.

			1 st Six months Date: 01/2021 Winter	2 nd six months Date: Summer	
HA#	Description of ACBM	Area Inspected	ACBM Condition*	ACBM Condition*	Date Removed
04	9"x9" Floor Tile	Classrooms 2, 3, 4, 5, Teacher's Workroom, Principal's Office and Clinic under existing 12" x 12" Gray Speckled Floor Tile	N/C		
Note:	Room 6: Art Classroom has 12"x12" Floor Tile. Bubbles observed at the window.				

*IF NO CHANGE IN CONDITION WRITE N/C

SURVEILLANCE INSPECTOR'S NAME (please print): _____ Emily M. Mollish _____

SURVEILLANCE INSPECTOR'S SIGNATURE:
(Surveillance Inspector is not required to be AHERA certified)

AHERA Accreditation Number/Date (if applicable): A-MP-68828-

TAHERA 9.0 (12/93)

In Progress

PERIODIC SURVEILLANCE REPORT

LEA NAME Anderson County Schools

LEA NO. 010

SCHOOL NAME Lake City Elementary

BUILDING NO. 14

BUILDING NAME _____

INSTRUCTIONS: AHERA regulations require a Periodic Surveillance be conducted every six months. Each school building containing ACBM must be inspected. Put the date in the appropriate column, fill in the HA#, Description of ACBM, and Area Inspected. If the ACBM has been removed, put the date removed in the appropriate column. Keep the original with your Management Plan.

			1 st Six months Date: 01/2021 Winter	2 nd Six months Date: Summer	
HA#	Description of ACBM	Area Inspected	ACBM Condition*	ACBM Condition*	Date Removed
01	9"x9" Gray and Tan Speckled Floor Tile	Classrooms 64-71 and Hallway on East of Building and Custodian Closet at Bathrooms	N/C		
03	9"x9" Tan Floor Tile	3 rd Grade Hall under Gray Speckled 12" x 12" Floor Tile	N/C		
Note:	Art Room: Some chips and delaminating tiles at the AC Unit.				

*IF NO CHANGE IN CONDITION WRITE N/C

SURVEILLANCE INSPECTOR'S NAME (please print): _____ Emily M. Mollish _____

SURVEILLANCE INSPECTOR'S SIGNATURE:
(Surveillance Inspector is not required to be AHERA certified)

AHERA Accreditation Number/Date (if applicable): A-MP-68828-TAHERA 9.0 (12/93)

Termite poison holes and chipped tile in kiln room at art room
Loose tiles at a unit in hallway at exterior door. Apex 20 tiles

In Progress

PERIODIC SURVEILLANCE REPORT

LEA NAME Anderson County Schools

LEA NO. 010

SCHOOL NAME Lake City Middle School

BUILDING NO. 12

BUILDING NAME _____

INSTRUCTIONS: AHERA regulations require a Periodic Surveillance be conducted every six months. Each school building containing ACBM must be inspected. Put the date in the appropriate column, fill in the HA#, Description of ACBM, and Area Inspected. If the ACBM has been removed, put the date removed in the appropriate column. Keep the original with your Management Plan.

			1 st Six months Date: 01/2021 Winter	2 nd six months Date: Summer	
HA#	Description of ACBM	Area Inspected	ACBM Condition*	ACBM Condition*	Date Removed
05	9"x9" Brown with Brown Specs Floor Tile	Janitor's Closet at Gymnasium and Closet in Classroom 124	N/C		

*IF NO CHANGE IN CONDITION WRITE N/C

SURVEILLANCE INSPECTOR'S NAME (please print): Emily M. Mollish

SURVEILLANCE INSPECTOR'S SIGNATURE:
(Surveillance Inspector is not required to be AHERA certified)

AHERA Accreditation Number/Date (if applicable): A-MP-68828-

TAHERA 9.0 (12/93)

In Progress

PERIODIC SURVEILLANCE REPORT

LEA NAME Anderson County Schools

LEA NO. 010

SCHOOL NAME Norris Elementary

BUILDING NO. 04

BUILDING NAME _____

INSTRUCTIONS: AHERA regulations require a Periodic Surveillance be conducted every six months. Each school building containing ACBM must be inspected. Put the date in the appropriate column, fill in the HA#, Description of ACBM, and Area Inspected. If the ACBM has been removed, put the date removed in the appropriate column. Keep the original with your Management Plan.

			1 st Six months Date: 01/2021 Winter	2 nd Six months Date: Summer	
HA#	Description of ACBM	Area Inspected	ACBM Condition*	ACBM Condition*	Date Removed
01	9"x9" Brown, Pink, and White Floor Tile	West Wing Classrooms 2, 4, 6,7,8,9, 10, 21	N/C		
02	9"x9" Gray, Black, and White Floor Tile	Office Under Current Tile	N/C		
03	1'x1' Black and White Floor Tile	Office Under Current Tile	N/C		
05	9"x9" Gray, Black, and White Floor Tile	West Wing Classrooms 1,3, 5 and Janitor Storeroom	N/C		
<p>Note: Cox Room: ½ Floor Tile is missing at the window/drain. Robinson Room: Cracks at the bathroom sink, one corner tile is loose at the window sink. Stedie Room: one Floor Tile is missing at the window/drain. Mrs.F Room: one chipped Floor Tile at bathroom sink, cracked tiles observed White Room: one chipped Floor Tile under closet, chipped tiles at window/drain. Replaced Floor Tile at rear window and sink Sharp Room: cracked bathroom Floor Tiles observed. Some patched Byrd Room: loose Floor Tile near rear white board, chipped tile at windows. Copeland Room: Cracked tiles at bathroom. Swisher Room: stained and cracked tiles in corner at the windows and along windows, bubbles near rear part of classroom. Travis Room: cracked Floor Tiles at the front of room at the storage closet and at windows. Missing Floor Tiles at windows/drain. "Welcome Owls" Room: one missing Floor Tile at sink and 2-4 loose tiles at sink Floyd Room: cracked Floor Tiles at sink</p>					

*IF NO CHANGE IN CONDITION WRITE N/C

SURVEILLANCE INSPECTOR'S NAME (please print): _____ Emily M. Mollish _____

SURVEILLANCE INSPECTOR'S SIGNATURE:
(Surveillance Inspector is not required to be AHERA certified)

AHERA Accreditation Number/Date (if applicable): A-MP-68828-

TAHERA 9.0 (12/93)

In Progress

PERIODIC SURVEILLANCE REPORT

LEA NAME Anderson County Schools

LEA NO. 010

SCHOOL NAME Norris Middle School

BUILDING NO. 18

BUILDING NAME _____

INSTRUCTIONS: AHERA regulations require a Periodic Surveillance be conducted every six months. Each school building containing ACBM must be inspected. Put the date in the appropriate column, fill in the HA#, Description of ACBM, and Area Inspected. If the ACBM has been removed, put the date removed in the appropriate column. Keep the original with your Management Plan.

			1 st Six months Date: 01/2021 Winter	2 nd Six months Date: Summer	
HA#	Description of ACBM	Area Inspected	ACBM Condition*	ACBM Condition*	Date Removed
02	1'x1' Brown and Black Floor Tile	Band/ Shop Wing Under Carpet	N/C		
04	Ceiling Tile	Cafeteria	N/C		
07	Ceiling Tile	Former Shop/ Technology Classrooms	N/C		
09	Pipe Insulation	Custodial Storage	N/C		
Note on HA 02:	Band hallway floor tile is cracked at the water fountain.				
Note on HA 04:	Cafeteria ceiling tile shows stains at the kitchen side/window side.				

*IF NO CHANGE IN CONDITION WRITE N/C

SURVEILLANCE INSPECTOR'S NAME (please print): Emily M. Mollish

SURVEILLANCE INSPECTOR'S SIGNATURE:
(Surveillance Inspector is not required to be AHERA certified)

AHERA Accreditation Number/Date (if applicable): A-MP-68828-TAHERA 9.0 (12/93)

In Progress

PERIODIC SURVEILLANCE REPORT

LEA NAME Anderson County Schools

LEA NO. 010

SCHOOL NAME Norwood Elementary

BUILDING NO. 19

BUILDING NAME _____

INSTRUCTIONS: AHERA regulations require a Periodic Surveillance be conducted every six months. Each school building containing ACBM must be inspected. Put the date in the appropriate column, fill in the HA#, Description of ACBM, and Area Inspected. If the ACBM has been removed, put the date removed in the appropriate column. Keep the original with your Management Plan.

			1 st Six months Date: 01/2021 Winter	2 nd Six months Date: Summer	
HA#	Description of ACBM	Area Inspected	ACBM Condition*	ACBM Condition*	Date Removed
18	Floor Tile under Beige Ceramic Tile	Library	N/C		
18	Blue and White Streaked 9" x 9" Floor Tile	Upper Wing Room 100	N/C		
18	Red and White Streaked 9" x 9" Floor Tile	Upper Wing Room 200	N/C		
18	Tan and Black Streaked 9" x 9" Floor Tile	Upper Wing Room 103, 104 under vinyl floor tile	N/C		
18	Gray with White and Black Streaks 9" x 9" Floor Tile	Upper Wing Room 101, 201, 206	N/C		
18	White speckled 12" x 12" Floor Tile	Upper Wing Room 202	N/C		
18	Floor Tile under Green 12" x 12" with Green Streaks	Upper Wing Room 105, 106 under vinyl floor tile	N/C		
Note:	Staining noted in Room 100 & 101. Room 101 had damage tile at the AC Unit. Carpet is covering floor in Room 102.				
	Room 104 has Floor Tile that is uncovered.				
	Room 200 has water stained tile located at the sink, cracks at bathroom, back door, and hvac.				
	Room 201 has damaged floor tile at the corkboard. Patches at sink and AC Units				
	Room 206 Patch at sink and AC Units, White stains from stripper				
	Room 101 (Mr. Tinker) Squishy tile with water coming out from AC Unit				
	Room 104 Significant squishy tile at AC Unit				

*IF NO CHANGE IN CONDITION WRITE N/C

SURVEILLANCE INSPECTOR'S NAME (please print): Emily M. Mollish

SURVEILLANCE INSPECTOR'S SIGNATURE:
(Surveillance Inspector is not required to be AHERA certified)

AHERA Accreditation Number/Date (if applicable): A-MP-68828-
TAHERA 9.0 (12/93)

In Progress

PERIODIC SURVEILLANCE REPORT

LEA NAME Anderson County Schools

LEA NO. 010

SCHOOL NAME Norwood Middle School

BUILDING NO. 17

BUILDING NAME _____

INSTRUCTIONS: AHERA regulations require a Periodic Surveillance be conducted every six months. Each school building containing ACBM must be inspected. Put the date in the appropriate column, fill in the HA#, Description of ACBM, and Area Inspected. If the ACBM has been removed, put the date removed in the appropriate column. Keep the original with your Management Plan.

			1 st Six months Date: 01/2021 Winter	2 nd Six months Date: Summer	
HA#	Description of ACBM	Area Inspected	ACBM Condition*	ACBM Condition*	Date Removed
05	Floor Tile	Center of Upper Floor – Principal’s Office, Front Office, Library under carpet	N/C		
Note:	Carpet in Library: damage at front desk, no tile exposed				
Note:	Coach’s rooms: tile removed				

*IF NO CHANGE IN CONDITION WRITE N/C

SURVEILLANCE INSPECTOR’S NAME (please print): Emily M. Mollish

SURVEILLANCE INSPECTOR’S SIGNATURE:
(Surveillance Inspector is not required to be AHERA certified)

AHERA Accreditation Number/Date (if applicable): A-MP-68828-

TAHERA 9.0 (12/93)

In Progress

PERIODIC SURVEILLANCE REPORT

LEA NAME Anderson County Schools

LEA NO. 010

SCHOOL NAME Office of Technology

BUILDING NO.

BUILDING NAME _____

INSTRUCTIONS:

AHERA regulations require a Periodic Surveillance be conducted every six months. Each school building containing ACBM must be inspected. Put the date in the appropriate column, fill in the HA#, Description of ACBM, and Area Inspected. If the ACBM has been removed, put the date removed in the appropriate column. Keep the original with your Management Plan.

			1 st Six months Date: 01/2021 Winter	2 nd Six months Date: Summer	
HA#	Description of ACBM	Area Inspected	ACBM Condition*	ACBM Condition*	Date Removed
10	White 12" x 12" with black streaked floor tile in checkered pattern (mastic and black tile negative)	Upstairs restrooms, multimedia center, upstairs hallway, lobby, admin area, break room, and data center under carpet	N/C		
12	Green 9" x 9" floor tile with black mastic	Upstairs janitor's closet and mechanical rooms under carpet	N/C		
13	Green 12" x 12" with white streaks floor tile with yellow mastic	Upstairs data manager's office, documentation center, copy center, kitchen, and technology trainer office under carpet	N/C		

*IF NO CHANGE IN CONDITION WRITE N/C

SURVEILLANCE INSPECTOR'S NAME (please print): Emily M. Mollish

SURVEILLANCE INSPECTOR'S SIGNATURE:
(Surveillance Inspector is not required to be AHERA certified)

AHERA Accreditation Number/Date (if applicable): A-MP-68828-
TAHERA 9.0 (12/93)

TABLE OF CONTENTS

DIVISION 00 – PROCUREMENT AND CONTRACTING REQUIREMENTS

BIDDING REQUIREMENTS

00 11 16	Invitation to Bid
00 21 13	AIA A701-2018 Instructions to Bidders
00 22 13	Supplementary Instructions to Bidders
00 35 00	Iran Divestment Act Signature Page
00 41 13	Bid Form <u>ADD2</u>
00 41 14	Bid Envelope Cover
00 42 01	Attachment 1 – Non-Collusion Affidavit
00 42 02	Attachment 2 – Diversity Business Information
00 42 03	Attachment 3 – Insurance Requirement Acknowledgement
00 42 04	Attachment 4 – Background Check
00 42 05	Attachment 5 – Drug Free Workplace Affidavit
00 42 06	Attachment 6 – Conflict of Interest Form
00 43 36	Subcontractors and Major Material Suppliers List
00 45 46	Authorization to do Business in Tennessee
00 48 61	Specification Compliance Form
00 62 00	MBI Electronic Files Release Form
00 62 17	Schedule of Inspection and Testing Agencies
00 62 18	Qualifications of Inspectors and Testing Technicians
00 63 13	Contractor’s Request for Information
00 63 25	Substitution Request Form

GENERAL CONDITIONS

00 72 00	AIA A201-2017 General Conditions of the Contract for Construction
00 73 00	Supplementary Conditions
00 73 43	Wage Rate Requirements
00 73 44	Wage Rate Determination

CONTRACT SPECIFICATIONS

DIVISION 01 - GENERAL REQUIREMENTS

01 10 00	Summary <u>ADD1</u>
01 21 00	Allowances <u>ADD2</u>
01 23 00	Alternates
01 25 00	Substitution Procedures
01 29 00	Payment Procedures
01 30 00	Administrative Requirements
01 31 00	Project Management and Coordination
01 32 00	Construction Progress Documentation
01 32 50	Weather Delays
01 33 20	Submittal Cover Sheet
01 35 00	Special Procedures
01 41 00	Regulatory Requirements
01 45 00	Quality Control
01 45 33	Code-Required Special Inspections and Procedures
01 50 00	Temporary Facilities and Controls
01 60 00	Product Requirements
01 70 00	Execution and Closeout Requirements
01 74 19	Construction Waste Management and Disposal

01 78 00 Closeout Submittals

DIVISION 02 - EXISTING CONDITIONS

02 06 14 Report of Geotechnical Exploration
02 41 19 Selective Demolition

DIVISION 03 - CONCRETE

03 30 00 Cast-In-Place Concrete
03 30 01 Mix Design Submittal Form
03 35 43 Polished Concrete Finishing ADD1

DIVISION 04 - MASONRY

04 20 00 Unit Masonry ADD2

DIVISION 05 - METALS

05 12 00 Structural Steel Framing
05 12 13 Architecturally-Exposed Structural Steel Framing
05 21 00 Steel Joist Framing
05 31 00 Steel Decking
05 40 00 Cold-Formed Metal Framing
05 50 00 Metal Fabrications

DIVISION 06 - WOOD, PLASTICS, AND COMPOSITES

06 10 00 Rough Carpentry
06 41 00 Architectural Wood Casework

DIVISION 07 - THERMAL AND MOISTURE PROTECTION

07 13 26 Waterproofing & Dampproofing
07 21 00 Thermal Insulation
07 46 05 Aluminum Soffits ADD2
07 53 23 EPDM Roofing – Fully Adhered
07 62 00 Sheet Metal Flashing and Trim
07 65 26 Self-Adhering Sheet Flashing
07 72 00 Roof Accessories
07 92 00 Joint Sealants

DIVISION 08 - OPENINGS

08 11 13 Hollow Metal Doors and Frames
08 14 16 Flush Wood Doors
08 31 00 Access Doors and Panels
08 51 13 Aluminum Windows
08 71 00 Door Hardware ADD2
08 71 13 Automatic Door Operators
08 80 00 Glazing ADD1
08 84 10 Corrugated Polycarbonate Panels

DIVISION 09 - FINISHES

09 21 16 Gypsum Board Assemblies

09 51 00	Acoustical Ceilings
09 54 23	Linear Metal Ceilings
09 65 20	Resilient Base
09 91 00	Painting

DIVISION 10 – SPECIALTIES

10 14 00	Signage
10 14 16	Plaques
10 21 13	Plastic Toilet Compartments
10 28 00	Toilet Accessories
10 44 00	Fire Protection Specialties
10 73 16	Freestanding Metal Canopy

DIVISION 11 - EQUIPMENT (NOT USED)

DIVISION 12 - FURNISHINGS

12 36 00	Countertops
----------	-------------

DIVISION 13 - SPECIAL CONSTRUCTION (NOT USED)

DIVISION 14 - CONVEYING EQUIPMENT (NOT USED)

DIVISION 21 - FIRE SUPPRESSION

DIVISION 22 - PLUMBING

DIVISION 23 - HEATING, VENTILATING, AND AIR CONDITIONING (HVAC)

DIVISION 26 – ELECTRICAL

26 05 19	Low-Voltage Electrical Power Conductors and Cables
26 05 26	Grounding and Bonding for Electrical Systems
26 05 29	Hangers and Supports for Electrical Systems
26 05 33	Raceways and Boxes for Electrical Systems
26 05 44	Sleeve and Sleeve Seals for Electrical Raceways and Cabling
26 05 53	Identification for Electrical Systems
26 24 16	Panelboards
26 27 26	Wiring Devices
26 28 16	Enclosed Switches and Circuit Breakers

DIVISION 27 – COMMUNICATIONS

27 00 00	Emergency Responder Radio Antenna-Repeater System
----------	---

DIVISION 28 - ELECTRONIC SAFETY AND SECURITY

28 46 21	Addressable Fire-Alarm Systems
----------	--------------------------------

DIVISION 31 - EARTHWORK (SPECIFICATIONS ON DRAWINGS)

DIVISION 32 - EXTERIOR IMPROVEMENTS (SPECIFICATIONS ON DRAWINGS)

DIVISION 33 – UTILITIES (SPECIFICATIONS ON DRAWINGS)

TO: Purchasing Department
Attention: Lydia Beckwith
Anderson County Courthouse
100 North Main Street, Room 214
Clinton, TN 37716

DATED: _____, 2022

Having carefully examined the Invitation and Instructions to Bidders, the General Conditions of the Contract and Specifications entitled "Addition and Renovation to: Norris Middle School", 5 Norris Square, Norris, TN 37828" and the Drawings similarly entitled, as well as the premises and conditions affecting the work, the Undersigned proposes to furnish all materials and labor called for by them for the work in accordance with said documents for the sum of:

_____ Dollars (\$_____).

hereinafter referred to as the Base Bid.

We further submit the following proposal for the described alternates below. The work under these alternates will conform to all applicable provisions of specifications, except as specifically noted otherwise. The amount quoted includes the cost of all incidental omissions, additions, adjustments required because of the change, and the modification and/or removal of existing items as necessary for the new work. All items not specifically identified as an alternate item is included in the Base Bid above.

ALTERNATE 1 – REPLACE CASEWORK AND REPAINT EXISTING CLASSROOMS #216 AND 217

If Alternate 1 for providing material, equipment, labor, and supervision necessary to replace existing casework in Classrooms #216 and 217; and repaint the walls in same classrooms is accepted, add to the Base Bid the sum of

_____ Dollars (\$_____).

Allowance #1: Discretionary Fund of \$100,000 is included in Base Bid.

All other allowances, see Section 01 21 00 – Allowances.

The Bidder hereby acknowledges that the following documents are attached to and made a condition of this Bid:

- | | |
|---|--|
| a) Required Bid Security in the form of: 5% Bid Bond. | b) Attachment 1: Non-Collusion Affidavit |
| c) Attachment 2: Diversity Business Information. | d) Attachment 3: Insurance Requirement Acknowledgement |
| e) Attachment 4: Background Check Compliance Form | f) Attachment 5: Drug Free Workplace Affidavit. |
| g) Attachment 6: Conflict of Interest Form | h) Specification Compliance Form |

If written notice of the acceptance of this bid is mailed, emailed, or delivered to the Undersigned within sixty (60) days after the date of receipt of bids or at any time thereafter before this bid is withdrawn, the Undersigned agrees that he will execute and deliver a Contract on the forms which will be provided him in accordance with bid as specified; and that he will give performance and payment bonds as specified with good and sufficient surety or sureties all within ten (10) days, unless a longer period is allowed after the prescribed forms are presented to him for signature.

The Bidder proposes to complete the work within _____ consecutive calendar days from the Notice to Proceed. The Bidder, by submitting this Bid, agrees to furnish labor, materials, equipment, etc., necessary to complete the work by the above stated dates and to accept the conditions for liquidated damages in the amount of **Five Hundred Dollars (\$500.00)** per calendar day. The above stated dates for completion of this project are of utmost importance to the Owner.

The Undersigned hereby acknowledges receipt of all Contract Documents including all pages of the Specifications, all sheets of the Drawings, and the following Addenda:

Addendum No. ____ Date: _____	Addendum No. ____ Date: _____
Addendum No. ____ Date: _____	Addendum No. ____ Date: _____
Addendum No. ____ Date: _____	Addendum No. ____ Date: _____

Sincerely,

Bidder (If by a Corporation, this Bid must have the Signature Required by its By-Laws)

Title

Firm Name

State of Incorporation

State License No.

Official Address

END OF BID FORM

PART 1 GENERAL

1.01 SUMMARY

- A. This section includes administrative and procedural requirements governing Allowances and Unit Prices.
- B. Allowances included on the drawings or in individual specification sections not specifically listed herein shall be bound by the procedures described herein. The Schedule of Allowances may not be a comprehensive list of all Allowances to be included in the Bid.

1.02 RELATED DOCUMENTS

- A. Applicable provisions of the General Conditions, Supplementary Conditions, and Division 1 General Requirements apply to the work under this section.

1.03 ALLOWANCES

- A. Types of allowances include the following:
 - 1. Allowances as listed hereafter.
 - 2. Discretionary Fund/Contingency Allowance.
- B. Selection and Purchases:
 - 1. At the earliest practical date after award of the Contract, advise the Architect of the date when the final selection and purchase of each product or system described by an allowance must be completed to avoid delaying the Work.
 - 2. At the Architect's request, obtain proposals for each allowance for use in making final selections. Include recommendations that are relevant to performing the Work.
 - 3. Purchase products and systems selected by the Architect from the designated supplier.
- C. Submittals:
 - 1. Submit proposals for purchase of products or systems included in allowances, in the form specified for Change Orders.
 - 2. Submit invoices or delivery slips to show the actual quantities of materials delivered to the site for use in fulfillment of each allowance.
 - 3. The Owner reserves the right to reject the Contractor's measurement of work-in-place that involves use of established unit costs, and to have this work measured, at the Owner's expense, by an independent surveyor acceptable to the Contractor.
 - 4. Schedule: A "Schedule of Allowances" is included at the end of this Section. Specification Sections referenced in the Schedule contain requirements for materials described under each Allowance.
- D. Discretionary Fund/Contingency Allowance:
 - 1. Use the discretionary fund only as directed by the Architect for the Owner's purposes and only by Field Orders Construction Change Directive (AIA Document G714) which indicate amounts to be charged to the allowance.
 - 2. The Contractor's related costs for products and equipment ordered by the Owner under the discretionary fund are not part of the Contract Sum. These costs include delivery, installation, taxes, insurance, equipment rental, and similar costs.
 - 3. Field Orders Construction Change Directive (AIA Document G714) authorizing use of funds from the discretionary fund will include Contractor's related costs and reasonable overhead and profit margins.
 - 4. At Project closeout, credit unused amounts remaining in the discretionary fund to the Owner by Change Order.
- E. Unused Materials:
 - 1. Return unused materials to the manufacturer or supplier for credit to the Owner, after installation has been completed and accepted.

2. When requested by the Architect, prepare unused material for storage by Owner where it is not economically practical to return the material for credit. When directed by the Architect, deliver unused material to the Owner's storage space. Otherwise, disposal of unused material is the Contractor's responsibility.

PART 2 PRODUCTS

NOT USED

PART 3 EXECUTION

3.01 SCHEDULE OF ALLOWANCES

- A. Allowance No. 1: Unsuitable Soil in Mass Excavation:
 1. Description: Allowance included in the Base Bid for the removal and disposal of 400 cubic yards of unsuitable soil in mass excavation and replacement with compacted Engineered Fill according to [Civil drawing notes](#).
- B. Allowance No. 2: Unsuitable Soil in Trench Excavation:
 1. Description: Allowance included in the Base Bid for the removal and disposal of 40 cubic yards of unsuitable soil in trench excavation and replacement with compacted Stone Fill according to [Civil drawing notes](#).
- C. Allowance No. 3: Rock in Mass Excavation:
 1. Description: Allowance included in the Base Bid for the removal and disposal of 100 cubic yards of rock in mass excavation according to [Civil drawing notes](#).
- D. Allowance No. 4: Rock in Trench Excavation:
 1. Description: Allowance included in the Base Bid for the removal and disposal of 20 cubic yards of rock in trench excavation according to [Civil drawing notes](#).
- E. Allowance No. 5. Reinforced Concrete Foundations:
 1. Description: Allowance included in Base Bid for providing and installing steel reinforced concrete footings according to Section 03 30 00 Concrete.
- ~~F. Allowance No. 6. Geotextile fabric:
 1. Description: Allowance included in Base Bid for providing and installing geotextile fabric each side of stone foundation drainage layer according to Section 31 20 00 Earth Moving.~~
- ~~G.F.~~ Allowance No. 7. Compacted Stone:
 1. Description: Allowance included in Base Bid for providing and installing 60 tons of compacted stone according to [Civil drawing notes](#).
- ~~H.G.~~ Allowance No. 8 Discretionary Fund Allowance:
 1. Description: Allowance included in Base Bid for use at the discretion of the Owner and the Architect according to Section 01 10 00 Summary of the Work.
- ~~H.~~ Allowance No. 9 Emergency Responder Radio Antenna-Repeater System:
 1. Description: Allowance included in Base Bid for build-out of Emergency Responder Radio Antenna-Repeater System if determined by testing after bid according to Section 27 00 00.

END OF SECTION

PART 1 GENERAL

1.01 SCOPE:

- A. Furnish all labor, materials and equipment, and perform all work required to install masonry work as shown on the drawings, including brick, concrete block, precast masonry lintels, and all necessary incidental work in connection therewith.

1.02 RELATED DOCUMENTS:

- A. Applicable provisions of the General Conditions, Supplementary Conditions, Division 1, General Requirements, and the following sections apply to the work under this section.

Section 07 62 00 – Sheet Metal Flashing and Trim.

Section 07 92 00 – Joint Sealants.

1.03 QUALITY ASSURANCE:

- A. Qualifications of workmen:

1. For the actual cutting and placing of concrete masonry units, use only skilled journeyman masons who are thoroughly experienced with the materials and methods specified and thoroughly familiar with the design requirements.
2. In acceptance or rejection of installed concrete masonry units, no allowance will be made for lack of skill on the part of workman.
3. Provide at least one (1) skilled journeyman mason who shall be present at all times during execution of the work of this Section and who shall personally direct the execution of this portion of the work.

- B. Masonry units exposed to view shall be obtained from a single manufacturer; each type of product shall be from a single batch or production run.

- C. Cementitious ingredients of mortar mix shall be obtained from a single manufacturer. Each aggregate for mortar mix shall be obtained from a single source.

- D. Comply with applicable portions of the American Society for Testing and Materials (ASTM) Applicable codes and regulations of authorities having jurisdiction.

1.04 SUBMITTALS:

- A. Submit manufacturer's product data for each type of masonry unit, accessory and other manufactured products, including certifications that each type complies with specified requirements.

1.05 SAMPLES:

- A. Contractor shall have verification in writing from the Architect which brick is to be used prior to ordering brick.

- B. ***Before any exterior facebrick is laid up***, the Contractor shall erect a sample panel, including concrete block backup and mortar, approximately 4 feet wide by 4 feet high. When approved, the panel shall be left in place until facebrick work is completed to serve as a standard for all work. At Architect's option, one corner of the building may be used as a sample panel.

- C. Protect the sample panel from the elements with weather resistant membrane. Retain approved sample panel during construction as a standard for judging completed masonry work. When directed, demolish sample panel and remove debris from site.

1.06 DELIVERY, STORAGE, AND HANDLING:

- A. Deliver masonry materials in undamaged condition. Handle masonry units to prevent damage. Store in a manner to protect against excessive moisture, temperature changes, contaminants, corrosion or other causes. Limit absorption of moisture as specified for Type I units.
- B. Deliver cementitious materials in manufacturers' original, unopened containers.
- C. Store cementitious materials above ground, under cover and in dry enclosure.
- D. Store aggregates so that separation of types of materials can be maintained.
- E. Protect masonry accessories from corrosion and accumulation of dirt.

1.07 PROJECT CONDITIONS:

- A. Protect exposed masonry work against staining and mortar droppings. Keep top of walls covered with non-staining waterproof paper or plastic sheet when work is not in progress and during precipitation of rain or snow. When work is resumed, clean top surface of walls free of loose mortar and in dry weather wet the surface before proceeding.
- B. Turn scaffolding plank every night and when wet to prevent spattering mortar on face of walls.
- C. Do not superimpose any load to masonry work for 12 hours after erection. Allow 3 days before applying concentrated loads.
- D. Cold Weather Protection:
 - 1. Remove ice or snow from masonry bed by applying eat until top surface is dry to touch.
 - 2. Remove all frozen or damaged masonry work.
 - 3. Do not use wet or frozen units or units. Units must be minimum of 20°F (-7°C) when laid.
 - 4. Never allow mortar to freeze
- E. Construction Requirements While Work is Progressing:
 - 1. For all air temperatures below 40°F (4°C), heat sand or mixing water to produce mortar temperatures between 40°F (4°C) and 120°F (49°C).
 - 2. Additionally, for all air temperatures below 25°F (-4°C), provide heat sources on both sides of wall during construction AND provide windbreaks when wind exceeds 15 mph.
 - 3. Additionally, for all air temperatures 20°F (-7°C) and below, provide enclosures and heat to maintain air temperature above 32°F (0°C).
- F. Protection requirements for completed work:
 - 1. Mean daily air temperature: 40°F (4°C) to 32°F (0°C):
 - a. Protect masonry from rain or snow with weather-resistive covering for 24 hours.
 - 2. Mean daily air temperature: 32°F (0°C) to 25°F (-4°C).
 - a. Completely cover masonry with weather-resistive covering for 24 hours.
 - 3. Mean daily air temperature: 25°F (-4°C) to 20°F (-7°C).
 - a. Completely cover masonry with insulating blankets or equal protection for 24 hours.
 - 4. Mean daily air temperature: 20°F (-7°C) and below.
 - a. Maintain masonry temperature above 32°F (-7°C) for 24 hours by using enclosures and supplementary heat or with electric heating blankets.

PART 2 PRODUCTS

2.01 MASONRY MATERIALS:

- A. Field face brick and accent face brick: (Basis of Design) General Shale Brick, Inc., Elon Blend Modular to match existing color mix of adjacent classroom wing, including existing mortar color.
- B. Face brick exposed on the exterior and interior of building shall be 7-5/8" x 3-3/4" x 2-1/4" to lay up 3 courses in 8". Range of color shall be uniformly distributed in brick as delivered.
- C. Face brick to be used in exposed locations shall conform to the requirements of ASTM C216 Grade SW and shall be Type FBS.
- D. In locations where the cores of cored brick would be exposed use solid brick with finished faces and ends as required to present a finished face on the exposed face.
- E. Brick in concealed locations shall be culled face brick or all hard-burned common brick, conforming to ASTM C62-75A, Grade SW.
- F. Concrete block shall be hollow load-bearing concrete masonry units, conforming to ASTM C 90, Grade N-1, made with Shalite, or equal, light-weight aggregate. Units shall be steam cured at atmospheric pressure for not less than 12 hours at temperatures between 160 and 190 degrees F., and then shall be air dried and cured at least 28 days. When delivered to the site, units shall have a moisture content of not more than specified in ASTM C 90.
 - a. Units generally shall be 8 inches x 16 inches nominal face size and thicknesses shown on the drawings. Furnish all special sizes, lintel blocks and other special shapes required by job conditions.
 - a. Precast U-Lintels and special shapes made from 3,500 psi concrete with reinforcing bars placed as indicated and filled with coarse grout shall be acceptable upon review and approval by the Structural Engineer of Record. Units shall have a sand block finish to match adjacent CMU.
 - b. Basis of Design: Precast concrete u-lintels are based on products manufactured by Cast Crete. Subject to compliance with requirements.
 - b. All exterior corners of interior masonry walls to be exposed to view shall be made with bull-nose (radius edge) block.
- G. Where it is necessary to cut masonry, use an approved masonry saw. Use no units less than half size. Promptly remove units showing evidence of being broken and replace with properly cut units.

2.02 REINFORCING MATERIALS:

- A. Masonry wall reinforcing for all masonry walls and partitions shall be Dur-O-Wall ladder design, Heckmann, Hohmann and Barnard, Wire-Bond or approved equal, and shall have product approval of the International Building Code Congress. Reinforcing shall be manufactured from cold drawn steel wire conforming to ASTM A 8272 and shall consist of two deformed longitudinal rods welded at 16" intervals to a continuous diagonal cross rod forming a truss design. Out-to-out spacing of side rods shall be approximately 2" less than the nominal thickness of the wall or partition. Cross rods and side rods shall be not less than No. 9 gauge.
 - 1. Reinforcing for CMU walls shall be Dur-O-Wall DA 320.
 - 2. Reinforcing for use with brick veneer at C.M.U. walls shall be Dur-O-Wall D/A 360 Ladur-Eye or equal spaced 16 inches on center each way.

3. Brick ties at metal stud framing shall be Dur-O-Wall D/A 213 with 14 gauge screw on plate and 3/16" pintles at 16" on center, each way.
4. Brick ties at wood stud framing shall be Dur-O-Wall D/A 990 22 gauge corrugated brick ties at 16" on center each way
5. Interior walls: reinforcement shall be galvanized in accordance with ASTM A 641 Class 1 (.4 ounces per square foot.)
6. Exterior walls reinforcement shall be galvanized in accordance with ASTM A 153 Class B2 (1.5 ounces per square foot).
7. When ordering cavity wall reinforcing, the Contractor must specify the CMU thickness, Cavity Wall Insulation thickness if any, the cavity width, and the Brick Thickness.

2.03 MORTAR MATERIALS:

- A. Portland Cement shall conform to ASTM C150, Type 1. Masonry cement shall conform to ASTM C91, and shall be equal to Cemex, Essroc Italcementi Group, Holcim or Lafarge North America. Hydrated lime shall conform to ASTM C207, Type S.
- B. Aggregate for mortar shall be natural or manufactured sand conforming to ASTM C 144; except for joints less than 1/4" thick, use aggregate graded with 100 percent passing the No. 16 sieve and shall be uniform in color for all masonry work.
- C. Mixing water shall be clean and free from harmful amounts of acids, alkalies, and organic materials.
- D. Mortar shall conform to requirements of ASTM C270. Mortar for masonry work below grade shall be one part Portland Cement, 1/4 part hydrated lime or lime putty, and not less than 2-1/4 nor more than 3 parts sand, by volume, or any other mix conforming to ASTM requirements for Type M or Type S mortar. Mortar for masonry work above grade shall be one part masonry cement to not less than 2-1/4 nor more than 3 parts sand, by volume, or any other mix conforming to ASTM requirements for Type S or Type N mortar.
- E. Sand for mortar shall be measured in a damp loose condition. Mix mortar with the maximum amount of water consistent with satisfactory workability for a minimum of 3 minutes in a drum type mechanical mixer. Mixer shall be thoroughly cleaned between batches. Water may be added to mortar to maintain workability. No mortar older than 1 hour shall be used..
- F. Colored mortar for use with face brick shall contain colored masonry cement similar and equal to Brixment as manufactured by Cemex, Essroc Italcementi Group, Holcim or Lafarge North America.

2.04 CAVITY DRAINAGE SYSTEM:

- A. Provide mortar/drainage netting at base of brick veneer cavities in size to completely fill width of cavity. Mortar netting shall be manufactured using recycled polyester or polyethylene. The following are acceptable products, alternate products must be approved prior to bidding:
 1. Mortar Net as manufactured by Mortar Net USA, LTD.
 2. Mortar Break as manufactured by Advanced Building Products, Inc.
 3. Driwall Mortar Deflection as manufactured by Keene Building Products
- B. Provide Weep Vents in masonry veneer over cavity at 24 inches on center and at the base of all cavity walls above flashing and above and below window and door openings above thru-wall flashing and as shown on the drawings. Weep Vents shall be 2-5/8 inch by 3 1/2 inch by 1/2 inch recycled polyester mesh. The following are acceptable products, alternate products must be approved by Architect prior to bidding:
 1. Weep Vents as manufactured by Mortar Net USA LTD.
 2. Cell Vent as manufactured by Advanced Building Products, Inc.
 3. Weep Vents 025 as manufactured by Keene Building Products.

2.05 CONTROL JOINTS:

- A. "Wal-Joint", wide flange type, as manufactured by Hohmann & Barnard, Inc., approved equals of Dur-o-wal, Carter-Waters, Tywal Accessories, or Vinyl's are acceptable.
- B. Provide vertical control joints in all masonry walls that exceed 32'-0" in length and/or exceed a ratio of panel length to height (L/H) of 3.
- C. All joint locations must be verified and approved by the Architect. Control joints shall not be placed above or at the side of a masonry opening except where necessary to separate masonry supported off the foundation from that supported from the structure.
- D. Steel lintels supporting masonry shall be discontinuous at control joints & expansion joints.

2.06 EXPANSION JOINTS IN BRICK VENEER:

- A. Provide vertical expansion joints in brick veneer walls at thirty-five feet (35'-0") on center maximum.

3PART 3 EXECUTION

3.01 COORDINATION WITH OTHER WORK:

- A. Coordinate with other trades to insure that they have ample opportunity to build in their work as the masonry work progresses. Build in frames, anchors, and other incidental items furnished under other sections of the specifications. Set loose steel lintels and construct chases and recesses as required. Verify dimensions and locations of anchors, chases, etc., with the other trades involved.
- B. Build in through wall flashing as masonry is laid ensuring laps at ends and end dams at end of flashing above and below openings.
- C. Coordinate the masonry work for reinforced masonry block brick walls closely with the installation of the concrete fill and steel reinforcement.
- D. Furr out around piping and electrical panels and other items wherever the existing wall or proposed walls are not thick enough to accommodate items that are scheduled to go in them.
- E. In the event of discrepancy, immediately notify the Architect. Do not proceed with installation in areas of discrepancy until all such discrepancies have been completely resolved.

3.02 TOLERANCES FOR CONSTRUCTION:

- A. Bed joints and head joints shall be nominal 3/8" thick with slight variations allowed (5/16" to 7/16") to adjust coursing and to avoid cutting. Standard coursing for brick: 3 bricks and 3 mortar joints shall equal 8 inches unless otherwise noted.
- B. Variation from the plumb in the lines and surfaces of columns, walls, and arises shall not exceed 1/8" in 10' and 3/8" in a story height or 3/8" in 20'-0" maximum. Variation from plumb for external corners, expansion joints and other conspicuous lines, shall not exceed 1/4" in any story or 1/4" in 20'-0" maximum.
- C. Variation from the level of the grades indicated on the Drawings for exposed lintels, sills, parapets, horizontal grooves, and other conspicuous lines shall not exceed 1/4" in any bay or module or 20'-0" (whichever dimension is the least) nor 1/2" in 40'-0" or more.
- D. Variation of the linear building line from an established position in plan and related portion of columns, walls, and partitions shall not exceed 1/4" in any bay or module or 20'-0" (whichever dimension is the least) nor 3/4" in 40'-0" or more.

- E. Variation in cross-sectional dimensions of columns and thickness of walls shall not exceed minus 1/4", nor plus 1/2" from the dimensions indicated on the Drawings.

3.03 CAVITIES

1. Keep cavities clean of mortar droppings and other materials during construction.
 - a. Install Cavity Drainage Material in cavities in accordance with manufacturer's recommendations.
 - b. Use wood strips temporarily placed in cavity to collect mortar droppings. As work progresses, remove strips, clean off mortar droppings, and replace in cavity.
- B. Install Weep Vents at 24 inches on center at the base of wall cavities, above and below window openings above thru wall flashing and elsewhere as shown on the drawings.
- C. Installing Cavity-Wall Insulation: Place small dabs of adhesive, spaced approximately 12 inches o.c. both ways, on inside face of insulation boards, or attach with plastic fasteners designed for this purpose. Fit courses of insulation between wall ties and other confining obstructions in cavity, with edges butted tightly both ways. Press units firmly against inside wythe of masonry or other construction as shown.
 - a. Fill cracks and open gaps in insulation with crack sealer compatible with insulation and masonry.

3.04 LAYING BRICK:

- A. Wet brick prior to laying unless their gain in weight is less than 3/4 oz. when immersed in 1/4" of water for one minute. Lay in full bed of slightly furrowed mortar and fill head joints completely.
- B. Lay facebrick on exterior walls in **common bond** and anchor to backup and to inner wythe with steel masonry reinforcing.
- C. Brick veneer shall be returned against CMU or sheathing at all openings in exterior wall as required to close cavity.

3.05 LAYING CONCRETE BLOCK:

- A. Lay with full mortar coverage on vertical and horizontal face shells. Vertical joints in exposed concrete block work shall break at center of stretcher above and below; otherwise, bond each course at corners and intersections and break vertical joints at least 4".
- B. Broken or split block shall not be used. All cutting required shall be done with a masonry saw. The mortar bedding for anchors for door bucks and frames shall be spread on strips of 1/8" mesh hardware cloth about 12" long.
- C. Install steel masonry reinforcing in all concrete block walls and partitions. Partitions abutting exterior walls shall be anchored thereto with steel masonry reinforcing unless otherwise noted.
- D. Partitions enclosing pipe and duct chases shall be built after the piping and ducts are in place and have been tested and approved.
- E. All partitions shall extend from concrete floor slabs to underside of roof deck except where specifically noted or shown otherwise. All partitions shall be not less than 1-hour fire-resistive construction and the concrete blocks shall be UL listed or shall conform to requirements of the Building Code adopted by the authority having jurisdiction for 1-hour fire-resistance.
- F. Provide centering and install bond beam block over all openings greater than 24" wide in concrete walls and partitions, including openings for panelboards, ducts, and grills. Extend bond beams 8 inches minimum beyond edge of opening each side. Reinforce bond beams as noted on the drawings or with a

minimum of 1 #5 bar top and bottom if not noted on the drawings. Fill Bond beams with concrete before laying next course of block.

- G. Install spandrel blocks for bond beams at the top of all masonry walls unless noted otherwise.
- H. Where masonry is to be exposed in the interior of a building the mortar joint at the intersection of interior masonry wall with exterior masonry wall shall be raked ¼ inch deep and caulked.

3.06 FLASHING:

- A. Place flashing in masonry work on a bed of mortar. Cover flashing with bed of mortar before placing units on flashing. Do not puncture flashing. Join sections of flashings by overlapping 6 inches minimum and fastening with adhesive to provide watertight joints. Turn up ends of flashing to provide positive drain to exterior. Comply with flashing manufacturer's recommendations. Install thru-wall flashings where shown on the drawings and in the following locations:
 - 1. Above all openings in exterior walls extend 12" beyond opening.
 - 2. Above all intersections of floors and exterior walls.
 - 3. Above all intersections of roofs with parapet walls, penthouses and all other exterior walls.
 - 4. Weep holes shall be installed above thru-wall flashings.

3.07 WORKMANSHIP:

- A. Masonry work shall be sound, straight, true, and complete in every respect, and exterior walls shall be so constructed as to preclude the penetration of water. Avoid over-plumbing and pounding of masonry units after they are set in place; where adjustments must be made after mortar has started to set, the mortar shall be removed and replaced with fresh mortar.
- B. Joints shall be thickness to conform to coursing specified or shown and shall be uniform and bond shall be true.
- C. Hollow metal door frames in masonry walls shall be filled solidly with mortar as the walls are laid up, but forming a cavity behind rubber bumper opening with a wad of newspaper. Unless otherwise specifically shown or specified, the space around anchors, flashing, steel lintels, and similar items built into the masonry work shall be filled solidly with mortar.
- D. Where nails or line pins have been used, they shall be removed when they have served their purpose and the holes left by their removal shall be filled immediately with fresh mortar.

3.08 POINTING

- A. After masonry work is completed, remove all line pins and point up all holes and open joints.

3.09 TOOLING:

- A. Tool all joints concave unless otherwise noted. Joints in exposed faces of facebrick on exterior and concrete block on interior shall be tooled with a round steel jointer, except at changes in brick color, just before the mortar hardens, with sufficient force to press the mortar against the masonry units on each side of the joint.
- B. Joints where brick changes color shall be raked joints. Face joints in concealed locations shall be struck flush
- C. Cut joints flush in block surfaces which will be concealed in the finished work or to which a finish material (other than paint) shall be supplied.

3.10 CLEANING OF MASONRY:

- A. Face of brick work shall be kept clean of mortar droppings, stains, and soil as the work progresses insofar as possible. The completed work shall be cleaned by methods approved by the Architect, equivalent to the following:
1. Cleaning shall not be started until mortar is thoroughly set and cured. Then surfaces shall be dry cleaned by removing large particles of mortar with wood paddles and scrapers, using a chisel or wire brush where necessary.
 2. Presoak wall by saturating the masonry with clean water and flush off all loose mortar and dirt.
 3. While the surface is still saturated, starting at top of wall, scrub down with a solution mixed in the proportions of one-half cup of trisodium phosphate (Calgon) and one-half cup household detergent (All) dissolved in one gallon of clean water. Scrub with stiff fiber brushes only. Keep wall area below work area wet down at all times.
 4. After scrubbing thoroughly, rinse off all cleaning solution, dirt and mortar crumbs, using pressurized water from a hose.
- B. In areas where the preceding procedure is not adequate, use a similar procedure, but substitute an acid solution instead of the cleaner solution for scrubbing. Acid solution shall be mixed one part clean, stain-free commercial grade of hydrochloric (Muriatic) acid to nine parts clean water, mixed in a non-metallic container. Keep all brick work below the area being cleaned, soaked and flush free of acid and dissolved mortar before it becomes dry. Do not use wire brushes or metal tools and do not allow acid solution to come in contact with any metal or cast stone work. Acid solution shall be used only as a last resort and where expressly permitted by the Architect.
- C. Exposed concrete block surfaces shall be kept clean of mortar droppings as the work progresses and the completed work shall be dry-cleaned to remove remaining mortar spots and dirt. Surface shall be brushed free of dust before painting.

END OF SECTION

PART I GENERAL

1.01 SCOPE:

- A. Furnish and install aluminum soffits and accessories as noted on the drawings and as specified herein.

1.02 RELATED DOCUMENTS:

- A. Applicable provisions of the General Conditions, Supplementary Conditions and Division 1, General Requirements, apply to the work under this section.

Section 07 21 00 – Thermal Insulation.

Section 07 62 00 - Sheet Metal Flashing and Trim.

Section 07 92 00 – Joint Sealants.

1.03 SUBMITTALS

- A. Shop Drawings: Submit detailed drawings showing installation and anchorage details, trim and accessories. Show details of weatherproofing, terminations and penetrations of soffit work.
- B. Product Data: Submit manufacturer's product description, including material types and thicknesses, and installation details.
- C. Samples: Submit one 6 inch long by full width sample of each product proposed for use.
- D. Certificates: Submit documents certifying that products proposed for use meet or exceed the requirements specified herein.
- E. Submit copy of manufacturer's warranty.

1.04 QUALITY ASSURANCE

- A. Source Limitations for Soffit: Obtain each type, color, texture, and pattern of soffit, including related accessories, through one source from a single manufacturer.
- B. Mockup: Build mockup to verify selections made under sample submittals and to demonstrate aesthetic effects.
 - 1. Include outside corner on one end of mockup and inside corner on other end. Show full range of effects including penetrations and closures.
- C. Installer's Qualifications: Installer shall have a minimum of 3 years successful experience installing similar products and shall have completed at least 5 projects in the last 3 years of comparable size and complexity that the Architect may view as evidence of skill and workmanship.

1.05 DELIVERY, STORAGE, AND HANDLING:

- A. Store materials off ground, under cover. Protect from damage and deterioration.
- B. Handle materials to prevent damage to surfaces, edges and ends of soffits and accessories. Damaged materials shall be rejected and removed from the site.
- C. Materials shall be delivered in manufacturer's unopened boxed with information adhered to packaging stating the product dimensions, type, profile, color, and SKU#.

1.06 WARRANTY:

- A. Special Warranty: Manufacturer's standard form in which manufacturer agrees to repair or replace soffit that does not comply with requirements or that fails within specified warranty period. Failures include, but are not limited to, cracking, deforming, uneven weathering, or otherwise deteriorating beyond normal weathering.

1. Warranty Period: Lifetime Limited transferable

1.07 EXTRA MATERIALS:

- A. Furnish extra materials described below that match products installed and that are packaged with protective covering for storage and identified with labels describing contents.

1. Furnish full lengths of soffit and trim in a quantity equal to 2 percent of amount installed.

PART II PRODUCTS

2.01 ALUMINUM SOFFIT:

- A. Formed and coated aluminum soffits complying with AAMA 1402, including Paragraph 2.2.4.2.1, "Standard Commercial Coating."

1. Available Manufacturers:
a. Alcoa Building Products, Inc.
b. Gentek Building Products, Inc.
c. Kaycan Ltd.
d. Norandex Inc./Reynolds Distribution Company.
e. Rollex Corporation.

- B. Pattern, Texture, Thickness, and Color:

1. Pattern: 12-inch exposure in V-grooved, double 6-inch board style.
a. Texture: Smooth.
b. Ventilation: Provide perforated and unperforated soffit as indicated.
c. Minimum Nominal Thickness: **0.024 inch**.
d. Finish: Manufacturer's standard two-coat PVC finish.
e. Colors for Aluminum Soffit: As selected by Architect from manufacturer's full range.

2.02 ALUMINUM ACCESSORIES:

- A. Provide accessories made from same material as adjacent soffit, unless otherwise indicated.

2.03 FLASHING:

- A. Provide aluminum flashing complying with Division 7 Section "Sheet Metal Flashing and Trim" at window and door heads and where indicated.

B. Finish for Aluminum Flashing: **High-performance organic finish, same color as soffits.**

2.04 ELASTOMERIC JOINT SEALANTS:

- A. Multicomponent urethane joint sealant complying with requirements in Division 7 Section "Joint Sealants" for Use NT (nontraffic) and for Uses M, G, A, and, as applicable to joint substrates indicated, O joint substrates

2.05 FASTENERS:

- A. For fastening to wood, use nails of sufficient length to penetrate a minimum of 1 inch into substrate.

1. For fastening to metal, use ribbed bugle-head screws of sufficient length to penetrate a minimum of 1/4 inch or 3 screw-threads into substrate.
2. For fastening aluminum, use aluminum fasteners. Where fasteners will be exposed to view, use prefinished aluminum fasteners in color to match item being fastened.
3. For fastening vinyl, use aluminum or hot-dip galvanized fasteners. Where fasteners will be exposed to view, use prefinished aluminum fasteners in color to match item being fastened

PART III EXECUTION

3.01 EXAMINATION:

- A. Examine substrates for compliance with requirements for installation tolerances and other conditions affecting performance of soffit. Proceed with installation only after unsatisfactory conditions have been corrected.

3.02 PREPARATION:

- A. Clean substrates of projections and substances detrimental to application.

3.03 INSTALLATION:

- A. General: Comply with soffit manufacturer's written installation instructions applicable to products and applications indicated unless more stringent requirements apply. Center nails in elongated nailing slots without binding soffit to allow for thermal movement. Overlap joints to shed water away from direction of prevailing wind.
- B. Install aluminum soffit and accessories according to AAMA 1402.
- C. Isolate dissimilar metals by separating with rubber gaskets or elastomeric sealant. Use rubber washers where fasteners made from dissimilar metal penetrate soffit. Isolate dissimilar metals behind soffit by covering with polyethylene film.

3.04 ADJUSTING AND CLEANING:

- A. Remove damaged, improperly installed, or otherwise defective materials and replace with new materials complying with specified requirements.
- B. Clean finished surfaces according to soffit manufacturer's written instructions and maintain in a clean condition during construction.

END OF SECTION

PART I GENERAL

1.01 SCOPE:

- A Furnish all labor, materials, tools, equipment, and supervision as required to properly and completely equip all doors as shown on the drawings and specified herein.

1.02 RELATED DOCUMENTS:

- A Applicable provisions of the General Conditions, supplemental Conditions and Division 1, General Requirements, apply to the work under this section.

1. Section 08 11 13 - Hollow Metal Doors and Frames.
2. Section 08 14 16 - Flush Wood Doors.
3. Division 26 – Electrical.

1.03 QUALITY ASSURANCE:

- A Obtain each type of Hardware (i.e. locks) from a single manufacturer.

- B "Supplier" refers to a recognized architectural hardware supplier, with warehouse facilities, furnishing hardware for not less than 2 years in the project's vicinity. Supplier must be or employ a full time experienced Architectural Hardware Consultant (AHC – Certified by the Door and Hardware Institute) who, at reasonable times during the course of the work, is available for consultation with the Owner, Architect and Contractor about the project's requirements.

1.04 SUBMITTALS:

- A Submit hardware schedule in manner indicated below. Coordinate hardware with doors, frames, and related work to insure proper size, thickness, hand, function and finish of hardware.

- B Final Hardware Schedule: Based on finish hardware, organize a schedule into "hardware sets" containing all items required for each door or opening. Include the following information:

1. Type, style, function, size, finish and manufacturer of each hardware item.
2. Explanation of abbreviations, symbols, codes, etc. contained in schedule.
3. Fastening and other pertinent information.
4. Location of hardware set cross-referenced to drawings.
5. Mounting locations for hardware.
6. Door frame size and material.

- C Submit schedule at earliest possible date since acceptance of hardware schedule must precede fabrication of other work (i.e. hollow metal frames) critical to construction schedule. Include with schedule the product data, samples, shop drawings of other work affected by finish hardware, and other information essential to a coordinated review of hardware schedule.

- D Furnish templates to fabricators of doors, frames, and other work to be factory-prepared for the installation of hardware. Upon request, check shop drawings of each other's work, to confirm that adequate provisions are made for proper location and installation of hardware.

- E No hardware shall be ordered until hardware schedule has been approved by the Architect.

1.05 PACKING AND MARKING:

- A All hardware shall have the required screws, bolts, and other fasteners necessary for its' installation packed in the same package as the hardware. Each package shall be legibly and adequately labeled to indicate the part of the work for which it is intended.

- B Hardware shall include such adjusting tools and instructions as furnished by the manufacturer as standard practice. Upon completion of the work, the Contractor shall turn over to the Owner or his representative all such tools, instructions and emergency keys.

PART II PRODUCTS

2.01 GENERAL:

- A Coordinate finish hardware work with work of other trades as required.
- B Cooperate with Finish Hardware supplier in scheduling dates for submittals and delivery of templates and finish hardware.

2.02 MATERIALS:

- A Catalog numbers used in the schedule are as follows:

Butts	- Hager Hinge Co.
Locksets and Card Scanners	- Marks Locksets
Closers	- Yale Security
Push, Pull, Kick Plates, Stops, Misc.	- Hager Hinge Co.
Thresholds, Weatherstrip, Drip Caps	- National Guard Products
Magnetic Holders	- Rixson/Firemark
Overhead Stop & Holders	- Glynn Johnson

- B Maintenance Requirements: Furnish a complete set of specialized tools and instructions for maintenance, adjustment, removal and replacement.

2.03 FINISH:

- A Finish to be Satin Chrome, US26D for all items unless otherwise scheduled. Closers to be sprayed Aluminum to match remainder of hardware.
- B Push, pull and kick plates and overhead holders shall be Satin Stainless Steel, US32D.
- C Thresholds and drip caps to have clear anodized finish.

2.04 KEYING:

- A Furnish all cylinders to Owner for keying by Owner.

2.05 BUTTS:

- A Butts, unless scheduled otherwise, shall be BB1279, 4.5" x 4.5" for doors not more than 36" wide and 5" x 4.5" for doors over 36" wide.
- B Provide two (2) pair butts for doors over 7'-2" high.
- C Provide non-removable pins for all out swinging exterior doors.

2.06 DOOR STOPS:

- A Except where overhead door holders are scheduled, provide 236W Series stop for each door leaf. Substitute type 241F Series of the proper height where wall stop cannot be installed.

2.07 DOOR SILENCERS:

- A Silencers for hollow metal door frames shall be GJ-64. Three mutes required for single swinging doors and two for pairs of doors. Omit for exterior openings.

2.08 CLOSERS:

- A Where closers are scheduled, provide types as specified for exterior and interior openings. Size shall be as recommended by the manufacturer.
- B Provide brackets for closers on exterior out swinging doors and for other doors as required.
- C Provide hold-open arms for all exterior doors and where scheduled for other doors.
- D Provide regular arm or parallel arm as required to mount closers in rooms away from public areas.

2.09 LOCKSETS:

- A Provide types as specified with design as specified at all locations. Cylindrical locksets shall be lever handle with free wheeling levers when lockset is in locked mode.

2.10 KICKPLATES:

- A Provide kick plates 8" high, unless noted otherwise, 2" less than nominal door width for single doors and 1" less than nominal door width for pairs of doors. Kick plates shall be 0.050" thick and beveled on all edges.

2.11 SCHEDULE OF DOOR HARDWARE:

Set No. 1A (101A, 105)

Each to have:

6	Hinges	BB1199	4 ½" x 4 ½"	NRP	US26D (Hager)
1	Mullion	4954		SP28	(Von Duprin)
1	Exit Device	99DT		US26D	(Von Duprin)
1	Exit Device	99NL		US26D	(Von Duprin)
1	Cylinder	As Required		US26D	(Marks)
2	Closers	4111-SCUSH		689	(LCN)
2	Kick Plates	190S	8" x 2" LDW	US32D	(Hager)
1	Threshold	425		ALUM	(NGP)
2	Sweeps	200NA		ALUM	(NGP)
1	Weatherstrip	127NA		ALUM	(NGP)
1	Mullion Seal	5100N		BLK	(NGP)

Set No. 1B (101B)

Each to Have:

6	Hinges	BB1199	4 ½" x 4 ½"	NRP	US26D (Hager)
1	Mullion	4854		SP28	(Von Duprin)
1	Electric Strike	6111-FSE		US32D	(Von Duprin)
1	Exit Device	99DT		US26D	(Von Duprin)
1	Exit Device	99NL		US26D	(Von Duprin)
1	Cylinder	As Required		US26D	(Marks)
1	Automatic Operator	By Others			
1	Closer	4111-SCUSH		689	(LCN)
2	Kick Plates	190S	8" x 2" LDW	US32D	(Hager)
1	Threshold	425		ALUM	(NGP)
2	Sweeps	200NA		ALUM	(NGP)
1	Weatherstrip	127NA		ALUM	(NGP)
1	Mullion Seal	5100N		BLK	(NGP)

Set No. 1C (101D)

Each to have:

6	Hinges	BB1168	4 ½" x 4 ½"	US26D	(Hager)
1	Mullion	4954		SP28	(Von Duprin)

1	Exit Device	99DT		US26D	(Von Duprin)
1	Exit Device	99NL		US26D	(Von Duprin)
1	Cylinder	As Required		US26D	(Marks)
2	Closers	4111-SCUSH		689	(LCN)
2	Kick Plates	190S	8" x 2" LDW	US32D	(Hager)
2	Silencers	307D		Gray	(Hager)

Set No. 1D (101C)

Each to have:

6	Hinges	BB1168	4 1/2" x 4 1/2"	US26D	(Hager)
1	Mullion	4854		SP28	(Von Duprin)
1	Electric Strike	6111-FSE		US32D	(Von Duprin)
1	Exit Device	99DT		US26D	(Von Duprin)
1	Exit Device	99NL		US26D	(Von Duprin)
1	Cylinder	As Required		US26D	(Marks)
1	Automatic Operator	By Others			
1	Closer	4111-SCUSH		689	(LCN)
2	Kick Plates	190S	8" x 2" LDW	US32D	(Hager)
2	Silencers	307D		Gray	(Hager)

Set No. 1E (102)

Each to have:

3	Hinges	BB1199	4 1/2" x 4 1/2"	NRP	US26D (Hager)
1	Exit Device	99NL		US26D	(Von Duprin)
1	Cylinder	As Required		US26D	(Marks)
1	Closer	4111-SCUSH		689	(LCN)
1	Kick Plate	190S	8" x 2" LDW	US32D	(Hager)
1	Threshold	425		ALUM	(NGP)
1	Sweep	200NA		ALUM	(NGP)
1	Weatherstrip	127NA		ALUM	(NGP)

Set No. 2

Each to have:

1.5 pr.	Butts	BB1279			
1	Lever Storeroom	Marks Locksets to match existing			
1	Door Closer	3301BF			
1	Door Stop				

Set No. 3

Each to have:

1.5 pr.	Butts	BB1279			
1	Lever Office	Marks Locksets to match existing			
1	Door Stop				

Set No. 4 – not used

Set No. 5

Each to have:

3 pr.	Butts	BB1279			
1	Lever Classroom	Marks Locksets: Grade 1, 195/26D to match existing			
1	Card Scanner	Marks Locksets to match existing system			
1	Door Closer	3301BF			

Set No. 6

Each to have:

3 pr.	Butts	BB1279			
-------	-------	--------	--	--	--

- | | | |
|---|---------------|----------------------------------|
| 1 | Lever Privacy | Marks Locksets to match existing |
| 1 | Door Stop | |

3PART III EXECUTION:

3.01 INSTALLATION:

- A Locations of hardware shall be in accordance with the recommendations of the National Builders Hardware Association for detailed locations.
- B Install hardware in accurate conformity with the manufacturer's templates.
- C Push and Pulls: Pull plates shall be through-bolted with bolt heads concealed behind push plated.
- D Lock trim shall be as listed in schedule, or equivalent of other approved manufacturers. Dummy trim levers and roses shall be identical to those supplies with locksets. All locksets shall be beveled 1/8" in 2".

3.02 ADJUSTMENT AND CLEANING:

- A Check and adjust each operating item to ensure proper functioning of each unit. Replace units which cannot be adjusted to operate properly.
- B Clean adjacent surfaces soiled by hardware installation.
- C Whenever hardware installation is completed more than one month prior to acceptance or occupancy of building or space, during the week prior to acceptance or occupancy, make final check and adjustment of all items. Clean operating items and restore proper function and finish of hardware and doors. Adjust door control devices to compensate for permanent heating and ventilating conditions.
- D During final adjustment of hardware, instruct Owner's personnel in proper adjustment and maintenance procedures for hardware operations and finished.

END OF SECTION

GENERAL NOTES

- 1. COMPLY WITH ALL PERTINENT PROVISIONS OF THE "MANUAL OF ACCIDENT PREVENTION IN CONSTRUCTION" ISSUED BY A.G.C. OF AMERICA, INC. AND THE SAFETY AND HEALTH REGULATIONS FOR CONSTRUCTION ISSUED BY THE U.S. DEPARTMENT OF LABOR, 29 CFR 1926 OSHA.

DEMOLITION NOTES

- 1. DO ALL DEMOLITION WORK REQUIRED TO REMOVE EXISTING MASONRY WALLS, PAVING, FOUNDATIONS, CONCRETE SLABS, EXISTING UNDERGROUND PIPING, CONDUIT, BUILDING FINISHES, DOORS, WINDOWS AS SHOWN ON THE DRAWINGS AND ANY OTHER NECESSARY ITEMS TO INSTALL THE PROPOSED WORK.

SITE NOTES

- 1. WHERE PROPOSED PAVEMENT ABUTS EXISTING PAVEMENT, THE EXISTING PAVEMENT SHALL BE CUT IN A NEAT STRAIGHT LINE THROUGH PAVEMENT AND BASE. PROVIDE A SMOOTH TRANSITION.

SURVEY NOTES

- 1. BOUNDARY AND TOPOGRAPHIC INFORMATION WAS PREPARED BY MBI COMPANIES INC., 299 N. WEISGARBBER ROAD, KNOXVILLE TN 37919. SURVEY PERFORMED 01/06/2022.

GRADING NOTES

- 1. FIELD VERIFY CRITICAL GRADES AT CONNECTION POINTS SUCH AS ENTRANCES PRIOR TO CONSTRUCTION AND NOTIFY PROJECT MANAGER OR ENGINEER OF ANY DISCREPANCIES.

DRAINAGE NOTES

- 1. FIELD VERIFY CRITICAL GRADES AT CONNECTION POINTS PRIOR TO CONSTRUCTION OR FABRICATION OF PRECAST STRUCTURES.

EROSION CONTROL NOTES

- 1. UNLESS SHOWN OTHERWISE, ALL DISTURBED AREAS NOT ULTIMATELY RECEIVING A HARD SURFACE SHALL HAVE A MINIMUM DEPTH OF 5" OF TOPSOIL AND BE STABILIZED WITH GRASS.

UTILITY NOTES

- 1. COORDINATE WITH EXISTING UTILITIES AND STORM SEWER INSTALLATION TO AVOID CONFLICTS. UTILITY INSTALLATION AND MATERIAL SHALL MEET THE REQUIREMENTS OF NORRIS WATER COMMISSION, CLINTON UTILITIES BOARD, AND POWELL-CLINCH UTILITY DISTRICT.

ABBREVIATIONS

Table listing abbreviations for various construction terms such as AT (AND), AASHTO (AMERICAN ASSOCIATION OF STATE HIGHWAY & TRANSPORTATION OFFICIALS), ADA (AMERICANS WITH DISABILITIES ACT), etc.

EXISTING LEGEND PROPOSED

Legend table showing symbols for existing and proposed features like EASEMENT, RIGHT-OF-WAY, PROPERTY LINE, MAJOR CONTOUR, MINOR CONTOUR, SANITARY SEWER, GAS PIPING, WATER LINE, etc.

AREAS & CALCULATIONS

Table showing IMPERVIOUS AREA, DISTURBED AREA, and PARKING CALCULATION with columns for EXISTING, PROPOSED, and TOTAL INCREASE.


PROPERTY INFORMATION


OWNER: ANDERSON COUNTY SCHOOLS
ADDRESS: 101 S. MAIN ST. CLINTON, TN 37916
PHONE: (865) 463-2800

PROPERTY DATA

ADDRESS: 5 NORRIS SQ. NORRIS, TN 37928
MAP: 031F
PARCEL ID: FAR002.00
ZONING: FAR


MBI logo, professional seal of Christopher B. Trego, project information, revision information, and sheet title 'CIVIL NOTES & LEGEND'.

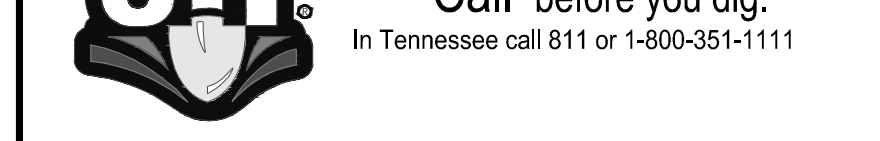

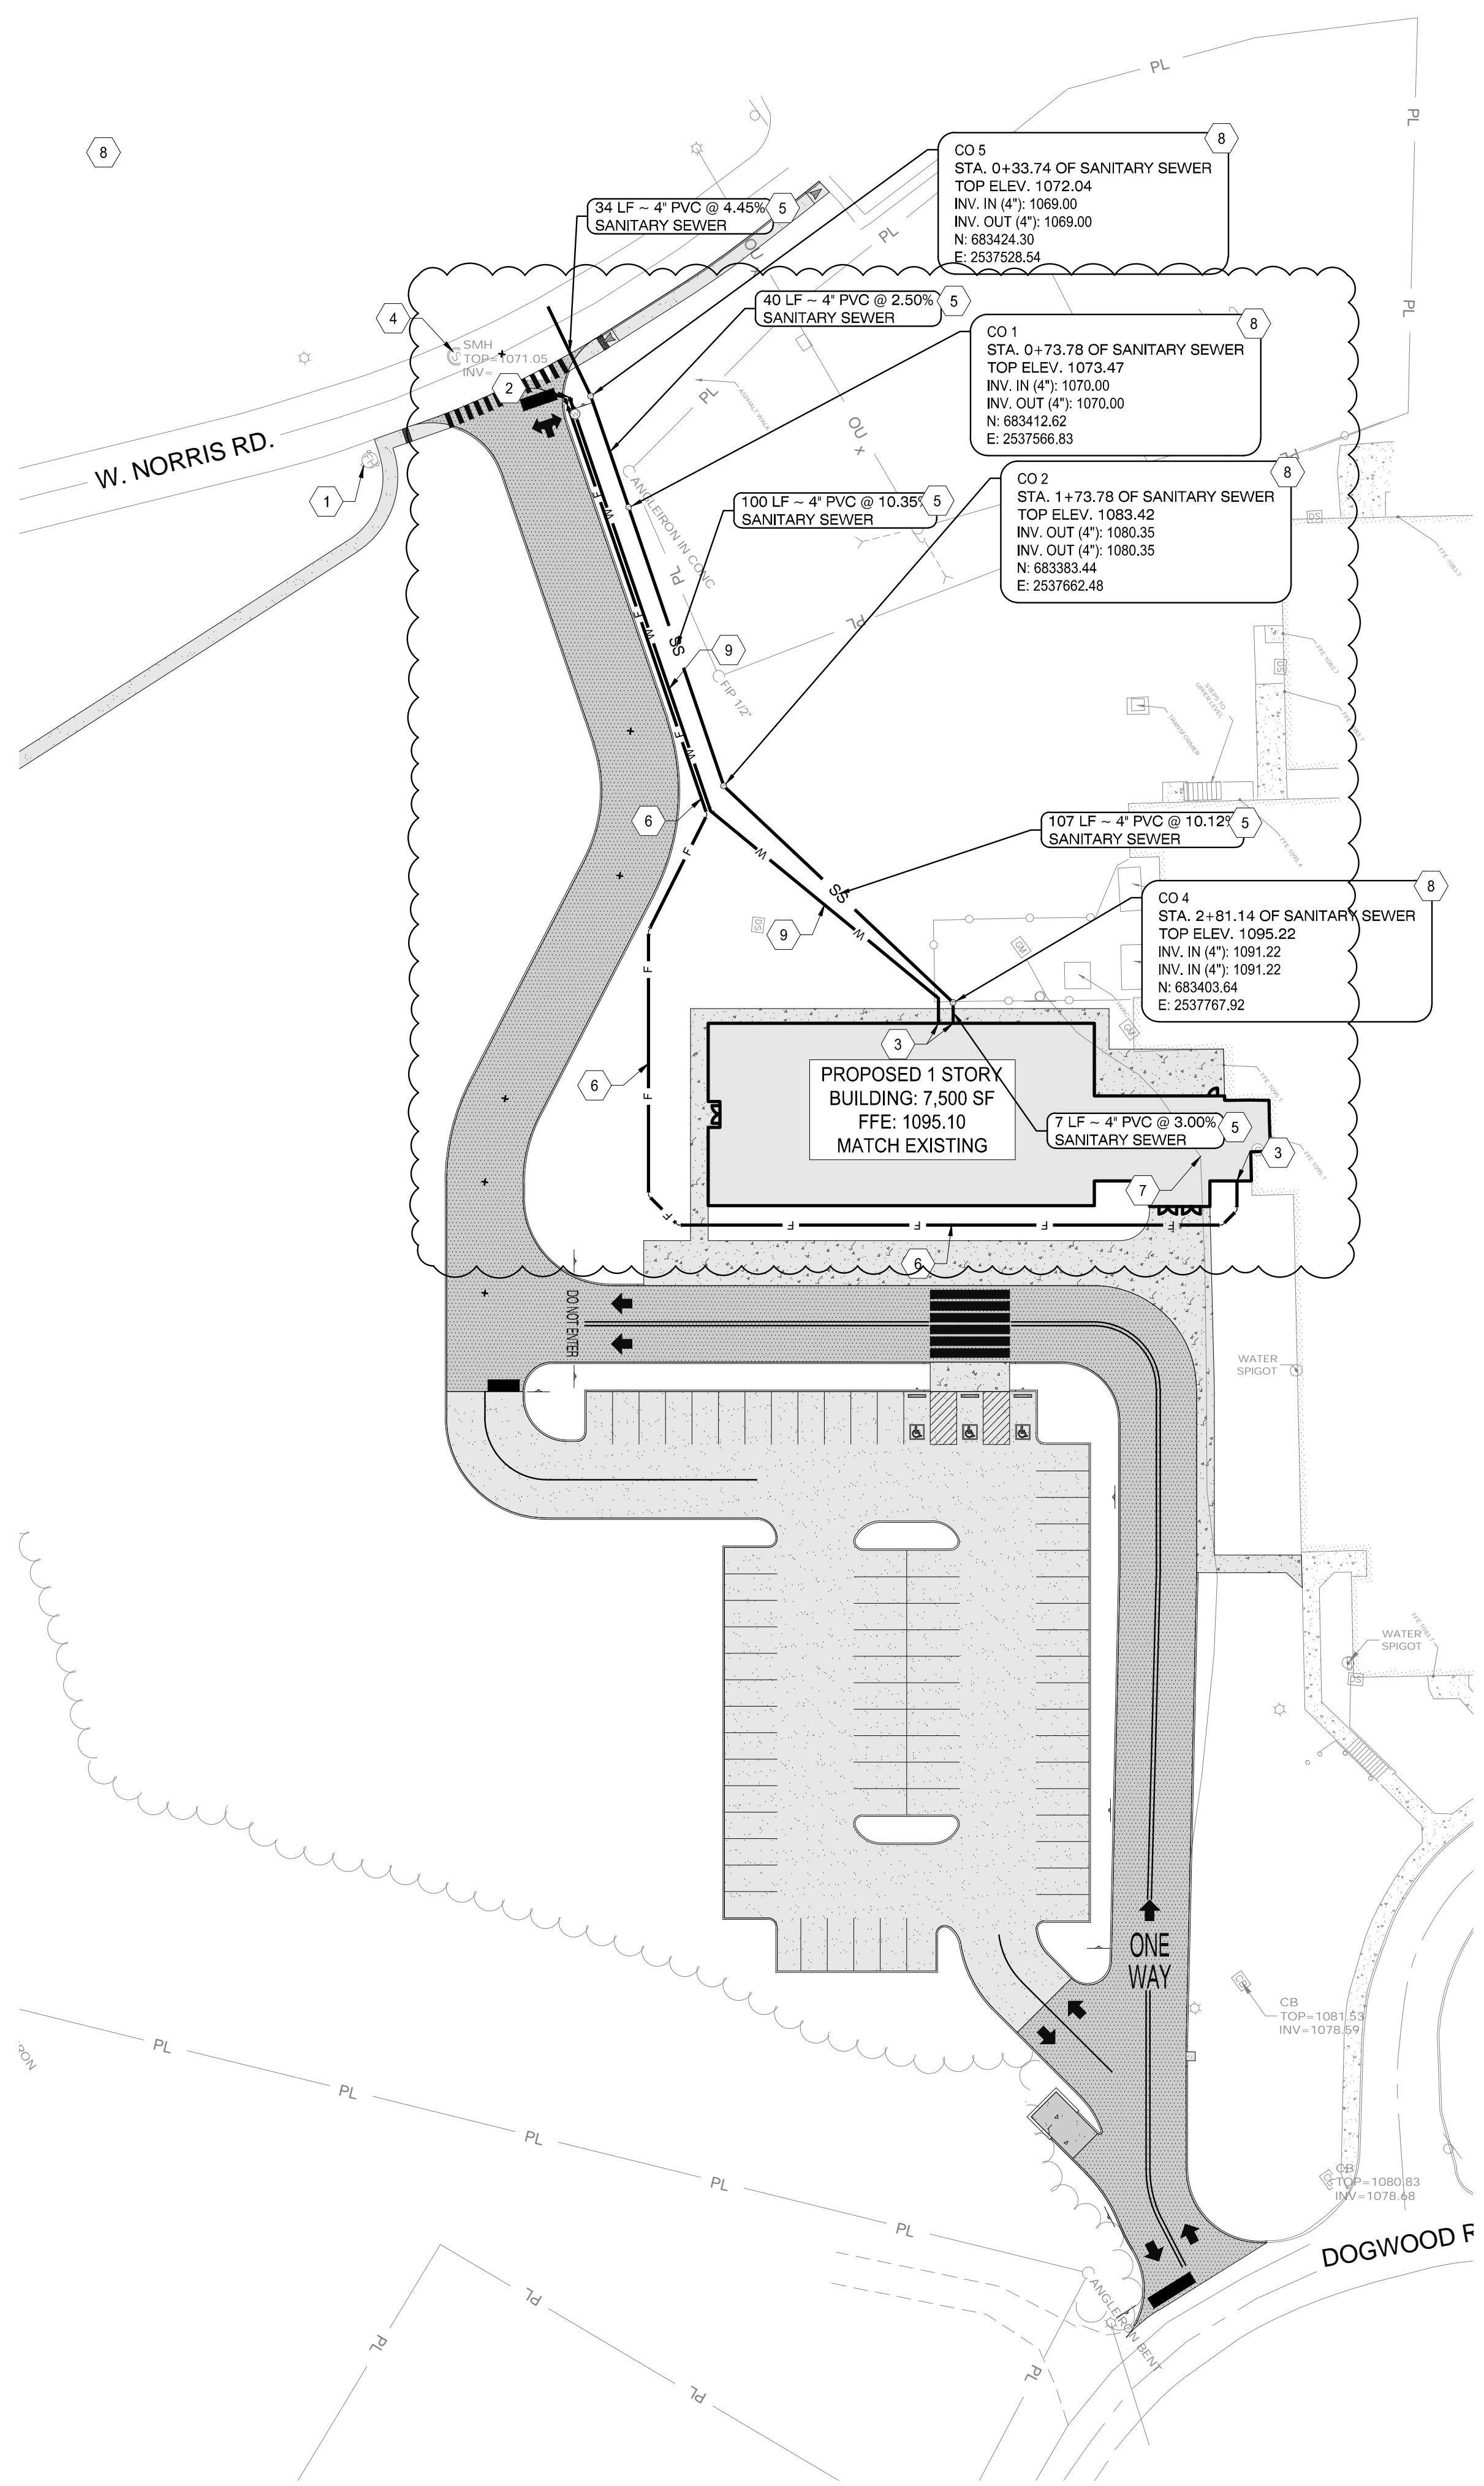


SITE UTILITY PLAN

1

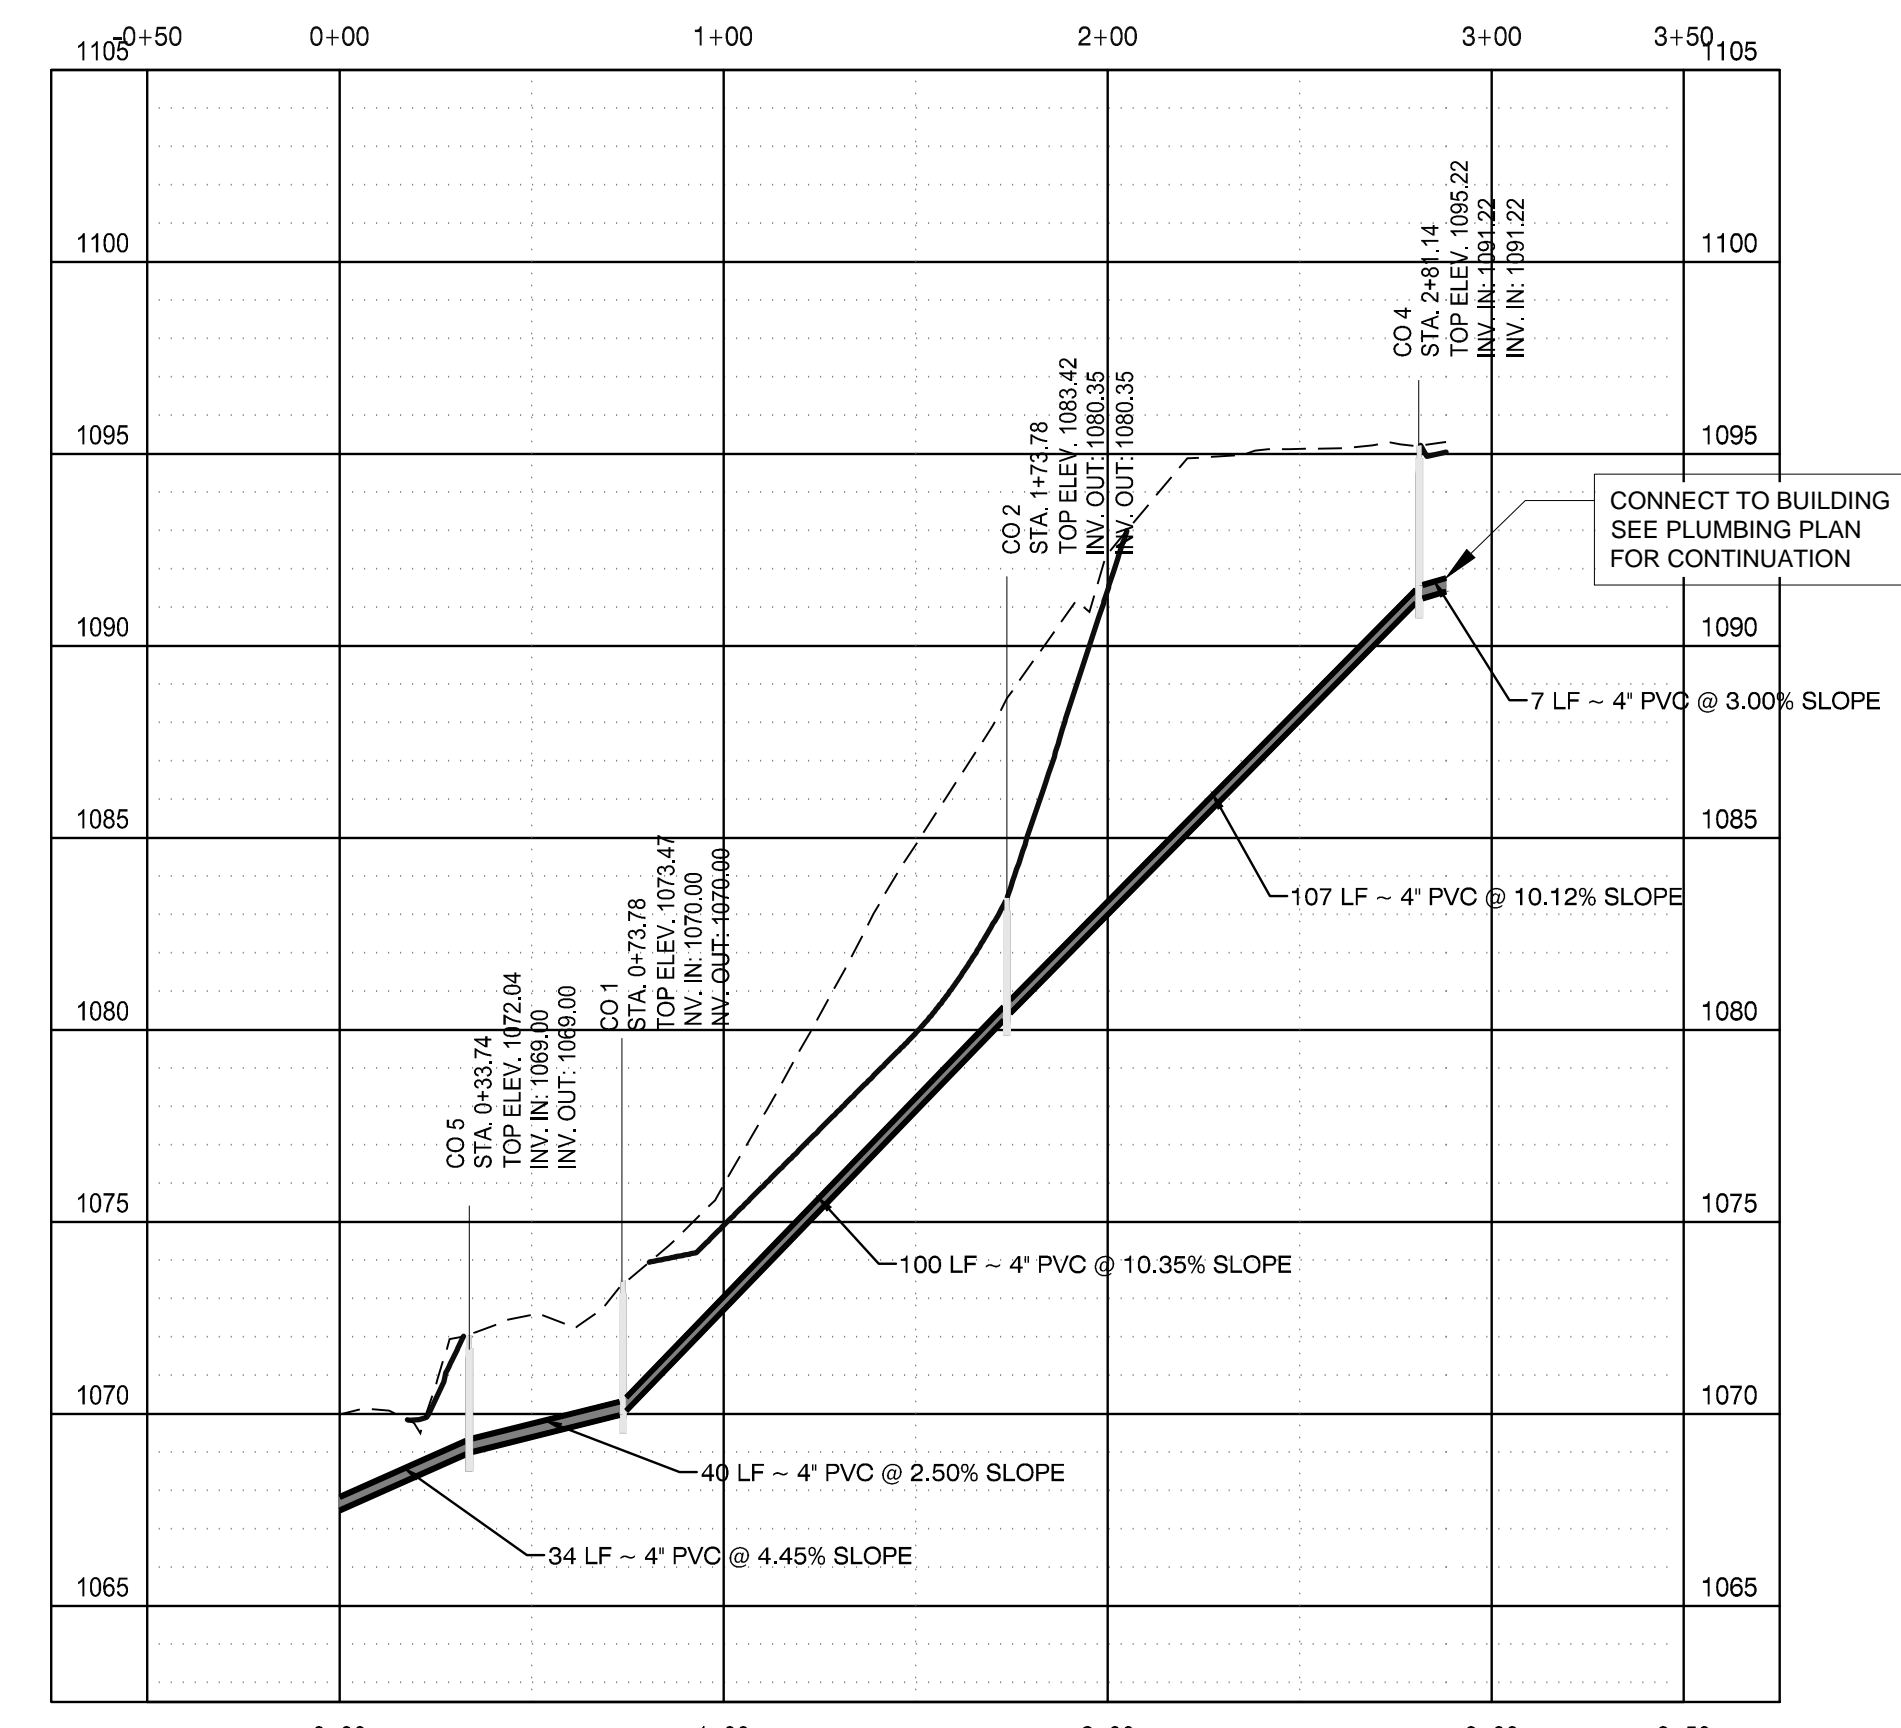

SANITARY SEWER 1

SCALE: H: 1" = 50'-0" V: 1" = 5'-0"

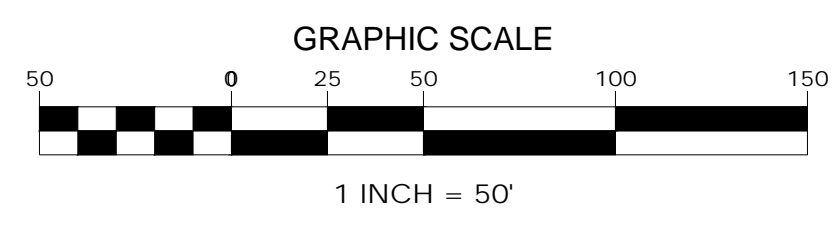

1 INCH = 50'

GENERAL SHEET NOTES

- SEE SHEET C001 FOR CIVIL NOTES AND LEGENDS
- COORDINATE ALL UTILITY CROSSINGS; SEE DETAIL 2/C803
- FIELD LOCATE ALL EXISTING UTILITIES PRIOR TO START OF CONSTRUCTION. DETERMINE LOCATED, SIZE, MATERIAL & INVERTS. REPORT ANY DISCREPANCIES TO OWNER & ENGINEER BEFORE PROCEEDING WITH CONSTRUCTION & INSTALLATION.

UTILITY CONTACTS

WATER NORRIS WATER COMMISSION 20 CHESTNUT ST NORRIS, TN 37828 (865) 494-7645	SEWER NORRIS WATER COMMISSION 20 CHESTNUT ST NORRIS, TN 37828 (865) 494-7645
GAS POWELL-CLING UTILITY DISTRICT 203 E 1ST ST ROCKY TOP, TN 37769 (865) 426-2822	ELECTRIC CLINTON UTILITIES BOARD 1001 CHARLES G. SEEVERS BLVD CLINTON, TN 37717 (865) 457-9232

PROFILE LEGEND



UTILITY LEGEND

- PIPE FITTING; SEE DETAIL 5/C803
- PIPE TEE; SEE DETAIL 5/C803
- GATE VALVE; SEE DETAIL 7/C803
- WATER METER BY LOCAL UTILITY
- CO-CLEANOUT; SEE DETAIL 6/C803

UTILITY KEYED NOTES

- EXISTING FIRE HYDRANT
- WATER LINE CONNECTION BY LOCAL UTILITY COMPANY. COORDINATE TAP & WATER METER LOCATIONS.
- FOR CONTINUATION SEE PLUMBING PLAN
- CONNECTION TO EXISTING MANHOLE; BY LOCAL UTILITY
- 4" ASTM D3034 SDR35 PVC BUILDING SANITARY SEWER SERVICE LINE @ 2.0% MIN. SLOPE; SEE DETAIL 1/C803
- 6" C-900 PVC FIRE PROTECTION SERVICE LINE; SEE DETAIL 1/C803
- GAS SERVICE LINE; TO BE RELOCATED BY LOCAL UTILITY
- SANITARY SEWER CLEANOUT; SEE DETAIL 6/C803
- 2" POTABLE WATER (PVC CLASS 200); SEE DETAIL 1/C803




ENGINEER:

MBI COMPANIES INC.
299 N. WEISGARBER ROAD
KNOXVILLE, TN 37919
PHONE: (865) 584-0999
FAX: (865) 584-5213
WEB: mbicompanies.com

CONSULTANT:

SEAL:

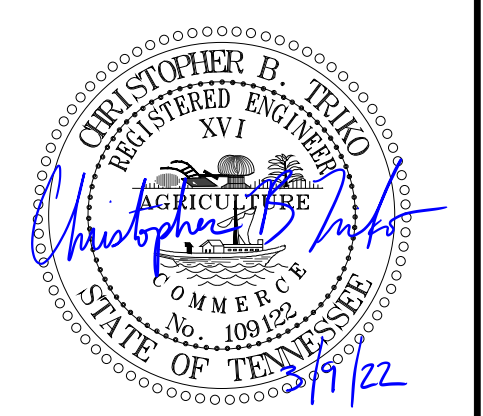

COPYRIGHT © MBI COMPANIES INC.
THE DESIGN PROFESSIONAL DENIES ANY AND ALL RESPONSIBILITY AND LIABILITY FOR PROBLEMS WHICH ARISE FROM FAILURE TO FOLLOW THESE PLANS, SPECIFICATIONS AND THE DESIGN INTENT THEY CONVEY, OR PROBLEMS WHICH ARISE FROM OTHERS' FAILURE TO OBTAIN AND/OR FOLLOW THE DESIGN PROFESSIONAL'S GUIDANCE WITH RESPECT TO ANY ERRORS, OMISSIONS, INCONSISTENCIES, AMBIGUITIES OR CONFLICTS WHICH ARE ALLEGED.

PROJECT INFORMATION
PROJECT:
**AN ADDITION & RENOVATION TO:
NORRIS MIDDLE SCHOOL**
PROJECT ADDRESS:
5 NORRIS SQUARE
NORRIS, TN 37828


PROJECT NO.:	210042-04									
ACTIVE DESIGN PHASE	<input type="checkbox"/> FOR REVIEW ONLY <input type="checkbox"/> FOR PERMITTING ONLY <input type="checkbox"/> SCHEMATIC DESIGN <input type="checkbox"/> DESIGN DEVELOPMENT <input type="checkbox"/> CONSTRUCTION BIDDING <input checked="" type="checkbox"/> CONSTRUCTION DOCUMENTS <input type="checkbox"/> AS-BUILT RECORD SET									
REVISION INFORMATION	<table border="1"> <thead> <tr> <th>NO.</th> <th>DATE</th> <th>DESCRIPTION</th> </tr> </thead> <tbody> <tr> <td>1</td> <td>02/22/2022</td> <td>ADDENDUM #1</td> </tr> <tr> <td>2</td> <td>03/09/2022</td> <td>ADDENDUM #2</td> </tr> </tbody> </table>	NO.	DATE	DESCRIPTION	1	02/22/2022	ADDENDUM #1	2	03/09/2022	ADDENDUM #2
NO.	DATE	DESCRIPTION								
1	02/22/2022	ADDENDUM #1								
2	03/09/2022	ADDENDUM #2								

SHEET INFORMATION	SHEET ISSUED: 03/02/2022 DESIGNED BY: I.A.J. DRAWN BY: I.A.J. REVIEWED BY: C.B.T. SHEET TITLE:
-------------------	--

KEY PLAN

SHEET TITLE:
SITE UTILITY PLAN

SHEET NO.:

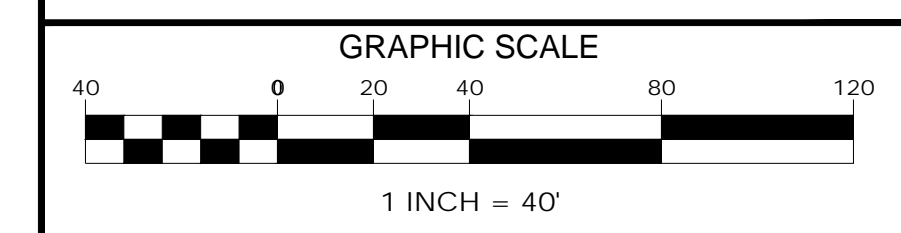

1 INCH = 40'

C500

DOOR SCHEDULE															
NUMBER	D-TYPE	D-MATL	DOORS			THICK	FINISH	FRAMES			DETAILS			REMARKS	
			FULL WIDTH	PANELS	HEIGHT			F-MATL	F-FINISH	HEAD	JAMB	T-HOLD	H-WARE		
101A	FG	HM	6'-0"	PAIR	7'-0"	1 3/4"	PT	1	HM	PT	1/A201	2/A201	5/A201	1A	ADA PUSH BUTTON OPENER
101B	FG	HM	6'-0"	PAIR	7'-0"	1 3/4"	PT	1	HM	PT	1/A201	2/A201	5/A201	1B	
101C	FG	HM	6'-0"	PAIR	7'-0"	1 3/4"	PT	1	HM	PT	1/A201	2/A201	5/A201	1D	
101D	FG	HM	6'-0"	PAIR	7'-0"	1 3/4"	PT	1	HM	PT	1/A201	2/A201	5/A201	1C	
102	FG	HM	3'-0"	SINGLE	7'-0"	1 3/4"	PT	2	HM	PT	1/A201	2/A201	5/A201	1E	
103	F	WD	3'-0"	SINGLE	7'-0"	1 3/4"	ST	3	HM	PT	3/A201	4/A201	6/A201	2	
104	F	WD	3'-0"	SINGLE	7'-0"	1 3/4"	ST	3	HM	PT	3/A201	4/A201	6/A201	3	
105	FG	HM	6'-0"	PAIR	7'-0"	1 3/4"	PT	3	HM	PT	1/A201	2/A201	5/A201	1A	
106	N	WD	3'-0"	SINGLE	7'-0"	1 3/4"	ST	3	HM	PT	3/A201	4/A201	6/A201	5	
107	N	WD	3'-0"	SINGLE	7'-0"	1 3/4"	ST	3	HM	PT	3/A201	4/A201	6/A201	5	
108	N	WD	3'-0"	SINGLE	7'-0"	1 3/4"	ST	3	HM	PT	3/A201	4/A201	6/A201	5	
109	F	WD	3'-0"	SINGLE	7'-0"	1 3/4"	ST	3	HM	PT	3/A201	4/A201	6/A201	2	
110	N	WD	3'-0"	SINGLE	7'-0"	1 3/4"	ST	3	HM	PT	3/A201	4/A201	6/A201	5	
111	N	WD	3'-0"	SINGLE	7'-0"	1 3/4"	ST	3	HM	PT	3/A201	4/A201	6/A201	5	
112	N	WD	3'-0"	SINGLE	7'-0"	1 3/4"	ST	3	HM	PT	3/A201	4/A201	6/A201	5	
113	N	WD	3'-0"	SINGLE	7'-0"	1 3/4"	ST	3	HM	PT	3/A201	4/A201	6/A201	5	
RR1	F	WD	3'-0"	SINGLE	7'-0"	1 3/4"	ST	3	HM	PT	3/A201	4/A201	6/A201	6	

GENERAL DOOR NOTES


- INTERIOR WOOD DOORS TO BE FACTORY FINISH. WOOD SPECIES TO BE ROTARY CUT BIRCH.
- EXTERIOR HOLLOW METAL DOORS ARE TO BE INSULATED.
- EXTERIOR HOLLOW METAL DOORS AND FRAMES ARE TO BE FACTORY PRIMED AND FIELD PAINTED.

GLAZING SCHEDULE


(M-1) 1/4" THICK TRANSPARENT ONE-WAY MIRROR, FULLY TEMPERED.

(IG-T) 1" THICK INSULATED GLASS WITH 1/2" AIR SPACE AND TWO 1/4" LITES, FULLY TEMPERED


(IG-G) 1" THICK INSULATED GLASS WITH 1/2" AIR SPACE, WITH INTERSTITIAL GRILLES, AND TWO 1/4" LITES, FULLY TEMPERED

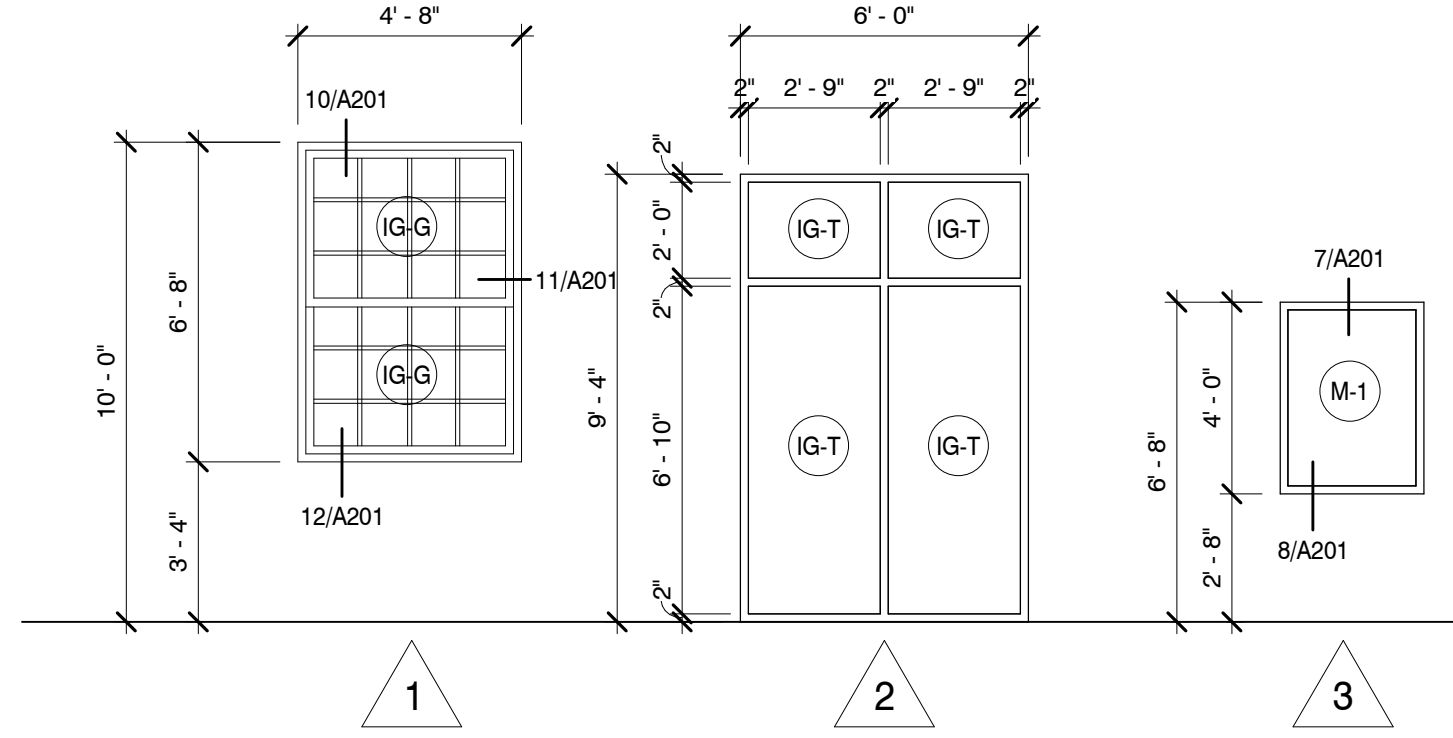


WINDOW TYPES
SCALE: 1/4" = 1'-0"

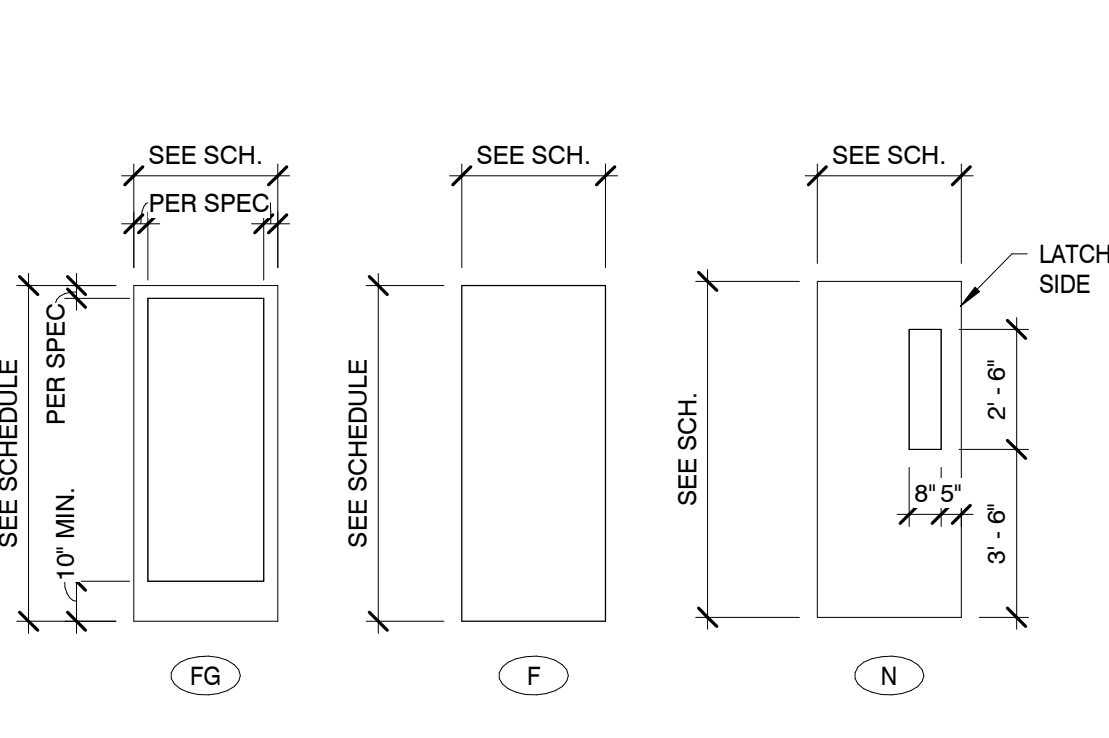


DOOR TYPES
SCALE: 1/4" = 1'-0"

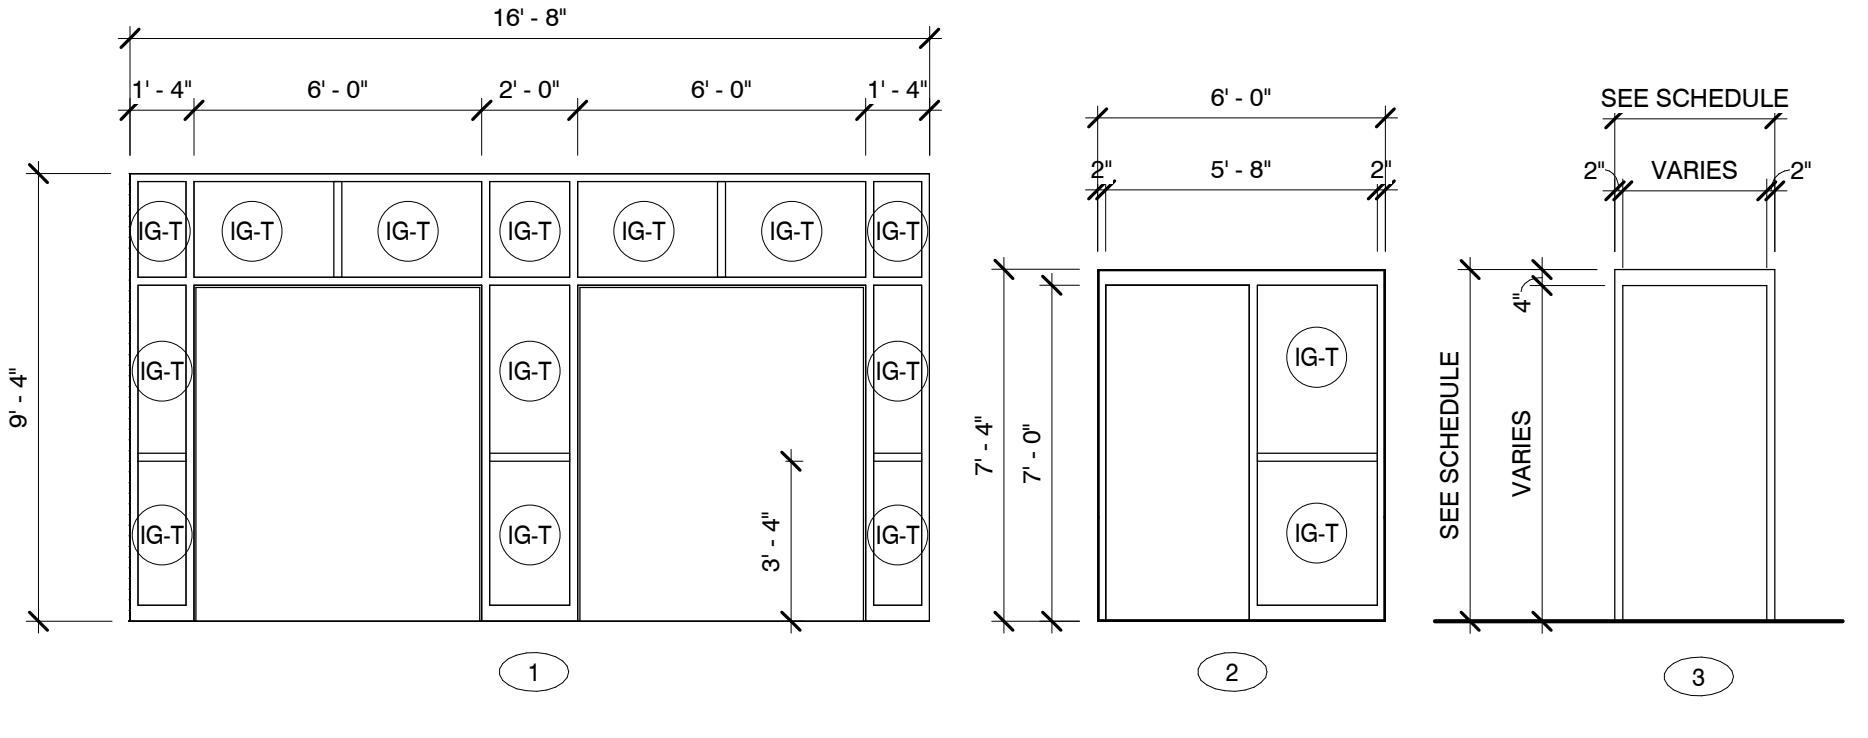


DOOR FRAME TYPES
SCALE: 1/4" = 1'-0"

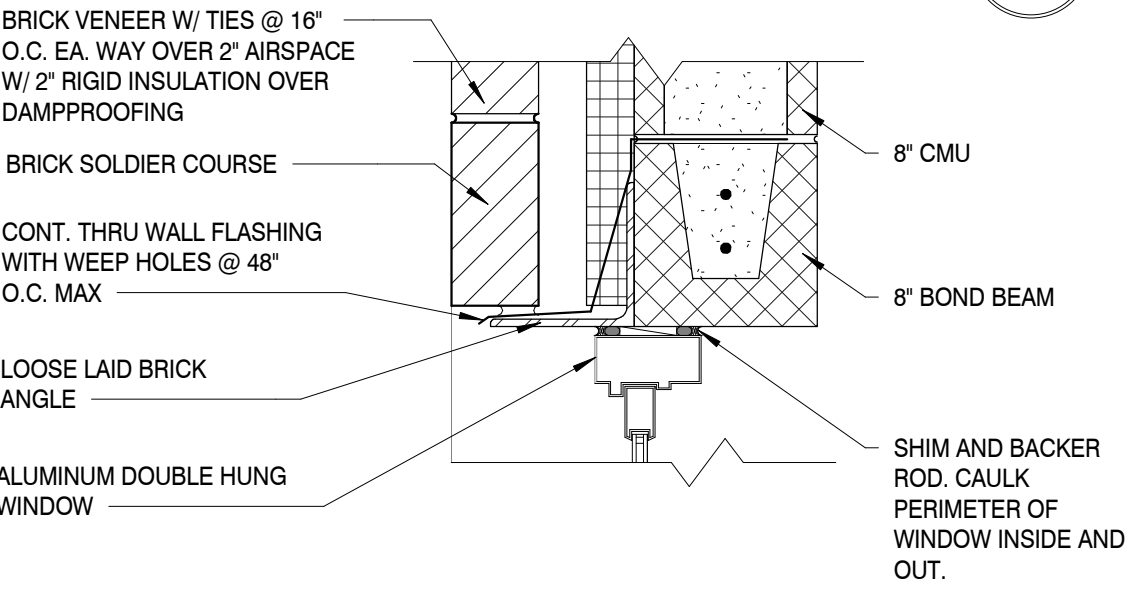


HEAD DETAIL
SCALE: 1 1/2" = 1'-0"

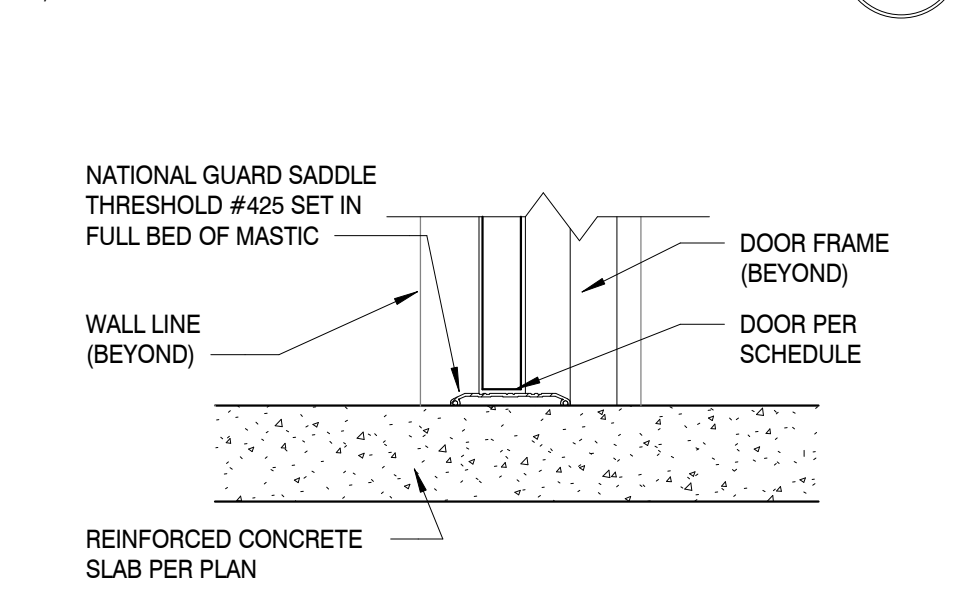


THRESHOLD DETAIL
SCALE: 1 1/2" = 1'-0"

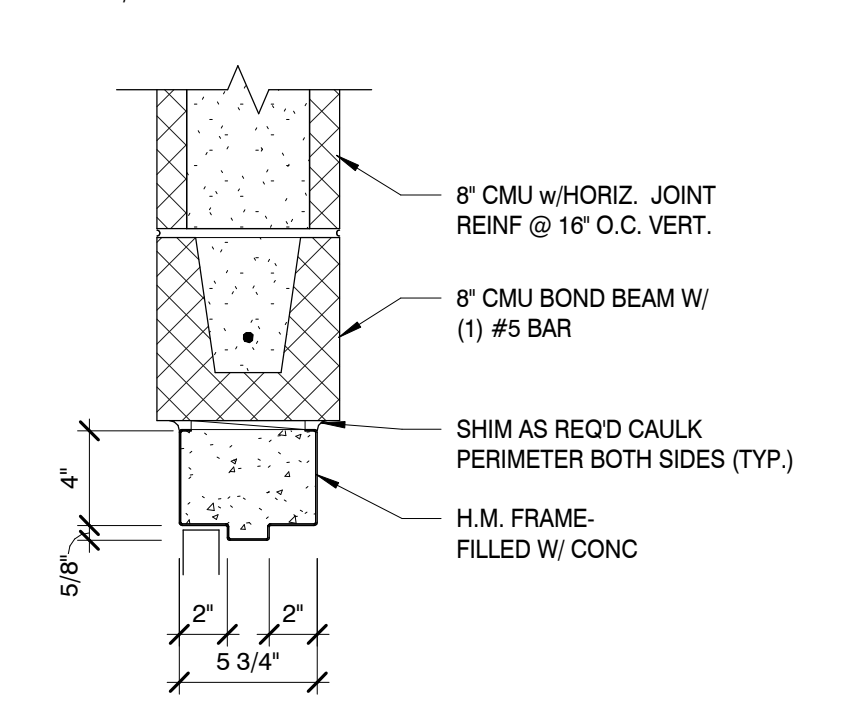


HEAD DETAIL
SCALE: 1 1/2" = 1'-0"

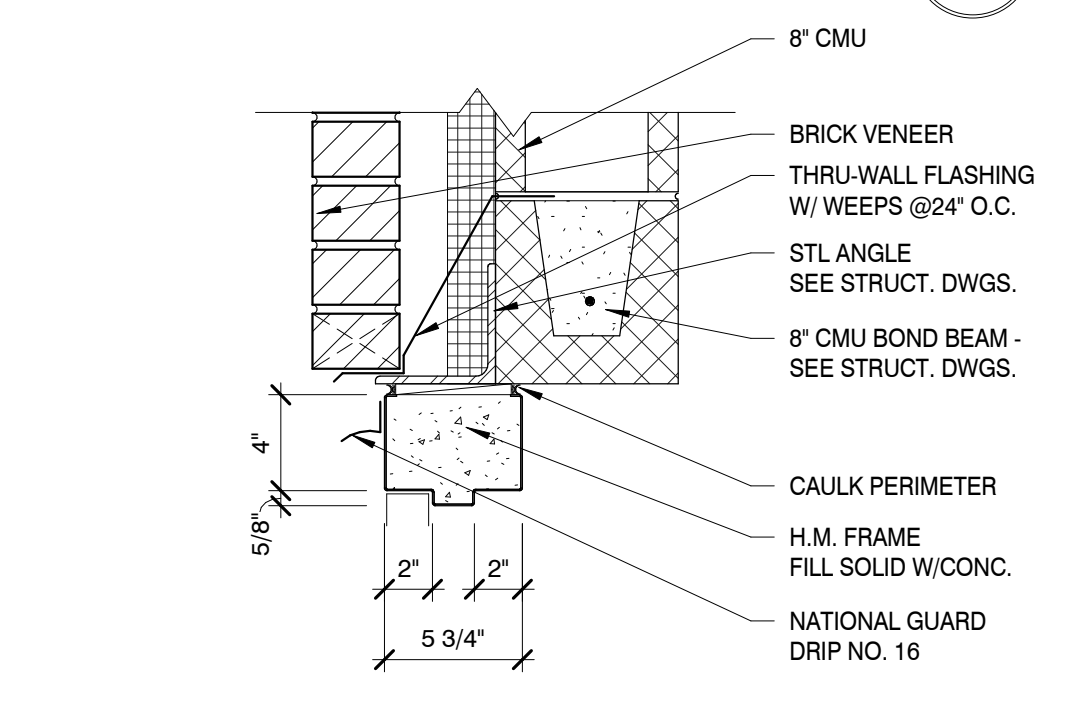


HEAD DETAIL
SCALE: 1 1/2" = 1'-0"

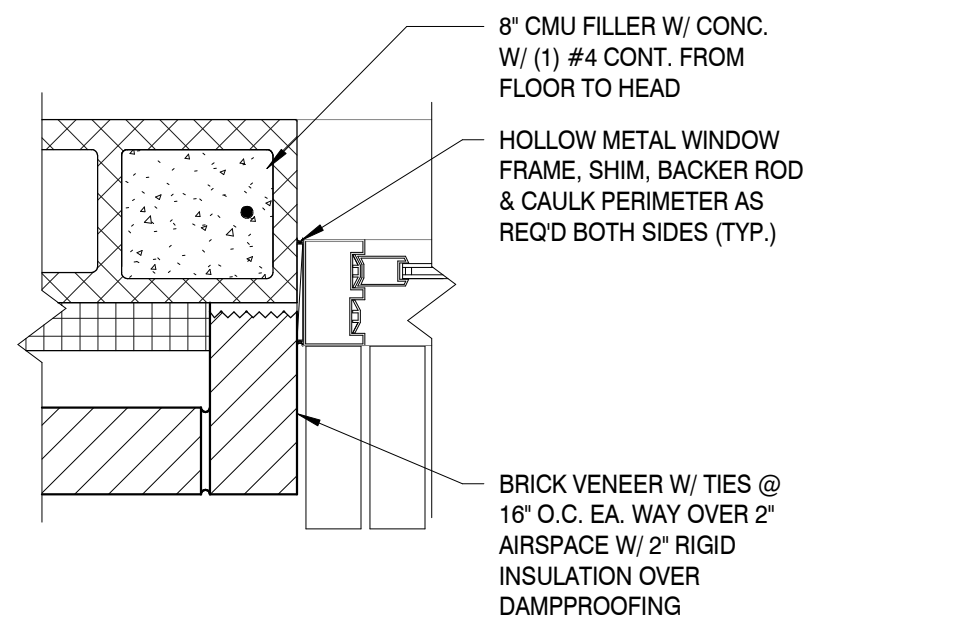


WINDOW JAMB
SCALE: 1 1/2" = 1'-0"

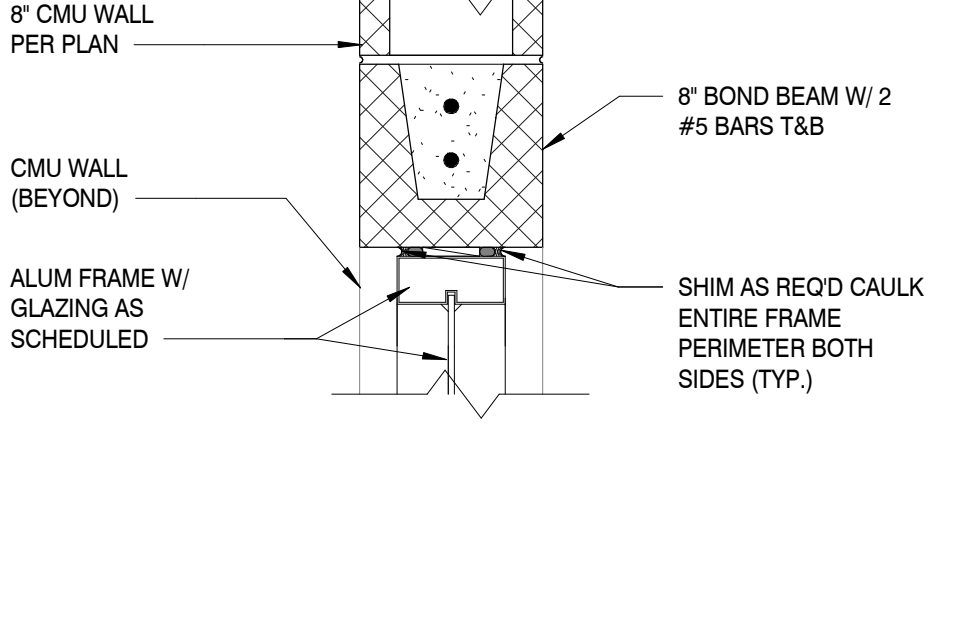


WINDOW HEAD
SCALE: 1 1/2" = 1'-0"

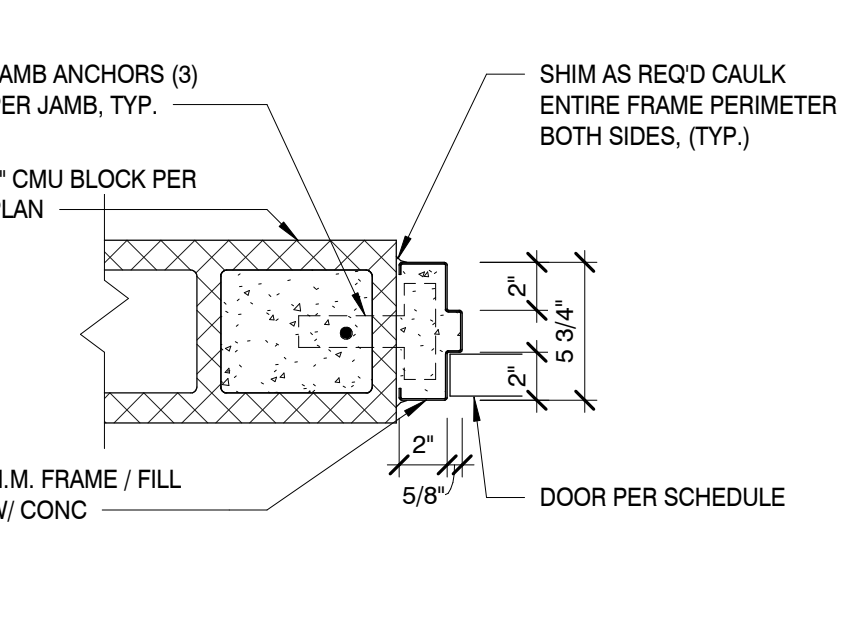


JAMB DETAIL
SCALE: 1 1/2" = 1'-0"

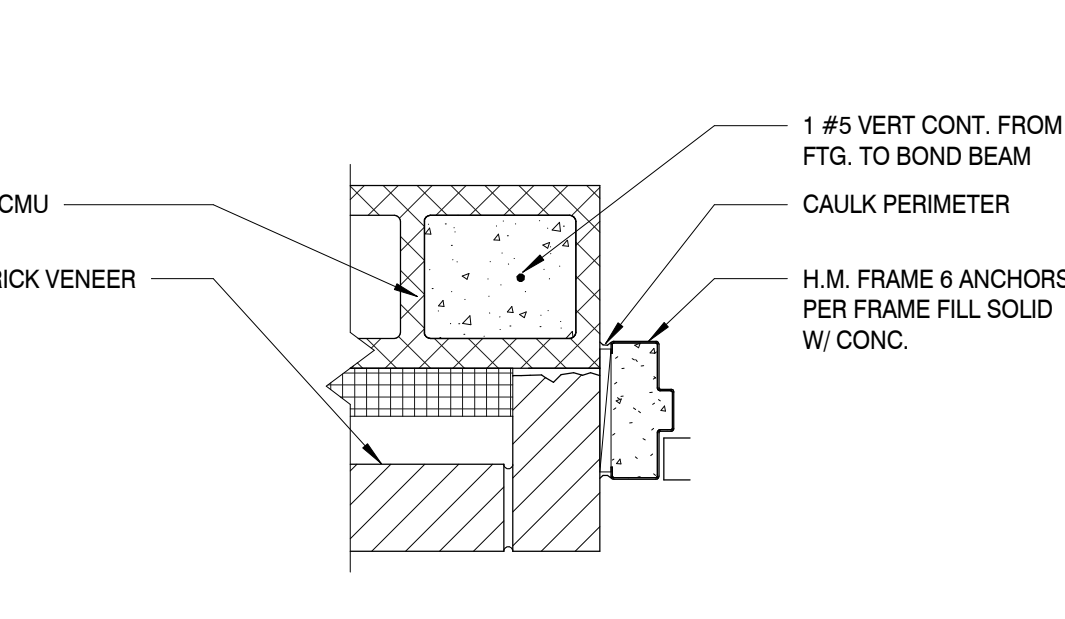


JAMB DETAIL
SCALE: 1 1/2" = 1'-0"

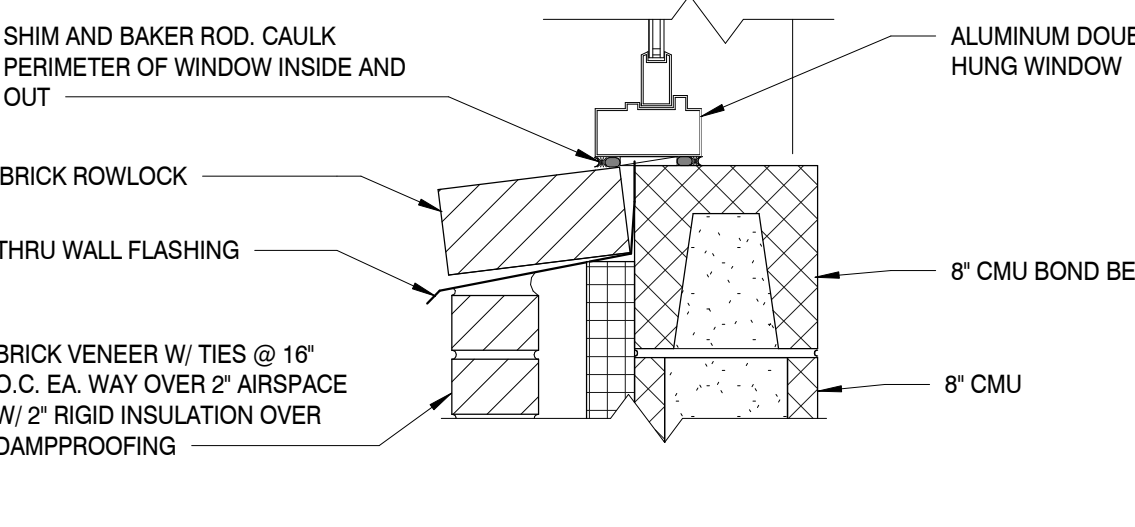

SILL DETAIL
SCALE: 1 1/2" = 1'-0"

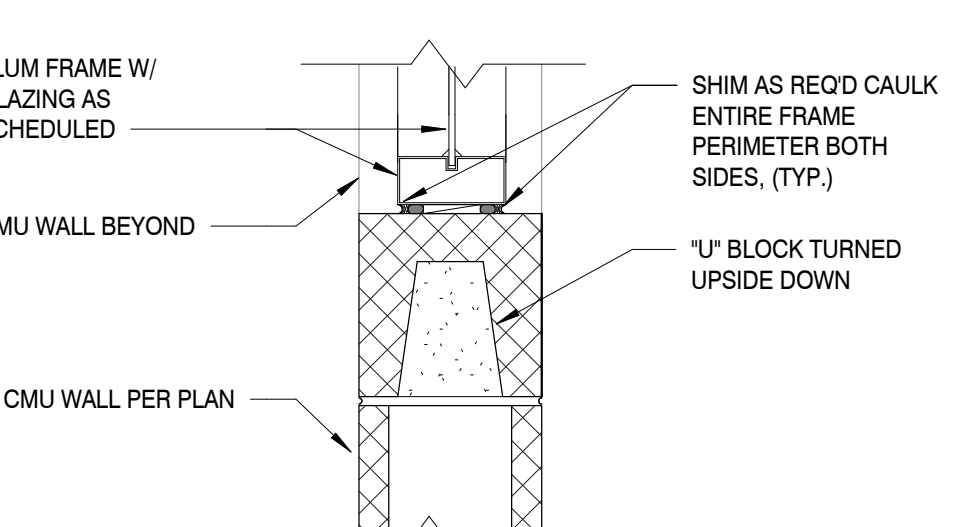

WINDOW SILL
SCALE: 1 1/2" = 1'-0"

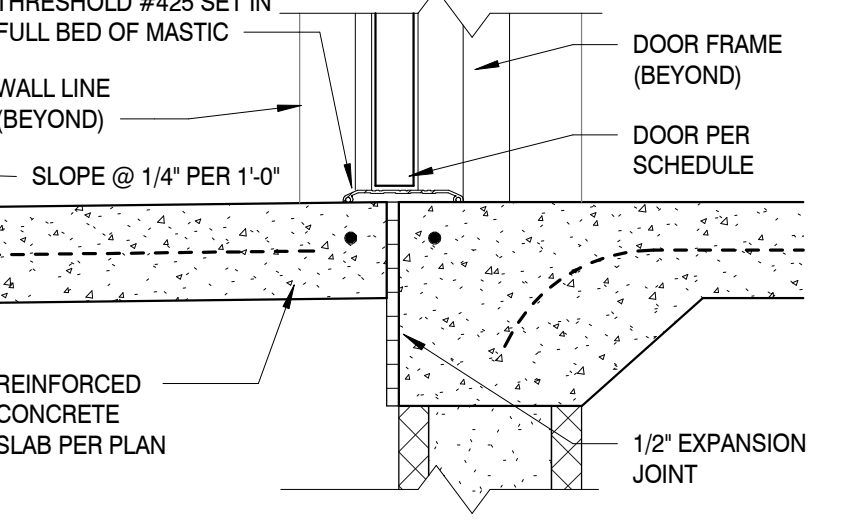

THRESHOLD DETAIL
SCALE: 1 1/2" = 1'-0"

MBI

MBI COMPANIES INC.
299 N. WEISGARDER ROAD
KNOXVILLE, TN 37919

PHONE: (865) 584-0999
FAX: (865) 584-5213
WEB: mbicompanies.com

CONSULTANT

SEAL

COPYRIGHT © MBI COMPANIES INC. 2021
THE DESIGN PROFESSIONAL DENIES ANY AND ALL RESPONSIBILITY AND LIABILITY FOR PROBLEMS WHICH ARISE FROM FAILURE TO FOLLOW THESE PLANS, SPECIFICATIONS AND THE DESIGN INTENT THEY CONVEY, OR PROBLEMS WHICH ARISE FROM OTHERS' FAILURE TO OBTAIN AND/OR FOLLOW THE DESIGN PROFESSIONAL'S GUIDANCE WITH RESPECT TO ANY ERRORS, OMISSIONS, INCONSISTENCIES, AMBIGUITIES OR CONFLICTS WHICH ARE ALLEGED.

PROJECT INFORMATION
PROJECT: AN ADDITION & RENOVATION TO: NORRIS MIDDLE SCHOOL
PROJECT ADDRESS: 5 NORRIS SQUARE, NORRIS, TN 37828
PROJECT NO.: 210042-04

ACTIVE DESIGN PHASE

FOR REVIEW ONLY
 FOR PERMITTING ONLY
 SCHEMATIC DESIGN
 DESIGN DEVELOPMENT
 CONSTRUCTION BIDDING
 CONSTRUCTION DOCUMENTS
 AS-BUILT RECORD SET

REVISION INFORMATION

NO.	DATE	DESCRIPTION
1	02/22/2022	Addendum #1
2	03/09/2022	Addendum #2

KEY PLAN

SHEET INFORMATION
SHEET ISSUED: 02/04/2022
DESIGNED BY: CMG
DRAWN BY: KEF
REVIEWED BY: CMG
SHEET TITLE: DOOR SCHEDULE, WINDOW TYPES, AND DETAILS
SHEET NO.: A201

C:\Users\mbi\OneDrive\Documents\210042-04_LatHydrR\BWA2.rvt
3/9/2022 2:11:03 PM



COPYRIGHT © MBI COMPANIES INC. 2021
THE DESIGN PROFESSIONAL DENIES ANY AND ALL RESPONSIBILITY AND LIABILITY FOR PROBLEMS WHICH ARISE FROM FAILURE TO FOLLOW THESE PLANS, SPECIFICATIONS AND THE DESIGN INTENT THEY CONVEY, OR PROBLEMS WHICH ARISE FROM OTHERS' FAILURE TO OBTAIN AND/OR FOLLOW THE DESIGN PROFESSIONAL'S GUIDANCE WITH RESPECT TO ANY ERRORS, OMISSIONS, INCONSISTENCIES, AMBIGUITIES OR CONFLICTS WHICH ARE ALLEGED.

PROJECT INFORMATION

PROJECT:

AN ADDITION &
RENOVATION TO:
NORRIS MIDDLE
SCHOOL

PROJECT ADDRESS:

5 NORRIS SQUARE,
NORRIS, TN 37828

PROJECT NO.: 210042-04

ACTIVE DESIGN PHASE

- FOR REVIEW ONLY
- FOR PERMITTING ONLY
- SCHEMATIC DESIGN
- DESIGN DEVELOPMENT
- CONSTRUCTION BIDDING
- CONSTRUCTION DOCUMENTS
- AS-BUILT RECORD SET

REVISION INFORMATION

NO.	DATE	DESCRIPTION
2	03/09/2022	Addendum #2


KEY PLAN

SHEET INFORMATION

SHEET ISSUED: 02/04/2022
DESIGNED BY: CMG
DRAWN BY: KEF
REVIEWED BY: CMG
SHEET TITLE:

ROOF PLAN

SHEET NO.: A301

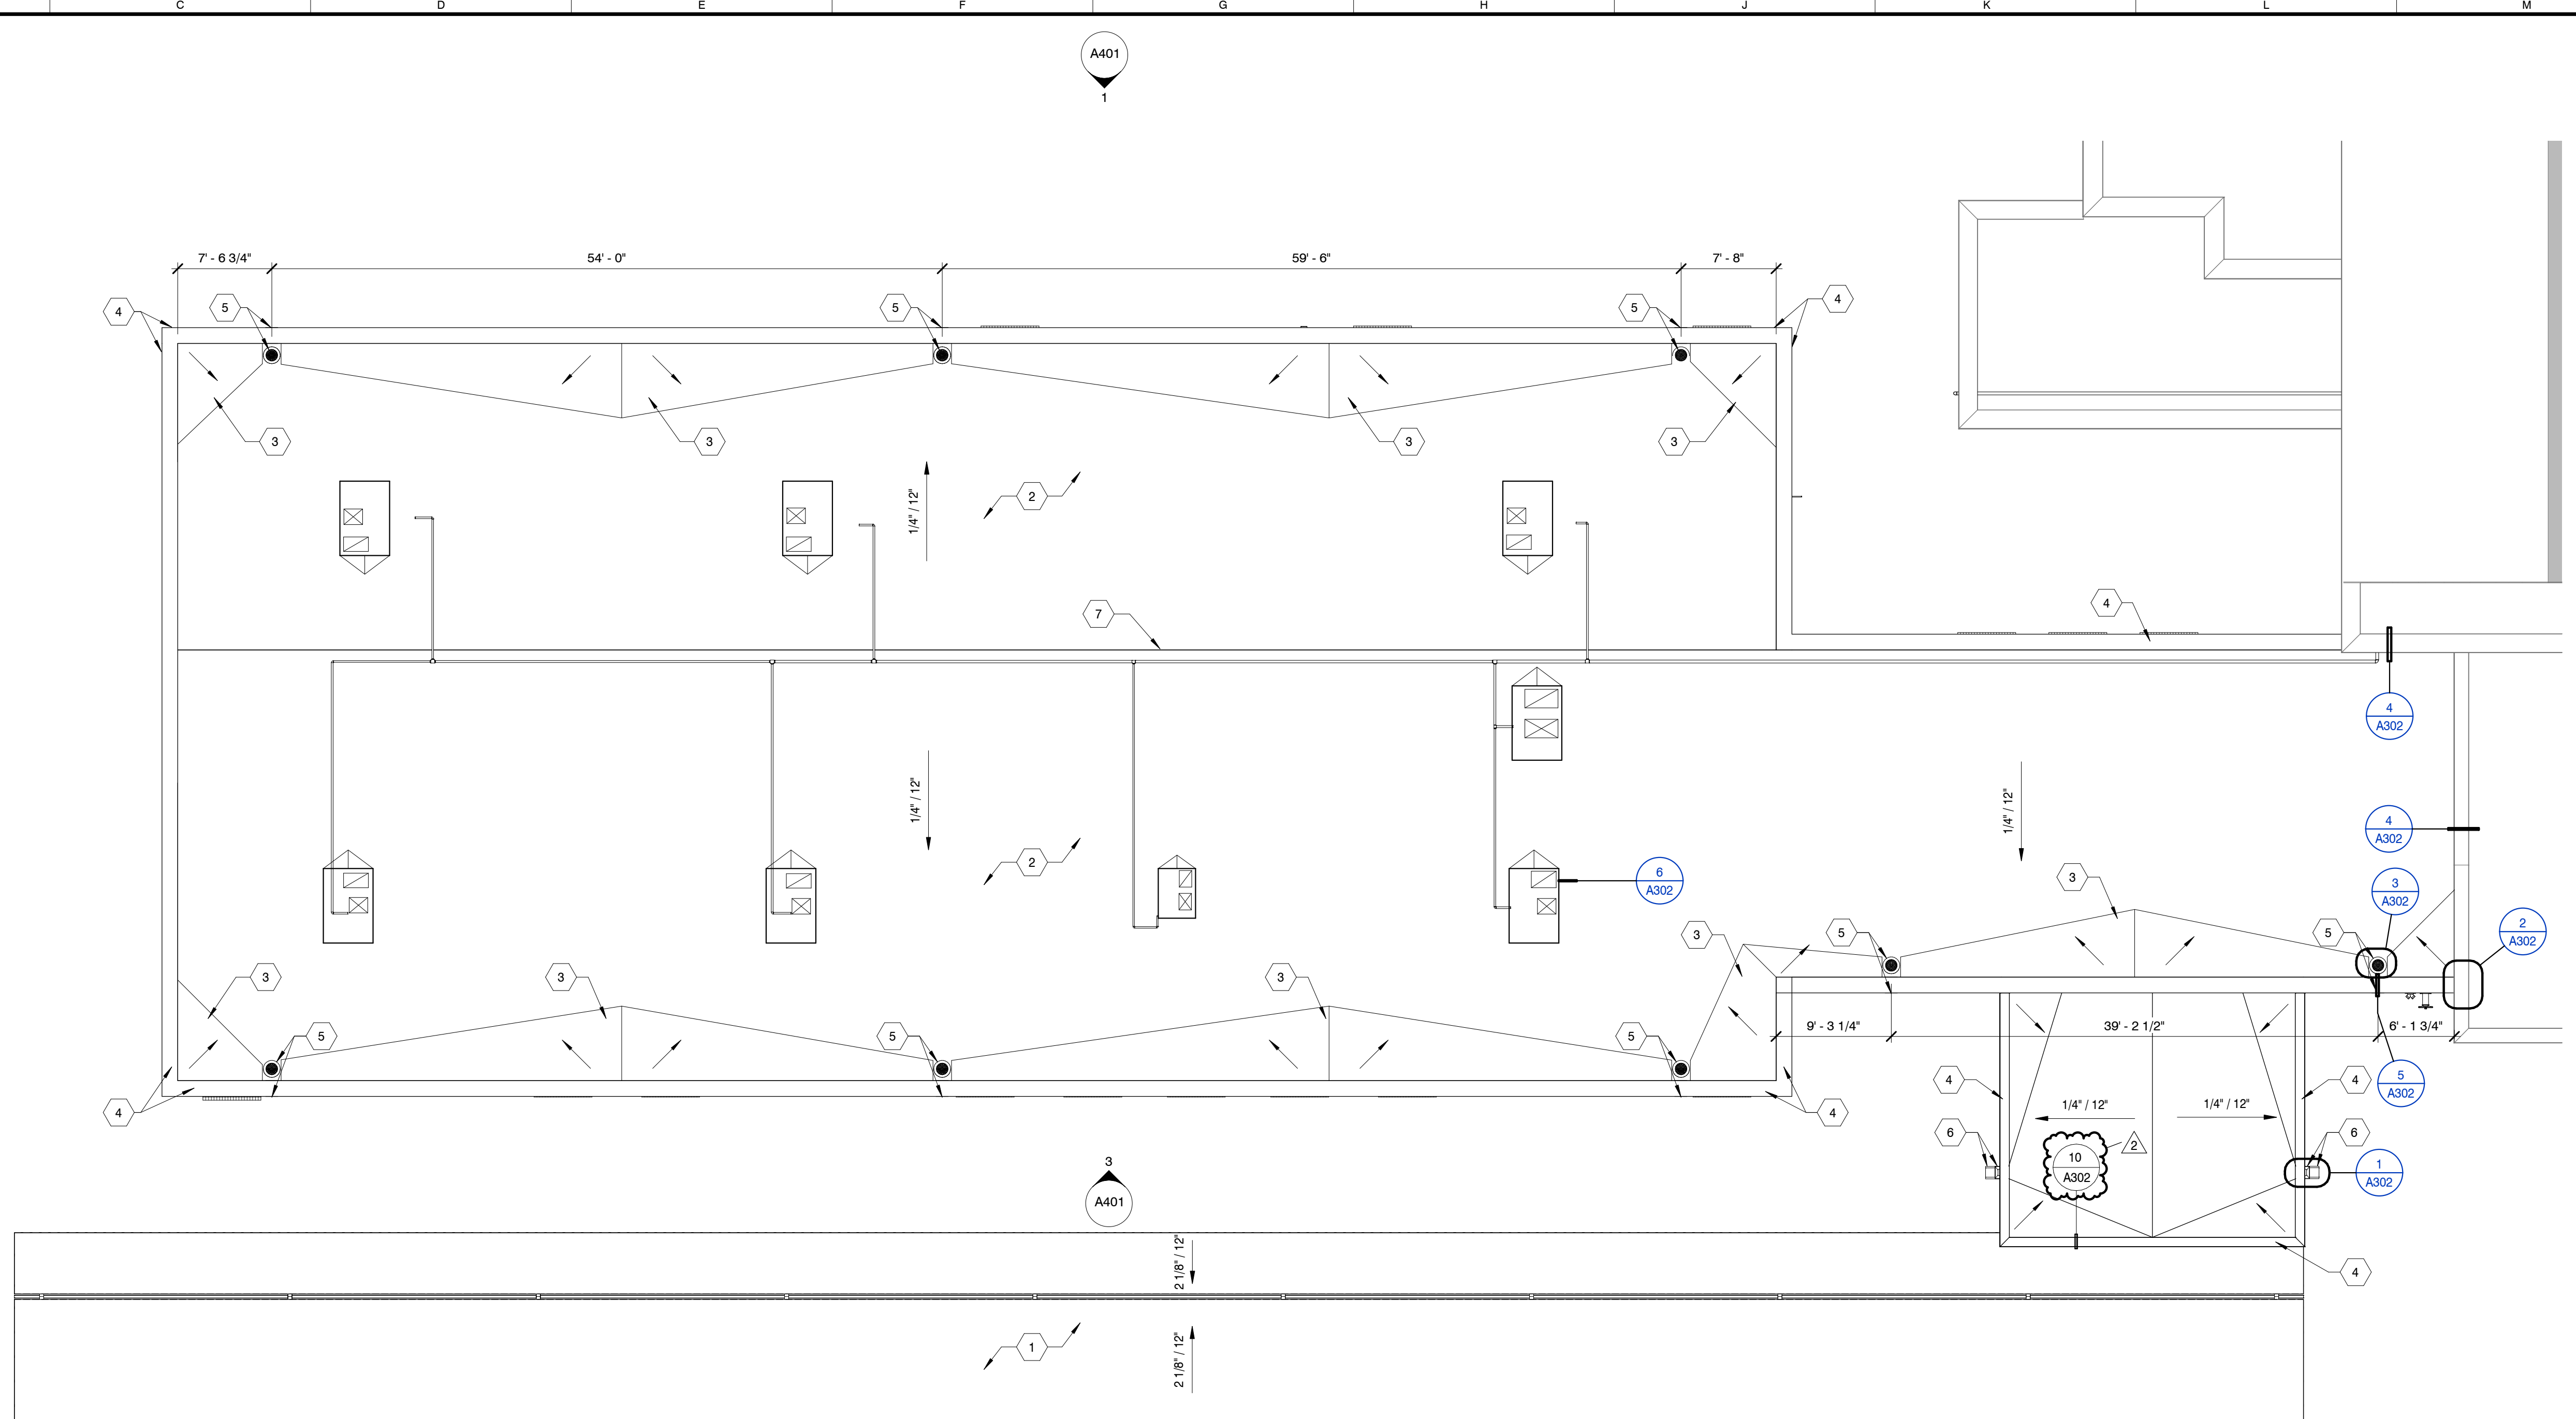


ROOF PLAN

SCALE: 1/8" = 1'-0"


ROOF PLAN KEYNOTES

1. FREESTANDING CANOPY WITH CORRUGATED POLYCARBONATE PANELS.
2. EPDM ROOFING.
3. TAPERED INSULATION, SLOPE TO DRAIN.
4. METAL COPING CAP.
5. ROOF DRAIN AND OVERFLOW SCUPPER.
6. SCUPPER, CONDUCTOR HEAD, DOWNPOUT, AND CONCRETE SPLASHBLOCK.
7. ROOF RIDGE LINE.


C:\Users\kellyr\OneDrive\Documents\210042-04_kellyr\RF\A301.rvt
3/9/2022 3:26:04 PM

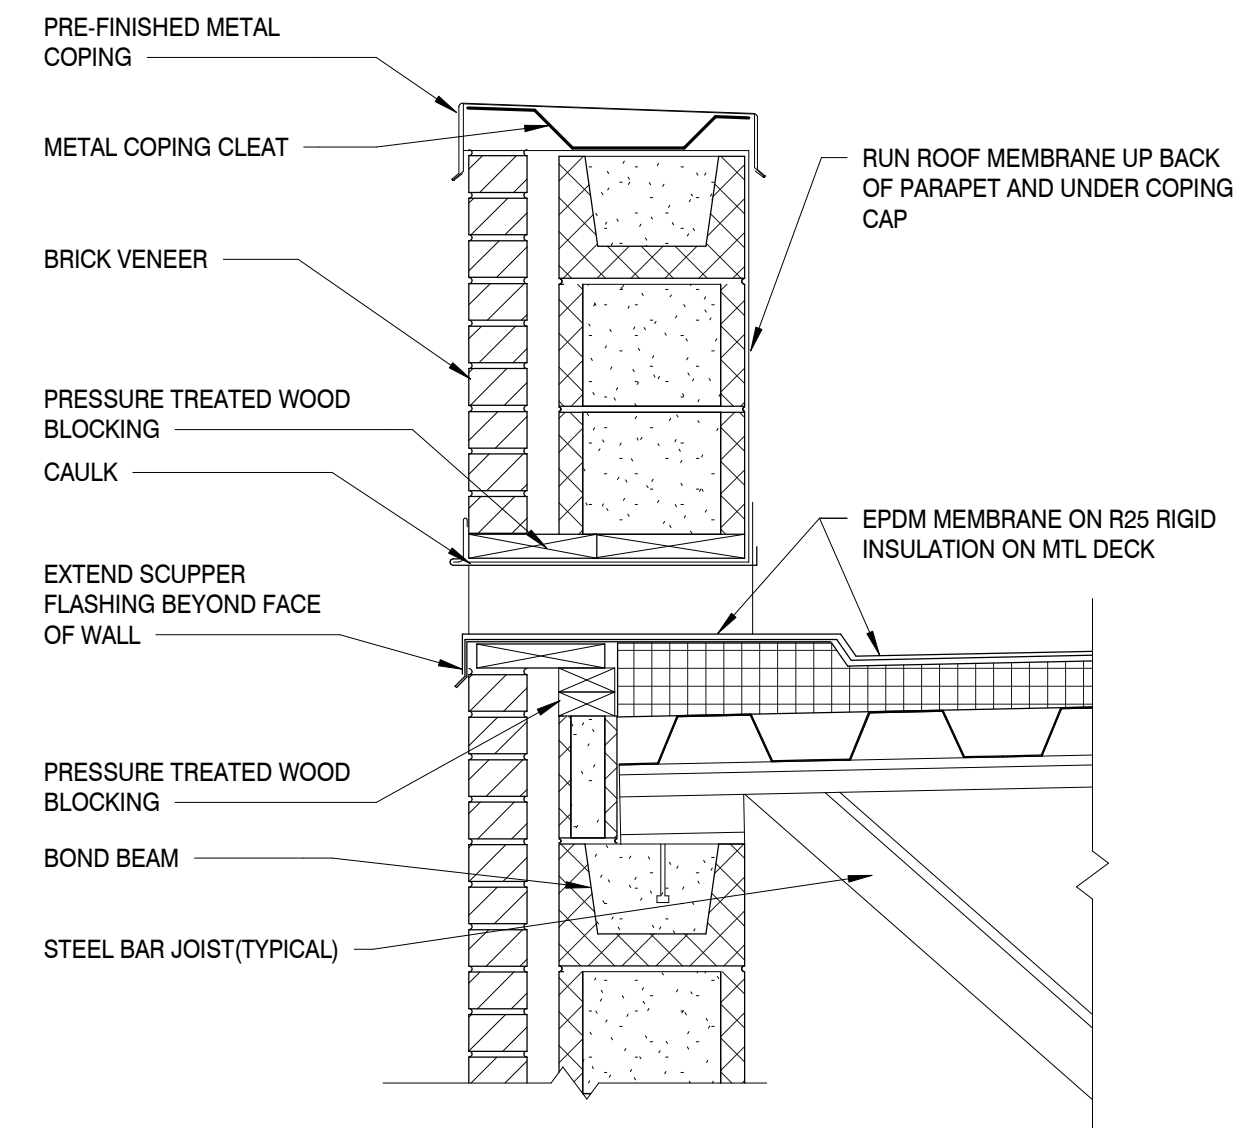


PARAPET W/ OVERFLOW SCUPPER
SCALE: 1" = 1'-0"

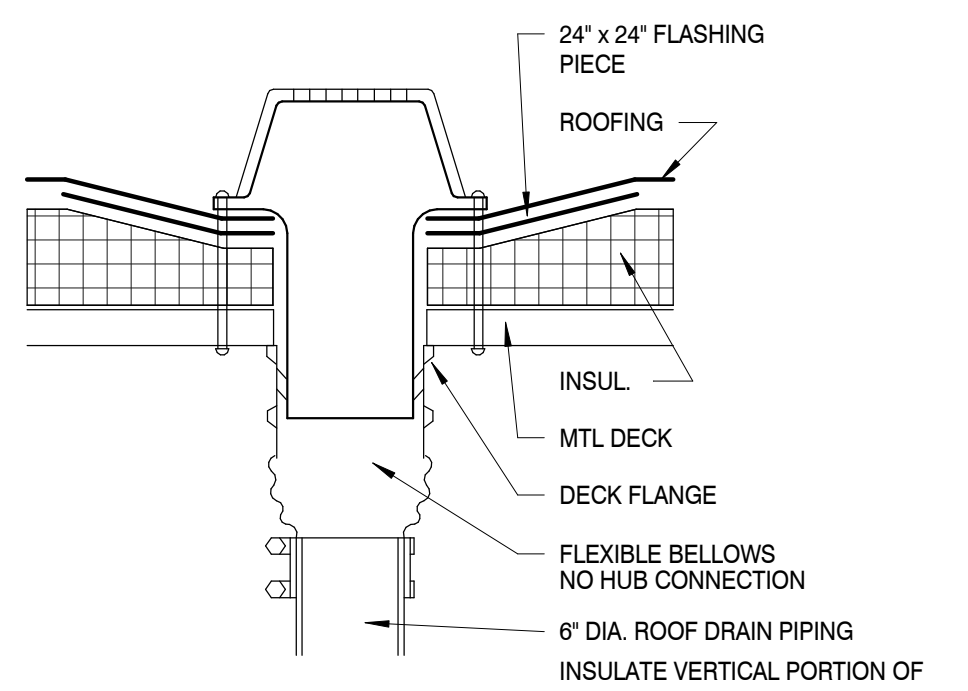


ROOF DRAIN
SCALE: 1 1/2" = 1'-0"

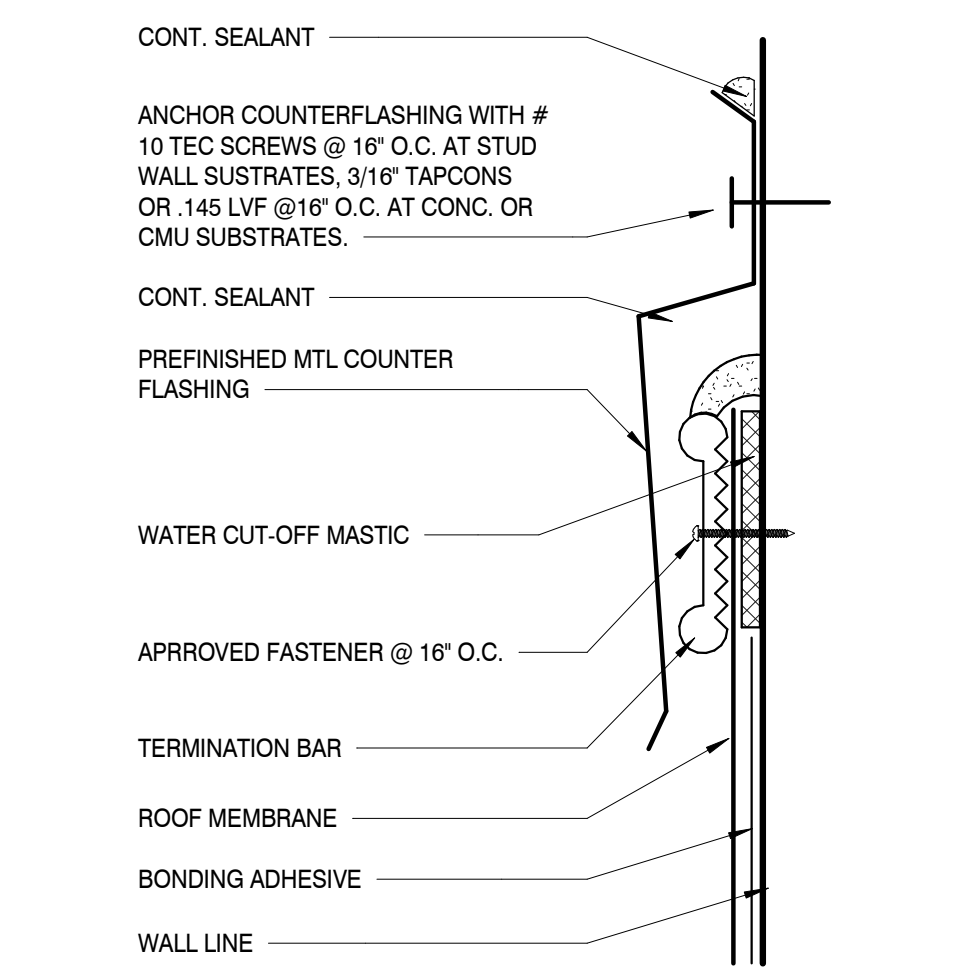


TERM BAR DETAIL
SCALE: 3" = 1'-0"

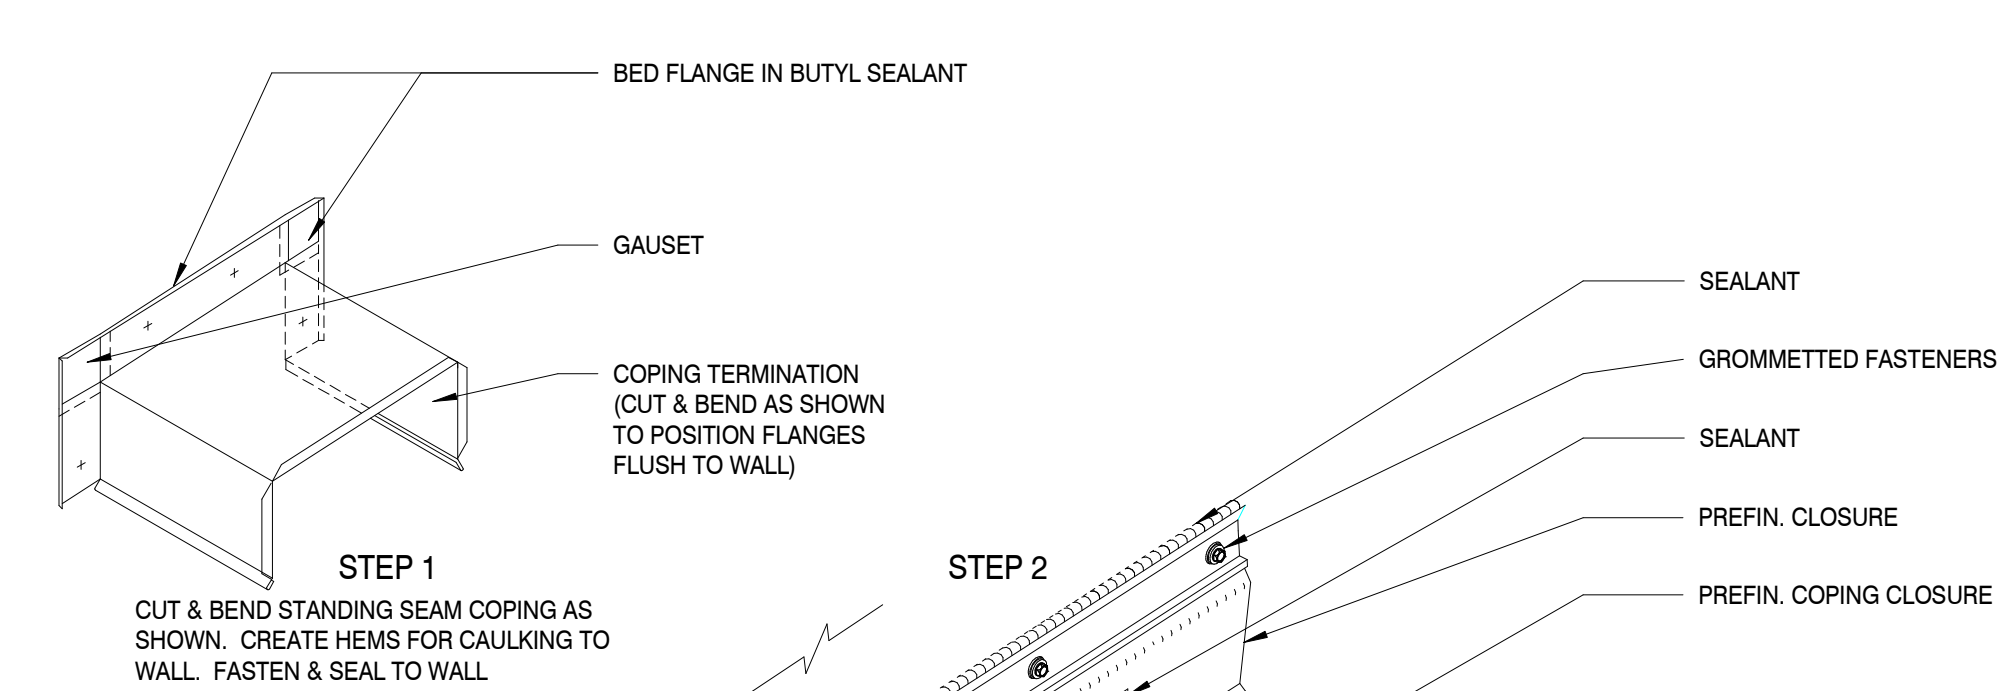


COPING TERMINATION DETAIL
SCALE: 1 1/2" = 1'-0"

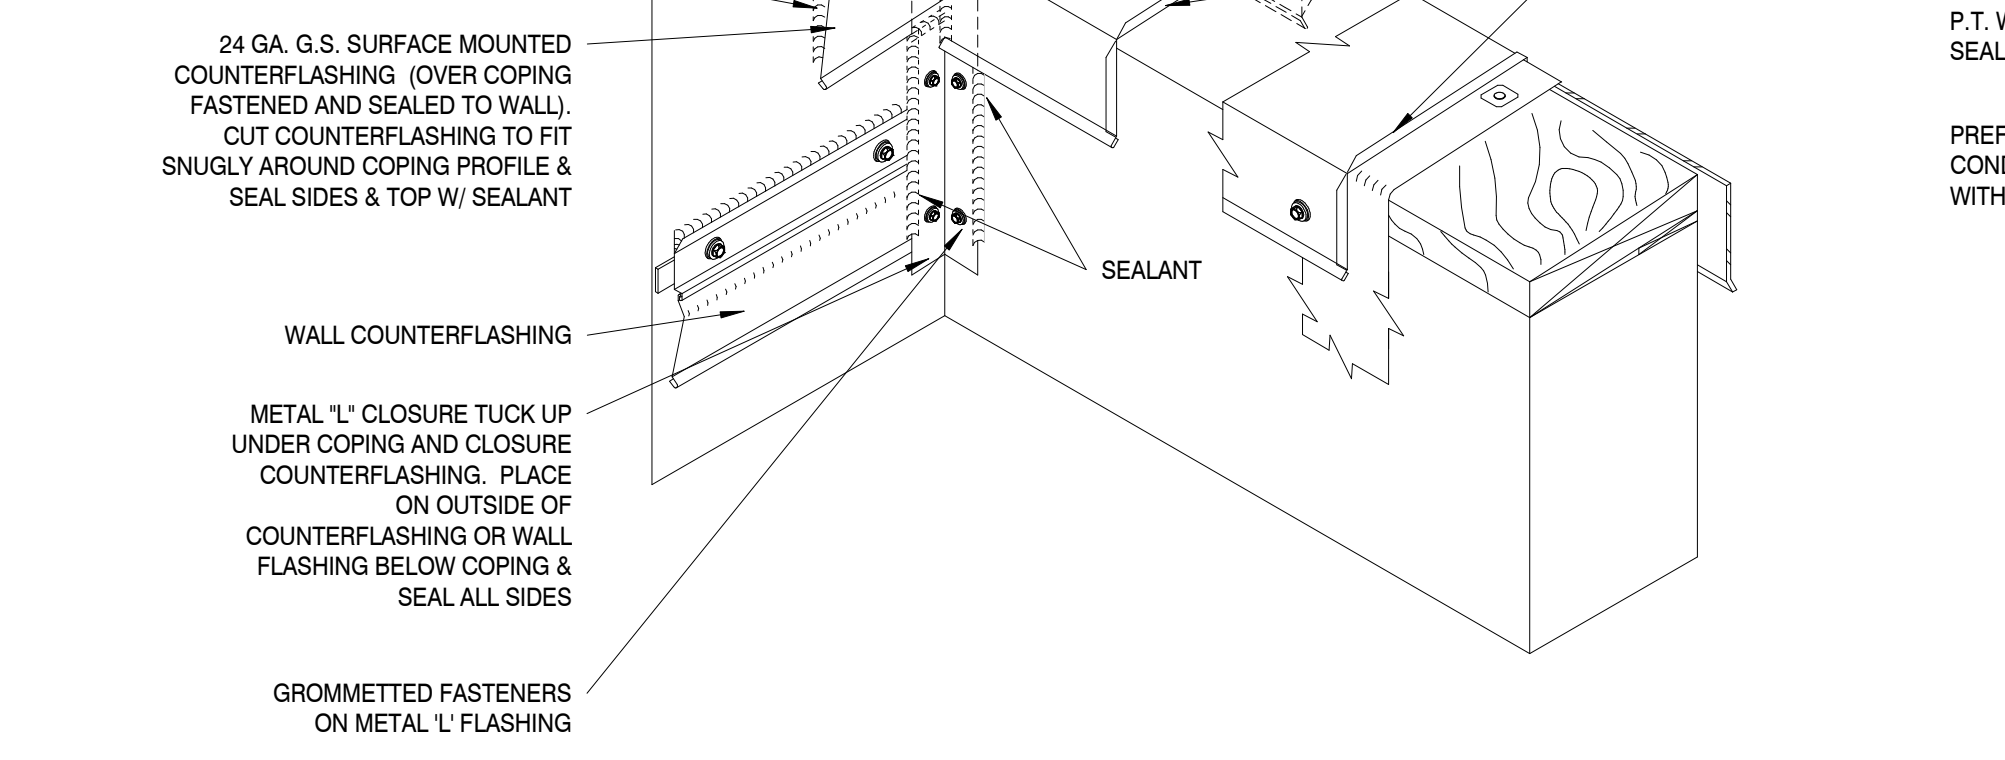


SCUPPER AND DOWNSPOUT
SCALE: 1 1/2" = 1'-0"

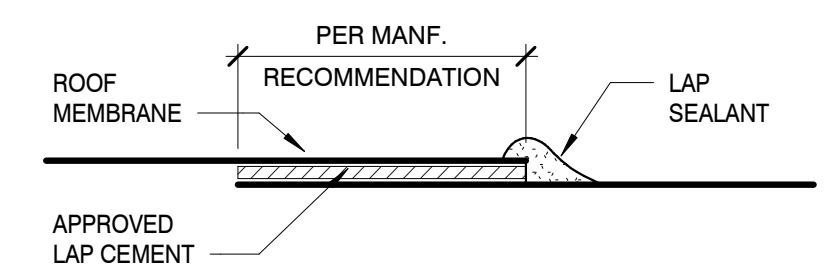


LAP SPLICE DETAIL
SCALE: 6" = 1'-0"

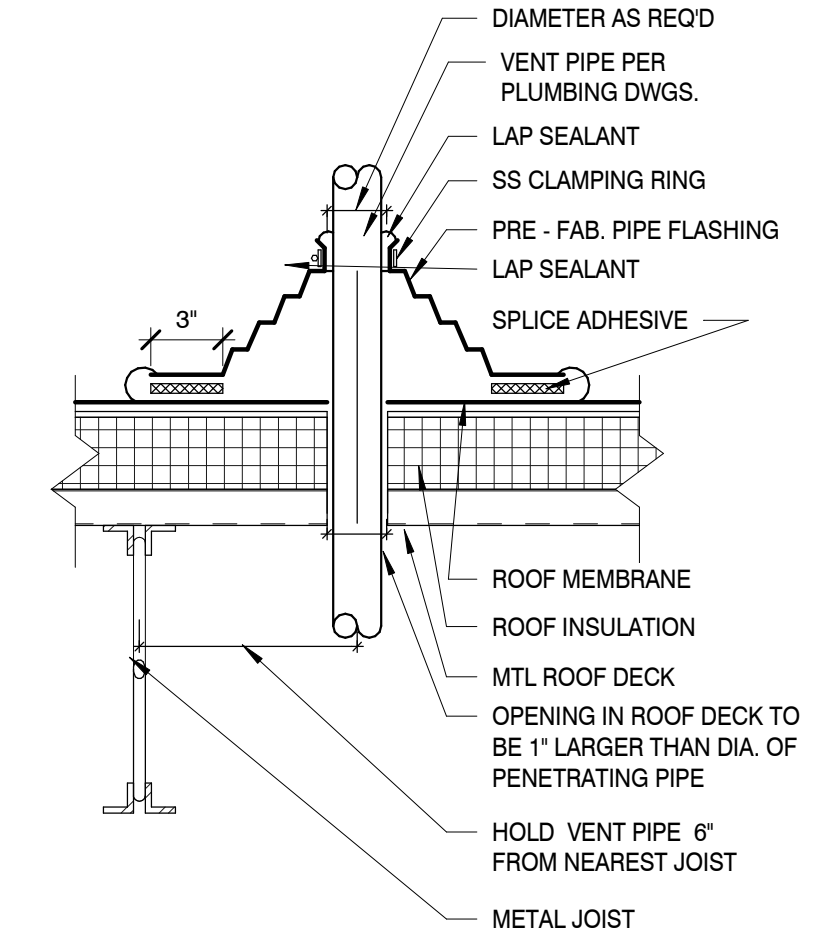


VENT PIPE DETAIL
SCALE: 1 1/2" = 1'-0"

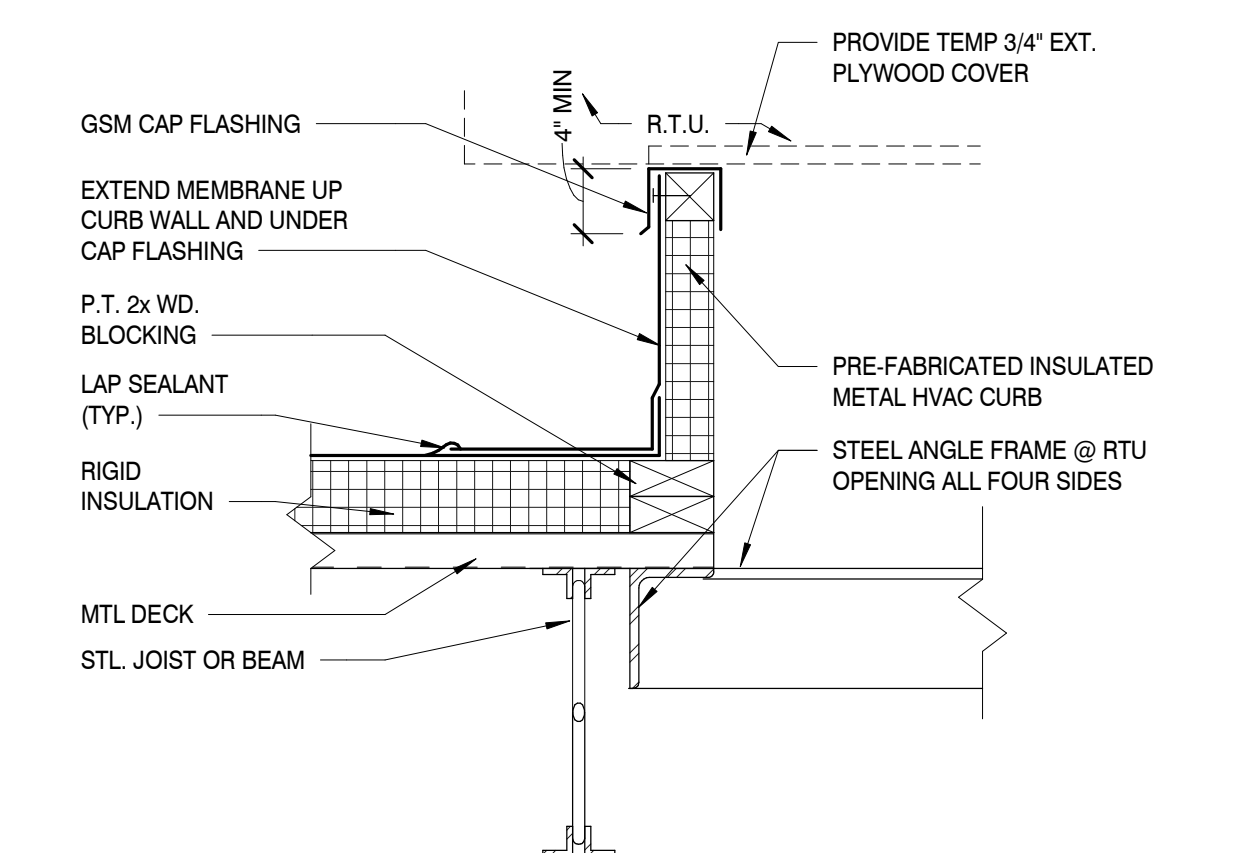

ROOF CURB DETAIL
SCALE: 1 1/2" = 1'-0"

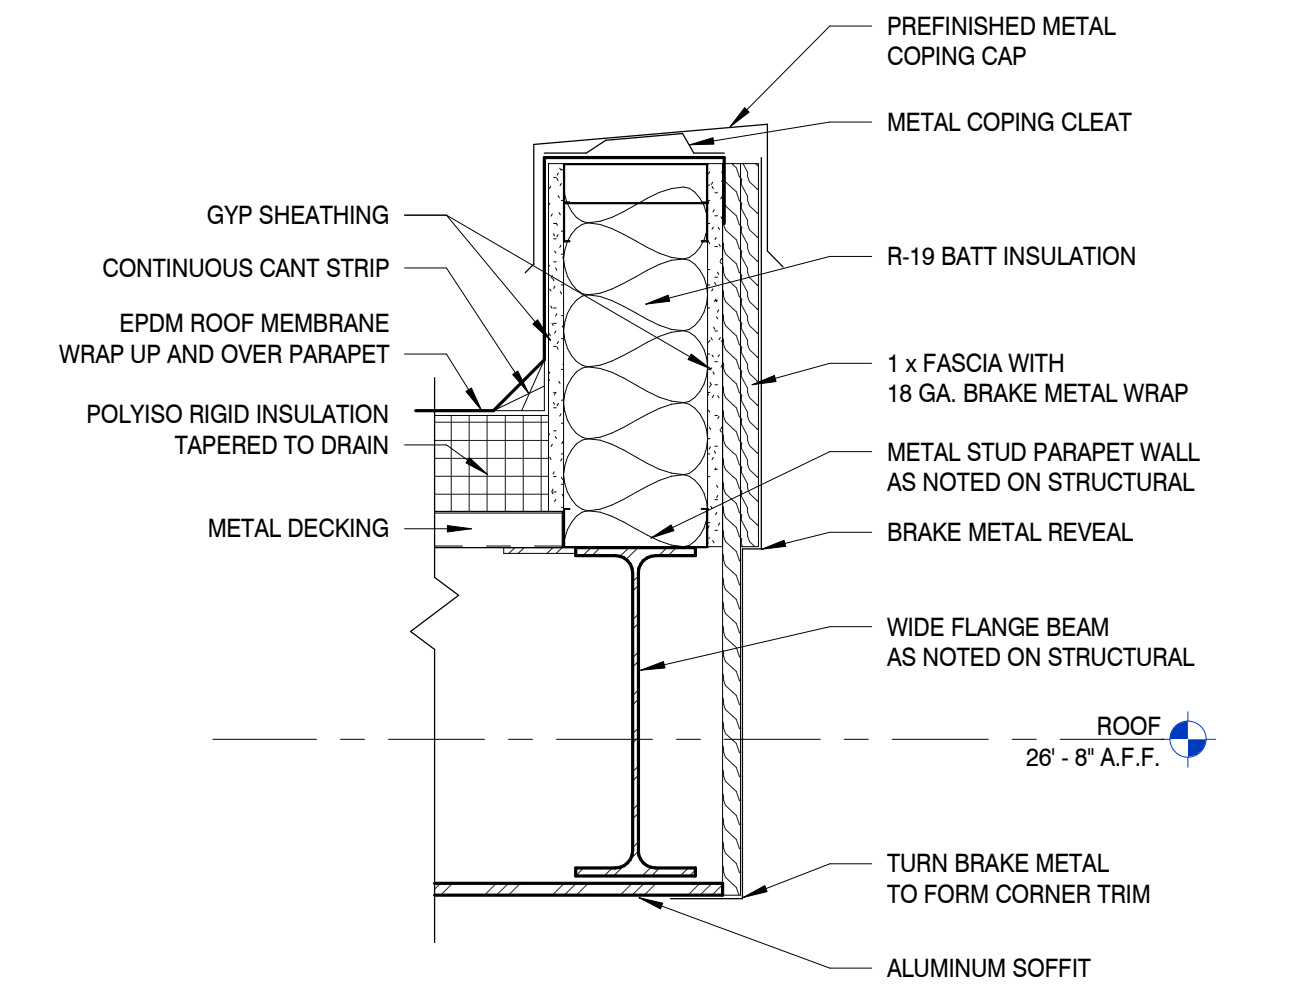


ENTRY PARAPET
SCALE: 1 1/2" = 1'-0"

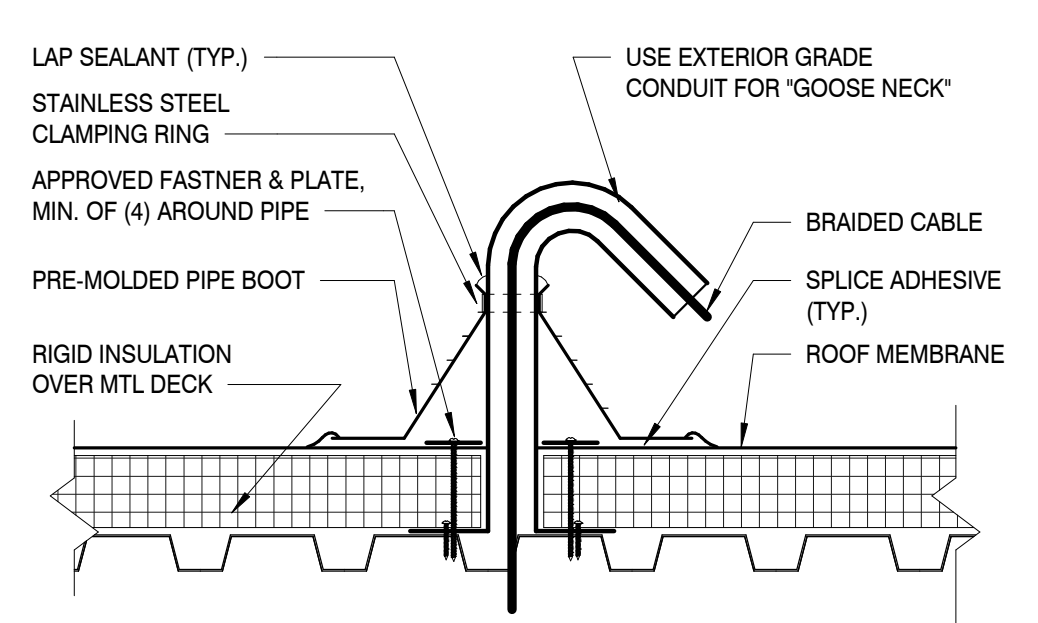

CABLE PENETRATION DETAIL
SCALE: 1 1/2" = 1'-0"

MBI COMPANIES INC.
290 N. WEISGARBER ROAD
KNOXVILLE, TN 37919
PHONE: (865) 584-0999
FAX: (865) 584-6213
WEB: mbicompanies.com

CONSULTANT

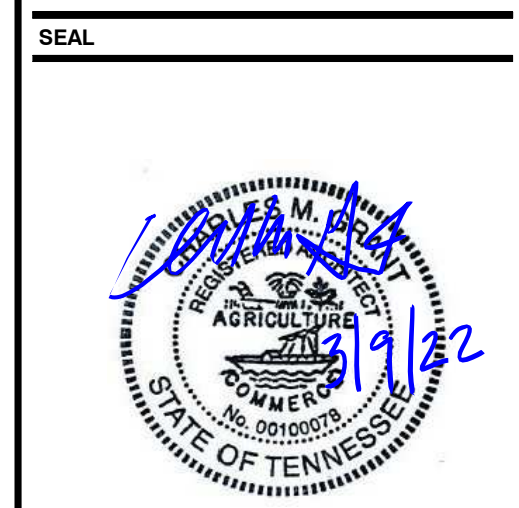

COPYRIGHT © MBI COMPANIES INC. 2021
THE DESIGN PROFESSIONAL DENIES ANY AND ALL RESPONSIBILITY AND LIABILITY FOR PROBLEMS WHICH ARISE FROM FAILURE TO FOLLOW THESE PLANS, SPECIFICATIONS AND THE DESIGN INTENT THEY CONVEY, OR PROBLEMS WHICH ARISE FROM OTHERS' FAILURE TO OBTAIN AND/OR FOLLOW THE DESIGN PROFESSIONAL'S GUIDANCE WITH RESPECT TO ANY ERRORS, OMISSIONS, INCONSISTENCIES, AMBIGUITIES OR CONFLICTS WHICH ARE ALLEGED.

PROJECT INFORMATION

PROJECT:
AN ADDITION & RENOVATION TO: NORRIS MIDDLE SCHOOL

PROJECT ADDRESS:
5 NORRIS SQUARE,
NORRIS, TN 37828
PROJECT NO.: 210042-04

ACTIVE DESIGN PHASE

<input type="checkbox"/>	FOR REVIEW ONLY
<input type="checkbox"/>	FOR PERMITTING ONLY
<input type="checkbox"/>	SCHEMATIC DESIGN
<input type="checkbox"/>	DESIGN DEVELOPMENT
<input type="checkbox"/>	CONSTRUCTION BIDDING
<input checked="" type="checkbox"/>	CONSTRUCTION DOCUMENTS
<input type="checkbox"/>	AS-BUILT RECORD SET


REVISION INFORMATION

NO.	DATE	DESCRIPTION
2	03/09/2022	Addendum #2

KEY PLAN

SHEET INFORMATION


SHEET ISSUED:	02/04/2022
DESIGNED BY:	CMG
DRAWN BY:	KEF
REVIEWED BY:	CMG
SHEET TITLE:	

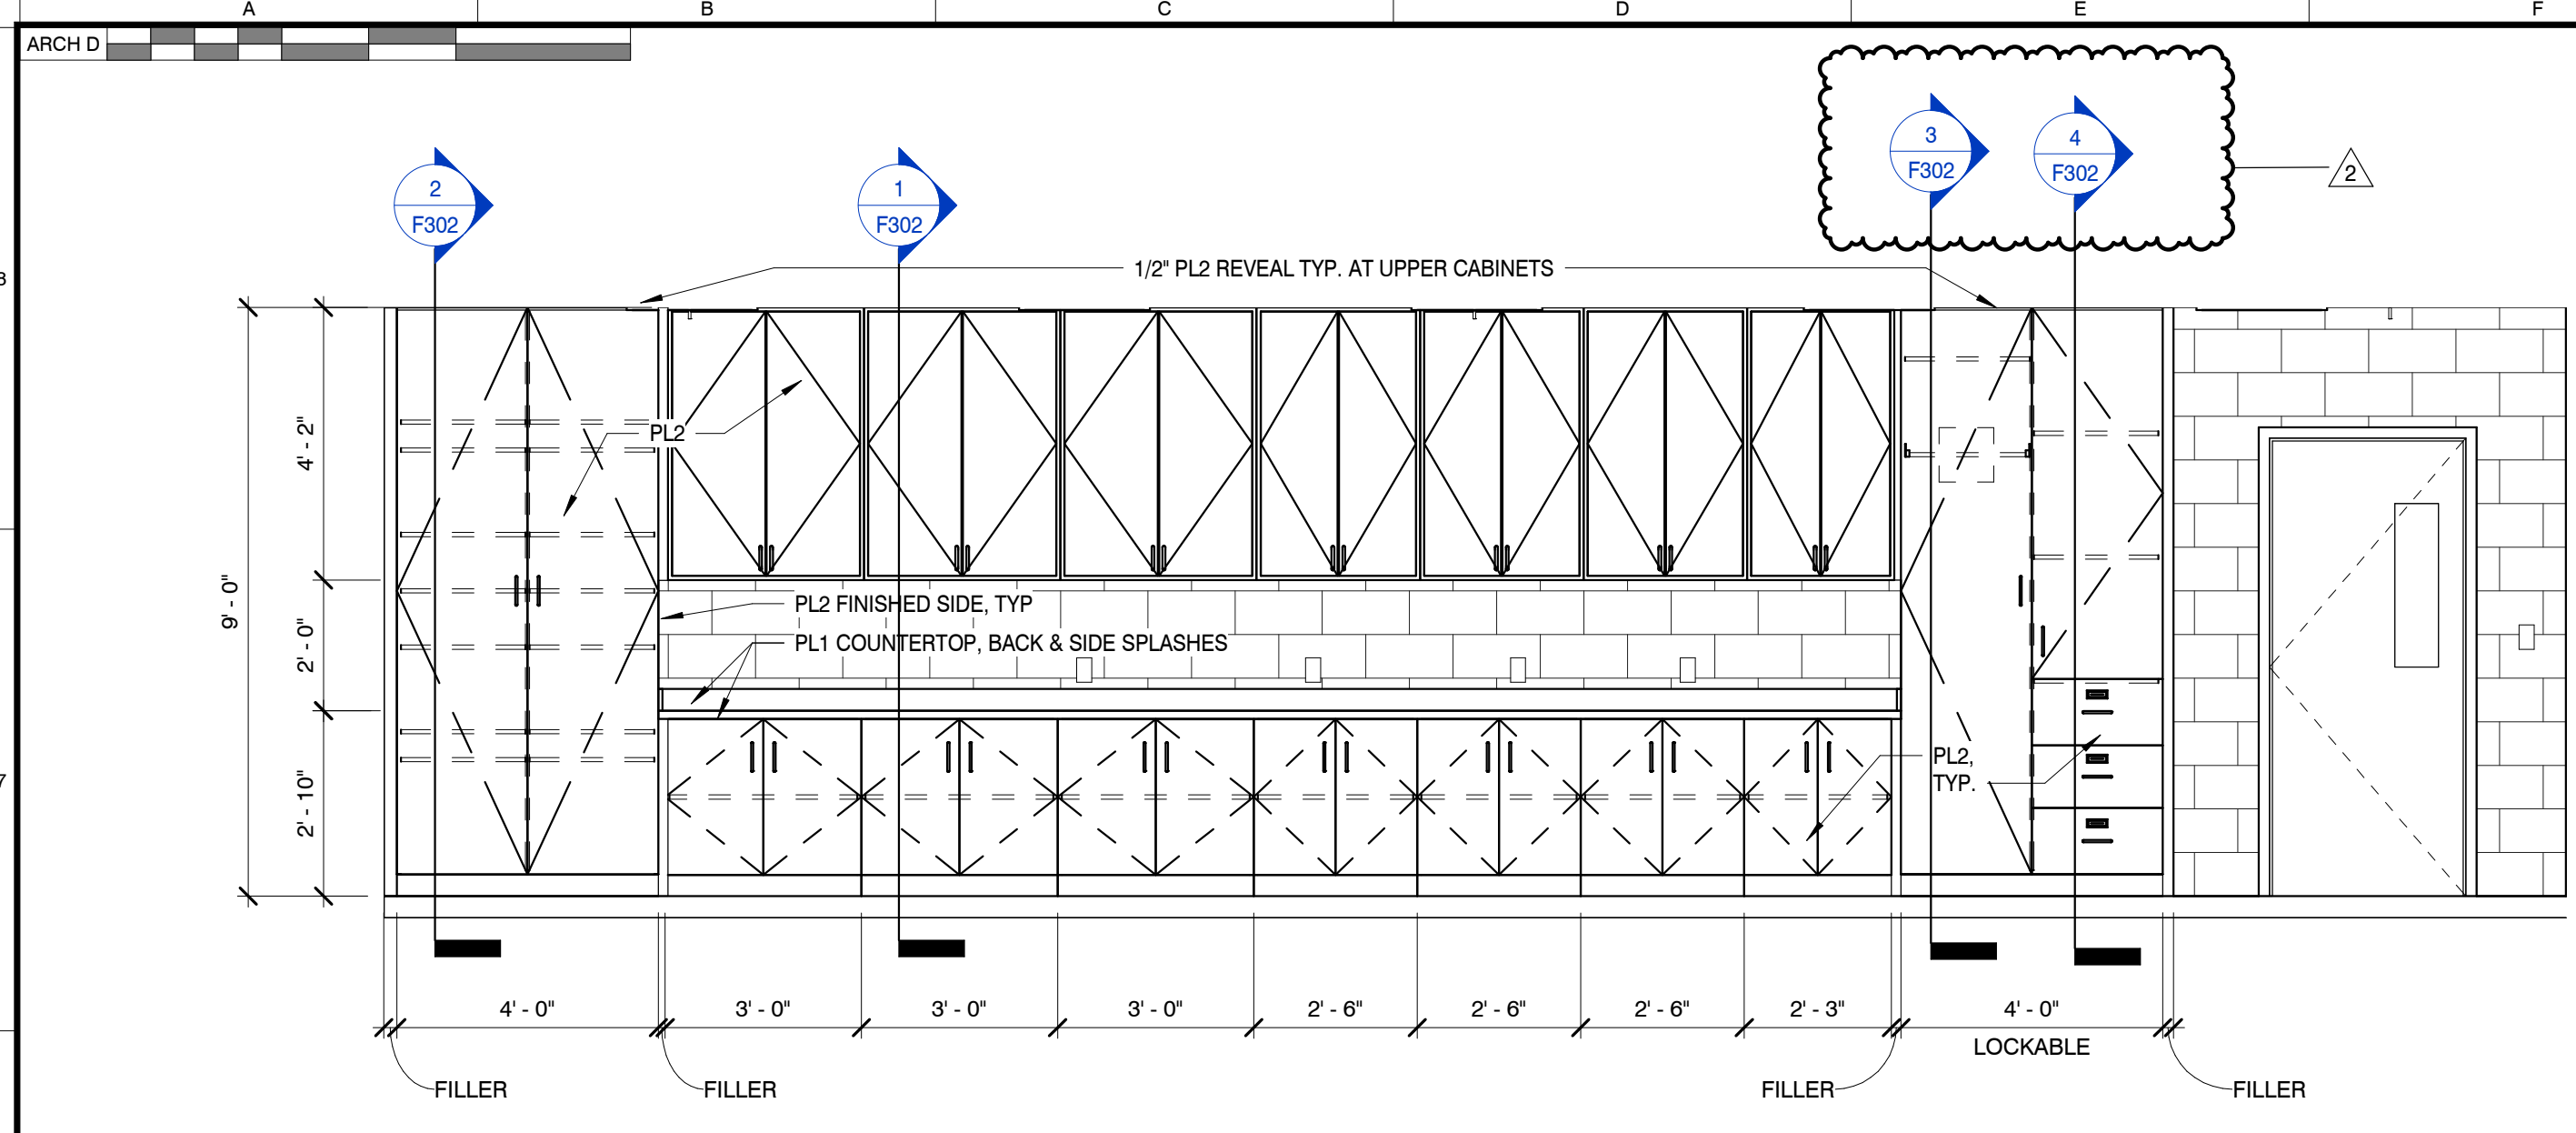

MILLWORK ELEVATION

SCALE : 3/8" = 1'-0"


1

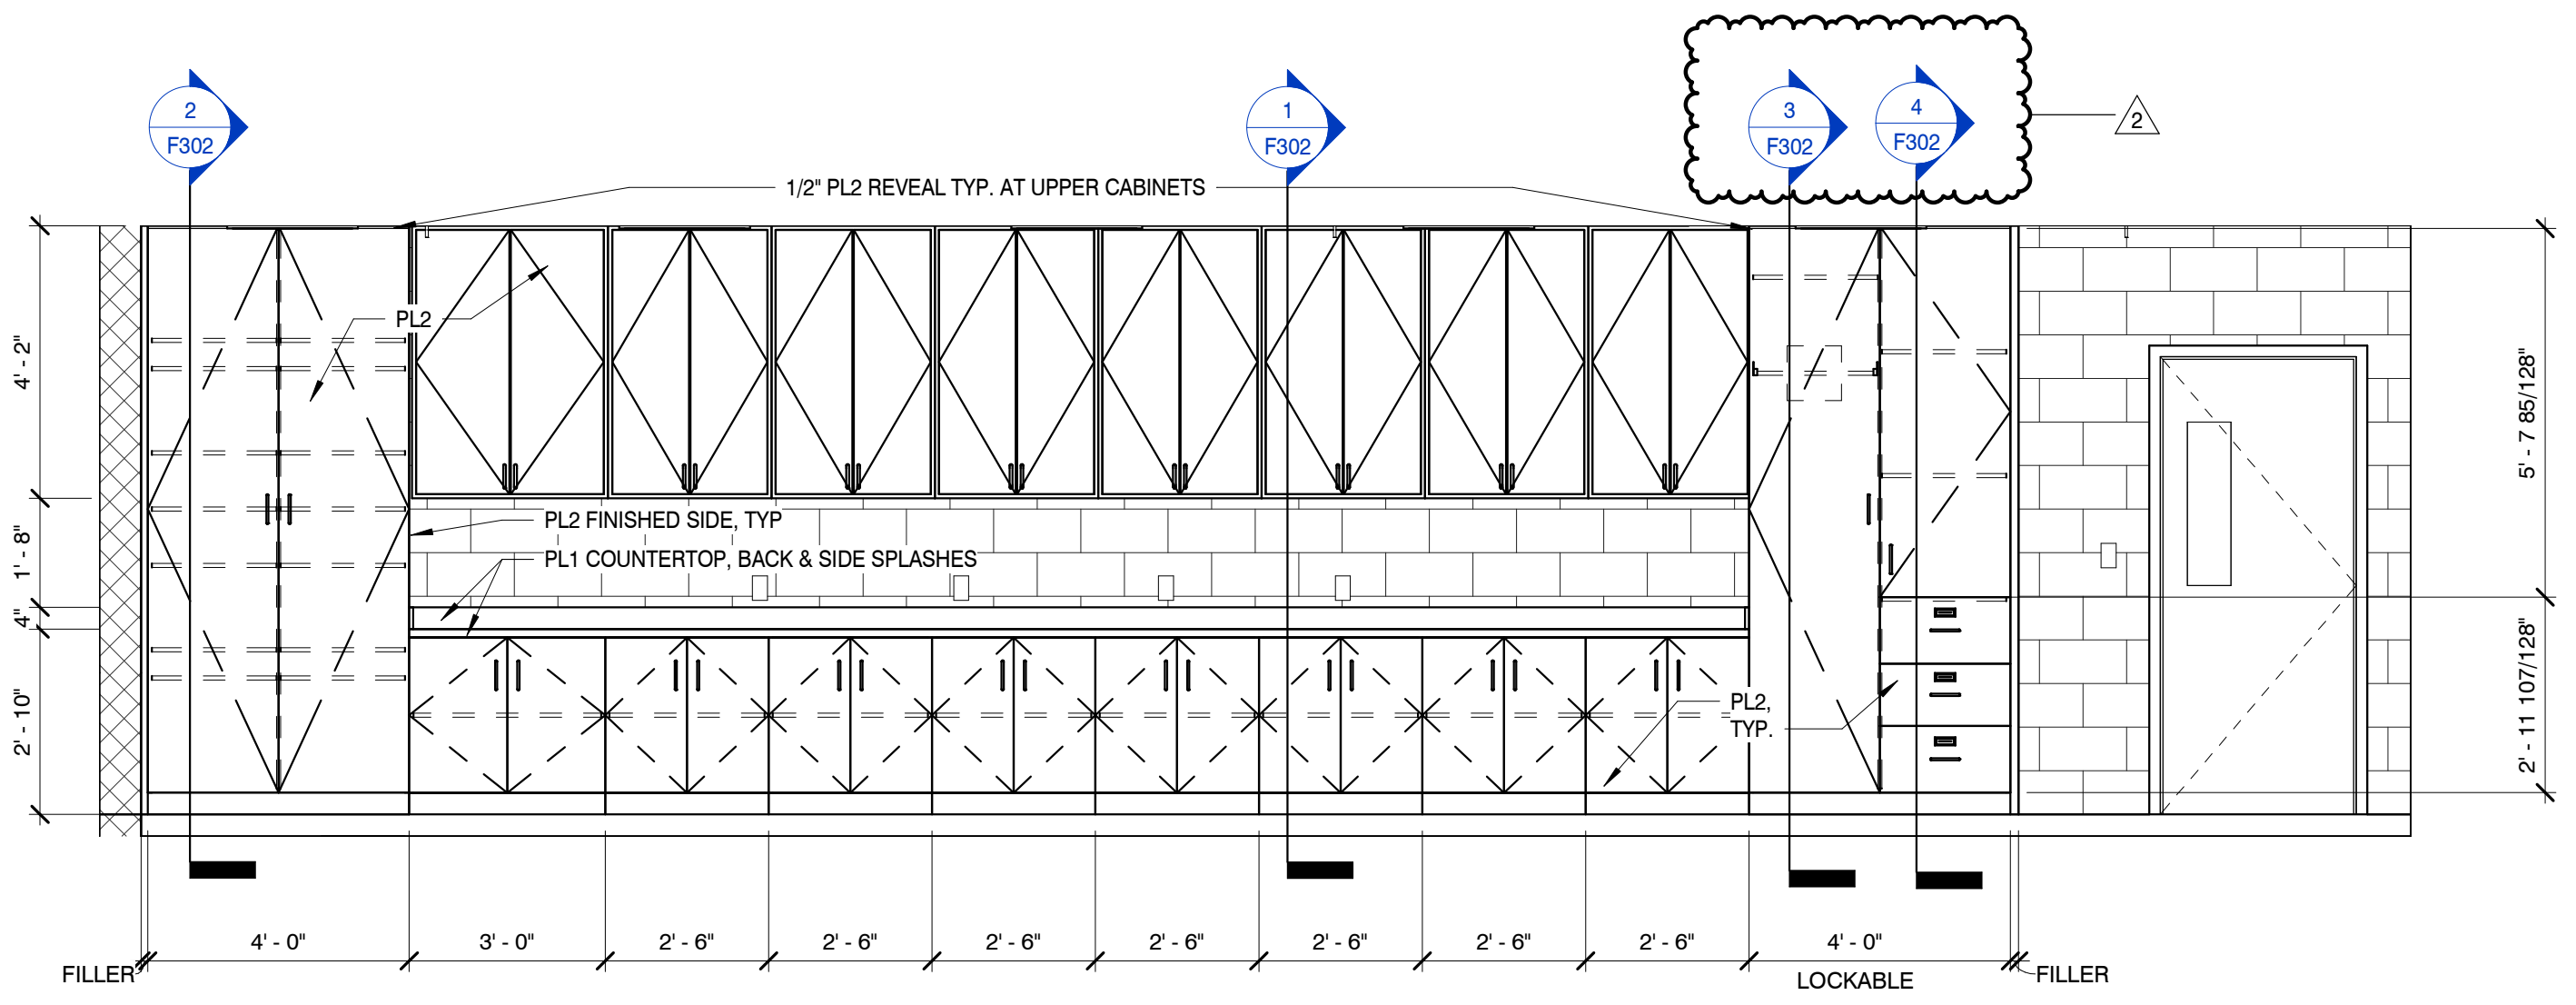

MILLWORK ELEVATION

SCALE : 3/8" = 1'-0"

2

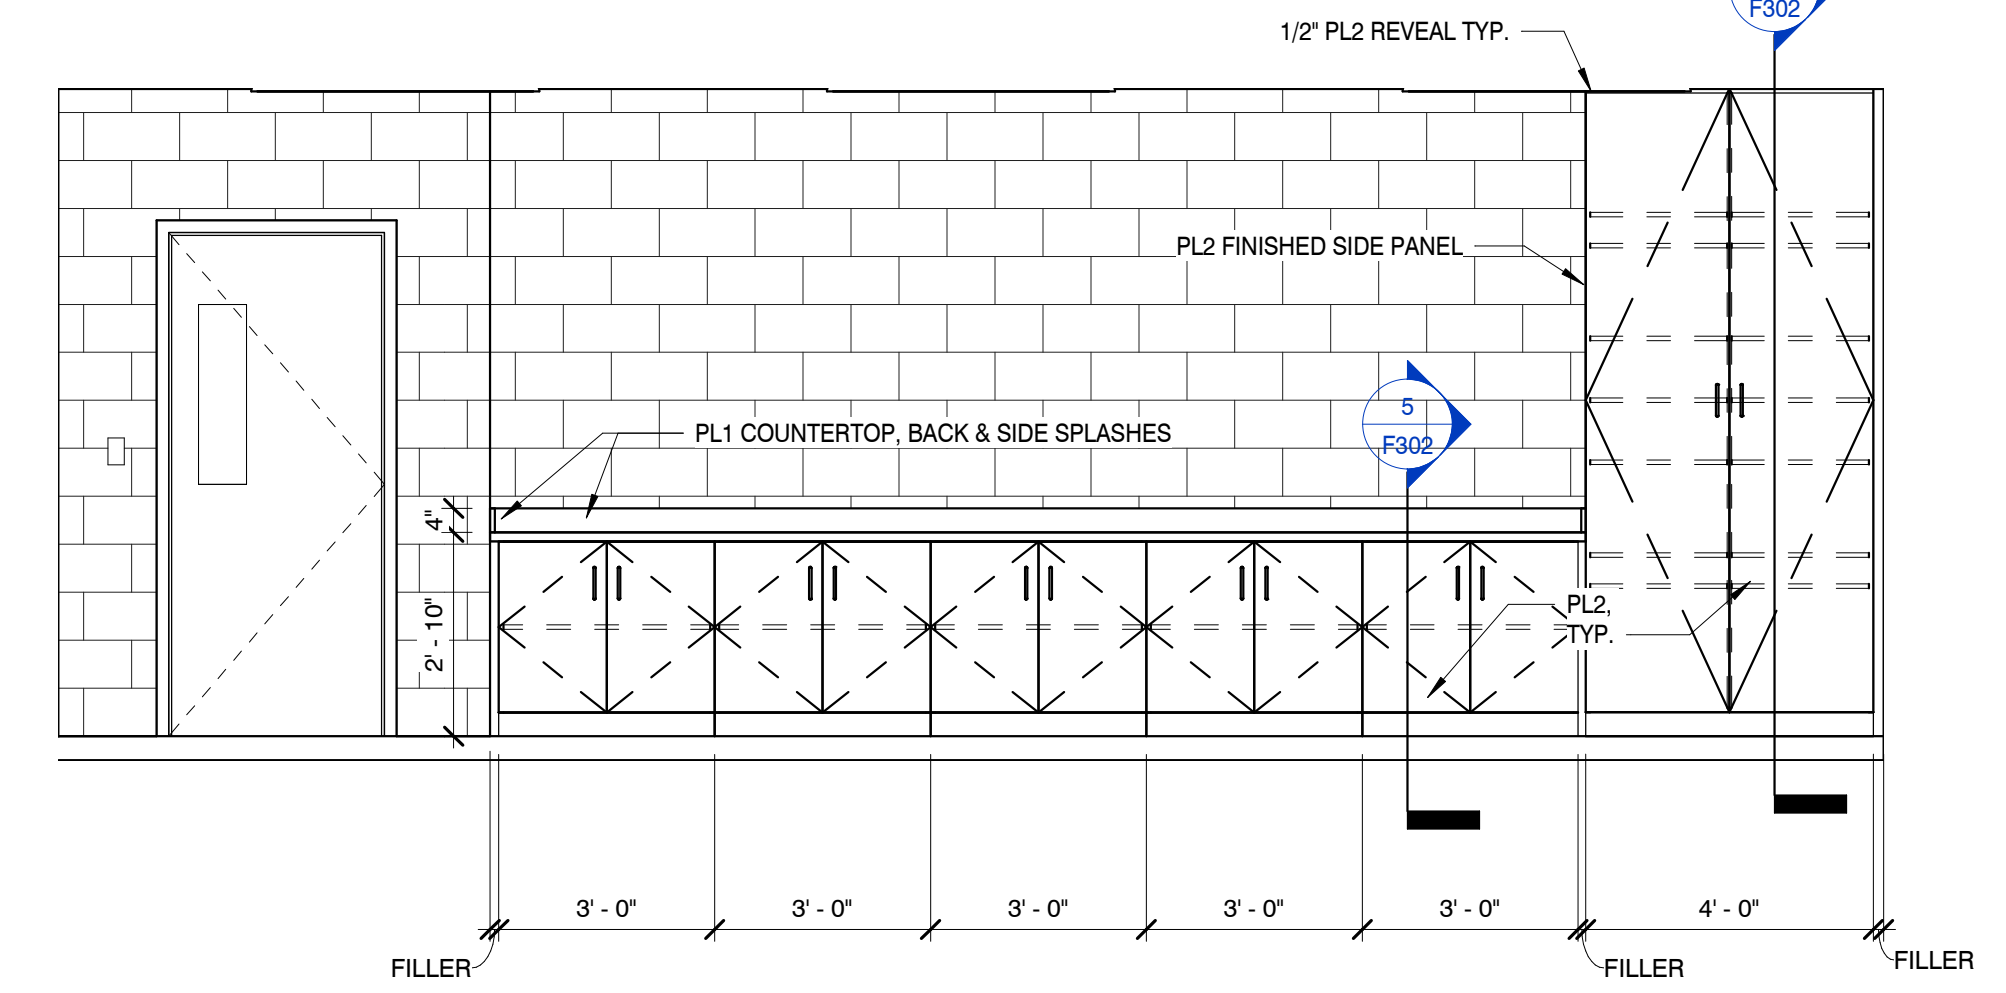

MILLWORK ELEVATION

SCALE : 3/8" = 1'-0"

3

GENERAL MILLWORK NOTES

- FURNISH ALL LABOR, MATERIALS, EQUIPMENT, AND SUPERVISION NECESSARY TO FABRICATE MILLWORK.
- SEE DRAWINGS, SCHEDULES AND DETAILS FOR LOCATION, QUANTITY AND DESIGN OF MILLWORK REQUIRED.
- MILLWORK IS DEFINED AS ALL SHOP FABRICATED CABINETS AND COUNTERTOPS, INCLUDING THE INSTALLATION OF THEM AS NECESSARY TO COMPLETE THE WORK.
- ALL WORK SHALL CONFORM TO THE QUALITY STANDARDS OF THE ARCHITECTURAL WOODWORK INDUSTRY (AWI) FOR CUSTOM GRADE.
- FURNISH ALL ITEMS OF ROUGH HARDWARE AND WOOD BLOCKING OR OTHER ACCESSORIES SHOWN OR REQUIRED TO PROPERLY SECURE THE WORK IN PLACE.
- CABINET MANF. SHALL HAVE A PROVEN HISTORY OF PRODUCING FINE QUALITY MILLWORK.
- CONTRACTOR SHALL NOT DELIVER OR INSTALL MILLWORK UNTIL BUILDING IS ENCLOSED, WET WORK IS COMPLETE AND HVAC SYSTEM IS OPERATING AND MAINTAINING TEMPERATURE AND RELATIVE HUMIDITY AT OCCUPANCY LEVELS DURING THE REMAINDER OF CONSTRUCTION PERIOD.
- CONTRACTOR TO FIELD VERIFY WHERE MILLWORK IS INDICATED TO FIT TO OTHER CONSTRUCTION. VERIFY DIMENSIONS AND INDICATE MEASUREMENTS ON SHOP DRAWINGS.
- CONTRACTOR TO COORDINATE FABRICATION SCHEDULE WITH CONSTRUCTION PROGRESS TO AVOID DELAYING THE WORK.
- CONTRACTOR TO LOCATE CONCEALED FRAMING, BLOCKING AND REINFORCEMENTS THAT SUPPORT WOODWORK BY FIELD MEASURING BEFORE BEING ENCLOSED AND INDICATE MEASUREMENTS ON SHOP DRAWINGS.
- CONTRACTOR TO COORDINATE SIZES AND LOCATIONS OF FRAMING, BLOCKING, FURRING, REINFORCEMENTS AND OTHER RELATED UNITS OF WORK AS INDICATED TO ENSURE THAT ARCHITECTURAL WOODWORK CAN BE SUPPORTED AND INSTALLED AS INDICATED.



MBI COMPANIES INC.
290 N. WEISGARBER ROAD
KNOXVILLE, TN 37919
PHONE: (865) 584-0999
FAX: (865) 584-6213
WEB: mbicompanies.com

CONSULTANT

SEAL



COPYRIGHT © MBI COMPANIES INC. 2021
THE DESIGN PROFESSIONAL DENIES ANY AND ALL RESPONSIBILITY AND LIABILITY FOR PROBLEMS WHICH ARISE FROM FAILURE TO FOLLOW THESE PLANS, SPECIFICATIONS AND THE DESIGN INTENT THEY CONVEY, OR PROBLEMS WHICH ARISE FROM OTHERS' FAILURE TO OBTAIN AND/OR FOLLOW THE DESIGN PROFESSIONAL'S GUIDANCE WITH RESPECT TO ANY ERRORS, OMISSIONS, INCONSISTENCIES, AMBIGUITIES OR CONFLICTS WHICH ARE ALLEGED.

PROJECT INFORMATION

PROJECT:
AN ADDITION & RENOVATION TO: NORRIS MIDDLE SCHOOL

PROJECT ADDRESS:
5 NORRIS SQUARE, NORRIS, TN 37828

PROJECT NO.: **210042-04**

ACTIVE DESIGN PHASE

<input type="checkbox"/>	FOR REVIEW ONLY
<input type="checkbox"/>	FOR PERMITTING ONLY
<input type="checkbox"/>	SCHEMATIC DESIGN
<input type="checkbox"/>	DESIGN DEVELOPMENT
<input type="checkbox"/>	CONSTRUCTION BIDDING
<input checked="" type="checkbox"/>	CONSTRUCTION DOCUMENTS
<input type="checkbox"/>	AS-BUILT RECORD SET

REVISION INFORMATION

NO.	DATE	DESCRIPTION
2	03/09/2022	Addendum #2

KEY PLAN




SHEET INFORMATION

SHEET ISSUED: 02/04/2022
DESIGNED BY: KEF
DRAWN BY: MMW/AJA
REVIEWED BY: CMG
SHEET TITLE:


MILLWORK ELEVATIONS

SHEET NO.: **F301**


C:\Users\kaj\OneDrive\Documents\210042-04_Leahy\MBI\210042-04.dwg
3/9/2022 3:28:52 PM

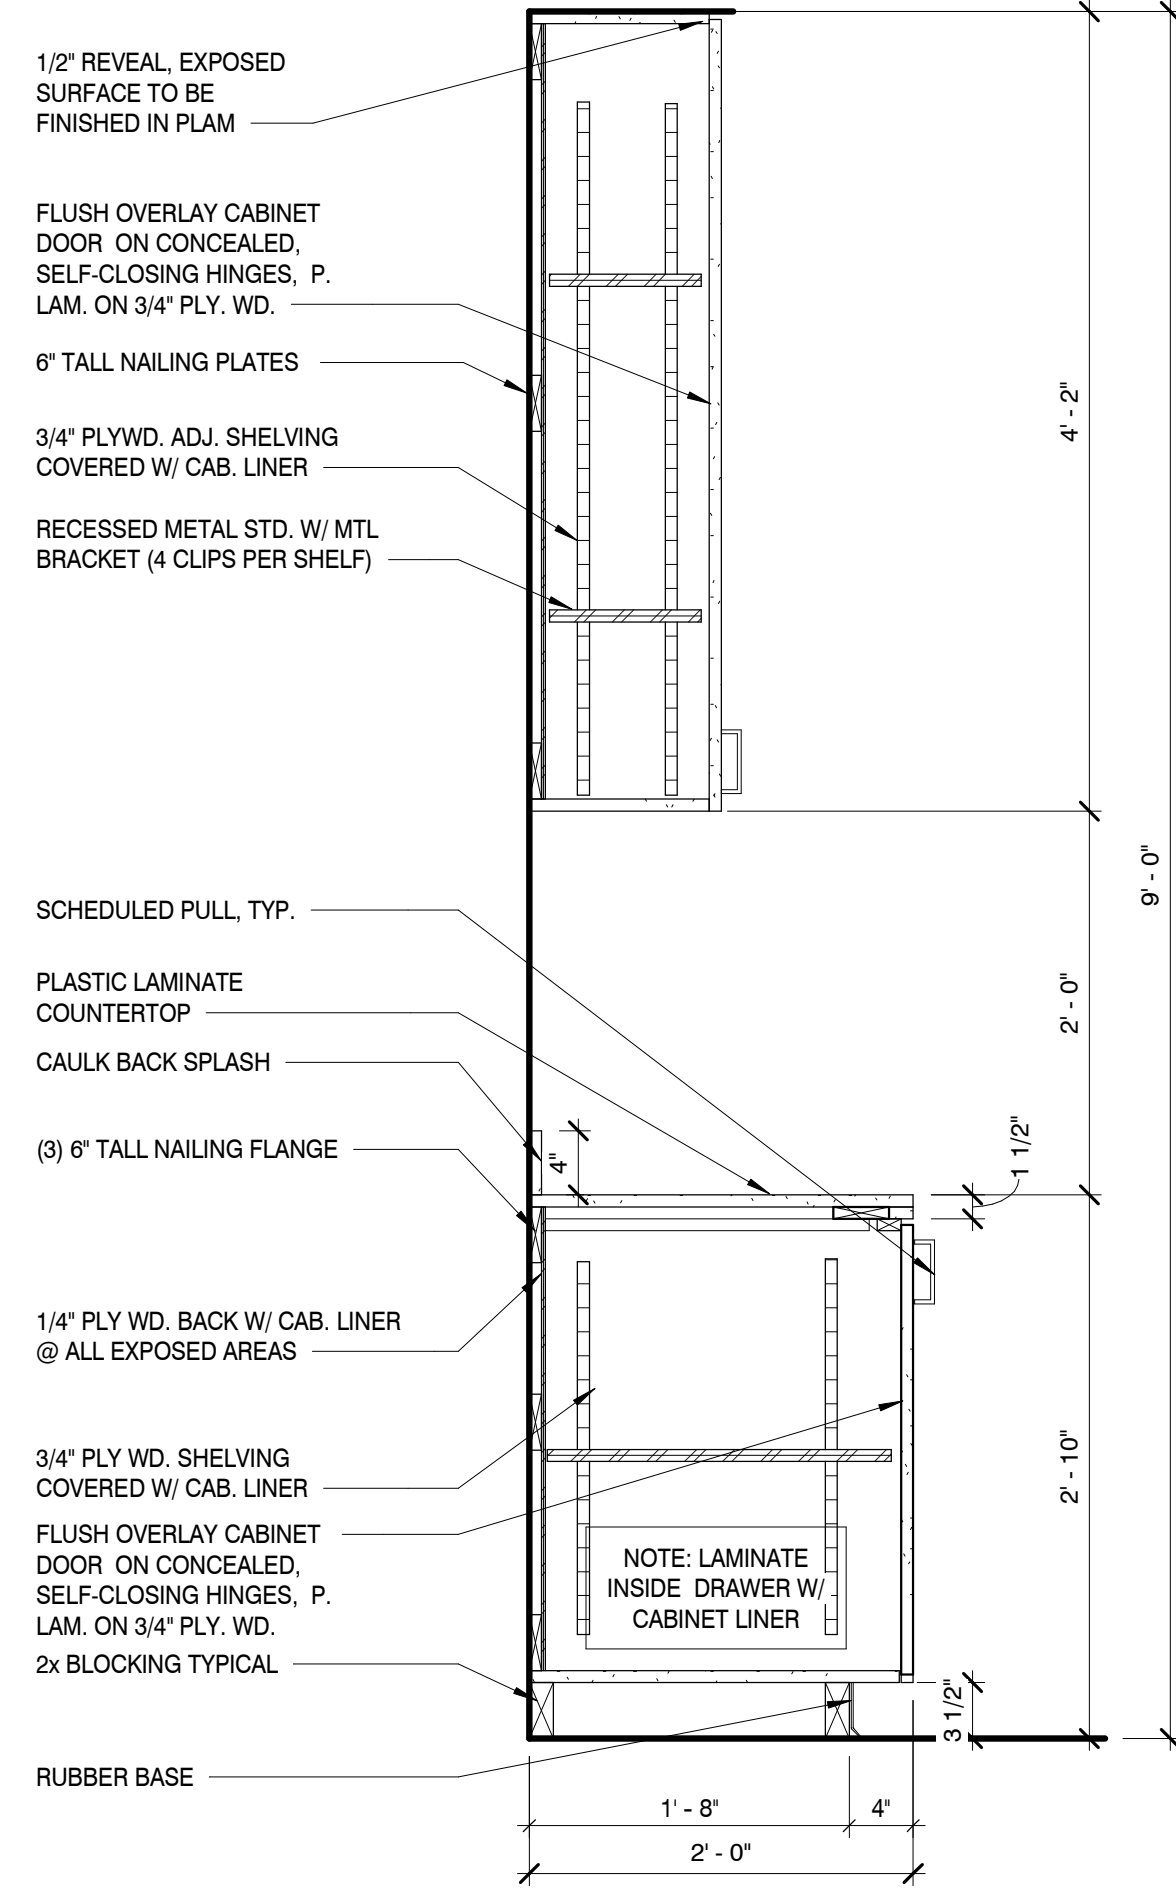


MILLWORK SECTION 1
SCALE: 1" = 1'-0"

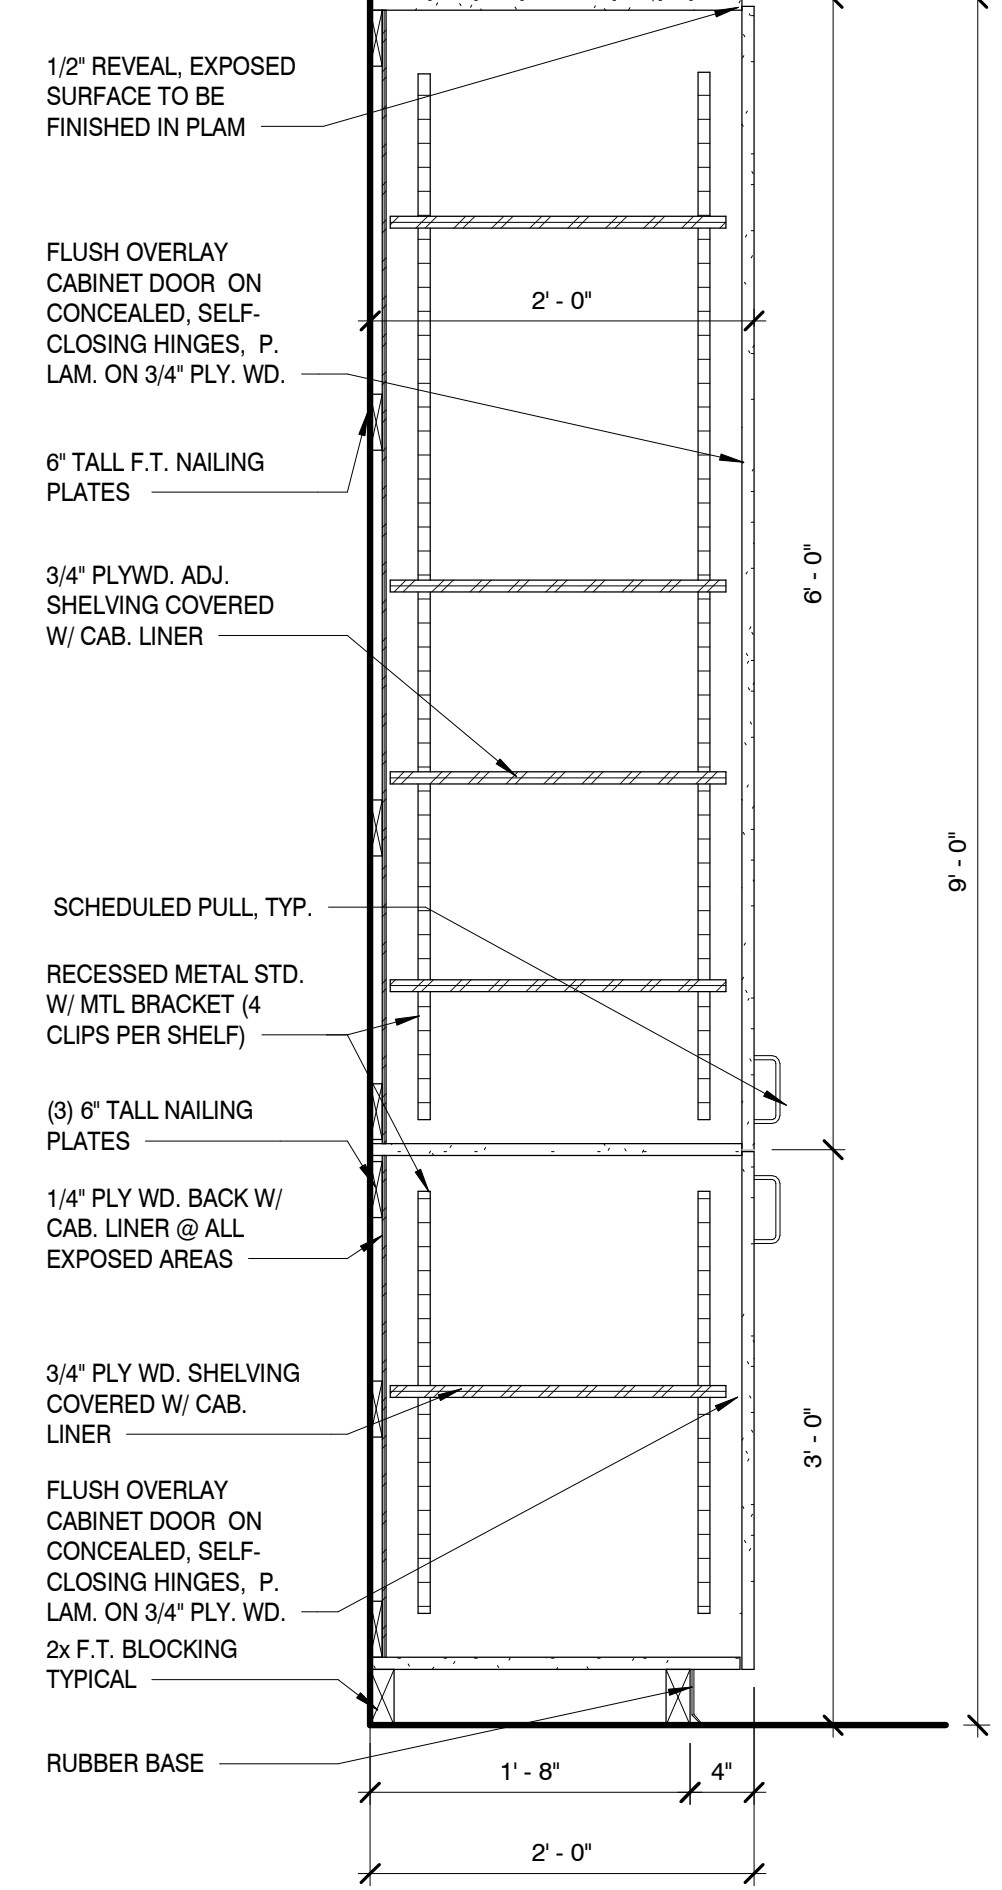


MILLWORK SECTION 2
SCALE: 1" = 1'-0"

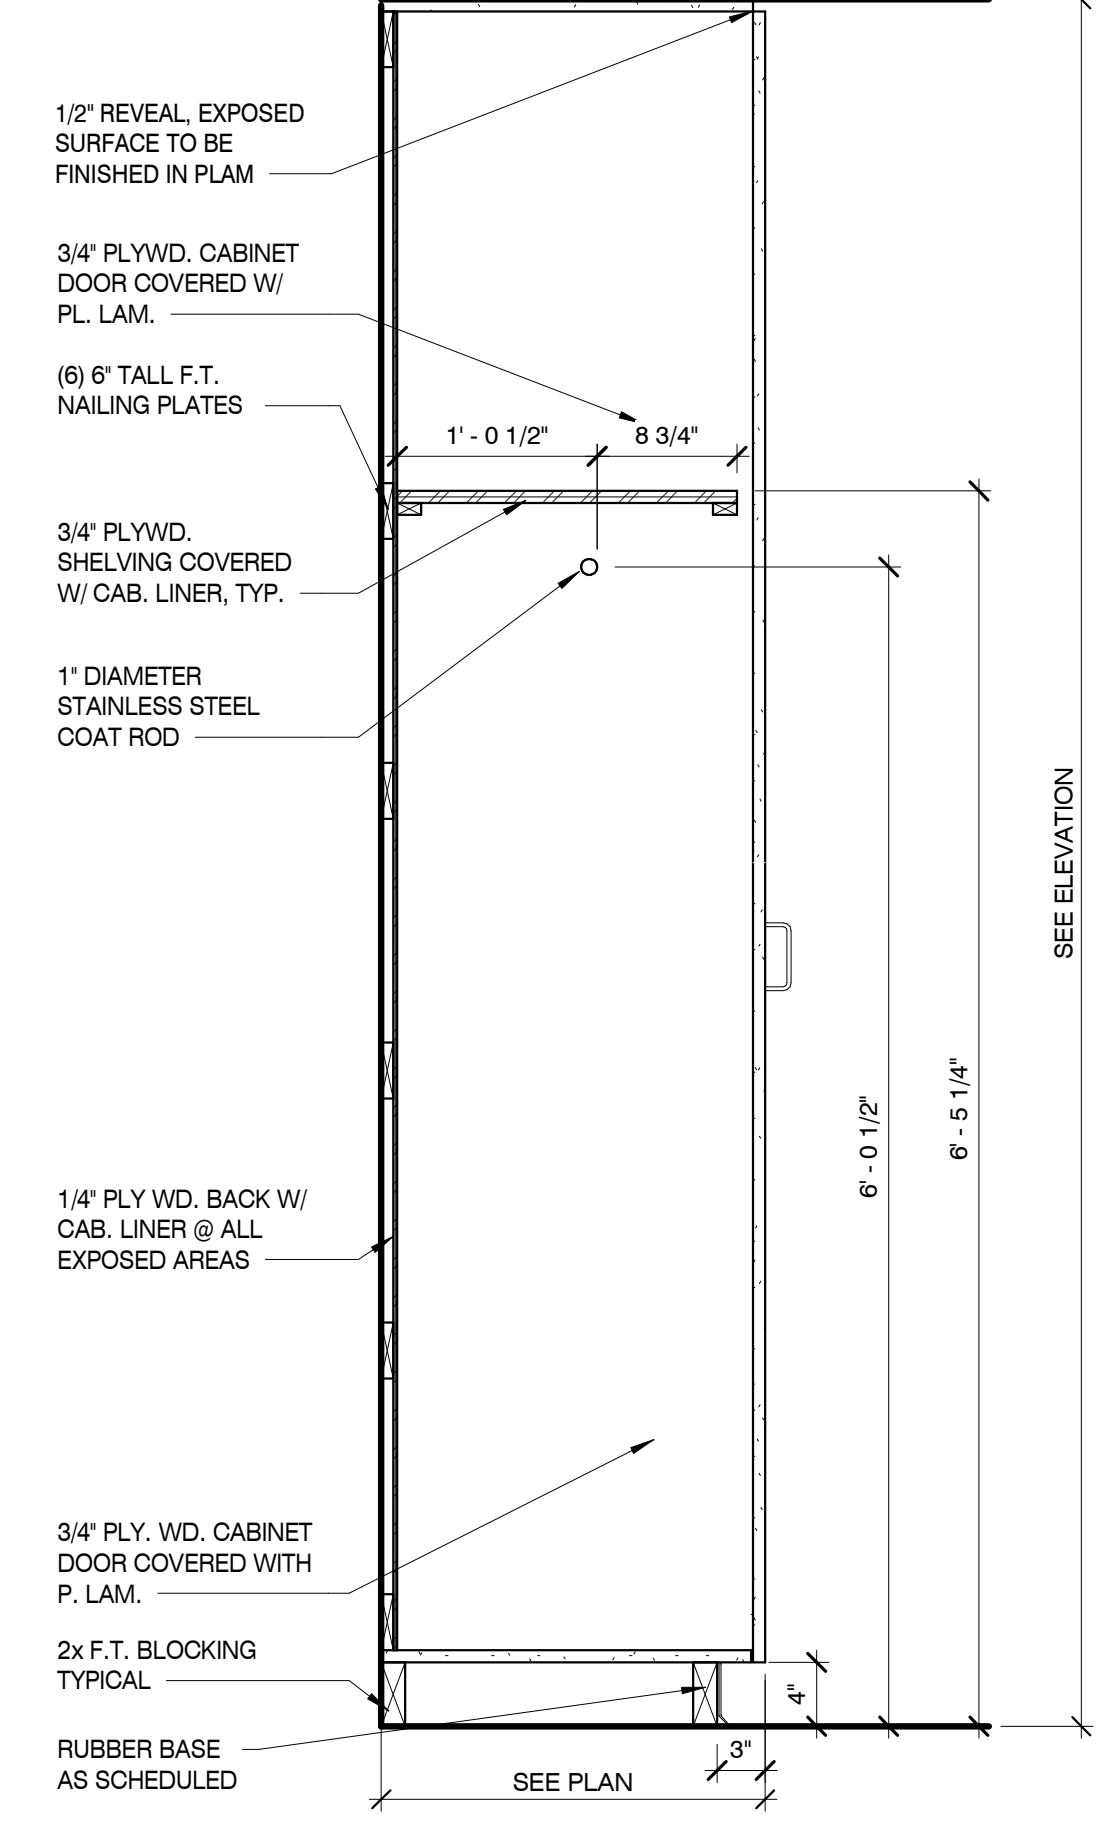


MILLWORK SECTION 3
SCALE: 1" = 1'-0"

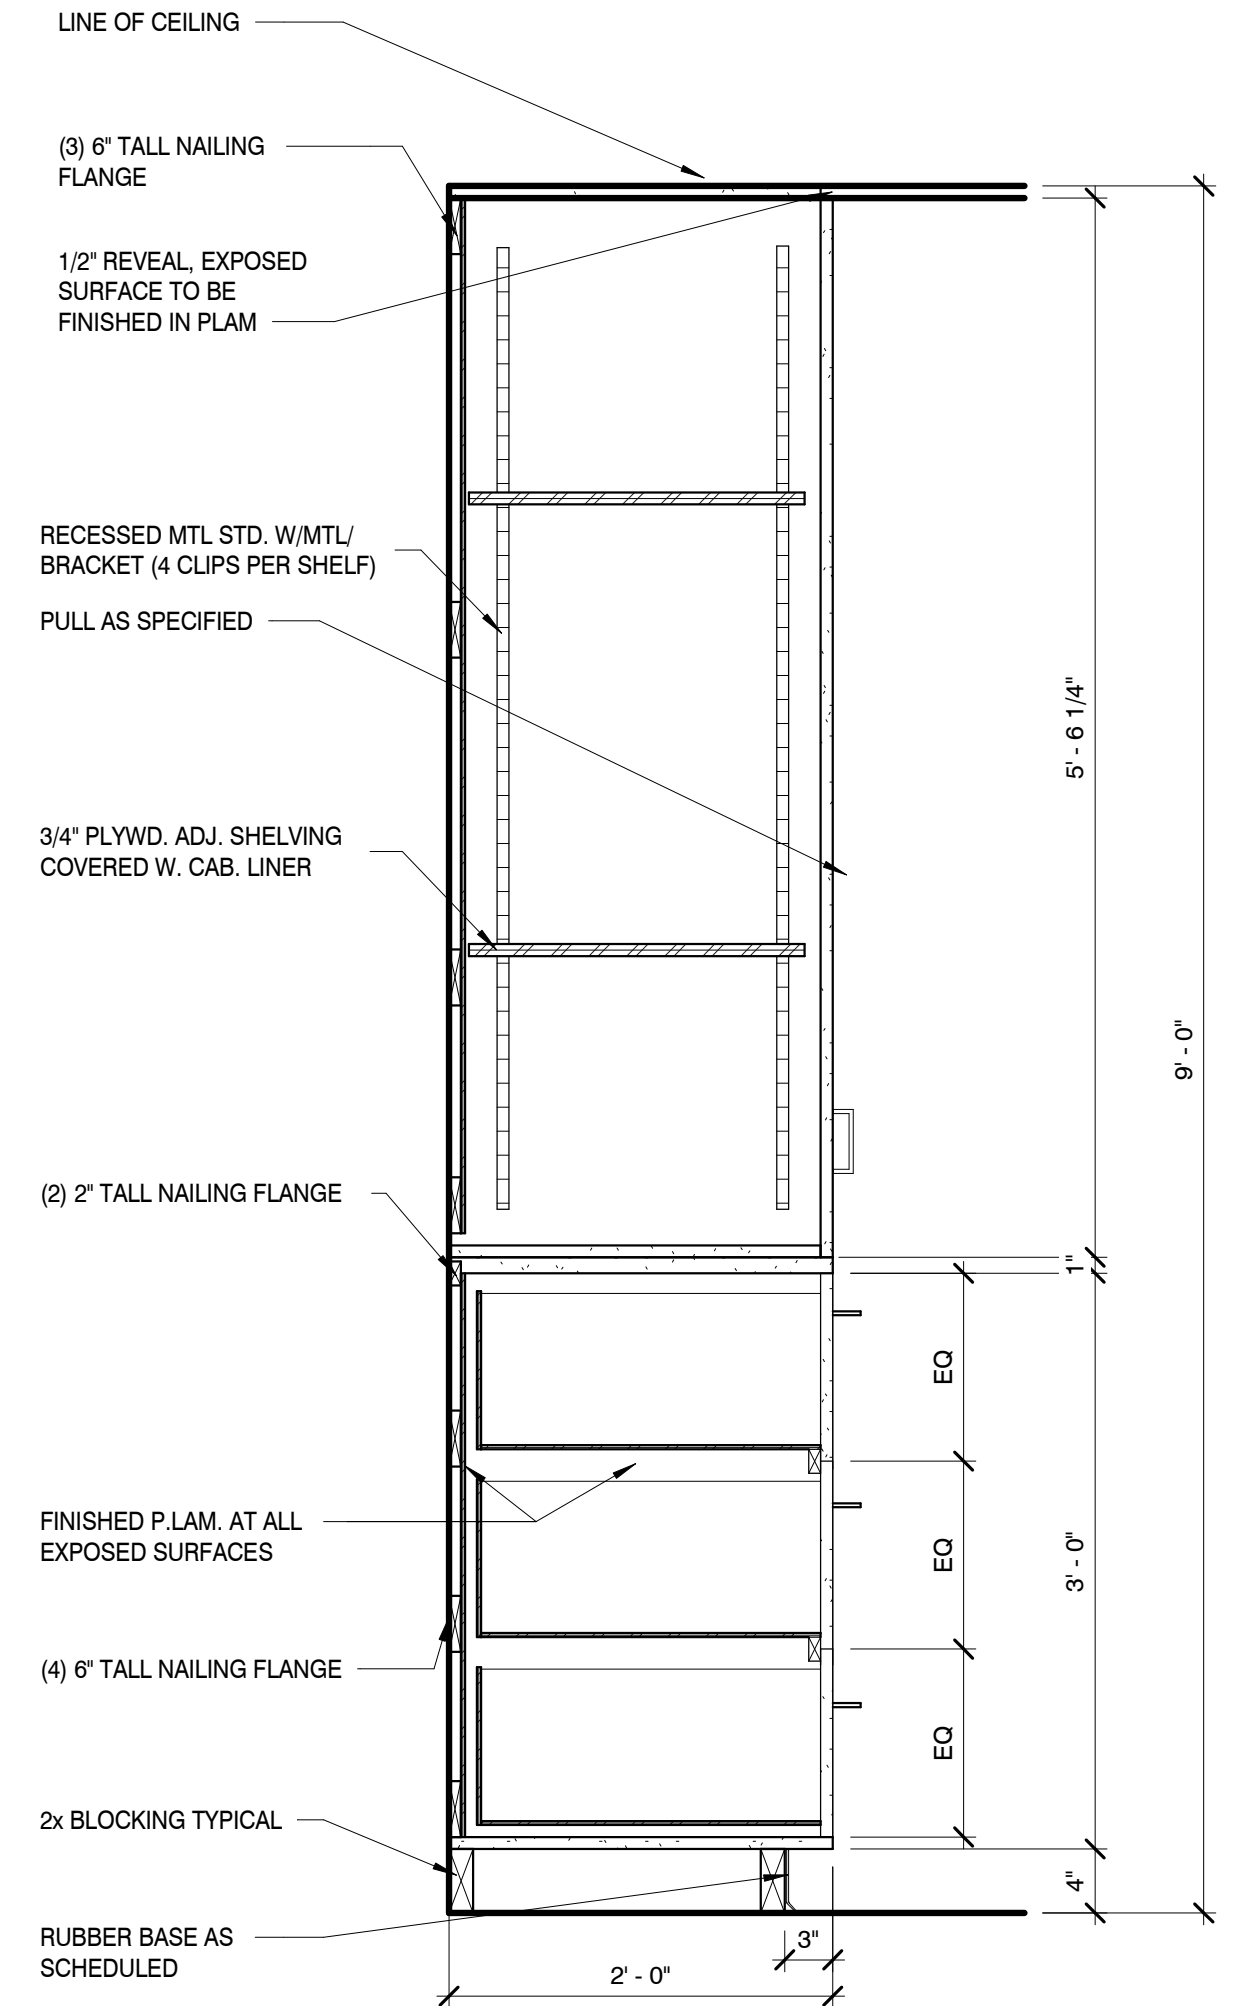

MILLWORK SECTION 4
SCALE: 1" = 1'-0"

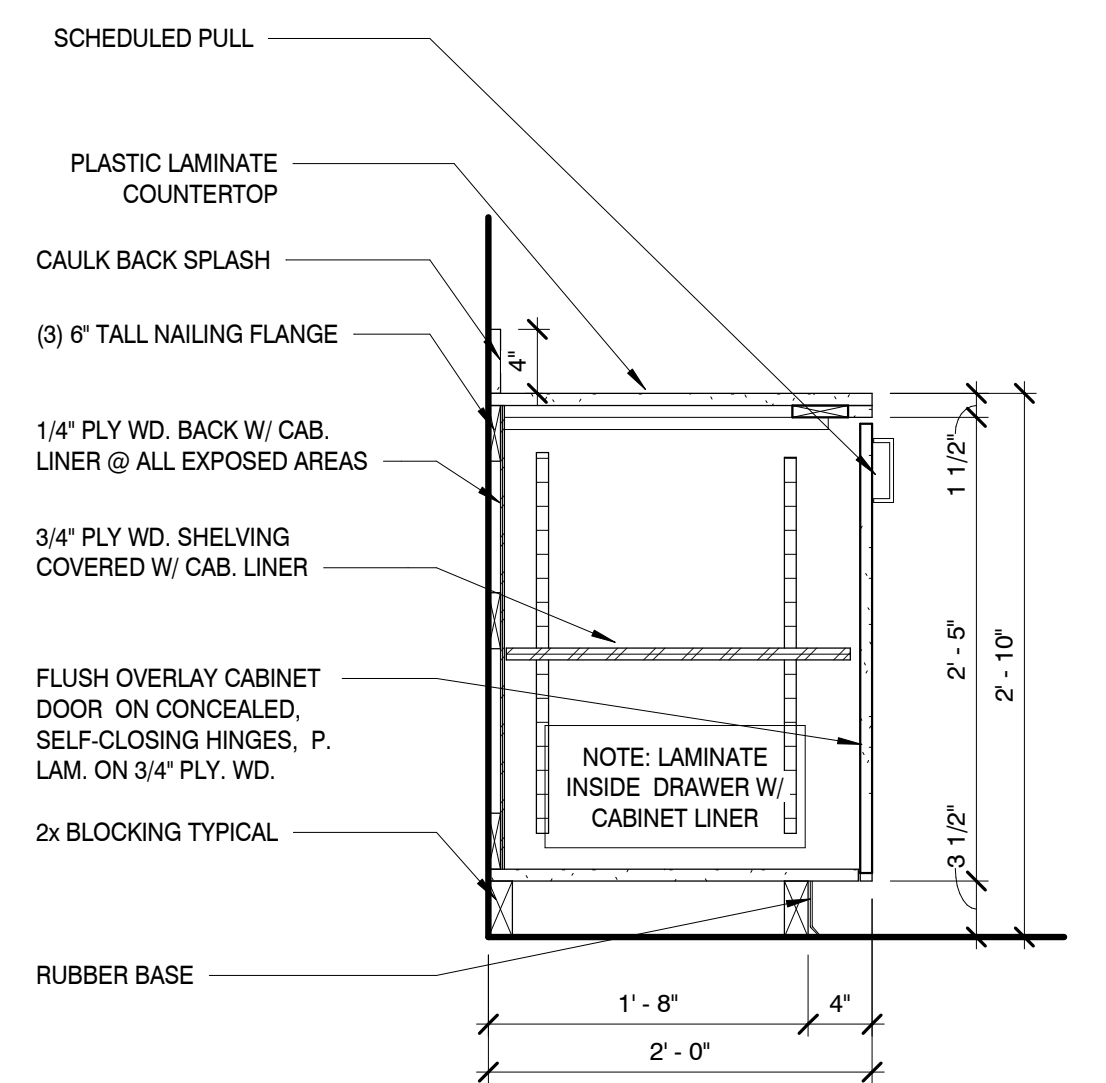

MILLWORK SECTION 5
SCALE: 1" = 1'-0"

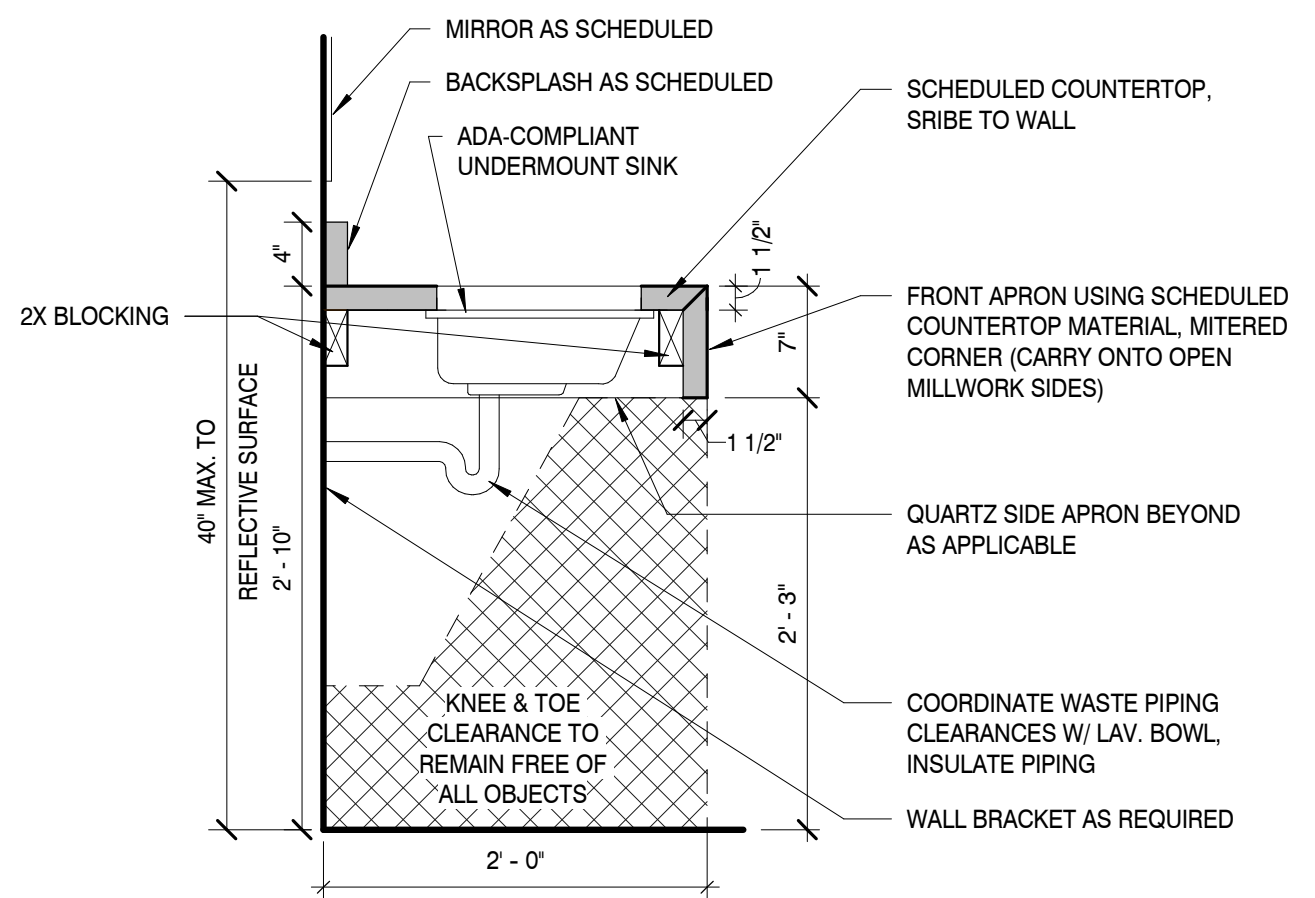

MILLWORK SECTION 6
SCALE: 1" = 1'-0"



COPYRIGHT © MBI COMPANIES INC. 2021
THE DESIGN PROFESSIONAL DENIES ANY AND ALL RESPONSIBILITY AND LIABILITY FOR PROBLEMS WHICH ARISE FROM FAILURE TO FOLLOW THESE PLANS, SPECIFICATIONS AND THE DESIGN INTENT THEY CONVEY, OR PROBLEMS WHICH ARISE FROM OTHERS' FAILURE TO OBTAIN AND/OR FOLLOW THE DESIGN PROFESSIONAL'S GUIDANCE WITH RESPECT TO ANY ERRORS, OMISSIONS, INCONSISTENCIES, AMBIGUITIES OR CONFLICTS WHICH ARE ALLEGED.

PROJECT INFORMATION

PROJECT: AN ADDITION & RENOVATION TO: NORRIS MIDDLE SCHOOL

PROJECT ADDRESS: 5 NORRIS SQUARE, NORRIS, TN 37828
PROJECT NO.: 210042-04

ACTIVE DESIGN PHASE

<input type="checkbox"/>	FOR REVIEW ONLY
<input type="checkbox"/>	FOR PERMITTING ONLY
<input type="checkbox"/>	SCHEMATIC DESIGN
<input type="checkbox"/>	DESIGN DEVELOPMENT
<input type="checkbox"/>	CONSTRUCTION BIDDING
<input checked="" type="checkbox"/>	CONSTRUCTION DOCUMENTS
<input type="checkbox"/>	AS-BUILT RECORD SET

REVISION INFORMATION


NO.	DATE	DESCRIPTION
2	03/09/2022	ADDENDUM #2

KEY PLAN



SHEET INFORMATION


SHEET ISSUED:	02/04/2022
DESIGNED BY:	KEF
DRAWN BY:	MMW/AJA
REVIEWED BY:	CMG
SHEET TITLE:	

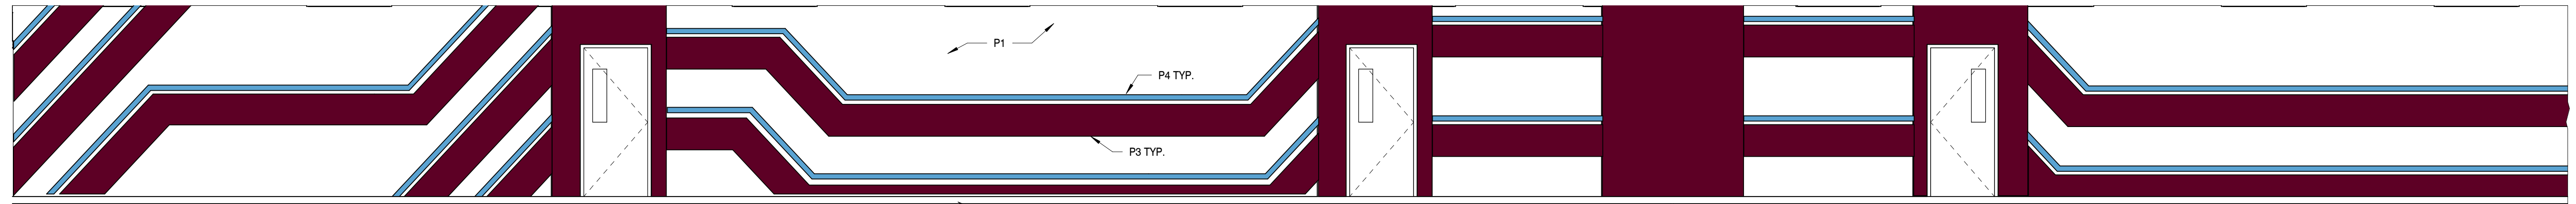

CORRIDOR NORTH ELEVATION

SCALE: 1/4" = 1'-0"


1

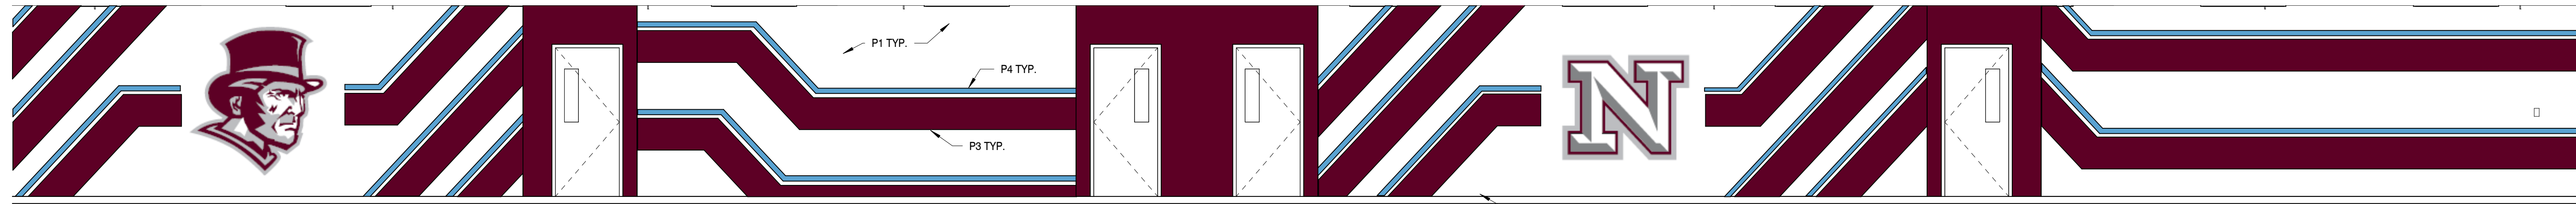

CORRIDOR SOUTH ELEVATION

SCALE: 1/4" = 1'-0"

2

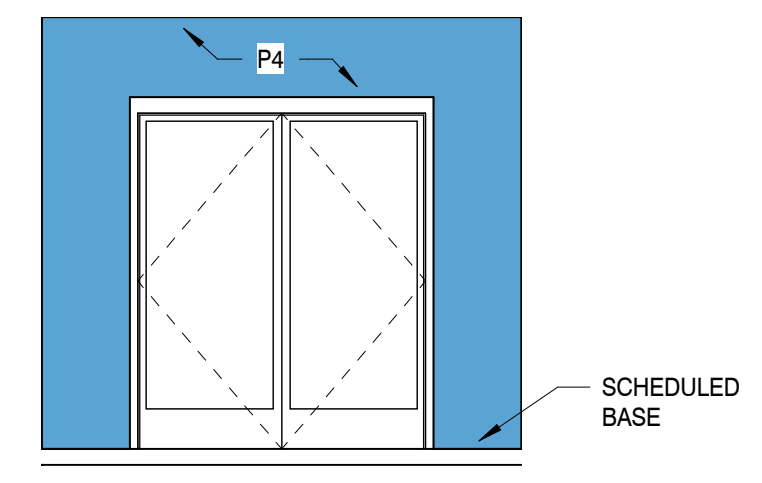


CORRIDOR WEST ELEVATION

SCALE: 1/4" = 1'-0"

3

MBI COMPANIES INC.
200 N. WEISGARBER ROAD
KNOXVILLE, TN 37919
PHONE: (865) 584-0999
FAX: (865) 584-6213
WEB: mbicompanies.com

CONSULTANT

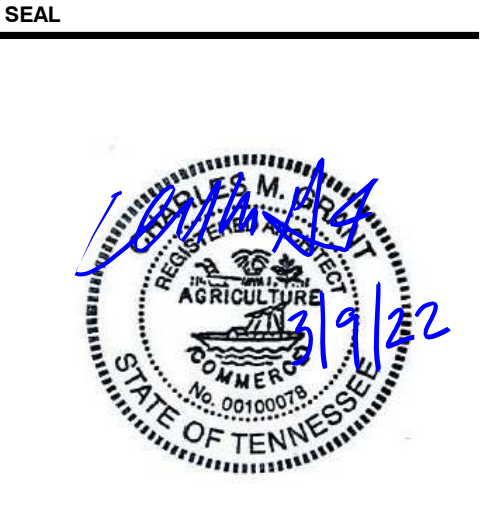

COPYRIGHT © MBI COMPANIES INC. 2021
THE DESIGN PROFESSIONAL DENIES ANY AND ALL RESPONSIBILITY AND LIABILITY FOR PROBLEMS WHICH ARISE FROM FAILURE TO FOLLOW THESE PLANS, SPECIFICATIONS AND THE DESIGN INTENT THEY CONVEY, OR PROBLEMS WHICH ARISE FROM OTHERS' FAILURE TO OBTAIN AND/OR FOLLOW THE DESIGN PROFESSIONAL'S GUIDANCE WITH RESPECT TO ANY ERRORS, OMISSIONS, INCONSISTENCIES, AMBIGUITIES OR CONFLICTS WHICH ARE ALLEGED.

PROJECT INFORMATION

PROJECT:
AN ADDITION & RENOVATION TO: NORRIS MIDDLE SCHOOL

PROJECT ADDRESS:
5 NORRIS SQUARE,
NORRIS, TN 37828

PROJECT NO.: **210042-04**

- ACTIVE DESIGN PHASE**
- FOR REVIEW ONLY
 - FOR PERMITTING ONLY
 - SCHEMATIC DESIGN
 - DESIGN DEVELOPMENT
 - CONSTRUCTION BIDDING
 - CONSTRUCTION DOCUMENTS
 - AS-BUILT RECORD SET

REVISION INFORMATION

NO.	DATE	DESCRIPTION
2	03/09/2022	Addendum #2

KEY PLAN




SHEET INFORMATION

SHEET ISSUED: 02/04/2022
DESIGNED BY: KEF
DRAWN BY: MMW/AJA
REVIEWED BY: CMG
SHEET TITLE:

INTERIOR ELEVATIONS


SHEET NO.: **F401**

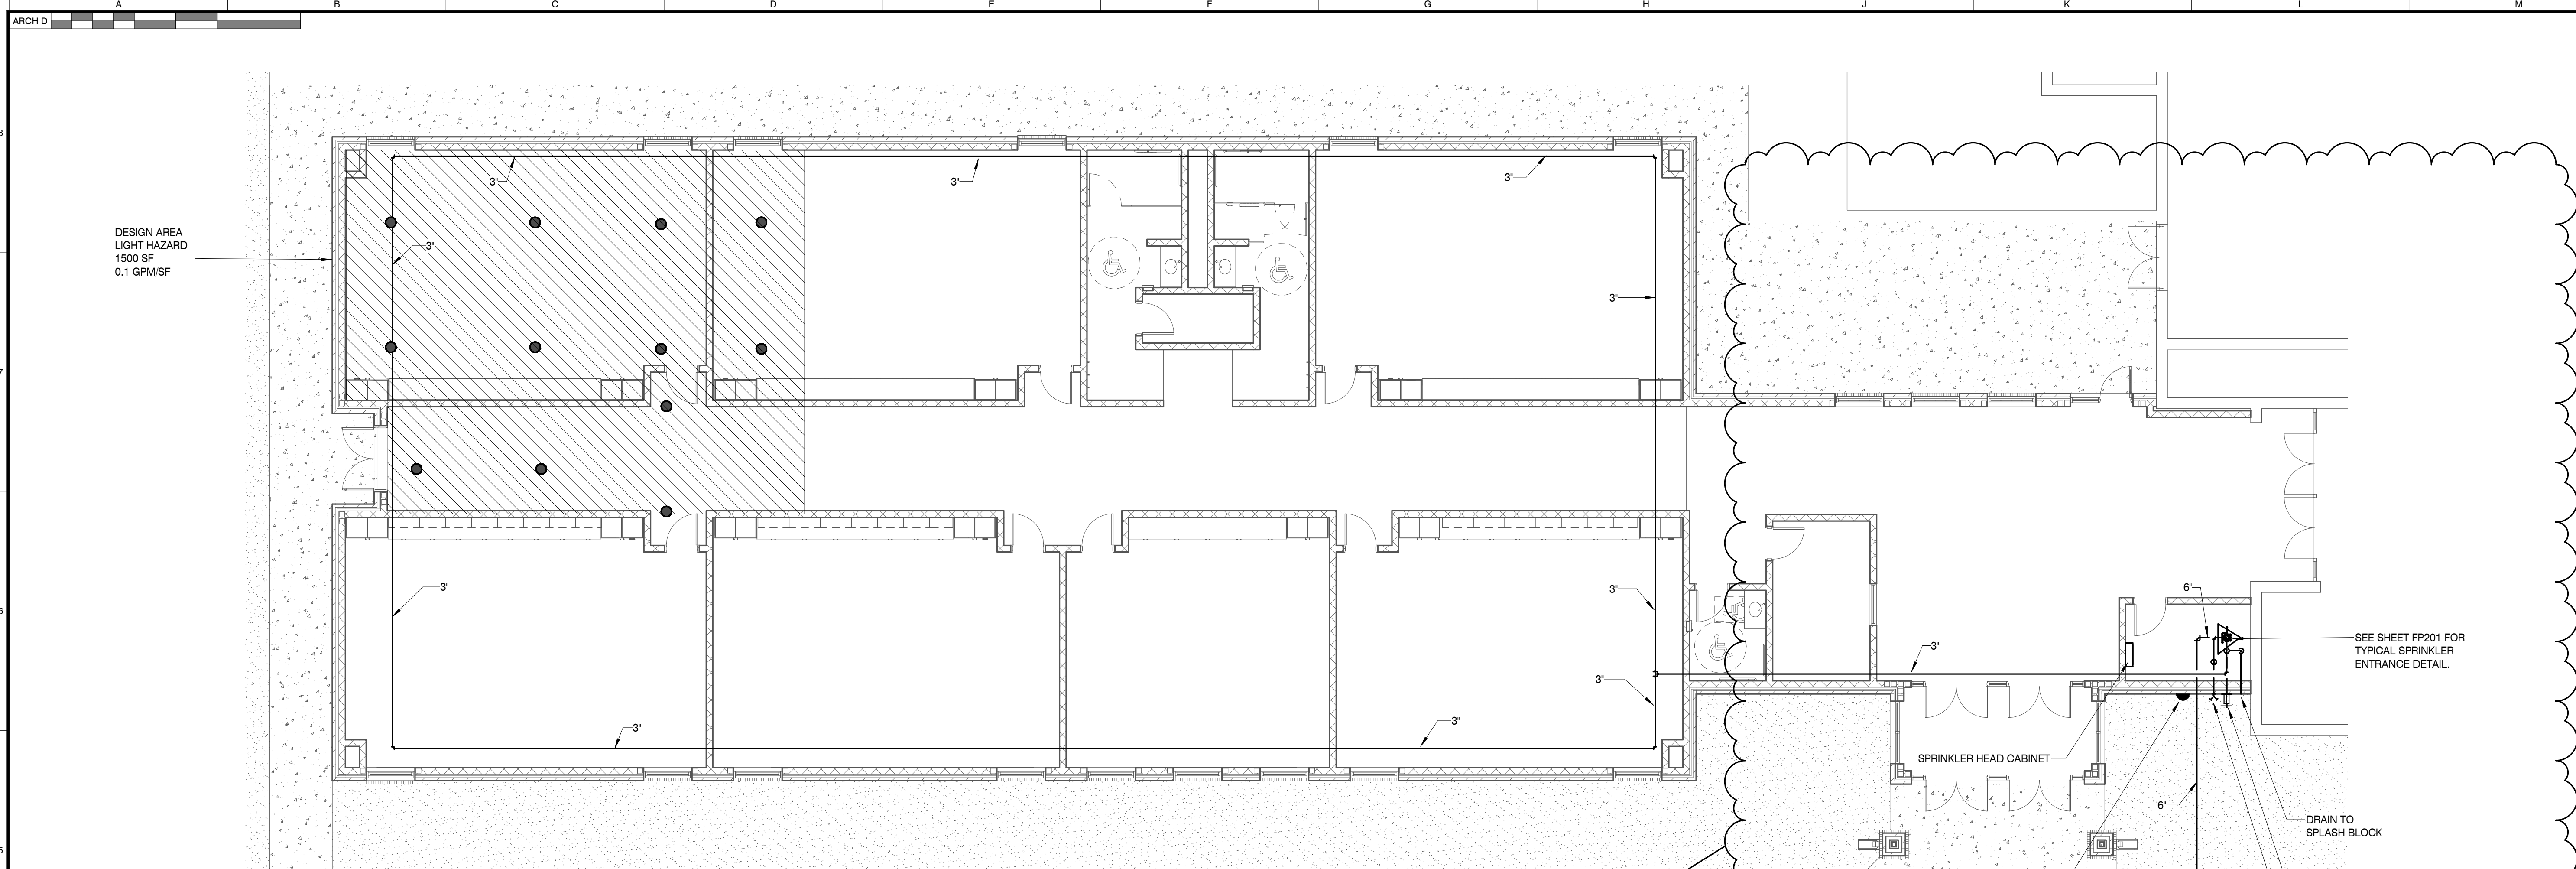

FLOOR PLAN - FIRE PROTECTION

SCALE: 1/8" = 1'-0"

1

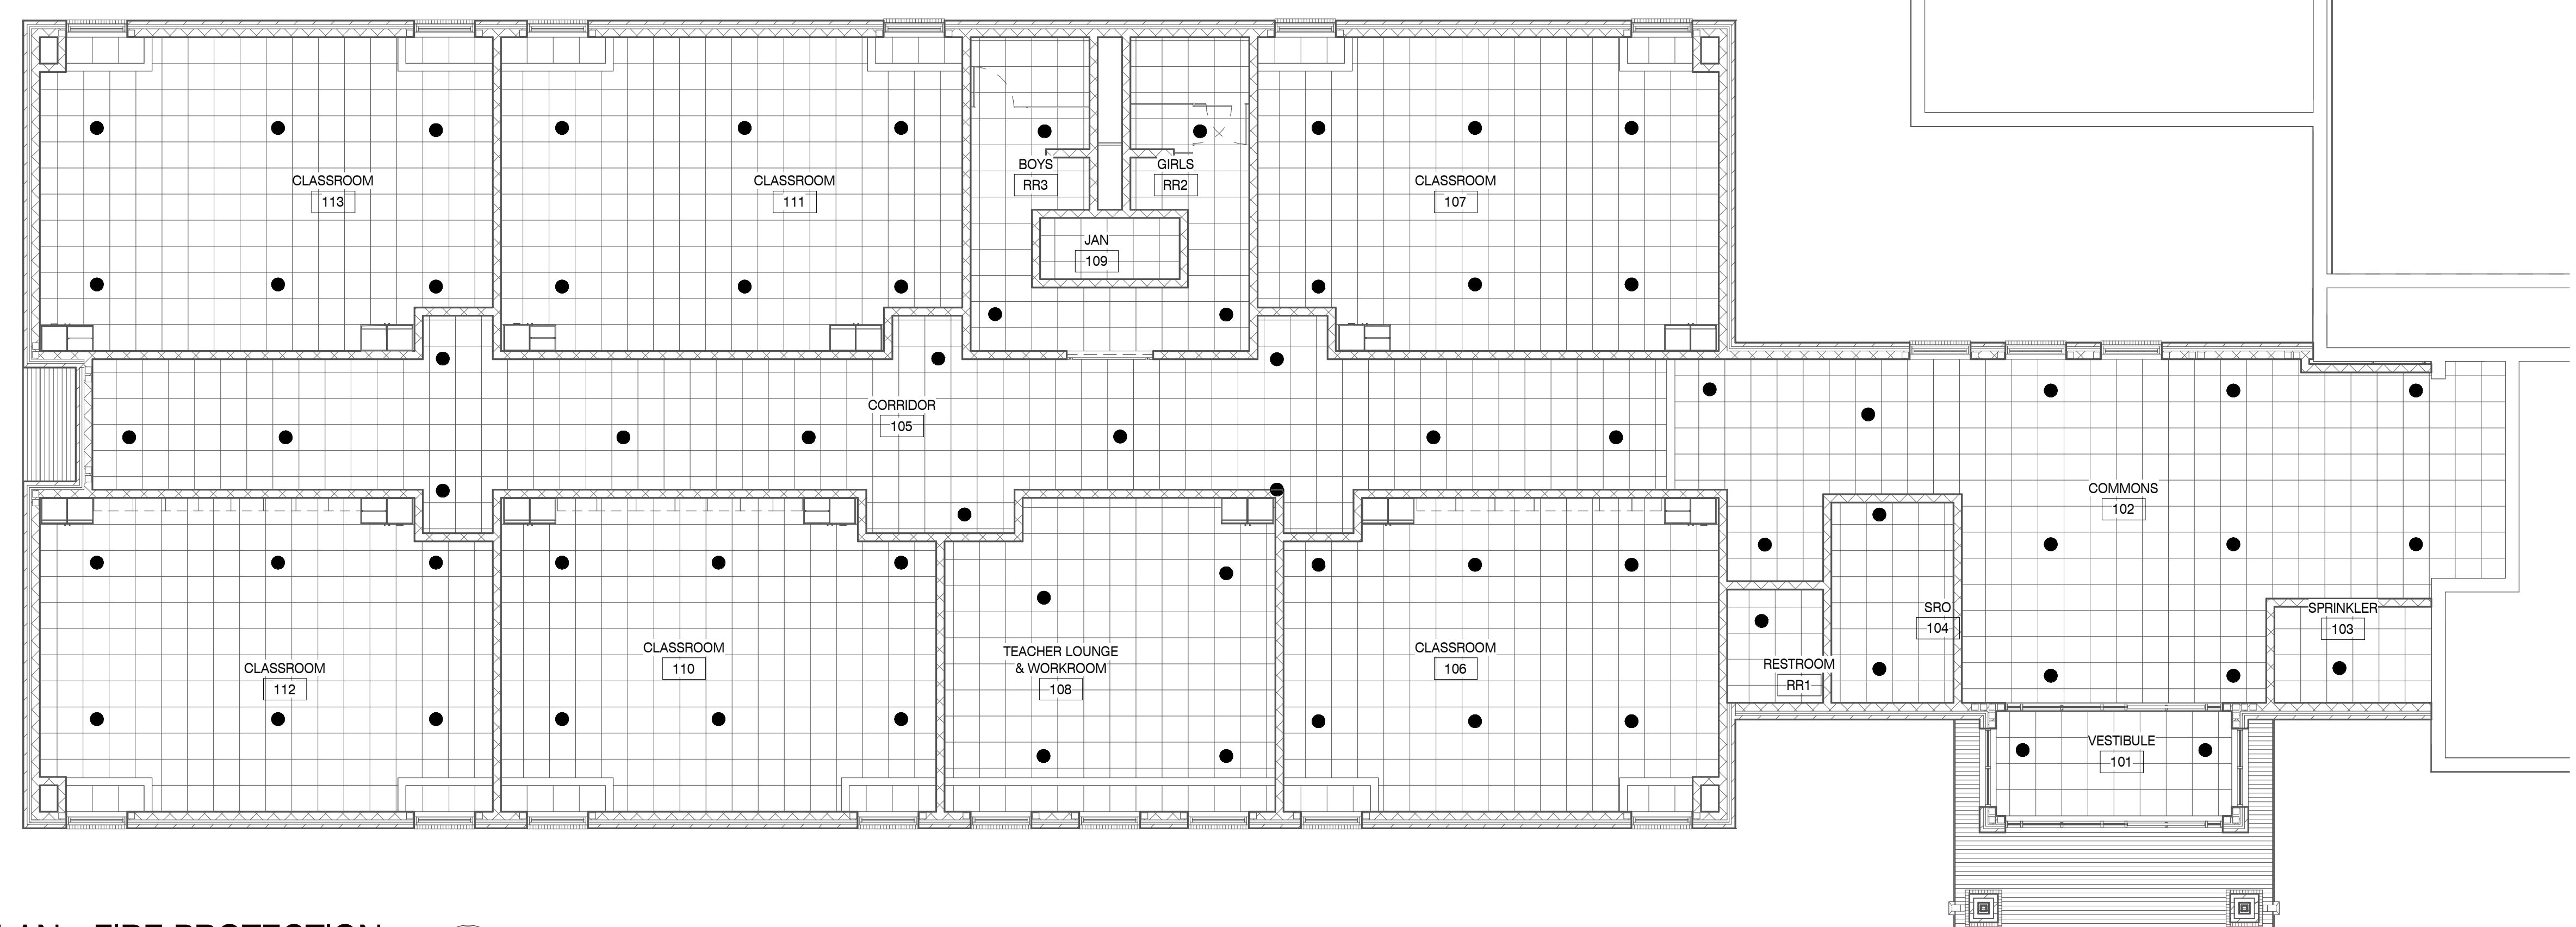

CEILING PLAN - FIRE PROTECTION

SCALE: 1/8" = 1'-0"


2

MBI COMPANIES INC.
299 N. WEISGARBER ROAD
KNOXVILLE, TN 37919
PHONE: (865) 584-0999
FAX: (865) 584-5213
WEB: mbicompanies.com

CONSULTANT
MECHANICAL ENGINEER:

MBI COMPANIES INC.
299 N. WEISGARBER ROAD
KNOXVILLE, TN 37919
PHONE: (865) 584-0999
FAX: (865) 584-5213
WEB: mbicompanies.com

SEAL

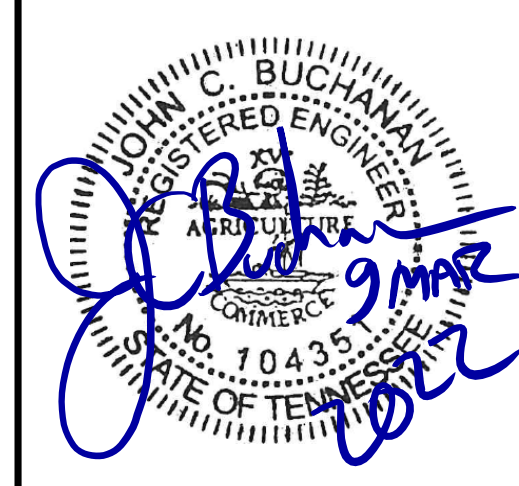

COPYRIGHT © MBI COMPANIES INC. 2020
THE DESIGN PROFESSIONAL DENIES ANY AND ALL RESPONSIBILITY AND LIABILITY FOR PROBLEMS WHICH ARISE FROM FAILURE TO FOLLOW THESE PLANS, SPECIFICATIONS AND THE DESIGN INTENT THEY CONVEY, OR PROBLEMS WHICH ARISE FROM OTHERS' FAILURE TO OBTAIN AND/OR FOLLOW THE DESIGN PROFESSIONAL'S GUIDANCE WITH RESPECT TO ANY ERRORS, OMISSIONS, INCONSISTENCIES, AMBIGUITIES OR CONFLICTS WHICH ARE ALLEGED.

PROJECT INFORMATION

PROJECT:
**AN ADDITION & RENOVATION TO:
NORRIS MIDDLE SCHOOL**

PROJECT ADDRESS:
5 NORRIS SQUARE,
NORRIS, TN 37828

PROJECT NO.: **210042-04**

ACTIVE DESIGN PHASE

- FOR REVIEW ONLY
- FOR PERMITTING ONLY
- SCHEMATIC DESIGN
- DESIGN DEVELOPMENT
- CONSTRUCTION BIDDING
- CONSTRUCTION DOCUMENTS
- AS-BUILT RECORD SET

REVISION INFORMATION

NO.	DATE	DESCRIPTION
2	3/9/22	ADDENDUM #2

KEY PLAN

SHEET INFORMATION

SHEET ISSUED: 2/4/2022
DESIGNED BY: DF
DRAWN BY: DF
REVIEWED BY: JCB
SHEET TITLE:

FLOOR PLAN - FIRE PROTECTION

SHEET NO.:

FP101

C:\Users\jcbuchan\Documents\Norris_MS_210042_R21(07_210042-04_MECH_dfermandez3DIA.rvt 3/9/2022 9:58:11 AM)

SZVAV AIR HANDLING UNIT SEQUENCE OF OPERATION (PAU-(1-6))

BUILDING AUTOMATION SYSTEM INTERFACE:

THE BUILDING AUTOMATION SYSTEM (BAS) SHALL SEND THE CONTROLLER OCCUPIED BYPASS, MORNING WARM-UP / PRE-COOL, OCCUPIED / UNOCCUPIED AND HEAT / COOL MODES. IF COMMUNICATION IS LOST WITH THE BAS THE CONTROLLER SHALL OPERATE USING DEFAULT MODES AND SETPOINTS. THE BAS SHALL ALSO SEND THE CONTROLLER A DUCT STATIC PRESSURE SETPOINT, DISCHARGE AIR TEMPERATURE SETPOINT, AND VENTILATION AIRFLOW SETPOINT, EACH CALCULATED BY OPTIMIZATION ROUTINES IN THE BAS.

OCCUPIED MODE:

DURING OCCUPIED PERIODS, THE SUPPLY FAN SHALL RUN CONTINUOUSLY AND THE OUTSIDE AIR DAMPER SHALL OPEN TO MAINTAIN THE CURRENT AIRFLOW SETPOINT. THE UNIT CONTROLLER SHALL CONTROL THE SUPPLY FAN VFD. THE DX COOLING SHALL STAGE AND GAS HEAT SHALL MODULATE TO MAINTAIN THE CURRENT DISCHARGE AIR TEMPERATURE SETPOINT. IF ECONOMIZING IS ENABLED THE OUTSIDE AIR DAMPER SHALL MODULATE TO MAINTAIN THE CURRENT DISCHARGE AIR TEMPERATURE SETPOINT.

UNOCCUPIED MODE:

WHEN THE SPACE TEMPERATURE IS BELOW THE UNOCCUPIED HEATING SETPOINT OF 60.0 DEG. F (ADJ.) THE SUPPLY FAN VARIABLE FREQUENCY DRIVE (VFD) SHALL BE ENABLED AND OPERATE AS NECESSARY. THE OUTSIDE AIR DAMPER SHALL REMAIN CLOSED AND THE GAS HEAT SHALL BE ENABLED. WHEN THE SPACE TEMPERATURE RISES ABOVE THE UNOCCUPIED HEATING SETPOINT OF 60.0 DEG. F (ADJ.) PLUS THE UNOCCUPIED DIFFERENTIAL OF 4.0 DEG. F (ADJ.) THE SUPPLY FAN AND THE GAS HEAT SHALL BE DISABLED.

WHEN THE SPACE TEMPERATURE IS ABOVE THE UNOCCUPIED COOLING SETPOINT OF 85.0 DEG. F (ADJ.) THE SUPPLY FAN VARIABLE FREQUENCY DRIVE (VFD) SHALL BE ENABLED AND OPERATE AS NECESSARY. THE OUTSIDE AIR DAMPER SHALL OPEN IF ECONOMIZING IS ENABLED AND REMAIN CLOSED IF ECONOMIZING IS DISABLED AND THE DX COOLING SHALL BE ENABLED. WHEN THE SPACE TEMPERATURE FALLS BELOW THE UNOCCUPIED COOLING SETPOINT OF 85.0 DEG. F (ADJ.) MINUS THE UNOCCUPIED DIFFERENTIAL OF 4.0 DEG. F (ADJ.) THE SUPPLY FAN AND THE DX COOLING SHALL BE DISABLED AND THE OUTSIDE AIR DAMPER SHALL CLOSE.

OPTIMAL START:

THE BAS SHALL MONITOR THE SCHEDULED OCCUPIED TIME, OCCUPIED SPACE SETPOINTS AND SPACE TEMPERATURE TO CALCULATE WHEN THE OPTIMAL START OCCURS.

MORNING WARM-UP MODE:

DURING OPTIMAL START, IF THE AVERAGE SPACE TEMPERATURE IS BELOW THE OCCUPIED HEATING SETPOINT A MORNING WARM-UP MODE SHALL BE ACTIVATED. WHEN MORNING WARM-UP IS INITIATED THE UNIT SHALL ENABLE THE SUPPLY FAN, RETURN FAN AND HEATING. THE OUTSIDE AIR DAMPER SHALL REMAIN CLOSED. WHEN THE AVERAGE SPACE TEMPERATURE REACHES THE OCCUPIED HEATING SETPOINT (ADJ.), THE UNIT SHALL TRANSITION TO THE OCCUPIED MODE.

PRE-COOL MODE:

DURING OPTIMAL START, IF THE AVERAGE SPACE TEMPERATURE IS ABOVE THE OCCUPIED COOLING SETPOINT, PRE-COOL MODE SHALL BE ACTIVATED. WHEN PRE-COOL IS INITIATED THE UNIT SHALL ENABLE THE FAN AND COOLING OR ECONOMIZER. THE OUTSIDE AIR DAMPER SHALL REMAIN CLOSED, UNLESS ECONOMIZING. WHEN THE AVERAGE SPACE TEMPERATURE REACHES OCCUPIED COOLING SETPOINT (ADJ.), THE UNIT SHALL TRANSITION TO THE OCCUPIED MODE.

OPTIMAL STOP:

THE BAS SHALL MONITOR THE SCHEDULED UNOCCUPIED TIME, OCCUPIED SETPOINTS AND SPACE TEMPERATURE TO CALCULATE WHEN THE OPTIMAL STOP OCCURS. WHEN THE OPTIMAL STOP MODE IS ACTIVE THE UNIT CONTROLLER SHALL MAINTAIN THE SPACE TEMPERATURE TO THE SPACE TEMPERATURE OFFSET SETPOINT.

OCCUPIED BYPASS:

THE BAS SHALL MONITOR THE STATUS OF THE "ON" AND "CANCEL" BUTTONS OF THE SPACE TEMPERATURE SENSORS. WHEN AN OCCUPIED BYPASS REQUEST IS RECEIVED FROM A SPACE SENSOR, THE UNIT SHALL TRANSITION FROM ITS CURRENT OCCUPANCY MODE TO OCCUPIED BYPASS MODE AND THE UNIT SHALL MAINTAIN THE SPACE TEMPERATURE TO THE OCCUPIED SETPOINTS (ADJ.).

COOLING MODE:

THE UNIT CONTROLLER SHALL USE THE DISCHARGE AIR TEMPERATURE SENSOR AND DISCHARGE AIR TEMPERATURE COOLING SETPOINT TO DETERMINE WHEN TO INITIATE REQUESTS FOR COOLING. DISCHARGE AIR SETPOINT SHALL BE MAINTAINED BY MODULATING THE ECONOMIZER OR STAGING THE DX COOLING AS REQUIRED TO MAINTAIN THE DISCHARGE AIR SETPOINT.

HEATING MODE:

THE UNIT CONTROLLER SHALL USE THE DISCHARGE AIR TEMPERATURE SETPOINT AND DISCHARGE AIR TEMPERATURE SENSOR TO DETERMINE WHEN TO INITIATE REQUEST FOR HEATING. WHEN THE DISCHARGE AIR TEMPERATURE FALLS 10.0 DEG. F BELOW THE DISCHARGE AIR TEMPERATURE SETPOINT, THE HEATING WILL MODULATE TO MAINTAIN THE SUPPLY AIR TEMPERATURE TO SETPOINT.

ECONOMIZER:

THE SUPPLY AIR SENSOR SHALL MEASURE THE DRY BULB TEMPERATURE OF THE AIR LEAVING THE EVAPORATOR COIL WHILE ECONOMIZING. WHEN ECONOMIZING IS ENABLED AND THE UNIT IS OPERATING IN THE COOLING MODE, THE ECONOMIZER DAMPER SHALL BE MODULATED BETWEEN ITS MINIMUM POSITION AND 100% TO MAINTAIN THE DISCHARGE AIR TEMPERATURE SETPOINT. THE ECONOMIZER DAMPER SHALL MODULATE TOWARD MINIMUM POSITION IN THE EVENT THE MIXED AIR TEMPERATURE FALLS BELOW THE LOW LIMIT TEMPERATURE SETTING. COMPRESSORS SHALL BE DELAYED FROM OPERATING UNTIL THE ECONOMIZER HAS OPENED TO 100%.

FILTER STATUS:

A DIFFERENTIAL PRESSURE SWITCH SHALL MONITOR THE DIFFERENTIAL PRESSURE ACROSS THE FILTER WHEN THE FAN IS RUNNING. IF THE SWITCH CLOSSES FOR 2 MINUTES AFTER A REQUEST FOR FAN OPERATION A DIRTY FILTER ALARM SHALL BE ANNUNCIATED AT THE BAS.

CAV AIR HANDLING UNIT SEQUENCE OF OPERATION (PAU-7/PAU-8)

BUILDING AUTOMATION SYSTEM INTERFACE:

THE BUILDING AUTOMATION SYSTEM (BAS) SHALL SEND THE CONTROLLER OCCUPIED BYPASS, MORNING WARM-UP / PRE-COOL, OCCUPIED / UNOCCUPIED AND HEAT / COOL MODES. IF COMMUNICATION IS LOST WITH THE BAS THE CONTROLLER SHALL OPERATE USING DEFAULT MODES AND SETPOINTS. SPACE TEMPERATURE SETPOINT, AND VENTILATION AIRFLOW SETPOINT, EACH CALCULATED BY OPTIMIZATION ROUTINES IN THE BAS.

OCCUPIED MODE:

DURING OCCUPIED PERIODS, THE SUPPLY FAN SHALL RUN CONTINUOUSLY AND THE OUTSIDE AIR DAMPER SHALL OPEN TO MAINTAIN THE CURRENT AIRFLOW SETPOINT. THE UNIT CONTROLLER SHALL ENABLE/DISABLE THE SUPPLY FAN. THE DX COOLING SHALL STAGE AND GAS HEAT SHALL MODULATE TO MAINTAIN THE CURRENT DISCHARGE AIR TEMPERATURE SETPOINT. IF ECONOMIZING IS ENABLED THE OUTSIDE AIR DAMPER SHALL MODULATE TO MAINTAIN THE CURRENT DISCHARGE AIR TEMPERATURE SETPOINT.

UNOCCUPIED MODE:

WHEN THE SPACE TEMPERATURE IS BELOW THE UNOCCUPIED HEATING SETPOINT OF 60.0 DEG. F (ADJ.) THE SUPPLY FAN SHALL BE ENABLED. THE OUTSIDE AIR DAMPER SHALL REMAIN CLOSED AND THE GAS HEAT SHALL BE ENABLED. WHEN THE SPACE TEMPERATURE RISES ABOVE THE UNOCCUPIED HEATING SETPOINT OF 60.0 DEG. F (ADJ.) PLUS THE UNOCCUPIED DIFFERENTIAL OF 4.0 DEG. F (ADJ.) THE SUPPLY FAN AND THE GAS HEAT SHALL BE DISABLED.

WHEN THE SPACE TEMPERATURE IS ABOVE THE UNOCCUPIED COOLING SETPOINT OF 85.0 DEG. F (ADJ.) THE SUPPLY FAN SHALL BE ENABLED. THE OUTSIDE AIR DAMPER SHALL OPEN IF ECONOMIZING IS ENABLED AND REMAIN CLOSED IF ECONOMIZING IS DISABLED AND THE DX COOLING SHALL BE ENABLED. WHEN THE SPACE TEMPERATURE FALLS BELOW THE UNOCCUPIED COOLING SETPOINT OF 85.0 DEG. F (ADJ.) MINUS THE UNOCCUPIED DIFFERENTIAL OF 4.0 DEG. F (ADJ.) THE SUPPLY FAN AND THE DX COOLING SHALL BE DISABLED AND THE OUTSIDE AIR DAMPER SHALL CLOSE.

OPTIMAL START:

THE BAS SHALL MONITOR THE SCHEDULED OCCUPIED TIME, OCCUPIED SPACE SETPOINTS AND SPACE TEMPERATURE TO CALCULATE WHEN THE OPTIMAL START OCCURS.

MORNING WARM-UP MODE:

DURING OPTIMAL START, IF THE AVERAGE SPACE TEMPERATURE IS BELOW THE OCCUPIED HEATING SETPOINT A MORNING WARM-UP MODE SHALL BE ACTIVATED. WHEN MORNING WARM-UP IS INITIATED THE UNIT SHALL ENABLE THE SUPPLY FAN, RETURN FAN AND HEATING. THE OUTSIDE AIR DAMPER SHALL REMAIN CLOSED. WHEN THE AVERAGE SPACE TEMPERATURE REACHES THE OCCUPIED HEATING SETPOINT (ADJ.), THE UNIT SHALL TRANSITION TO THE OCCUPIED MODE.

PRE-COOL MODE:

DURING OPTIMAL START, IF THE AVERAGE SPACE TEMPERATURE IS ABOVE THE OCCUPIED COOLING SETPOINT, PRE-COOL MODE SHALL BE ACTIVATED. WHEN PRE-COOL IS INITIATED THE UNIT SHALL ENABLE THE FAN AND COOLING OR ECONOMIZER. THE OUTSIDE AIR DAMPER SHALL REMAIN CLOSED, UNLESS ECONOMIZING. WHEN THE AVERAGE SPACE TEMPERATURE REACHES OCCUPIED COOLING SETPOINT (ADJ.), THE UNIT SHALL TRANSITION TO THE OCCUPIED MODE.

OPTIMAL STOP:

THE BAS SHALL MONITOR THE SCHEDULED UNOCCUPIED TIME, OCCUPIED SETPOINTS AND SPACE TEMPERATURE TO CALCULATE WHEN THE OPTIMAL STOP OCCURS. WHEN THE OPTIMAL STOP MODE IS ACTIVE THE UNIT CONTROLLER SHALL MAINTAIN THE SPACE TEMPERATURE TO THE SPACE TEMPERATURE OFFSET SETPOINT.

OCCUPIED BYPASS:

THE BAS SHALL MONITOR THE STATUS OF THE "ON" AND "CANCEL" BUTTONS OF THE SPACE TEMPERATURE SENSORS. WHEN AN OCCUPIED BYPASS REQUEST IS RECEIVED FROM A SPACE SENSOR, THE UNIT SHALL TRANSITION FROM ITS CURRENT OCCUPANCY MODE TO OCCUPIED BYPASS MODE AND THE UNIT SHALL MAINTAIN THE SPACE TEMPERATURE TO THE OCCUPIED SETPOINTS (ADJ.).

COOLING MODE:

THE UNIT CONTROLLER SHALL USE THE DISCHARGE AIR TEMPERATURE SENSOR AND DISCHARGE AIR TEMPERATURE COOLING SETPOINT TO DETERMINE WHEN TO INITIATE REQUESTS FOR COOLING. DISCHARGE AIR SETPOINT SHALL BE MAINTAINED BY MODULATING THE ECONOMIZER OR STAGING THE DX COOLING AS REQUIRED TO MAINTAIN THE DISCHARGE AIR SETPOINT.

HEATING MODE:

THE UNIT CONTROLLER SHALL USE THE DISCHARGE AIR TEMPERATURE SETPOINT AND DISCHARGE AIR TEMPERATURE SENSOR TO DETERMINE WHEN TO INITIATE REQUEST FOR HEATING. WHEN THE DISCHARGE AIR TEMPERATURE FALLS 10.0 DEG. F BELOW THE DISCHARGE AIR TEMPERATURE SETPOINT, THE HEATING WILL MODULATE TO MAINTAIN THE SUPPLY AIR TEMPERATURE TO SETPOINT.

ECONOMIZER: (PAU-7 ONLY)

THE SUPPLY AIR SENSOR SHALL MEASURE THE DRY BULB TEMPERATURE OF THE AIR LEAVING THE EVAPORATOR COIL WHILE ECONOMIZING. WHEN ECONOMIZING IS ENABLED AND THE UNIT IS OPERATING IN THE COOLING MODE, THE ECONOMIZER DAMPER SHALL BE MODULATED BETWEEN ITS MINIMUM POSITION AND 100% TO MAINTAIN THE DISCHARGE AIR TEMPERATURE SETPOINT. THE ECONOMIZER DAMPER SHALL MODULATE TOWARD MINIMUM POSITION IN THE EVENT THE MIXED AIR TEMPERATURE FALLS BELOW THE LOW LIMIT TEMPERATURE SETTING. COMPRESSORS SHALL BE DELAYED FROM OPERATING UNTIL THE ECONOMIZER HAS OPENED TO 100%.

FILTER STATUS:

A DIFFERENTIAL PRESSURE SWITCH SHALL MONITOR THE DIFFERENTIAL PRESSURE ACROSS THE FILTER WHEN THE FAN IS RUNNING. IF THE SWITCH CLOSSES FOR 2 MINUTES AFTER A REQUEST FOR FAN OPERATION A DIRTY FILTER ALARM SHALL BE ANNUNCIATED AT THE BAS.

EXISTING BMS FRONT END

1. THE EXISTING BMS IS AN AUTOMATED LOGIC CONTROL SYSTEM. THIS CONTROL SYSTEM SHALL TIE INTO THAT. THE CONTRACTOR SHALL PROVIDE CONTROLLERS FOR ALL UNITS WITH BACNET CONNECTIONS TO TIE INTO THE BAS FRONT END.

MBI

MBI COMPANIES INC.
299 N. WEISGARBER ROAD
KNOXVILLE, TN 37919

PHONE: (865) 584-0999
FAX: (865) 584-6213

WEB: mbicompanies.com

CONSULTANT

SEAL



COPYRIGHT © MBI COMPANIES INC. 2020
THE DESIGN PROFESSIONAL DENIES ANY AND ALL RESPONSIBILITY AND LIABILITY FOR PROBLEMS WHICH ARISE FROM FAILURE TO FOLLOW THESE PLANS, SPECIFICATIONS AND THE DESIGN INTENT THEY CONVEY, OR PROBLEMS WHICH ARISE FROM OTHERS' FAILURE TO OBTAIN AND/OR FOLLOW THE DESIGN PROFESSIONAL'S GUIDANCE WITH RESPECT TO ANY ERRORS, OMISSIONS, INCONSISTENCIES, AMBIGUITIES OR CONFLICTS WHICH ARE ALLEGED.

PROJECT INFORMATION

PROJECT:

AN ADDITION &
RENOVATION TO:
NORRIS MIDDLE
SCHOOL

PROJECT ADDRESS:

5 NORRIS SQUARE,
NORRIS, TN 37828

PROJECT NO.: 210042-04

ACTIVE DESIGN PHASE

- FOR REVIEW ONLY
 FOR PERMITTING ONLY
 SCHEMATIC DESIGN
 DESIGN DEVELOPMENT
 CONSTRUCTION BIDDING
 CONSTRUCTION DOCUMENTS
 AS-BUILT RECORD SET

REVISION INFORMATION

NO.	DATE	DESCRIPTION	REV #1
1	2/22/22		
2	3/9/22	ADDENDUM #2	

KEY PLAN

SHEET INFORMATION

SHEET ISSUED: 2/4/2022
DESIGNED BY: DF
DRAWN BY: DF
REVIEWED BY: JCB
SHEET TITLE:

HVAC CONTROLS

SHEET NO.:

M202