



THIS DRAWING AND PREPARED BY CONTRACTOR'S ARCHITECT.  
 THESE ARE SUBJECT TO THE APPROVAL OF THE LOCAL AUTHORITY.  
 THESE SHALL BE RETURNED FOR THEIR REQUEST.

### PLAN NOTES

- NON ADA REQUIRED SIGNAGE SHALL BE PROVIDED AND INSTALLED BY THE OWNER.
- PROVIDE ALL WALL BLOCKING AS REQUIRED FOR FIXTURES, CASEWORK, EQUIPMENT, ETC. ALL WOOD BLOCKING SHALL BE FIRE TREATED LUMBER. (CONTRACTOR MAY PROVIDE 20 GA. STEEL STUDS, IN LIEU OF WOOD BLOCKING, IN METAL STUD WALL CONSTRUCTION.)
- ALL ROOM FURNISHINGS AND EQUIPMENT TO BE SUPPLIED BY THE OWNER, EXCEPT FOR CASEWORK WORK INDICATED ON THE PLAN.
- FOR GENERAL NOTES SEE DRAWING G-01.
- FIRE EXTINGUISHERS SHALL BE PROVIDED AND INSTALLED BY THE OWNER.
- FIRE EXTINGUISHERS ARE NOTED AS "FE" & "FEC" ON THE PLAN. (LOCATE EXTINGUISHERS AS DIRECTED BY THE LOCAL AUTHORITY HAVING JURISDICTION.)
- DIMENSIONS ARE FROM FACE OF STUD OR FACE OF MASONRY, UNLESS OTHERWISE NOTED F.O.F. (FACE OF FINISH)

### WALL NOTES


- CONTRACTOR SHALL ENSURE THAT EXISTING INSULATION COVERS ALL AREAS AND CAVITIES IN EXISTING EXTERIOR WALLS. IN AREAS THAT ARE NOT COVERED, CONTRACTOR SHALL PROVIDE NEW INSULATION TO ACHIEVE THE ASSUMED R-VALUE FOR THAT ASSEMBLY.
- PROVIDE MOISTURE RESISTANT GYPSUM WALLBOARD WITHIN 1'-6" OF A PLUMBING PENETRATION OR FIXTURE.
- COORDINATE WITH FINISH PLAN AREAS THAT ARE TO RECEIVE WALL TILE AND PROVIDE DUROCK SUBSTRATE IN THOSE LOCATIONS.

### LEGEND



- EXISTING CONSTRUCTION TO REMAIN
- NEW MASONRY CONSTRUCTION
- NEW WALL CONSTRUCTION
- NEW BUILT-IN CASEWORK
- FIRE EXTINGUISHER / FIRE EXTINGUISHER CABINET

### BID ALTERNATES


- ADD ALTERNATE #1**  
 ALTERNATE TO INCLUDE CONSTRUCTION OF ALL INTERIOR CONSTRUCTION OF NEW ARENA SPACE. TO INCLUDE RESTROOMS, CONCESSIONS, BLEACHER SEATING, CONCRETE CURB, STEEL LINER PANELS, AND ALL ASSOCIATED PLUMBING, ELECTRICAL, AND MECHANICAL WORK. REFER TO SPECIFICATIONS FOR ADDITIONAL COMMENTS.
- ADD ALTERNATE #2**  
 ALTERNATE TO INCLUDE REPLACEMENT OF EXISTING METAL BUILDING SIDING, AND METAL ROOFING SYSTEM, REPLACEMENT OF ALL EXTERIOR DOORS W/ HARDWARE. REFER TO SPECIFICATIONS FOR ADDITIONAL COMMENTS.
- ADD ALTERNATE #3**  
 ALTERNATE TO PROVIDE AND INSTALL COMMERCIAL KITCHEN EQUIPMENT DELINEATED ON SHEET A-40 AS ALTERNATE #3.
- ADD ALTERNATE #4**  
 ALTERNATE TO PROVIDE AND INSTALL OPERABLE PANEL PARTITION IN AUDITORIUM 136. (OVERHEAD TRACK AND SUPPORT STRUCTURE SHALL BE PROVIDED AND INSTALLED UNDER BASE BID.)

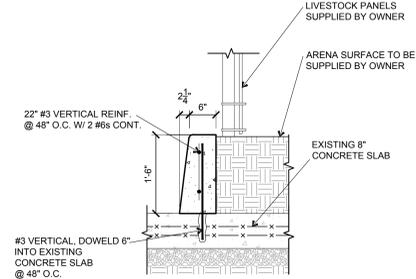


**DETAIL 1**  
 SCALE: 3/4" = 1'-0"  
 A-11

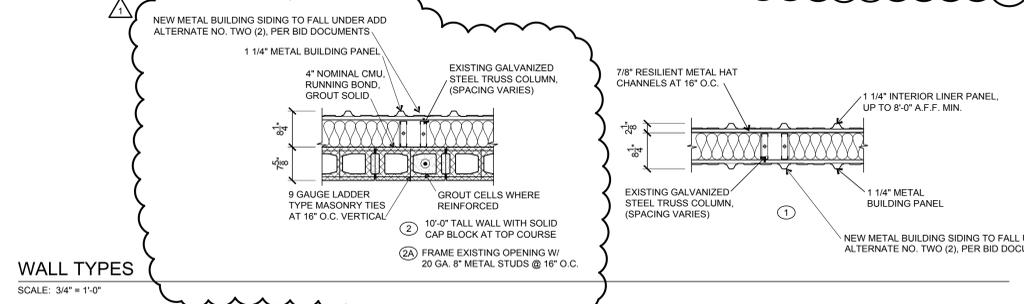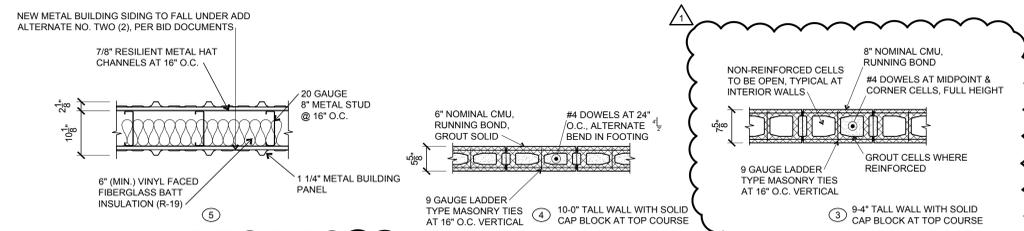

**WALL TYPES**  
 SCALE: 3/4" = 1'-0"

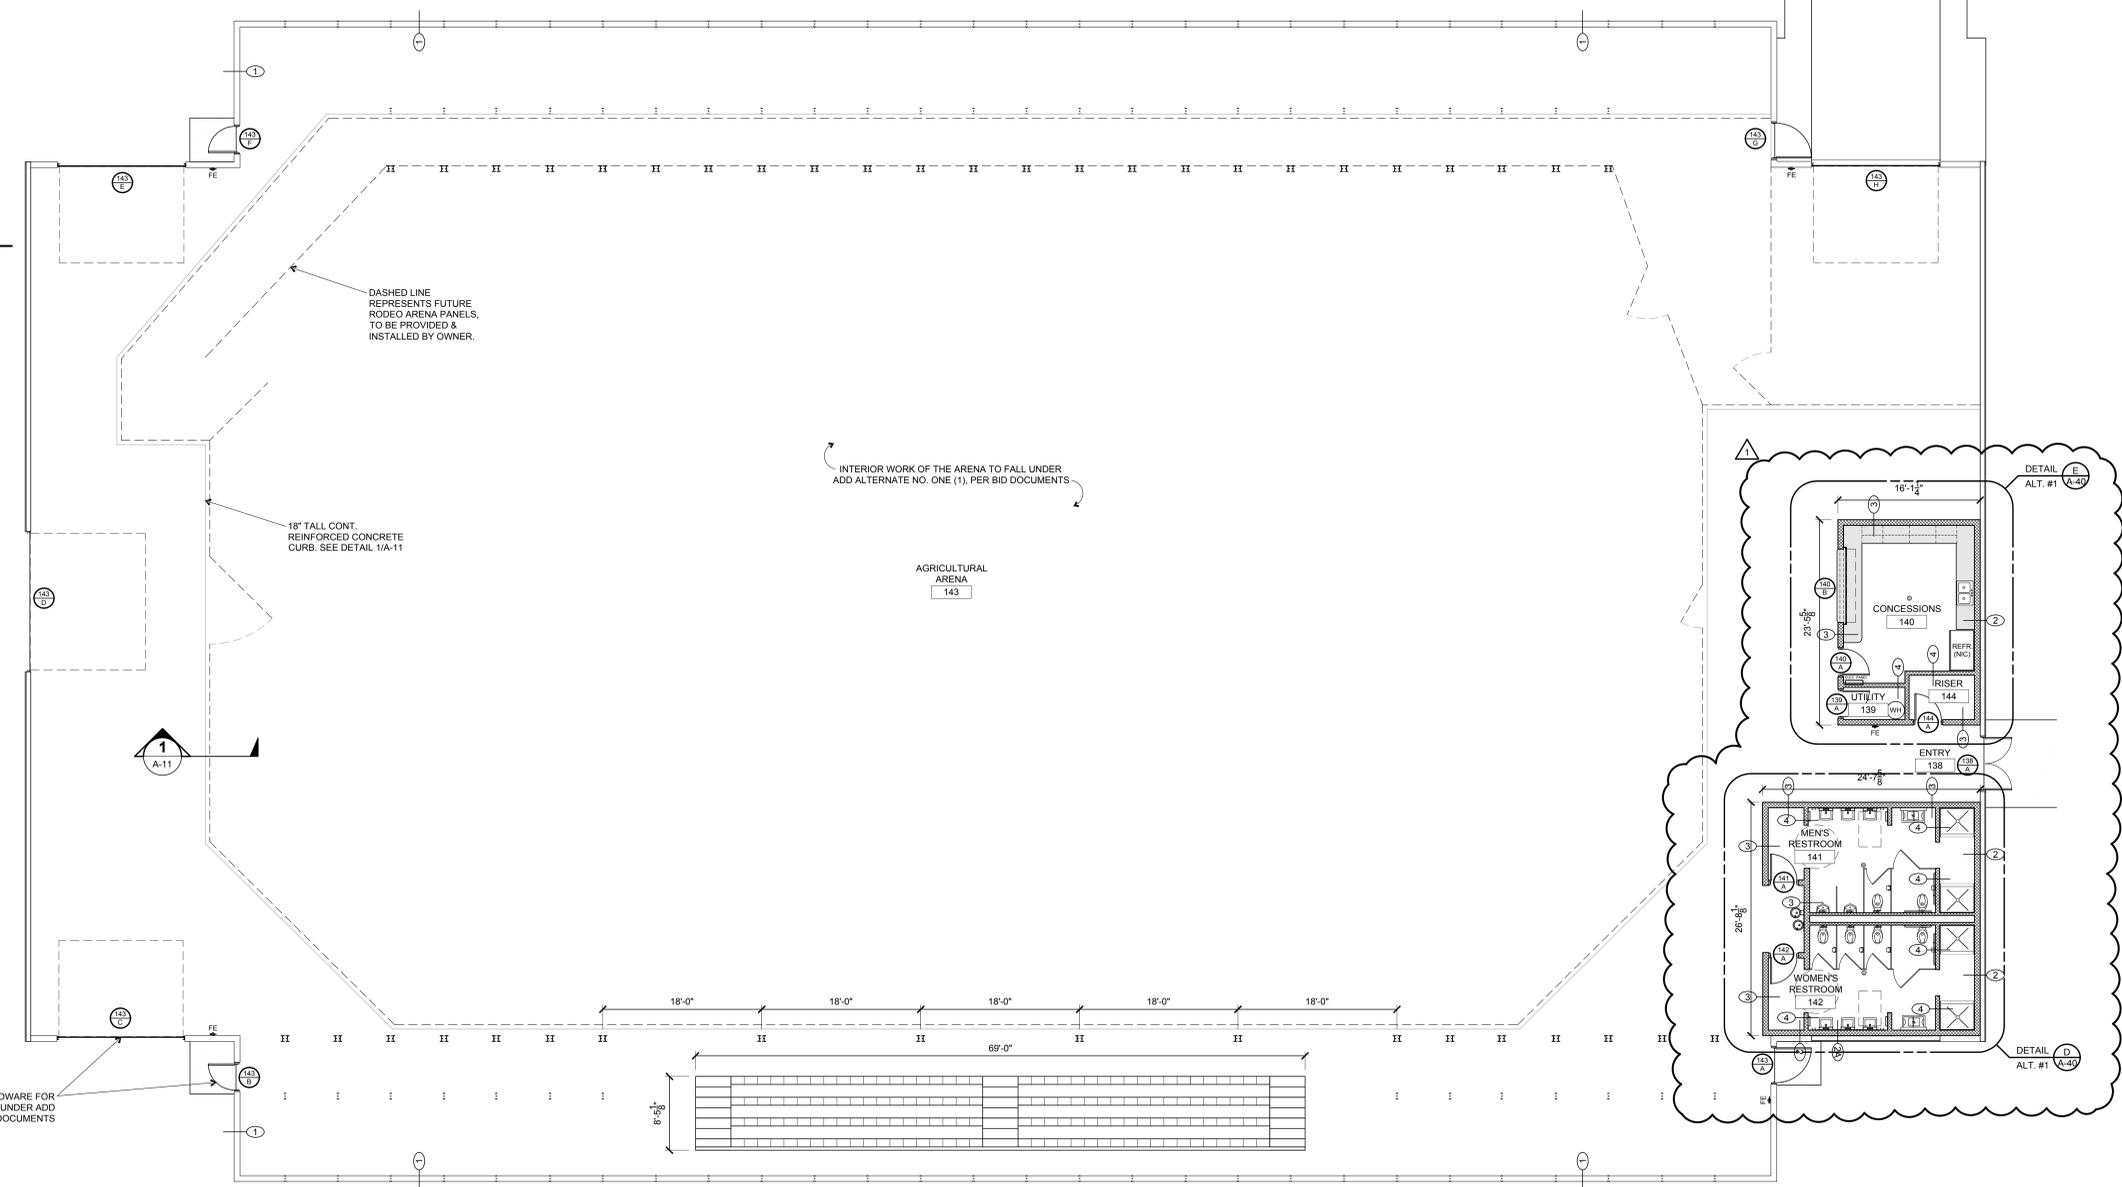

**ARENA FLOOR PLAN**  
 SCALE: 1/8" = 1'-0"  
 PLAN NORTH TRUE NORTH

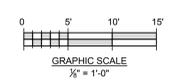

CDR	By
1	02-15-16
no.	date
1	02-15-16
revision	date

A New Agricultural Facility For  
**Sullivan County Tennessee**  
 Blountville, Tennessee

**Architectural Services**  
**Cain Rash West** Architects

130 Regional Park Dr.  
 Kingsport, TN 37660  
 Phn (423) 349-7760  
 Fax (423) 349-7413  
 www.grcinc.com



issued	1-29-16
checked	STUMP
approved	CAIN
drawn	CDR
project no.	201538
drawing name	ARENA FLOOR PLAN

**A-11**

plotted: 2/16/2016 10:34:52 AM file: A-11\_ARENA FLOOR PLAN\_201538.DWG

TFM No. \_\_\_\_\_

THIS DRAWING AND ANY INFORMATION CONTAINED HEREIN IS UNCLASSIFIED EXCEPT WHERE SHOWN OTHERWISE. IT IS THE PROPERTY OF ARCHITECTURAL SERVICES AND SHALL BE RETURNED UPON REQUEST.

### ROOF PLAN NOTES

- CONTRACTOR SHALL BE SOLELY RESPONSIBLE FOR VERIFICATION OF ACTUAL CONDITIONS SURROUNDING THE PROJECT INCLUDING AS-BUILT CONDITION OF THE EXISTING BUILDING AND ROOF. CONTRACTOR SHALL CONFINE HIS OPERATIONS TO THE IMMEDIATE VICINITY OF THE WORK SITE AS DIRECTED BY THE OWNER AND THE ARCHITECT.
- CONTRACTOR SHALL BE SOLELY RESPONSIBLE FOR VERIFICATION OF ROOF DIMENSIONS AND SIZES, LOCATIONS, ETC. OF EXISTING ROOF MOUNTED EQUIPMENT AND ACCESSORIES, AND OTHER SPECIALS. CONTRACTOR SHALL PROTECT AND SALVAGE ALL EXISTING ROOF ACCESSORY ITEMS TO REMAIN.
- DURING CONSTRUCTION, CONTRACTOR SHALL BE RESPONSIBLE FOR PROTECTION OF THE EXISTING BUILDING AND ITS CONTENTS FROM THE ELEMENTS AND SHALL PROVIDE TEMPORARY ROOF PROTECTION AND COVERING AS NECESSARY.
- ALL WASTE VENTS SHALL BE A MINIMUM 10'-0" FROM ANY ROOFTOP UNIT.
- REFER TO ENGINEERING DRAWINGS FOR OTHER MISCELLANEOUS ROOF PENETRATIONS NOT SHOWN THIS DRAWING. FLASH AND SEAL ALL PENETRATIONS PER ROOFING MANUFACTURER'S STANDARD DETAILS AND RECOMMENDATIONS.
- CONTRACTOR SHALL INSURE THAT THE ROOF STRUCTURE IS NOT OVERLOADED BY THE WEIGHT OF MATERIALS, EQUIPMENT OR PERSONNEL DURING CONSTRUCTION. AT NO TIME SHALL THE ROOF BE USED FOR THE STORAGE OF ROOFING MATERIALS OR CONSTRUCTION EQUIPMENT.
- STRUCTURAL ENGINEER SHALL REVIEW THE RTU SIZES AND WEIGHTS PRIOR TO THEIR INSTALLATION.
- PROVIDE CONCRETE SPLASH BLOCKS AT ALL DOWNSPOUTS.
- NEW RIDGE VENTILATOR ATOP EXISTING BUILDING SHALL BE PROVIDED WITH AN OPERABLE LOUVER SYSTEM WHICH MAY BE MECHANICALLY OPENED OR CLOSED AS CLIMATE CONDITIONS DICTATE.
- INTERIOR ROOF PANELS SHALL BE INSULATED WITH MINIMUM 3" THICK FIBERGLASS BLANKET INSULATION WITH VINYL BACKING SECURED TO ROOF PURLINS.
- CONTRACTOR SHALL IMMEDIATELY NOTIFY THE ARCHITECT OF ANY EXISTING ROOF FRAMING MEMBERS DISCOVERED TO BE RUSTED, STRUCTURALLY DAMAGED, OR OTHERWISE DEFICIENT.

### BID ALTERNATES

#### ADD ALTERNATE #1

ALTERNATE TO INCLUDE CONSTRUCTION OF ALL INTERIOR CONSTRUCTION OF NEW ARENA SPACE. TO INCLUDE RESTROOMS, CONCESSIONS, BLEACHER SEATING, CONCRETE CURB, STEEL LINER PANELS, AND ALL ASSOCIATED PLUMBING, ELECTRICAL, AND MECHANICAL WORK. REFER TO SPECIFICATIONS FOR ADDITIONAL COMMENTS.

#### ADD ALTERNATE #2


ALTERNATE TO INCLUDE REPLACEMENT OF EXISTING METAL BUILDING SIDING AND METAL ROOFING SYSTEM, REPLACEMENT OF ALL EXTERIOR DOORS W/ HARDWARE. REFER TO SPECIFICATIONS FOR ADDITIONAL COMMENTS.

#### ADD ALTERNATE #3


ALTERNATE TO PROVIDE AND INSTALL COMMERCIAL KITCHEN EQUIPMENT DELINEATED ON SHEET A-40 AS ALTERNATE #3.

#### ADD ALTERNATE #4


ALTERNATE TO PROVIDE AND INSTALL OPERABLE PANEL PARTITION IN AUDITORIUM 136. (OVERHEAD TRACK AND SUPPORT STRUCTURE SHALL BE PROVIDED AND INSTALLED UNDER BASE BID.)

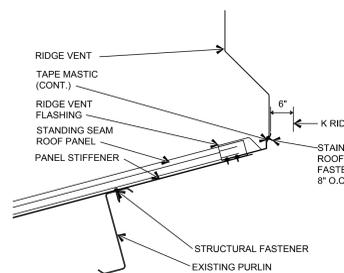


**DETAIL E**  
SCALE: 1/2" = 1'-0"

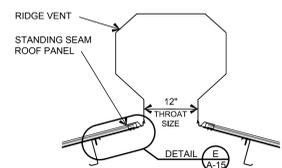


**DETAIL D**  
SCALE: 1/2" = 1'-0"

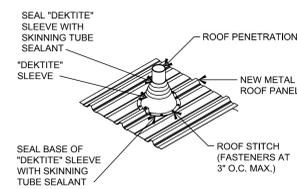



**DETAIL C**  
SCALE: 1/2" = 1'-0"

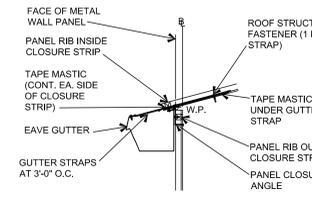

**DETAIL B**  
SCALE: 1/2" = 1'-0"


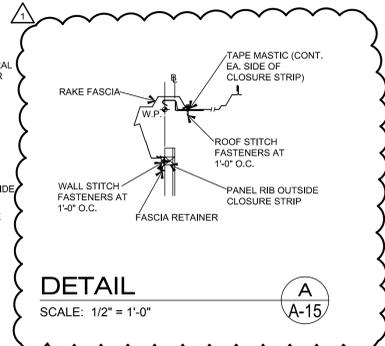


**DETAIL A**  
SCALE: 1/2" = 1'-0"

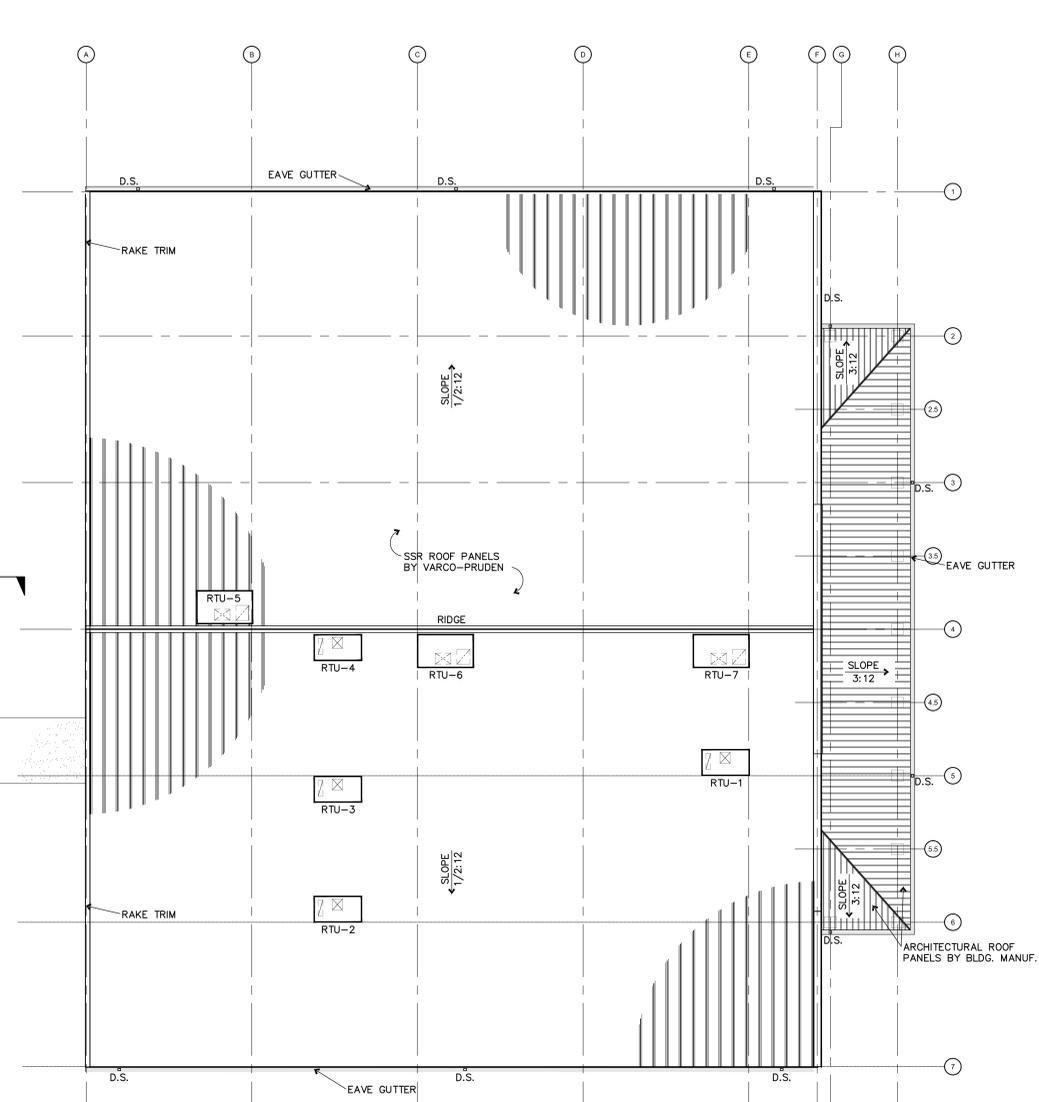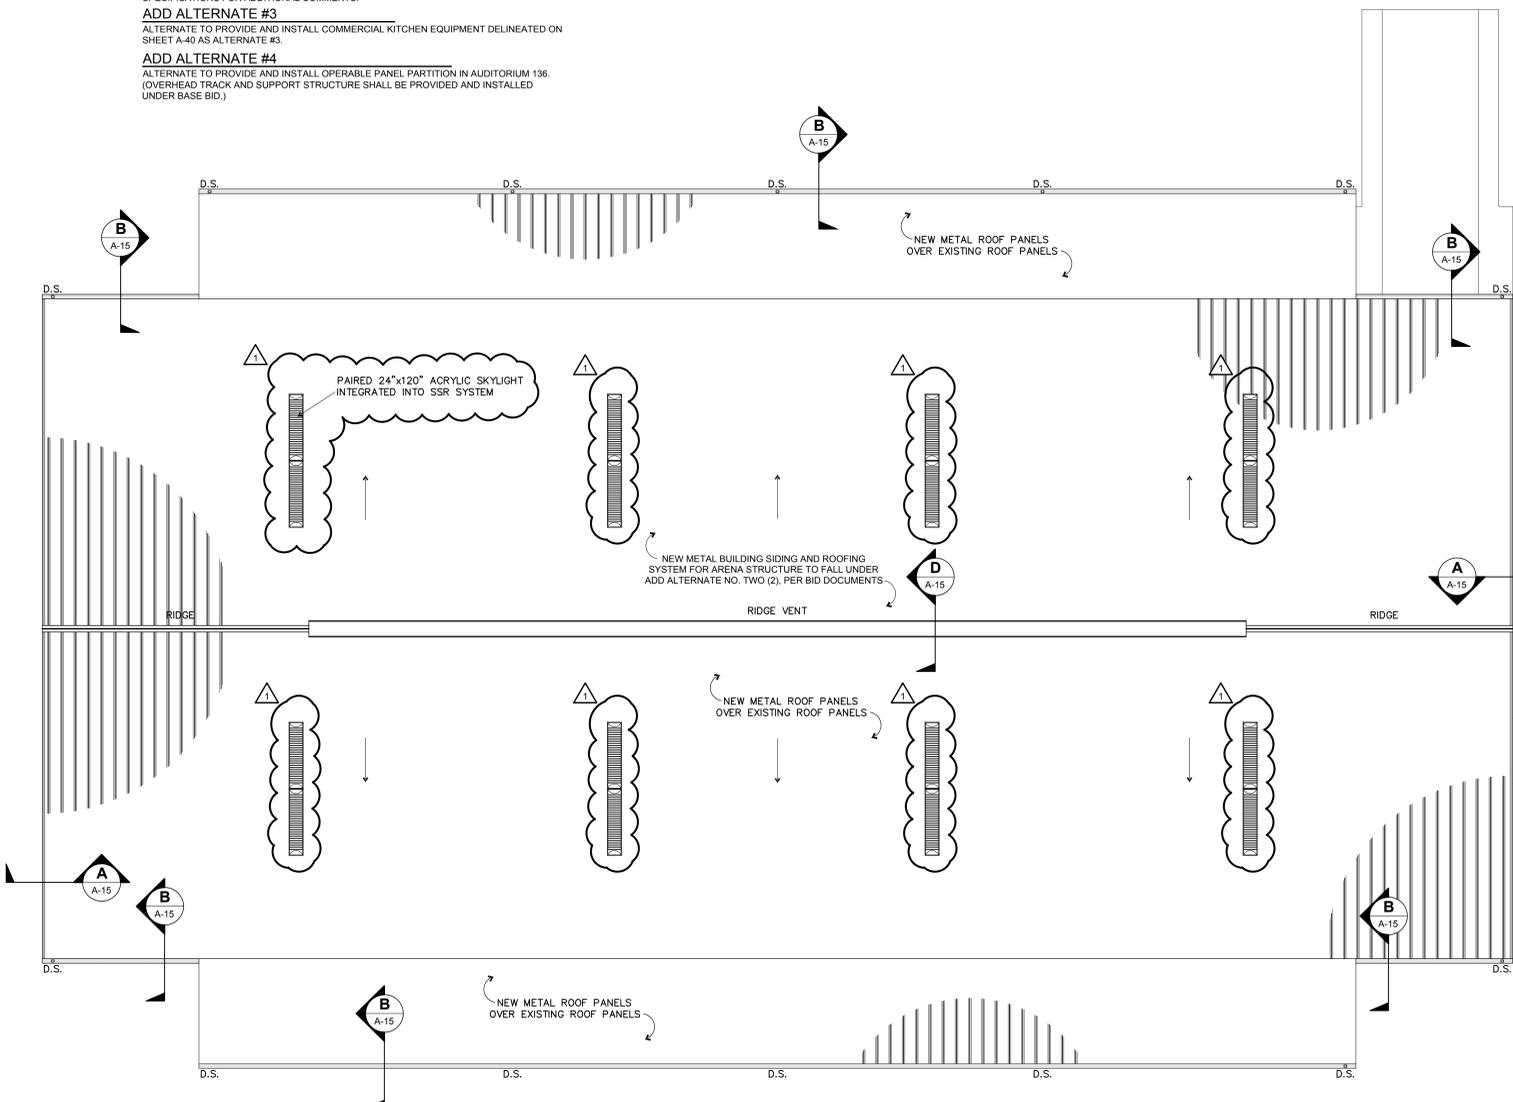

### ARENA AND OFFICE ROOF PLAN

SCALE: 3/32" = 1'-0"

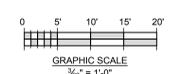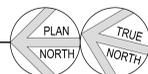


TFM No. \_\_\_\_\_

plotted: 2/16/2016 10:35:08 AM file: A-15, ROOF PLAN\_201538.DWG

no.	date	revision	By
1	02-15-16	ADDITION OF SKYLIGHT SYSTEM	CDR

A New Agricultural Facility For  
**Sullivan County Tennessee**  
 Blountville, Tennessee


**Architectural Services**  
**Cain Rash West Architects**  
 130 Regional Park Dr.  
 Kingsport, TN 37660  
 Phn (423) 349-7760  
 Fax (423) 349-7413  
 www.grcinc.com

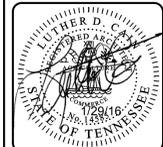

issued	1-29-16
checked	STUMP
approved	CAIN
drawn	CDR
project no.	201538
drawing name	ARENA AND OFFICE ROOF PLAN

**A-15**


THIS DRAWING IS THE PROPERTY OF ARCHITECTURAL SERVICES. IT IS TO BE USED ONLY FOR THE PROJECT AND SITE SPECIFICALLY IDENTIFIED HEREIN. IT IS NOT TO BE REPRODUCED OR TRANSMITTED IN ANY FORM OR BY ANY MEANS, ELECTRONIC OR MECHANICAL, WITHOUT THE WRITTEN PERMISSION OF ARCHITECTURAL SERVICES.

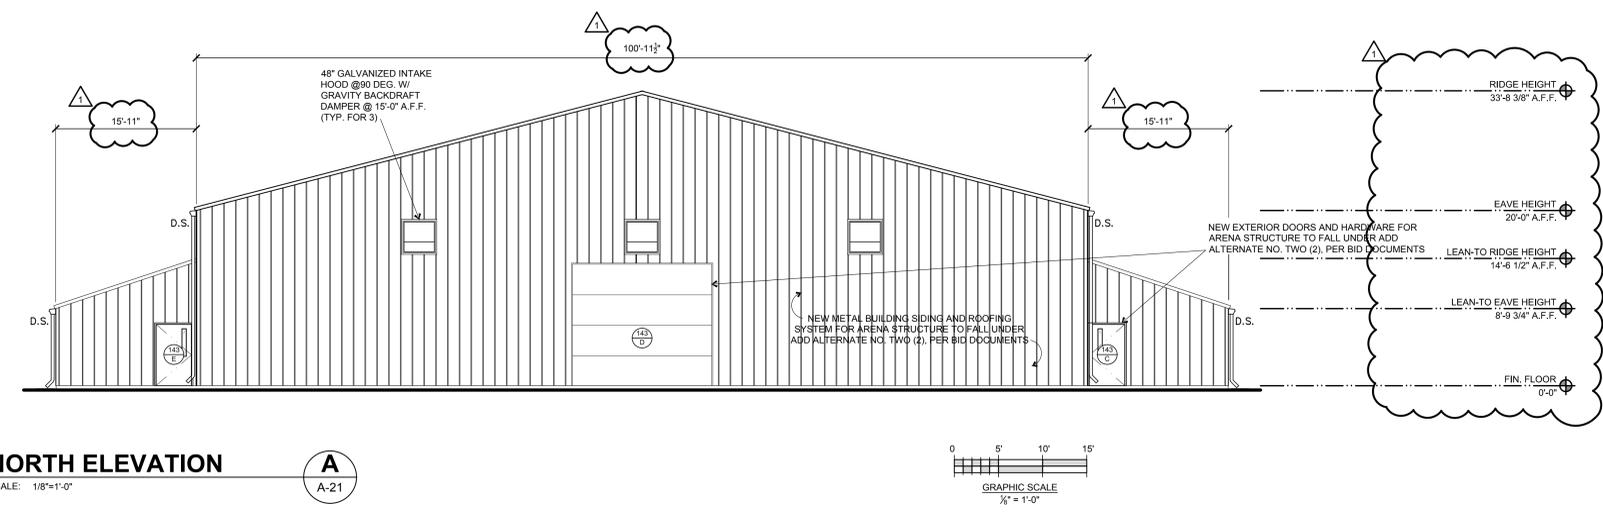


**NORTH ELEVATION**  
SCALE: 1/8"=1'-0"  
A-21

**BID ALTERNATES**

- ADD ALTERNATE #1**  
ALTERNATE TO INCLUDE CONSTRUCTION OF ALL INTERIOR CONSTRUCTION OF NEW ARENA SPACE, TO INCLUDE RESTROOMS, CONCESSIONS, BLEACHER SEATING, CONCRETE CURB, STEEL LINER PANELS, AND ALL ASSOCIATED PLUMBING, ELECTRICAL, AND MECHANICAL WORK. REFER TO SPECIFICATIONS FOR ADDITIONAL COMMENTS.
- ADD ALTERNATE #2**  
ALTERNATE TO INCLUDE REPLACEMENT OF EXISTING METAL BUILDING SIDING, AND METAL ROOFING SYSTEM, REPLACEMENT OF ALL EXTERIOR DOORS W/ HARDWARE. REFER TO SPECIFICATIONS FOR ADDITIONAL COMMENTS.
- ADD ALTERNATE #3**  
ALTERNATE TO PROVIDE AND INSTALL COMMERCIAL KITCHEN EQUIPMENT DELINEATED ON SHEET A-40 AS ALTERNATE #3.
- ADD ALTERNATE #4**  
ALTERNATE TO PROVIDE AND INSTALL OPERABLE PANEL PARTITION IN AUDITORIUM 136. (OVERHEAD TRACK AND SUPPORT STRUCTURE SHALL BE PROVIDED AND INSTALLED UNDER BASE BID.)

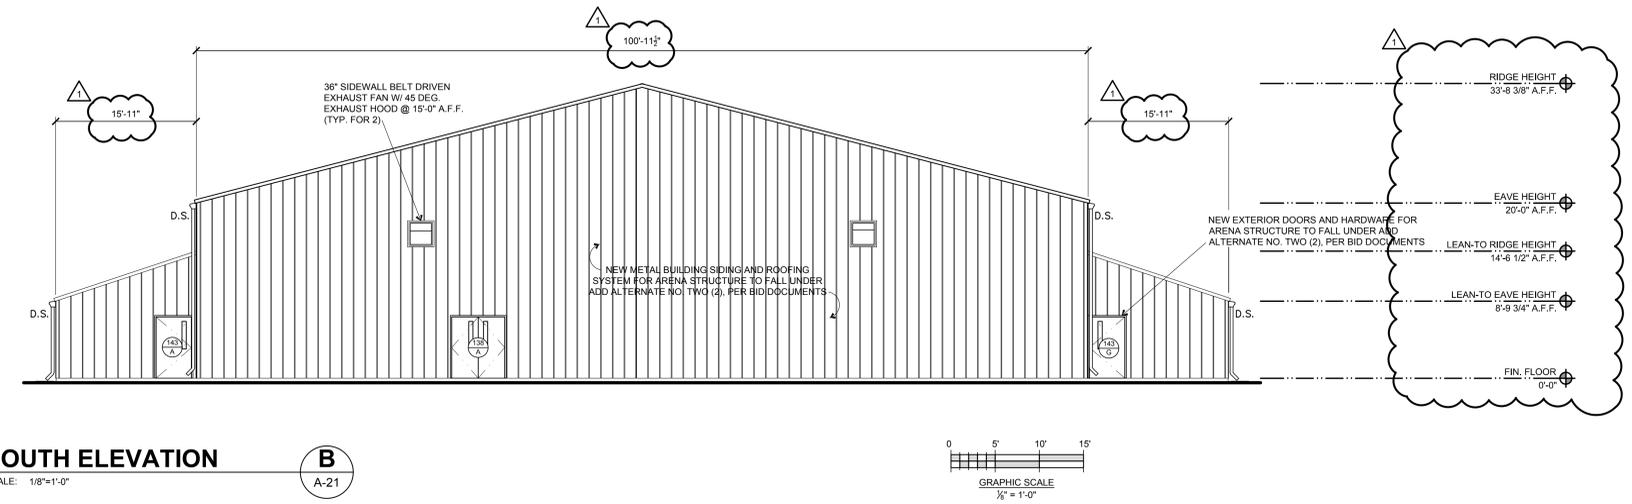

**SOUTH ELEVATION**  
SCALE: 1/8"=1'-0"  
B-21

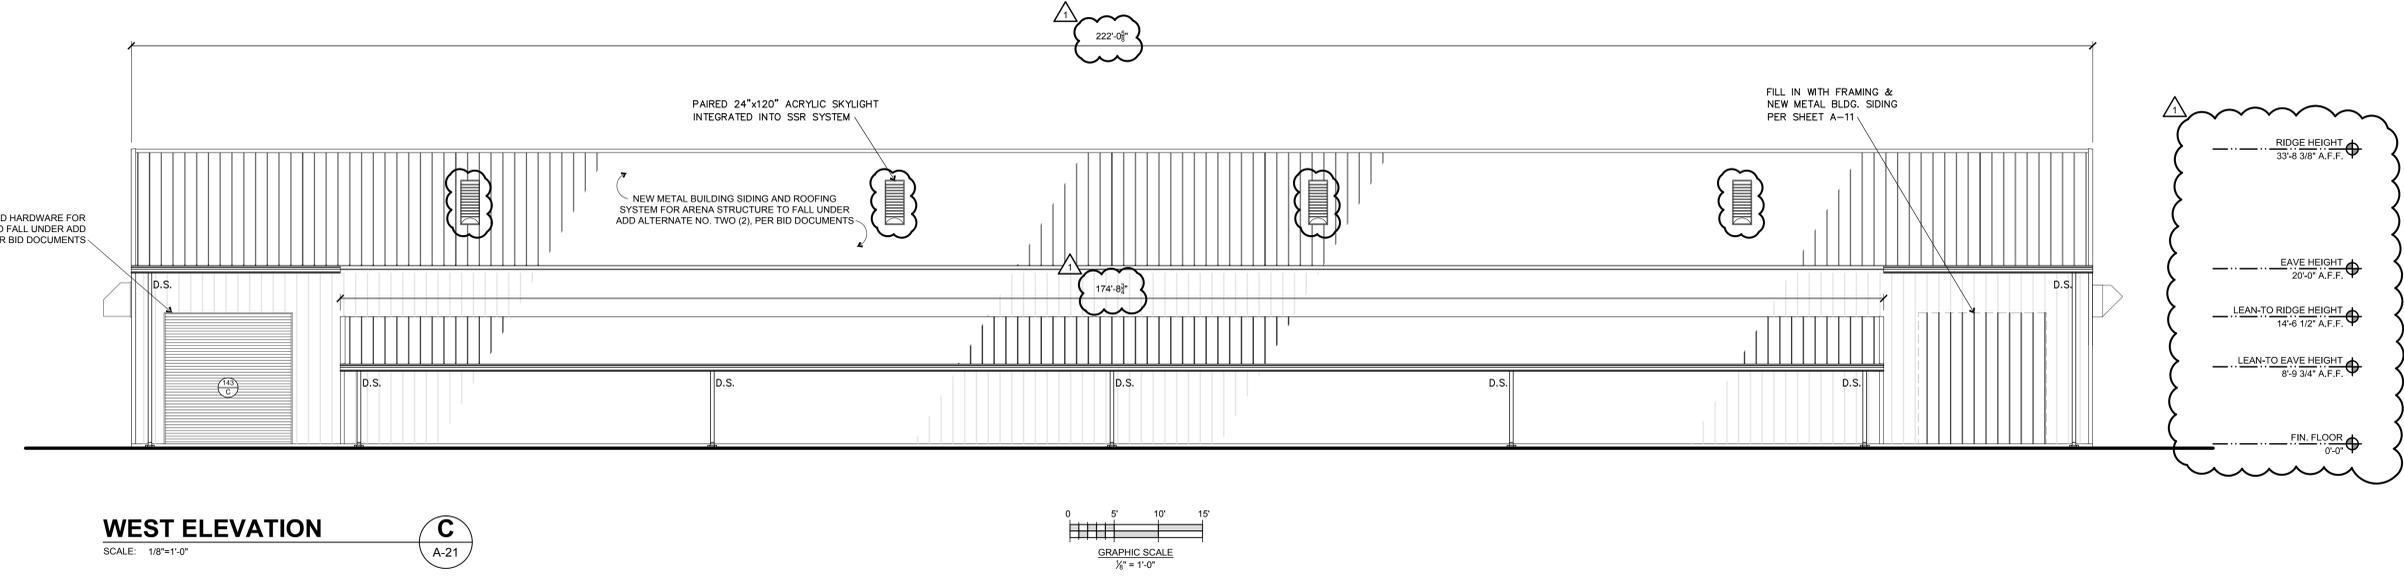

**WEST ELEVATION**  
SCALE: 1/8"=1'-0"  
C-21

no.	date	revision	CDR
1	12-15-16		

A New Agricultural Facility For  
**Sullivan County Tennessee**  
Blountville, Tennessee

**Architectural Services**  
**Cain Rash West Architects**

130 Regional Park Dr.  
Kingsport, TN 37660  
Phn (423) 349-7760  
Fax (423) 349-7413  
www.grcinc.com




issued	1-29-16
checked	STUMP
approved	CAIN
drawn	CDR
project no.	201538
drawing name	ARENA ELEVATIONS

**A-21**

plotted: 2/16/2016 10:35:22 AM file: A-20\_ELEVATIONS\_201538.DWG


THIS DRAWING IS THE PROPERTY OF CAIN RASH WEST ARCHITECTS. IT IS TO BE USED ONLY FOR THE PROJECT AND SITE SPECIFICALLY IDENTIFIED HEREON. IT IS NOT TO BE REPRODUCED, COPIED, OR TRANSMITTED IN ANY FORM OR BY ANY MEANS, ELECTRONIC OR MECHANICAL, WITHOUT THE WRITTEN PERMISSION OF CAIN RASH WEST ARCHITECTS. IT SHALL BE RETURNED FOR THEIR REQUEST.

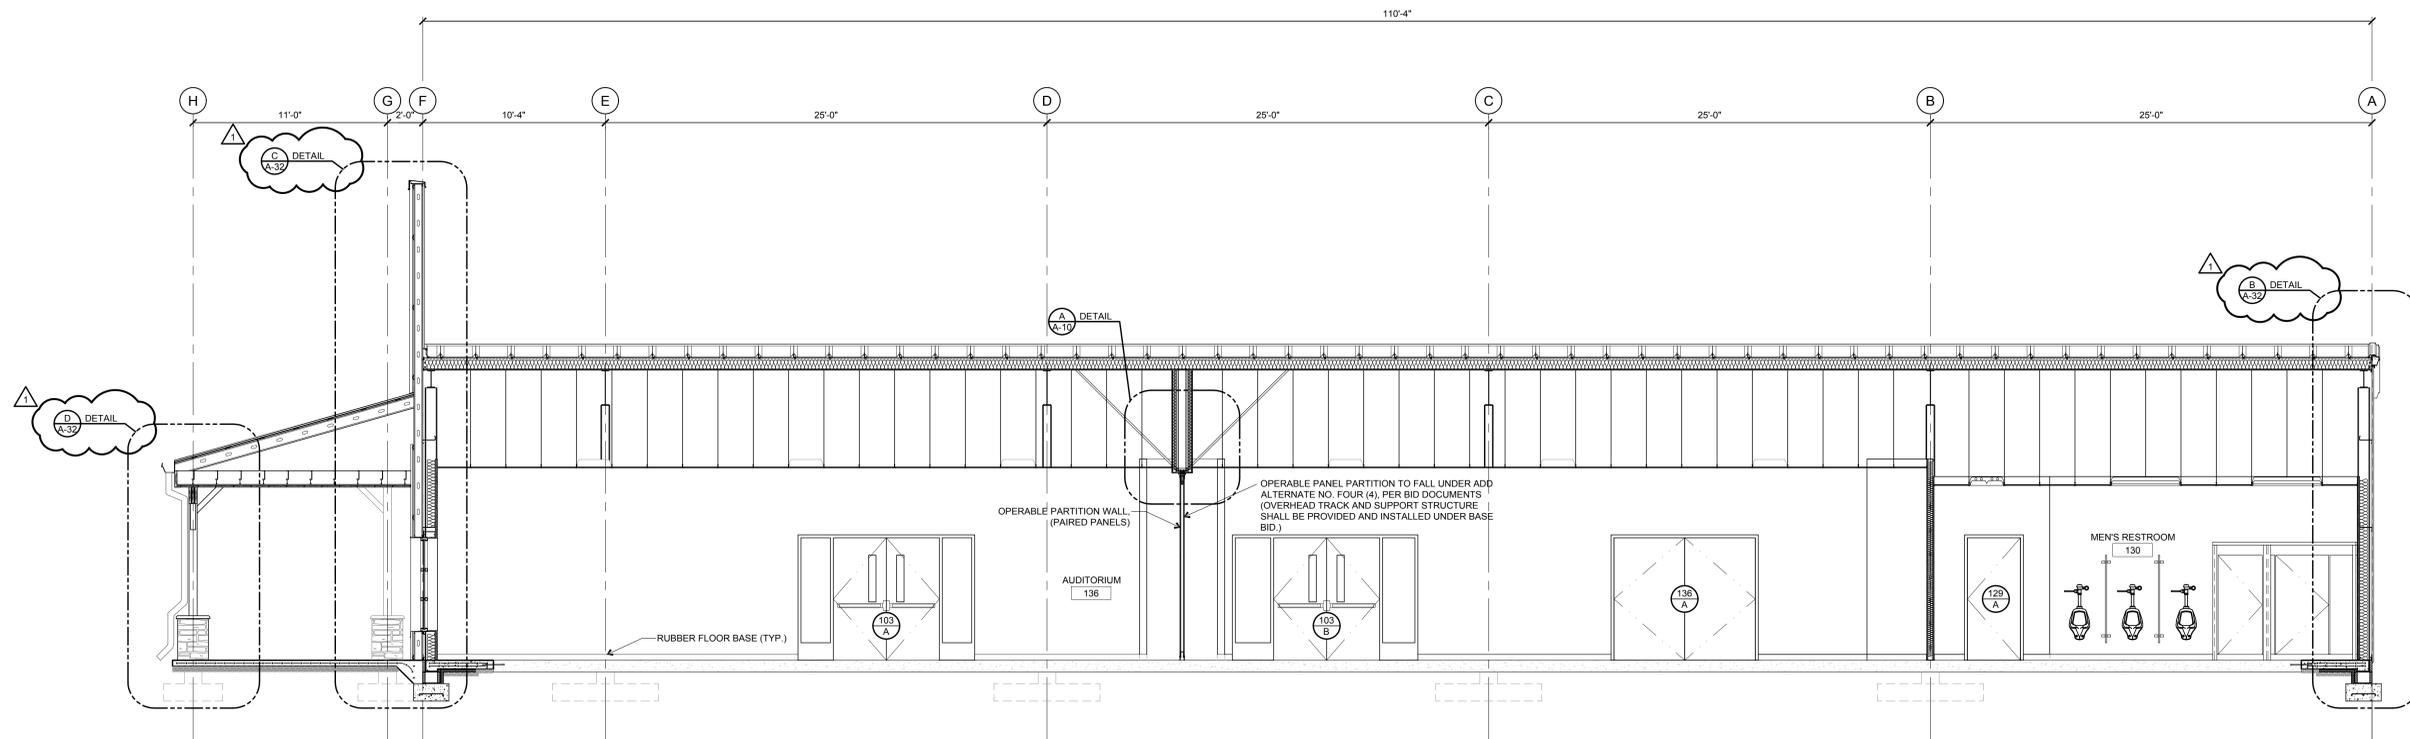

**BUILDING SECTION**


2  
A-30

SCALE: 1/4"=1'-0"

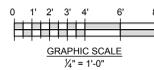

**BID ALTERNATES**

- ADD ALTERNATE #1**  
ALTERNATE TO INCLUDE CONSTRUCTION OF ALL INTERIOR CONSTRUCTION OF NEW ARENA SPACE, TO INCLUDE RESTROOMS, CONCESSIONS, BLEACHER SEATING, CONCRETE CURB, STEEL LINER PANELS, AND ALL ASSOCIATED PLUMBING, ELECTRICAL, AND MECHANICAL WORK. REFER TO SPECIFICATIONS FOR ADDITIONAL COMMENTS.
- ADD ALTERNATE #2**  
ALTERNATE TO INCLUDE REPLACEMENT OF EXISTING METAL BUILDING SIDING, AND METAL ROOFING SYSTEM, REPLACEMENT OF ALL EXTERIOR DOORS W/ HARDWARE. REFER TO SPECIFICATIONS FOR ADDITIONAL COMMENTS.
- ADD ALTERNATE #3**  
ALTERNATE TO PROVIDE AND INSTALL COMMERCIAL KITCHEN EQUIPMENT DELINEATED ON SHEET A-40 AS ALTERNATE #3.
- ADD ALTERNATE #4**  
ALTERNATE TO PROVIDE AND INSTALL OPERABLE PANEL PARTITION IN AUDITORIUM 136. (OVERHEAD TRACK AND SUPPORT STRUCTURE SHALL BE PROVIDED AND INSTALLED UNDER BASE BID.)

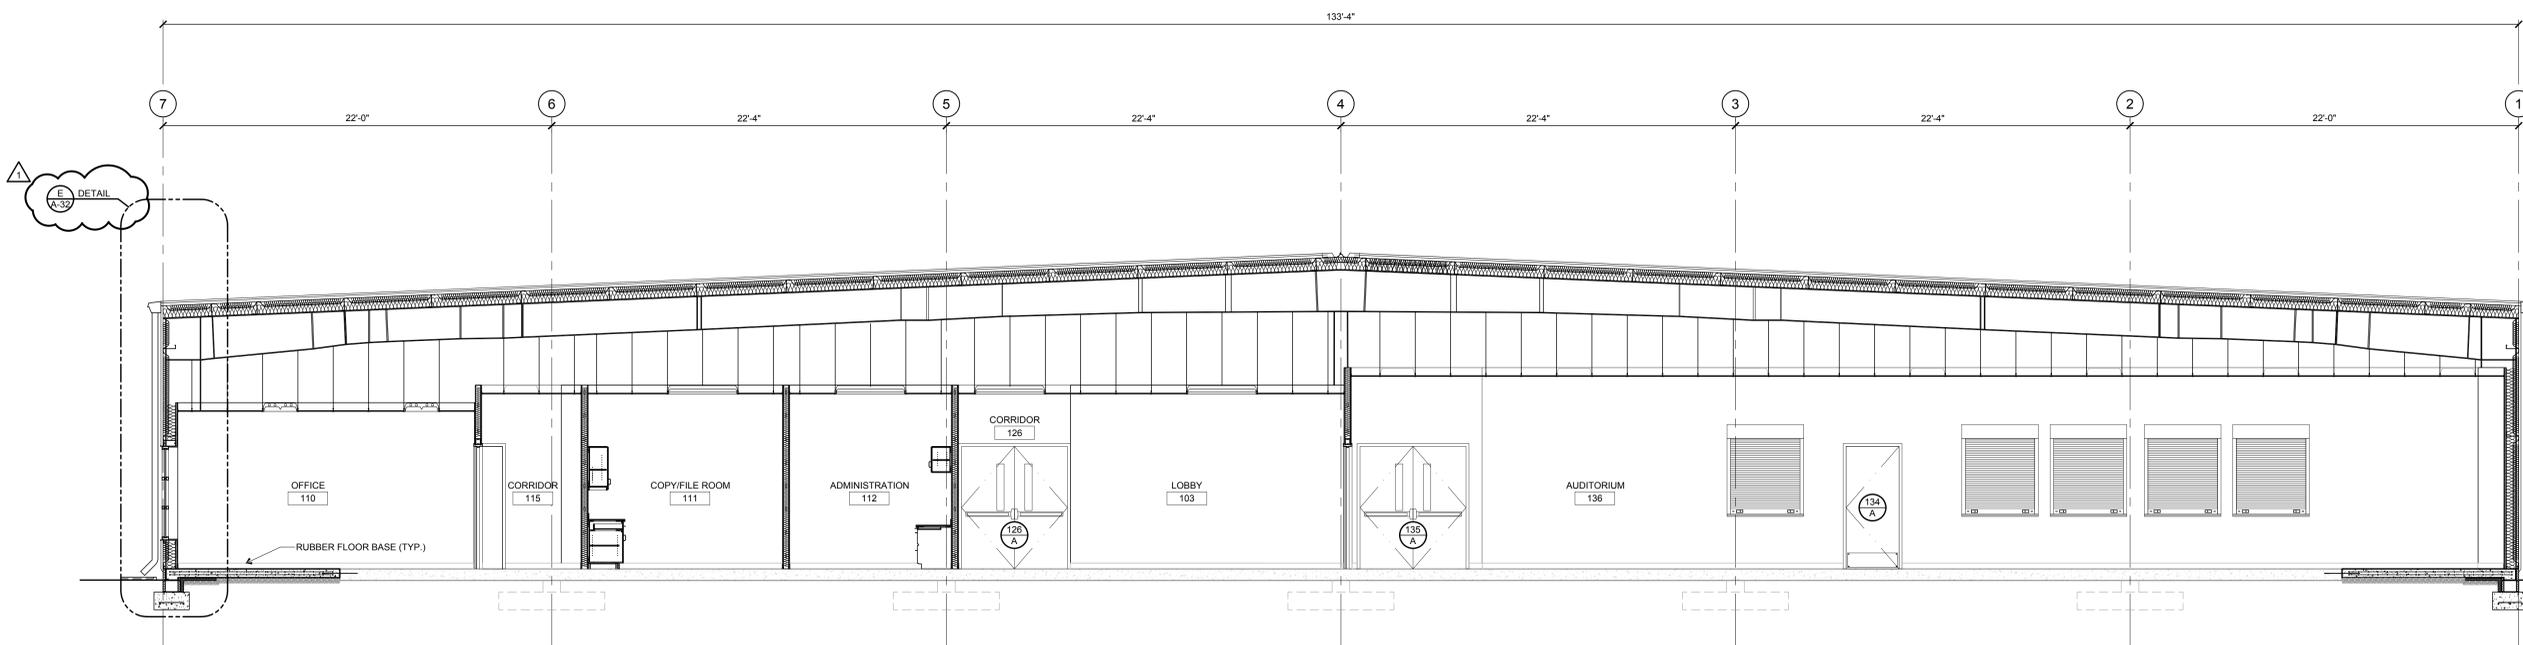

**BUILDING SECTION**

1  
A-30

SCALE: 1/4"=1'-0"




TFM No. \_\_\_\_\_

plotted: 2/16/2016 10:35:35 AM file: A-30\_BUILDING SECTIONS\_201538.DWG

no.	date	revision	by
1	02-15-16	REVISE DETAIL CALLOUTS	CDR

A New Agricultural Facility For  
**Sullivan County Tennessee**  
 Blountville, Tennessee






**Architectural Services**  
**Cain Rash West** Architects  
 130 Regional Park Dr.  
 Kingsport, TN 37660  
 Phn (423) 349-7760  
 Fax (423) 349-7413  
 www.grcinc.com

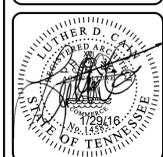

issued	1-29-16
checked	STUMP
approved	CAIN
drawn	CDR
project no.	201538
drawing name	OFFICE BUILDING SECTIONS

**A-30**

THIS DRAWING IS THE PROPERTY OF CAIN RASH WEST ARCHITECTS. IT IS TO BE USED ONLY FOR THE PROJECT AND SITE SPECIFICALLY IDENTIFIED HEREON. IT IS NOT TO BE REPRODUCED, COPIED, OR TRANSMITTED IN ANY FORM OR BY ANY MEANS, ELECTRONIC OR MECHANICAL, WITHOUT THE WRITTEN PERMISSION OF CAIN RASH WEST ARCHITECTS.

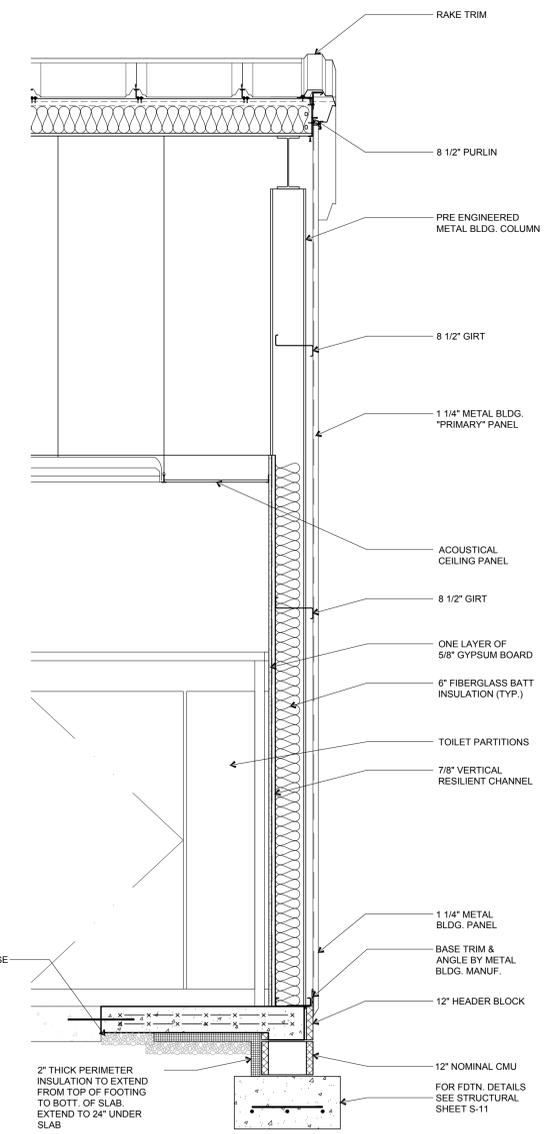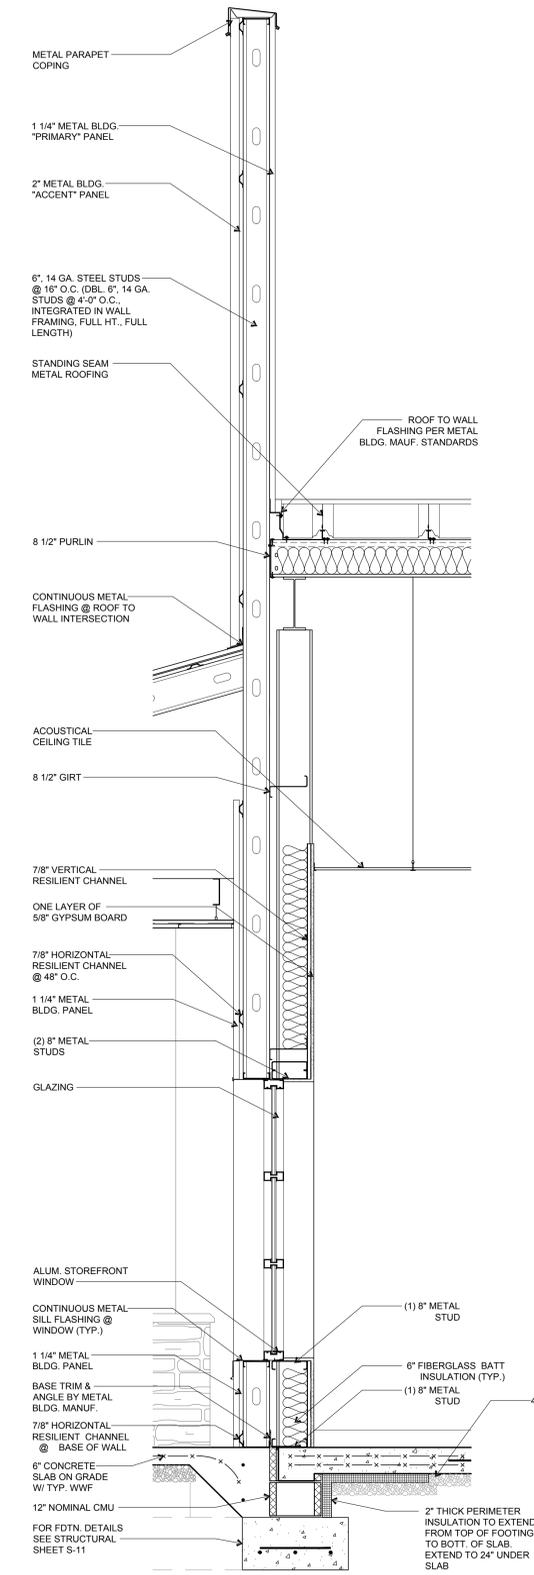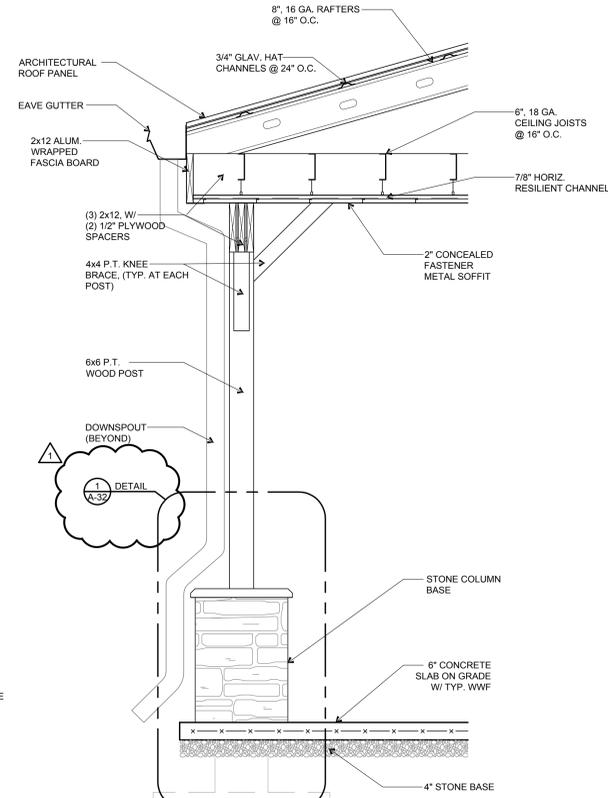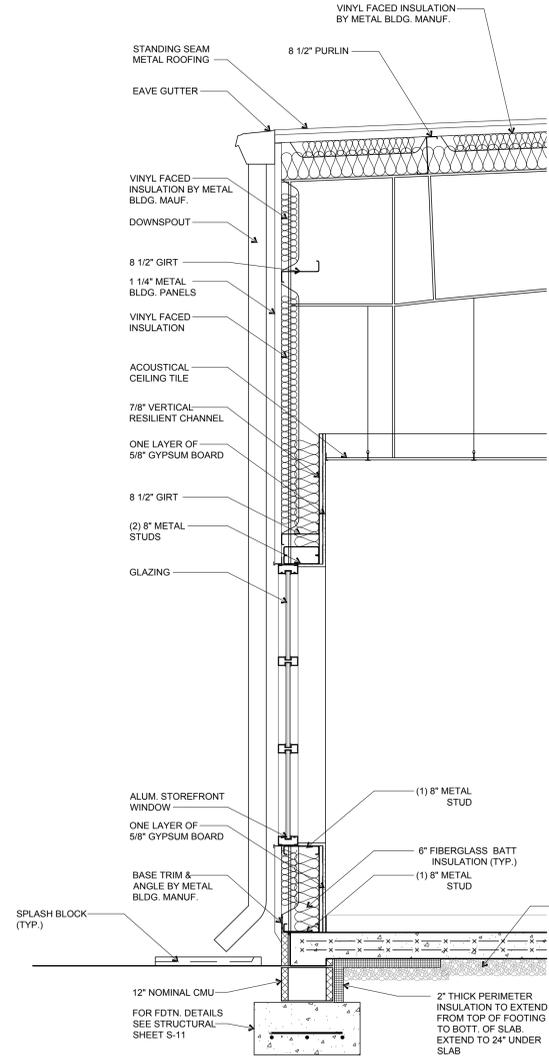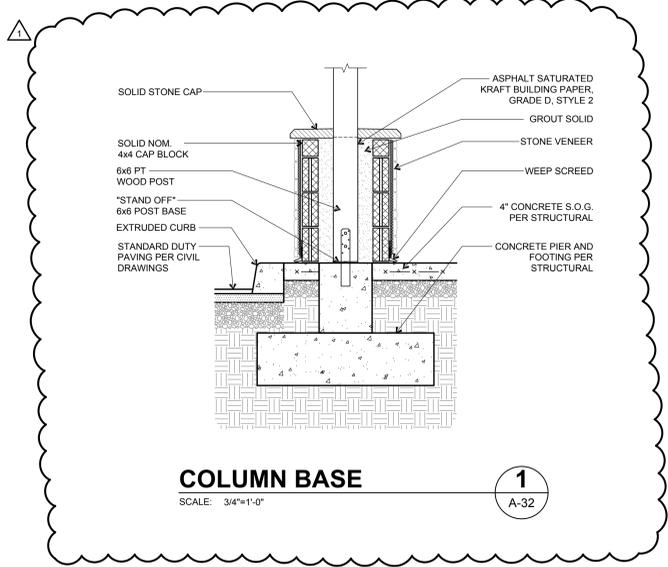

plotted: 2/16/2016 10:35:55 AM file: A-32 WALL SECTIONS\_201538.DWG

TFM No. \_\_\_\_\_

1	02-15-16	REVISE DETAIL CALLOUTS & ADD OF COLUMN BASE DETAIL	CDR
			By

A New Agricultural Facility For  
**Sullivan County Tennessee**  
Blountville, Tennessee

**Cain Rash West** Architects

130 Regional Park Dr.  
Kingsport, TN 37660  
Phn (423) 349-7760  
Fax (423) 349-7413  
www.grcinc.com



issued	1-29-16
checked	STUMP
approved	NAME
drawn	CAIN
project no.	201538
drawing name	WALL SECTIONS

**A-32**

### KITCHEN EQUIPMENT SCHEDULE

MARK	DESCRIPTION	MANUFACTURER	MODEL NUMBER
1	AUTOMATIC DISHWASHER	HOBART	AM-15T
2	STAINLESS STEEL WORK SURFACE W/DROP-IN SINK	CUSTOM	—
3	HANDWASHING SINK W/ FOOT PEDAL	ADVANCE TABCO	7-PS-90
4	WALK-IN FREEZER	KOLPAK	—
5	COOLER / FREEZER SHELVING	METROSEAL SHELVING	0000NK
6	FOOD PROCESSOR	ROBOT COUPE	R2N
7	VEGETABLE TABLE / SINK	ADVANCE TABCO	DL-2-1410
8	PASS-THRU HEATED CABINET	METRO	CS, 6-SERIES
9	STAINLESS STEEL WORK TABLE	ADVANCE TABCO	SS-245
10	20 QUART MIXER	HOBART	A200T
11	STAINLESS STEEL WORK TABLE	ADVANCE TABCO	SS-3012
12	WIRE SHELVING	METRO	0000NZ
13	UNDER COUNTER WAREWASHER	NOBLE	UL30
14	DISH / POT SINK "900 SERIES" (3-COMPARTMENT)	ADVANCE TABCO	9-23-60-36RL
15	REACH-IN REFRIGERATOR	AVANTCO	CFD SERIES
16	REACH-IN FREEZER	AVANTCO	CFD SERIES
17	STAINLESS STEEL BRAISING PAN	GROEN	BPP-30E
18	48" LP RANGE	VULCAN (OR) BAKERS PRIDE	E48L SERIES 48" RESTAURANT SERIES
19	ELECTRIC CONVECTION OVEN	VULCAN (OR) MANTOVOK	ECC02D SUNFIRE SCO SERIES SCO-ES-10S
20	28 LB. FLOOR FRYER	PITCO FRIALATOR	E12A
21	STAINLESS STEEL WORK TABLE	ADVANCE TABCO	SS-3012
22	STAINLESS STEEL CAFETERIA SERVING TABLE	ADVANCE TABCO	SS-305
23	STAINLESS STEEL WORK TABLE	ADVANCE TABCO	SS248
24	MODULAR CONTOUR ICE CUBERS	SCOTSMAN	C0330
25	MODULAR ICE STORAGE BIN	SCOTSMAN	B530P/S
26	HEAVY DUTY DISPOSER	ISE IN-SINK-ERATOR	SS-200
27	RANGE HOOD	CAPTIVEAIRE	SWI
28	MIXER	KITCHEN AID	KSMC50SWH-WHITE
29	3 COMPARTMENT HOT WELL (2)	ADVANCE TABCO	DISW-3-120

THE OWNER'S REPRESENTATIVE'S CONFIRMATION SHOULD BE OBTAINED FOR THE SPECIFIC IDENTIFIED PRODUCTS. THIS DOCUMENT IS THE PROPERTY OF CAIN RASH WEST ARCHITECTS AND SHALL BE RETURNED UPON THEIR REQUEST.

ALL LISTED KITCHEN EQUIPMENT TO FALL UNDER ADD ALTERNATE NO. THREE (3), PER BID DOCUMENTS

### ACCESSORIES SCHEDULE

MARK	DESCRIPTION	MANUFACTURER/ MODEL NO.	REMARKS
1	42" GRAB BAR	BOBRICK B-6806.99x42	PEENED FINISH
2	36" GRAB BAR	BOBRICK B-6806.99x36	PEENED FINISH
3	18" GRAB BAR (VERTICAL)	BOBRICK B-6806.99x18	PEENED FINISH
4	TOILET TISSUE DISPENSER	BOBRICK B-6857	SURFACE MOUNTED
5	24" x 30" MIRROR	BOBRICK B-165 2430	CHANNEL FRAMED
6	PAPER TOWEL DISPENSER / WASTE	BOBRICK B-369	CLASSIC SERIES, RECESSED
7	LIQUID SOAP DISPENSER	BOBRICK B-2111	CLASSIC SERIES, SURFACE MOUNTED
8	MOP AND BROOM HOLDER	BOBRICK B-223x24	—
9	CLOTHES HOOKS	BOBRICK B-2116	HEAVY DUTY, CONCEALED MOUNTING
10	BABY CHANGING STATION	BOBRICK KB200-00	HORIZONTAL WALL MOUNTED, 35"x22" POLYPROPYLENE
11	PAPER TOWEL DISPENSER	BOBRICK B-262	CLASSIC SERIES, SURFACE MOUNTED
12	STAINLESS STEEL WASTE RECEPTACLE	BOBRICK B-2280	FLOOR MOUNTED WITH OPEN TOP

NOTE: ALL ITEMS AND ACCESSORIES SCHEDULED ABOVE ARE INTENDED TO ESTABLISH A STANDARD OF QUALITY. EQUAL (OR SUPERIOR) PRODUCTS BY ALTERNATE MANUFACTURERS ARE ACCEPTABLE. DETERMINATION AS TO THE EQUALITY OF PROPOSED SUBSTITUTIONS SHALL BE MADE SOLELY BY THE ARCHITECT.

### BID ALTERNATES

#### ADD ALTERNATE #1

ALTERNATE TO INCLUDE CONSTRUCTION OF ALL INTERIOR CONSTRUCTION OF NEW ARENA SPACE, TO INCLUDE RESTROOMS, CONCESSIONS, BLEACHER SEATING, CONCRETE CURB, STEEL LINER PANELS, AND ALL ASSOCIATED PLUMBING, ELECTRICAL, AND MECHANICAL WORK. REFER TO SPECIFICATIONS FOR ADDITIONAL COMMENTS.

#### ADD ALTERNATE #2


ALTERNATE TO INCLUDE REPLACEMENT OF EXISTING METAL BUILDING SIDING AND METAL ROOFING SYSTEM. REPLACEMENT OF ALL EXTERIOR DOORS W/ HARDWARE. REFER TO SPECIFICATIONS FOR ADDITIONAL COMMENTS.

#### ADD ALTERNATE #3


ALTERNATE TO PROVIDE AND INSTALL COMMERCIAL KITCHEN EQUIPMENT DELINEATED ON SHEET A-40 AS ALTERNATE #3.

#### ADD ALTERNATE #4


ALTERNATE TO PROVIDE AND INSTALL OPERABLE PANEL PARTITION IN AUDITORIUM 136. (OVERHEAD TRACK AND SUPPORT STRUCTURE SHALL BE PROVIDED AND INSTALLED UNDER BASE BID.)

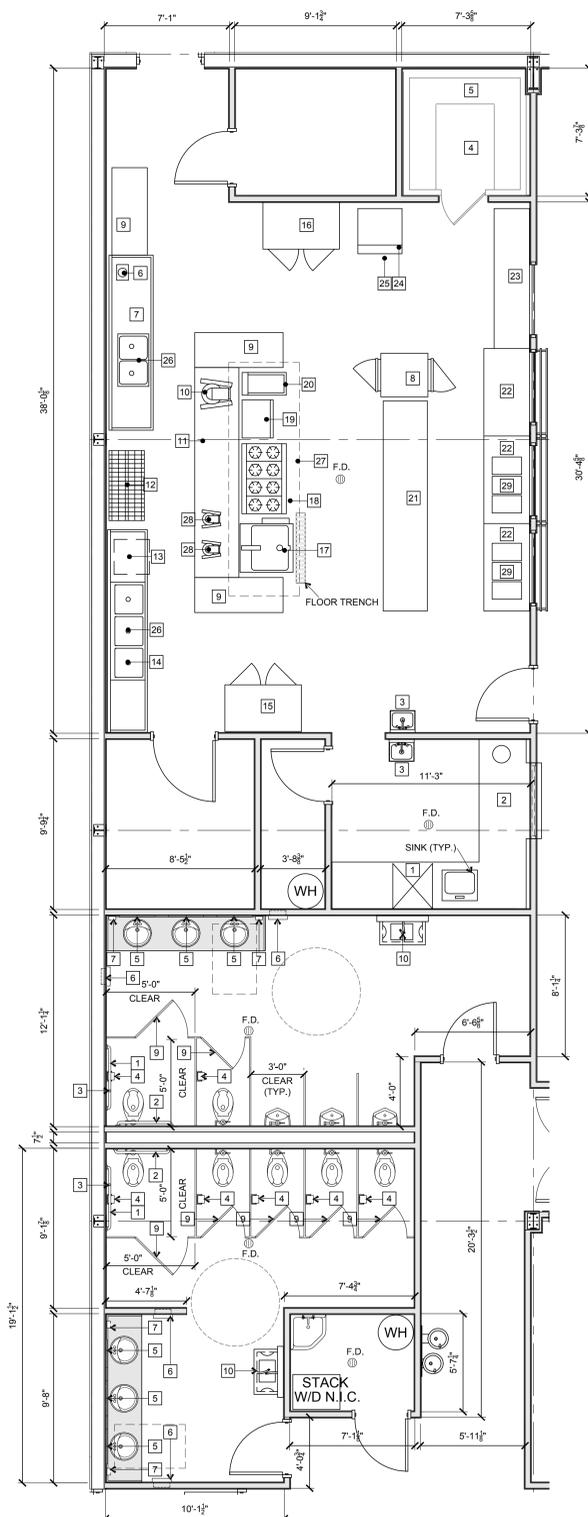


**PARTIAL FLOOR PLAN A**  
SCALE: 1/4"=1'-0"  
A-40

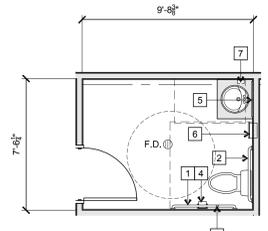


**PARTIAL FLOOR PLAN B**  
SCALE: 1/4"=1'-0"  
A-40

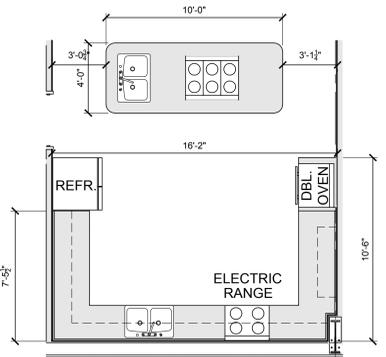

**PARTIAL FLOOR PLAN C**  
SCALE: 1/4"=1'-0"  
A-40

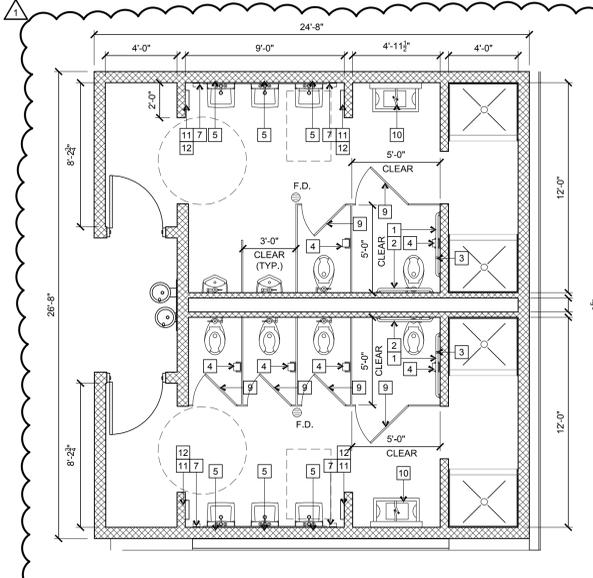

**PARTIAL FLOOR PLAN D**  
SCALE: 1/4"=1'-0"  
A-40

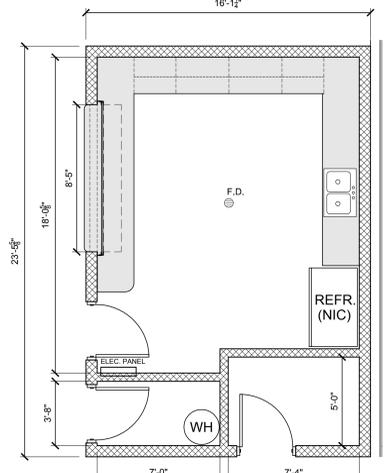

**PARTIAL FLOOR PLAN E**  
SCALE: 1/4"=1'-0"  
A-40

no.	date	revision	CDR	BY
1	02-15-16	REVISION OF 8' NOM. CMU WALL DIMENSIONS		

A New Agricultural Facility For  
**Sullivan County Tennessee**  
Blountville, Tennessee

**Cain Rash West Architects**  
Architects

130 Regional Park Dr.  
Kingsport, TN 37660  
Phn (423) 349-7760  
Fax (423) 349-7413  
www.grcinc.com



issued	1-29-16
checked	STUMP
approved	CAIN
drawn	CDR / DLS
project no.	201538
drawing name	PARTIAL FLOOR PLANS, ACCESSORY SCHED.

**A-40**

THIS DRAWING IS PROVIDED BY CONTRACTOR AS A REFLECTED CEILING PLAN. THE CONTRACTOR SHALL VERIFY ALL CONDITIONS ON SITE. IN THE EVENT DIMENSIONS ARE IN QUESTION OR IF ANY DISCREPANCIES ARE ENCOUNTERED DURING CONSTRUCTION, THE CONTRACTOR IS REQUIRED TO NOTIFY THE ARCHITECT FOR CLARIFICATIONS PRIOR TO PROCEEDING WITH THE WORK.

### GENERAL CEILING NOTES

- CONTRACTOR SHALL VERIFY ALL CONDITIONS ON SITE. IN THE EVENT DIMENSIONS ARE IN QUESTION OR IF ANY DISCREPANCIES ARE ENCOUNTERED DURING CONSTRUCTION, THE CONTRACTOR IS REQUIRED TO NOTIFY THE ARCHITECT FOR CLARIFICATIONS PRIOR TO PROCEEDING WITH THE WORK.
- CONTRACTOR SHALL NOT SCALE THIS OR ANY OTHER DRAWING IN BID PACKAGE. DIMENSIONS SHALL ALWAYS TAKE PRECEDENCE. CONTACT ARCHITECT FOR CLARIFICATION CONCERNING ANY AND ALL DISCREPANCIES.
- ALL DIMENSIONS SHOWN ON REFLECTED CEILING PLAN ARE FINISH DIMENSIONS.
- ALL GYPSUM BOARD SOFFIT AND CEILING HEIGHTS INDICATED SHALL BE MEASURED FROM BOTTOM OF FINISH SURFACE TO FINISHED FLOOR DIRECTLY BELOW.
- ALL GYPSUM BOARD SOFFITS AND CEILINGS, EXCEPT AS NOTED OR DIMENSIONED OTHERWISE SHALL BE CONSTRUCTED OF 24 GAUGE 3 5/8" METAL STUDS AT 16" O.C. WITH 12" GYPSUM BOARD AND BRACED TO STRUCTURE ABOVE AS REQUIRED FOR LATERAL STABILITY, AND TO SATISFACTION OF STRUCTURAL ENGINEER.
- ALL CEILING HEIGHTS NOT INDICATED SHALL BE 9'-0" ABOVE FINISHED FLOOR.
- ALL DUCTWORK IS TO BE BRACED TO STRUCTURE ABOVE AND SHALL NOT REST ON CEILINGS OR SOFFITS.
- SEE SPECIFICATIONS AND FINISH PLANS FOR SUSPENDED ACOUSTICAL TILE CEILING TYPES.
- ALL GRIDS NOT SPECIFICALLY LOCATED SHALL BE CENTERED IN SPACE AS SHOWN.
- ALL DIMENSIONS MARKED ALPHABETICALLY ALIKE SHALL BE EQUAL.
- REFER TO ELECTRICAL AND MECHANICAL DRAWINGS FOR ALL ADDITIONAL LIGHTING FIXTURES, DIFFUSERS, AND OTHER CEILING APPURTENANCES NOT SHOWN. ARCHITECTURAL DRAWINGS SHALL TAKE PRECEDENCE OVER MEP DRAWINGS, CONCERNING LOCATIONS OF CEILING FIXTURES AND APPURTENANCES.
- ACOUSTICAL CEILING INSTALLATION SHALL BE COORDINATED WITH ALL OTHER TRADES PRIOR TO COMMENCEMENT OF WORK.
- SEE ROOF DETAILS AND WALL SECTIONS FOR SOFFIT AND OVERHANG DIMENSIONS.
- FULL CEILING TILE DENOTED BY:  $\frac{1}{2} \frac{F}{\downarrow}$

### BID ALTERNATES

#### ADD ALTERNATE #1

ALTERNATE TO INCLUDE CONSTRUCTION OF ALL INTERIOR CONSTRUCTION OF NEW ARENA SPACE, TO INCLUDE RESTROOMS, CONCESSIONS, BLEACHER SEATING, CONCRETE CURB, STEEL LINER PANELS, AND ALL ASSOCIATED PLUMBING, ELECTRICAL, AND MECHANICAL WORK. REFER TO SPECIFICATIONS FOR ADDITIONAL COMMENTS.

#### ADD ALTERNATE #2

ALTERNATE TO INCLUDE REPLACEMENT OF EXISTING METAL BUILDING SIDING, AND METAL ROOFING SYSTEM, REPLACEMENT OF ALL EXTERIOR DOORS W/ HARDWARE, REFER TO SPECIFICATIONS FOR ADDITIONAL COMMENTS.

#### ADD ALTERNATE #3

ALTERNATE TO PROVIDE AND INSTALL COMMERCIAL KITCHEN EQUIPMENT DELINEATED ON SHEET A-40 AS ALTERNATE #3.


#### ADD ALTERNATE #4

ALTERNATE TO PROVIDE AND INSTALL OPERABLE PANEL PARTITION IN AUDITORIUM 136. (OVERHEAD TRACK AND SUPPORT STRUCTURE SHALL BE PROVIDED AND INSTALLED UNDER BASE BID.)


### LEGEND

- 12"x48" SURFACE MOUNTED LED LIGHT FIXTURE
- 24"x48" LAY-IN LED LIGHT FIXTURE
- 24"x24" LAY-IN LED LIGHT FIXTURE
- STEM HUNG LED LIGHT FIXTURE
- 8 5/16"x48" SURFACE MOUNTED FLUORESCENT
- GYPSUM BOARD CEILING OR SOFFIT
- MOISTURE RESISTANT GYPSUM BOARD CEILING
- HVAC SUPPLY DIFFUSER
- HVAC RETURN AIR GRILLE
- EXHAUST FAN
- (ACT 1) 24"x24"x5/8" CORTEGA TEGULAR EDGE SUSPENDED ACOUSTICAL CEILING TILE (MEDIUM TEXTURE) AND 15/16" GRID. (TYP. WHERE NOT NOTED)
- (ACT 2) 24"x24"x3/4" ULTIMA TEGULAR BEVELED EDGE SUSPENDED ACOUSTICAL CEILING TILE (FINE TEXTURE) AND 9/16" GRID.
- FLUSH METAL PANEL CEILING
- RECESSED LED CAN LIGHT FIXTURE
- EXTERIOR RECESSED INCANDESCENT CAN LIGHT FIXTURE
- EXIT SIGN
- EMERGENCY LIGHT
- SPRINKLER HEAD
- WALL MOUNTED SPRINKLER HEAD
- SMOKE DETECTOR
- HEAT DETECTOR
- PROJECTOR (NIC)

ALL LISTED KITCHEN EQUIPMENT TO FALL UNDER ADD ALTERNATE NO. THREE (3), PER BID DOCUMENTS.

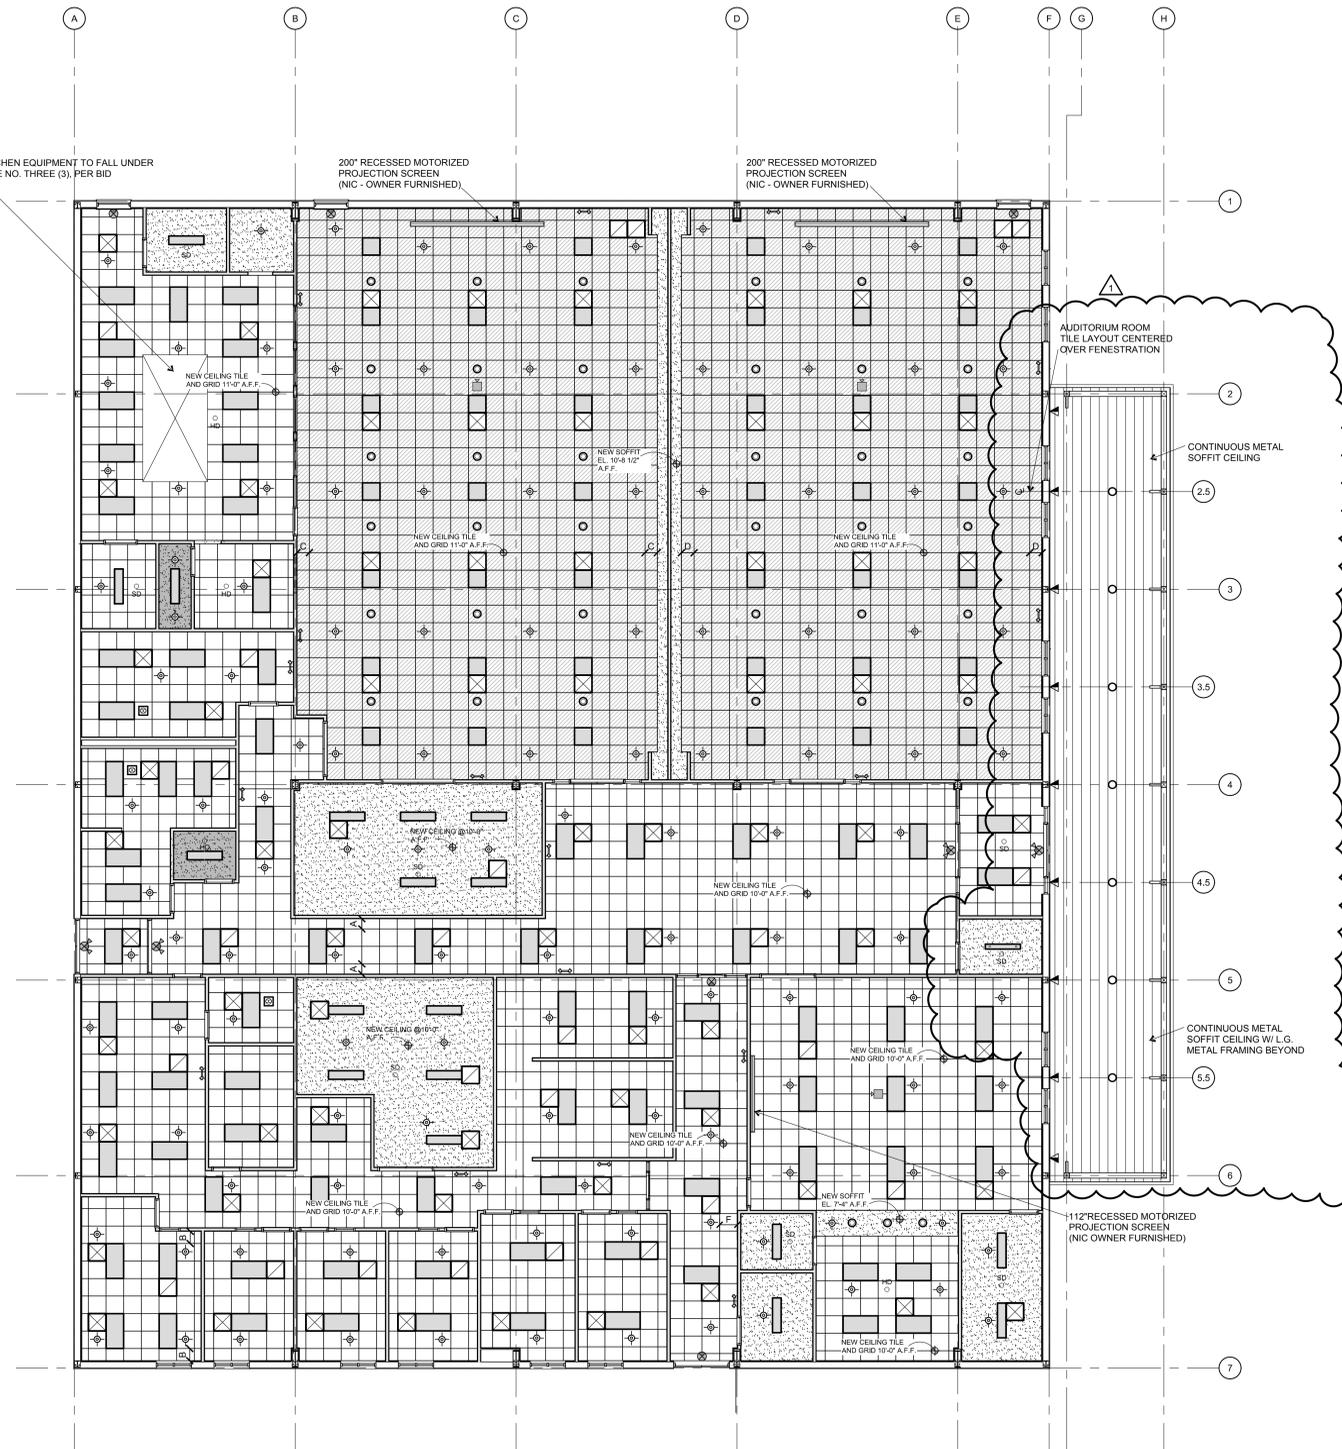


INTERIOR WORK OF THE ARENA TO FALL UNDER ADD ALTERNATE NO. ONE (1), PER BID DOCUMENTS.

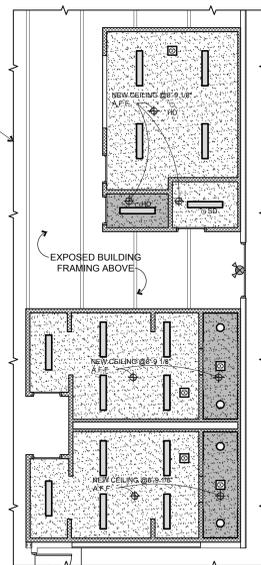



### REFLECTED CEILING PLAN - ARENA RESTROOMS & CONCESSION

SCALE: 1/8" = 1'-0"

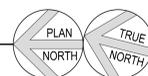

### REFLECTED CEILING PLAN - OFFICE

SCALE: 1/8" = 1'-0"

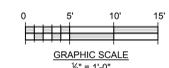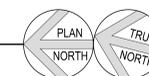


TFM No. \_\_\_\_\_

CDR	By
12-15-16	date
1	revision
	no.
	of
	revisions
	of
	overhang

A New Agricultural Facility For  
**Sullivan County Tennessee**  
 Blountville, Tennessee

**Architectural Services**  
**Cain Rash West Architects**

130 Regional Park Dr.  
 Kingsport, TN 37660  
 Phn (423) 349-7760  
 Fax (423) 349-7413  
 www.grcinc.com

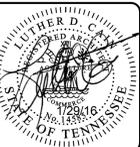

issued	1-29-16
checked	STUMP
approved	CAIN
drawn	CDR
project no.	201538
drawing name	REFLECTED CEILING PLAN - OFFICE & ARENA

I-21

plotted: 2/16/2016 11:38:12 AM file: I-21\_RCP\_201538.DWG

