

# SANITARY SEWERS

NO	TOP EL.	INV. EL.
A	1172.0	1165.0
B	1163.0	1157.6
C	1163.75	1156.2
D	1163.0	1155.0
E	1163.3	1154.2
F	1153.4	1152.0
G	1156.0	1151.0
H	1151.2	1145.0
A-A	1163.6	1160.4

# STORM SEWERS

MAN HOLES			CATCH BASINS		
NO	TOP EL	INV. EL	NO	TOP EL	INV. EL
I	1163.3	1154.0	1	1163.0	1159.1
J	1158.4	1152.0	2	1163.0	1157.6
K	1155.2	1151.0	3	1163.0	1156.0
L	1152.7	1147.0	4	1157.0	1153.5
			5	1157.0	1153.0
			6	1156.8	1154.0
			7	1156.8	1153.0
			8	1161.7	1158.0
			9	1161.6	1158.6
			10	1175.0	1172.5
			11	Do	1172.0
			12	Do	1171.7
			13	Do	1171.5
			14	Do	1171.0
			15	1175.0	1170.5
			16	1164.25	1162.95

BLDG. DEPT COPY

RECEIVED

MAY 21 1990


BUILDING/ZONING DEPT.  
CITY OF TALLMADGE

~~Provide complete electrical and heating plans for review and approval.~~

Rec'd  
6/1/90  
RAI

Provide construction details

Proposed  
20' (x 30')  
Asphalt  
driveway  
access

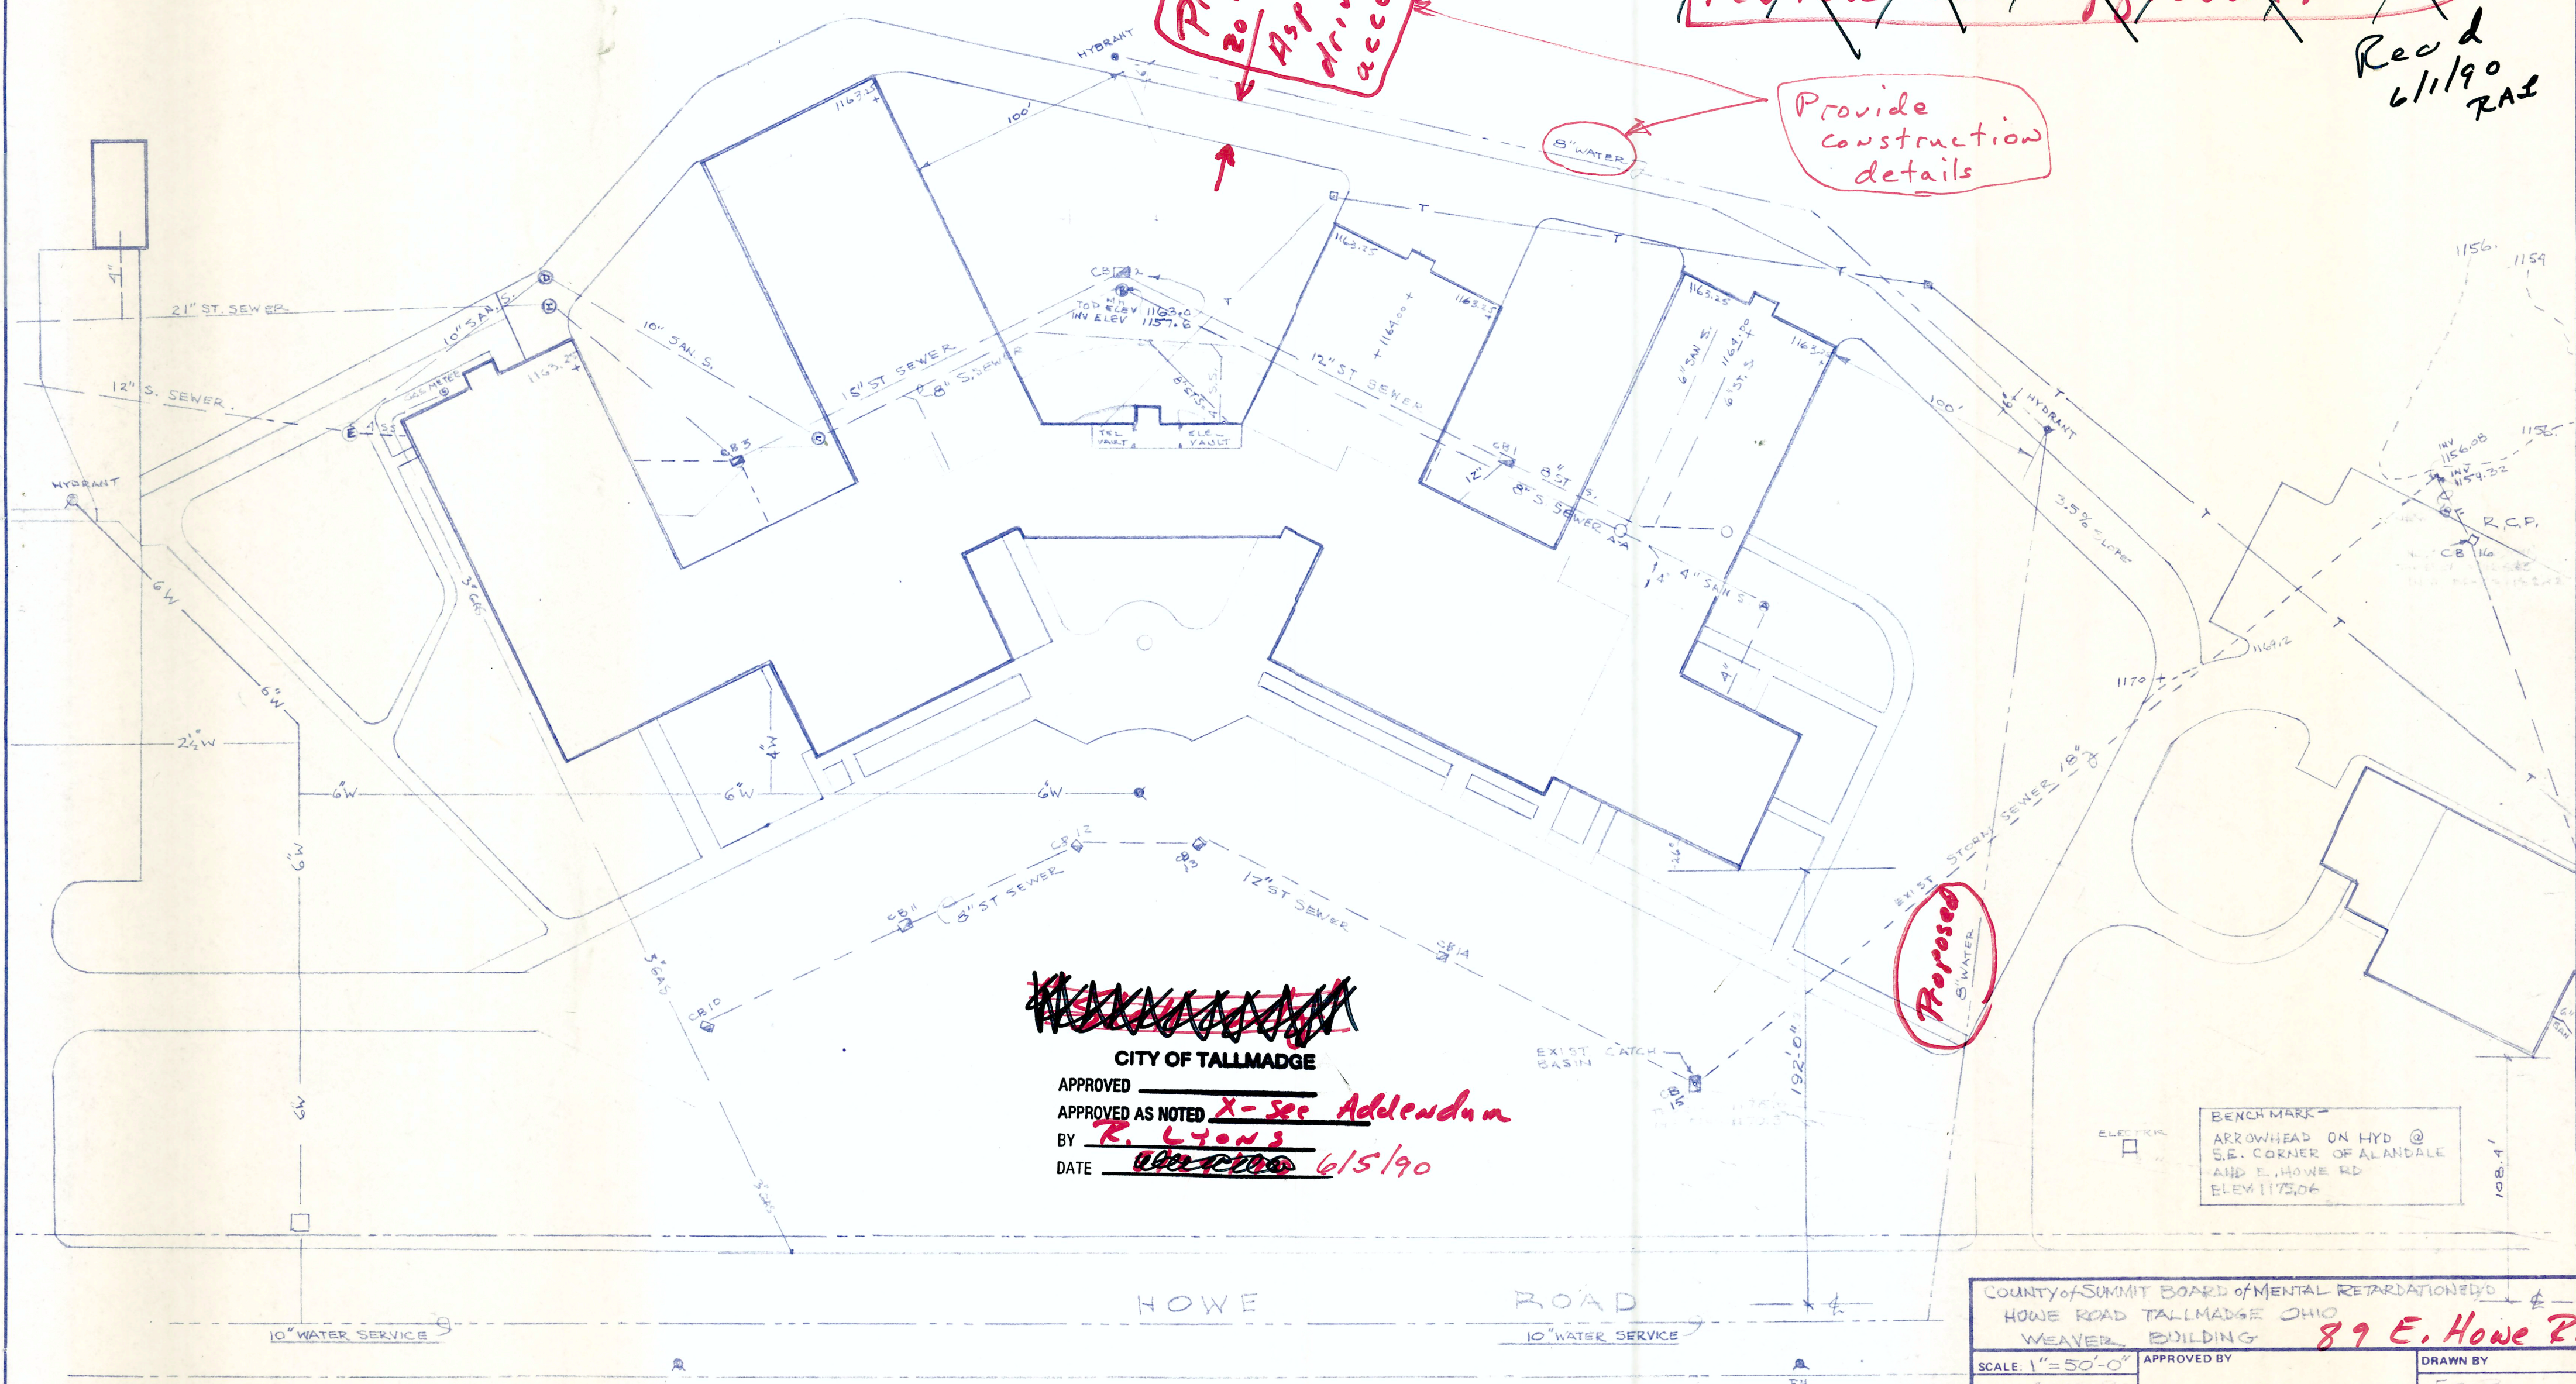


~~XXXXXXXXXXXX~~

CITY OF TALLMADGE


APPROVED \_\_\_\_\_  
APPROVED AS NOTED X-See Addendum  
BY R. Lyons  
DATE 6/15/90

COUNTY OF SUMMIT BOARD OF MENTAL RETARDATION		89 E. Howe Rd	
HOWE ROAD TALLMADGE OHIO		WEAVER BUILDING	
SCALE: 1"=50'-0"	APPROVED BY	DRAWN BY	
DATE: 4-10-90		E.C.K.	
SITE PLAN - SERVICE ROAD			
Thurmon Conley 630-3080		DRAWING NUMBER	
Maintenance Supr.		AI	



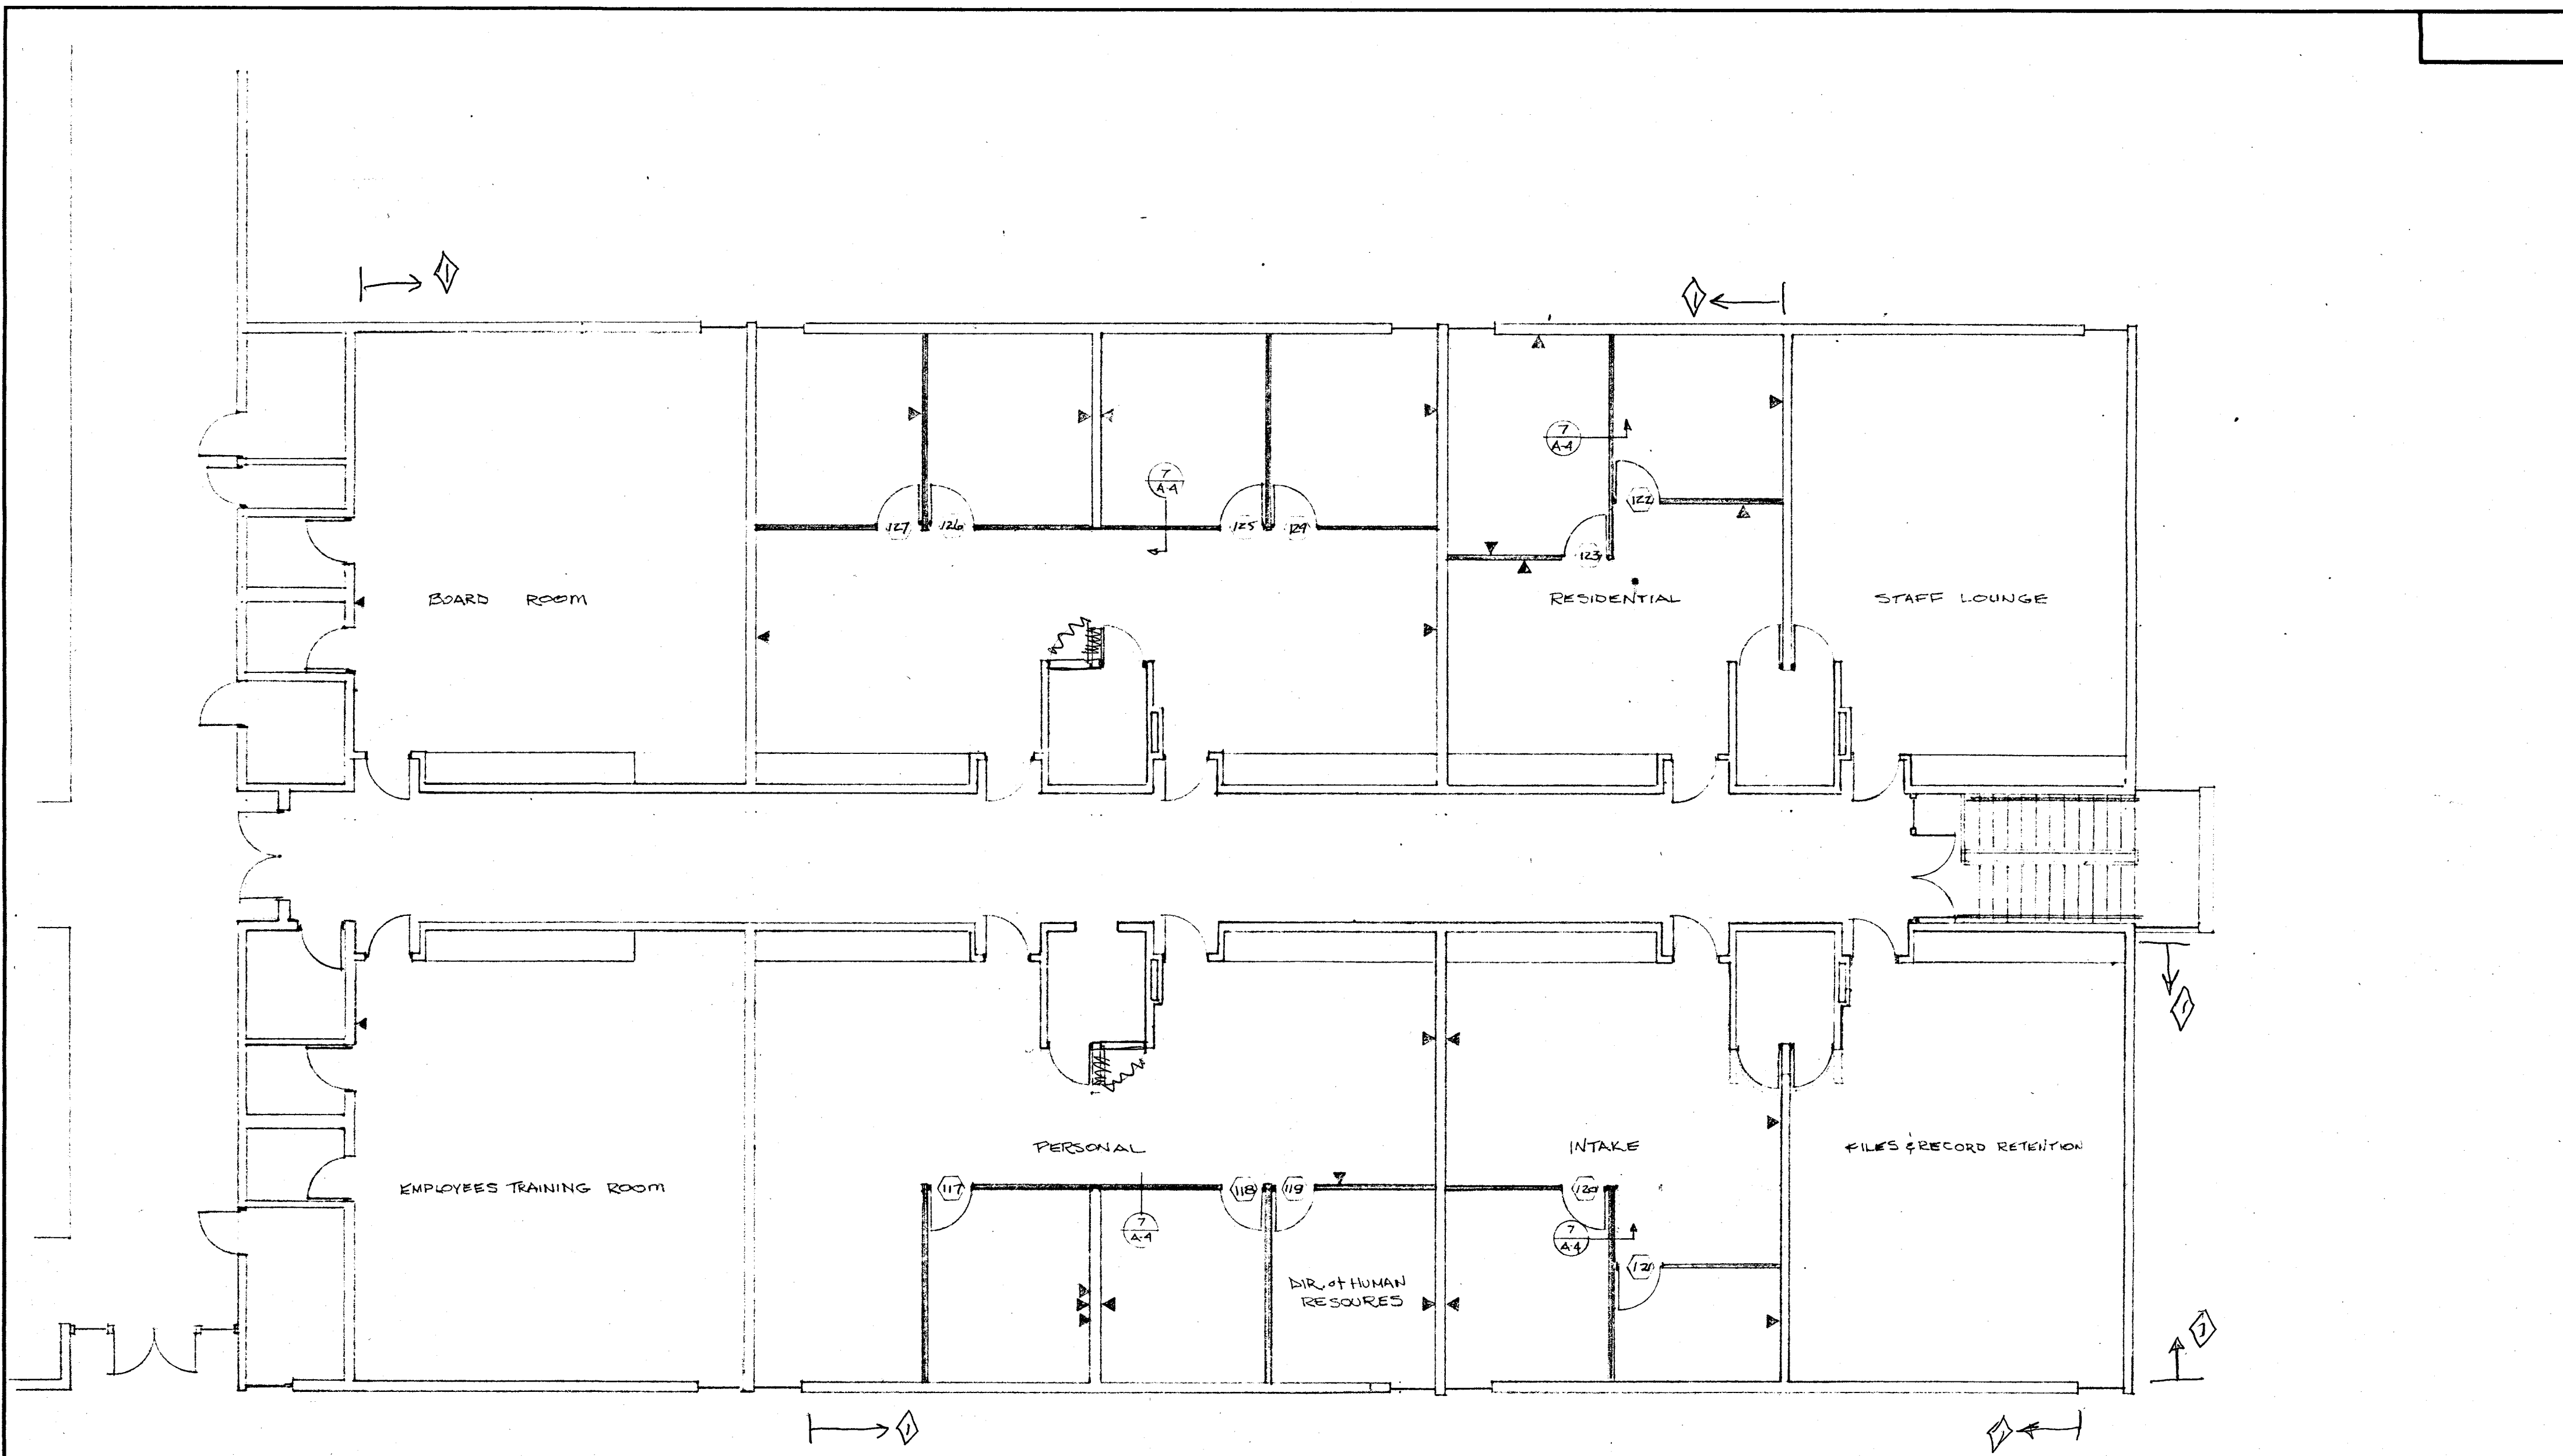


Exterior walls - 3/4" furring 16" oc,  
 3" rigid insulation and 1/2 drywall applied

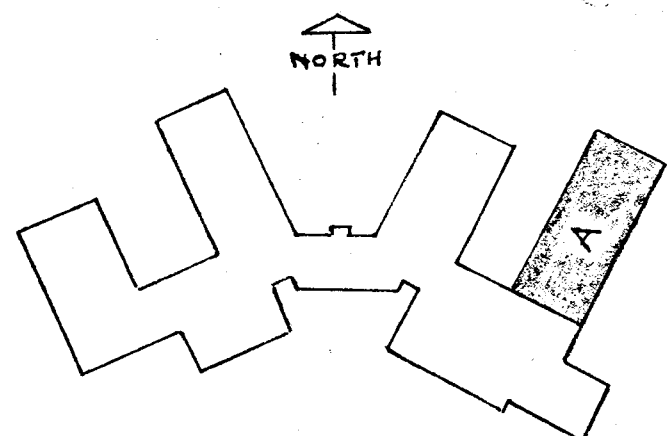


KEY PLAN  
 1" = 200'

COUNTY OF SUMMIT BOARD OF MENTAL RETARDATION & DD		
HOWE ROAD TALLMADGE, OHIO		
SCALE: 1/8" = 1'-0"	APPROVED BY	DRAWN BY
DATE: 5-7-90		
ADMINISTRATION OFFICES WING "A"		
89 E. Howe		DRAWING NUMBER A-2

8" MASONRY FLOOR TO  
CANK DECK W/  
SHR DOOR ASSEMBLY  
112

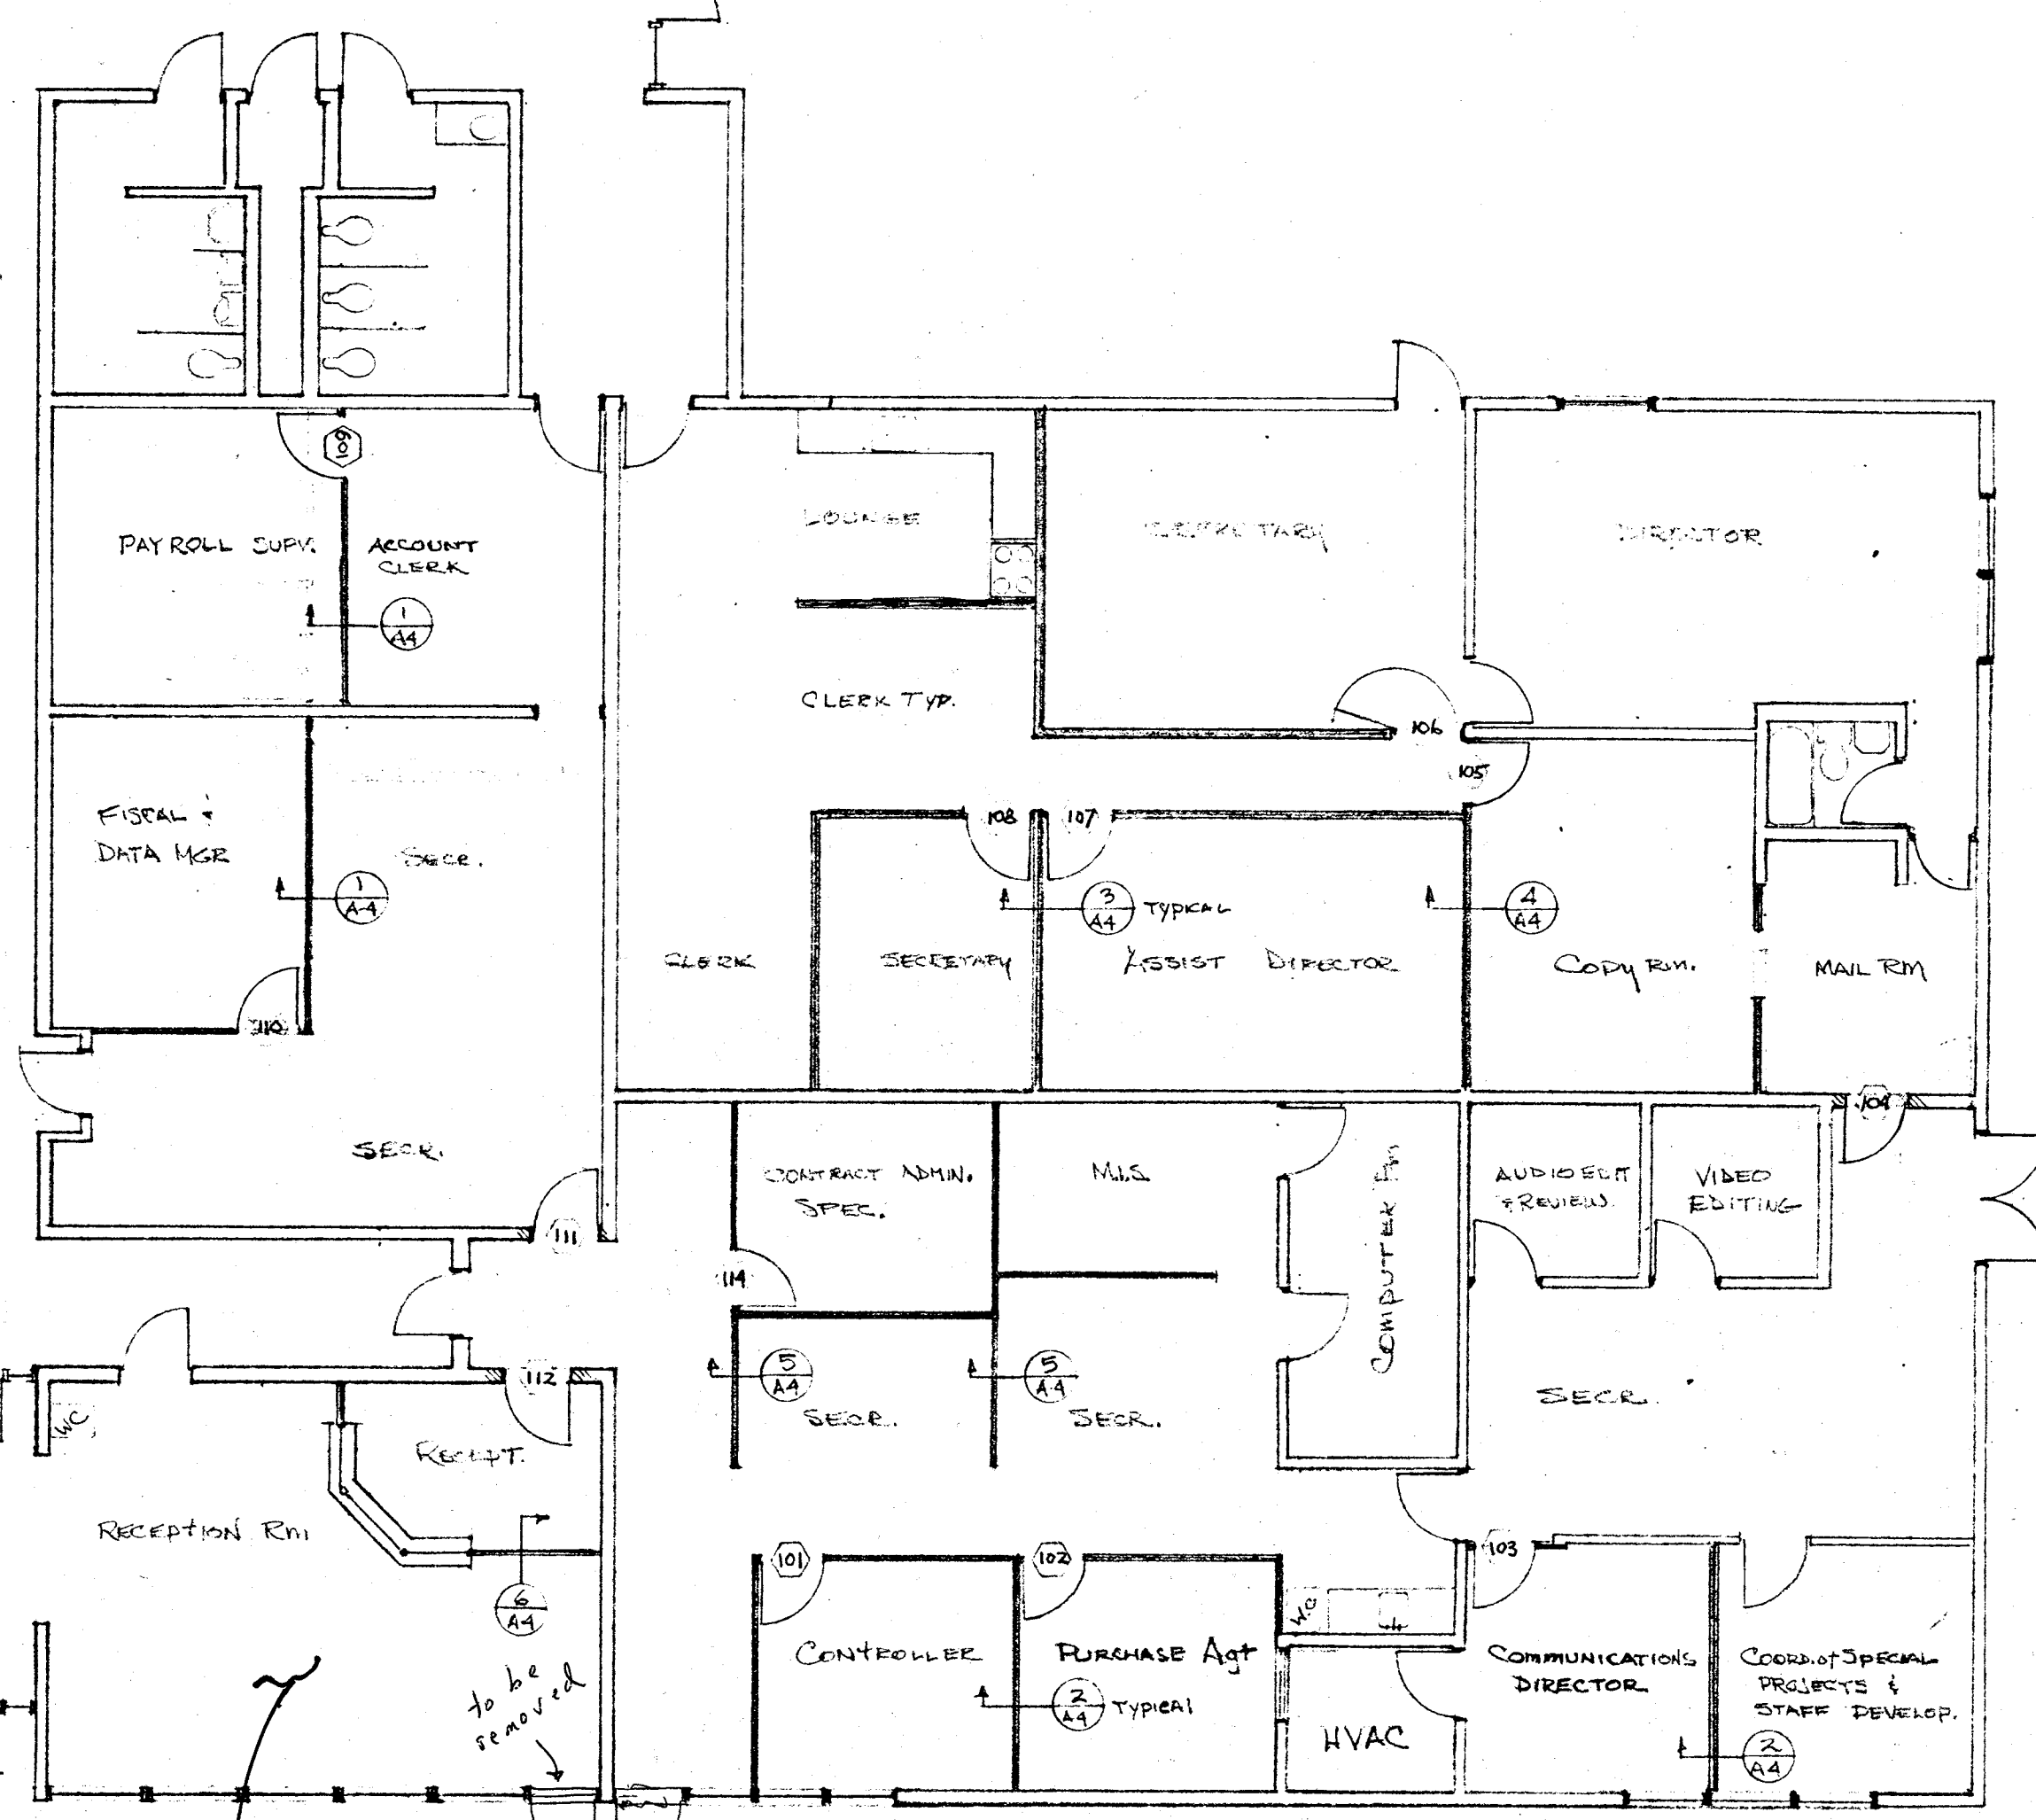


verify glazing  
in roof complies  
w/ OBC 2203.0  
& 2204.0

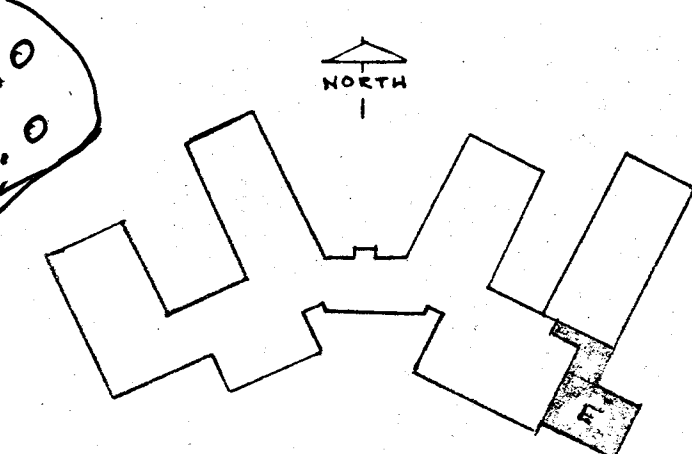

KEY PLAN  
1" = 200'

COUNTY OF SUMMIT BOARD OF MENTAL RETARDATION & D/D		
89 HOWE ROAD TALLMADGE, OHIO		
SCALE: 1/8" = 1'-0"	APPROVED BY	DRAWN BY
DATE: 5-7-90		ESP
ADMINISTRATION OFFICES WING "E"		
		DRAWING NUMBER
		A3


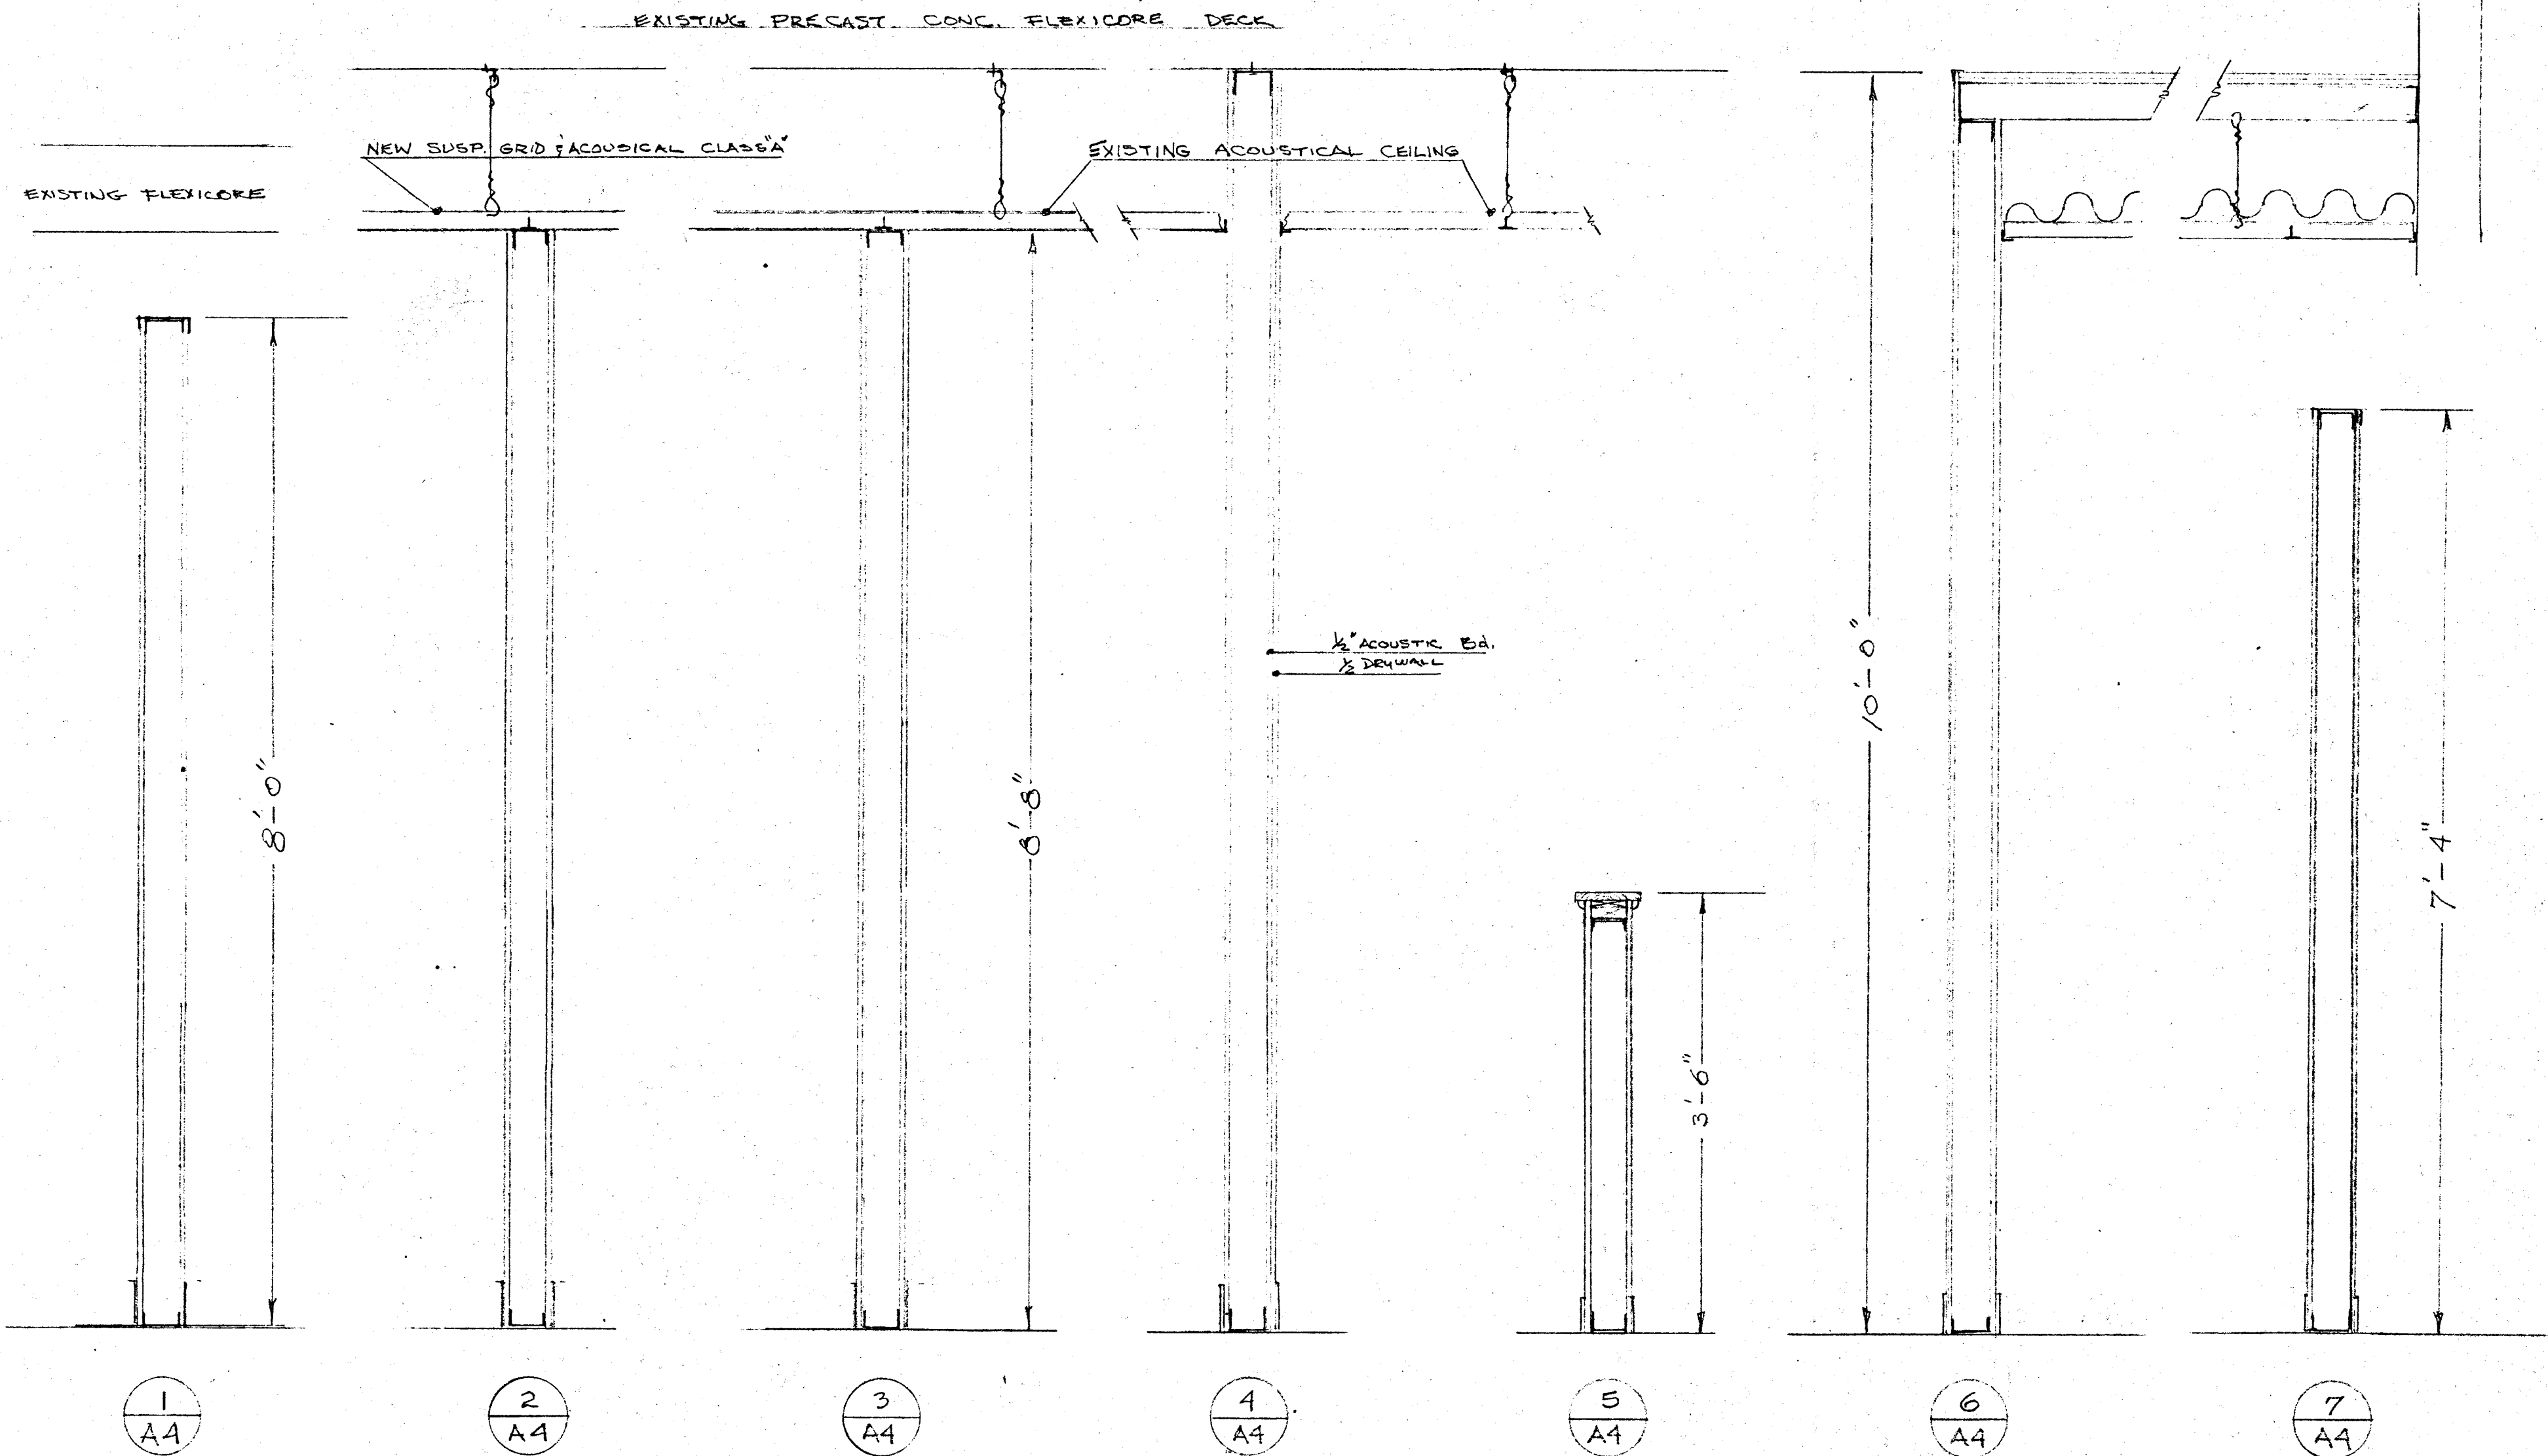


NOTE: ALL INTERIOR PARTITIONS - 3 5/8" MTL STUDS  
 WITH 1/2" GYP. BOARD OR AS NOTED.  
 & RUBBER BASE ON ALL WALLS

COUNTY OF SUMMIT BOARD OF MENTAL RETARDATION & D/D		
89 E. HOWE ROAD TALLMADGE, OHIO		
SCALE: 1" = 1'-0"	APPROVED BY	DRAWN BY
DATE: 5-7-90		ECR
WALL SECTIONS		
DRAWING NUMBER		A4

# DOOR SCHEDULE

DR. NO.	DOORS								FRAME						HDW. SET	REMARKS
	TYPE	WIDTH	HEIGHT	THICK	MAT'R	LABEL	GLASS	LOUVER	TYPE	SIZE	HEAD	JAMB	THR	MAT'R	LABEL	
101	1	3-0	6-8	1 3/8	HC.WD.				1	4 5/8	E	G		HM		
102	1															
103	1				HC.WD.					4 5/8	E	G				
104	3				HM					4	A	C				
105	1				HC.WD.					4 5/8	E	G				
106	1															
107	1															
108	1															
109	1															
110	1			1 3/8	HC.WD.					4 5/8	E	G		HM		
111	3			1 3/4	HM					4"	A	C		HM		
112	3	3-0	6-8	1 3/4	HM				1	4"	A	C		HM		
113	2	PR 3-0	7-0	1 3/4	ALUM				3	4"				ALUM		
114	1	3-0	6-8	1 3/8	HC.WD.											
115																
116																
117	1	3-0	6-8	1 3/8	HC.WD.					4 5/8	E	G		HM		
118																
119																
120																
121																
122																
123																
124																
125																
126				1 3/8												
127		3-0		1 3/4	HC.WD.				1	4 5/8	E	G		HM		
128	1	PR 3-0	6-8	1 3/4	HM	A			1	4	A	C		HM	A	
129	3	PR 3-0	7-2"	1 3/4	HM				3	8 3/4	F	H	1	H.M.		REUSE DRS, FRAME & HARDWARE FROM #130 OPN.
130	4	PR 3-0	6-8	1 3/4	HM	A			4	8 3/4	B	D	1	H.M.	A	GROUND FLOOR WING "A" STAIRS
131																
132																

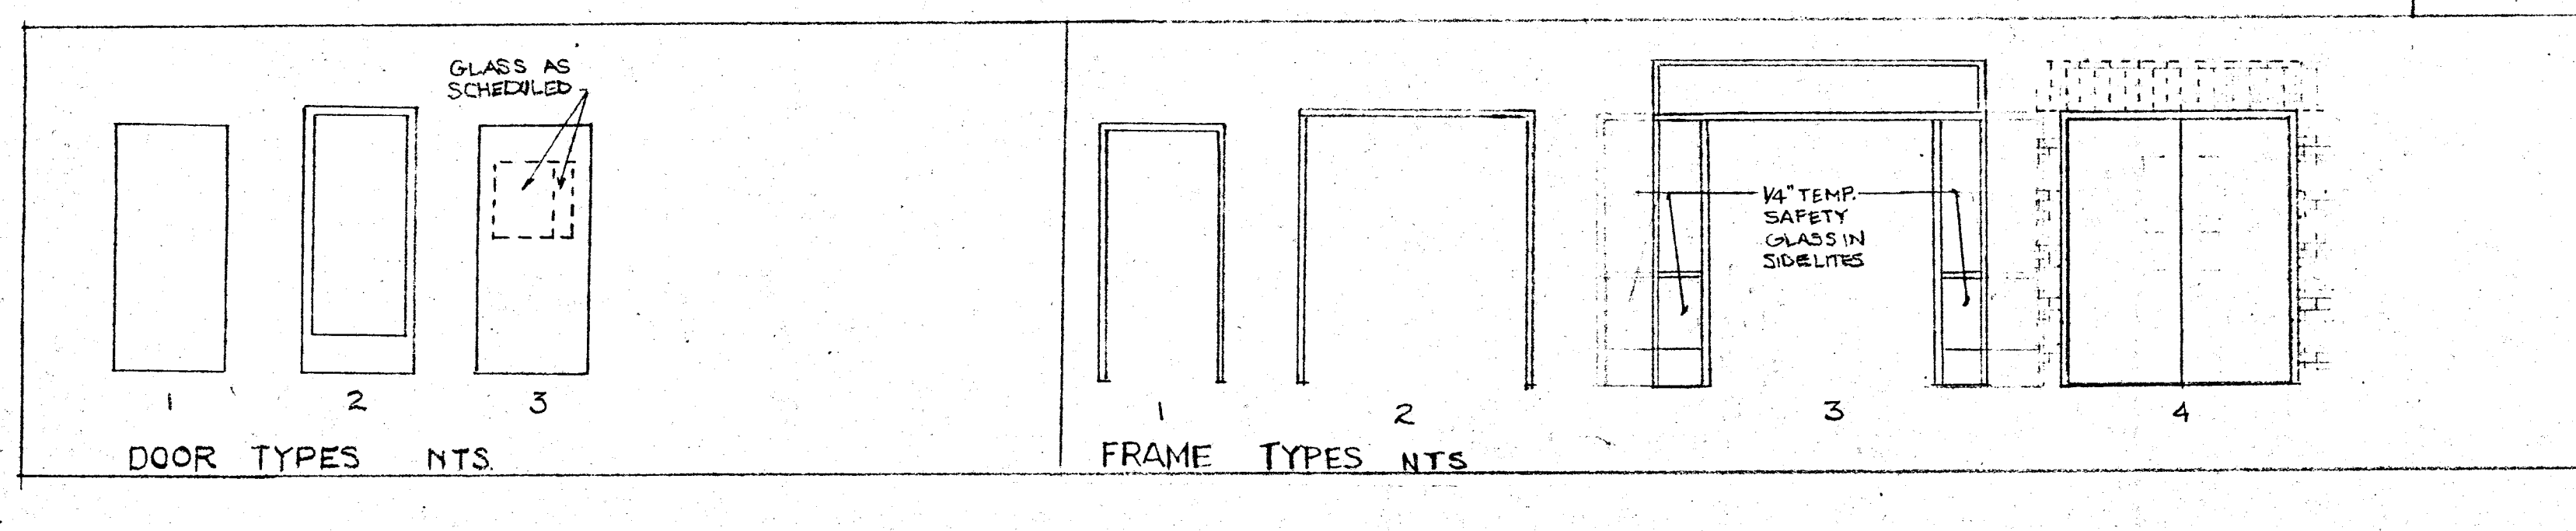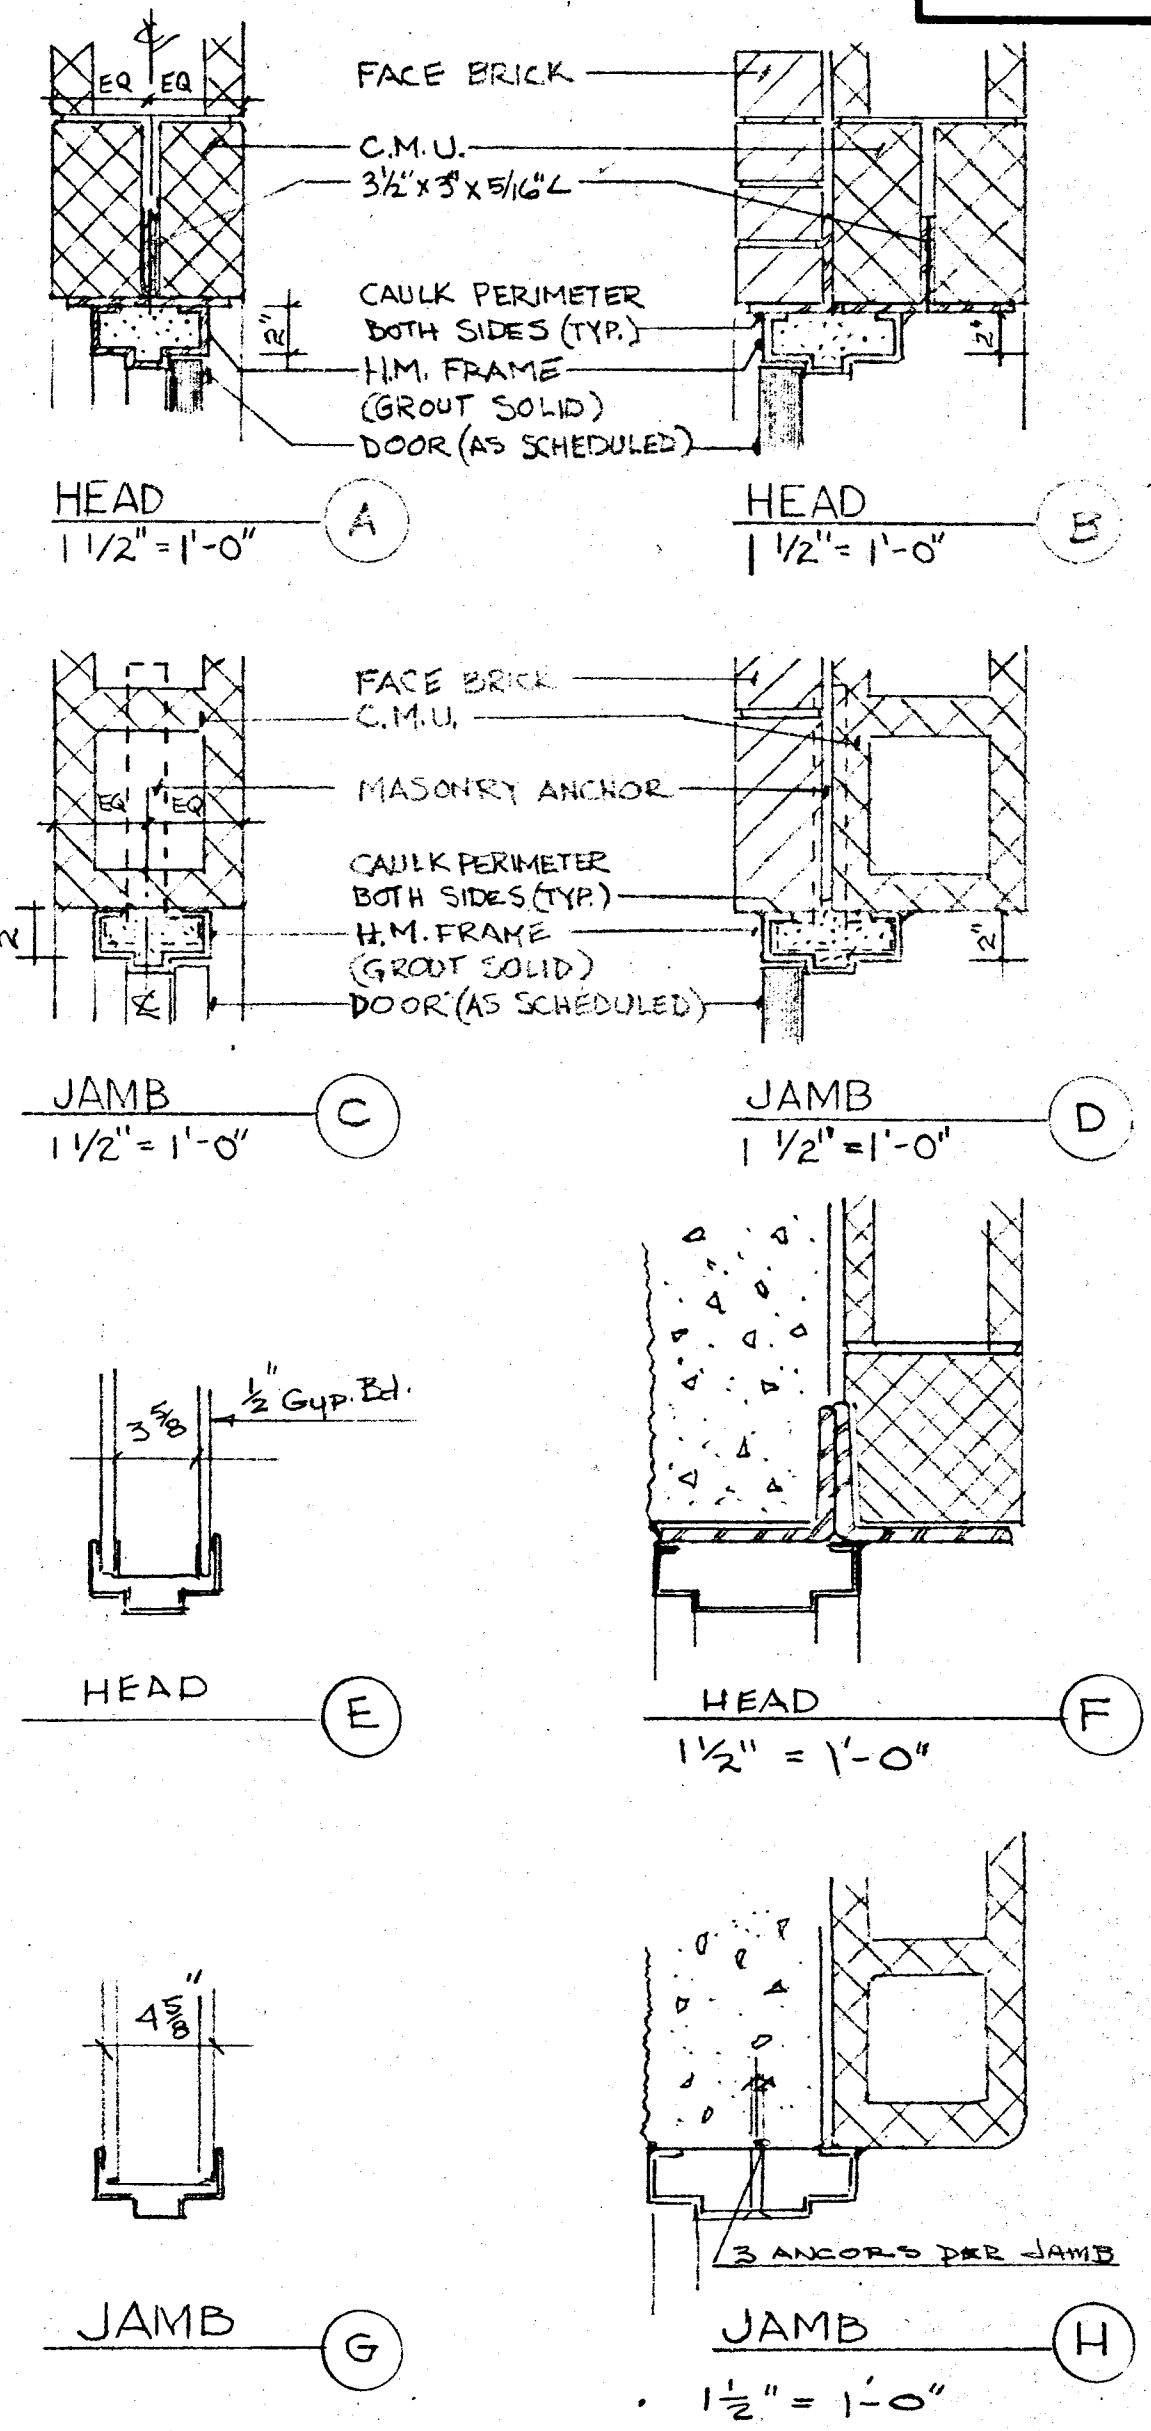

COUNTY OF SUMMIT BOARD OF MENTAL RETARDATION & D/D  
 89 E. HOWE RD TALLMADGE, OHIO

SCALE: AS SHOWN - APPROVED BY: DRAWN BY: GCF.

DATE: E-7-90


ADMINISTRATION OFFICES

DOOR SCHEDULE & DETAILS

DRAWING NUMBER: A5




Bldg. Dept. Copy

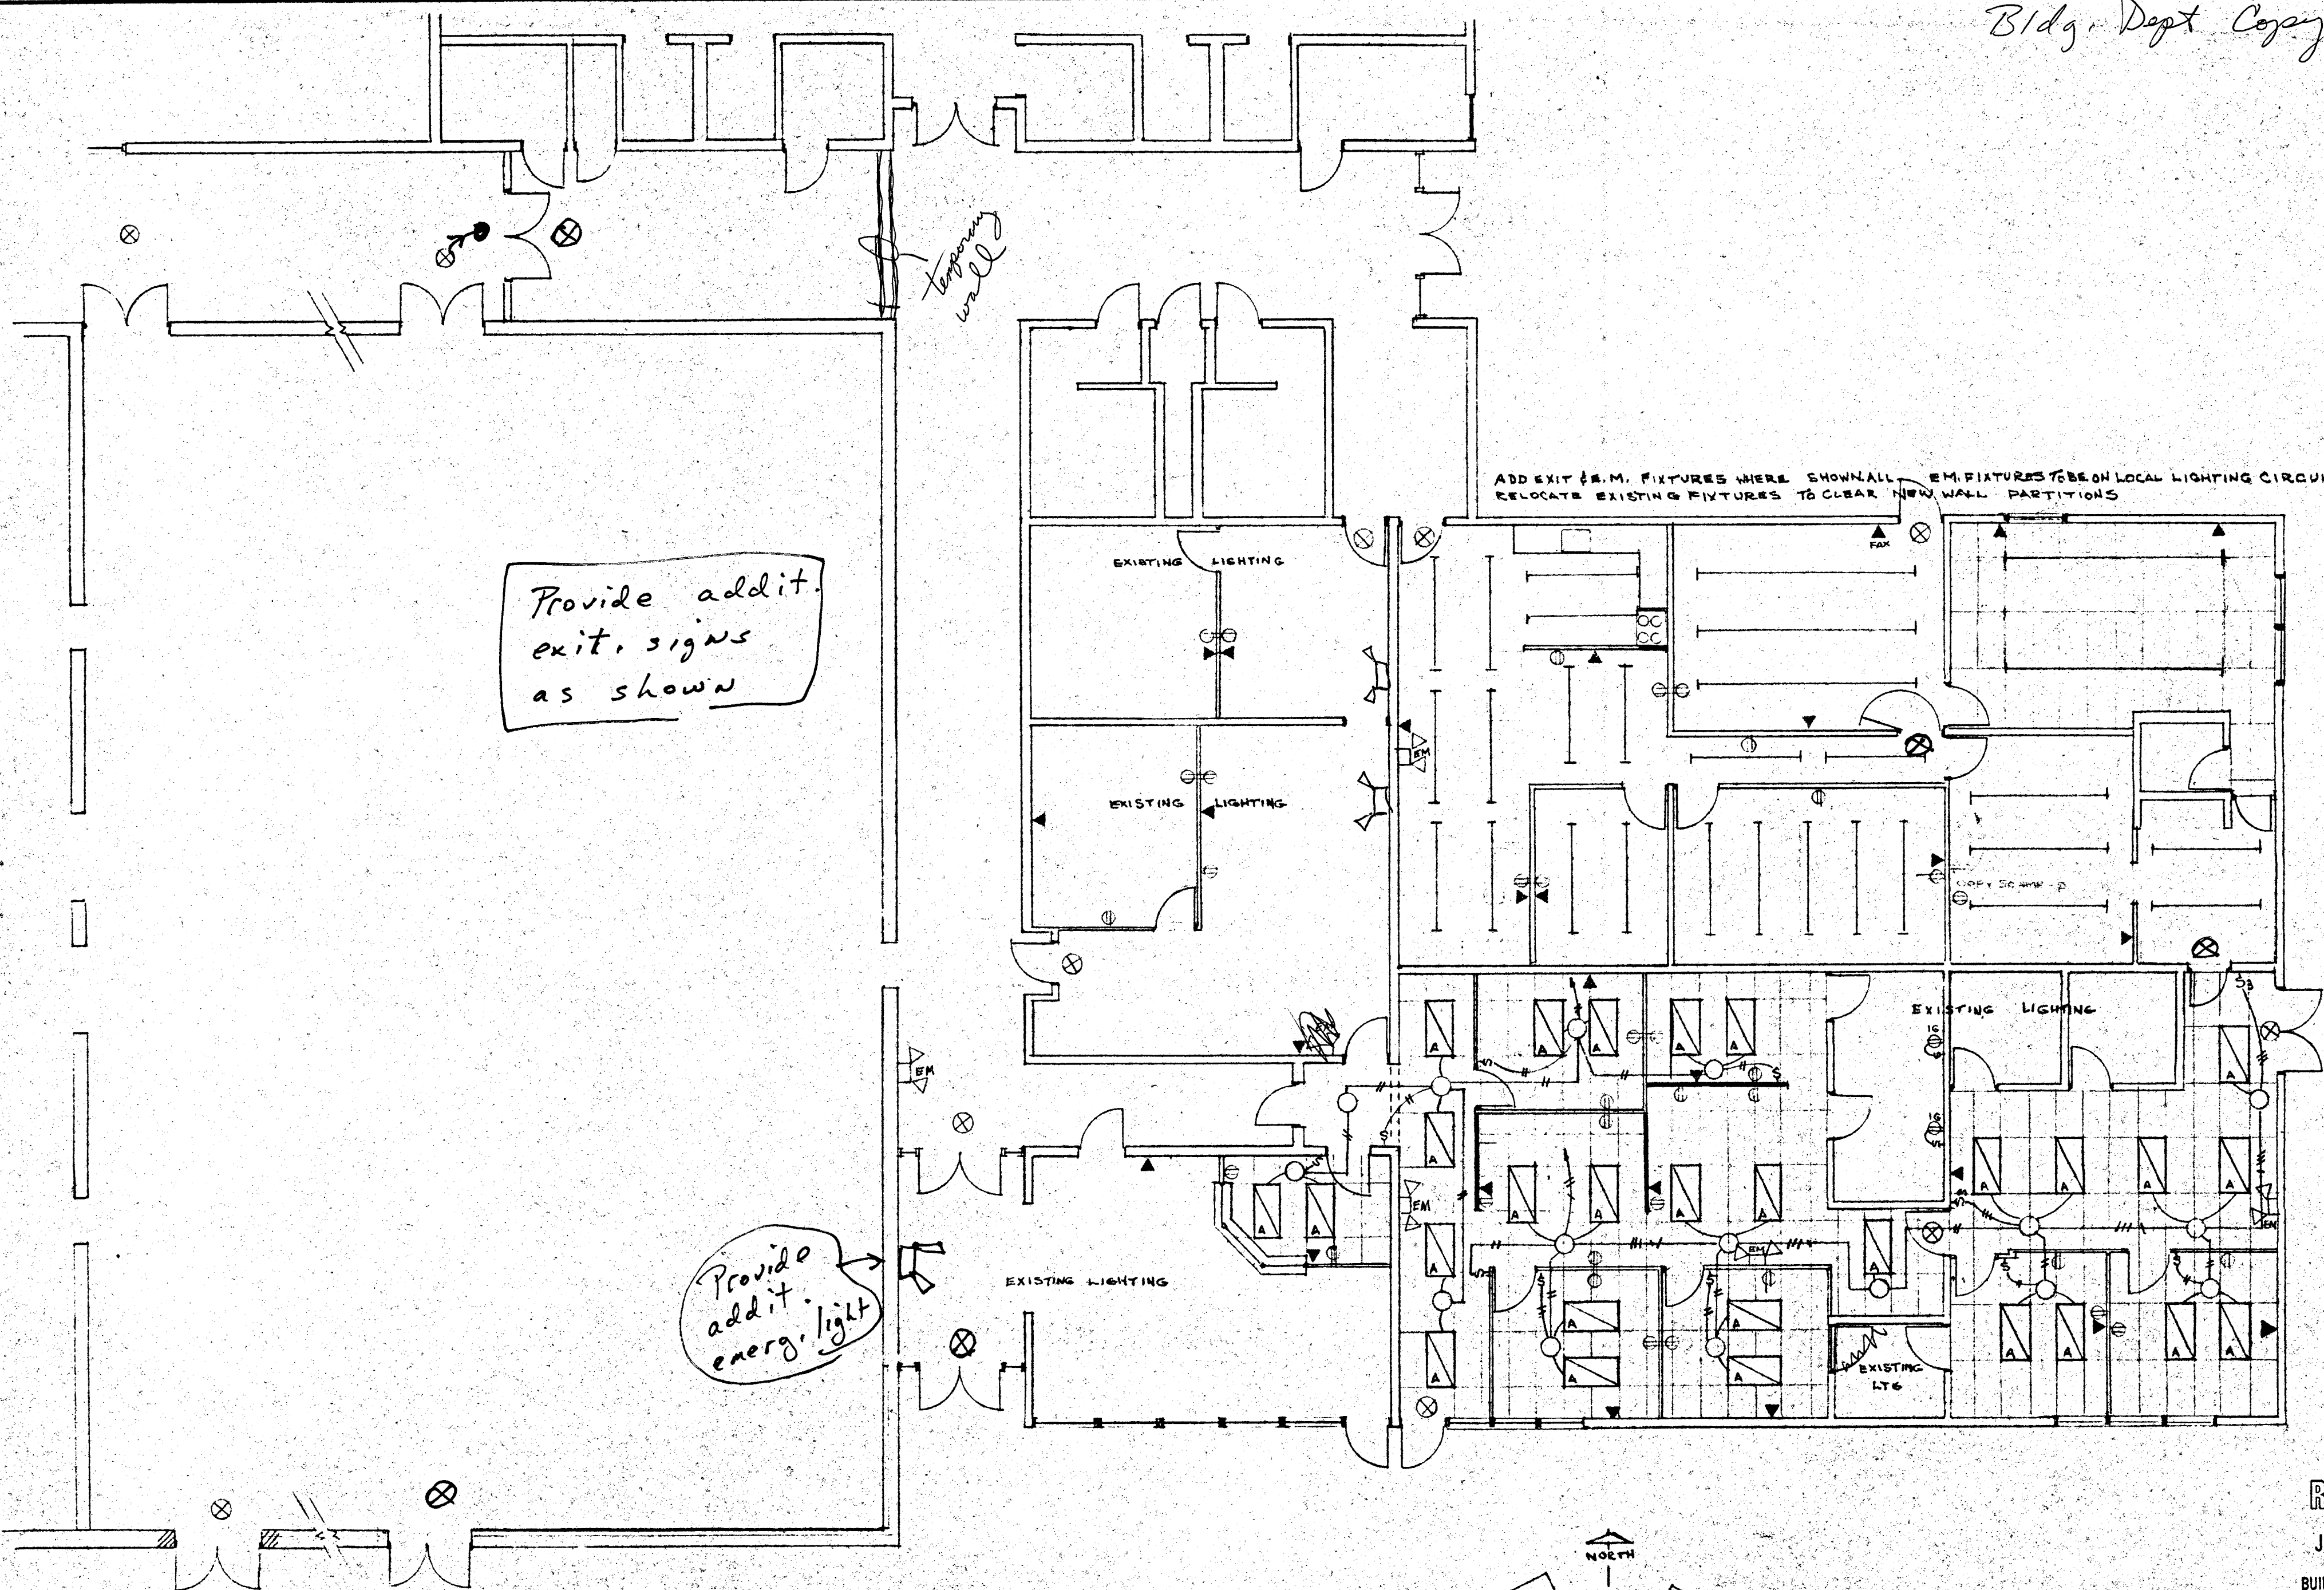

RECEIVED


JUN - 1 1990

BUILDING/ZONING DEPT.  
CITY OF TALLMADGE

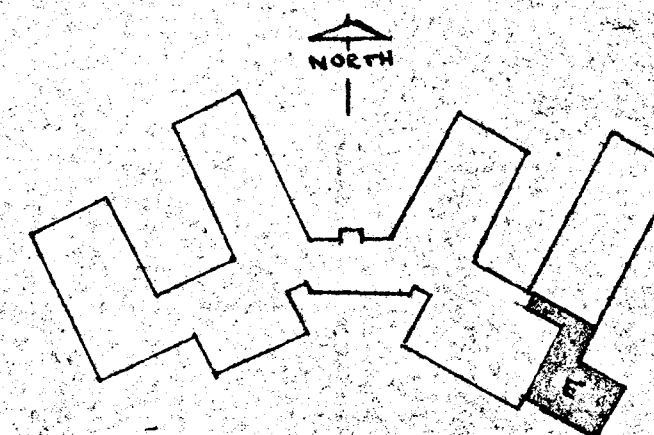


Electrical, P. 10/11  
6/4/90 J. K. Brown

COUNTY of SUMMIT BOARD of MENTAL RETARDATION & D/D		
89 E HOWE ROAD TALLMADGE, OHIO		
SCALE: 1/8" = 1'-0"	APPROVED BY	DRAWN BY
DATE: 5-7-90		ECR
ADMINISTRATION OFFICES WING "E"		
LIGHTING LAYOUT		DRAWING NUMBER
		E1

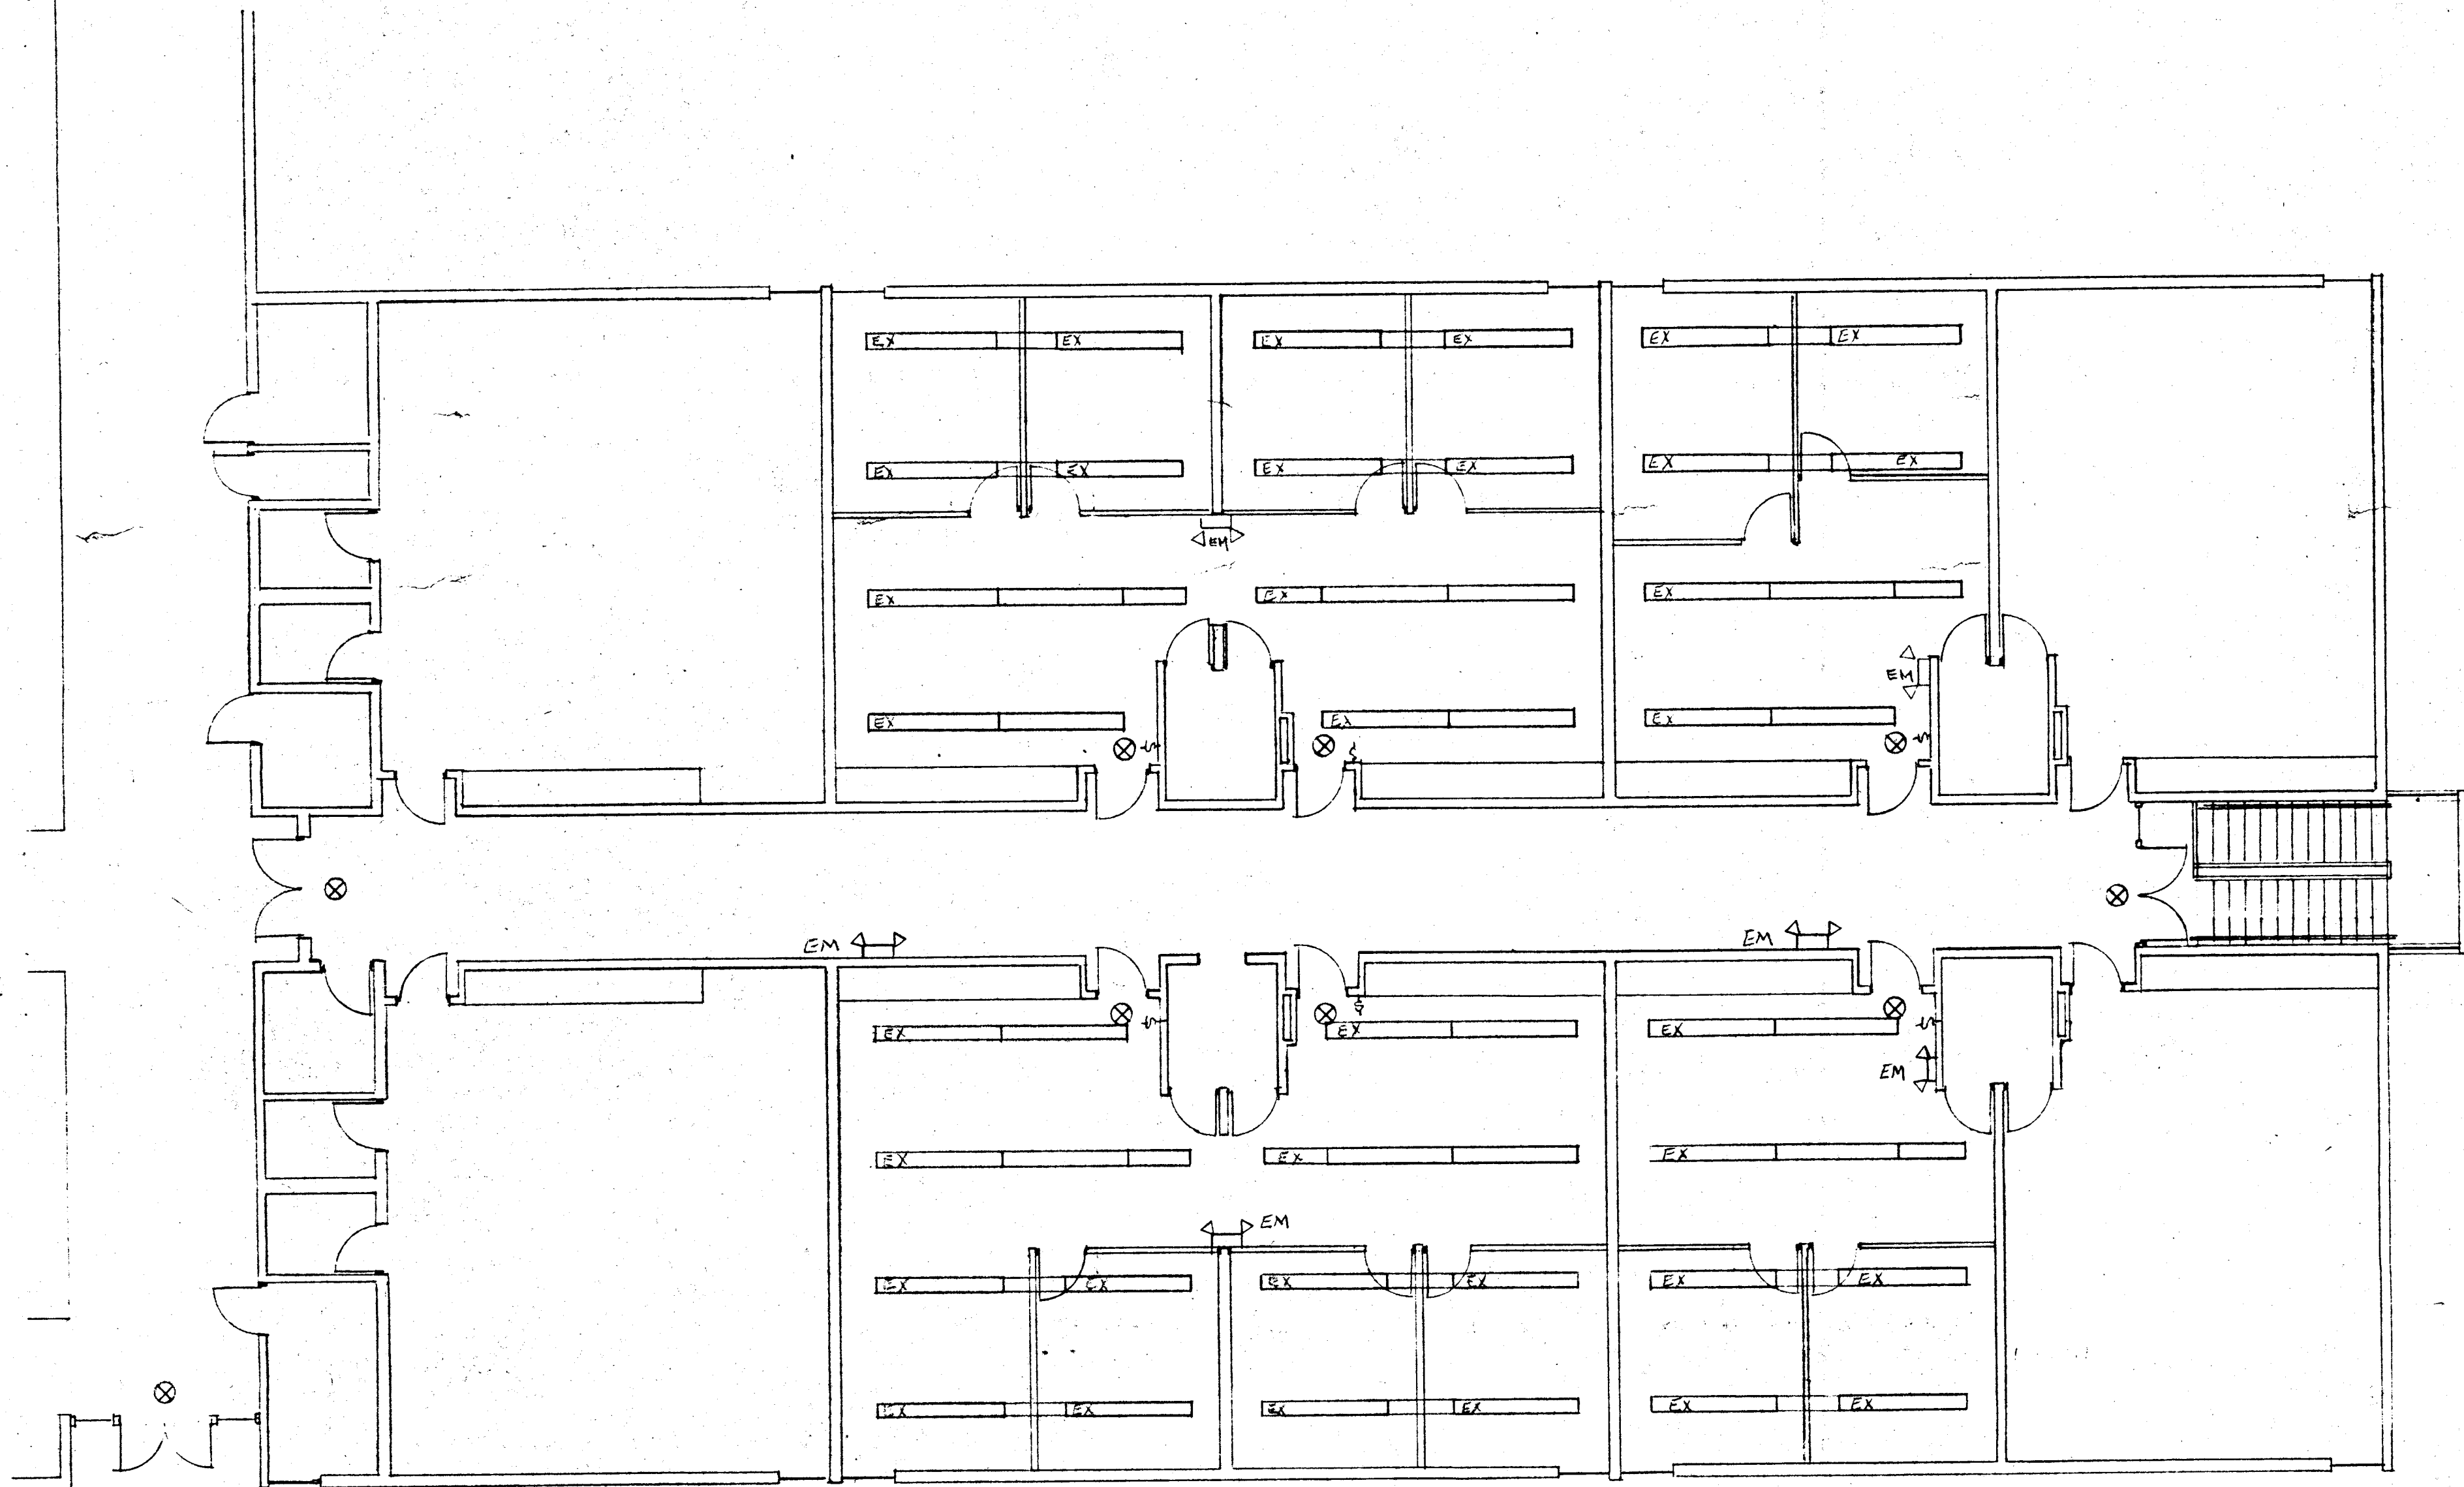


NO CHANGE IN FIXTURES OR SWITCHES  
 ADD EXIT & EM FIXTURES WHERE SHOWN  
 ALL EM FIXTURES TO BE ON LOCAL LIGHTING CIRCUIT

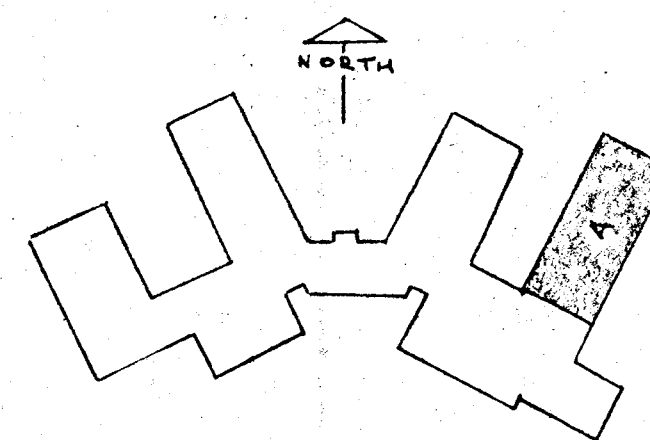

KEY PLAN  
 1" = 200'

COUNTY OF SUMMIT BOARD OF MENTAL RETARDATION & D/D		
89 E. HOWE ROAD TALLMADGE OHIO		
SCALE: 1/8" = 1'-0"	APPROVED BY	DRAWN BY
DATE: 5-7-90		
ADMINISTRATION OFFICES WING "A"		
LIGHTING LAYOUT		DRAWING NUMBER E2



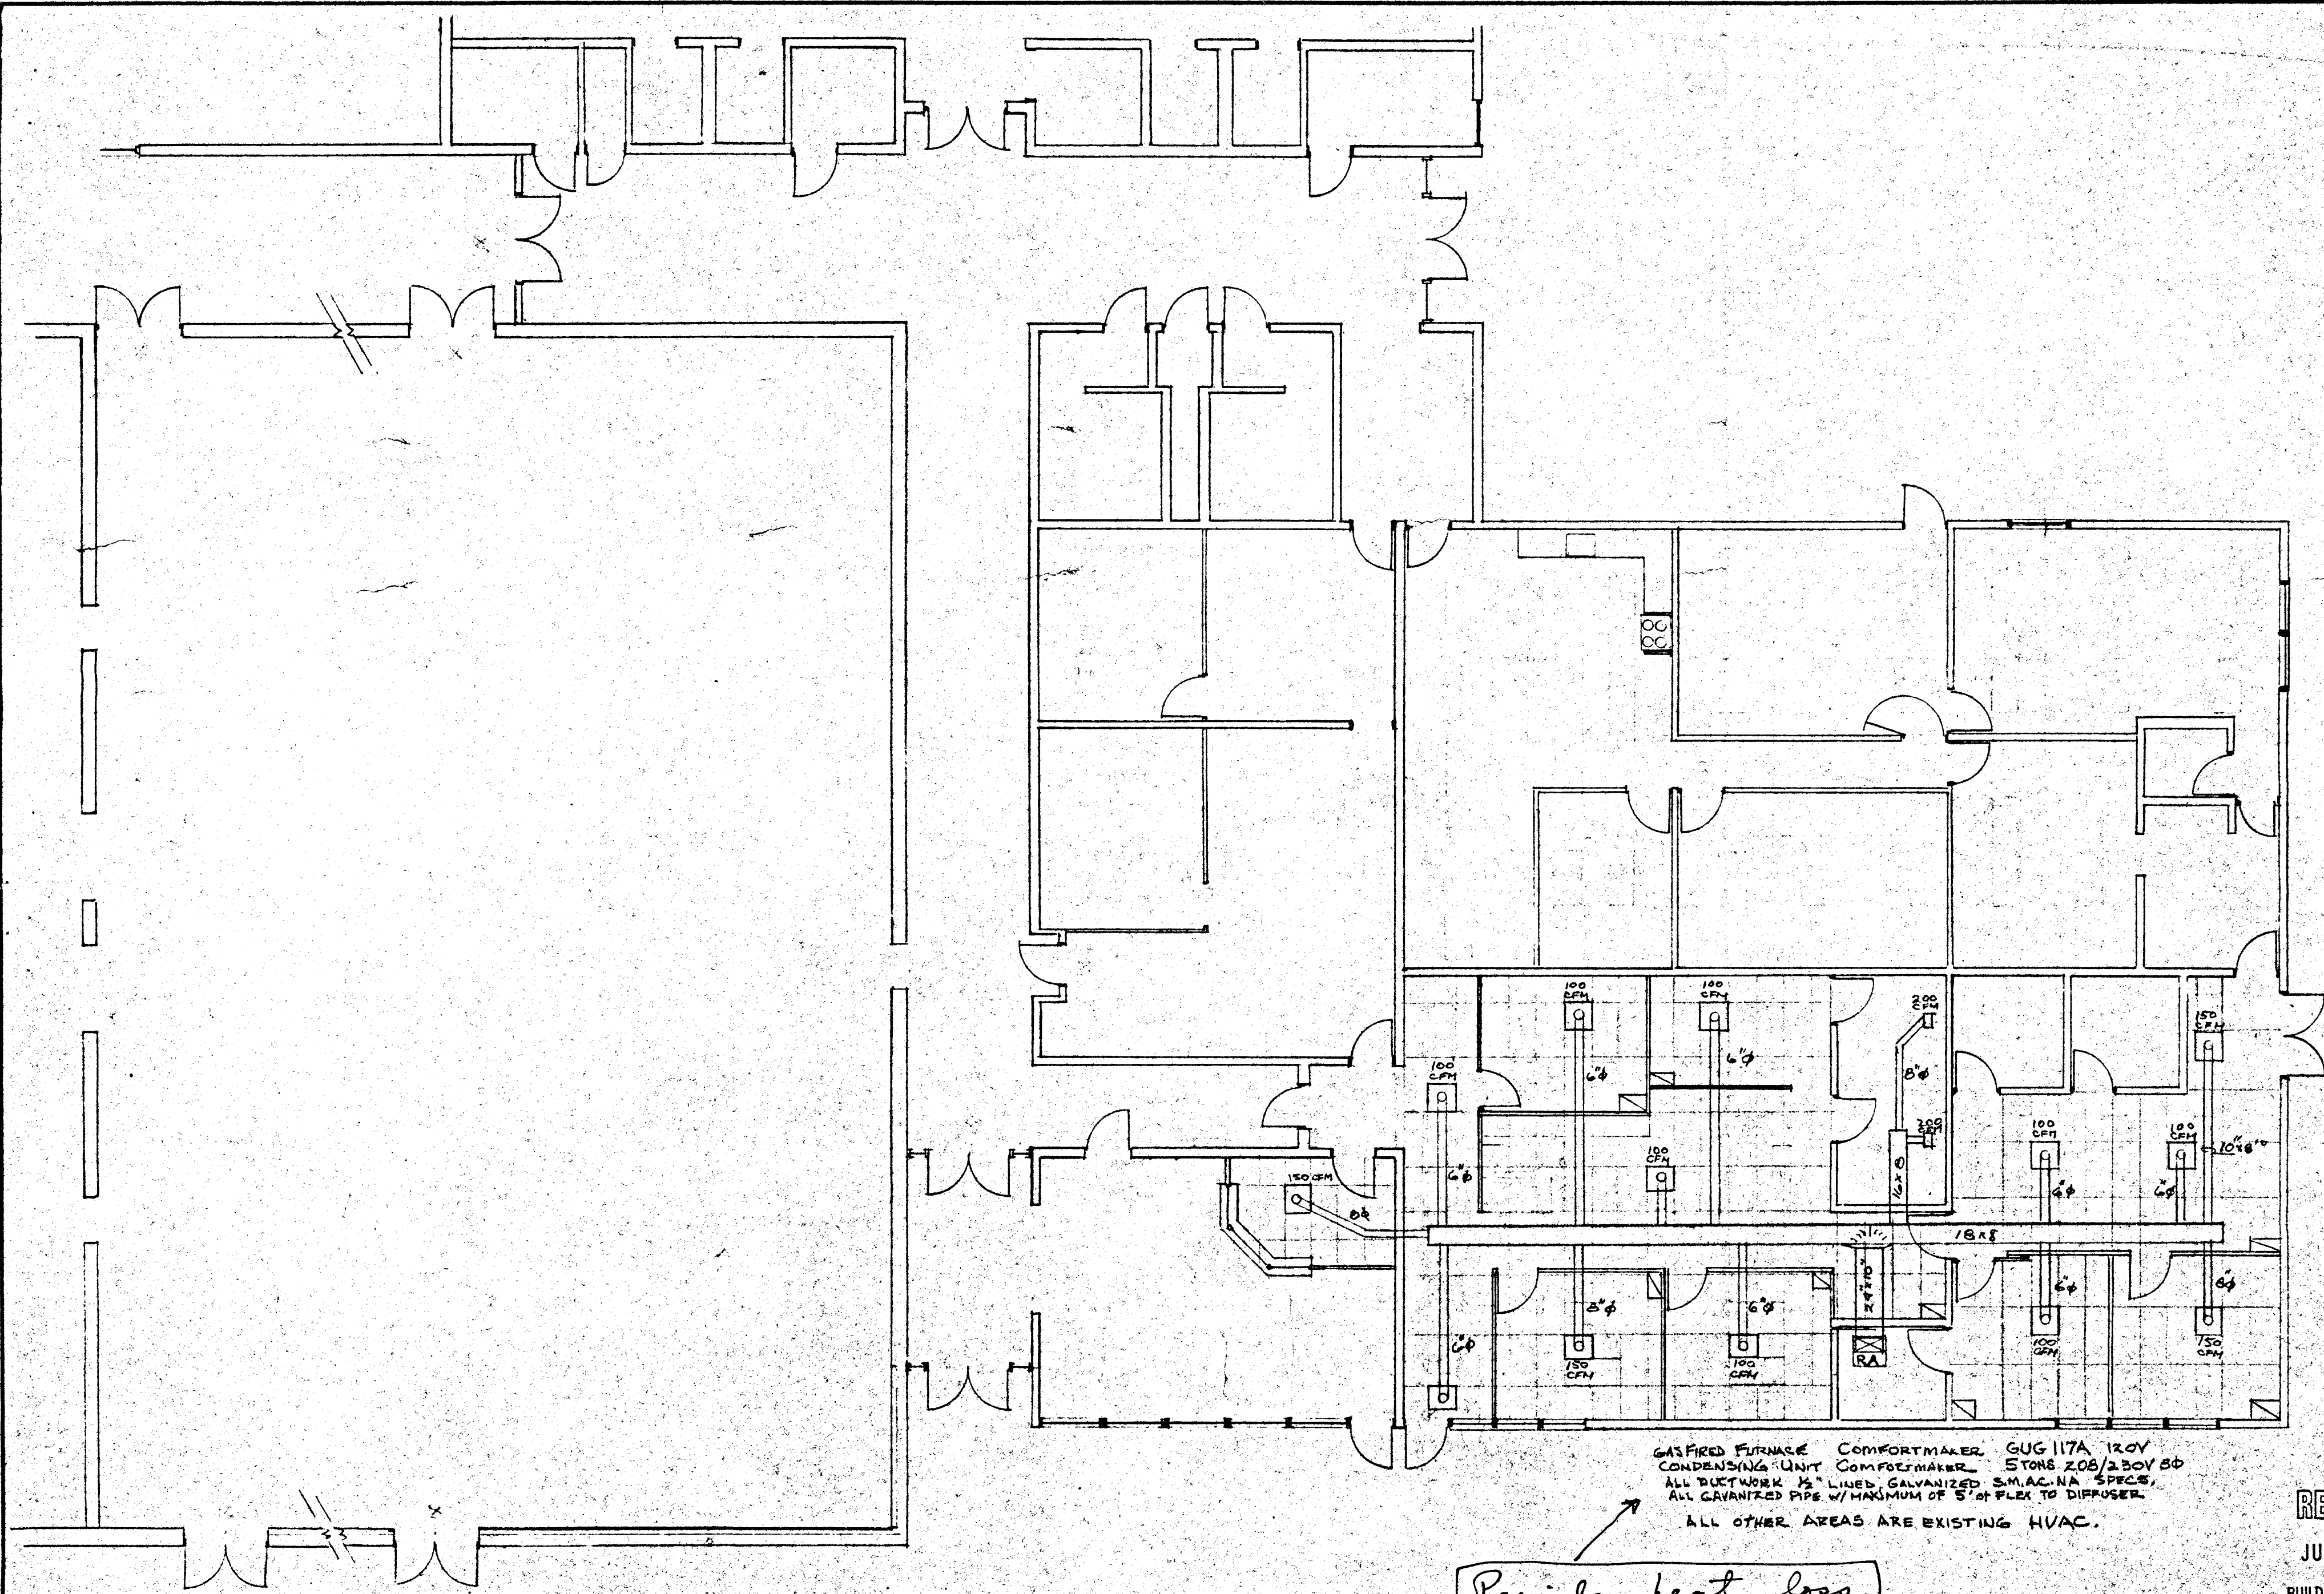

Provide heat loss  
calcs. for approval

GAS FIRED FURNACE COMFORTMAKER GUG 117A 120V  
CONDENSING UNIT COMFORTMAKER STORS 208/230V 80  
ALL BUT WORK 1/2" LINED GALVANIZED S.M.I.A.C. NA SPEC'S  
ALL GALVANIZED PIPE W/ MAXIMUM OF 5' OF FLEX TO DIFFUSER  
ALL OTHER AREAS ARE EXISTING HVAC.

RECEIVED  
JUN - 1 1990  
BUILDING/ZONING DEPT.  
CITY OF TALLMADGE

COUNTY OF SUMMIT BOARD OF MENTAL RETARDATION & D/D		
89 E. HOWE ROAD TALLMADGE OHIO		
SCALE: 1/8" = 1'-0"	APPROVED BY	DRAWN BY
DATE: 5-31-90		ECR
NEW HEATING & AIR CONDITIONING		
DRAWING NUMBER		H1