



BUILDING CODE NOTES

- EXIST'G BLD'G CONST. TYPE: 1B
- EXIST'G USE GROUP: E
- EXIST'G FLOOR/CEILING ASSEMBLY: 4 HR. (UL DESIGN # G401)
- NEW USE GROUP: B & (2-2) (SEPARATED USE - 1 HR. SEPARATION)
- FIRE SUPPRESSION: ENTIRE NEW AREA.


S-1 per owner

Submit sprinkler plans and calculations for approval and permit


Submit fire alarm plans for approval and permit

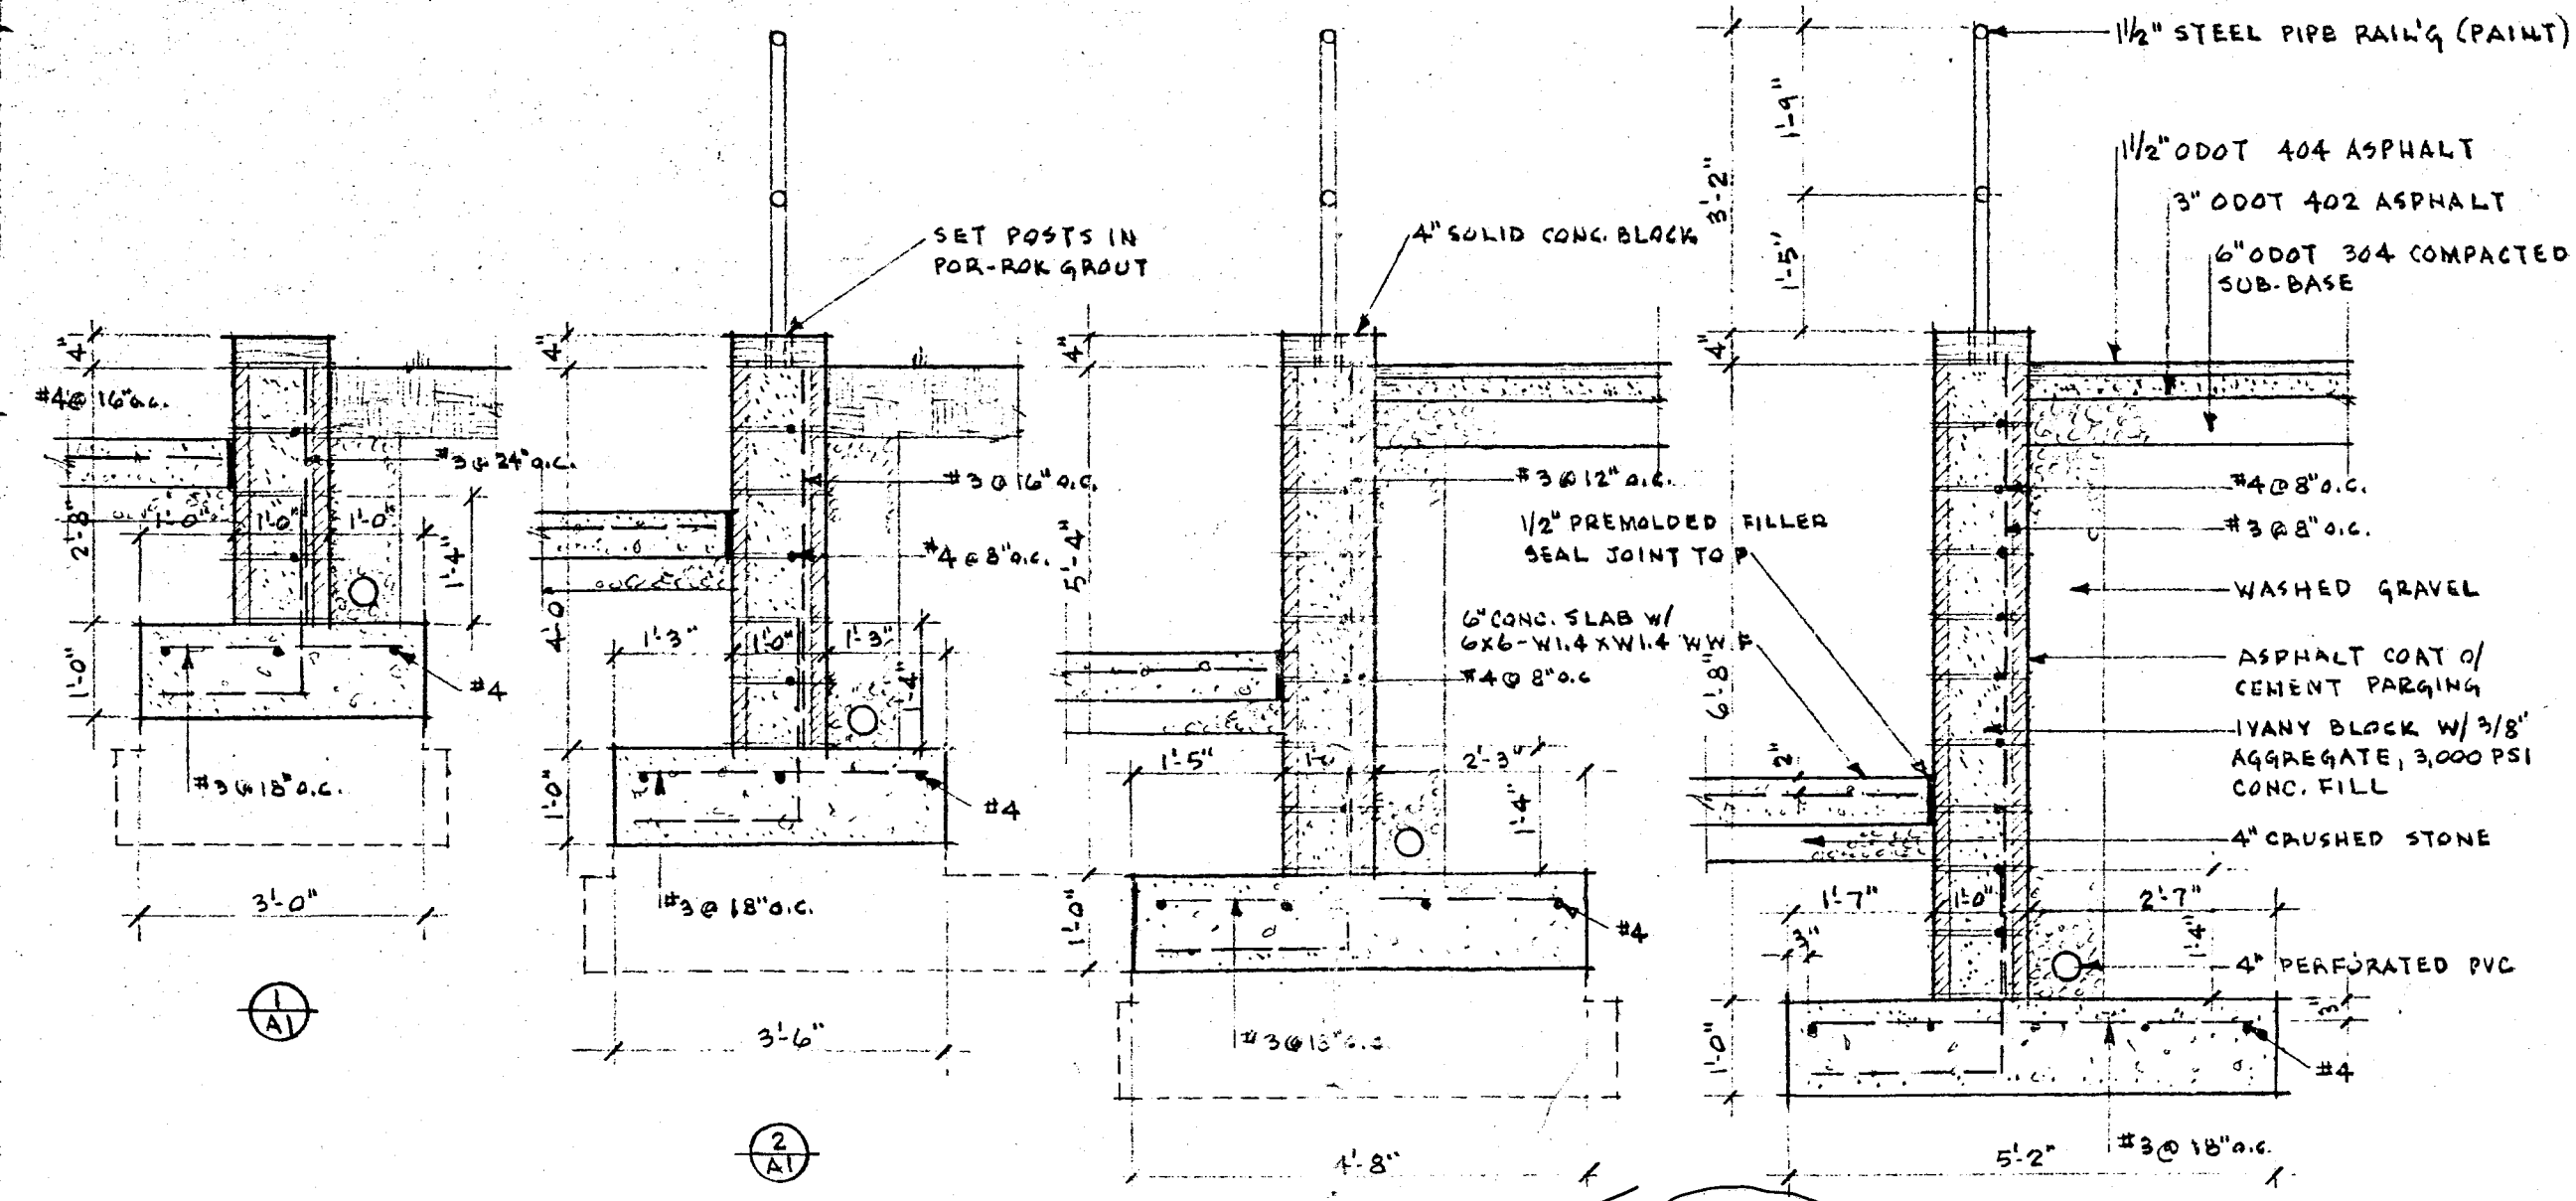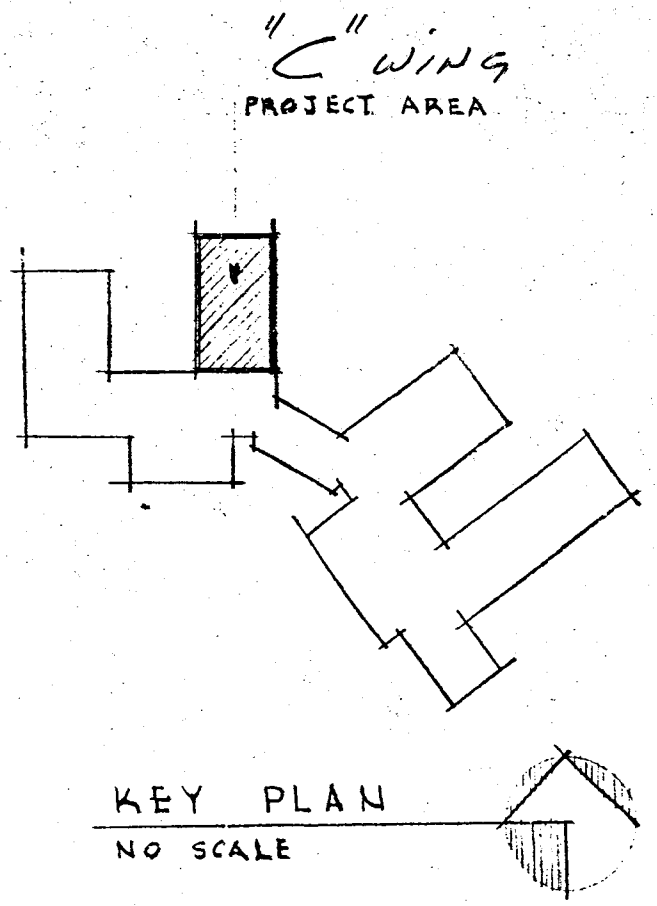


RETAINING WALL SECTIONS
1/2" = 1'-0"

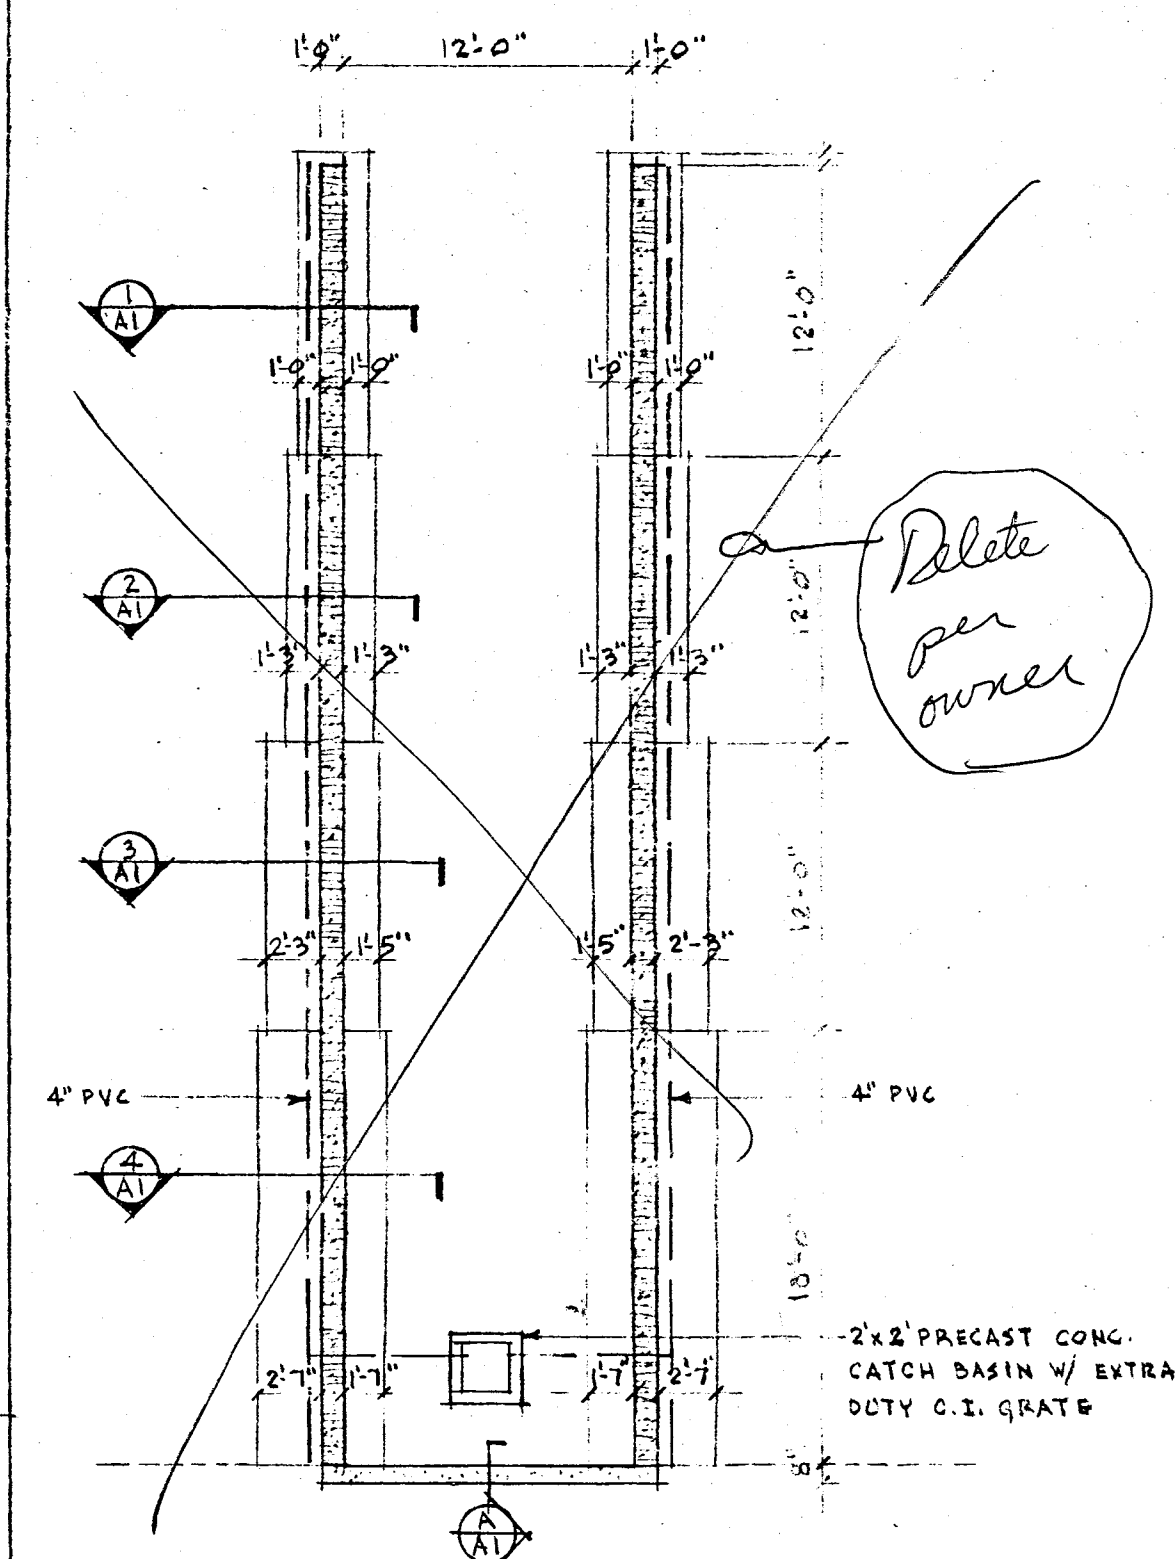

RAMP FOUNDATION PLAN
1/8" = 1'-0"

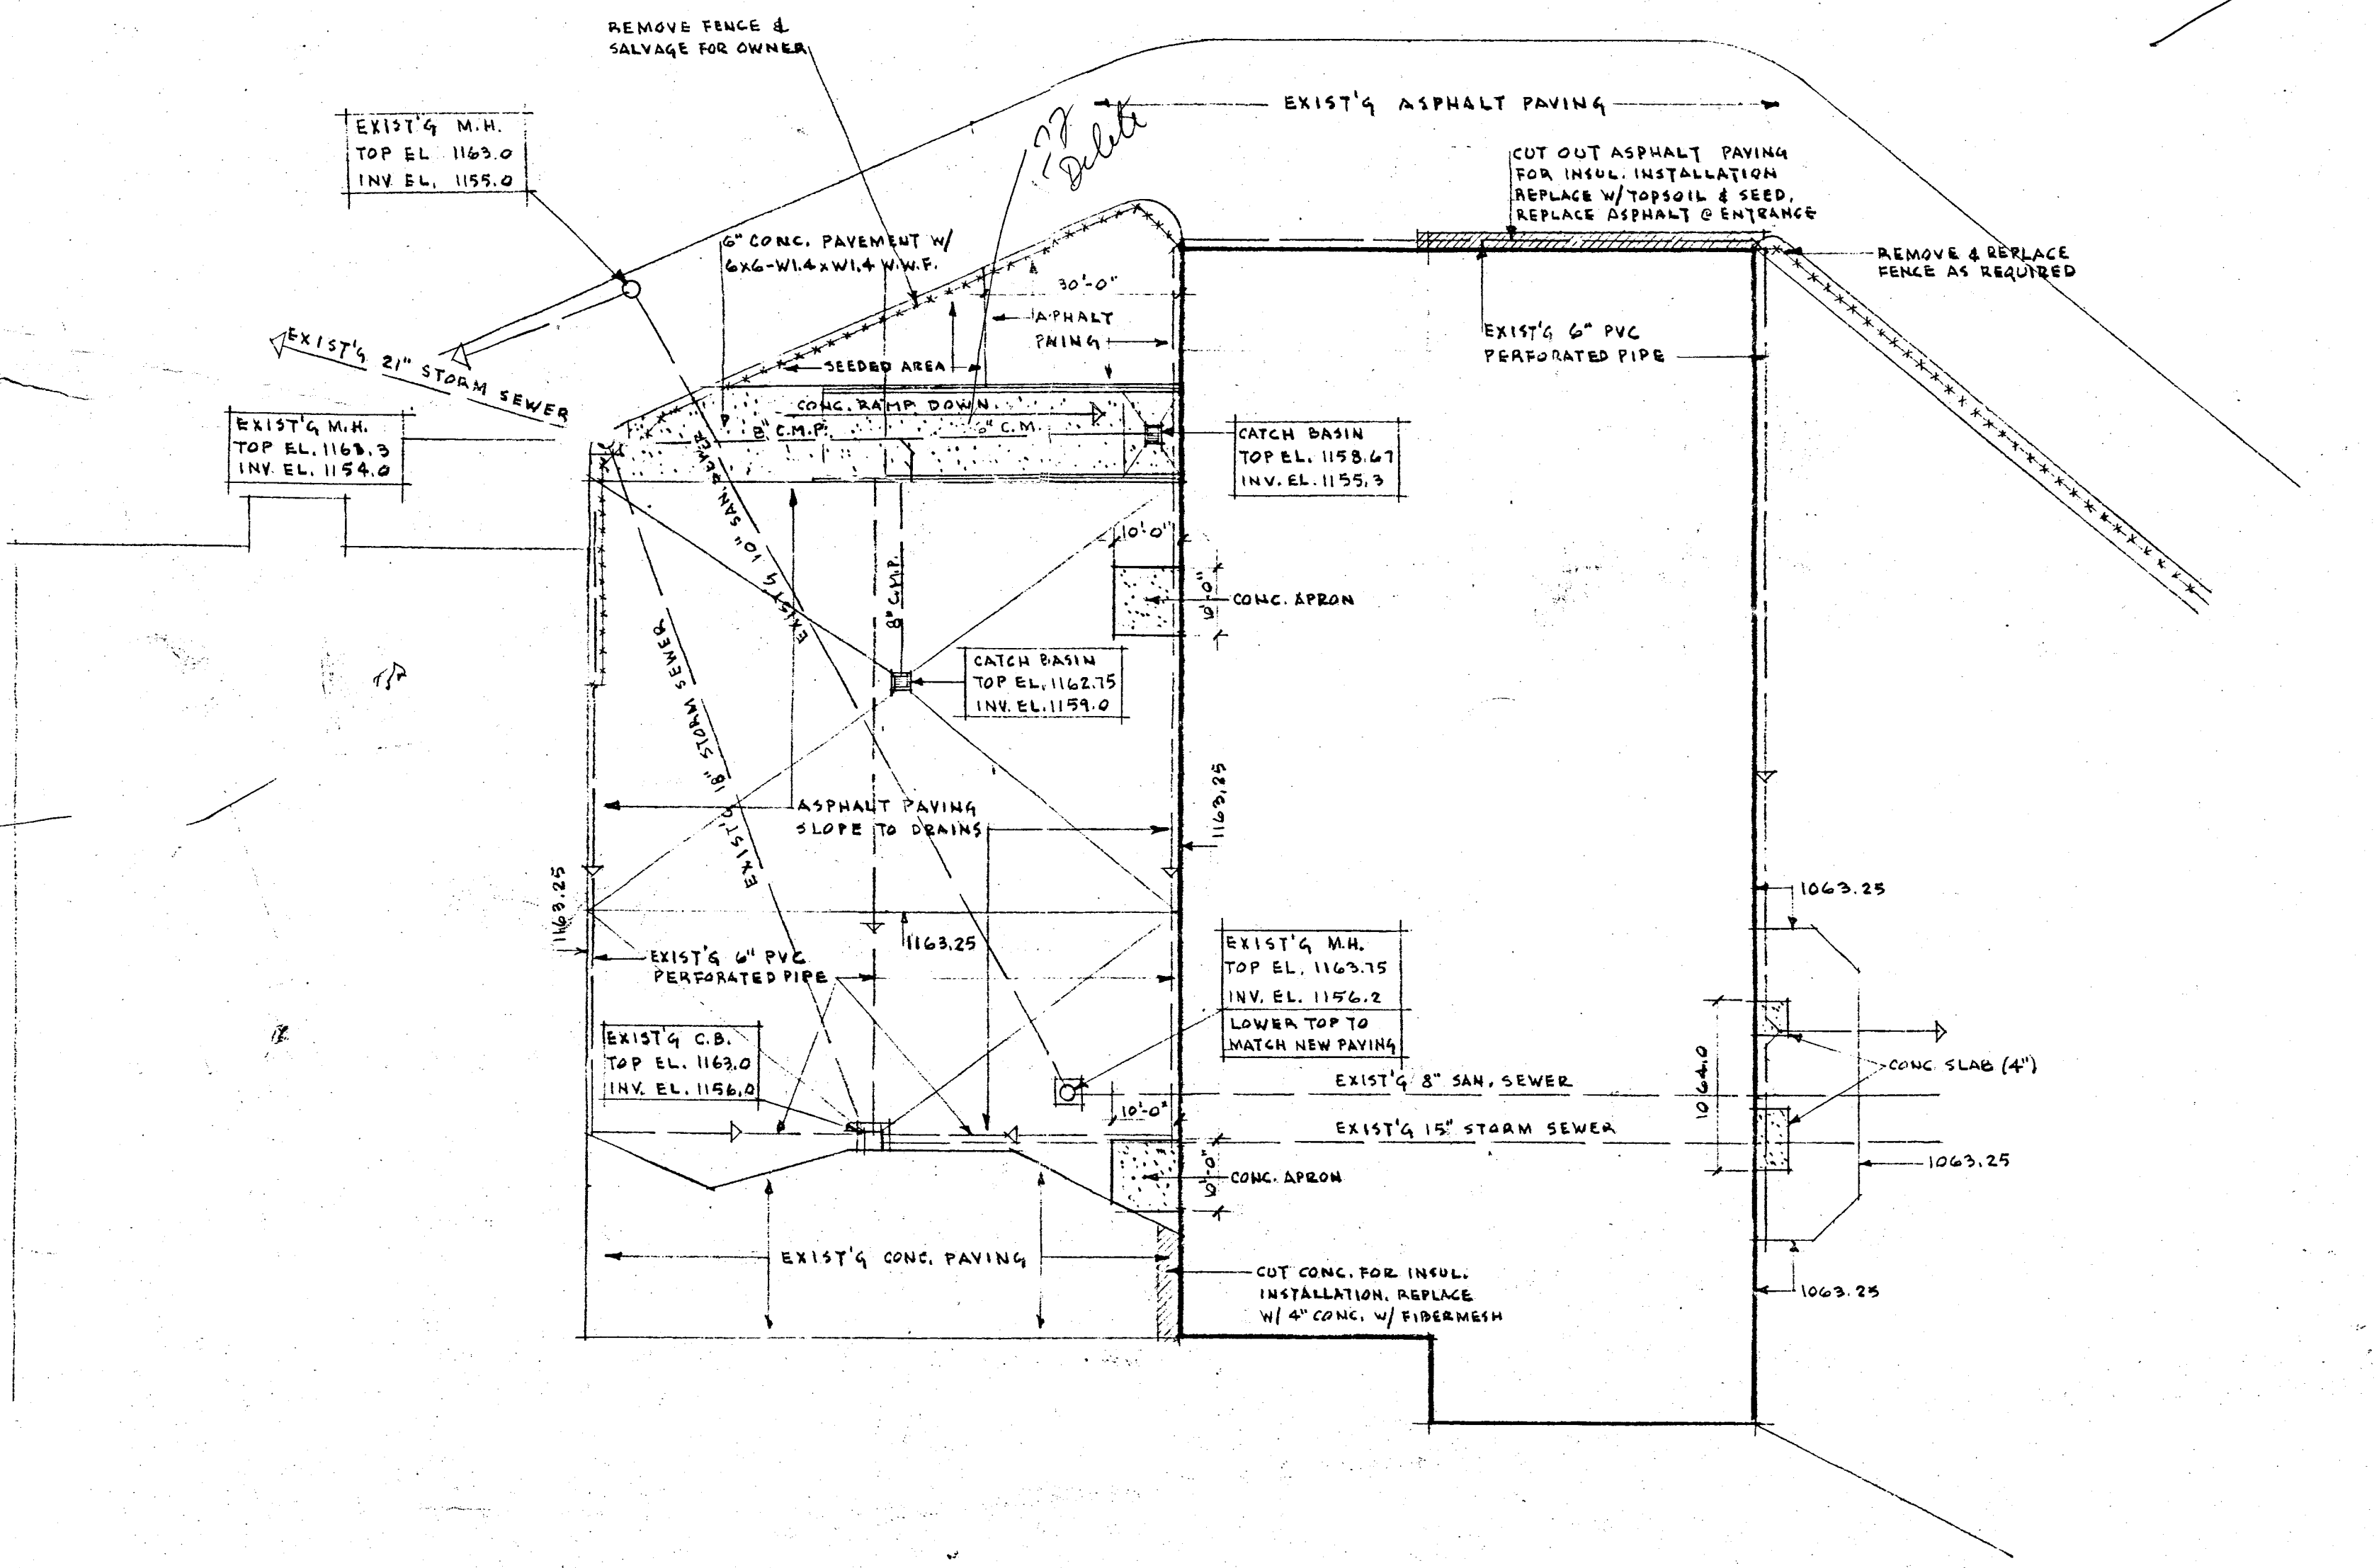

SITE PLAN
1" = 20'

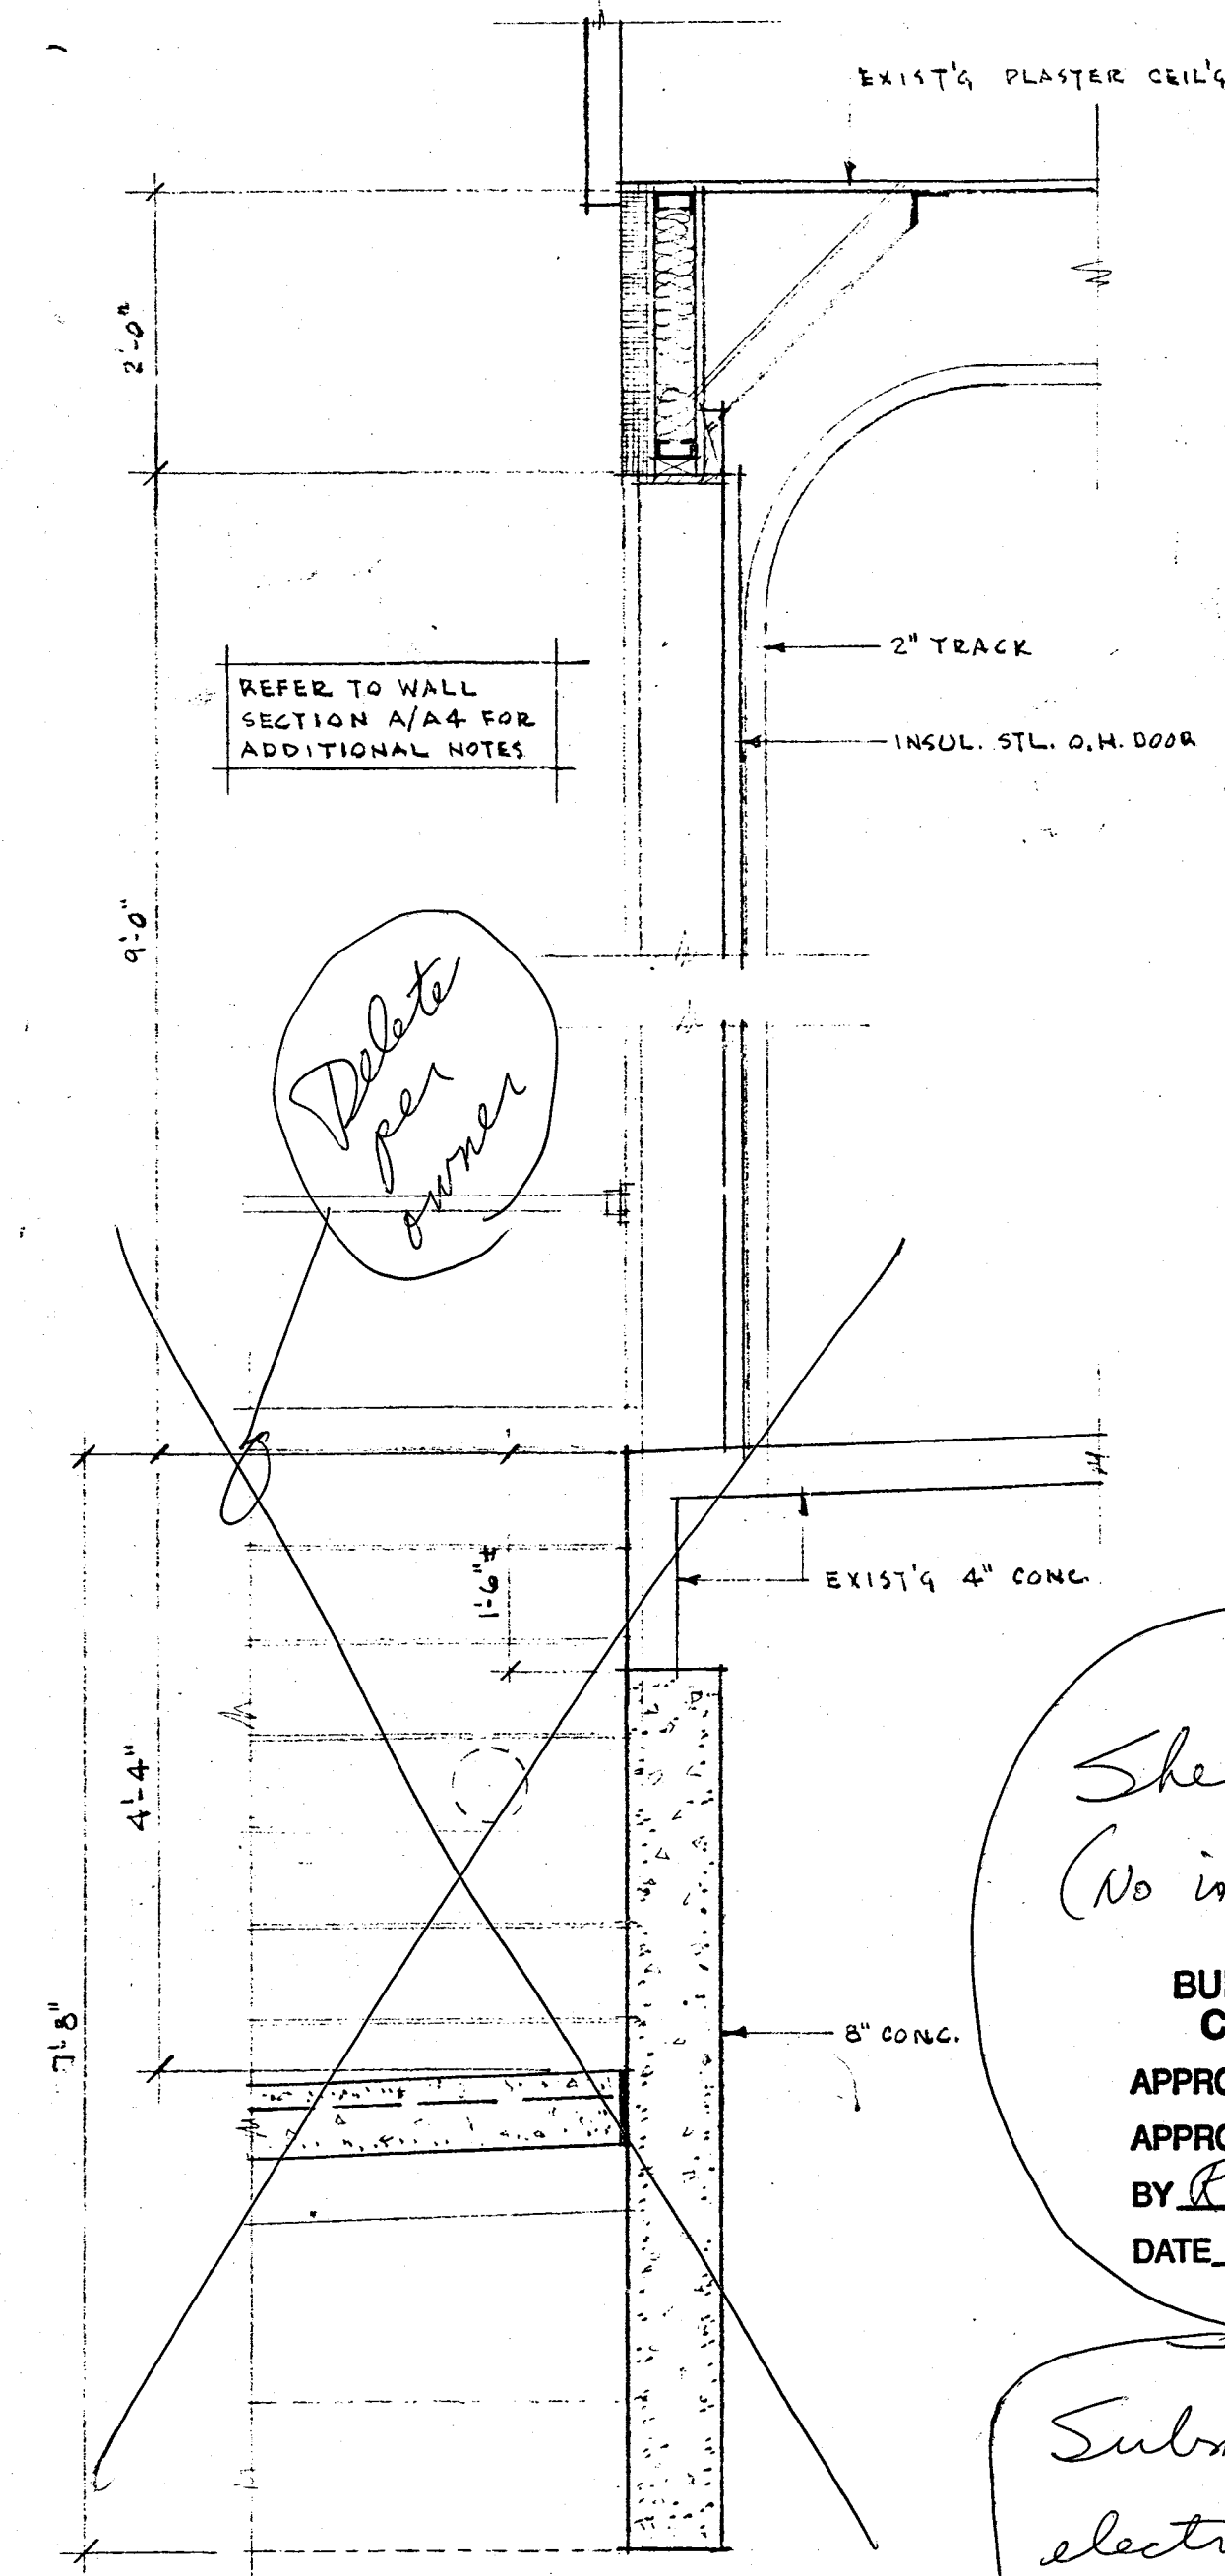

WALL SECTION
3/4" = 1'-0"

Shell Permit Only
(No interior walls)

**BUILDING DEPARTMENT
CITY OF TALLMADGE**

APPROVED _____
APPROVED AS NOTED
BY R. Lyons, Plans Exam
DATE 7/18/95

Submit Hg., plbg., electrical and interior bldg. dwgs for approval


Note:
Delete Ramp (door) and Group Restrooms

CITY OF TALLMADGE
OCCUPANCY
NOT PERMITTED
UNTIL AFTER
INSPECTION


These plans have been reviewed for compliance with the building and construction codes adopted by this jurisdiction. There may be other regulations applicable which this department has no authority to enforce and therefore not been evaluated as part of this plan review.



AI

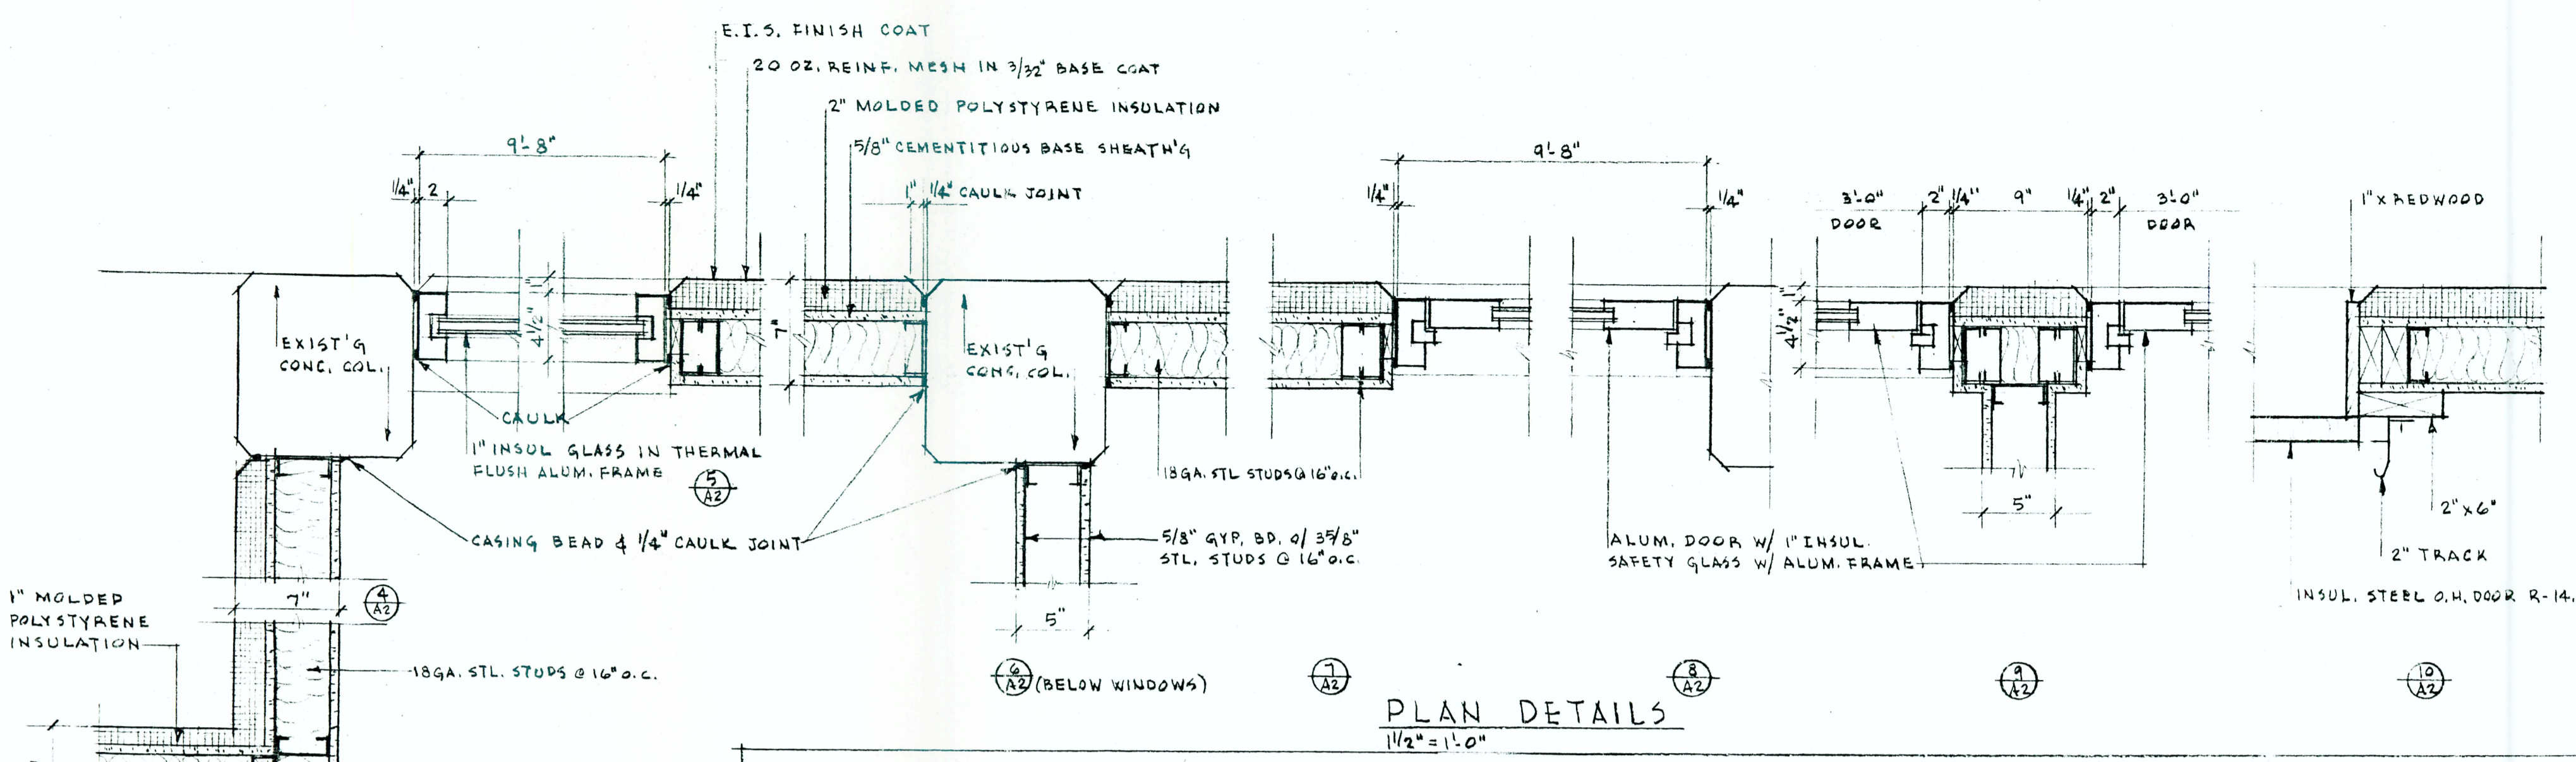


PLAN DETAILS
 1/2" = 1'-0"

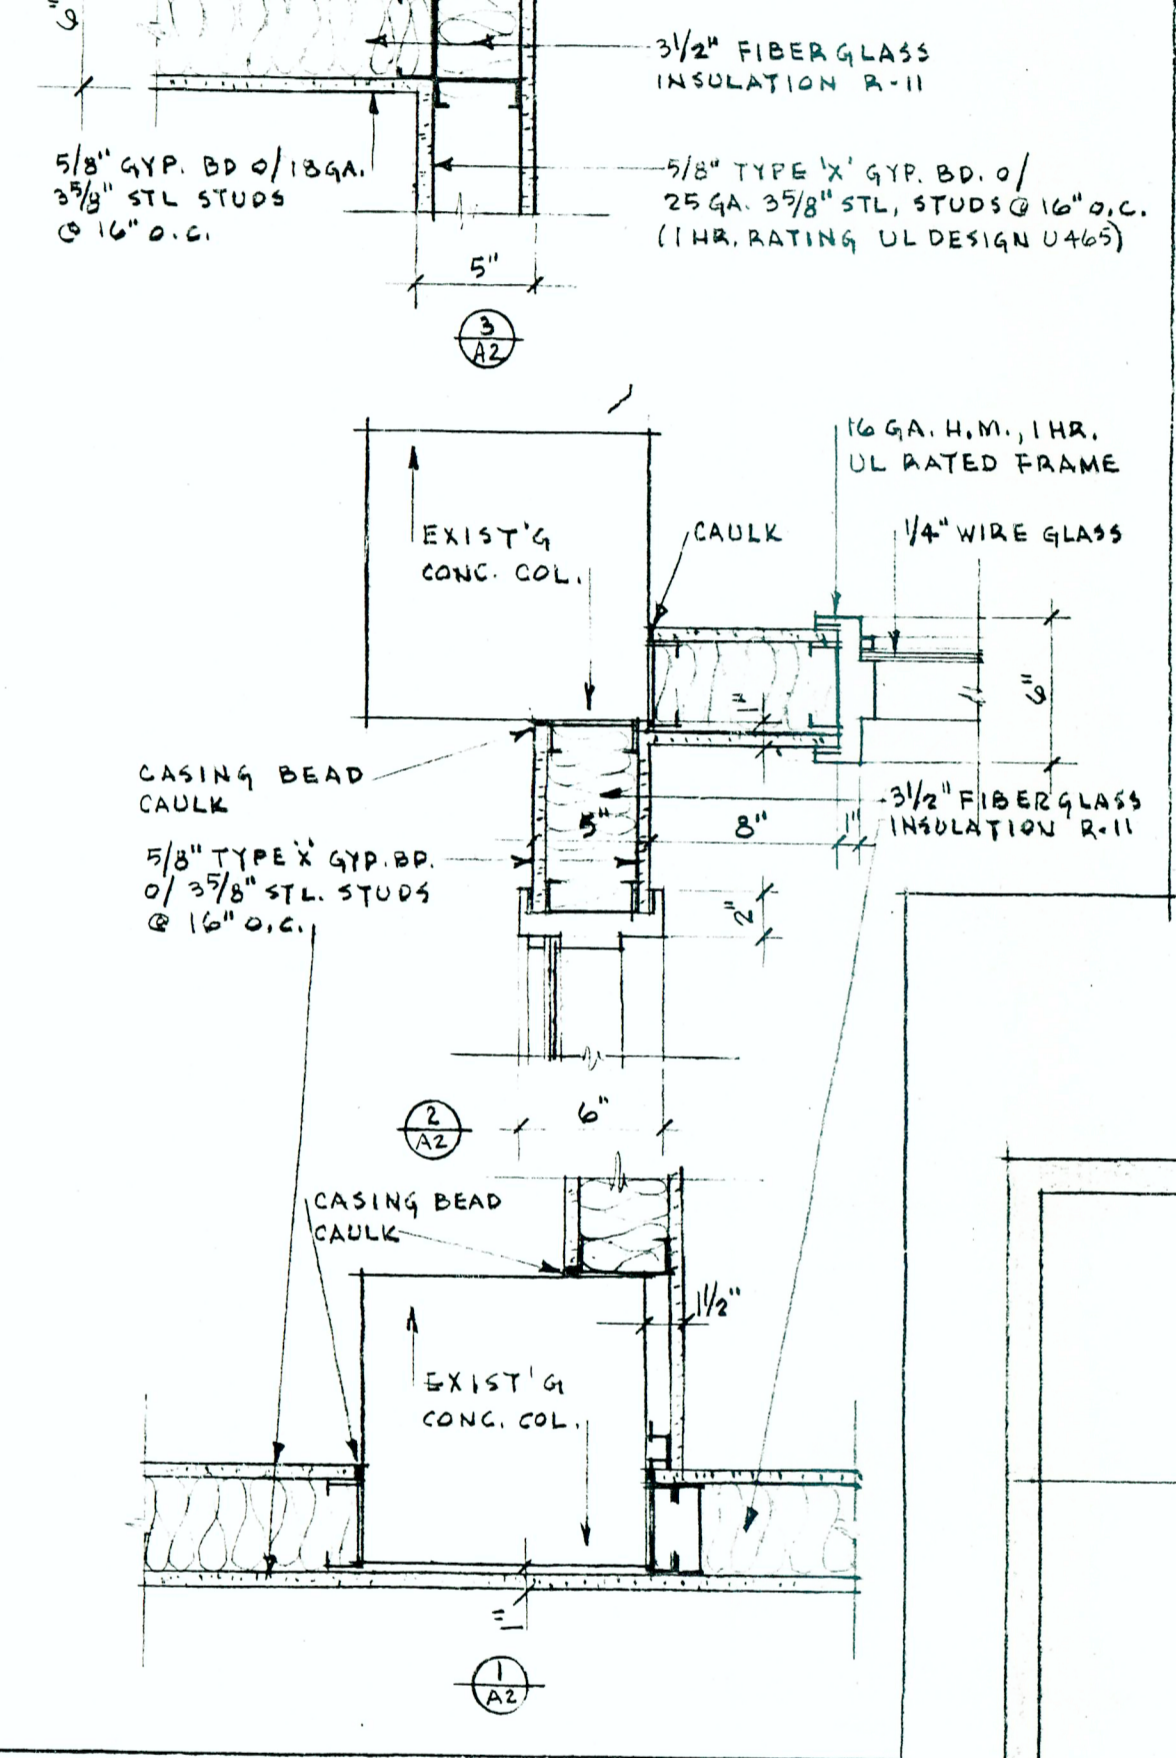

INTERIOR WALLS

WALL TYPES	A	B	C	D	E	F
3/8" x 25 GA. STL. STUDS @ 16" O.C.						
6" 25 GA. STL. STUDS @ 16" O.C.						
5/8" GYP. BD. BOTH SIDES						
5/8" TYPE 'X' GYP. BD. BOTH SIDES						
3/2" FIBERGLASS INSUL.						
3/2" SOUND INSUL.						
RUN WALLS TO EXIST'G. CELLG.						
RUN WALLS TO 9'-4" A.F.F.						
RUN WALLS TO 8'-4" A.F.F.						

EXIST'G. WALLS SHOWN SHADED

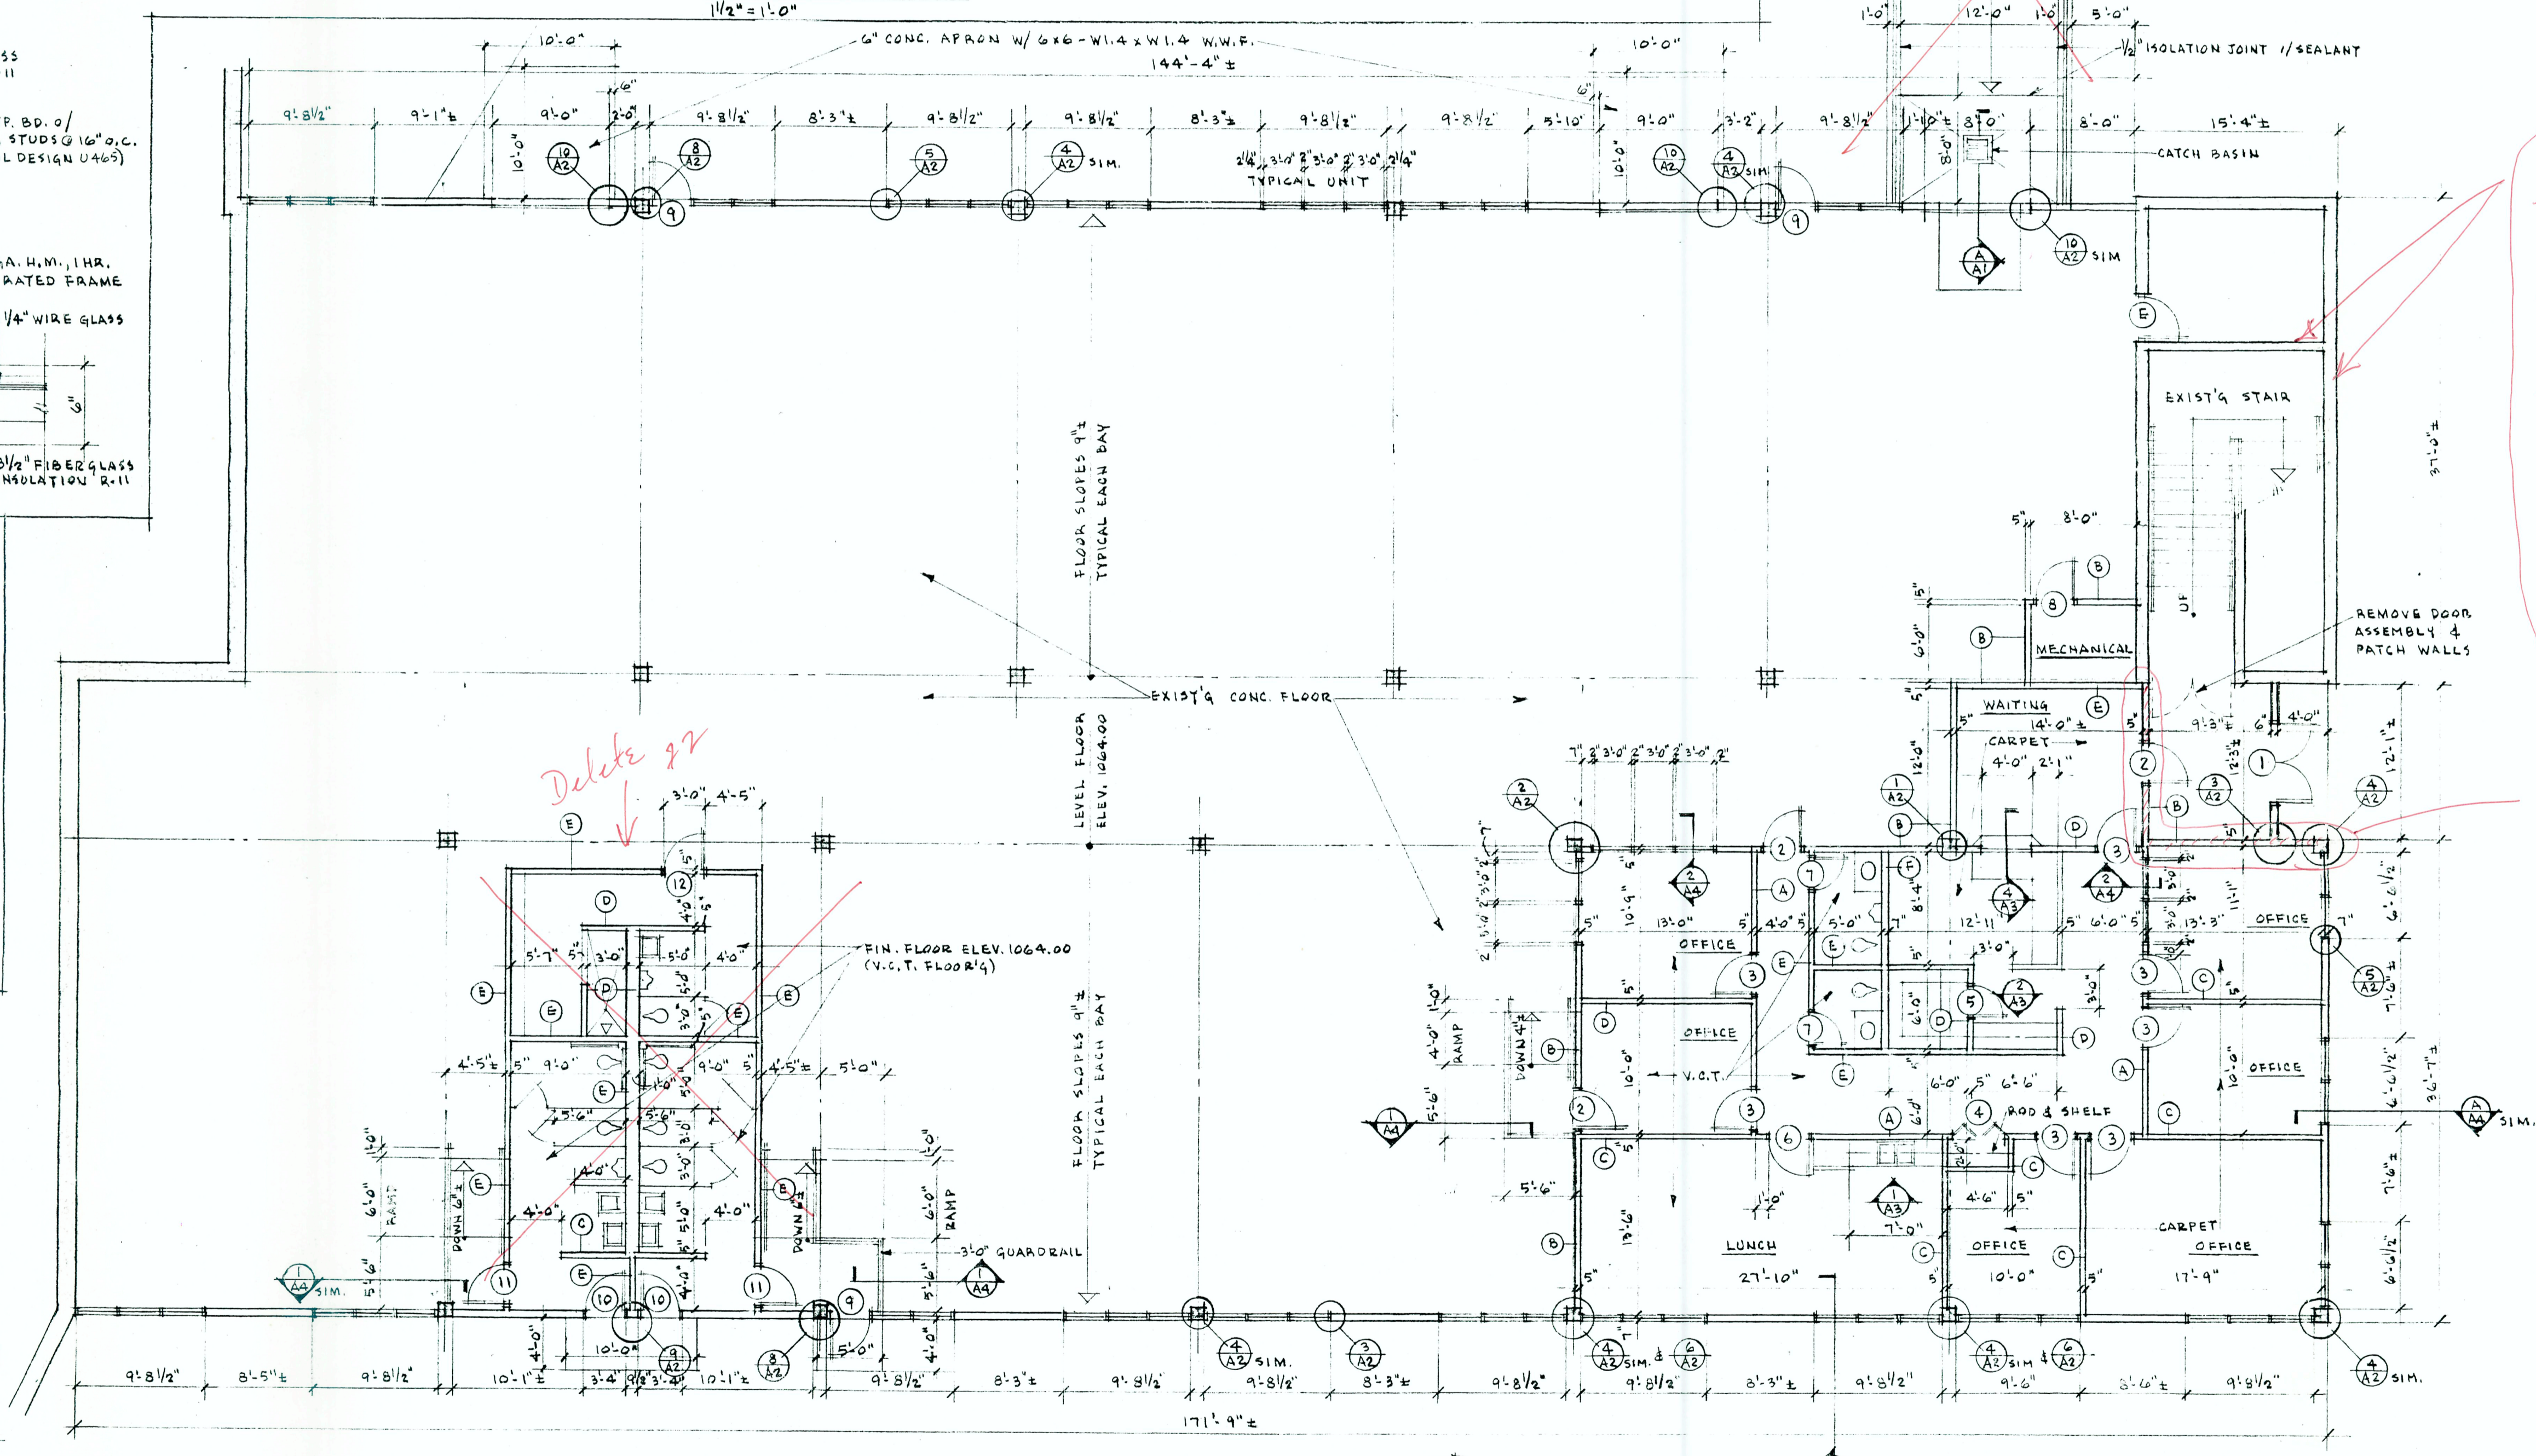


FLOOR PLAN
 1/8" = 1'-0"

Verify 1-Hr rated enclosure walls and doors for stairway - replace existing glass enclosure on upper floor w/ 2x4 metal studs at 16" O.C. w/ 5/8" fire-rated drywall each side & tight to deck or approved equal

Provide 2-Hr rated wall to separate fire areas - tight to deck

SUMMIT COUNTY MI/MB FACILITIES OPERATION
 80 EAST HOME ROAD
 TALLMADGE, OHIO



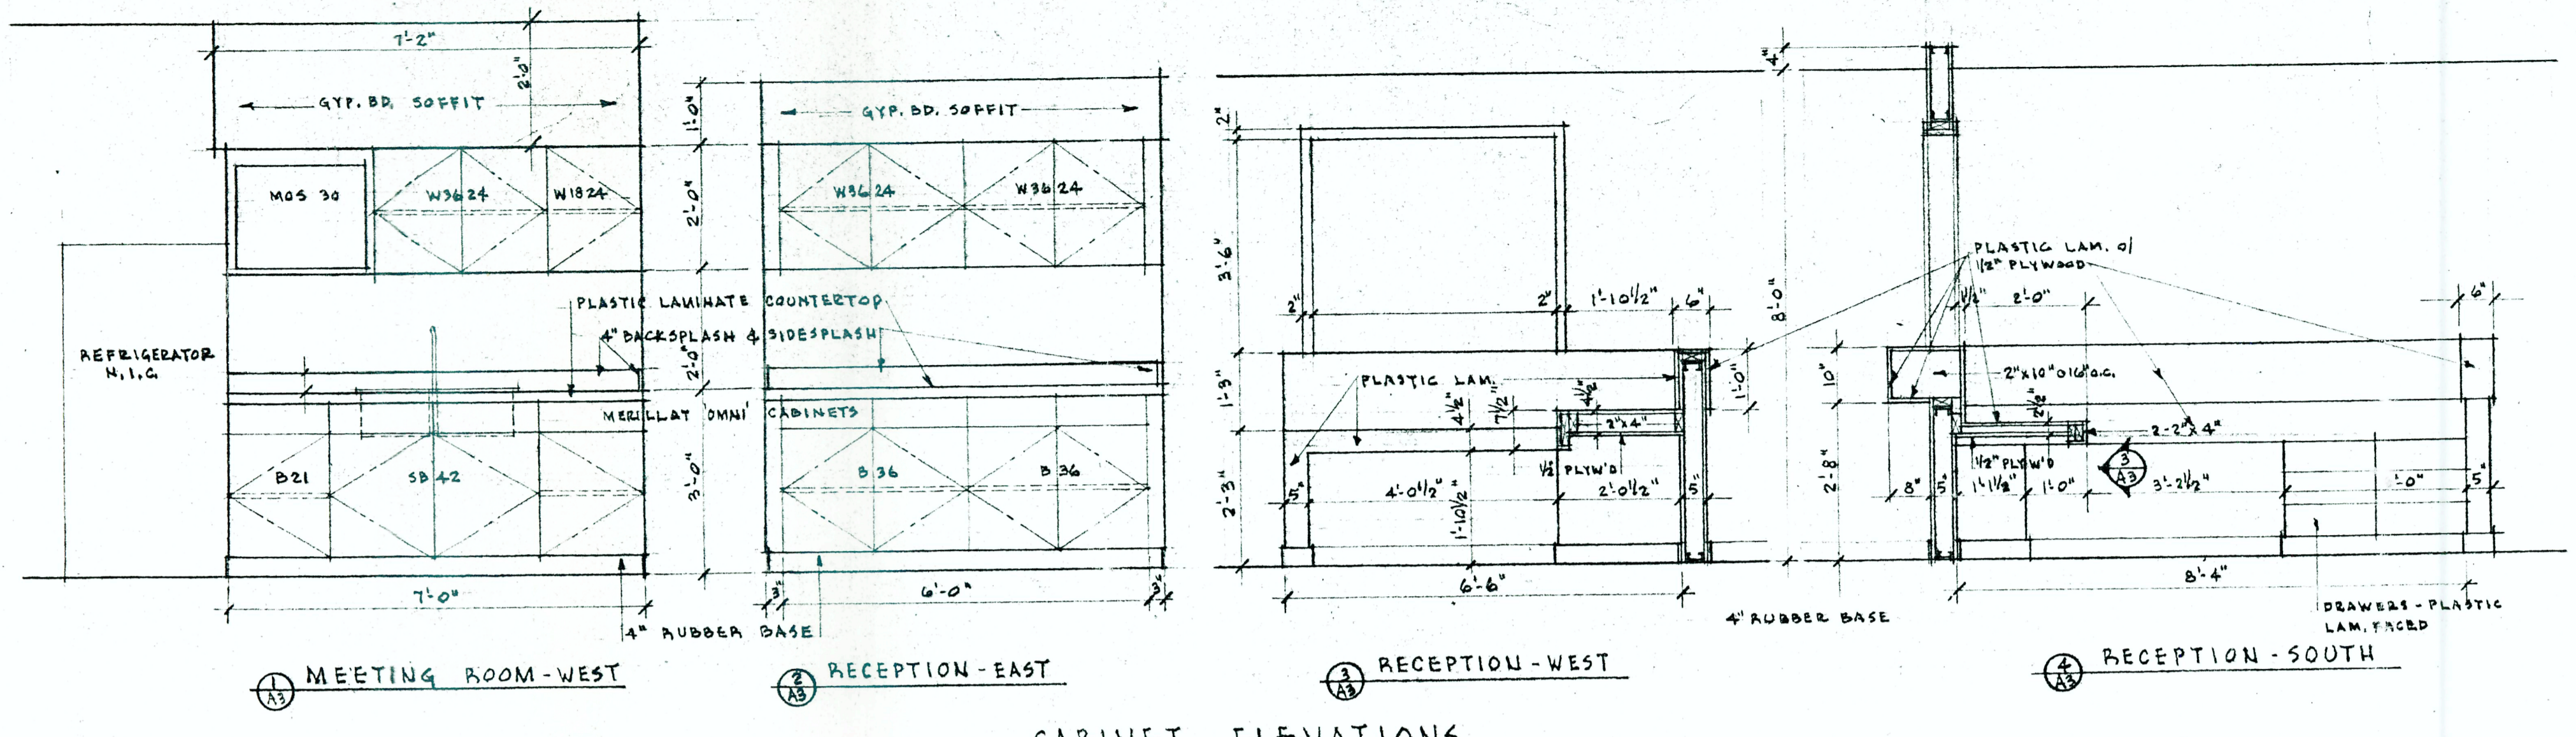


1 1/2 hr generated

DOOR SCHEDULE				
No.	SIZE	MATERIAL	UL LABEL	REMARKS
1	PR. 3' x 7' x 1 3/4"	ALUM. ALUM.		ADAMS SERIES 8600 PANIC HARDWARE, EXTERIOR PULLS, CLOSERS, LOCKSETS, PIVOT HINGES, THRESHOLD, WEATHERSTRIP'S
2	3' x 7' x 1 3/4"	OAK H.M.	20 MIN	LOCKSET & CLOSER
3	3' x 7' x 1 3/4"	OAK H.M.		LOCKSET & DOOR STOP
4	4' x 7' x 1 3/4"	OAK OAK		4-LEAF BI-FOLD, DUMMY KNOBSSETS
5	2' x 7' x 1 3/4"	OAK H.M.		LOCKSET
6	3' x 7' x 1 3/4"	OAK H.M.		LATCHSET
7	2' x 7' x 1 3/4"	OAK H.M.		PRIVACY LOCK & CLOSER
8	3' x 7' x 1 3/4"	ALUM. H.M.	20 MIN	LOCKSET & CLOSER
9	3' x 7' x 1 3/4"	ALUM. ALUM.		LOCKSET, CLOSER, THRESHOLD, WEATHERSTRIP'S
10	3' x 7' x 1 3/4"	ALUM. ALUM.		LOCKSET, CLOSER, THRESHOLD, WEATHERSTRIP'S
11	3' x 7' x 1 3/4"	MARLITE H.M.		LOCKSET, CLOSER
12	3' x 7' x 1 3/4"	MARLITE H.M.		LATCHSET, CLOSER


• INTERIOR DOORS: STANDARD SOLID CORE, FLUSH TYPE.
 • EXTERIOR DOORS: WIDE STILE ALUMINUM, CLEAR FINISH.
 • KNOBSSETS: SCHLAGE S-SERIES, SATURN STYLE
 • CLOSERS: LCN 4040 SERIES
 • THRESHOLDS: ZERO 545A

All new doors and hardware to be handicapped accessible per ADA 9

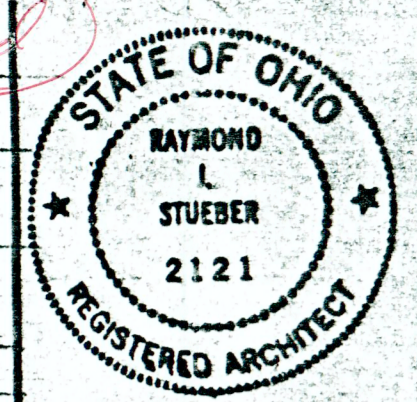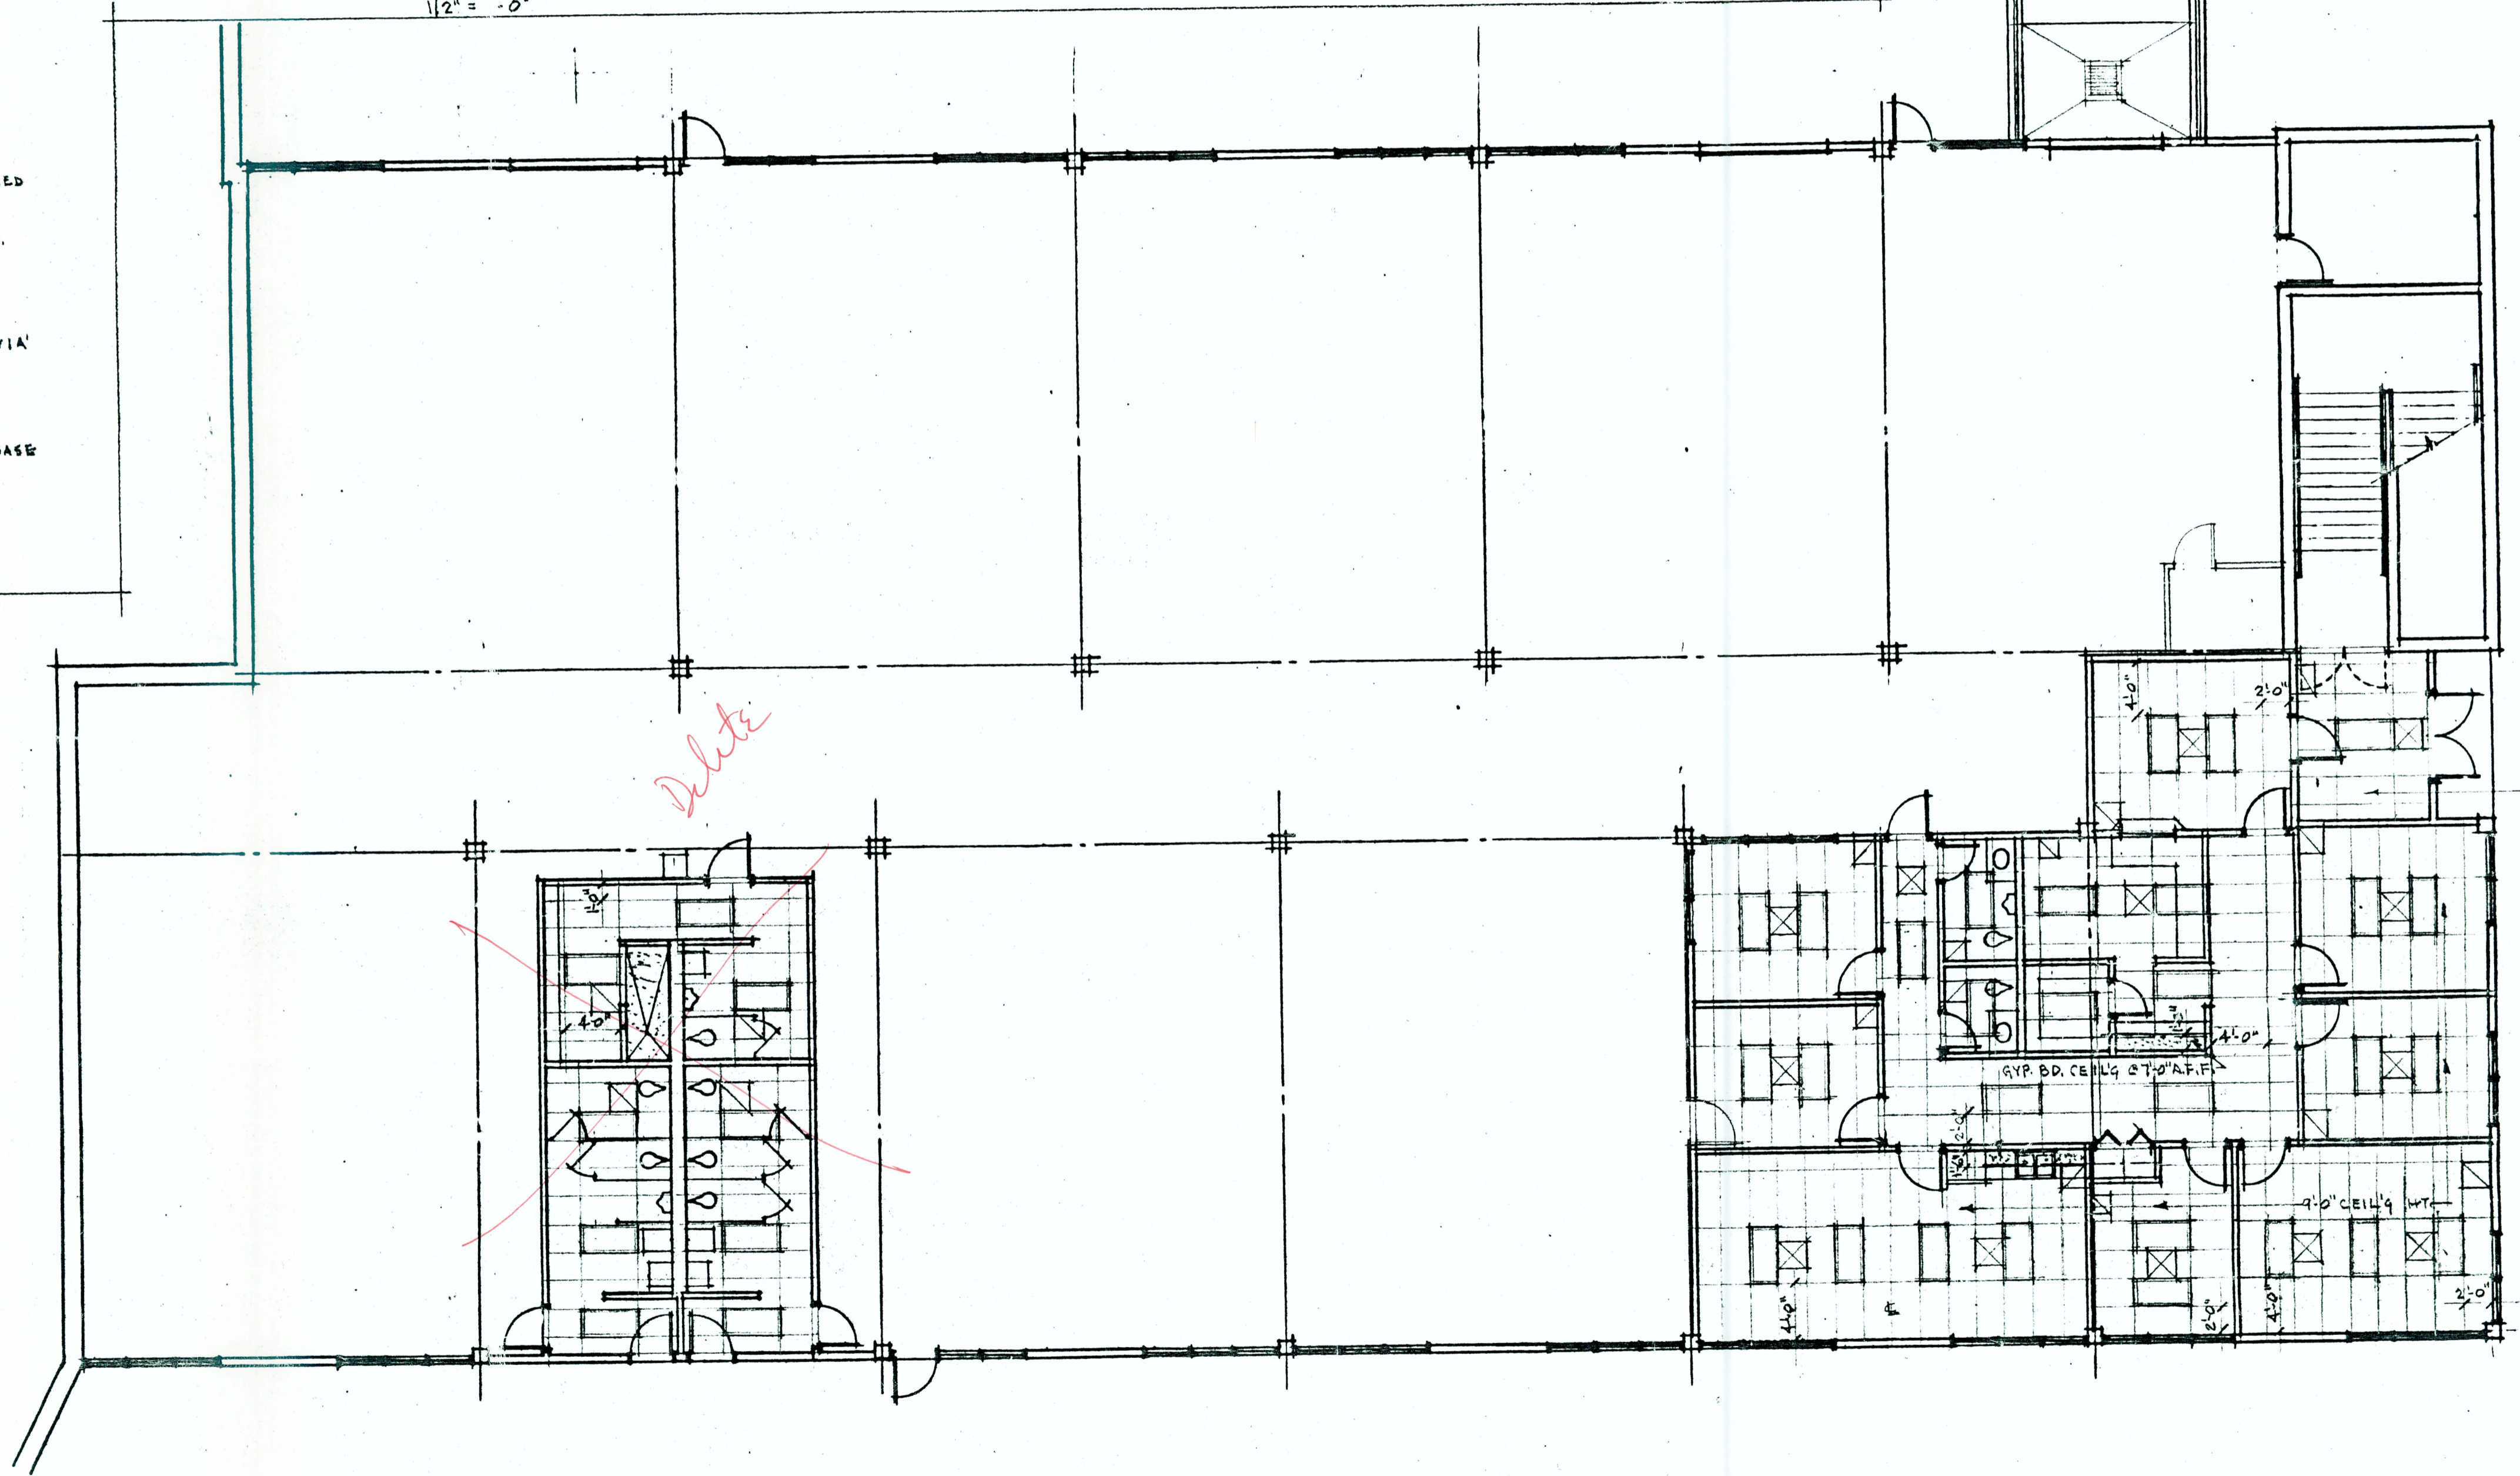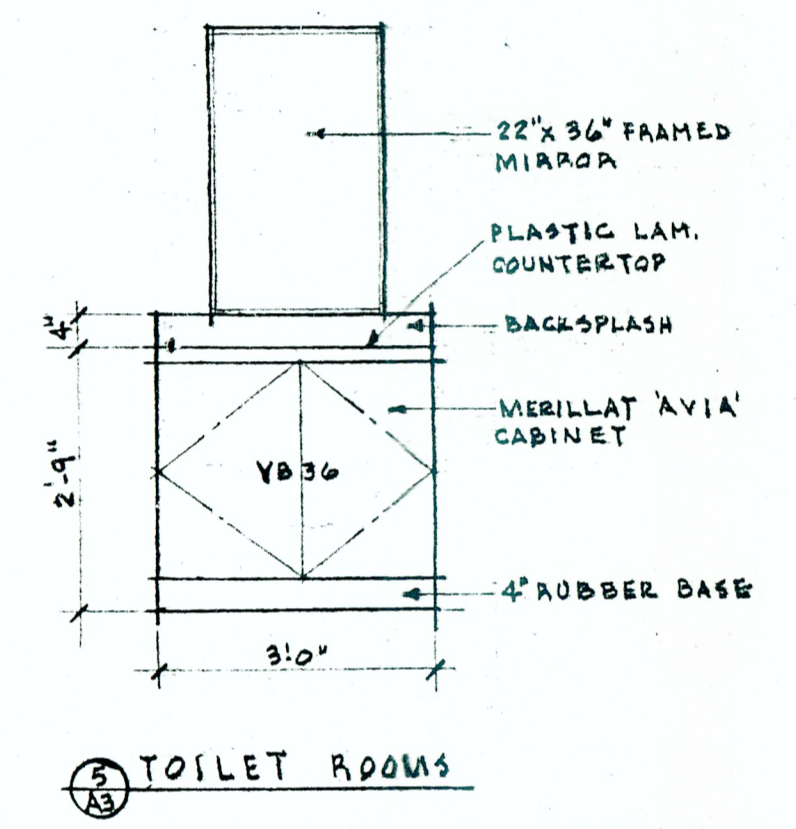


SUMMIT COUNTY MH/MR FACILITIES OPERATION
30 EAST HOME ROAD
TALLMADGE, OHIO


A3

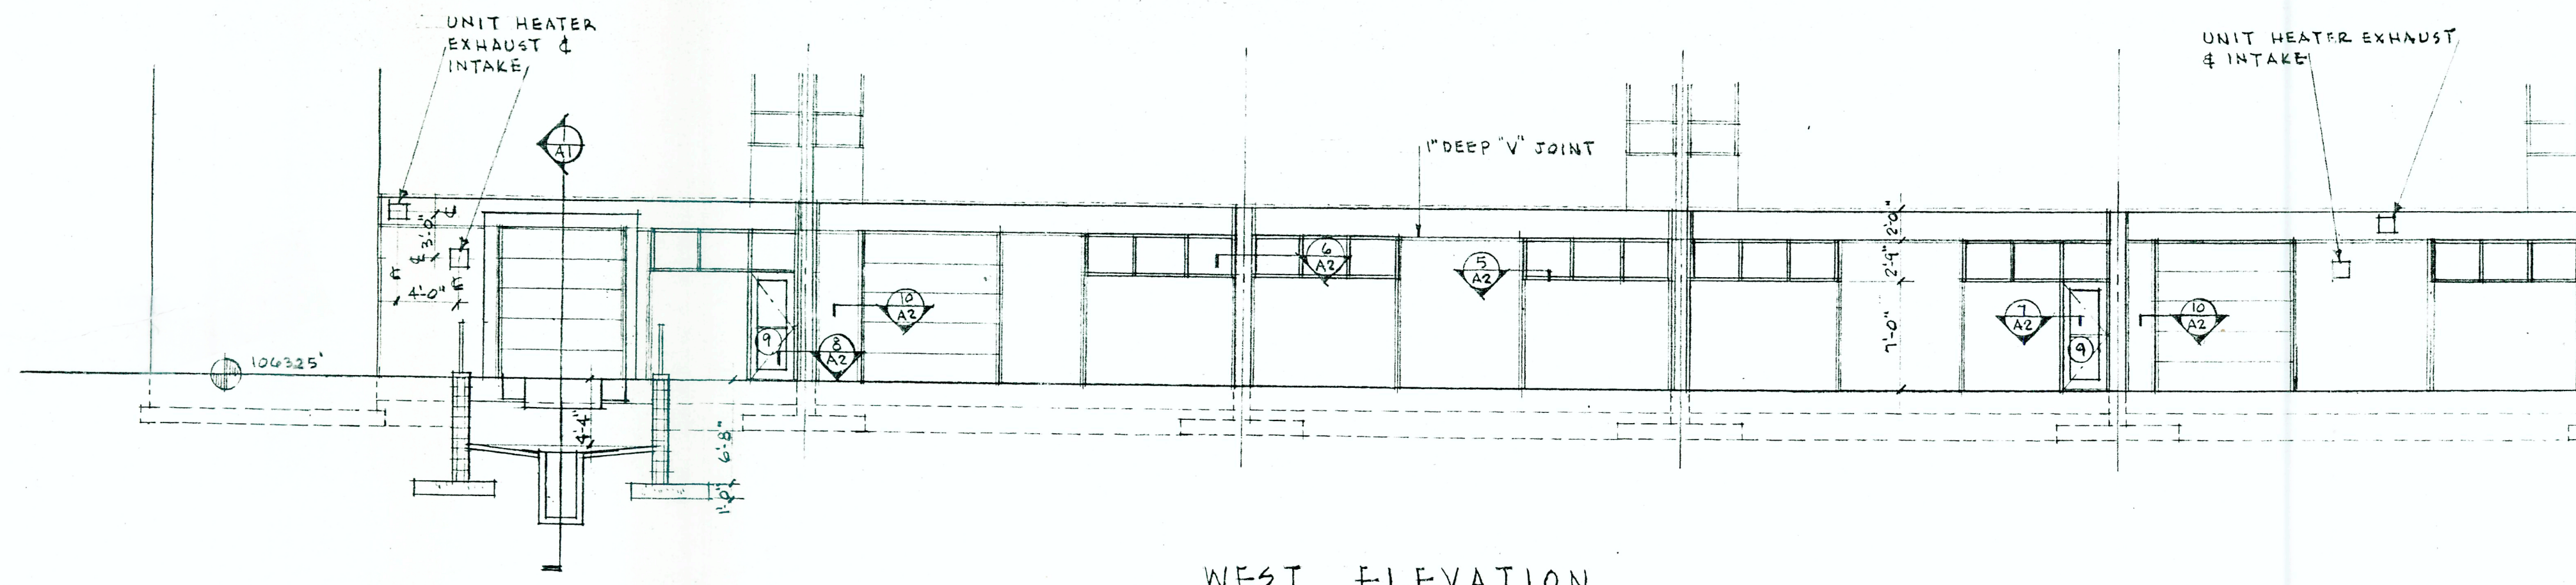


WEST ELEVATION
 1/8" = 1'-0"

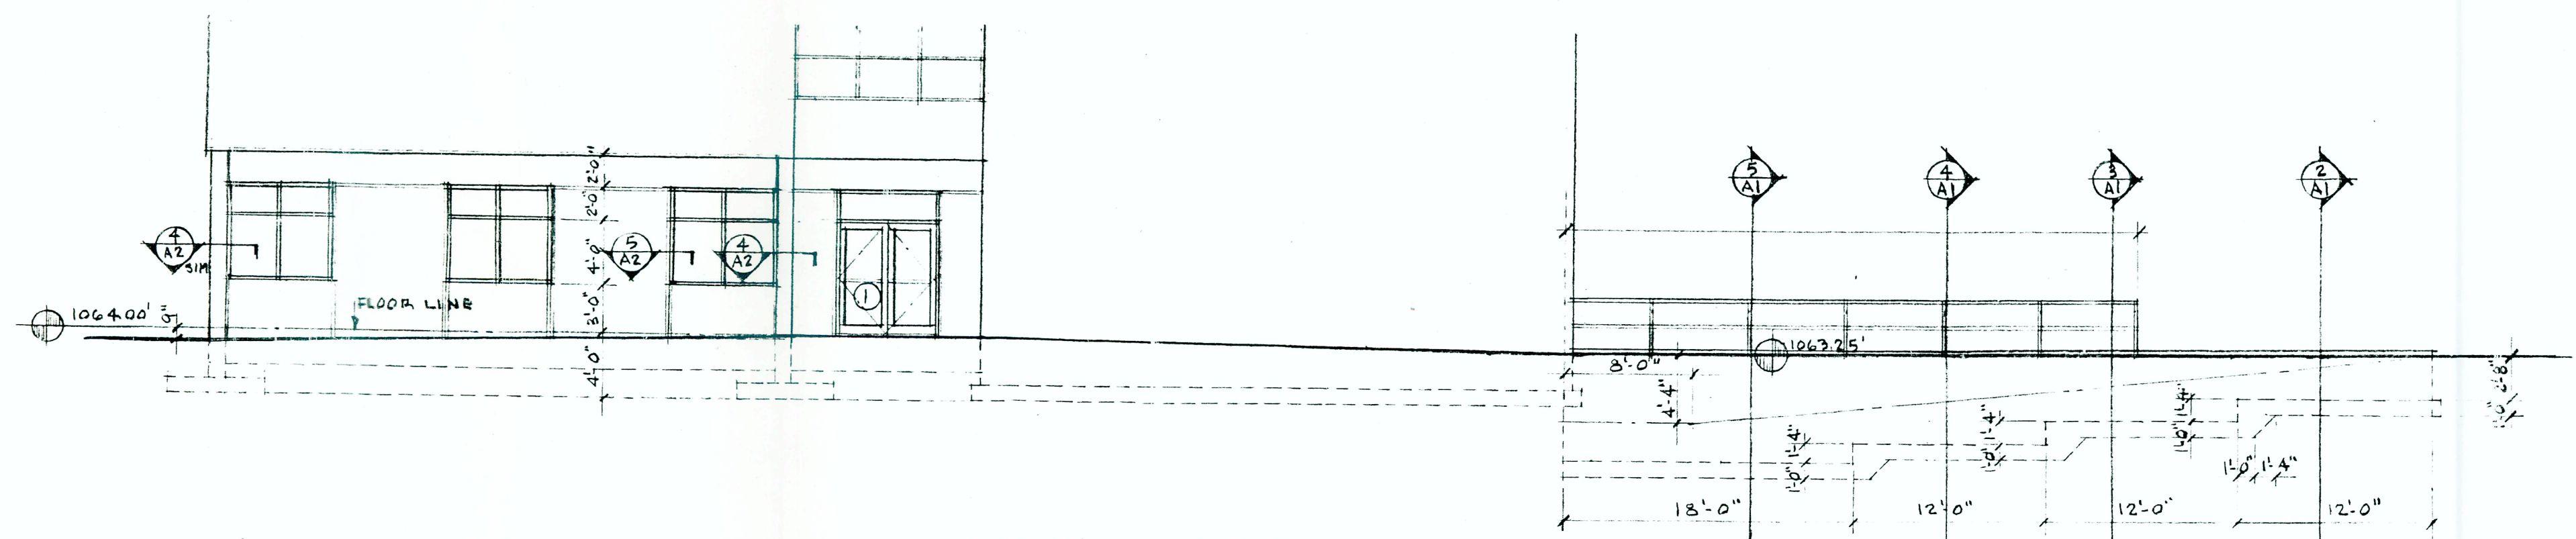

NORTH ELEVATION
 1/8" = 1'-0"

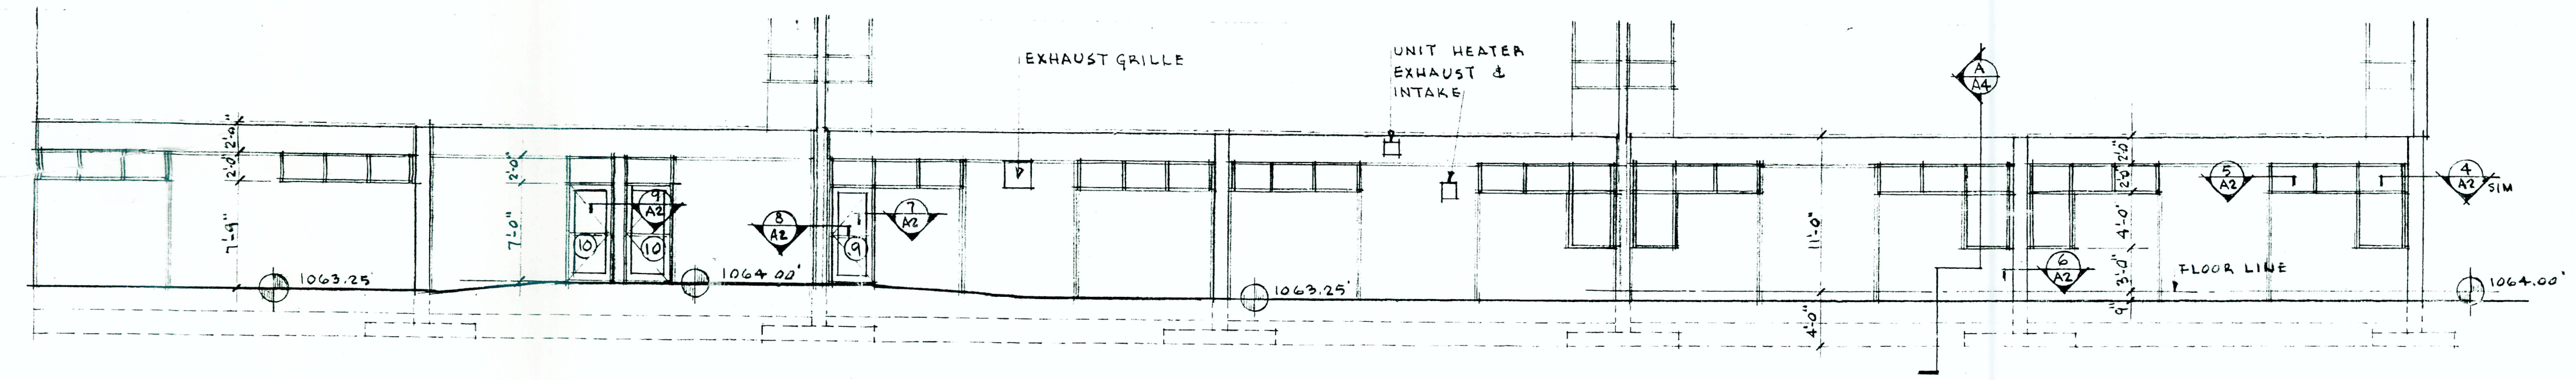


EAST ELEVATION
 1/8" = 1'-0"

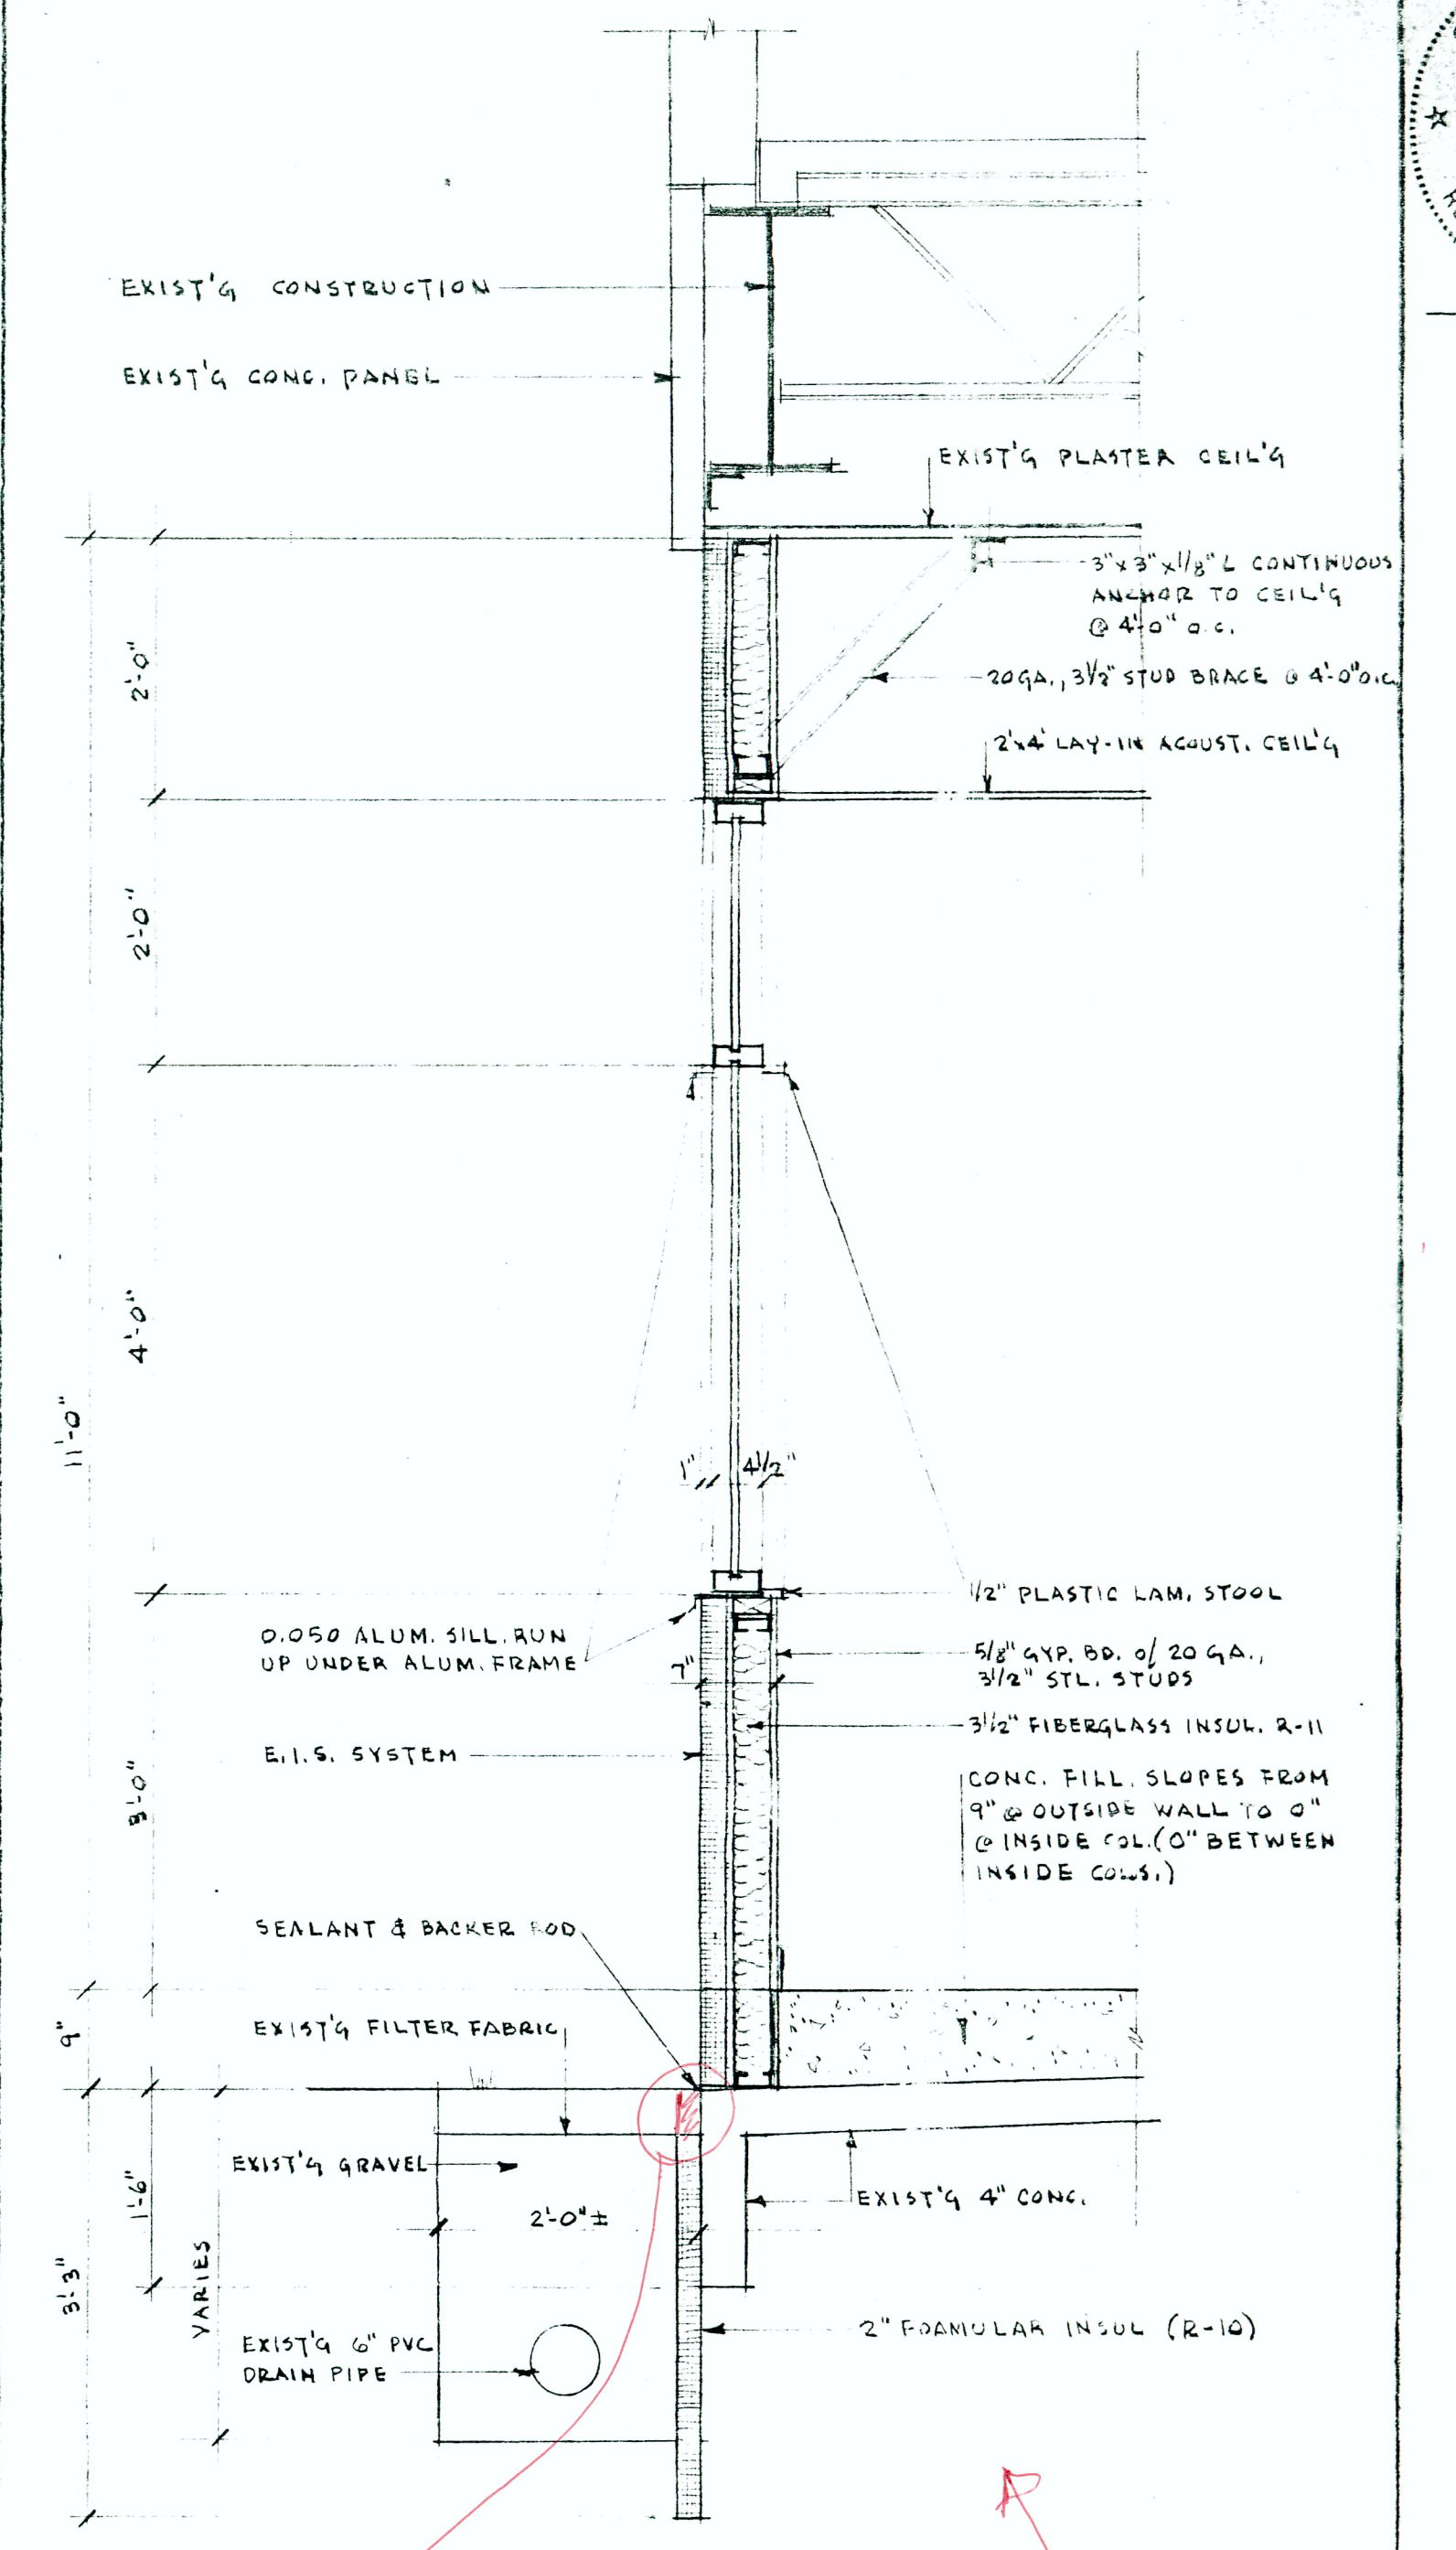


WALL SECTION
 3/4" = 1'-0"

extend insulation - protect top of insulation as req'd

Provide design info to verify frost protection w/ this system per OBBC 1806.1

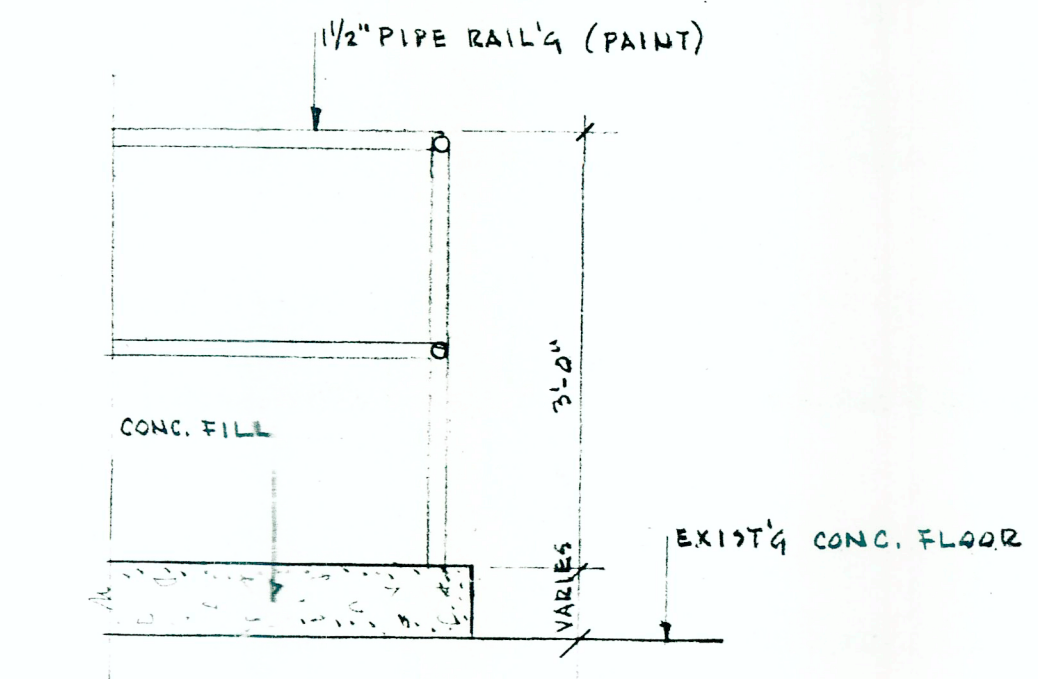

FLOOR DETAIL
 3/4" = 1'-0"

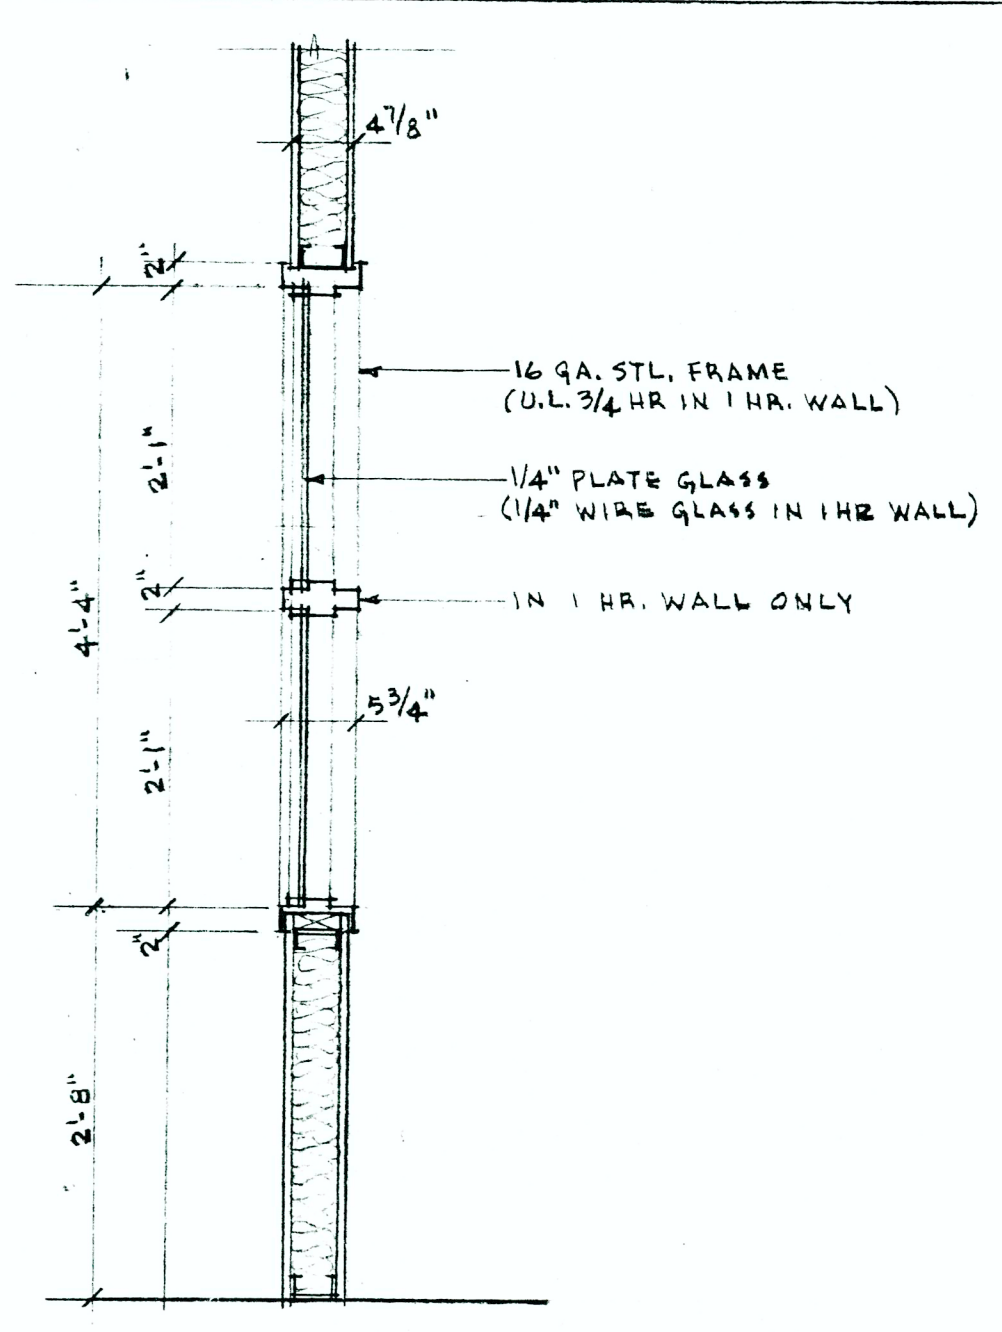


WALL DETAIL
 3/4" = 1'-0"

DOOR SCHEDULE					
NO	SIZE	DOOR	FRAME	UL LABEL	REMARKS
1	3'-7" x 1'-3/4"	MPL	MPL	IHR	AUTOMATIC CLOSER, LOCKSET
2	3'-7" x 1'-3/4"	OAK	MPL	90MIN	CLOSER, LOCKSET
3	3'-7" x 1'-3/4"	OAK	MPL		CLOSER
4	3'-7" x 1'-3/4"	OAK	MPL		
5	3'-7" x 1'-3/4"	OAK	MPL		
6	3'-7" x 1'-3/4"	OAK	MPL		
7	3'-7" x 1'-3/4"	OAK	MPL		
8	2'-7" x 1'-3/4"	OAK	MPL		PUSHBUTTON LOCKSET, CLOSER
9	3'-7" x 1'-3/4"	OAK	MPL	90MIN	CLOSER, *
10	2'-7" x 1'-3/4"	OAK	MPL		PUSHBUTTON LOCKSET, CLOSER
11	3'-7" x 1'-3/4"	OAK	MPL		
12	3'-7" x 1'-3/4"	OAK	MPL		
13	3'-7" x 1'-3/4"	OAK	MPL		
14	3'-7" x 1'-3/4"	OAK	MPL		
15	3'-7" x 1'-3/4"	OAK	MPL	90MIN	CLOSER *
16	3'-7" x 1'-3/4"	ALUM	ALUM		MATCH OTHER EXIT DRS - THRESHOLD, CLOSER
17	MATCH OTHER	MPL	MPL	IHR	LOCKSET
18	6'-7" x 1'-3/4"	MPL	MPL		


All door hardware to comply w/ ADA

* door must latch when closed

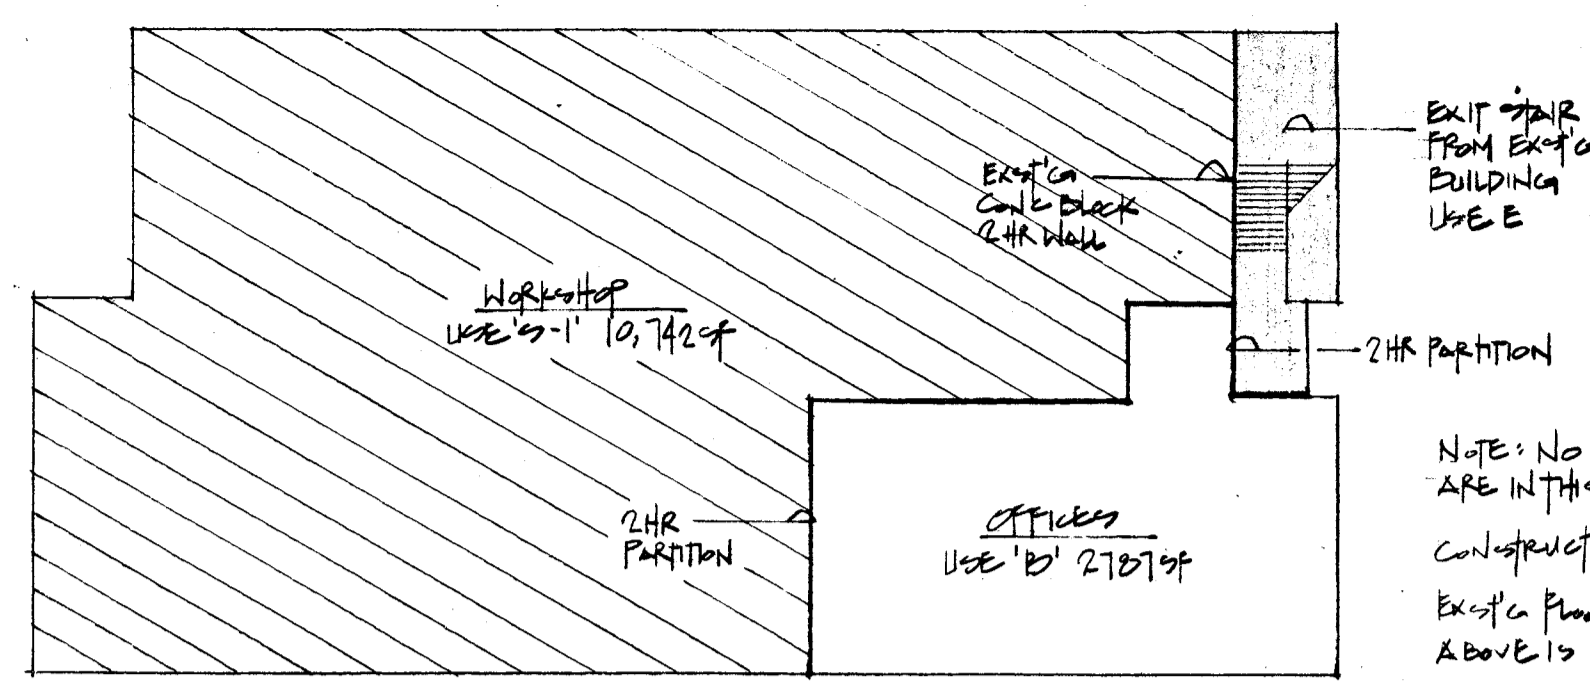

NOTE: NO SPRINKLERS ARE IN THIS BUILDING
CONSTRUCTION CLASS 1B
EXIST'G FLOOR / CEILING ASSEMBLY ABOVE IS 4HR UL-C-401

CODE INFORMATION

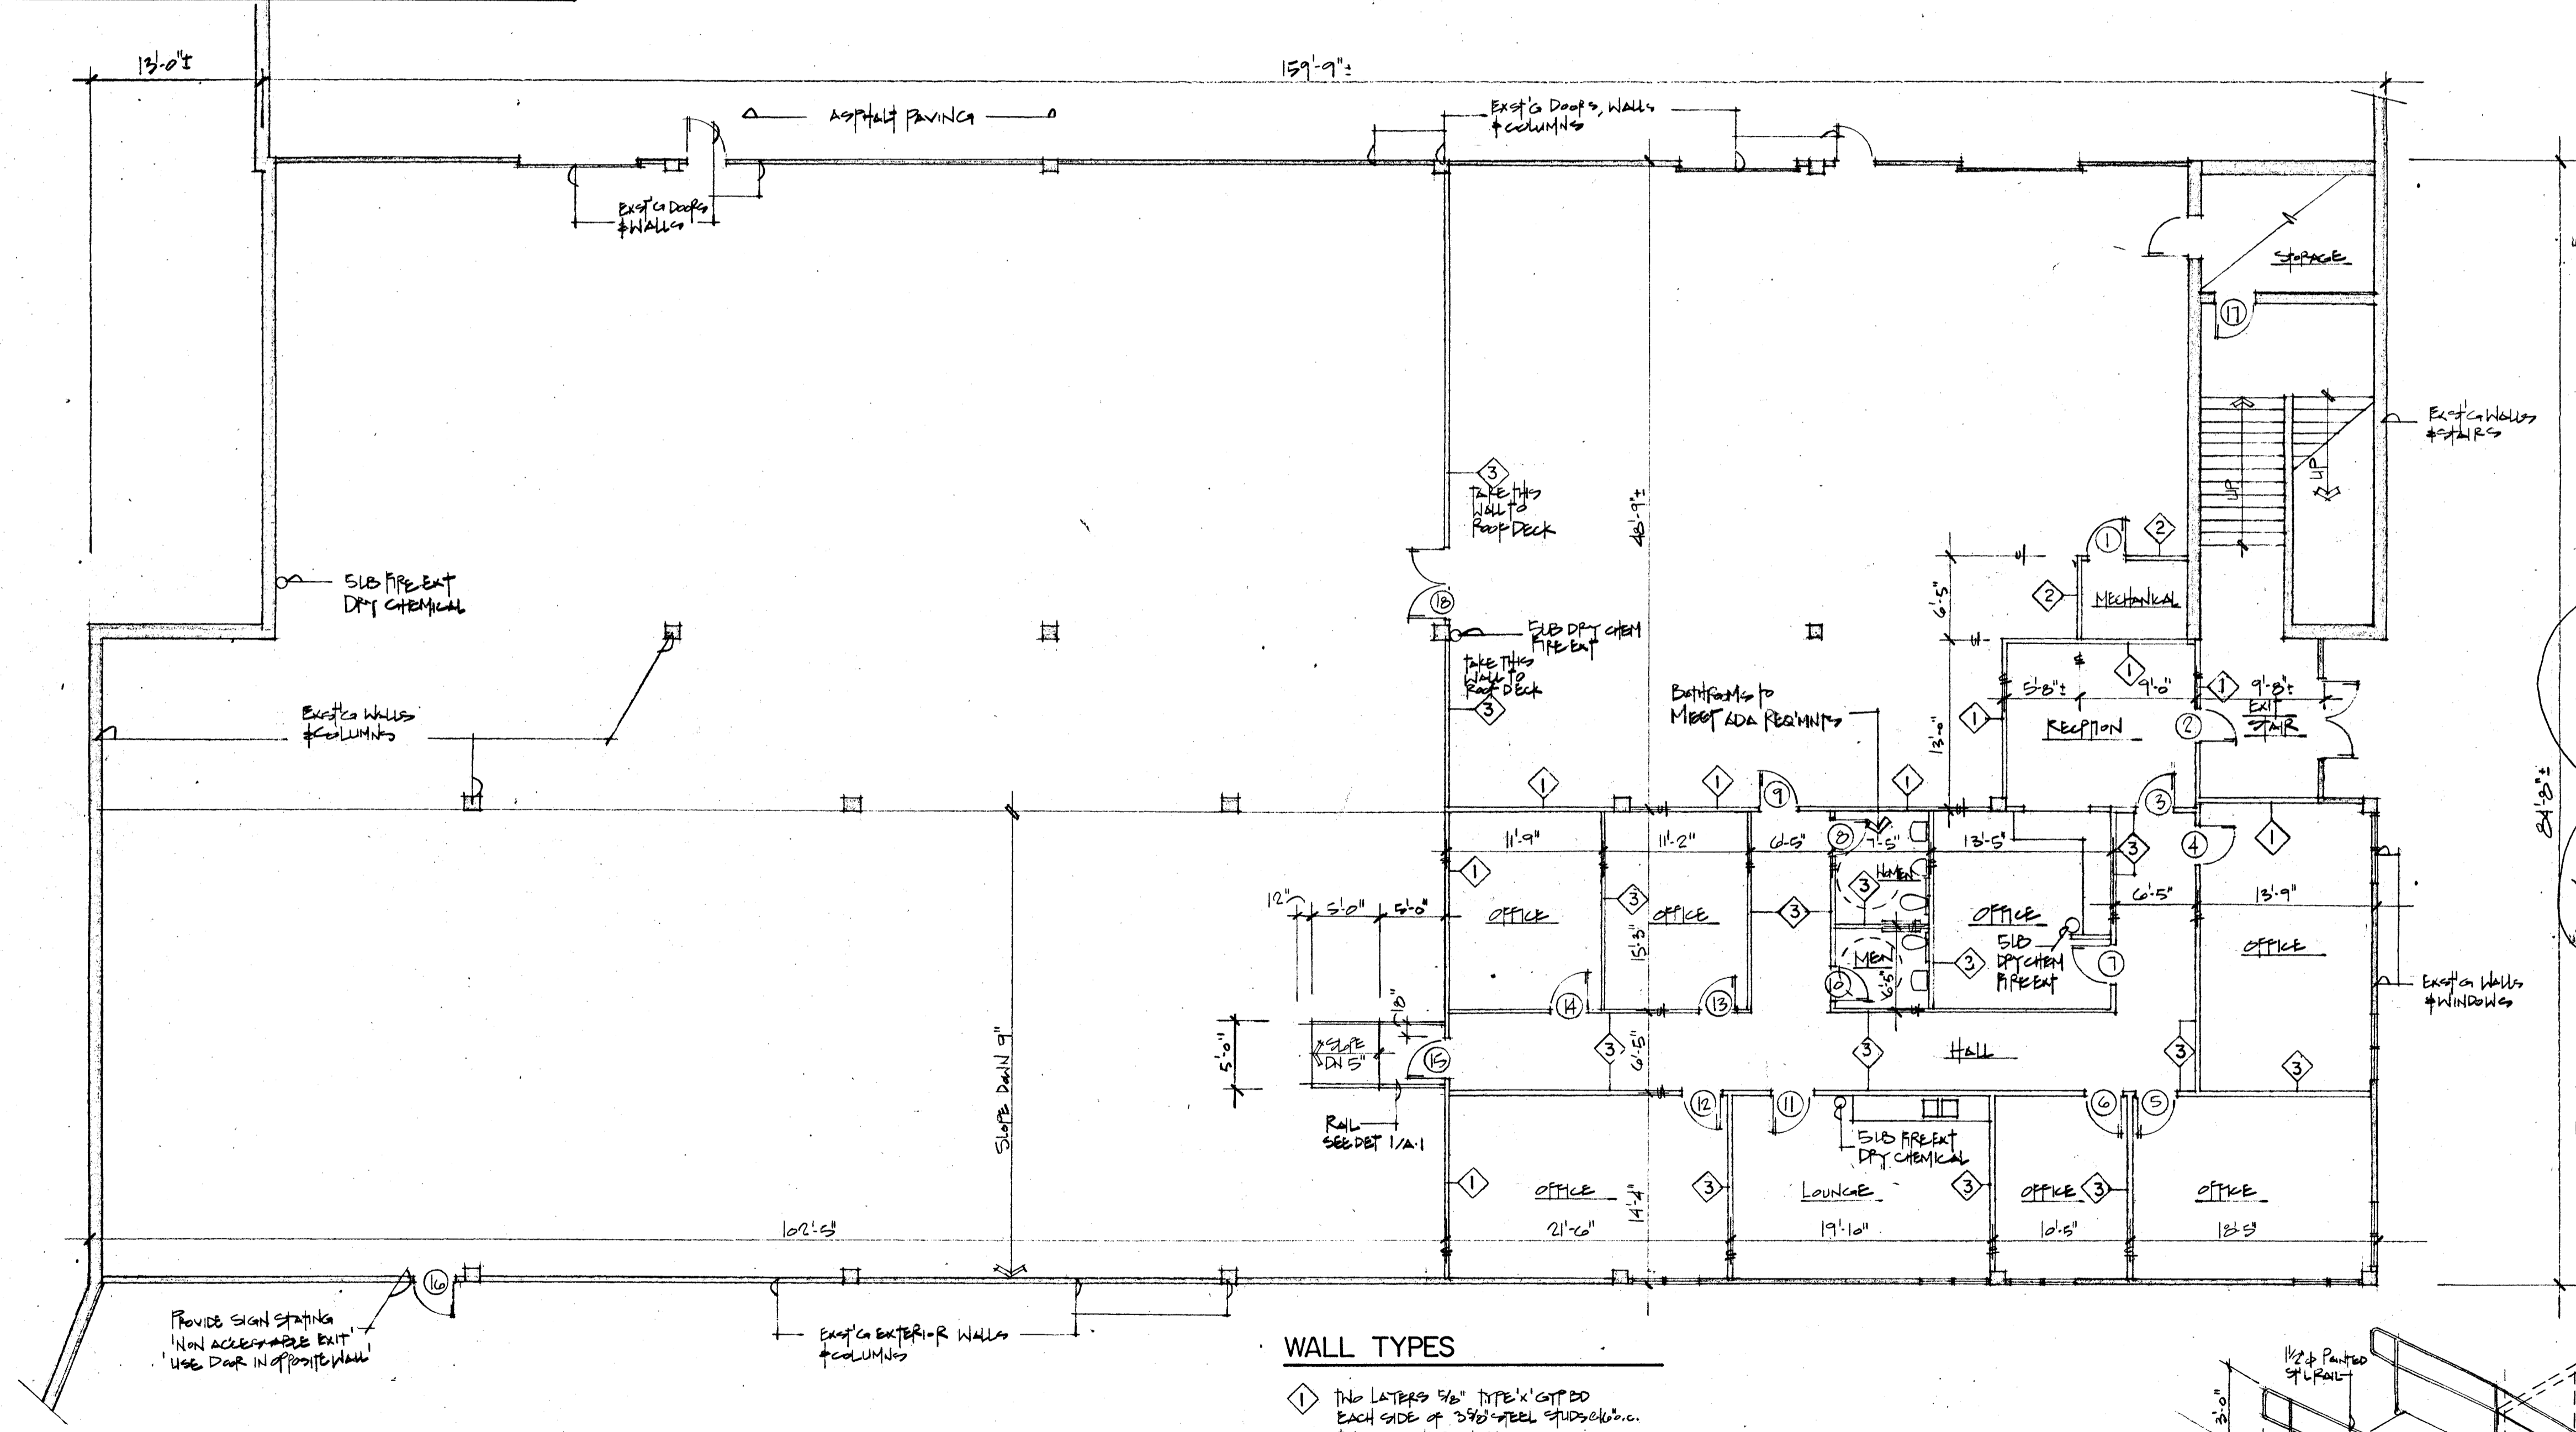

These dwgs revised from original submittal approved 9/5/95


See dwgs submitted for "Shell Permit Only" and approved 7/18/95

BUILDING DEPARTMENT
CITY OF TALLMADGE
APPROVED _____
APPROVED AS NOTED & BY R. Lewis, Plans Exam
DATE 10/20/95

WALL TYPES


- 1 TWO LAYERS 5/8" TYPE 'X' GYP BD EACH SIDE OF 2 3/8" STEEL STUDS @ 16" o.c. TAKE WALL TO DECK ABOVE UL-C U-111 2HR RATING
- 2 ONE LAYER 5/8" TYPE 'X' GYP BD EACH SIDE OF 2 3/8" STEEL STUDS @ 16" o.c. TAKE WALL TO DECK ABOVE FM-1 W-1A 1HR RATING
- 3 ONE LAYER 5/8" GYP BD EACH SIDE OF 2 3/8" STEEL STUDS @ 16" o.c. TAKE WALL TO 9'-4" AFF USE MR GYP BD IN RECEPTION

Provide fire extinguishers per NFPA 10

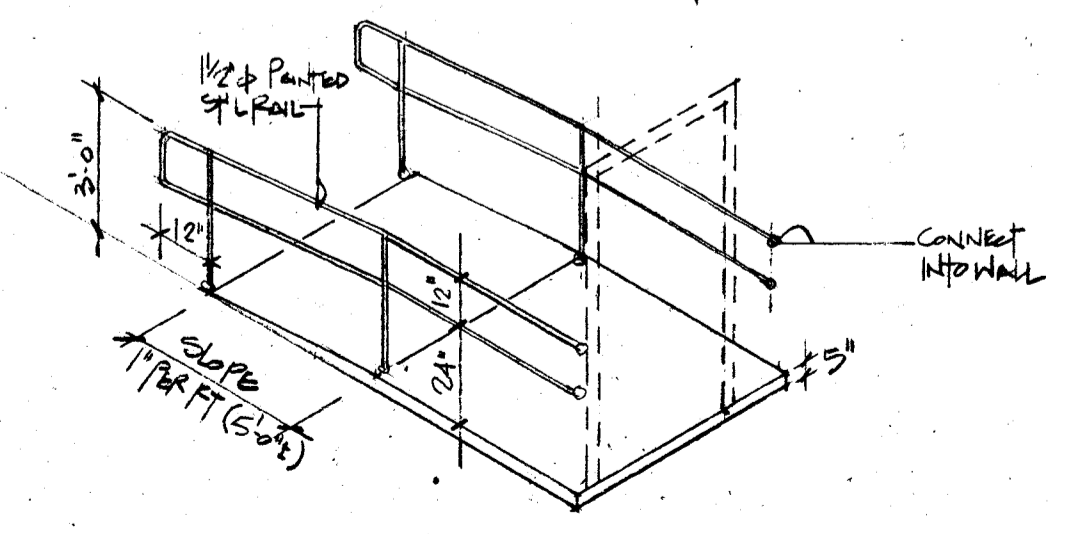


RAMP DETAIL

FLOOR PLAN

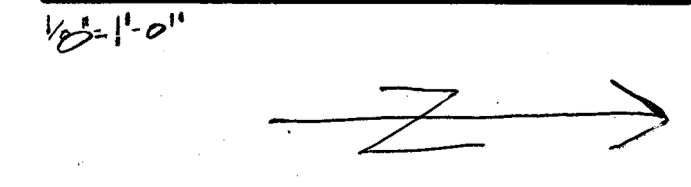

RWL architects inc.
33 MERZ BLVD. FAIRLAWN, OHIO 44333
5320 HOAG DR. # C ELYRIA, OHIO 44035
(216) 867-0679
(216) 322-7616

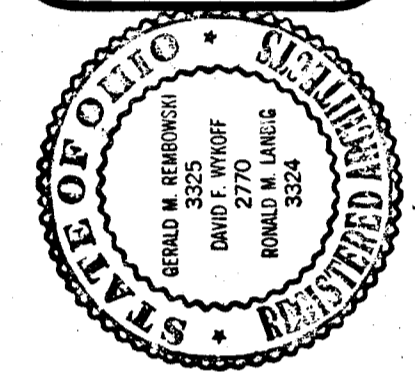


PROJECT: INTERIOR REMODELING TO WEAVER CAPITAL LOWER FLOOR 'C' WING BY EAST HOWE RD TALLMADGE, OHIO


NO.	DATE	REVISIONS
1	oct 17, 1995	
2	9/5/95	

DRWG: A-1

RECEIVED
OCT 18 1995
BUILDING/ZONING DEPT.
CITY OF TALLMADGE

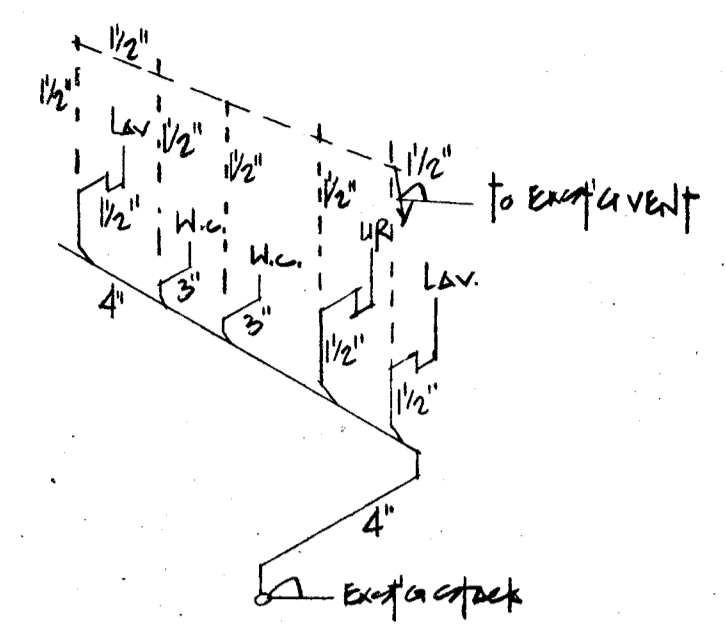

PLUMBING ISOMETRIC
N.P.S.

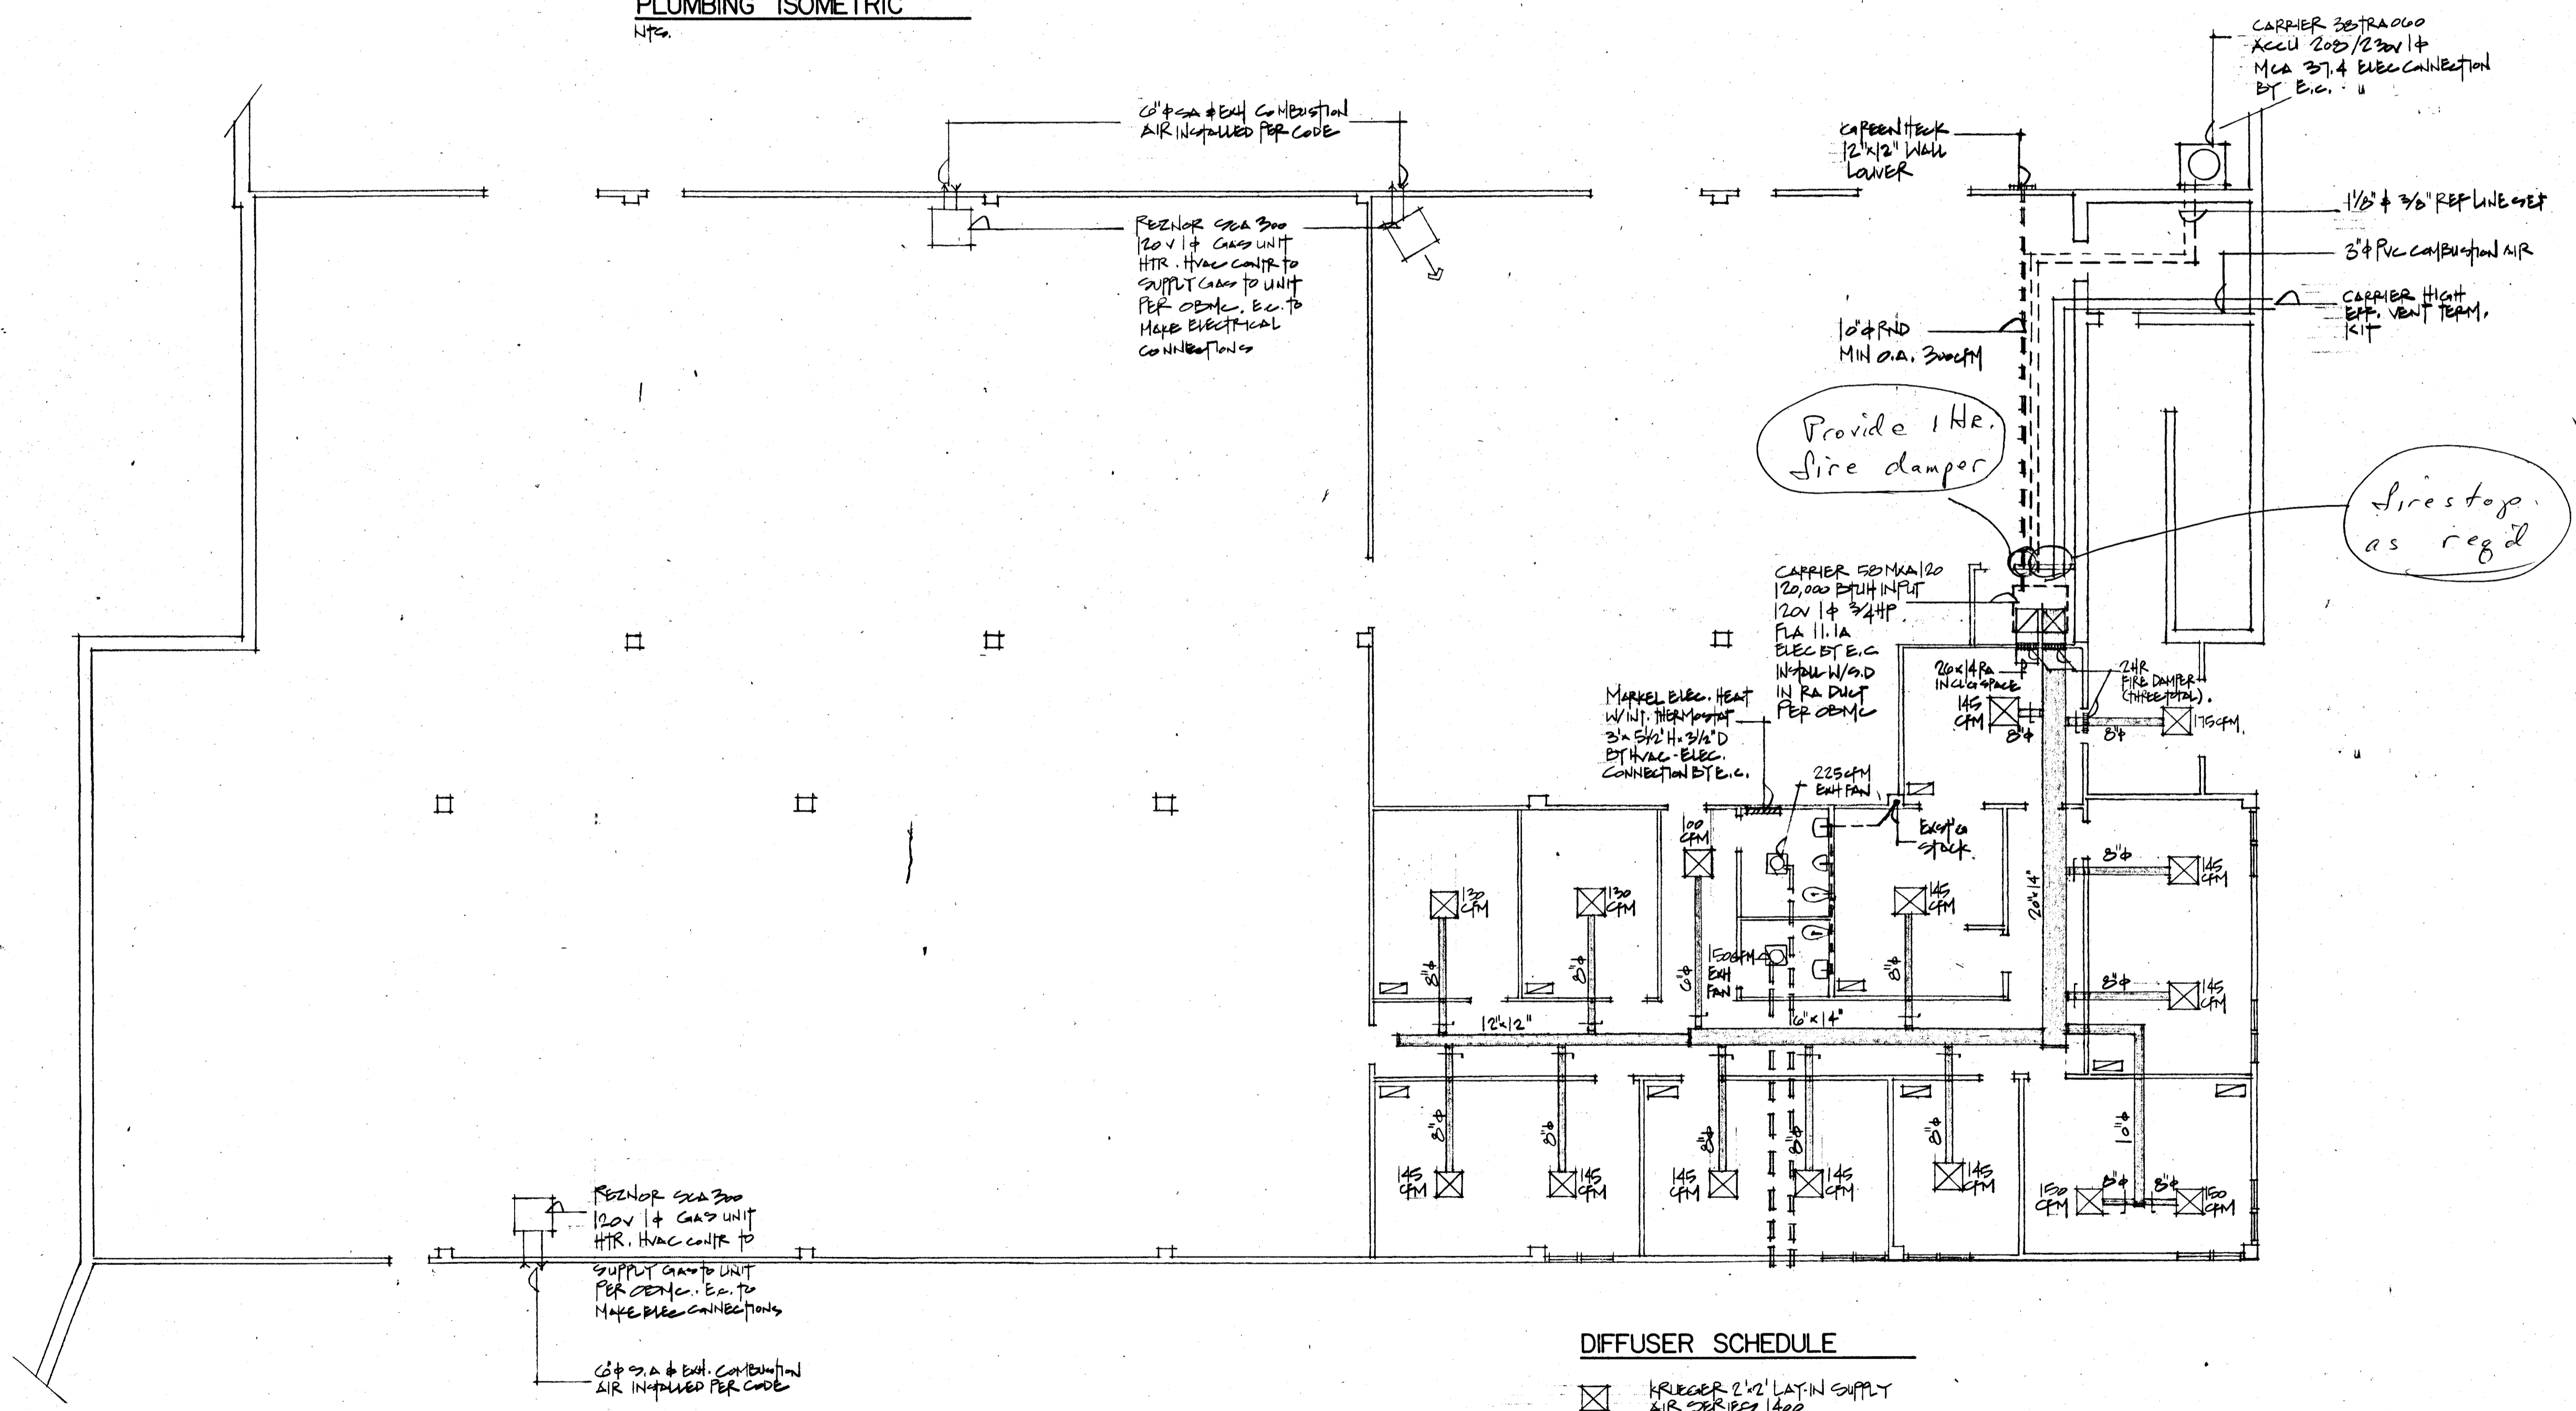


DIFFUSER SCHEDULE

- ☒ FRUIGER 2'x2' LATH SUPPLY AIR CAPACITY 1400
- ☒ 2'x1' RETURN AIR ECOSAFATE


MECHANICAL PLAN
1/8"=1'-0"

RWL architects inc.
33 MERZ BLVD. FAIRLAWN, OHIO 44333
5320 HOAG DR. # C ELYRIA, OHIO 44035
(216) 867-0679
(216) 322-7616

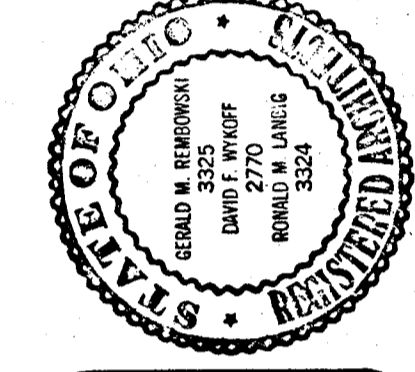

PROJECT:
INTERIOR REMODELING TO WEAVER SCHOOL
LOWER FLOOR 'C' WING
89 EAST HANE RD, TALLMADGE OHIO





DRWG.	JOB	DATE	REVISIONS
M-1	9516	09/17, 1995	

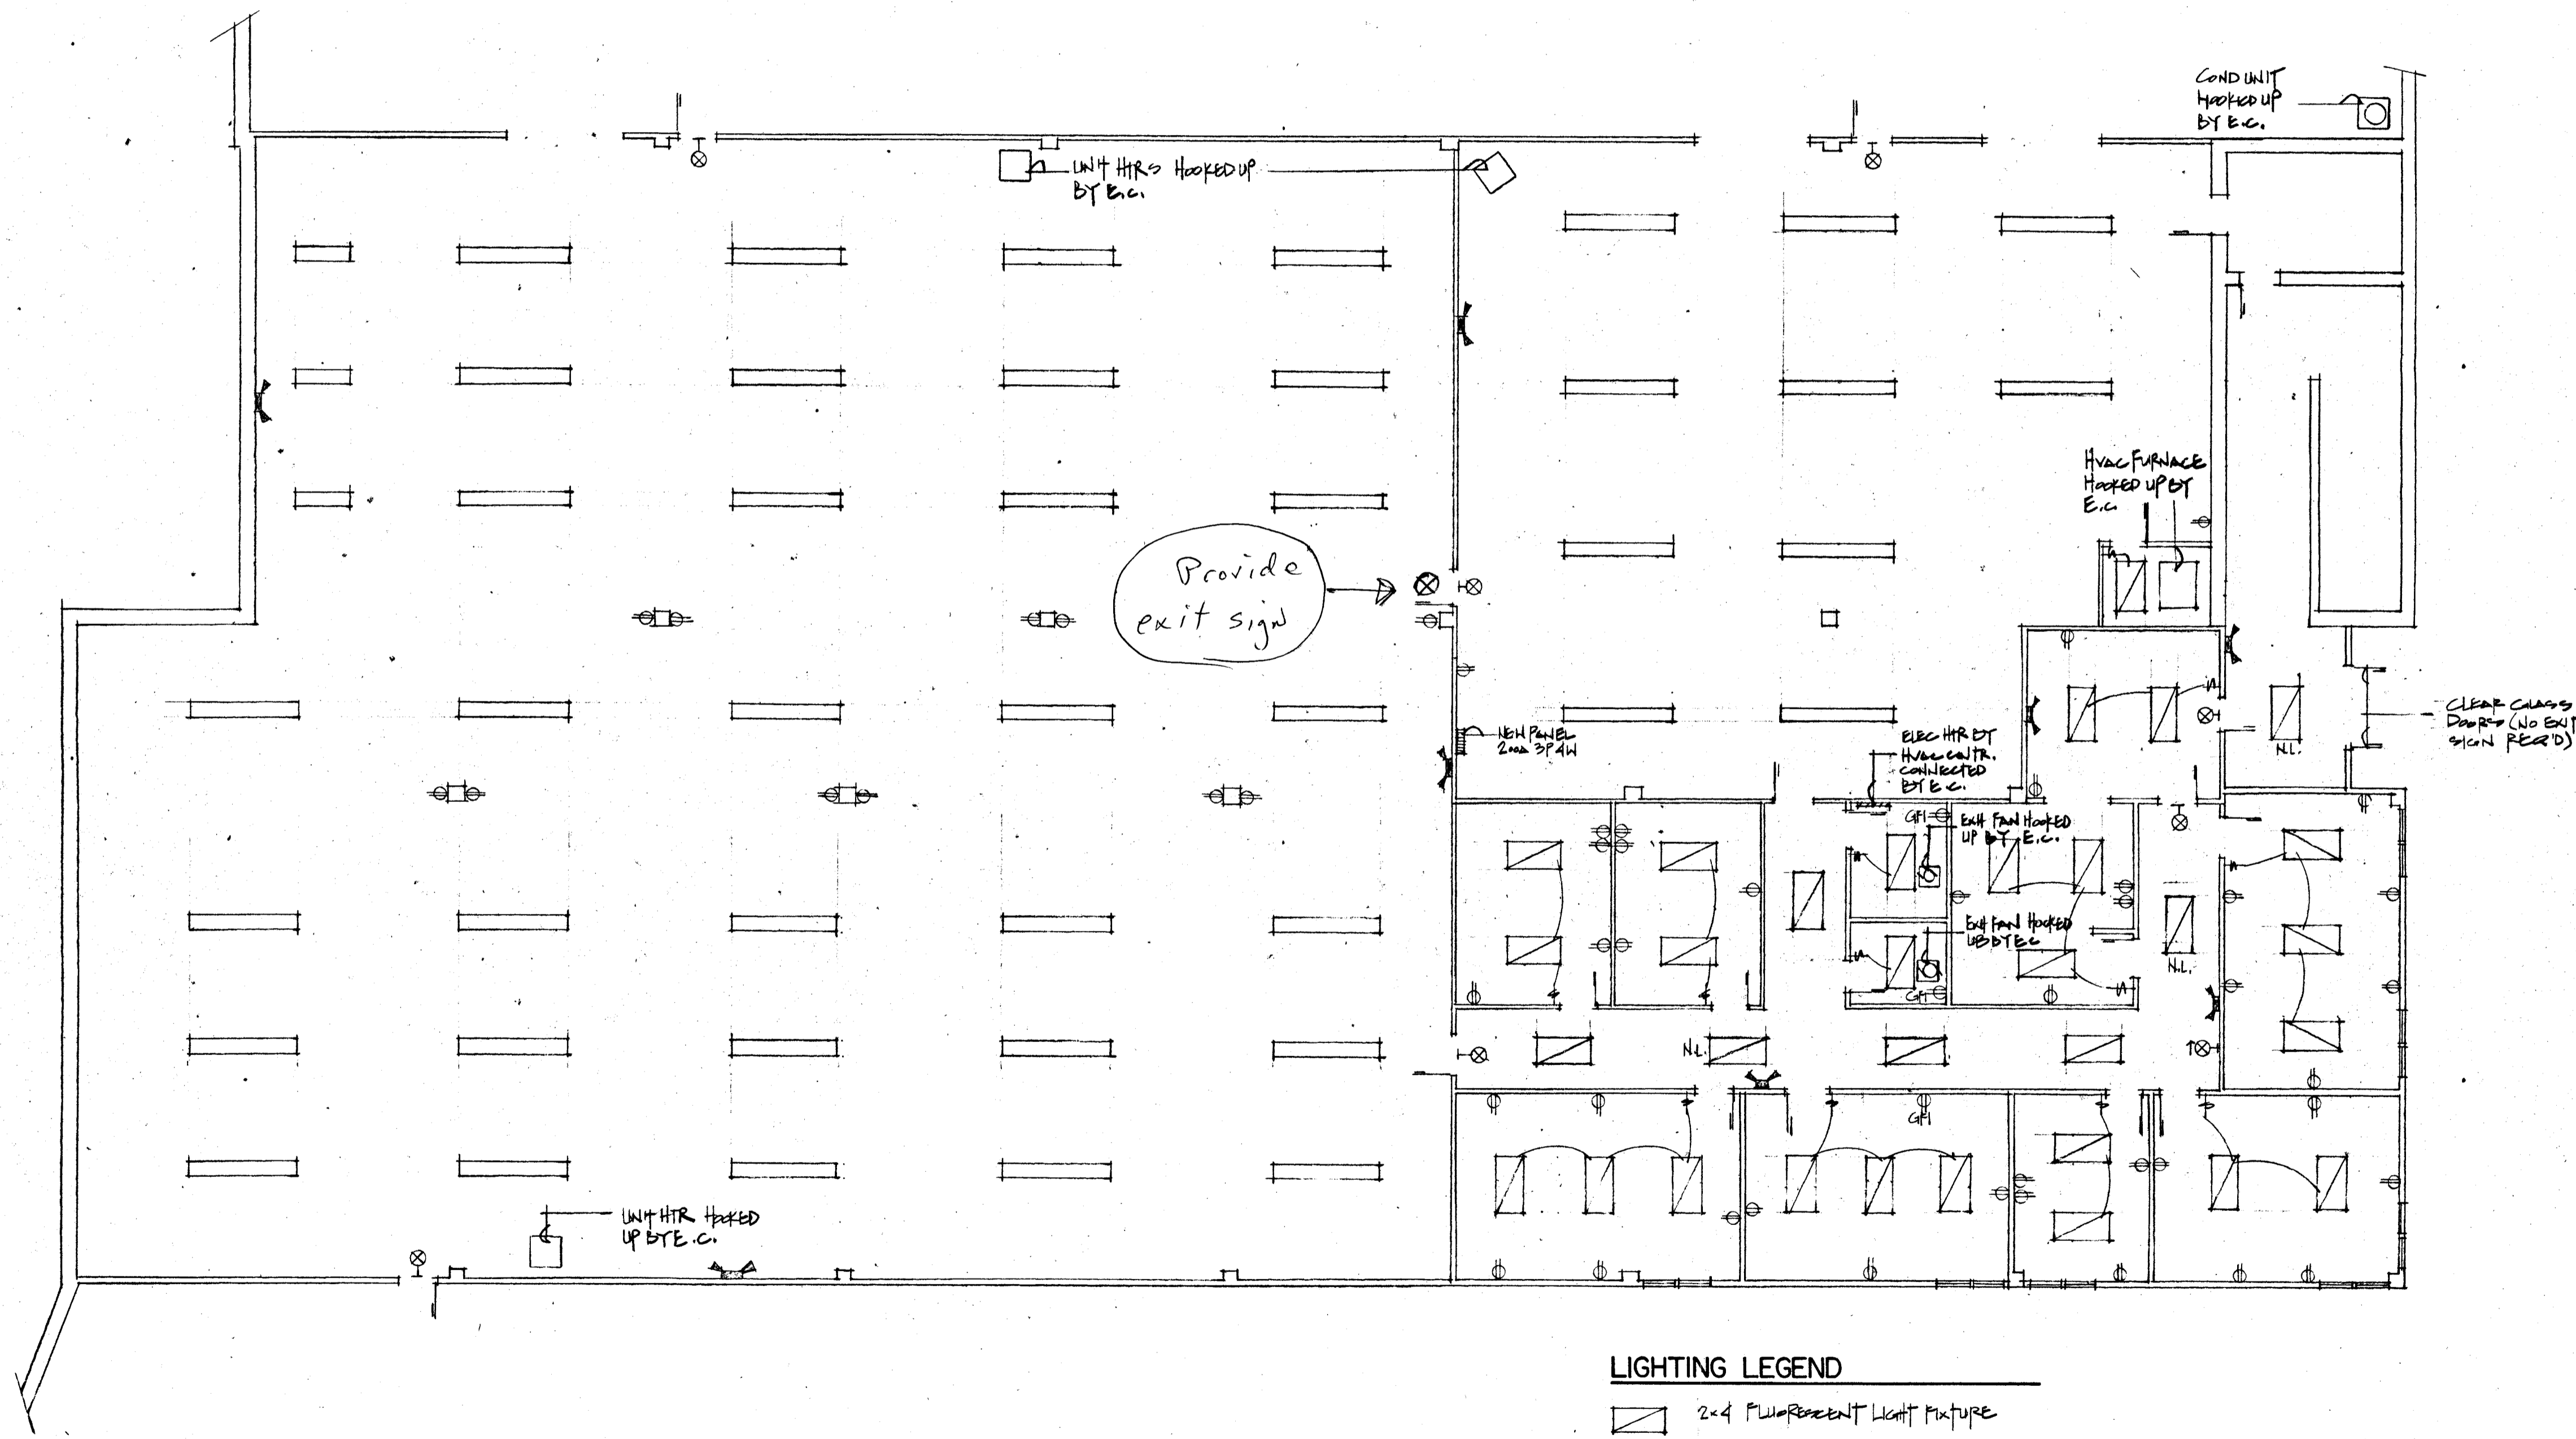


ELECTRICAL PLAN

1/8"=1'-0"


LIGHTING LEGEND

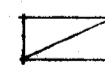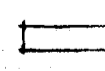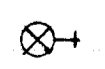-  2x4 FLUORESCENT LIGHT FIXTURE
-  1x3 FLUORESCENT LIGHT FIXTURE
-  WALL MOUNTED EXIT SIGN - ARROW AS INDICATED - PROVIDE BATTERY BACKUP
-  WALL MOUNTED EMERGENCY LIGHTS W/ BATTERY BACKUP

RWL architects inc.
 33 MERZ BLVD. FAIRLAWN, OHIO 44333 (216) 867-0679
 5320 HOAG DR. * C ELYRIA, OHIO 44035 (216) 322-7616

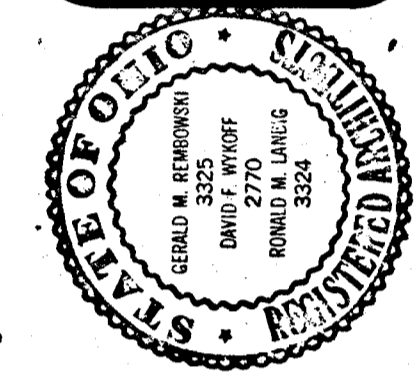

PROJECT: INTERIOR REMODELING AT WEAVER SCHOOL
 LOWER FLOOR C'WING
 89 EAST HOWE RD. TALLMADGE OHIO

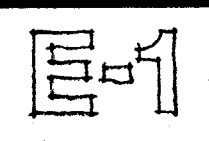DRWG.	JOB	DATE	REVISIONS
	9516	02 17, 1996	