



REMOVE EXISTING FIRE HYDRANT 05-B02-1008 AS INSTALLED PER THE BOWENS CORNER ELEMENTARY SCHOOL PROJECT, JOB # 2016-200065 EXT. # 1687-754. INSTALL 6"X6" TEE AND 6" GATE VALVE. RECONNECT THE FIRE HYDRANT WITH A 6" CONTROL VALVE ON THE BRANCH SIDE OF THE NEW TEE.

NOTE: CONTRACTOR TO VERIFY, CONTACT ENGINEER IF ANY DISCREPANCIES

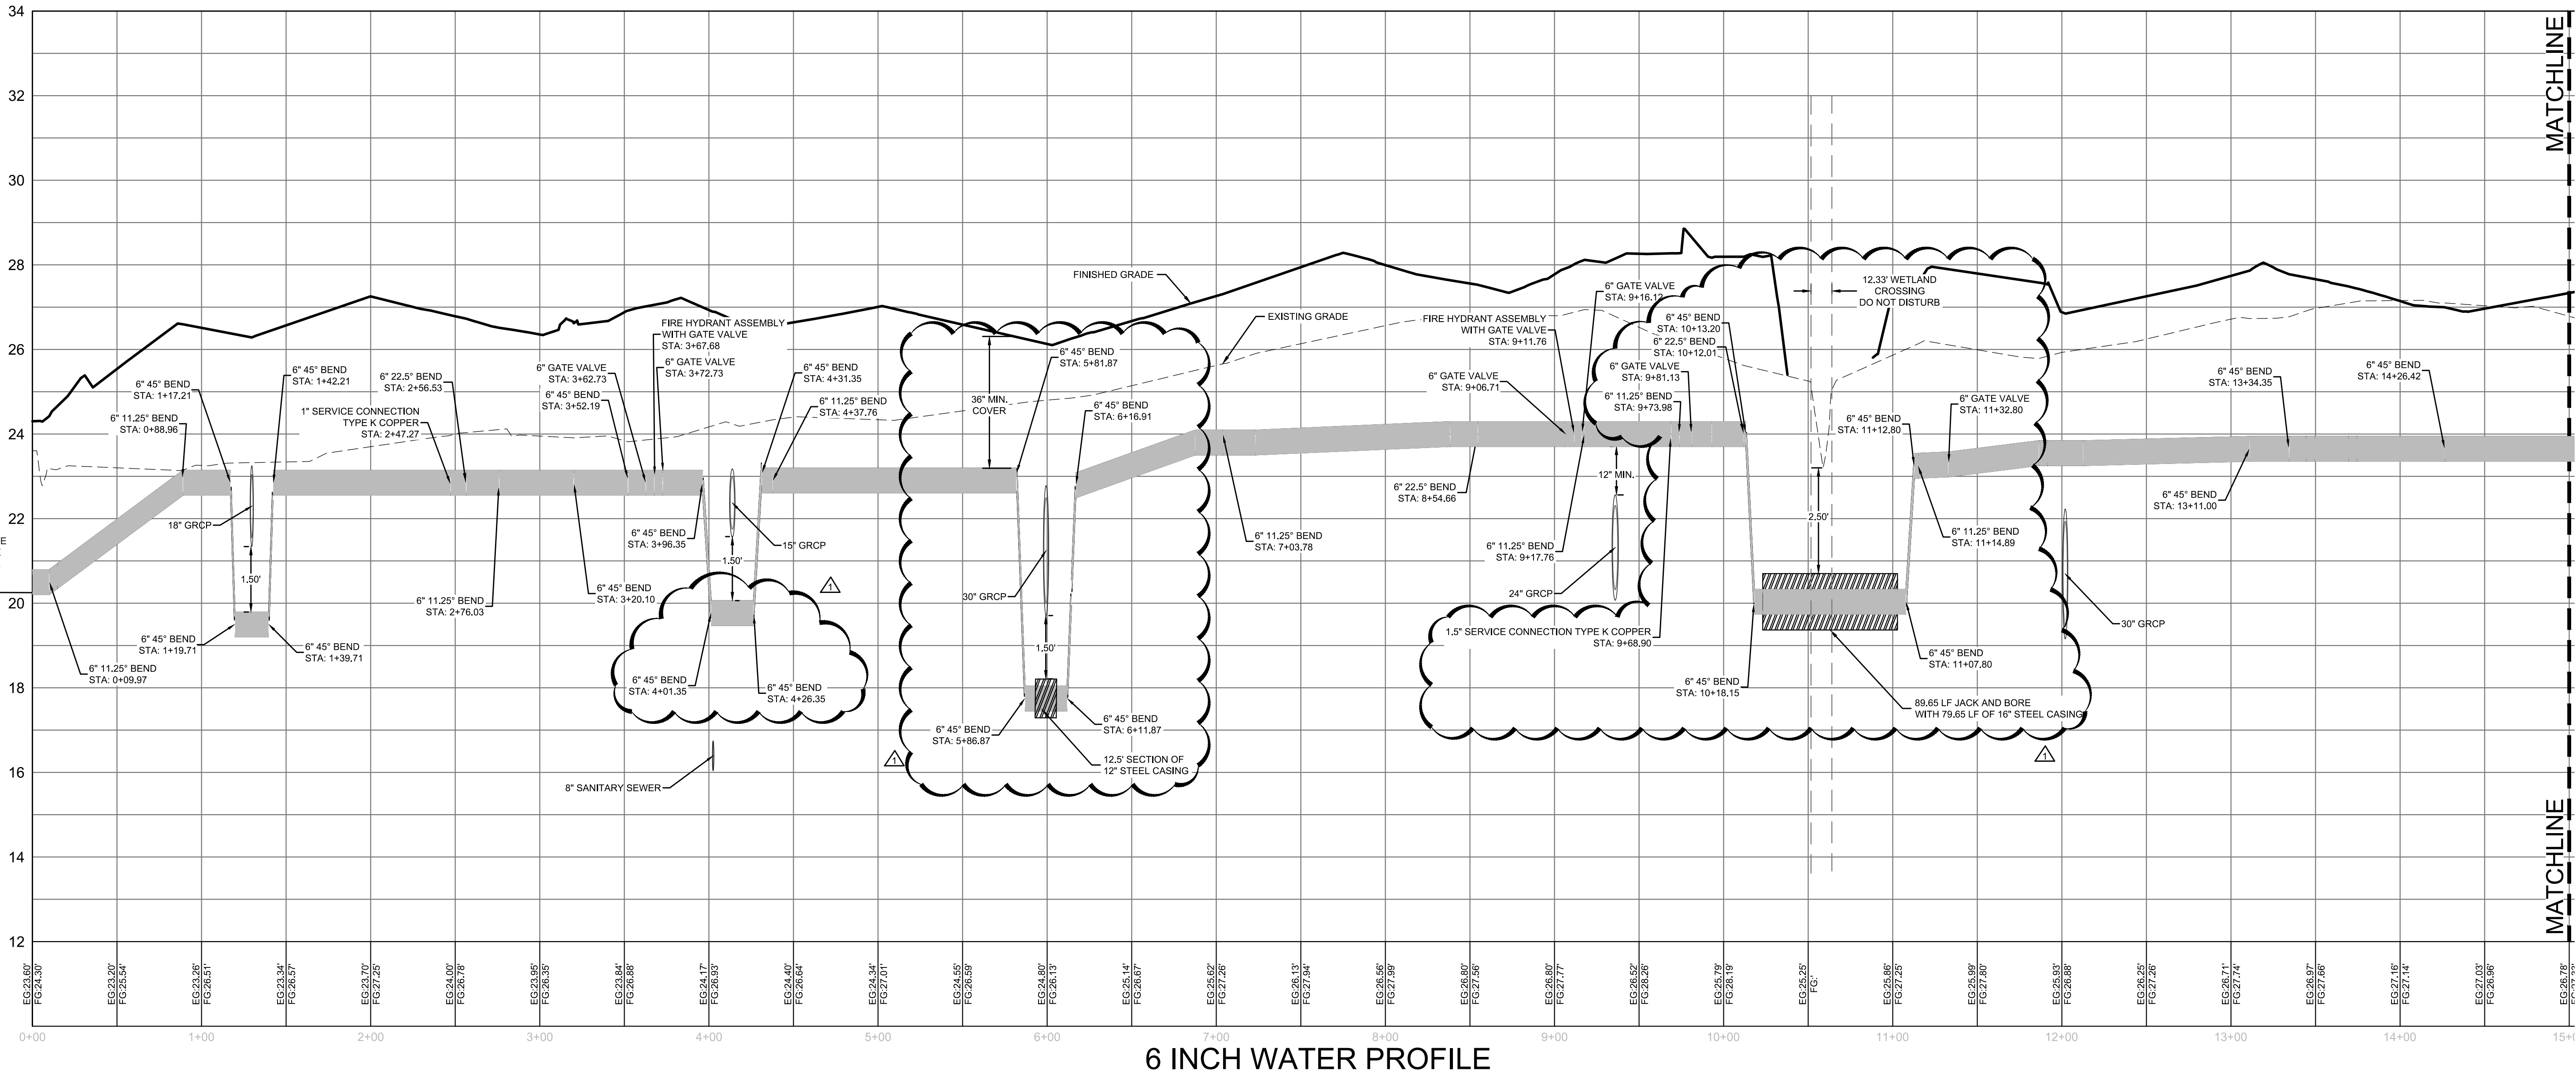


NOTE:
ALL 6" AND 8" WATER MAIN SHALL BE D.I.P

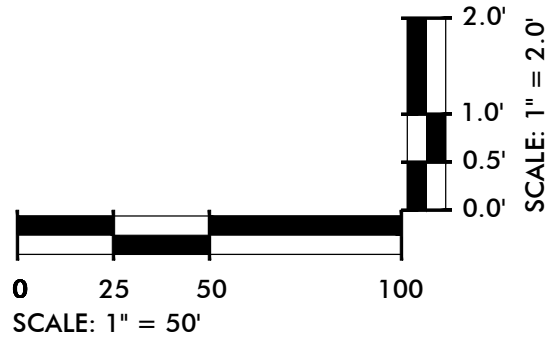

Know what's below.
Call before you dig.



MOUNT PLEASANT, SC 843.884.1667
GREENVILLE, SC 864.298.0534
SUMMERVILLE, SC 843.972.0710
SPARTANBURG, SC 864.298.0534
CHARLOTTE, NC 980.312.5450
WWW.SEAMONWHITESIDE.COM

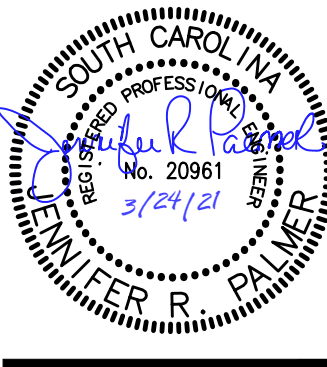

HANAHAN RECREATION
COMPLEX
CITY OF HANAHAN
HANAHAN, SOUTH CAROLINA

SW+ PROJECT: 7867
DATE: 06/12/20
DRAWN BY: BET
CHECKED BY: JRP

REVISION HISTORY	
A	6/12/20
B	10/29/20
C	01/22/21
D	03/11/21
E	03/26/21

WATER
PROFILES