


LEGEND	
	NEW PATHWAYS
	EXIST. PATHWAYS

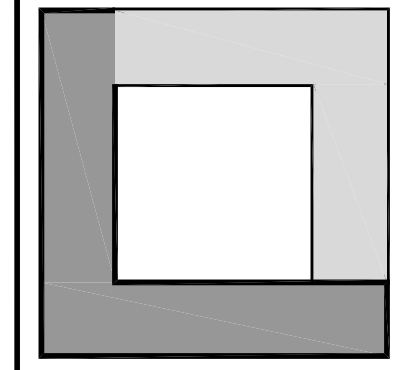


LONGITUDE SURVEYORS

7769 NW 48th STREET
 SUITE 375
 DORAL, FLORIDA
 33166
 PH: (305) 463-0912
 FAX: (305) 513-5680
 FLORIDA CERTIFICATE
 OF AUTHORIZATION
 LB 7335

WWW.LONGITUDESURVEYORS.COM

By:	Date:	No.:	RECORD OF REVISION Description




Project Name: CORAL REEF PARK
 7895 SW 152nd ST.
 PALMETTO BAY, FLORIDA 33157
GENERAL SITE PLAN

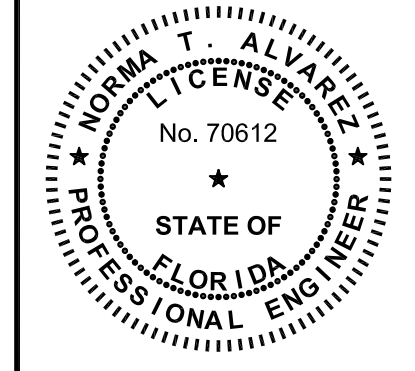


THIS ITEM HAS BEEN DIGITALLY SIGNED AND
 SEALED BY NORMA T. ALVAREZ, P.E.
 ON THE DATE ADJACENT TO THE SEAL.
 PRINTING COPIES OF THIS DOCUMENT ARE
 NOT CONSIDERED SIGNED AND SEALED AND
 THE SIGNATURE MUST BE VERIFIED ON ANY
 ELECTRONIC COPIES.

APPROVED BY:
 NORMA T. ALVAREZ, P.E.
 FLORIDA REG. NO. 70612
 CIVIL ENGINEER

Scale:	AS SHOWN
Drawn By:	J.G.
Checked By:	N.T.A.
Managed By:	N.T.A.
Drawing Date:	AUG. 2, 2021
Project No.:	13100.0.09
SITE P-1 PATHWAYS	

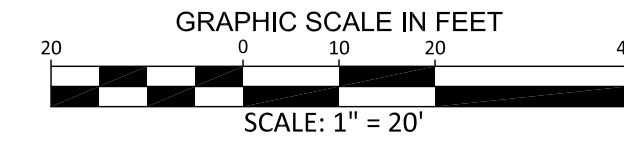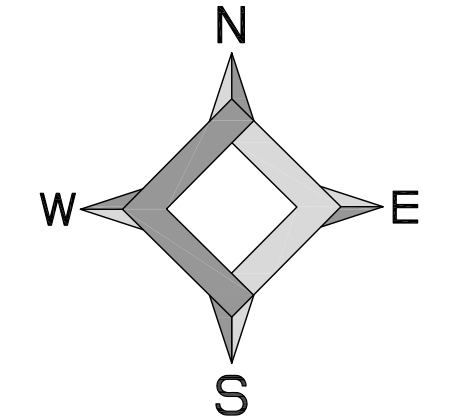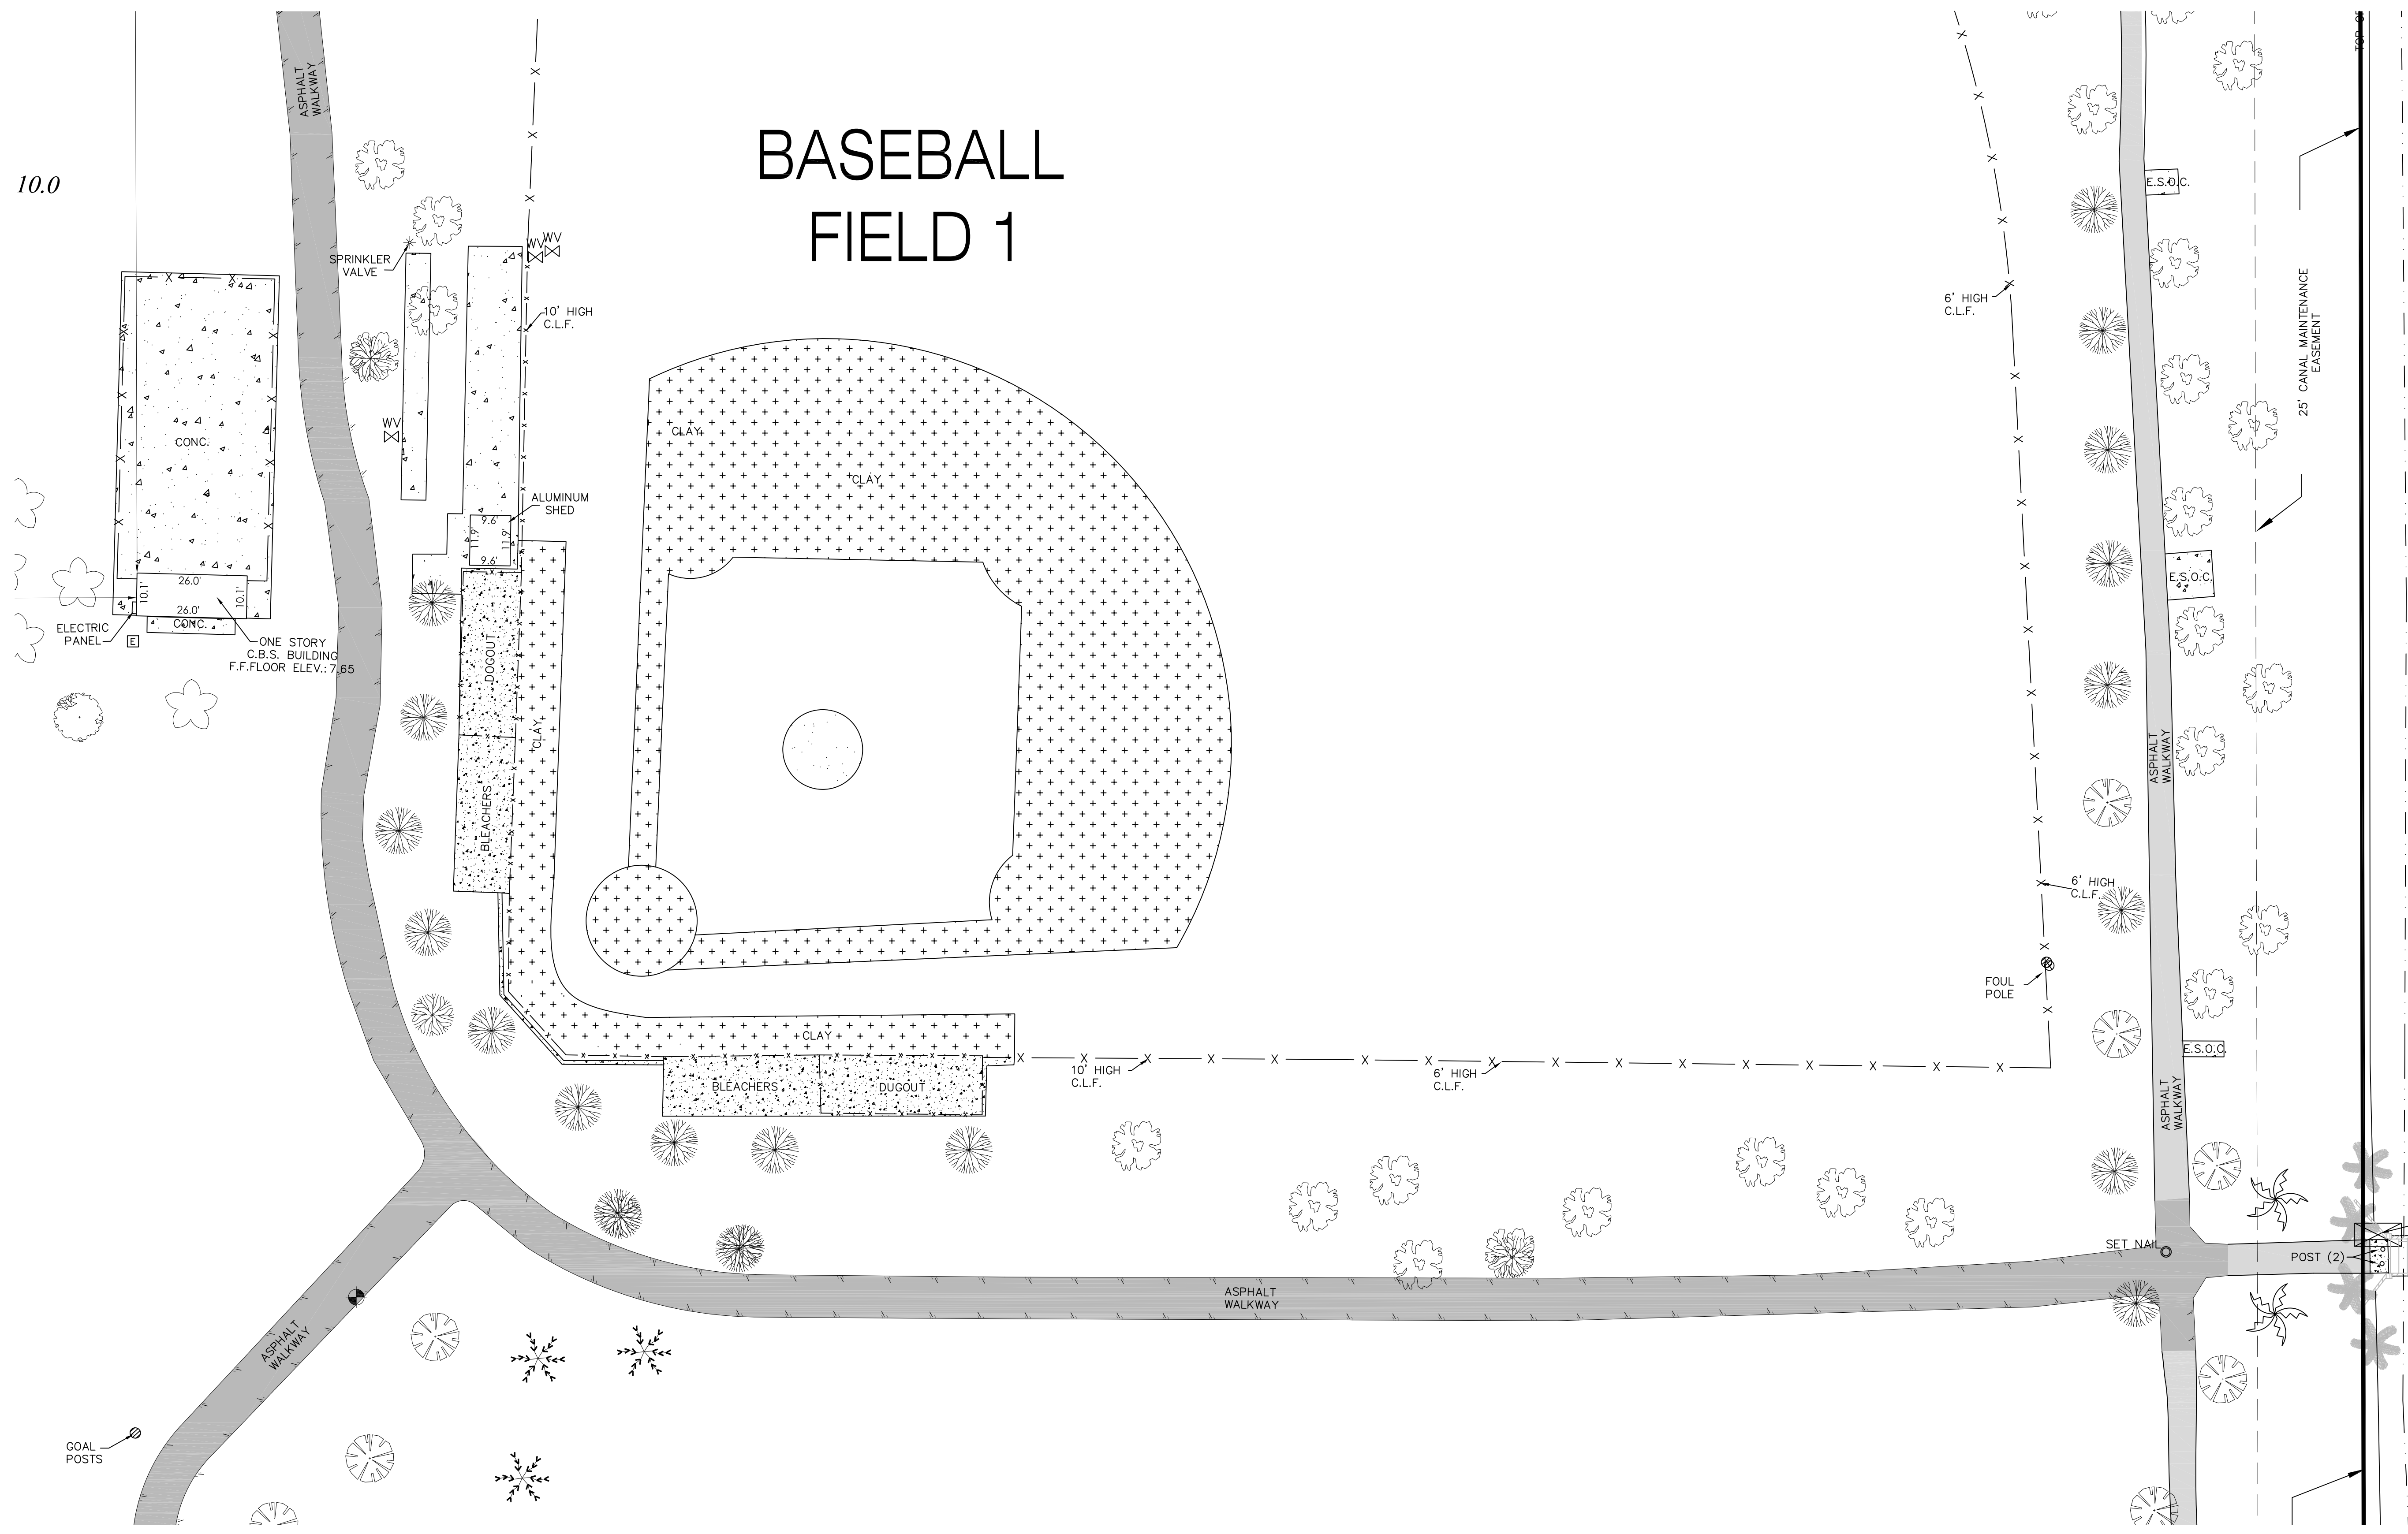

LEGEND	
	NEW PATHWAYS
	EXIST. PATHWAYS

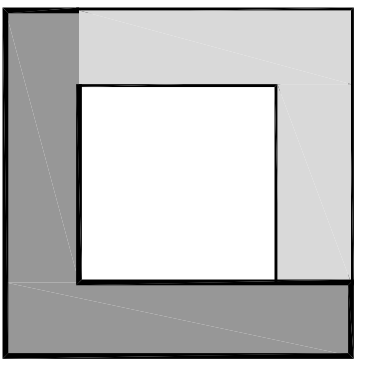

LONGITUDE SURVEYORS


7769 NW 48th STREET
SUITE 375
DORAL, FLORIDA
33166
PH: (305) 463-0912
FAX: (305) 513-5680
FLORIDA CERTIFICATE
OF AUTHORIZATION
LB 7335

WWW.LONGITUDESURVEYORS.COM

By:	Date:	No.:	RECORD OF REVISION
			Description

Project Name: **CORAL REEF PARK**
7895 SW 152nd ST.
PALMETTO BAY, FLORIDA 33157

BASEBALL FIELD 1

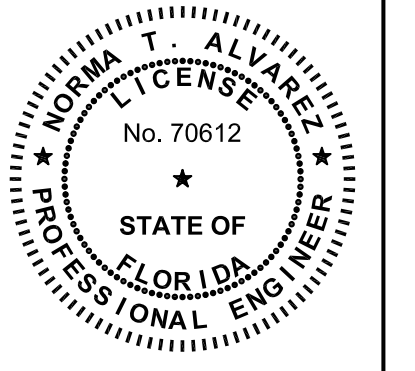

THIS ITEM HAS BEEN DIGITALLY SIGNED AND SEALED BY NORMA T. ALVAREZ, P.E. ON THE DATE ADJACENT TO THE SEAL.




PRINTING COPIES OF THIS DOCUMENT ARE NOT CONSIDERED SIGNED AND SEALED AND THE SIGNATURE MUST BE VERIFIED ON ANY ELECTRONIC COPIES.

APPROVED BY:
NORMA T. ALVAREZ, P.E.
FLORIDA REG. NO. 70612
CIVIL ENGINEER


Scale:	AS SHOWN
Drawn By:	J.G.
Checked By:	N.T.A.
Managed By:	N.T.A.
Drawing Date:	AUG 02, 2021
Project No.:	13100.0.09
SITE P-2 BASEBALL FIELD 1	

BASEBALL FIELD 2

PAVILION

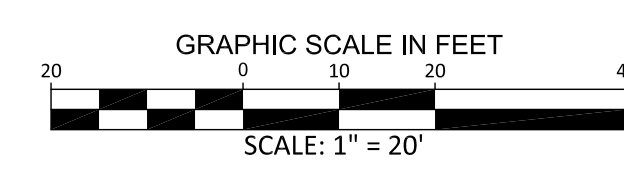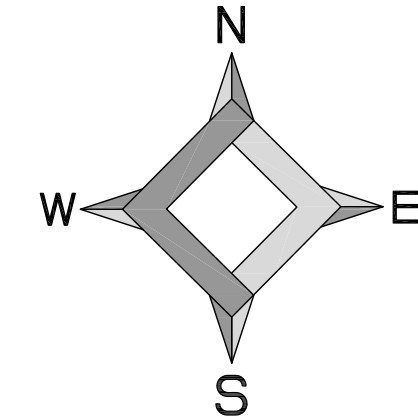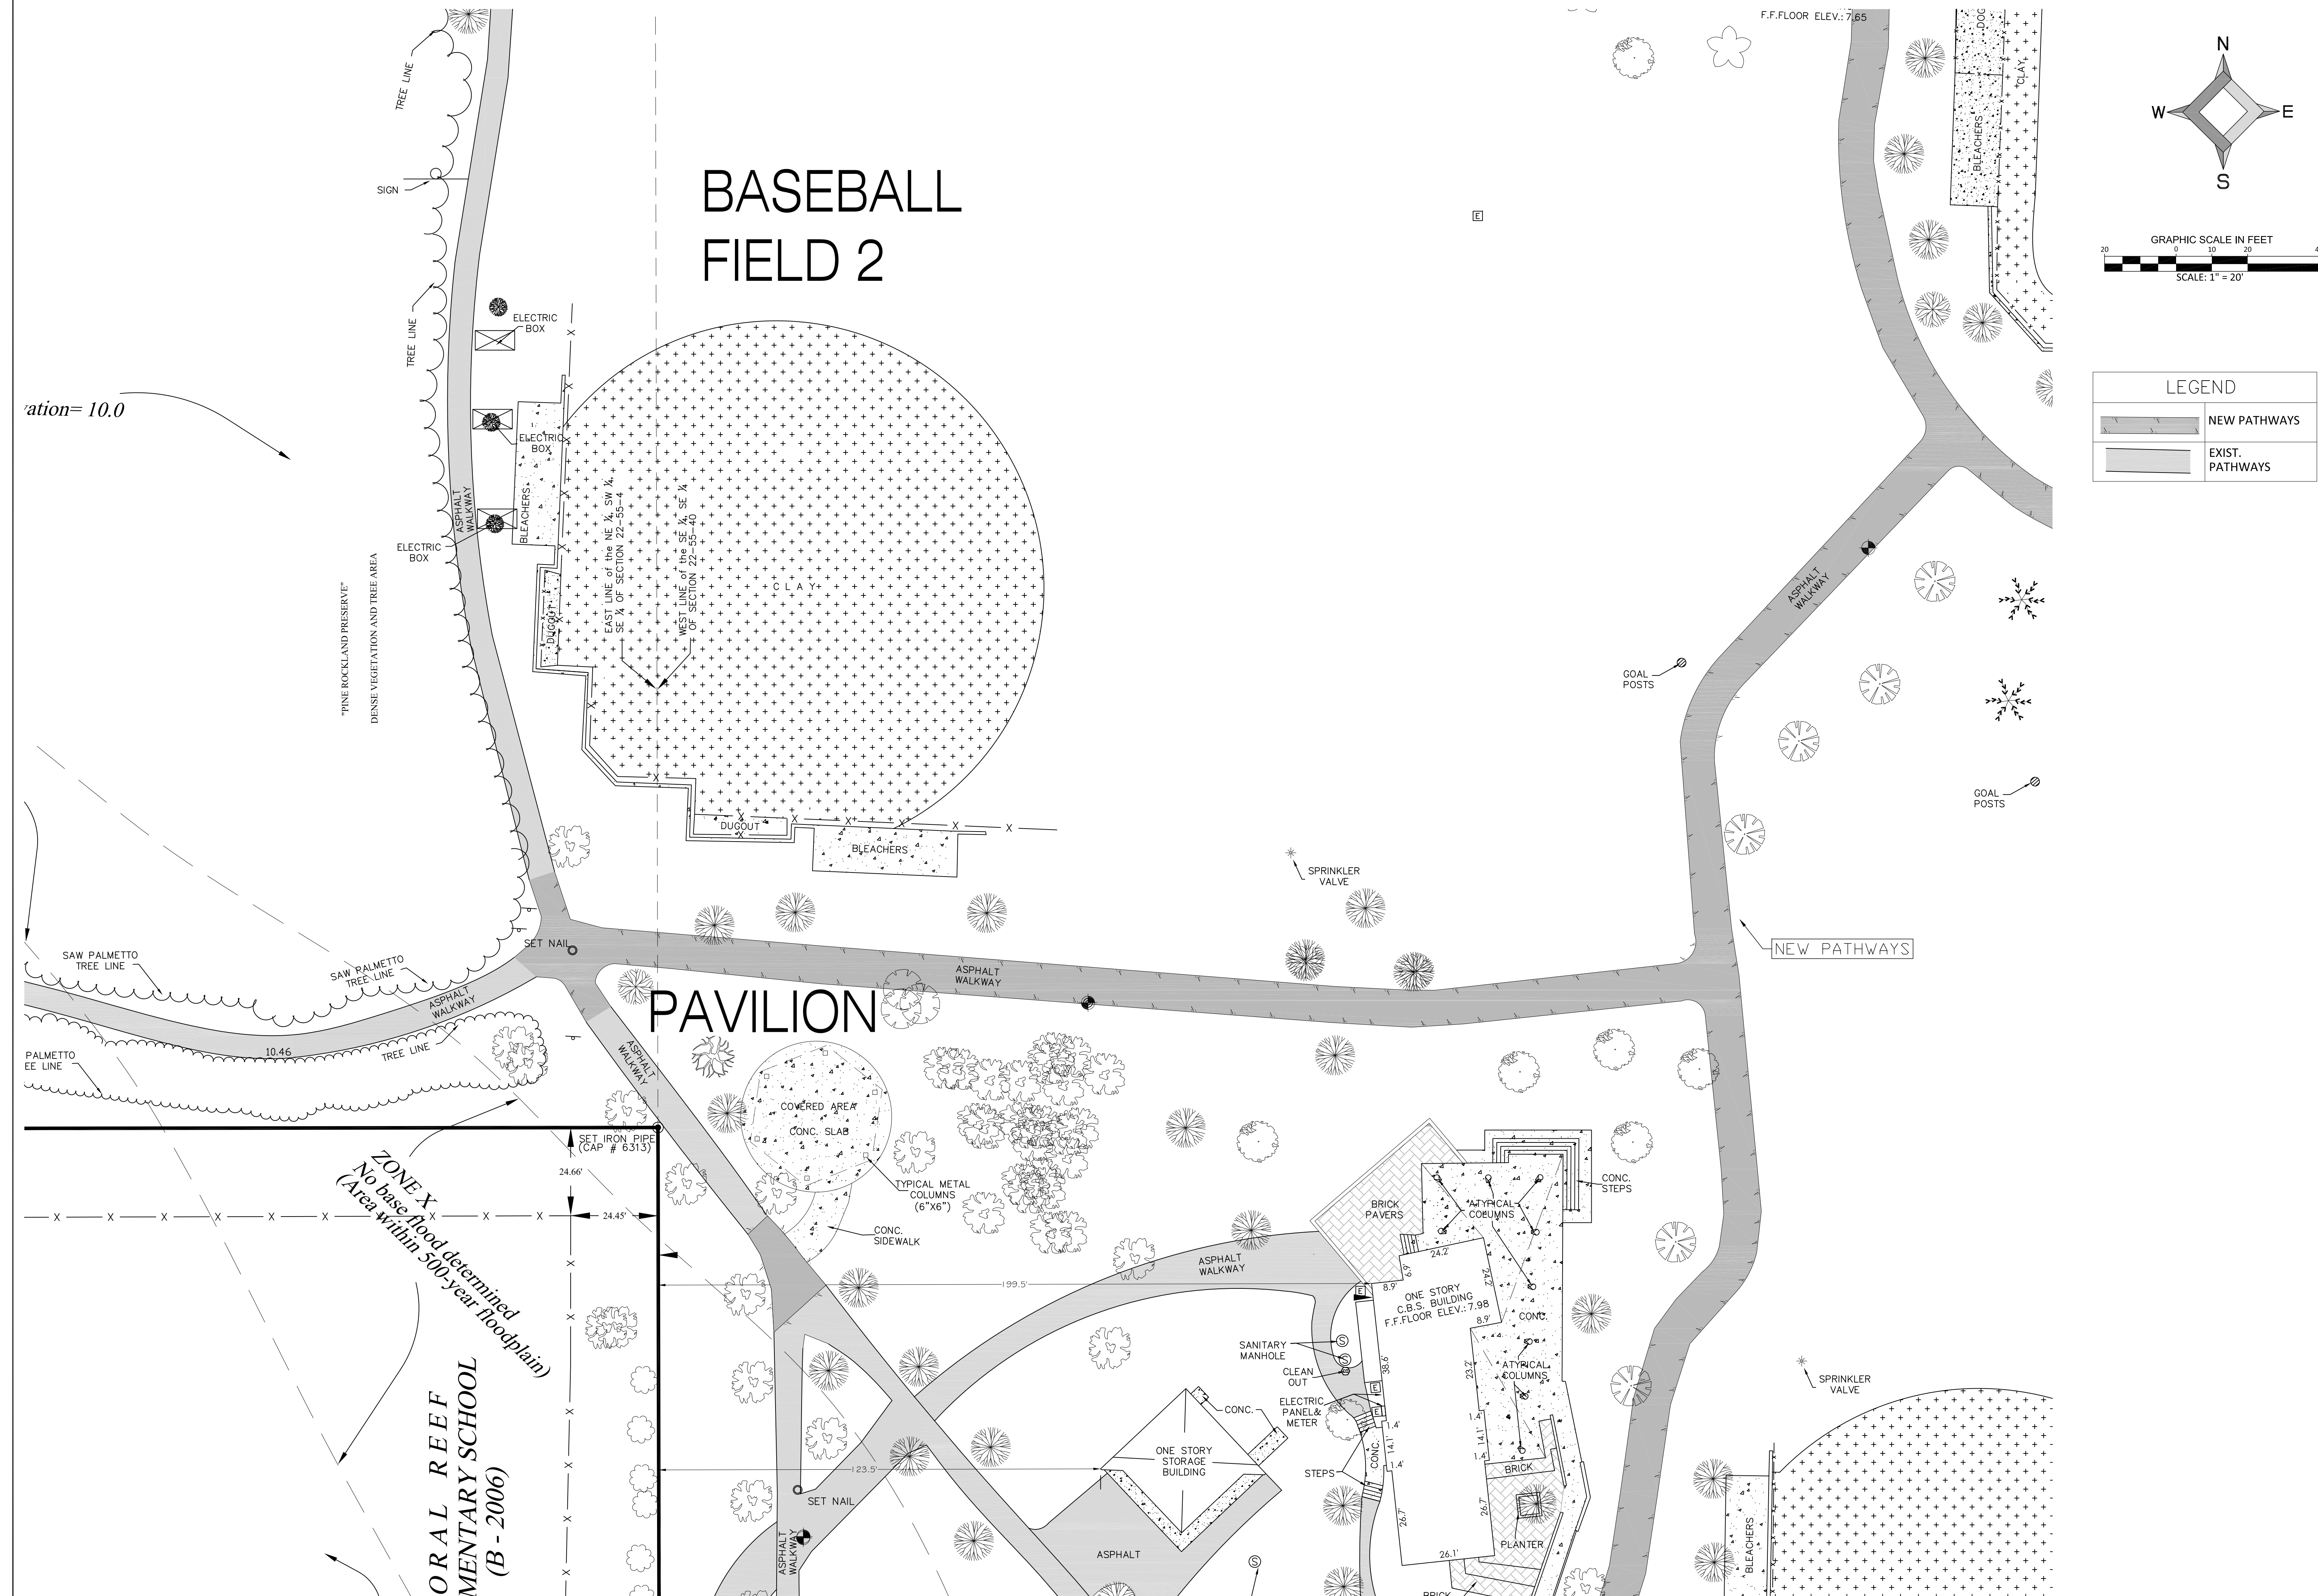

LEGEND	
	NEW PATHWAYS
	EXIST. PATHWAYS

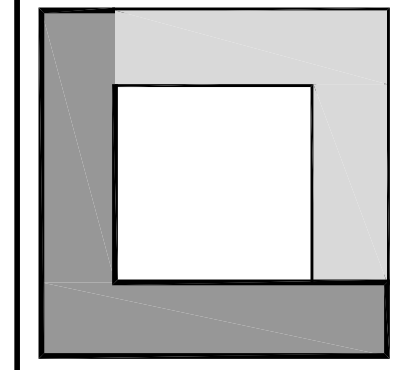


LONGITUDE SURVEYORS

7769 NW 48th STREET
SUITE 375
DORAL, FLORIDA
33166
PH: (305) 463-0912
FAX: (305) 513-5680
FLORIDA CERTIFICATE
OF AUTHORIZATION
LB 7335

WWW.LONGITUDESURVEYORS.COM

By:	Date:	No.:	RECORD OF REVISION
			Description

Project Name:
CORAL REEF PARK
7895 SW 152nd ST.
PALMETTO BAY, FLORIDA 33157
BASEBALL FIELD 2 AND PAVILION

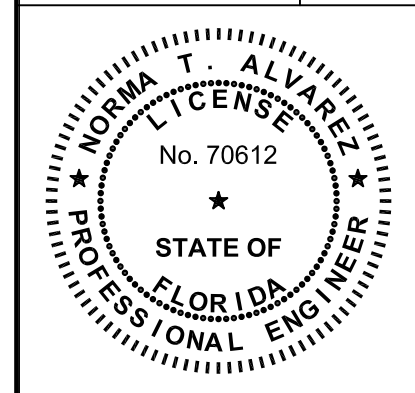

THIS ITEM HAS BEEN DIGITALLY SIGNED AND SEALED BY NORMA T. ALVAREZ, P.E. ON THE DATE ADJACENT TO THE SEAL.
PRINTING COPIES OF THIS DOCUMENT ARE NOT CONSIDERED SIGNED AND SEALED AND THE SIGNATURE MUST BE VERIFIED ON ANY ELECTRONIC COPIES.


AUGUST 03, 2021
APPROVED BY:
NORMA T. ALVAREZ, P.E.
FLORIDA REG. NO. 70612
CIVIL ENGINEER

Scale:	AS SHOWN
Drawn By:	J.G.
Checked By:	N.T.A.
Managed By:	N.T.A.
Drawing Date:	AUG. 02, 2021
Project No.:	13100.0.09
SITE P-3 BASEBALL FIELD 2 AND PAVILION	

ation= 10.0



ZONE X
No base flood determined
(Area within 500-year floodplain)

**CORAL REEF
MENTARY SCHOOL
(B - 2006)**

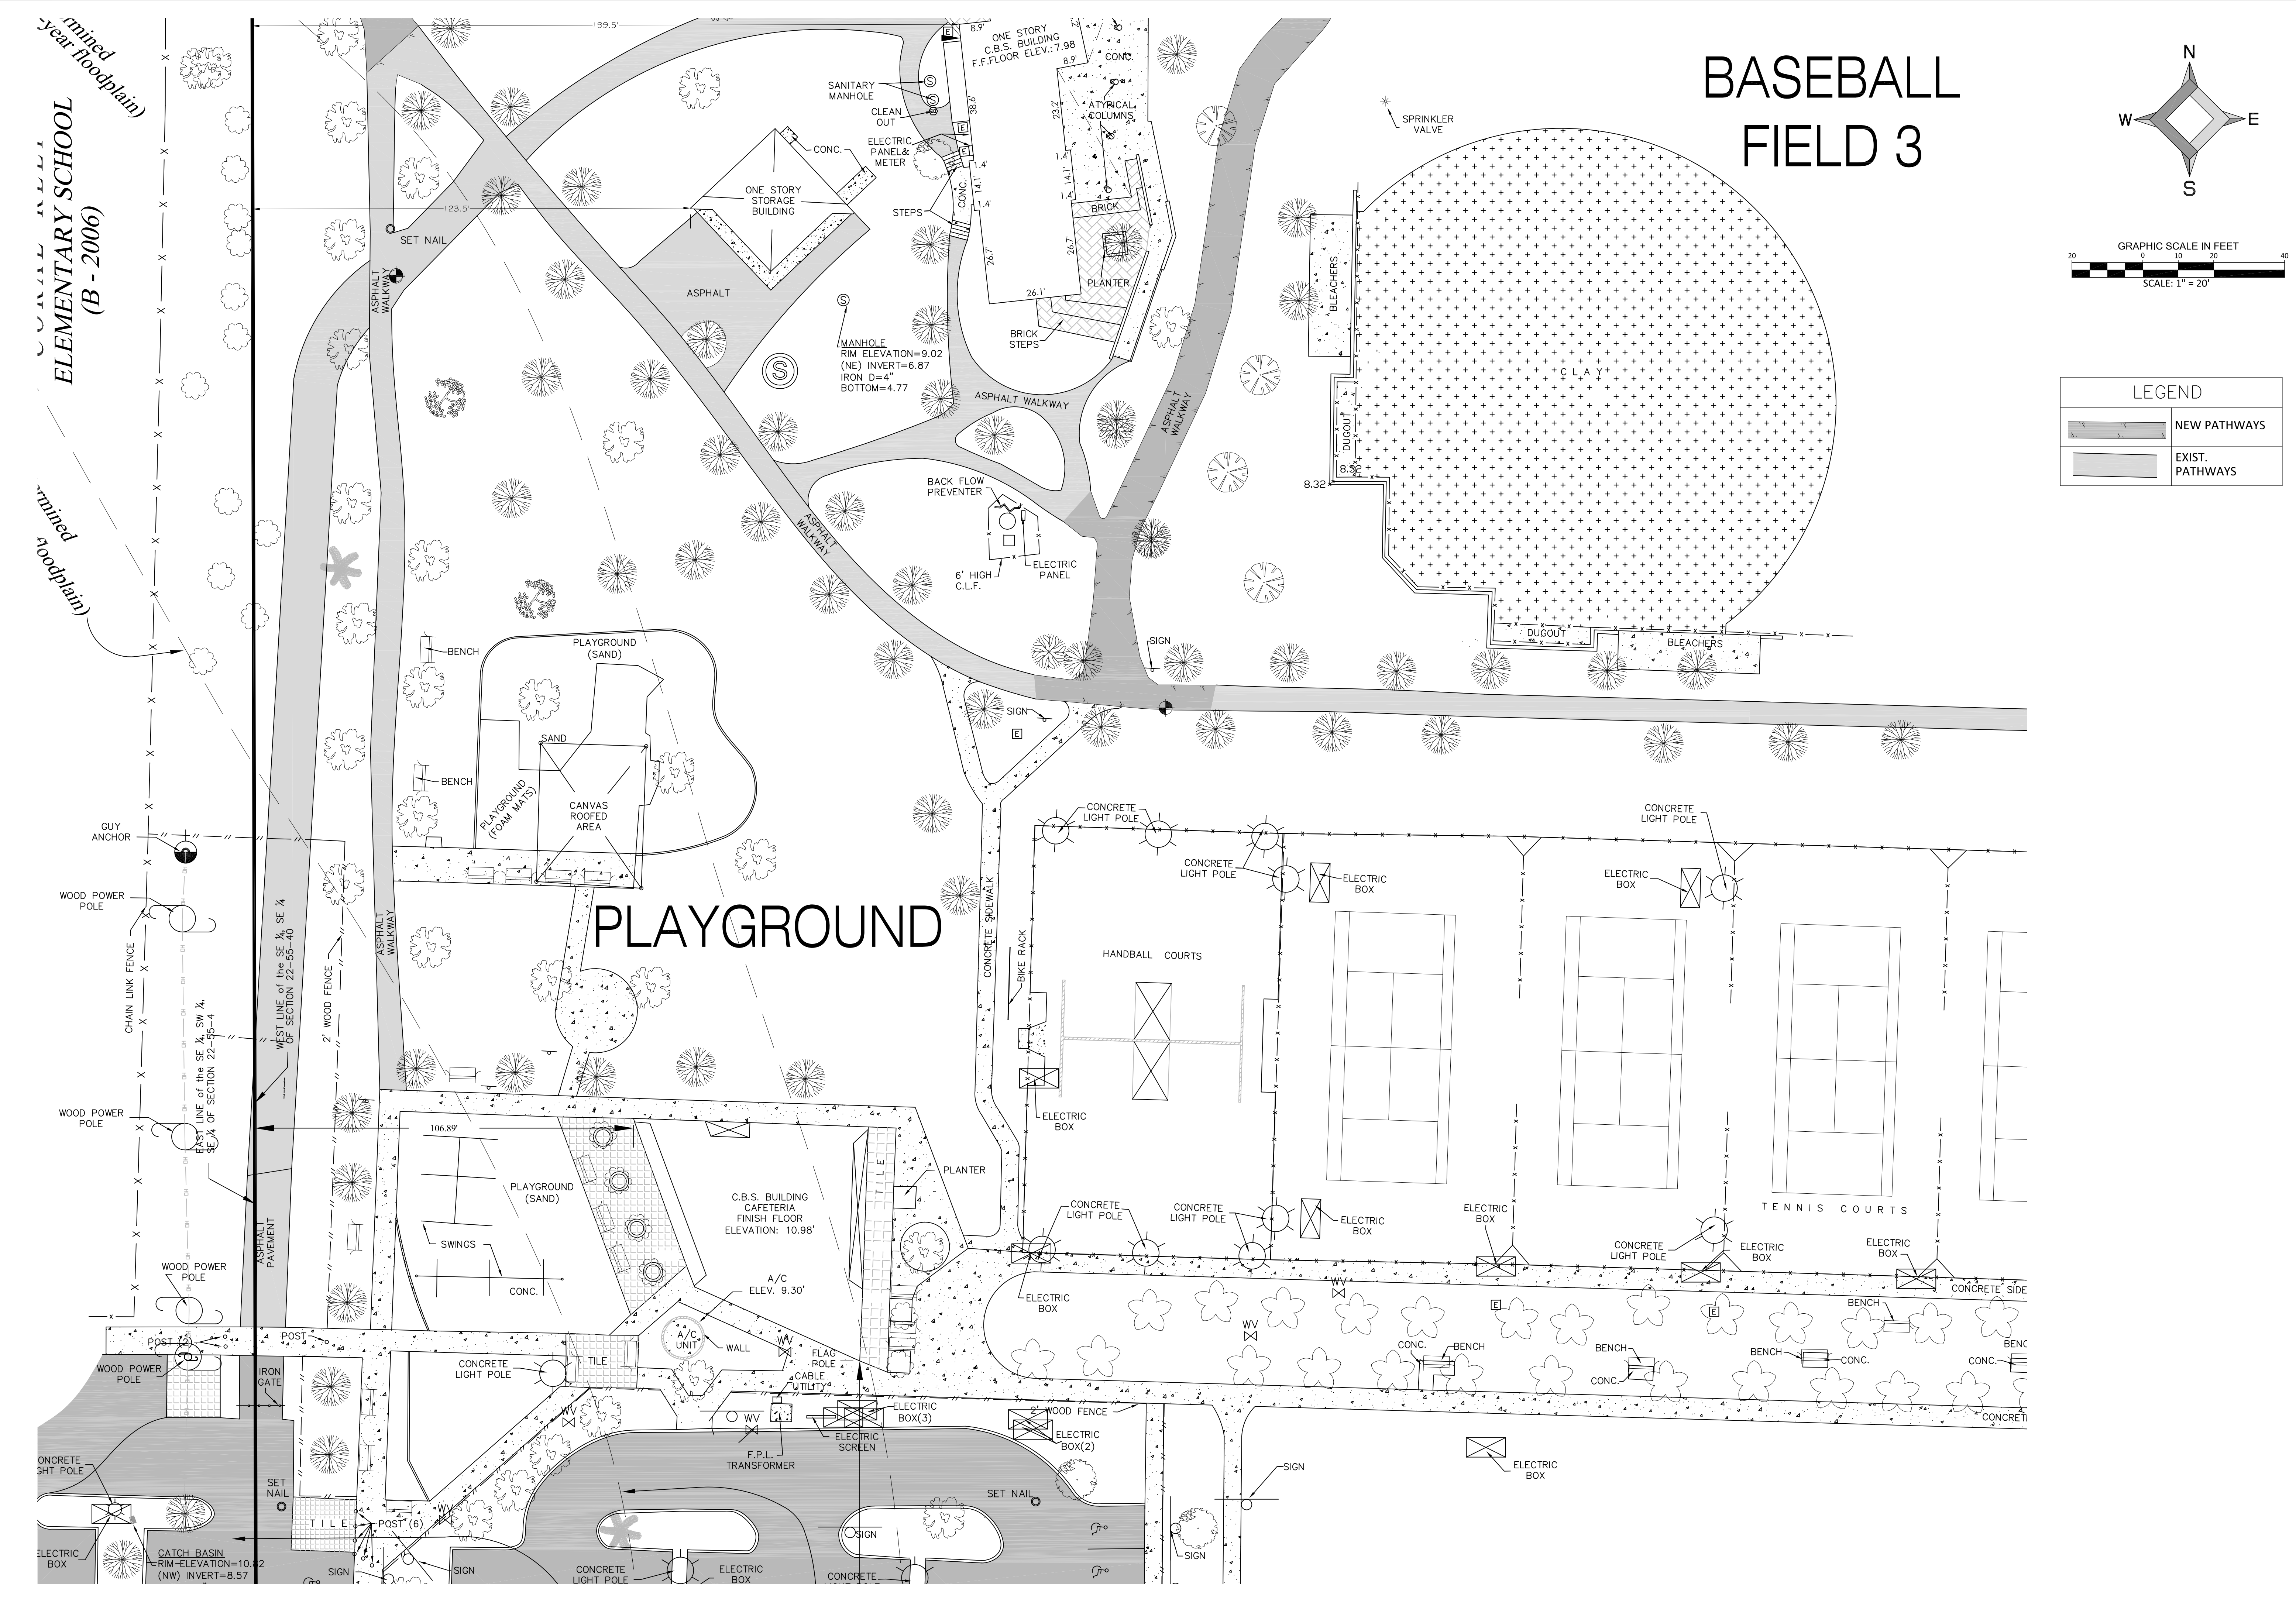


mined year floodplain)
ELEMENTARY SCHOOL (B - 2006)

BASEBALL FIELD 3

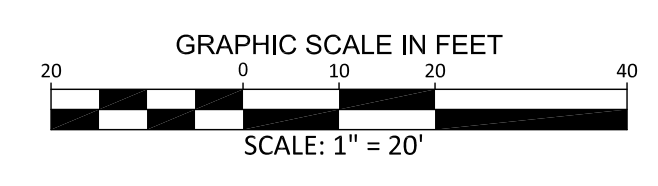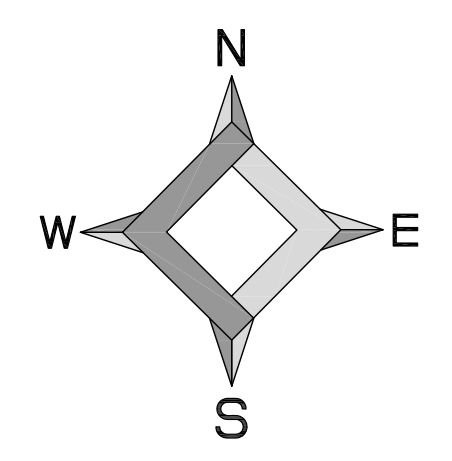

LEGEND	
	NEW PATHWAYS
	EXIST. PATHWAYS

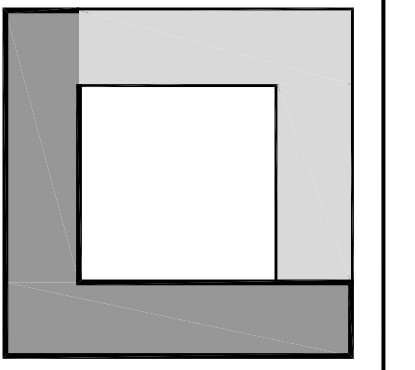

LONGITUDE SURVEYORS


7769 NW 48th STREET
 SUITE 375
 DORAL, FLORIDA 33166
 PH: (305) 463-0912
 FAX: (305) 513-5680
 FLORIDA CERTIFICATE OF AUTHORIZATION LB 7335

WWW.LONGITUDESURVEYORS.COM

By:	Date:	No.:	RECORD OF REVISION Description

Project Name: **CORAL REEF PARK
 7895 SW 152nd ST.
 PALMETTO BAY, FLORIDA 33157**


BASEBALL FIELD 3 AND PLAYGROUND

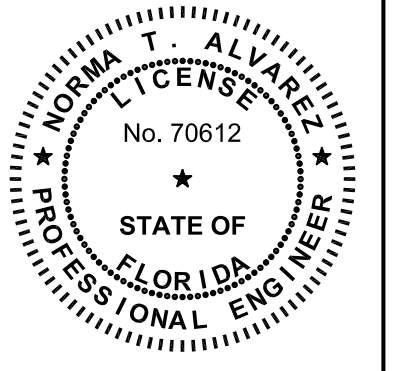


THIS ITEM HAS BEEN DIGITALLY SIGNED AND SEALED BY NORMA T. ALVAREZ, P.E. ON THE DATE ADJACENT TO THE SEAL.
 PRINTING COPIES OF THIS DOCUMENT ARE NOT CONSIDERED SIGNED AND SEALED AND THE SIGNATURE MUST BE VERIFIED ON ANY ELECTRONIC COPIES.

APPROVED BY:
 NORMA T. ALVAREZ, P.E.
 FLORIDA REG. NO. 70612
 CIVIL ENGINEER

Scale:	AS SHOWN
Drawn By:	J.G.
Checked By:	N.T.A.
Managed By:	N.T.A.
Drawing Date:	AUG. 02, 2021
Project No.:	13100.0.09
SITE P-4 BASEBALL FIELD 3 AND PLAYGROUND	

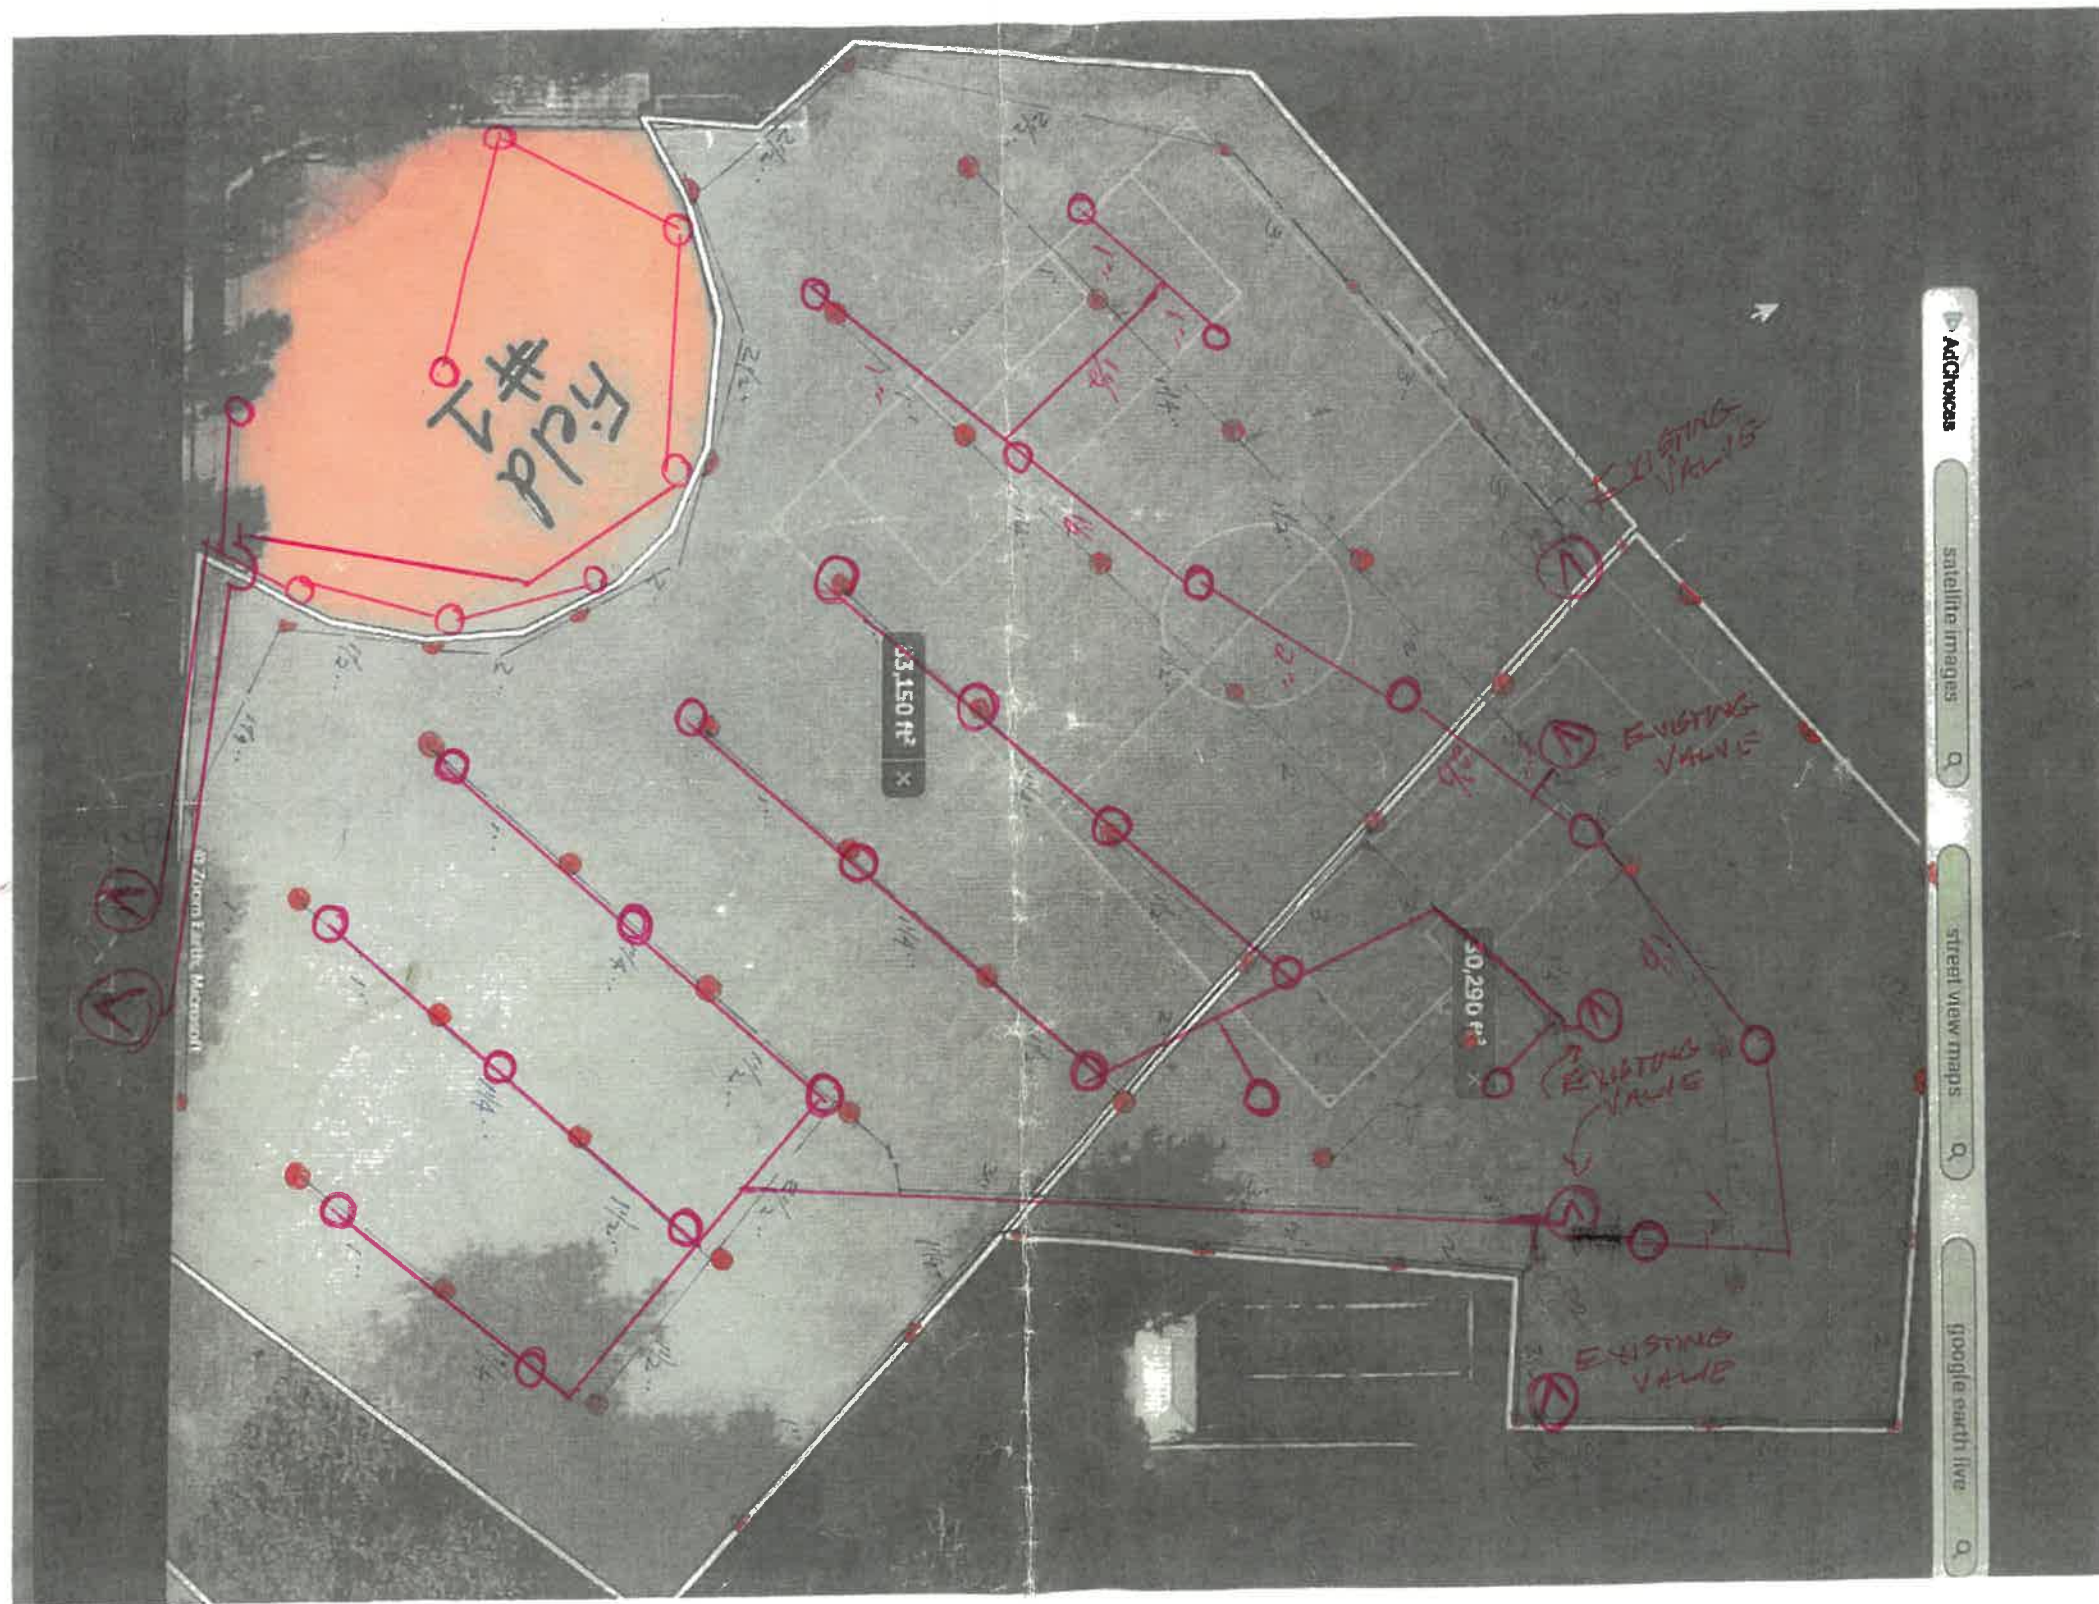

AS-BUILT

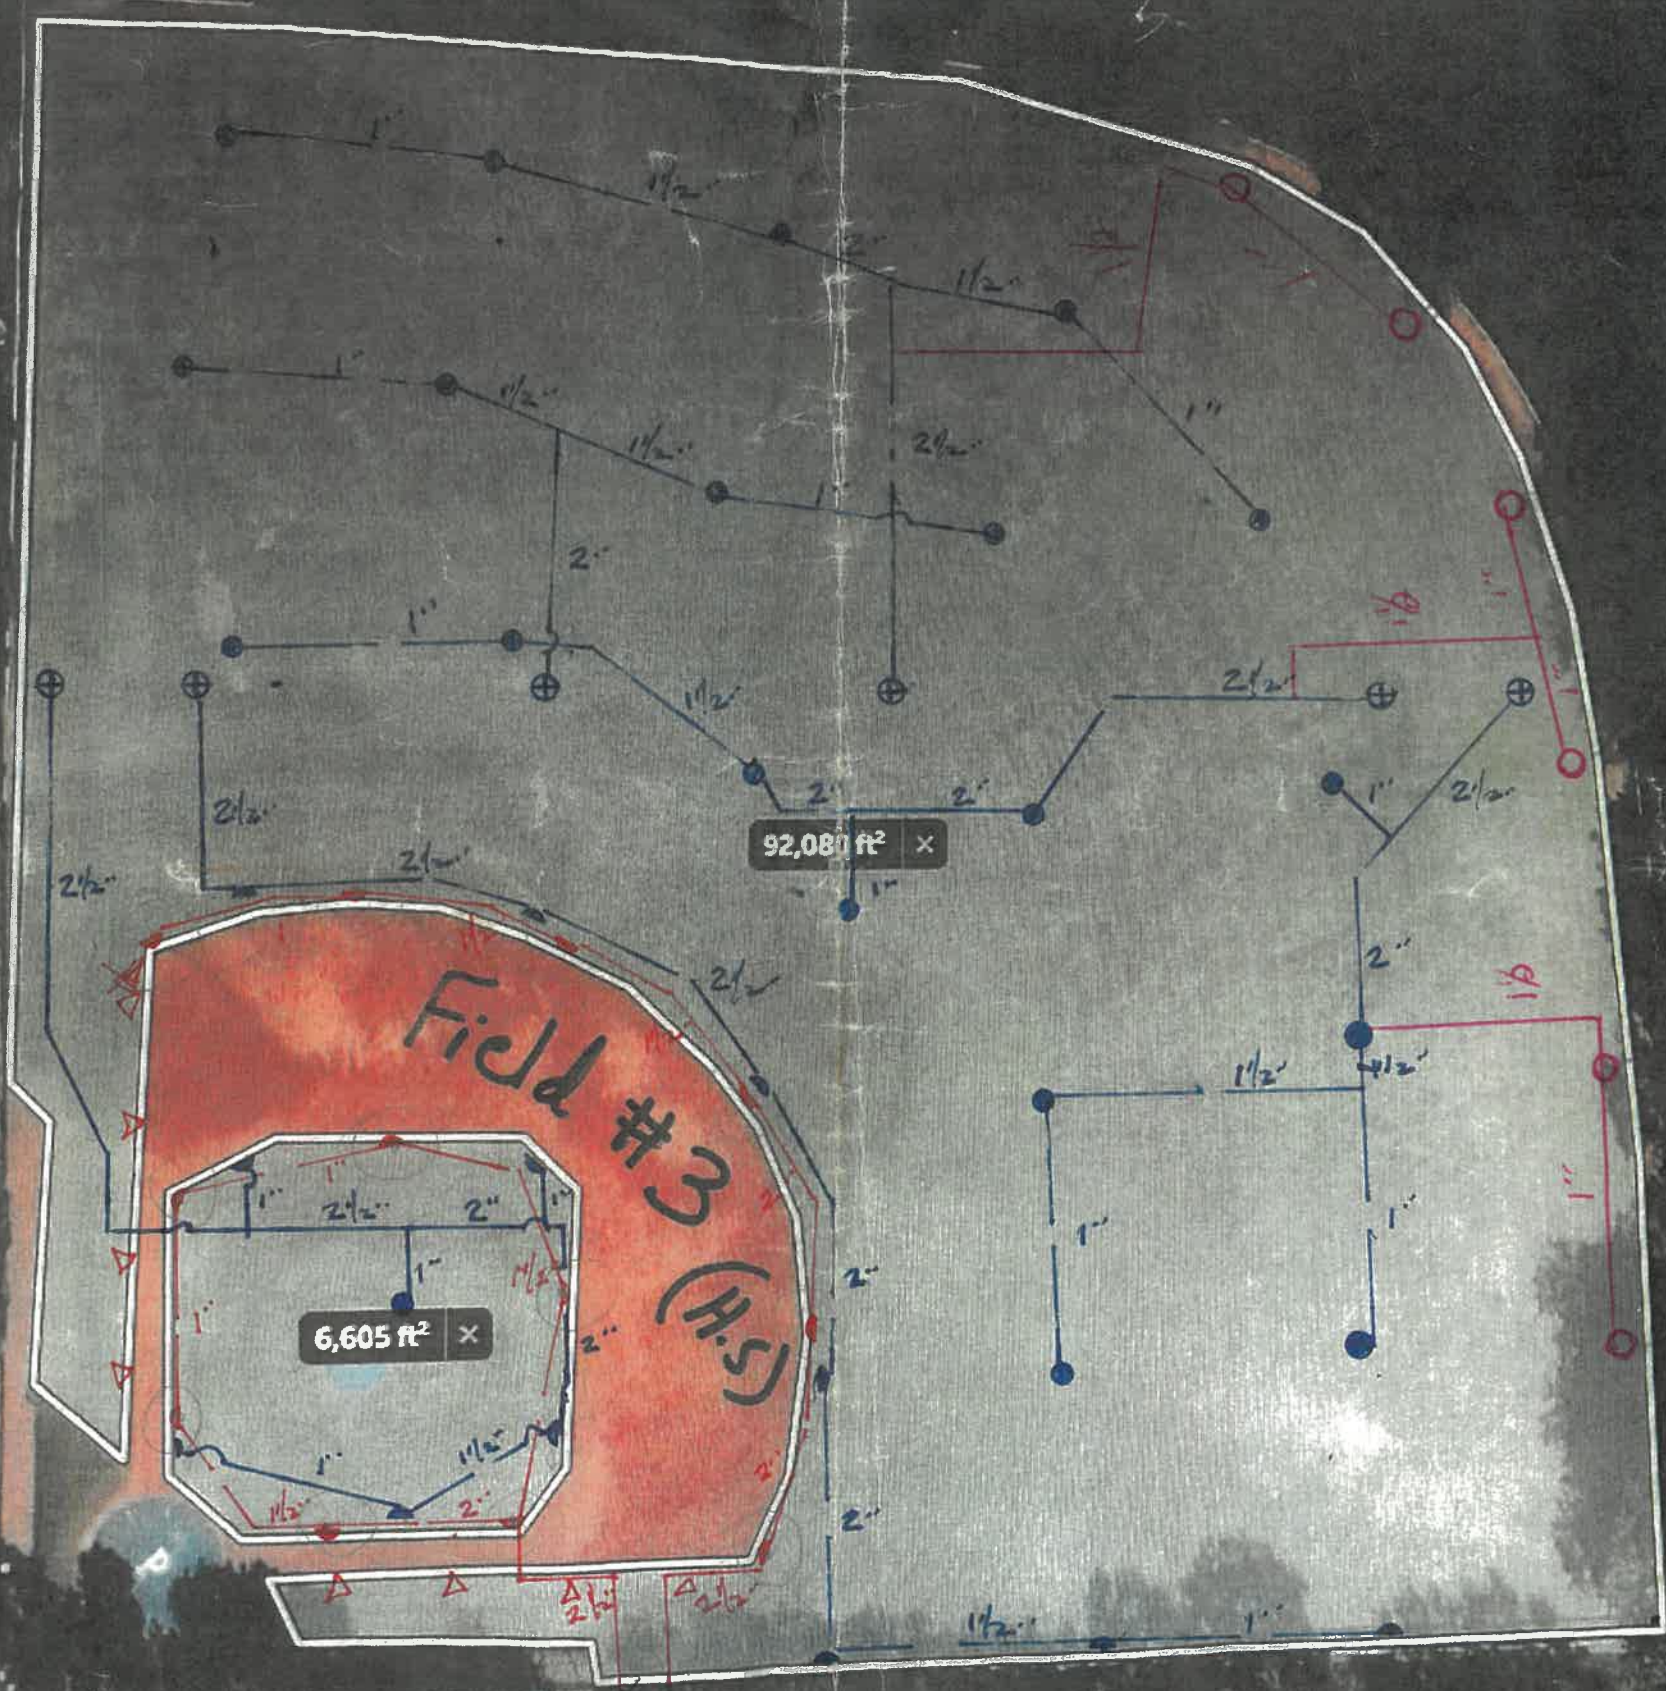

© Zoom Earth, Microsoft

9:51 AM
9/1/20

"AS-BUILT"

