

OWNER ARCHITECT CONTRACTOR

Field Order #45

Pro	ject: A NEW	A NEW North Whitfield Middle School		18-014/0050CA
	North Whitfield Midd			October 15, 2020
	3450 Cleveland HWY		To:	Womack Lewis & Smith
	Dalton, Ga. 30721		Submitted By:	Josh Scott (KRH)
	Price for Approval Only		Proceed Based on Time and Material Basis	
$\overline{\checkmark}$	Proceed		Clarification	
The Architects Office shall be notified in writing of any field orders that result in adjustments in the contract price or the				

Band Room - Technology


Please add the following as shown below and in the attachment. All data junction boxes to be 2"x2". This will relate to Addendum No. 1, Item #15.


In Band Room 1207, add the following:


Furnish and install a recessed junction boxes on the wall for the owner furnished wireless access points and speakers. Run a 1"conduit with pull rope from the box to the corridor cable tray. Coordinate the exact location and mounting height and box size with the Owner prior to rough-in. Contractor shall include in base bid a quantity of (6) six locations for these boxes and conduits.

KRH Architects Page 1

MIDDLE

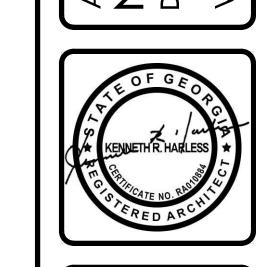

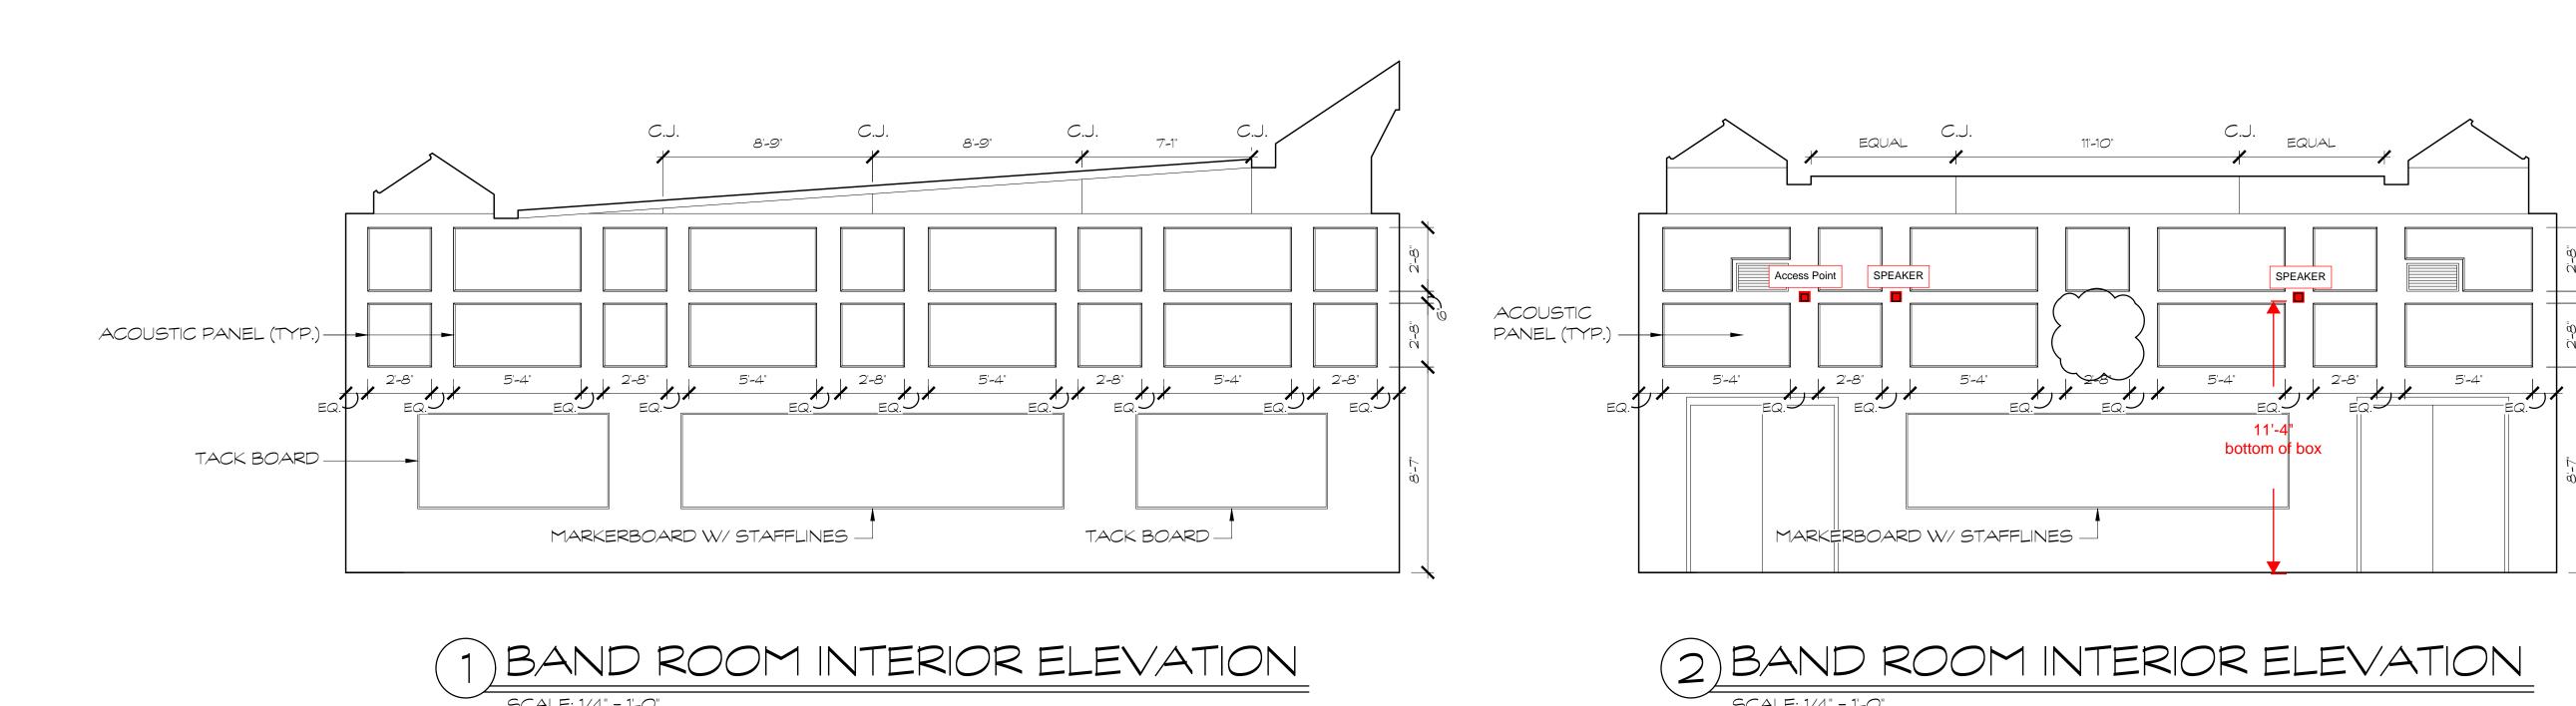

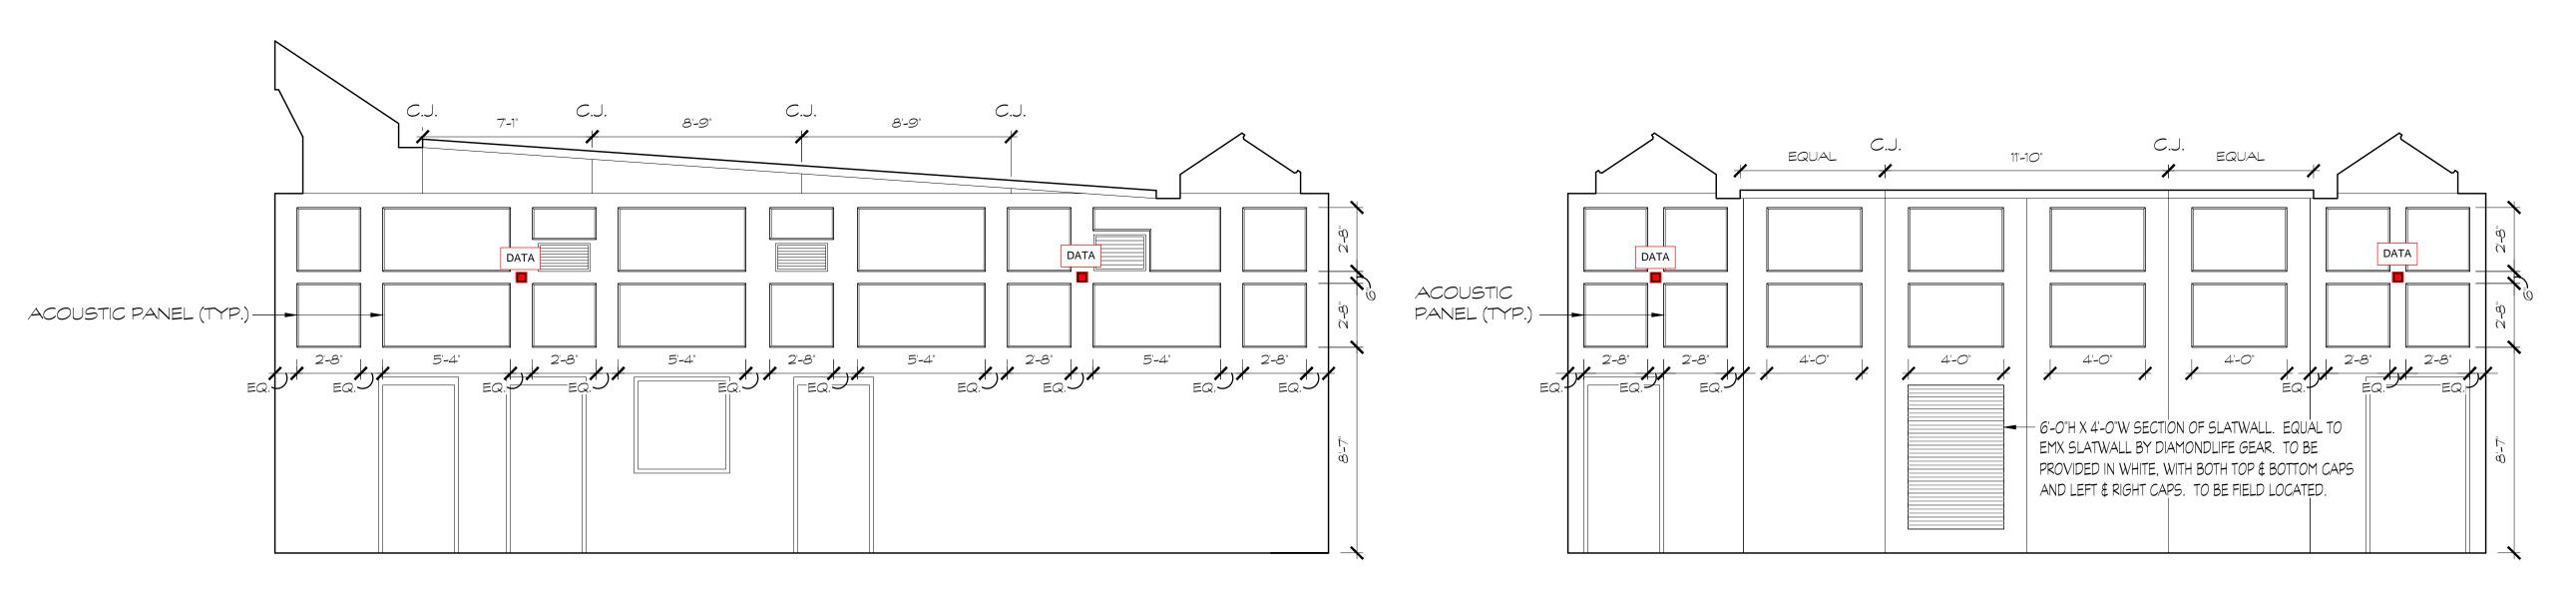

SCALE: 1/4" = 1'-0"

SCALE: 1/4" = 1'-0"