



FLOOR PLANS

See comments on A6.

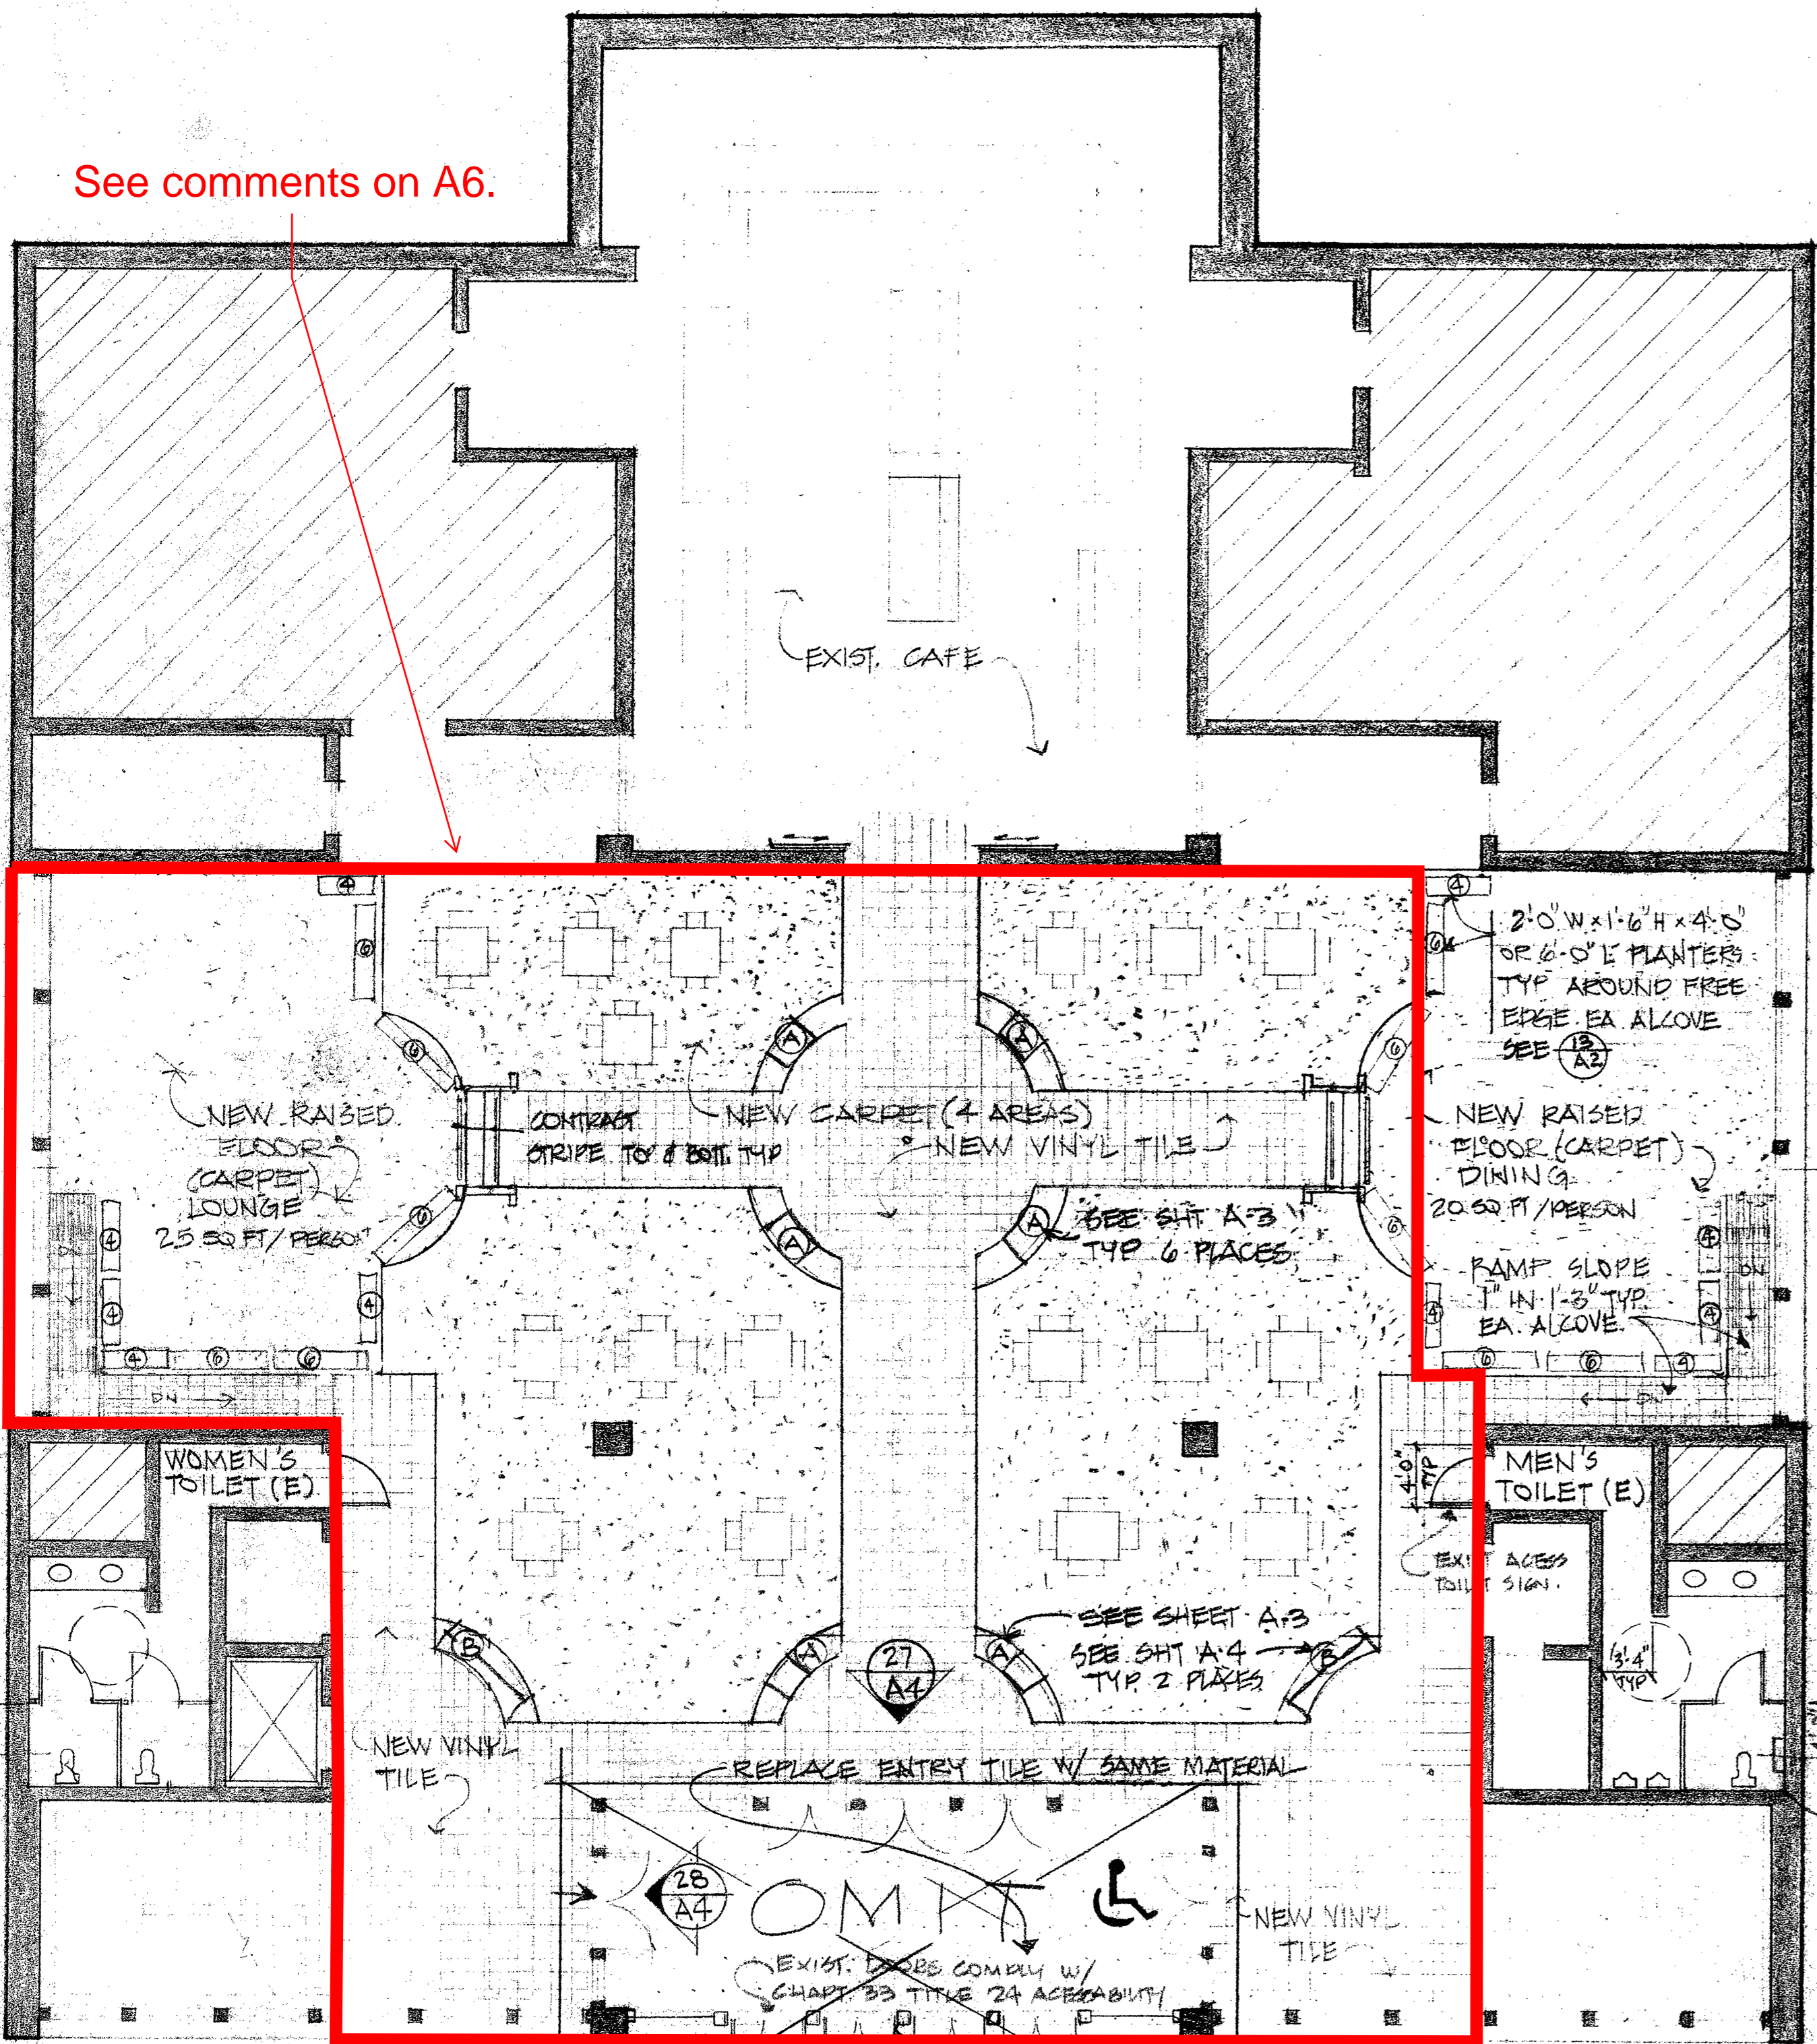

MAIN FLOOR

SCALE 1/8" = 1'-0"

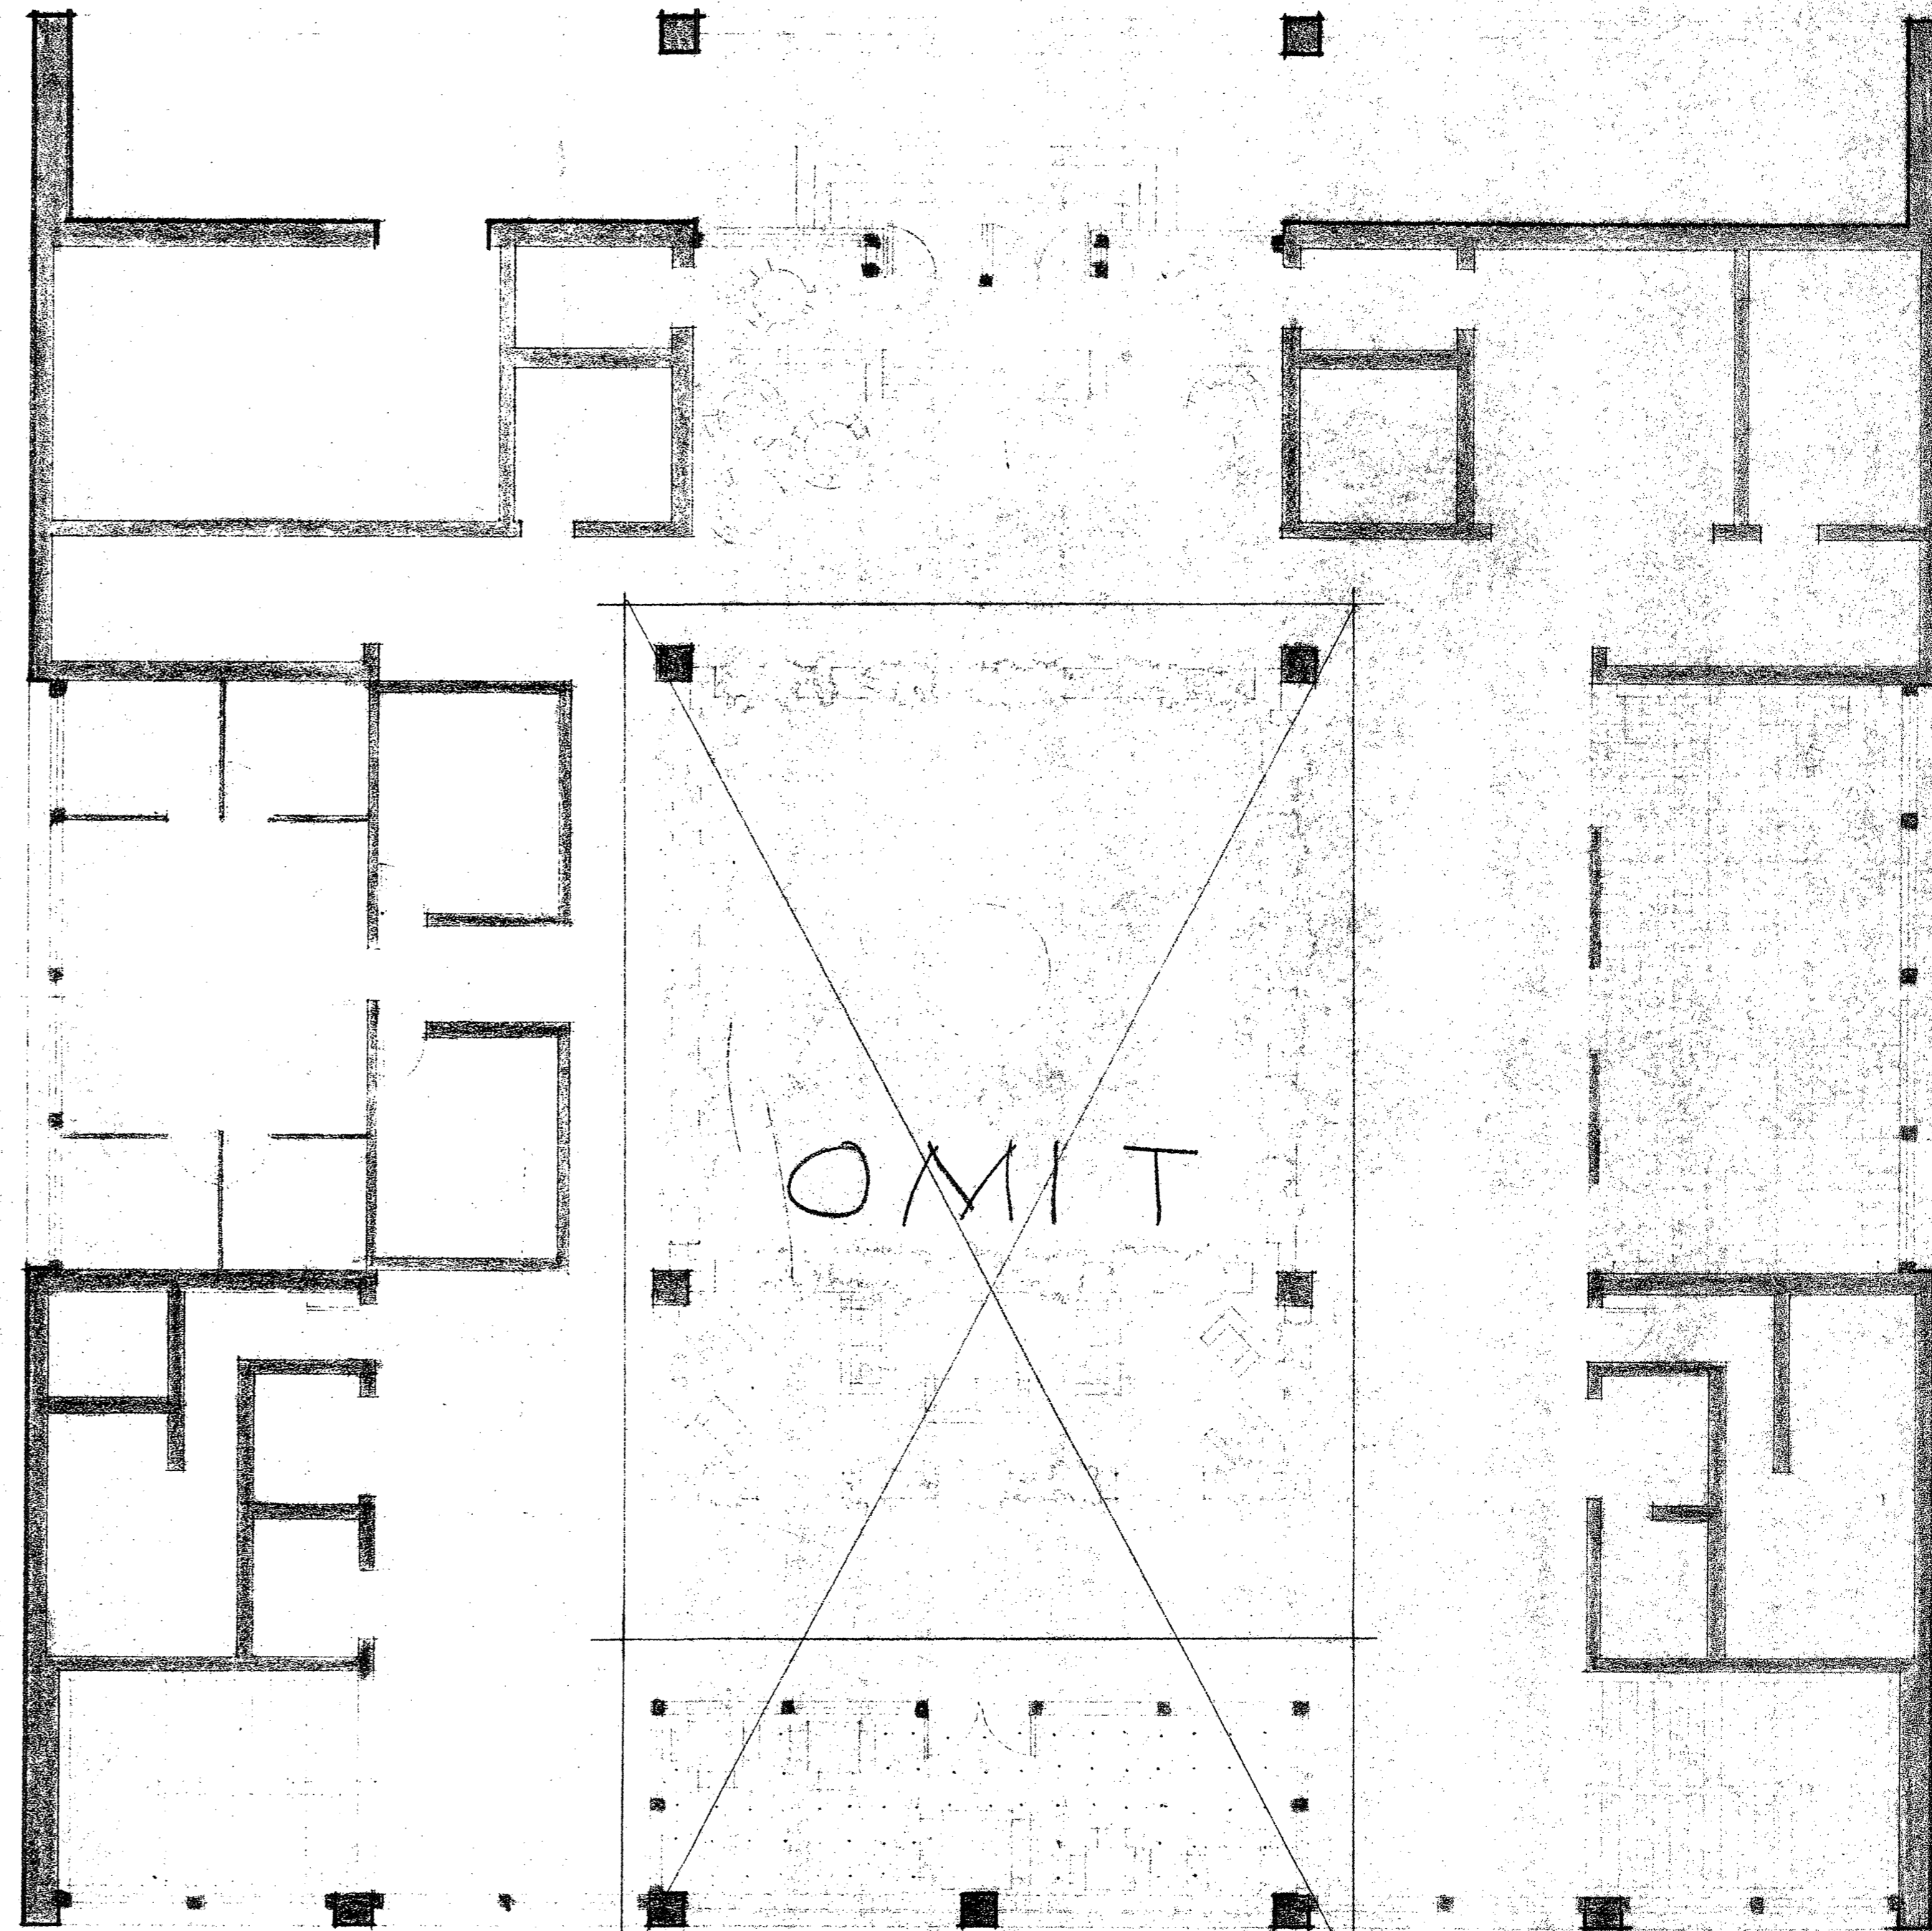

MEZZANINE

SCALE 1/8" = 1'-0"

NOTE:
EXIST. EMERGENCY AND EXIT LIGHTING SYSTEM TO REMAIN IN SERVICE

STATE OF CALIFORNIA
DEPARTMENT OF GENERAL SERVICES
DEC 11 1991
OFFICE OF THE STATE ARCHITECT
STRUCTURAL SAFETY SECTION S.F.

OFFICE OF THE STATE ARCHITECT
ACCESS COMPLIANCE SECTION
56419 OCT-7-91
APPLICATION: 228 N. 2nd Street
No. 35

APPROVED
Department of General Services
Office of the State Architect
OCT - 7 1991
Structural Safety Section
No. 56419
Checked by: [Signature]

CALIFORNIA STATE FIRE-MARSHAL
APPROVED

APPROVAL OF THIS PLAN DOES NOT CONSTITUTE OR APPROVE ANY GUARANTEE OR WARRANTY FROM APPLICABLE REGULATIONS. FINAL OPERATIONAL PLANS MUST BE SUBMITTED TO THE ARCHITECT FOR REVIEW AND APPROVAL. REVISIONS TO THIS PROJECT SHEET AT THE TIME.

THOMAS LEE TURMAN
ARCHITECT
1718 Ninth Street
Berkeley, California 94710
(415) 857-3773

G. LEMLEY
H. CHILDRESS

STUDENT UNION
LANEY COLLEGE
OAKLAND, CALIFORNIA



FLOOR PLANS
MAIN FLOOR
MEZZANINE

9/12/91

A1

FLOORING LEGEND

Current floor is not carpet.
Current floor has 2 layers of VCT.

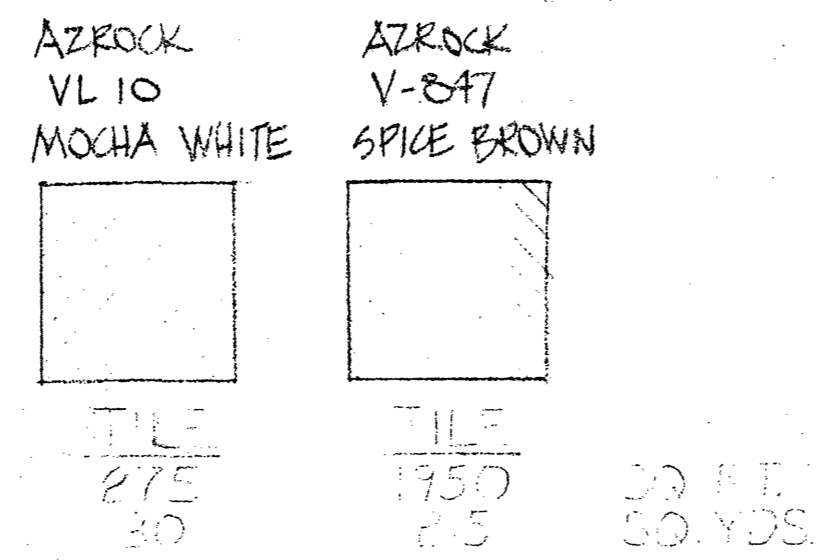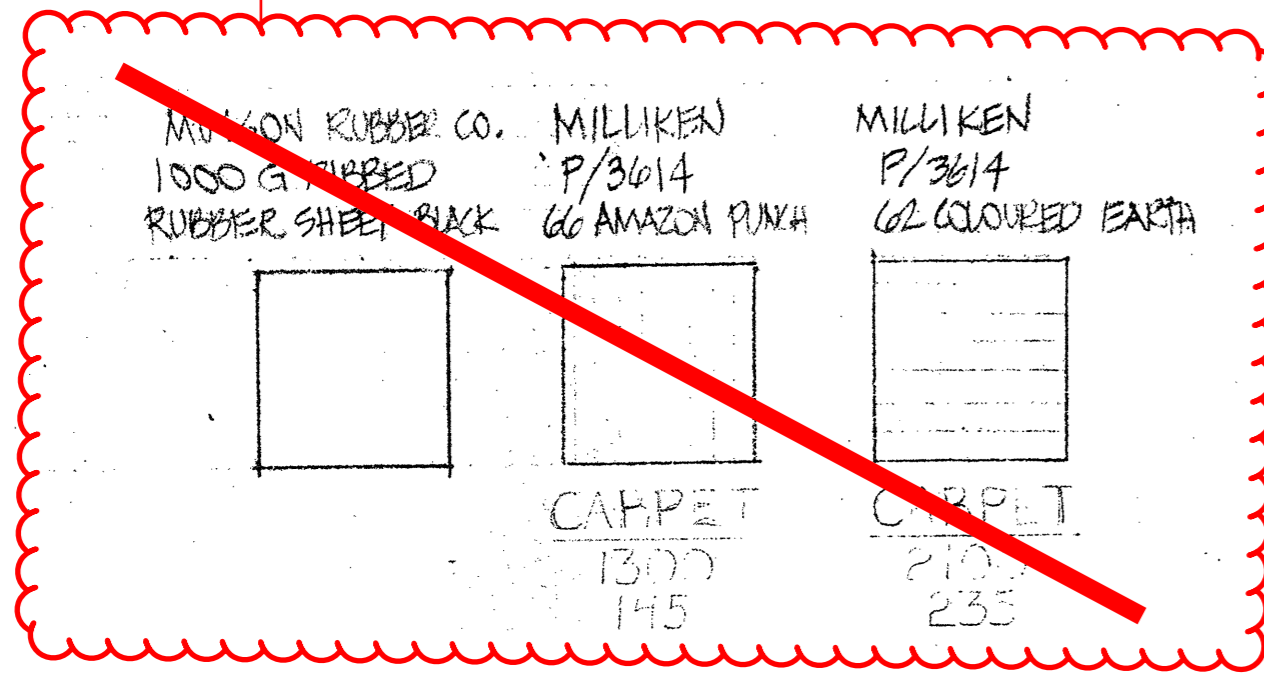


PAINT SCHEDULE
SYMMETRICAL ABOUT C

WALLS A, B, C, G, H, I, COFFERED CEILING | LIGHT COLOR - TO BE SELECTED

WALLS D, E, F FACE OF ALCOVE DROPPED CEILING ALL PILLARS, AIR DUCTS AND ATRIUM FACE | DARKER COLOR - TO BE SELECTED

COFFERED CEILING DUCTS SPRINKLER PIPES OTHER EQPT. ABOVE SUSPENDED CEILING PANELS | GREY

CASE 457 ENTRY ENCLOSURE | METAL STUDS - BLACK
METAL GRATE - DEEP GREEN

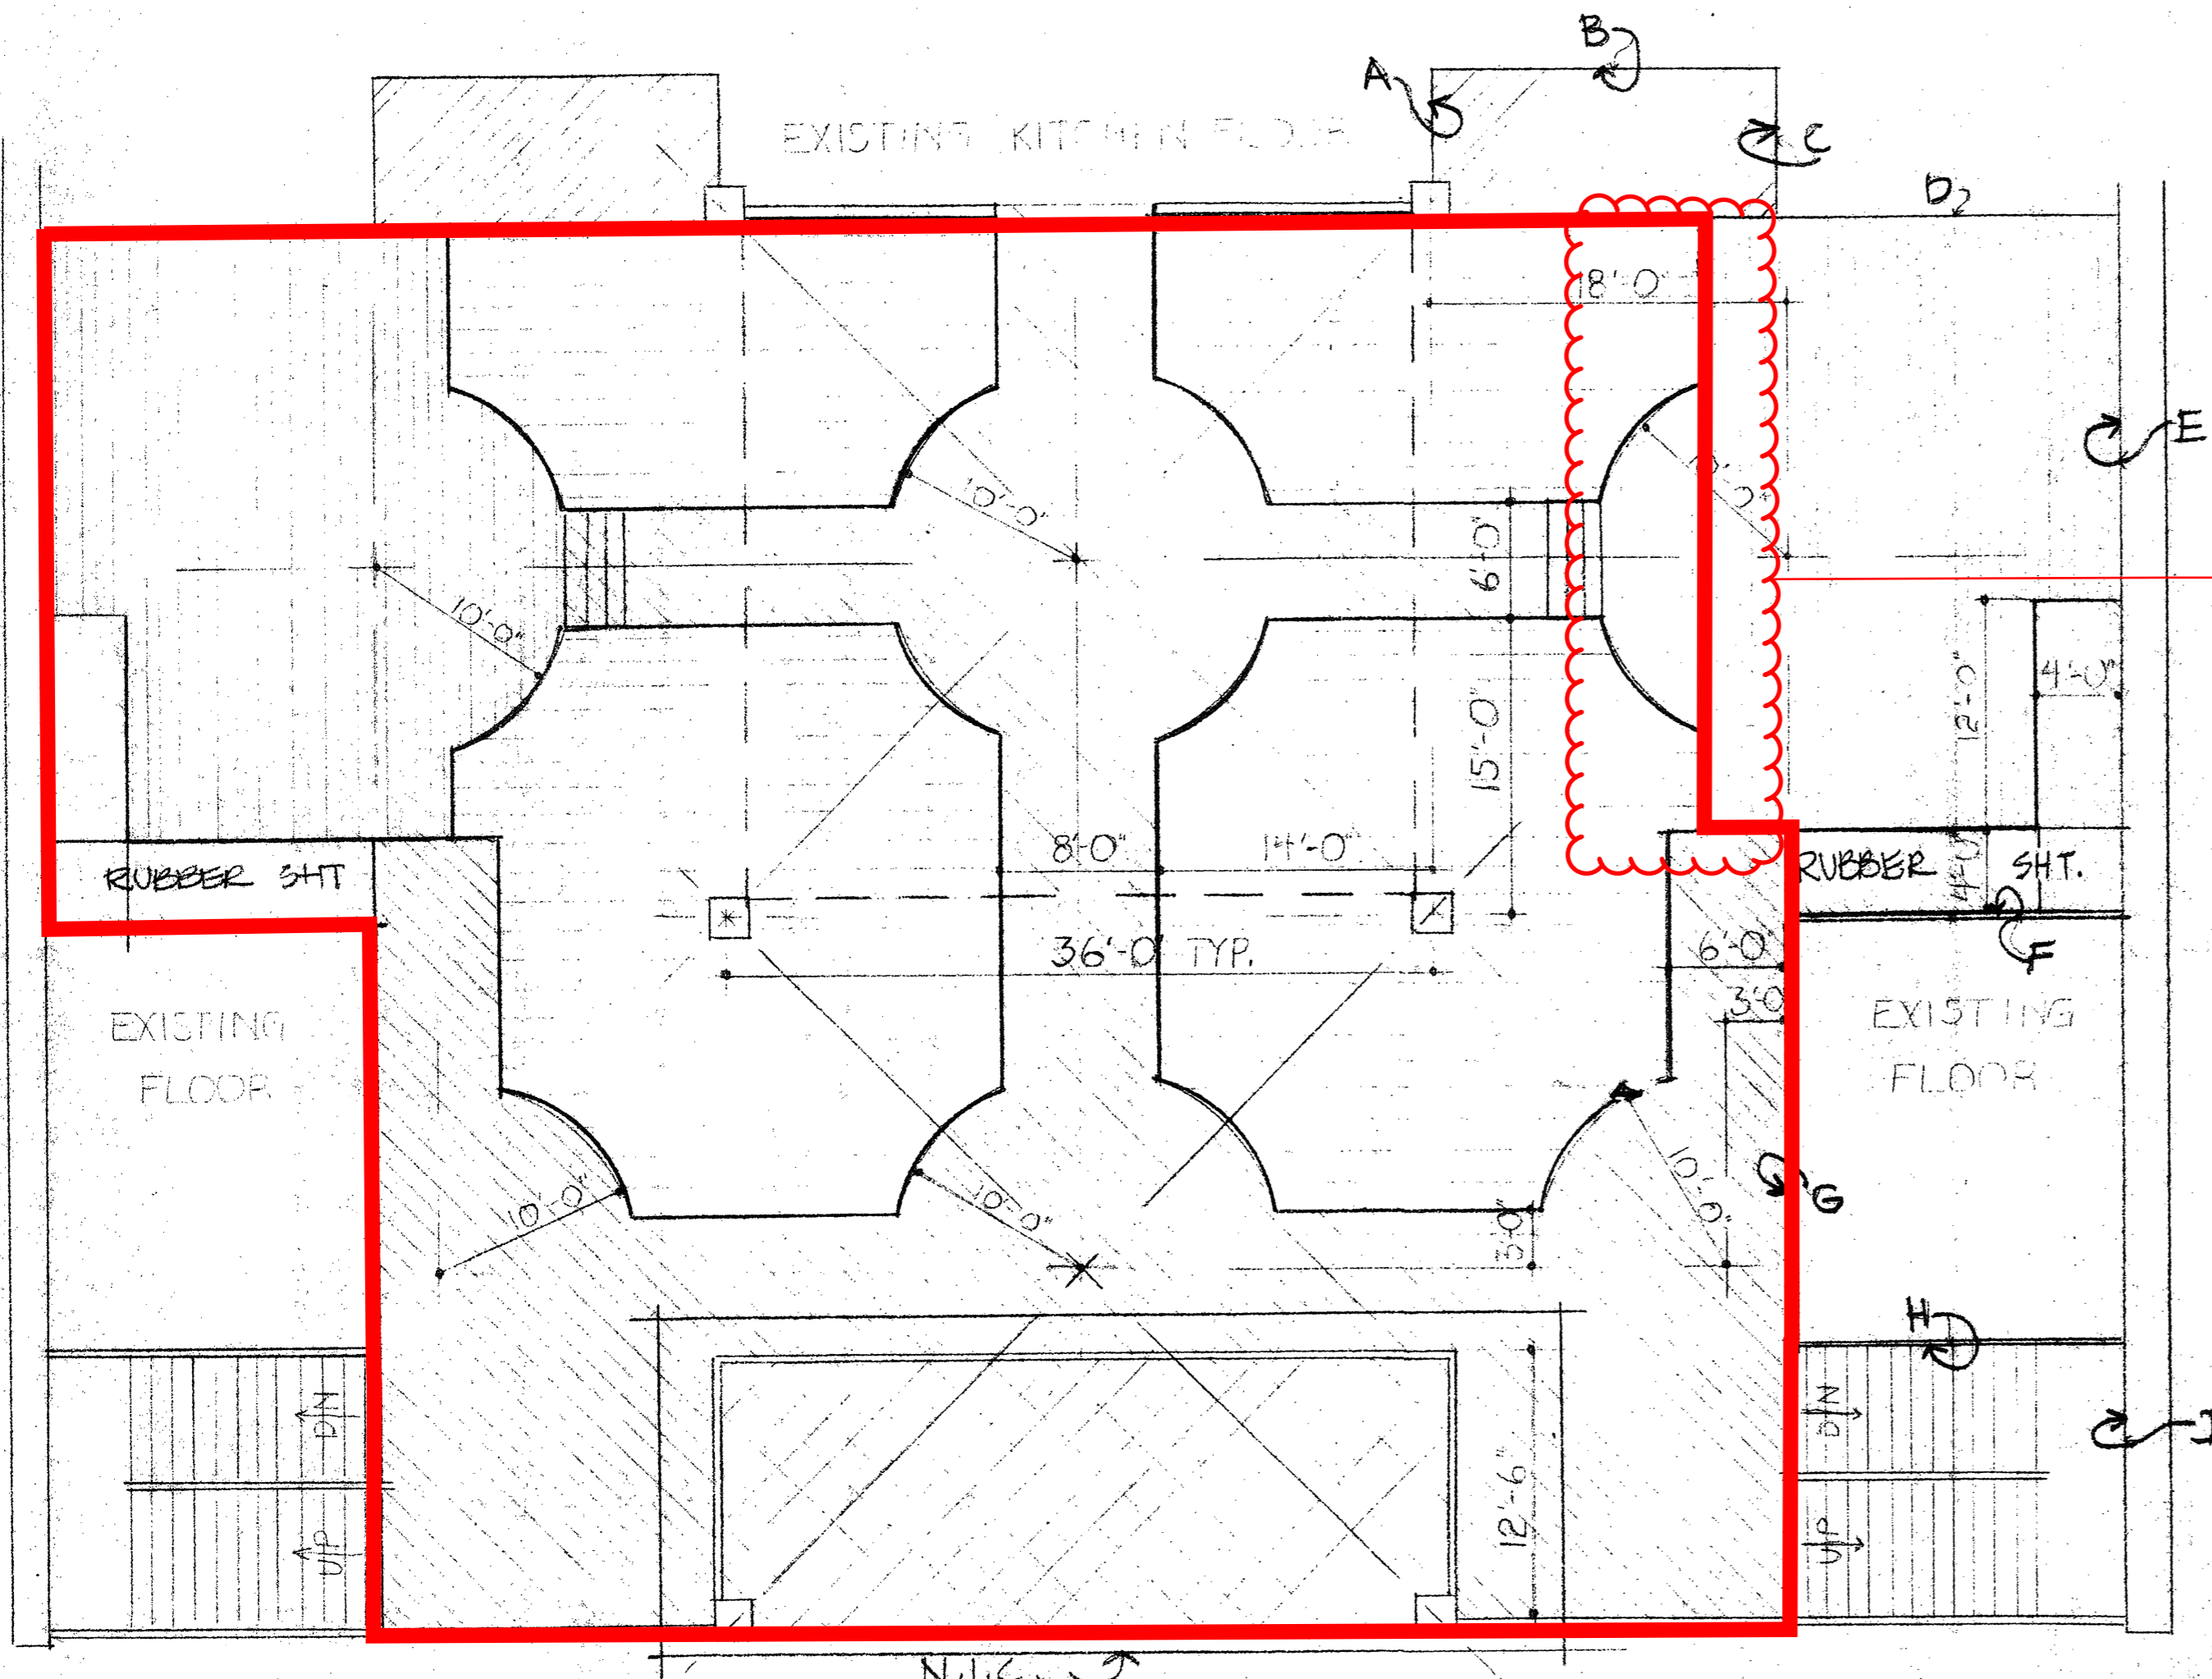

No raised bulb-out at this location. Reference Union Bank Branch Drawings A0.22

NOTE: FLOOR AND OTHER DIMENSIONS, MATERIALS, AND FINISHES ARE IDENTICAL FOR THE LEFT AND RIGHT SIDES OF THE ROOM

FLOOR & FINISH PLAN
1/8" = 1'-0"

STATE OF CALIFORNIA
DEPARTMENT OF GENERAL SERVICES
DEC 11 1991
OFFICE OF THE STATE ARCHITECT
STRUCTURAL SAFETY SECTION

APPROVED
Department of General Services
Office of the State Architect
OCT - 7 1991
Structural Safety Section
App. # 56419
Checked By: SAA

CALIFORNIA STATE FIRE MARSHAL
APPROVED

OFFICE OF THE STATE ARCHITECT
ACCESS COMPLIANCE SECTION
56419 OCT-7-91
APPLICATION NO. 56419

APPROVAL OF THIS PLAN AND SPECIFICATIONS BY APPROVE ANY COMMISSION FOR DEPARTMENT OF GENERAL SERVICES AND THE STATE ARCHITECT APPROVAL IS SUBJECT TO THE DEPARTMENT OF GENERAL SERVICES PLANS SHALL BE RETURNED TO THE ARCHITECT

THOMAS LEE TURMAN
ARCHITECT
3715 Ninth Street
Berkeley, California 94710
(415) 847-9773

GREGORY LEMLEY
HERB CHILDRESS

STUDENT UNION
LANEY COLLEGE
OAKLAND, CALIFORNIA

FLOORING AND FINISHES

DRAWN BY: JIC

9/12/91

A6



lx design group
 architecture • planning • interiors
 San Antonio, Texas 78249
 16010 Via Shavano -
 210.824.8825

**Union Bank Branch
 at Laney College**
 900 Fallon Street
 Oakland, CA 94607

IDENTIFICATION STAMP
 DIV. OF THE STATE ARCHITECT
 OFFICE OF REGULATIONS SERVICES

APPL

AC ___ FLS ___ SS ___
 DATE _____



No.	Description	Date

PROJECT NO.: 19179
 PROJECT MGR: MR
 ASSISTED BY: MA
 DATE: 05/18/2020

LIFE SAFETY PLAN
A0.22

OCCUPANT LOAD CALCULATION - FIRST FLOOR

ROOM NAME	ROOM AREA	FUNCTION OF SPACE	OCCUPANT LOAD FACTOR	OCCUPANT LOAD
TELLER	243 SF	BUSINESS	150 SF	2
CASH/IT	98 SF	BUSINESS	150 SF	1
PLATFORM	77 SF	BUSINESS	150 SF	1
EXPRESS BANKING	132 SF	BUSINESS	150 SF	1
LOBBY	161 SF	BUSINESS	150 SF	2
WOMENS TLT	211 SF	---	---	---
STORAGE	104 SF	STORAGE	300 SF	1
STAIR #3	415 SF	---	---	---
STORAGE	300 SF	STORAGE	300 SF	1
STORAGE	57 SF	STORAGE	300 SF	1
TRAY WASHING	427 SF	STORAGE	300 SF	2
MENS TLT	178 SF	---	---	---
JANITOR	106 SF	---	300 SF	1
SERVING	1947 SF	ASSEMBLY UNCONCENTRATED	15 SF	130
FOOD STORAGE	317 SF	STORAGE	300 SF	2
STORAGE	130 SF	STORAGE	300 SF	1
MAIN DINING AREA	5847 SF	ASSEMBLY UNCONCENTRATED	15 SF	390
TOTAL				536

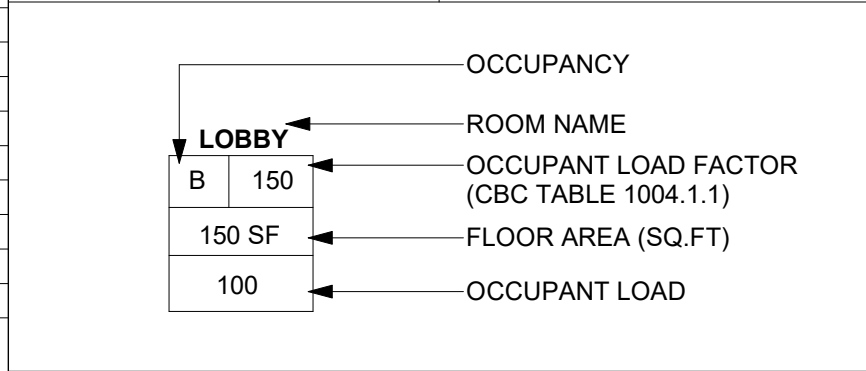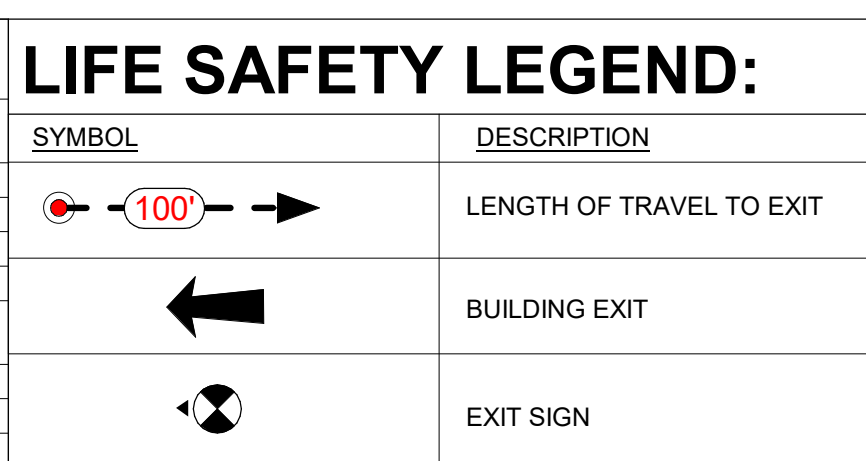


NUMBER AND ARRANGEMENT OF EXITS

OCCUPANCY	Area	OCCUPANT LOAD	MINIMUM NUMBER OF EXITS (TABLE 1006.3.1)		TRAVEL DISTANCE (TABLE 1017.2)		ARRANGEMENT OF MEANS OF EGRESS (SECTION 1007.1.1)	
			REQ'D	SHOWN ON PLANS	ALLOWABLE TRAVEL DISTANCE	ACTUAL TRAVEL DISTANCE SHOWN ON PLAN	MIN. REQUIRED DISTANCE BETWEEN EXIT DOORS	ACTUAL DISTANCE SHOWN ON PLANS
FIRST FLOOR	13294 SF	536	3	5	300' - 0"	50' - 0"	51' - 0"	88' - 0"

EXIT WIDTH

Name	SF	LOAD (OCCUPANTS)	EGRESS WIDTH PER OCCUPANT		EXIT WIDTH (IN)			
			STAIR	LEVEL	REQUIRED		ACTUAL	
FIRST FLOOR	13,294	536	.2	.15	107	80	204	350

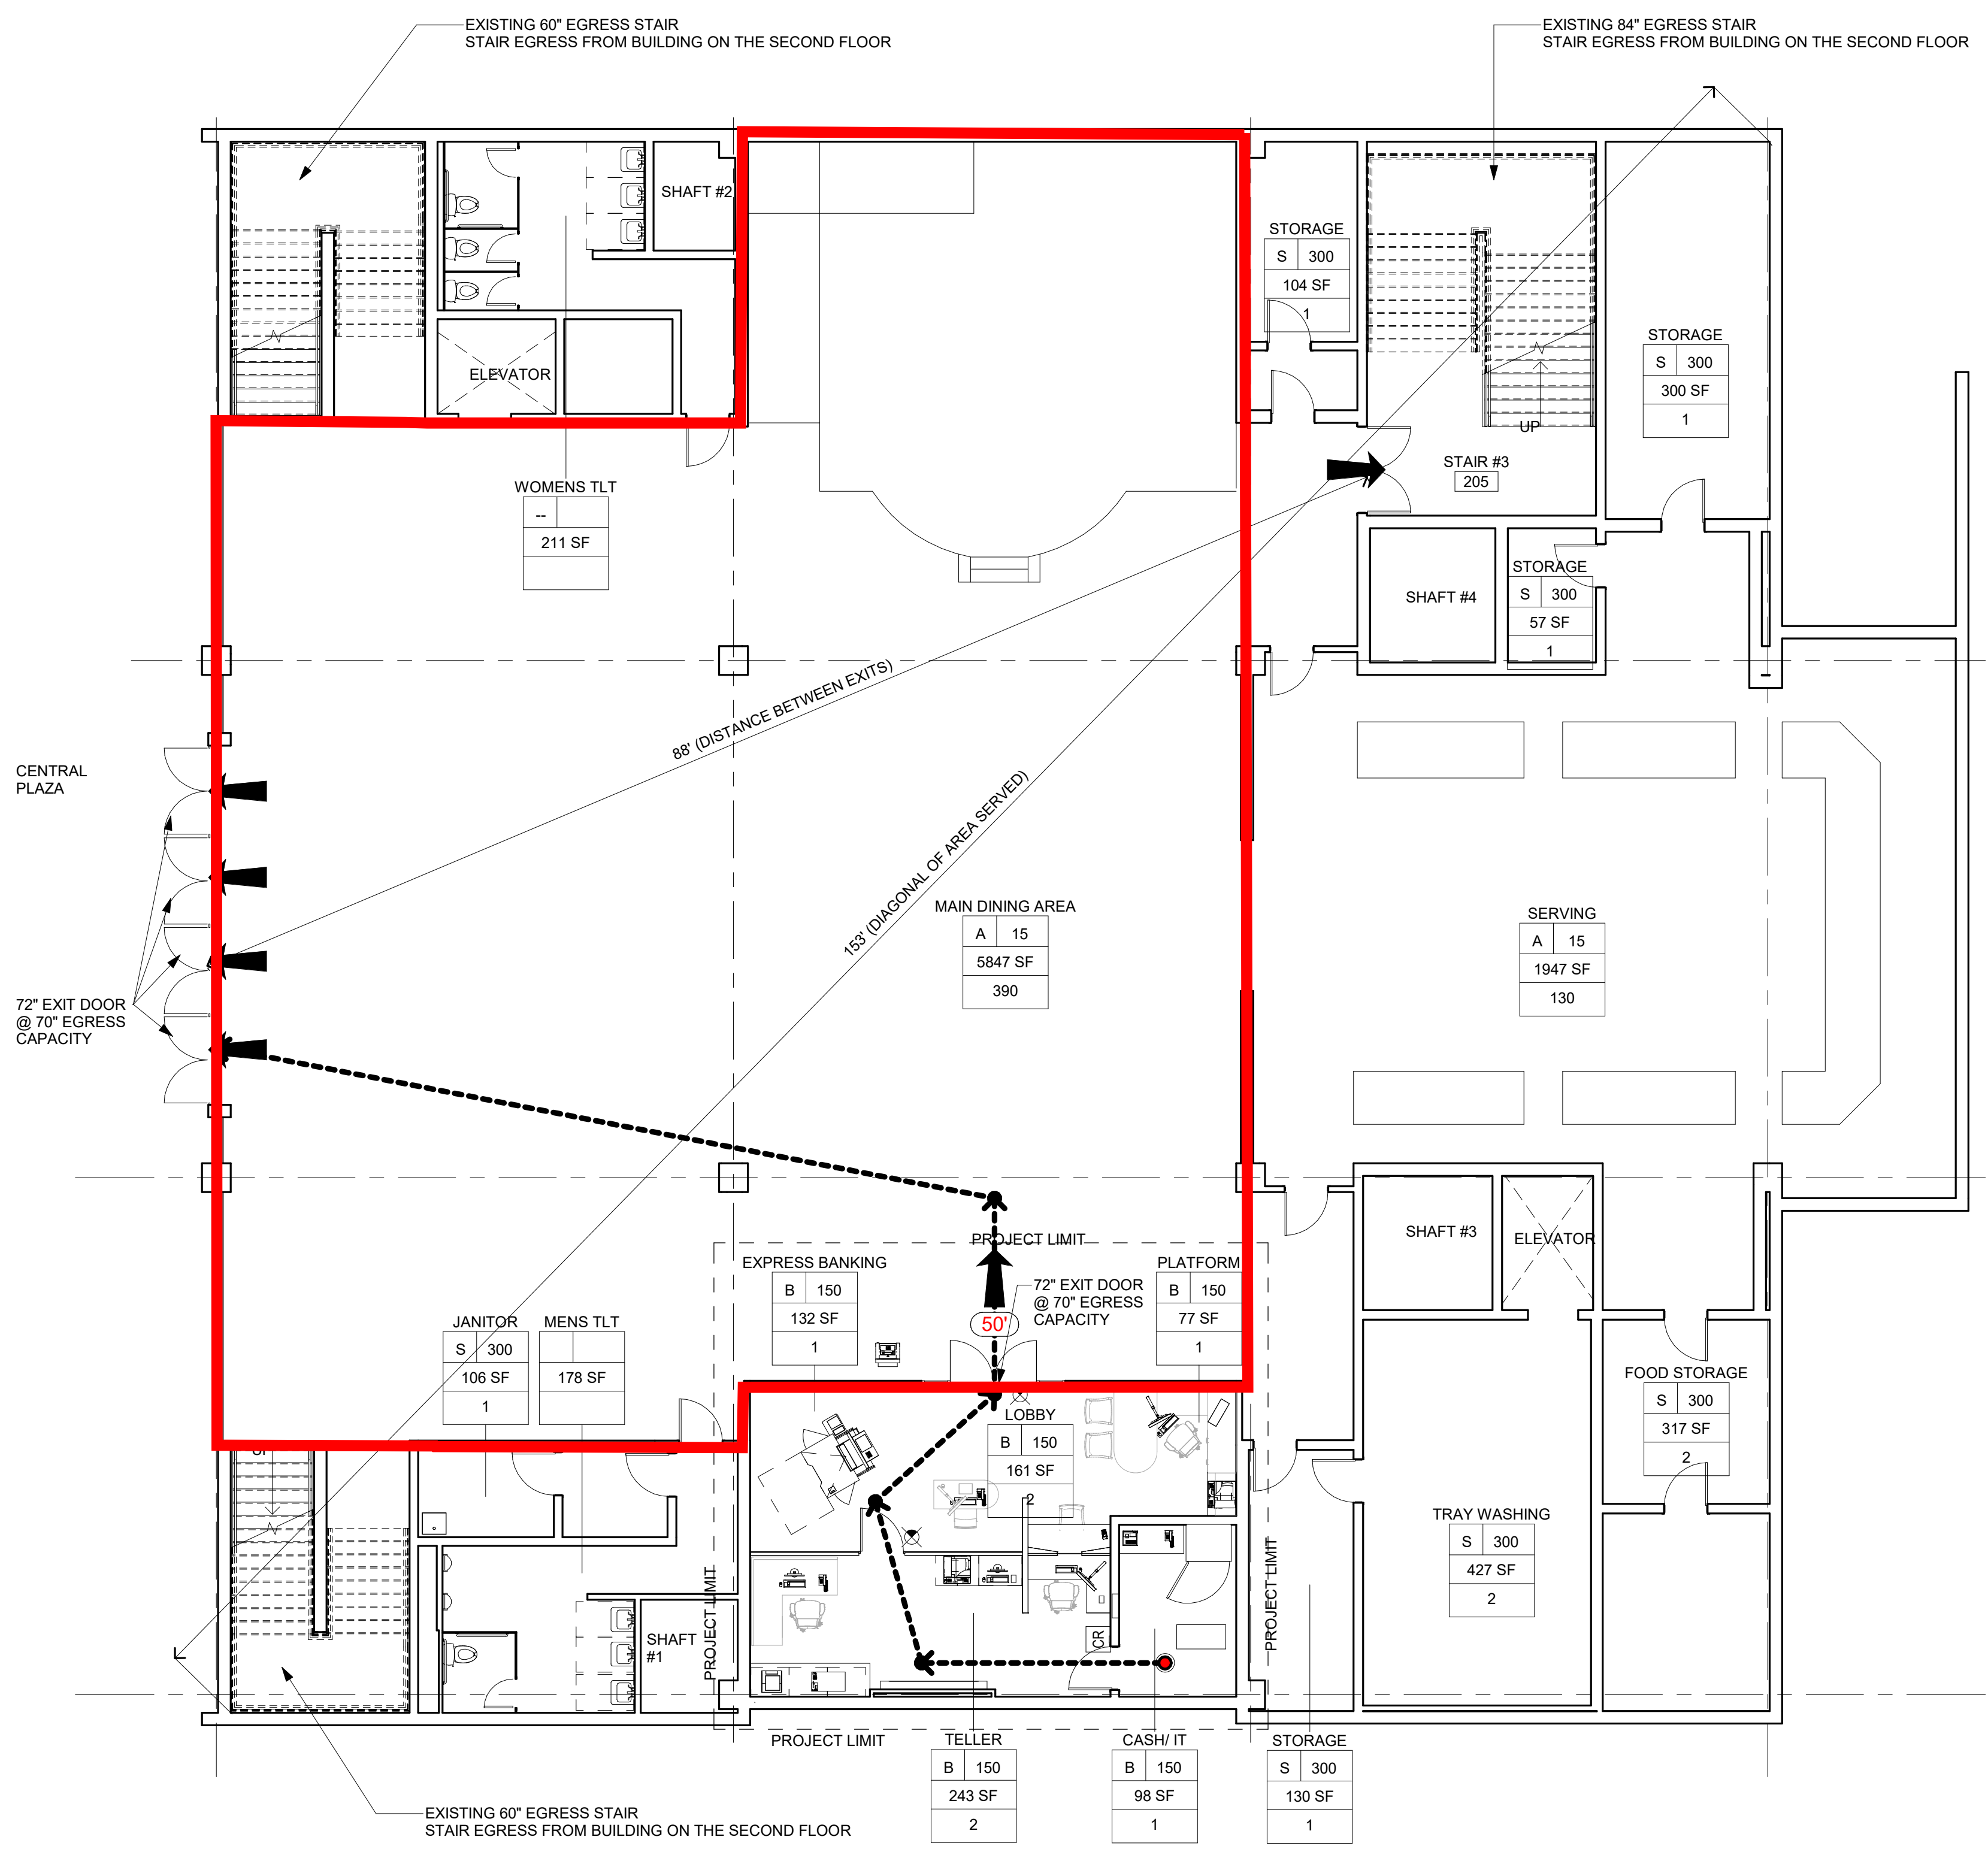

TRUE PLAN NORTH NORTH
 1 LIFE SAFETY PLAN
 1/8" = 1'-0"