

Addendum

Project Number

LGA Project No. 21074

Client / Project Title

A New School Facility: Horace Maynard Middle School

Addendum Number

Addendum 003

Date

Friday, June 14, 2024

Addendum Compiled By

Jake Thomas, Lewis Group Architects - JThomas@lewisgroup.net

Overview

To prime contractors and all others to whom drawings have been issued. Acknowledge receipt of this Addendum in the space provided on the Bid Form. Failure to do so may subject the Bidder to disqualification. This addendum forms a part of the Contract Documents dated 3/15/2024.

Prior Addenda

ADD 001 stamped 31May2024 (issued 03June2024) ADD 002 stamped 10June2024

This addendum supplements and modifies the Contract Documents as follows:

CLARIFICATIONS

1. There is no synthetic turf scheduled for this project.
2. An irrigation system is not required for this project.
3. The material and installation of natural grass sod for the baseball, softball, and football fields is by the G.C.
4. All (non-grass) landscaping will be furnished and installed by the Owner.
5. The new school shall be equipped with approved radio coverage for emergency responders in accordance with requirements set forth in IFC 510 as well as NFPA 1221. For the purposes of bidding, the electrical subcontractor shall include in the bid price an allowance of \$125,000 for a Distributed Antenna System (DAS). When building construction has progressed to the point where accurate testing of radio coverage can be accomplished, the electrical contractor shall arrange with the general contractor for a licensed DAS vendor to survey the site and finalize the specifics of the DAS installation, if it is determined during the survey that the DAS system is indeed required. An Allowance spec will be issued with ADD 004.

QUESTIONS

6. **Q1: Do we need to include the pricing for the full Fire Alarm system install or just the conduit, boxes, and pull string? Drawing E6.13 indicates that we only provide that, while the specs indicate that we need to carry the whole system, which one is correct?**
A1: A full fire alarm system is to be provided per contract electrical drawings and Division 28 specifications.
7. **Q2: Do we need to provide conduit for the entire Fire Alarm system, or can we use plenum rated cabling above accessible ceilings?**
A2: Refer to Note # 4 on all communications drawings which sets forth conduit and wiring requirements for all "low voltage" system wiring on the project, which includes fire alarm system wiring.
8. **Q3: Do we need to provide any electrical connections to the Propane Pad shown on drawing C401?**
A3: We will review and issue any clarifications that are needed as part of forthcoming ADD 004.
9. **Q4: Panel LC4 is not shown on the Riser Diagram but it is shown on drawing E2.13 in Media Storage Room B21d, is it fed from panel LCDP? There is a panel schedule for it. Please clarify.**
A4: See revised drawing E6.13.
10. **Q5: What size Hilti EZ Sleeves do we need to provide there is 2" and 4" shown on the detail on drawing E6.12, but there is no indication on the communication drawings on what size and where to install them? Please clarify.**
A5: See revised drawings E6.11 and E6.12.

CHANGES TO THE PROJECT MANUAL

1. **07 42 13 -Metal Wall Panels**
 - a. New spec section
1. **07 42 43 - Composite Metal Panels**
 - a. New spec section

CHANGES TO THE DRAWINGS

1. **COVER SHEET**
 - a. Updated to indicate revised drawings
2. **AS1.21 - SOUTH CANOPY PLANS & ELEVATIONS**
 - a. Drawings updated
3. **AS1.22 - SOUTH CANOPY DETAILS**
 - a. Drawings updated
4. **A2.11 - BUILDING ELEVATIONS - SOUTH**
 - a. Updated to clarify materials
5. **A2.12 - BUILDING ELEVATIONS - NORTH**
 - a. Updated to clarify materials
6. **A2.13 - BUILDING ELEVATIONS - EAST & WEST**
 - a. Updated to clarify materials
7. **A2.14 - BUILDING ELEVATIONS - HIDE**
 - a. Updated to clarify materials
8. **A2.21 - BUILDING ELEVATIONS - ENLARGED**
 - a. Updated to clarify materials
9. **A4.12 - WALL SECTIONS**
 - a. Updated to clarify materials
10. **A4.15 - WALL SECTIONS - ADMINISTRATION**
 - a. Drawings updated
11. **A4.16 - WALL SECTIONS - ADMINISTRATION**
 - a. Drawings updated
12. **A5.21 - ROOF DETAILS**
 - a. Detail updated
13. **A8.21 - HEAD, JAMB AND SILL DETAILS**
 - a. Details updated
14. **E1.12 - FIRST FLOOR PLAN - AREA 'B' - LIGHTING**
 - a. Ceiling updated
15. **E1.14 - SECOND FLOOR PLAN - AREA 'D' - LIGHTING**
 - a. Ceiling updated
16. **E1.16 - SECOND FLOOR PLAN - AREA 'F' - LIGHTING**
 - a. Ceiling updated
17. **E6.11 - LEGEND AND LIGHTING FIXTURE SCHEDULE**
 - a. See question 5
18. **E6.12 - DETAILS**
 - a. See question 5
19. **E6.13 - FEEDER DIAGRAM**
 - a. See question 4

ATTACHMENTS

- (02) Specification Sections
- (19) Drawing Sheets

END OF ADDENDUM / ATTACHMENTS FOLLOW



SECTION 07 42 43 – COMPOSITE METAL PANELS

PART 1 - GENERAL

1.1 RELATED DOCUMENTS

- A. Drawings and general provisions of the Contract, including General and Supplementary Conditions and Division 1 Specification Sections, apply to this Section.

1.2 SUMMARY

- A. This Section includes the following:
 - 1. Aluminum-faced composite wall panels (ACM).
- B. Related Sections include the following:
 - 1. Division 9 Section "Non-Structural Metal Framing" for secondary support framing supporting metal wall panels.
 - 2. Division 7 Section "Sheet Metal Flashing and Trim" for copings, flashings and other sheet metal work not part of metal wall panel assemblies.
 - 3. Division 7 Section "Joint Sealants" for field-applied sealants not otherwise specified in this Section.
 - 4. Division 6 Section "Rough Carpentry" for wood framing and substrates.

1.3 DEFINITIONS

- A. Metal Wall Panel Assembly: Metal wall panels, attachment system components, miscellaneous metal framing, thermal insulation, and accessories necessary for a complete weathertight system.
- B. Aluminum Sheet Thickness: Minimum thickness of base metal without metallic coatings or painted finishes.
- C. DBVR: Drained and back-ventilated rainscreen system; rainscreen system designed to drain and dry cavity entering water through drainage channels, weeps, and air ventilation.
- D. ACM: ACM cladding material formed by joining two thin (aluminum) metal skins to polyethylene or fire-retardant core and bonded under precise temperature, pressure, and tension.

1.4 SUBMITTALS

- A. Product Data: Include construction details, material descriptions, dimensions of individual components and profiles, and finishes for each type of metal wall panel and accessory.

- B. Shop Drawings: Show fabrication and installation layouts of metal wall panels; details of edge conditions, joints, panel profiles, corners, anchorages, attachment system, trim, flashings, closures, and accessories; and special details. Distinguish between factory- and field-assembled work.
 - 1. Accessories: Include details of the following items, at a scale of not less than 1-1/2"= 1' - 0".
 - a. Flashing and trim.
- C. Coordination Drawings: Exterior elevations drawn to scale and coordinating penetrations and wall-mounted items. Show the following:
 - 1. Wall panels and attachments.
 - 2. Girts, Stud framing.
 - 3. Wall-mounted items including doors, windows, louvers, and lighting fixtures.
- D. Samples for Initial Selection: For each type of metal wall panel indicated with factory-applied color finishes.
 - 1. Include similar Samples of trim and accessories involving color selection.
 - 2. Include manufacturer's color charts consisting of strips of cured sealants showing the full range of colors available for each sealant exposed to view.
- E. Samples for Verification: For each type of exposed finish required, prepared on Samples of size indicated below.
 - 1. Metal Wall Panels: two samples with formed edges, 12 inches long by 12 inches wide. Include fasteners, closures, and other metal wall panel accessories.
 - a. Include four-way joint for composite panels.
 - 2. Trim and Closures: 12 inches long. Include fasteners and other exposed accessories.
 - 3. Accessories: 12-inch long Samples for each type of accessory.
 - 4. Exposed Gaskets: 12 inches long.
 - 5. Exposed Sealants: For each type and color of joint sealant required. Install joint sealants in 1/2-inch wide joints formed between two 12-inch long strips of material matching the appearance of metal wall panels adjacent to joint sealants.
- F. Warranties: Special warranties specified in this Section.

1.5 QUALITY ASSURANCE

- A. Installer Qualifications: An employer of workers trained and approved by manufacturer.
- B. Installer Qualifications: Fabricator of aluminum-faced composite material wall panels.
 - 1. Installer's responsibilities include fabricating and installing metal wall panel assemblies and providing professional engineering services needed to assume engineering responsibility.
 - 2. Engineering Responsibility: Preparation of Shop Drawings and comprehensive engineering analysis by a qualified professional engineer.
- C. Fabricator Qualifications: Certified by metal-faced composite wall panel manufacturer to fabricate and install manufacturer's wall panel system.

- D. Source Limitations: Obtain each type of metal wall panel through one source from a single manufacturer.
- E. Product Options: Drawings indicate size, profiles, and dimensional requirements of metal wall panels. Refer to Division 1 Section "Product Requirements."
 - 1. Do not modify intended aesthetic effects, as judged solely by Architect, except with Architect's approval. If modifications are proposed, submit comprehensive explanatory data to Architect for review.
- F. Mockups: Build mockups to verify selections made under sample Submittals and to demonstrate aesthetic effects and qualities of materials and execution.
 - 1. Build mockup of typical wall panel, including soffit, as shown on Drawings; approximately 48 inches square by full thickness, including insulation, supports, attachments, and accessories.
 - a. Include four-way joint for metal-faced composite wall panels.
 - 2. Approval of mockups does not constitute approval of deviations from the Contract Documents contained in mockups unless such deviations are specifically approved by Architect in writing.
 - 3. Approved mockups may become part of the completed Work if undisturbed at time of Substantial Completion.
- G. Preinstallation Conference: Conduct conference at Project site. Review methods and procedures related to metal wall panel assemblies including, but not limited to, the following:
 - 1. Meet with Architect, panel Installer, metal wall panel manufacturer's representative, structural-support Installer, and installers whose work interfaces with or affects metal wall panels including installers of doors, windows, and louvers.
 - 2. Review and finalize construction schedule and verify availability of materials, Installer's personnel, equipment, and facilities needed to make progress and avoid delays.
 - 3. Review methods and procedures related to metal wall panel installation, including manufacturer's written instructions.
 - 4. Examine support conditions for compliance with requirements, including alignment between and attachment to structural members.
 - 5. Review flashings, special siding details, wall penetrations, openings, and condition of other construction that will affect metal wall panels.
 - 6. Review temporary protection requirements for metal wall panel assembly during and after installation.
 - 7. Review wall panel observation and repair procedures after metal wall panel installation.
 - 8. Document proceedings, including corrective measures and actions required, and furnish copy of record to each participant.

1.6 DELIVERY, STORAGE, AND HANDLING

- A. Deliver components, ACM panels, and other manufactured items so as not to be damaged or deformed. Package ACM panels for protection during transportation and handling.

- B. Unload, store, and erect ACM panels in a manner to prevent bending, warping, twisting, and surface damage.
- C. Stack ACM panels on platforms or pallets, covered with suitable weathertight and ventilated covering. Store ACM panels to ensure dryness, with positive slope for drainage of water. Do not store ACM panels in contact with other materials that might cause staining, denting, or other surface damage.
- D. Retain strippable protective covering on ACM panels during installation.

1.7 PROJECT CONDITIONS

- A. Weather Limitations: Proceed with installation only when existing and forecasted weather conditions permit assembly of metal wall panels to be performed according to manufacturers' written instructions and warranty requirements.
- B. Field Measurements: Verify locations of structural members and wall opening dimensions by field measurements before metal wall panel fabrication and indicate measurements on Shop Drawings.

1.8 COORDINATION

- A. Coordinate metal wall panel assemblies with rain drainage work, flashing, trim, and construction of wall framing including studs, other window wall, wall and soffit framing, and other adjoining work to provide a leakproof, secure, and noncorrosive installation.

1.9 WARRANTY

- A. Special Warranty: Manufacturer's standard form in which manufacturer agrees to repair or replace components of metal wall panel assemblies that fail in materials or workmanship within specified warranty period.
 - 1. Failures include, but are not limited to, the following:
 - a. Structural failures, including rupturing, cracking, or puncturing.
 - b. Failure of attachment to underlying framing.
 - c. Deterioration of metals, metal finishes, and other materials beyond normal weathering.
 - 2. Warranty Period: Ten years from date of Substantial Completion.
- B. Special Weathertightness Warranty: Manufacturer's standard form in which manufacturer agrees to repair or replace metal wall panel assemblies that fail to remain weathertight, including leaks, within specified warranty period.
 - a. Weathertight Warranty Period: 10 years from date of Substantial Completion.

PART 2 - PRODUCTS

2.1 PANEL MATERIALS

- A. Aluminum Sheet: Coil-coated sheet, ASTM B 209, alloy as standard with manufacturer, with temper as required to suit forming operations and structural performance required.

2.2 ALUMINUM FINISHES

- A. Exposed Panel Face Finish:
 - 1. General: Comply with NAAMM's "Metal Finishes Manual for Architectural and Metal Products" for recommendations for applying and designating finishes.
 - 2. Finish designations prefixed by AA comply with the system established by the Aluminum Association for designating aluminum finishes.
- B. Concealed Finish: Apply pretreatment and manufacturer's standard white or light-colored acrylic or polyester backer finish, consisting of prime coat and wash coat with a minimum total dry film thickness of 0.5 mil.

2.3 MANUFACTURERS

- A. Approved composite metal panel Manufacturers or equal as approved by Architect:
 - 1. Alucobond
 - 2. Reynobond
 - 3. Centria
 - 4. Other Manufacturers as approved by Architect
- B. Aluminum Extrusions: ASTM B 221, alloy and temper recommended by manufacturer for type of use and finish indicated.
- C. Panel Sealants:
 - 1. Sealant Tape: Pressure-sensitive, 100 percent solids, gray polyisobutylene compound sealant tape with release-paper backing. Provide permanently elastic, nonsag, nontoxic, nonstaining tape 1/2 inch wide and 1/8 inch thick.
 - 2. Joint Sealant: ASTM C 920; elastomeric polyurethane, polysulfide, or silicone sealant; of type, grade, class, and use classifications required to seal joints in metal wall panels and remain weathertight; and as recommended in writing by metal wall panel manufacturer.
 - 3. Butyl-Rubber-Based, Solvent-Release Sealant: ASTM C 1311.
 - 4. All exposed sealant colors to be selected by Architect from manufacturer's full range of colors.

2.4 SUBSTRATE BOARDS

- A. Glass-Mat Gypsum Sheathing Board: ASTM C 1177/C 1177M.
 - 1. Type and Thickness: Regular or Type X, 5/8 inch thick.
 - 2. Product: Subject to compliance with requirements, provide "Dens-Glass Gold" by Georgia-Pacific Corporation, or approved equal.
- B. Engineered wood substrate boards at canopy, refer to Section 06 10 00 "Rough Carpentry". Only fire-retardant wood is acceptable.

- C. Substrate-Board Fasteners: Factory-coated steel fasteners and metal or plastic plates complying with corrosion-resistance provisions in FMG 4470, designed for fastening substrate board to substrate.

2.5 ACM WALL PANELS

- A. ACM Wall Panel Systems: Provide factory-formed and -assembled, ACM wall panels fabricated from two metal facings that are bonded to a solid, extruded thermoplastic core; formed into profile for installation method indicated. Include attachment assembly components, panel stiffeners, and accessories required.

Basis-of-Design Product: Subject to compliance with requirements, provide; 3A Composites USA Inc.; Alucobond Plus FaceFastened System.

- B. Aluminum-Faced Composite Wall Panels: Formed with 0.020-inch- (0.50-mm-) thick, coil-coated aluminum sheet facings.
 - 1. Panel Thickness: 0.157 inch (4 mm).
 - 2. Core: Fire retardant.
 - 3. Exterior Finish: PVDF fluoropolymer.

Colors: Listed below as indicated on drawings.

- 1) ACM 1: Alucobond Brilliant Silver Metallic (or equal).
 - 2) ACM 2: Alucobond Greyhound (or equal).
 - 4. Peel Strength: 22.5 in-lb/in. (100 N x mm/mm) when tested for bond integrity in accordance with ASTM D1781.
 - 5. Fire Performance: Flame spread less than 25 and smoke developed less than 450, in accordance with ASTM E84.
- C. Attachment Assembly Components: Formed from 3A Composites NA Inc.
 - 1. Alucobond FaceFastened Joint-Rail
 - 2. Alucobond FaceFastened (Mid Start) Rail
 - 3. Alucobond FaceFastened Screw

2.6 MISCELLANEOUS MATERIALS

- A. Miscellaneous Metal Subframing and Furring: ASTM C645, cold-formed, metallic-coated steel sheet ASTM A653/A653M, G90 (Z275 hot-dip galvanized) coating designation or ASTM A792/A792M, Class AZ50 (Class AZM150) aluminum-zinc-alloy coating designation unless otherwise indicated. Provide Fabricator's standard sections as required for support and alignment of MCM panel system.
- B. Panel Accessories: Provide components required for a complete, weathertight panel system including trim, copings, fasciae, mullions, sills, corner units, clips, flashings, sealants, gaskets, fillers, closure strips, and similar items. Match material and finish of ACM panels unless otherwise indicated.

- C. Flashing and Trim: Provide flashing and trim formed from same material as ACM panels as required to seal against weather and to provide finished appearance. Locations include, but are not limited to, bases, drips, sills, jambs, corners, endwalls, framed openings, rakes, fasciae, parapet caps, soffits, reveals, and fillers. Finish flashing and trim with same finish system as adjacent ACM panels.
 - 1. Basis-of-Design Product: Subject to compliance with requirements, provide Alucobond 3A Composites USA Inc.; Alucobond Axcen™ Trim or approved equal.
 - 2. Color: Matching the adjacent panel color.
- D. Panel Fasteners: Utilize ALUCOBOND FaceFastened Screw supplied by 3A Composites NA Inc. Screws are painted to match panel color.
- E. Panel Sealants: ASTM C920; elastomeric polyurethane or silicone sealant; of type, grade, class, and use classifications required to seal joints in ACM panels and remain weathertight; and as recommended in writing by ACM panel manufacturer.

2.7 FABRICATION

- A. General: Fabricate and finish ACM panels and accessories at the factory, by manufacturer's standard procedures and processes, as necessary to fulfill indicated performance requirements demonstrated by laboratory testing. Comply with indicated profiles and with dimensional and structural requirements.
- B. Panel Edge Treatment: Rout and fold the front edge of the panel over fire rated core per manufacturers recommendations.
- C. Sheet Metal Flashing and Trim: Fabricate flashing and trim to comply with manufacturer's recommendations or recommendations in SMACNA's "Architectural Sheet Metal Manual" that apply to design, dimensions, metal, and other characteristics of item indicated.
 - 1. Form exposed sheet metal accessories that are without excessive oil canning, buckling, and tool marks and that are true to line and levels indicated, with exposed edges folded back to form hems.
 - 2. Seams for Aluminum: Fabricate nonmoving seams with flat-lock seams. Form seams and seal with epoxy seam sealer. Rivet joints for additional strength.
 - 3. Seams for Other Than Aluminum: Fabricate nonmoving seams in accessories with flat-lock seams. Tin edges to be seamed, form seams, and solder.
 - 4. Sealed Joints: Form non-expansion, but movable, joints in metal to accommodate sealant and to comply with SMACNA standards.
 - 5. Conceal fasteners and expansion provisions where possible. Exposed fasteners are not allowed on faces of accessories exposed to view.
 - 6. Fabricate cleats and attachment devices from same material as accessory being anchored or from compatible, noncorrosive metal recommended in writing by metal panel manufacturer.
 - a. Size: As recommended by SMACNA's "Architectural Sheet Metal Manual" or metal wall panel manufacturer for application but not less than thickness of metal being secured.

2.8 FINISHES

- A. Protect mechanical and painted finishes on exposed surfaces from damage by applying a strippable, temporary protective covering before shipping.
- B. Appearance of Finished Work: Variations in appearance of abutting or adjacent pieces are acceptable if they are within one-half of the range of approved Samples. Noticeable variations in same piece are not acceptable. Variations in appearance of other components are acceptable if they are within the range of approved Samples and are assembled or installed to minimize contrast.
- C. Aluminum Panels and Accessories:
 - 1. PVDF Fluoropolymer: AAMA 2605. Fluoropolymer finish containing not less than 70 percent PVDF resin by weight in color coat. Prepare, pretreat, and apply coating to exposed metal surfaces to comply with coating and resin manufacturers' written instructions.

PART 3 - EXECUTION

3.1 EXAMINATION

- A. Examine substrates, areas, and conditions, with Installer present, for compliance with requirements for installation tolerances, ACM panel supports, and other conditions affecting performance of the Work.
 - 1. Examine wall framing to verify that girts, angles, channels, studs, and other structural panel support members and anchorage have been installed within alignment tolerances required by ACM wall panel manufacturer.
 - 2. Examine wall sheathing to verify that sheathing joints are supported by framing or blocking and that installation is within flatness tolerances required by ACM wall panel manufacturer.
 - a. Verify that air- or water-resistive barriers have been installed over sheathing or backing substrate to prevent air infiltration or water penetration.
- B. Examine roughing-in for components and assemblies penetrating ACM panels to verify actual locations of penetrations relative to seam locations of ACM panels before installation.
- C. Proceed with installation only after unsatisfactory conditions have been corrected.

3.2 PREPARATION

- A. Miscellaneous Supports: Install sub-framing, furring, and other miscellaneous panel support members and anchorages in accordance with ASTM C754 and ACM panel manufacturer's written recommendations.

3.3 ACM PANEL INSTALLATION

- A. General: Install ACM panels in accordance with Fabricator's written instructions in orientation, sizes, and locations indicated on Drawings. Install panels perpendicular to supports unless otherwise indicated. Anchor ACM panels and other components of the Work securely in place, with provisions for thermal and structural movement.
1. Shim or otherwise plumb substrates receiving ACM panels.
 2. Flash ACM panels at perimeter of all openings. Fasten with self-tapping screws. Do not begin installation until air- or water-resistive barriers and flashings that will be concealed by ACM panels are installed.
 3. Install screw fasteners in predrilled holes.
 4. Locate and space fastenings in uniform vertical and horizontal alignment.
 5. Install flashing and trim as ACM panel work proceeds.
 6. Locate panel splices over, but not attached to, structural supports. Stagger panel splices and end laps to avoid a four-panel lap splice condition.
 7. Align bottoms of ACM panels and fasten with blind rivets, bolts, or self-tapping screws. Fasten flashings and trim around openings and similar elements with self-tapping screws.
 8. Provide weathertight escutcheons for pipe- and conduit-penetrating panels.
- B. Metal Protection: Where dissimilar metals contact each other or corrosive substrates, protect against galvanic action as recommended in writing by ACM panel manufacturer.
- C. Attachment Assembly, General: Install attachment assembly required to support ACM wall panels and to provide a complete wall system, including subgirts, perimeter extrusions, tracks, drainage channels, panel clips, and anchor channels.
1. Include attachment to supports, panel-to-panel joinery, panel-to-dissimilar-material joinery, and panel-system joint seals.
- D. Panel Installation: Attach ACM wall panels to supports at locations, spacings, and with manufacturer's approve screws to achieve performance requirements specified.
1. Face Fastened System: Attach ACM wall panels by inserting horizontal support pins into notches in vertical channels and into flanges of panels. Leave horizontal and vertical joints with open reveal.
 - a. Space, locate, align, and fasten manufacturer's Joint-Rail and Mid/End Rail over gypsum sheathing after application of air barrier as specified by Section 07 27 26.
 - b. Install fasteners in lengths and locations required in order to penetrate hat channels and structural metal wall framing in accordance with fastener manufacturers' instructions.
 - c. Torque screws as necessary for a snug fit. Do not over-torque; prevent 'oil canning' of panels.
 - d. Install wall panels to allow individual panels expand and contract and be installed and removed without disturbing adjacent panels.

- E. Accessory Installation: Install accessories with positive anchorage to building and weathertight mounting, and provide for thermal expansion. Coordinate installation with flashings and other components.
 - 1. Install components required for a complete ACM panel assembly including trim, copings, corners, seam covers, flashings, sealants, gaskets, fillers, closure strips, and similar items. Provide types indicated by ACM panel Fabricator; or, if not indicated, provide types recommended in writing by ACM system Fabricator.
- F. Flashing and Trim: Comply with performance requirements, manufacturer's written installation instructions, or SMACNA's "Architectural Sheet Metal Manual." Provide concealed fasteners where possible, and set units true to line and level as indicated. Install work with laps, joints, and seams that are permanently watertight.
 - 1. Install exposed flashing and trim that is without buckling and tool marks and that is true to line and levels indicated, with exposed edges folded back to form hems. Install sheet metal flashing and trim to fit substrates and to result in waterproof performance.
 - 2. Expansion Provisions: Provide for thermal expansion of exposed flashing and trim. Space movement joints at a maximum of 10 feet (3 m) with no joints allowed within 24 inches (605 mm) of corner or intersection. Where lapped expansion provisions cannot be used or would not be sufficiently waterproof, form expansion joints of intermeshing hooked flanges, not less than 1 inch (25 mm) deep, filled with mastic sealant (concealed within joints).

3.4 ERECTION TOLERANCES

- A. Site Verifications of Conditions:
 - 1. Verify conditions of substrate previously installed under other Sections are acceptable for the ACM system installation. Provide documentation indicating detrimental conditions to the ACM system performance.
 - 2. Once conditions are verified, ACM system installation tolerances are as follows:
 - a. Shim and align MCM wall panel units within installed tolerance of 1/4 inch in 20 feet (6 mm in 6 m), non-accumulative, on level, plumb, and location lines as indicated, and within 1/8-inch (3-mm) offset of adjoining faces and of alignment of matching profiles.

3.5 FIELD QUALITY CONTROL

- A. Water-Spray Test: After installation, test area of assembly as directed by Architect for water penetration in accordance with AAMA 501.2.
- B. Fabricator's Field Service: Engage a factory-authorized service representative to test and inspect completed ACM wall panel installation, including accessories.
- C. ACM wall panels will be considered defective if they do not pass test and inspections.

- D. Additional tests and inspections, at Contractor's expense, are performed to determine compliance of replaced or additional work with specified requirements.
- E. Prepare test and inspection reports.

3.6 CLEANING AND PROTECTION

- A. Remove temporary protective coverings and strippable films, if any, as ACM panels are installed, unless otherwise indicated in manufacturer's written installation instructions. On completion of ACM panel installation, clean finished surfaces as recommended by ACM panel manufacturer. Maintain a clean condition during construction.
- B. After ACM panel installation, clear weep holes and drainage channels of obstructions, dirt, and sealant.
- C. Replace ACM panels that have been damaged or have deteriorated beyond successful repair by finish touchup or similar minor repair procedures.

END OF SECTION 07 42 43

SECTION 07 42 13 – METAL WALL PANELS

PART 1 - GENERAL

1.1 RELATED DOCUMENTS

- A. Drawings and general provisions of the Contract, including General and Supplementary Conditions and Division 01 Specification Sections, apply to this Section.

1.2 SUMMARY

- A. Section Includes:
 - 1. Concealed-fastener, lap-seam metal wall panels.
- B. Related Sections:
 - 1. Division 05 Section "Cold-Formed Metal Framing" for support framing, including girts, studs, and bracing.
 - 2. Division 07 Section "Air Barriers" for continuous air barrier systems.
 - 3. Division 07 Section "Sheet Metal Flashing and Trim" for flashing and other sheet metal work that is not part of metal wall panel assemblies.

1.3 DEFINITION

- A. Metal Wall Panel Assembly: Metal wall panels, attachment system components, miscellaneous metal framing, thermal insulation, and accessories necessary for a complete weather-tight wall system.

1.4 PERFORMANCE REQUIREMENTS

- A. General Performance: Metal wall panel assemblies shall comply with performance requirements without failure due to defective manufacture, fabrication, installation, or other defects in construction.
- B. Delegated Design: Design metal wall panel assembly, including comprehensive engineering analysis by a qualified professional engineer, using performance requirements and design criteria indicated.
- C. Air Infiltration: Air leakage through assembly of not more than 0.06 cfm/sq. ft. (0.3 L/s per sq. m) of wall area when tested according to ASTM E 283 at the following test-pressure difference:
 - 1. Test-Pressure Difference: 1.57 lbf/sq. ft. (75 Pa).
- D. Water Penetration under Static Pressure: No water penetration when tested according to ASTM E 331 at the following test-pressure difference:
 - 1. Test-Pressure Difference: 6.24 lbf/sq. ft. (300 Pa).

- E. Structural Performance: Provide metal wall panel assemblies capable of withstanding the effects the following loads and stresses within limits and under conditions indicated, based on testing according to ASTM E 1592:
 - 1. Wind Loads: Determine loads based on the following minimum design wind pressures:
 - a. Uniform pressure of 20 lbf/sq. ft. (957 Pa), acting inward or outward.
 - 2. Deflection Limits: Metal wall panel assemblies shall withstand wind loads with horizontal deflections no greater than 1/180 of the span.
- F. Thermal Movements: Allow for thermal movements from ambient and surface temperature changes by preventing buckling, opening of joints, overstressing of components, failure of joint sealants, failure of connections, and other detrimental effects. Base calculations on surface temperatures of materials due to both solar heat gain and nighttime-sky heat loss.
 - 1. Temperature Change (Range): 120 deg F (67 deg C), ambient; 180 deg F (100 deg C), material surfaces.

1.5 SUBMITTALS

- A. Product Data: For each type of product indicated. Include construction details, material descriptions, dimensions of individual components and profiles, and finishes for each type of wall panel and accessory.
- B. Shop Drawings: Show fabrication and installation layouts of metal wall panels; details of edge conditions, joints, panel profiles, corners, anchorages, attachment system, trim, flashings, closures, and accessories; and special details. Distinguish between factory-, shop- and field-assembled work.
 - 1. Accessories: Include details of the following items, at a scale of not less than 1-1/2 inches = 1'-0":
 - a. Flashing and trim.
 - b. Anchorage systems.
- C. Samples for Verification: For each type of exposed finish required, prepared on Samples of size indicated below.
 - 1. Metal Wall Panels: 12 inches (305 mm) long by actual panel width. Include fasteners, closures, and other metal wall panel accessories.
 - 2. Trim and Closures: 12 inches (305 mm) long. Include fasteners and other exposed accessories.
 - 3. Accessories: 12-inch- (305-mm-) long Samples for each type of accessory.
- D. Qualification Data: For Installer, professional engineer and testing agency.
- E. Product Test Reports: Based on evaluation of comprehensive tests performed by a qualified testing agency, for each product.
- F. Maintenance Data: For metal wall panels to include in maintenance manuals.
- G. Warranties: Sample of special warranties.

1.6 QUALITY ASSURANCE

- A. Installer Qualifications: An employer of workers trained and approved by manufacturer.
- B. Testing Agency Qualifications: Qualified according to ASTM E 329 for testing indicated.
- C. Source Limitations: Obtain each type of metal wall panel from single source from single manufacturer.
- D. Fire-Resistance Ratings: Where indicated, provide metal wall panels identical to those of assemblies tested for fire resistance per ASTM E 119 by a qualified testing agency. Identify products with appropriate markings of applicable testing agency.
 - 1. Indicate design designations from UL's "Fire Resistance Directory" or from the listings of another qualified testing agency.
- E. Mockups: Build mockups to verify selections made under sample submittals and to demonstrate aesthetic effects and set quality standards for fabrication and installation.
 - 1. Construct a mock-up wall incorporating the information, materials, and extents identified by the Architect which shall include in addition to the items listed above typical brick conditions, metal wall paneling, storefront system, composite metal panels, glazing, and sills.
 - a. Location and Orientation: As directed by Architect not interfering with construction activity.
 - b. Wall size: 8'-0" tall x 8'-0" wide
 - c. Colors and Finishes: As specified or selected by Architect for this project.
 - 2. Build mockup of typical wall panel condition, including insulation, supports, attachments, and accessories.
 - 3. Conduct water spray test of mockup of metal wall panel assembly, testing for water penetration according to AAMA 501.2.
 - 4. Approval of mockups does not constitute approval of deviations from the Contract Documents contained in mockups unless Architect specifically approves such deviations in writing.
 - 5. Approved mockups may become part of the completed Work if undisturbed at time of Substantial Completion.
- F. Preinstallation Conference: Conduct conference at Project site.
 - 1. Meet with Owner, Architect, Owner's insurer if applicable, testing and inspecting agency representative, metal wall panel Installer, metal wall panel manufacturer's representative, structural-support Installer, and installers whose work interfaces with or affects metal wall panels, including installers of doors, windows, and louvers.
 - 2. Review and finalize construction schedule and verify availability of materials, Installer's personnel, equipment, and facilities needed to make progress and avoid delays.
 - 3. Review methods and procedures related to metal wall panel installation, including manufacturer's written instructions.
 - 4. Examine support conditions for compliance with requirements, including alignment between and attachment to structural members.
 - 5. Review flashings, special siding details, wall penetrations, openings, and condition of other construction that will affect metal wall panels.

6. Review governing regulations and requirements for insurance, certificates, and tests and inspections if applicable.
7. Review temporary protection requirements for metal wall panel assembly during and after installation.
8. Review wall panel observation and repair procedures after metal wall panel installation.

1.7 DELIVERY, STORAGE, AND HANDLING

- A. Deliver components, sheets, metal wall panels, and other manufactured items so as not to be damaged or deformed. Package metal wall panels for protection during transportation and handling.
- B. Unload, store, and erect metal wall panels in a manner to prevent bending, warping, twisting, and surface damage.
- C. Stack metal wall panels horizontally on platforms or pallets, covered with suitable weather-tight and ventilated covering. Store metal wall panels to ensure dryness, with positive slope for drainage of water. Do not store metal wall panels in contact with other materials that might cause staining, denting, or other surface damage.
- D. Retain strippable protective covering on metal wall panel for period of metal wall panel installation.

1.8 PROJECT CONDITIONS

- A. Weather Limitations: Proceed with installation only when existing and forecasted weather conditions permit assembly of metal wall panels to be performed according to manufacturers' written instructions and warranty requirements.
- B. Field Measurements: Verify locations of structural members and wall opening dimensions by field measurements before metal wall panel fabrication, and indicate measurements on Shop Drawings.

1.9 COORDINATION

- A. Coordinate metal wall panel assemblies with rain drainage work, flashing, trim, and construction of studs, soffits, and other adjoining work to provide a leakproof, secure, and noncorrosive installation.

1.10 WARRANTY

- A. Special Warranty: Manufacturer's standard form in which manufacturer agrees to repair or replace components of metal wall panel assemblies that fail in materials or workmanship within specified warranty period.
 1. Failures include, but are not limited to, the following:
 - a. Structural failures including rupturing, cracking, or puncturing.

- b. Deterioration of metals and other materials beyond normal weathering.
 2. Warranty Period: Two years from date of Substantial Completion.
- B. Special Warranty on Panel Finishes: Manufacturer's standard form in which manufacturer agrees to repair finish or replace metal wall panels that show evidence of deterioration of factory-applied finishes within specified warranty period.
 1. Exposed Panel Finish: Deterioration includes, but is not limited to, the following:
 - a. Color fading more than 5 Hunter units when tested according to ASTM D 2244.
 - b. Chalking in excess of a No. 8 rating when tested according to ASTM D 4214.
 - c. Cracking, checking, peeling, or failure of paint to adhere to bare metal.
 2. Finish Warranty Period: 20 years from date of Substantial Completion.

PART 2 - PRODUCTS

2.1 PANEL MATERIALS

- A. Metallic-Coated Steel Sheet: Restricted flatness steel sheet metallic coated by the hot-dip process and prepainted by the coil-coating process to comply with ASTM A 755/A 755M.
 1. Aluminum-Zinc Alloy-Coated Steel Sheet: ASTM A 792/A 792M, Class AZ50 coating designation, Grade 40; structural quality.
 2. Surface: Smooth, flat finish.
 3. Exposed Coil-Coated Finish:
 - a. Exterior finish: Kynar 500 or Hylar 5000 fluorocarbon coating with a top side film thickness of 0.70 to 0.90 mil over 0.25 to 0.31 mil prime coat to provide a total dry film thickness of 0.95 to 1.25 mil. Bottom side shall be coated with a primer with a dry film thickness of 0.25 mil. Finish shall conform to all tests for adhesion, flexibility, and longevity as specified by the finish supplier.
 4. Concealed Finish: Apply pretreatment and manufacturer's standard white or light-colored acrylic or polyester backer finish consisting of prime coat and wash coat with a minimum total dry film thickness of 0.5 mil (0.013 mm).

2.2 FIELD-INSTALLED THERMAL INSULATION

- A. Refer to Division 07 Section "Thermal Insulation."

2.3 MISCELLANEOUS MATERIALS

- A. Panel Fasteners: Self-tapping screws, bolts, nuts, self-locking rivets and bolts, end-welded studs, and other suitable fasteners designed to withstand design loads. Provide exposed fasteners with heads matching color of metal wall panels by means of plastic caps or factory-applied coating. Provide EPDM, PVC, or neoprene sealing washers.

2.4 METAL WALL PANELS

- A. General: Provide factory-formed metal wall panels designed to be field assembled by lapping and interconnecting side edges of adjacent panels and mechanically attaching through panel to supports using concealed fasteners and factory-applied sealant in side laps. Include accessories required for weather-tight installation.
- B. Metal Wall Panel: Concealed-Fastener Metal Wall Panels, basis of design product is Petersen Aluminum Pac-Clad 16-inch "HWP Panel". Horizontal installation.
 - 1. Other Manufacturers: Subject to compliance with requirements, provide products by one of the following:
 - a. Centria.
 - b. Morin, a Kingspan Group Company.
 - c. Berridge Manufacturing Company.
 - 2. Material: Aluminum-zinc alloy-coated steel sheet.
 - a. Exterior Finish: Manufacturer's standard Kynar 500 coating.
 - b. Color: Pac-Clad "Charcoal" (or selected manufacturer's equal).
 - c. Panel Coverage: 16 inches, nominal.
 - d. 24-gauge panel, smooth finish (no stiffener beads).
 - e. 7/8" panel depth.
 - 3. Refer to drawings for locations.

2.5 ACCESSORIES:

- A. Wall Panel Accessories: Provide components required for a complete metal wall panel assembly including trim, copings, fasciae, mullions, sills, corner units, clips, flashings, sealants, gaskets, fillers, closure strips, and similar items. Match material and finish of metal wall panels, unless otherwise indicated.
 - 1. Closures: Provide closures at eaves and rakes, fabricated of same metal as metal wall panels.
 - 2. Backing Plates: Provide metal backing plates at panel end splices, fabricated from material recommended by manufacturer.
 - 3. Closure Strips: Closed-cell, expanded, cellular, rubber or crosslinked, polyolefin-foam or closed-cell laminated polyethylene; minimum 1-inch- (25-mm-) thick, flexible closure strips; cut or premolded to match metal wall panel profile. Provide closure strips where indicated or necessary to ensure weathertight construction.
- B. Flashing and Trim: Formed from 0.018-inch (0.46-mm) minimum thickness, zinc-coated (galvanized) steel sheet or aluminum-zinc alloy-coated steel sheet prepainted with coil coating. Provide flashing and trim as required to seal against weather and to provide finished appearance. Locations include, but are not limited to, bases, drips, sills, jambs, corners, endwalls, framed openings, rakes, fasciae, parapet caps, soffits, reveals, and fillers. Finish flashing and trim with same finish system as adjacent metal wall panels.

2.6 FABRICATION

- A. General: Fabricate and finish metal wall panels and accessories at the factory to greatest extent possible, by manufacturer's standard procedures and processes, as

necessary to fulfill indicated performance requirements demonstrated by laboratory testing. Comply with indicated profiles and with dimensional and structural requirements.

- B. Fabricate metal wall panels in a manner that eliminates condensation on interior side of panel and with joints between panels designed to form weathertight seals.
- C. Provide panel profile for full length of panel.
- D. Fabricate metal wall panel joints with factory-installed captive gaskets or separator strips that provide a tight seal and prevent metal-to-metal contact, and that will minimize noise from movements within panel assembly.
- E. Sheet Metal Accessories: Fabricate flashing and trim to comply with recommendations in SMACNA's "Architectural Sheet Metal Manual" that apply to the design, dimensions, metal, and other characteristics of item indicated.
 - 1. Form exposed sheet metal accessories that are without excessive oil canning, buckling, and tool marks and that are true to line and levels indicated, with exposed edges folded back to form hems.
 - 2. Seams for Metals Other Than Aluminum: Fabricate nonmoving seams in accessories with flat-lock seams. Tin edges to be seamed, form seams, and solder.
 - 3. Sealed Joints: Form nonexpansion but movable joints in metal to accommodate elastomeric sealant to comply with SMACNA standards.
 - 4. Conceal fasteners and expansion provisions where possible. Exposed fasteners are not allowed on faces of accessories exposed to view.
 - 5. Fabricate cleats and attachment devices from same material as accessory being anchored or from compatible, noncorrosive metal recommended by metal wall panel manufacturer.
 - a. Size: As recommended by SMACNA's "Architectural Sheet Metal Manual" or metal wall panel manufacturer for application but not less than thickness of metal being secured.

2.7 GENERAL FINISH REQUIREMENTS

- A. Comply with NAAMM's "Metal Finishes Manual for Architectural and Metal Products" for recommendations for applying and designating finishes.
- B. Protect mechanical and painted finishes on exposed surfaces from damage by applying a strippable, temporary protective covering before shipping.
- C. Appearance of Finished Work: Variations in appearance of abutting or adjacent pieces are acceptable if they are within one-half of the range of approved Samples. Noticeable variations in the same piece are not acceptable. Variations in appearance of other components are acceptable if they are within the range of approved Samples and are assembled or installed to minimize contrast.

PART 3 - EXECUTION

3.1 EXAMINATION

- A. Examine substrates, areas, and conditions, with Installer present, for compliance with requirements for installation tolerances, metal wall panel supports, and other conditions affecting performance of work.
 - 1. Examine wall framing to verify that girts, angles, channels, studs, and other structural panel support members and anchorage have been installed within alignment tolerances required by metal wall panel manufacturer.
 - 2. Examine wall sheathing to verify that sheathing joints are supported by framing or blocking and that installation is within flatness tolerances required by metal wall panel manufacturer.
 - 3. Verify that weather-resistant sheathing paper has been installed over sheathing or backing substrate to prevent air infiltration or water penetration.
 - 4. For the record, prepare written report, endorsed by Installer, listing conditions detrimental to performance of work.
- B. Examine roughing-in for components and systems penetrating metal wall panels to verify actual locations of penetrations relative to seam locations of metal wall panels before metal wall panel installation.
- C. Proceed with installation only after unsatisfactory conditions have been corrected.

3.2 METAL WALL PANEL INSTALLATION

- A. General: Install metal wall panels according to manufacturer's written instructions in orientation, sizes, and locations indicated on Drawings. Install panels perpendicular to girts and subgirts unless otherwise indicated. Anchor metal wall panels and other components of the Work securely in place, with provisions for thermal and structural movement.
 - 1. Commence metal wall panel installation and install minimum of 300 sq. ft. in presence of factory-authorized representative.
 - 2. Shim or otherwise plumb substrates receiving metal wall panels.
 - 3. Flash and seal metal wall panels at perimeter of all openings. Fasten with self-tapping screws. Do not begin installation until weather barrier and flashings that will be concealed by metal wall panels are installed.
 - 4. Install screw fasteners in predrilled holes.
 - 5. Locate and space fastenings in uniform vertical and horizontal alignment.
 - 6. Install flashing and trim as metal wall panel work proceeds.
 - 7. Locate panel splices over, but not attached to, structural supports. Stagger panel splices and end laps to avoid a four-panel lap splice condition.
 - 8. Apply elastomeric sealant continuously between metal base channel (sill angle) and concrete and elsewhere as indicated or, if not indicated, as necessary for waterproofing.
 - 9. Align bottom of metal wall panels and fasten with blind rivets, bolts, or self-tapping screws. Fasten flashings and trim around openings and similar elements with self-tapping screws.
 - 10. Provide weathertight escutcheons for pipe and conduit penetrating exterior walls.
- B. Fasteners:

1. Steel Wall Panels: Use stainless-steel fasteners for surfaces exposed to the exterior; use galvanized steel fasteners for surfaces exposed to the interior.
- C. Metal Protection: Where dissimilar metals will contact each other or corrosive substrates, protect against galvanic action as recommended by metal wall panel manufacturer.
- D. Joint Sealers: Install gaskets, joint fillers, and sealants where indicated and where required for weathertight performance of metal wall panel assemblies. Provide types of gaskets, fillers, and sealants indicated or, if not indicated, types recommended by metal wall panel manufacturer.
 1. Seal metal wall panel end laps with double beads of tape or sealant, full width of panel. Seal side joints where recommended by metal wall panel manufacturer.
 2. Prepare joints and apply sealants to comply with requirements in Division 07 Section "Joint Sealants."
- E. Lap-Seam Metal Wall Panels: Fasten metal wall panels to supports with fasteners at each lapped joint at location and spacing recommended by manufacturer.
 1. Lap ribbed or fluted sheets one full rib corrugation. Apply panels and associated items for neat and weathertight enclosure. Avoid "panel creep" or application not true to line.
 2. Provide metal-backed washers under heads of exposed fasteners bearing on weather side of metal wall panels.
 3. Locate and space exposed fasteners in uniform vertical and horizontal alignment. Use proper tools to obtain controlled uniform compression for positive seal without rupture of washer.
 4. Install screw fasteners with power tools having controlled torque adjusted to compress washer tightly without damage to washer, screw threads, or panels. Install screws in predrilled holes.
 5. Provide sealant tape at lapped joints of metal wall panels and between panels and protruding equipment, vents, and accessories.
 6. Apply a continuous ribbon of sealant tape to weather-side surface of fastenings on end laps; on side laps of nesting-type panels; on side laps of corrugated nesting-type, ribbed, or fluted panels; and elsewhere as needed to make panels weathertight.
 7. At panel splices, nest panels with minimum 6-inch (152-mm) end lap, sealed with butyl-rubber sealant and fastened together by interlocking clamping plates. Substrate boards in paragraph below are specified in Division 06 Section "Sheathing."

3.3 ACCESSORY INSTALLATION

- A. General: Install accessories with positive anchorage to building and weathertight mounting, and provide for thermal expansion. Coordinate installation with flashings and other components.
 1. Install components required for a complete metal wall panel assembly including trim, copings, corners, seam covers, flashings, sealants, gaskets, fillers, closure strips, and similar items.

- B. Flashing and Trim: Comply with performance requirements, manufacturer's written installation instructions, and SMACNA's "Architectural Sheet Metal Manual." Provide concealed fasteners where possible, and set units true to line and level as indicated. Install work with laps, joints, and seams that will be permanently watertight and weather resistant.
 - 1. Install exposed flashing and trim that is without excessive oil canning, buckling, and tool marks and that is true to line and levels indicated, with exposed edges folded back to form hems. Install sheet metal flashing and trim to fit substrates and to result in waterproof and weather-resistant performance.
 - 2. Expansion Provisions: Provide for thermal expansion of exposed flashing and trim. Space movement joints at a maximum of 10 feet (3 m) with no joints allowed within 24 inches (605 mm) of corner or intersection. Where lapped expansion provisions cannot be used or would not be sufficiently weather resistant and waterproof, form expansion joints of intermeshing hooked flanges, not less than 1 inch (25 mm) deep, filled with mastic sealant (concealed within joints).


3.4 FIELD QUALITY CONTROL

- A. Water Penetration: Test areas of installed system indicated on Drawings for compliance with system performance requirements according to ASTM E 1105 at minimum differential pressure of 20 percent of inward-acting, wind-load design pressure as defined by SEI/ASCE 7, but not less than 6.24 lbf/sq. ft. (300 Pa).
- B. Manufacturer's Field Service: Engage a factory-authorized service representative to inspect and test completed metal wall panel installation, including accessories.
- C. Remove and replace metal wall panels where tests and inspections indicate that they do not comply with specified requirements.
- D. Additional tests and inspections, at Contractor's expense, will be performed to determine compliance of replaced or additional work with specified requirements.


3.5 CLEANING AND PROTECTION

- A. Remove temporary protective coverings and strippable films, if any, as metal wall panels are installed, unless otherwise indicated in manufacturer's written installation instructions. On completion of metal wall panel installation, clean finished surfaces as recommended by metal wall panel manufacturer. Maintain in a clean condition during construction.
- B. After metal wall panel installation, clear weep holes and drainage channels of obstructions, dirt, and sealant.
- C. Replace metal wall panels that have been damaged or have deteriorated beyond successful repair by finish touchup or similar minor repair procedures.


END OF SECTION 07 42 13

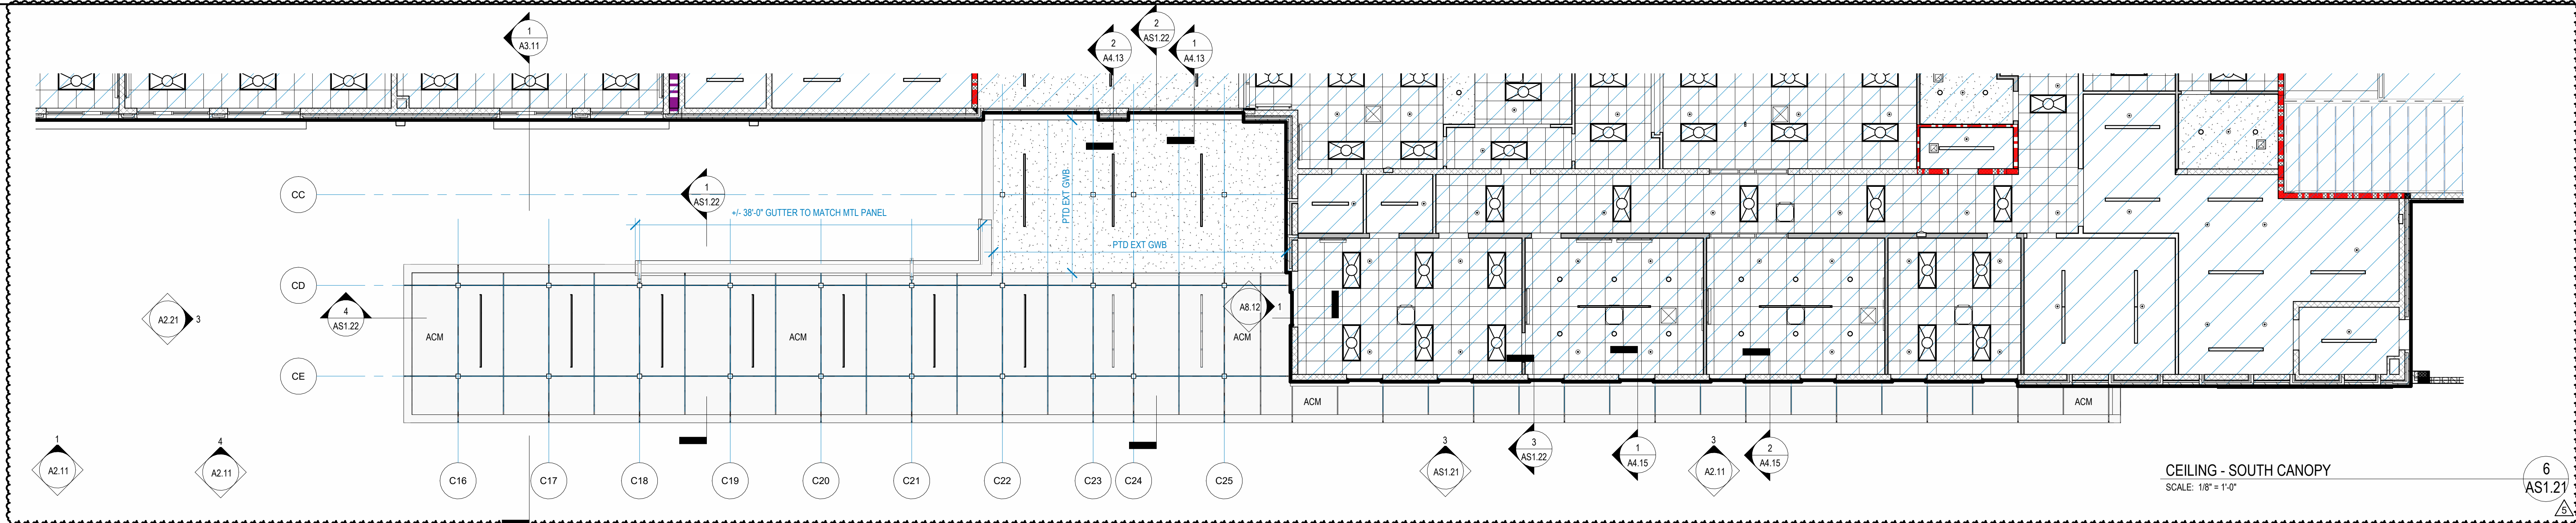


CEILING - SOUTH CANOPY
SCALE: 1/8" = 1'-0"

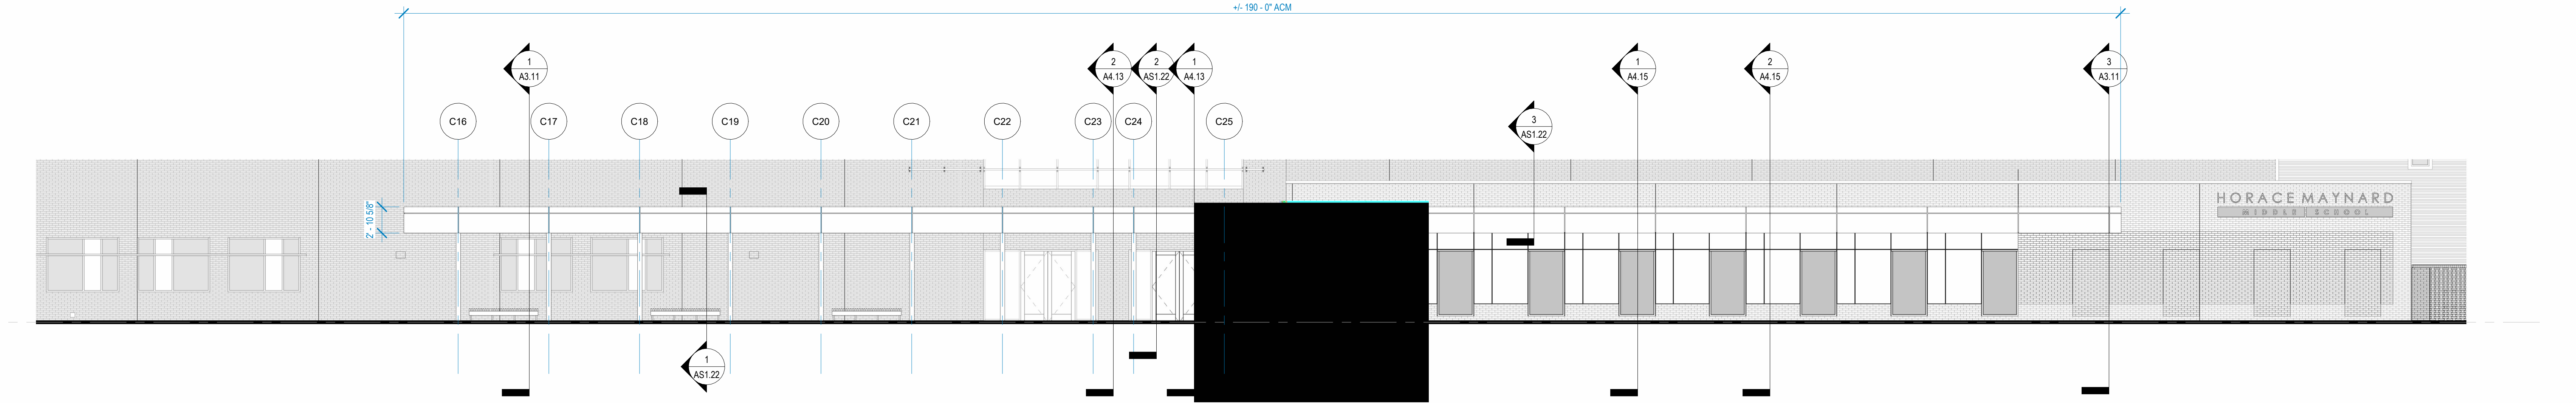


SOUTH CANOPY ELEVATION
SCALE: 1/8" = 1'-0"

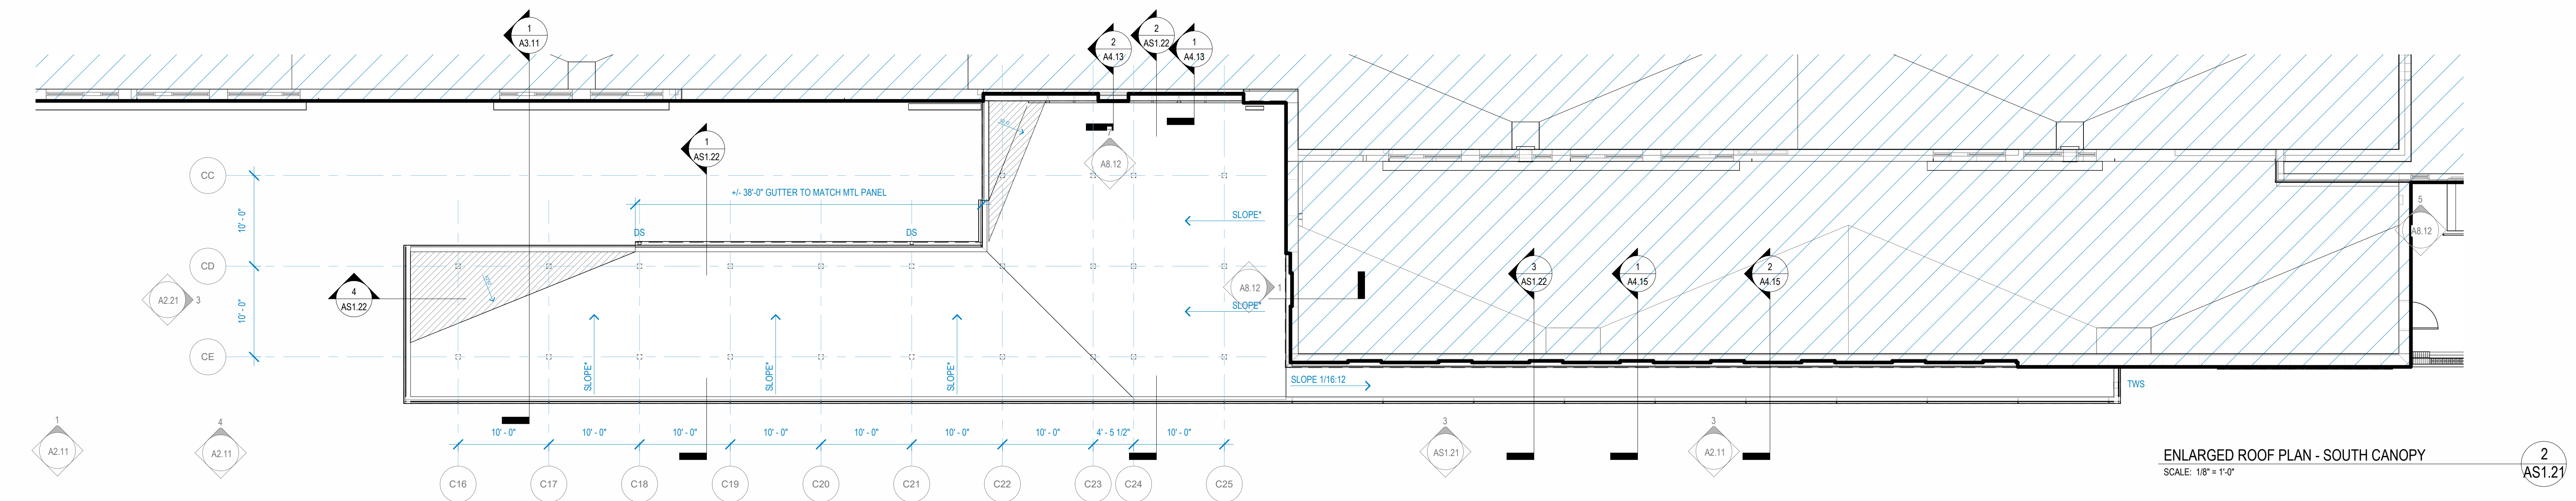

ENLARGED ROOF PLAN - SOUTH CANOPY
SCALE: 1/8" = 1'-0"

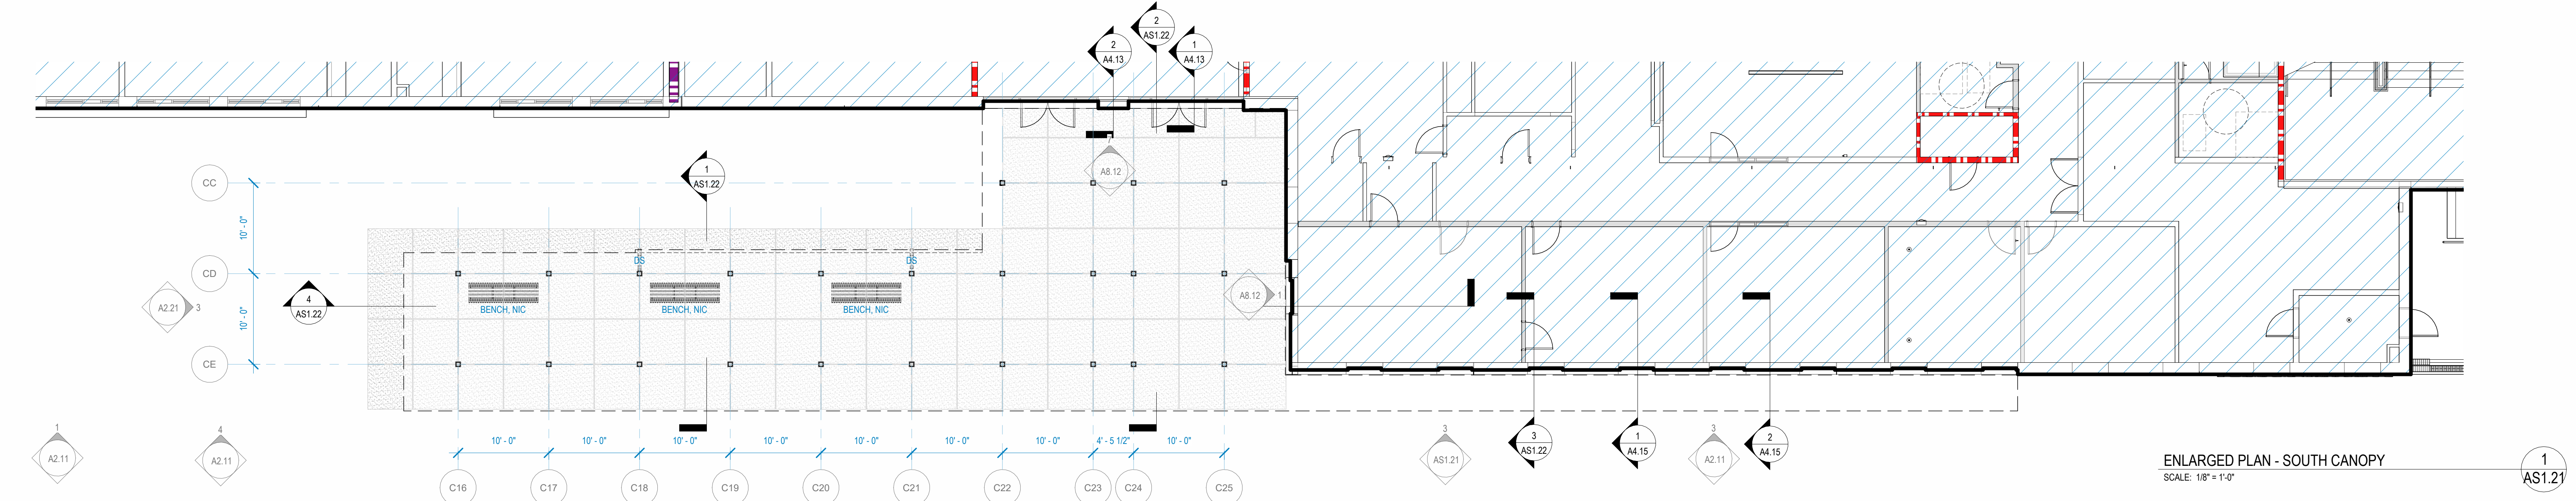

ENLARGED PLAN - SOUTH CANOPY
SCALE: 1/8" = 1'-0"

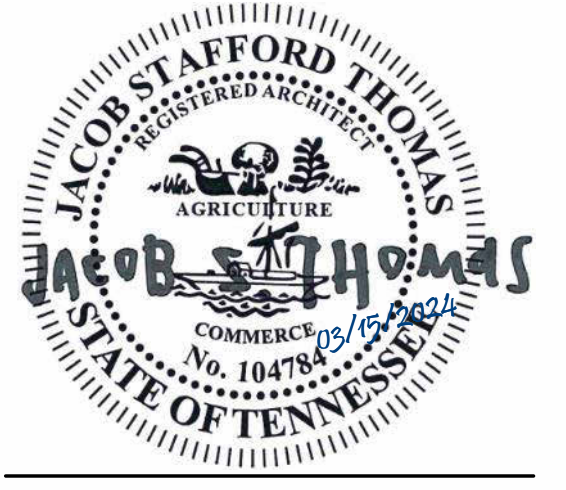

A NEW SCHOOL FACILITY:
HORACE MAYNARD MIDDLE SCHOOL
UNION COUNTY PUBLIC SCHOOLS
MAYNARDVILLE, TN


DATE: 03/15/2024
PROJECT NO: 21074
SBC NO:

PROJECT REVISIONS


#	DATE	DESCRIPTION
2	05/20/2024	R2
5	06/14/2024	ADD 003

THIS DRAWING IS THE PROPERTY OF THE LEWIS GROUP ARCHITECTS, INC. AND IS TO BE USED ONLY FOR THE PROJECT AND SITE SPECIFICALLY IDENTIFIED HEREIN. THIS DRAWING IS NOT TO BE USED ON ANY OTHER PROJECT WHETHER THE PROJECT FOR WHICH IT IS MADE IS EXECUTED OR NOT. THIS DRAWING AND ITS CONTENTS ARE THE SOLE PROPERTY OF THE LEWIS GROUP ARCHITECTS, INC. AND SHALL NOT BE REPRODUCED IN ANY MANNER WITHOUT THE WRITTEN CONSENT. IT IS TO BE RETURNED UPON REQUEST.


SOUTH CANOPY PLANS & ELEVATIONS

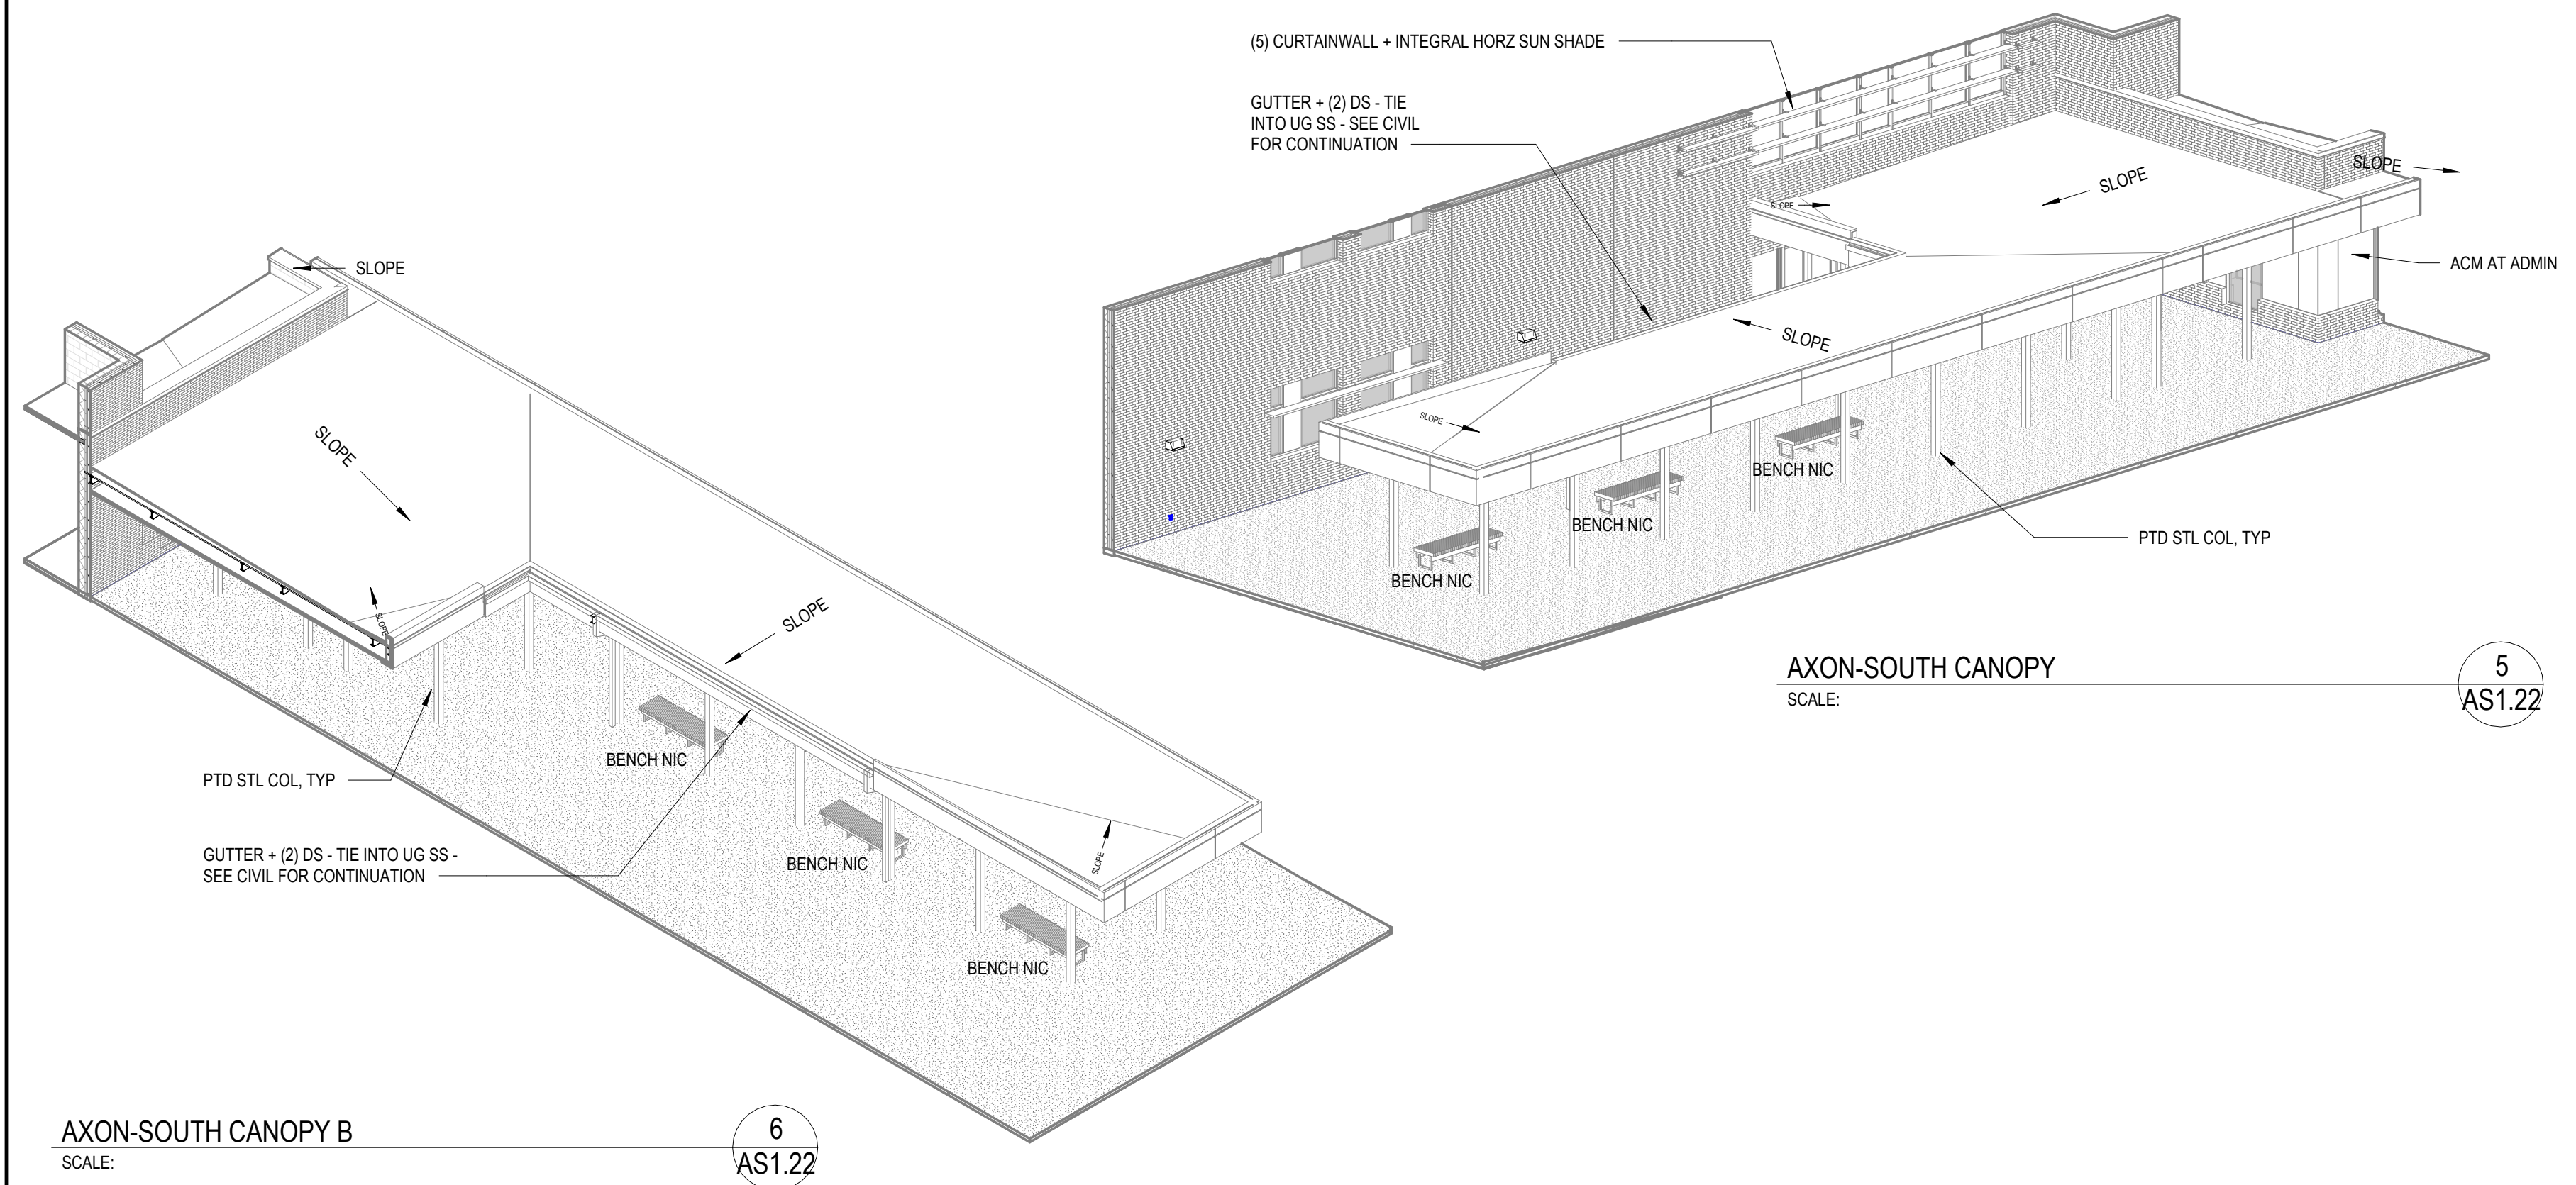


AXON-SOUTH CANOPY B
 SCALE: AS1.22

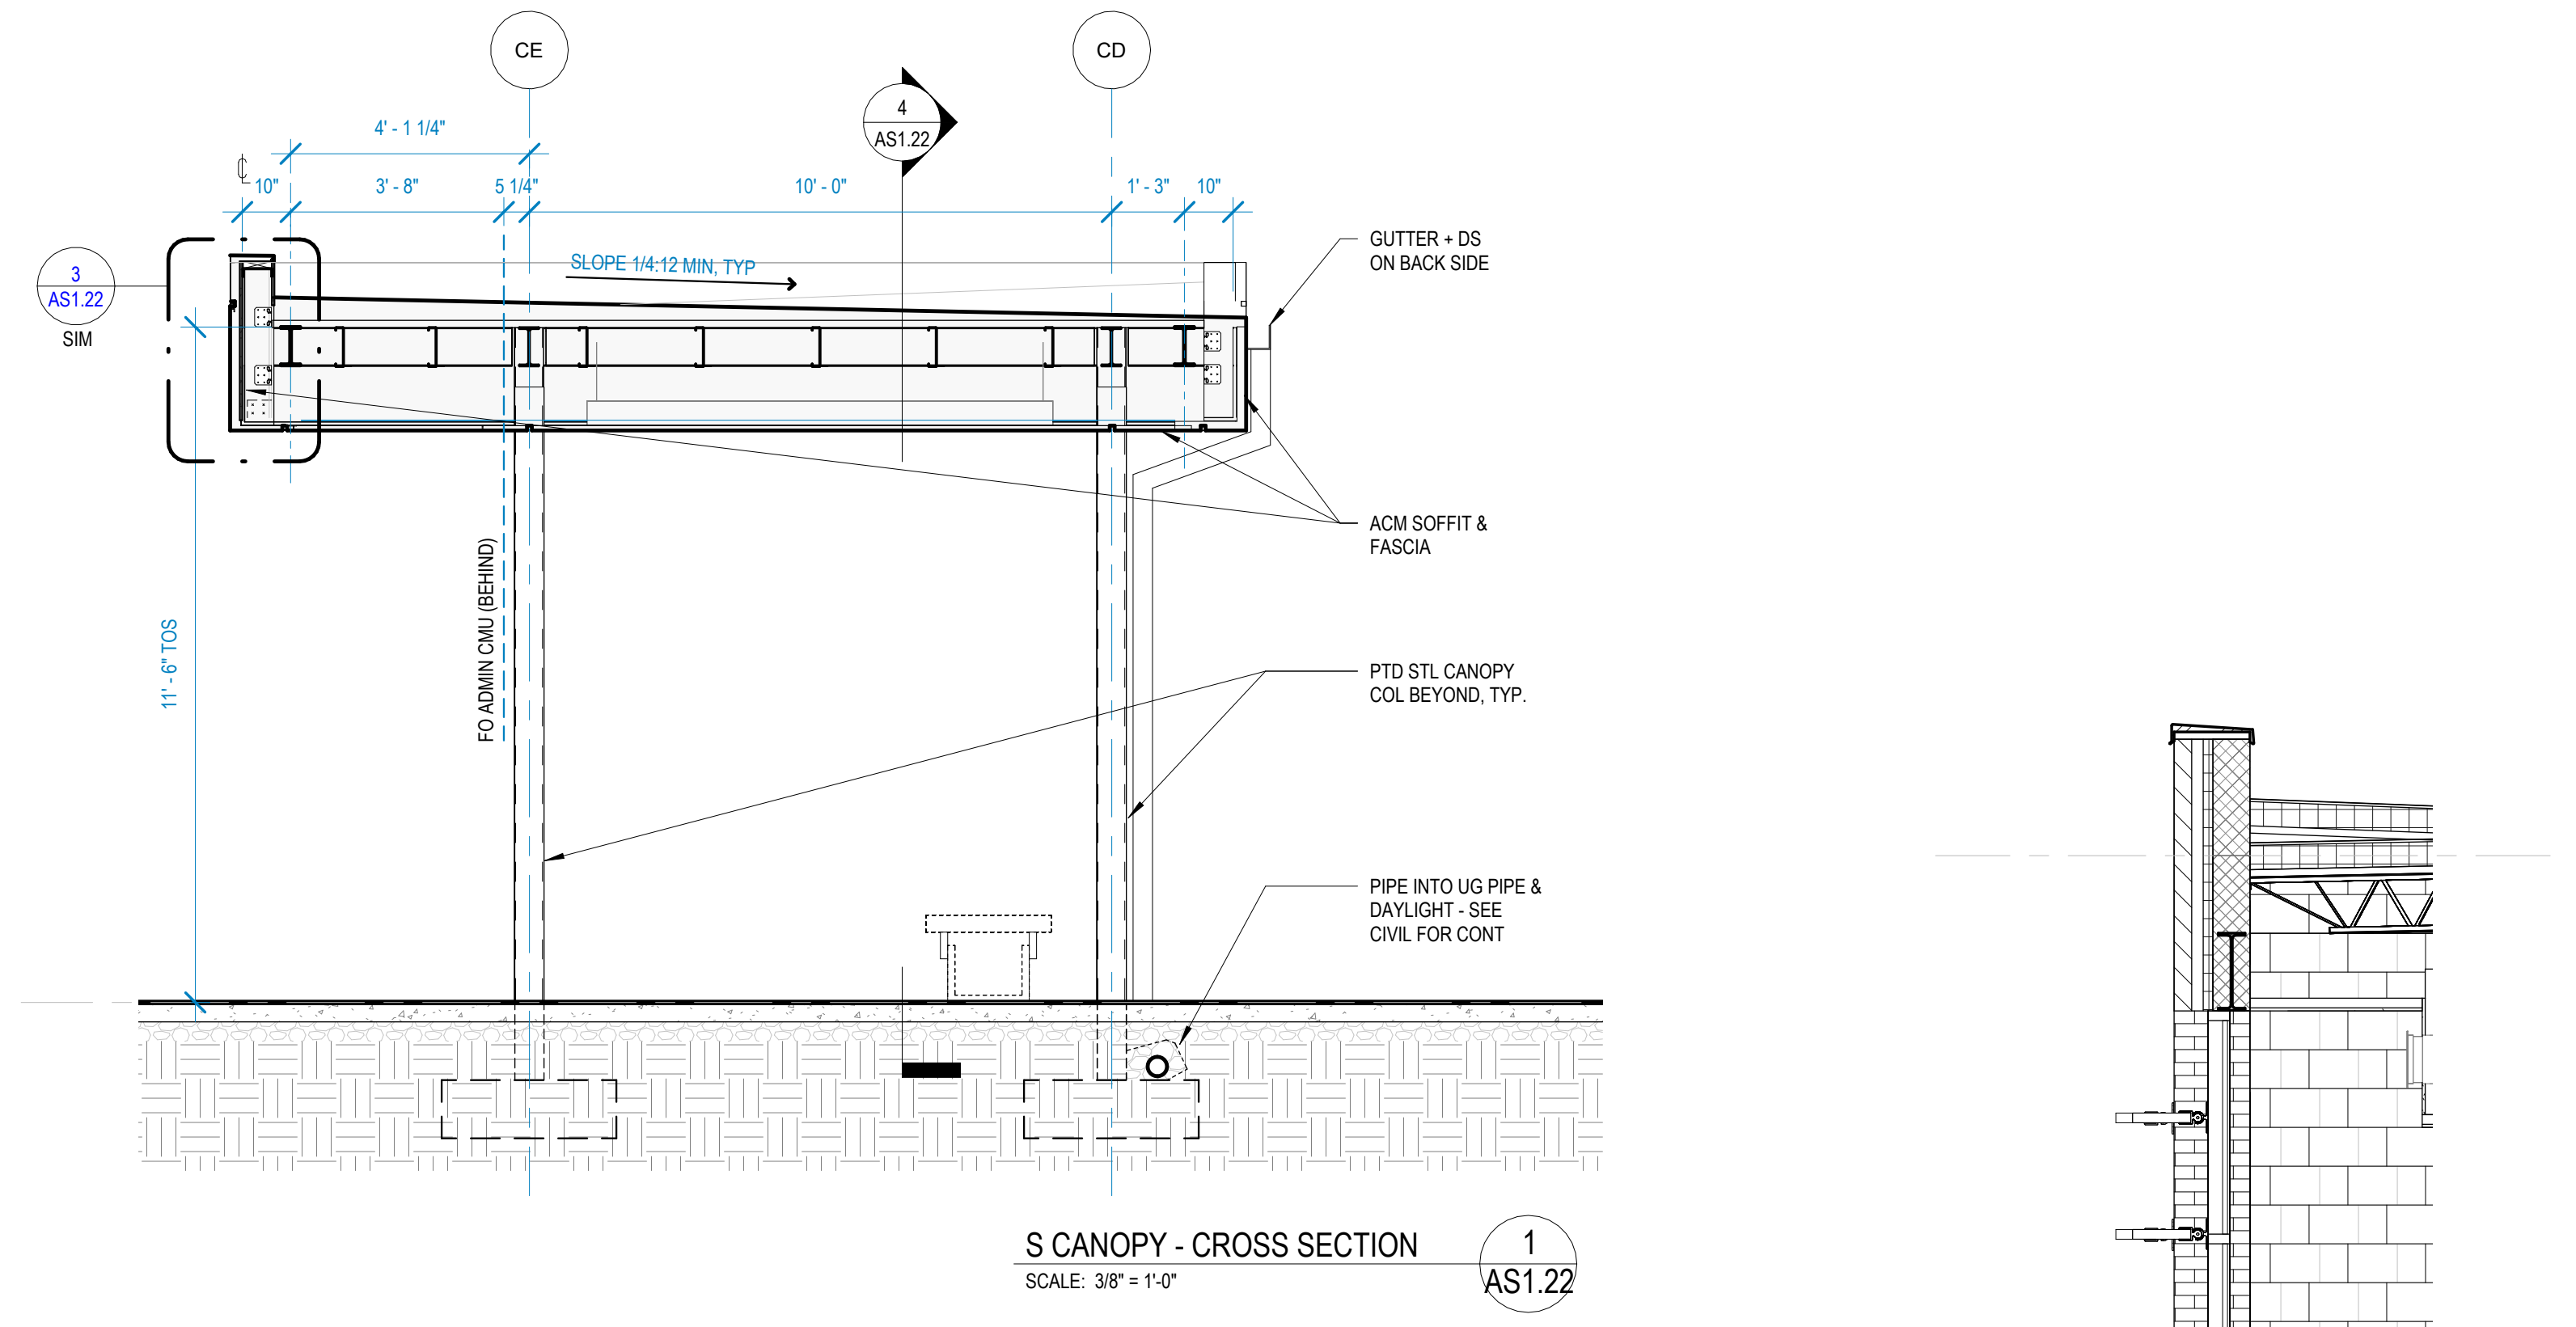


S CANOPY - CROSS SECTION
 SCALE: 3/8" = 1'-0"

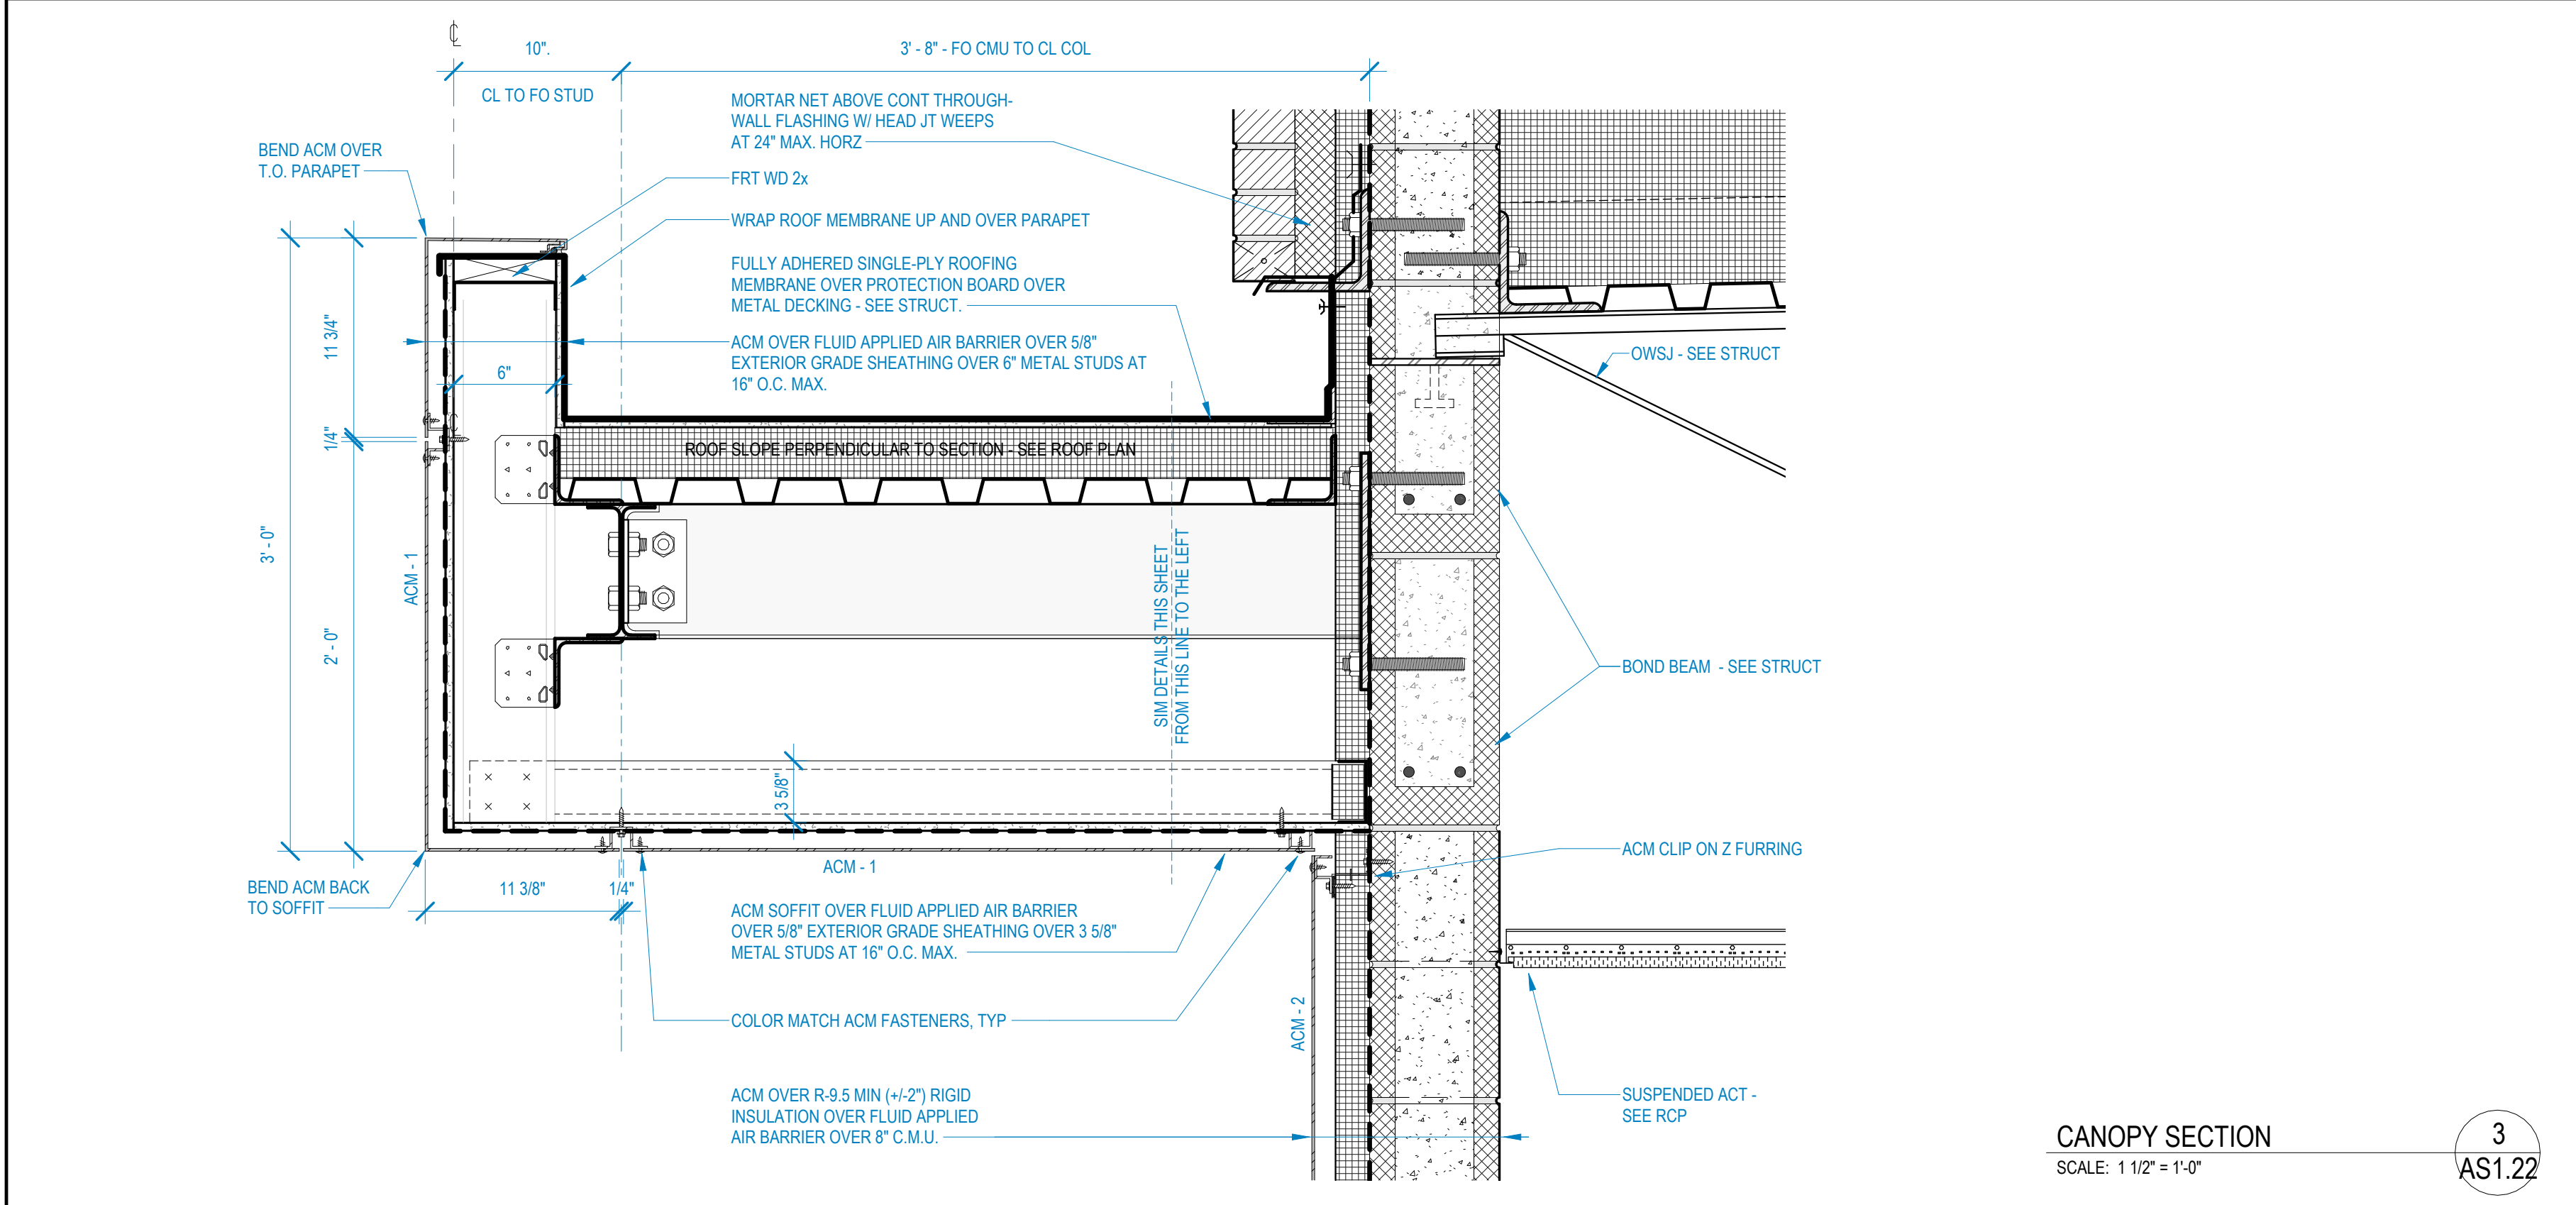

CANOPY SECTION
 SCALE: 1 1/2" = 1'-0"

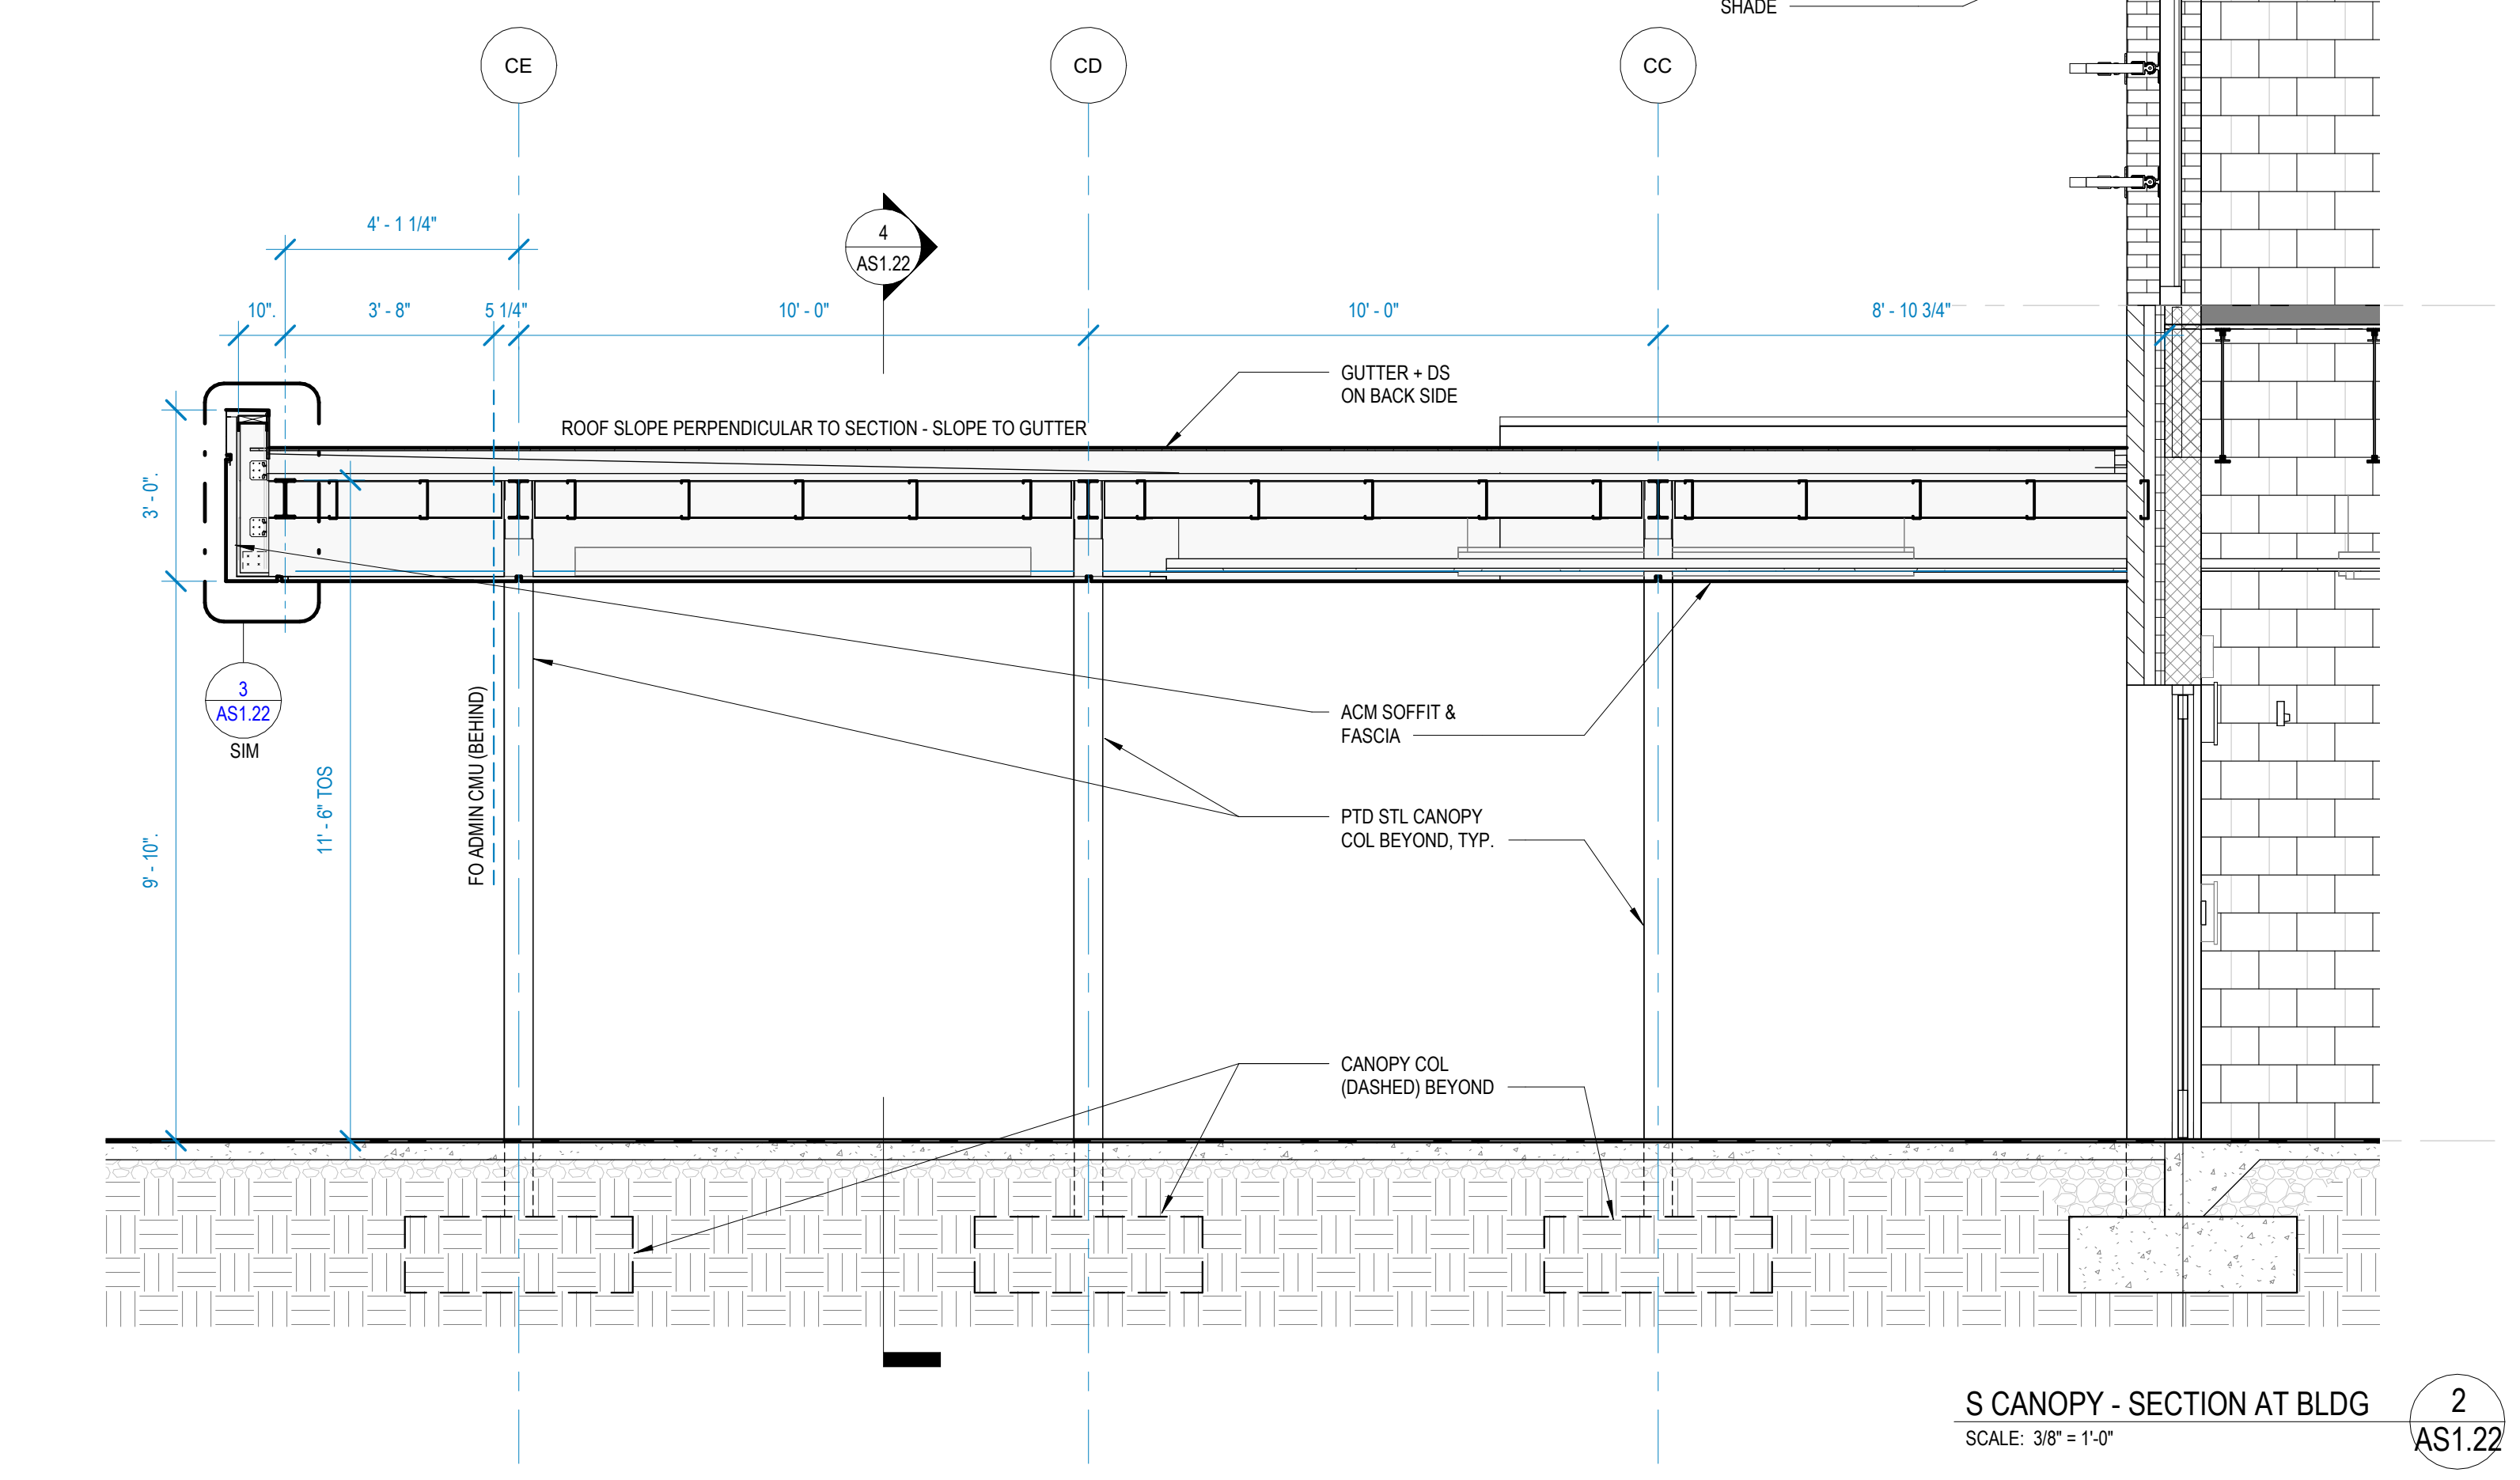


S CANOPY - SECTION AT BLDG
 SCALE: 3/8" = 1'-0"

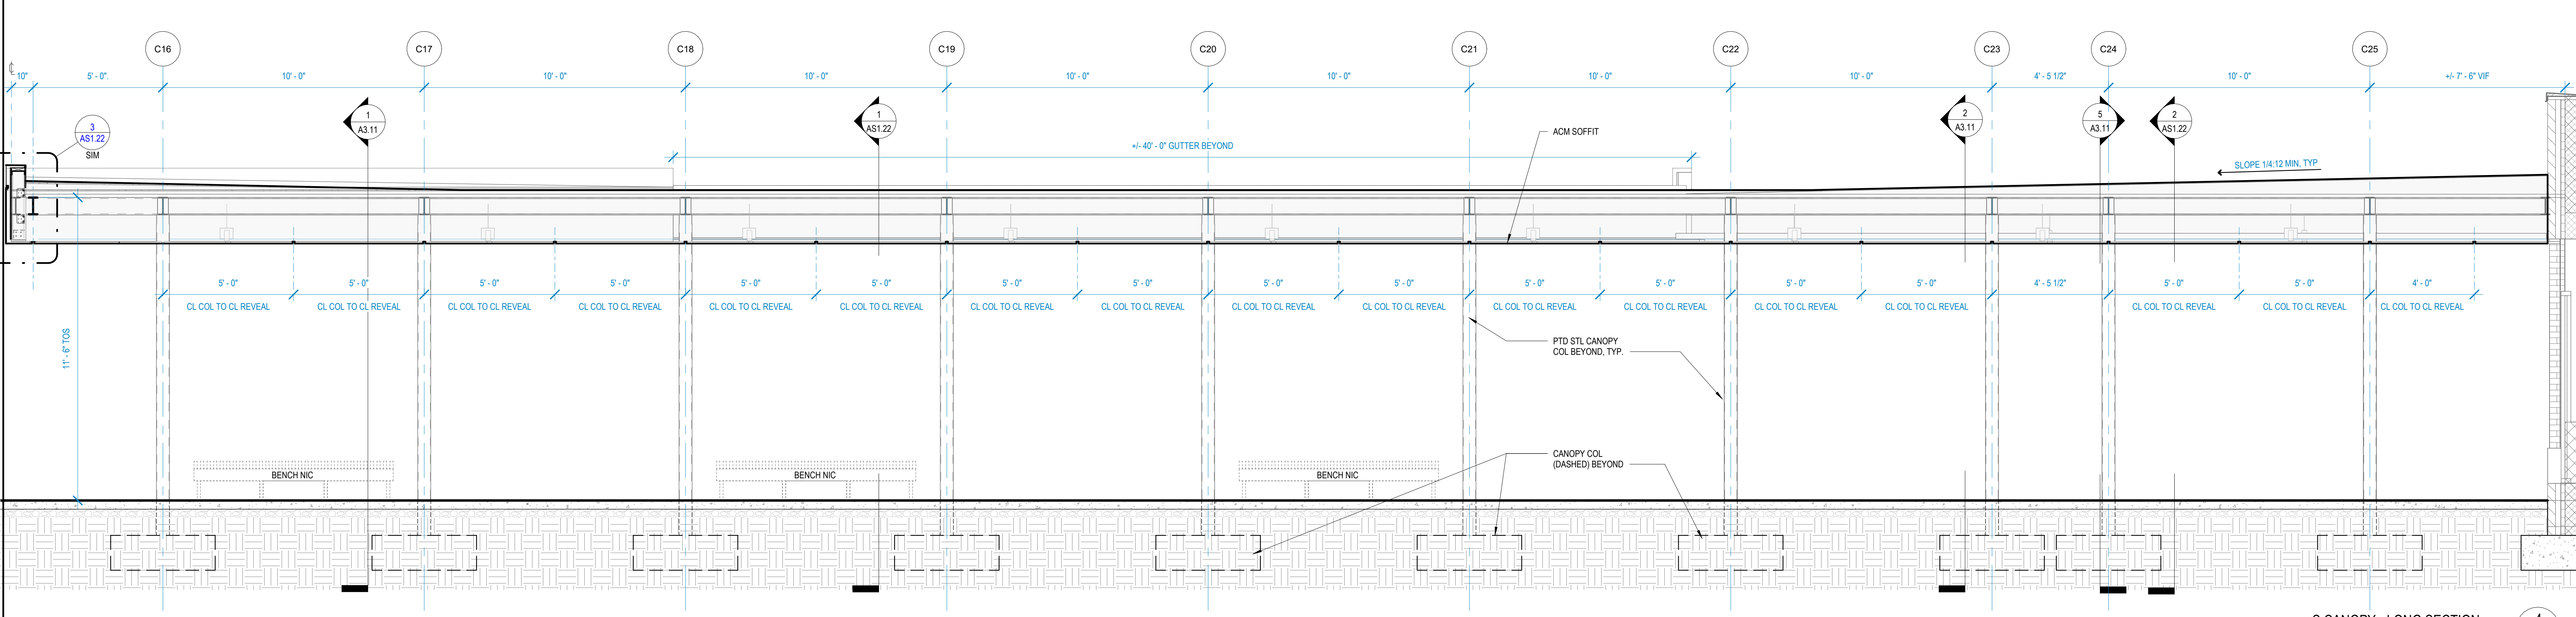

S CANOPY - LONG SECTION
 SCALE: 3/8" = 1'-0"

LEWIS GROUP ARCHITECTS
 1 KNOXVILLE, TN | 6512 DEANE HILL DR. 37919 - PH. 865.584.5000 | CLEVELAND, TN | 63 OODEL ST. 37311 - PH. 423.476.0022
 info@lewisgroup.net | www.lewisgroup.net

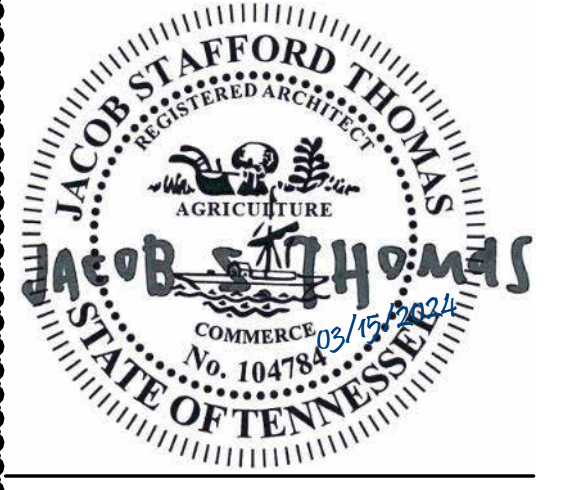

A NEW SCHOOL FACILITY:
HORACE MAYNARD MIDDLE SCHOOL
 UNION COUNTY PUBLIC SCHOOLS
 MAYNARDVILLE, TN


DATE: 03/15/2024
 PROJECT NO: 21074
 SBC NO:

#	DATE	DESCRIPTION
5	06/14/2024	ADD 003

THIS DRAWING IS THE PROPERTY OF THE LEWIS GROUP ARCHITECTS, INC. AND IS TO BE USED ONLY FOR THE PROJECT AND SITE SPECIFICALLY IDENTIFIED HEREIN. THIS DRAWING IS NOT TO BE USED ON ANY OTHER PROJECT WHETHER THE PROJECT FOR WHICH IT IS MADE IS EXECUTED OR NOT. THIS DRAWING AND ITS CONTENTS ARE THE SOLE POSSESSION OF THE LEWIS GROUP ARCHITECTS, INC. AND SHALL NOT BE REPRODUCED OR TRANSMITTED IN ANY FORM OR BY ANY MEANS, ELECTRONIC OR MECHANICAL, INCLUDING PHOTOCOPYING, RECORDING, OR BY ANY INFORMATION STORAGE AND RETRIEVAL SYSTEM, WITHOUT THE WRITTEN PERMISSION OF THE LEWIS GROUP ARCHITECTS, INC. IT IS TO BE RETURNED UPON REQUEST.


SOUTH CANOPY DETAILS

AS1.22

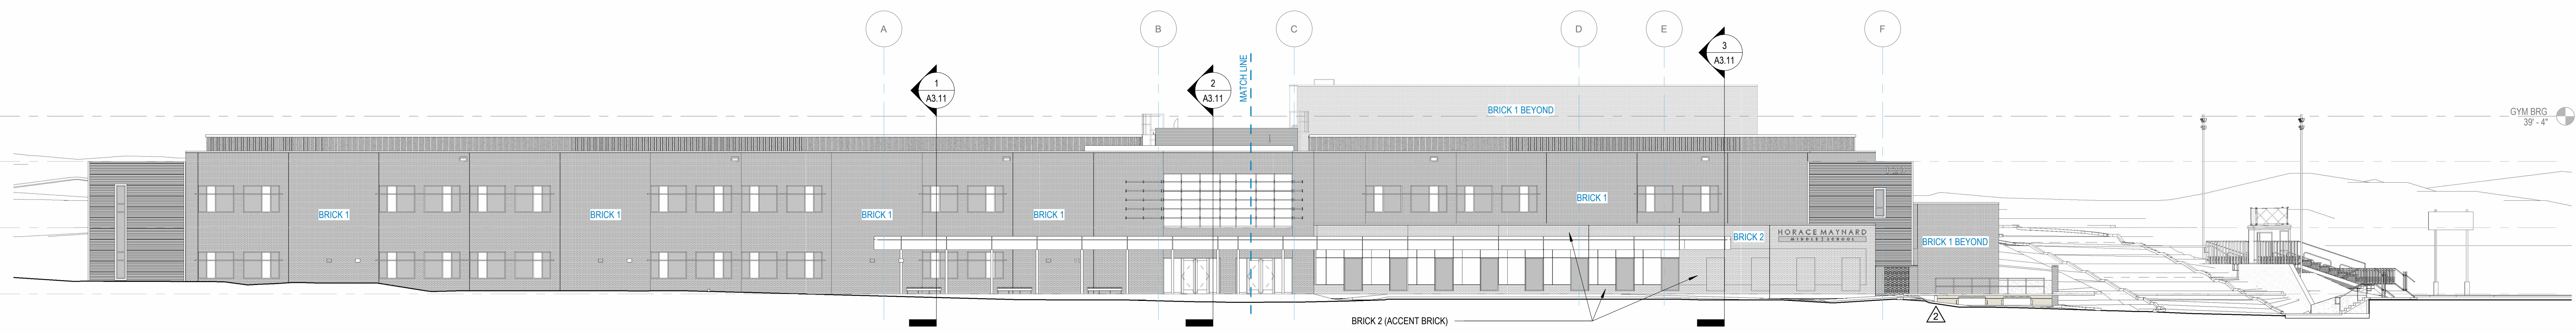


OVERALL SOUTH ELEVATION
SCALE: 1/16" = 1'-0"

1
A2.11

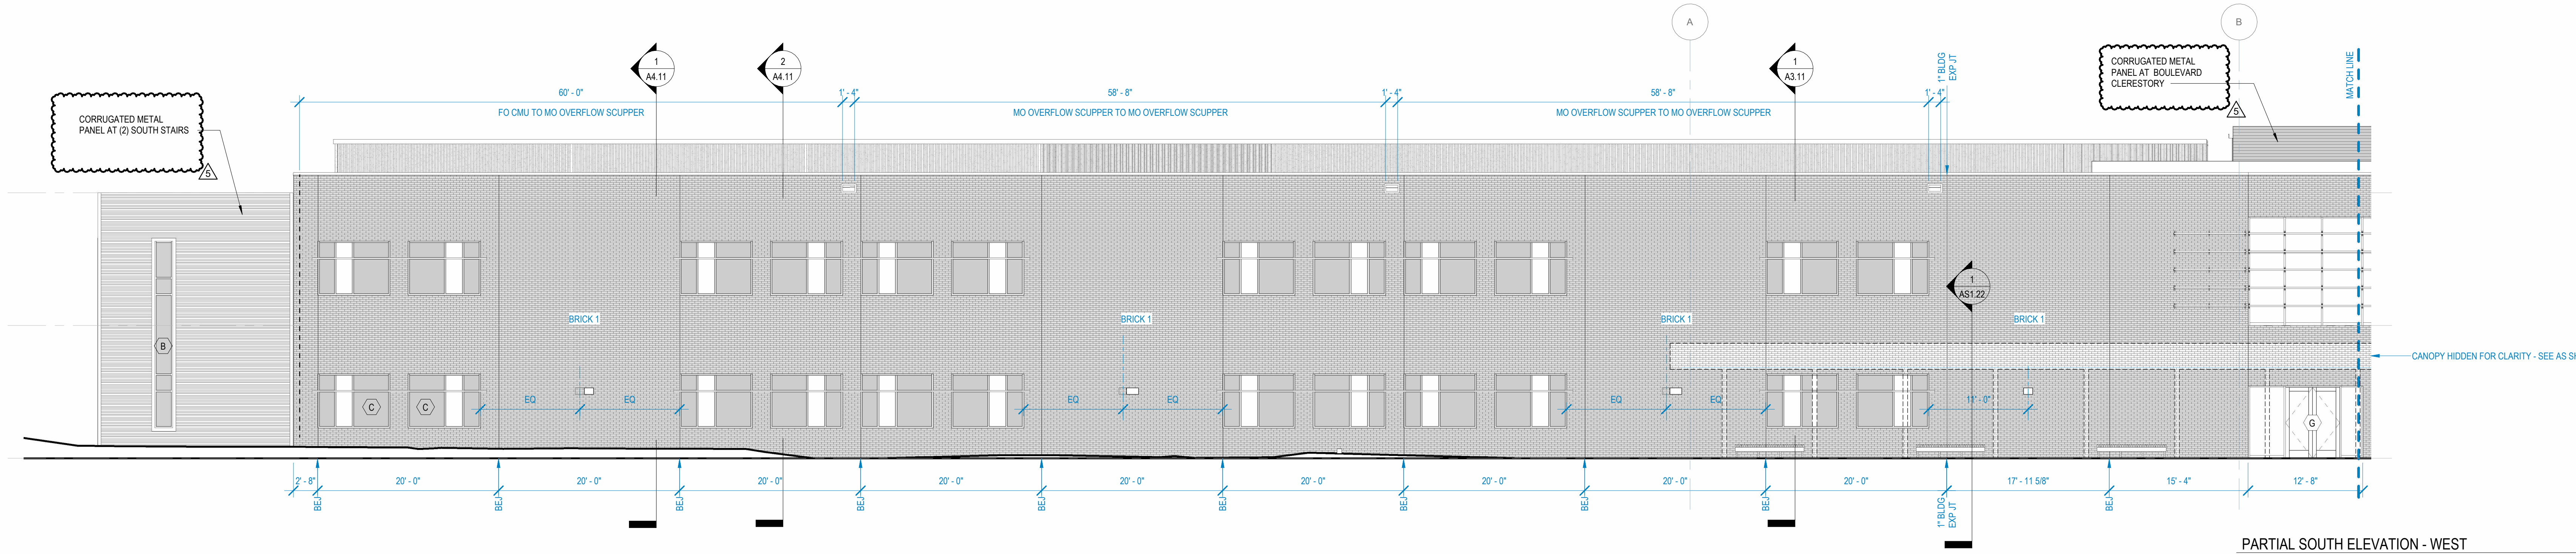


PARTIAL SOUTH ELEVATION - WEST
SCALE: 1/8" = 1'-0"

4
A2.11

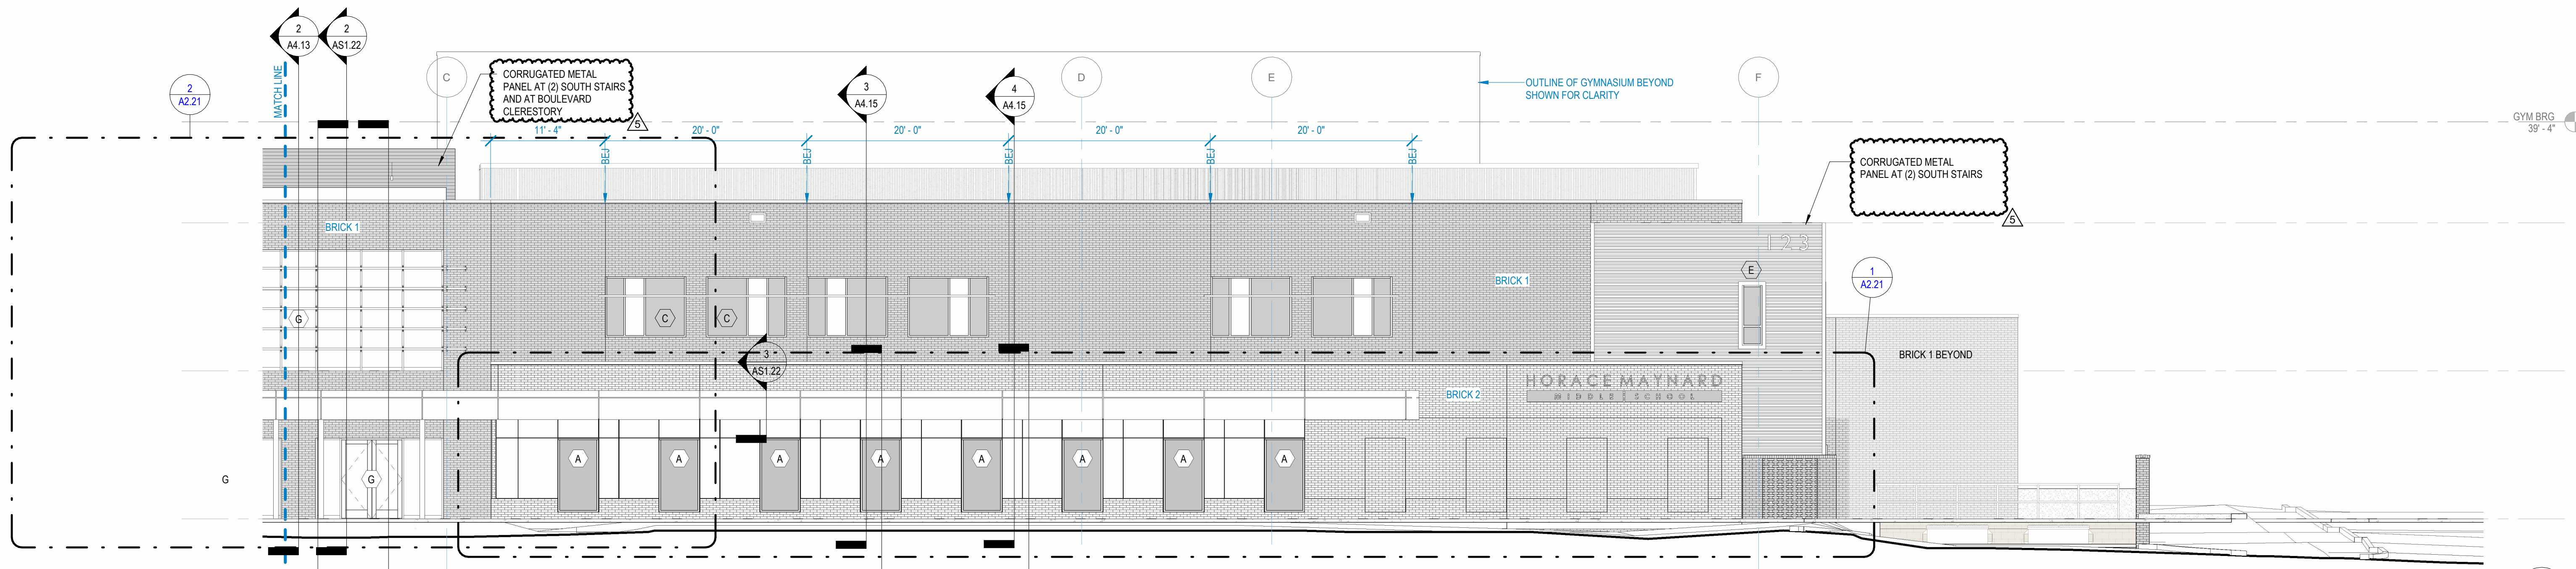

PARTIAL SOUTH ELEVATION - EAST
SCALE: 1/8" = 1'-0"

3
A2.11

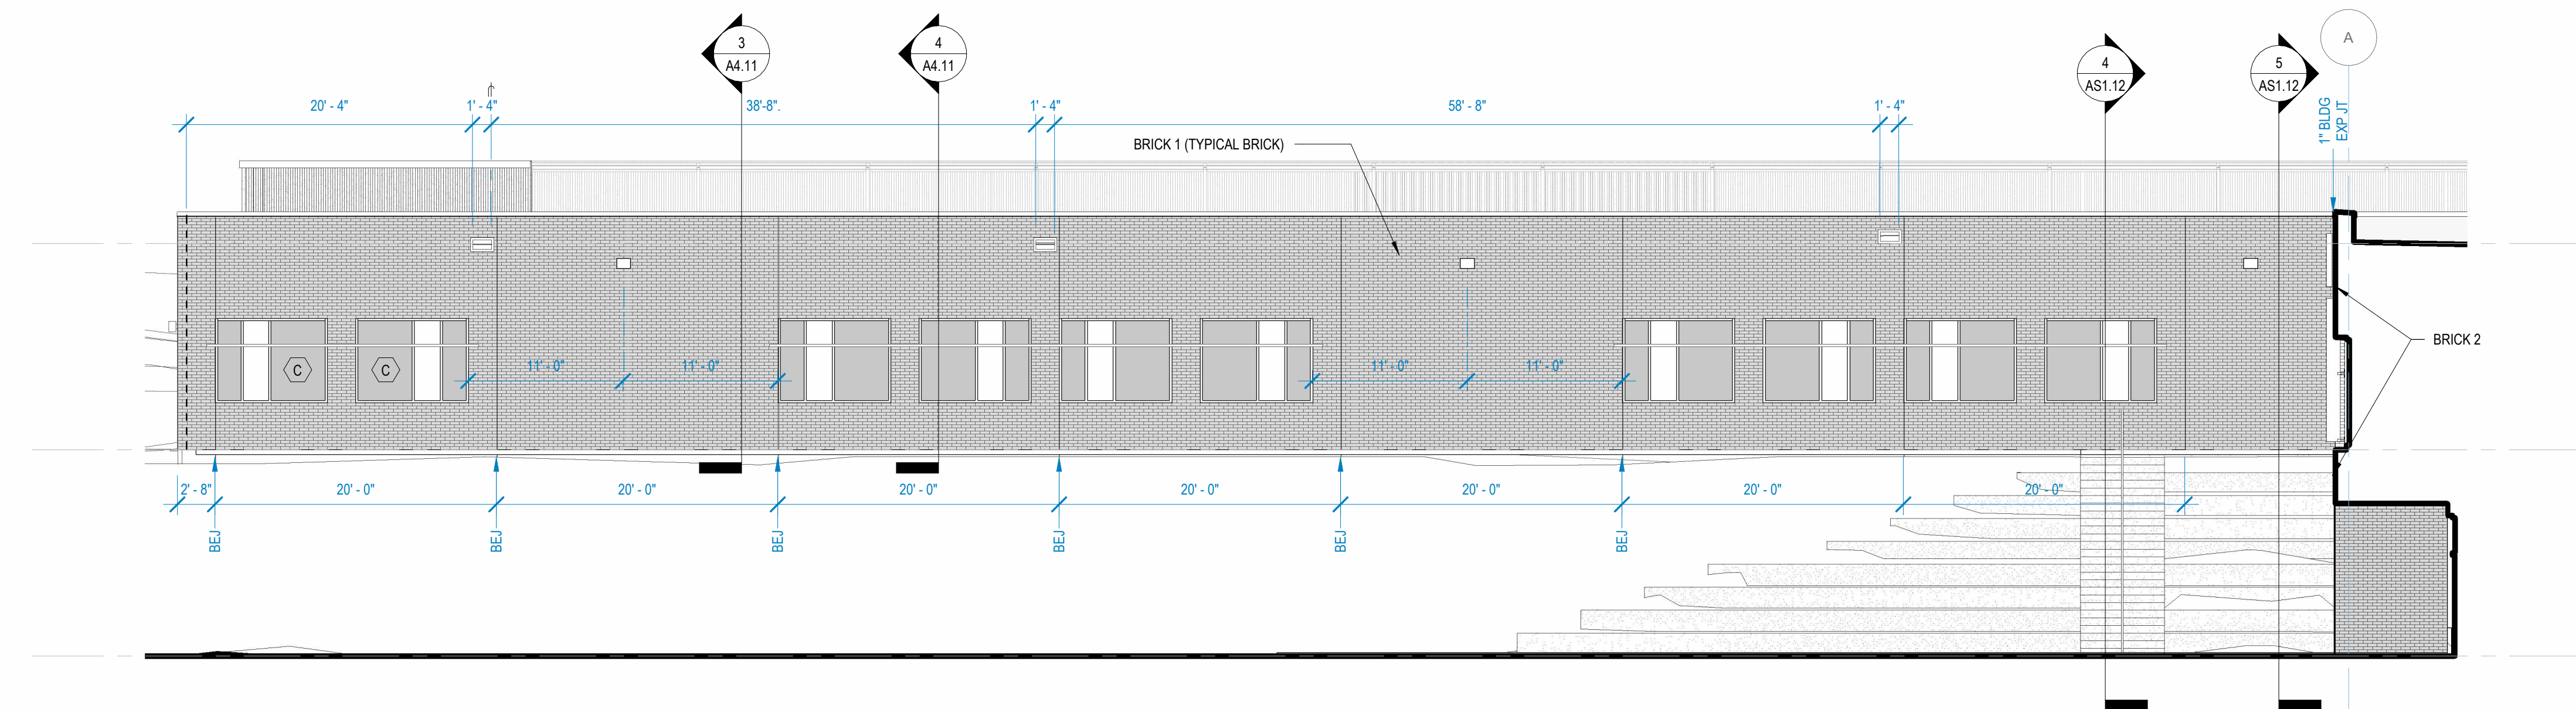

COURTYARD ELEVATION - SOUTH
SCALE: 1/8" = 1'-0"

2
A2.11




DATE: 03/15/2024
PROJECT NO: 21074
SBC NO:

PROJECT REVISIONS


#	DATE	DESCRIPTION
2	05/20/2024	R2
3	05/31/2024	ADD 001
5	06/14/2024	ADD 003

THIS DRAWING IS THE PROPERTY OF THE LEWIS GROUP ARCHITECTS, INC. AND IS TO BE USED ONLY FOR THE PROJECT AND SITE SPECIFICALLY IDENTIFIED HEREIN. THIS DRAWING IS NOT TO BE REPRODUCED OR COPIED IN ANY MANNER WITHOUT THE WRITTEN PERMISSION OF THE LEWIS GROUP ARCHITECTS, INC. AND SHALL NOT BE REPRODUCED OR COPIED IN ANY MANNER WITHOUT THEIR FULL CONSENT. IT IS TO BE RETURNED UPON REQUEST.

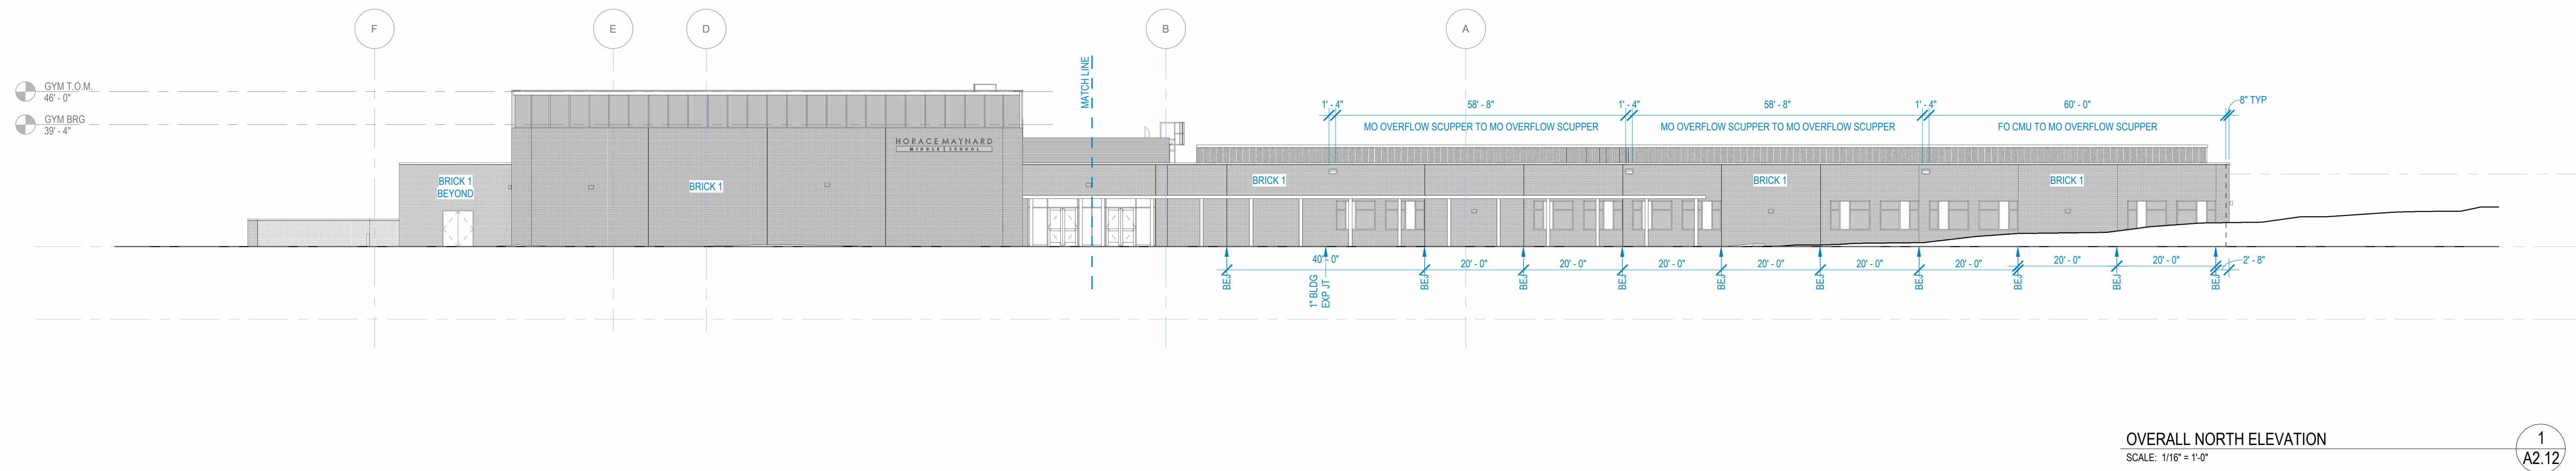


OVERALL NORTH ELEVATION
SCALE: 1/16" = 1'-0"

1
A2.12

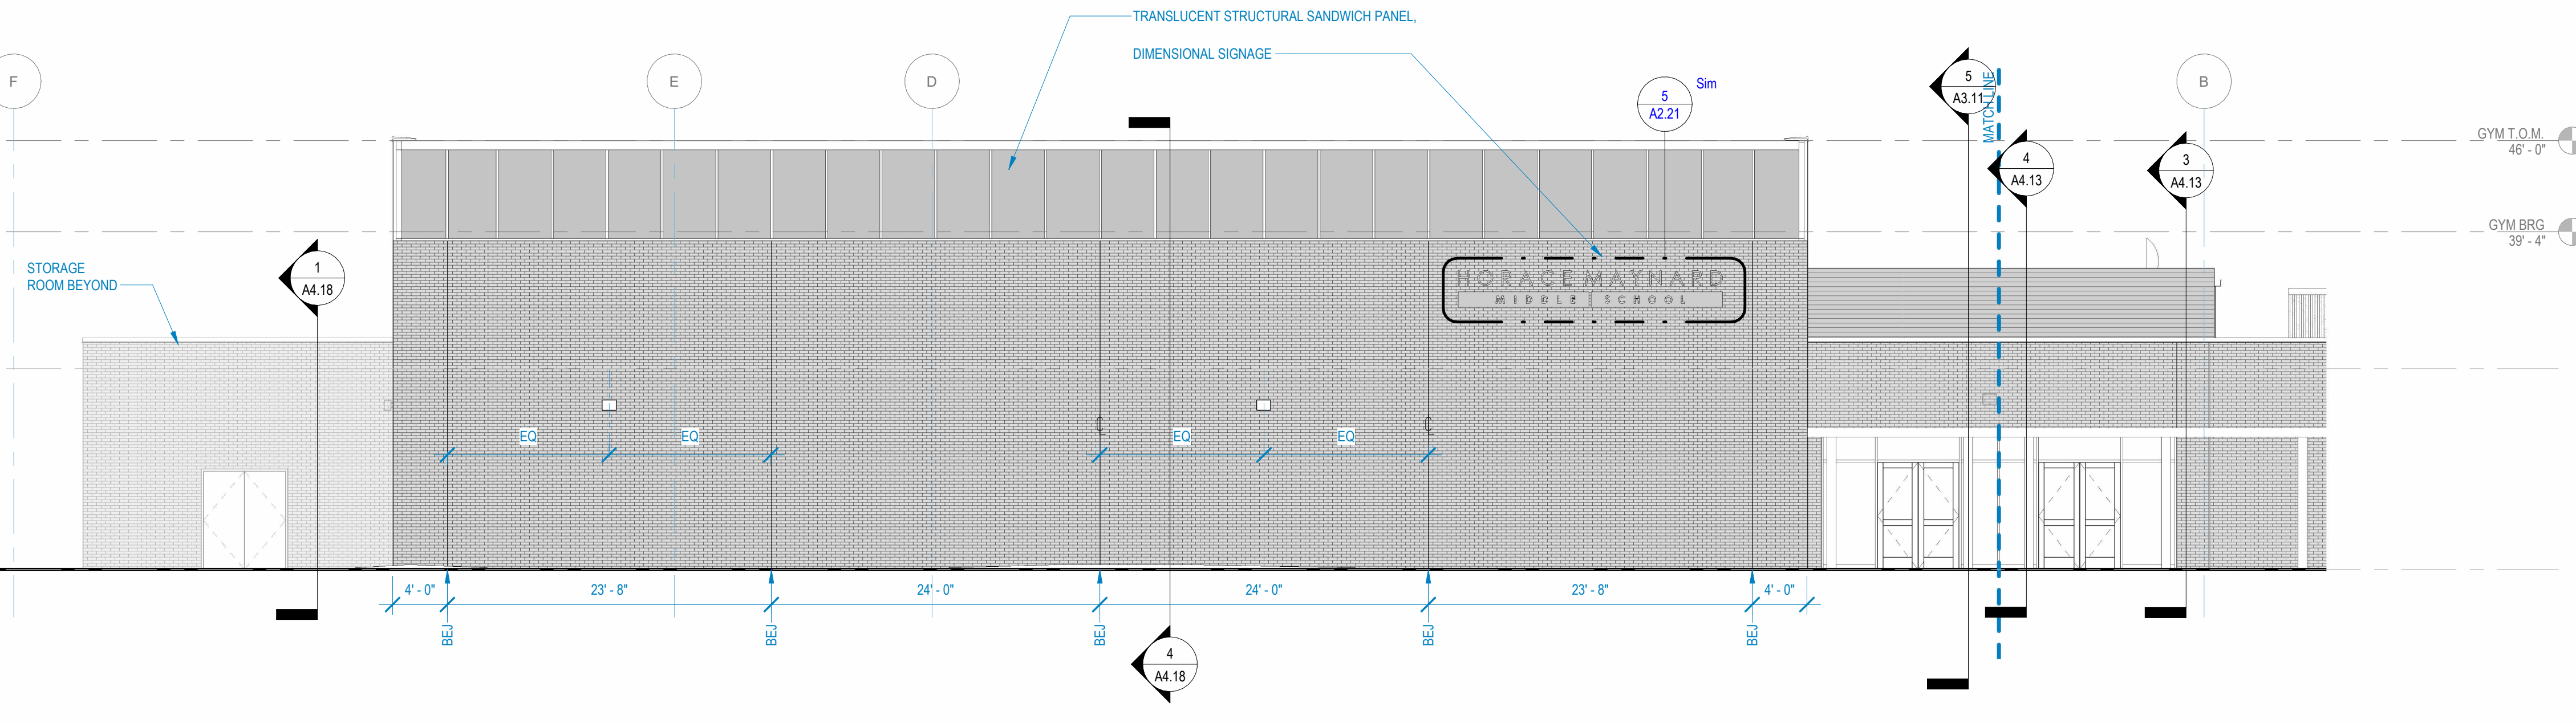


PARTIAL NORTH ELEVATION - EAST
SCALE: 1/8" = 1'-0"

3
A2.12

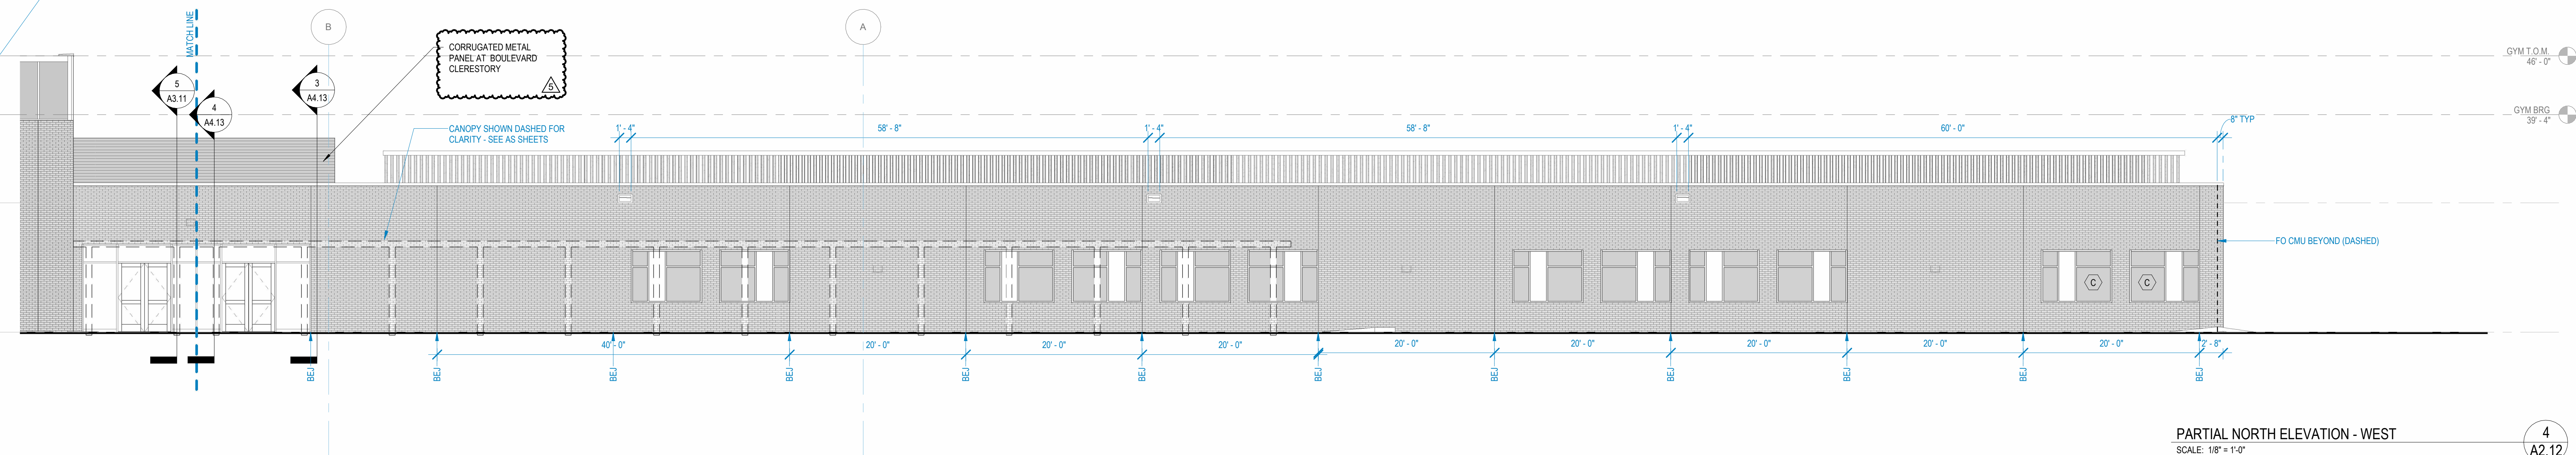


PARTIAL NORTH ELEVATION - WEST
SCALE: 1/8" = 1'-0"

4
A2.12

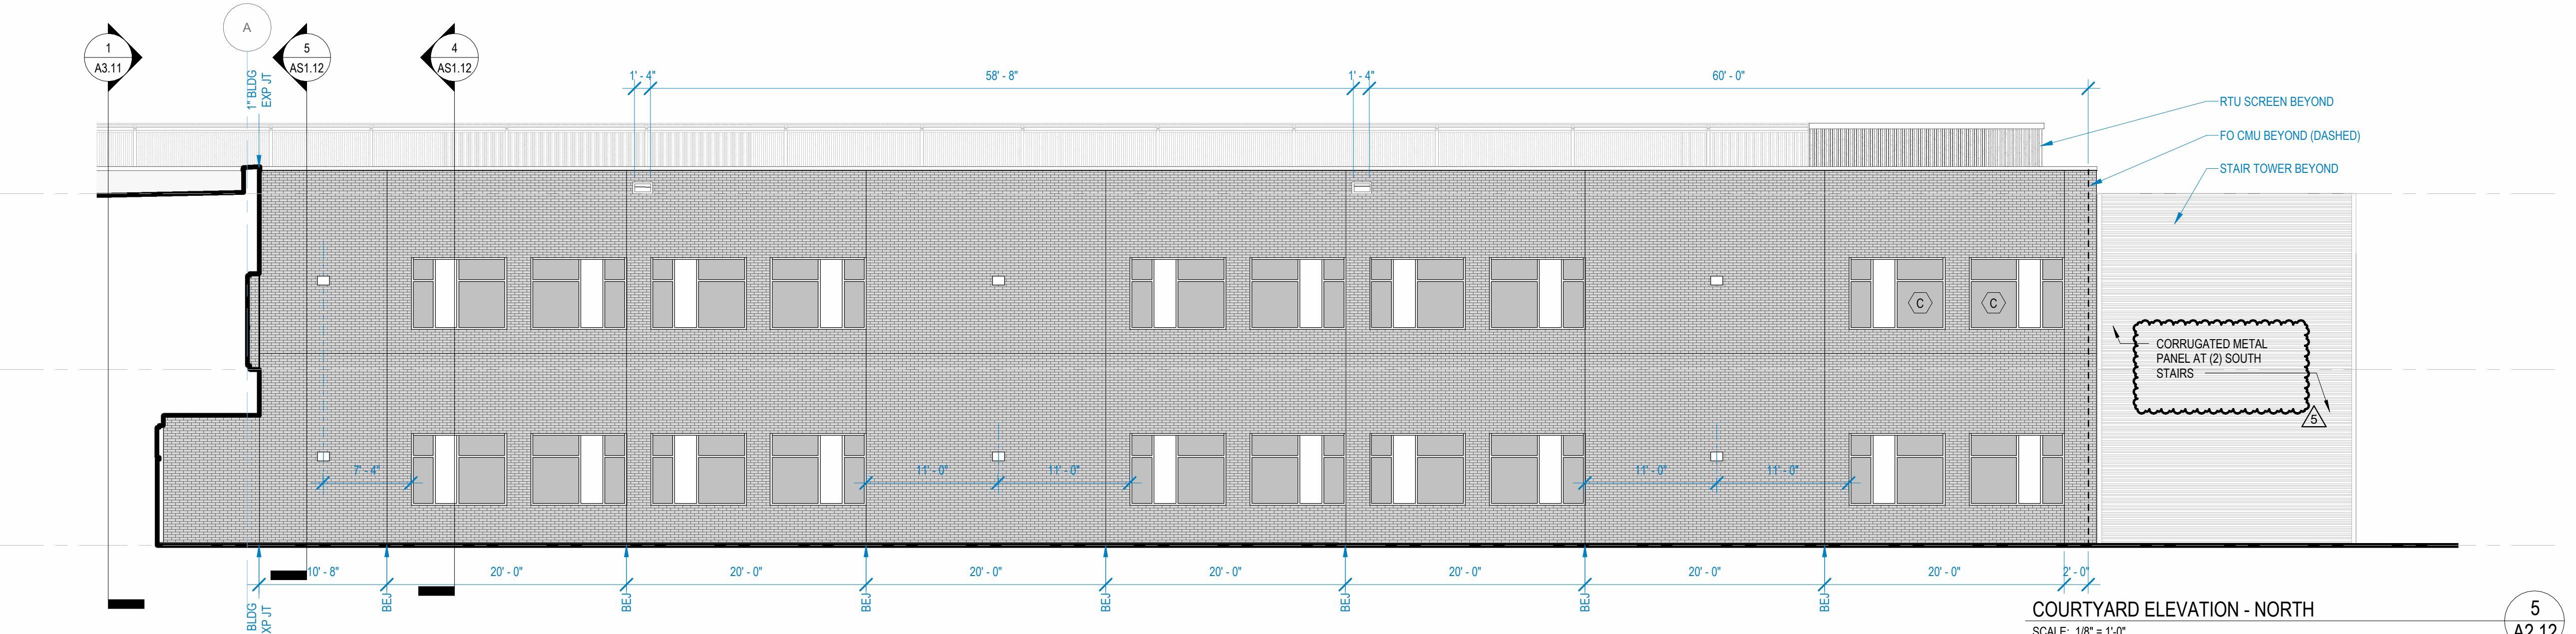

COURTYARD ELEVATION - NORTH
SCALE: 1/8" = 1'-0"

5
A2.12

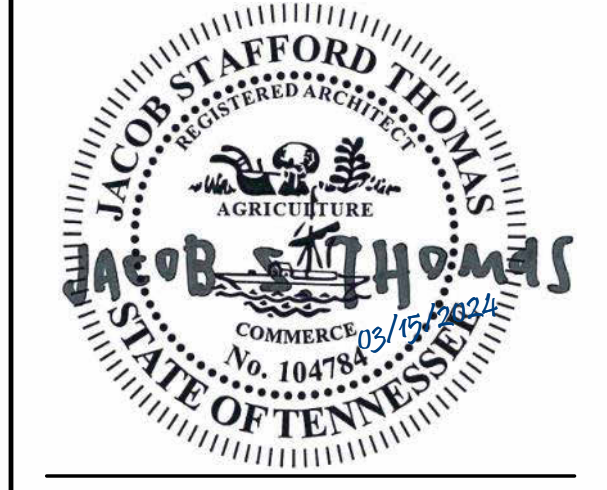

A NEW SCHOOL FACILITY:
HORACE MAYNARD MIDDLE SCHOOL
UNION COUNTY PUBLIC SCHOOLS
MAYNARDVILLE, TN

DATE: 03/15/2024
PROJECT NO: 21074
SBC NO:


PROJECT REVISIONS

#	DATE	DESCRIPTION
3	05/13/2024	ADD 001
5	06/14/2024	ADD 003


THIS DRAWING IS THE PROPERTY OF THE LEWIS GROUP ARCHITECTS, INC. AND IS TO BE USED ONLY FOR THE PROJECT AND SITE SPECIFICALLY IDENTIFIED HEREIN. THIS DRAWING IS NOT TO BE USED ON ANY OTHER PROJECT WHETHER THE PROJECT FOR WHICH IT IS MADE IS EXECUTED OR NOT. THIS DRAWING AND ITS CONTENTS ARE THE SOLE POSSESSION OF THE LEWIS GROUP ARCHITECTS, INC. AND SHALL NOT BE REPRODUCED OR TRANSMITTED IN ANY MANNER WITHOUT THE WRITTEN CONSENT OF THE LEWIS GROUP ARCHITECTS, INC. IT IS TO BE RETURNED UPON REQUEST.

BUILDING ELEVATIONS - NORTH


A2.12

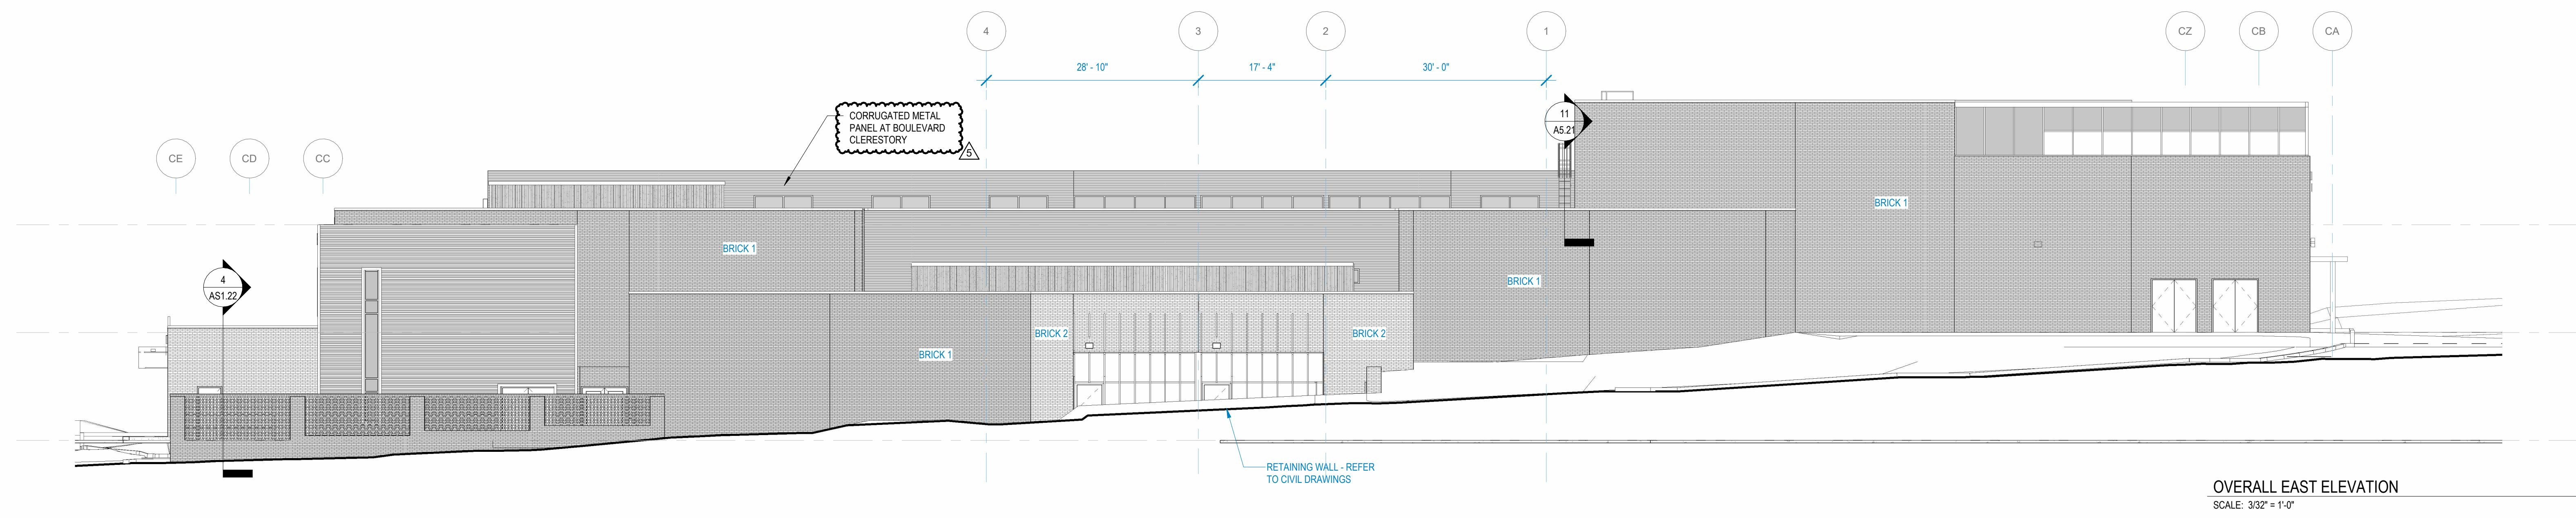


OVERALL EAST ELEVATION
SCALE: 3/32" = 1'-0"
1 A2.13

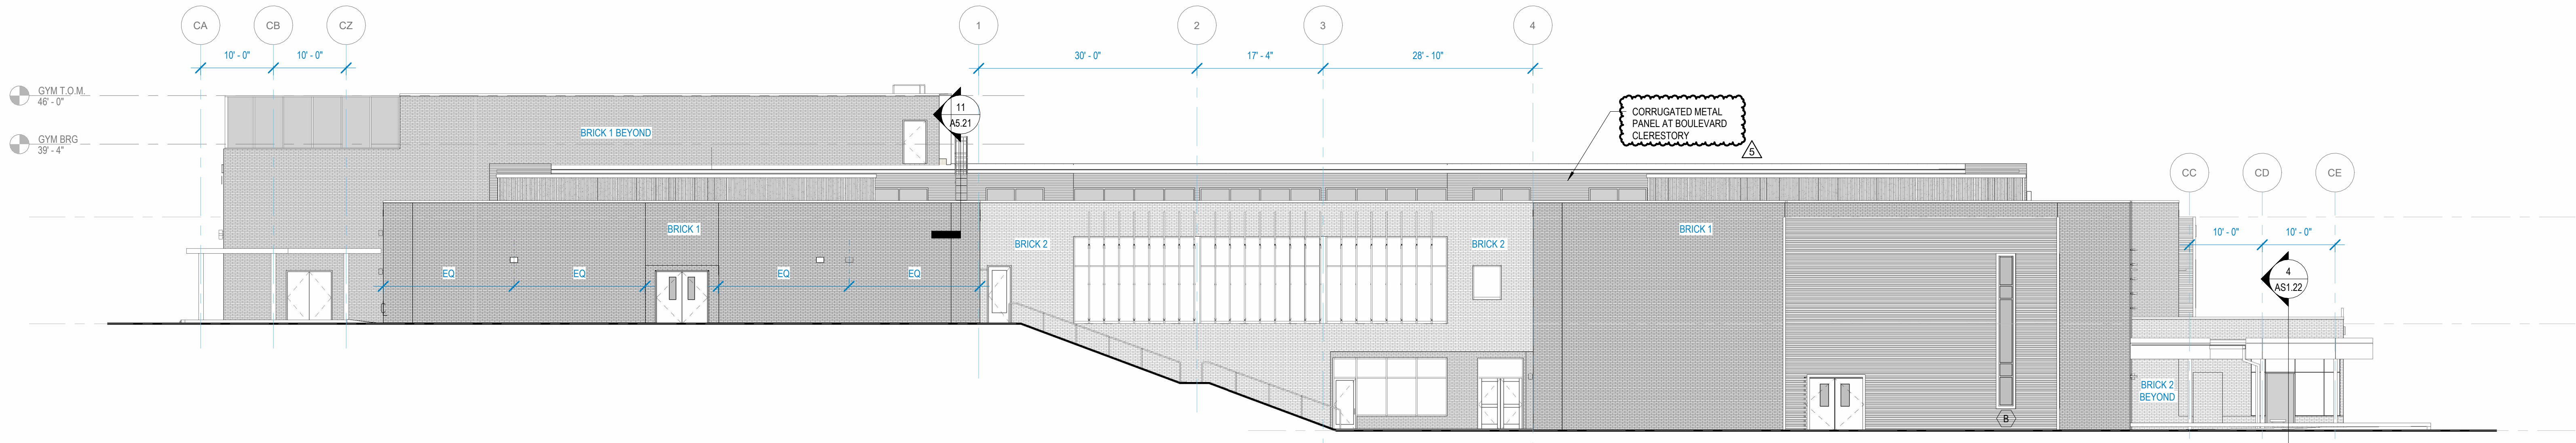


OVERALL WEST ELEVATION
SCALE: 3/32" = 1'-0"
2 A2.13

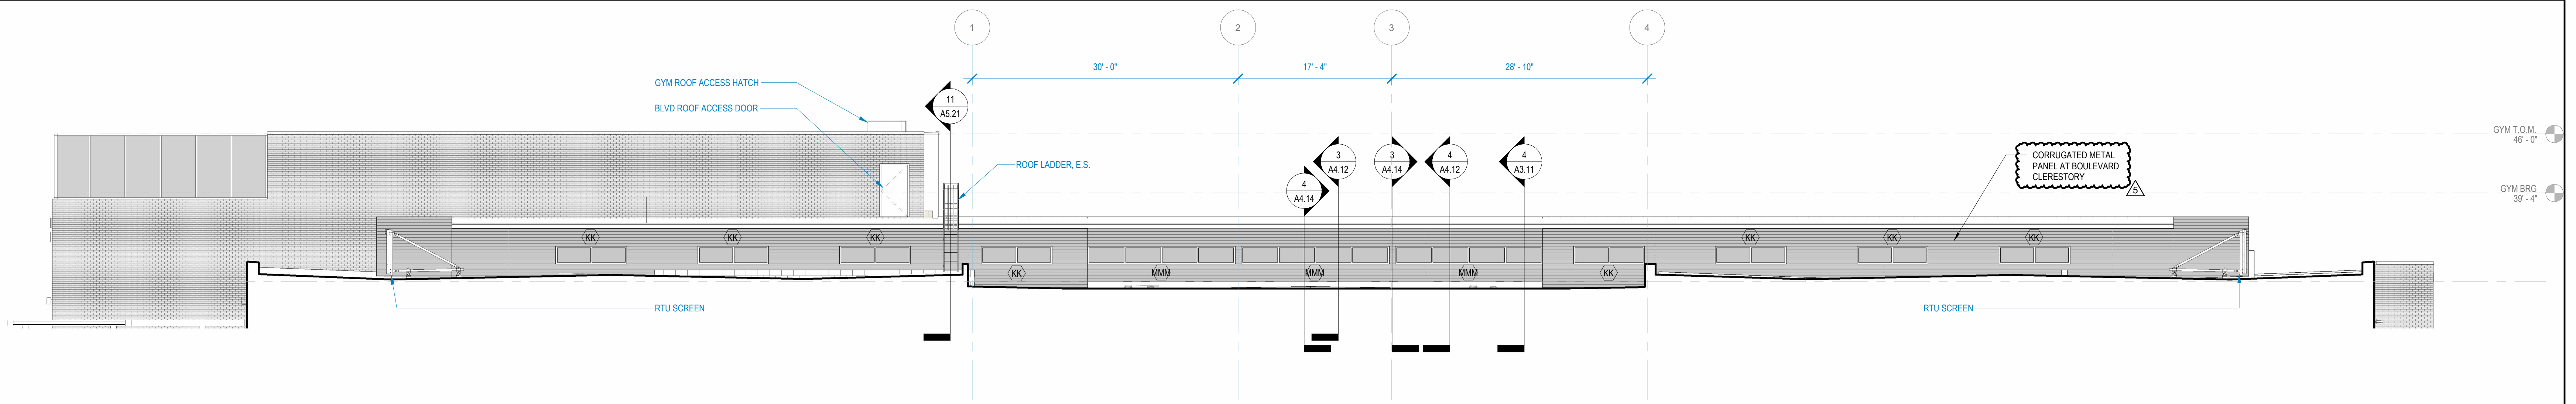

BOULEVARD CLERISTERY WEST ELEVATION
SCALE: 1/8" = 1'-0"
3 A2.13

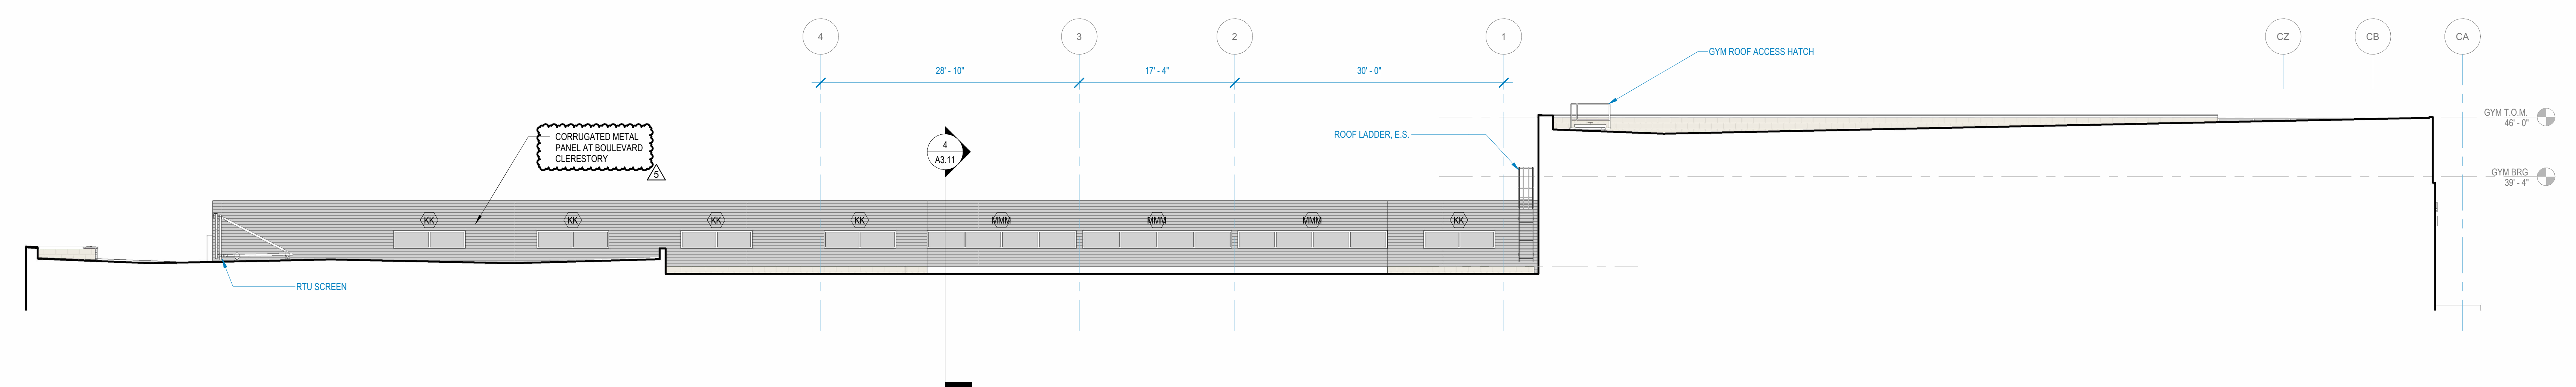

BOULEVARD CLERISTERY EAST ELEVATION
SCALE: 1/8" = 1'-0"
4 A2.13

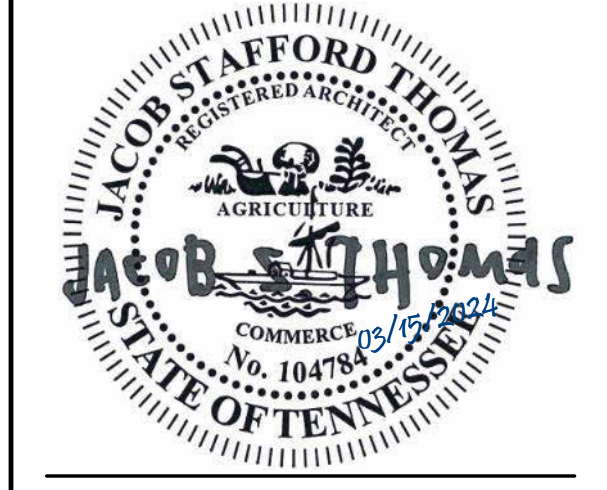

A NEW SCHOOL FACILITY:
HORACE MAYNARD MIDDLE SCHOOL
 UNION COUNTY PUBLIC SCHOOLS
 MAYNARDVILLE, TN


DATE: 03/15/2024
 PROJECT NO: 21074
 SBC NO:

PROJECT REVISIONS


#	DATE	DESCRIPTION
3	05/23/2024	ADD 003
5	06/14/2024	ADD 003

THIS DRAWING IS THE PROPERTY OF THE LEWIS GROUP ARCHITECTS, INC. AND IS TO BE USED ONLY FOR THE PROJECT AND SITE SPECIFICALLY IDENTIFIED HEREIN. THIS DRAWING IS NOT TO BE USED ON ANY OTHER PROJECT WITHOUT THE PROJECT FOR WHICH IT IS MADE OR EXECUTED OR NOT. THIS DRAWING AND ITS CONTENTS ARE THE SOLE POSSESSION OF THE LEWIS GROUP ARCHITECTS, INC. AND SHALL NOT BE UPLOADED IN ANY WAY WITHOUT THEIR FULL CONSENT. IT IS TO BE RETURNED UPON REQUEST.


BUILDING ELEVATIONS - EAST & WEST

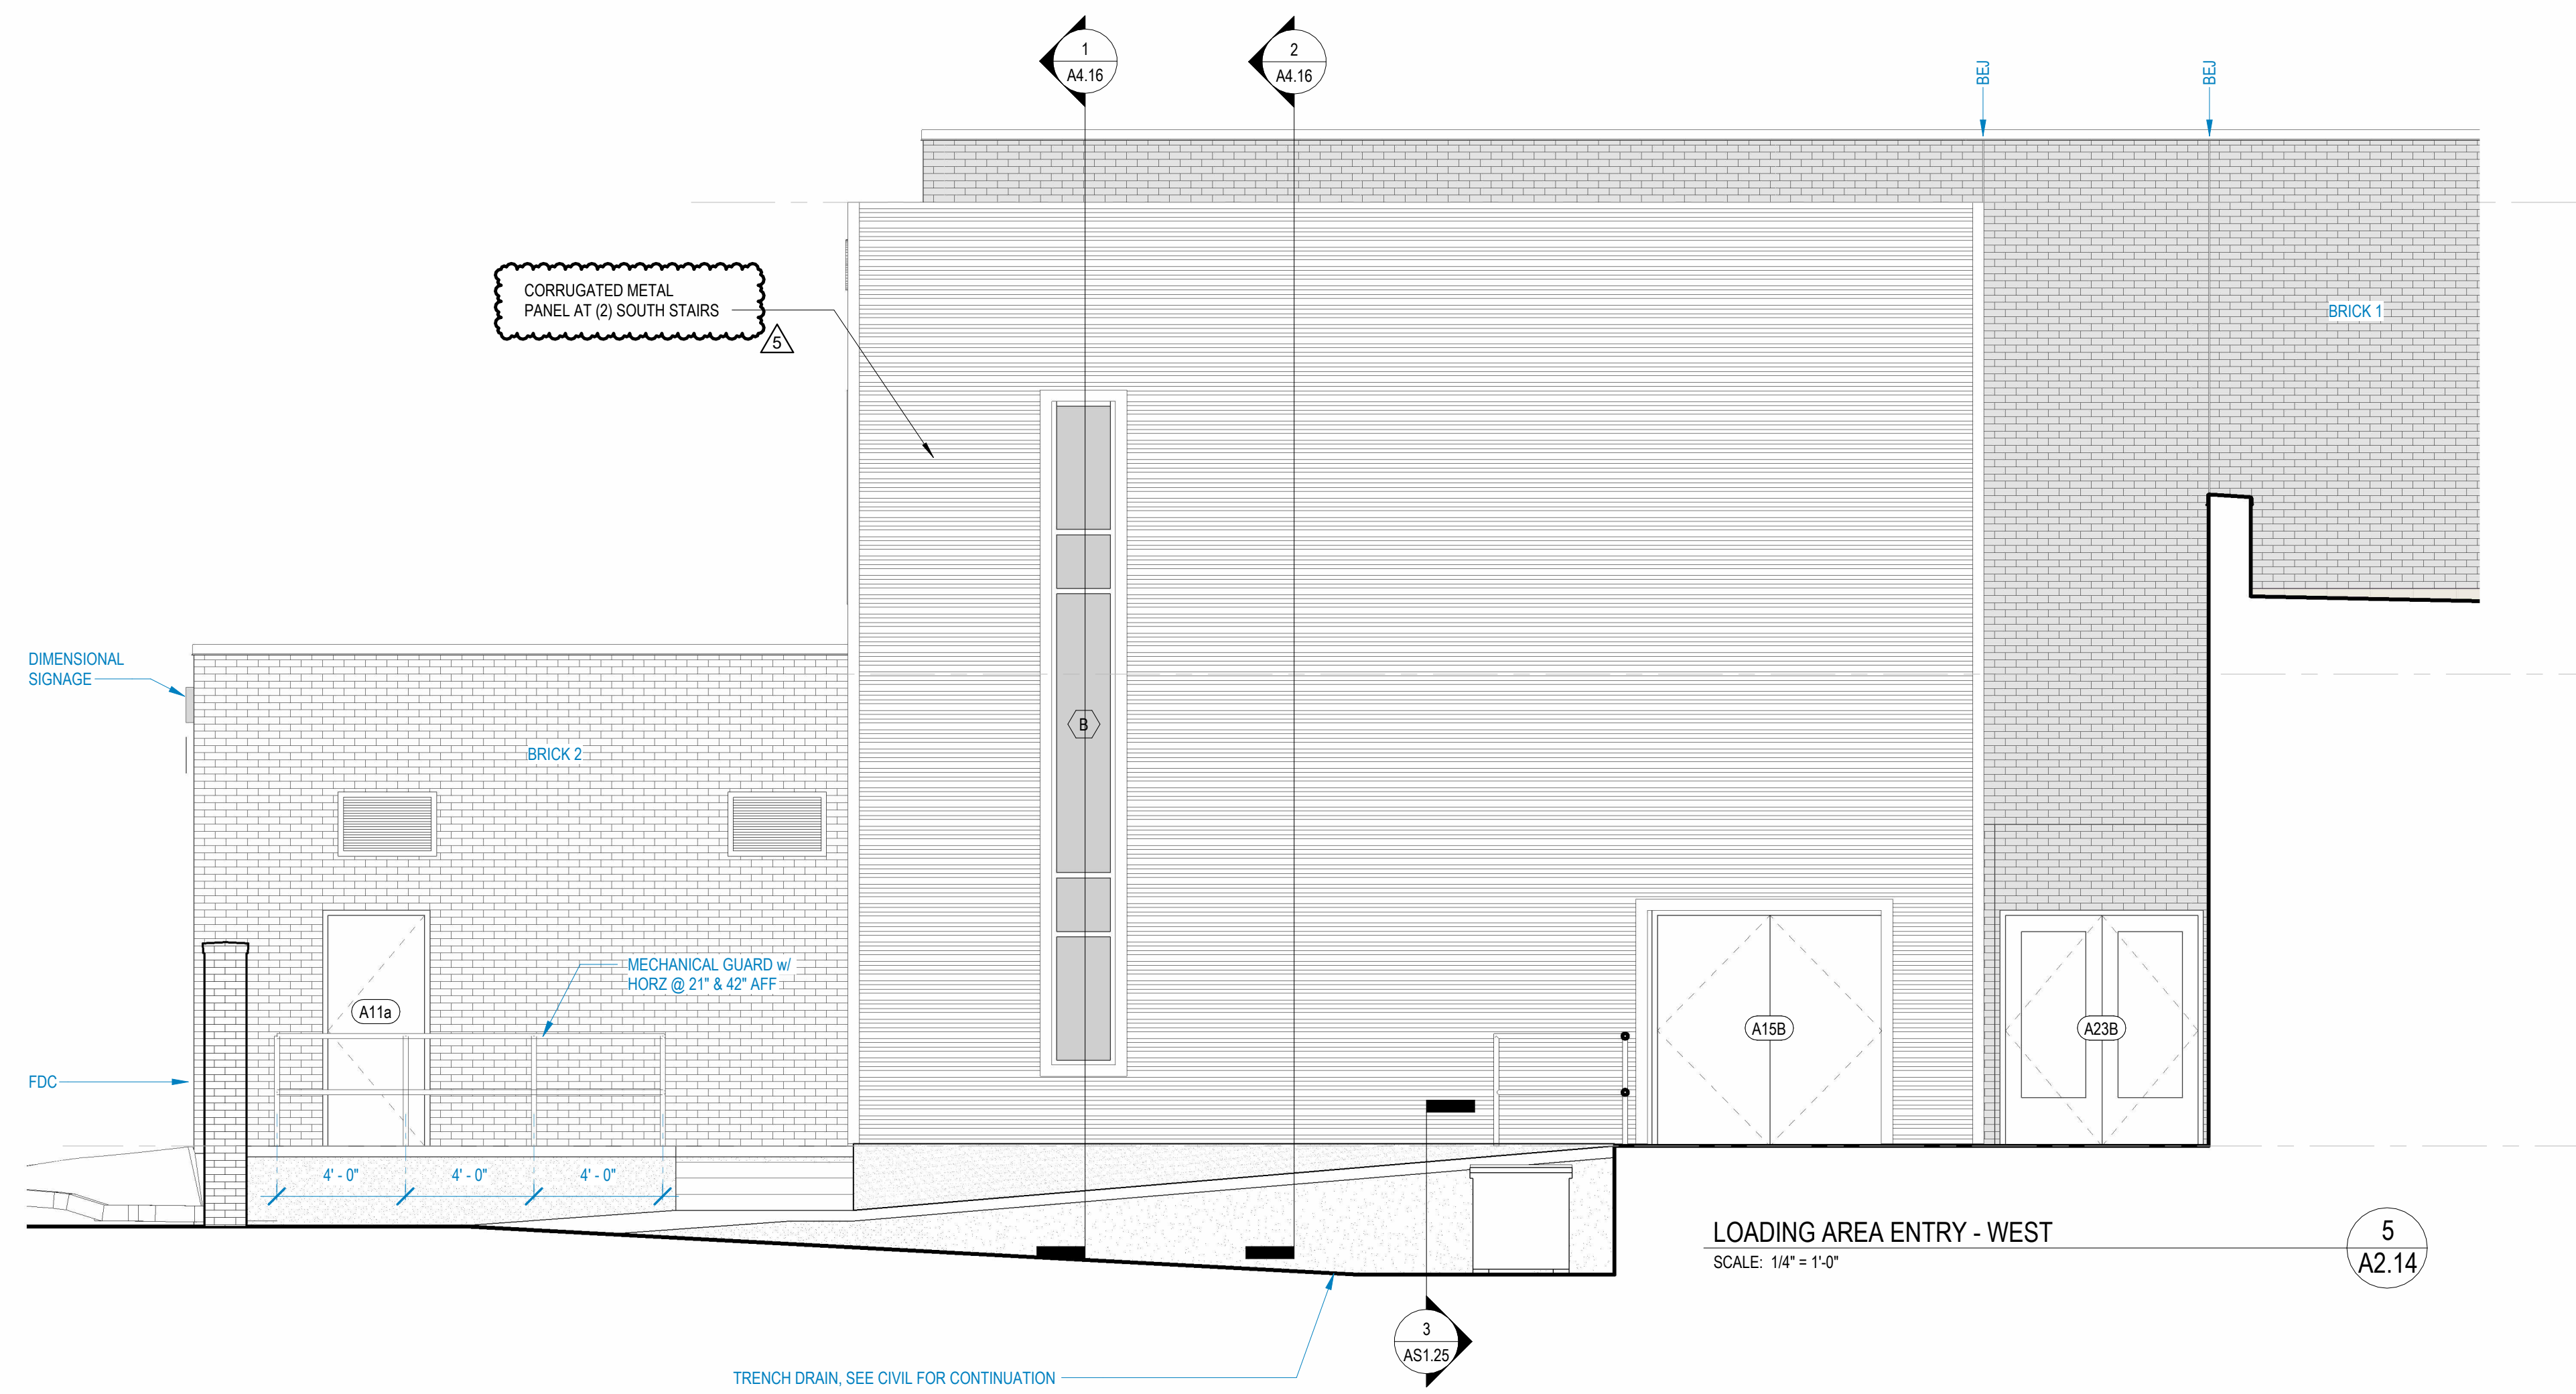


LOADING AREA ENTRY - WEST
SCALE: 1/4" = 1'-0"

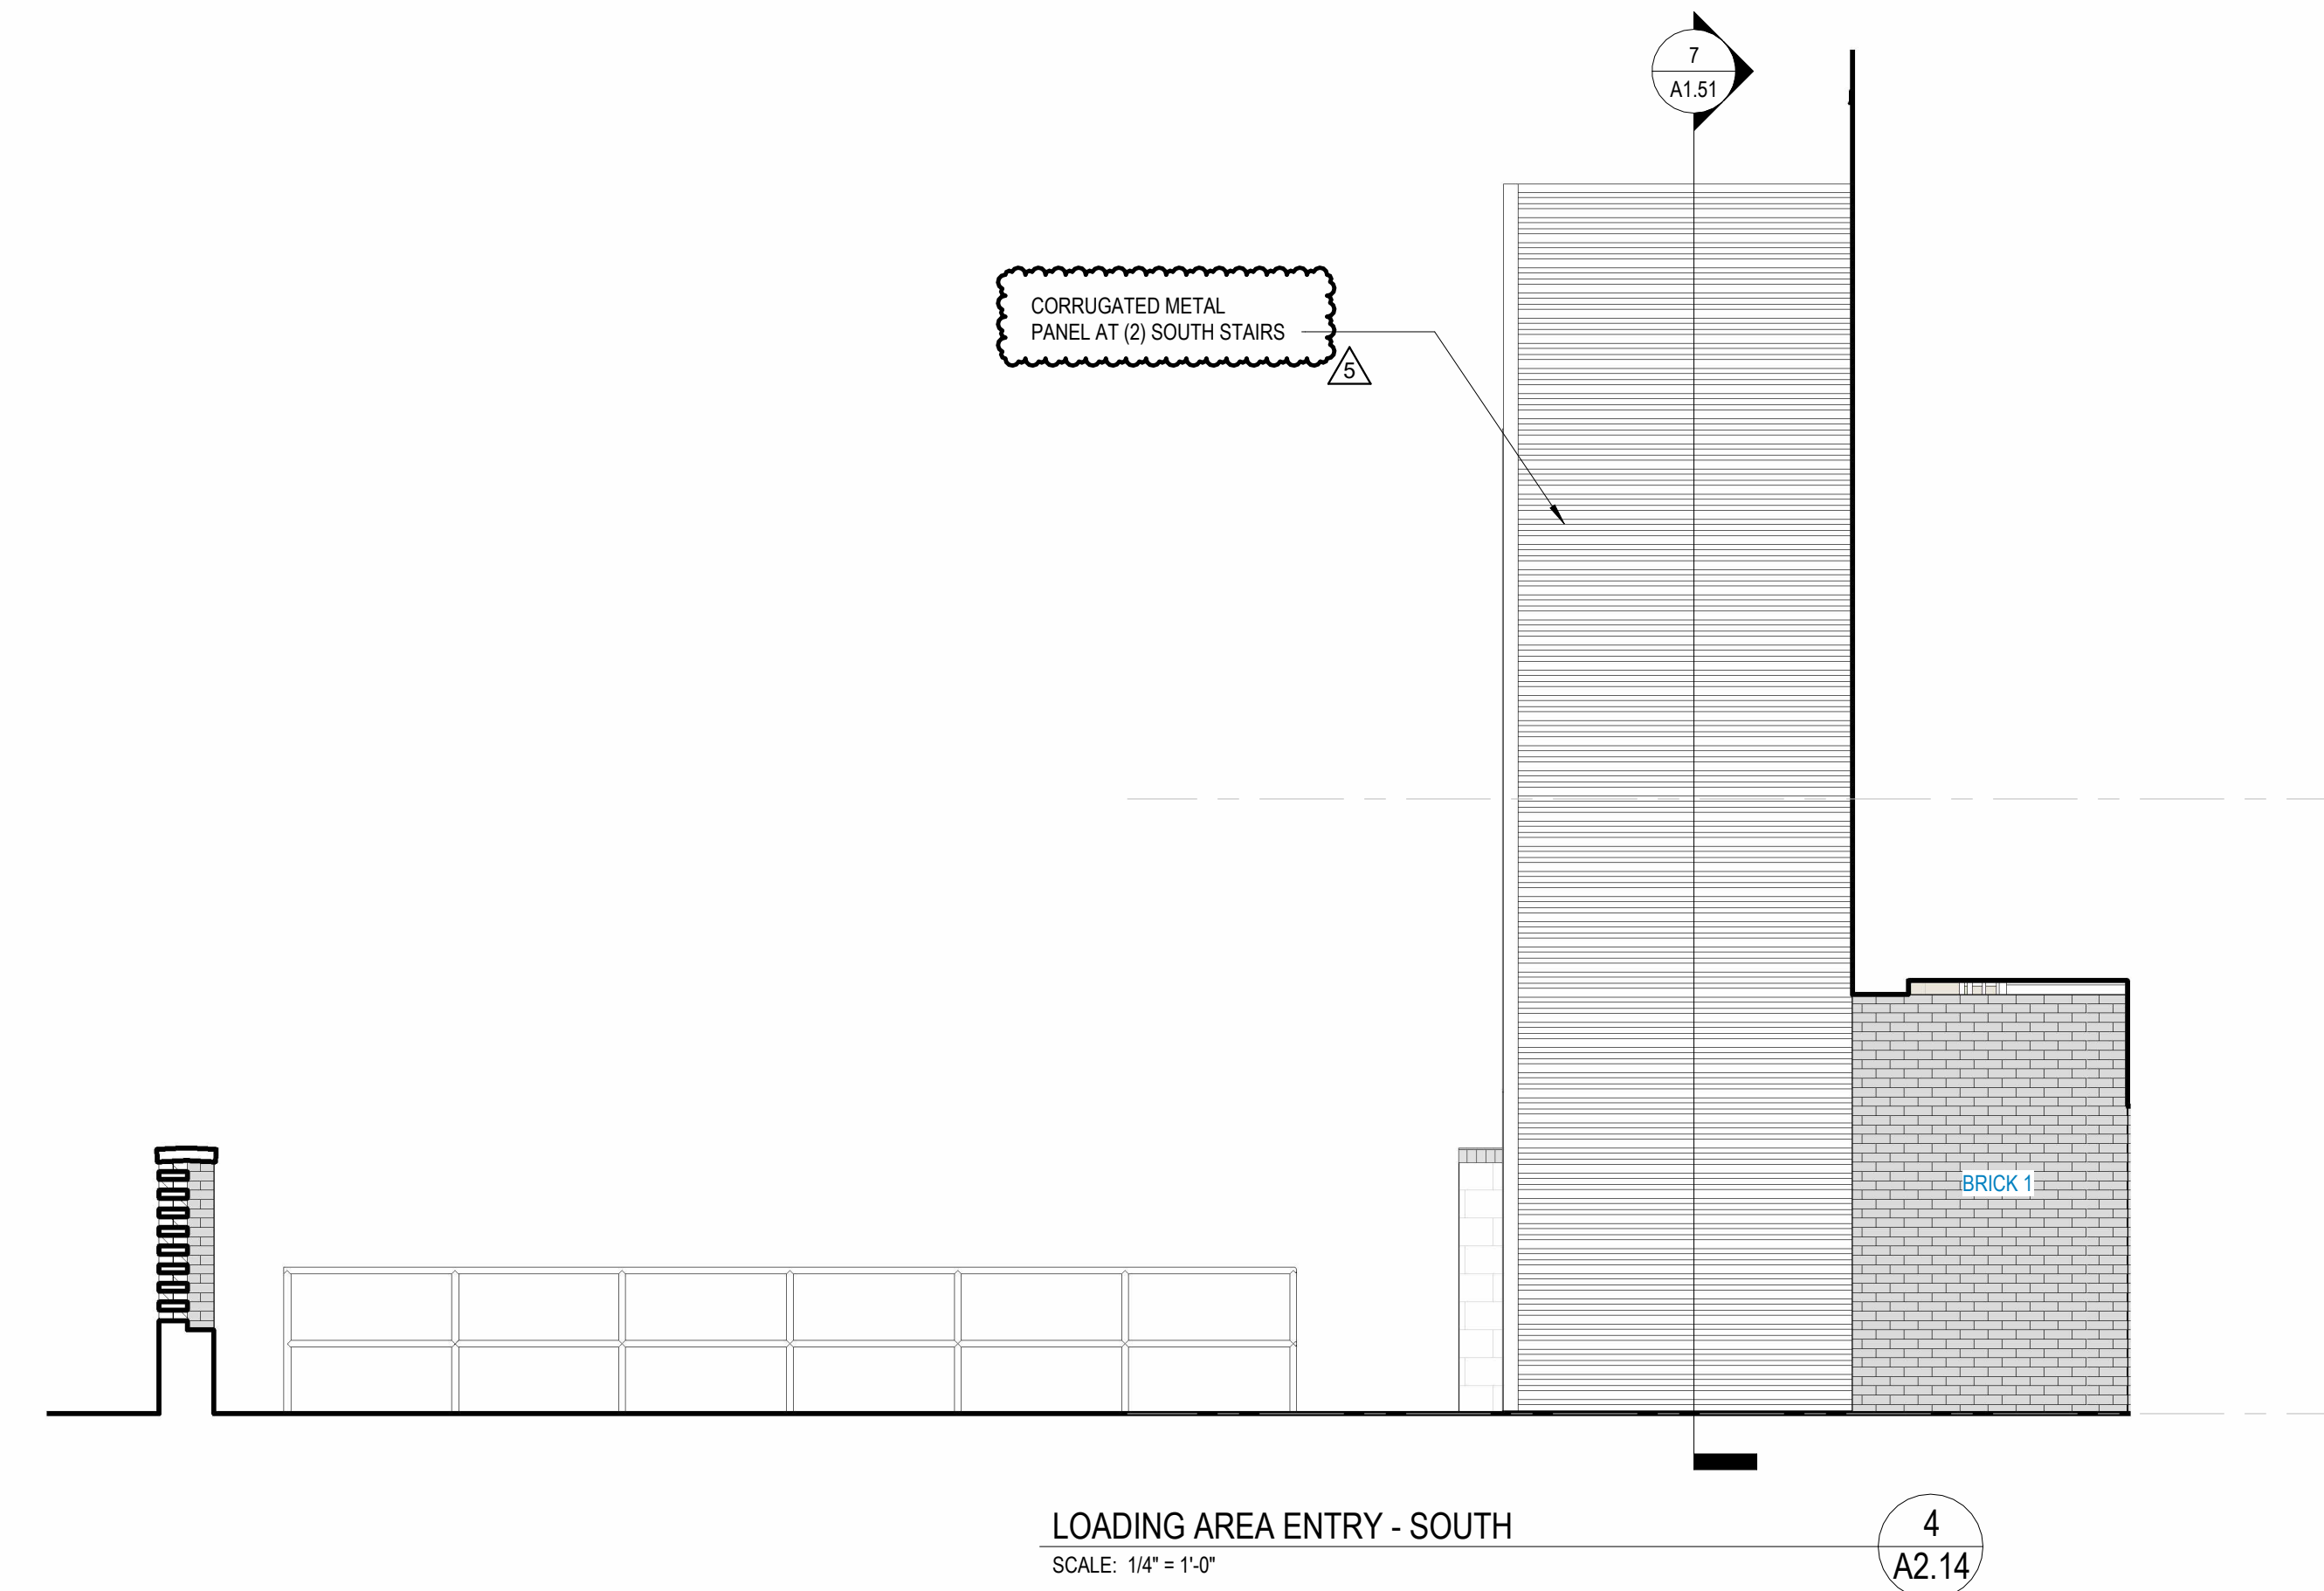


LOADING AREA ENTRY - SOUTH
SCALE: 1/4" = 1'-0"

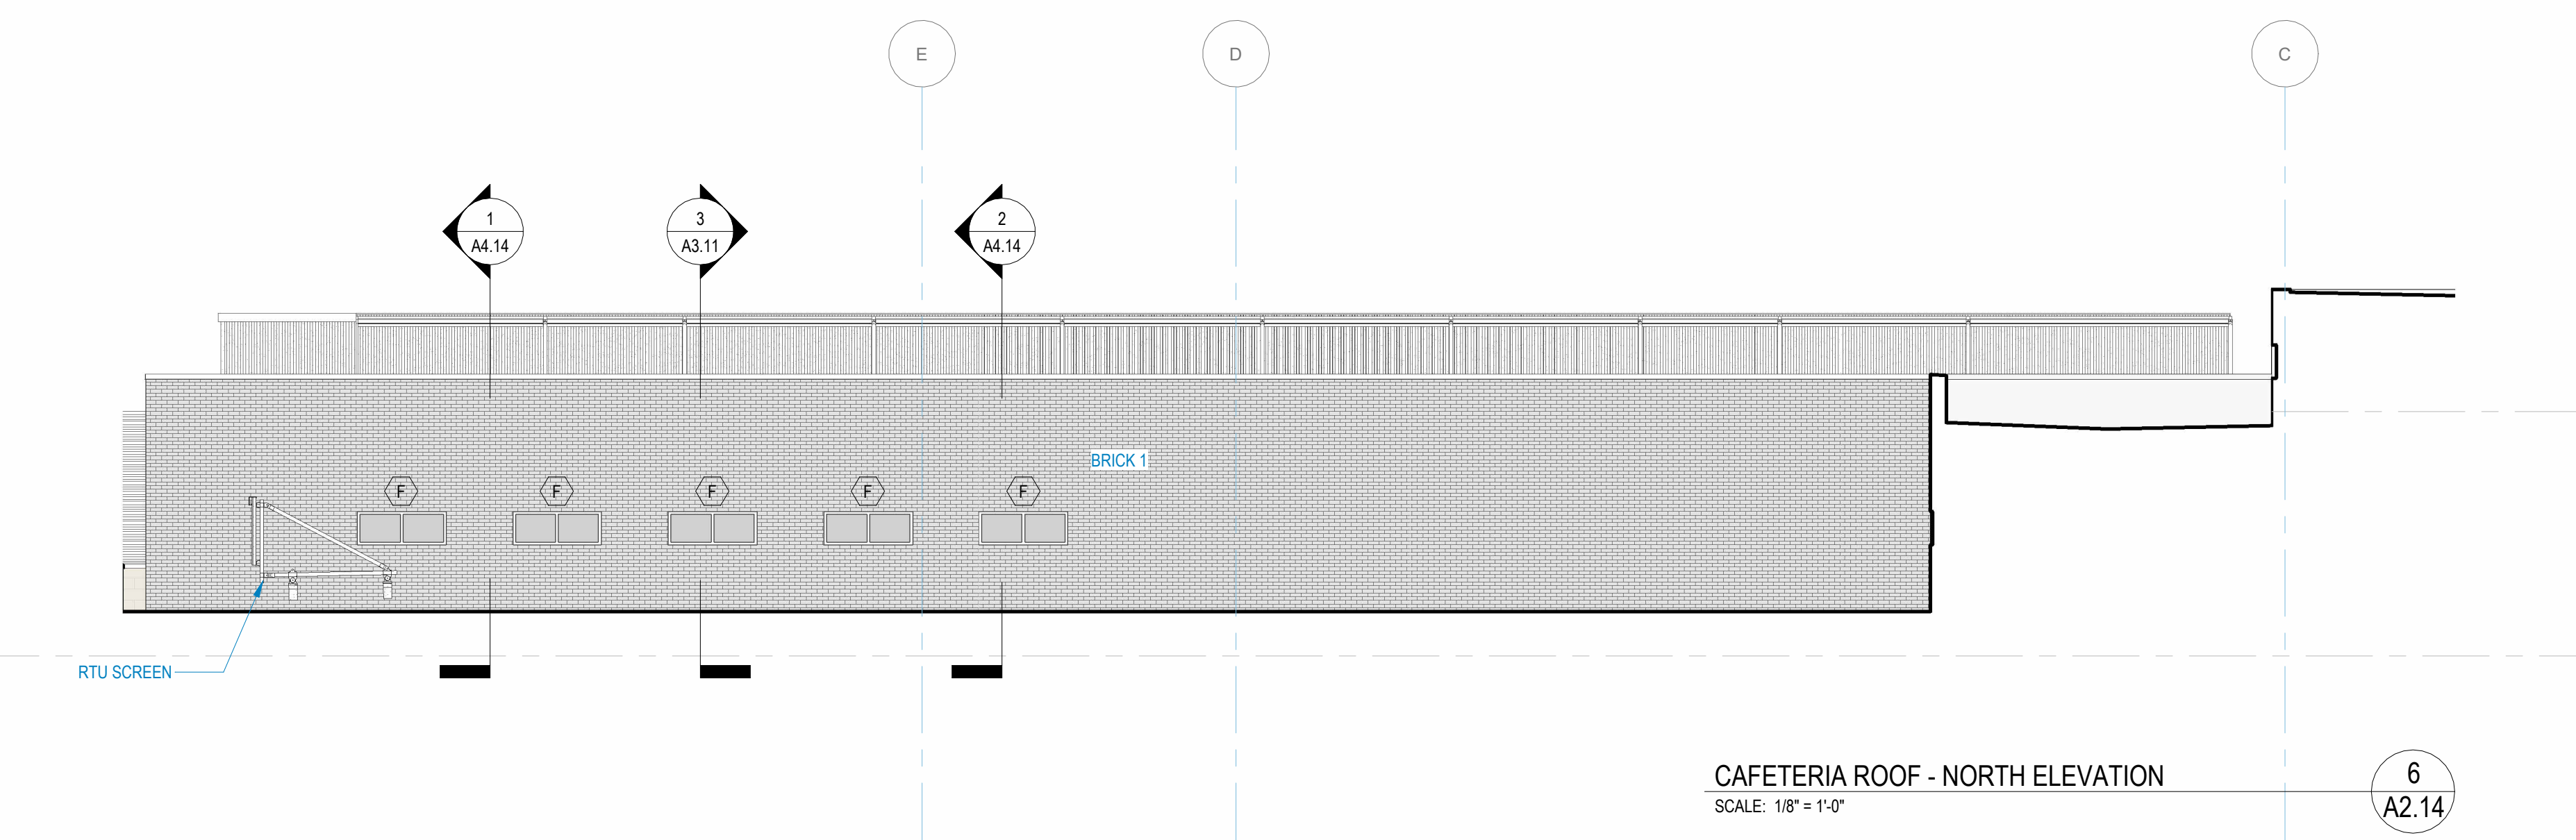


CAFETERIA ROOF - NORTH ELEVATION
SCALE: 1/8" = 1'-0"

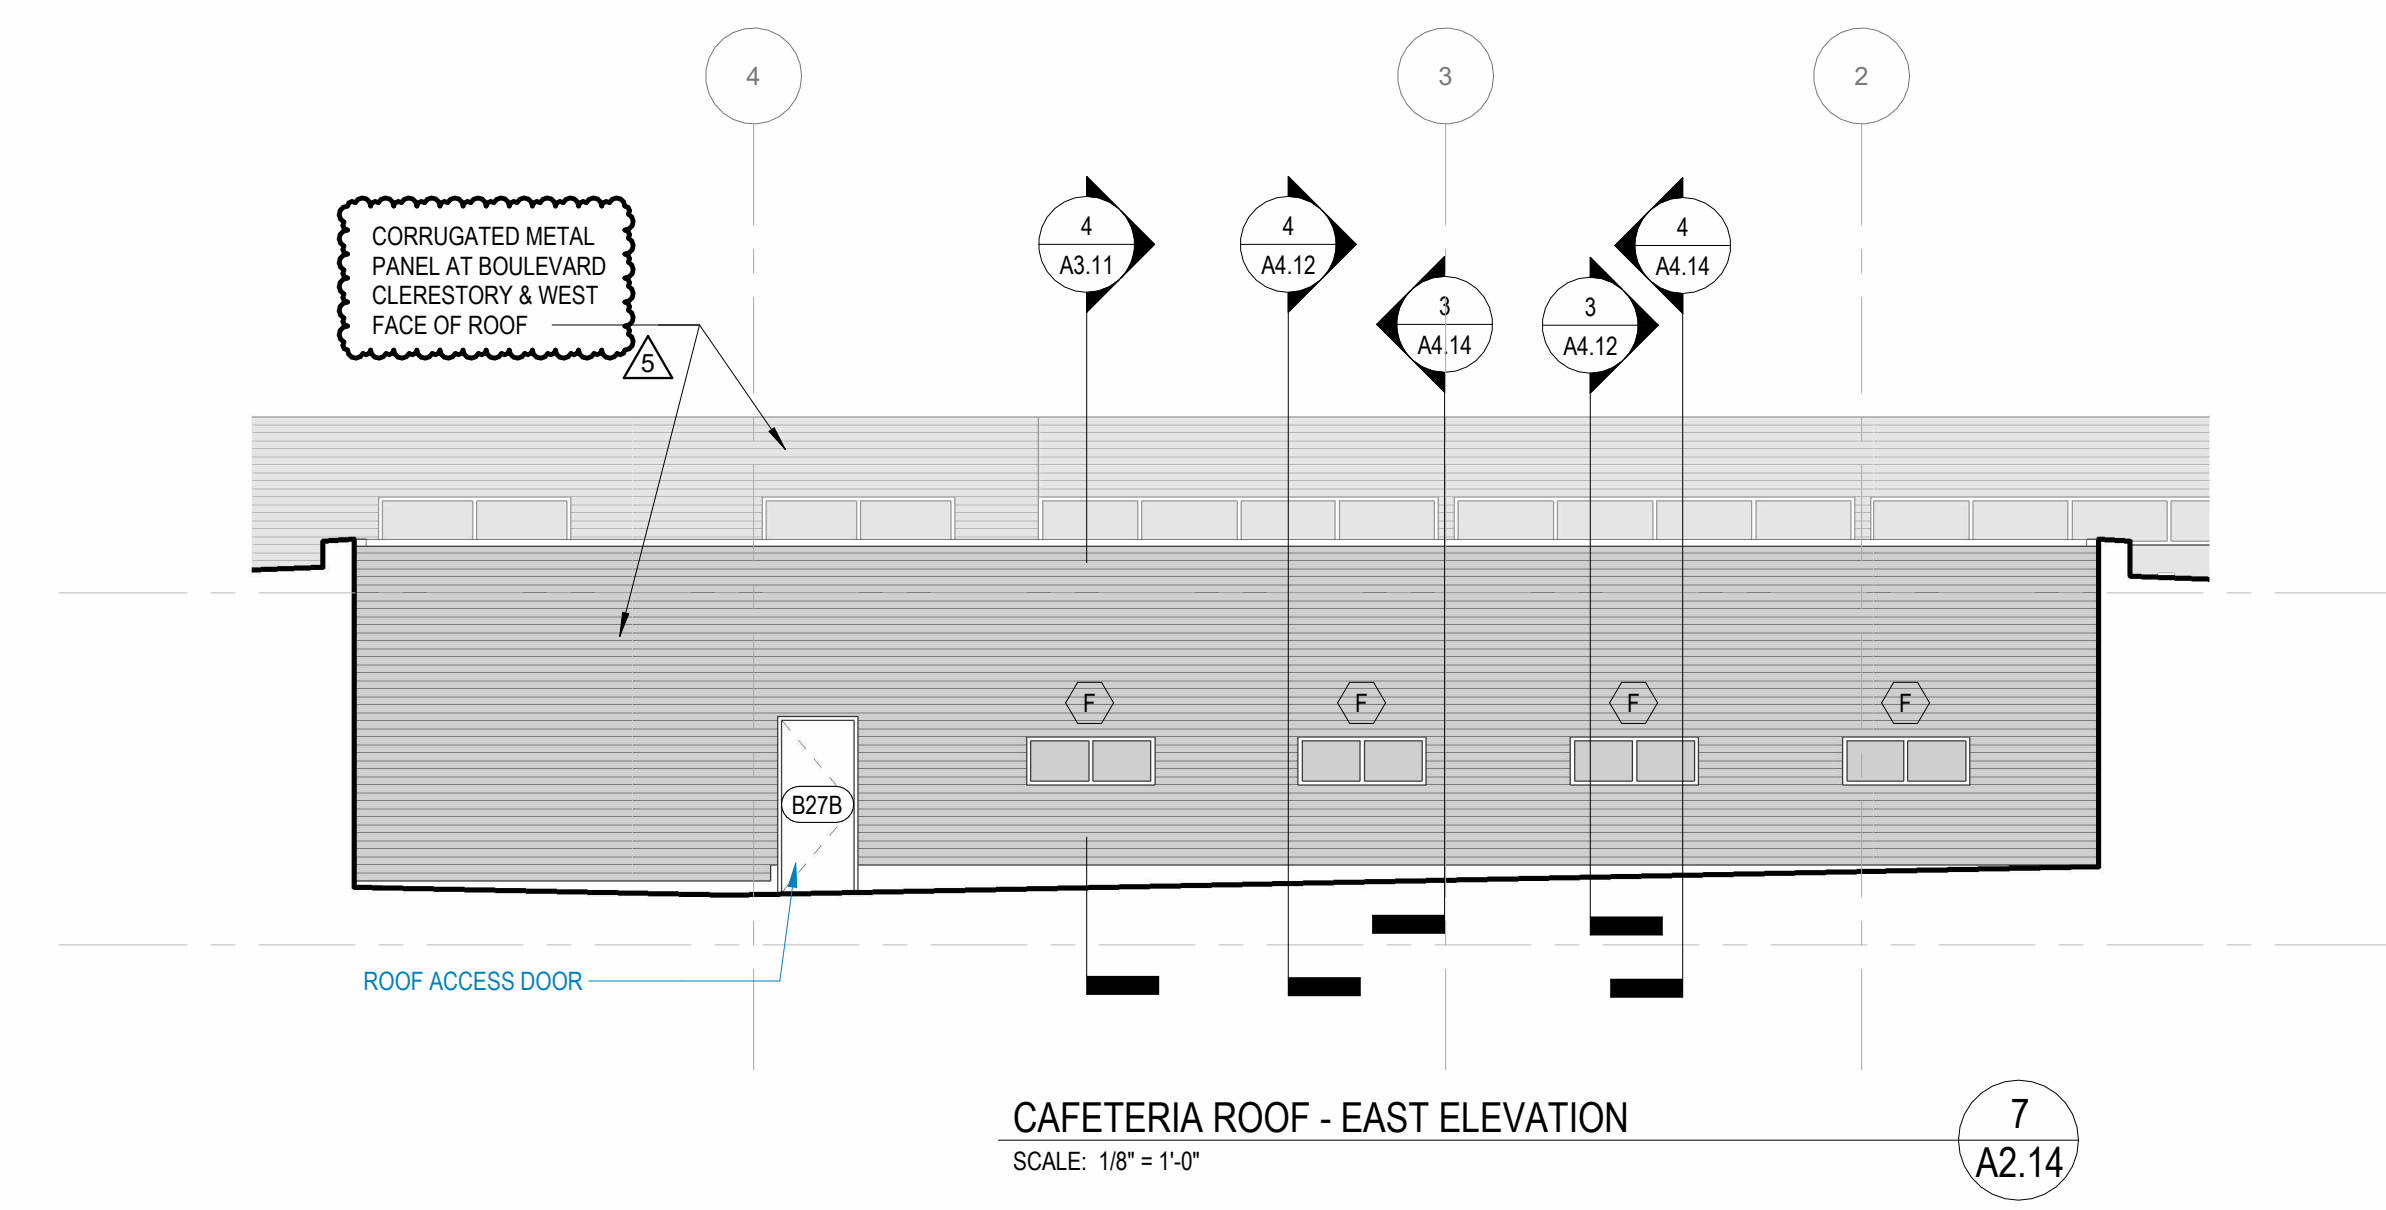


CAFETERIA ROOF - EAST ELEVATION
SCALE: 1/8" = 1'-0"

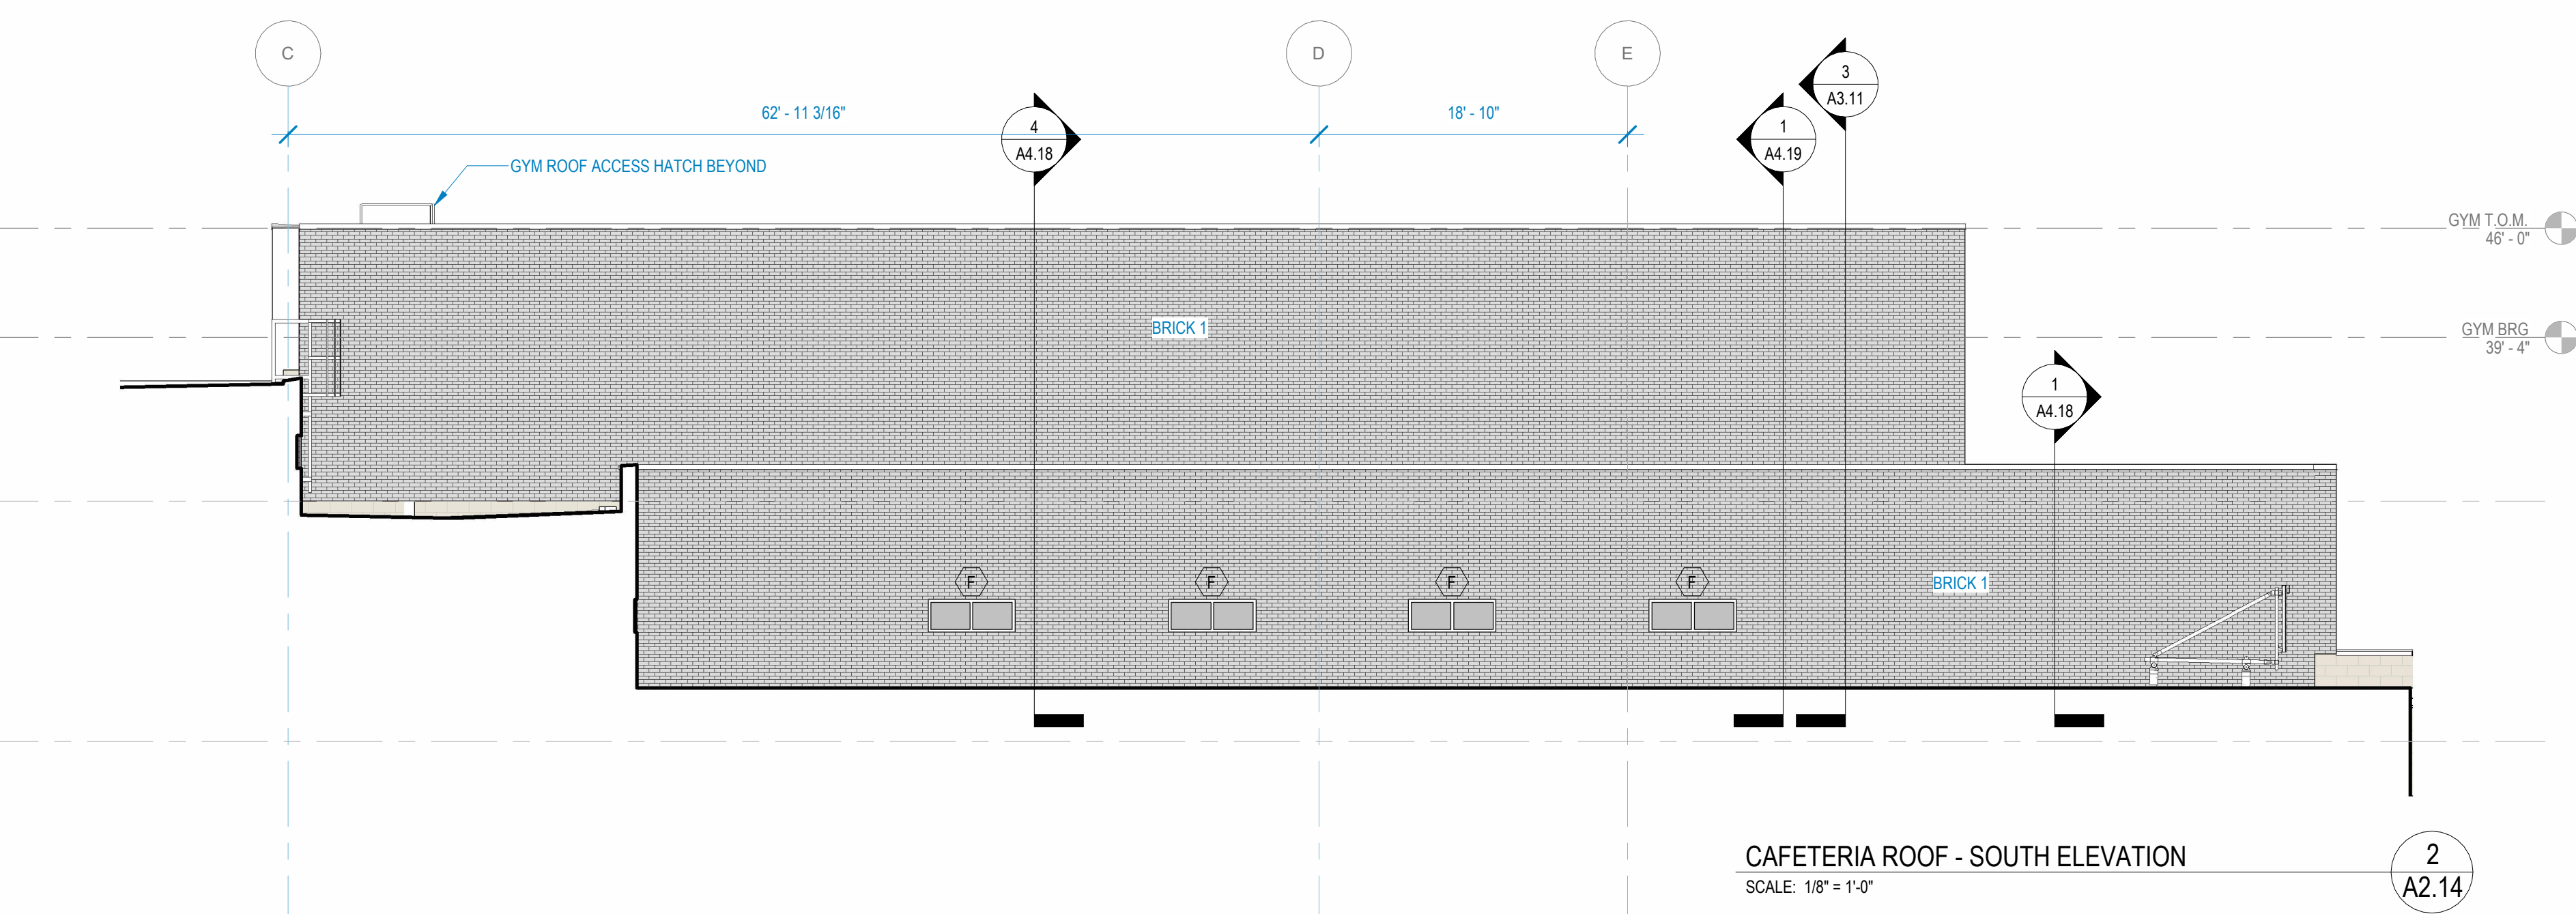


CAFETERIA ROOF - SOUTH ELEVATION
SCALE: 1/8" = 1'-0"

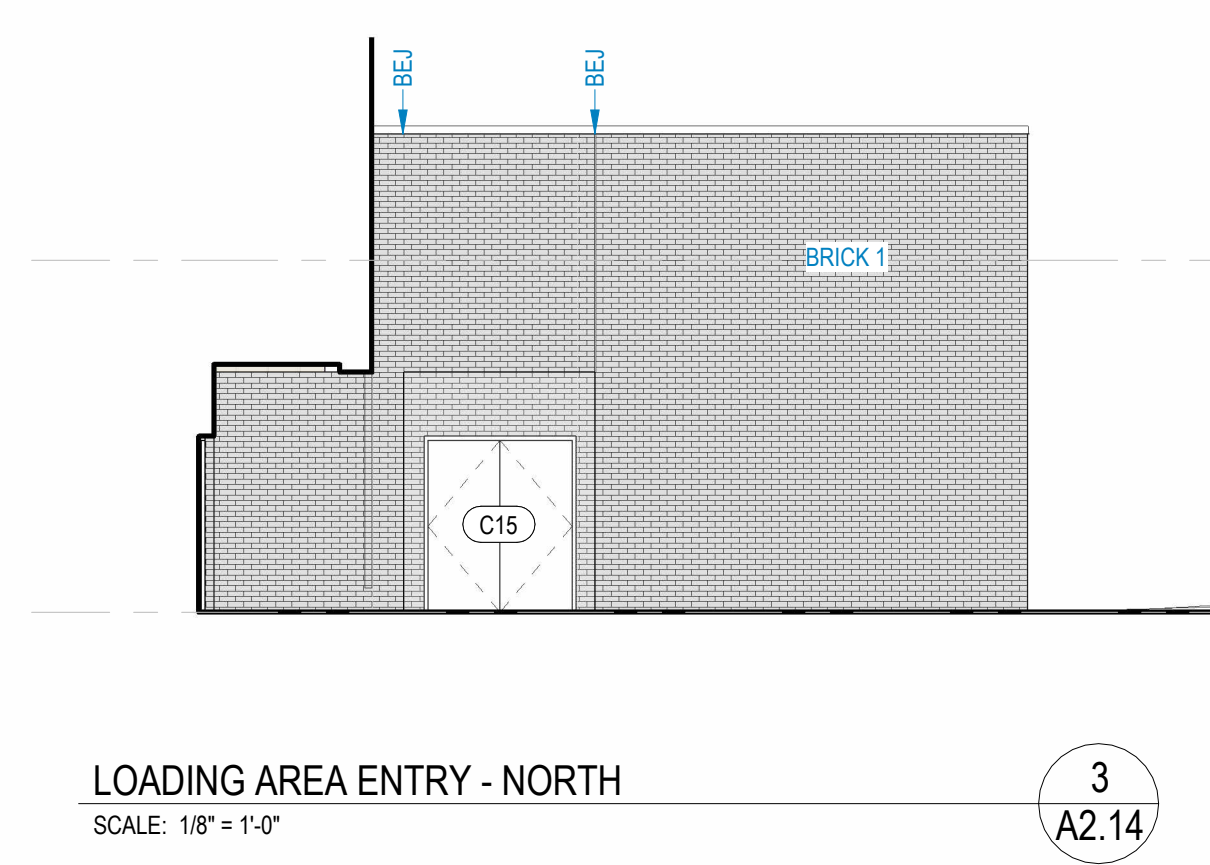

LOADING AREA ENTRY - NORTH
SCALE: 1/8" = 1'-0"

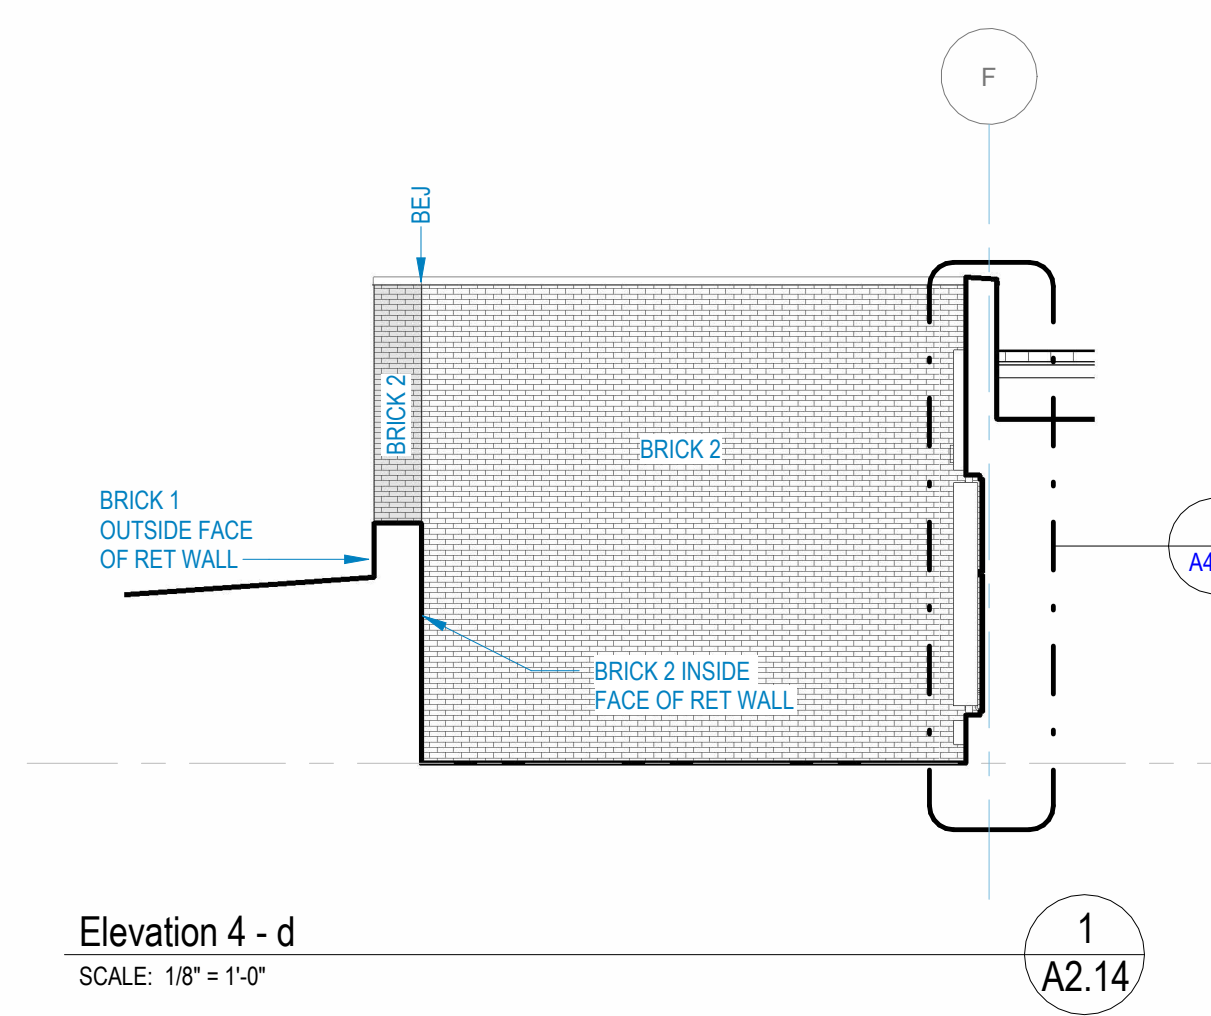

Elevation 4 - d
SCALE: 1/8" = 1'-0"

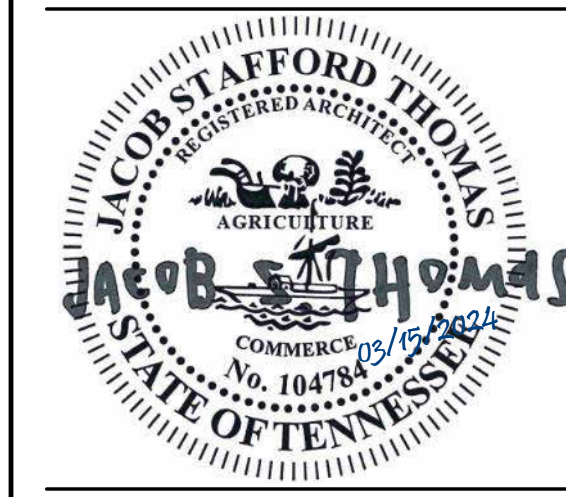


A NEW SCHOOL FACILITY:
HORACE MAYNARD MIDDLE SCHOOL
UNION COUNTY PUBLIC SCHOOLS
MAYNARDVILLE, TN

DATE: 03/15/2024
PROJECT NO: 21074
SBC NO:


#	DATE	DESCRIPTION
3	05/23/2024	ADD 003
5	06/14/2024	ADD 003

THIS DRAWING IS THE PROPERTY OF THE LEWIS GROUP ARCHITECTS, INC. AND IS TO BE USED ONLY FOR THE PROJECT AND SITE SPECIFICALLY IDENTIFIED HEREIN. THIS DRAWING IS NOT TO BE USED ON ANY OTHER PROJECT WITHOUT THE PROJECT FOR WHICH IT IS MADE OR EXECUTED OR NOT. THIS DRAWING AND ITS CONTENTS ARE THE SOLE POSSESSION OF THE LEWIS GROUP ARCHITECTS, INC. AND SHALL NOT BE UPLOADED IN ANY WAY WITHOUT THEIR FULL CONSENT. IT IS TO BE RETURNED UPON REQUEST.


BUILDING ELEVATIONS - HIDDEN

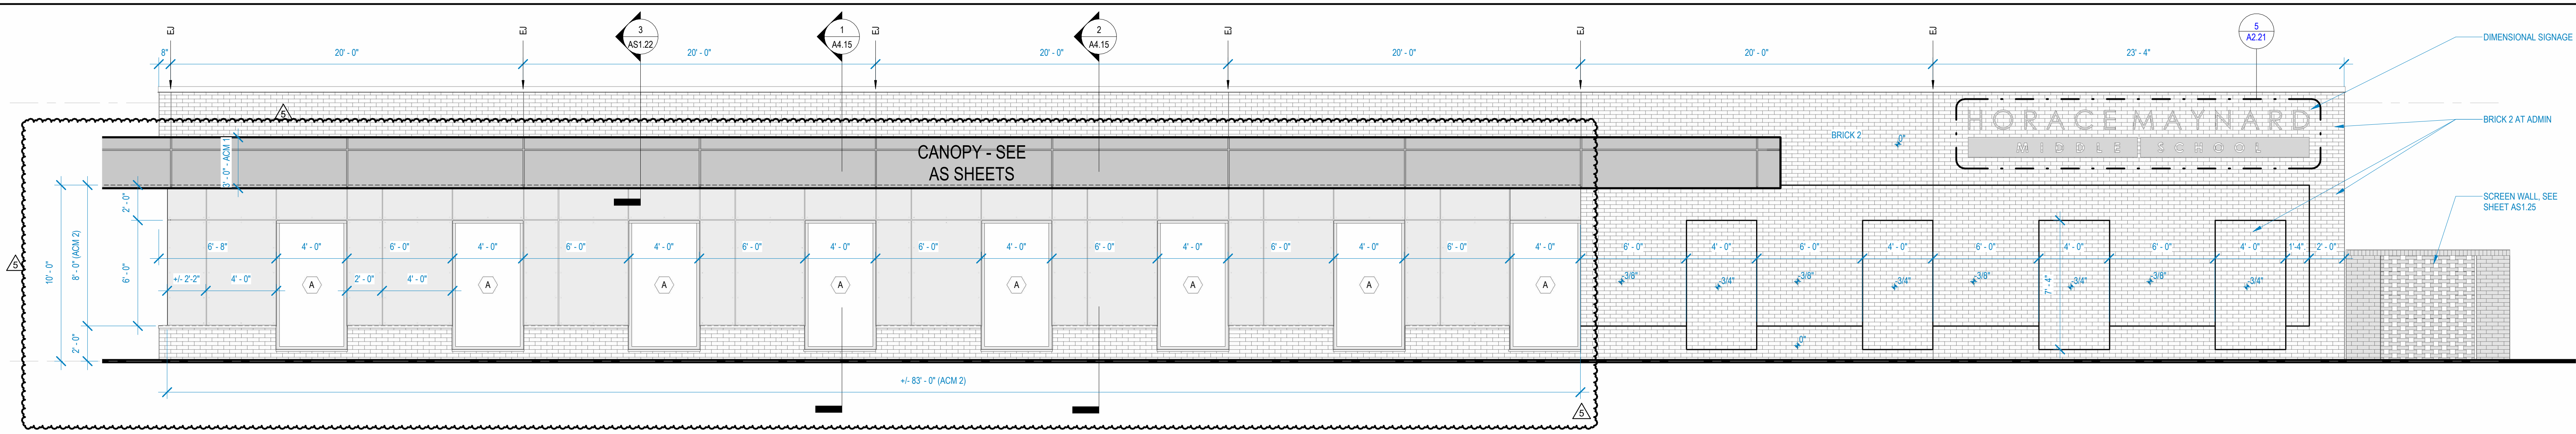


ENLARGED ELEVATION - ADMIN SOUTH
SCALE: 1/4" = 1'-0"
1
A2.21

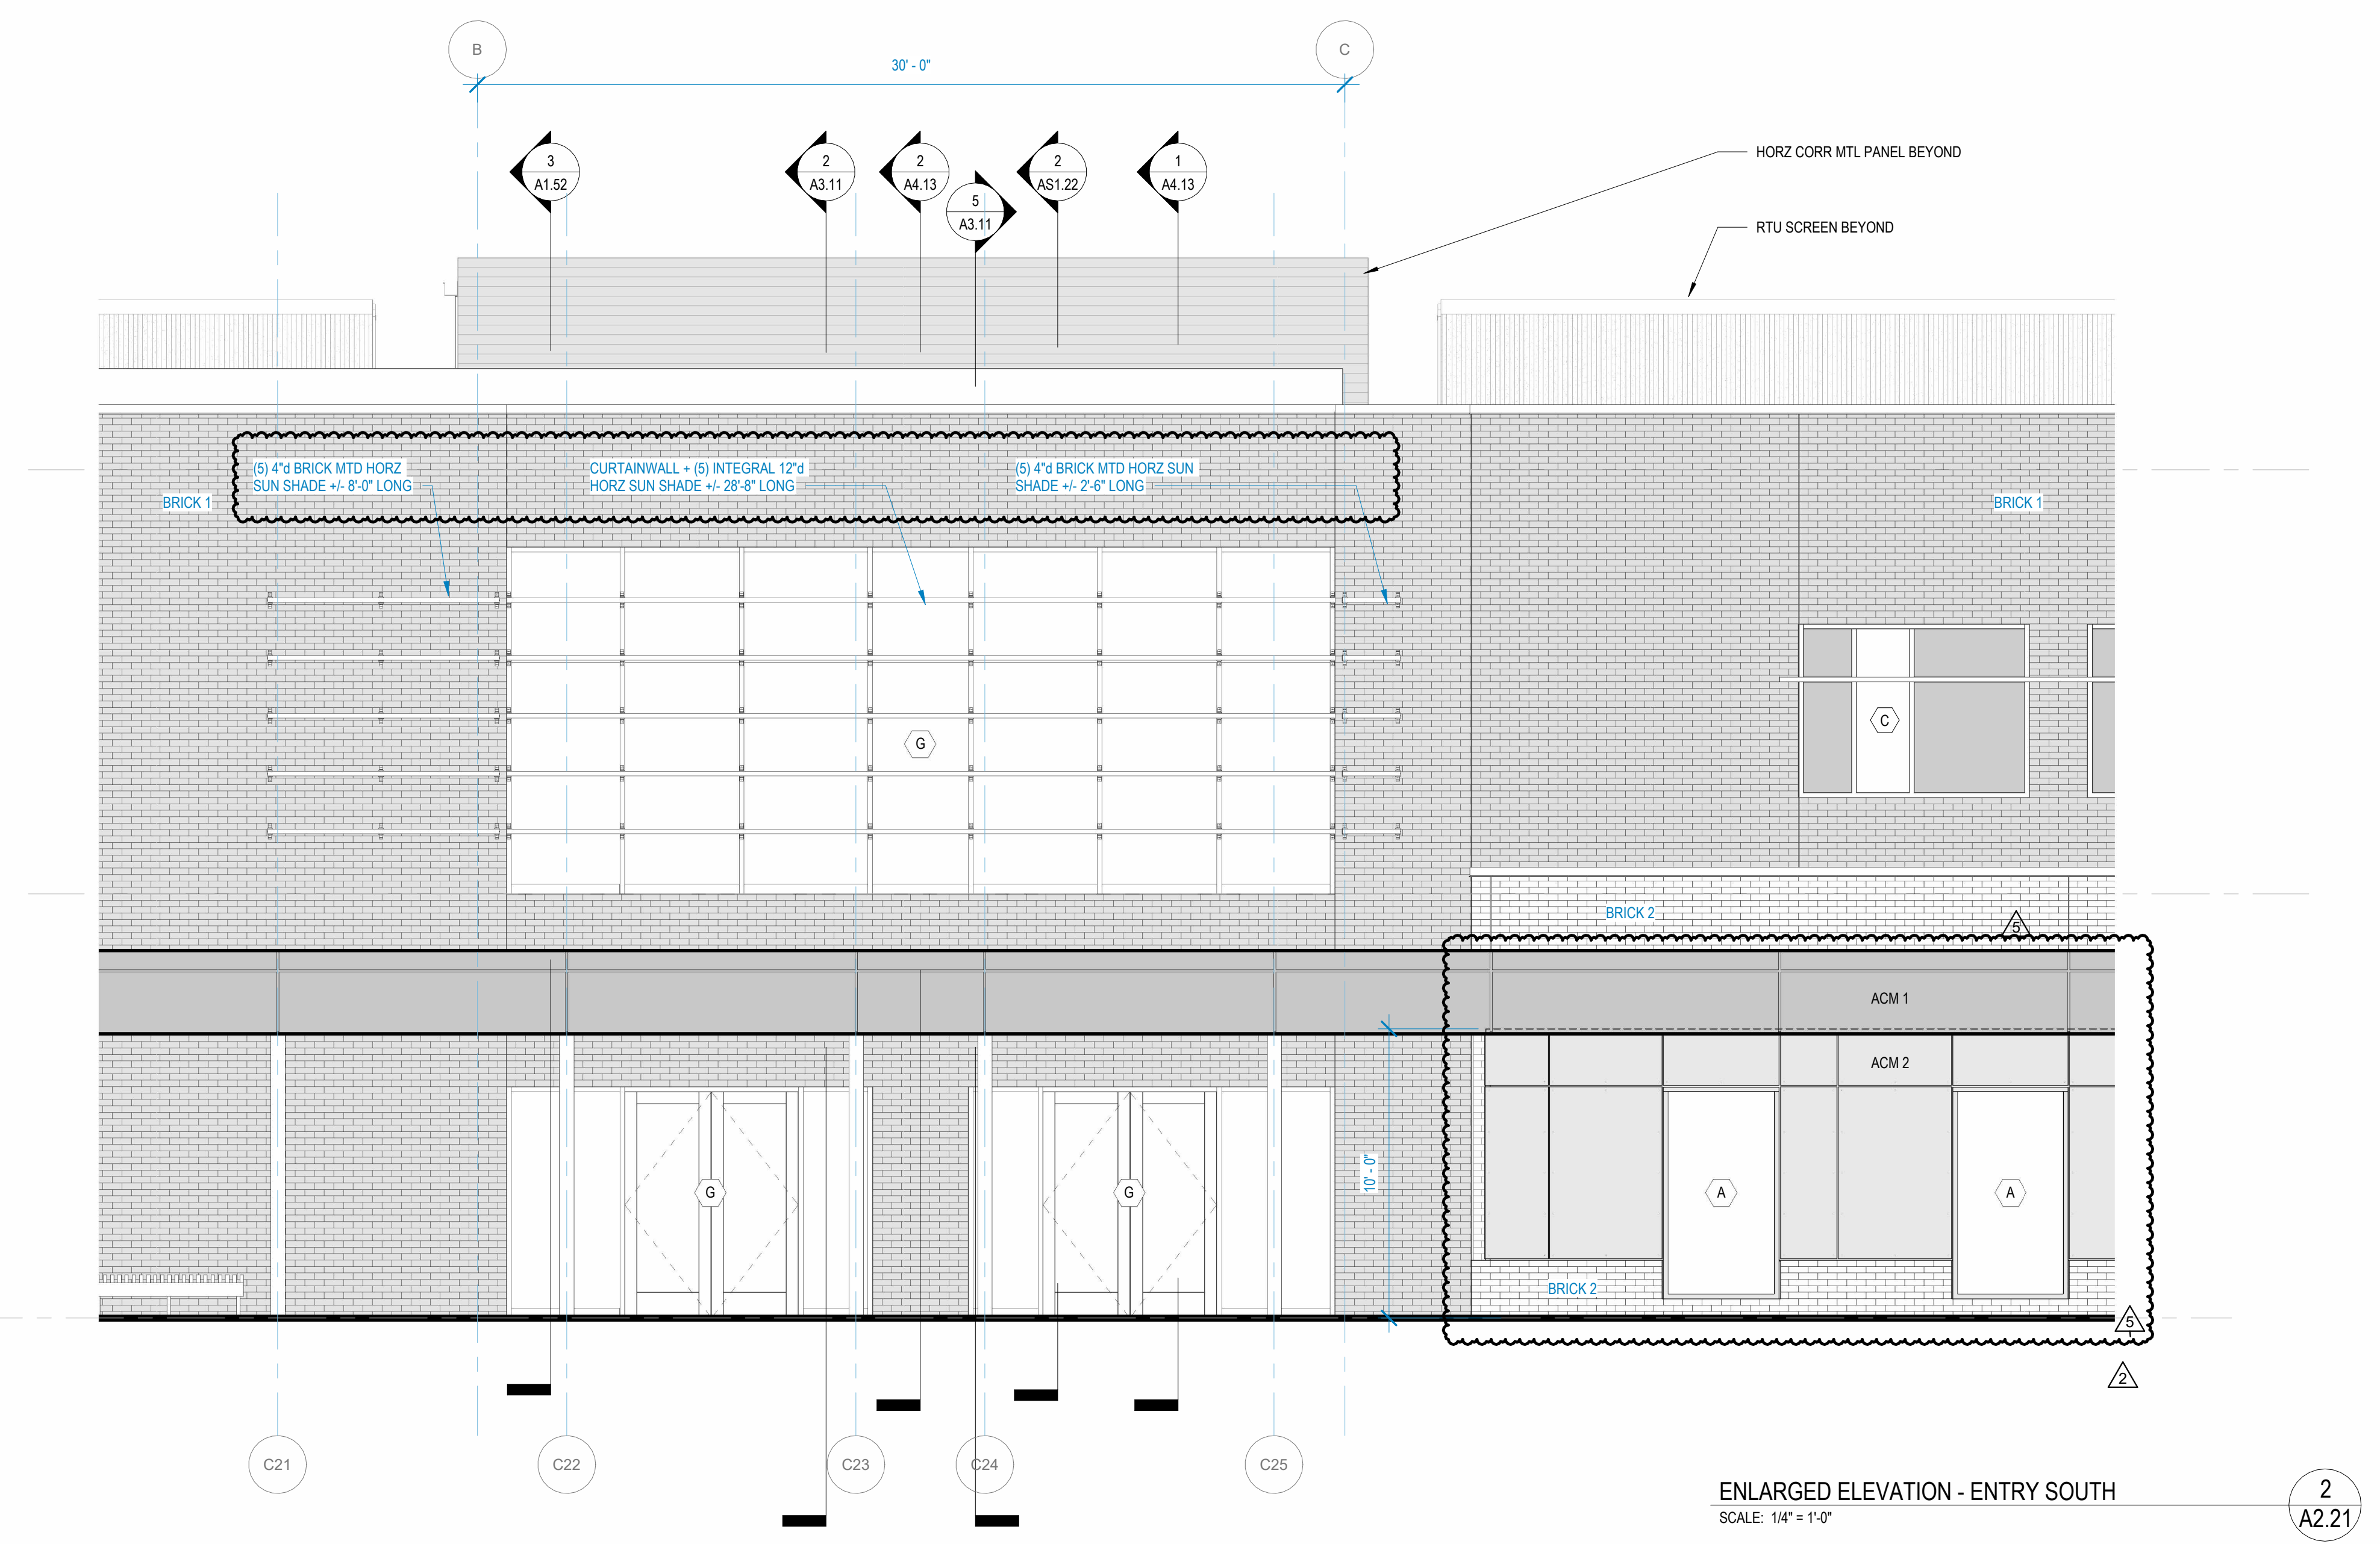


ENLARGED ELEVATION - ENTRY SOUTH
SCALE: 1/4" = 1'-0"
2
A2.21

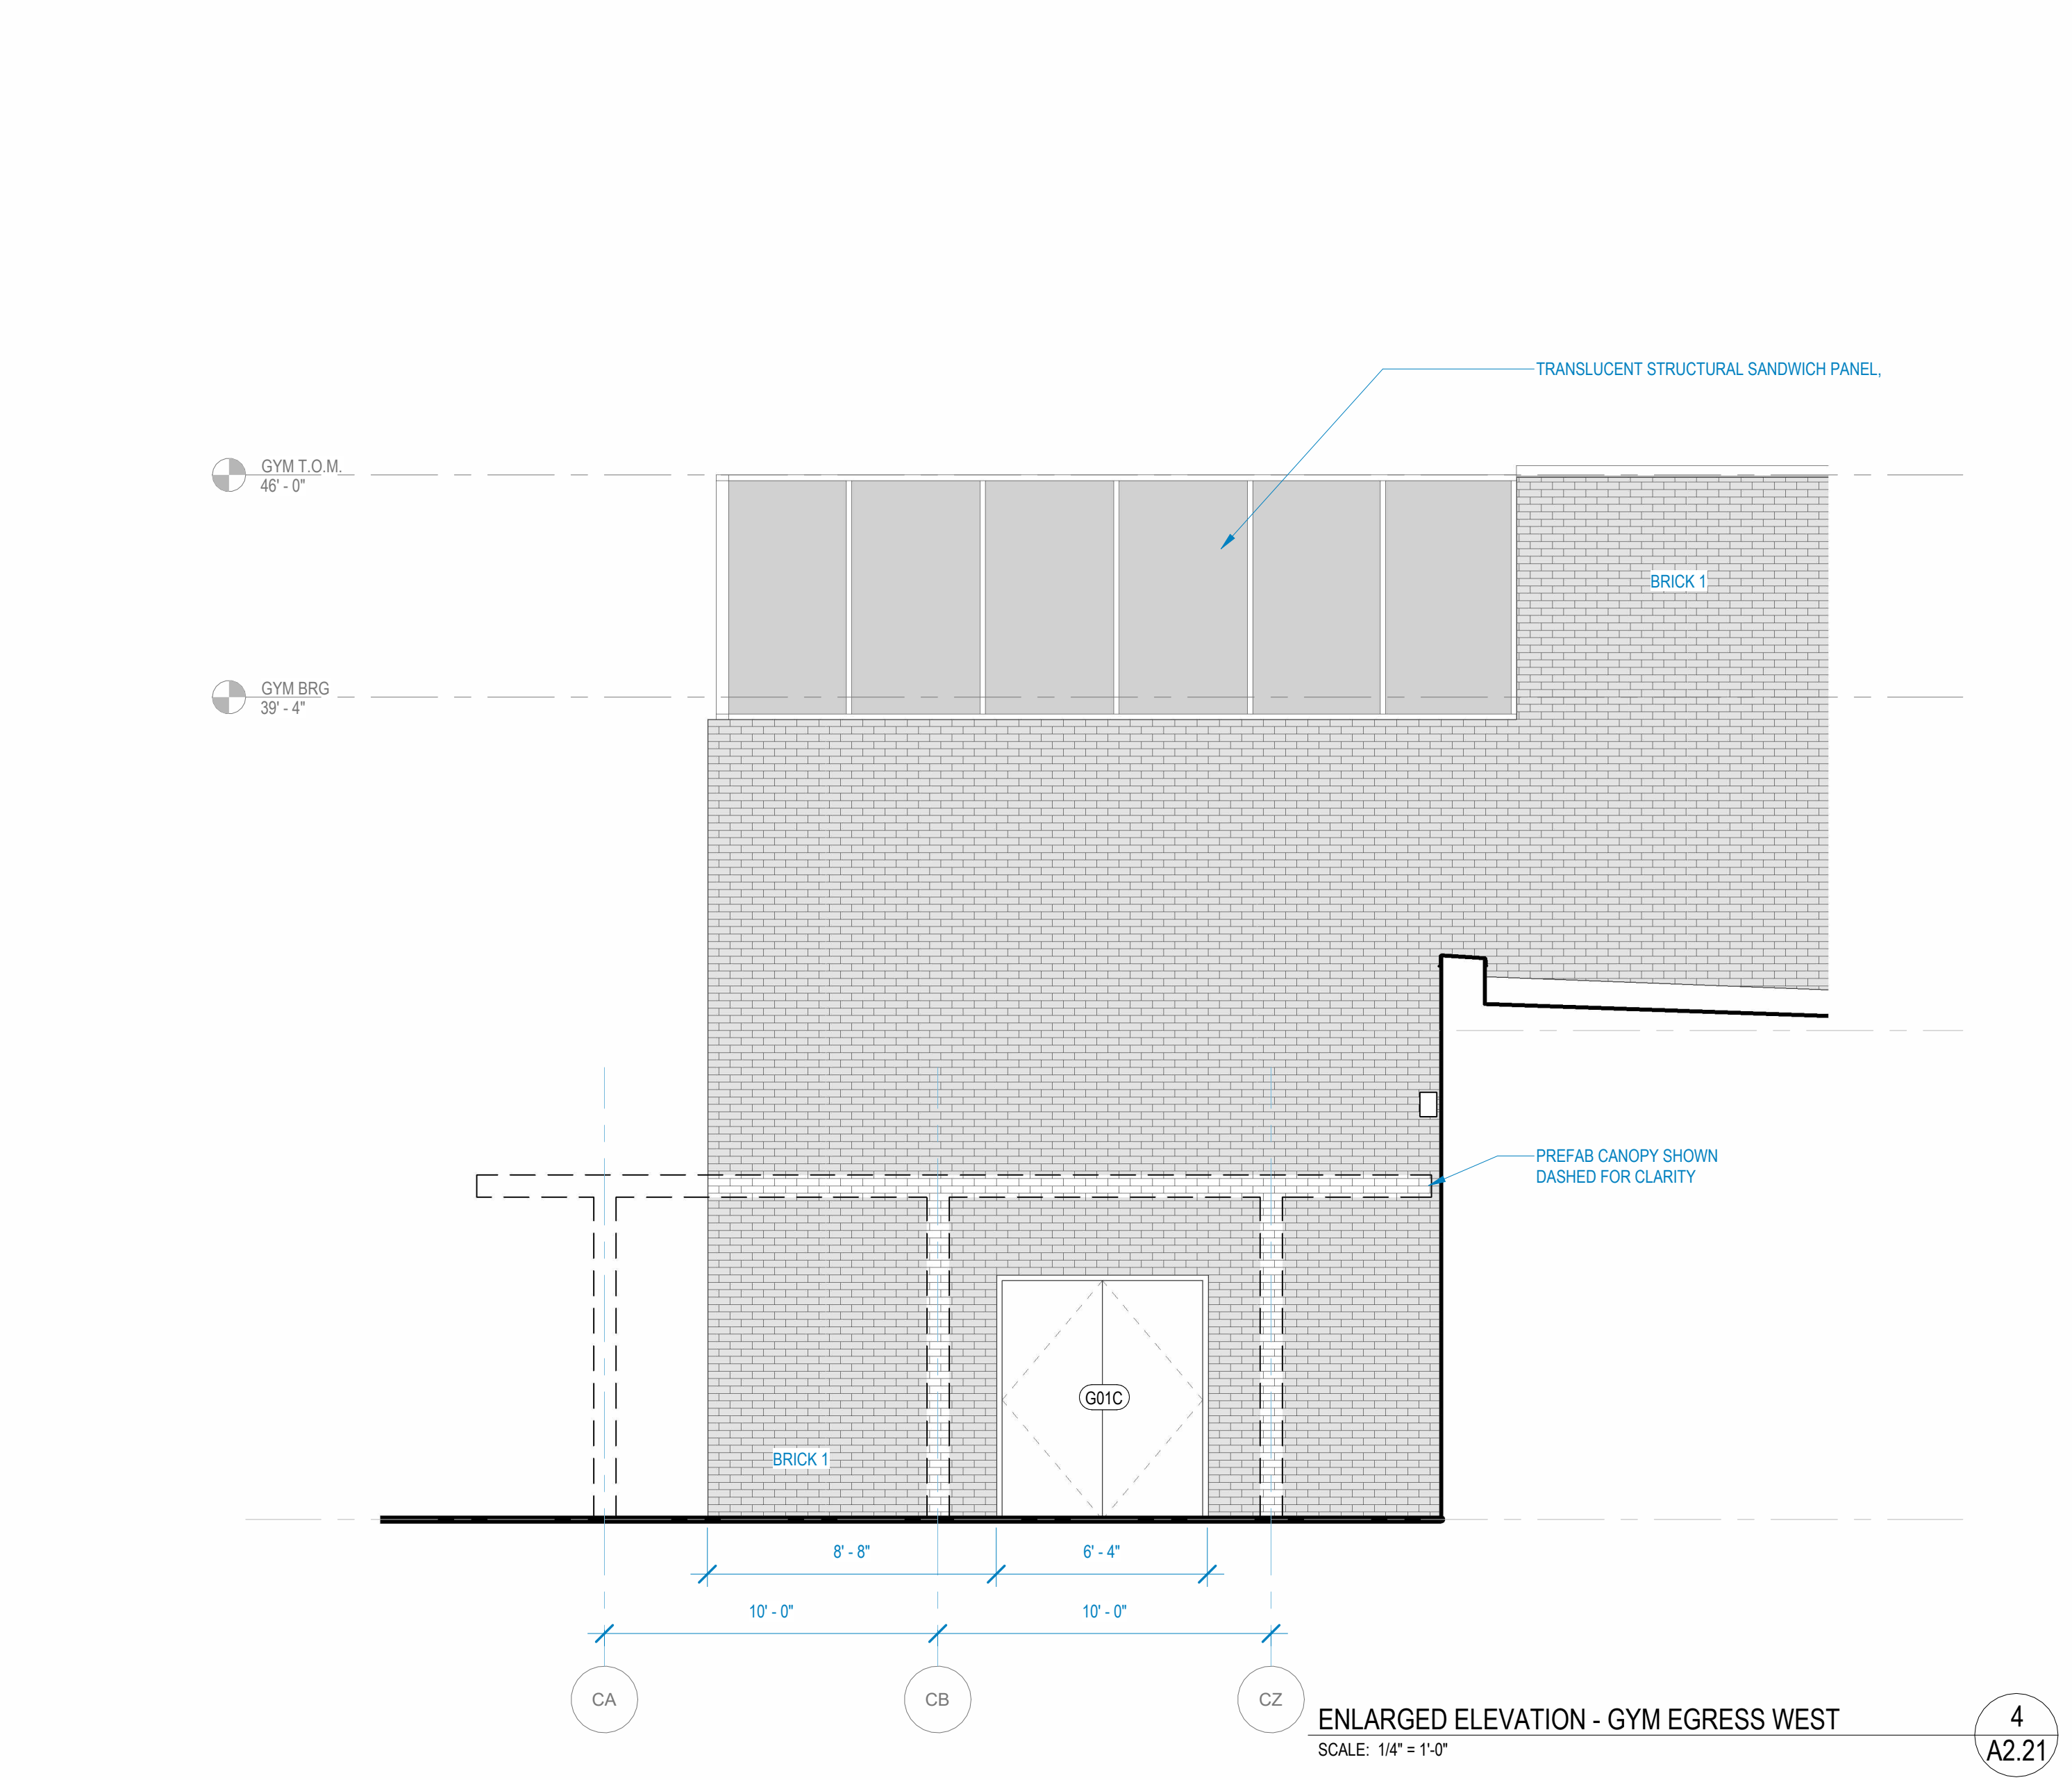


ENLARGED ELEVATION - GYM EGRESS WEST
SCALE: 1/4" = 1'-0"
4
A2.21

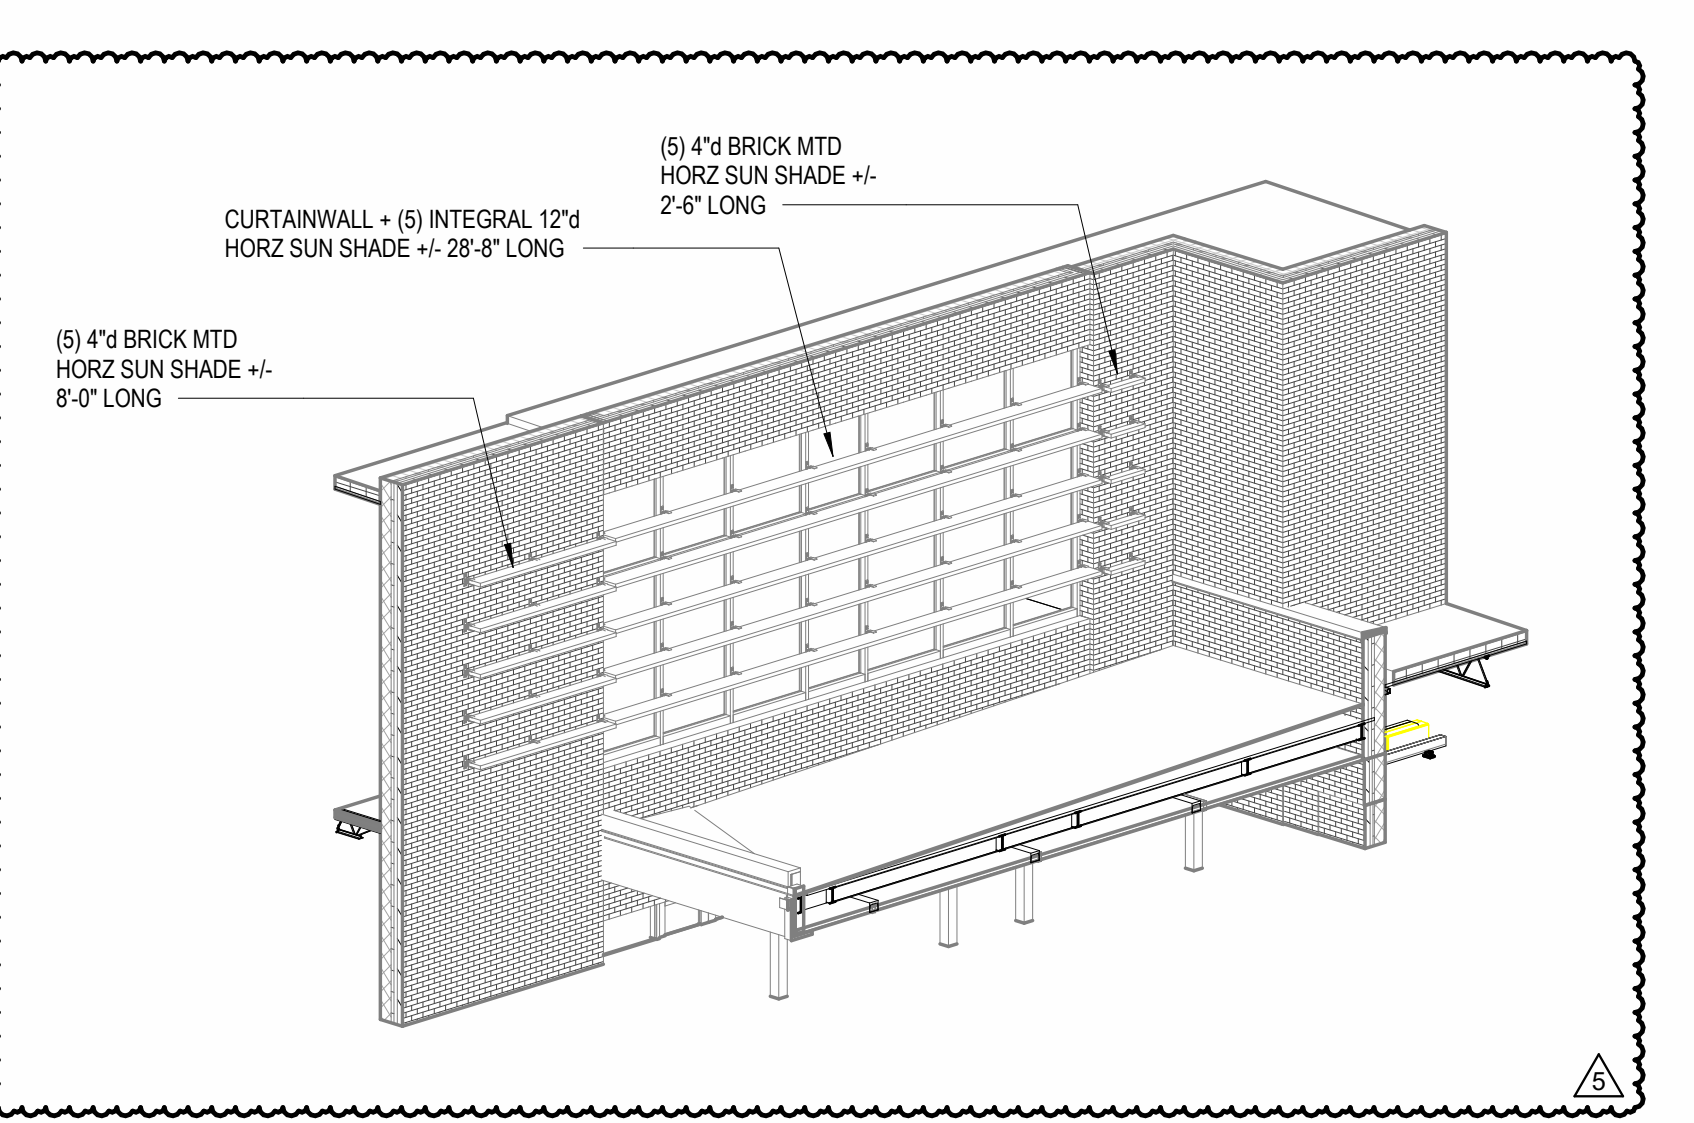


AXON - ENTRY SOUTH
SCALE:
6
A2.21

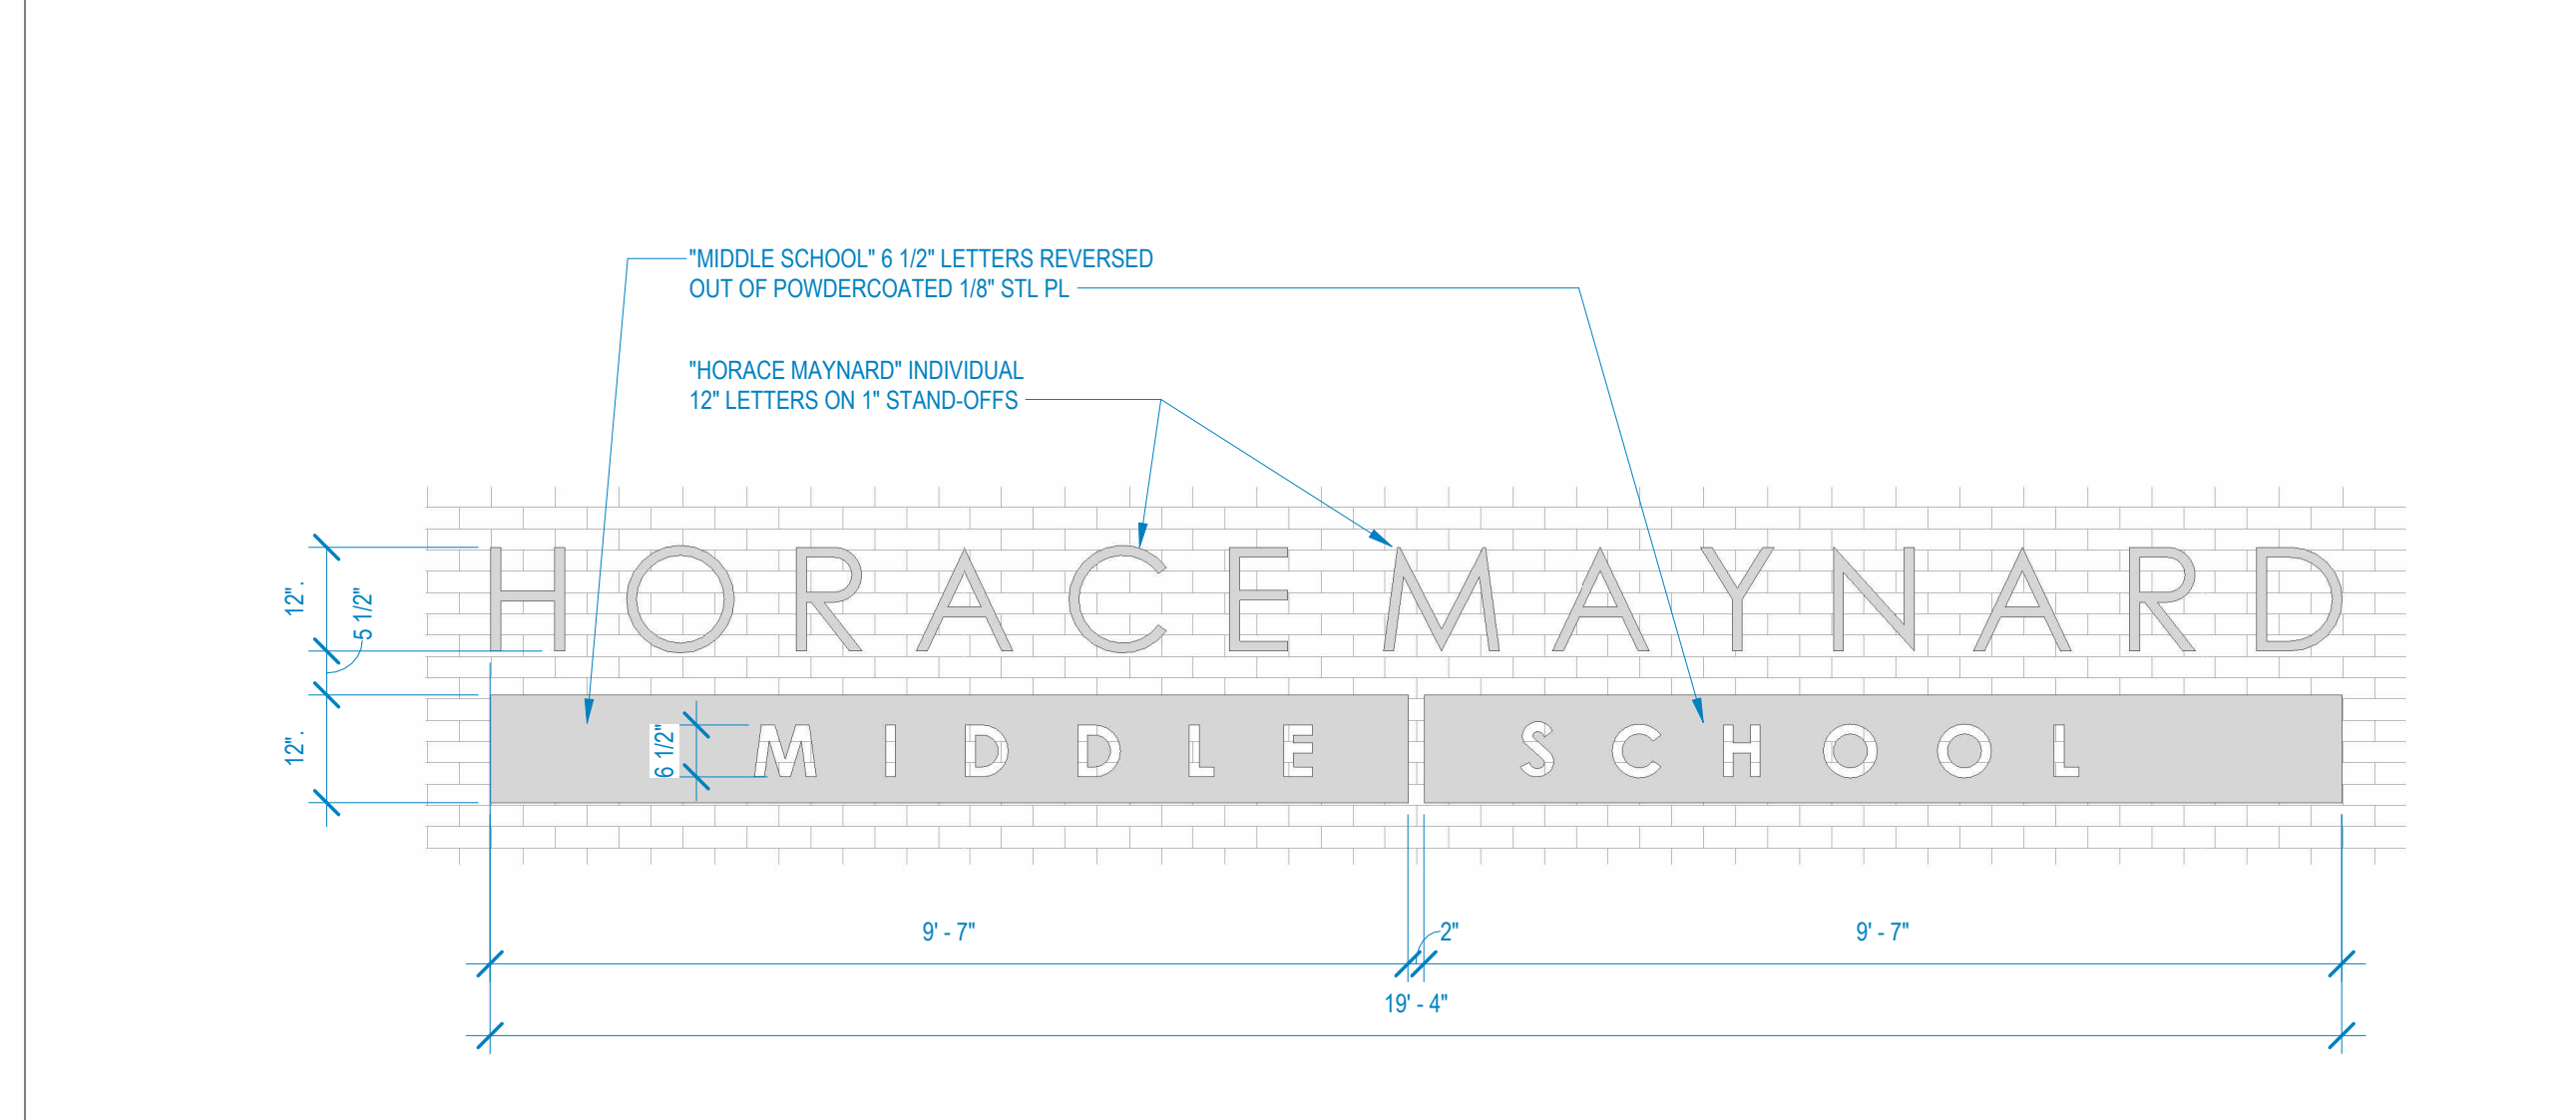

BUILDING SIGNAGE - ENLARGED ELEVATION
SCALE: 1/2" = 1'-0"
5
A2.21

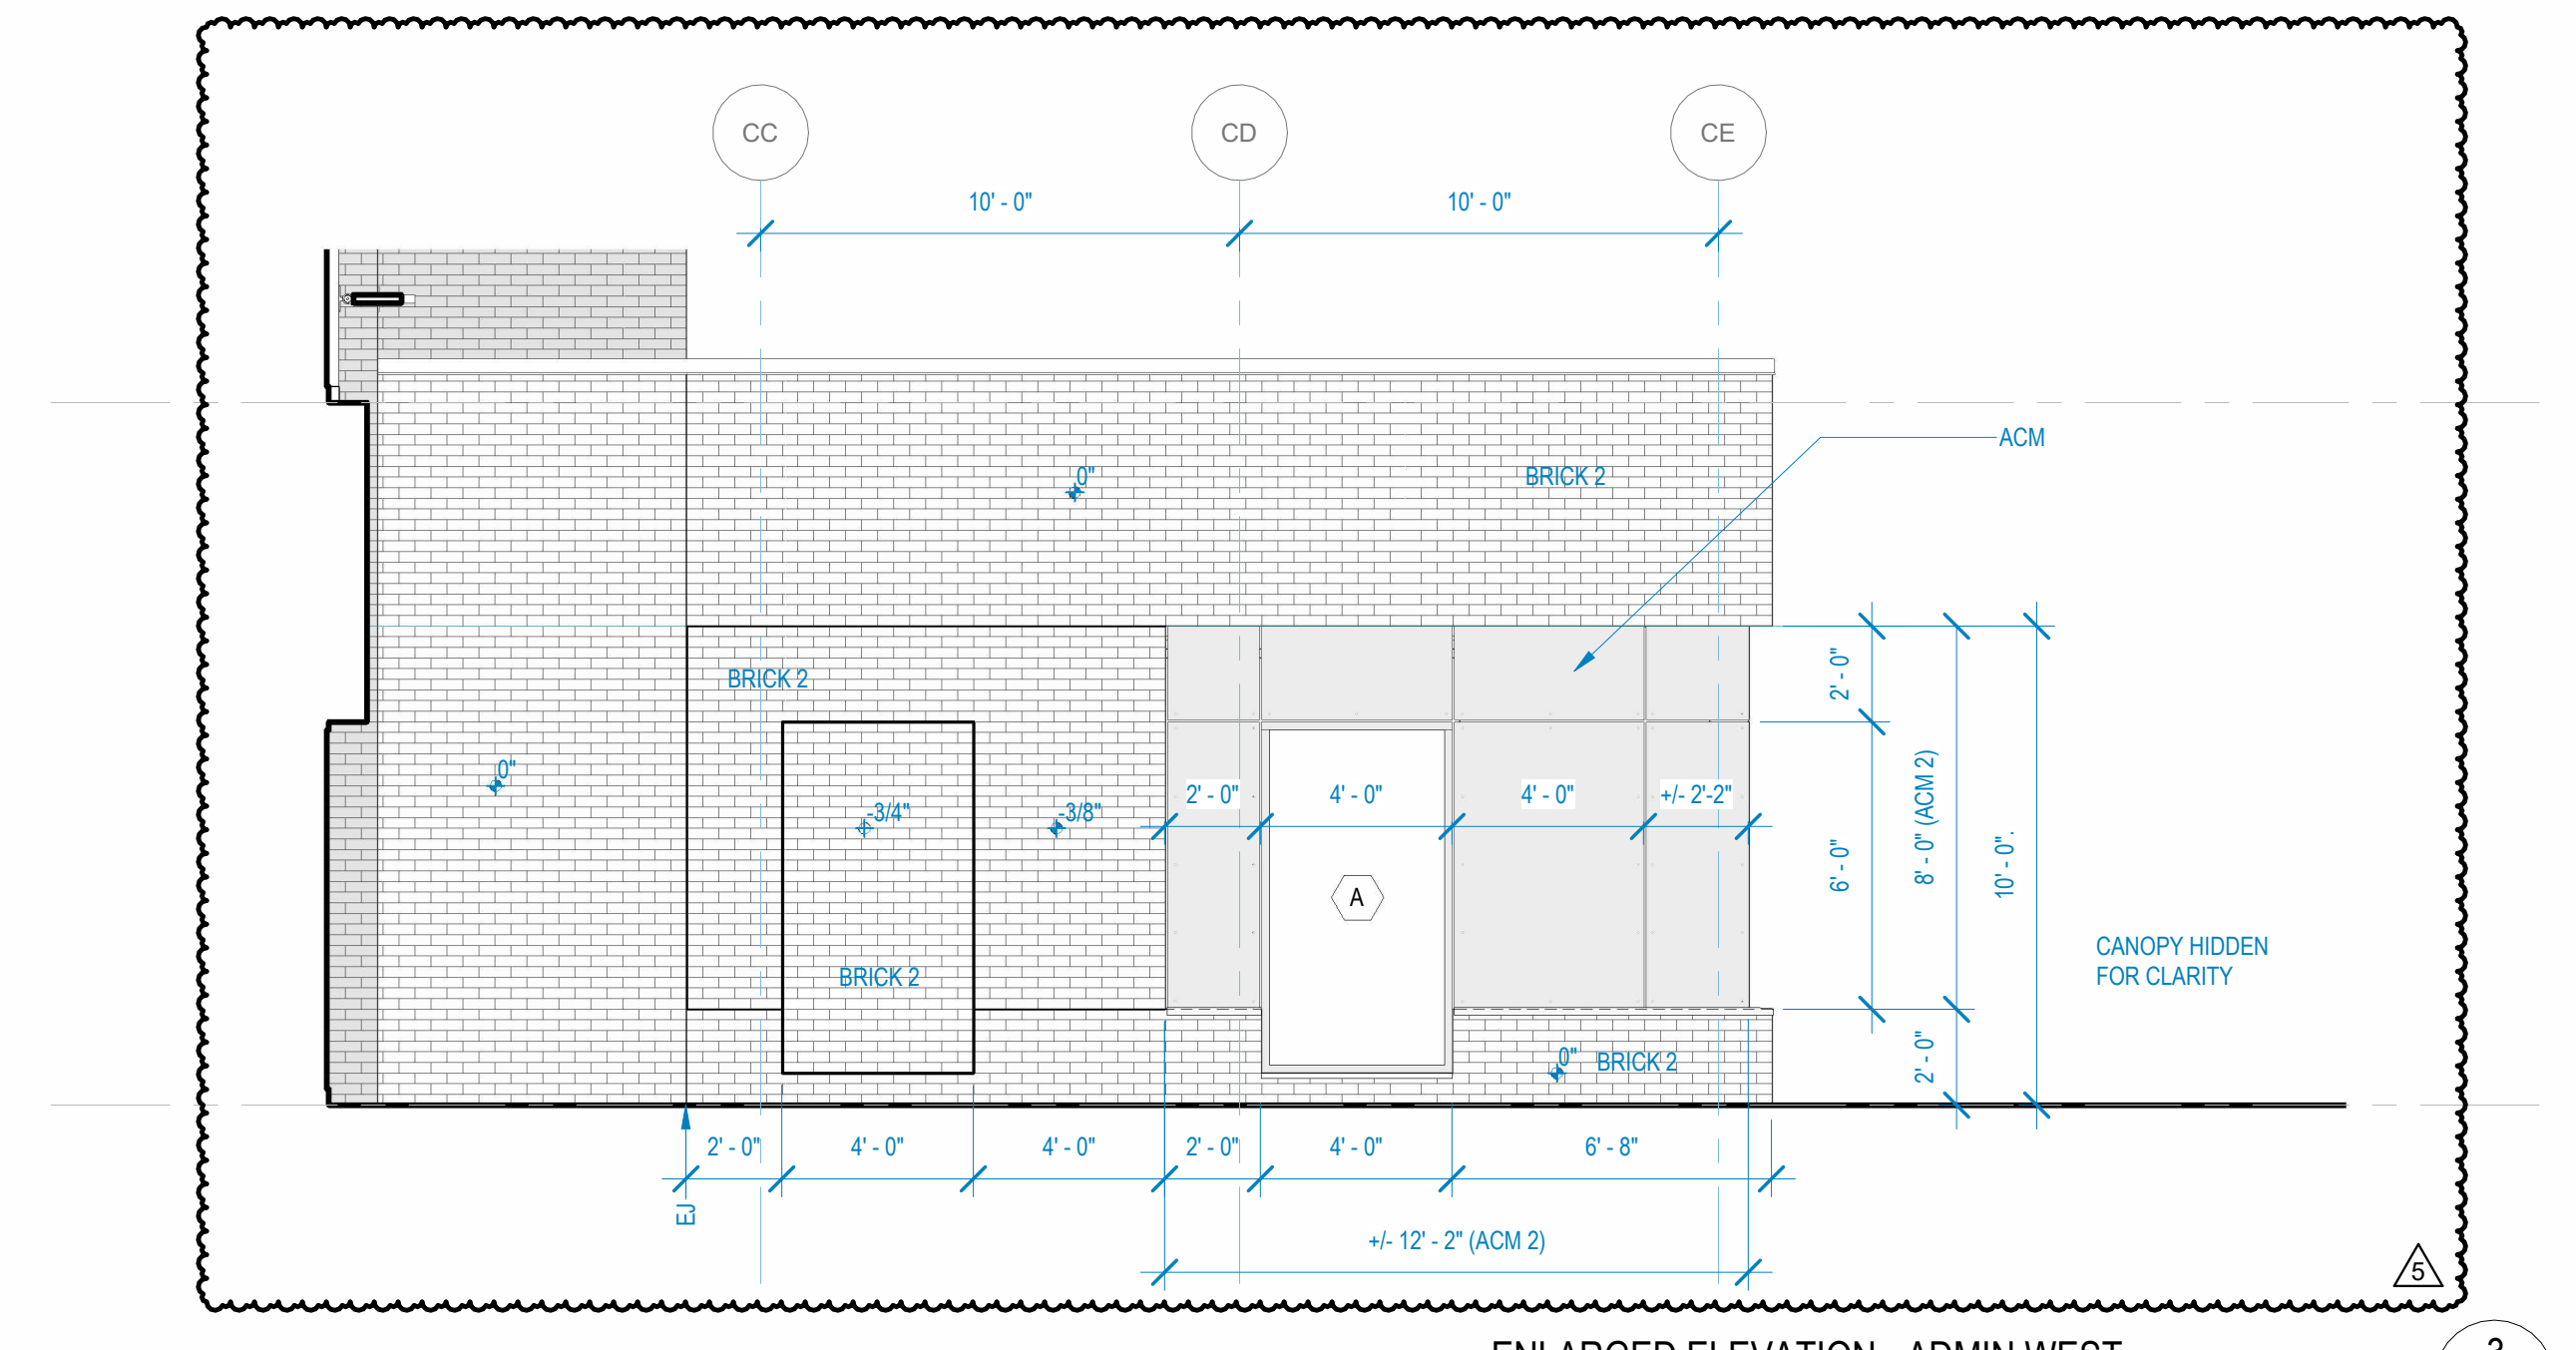

ENLARGED ELEVATION - ADMIN WEST
SCALE: 1/4" = 1'-0"
3
A2.21




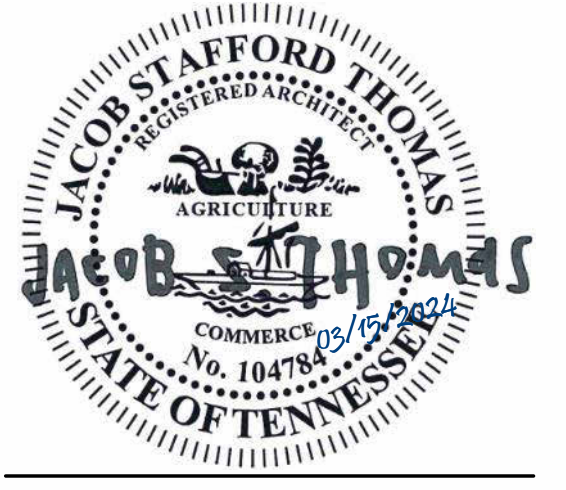


DATE: 03/15/2024
PROJECT NO: 21074
SBC NO:

PROJECT REVISIONS

#	DATE	DESCRIPTION
1	05/20/2024	R2
2	05/20/2024	ADD 001
3	05/31/2024	ADD 001
5	06/14/2024	ADD 003

THIS DRAWING IS THE PROPERTY OF THE LEWIS GROUP ARCHITECTS, INC. AND IS TO BE USED ONLY FOR THE PROJECT AND SITE SPECIFICALLY IDENTIFIED HEREIN. THIS DRAWING IS NOT TO BE REPRODUCED OR COPIED IN ANY MANNER WITHOUT THE WRITTEN CONSENT OF THE LEWIS GROUP ARCHITECTS, INC. AND SHALL NOT BE REPRODUCED OR COPIED IN ANY MANNER WITHOUT THEIR FULL CONSENT. IT IS TO BE RETURNED UPON REQUEST.

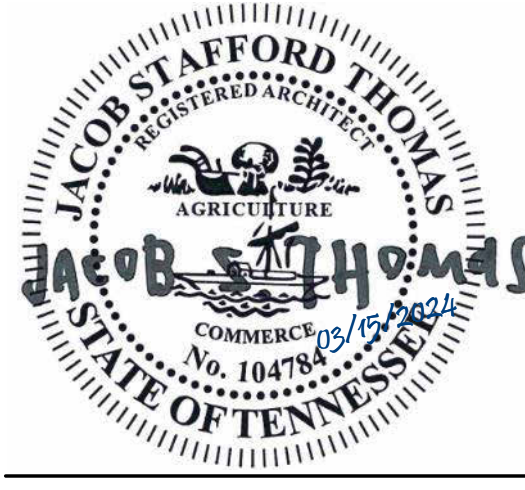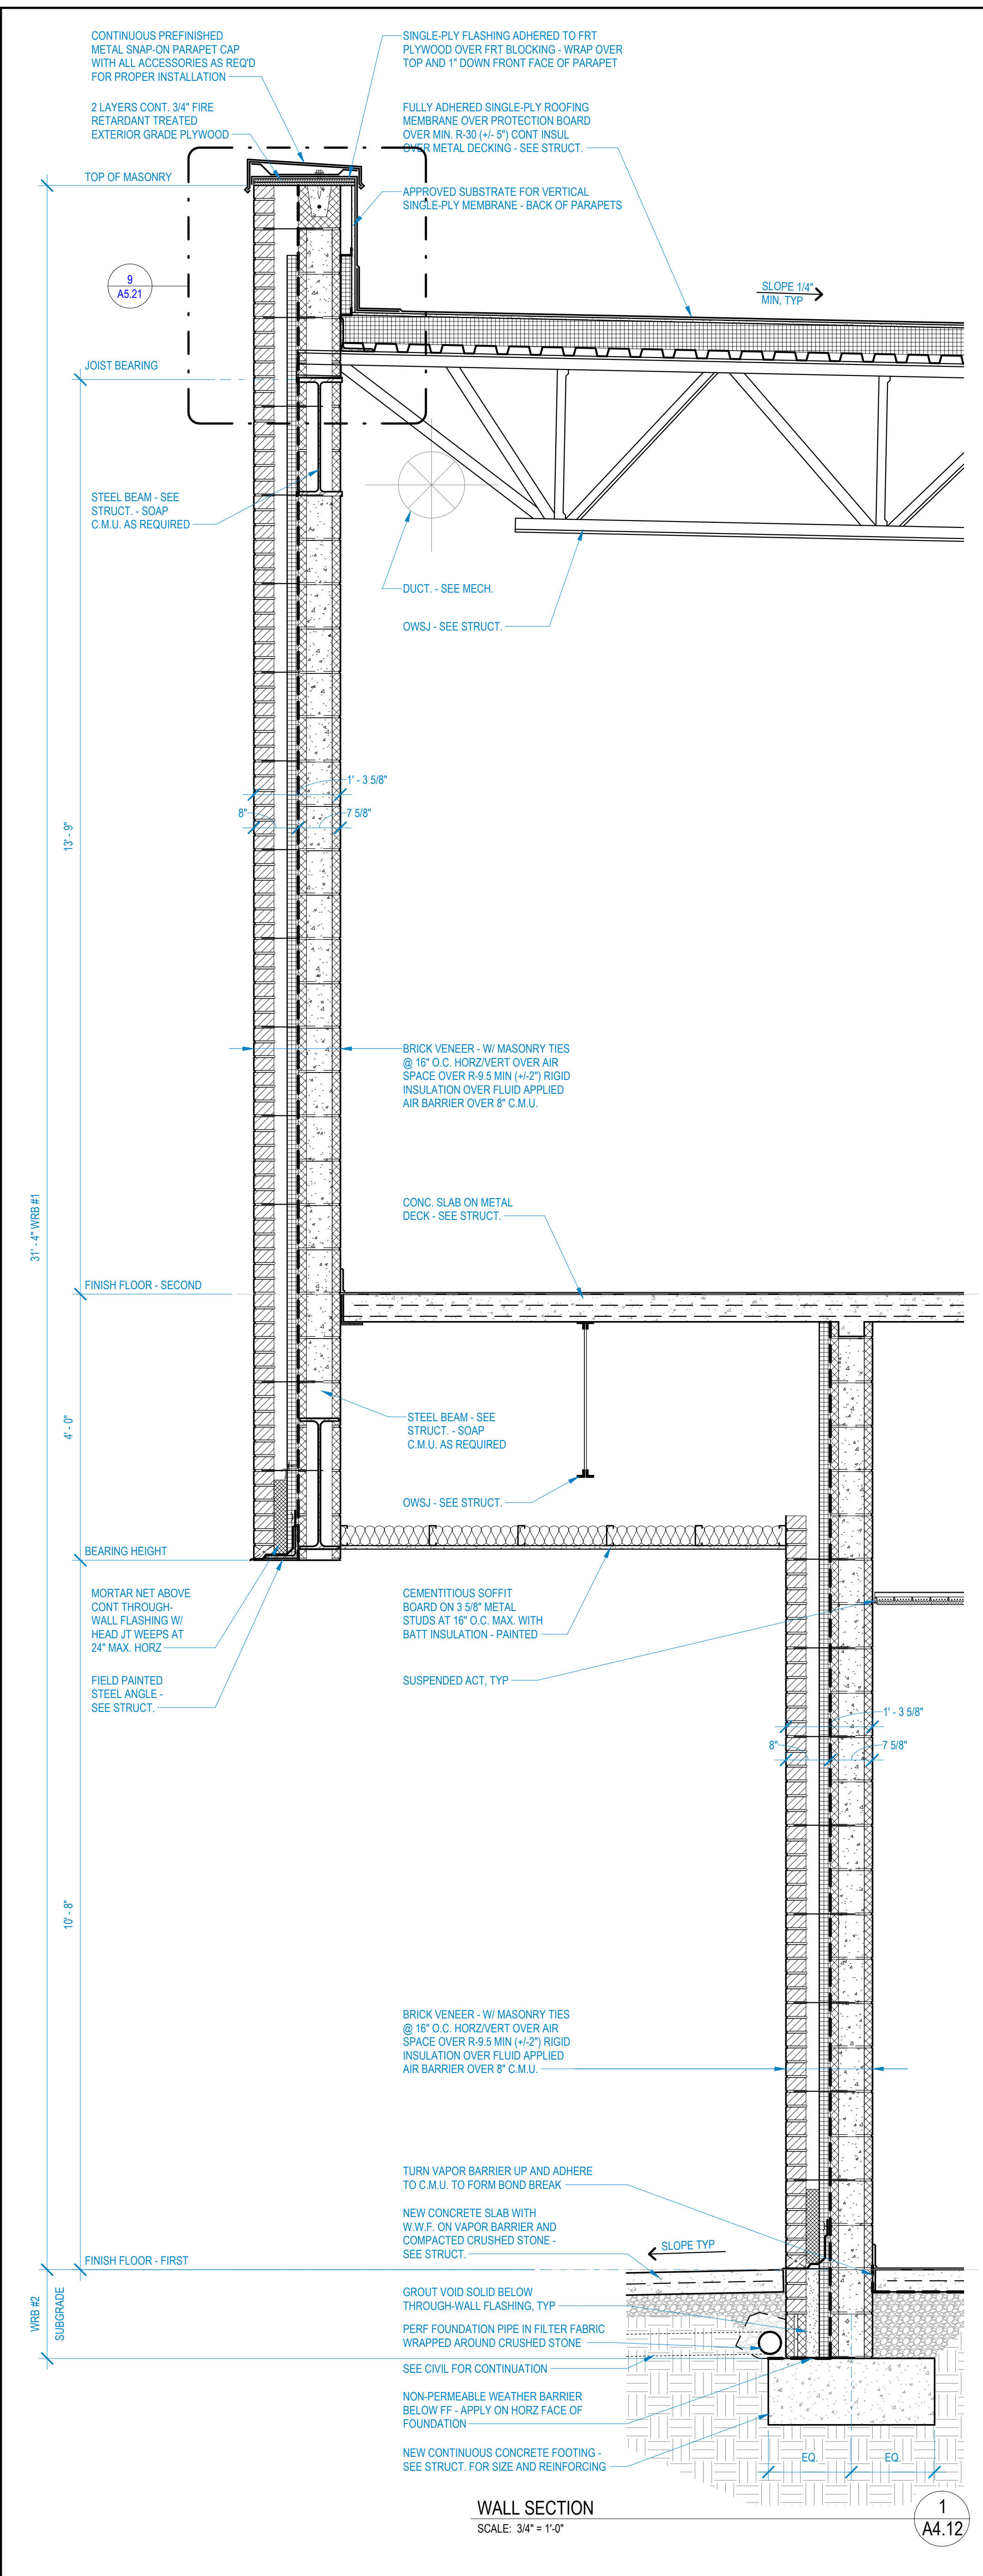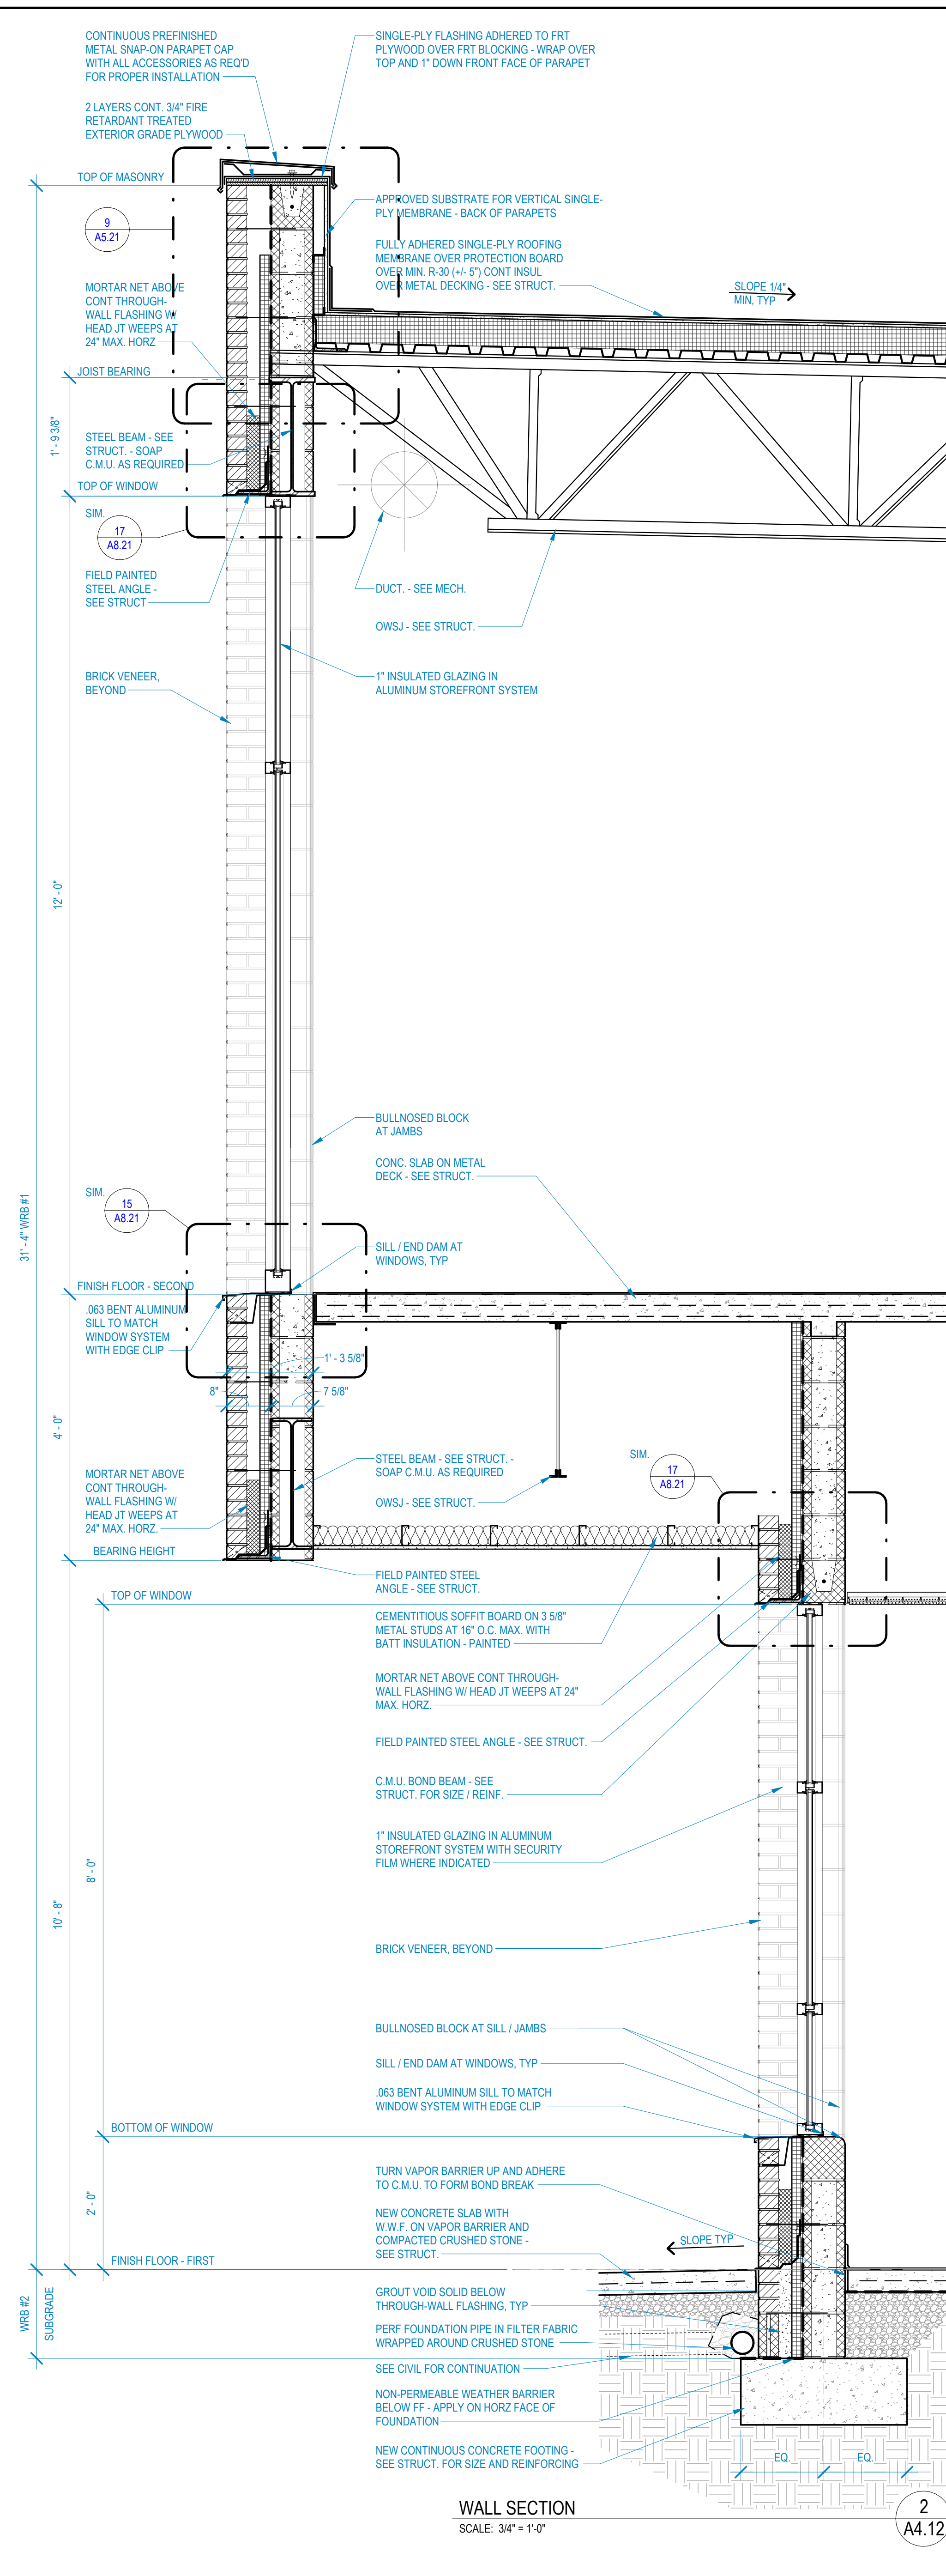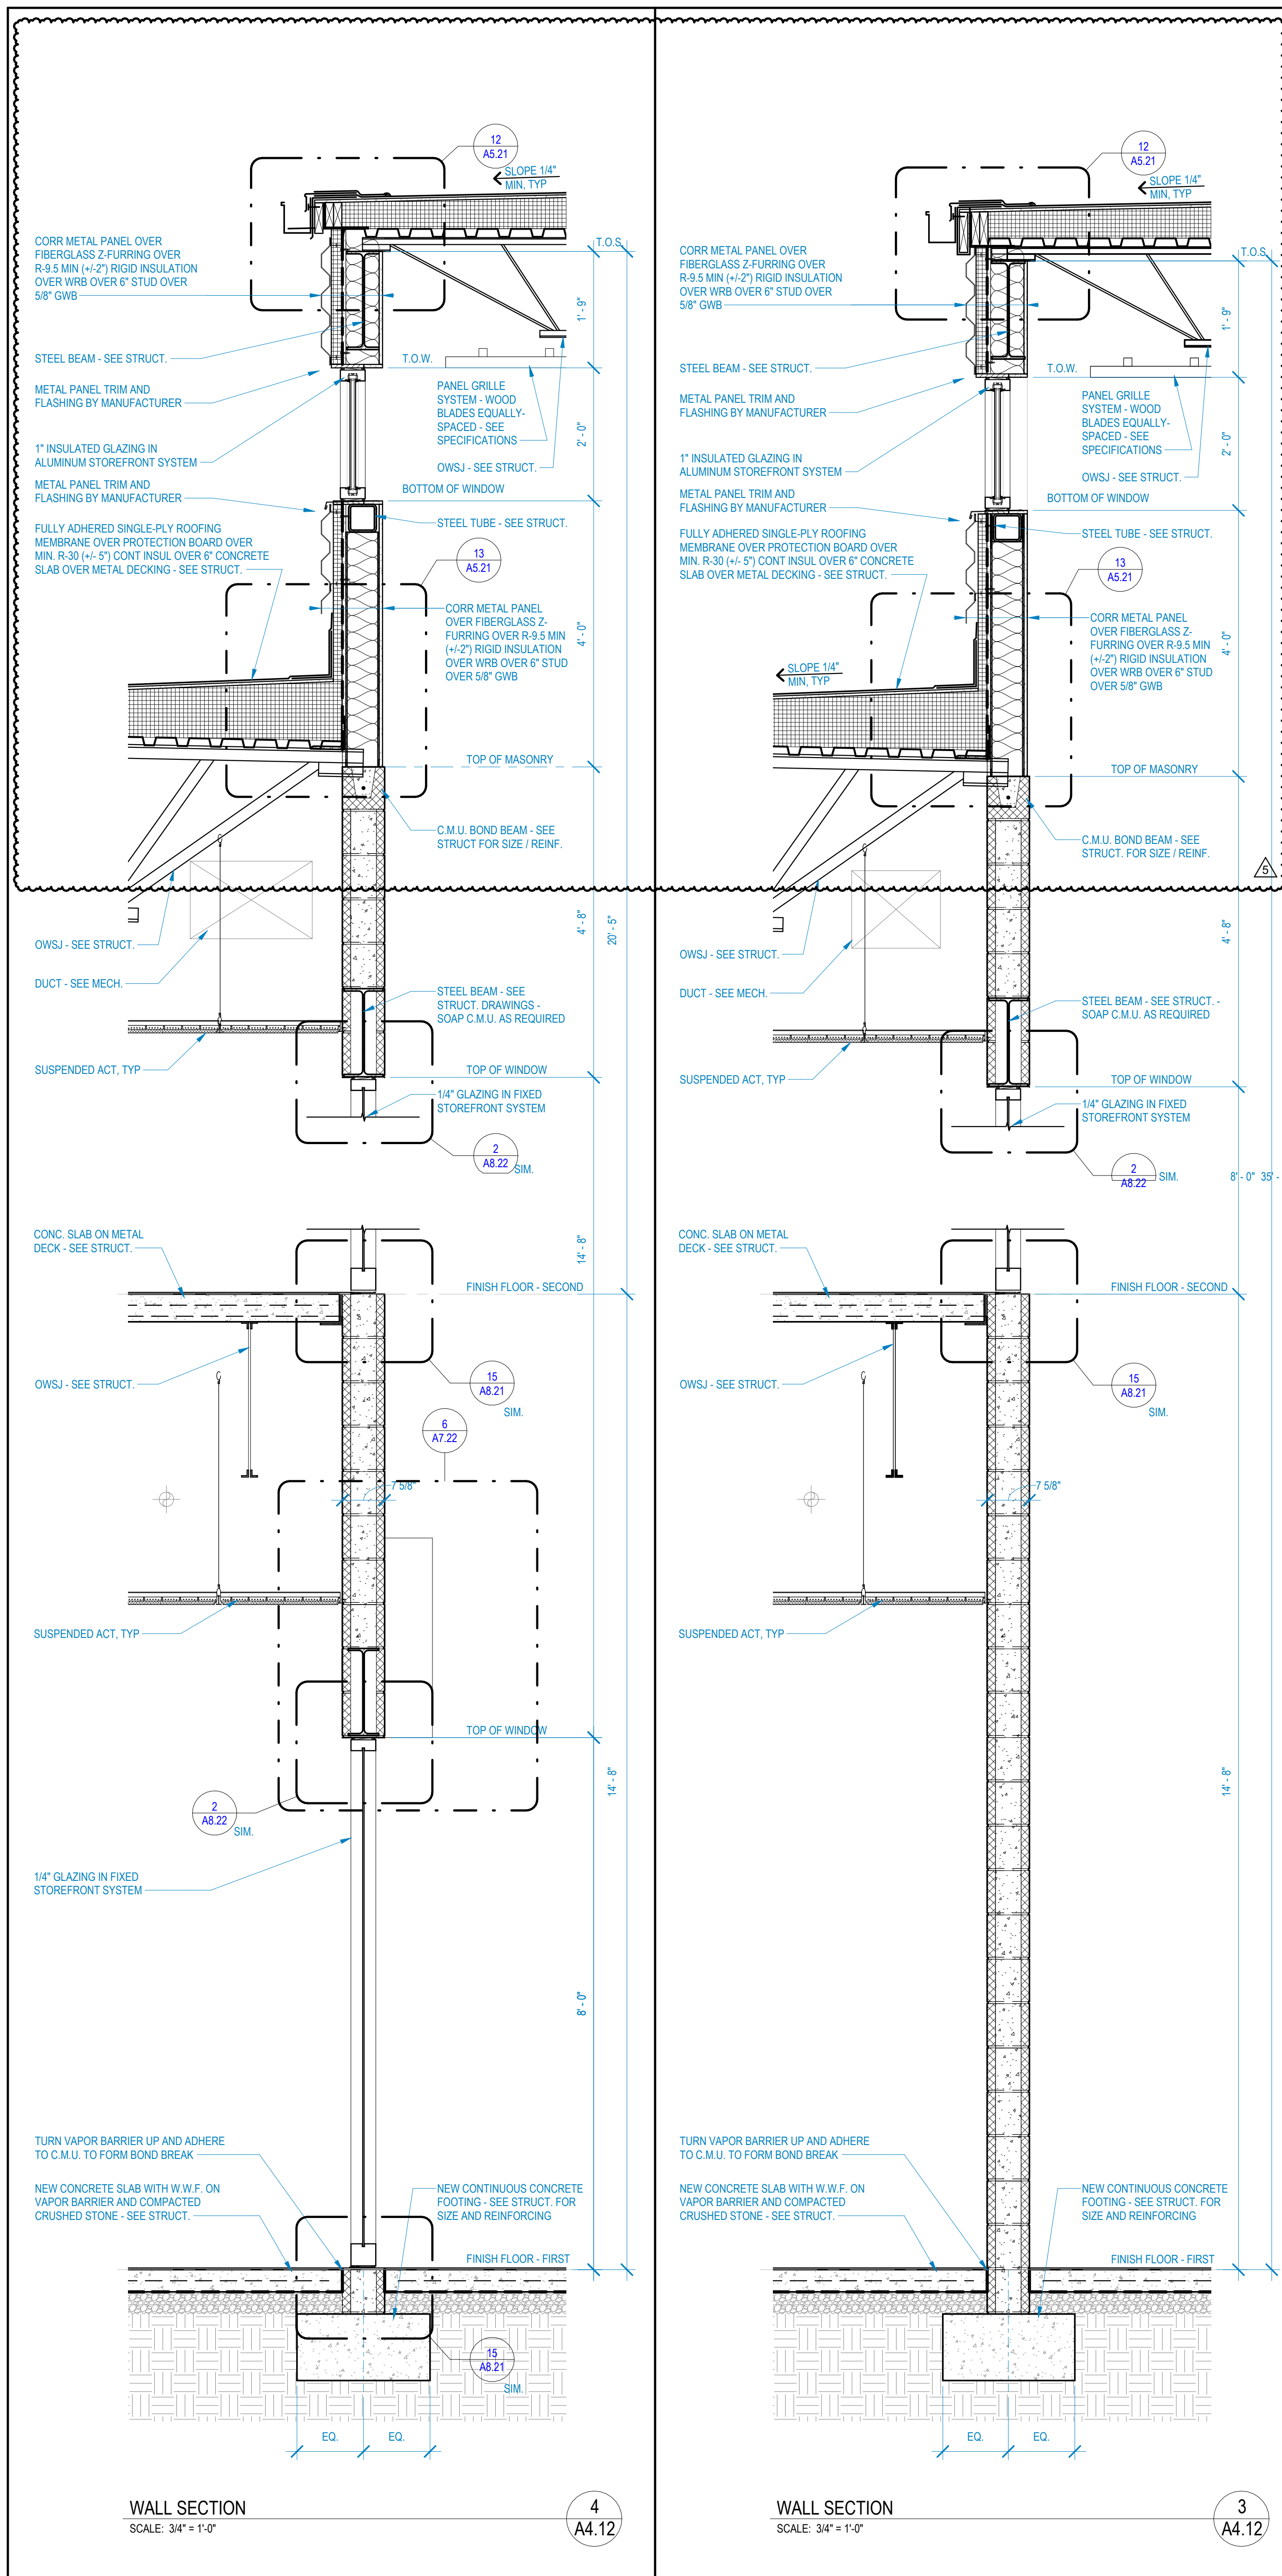

A NEW SCHOOL FACILITY:
HORACE MAYNARD MIDDLE SCHOOL
UNION COUNTY PUBLIC SCHOOLS
MAYNARDVILLE, TN

DATE: 03/15/2024
PROJECT NO: 21074
SBC NO:

PROJECT REVISIONS

#	DATE	DESCRIPTION
3	05/31/2024	ADD 001
5	06/14/2024	ADD 003

THIS DRAWING IS THE PROPERTY OF THE LEWIS GROUP ARCHITECTS, INC. AND IS TO BE USED ONLY FOR THE PROJECT AND SITE SPECIFICALLY IDENTIFIED HEREIN. THIS DRAWING IS NOT TO BE USED ON ANY OTHER PROJECT WITHOUT THE PROJECT FOR WHICH IT IS MADE OR EXECUTED OR NOT. THIS DRAWING AND ITS CONTENTS ARE THE SOLE PROPERTY OF THE LEWIS GROUP ARCHITECTS, INC. AND SHALL NOT BE REPRODUCED OR TRANSMITTED IN ANY FORM OR BY ANY MEANS, ELECTRONIC OR MECHANICAL, INCLUDING PHOTOCOPYING, RECORDING, OR BY ANY INFORMATION STORAGE AND RETRIEVAL SYSTEM, WITHOUT THE WRITTEN PERMISSION OF THE LEWIS GROUP ARCHITECTS, INC. IT IS TO BE RETURNED UPON REQUEST.

WALL SECTIONS










A NEW SCHOOL FACILITY:
HORACE MAYNARD MIDDLE SCHOOL
 UNION COUNTY PUBLIC SCHOOLS
 MAYNARDVILLE, TN




DATE: 03/15/2024
 PROJECT NO: 21074
 SBC NO:

PROJECT REVISIONS	
#	DATE DESCRIPTION
5	06/14/2024 ADD 003

THIS DRAWING IS THE PROPERTY OF THE LEWIS GROUP ARCHITECTS, INC. AND IS TO BE USED ONLY FOR THE PROJECT AND SITE SPECIFICALLY IDENTIFIED HEREIN. THIS DRAWING IS NOT TO BE USED IN ANY OTHER PROJECT WITHOUT THE PROJECT FOR WHICH IT IS MADE OR EXECUTED OR NOT. THIS DRAWING AND ITS CONTENTS ARE THE SOLE POSSESSION OF THE LEWIS GROUP ARCHITECTS, INC. AND SHALL NOT BE REPRODUCED OR TRANSMITTED IN ANY FORM OR BY ANY MEANS WITHOUT THEIR FULL CONSENT. IT IS TO BE RETURNED UPON REQUEST.

WALL SECTIONS
 ADMINISTRATION

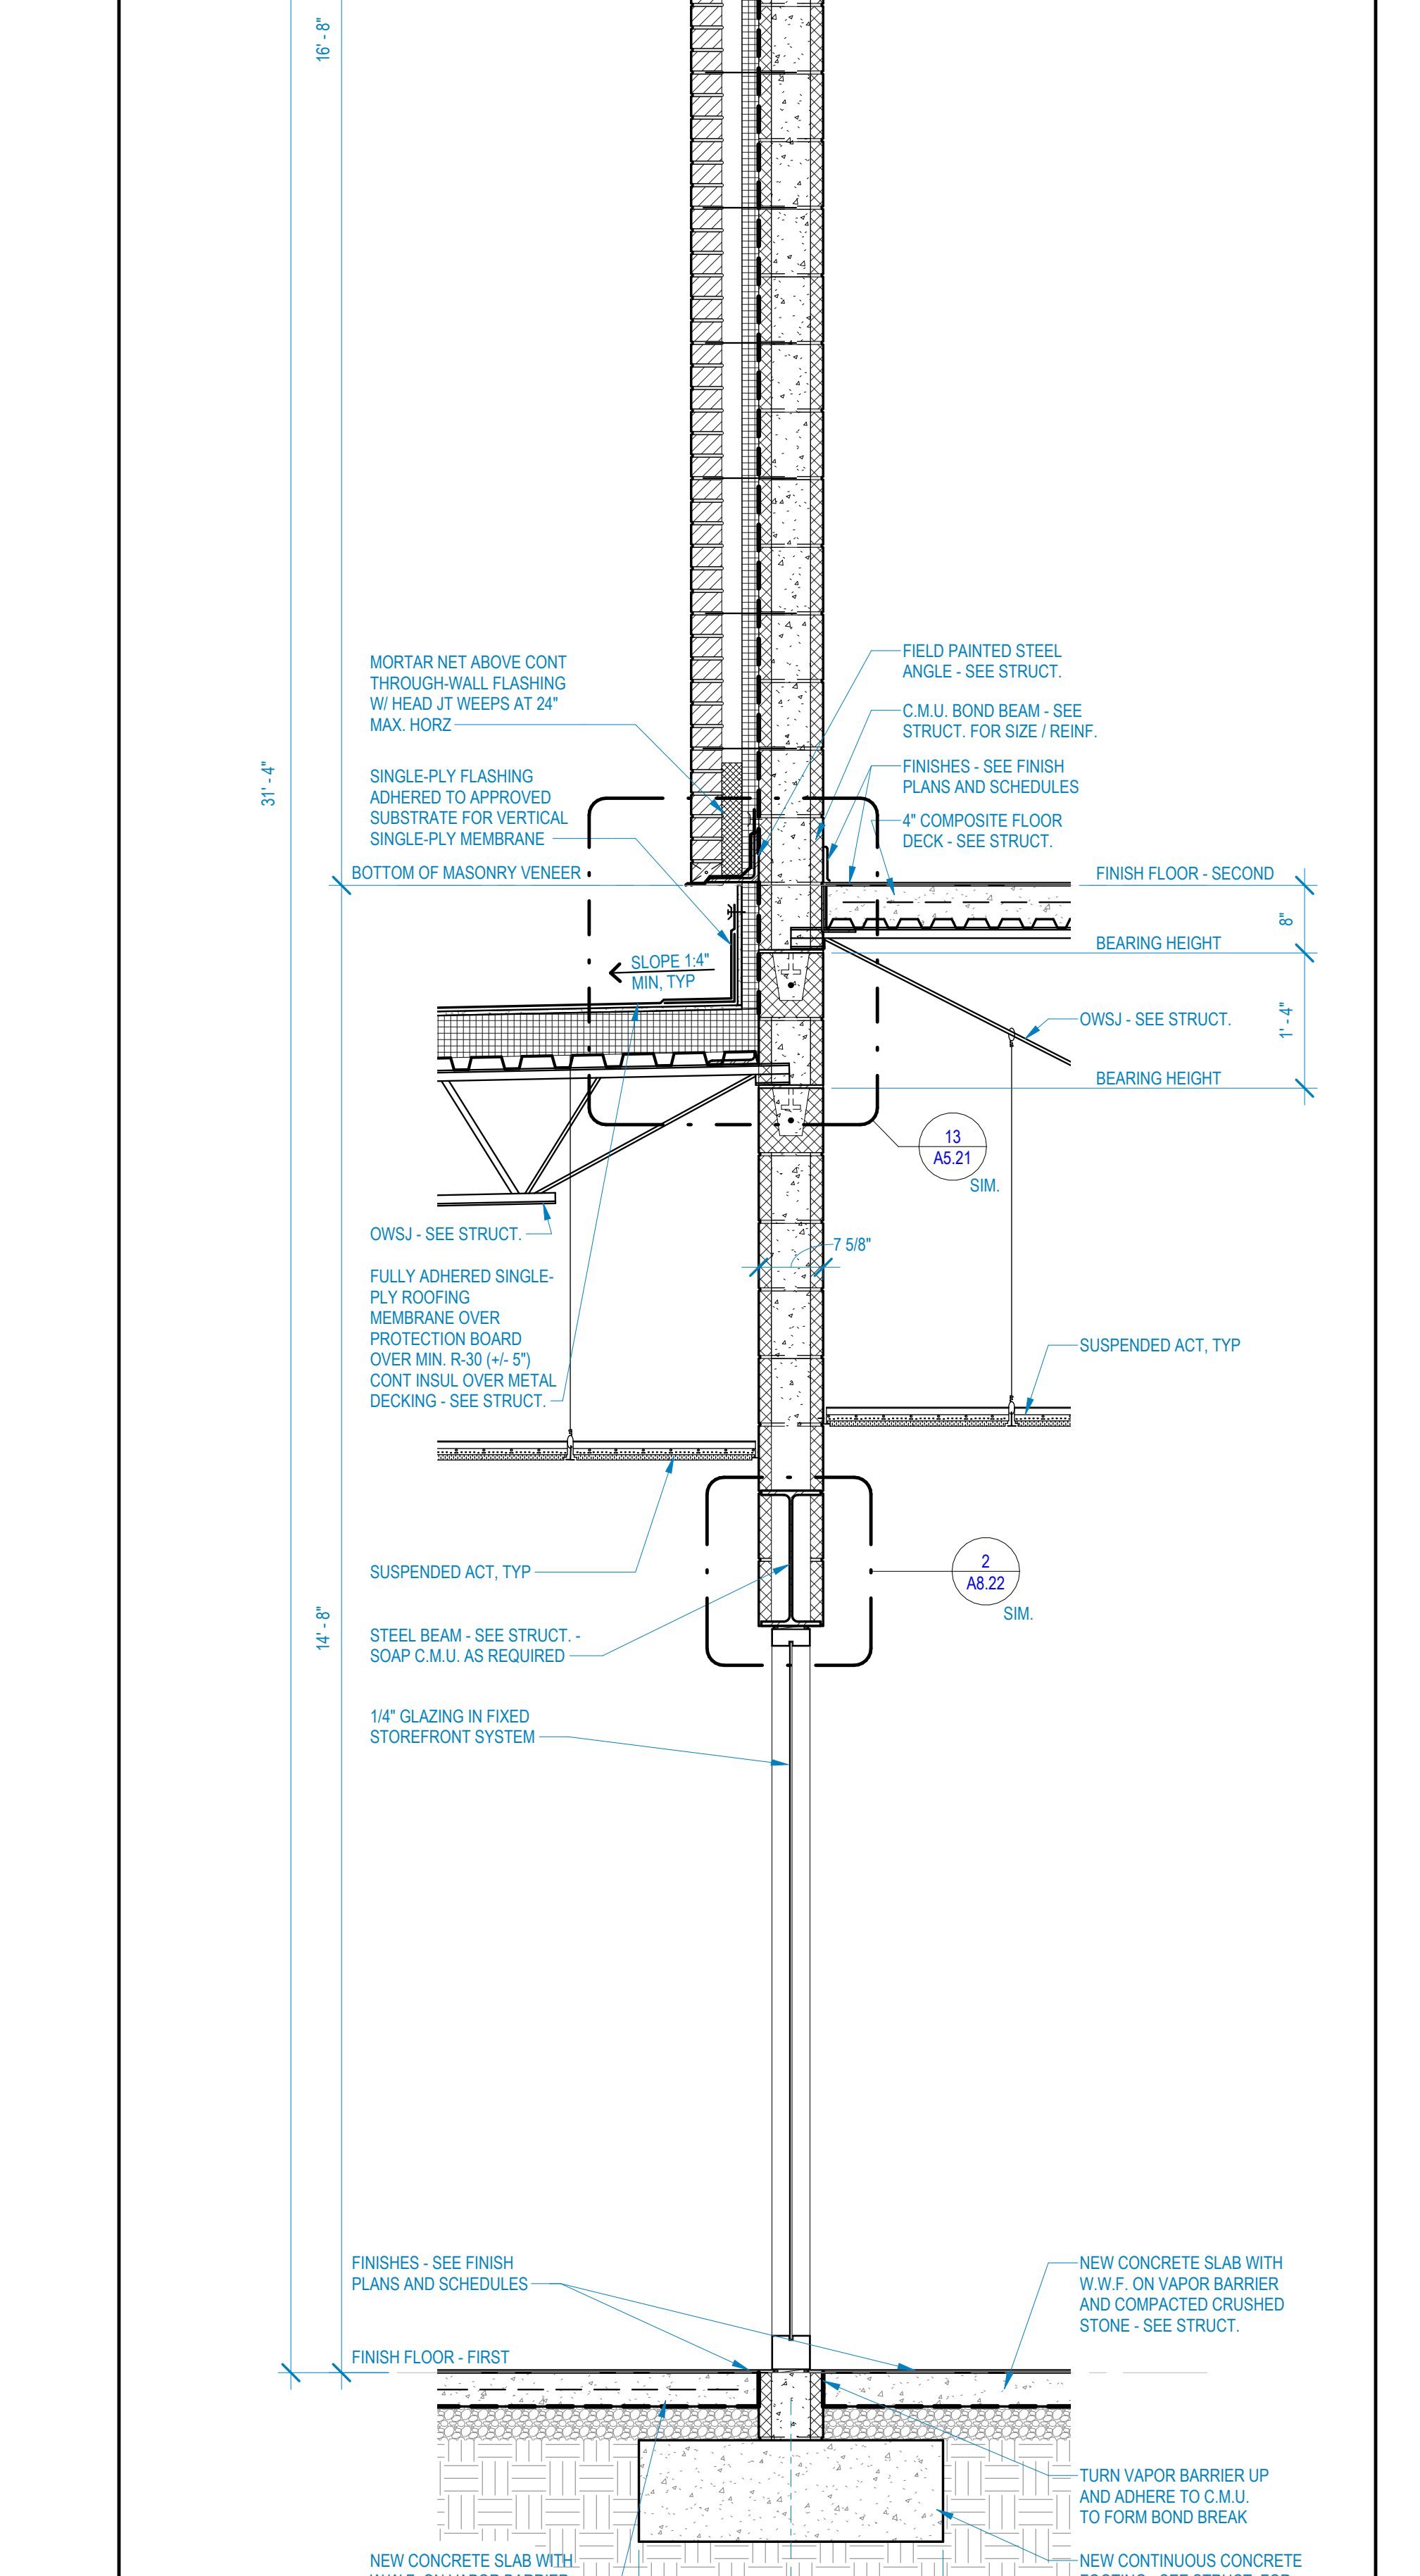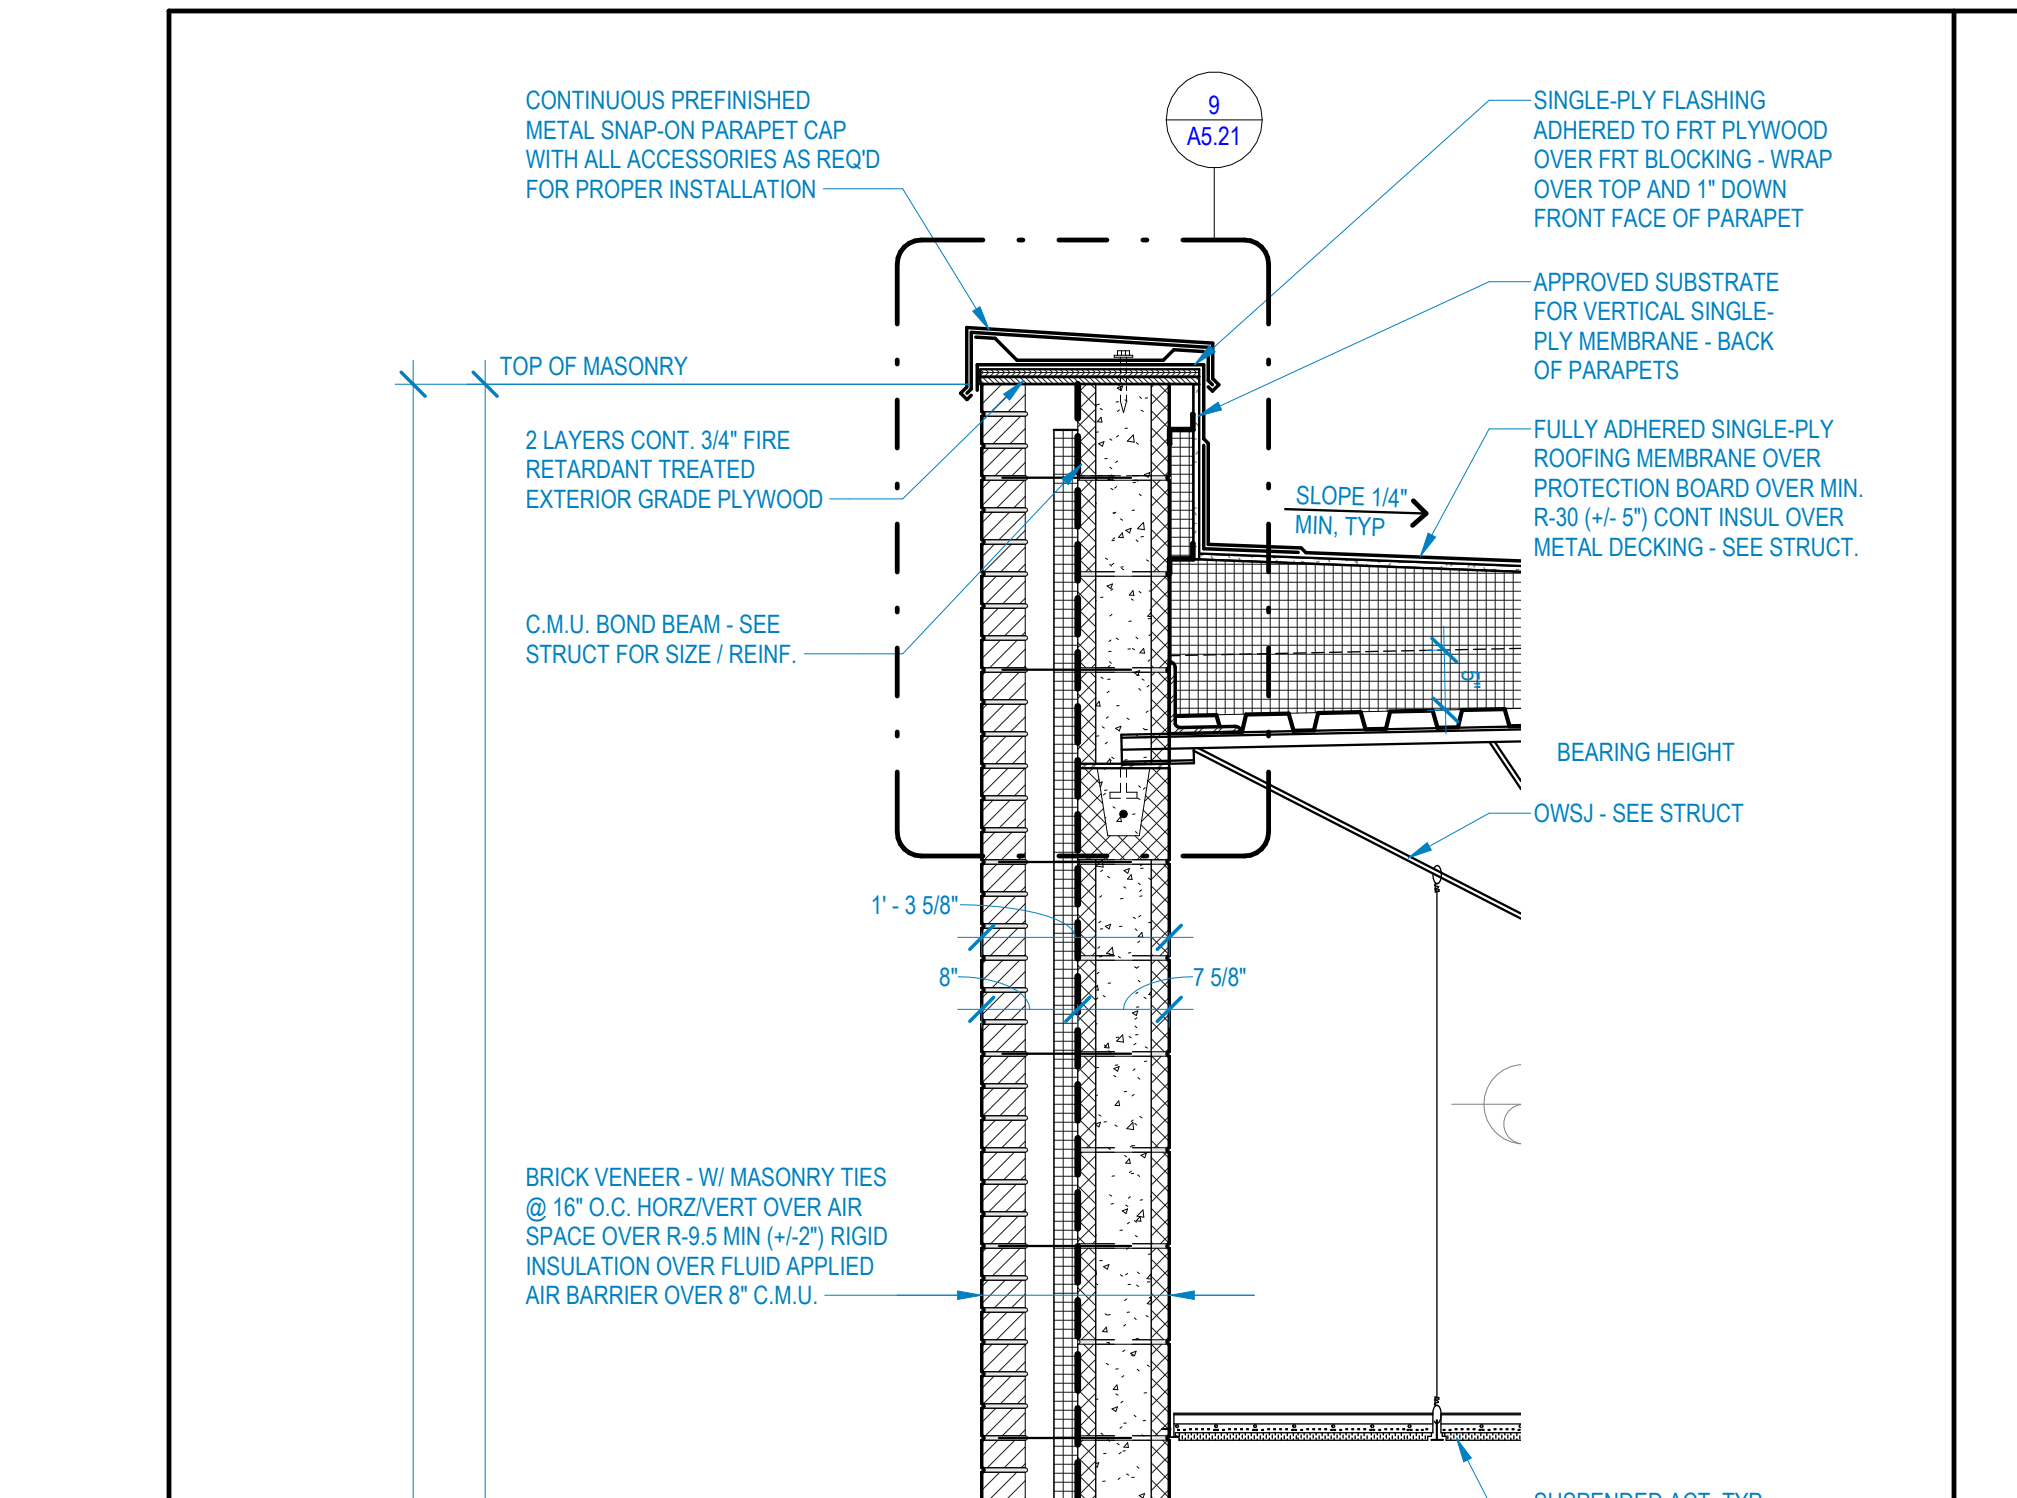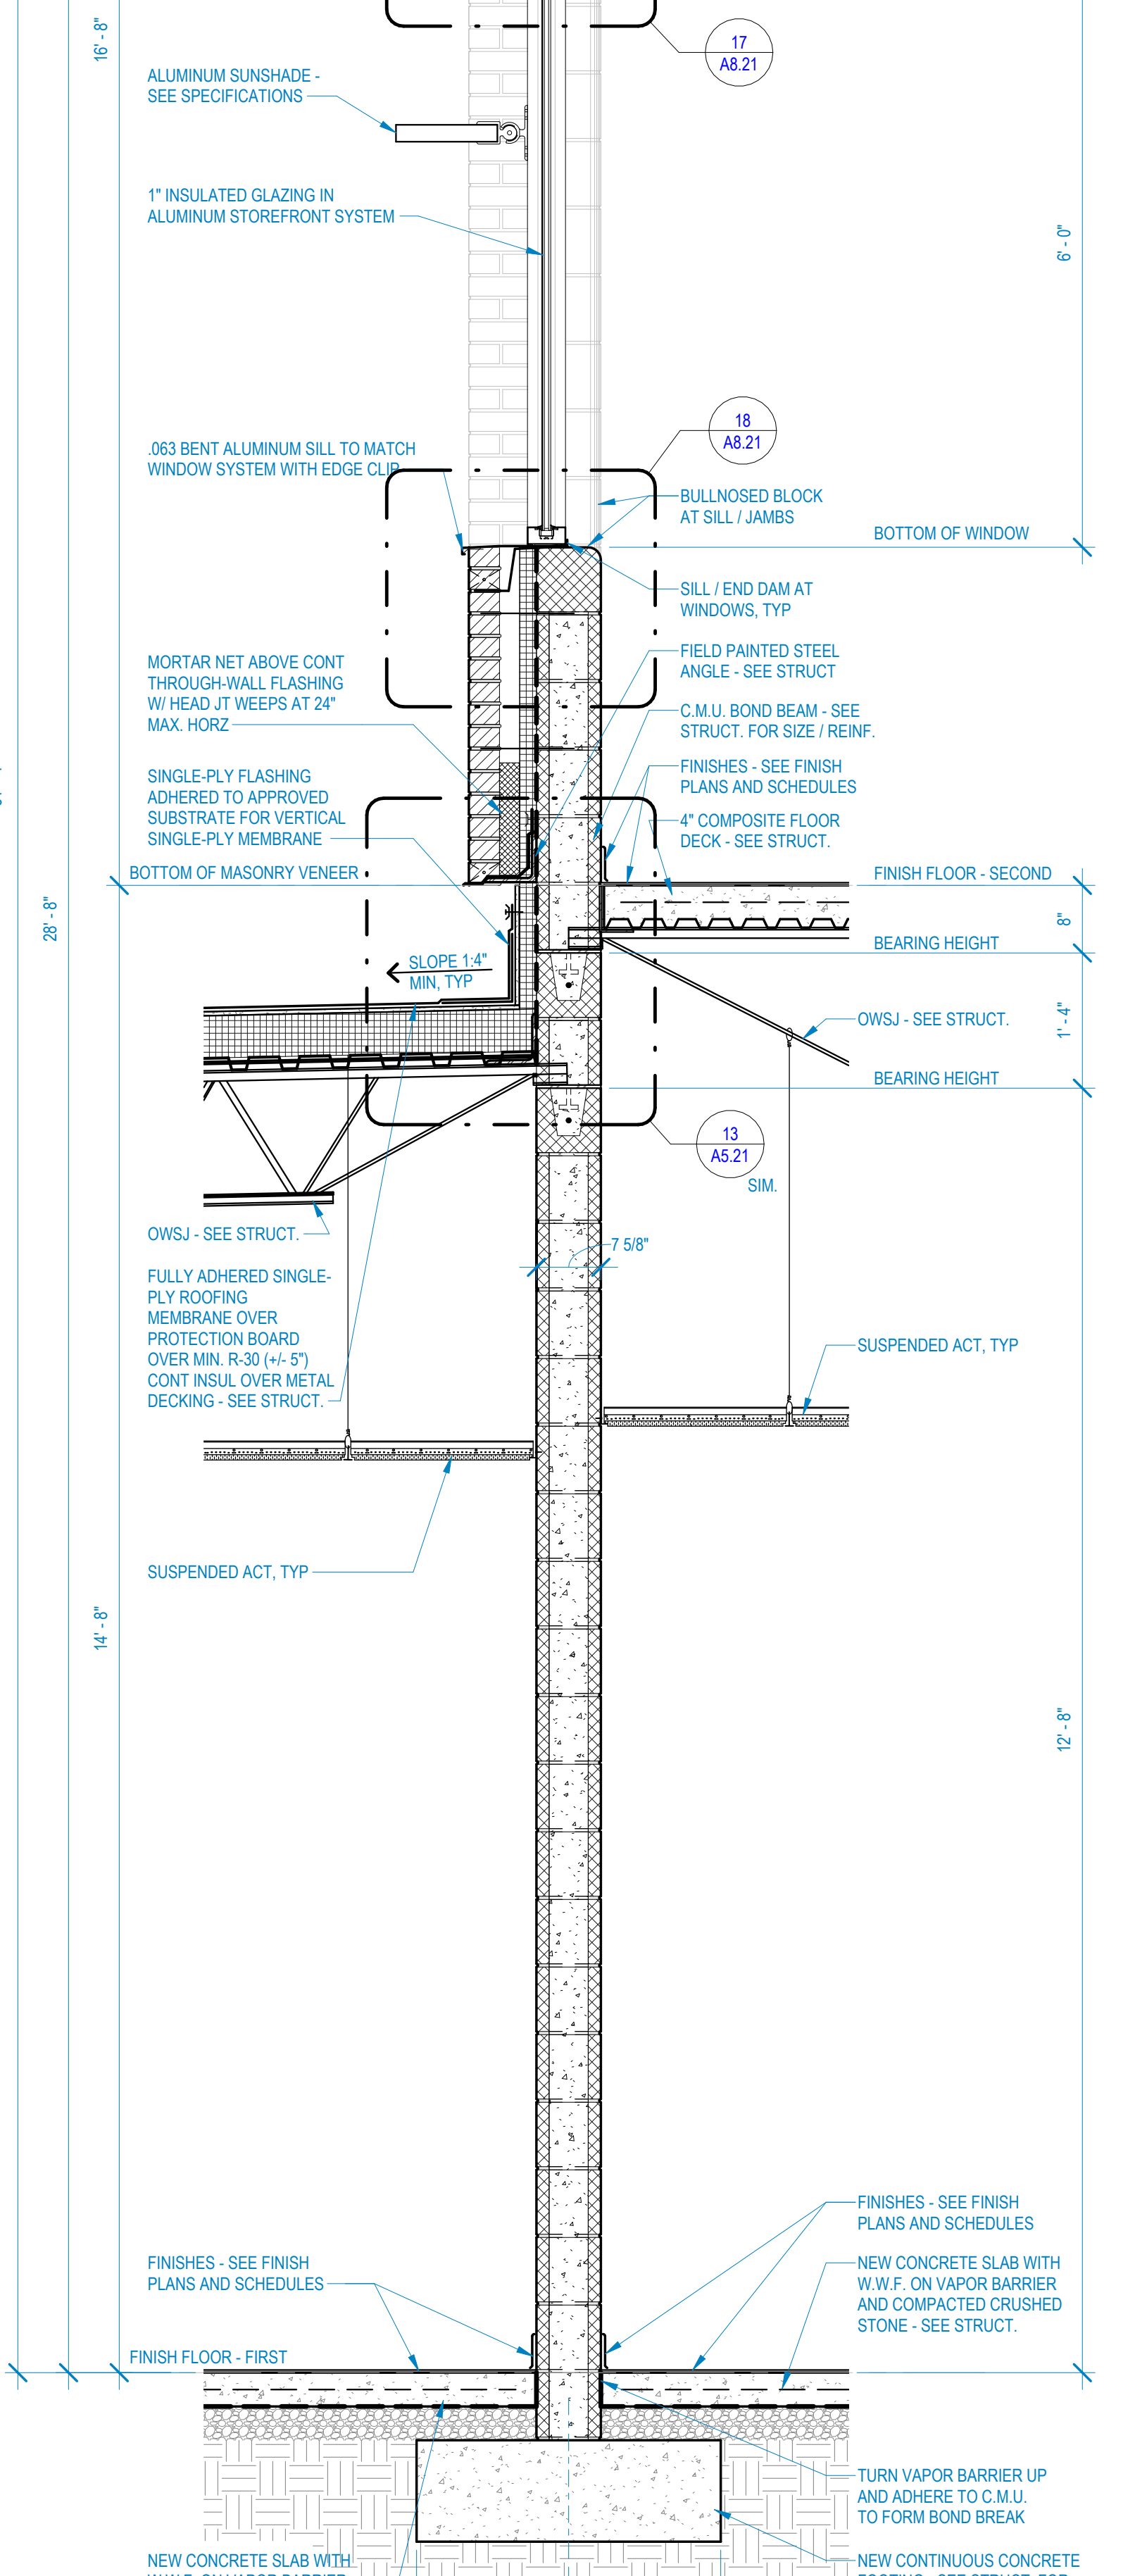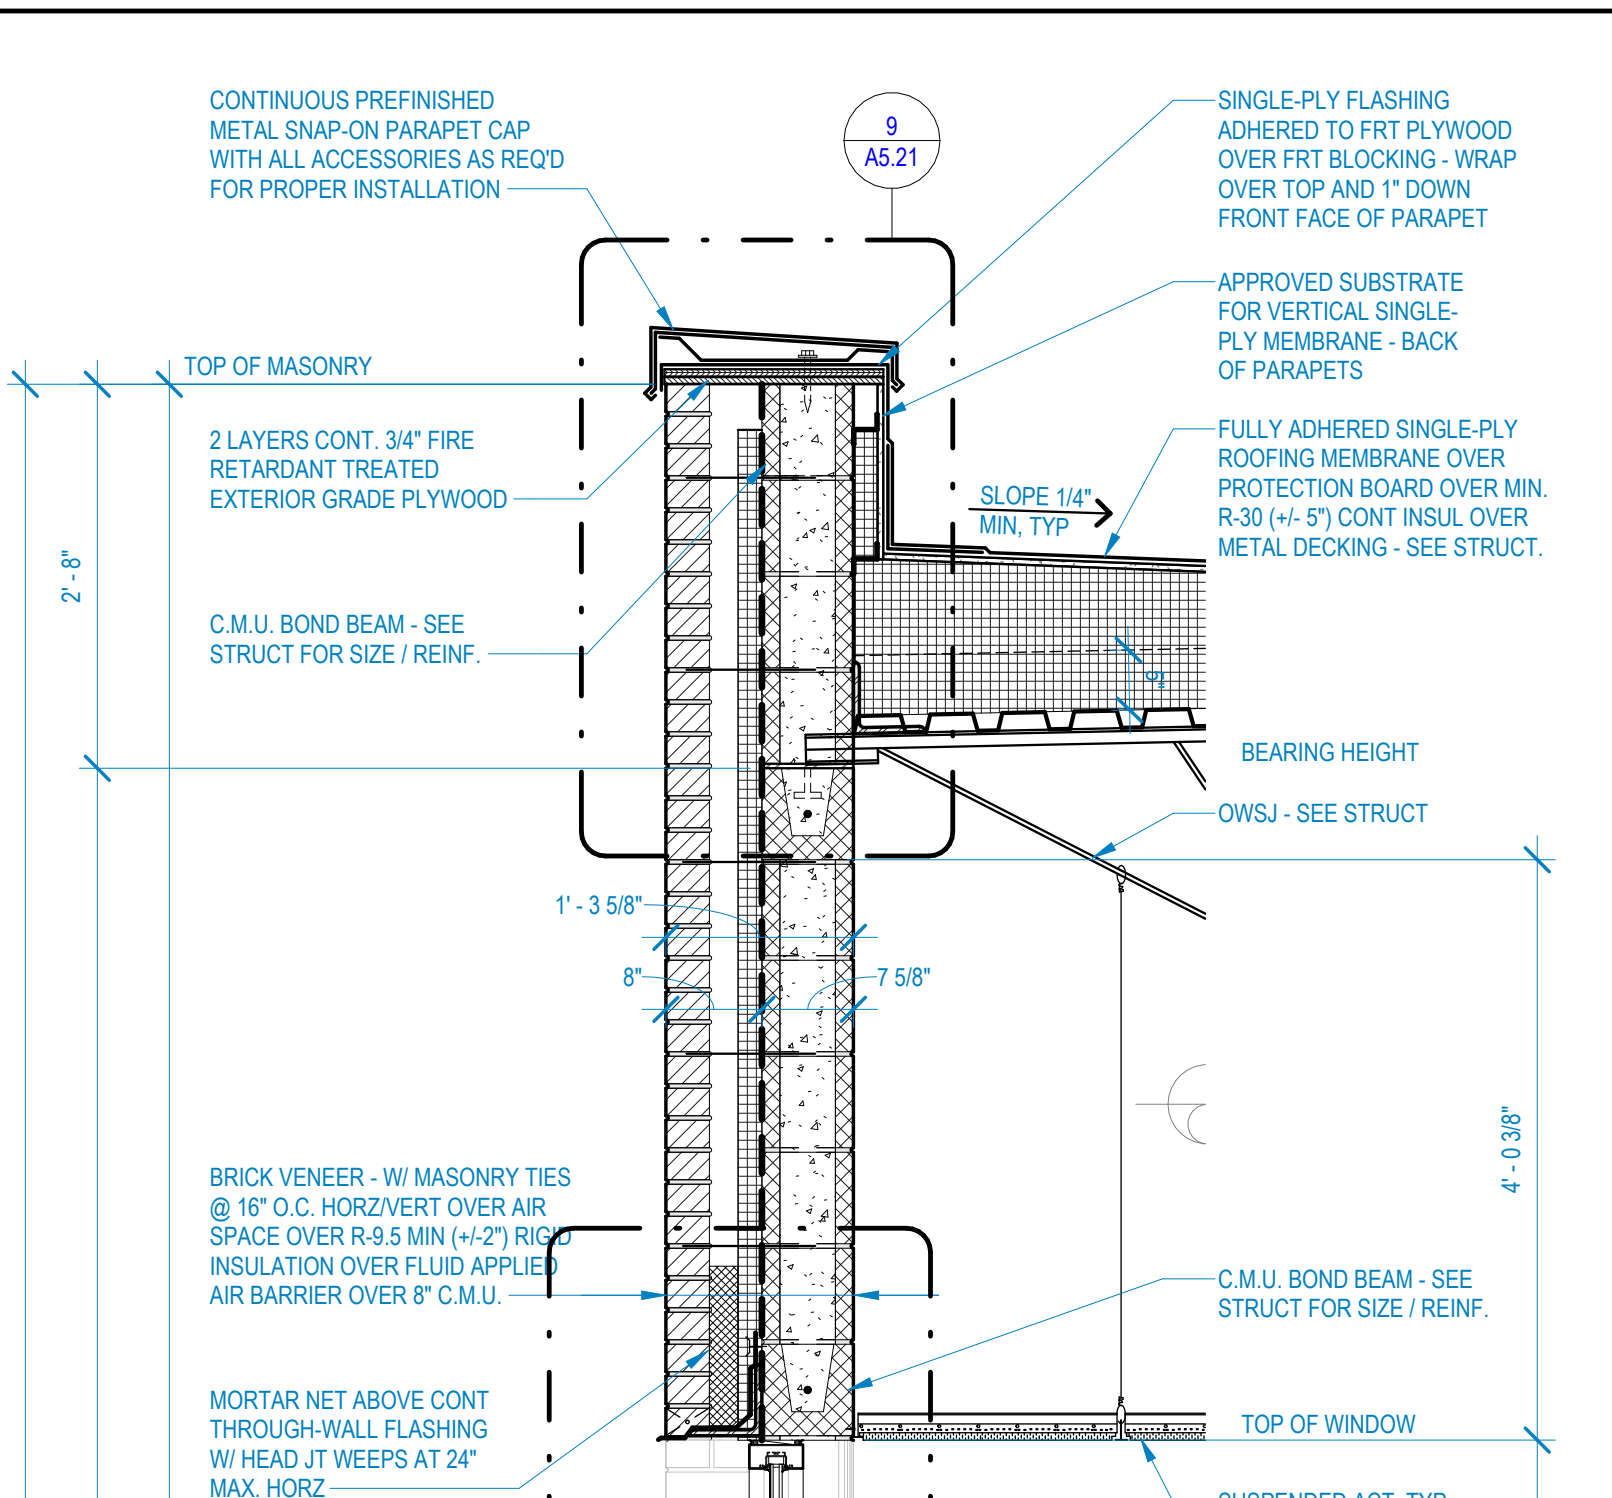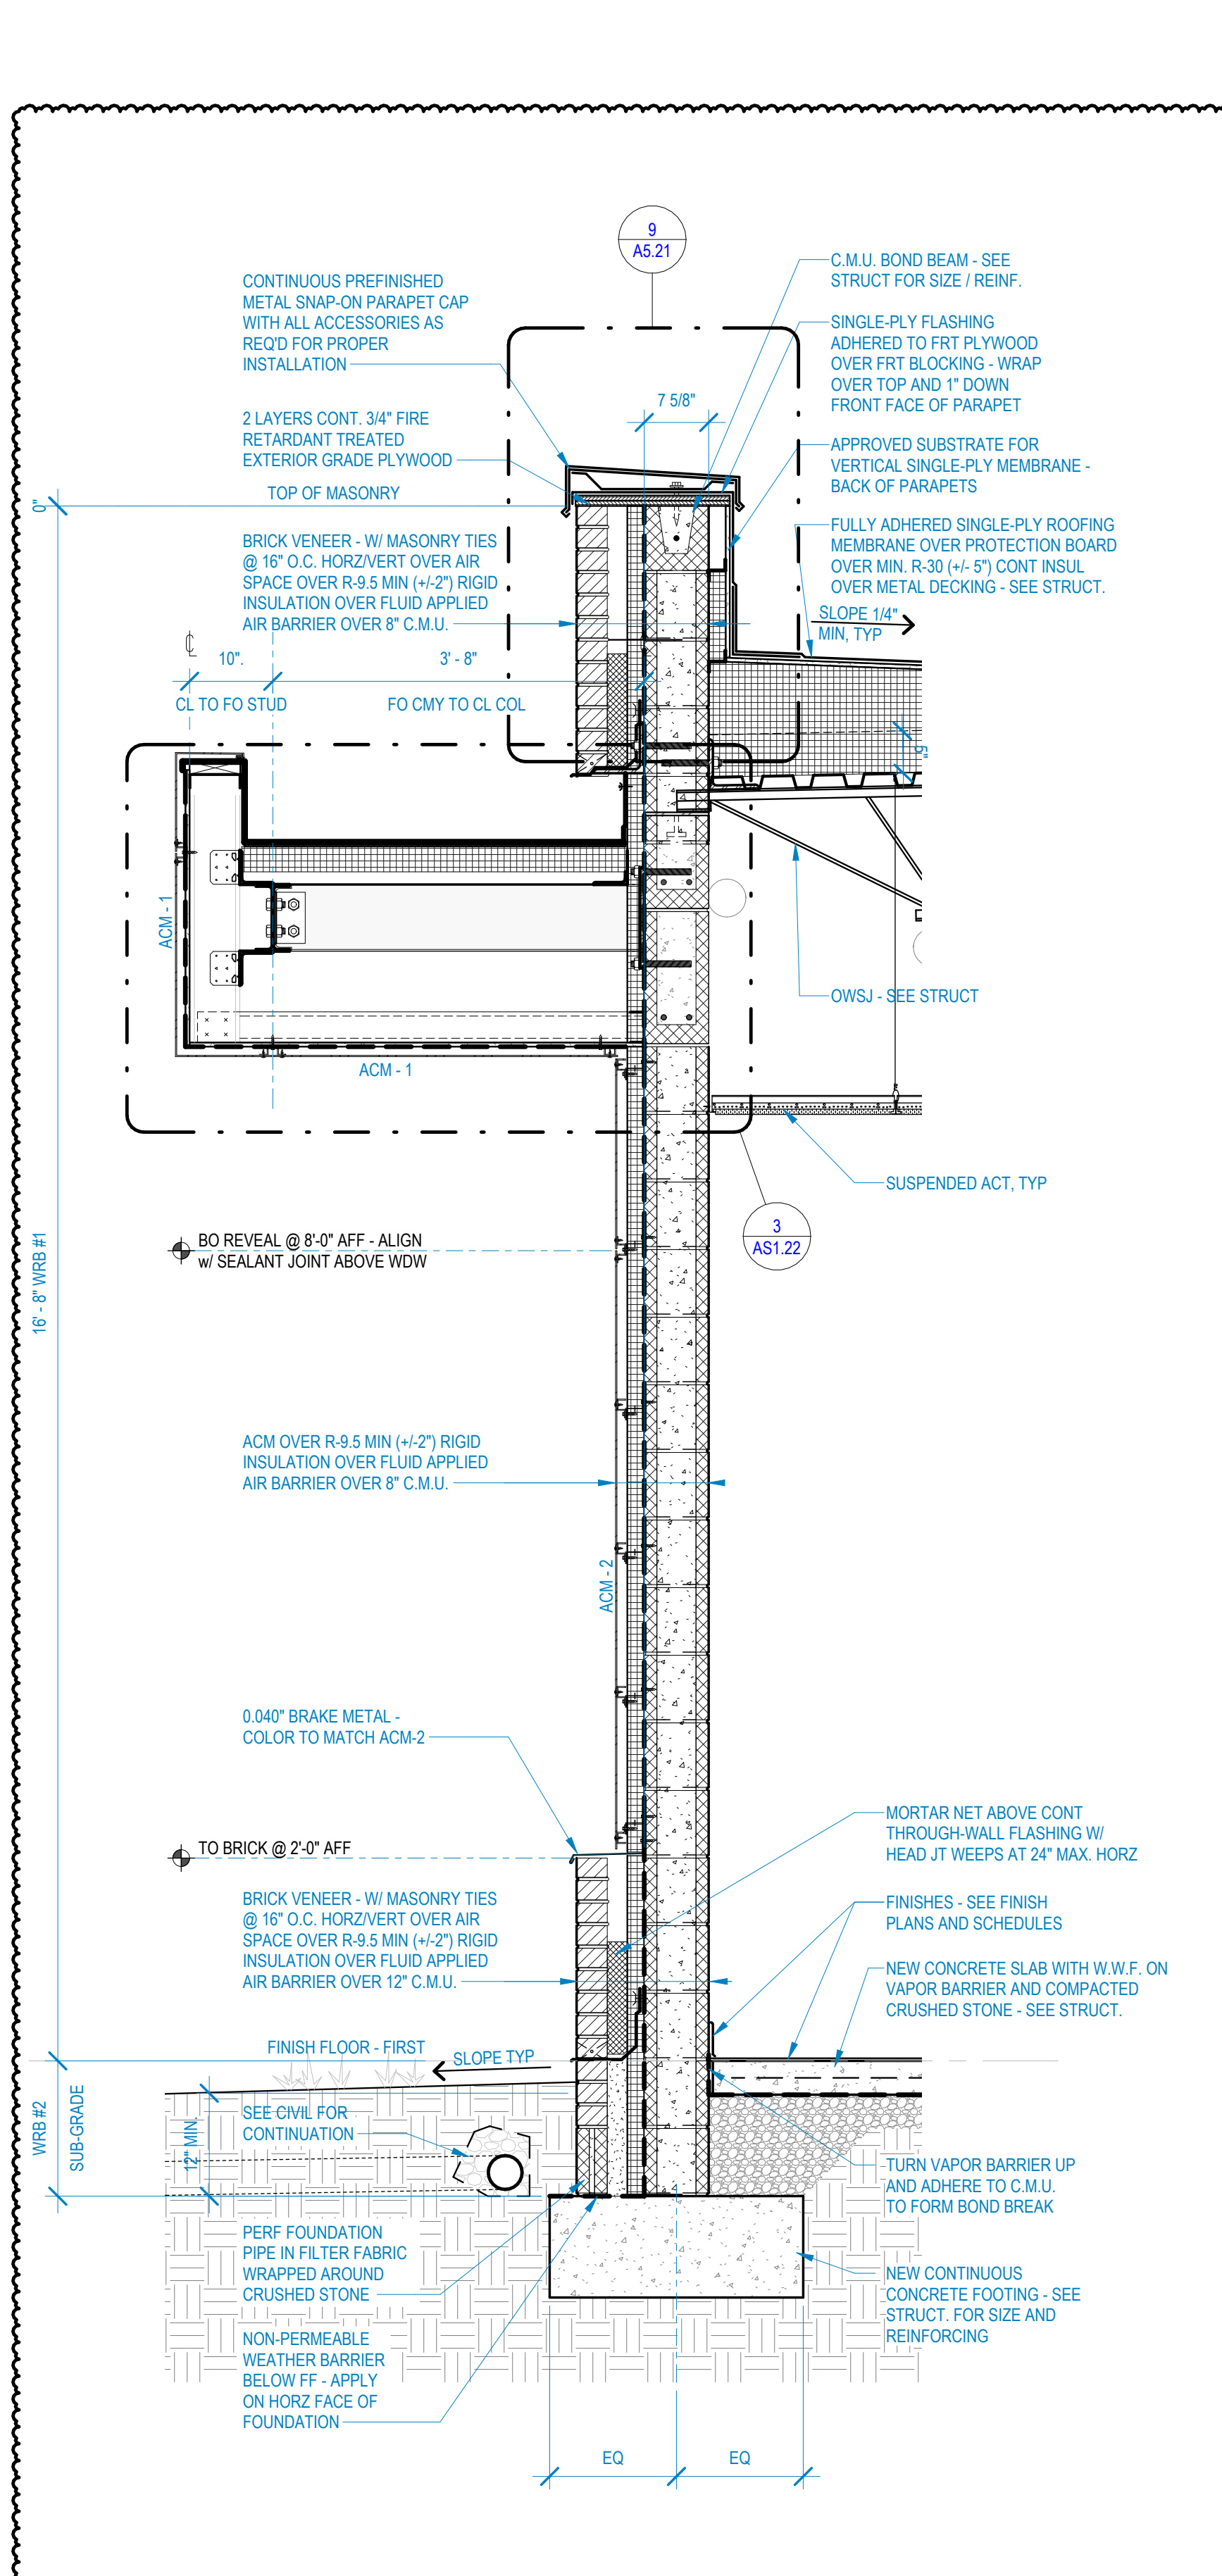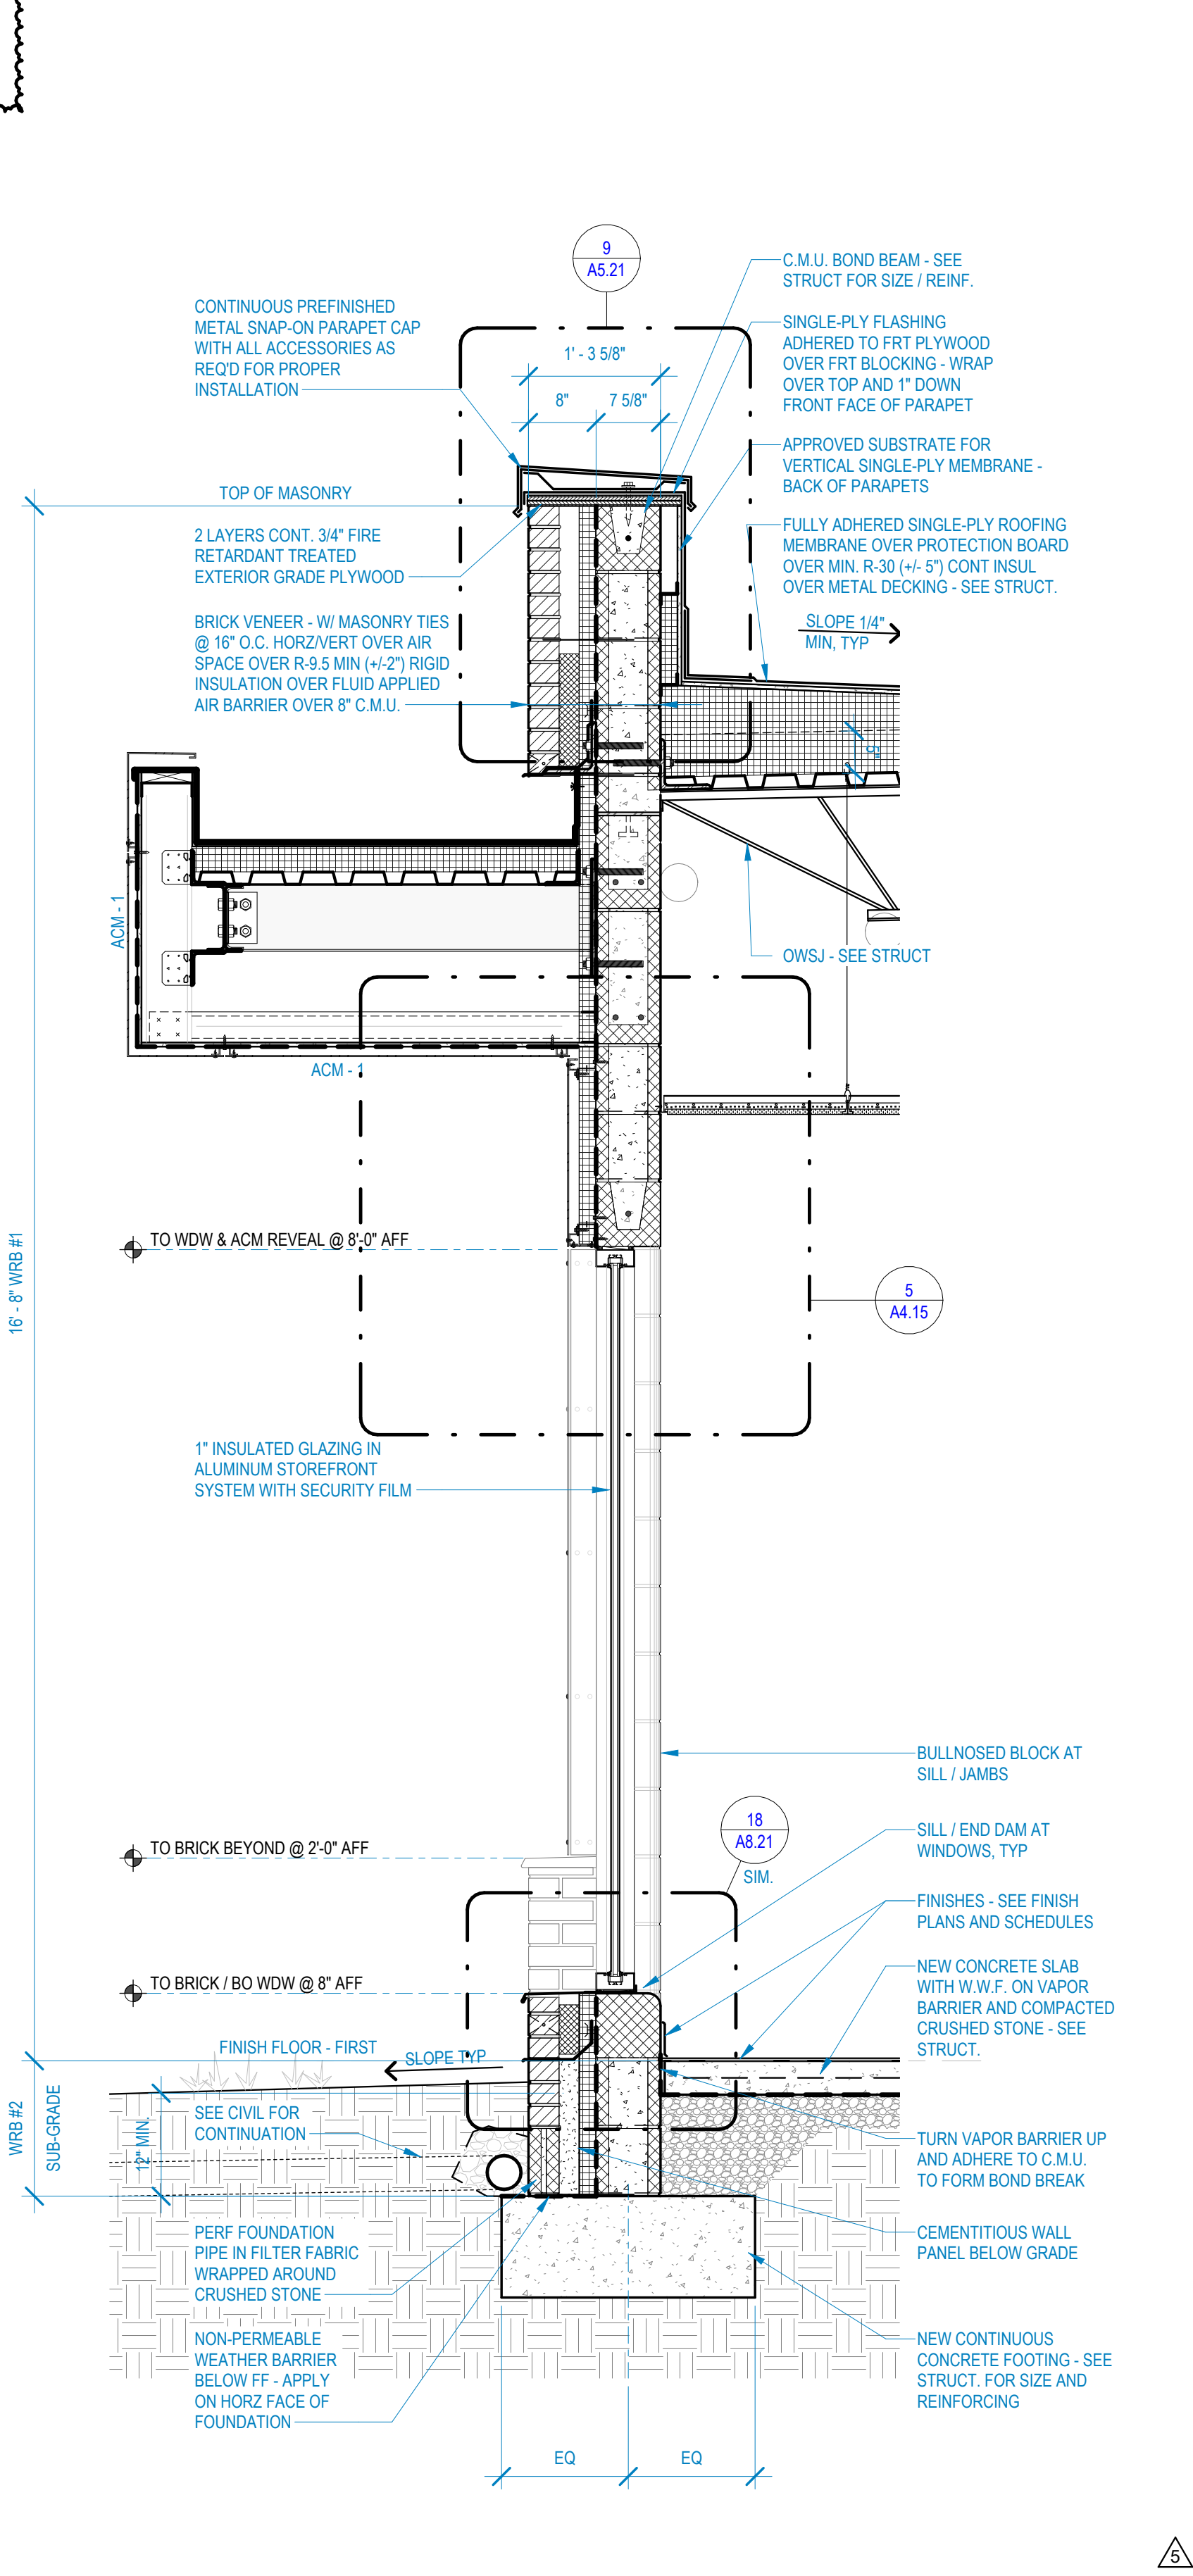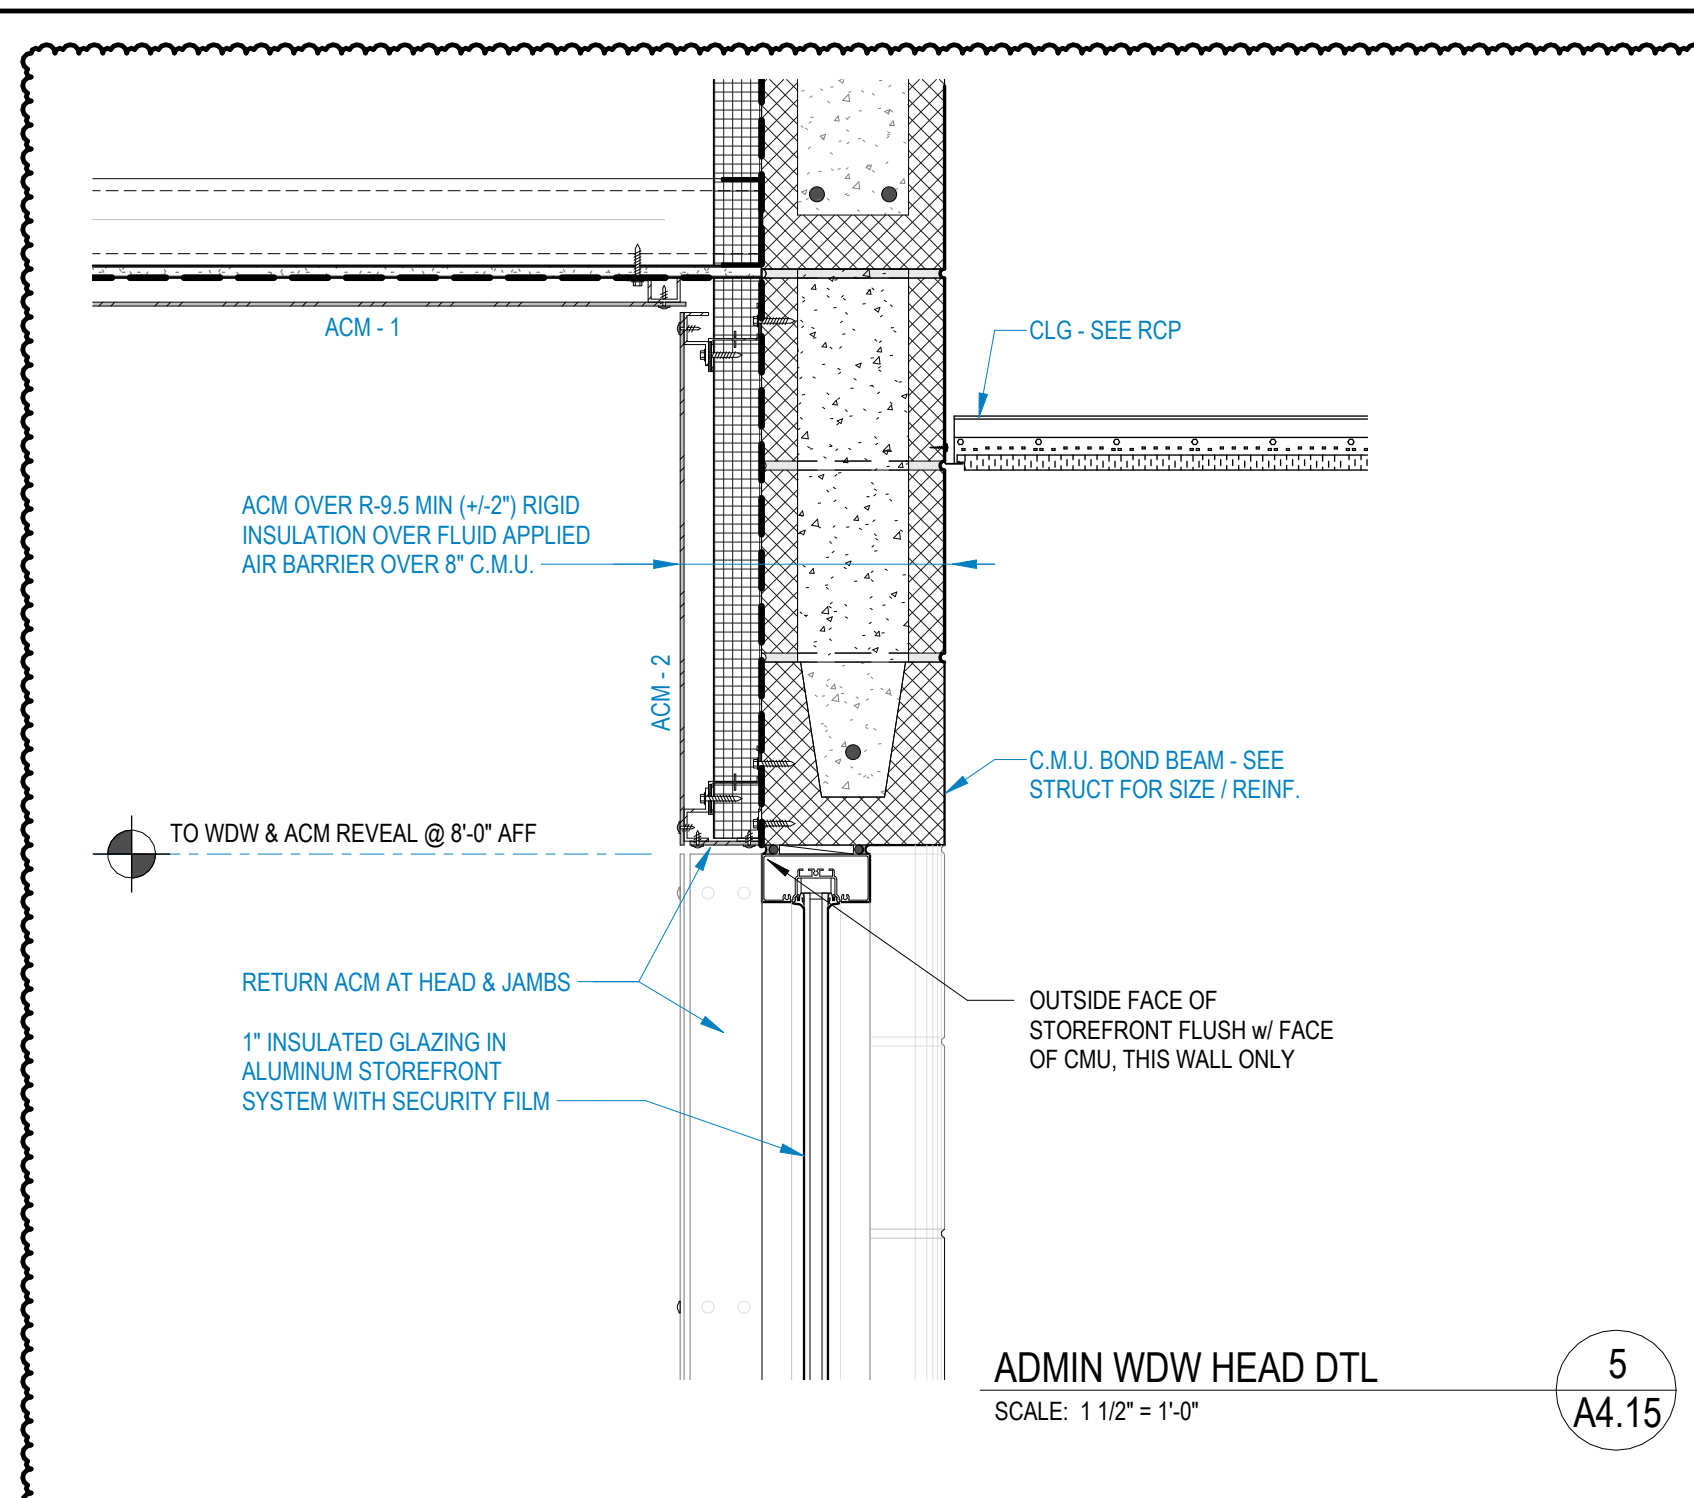

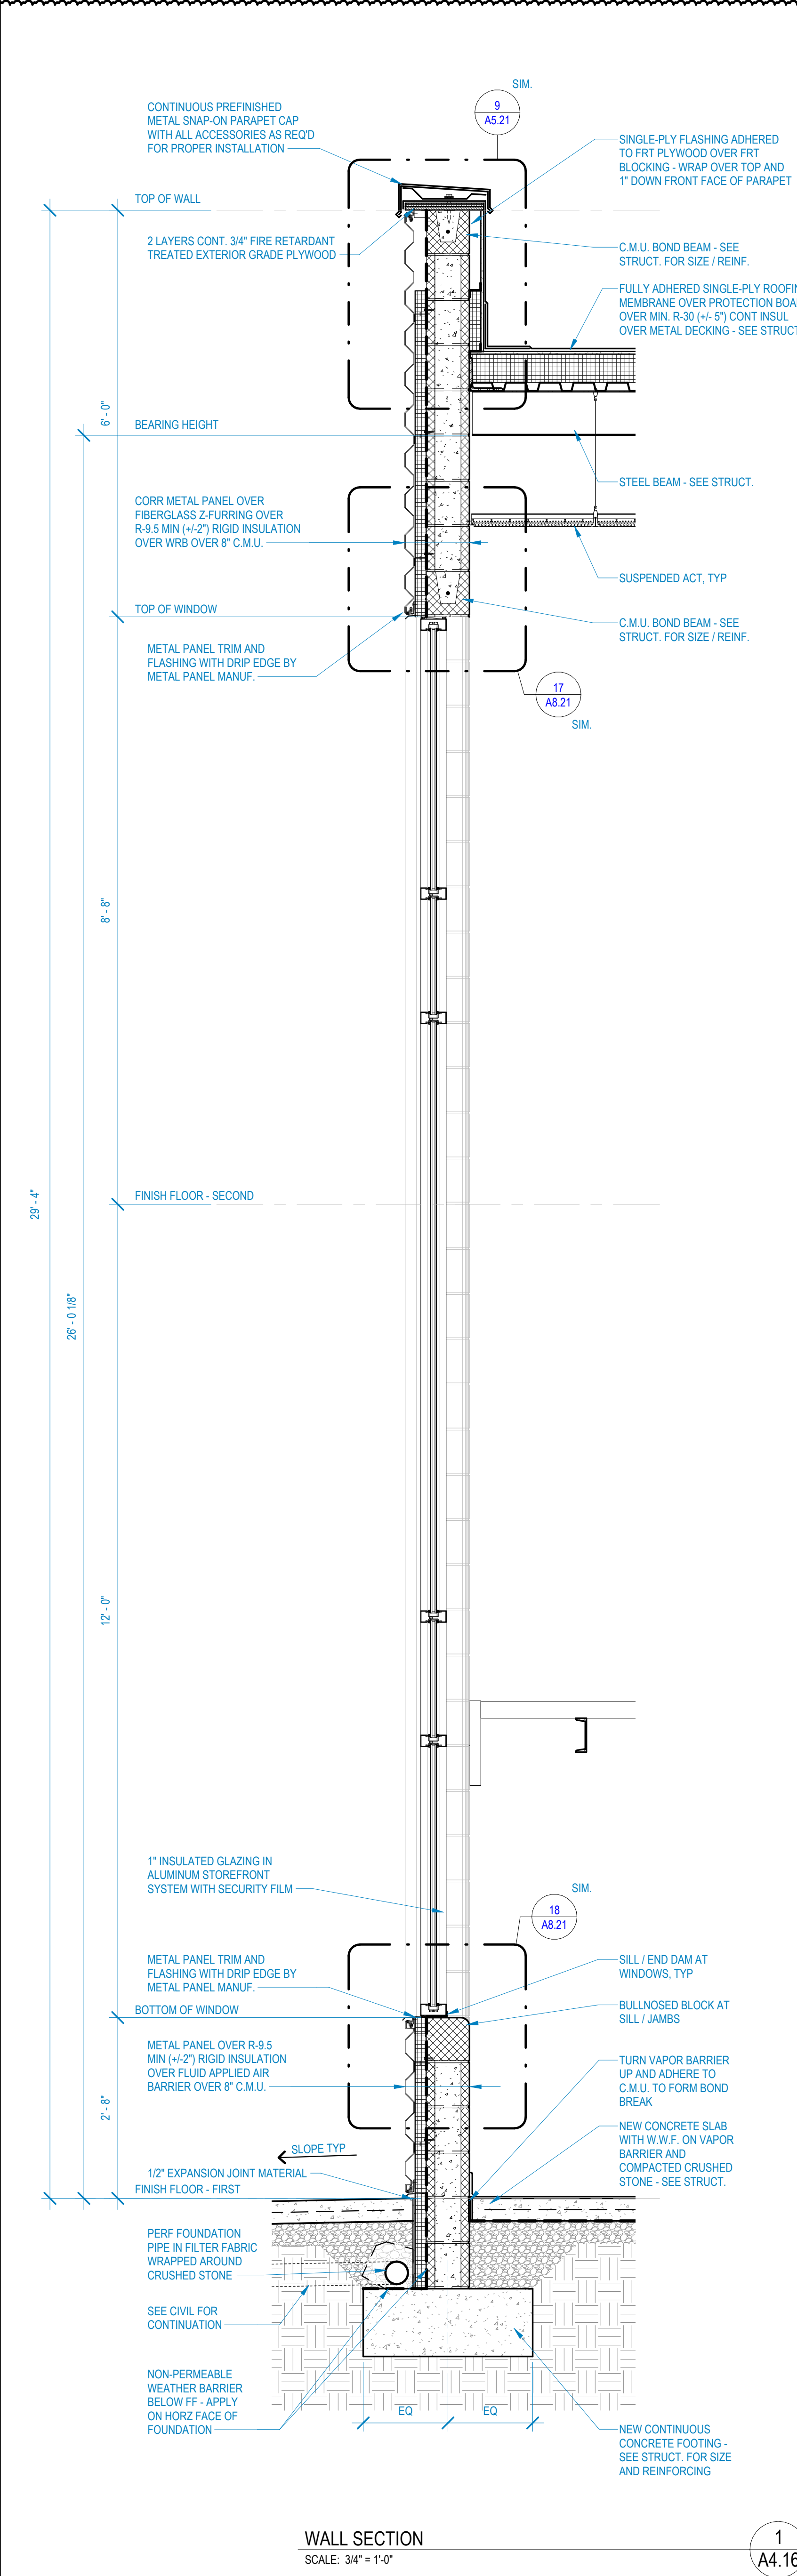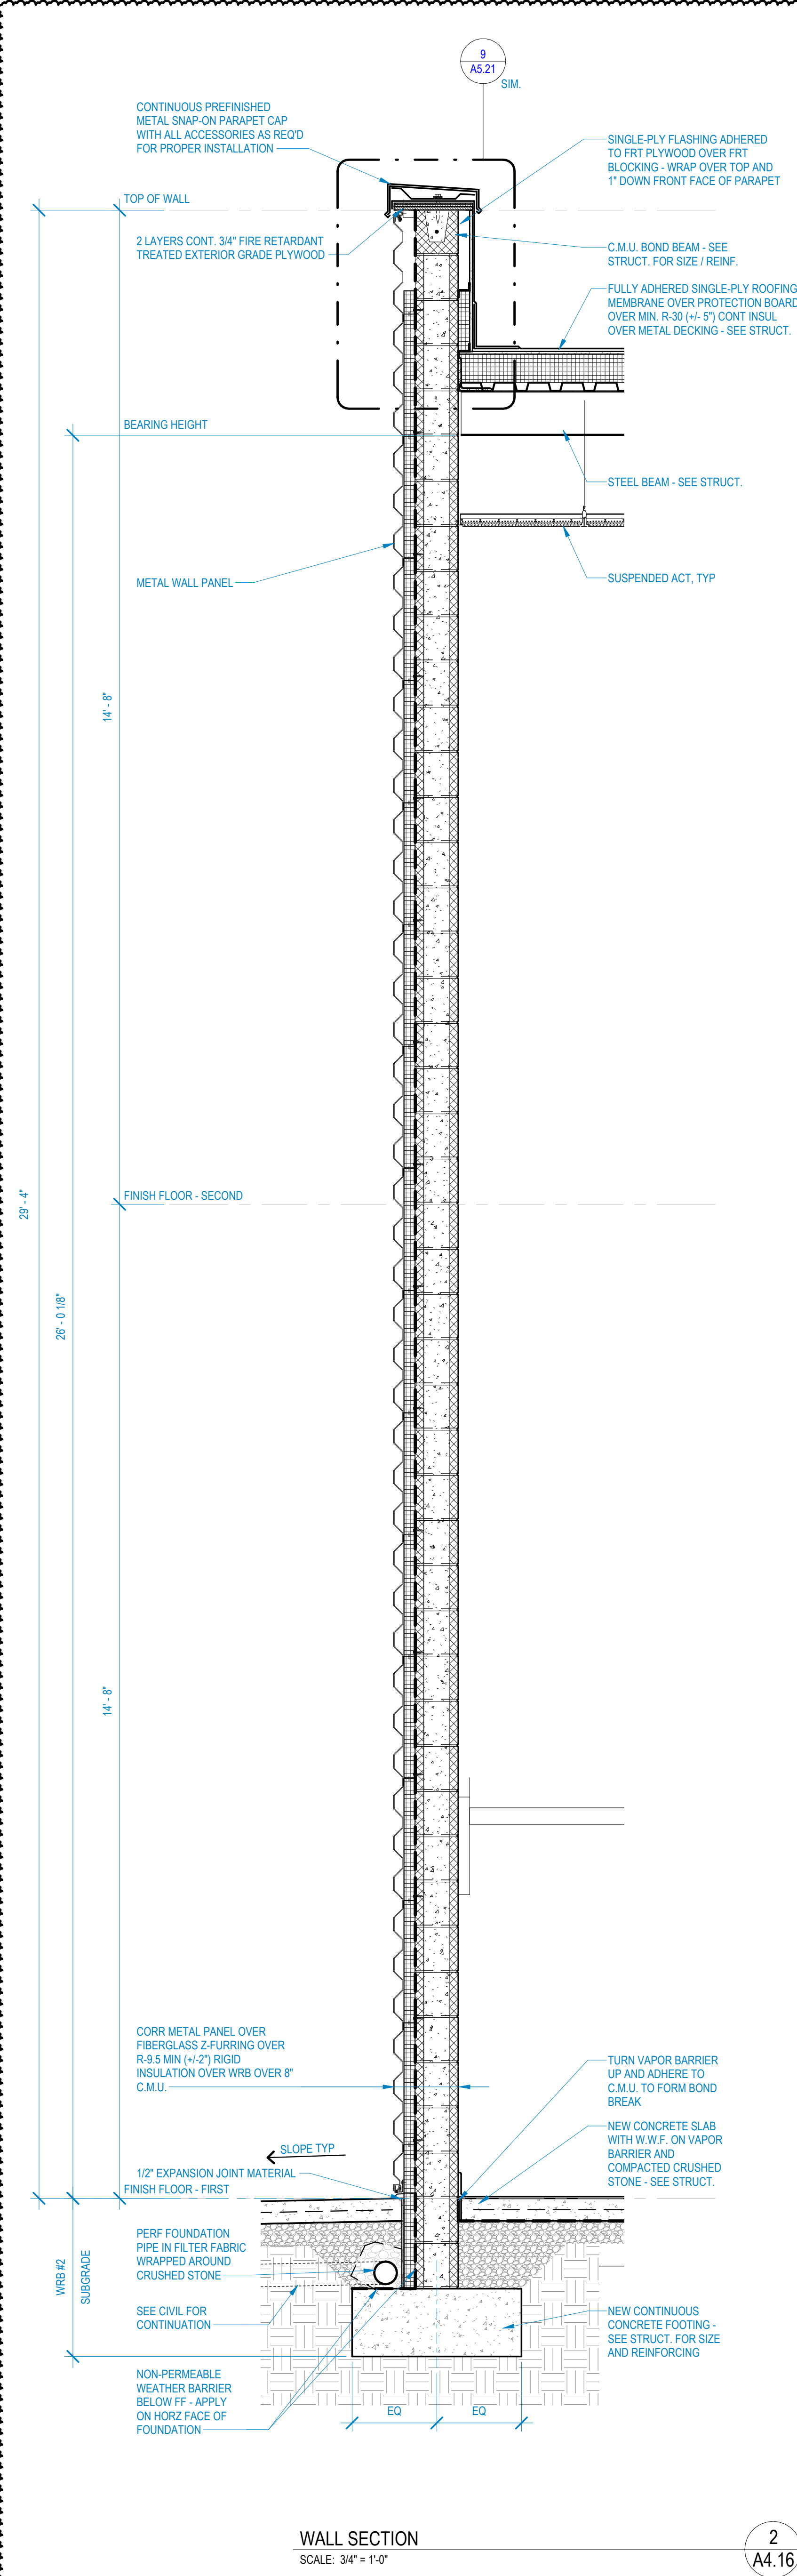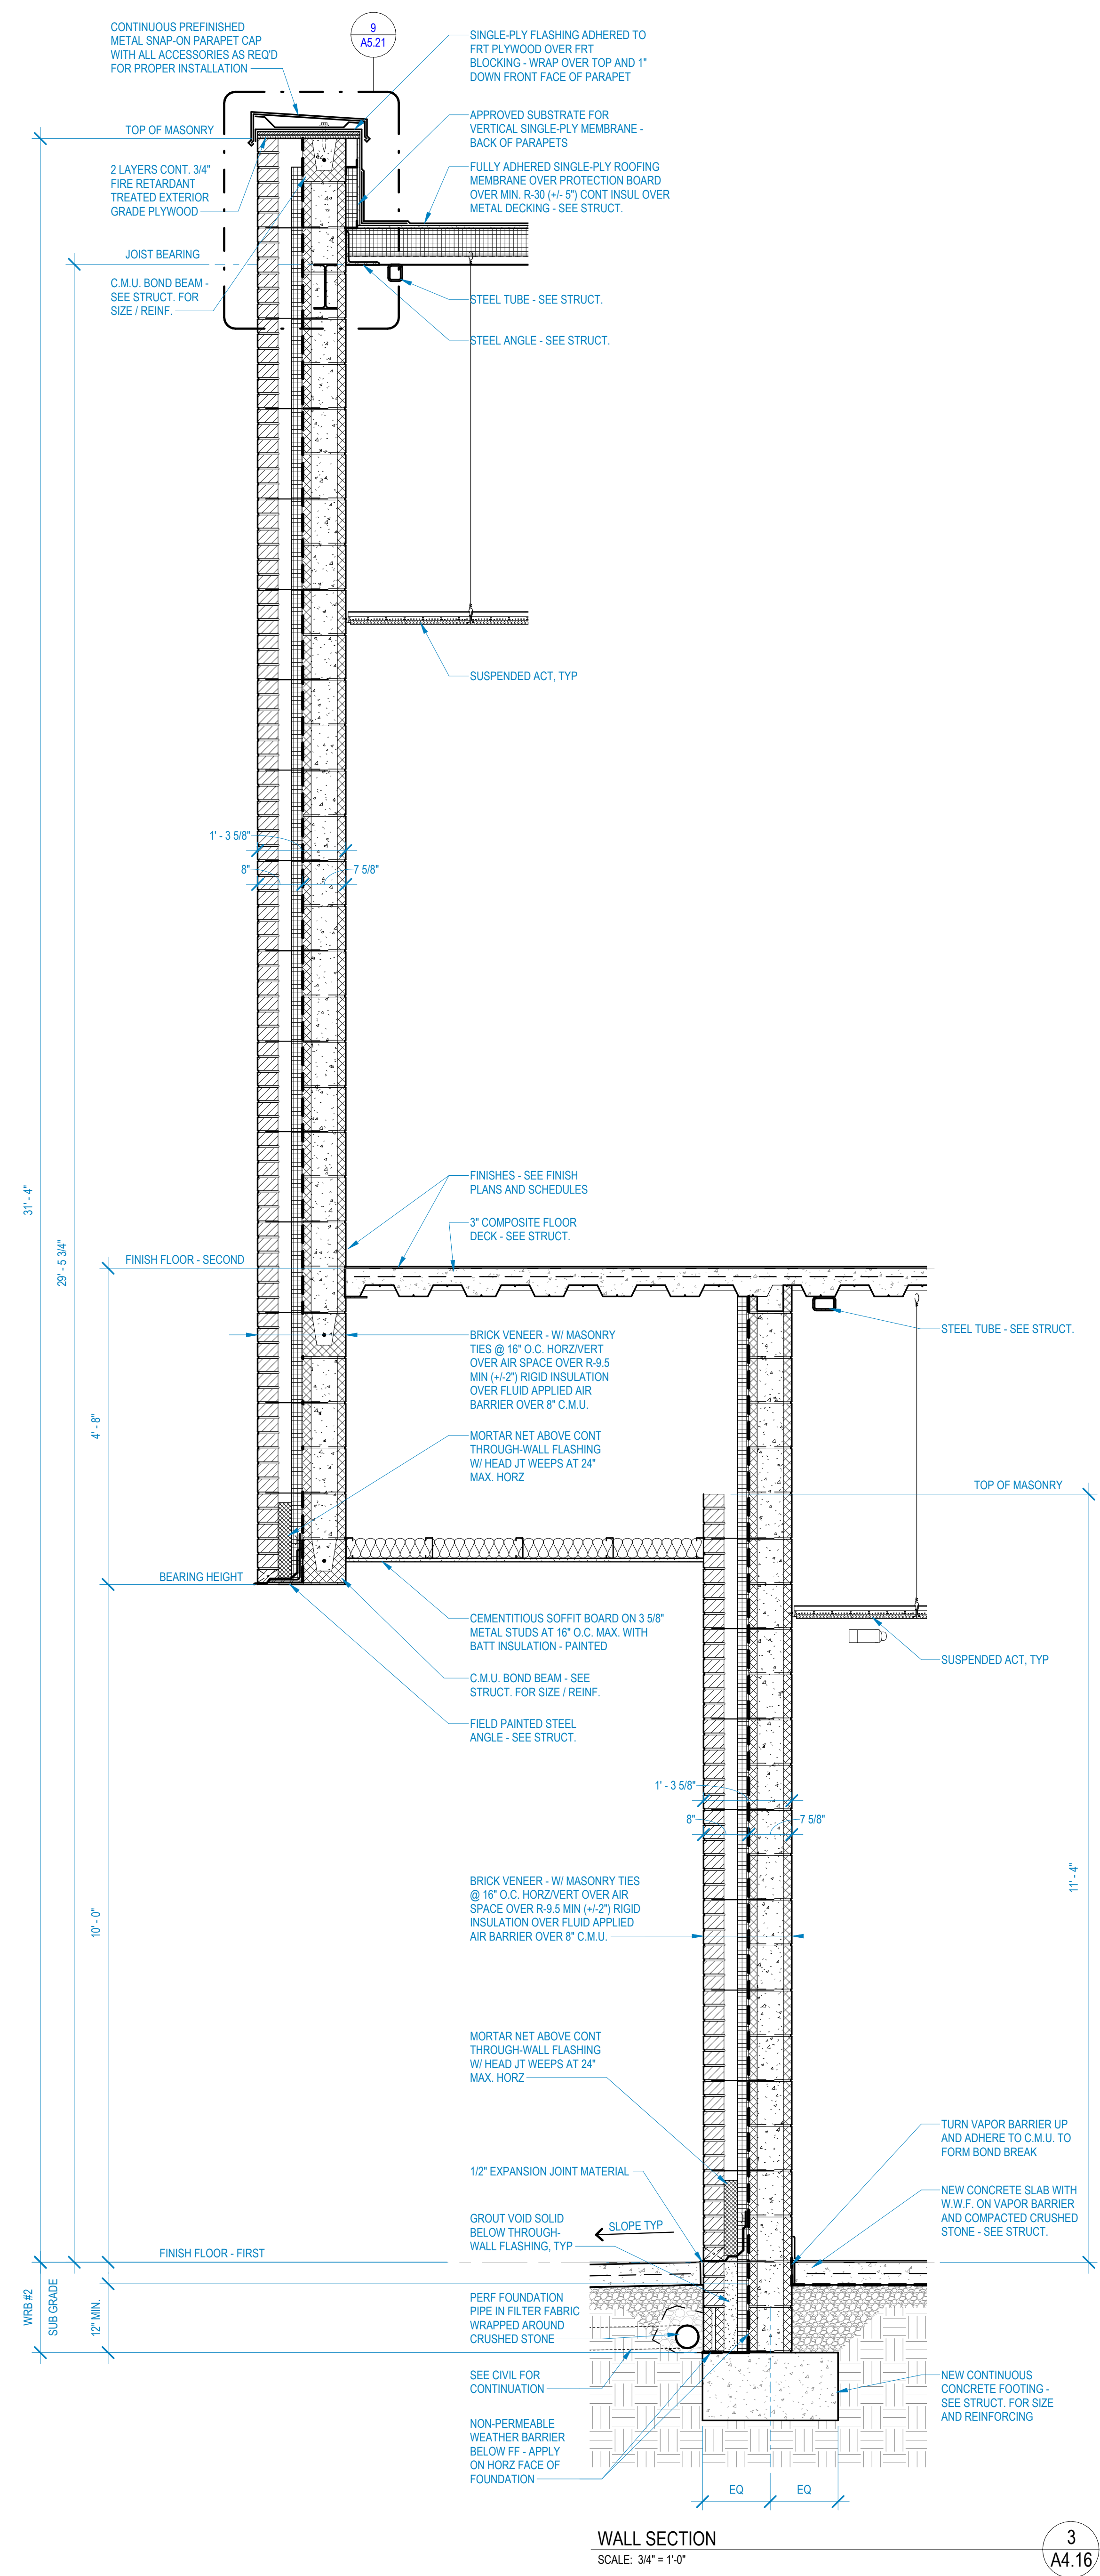

LEWIS GROUP ARCHITECTS
 A NEW SCHOOL FACILITY:
HORACE MAYNARD MIDDLE SCHOOL
 UNION COUNTY PUBLIC SCHOOLS
 MAYNARDVILLE, TN












DATE: 03/15/2024
 PROJECT NO: 21074
 SBC NO:

PROJECT REVISIONS

#	DATE	DESCRIPTION
5	06/14/2024	ADD 003

THIS DRAWING IS THE PROPERTY OF THE LEWIS GROUP ARCHITECTS, INC. AND IS TO BE USED ONLY FOR THE PROJECT AND SITE SPECIFICALLY IDENTIFIED HEREIN. THIS DRAWING IS NOT TO BE USED ON ANY OTHER PROJECT WITHOUT THE PROJECT FOR WHICH IT IS MADE OR EXECUTED OR NOT. THIS DRAWING AND ITS CONTENTS ARE THE SOLE POSSESSION OF THE LEWIS GROUP ARCHITECTS, INC. AND SHALL NOT BE REPRODUCED OR TRANSMITTED IN ANY FORM OR BY ANY MEANS WITHOUT THE WRITTEN CONSENT OF THE LEWIS GROUP ARCHITECTS, INC. IT IS TO BE RETURNED UPON REQUEST.

WALL SECTIONS
ADMINISTRATION
A4.16

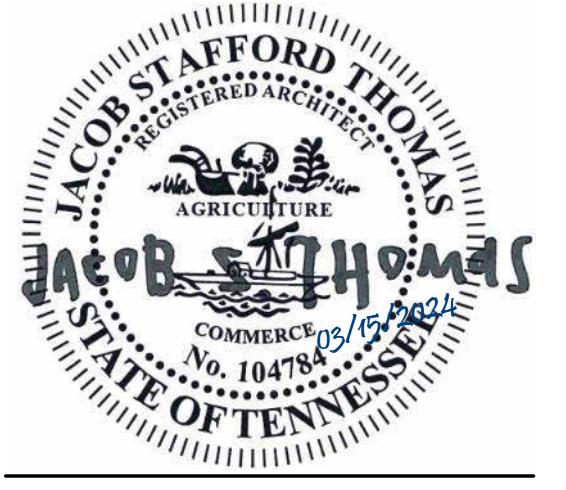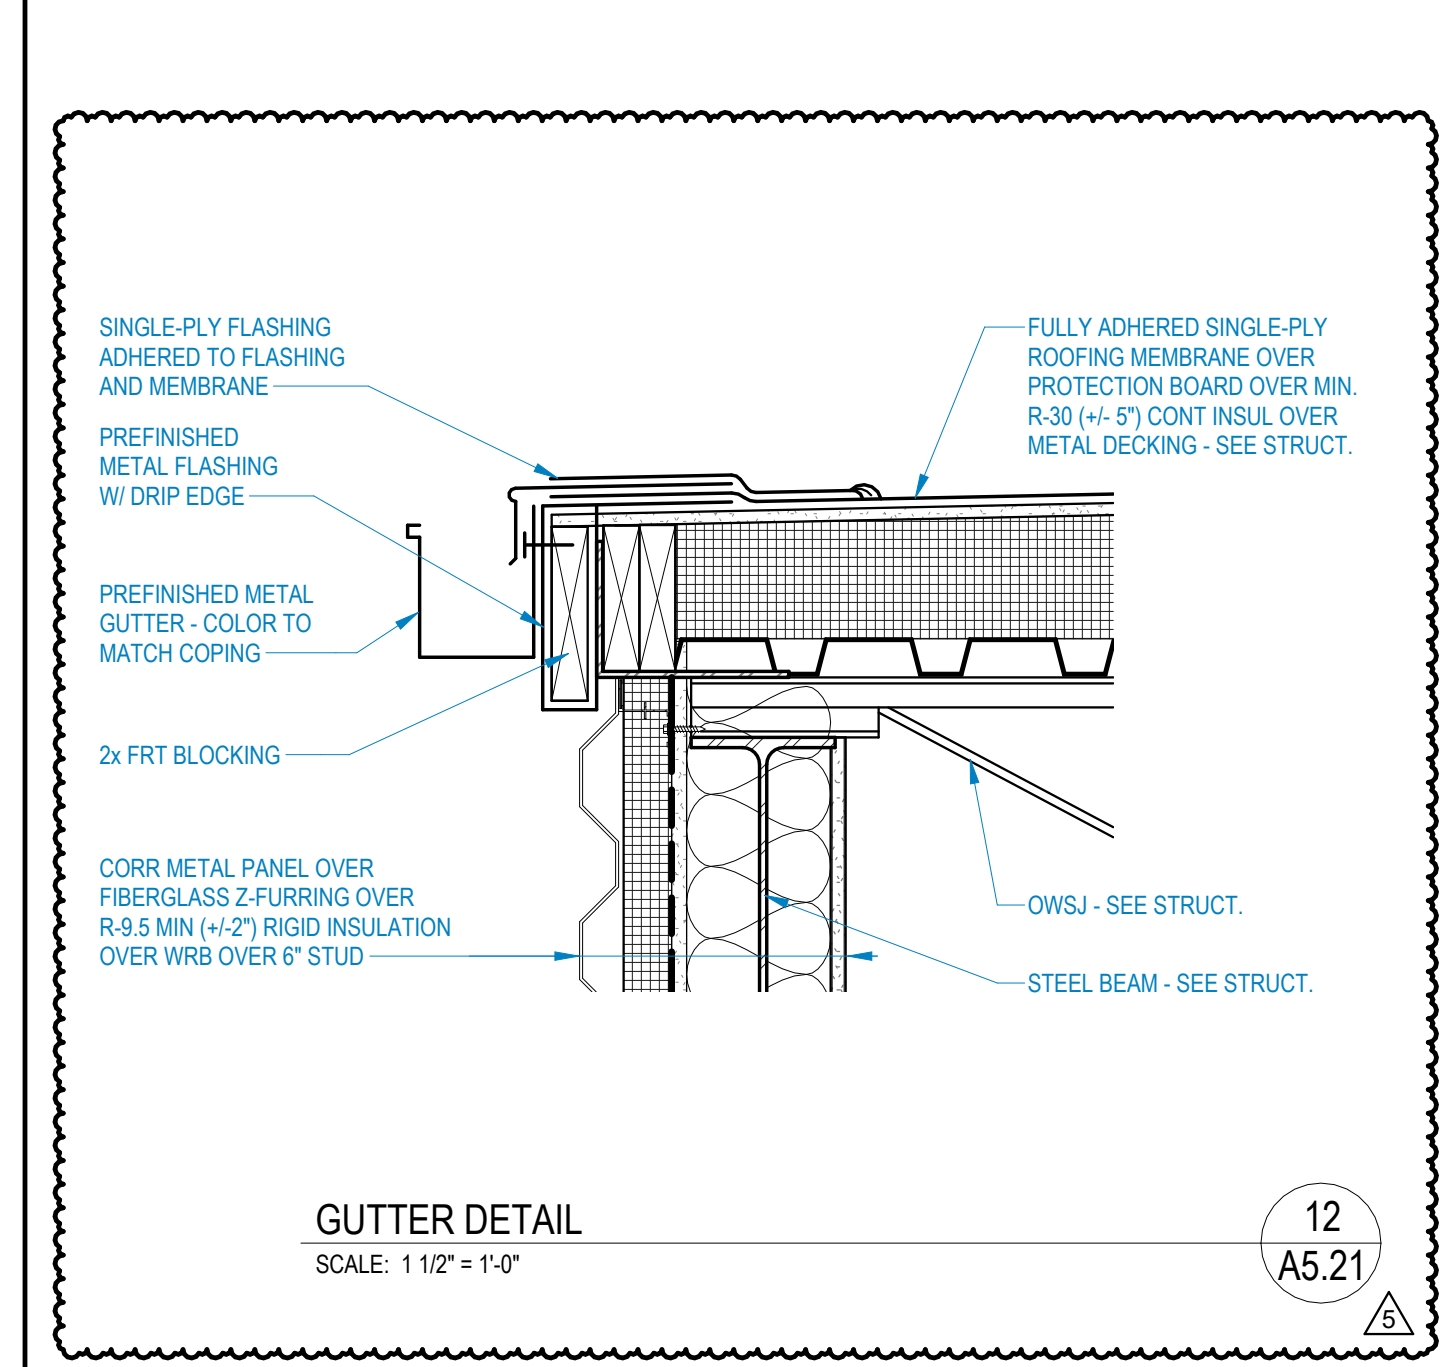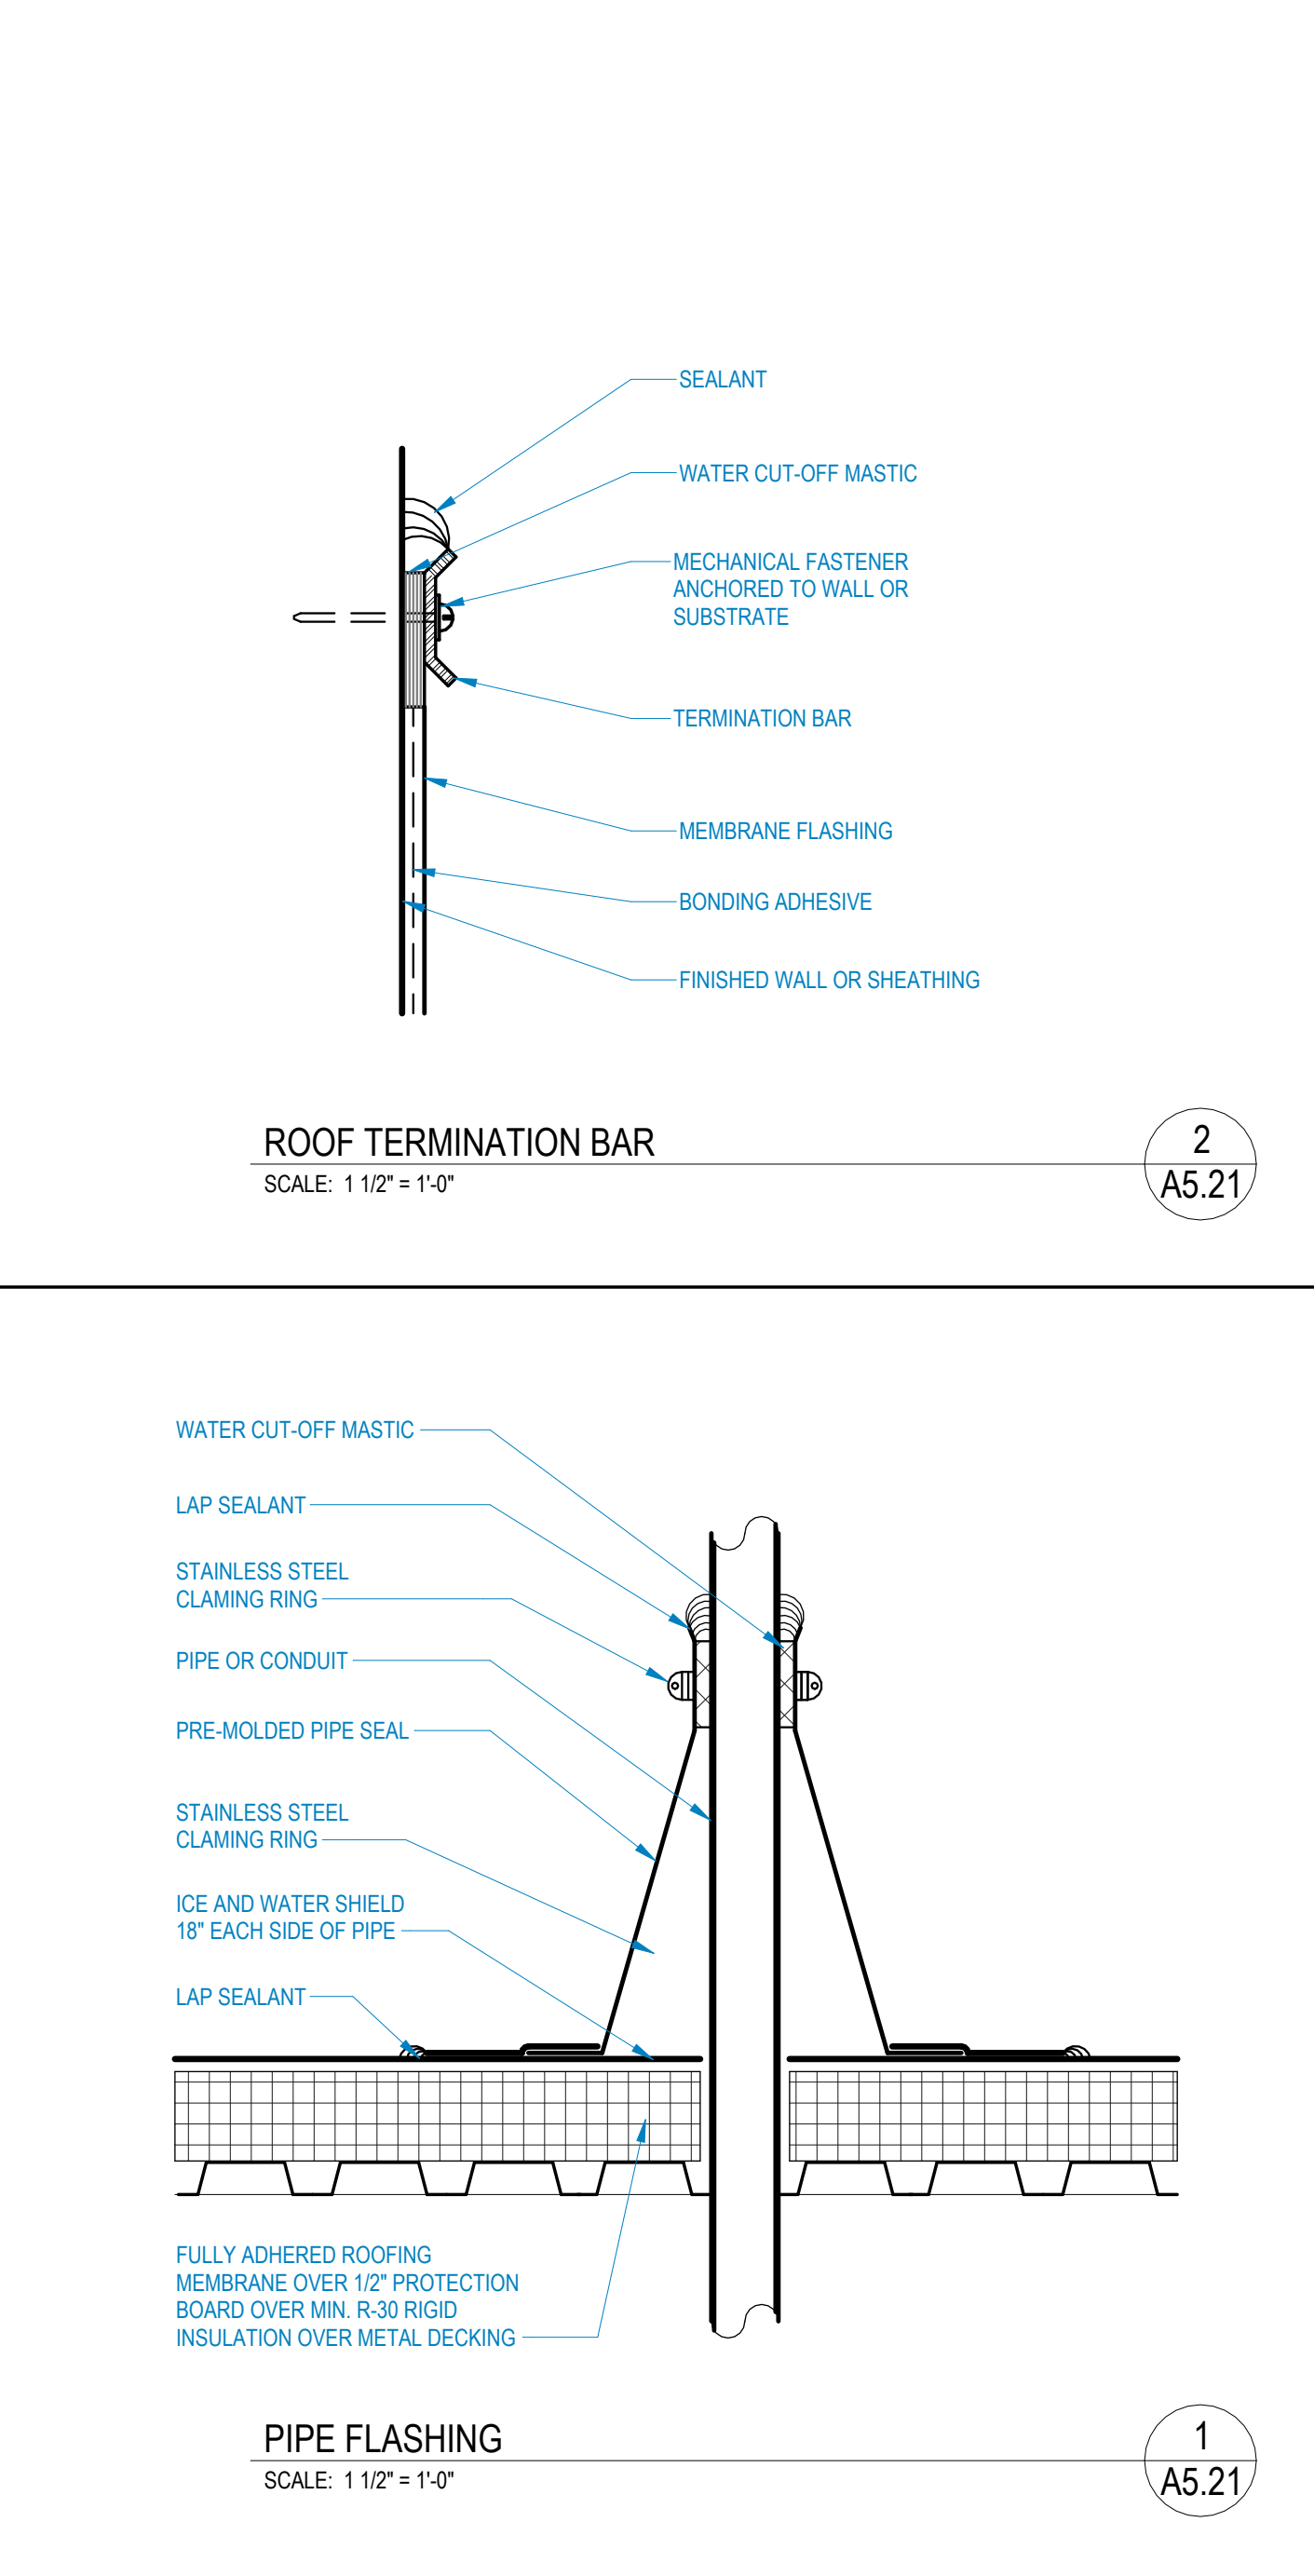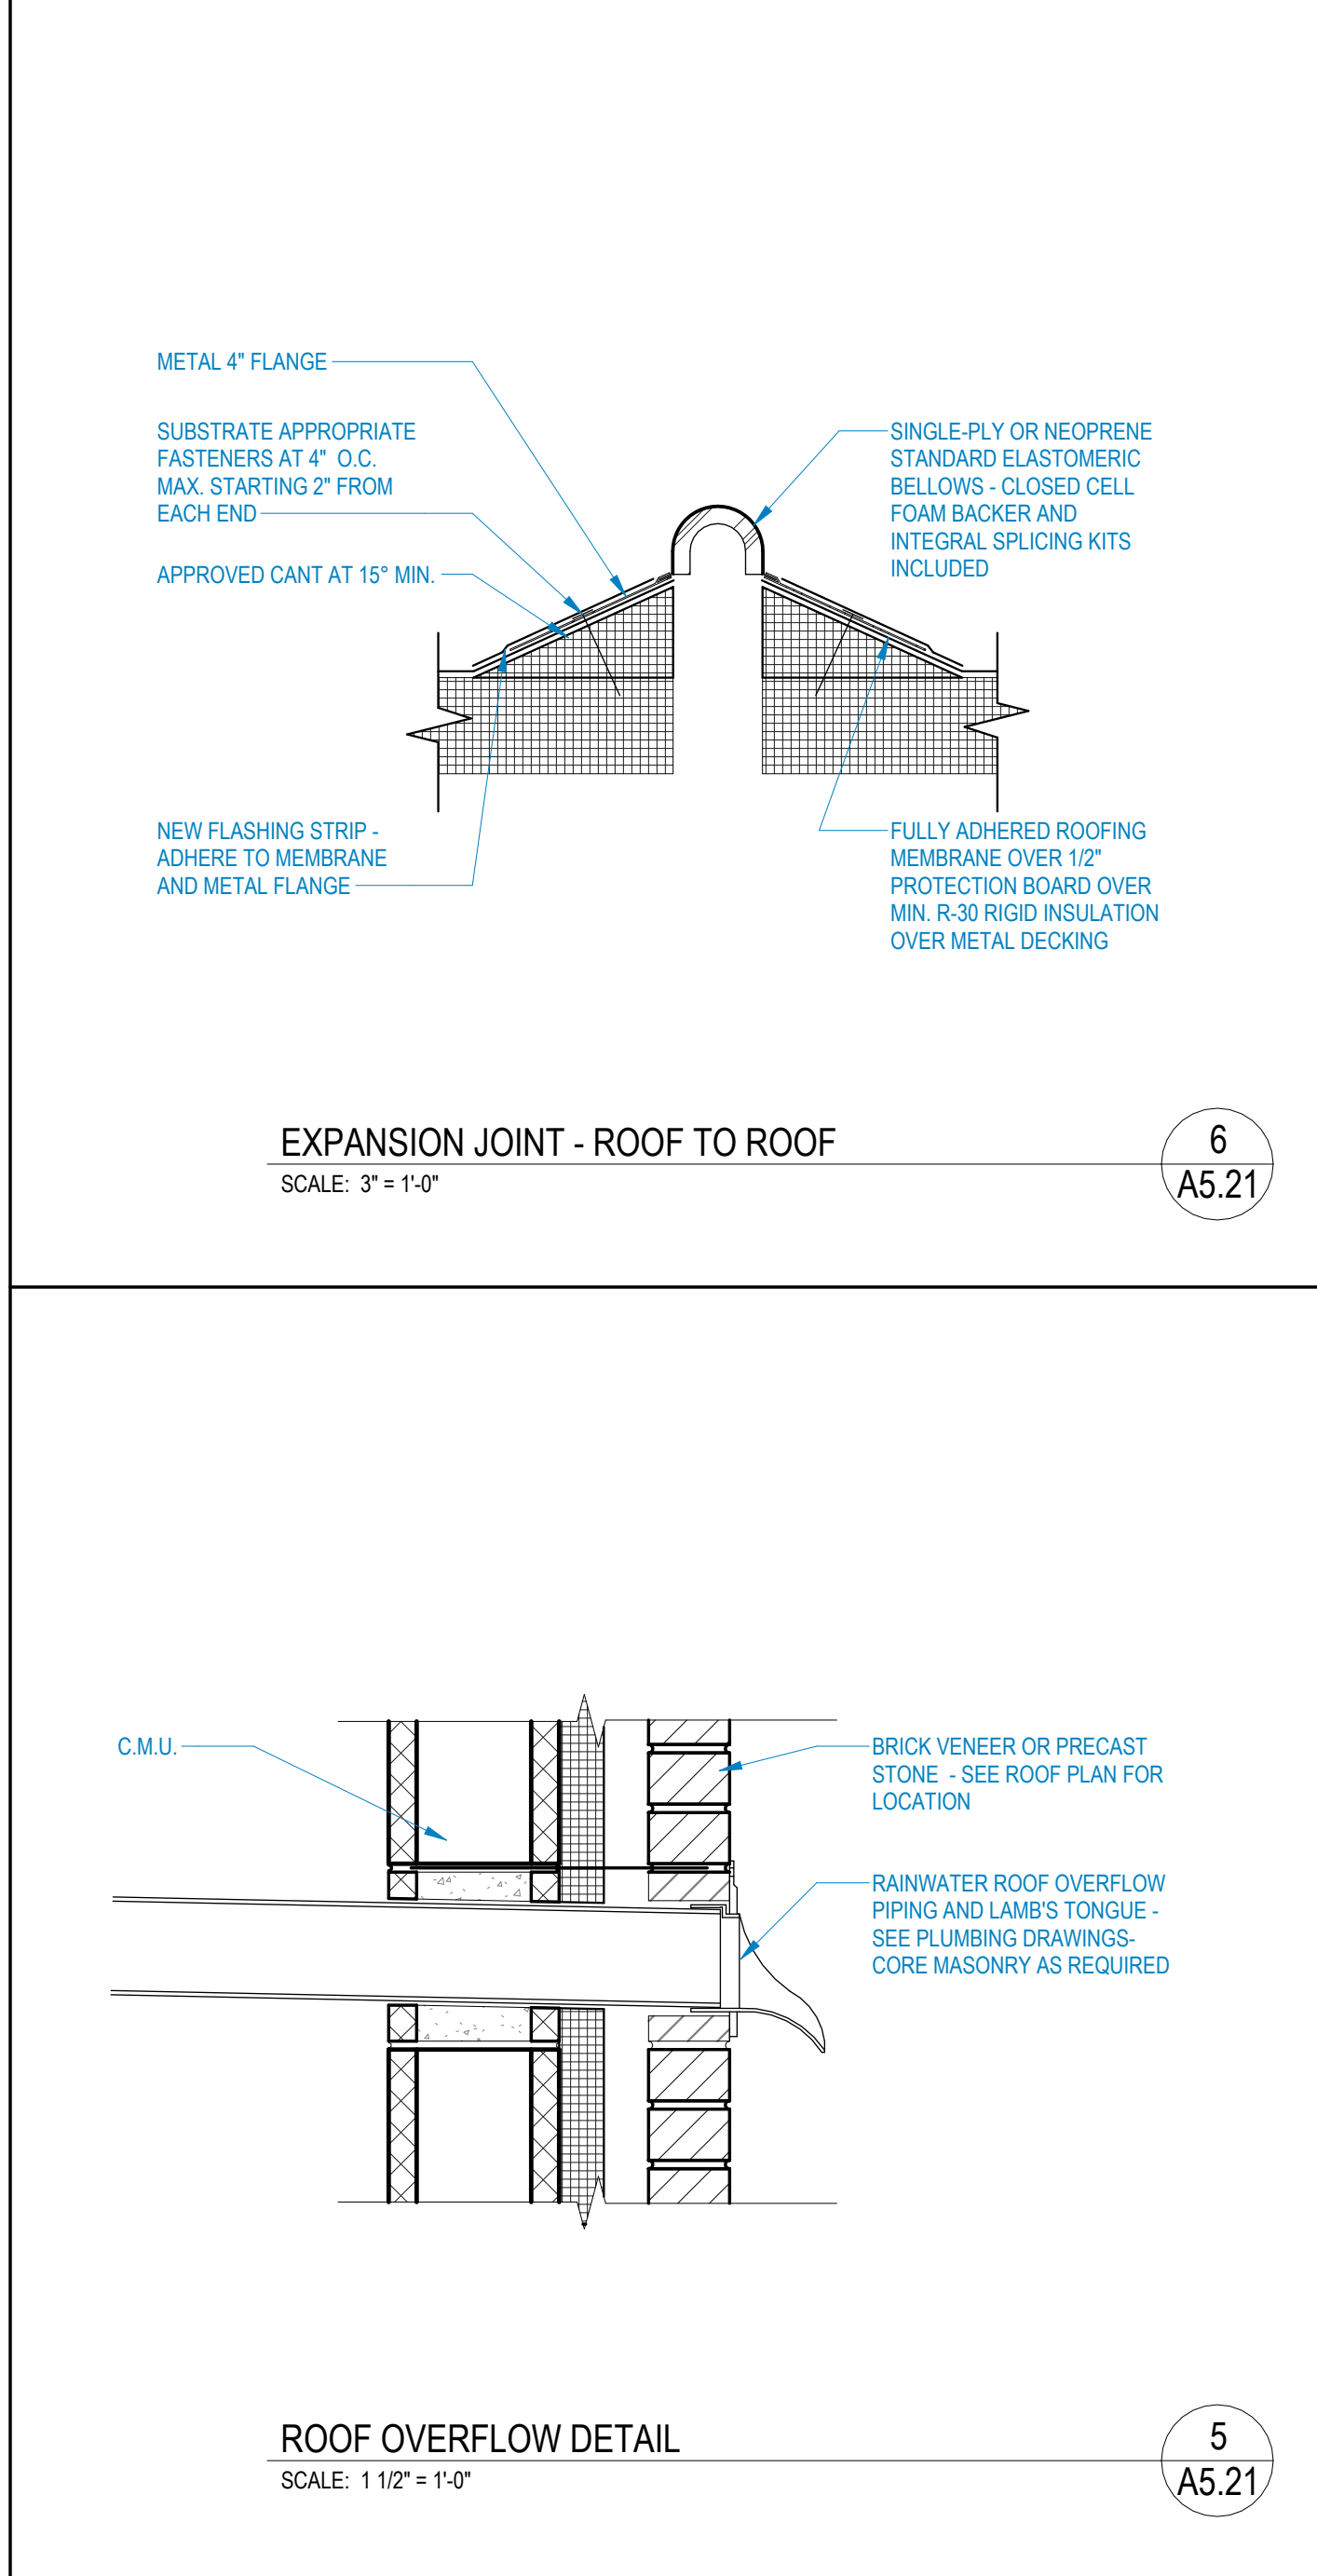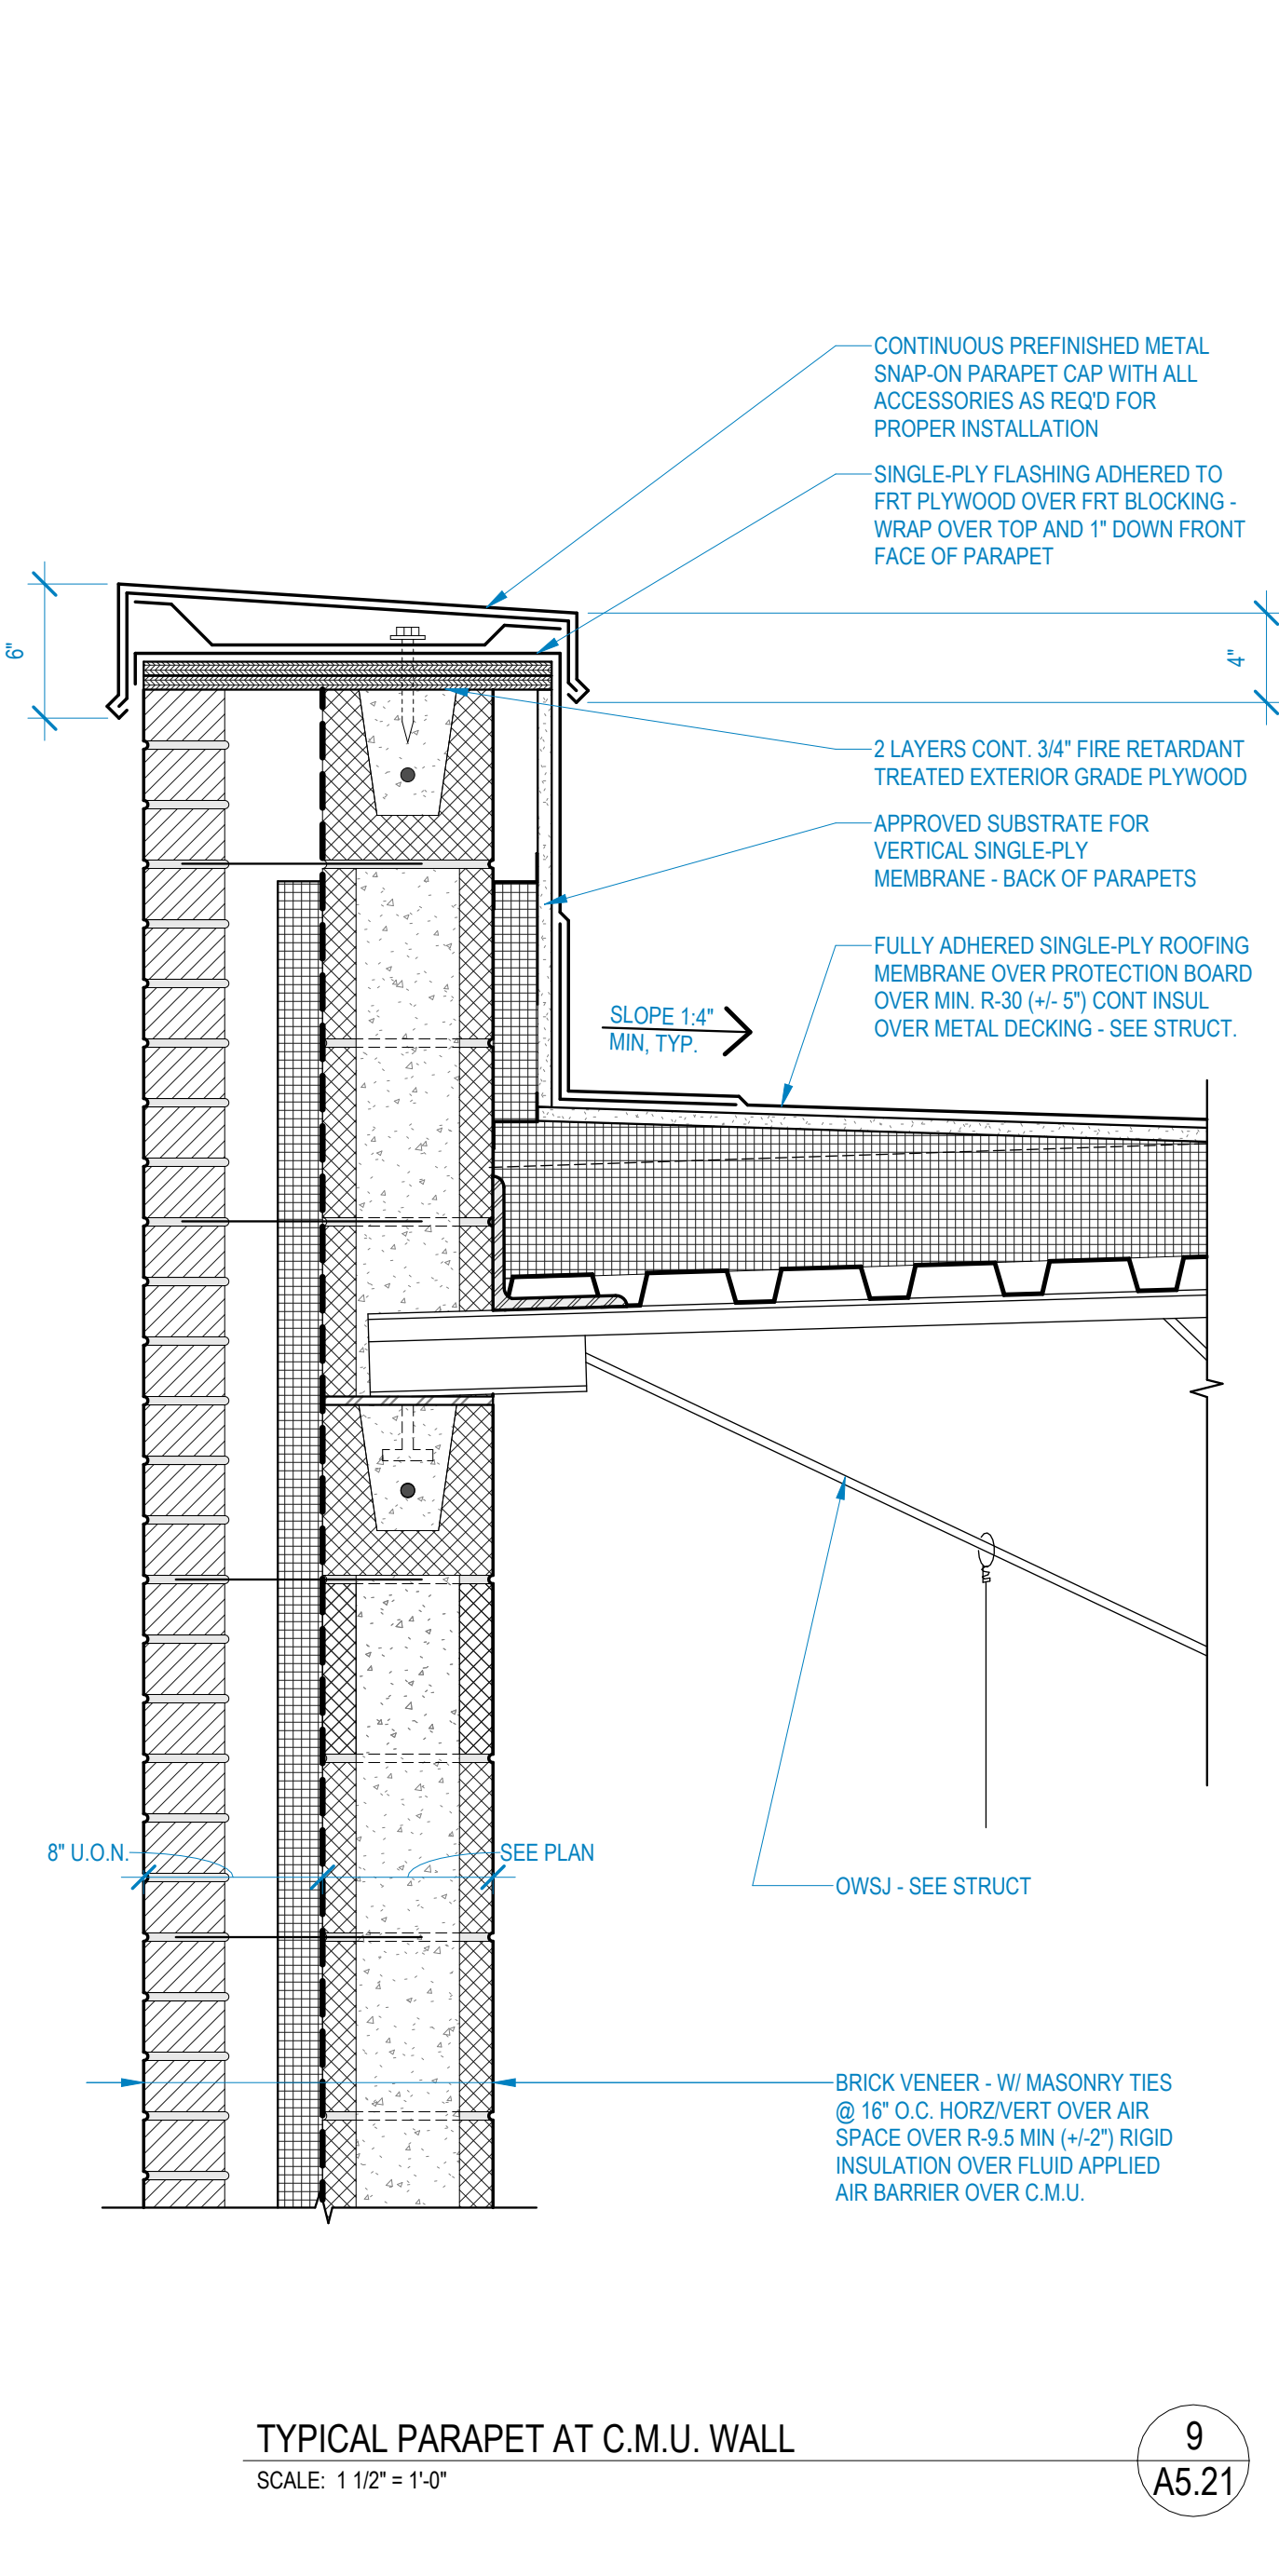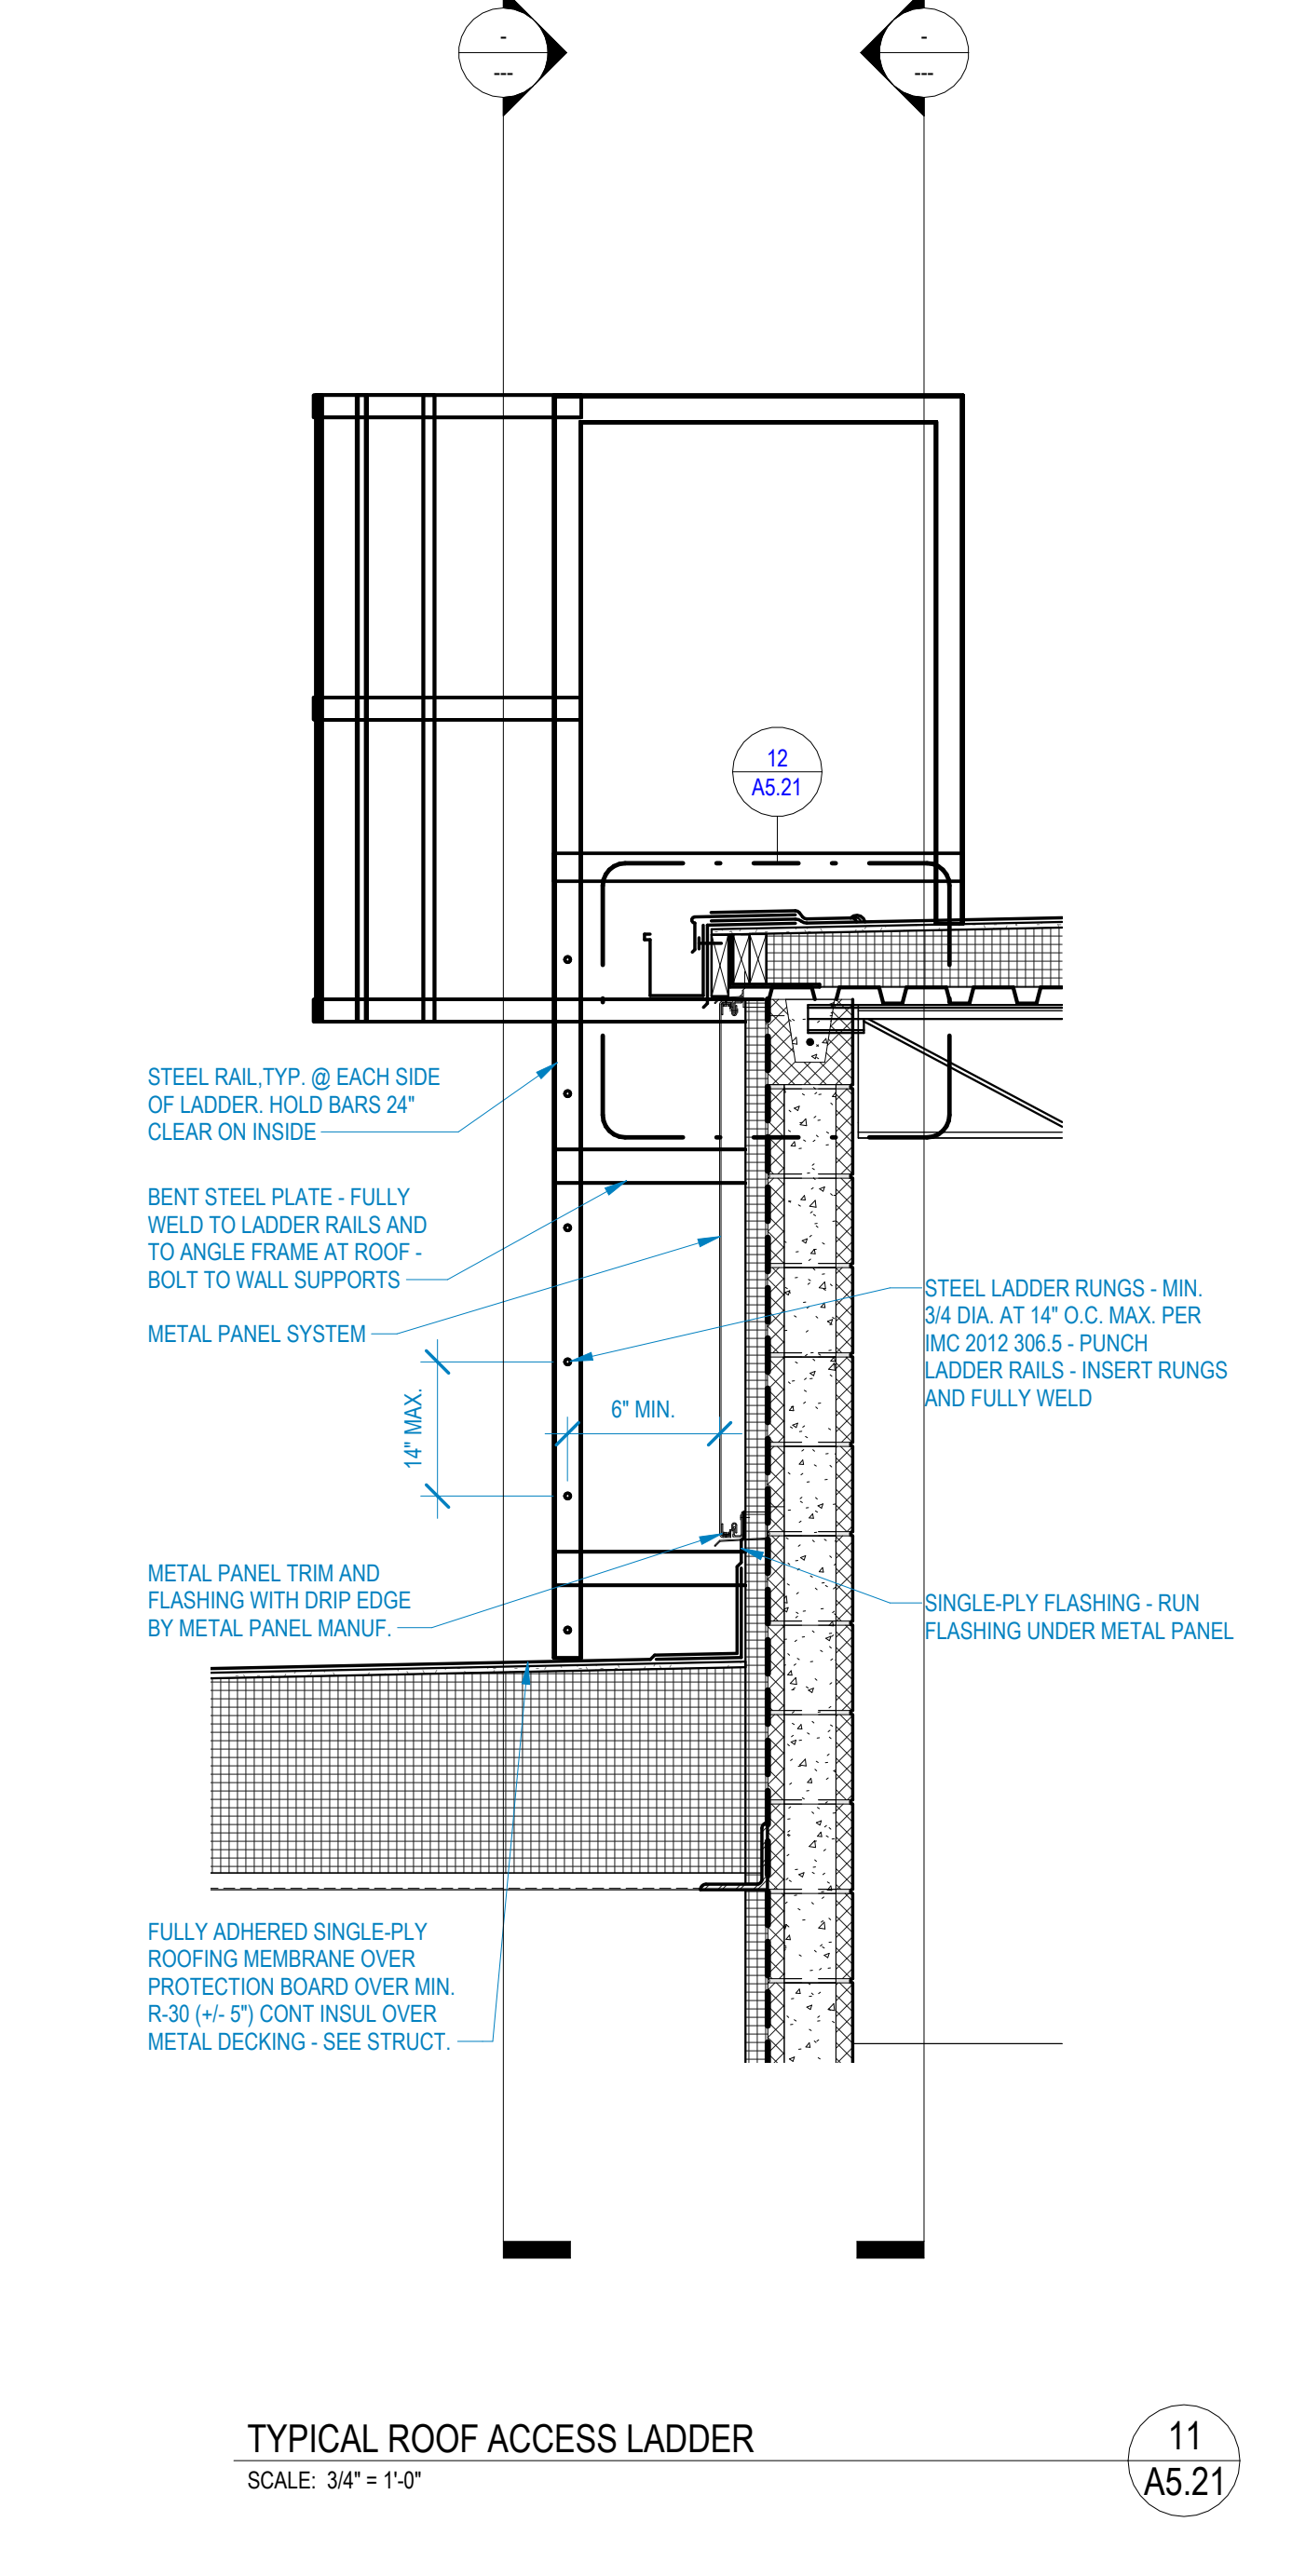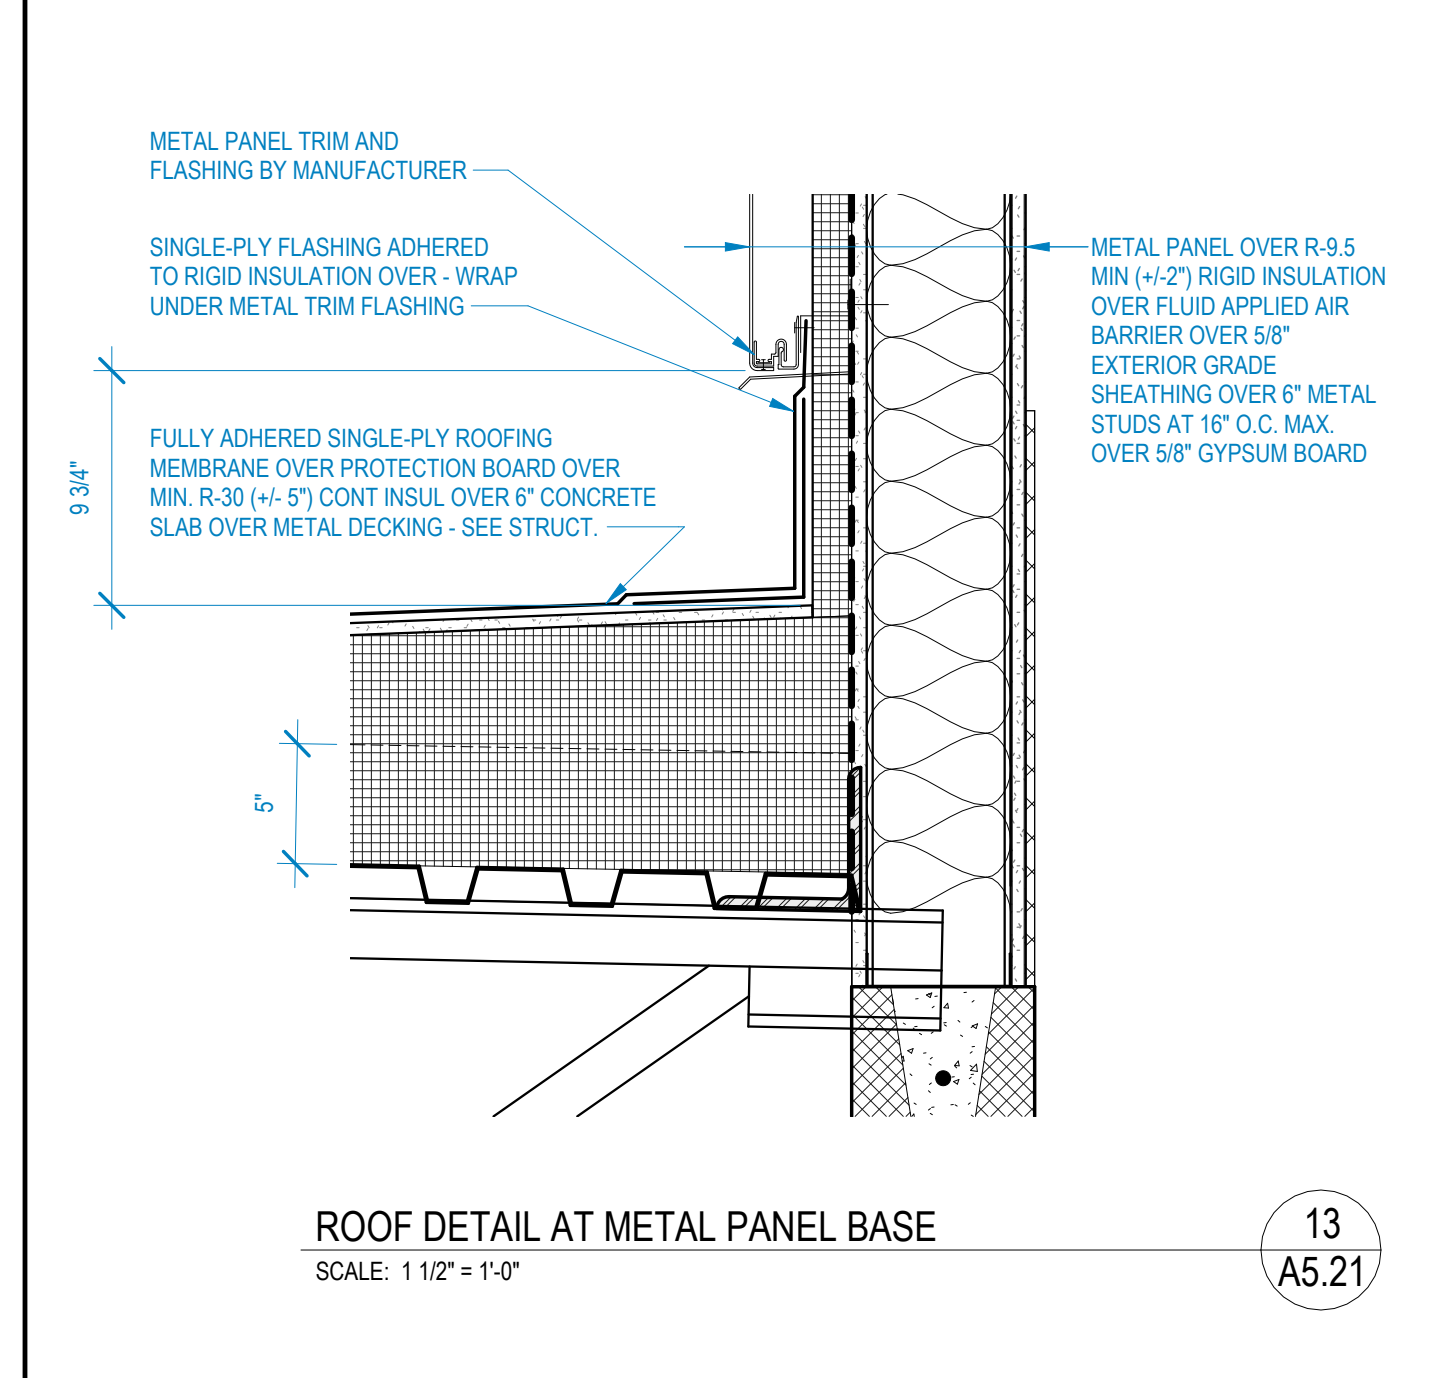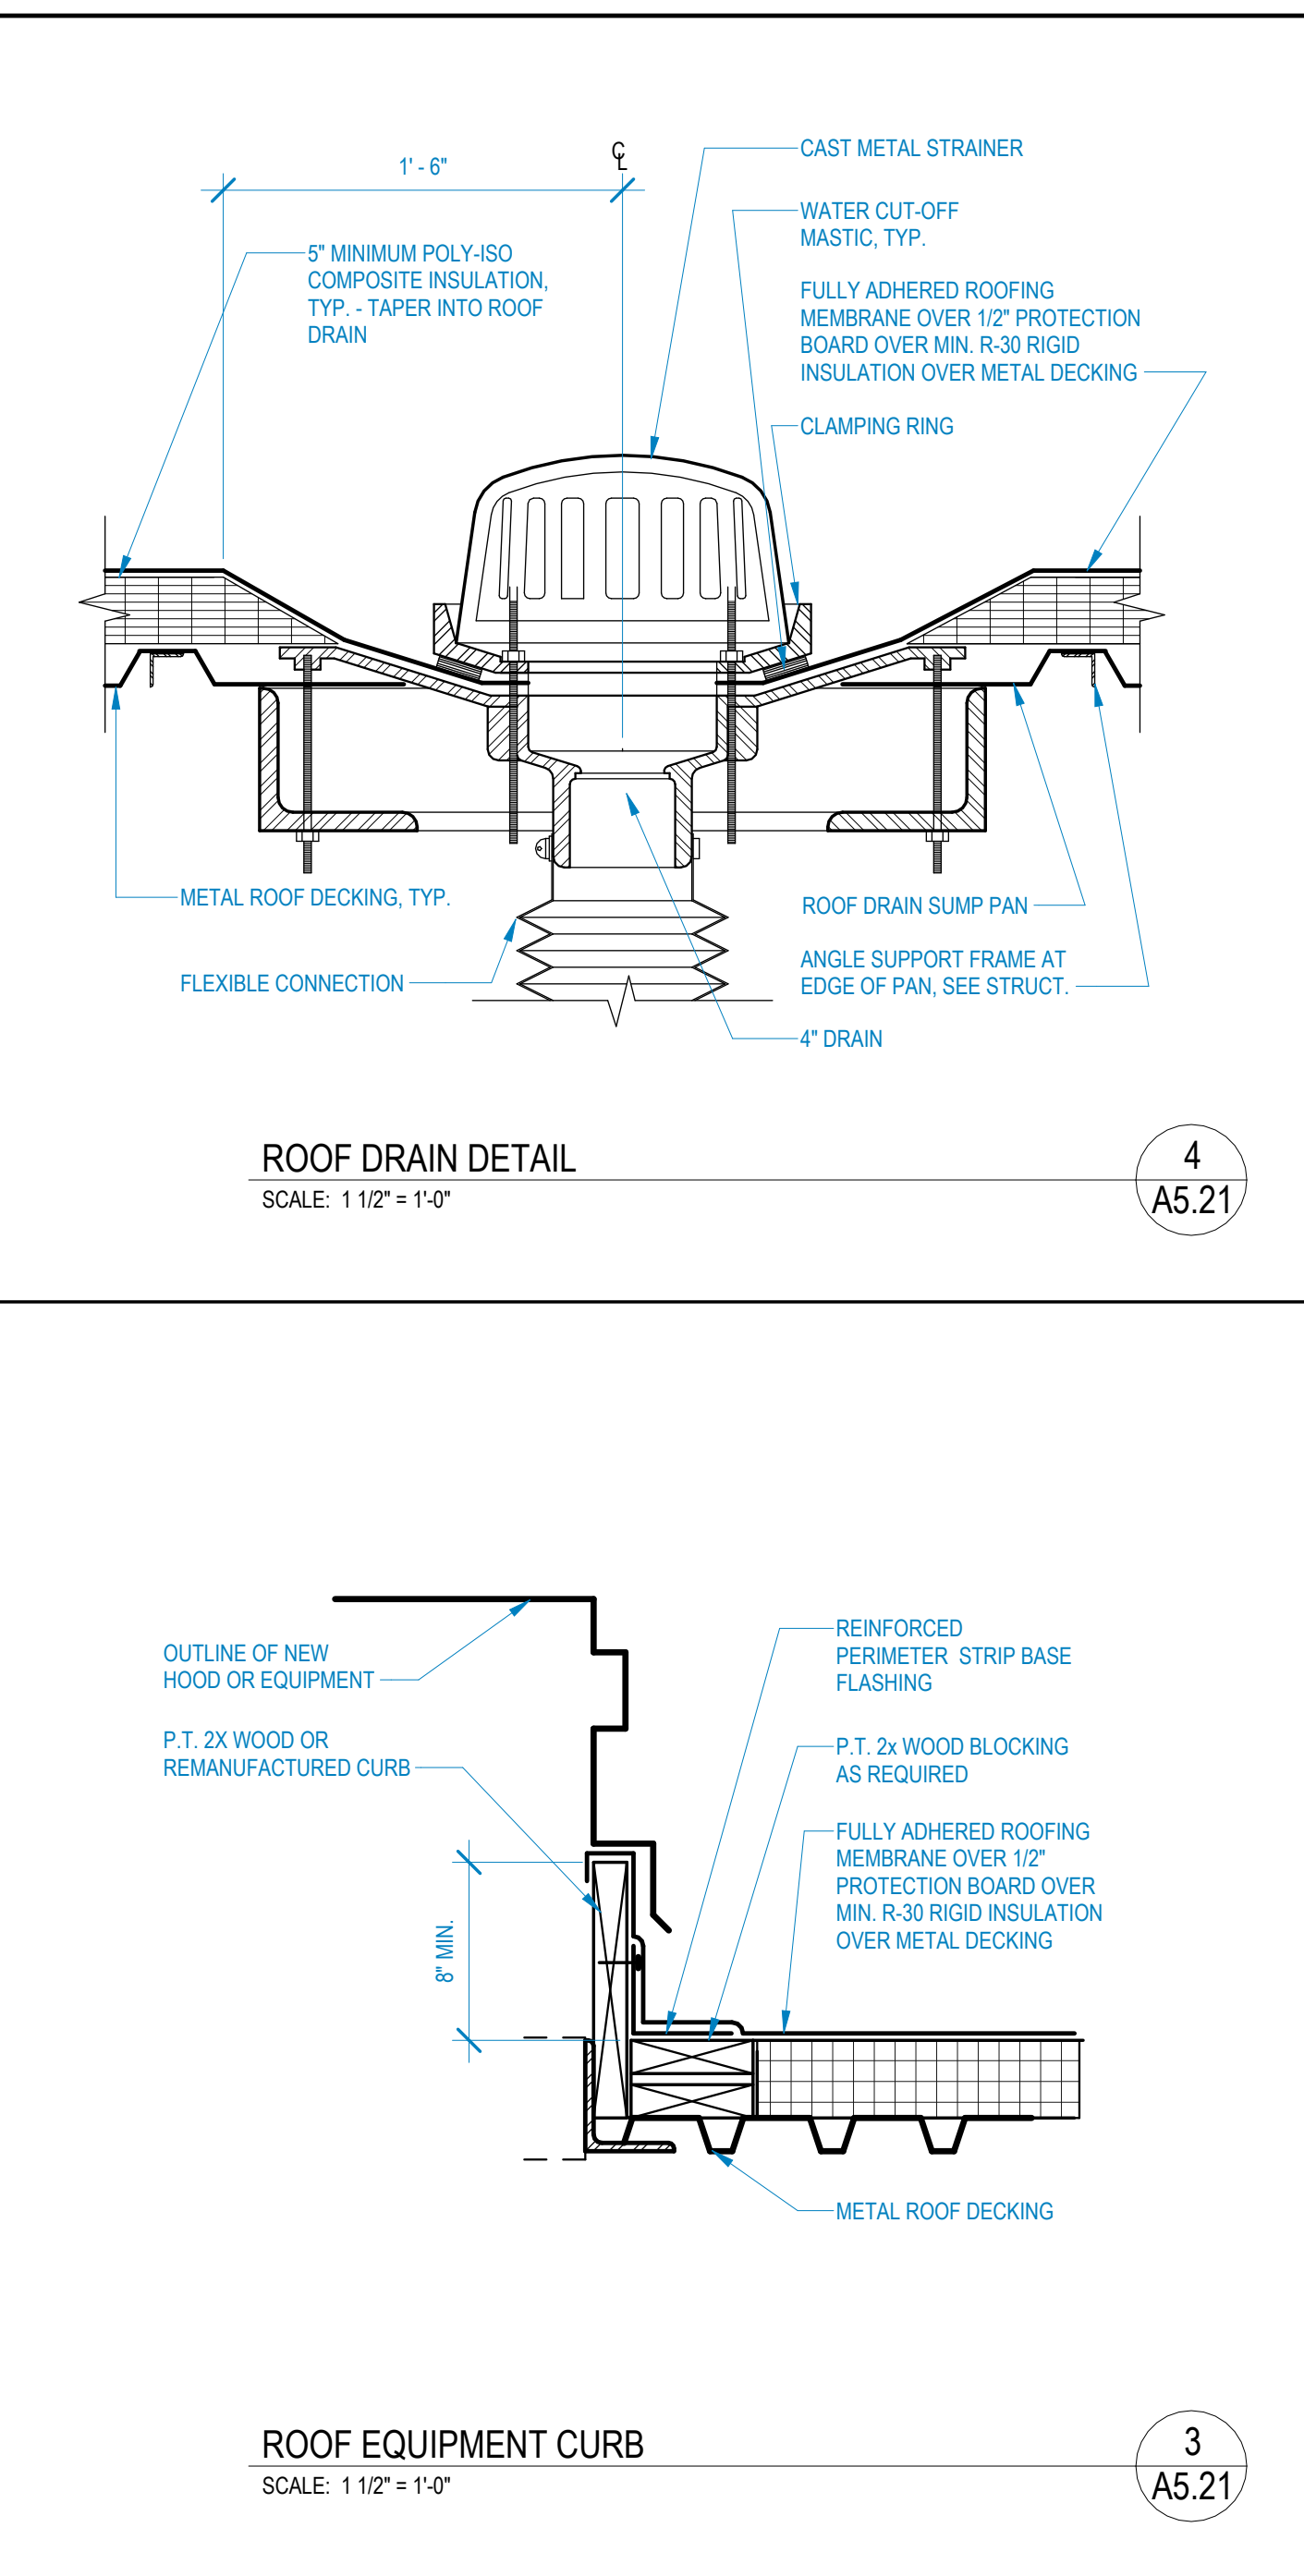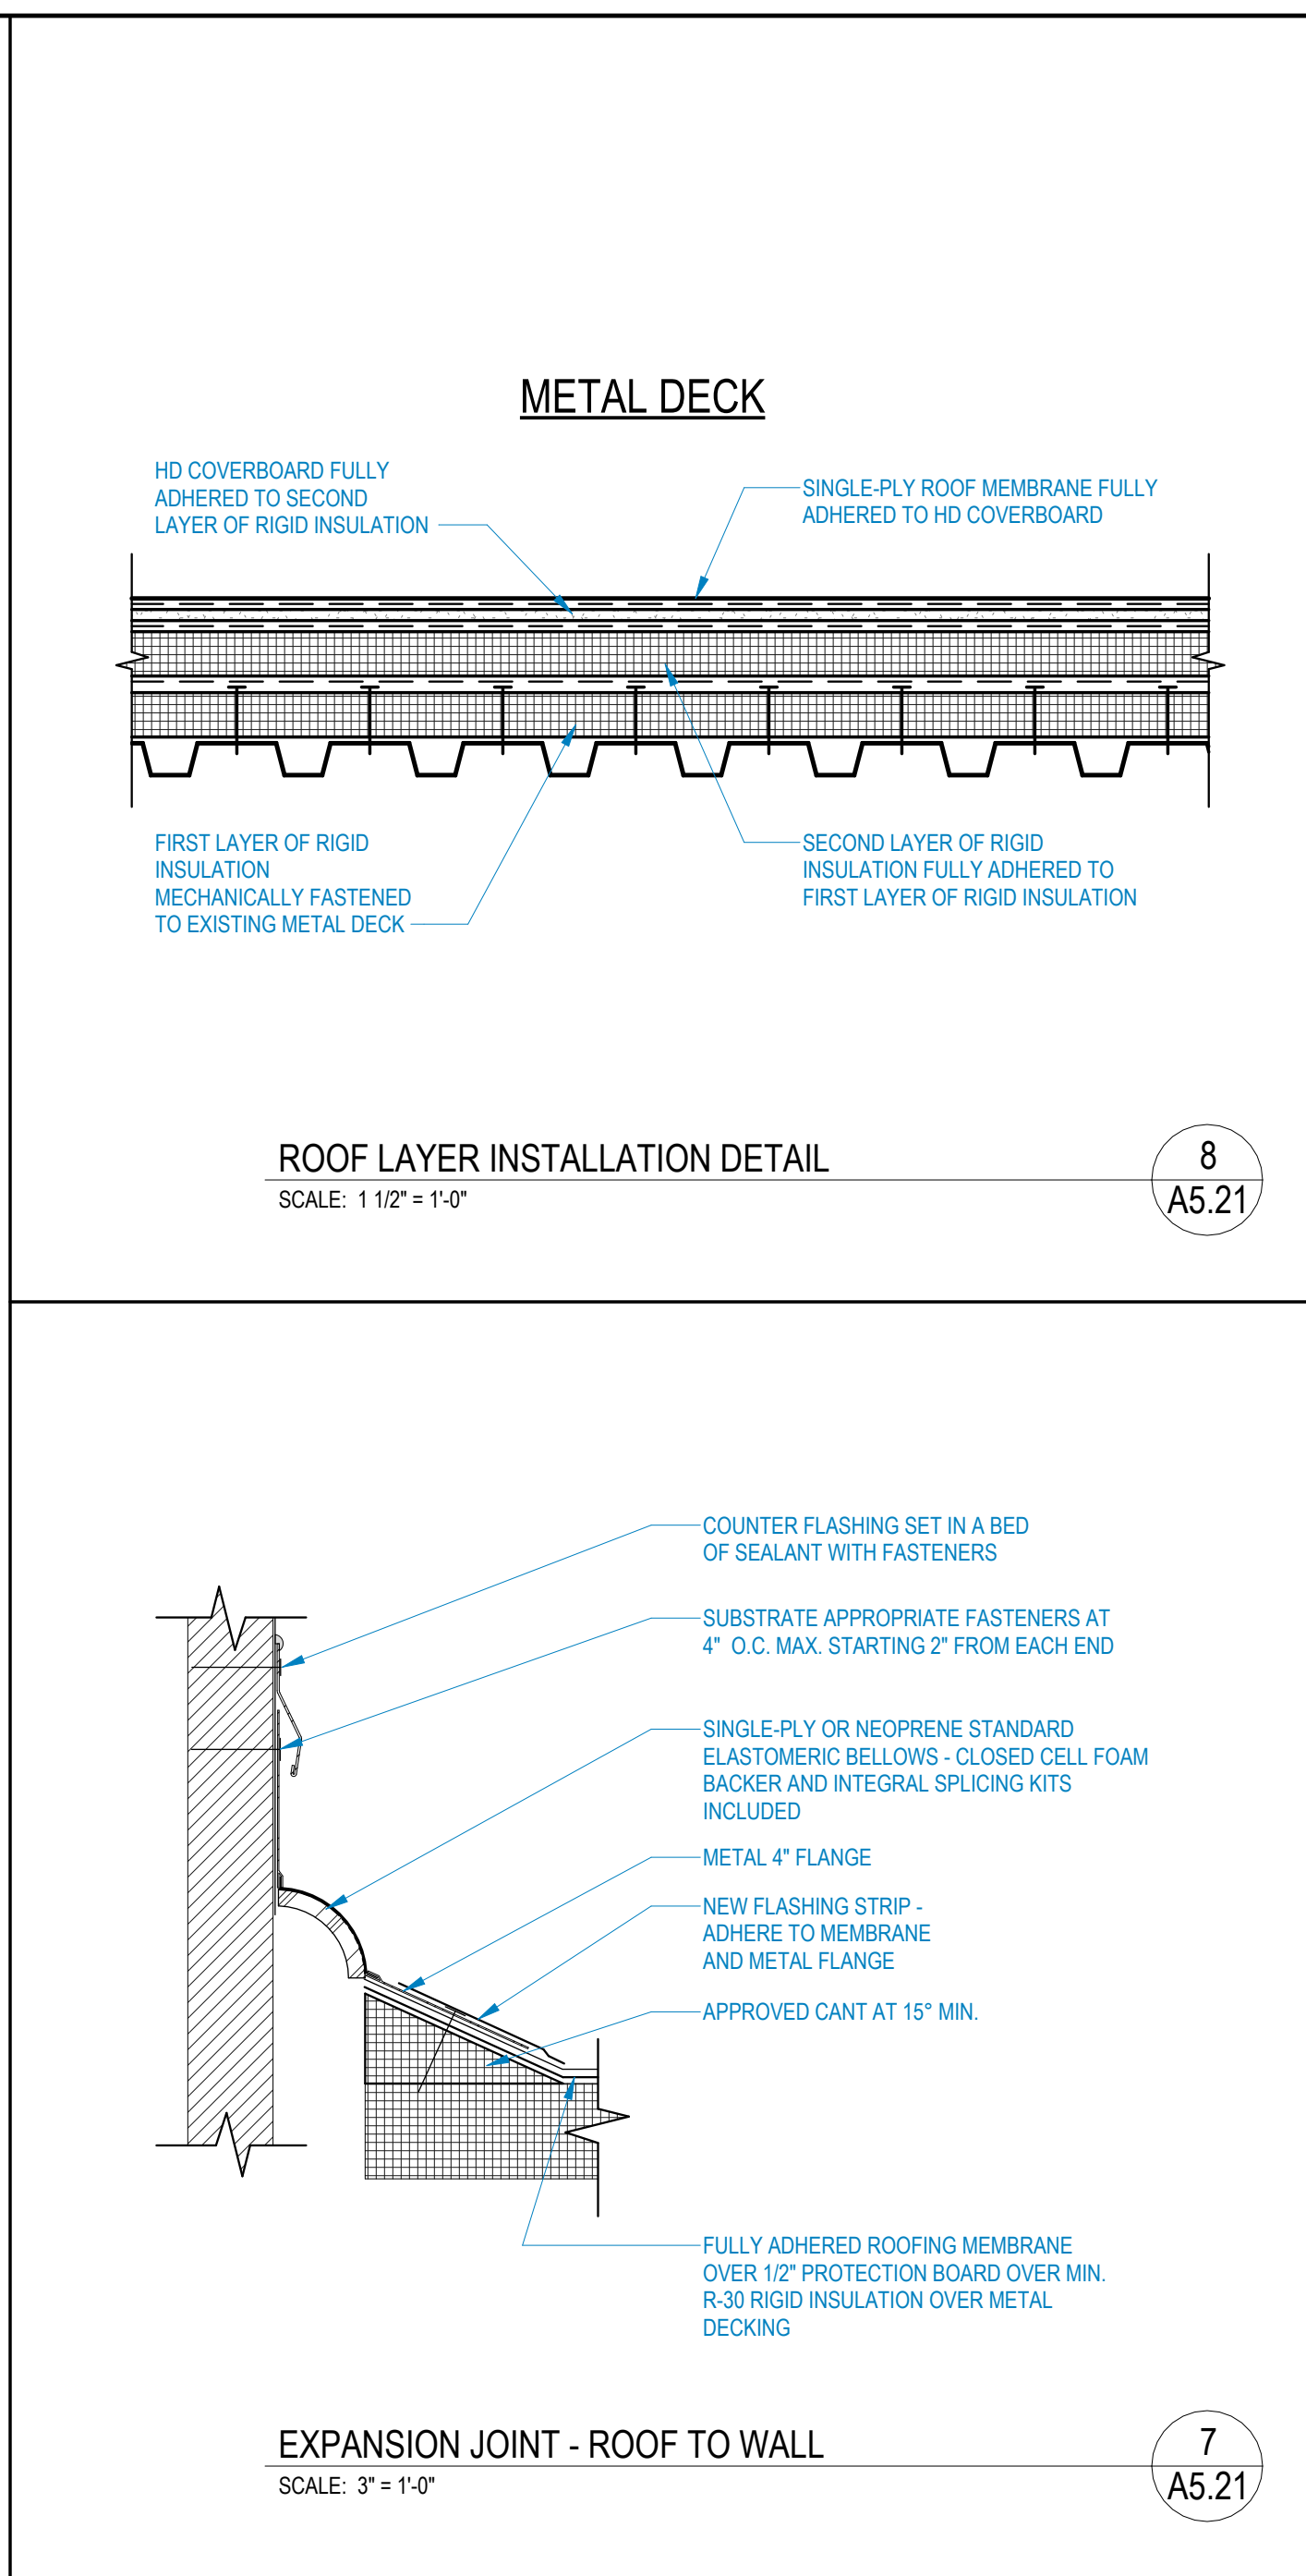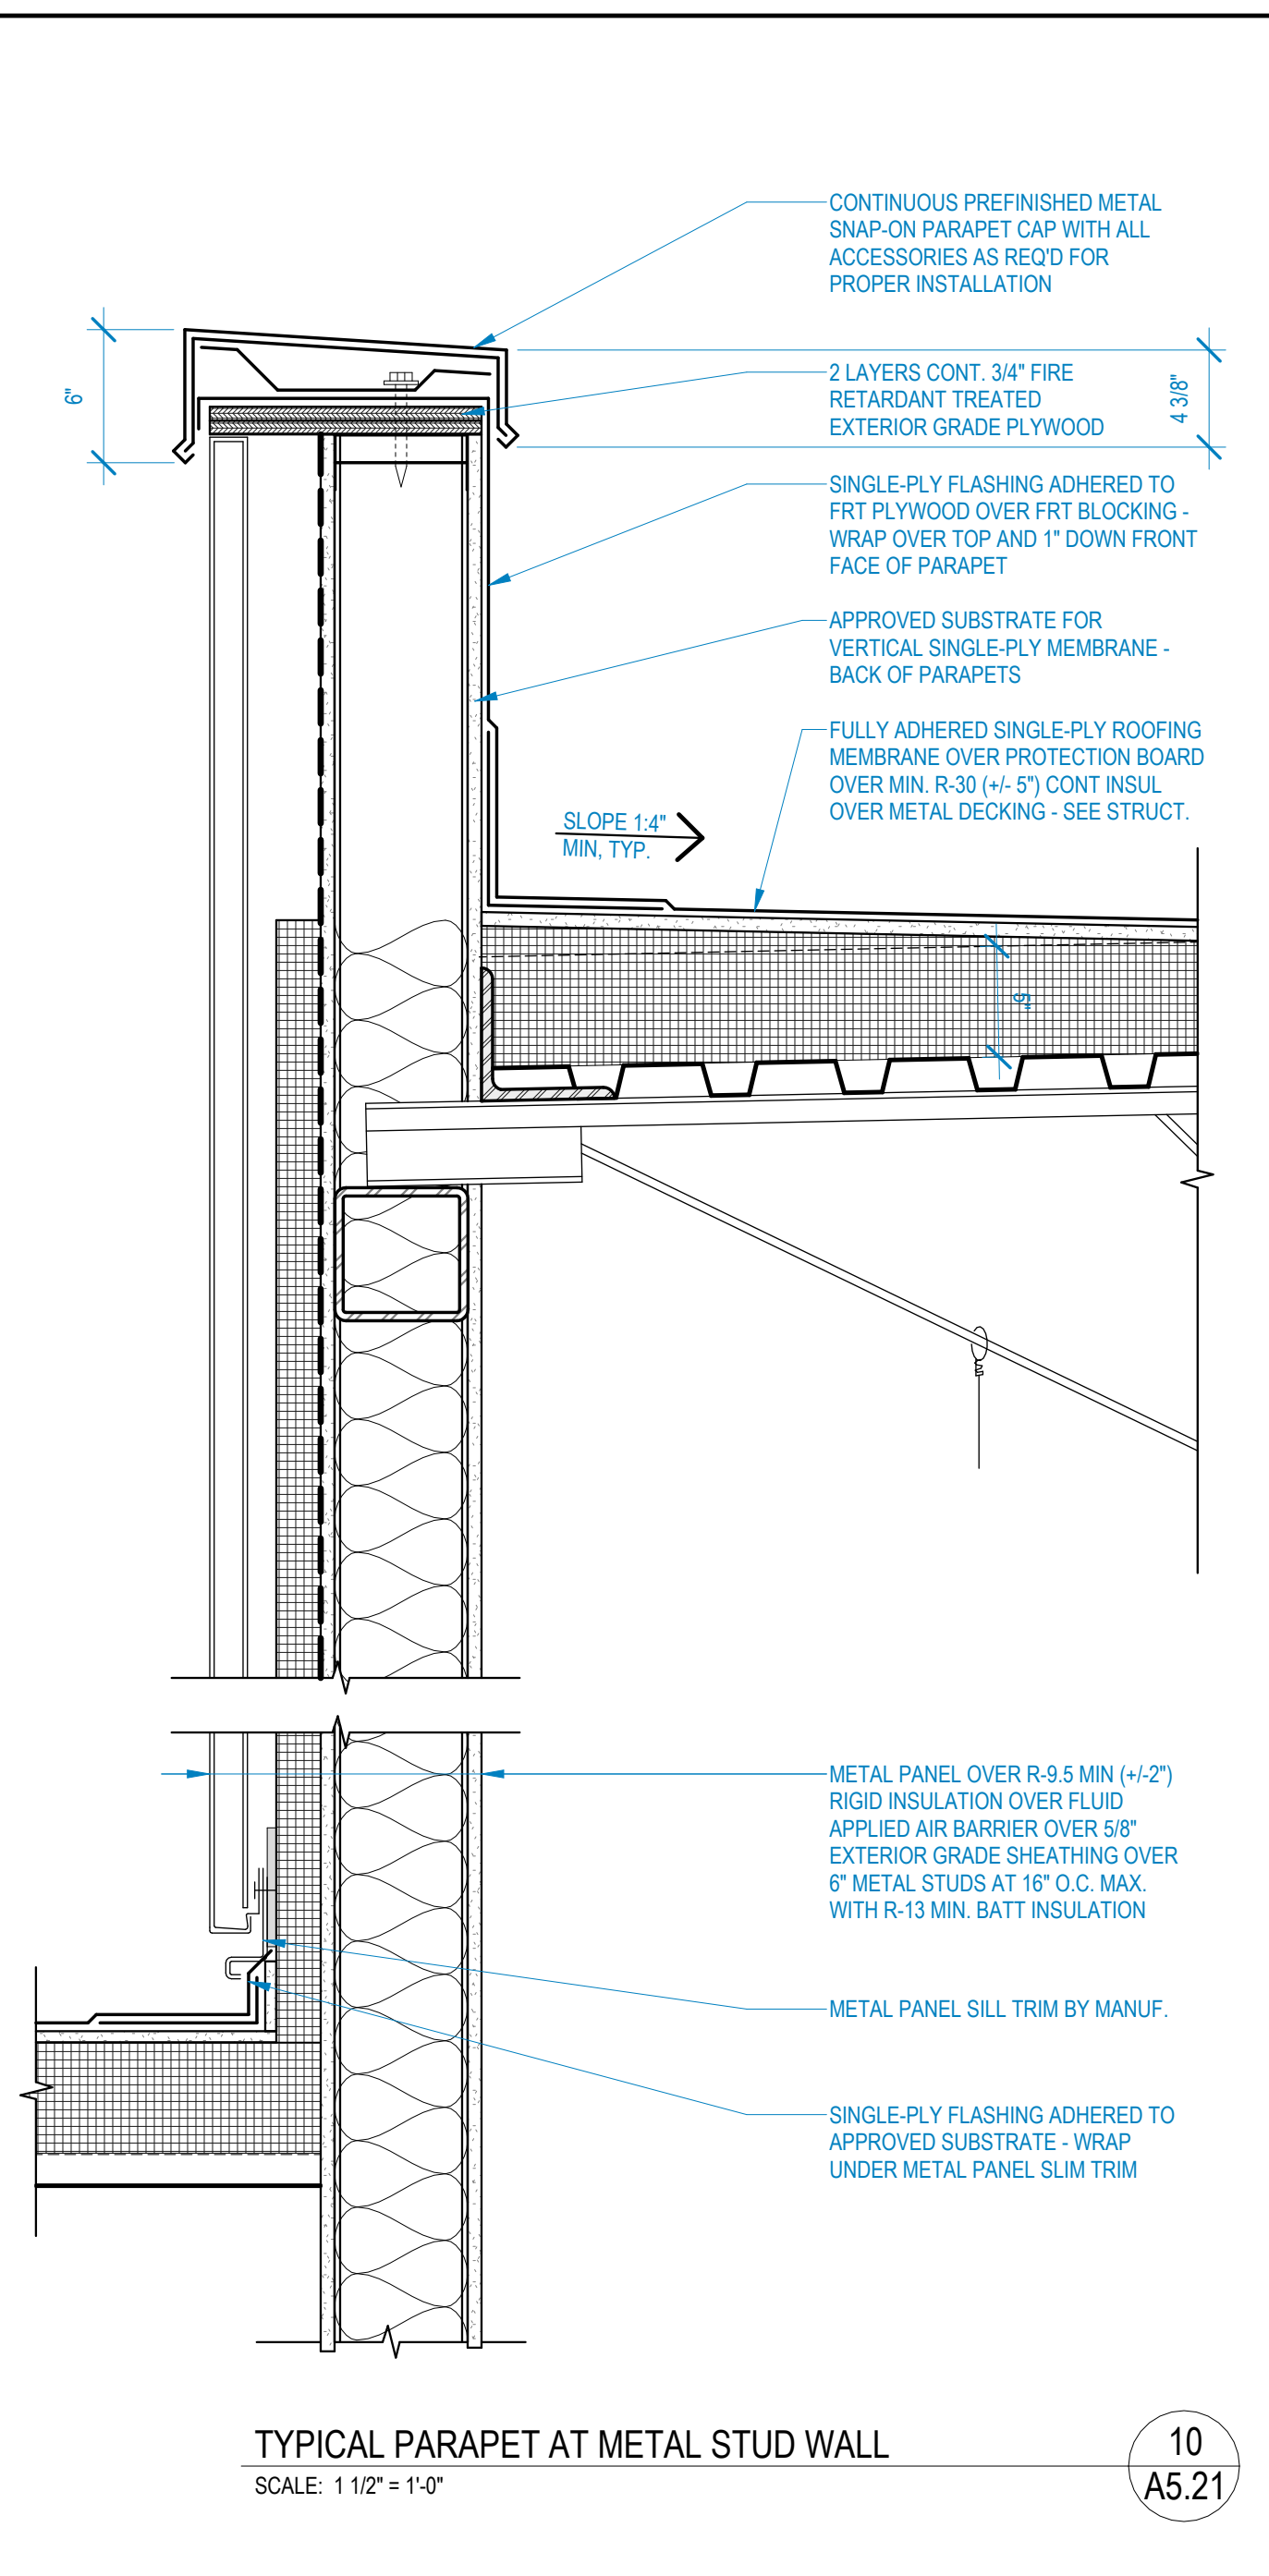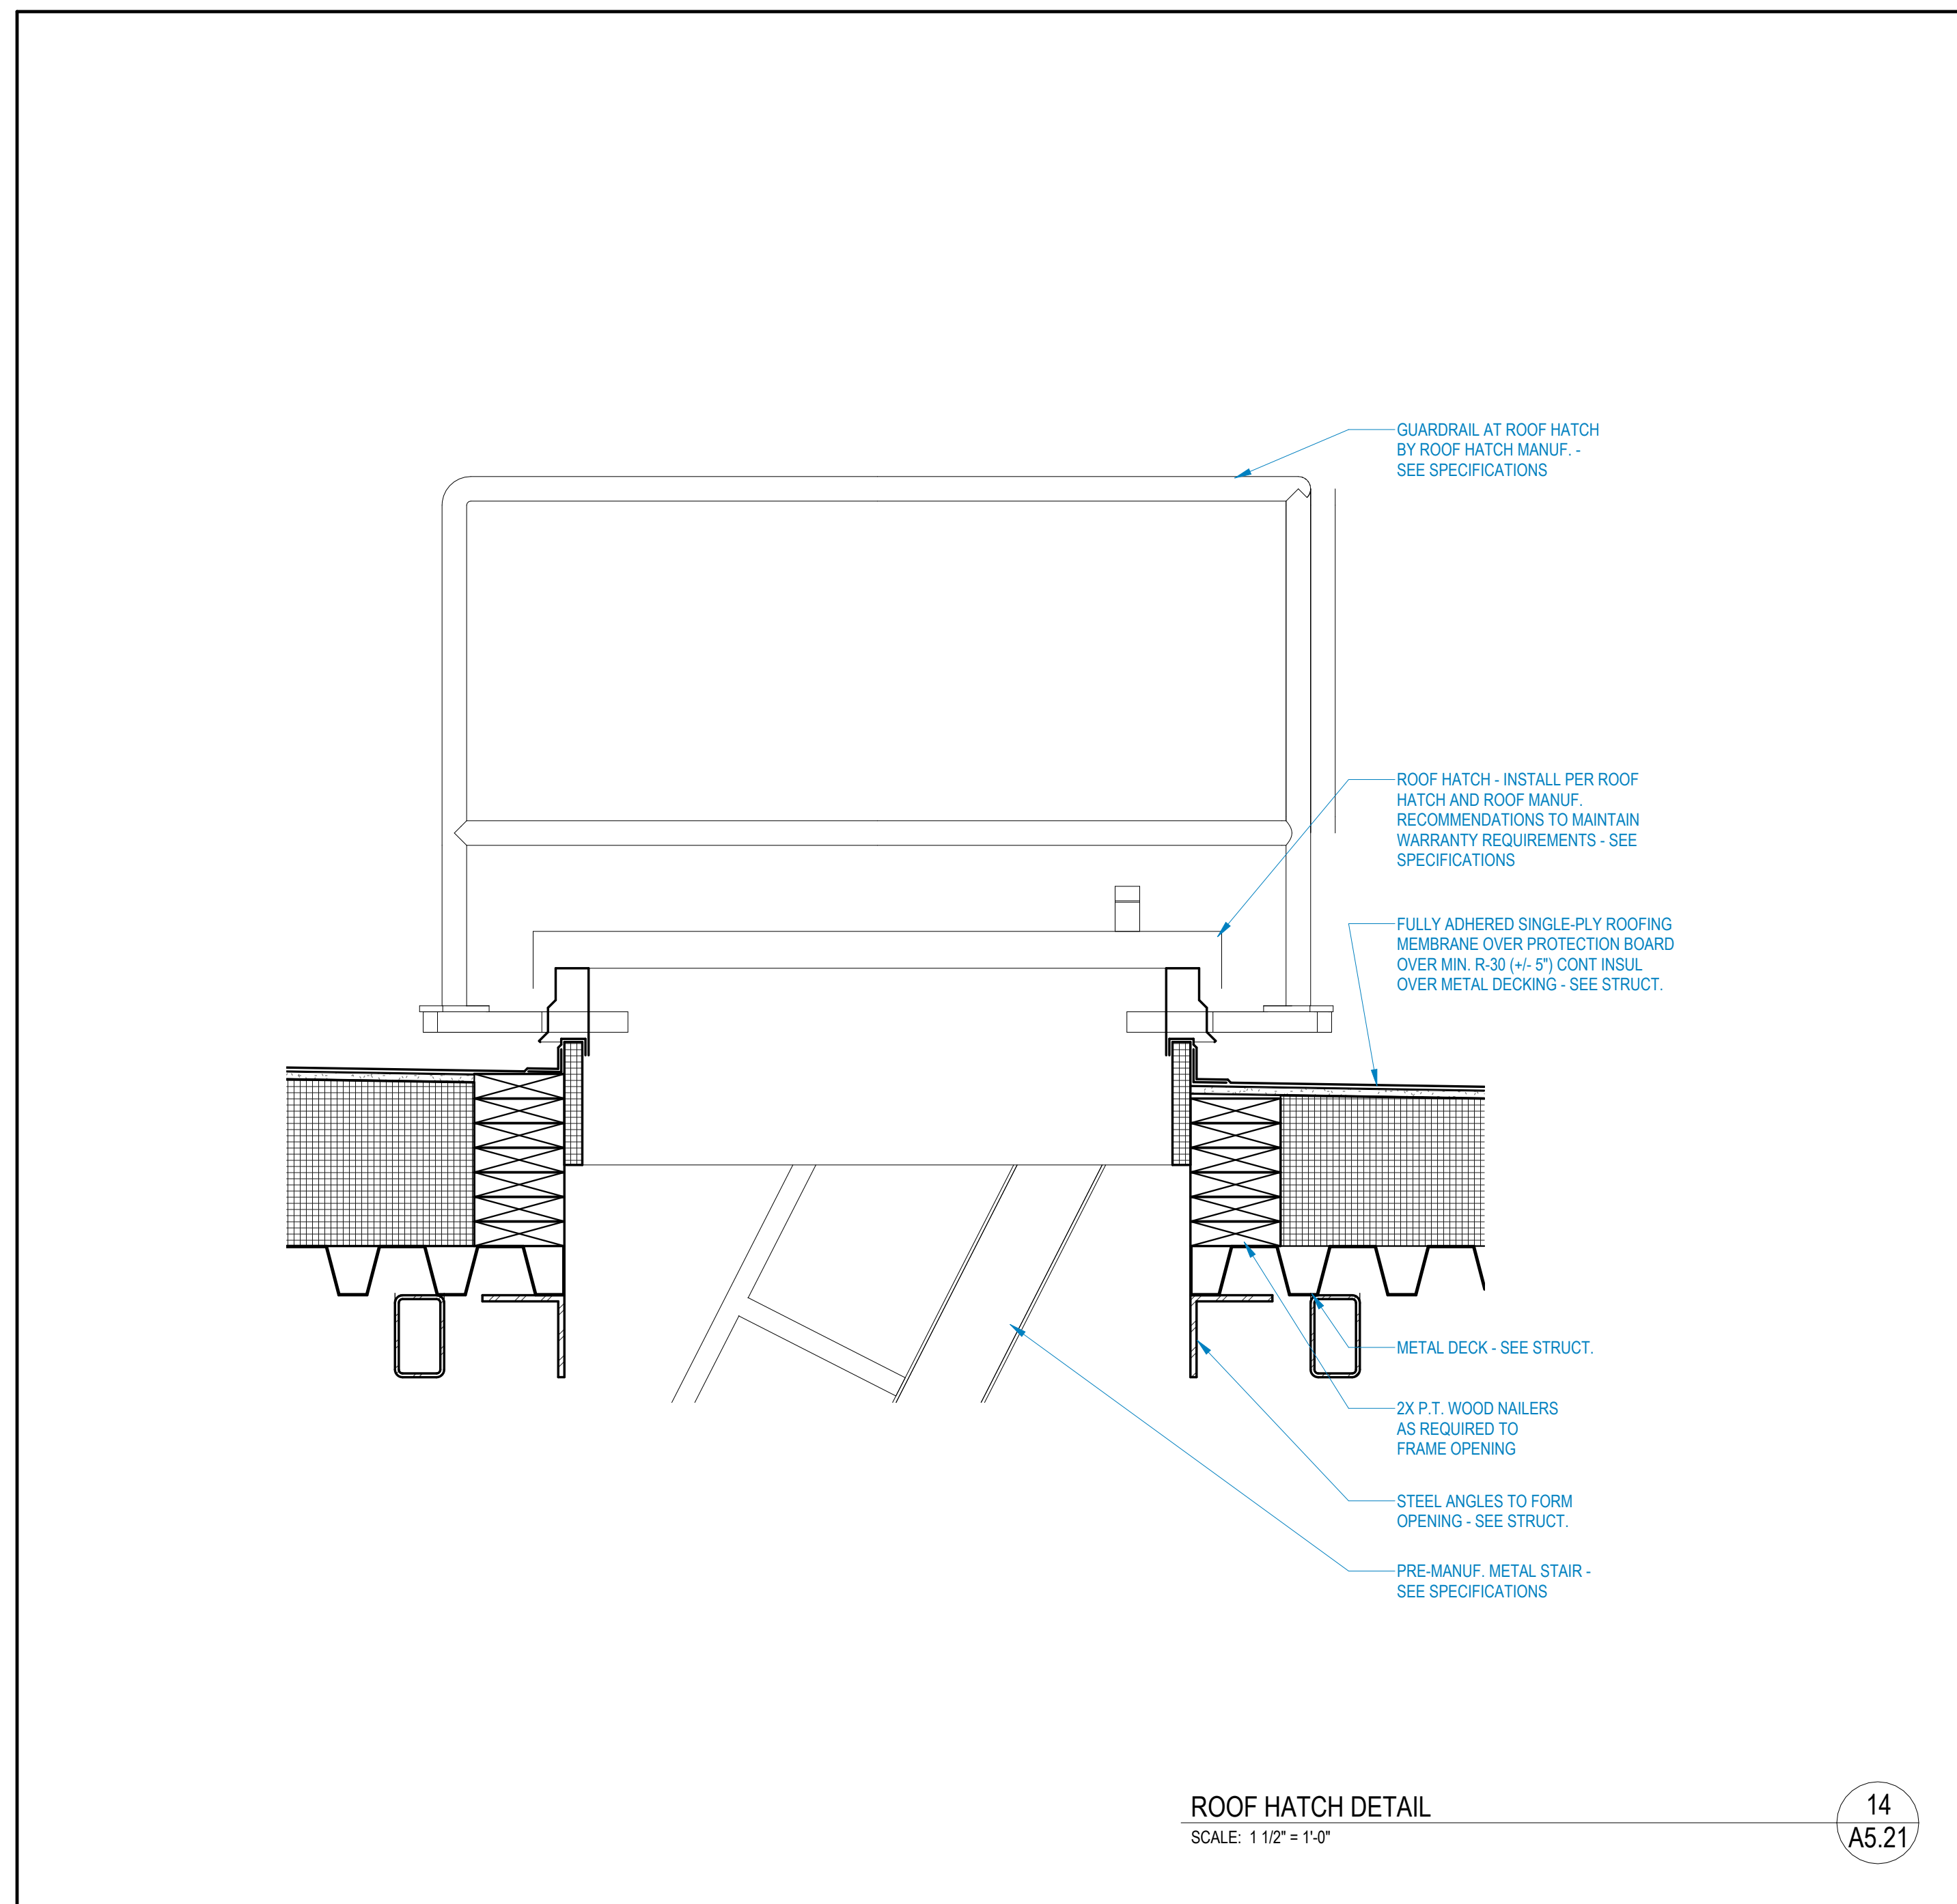

A NEW SCHOOL FACILITY:
HORACE MAYNARD MIDDLE SCHOOL
UNION COUNTY PUBLIC SCHOOLS
MAYNARDVILLE, TN

DATE: 03/15/2024
PROJECT NO: 21074
SBC NO:

PROJECT REVISIONS		
#	DATE	DESCRIPTION
5	06/14/2024	ADD 003

THIS DRAWING IS THE PROPERTY OF THE LEWIS GROUP ARCHITECTS, INC. AND IS TO BE USED ONLY FOR THE PROJECT AND SITE SPECIFICALLY IDENTIFIED HEREIN. THIS DRAWING IS NOT TO BE USED ON ANY OTHER PROJECT WITHOUT THE PROJECT FOR WHICH IT IS MADE OR EXECUTED OR NOT. THIS DRAWING AND ITS CONTENTS ARE THE SOLE POSSESSION OF THE LEWIS GROUP ARCHITECTS, INC. AND SHALL NOT BE REPRODUCED OR TRANSMITTED IN ANY MANNER WITHOUT THEIR FULL CONSENT. IT IS TO BE RETURNED UPON REQUEST.

ROOF DETAILS

A5.21

LEWIS GROUP ARCHITECTS
1 INNOVATION, TN | 6512 DEANE HILL DR. 37919 - PH. 865.864.5000 | CLEVELAND, TN | 650 COOKE ST. 37311 - PH. 423.676.0022
info@lewisgroup.net | www.lewisgroup.net



A NEW SCHOOL FACILITY:
HORACE MAYNARD MIDDLE SCHOOL
 UNION COUNTY PUBLIC SCHOOLS
 MAYNARDVILLE, TN

DATE: 03/15/2024
 PROJECT NO: 21074
 SBC NO:


PROJECT REVISIONS

#	DATE	DESCRIPTION
5	06/14/2024	ADD 003


THIS DRAWING IS THE PROPERTY OF THE LEWIS GROUP ARCHITECTS, INC. AND IS TO BE USED ONLY FOR THE PROJECT AND SITE SPECIFICALLY IDENTIFIED HEREIN. THIS DRAWING IS NOT TO BE REPRODUCED OR COPIED IN ANY MANNER WITHOUT THE WRITTEN PERMISSION OF THE LEWIS GROUP ARCHITECTS, INC. AND SHALL NOT BE REPRODUCED OR COPIED IN ANY MANNER WITHOUT THEIR FULL CONSENT. IT IS TO BE RETURNED UPON REQUEST.

HEAD, JAMB, AND SILL DETAILS


A8.21

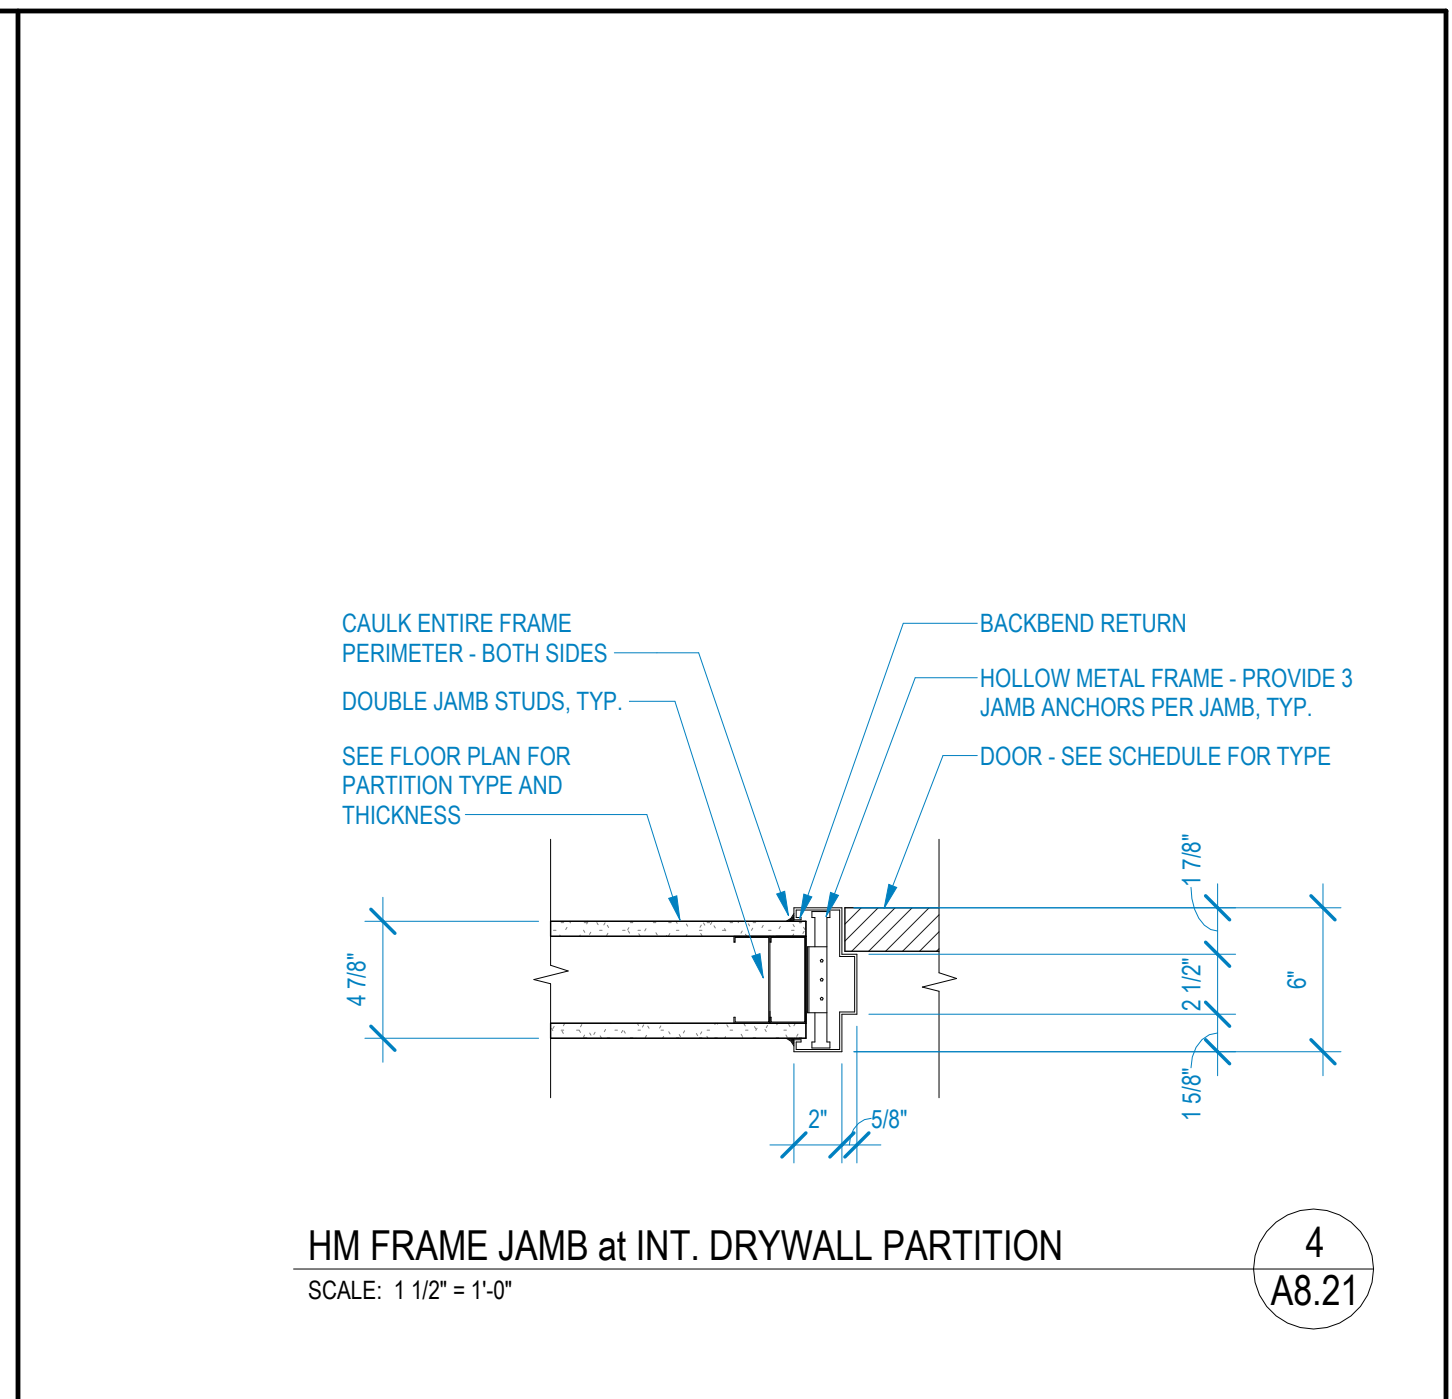


HM FRAME JAMB at INT. DRYWALL PARTITION
 SCALE: 1 1/2" = 1'-0"
 4 (A8.21)

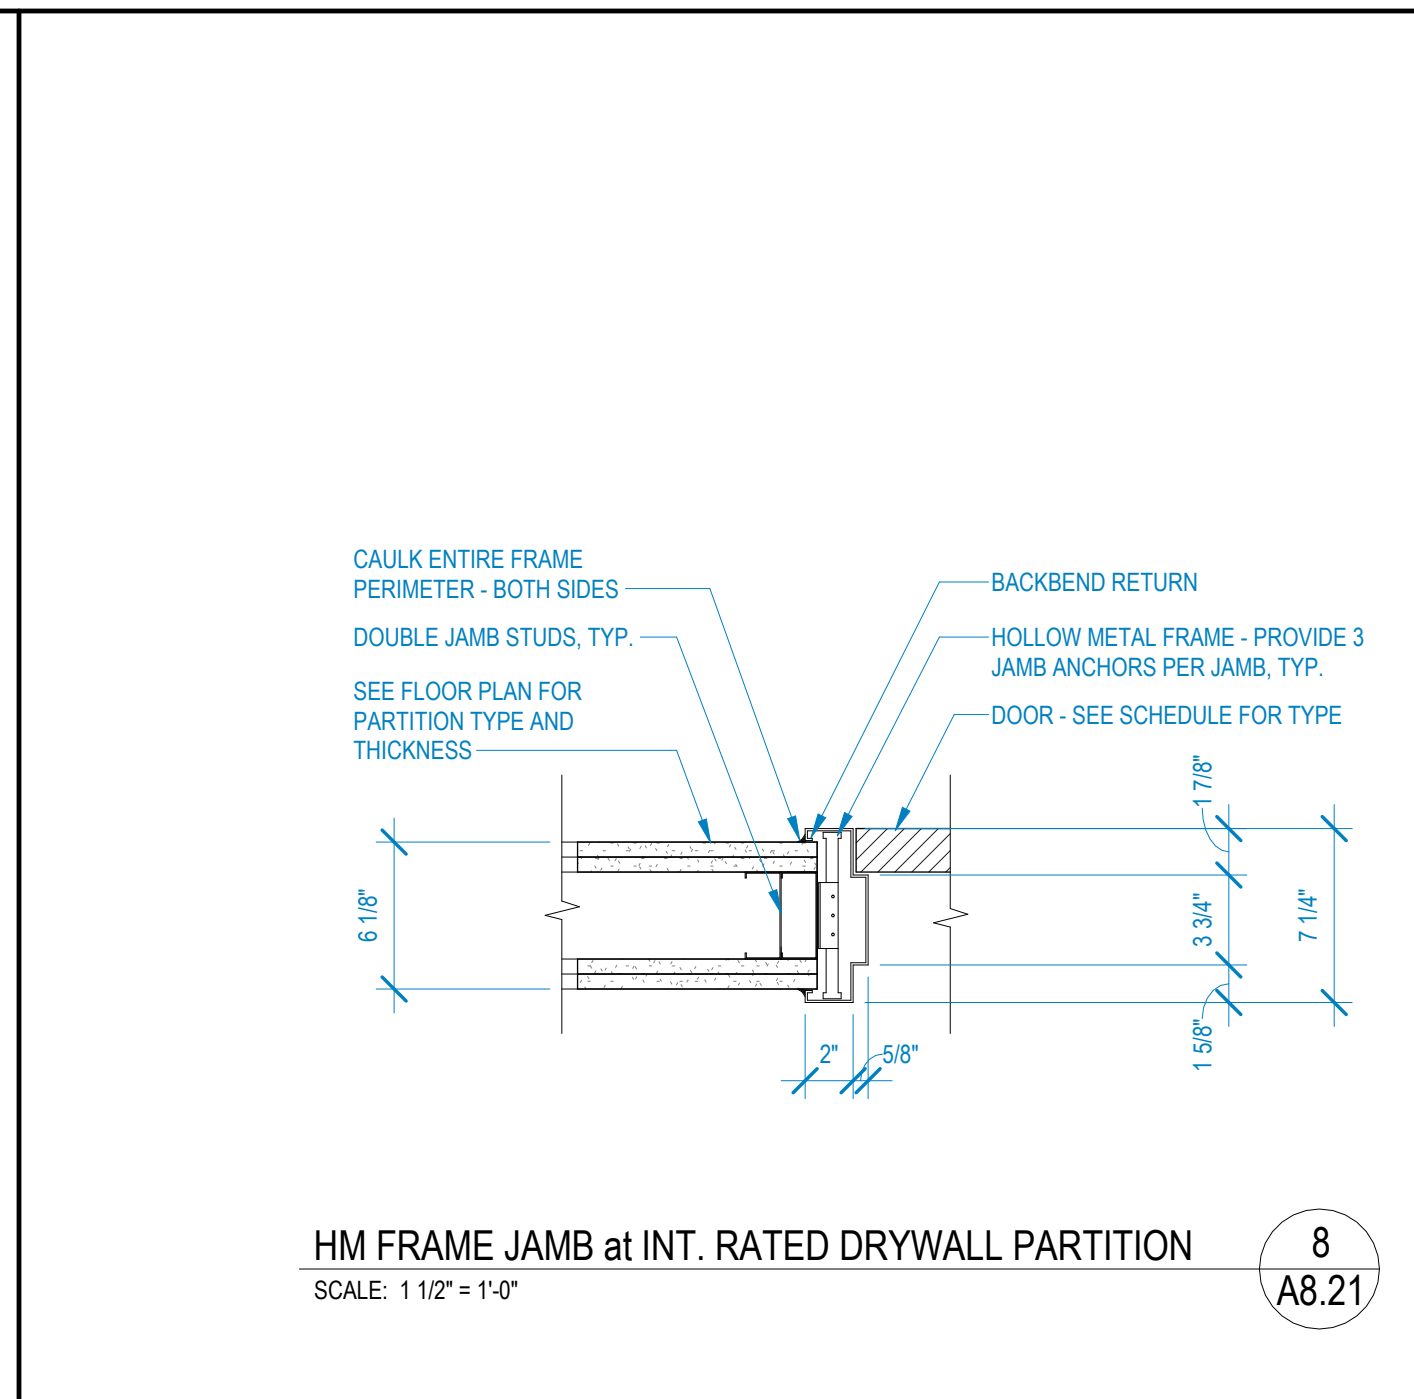


HM FRAME JAMB at INT. RATED DRYWALL PARTITION
 SCALE: 1 1/2" = 1'-0"
 8 (A8.21)

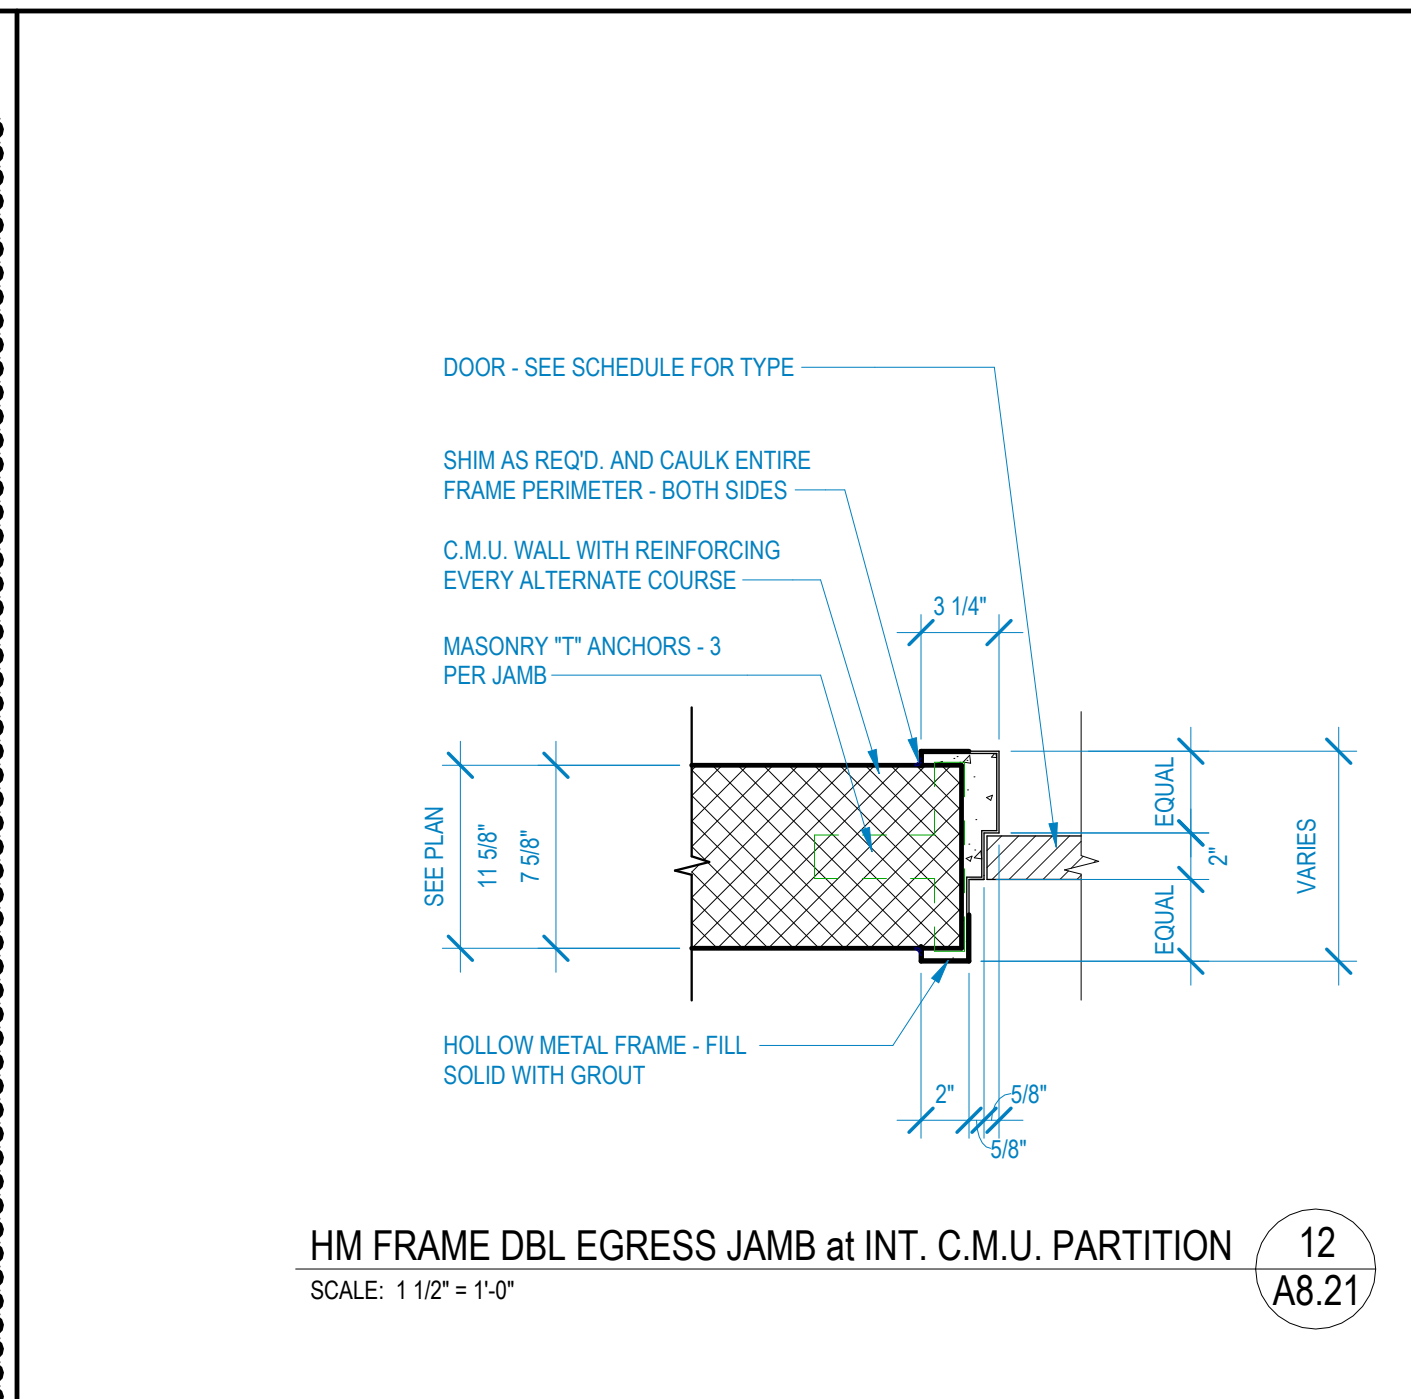


HM FRAME DBL EGRESS JAMB at INT. C.M.U. PARTITION
 SCALE: 1 1/2" = 1'-0"
 12 (A8.21)

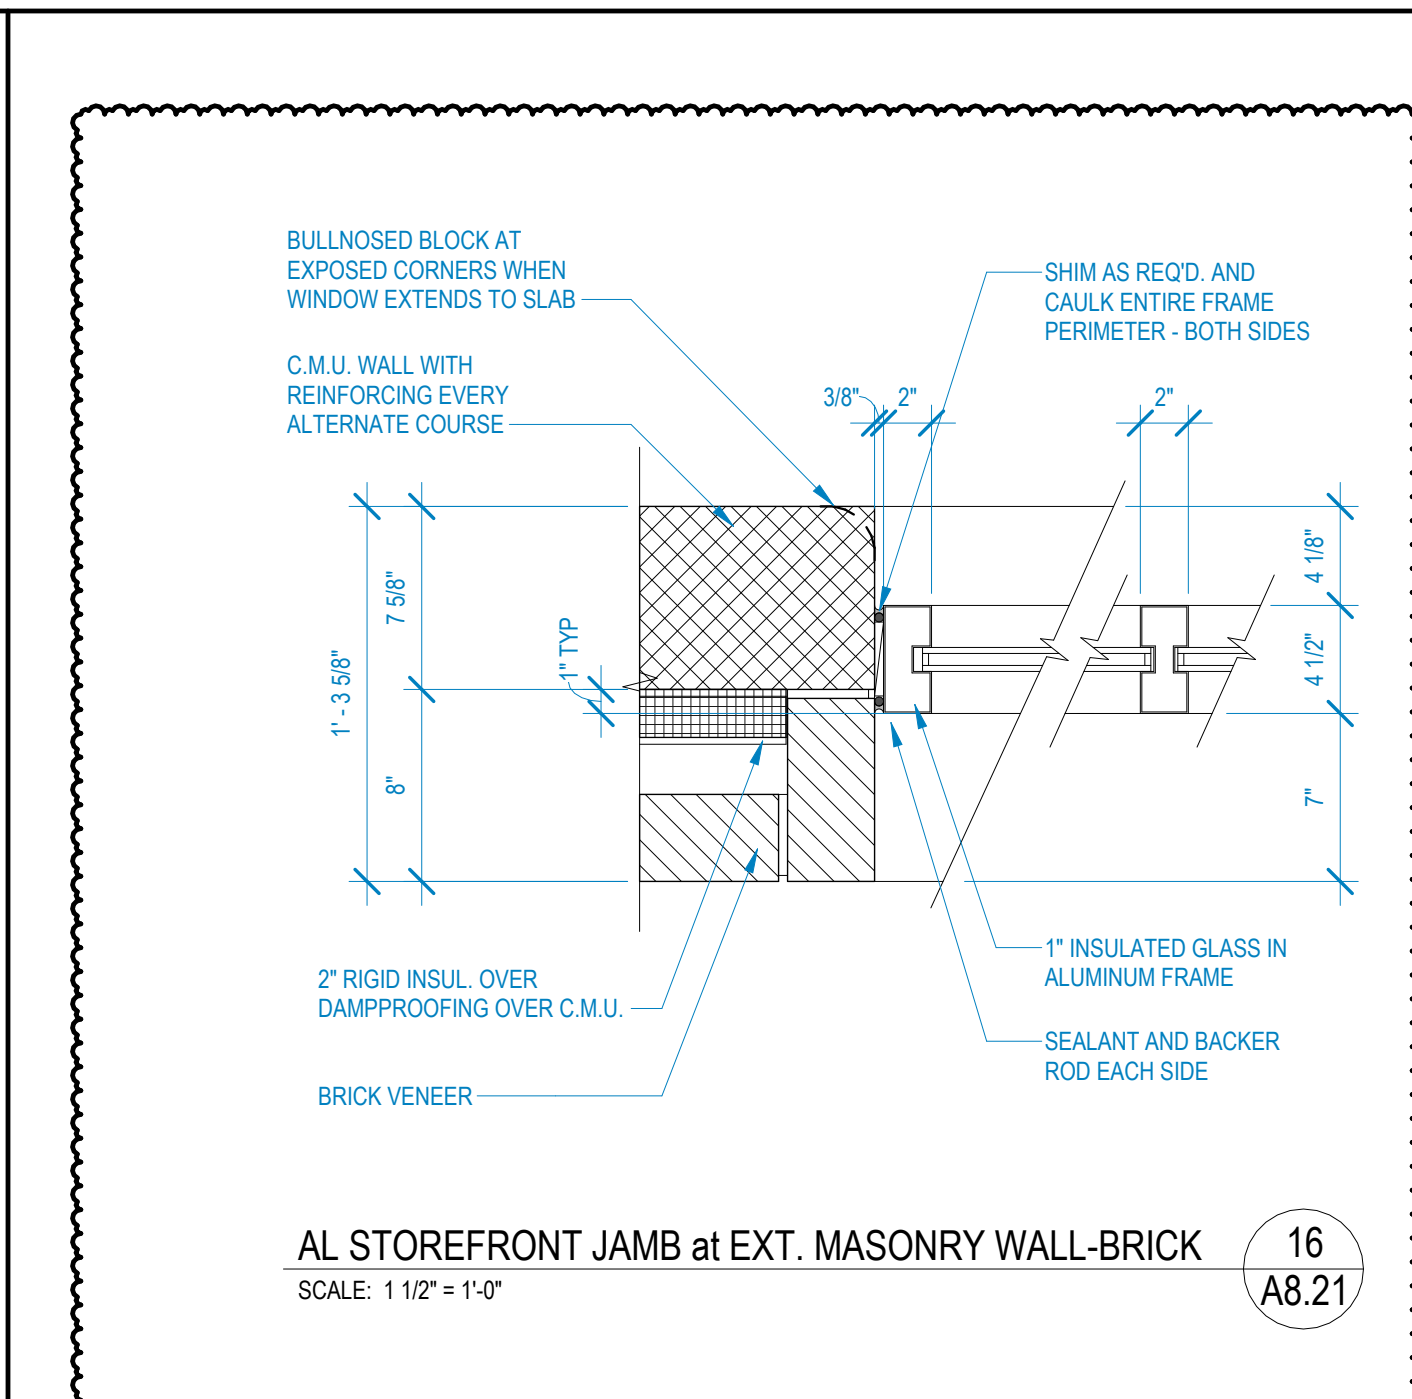


AL STOREFRONT JAMB at EXT. MASONRY WALL-BRICK
 SCALE: 1 1/2" = 1'-0"
 16 (A8.21)

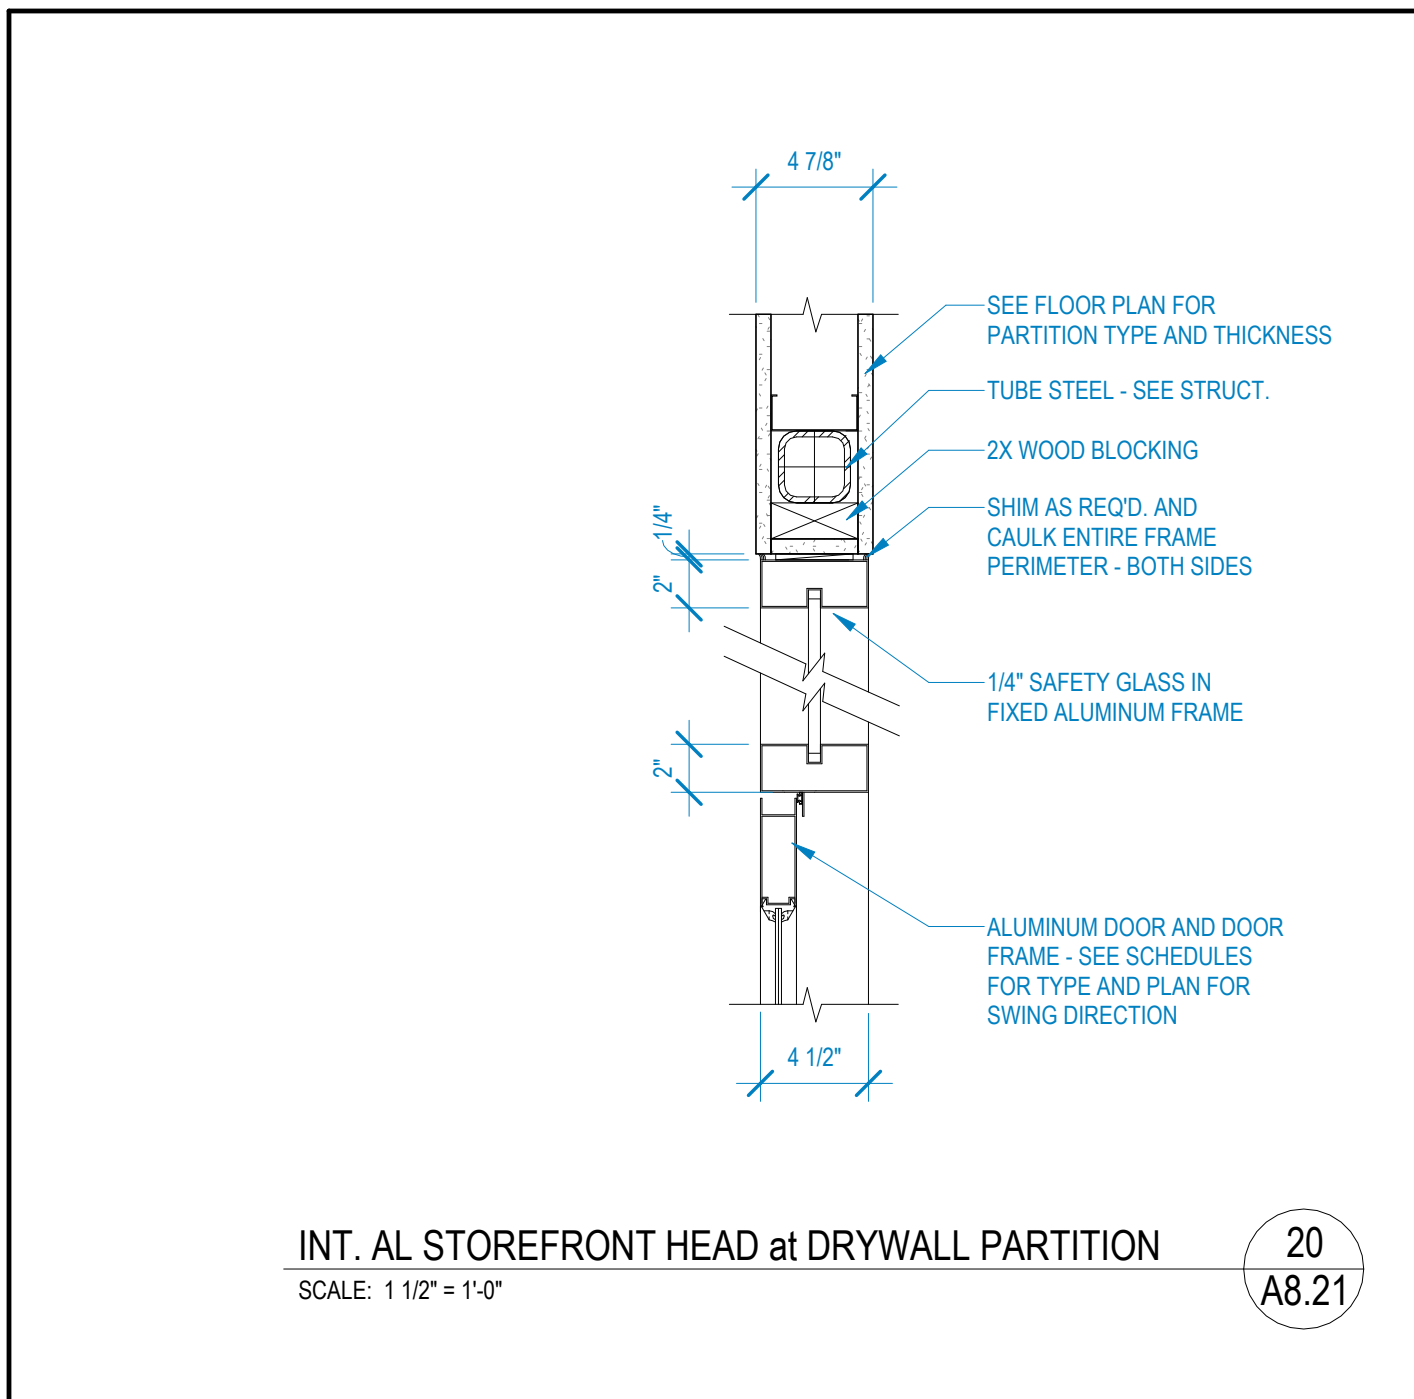


INT. AL STOREFRONT HEAD at DRYWALL PARTITION
 SCALE: 1 1/2" = 1'-0"
 20 (A8.21)

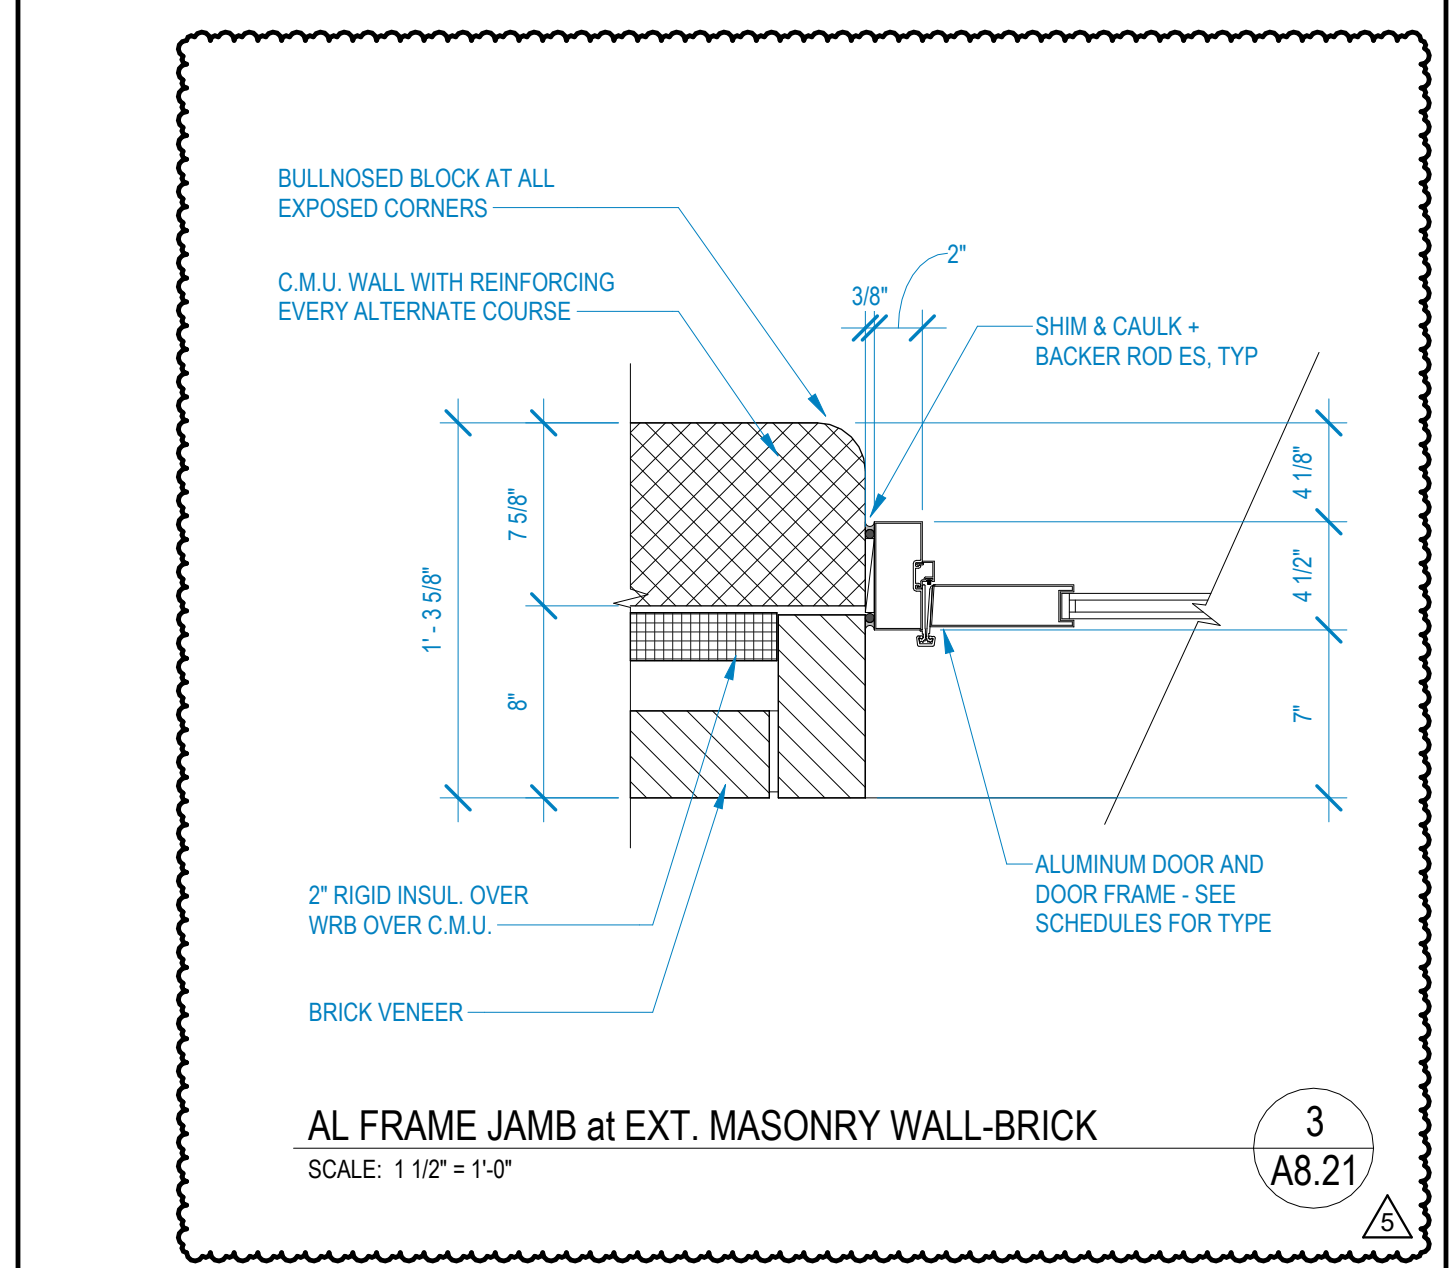


AL FRAME JAMB at EXT. MASONRY WALL-BRICK
 SCALE: 1 1/2" = 1'-0"
 3 (A8.21)

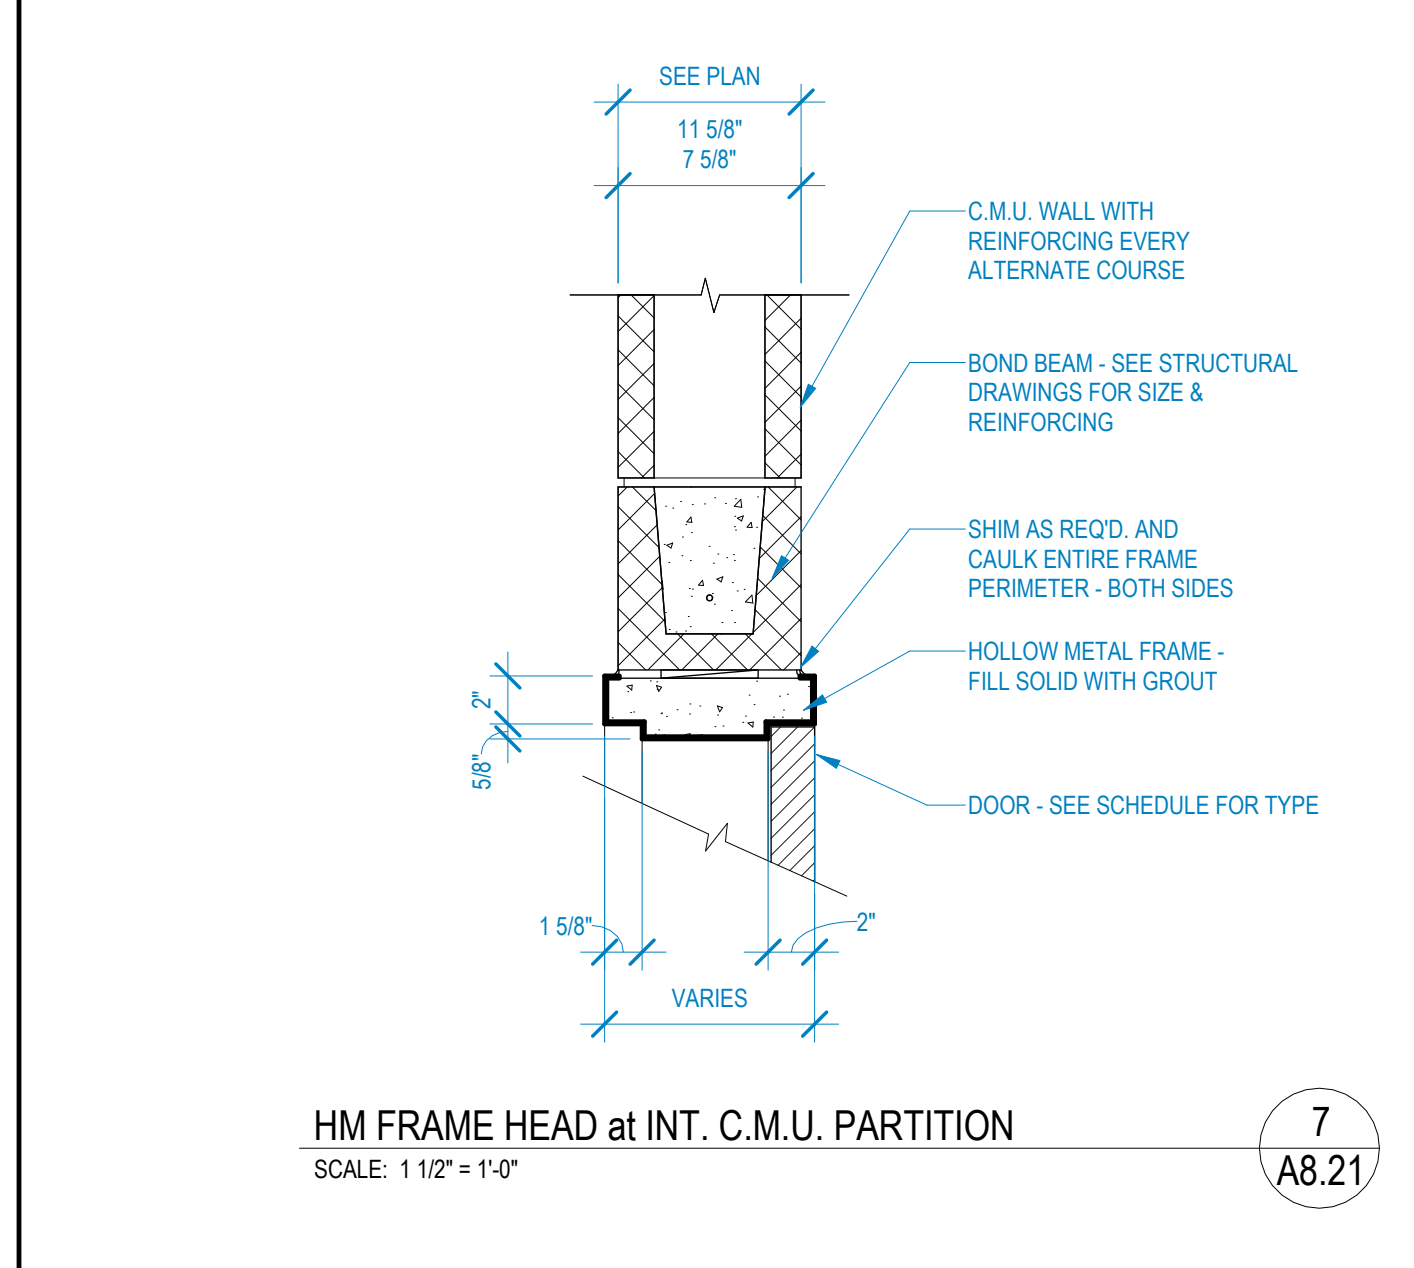


HM FRAME HEAD at INT. C.M.U. PARTITION
 SCALE: 1 1/2" = 1'-0"
 7 (A8.21)

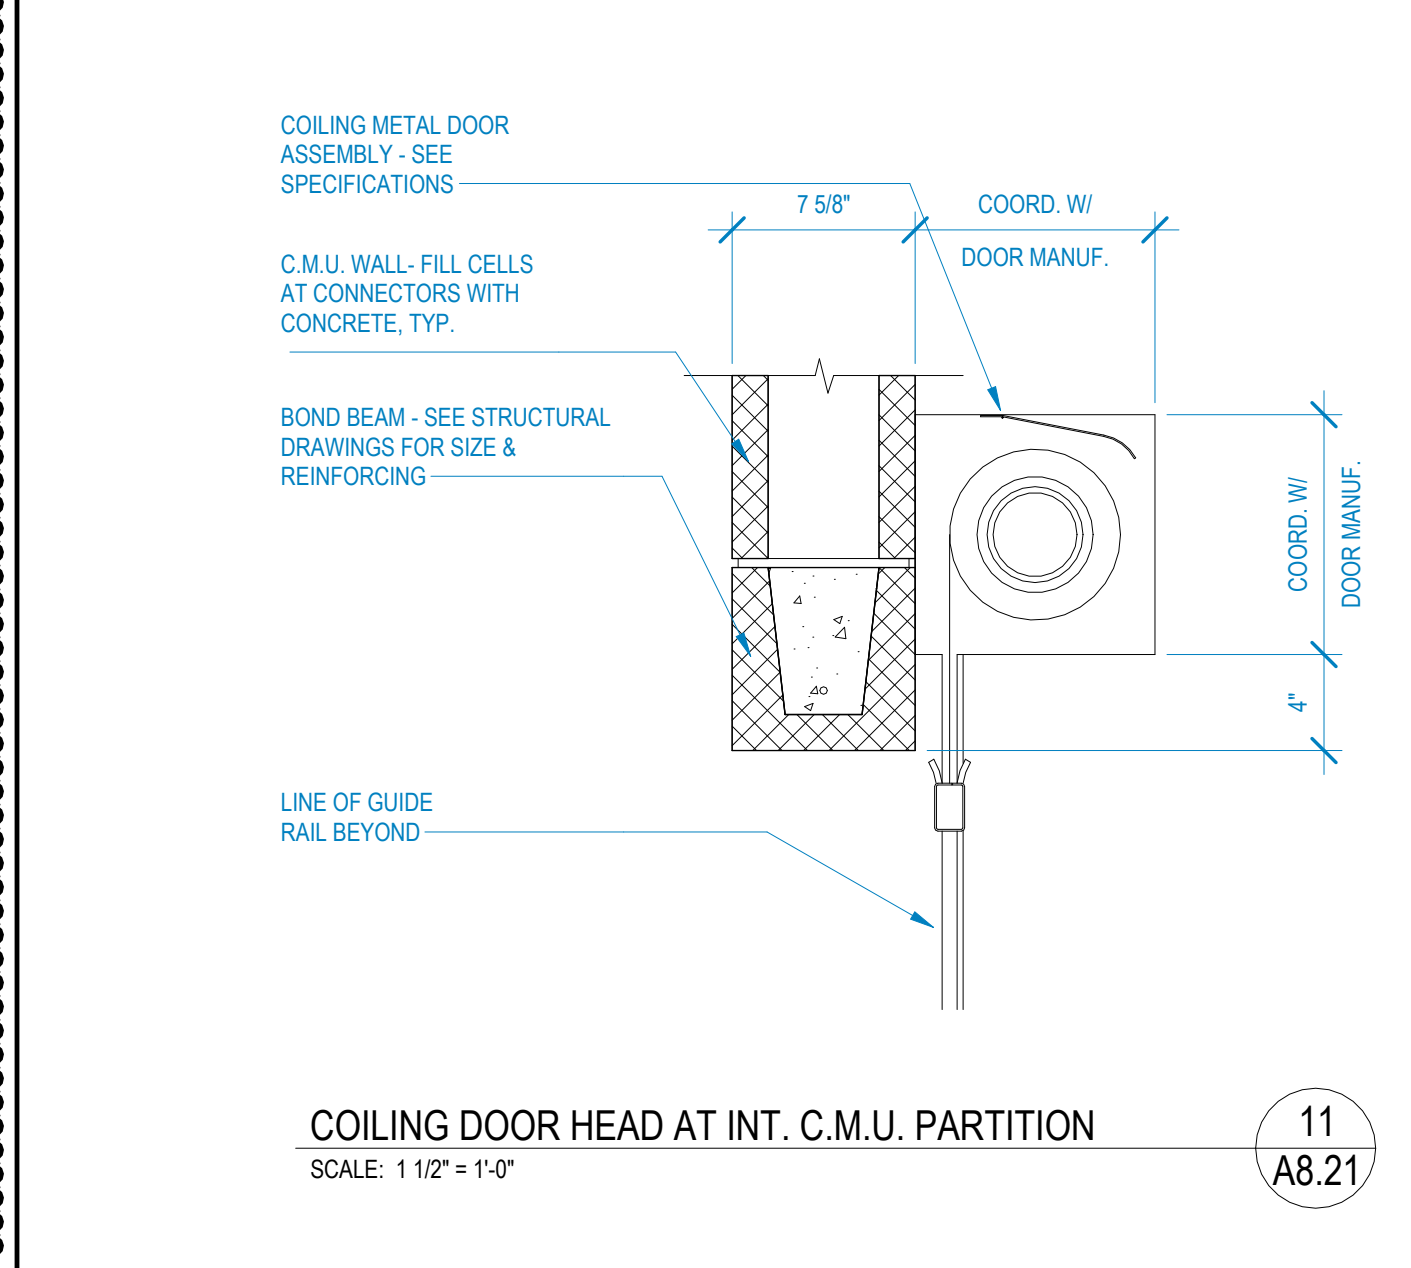


COILING DOOR HEAD at INT. C.M.U. PARTITION
 SCALE: 1 1/2" = 1'-0"
 11 (A8.21)

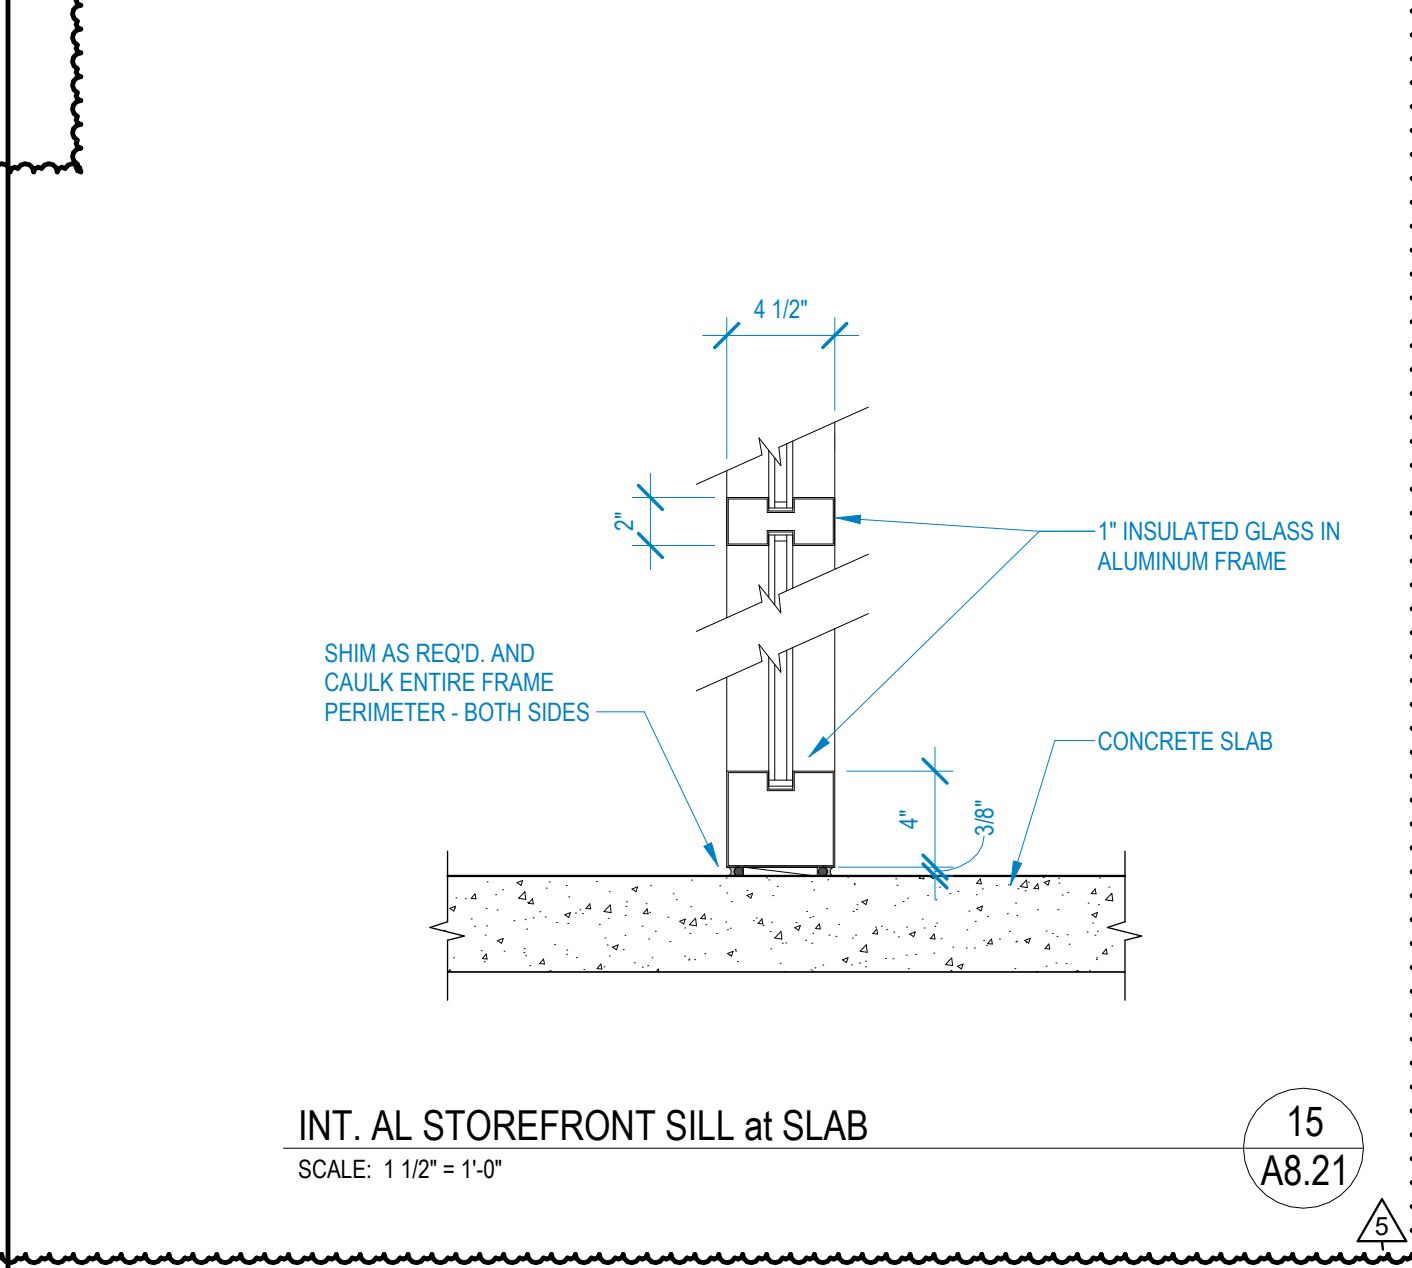


INT. AL STOREFRONT SILL at SLAB
 SCALE: 1 1/2" = 1'-0"
 15 (A8.21)

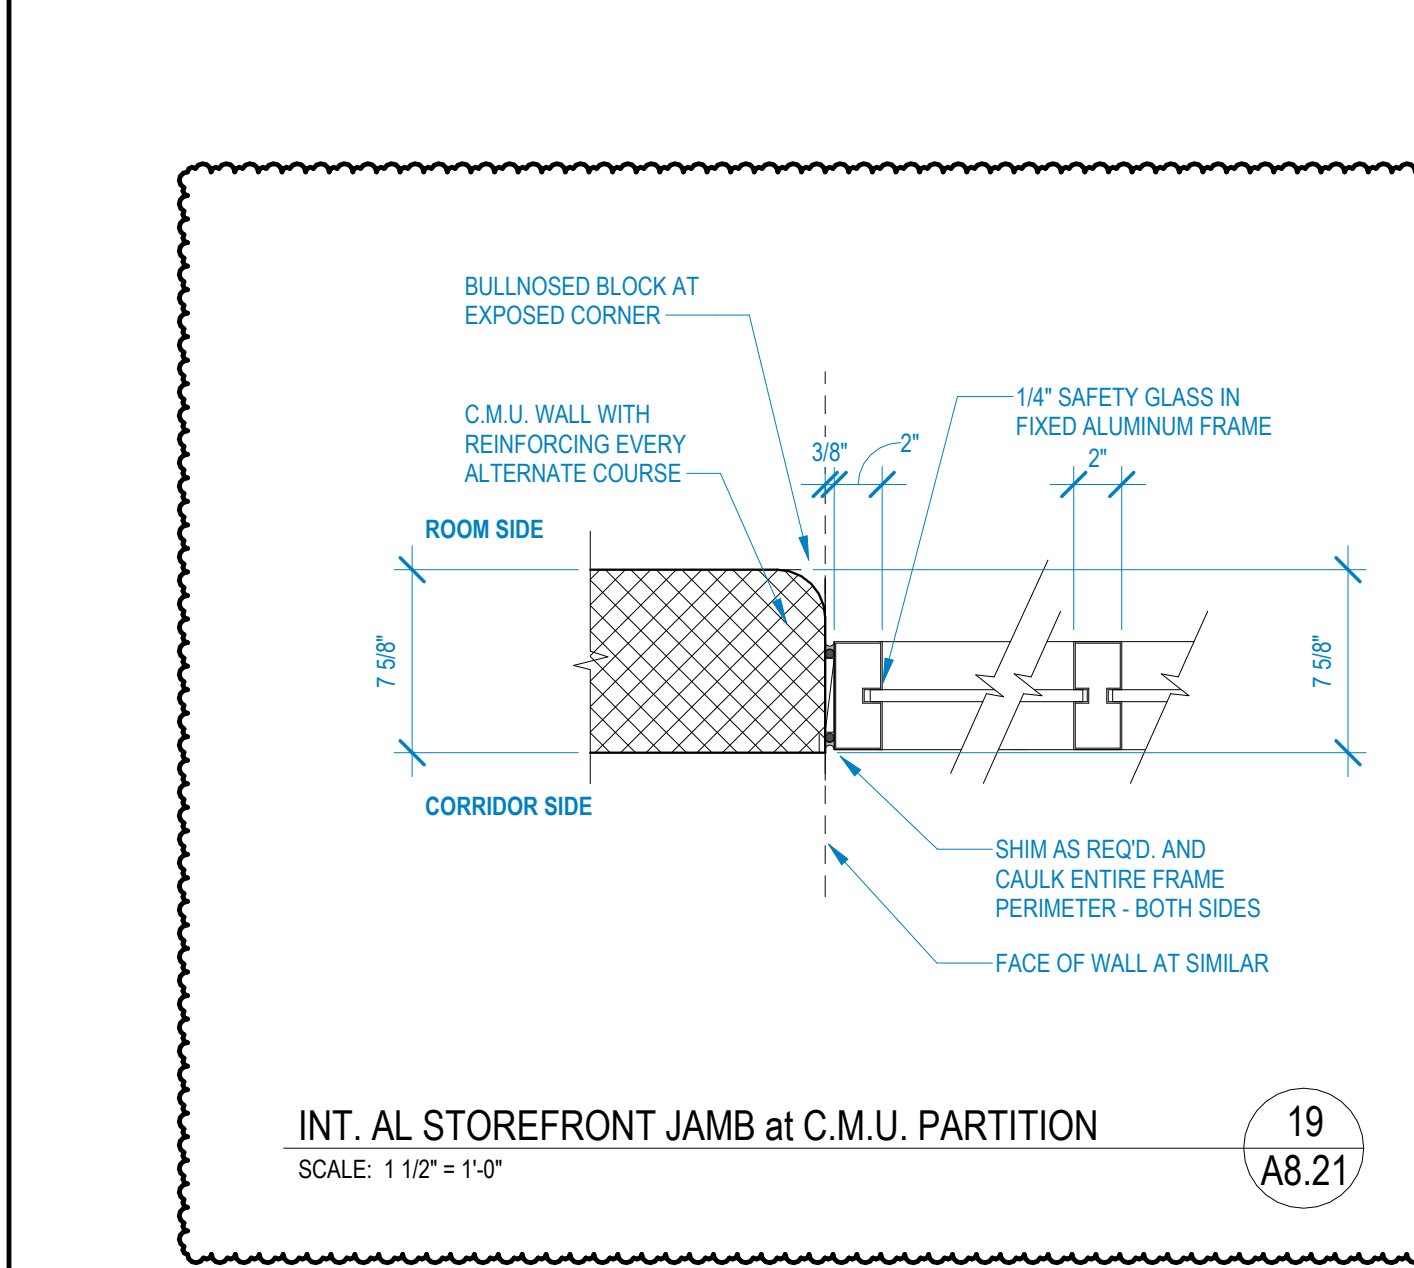


INT. AL STOREFRONT JAMB at C.M.U. PARTITION
 SCALE: 1 1/2" = 1'-0"
 19 (A8.21)

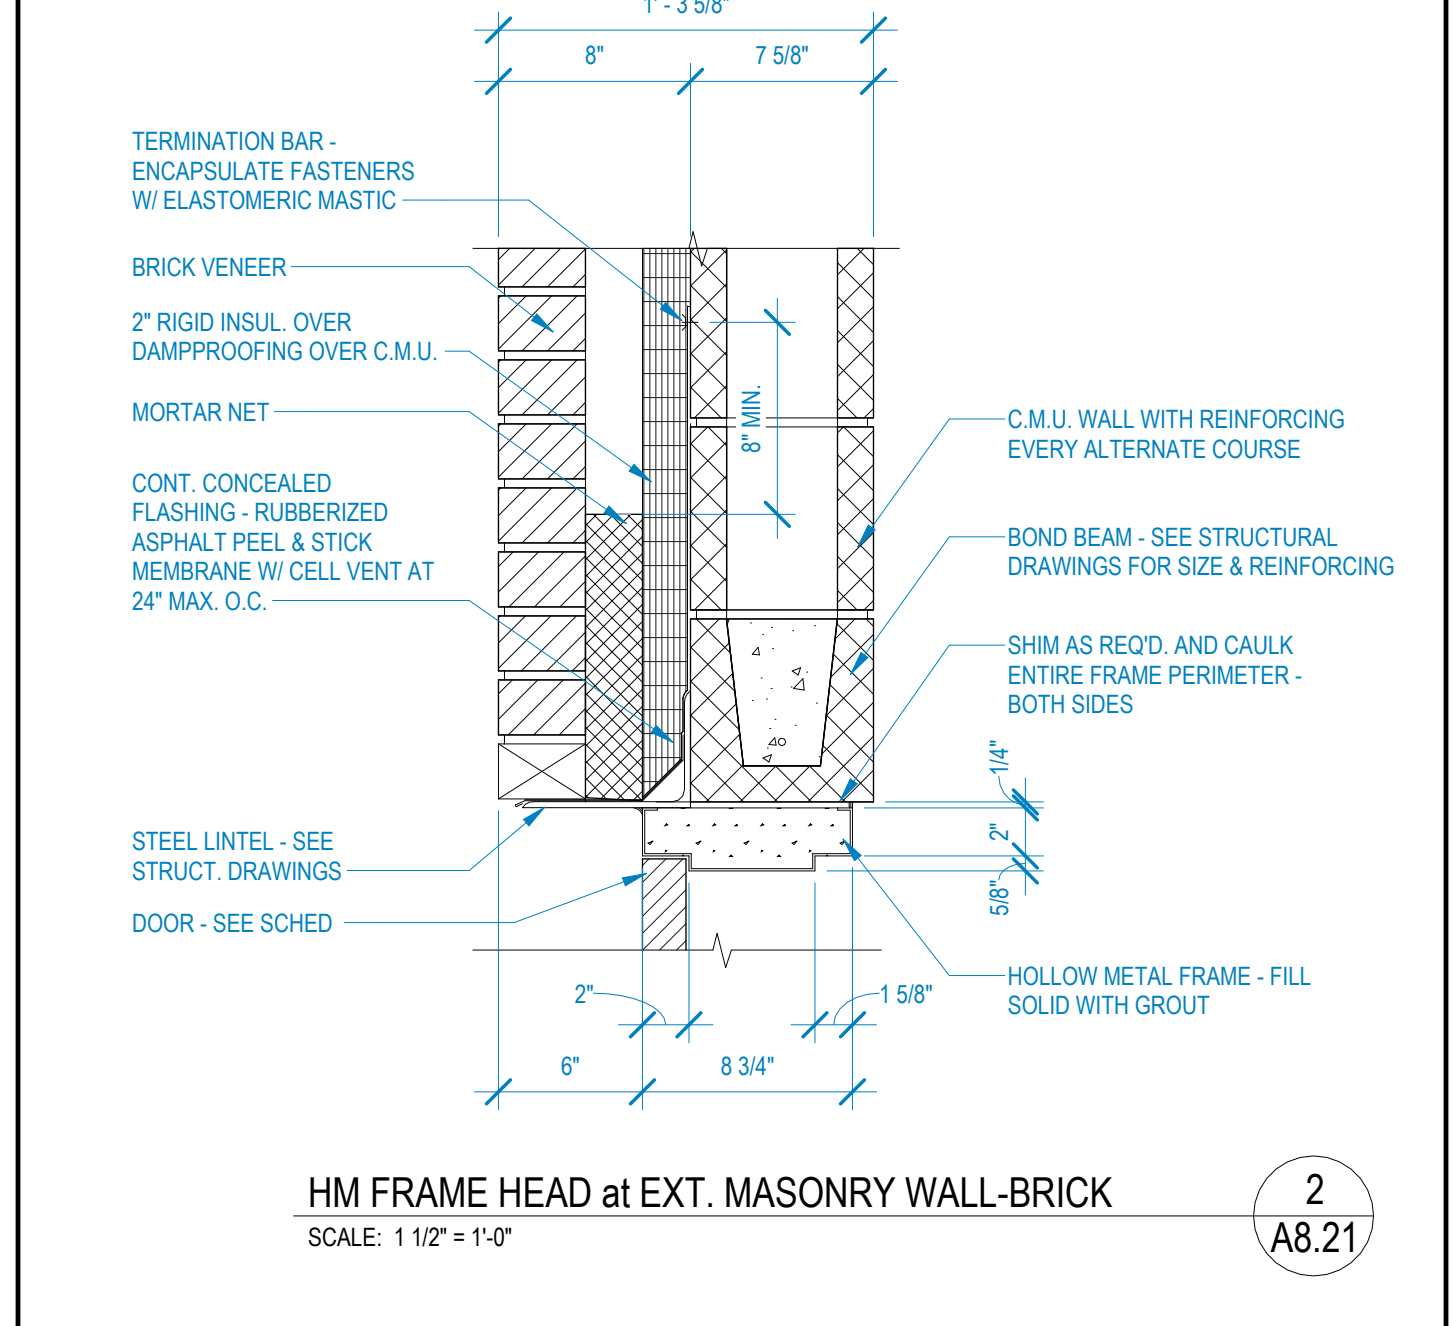


HM FRAME HEAD at EXT. MASONRY WALL-BRICK
 SCALE: 1 1/2" = 1'-0"
 2 (A8.21)

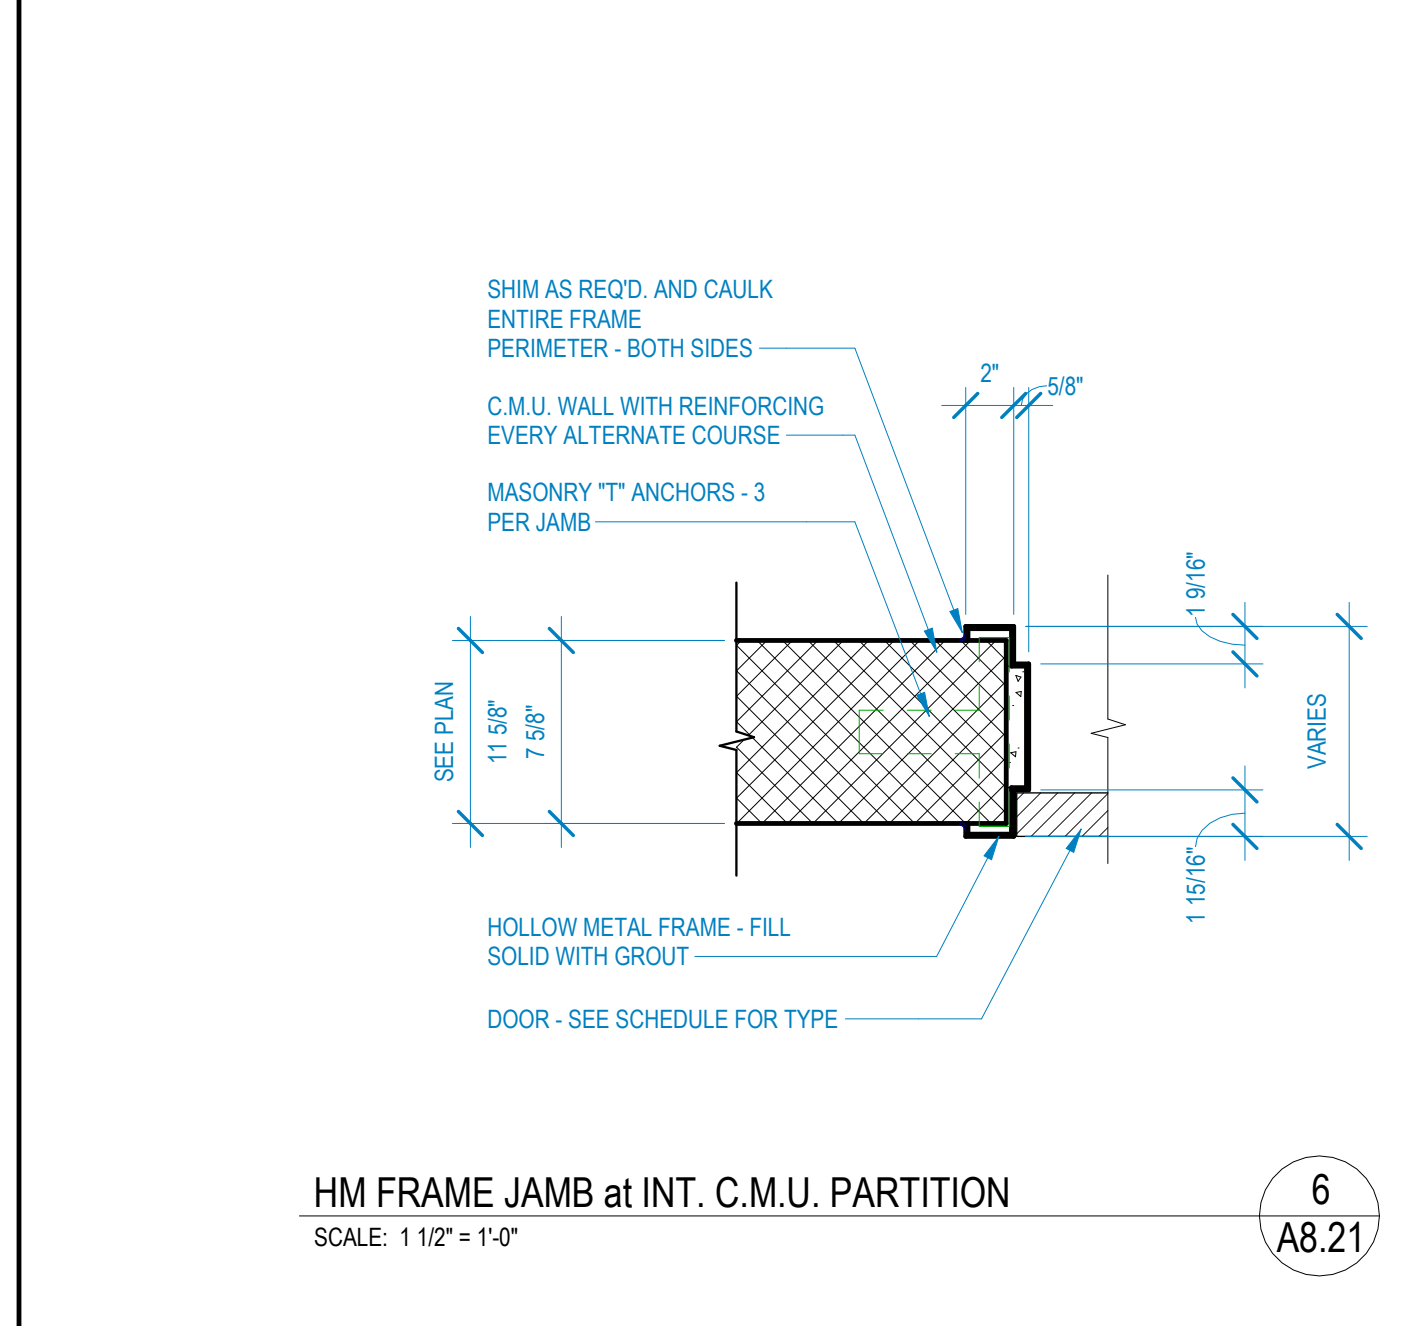


HM FRAME JAMB at INT. C.M.U. PARTITION
 SCALE: 1 1/2" = 1'-0"
 6 (A8.21)

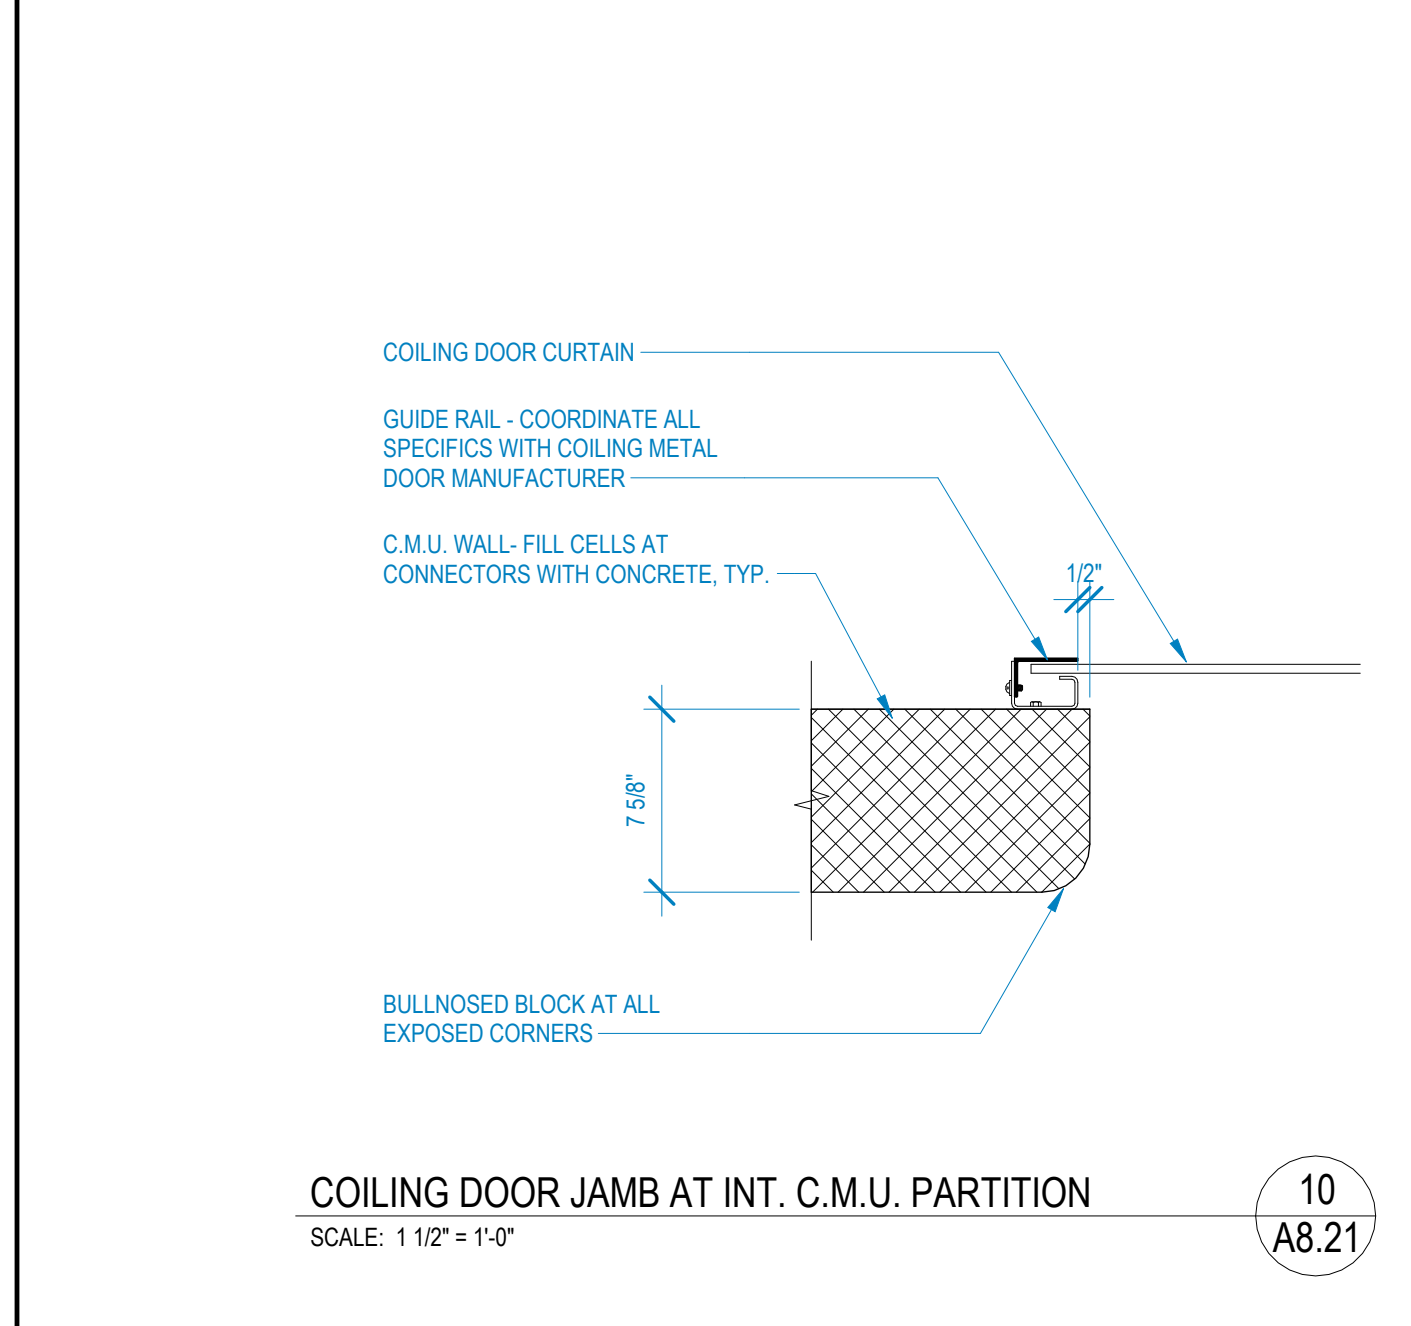


COILING DOOR JAMB at INT. C.M.U. PARTITION
 SCALE: 1 1/2" = 1'-0"
 10 (A8.21)

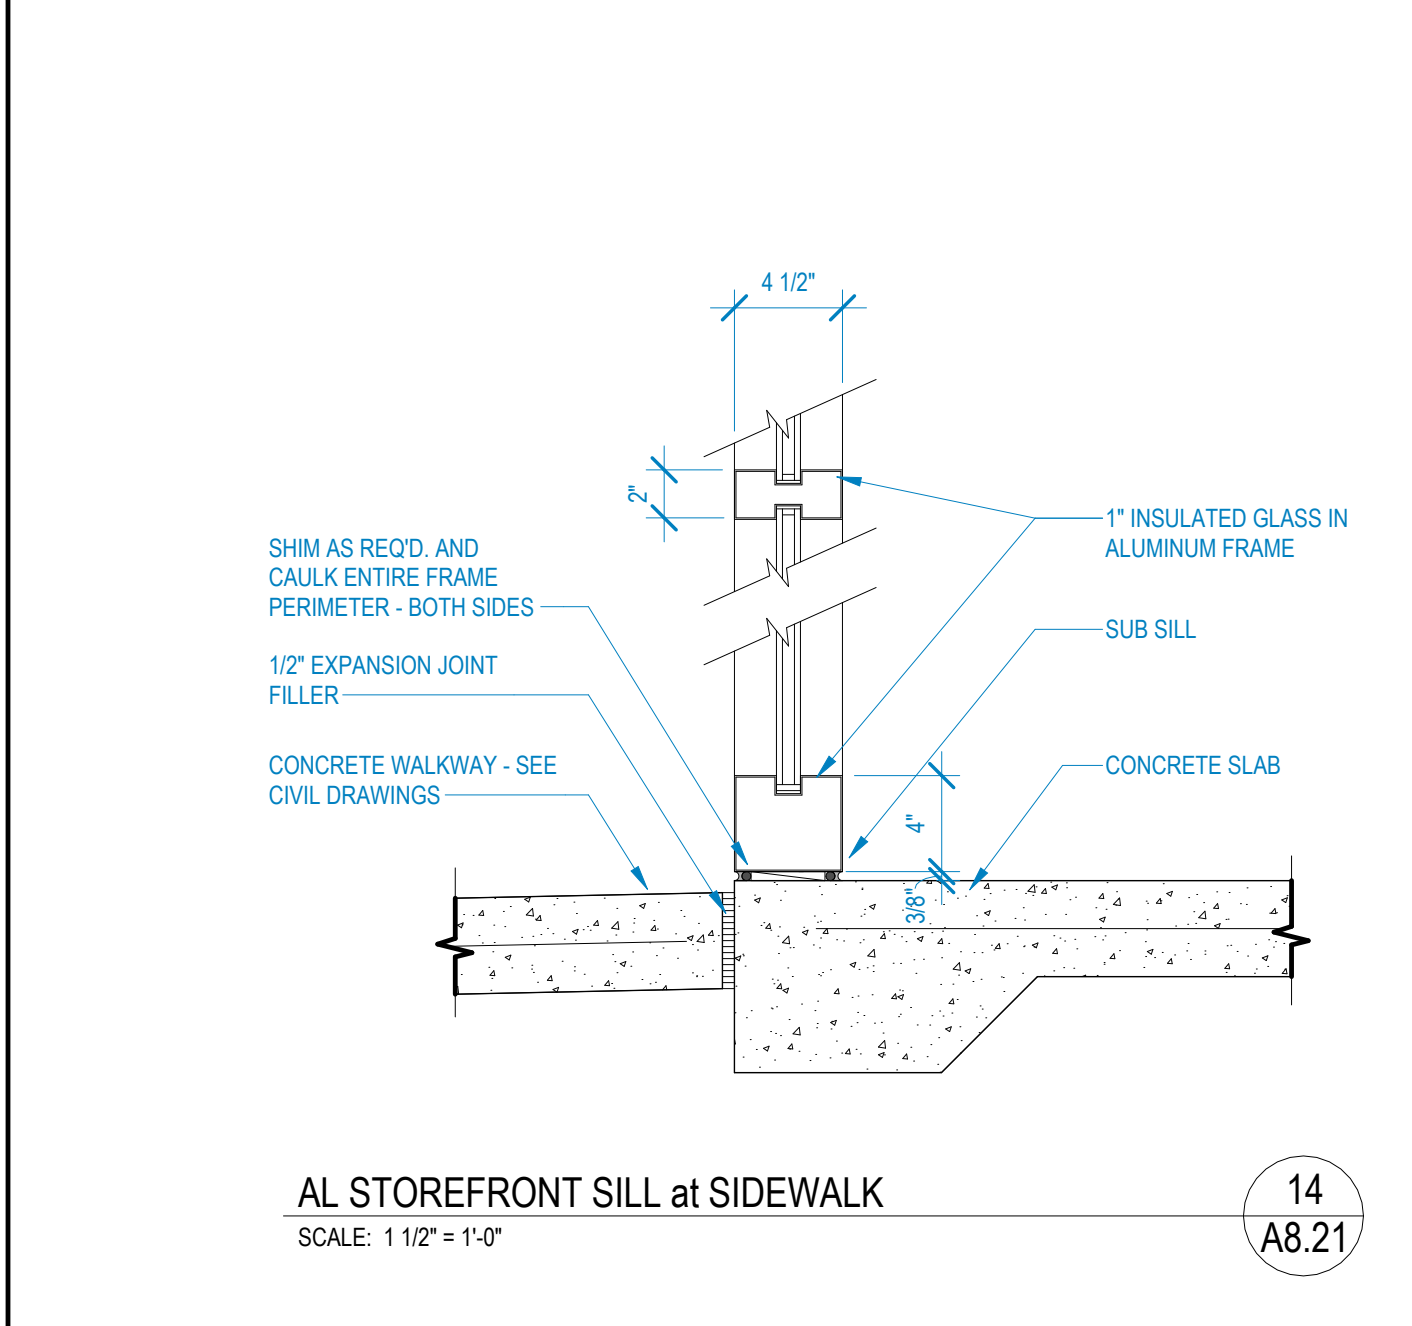


AL STOREFRONT SILL at SIDEWALK
 SCALE: 1 1/2" = 1'-0"
 14 (A8.21)

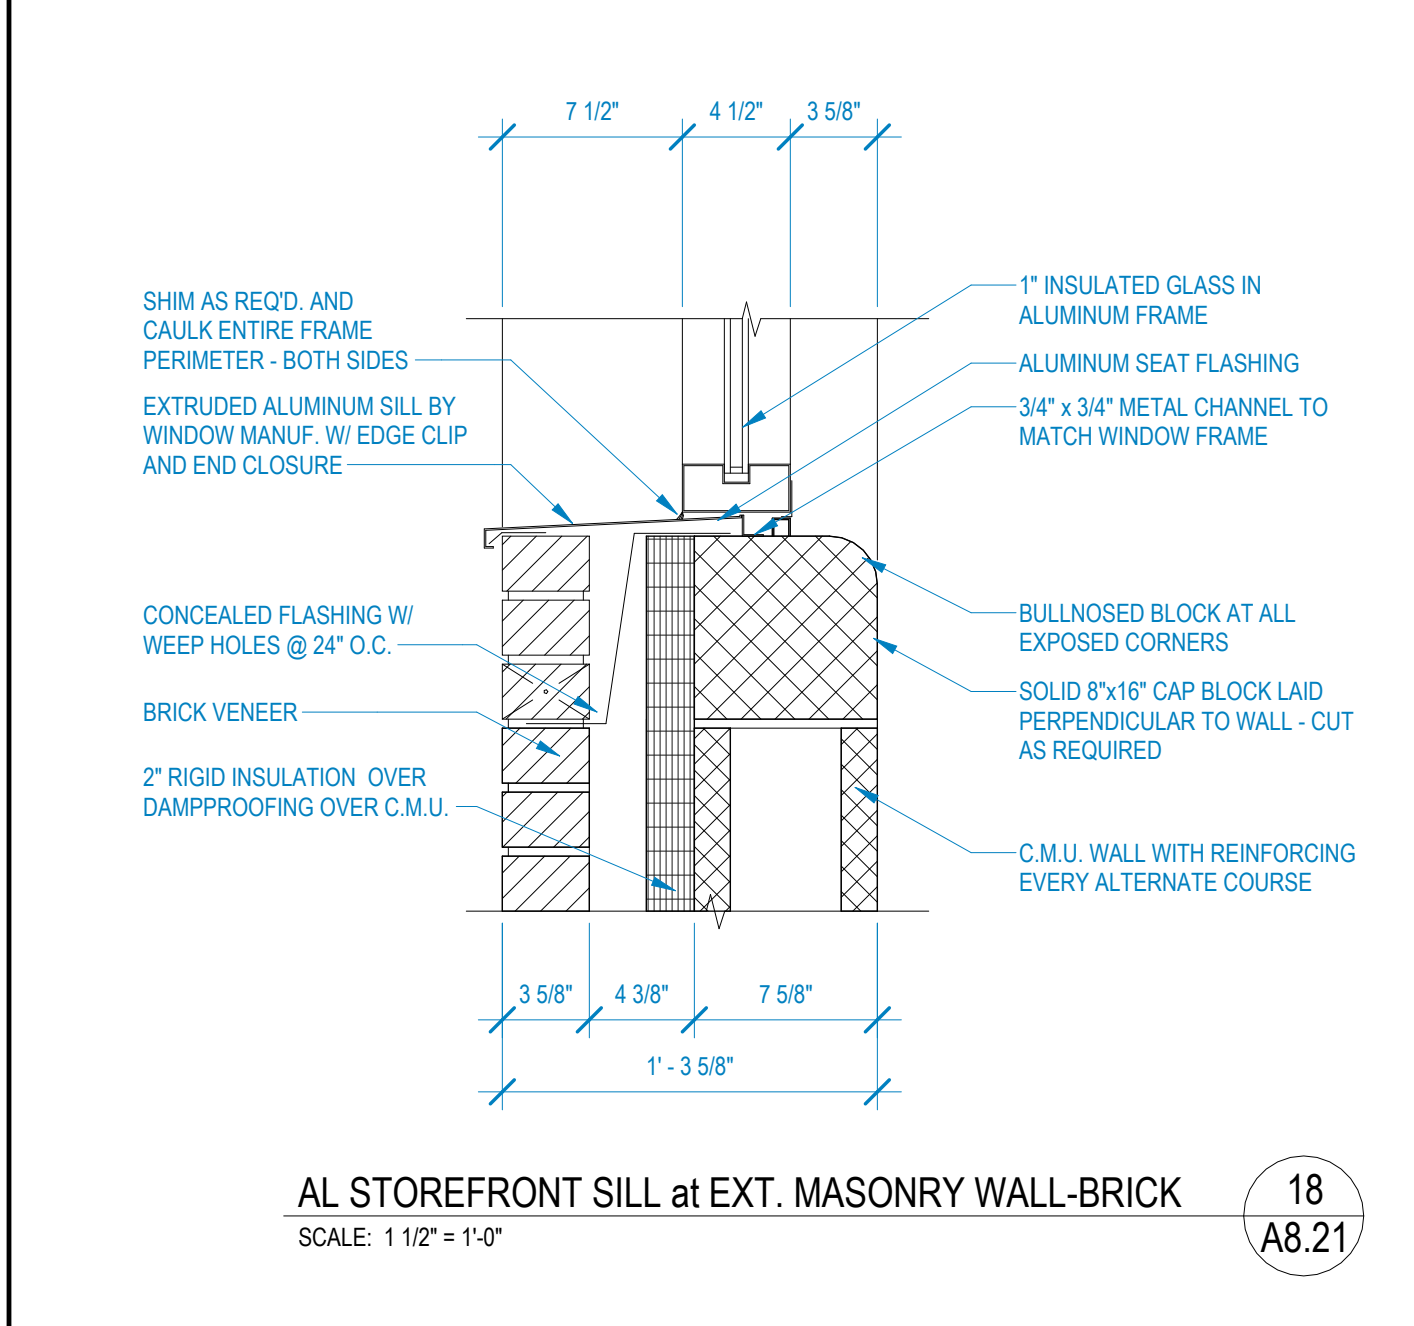


AL STOREFRONT SILL at EXT. MASONRY WALL-BRICK
 SCALE: 1 1/2" = 1'-0"
 18 (A8.21)

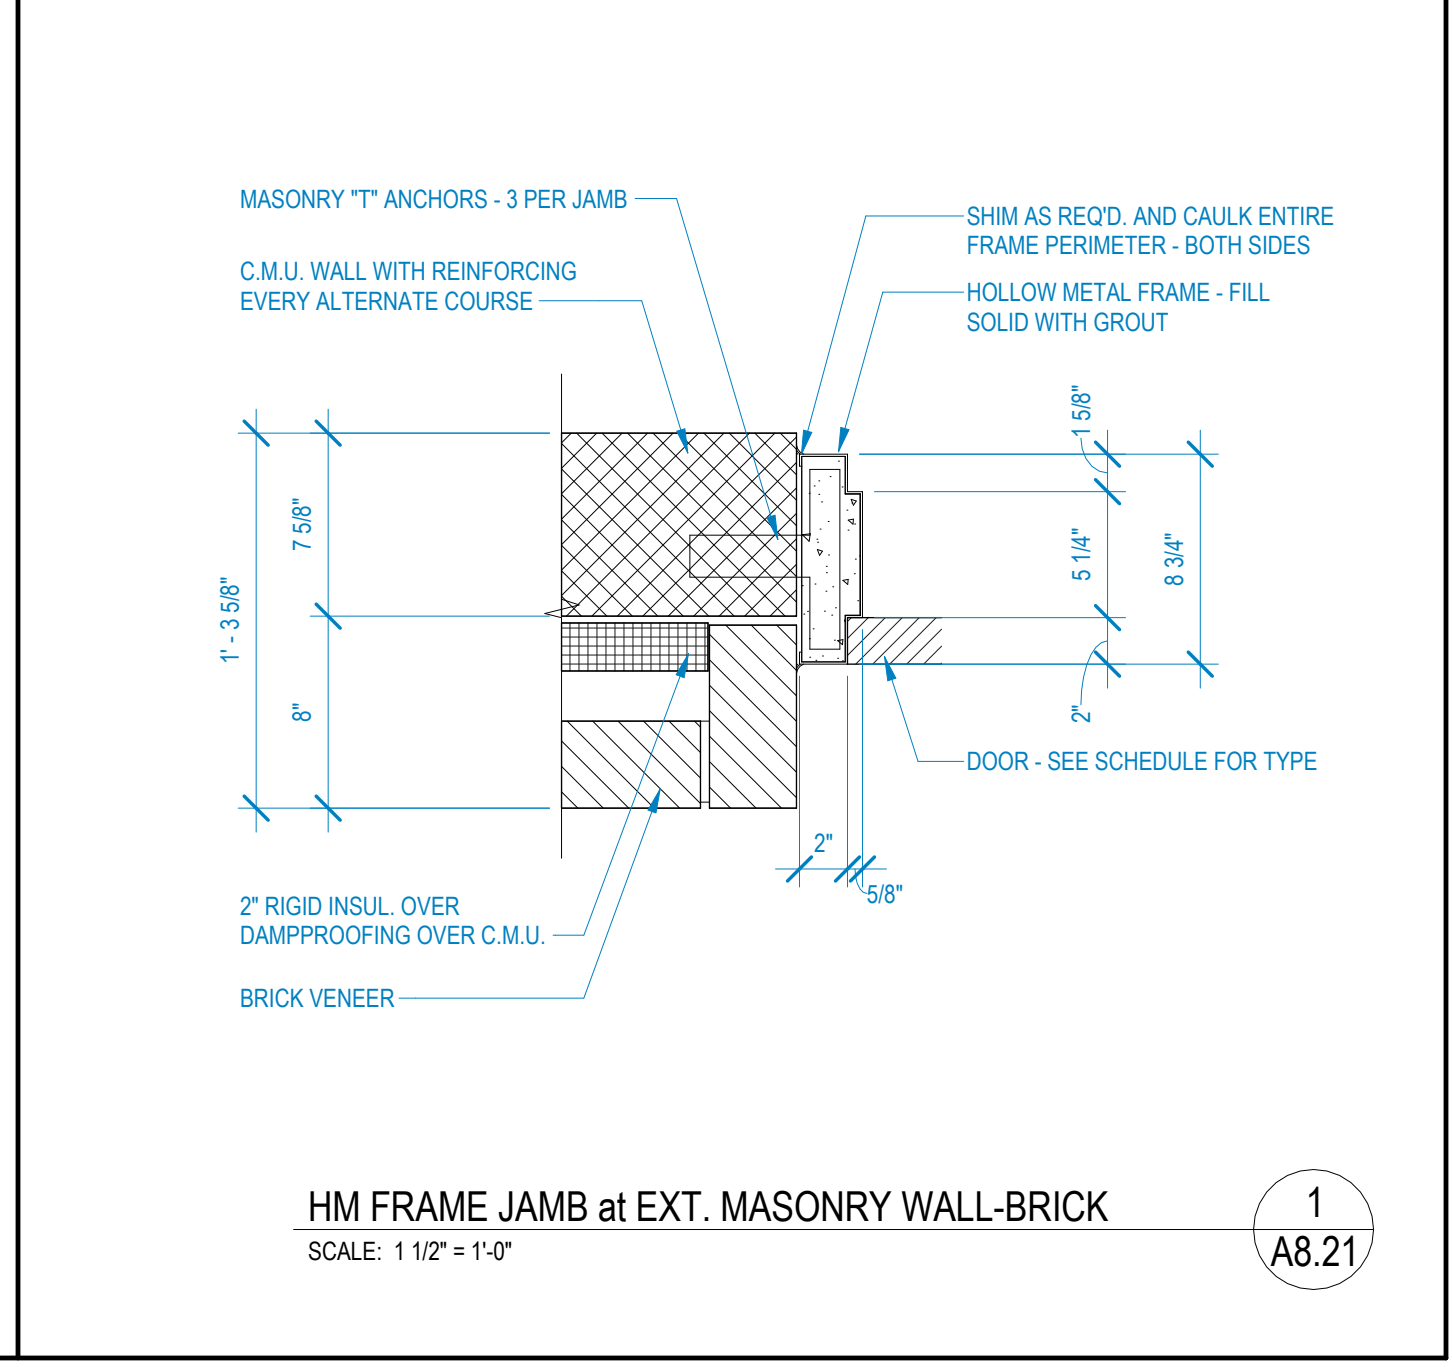


HM FRAME JAMB at EXT. MASONRY WALL-BRICK
 SCALE: 1 1/2" = 1'-0"
 1 (A8.21)

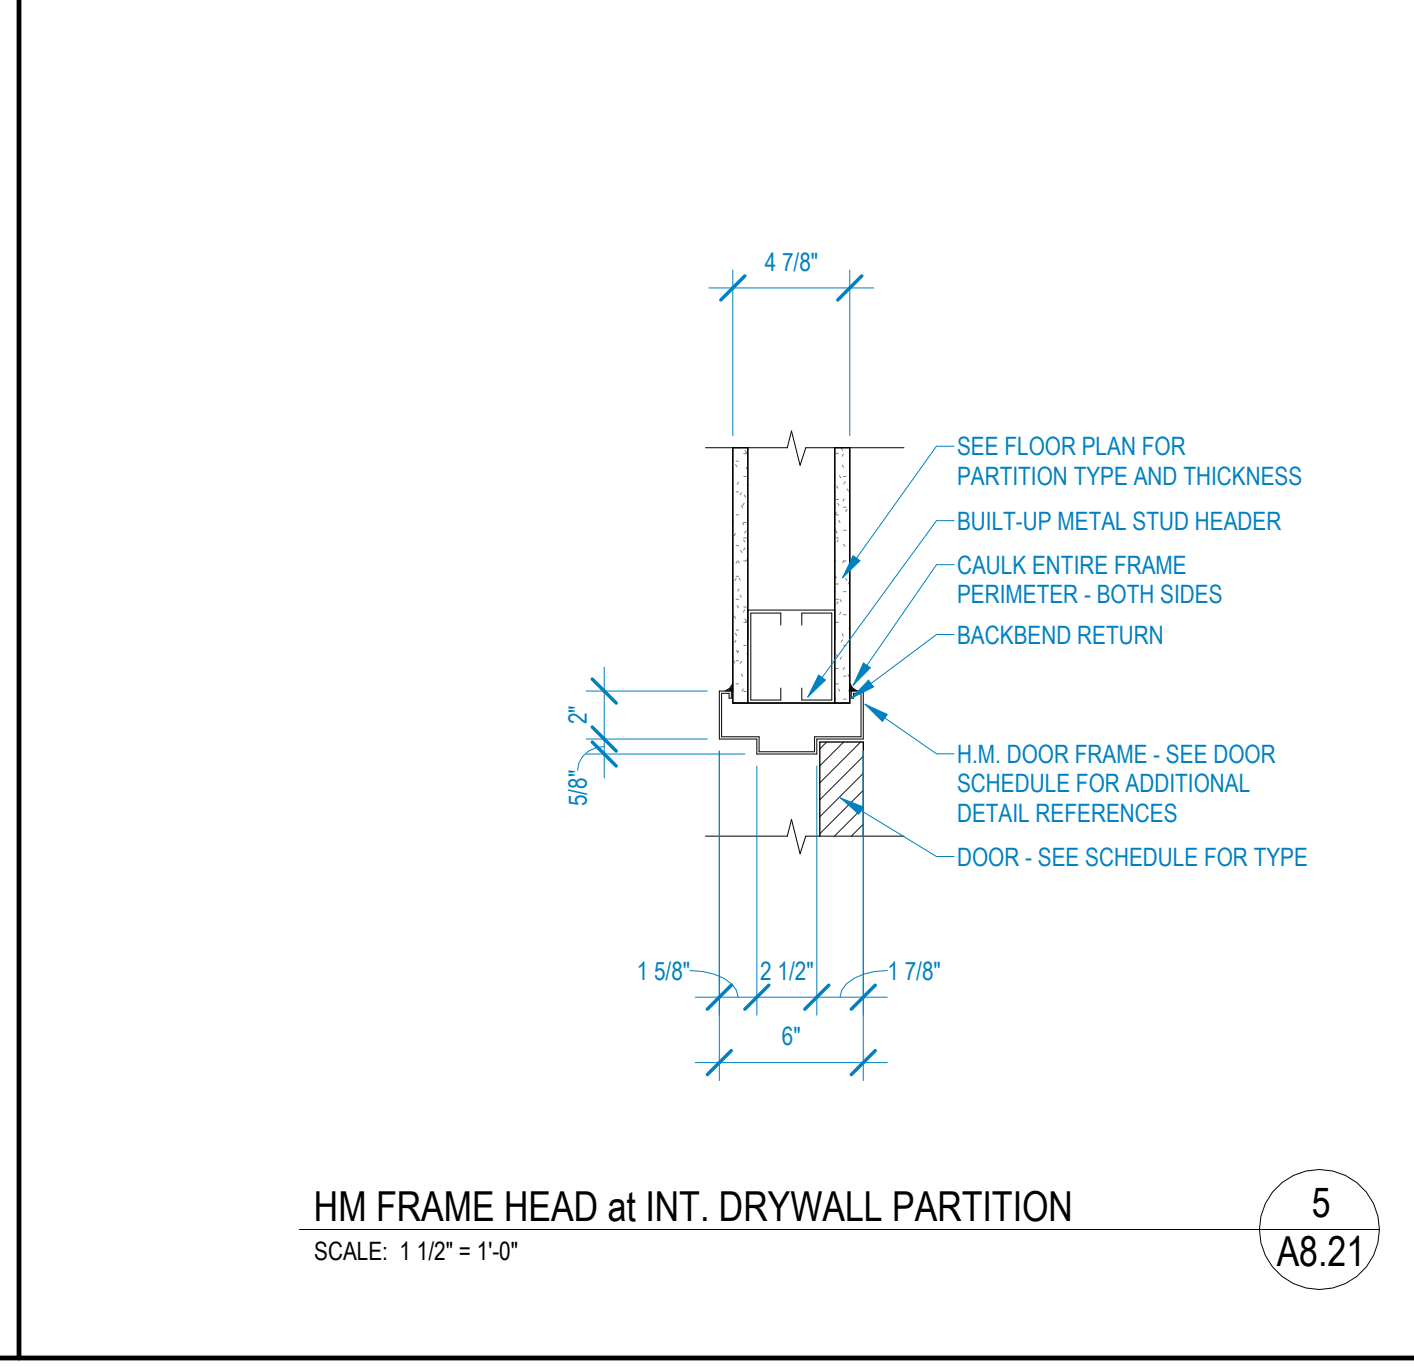


HM FRAME HEAD at INT. DRYWALL PARTITION
 SCALE: 1 1/2" = 1'-0"
 5 (A8.21)

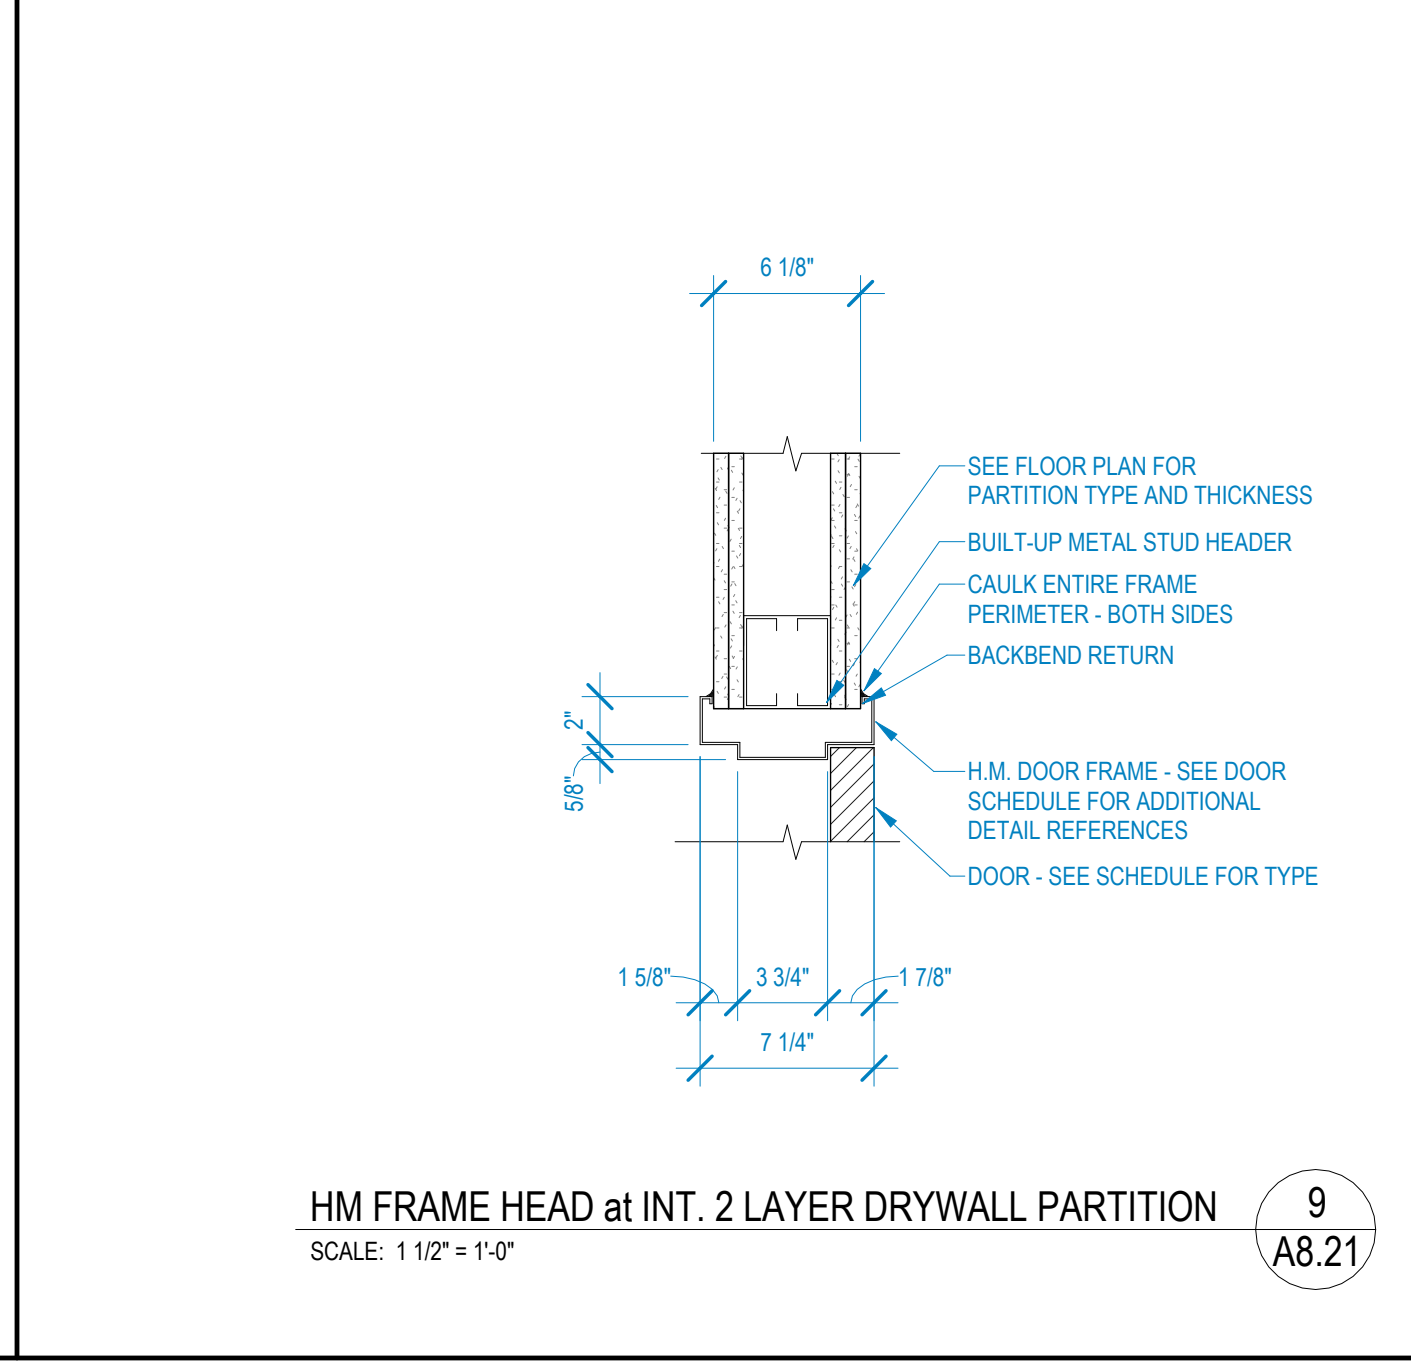


HM FRAME HEAD at INT. 2 LAYER DRYWALL PARTITION
 SCALE: 1 1/2" = 1'-0"
 9 (A8.21)

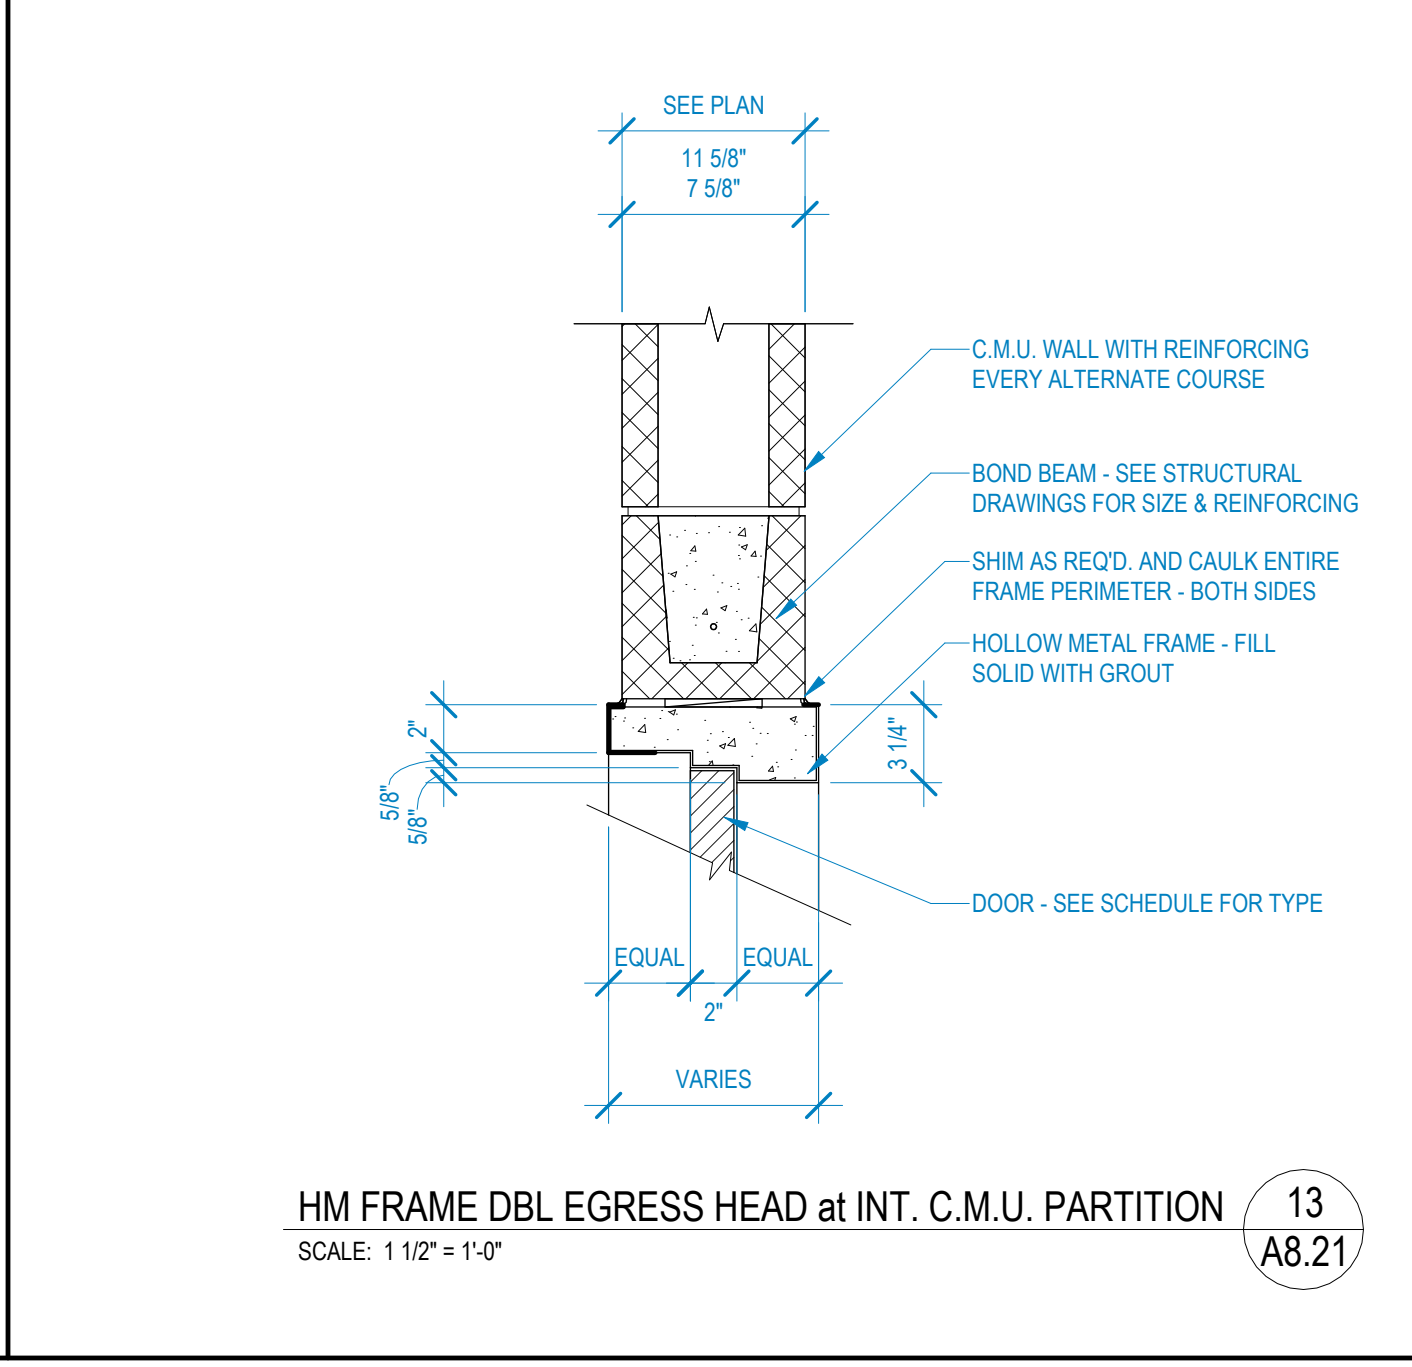

HM FRAME DBL EGRESS HEAD at INT. C.M.U. PARTITION
 SCALE: 1 1/2" = 1'-0"
 13 (A8.21)

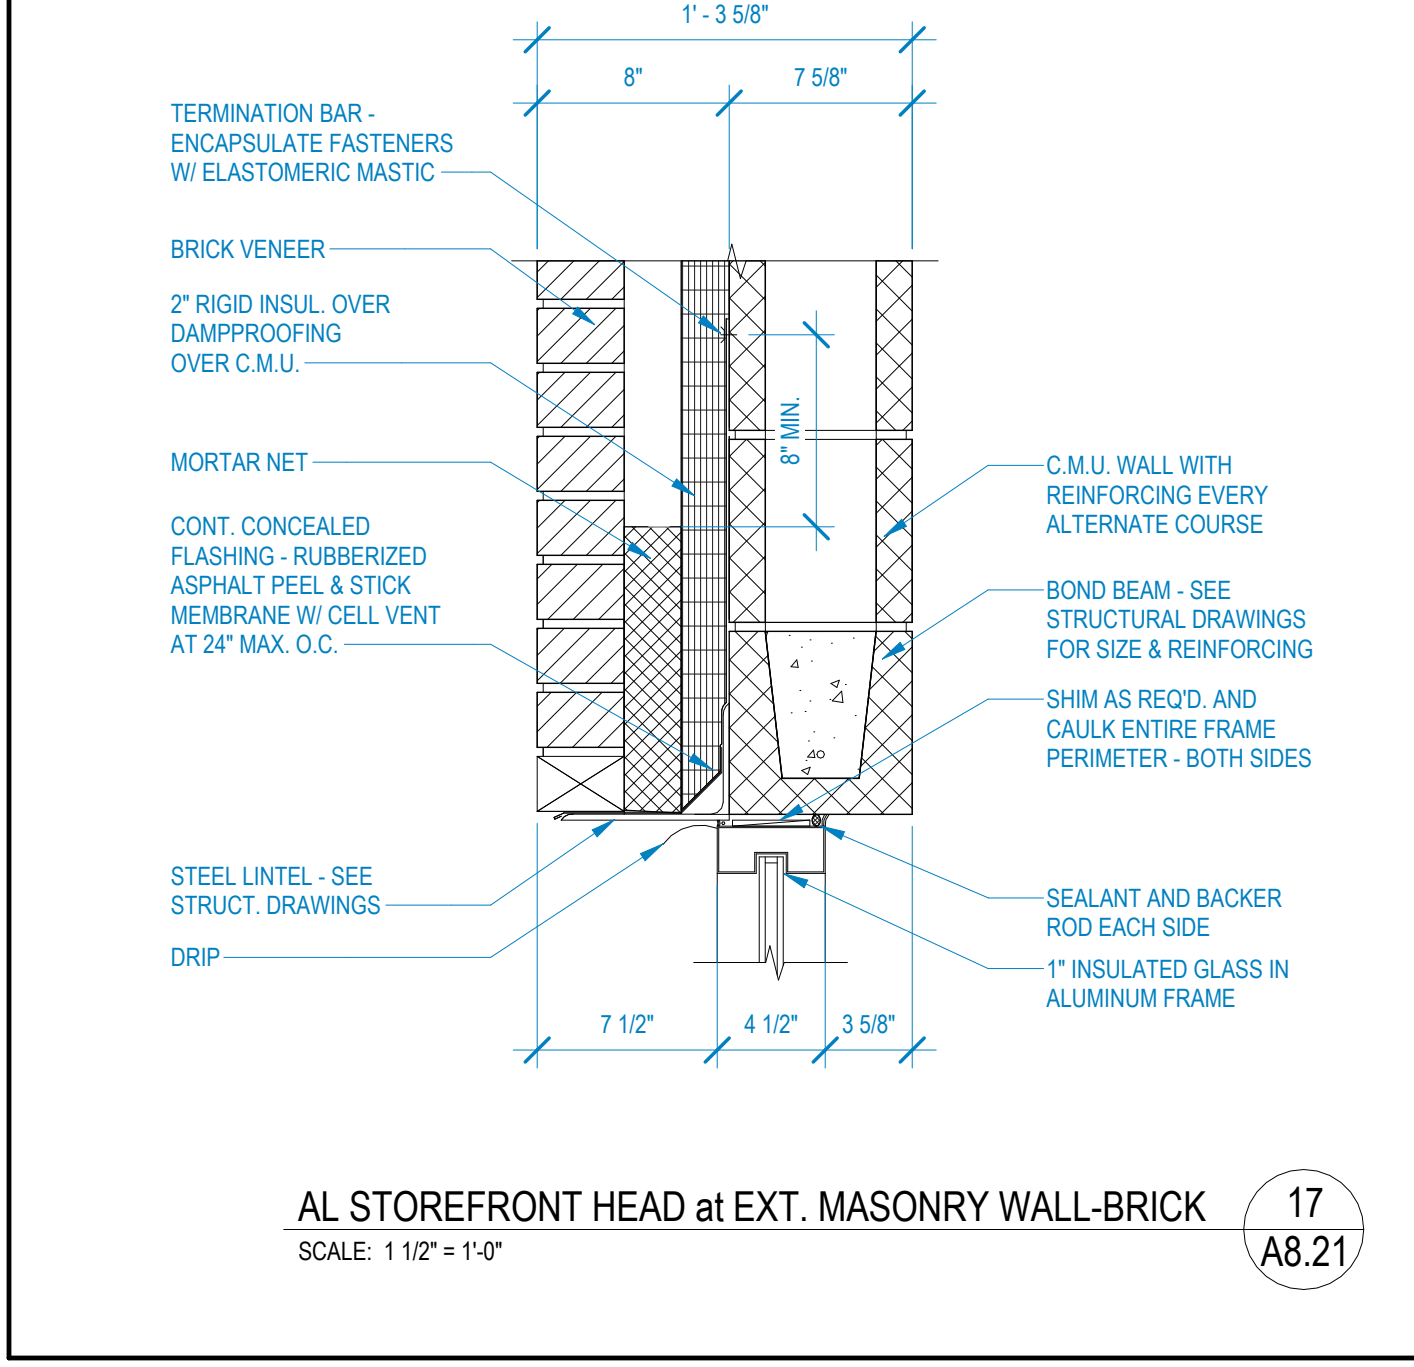

AL STOREFRONT HEAD at EXT. MASONRY WALL-BRICK
 SCALE: 1 1/2" = 1'-0"
 17 (A8.21)

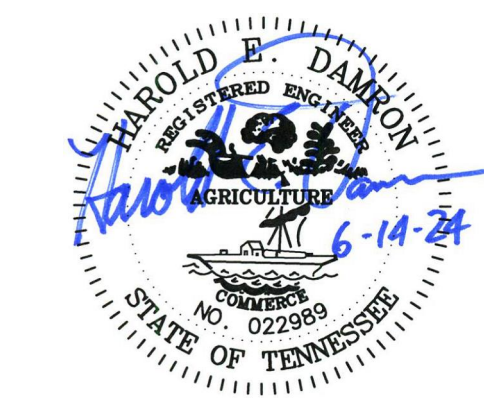

A NEW SCHOOL FACILITY:
 DATE: 03/15/2024
 PROJECT NO: 21074
 SBC NO: 540 / 001-05-2023 SP2

PROJECT REVISIONS

#	DATE	DESCRIPTION
1	4-26-24	SFAD COMMENTS
4	6-14-24	ADD ODS

THIS DRAWING IS THE PROPERTY OF THE LEWIS GROUP ARCHITECTS, INC. AND IS TO BE USED ONLY FOR THE PROJECT AND SITE SPECIFICALLY IDENTIFIED HEREIN. THIS DRAWING IS NOT TO BE USED ON ANY OTHER PROJECT WITHOUT THE PROJECT FOR WHICH IT IS MADE OR EXECUTED ON. THIS DRAWING AND ITS CONTENTS ARE THE SOLE POSSESSION OF THE LEWIS GROUP ARCHITECTS, INC. AND SHALL NOT BE REPRODUCED OR TRANSMITTED IN ANY FORM OR BY ANY MEANS, ELECTRONIC OR MECHANICAL, INCLUDING PHOTOCOPYING, RECORDING, OR BY ANY INFORMATION STORAGE AND RETRIEVAL SYSTEM, WITHOUT THE WRITTEN PERMISSION OF THE LEWIS GROUP ARCHITECTS, INC. IT IS TO BE RETURNED UPON REQUEST.

FIRST FLOOR PLAN - AREA 'B' - LIGHTING

E1.12

WALL LEGEND

- EXTERIOR WALL
- ONE HOUR FIRE RATED EXTERIOR ASSEMBLY
- NON-RATED PARTITION
- ONE HOUR RATED PARTITION
- SMOKE PARTITION
- ONE HOUR RATED SMOKE BARRIER

CONDUCTOR SIZE TABLE



FOR 20 AMP FIRE CIRCUITS, THE FOLLOWING ARE THE MAXIMUM ONE-WAY DISTANCES ALLOWED:

CONDUCTOR SIZE	120V	208V/1Ø	208V/3Ø	277V	480V/3Ø
NO. 12	80'	140'	225'	180'	550'
NO. 10	125'	215'	425'	225'	-
NO. 8	195'	340'	665'	435'	-


TABLE IS BASED ON 3% VOLTAGE DROP ON 12.0 F.L.A., 0.85 POWER FACTOR. USE LARGER SIZES IF SPECIFICALLY NOTED ON PLANS.

- VOLTAGE DROP CALCULATION NOTES:**
- REFER TO CONDUCTOR SIZE TABLE FOR WIRE SIZING REQUIREMENTS FOR 20 AMPERE BRANCH CIRCUITS.
 - FOR ALL OTHER FEEDER AND BRANCH CIRCUIT WIRING SHOWN ON DRAWINGS, WIRE SIZING HAS BEEN SPECIFIED TO MEET VOLTAGE DROP REQUIREMENTS AS SET FORTH IN NFPA 70 (NEC) AND IECC C405.9.

- LIGHTING NOTES:**
- REFER TO ARCHITECTURAL REFLECTED CEILING PLAN FOR EXACT LOCATIONS OF ALL LIGHTING FIXTURES.
 - EXIT SIGNS AND BUILT-IN BATTERY PACKS SHALL BE CONNECTED TO LOCAL UNSWITCHED LIGHTING CIRCUITS AS INDICATED ON DRAWINGS.
 - "NL" BY LIGHTING FIXTURE INDICATES FIXTURE TO BE UNSWITCHED "NIGHT LIGHT".
 - "EM" BY LIGHTING FIXTURE INDICATES FIXTURE TO BE EQUIPPED WITH BUILT-IN EMERGENCY BATTERY PACK.
 - WIRING ROUTING TO EXTERIOR LIGHTING FIXTURE NOT SHOWN FOR DRAWING CLARITY. PROVIDE 20 AMPERE BRANCH CIRCUIT INDICATED TO THIS FIXTURE, SIMILAR TO OTHER LIGHTING CIRCUITS SHOWN ON PLANS.
 - ROUTE LIGHTING CIRCUITS HB1-2 AND 11 THROUGH RELAY PANEL. PROVIDE A SEPARATE UNSWITCHED "HOT" CONDUCTOR (I.E. BYPASSING RELAY PANEL) FOR CIRCUITS HB1-11 TO ALLOW NORMAL SWITCHING OF THIS CIRCUIT VIA RELAY PANEL WITHOUT DISCHARGING BATTERIES/TURNING ON "NIGHT LIGHTS".

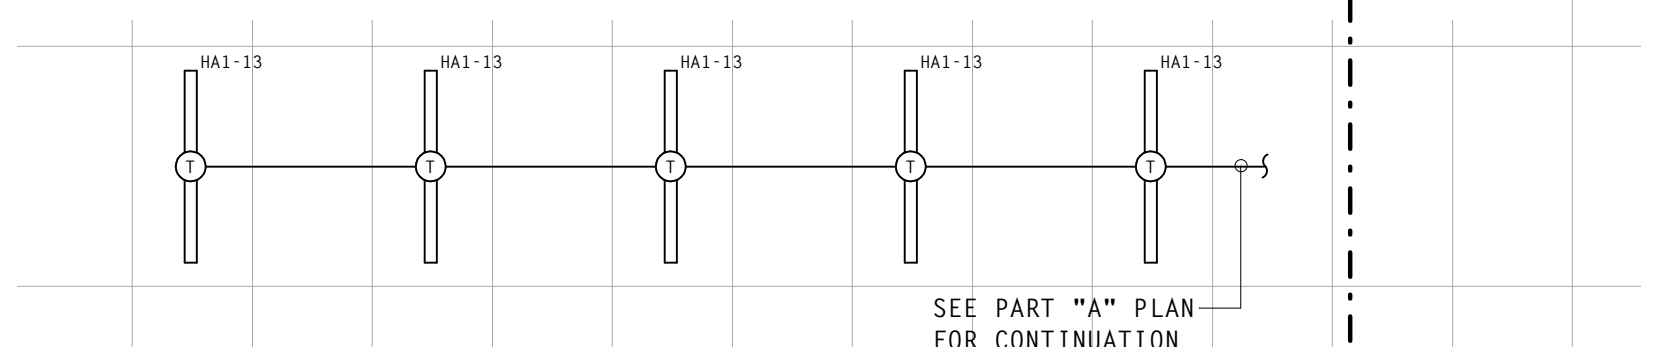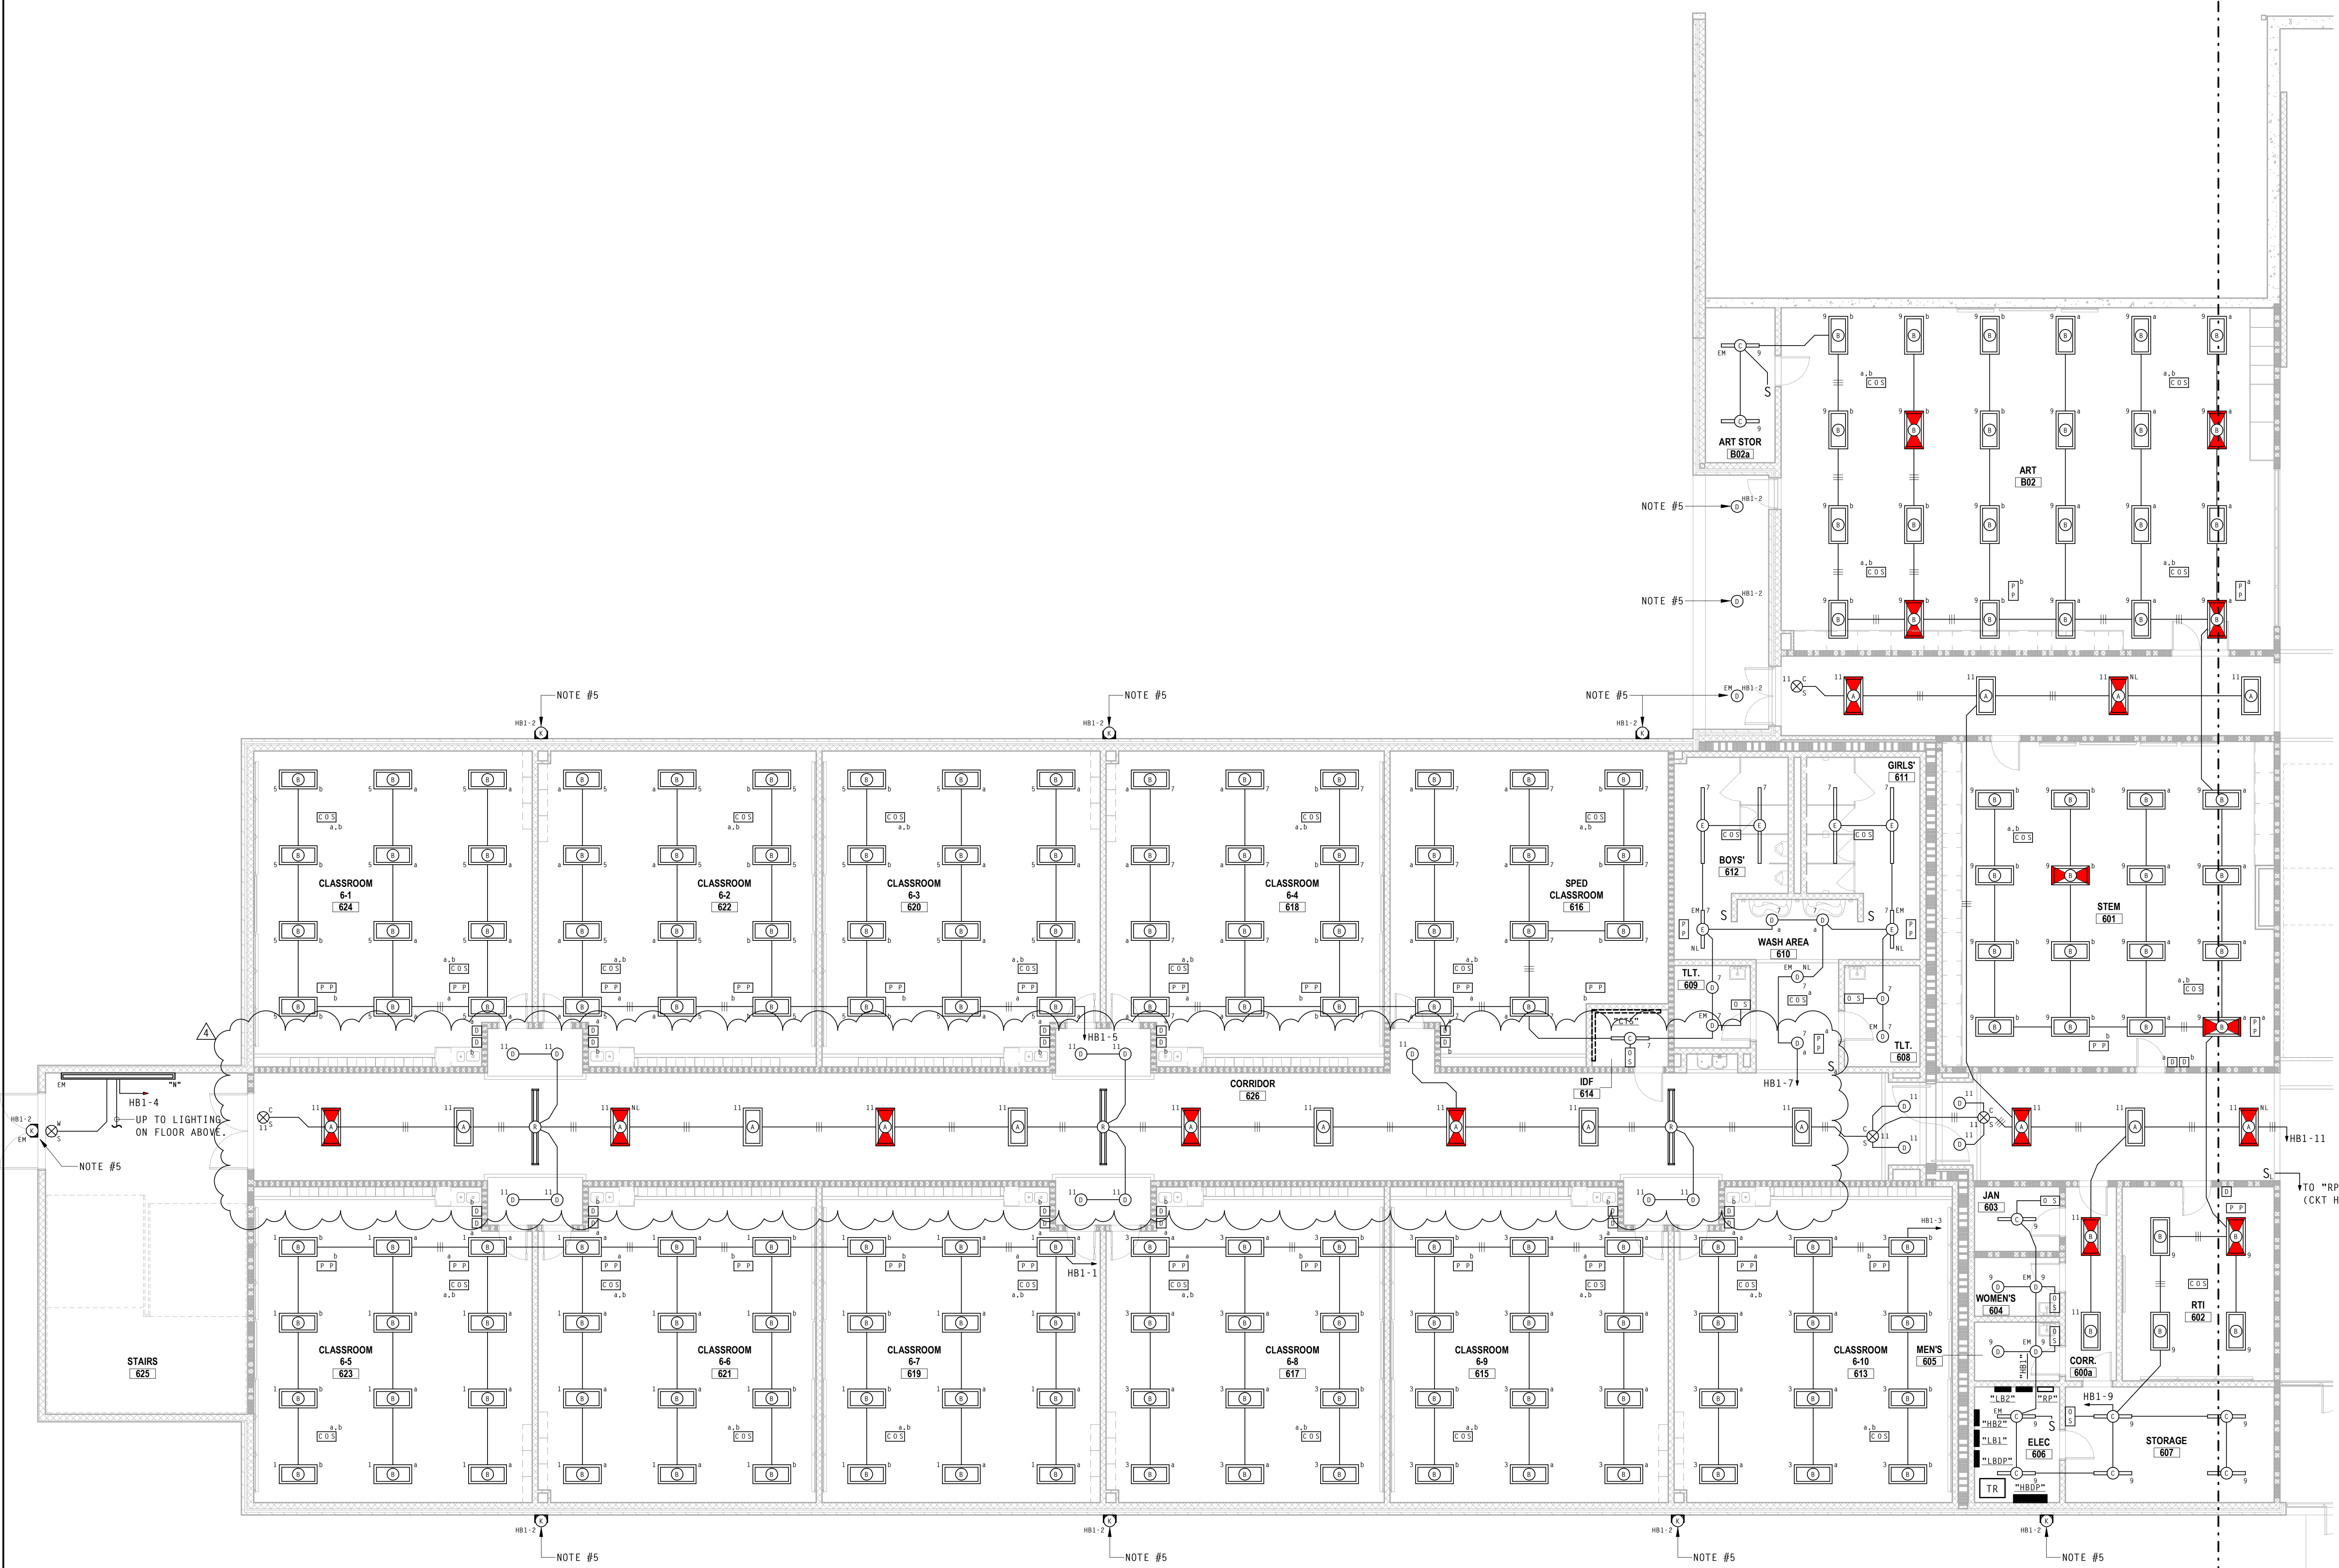



FIRST FLOOR PLAN - AREA 'B' - LIGHTING
 SCALE: 1/8" = 1'-0"

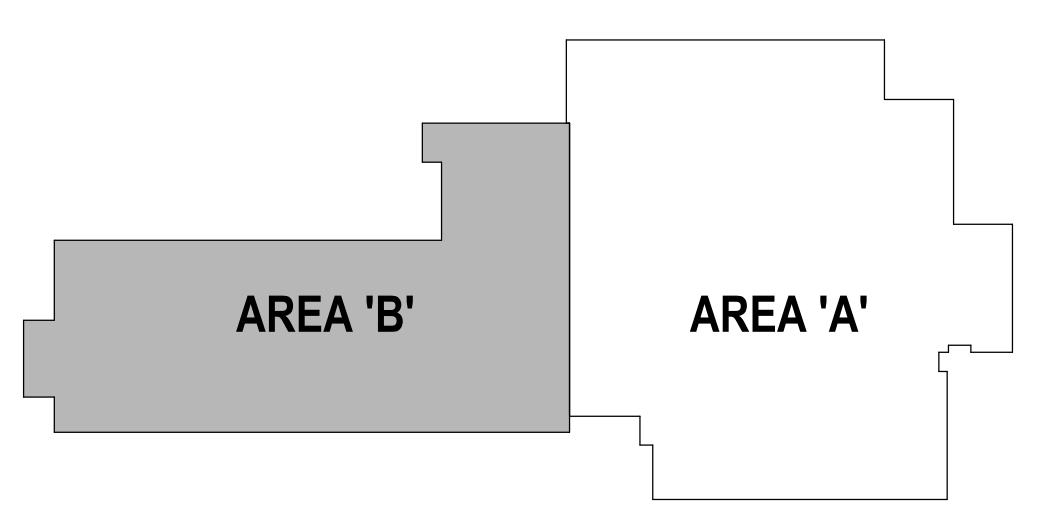

1ST FLOOR KEY MAP - AREA 'B'
 SCALE: 1" = 80'-0"

Vrecland Engineers Inc.
 3127 Suckey Lane Ave.
 P.O. Box 10648
 Knoxville TN, TN, 37939
 PH: (865) 627-4451
 1-800-362-9789
 vrecland@vreecland.com
 VEI Job No. 22116

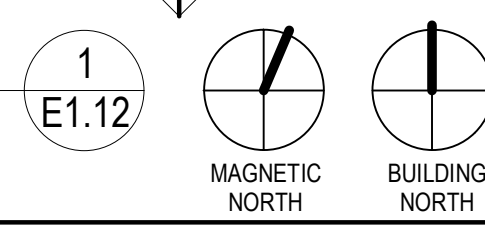

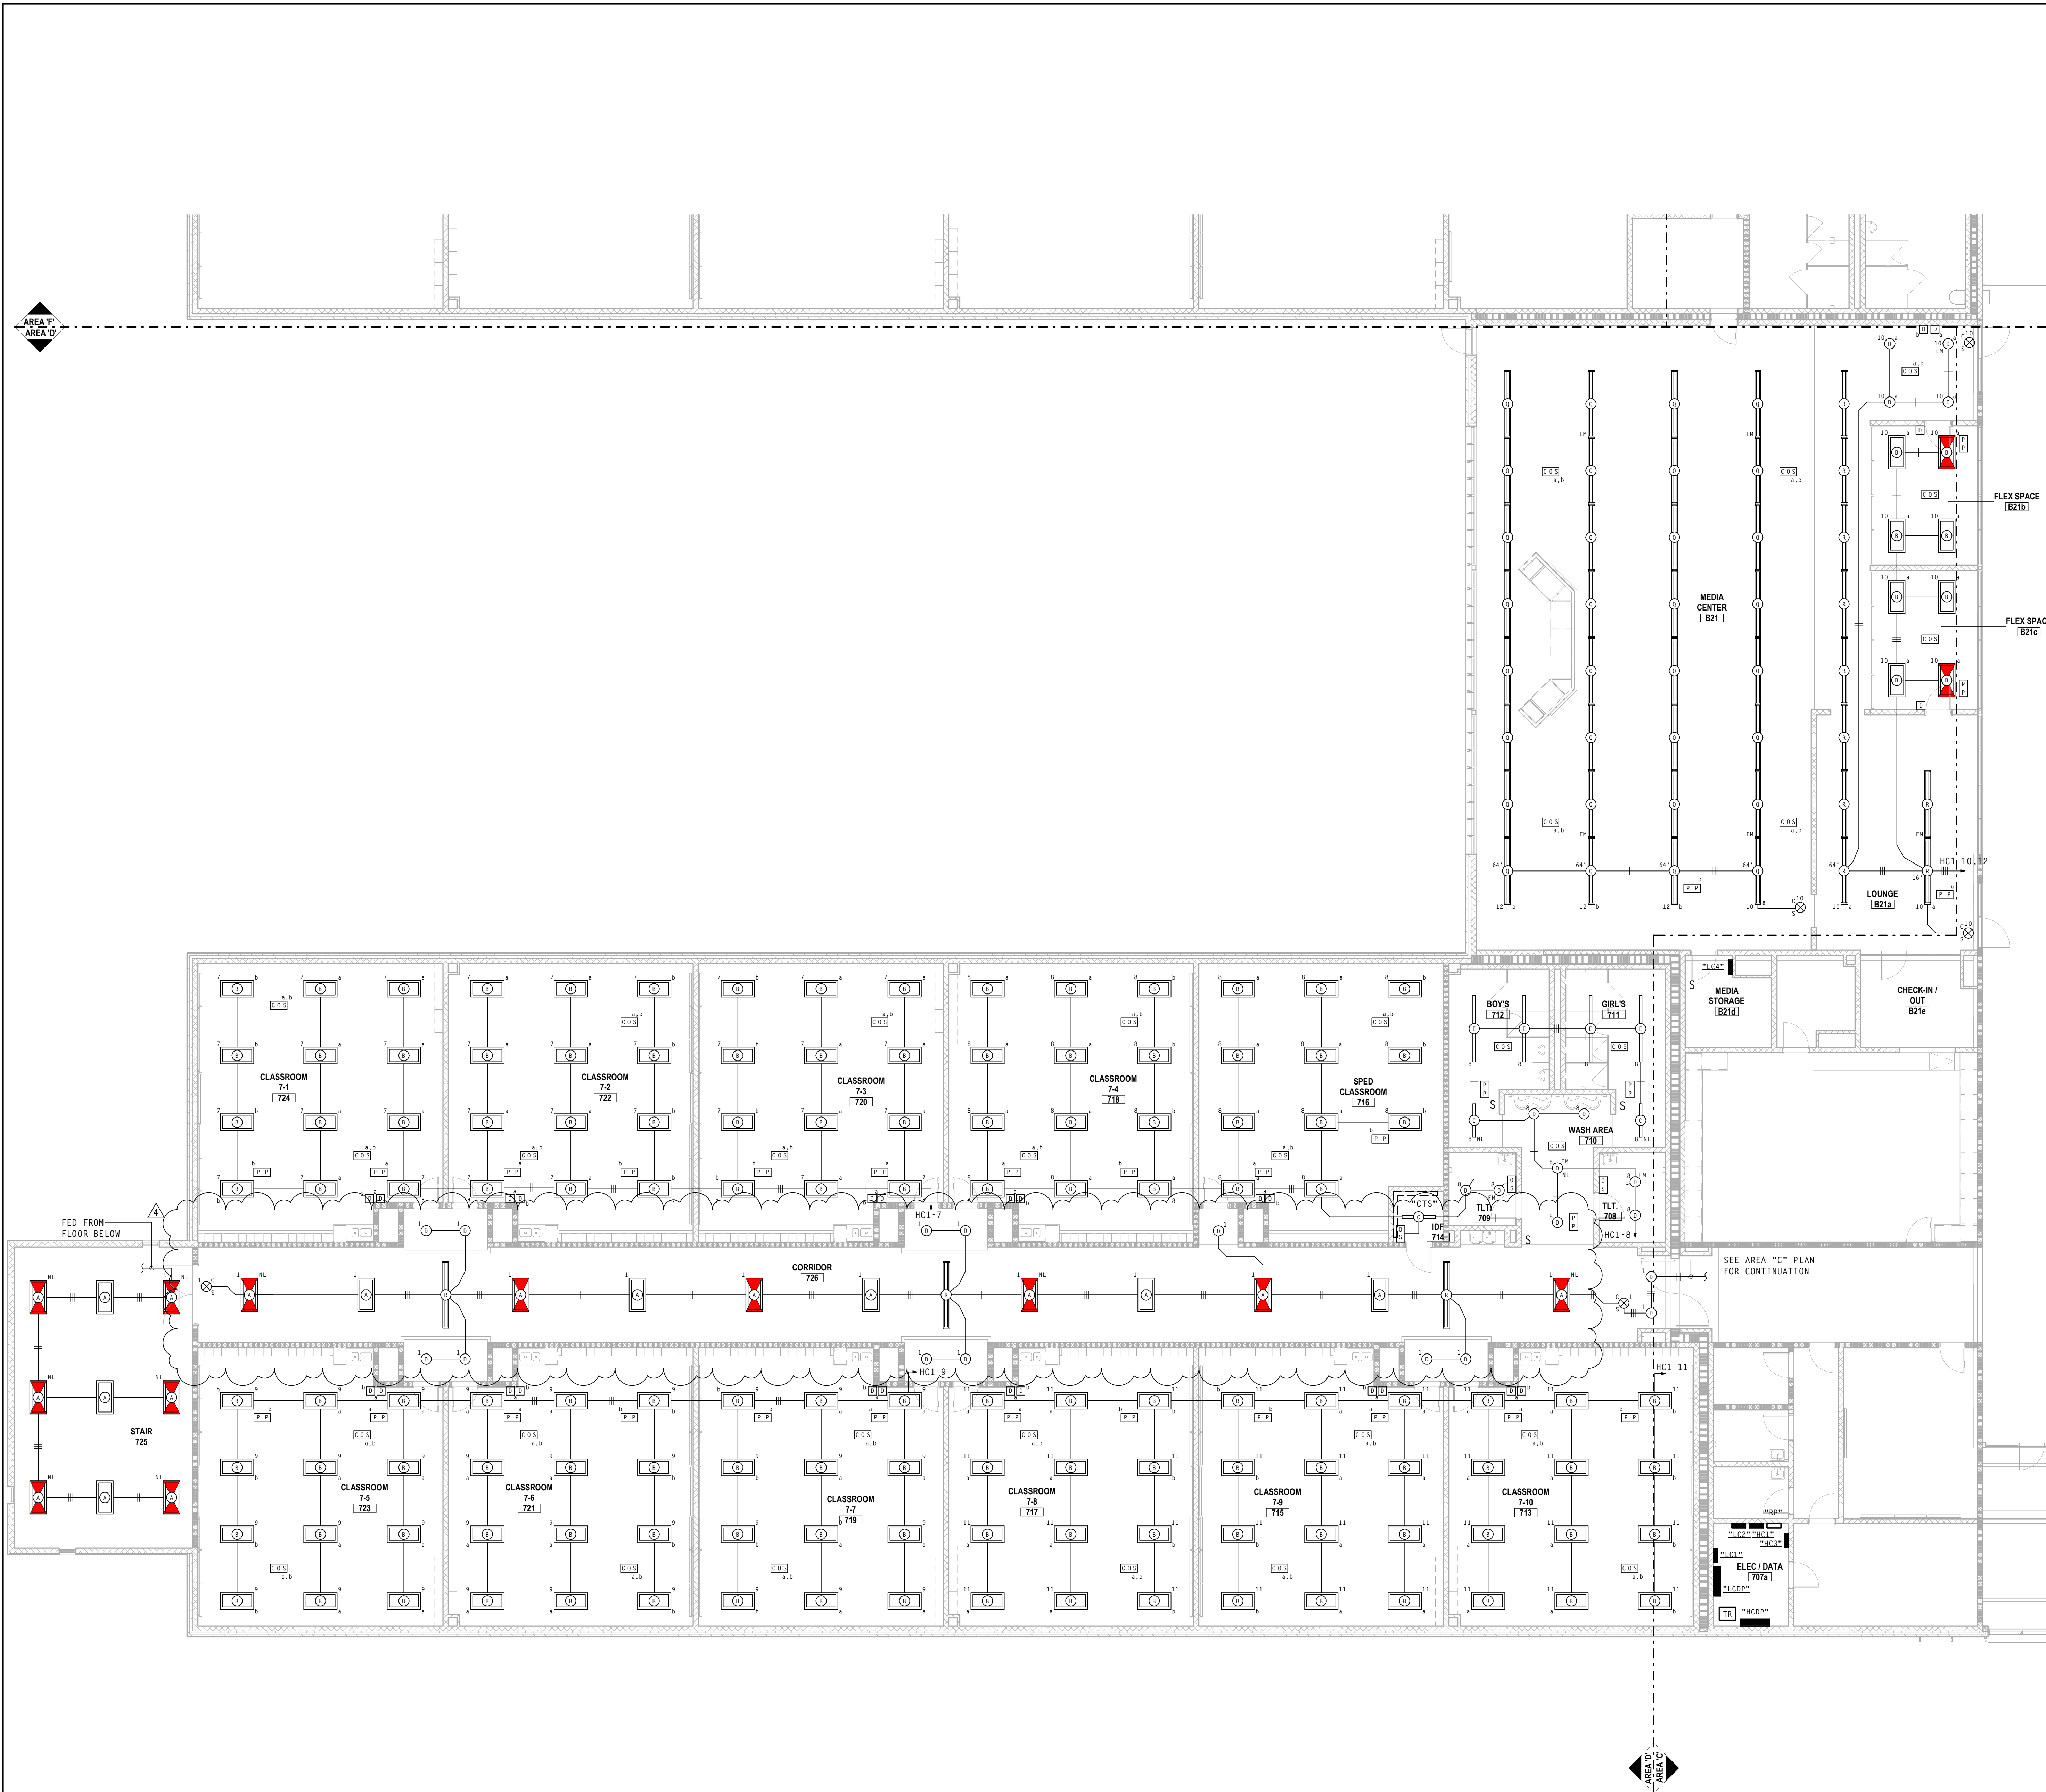

WALL LEGEND

- EXTERIOR WALL
- ONE HOUR FIRE RATED EXTERIOR ASSEMBLY
- NON-RATED PARTITION
- ONE HOUR RATED PARTITION
- SMOKE PARTITION
- ONE HOUR RATED SMOKE BARRIER

CONDUCTOR SIZE TABLE

FOR 20 AMP BRANCH CIRCUITS, THE FOLLOWING ARE THE MAXIMUM ONE-WAY DISTANCES ALLOWED:

CONDUCTOR SIZE	120V	208V/1Ø	208V/3Ø	277V	480V/3Ø
NO. 12	80'	140'	225'	180'	550'
NO. 10	125'	215'	425'	225'	-
NO. 8	195'	340'	665'	435'	-

TABLE IS BASED ON 3% VOLTAGE DROP ON 12.0 F.L.A., 0.85 POWER FACTOR. USE LARGER SIZES IF SPECIFICALLY NOTED ON PLANS.


- VOLTAGE DROP CALCULATION NOTES:**
- REFER TO CONDUCTOR SIZE TABLE FOR WIRE SIZING REQUIREMENTS FOR 20 AMPERE BRANCH CIRCUITS.
 - FOR ALL OTHER FEEDER AND BRANCH CIRCUIT WIRING SHOWN ON DRAWINGS, WIRE SIZING HAS BEEN SPECIFIED TO MEET VOLTAGE DROP REQUIREMENTS AS SET FORTH IN NFPA 70 (NEC) AND IECC C405.9.

- LIGHTING NOTES:**
- REFER TO ARCHITECTURAL REFLECTED CEILING PLAN FOR EXACT LOCATIONS OF ALL LIGHTING FIXTURES.
 - EXIT SIGNS AND BUILT-IN BATTERY PACKS SHALL BE CONNECTED TO LOCAL UNSWITCHED LIGHTING CIRCUITS AS INDICATED ON DRAWINGS.
 - "NL" BY LIGHTING FIXTURE INDICATES FIXTURE TO BE UNSWITCHED "NIGHT LIGHT".
 - "EM" BY LIGHTING FIXTURE INDICATES FIXTURE TO BE EQUIPPED WITH BUILT-IN EMERGENCY BATTERY PACK.
 - WIRING ROUTING TO EXTERIOR LIGHTING FIXTURES NOT SHOWN FOR DRAWING CLARITY. PROVIDE 20 AMPERE BRANCH CIRCUIT INDICATED TO THIS FIXTURE, SIMILAR TO OTHER LIGHTING CIRCUITS SHOWN ON PLANS.

LEWIS GROUP ARCHITECTS
 1 KNOXVILLE, TN | 615.112.0000 | CLEVELAND, TN | 615.444.3711 | PH: 423.776.0012
 info@lewisgroup.net | www.lewisgroup.net



A NEW SCHOOL FACILITY:
HORACE MAYNARD MIDDLE SCHOOL
 UNION COUNTY PUBLIC SCHOOLS
 MAYNARDVILLE, TN

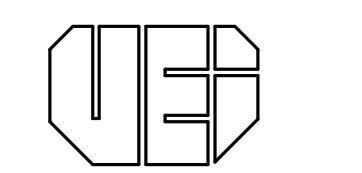


Vrecland Engineers Inc.
 3127 Suckey Lane, Ave.
 P.O. Box 10648
 Knoxville TN, TN, 37939
 PH: (865) 627-4451
 1-800-362-9789
 vrei@andrei.com
 VEI Job No. 22116

DATE: 03/15/2024
 PROJECT NO: 21074
 SBC NO: 540 / 001-05-2023 SP2


PROJECT REVISIONS

#	DATE	DESCRIPTION
1	4-26-24	SFAD COMMENTS
4	6-14-24	ADD 003

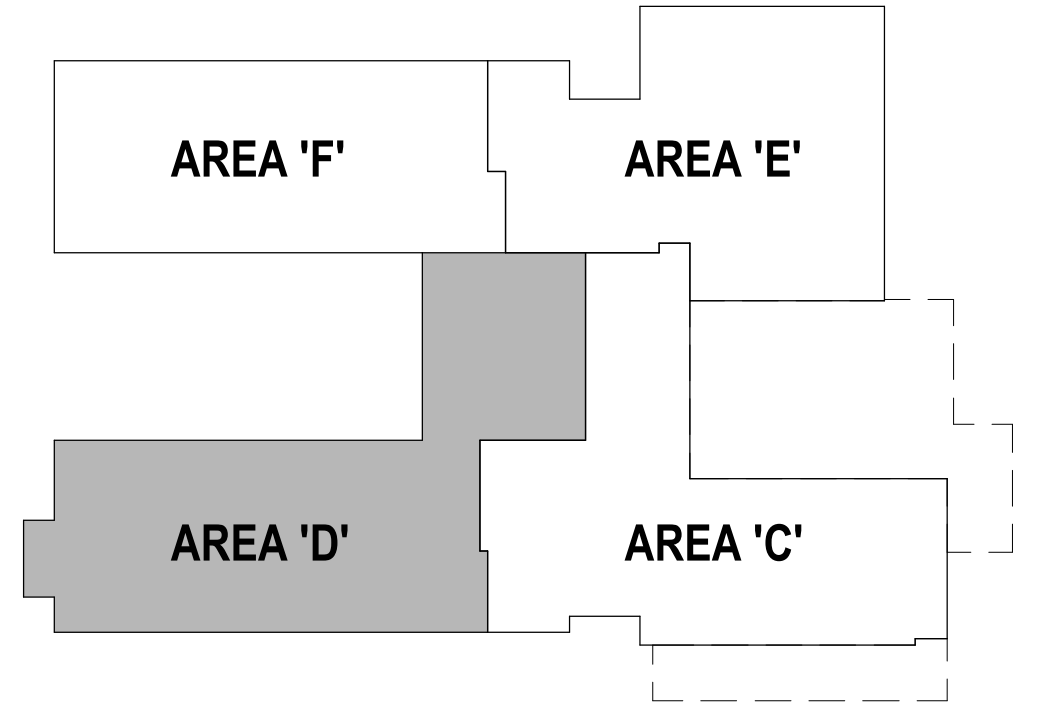

2ND FLOOR KEY MAP - AREA 'D'
 SCALE: 1" = 80'-0"


SECOND FLOOR PLAN - AREA 'D' - LIGHTING
 SCALE: 1/8" = 1'-0"

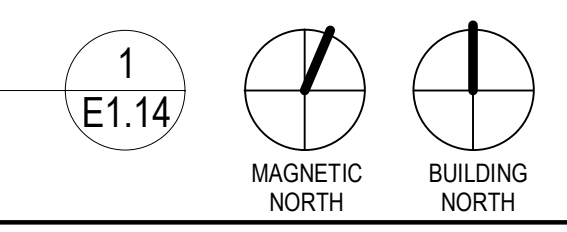

THIS DRAWING IS THE PROPERTY OF THE LEWIS GROUP ARCHITECTS, INC. AND IS TO BE USED ONLY FOR THE PROJECT AND SITE SPECIFICALLY IDENTIFIED HEREIN. THIS DRAWING IS NOT TO BE USED ON ANY OTHER PROJECT WITHOUT THE PROJECT FOR WHICH IT IS MADE OR EXECUTED ON. THIS DRAWING AND ITS CONTENTS ARE THE SOLE POSSESSION OF THE LEWIS GROUP ARCHITECTS, INC. AND SHALL NOT BE UTILIZED IN ANY MANNER WITHOUT THEIR FULL CONSENT. IT IS TO BE RETURNED UPON REQUEST.

SECOND FLOOR PLAN - AREA 'D' - LIGHTING

E1.14

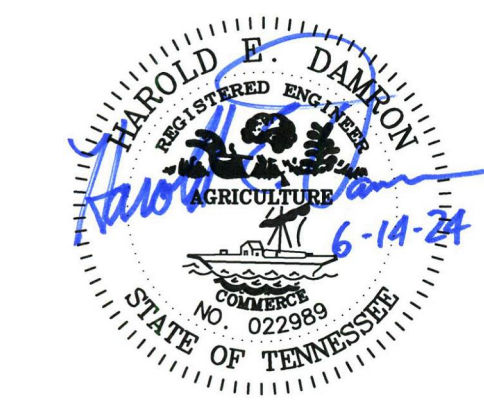

DATE: 03/15/2024
 PROJECT NO: 21074
 SBC NO: 540 / 001-05-2023 SP2

PROJECT REVISIONS

#	DATE	DESCRIPTION
1	4-26-24	SFAD COMMENTS
4	6-14-24	ADD 003

THIS DRAWING IS THE PROPERTY OF THE LEWIS GROUP ARCHITECTS, INC. AND IS TO BE USED ONLY FOR THE PROJECT AND SITE SPECIFICALLY IDENTIFIED HEREIN. THIS DRAWING IS NOT TO BE USED ON ANY OTHER PROJECT WITHOUT THE PROJECT FOR WHICH IT IS MADE OR EXECUTED OR NOT. THIS DRAWING AND ITS CONTENTS ARE THE SOLE POSSESSION OF THE LEWIS GROUP ARCHITECTS, INC. AND SHALL NOT BE UTILIZED IN ANY MANNER WITHOUT THEIR FULL CONSENT. IT IS TO BE RETURNED UPON REQUEST.

SECOND FLOOR PLAN - AREA 'F' - LIGHTING

E1.16

WALL LEGEND

- EXTERIOR WALL
- ONE HOUR FIRE RATED EXTERIOR ASSEMBLY
- NON-RATED PARTITION
- ONE HOUR RATED PARTITION
- SMOKE PARTITION
- ONE HOUR RATED SMOKE BARRIER

CONDUCTOR SIZE TABLE


FOR 20 AMP BRANCH CIRCUITS, THE FOLLOWING ARE THE MAXIMUM ONE-WAY DISTANCES ALLOWED:

CONDUCTOR SIZE	120V	208V/1Ø	208V/3Ø	277V	480V/3Ø
NO. 12	80'	140'	225'	180'	550'
NO. 10	125'	215'	425'	225'	-
NO. 8	195'	340'	665'	435'	-



TABLE IS BASED ON 3% VOLTAGE DROP ON 12.0 F.L.A., 0.85 POWER FACTOR. USE LARGER SIZES IF SPECIFICALLY NOTED ON PLANS.

- VOLTAGE DROP CALCULATION NOTES:**
- REFER TO CONDUCTOR SIZE TABLE FOR WIRE SIZING REQUIREMENTS FOR 20 AMPERE BRANCH CIRCUITS.
 - FOR ALL OTHER FEEDER AND BRANCH CIRCUIT WIRING SHOWN ON DRAWINGS, WIRE SIZING HAS BEEN SPECIFIED TO MEET VOLTAGE DROP REQUIREMENTS AS SET FORTH IN NFPA 70 (NEC) AND IECC C405.9.


- LIGHTING NOTES:**
- REFER TO ARCHITECTURAL REFLECTED CEILING PLAN FOR EXACT LOCATIONS OF ALL LIGHTING FIXTURES.
 - EXIT SIGNS AND BUILT-IN BATTERY PACKS SHALL BE CONNECTED TO LOCAL UNSWITCHED LIGHTING CIRCUITS AS INDICATED ON DRAWINGS.
 - "NL" BY LIGHTING FIXTURE INDICATES FIXTURE TO BE UNSWITCHED "NIGHT LIGHT".
 - "EM" BY LIGHTING FIXTURE INDICATES FIXTURE TO BE EQUIPPED WITH BUILT-IN EMERGENCY BATTERY PACK.
 - WIRING ROUTING TO EXTERIOR LIGHTING FIXTURES NOT SHOWN FOR DRAWING CLARITY. PROVIDE 20 AMPERE BRANCH CIRCUIT INDICATED TO THIS FIXTURE, SIMILAR TO OTHER LIGHTING CIRCUITS SHOWN ON PLANS.
 - ROUTE LIGHTING CIRCUITS HE1-9, 32, 34, AND 36 THROUGH RELAY PANEL. SEE SITE ELECTRICAL PLAN FOR CIRCUITS 32, 34, 36. PROVIDE A SEPARATE UNSWITCHED "HOT" CONDUCTOR (I.E. BYPASSING RELAY PANEL) FOR CIRCUIT HE1-9 TO ALLOW NORMAL SWITCHING OF THIS CIRCUIT VIA RELAY PANEL WITH DISCHARGING BATTERIES.

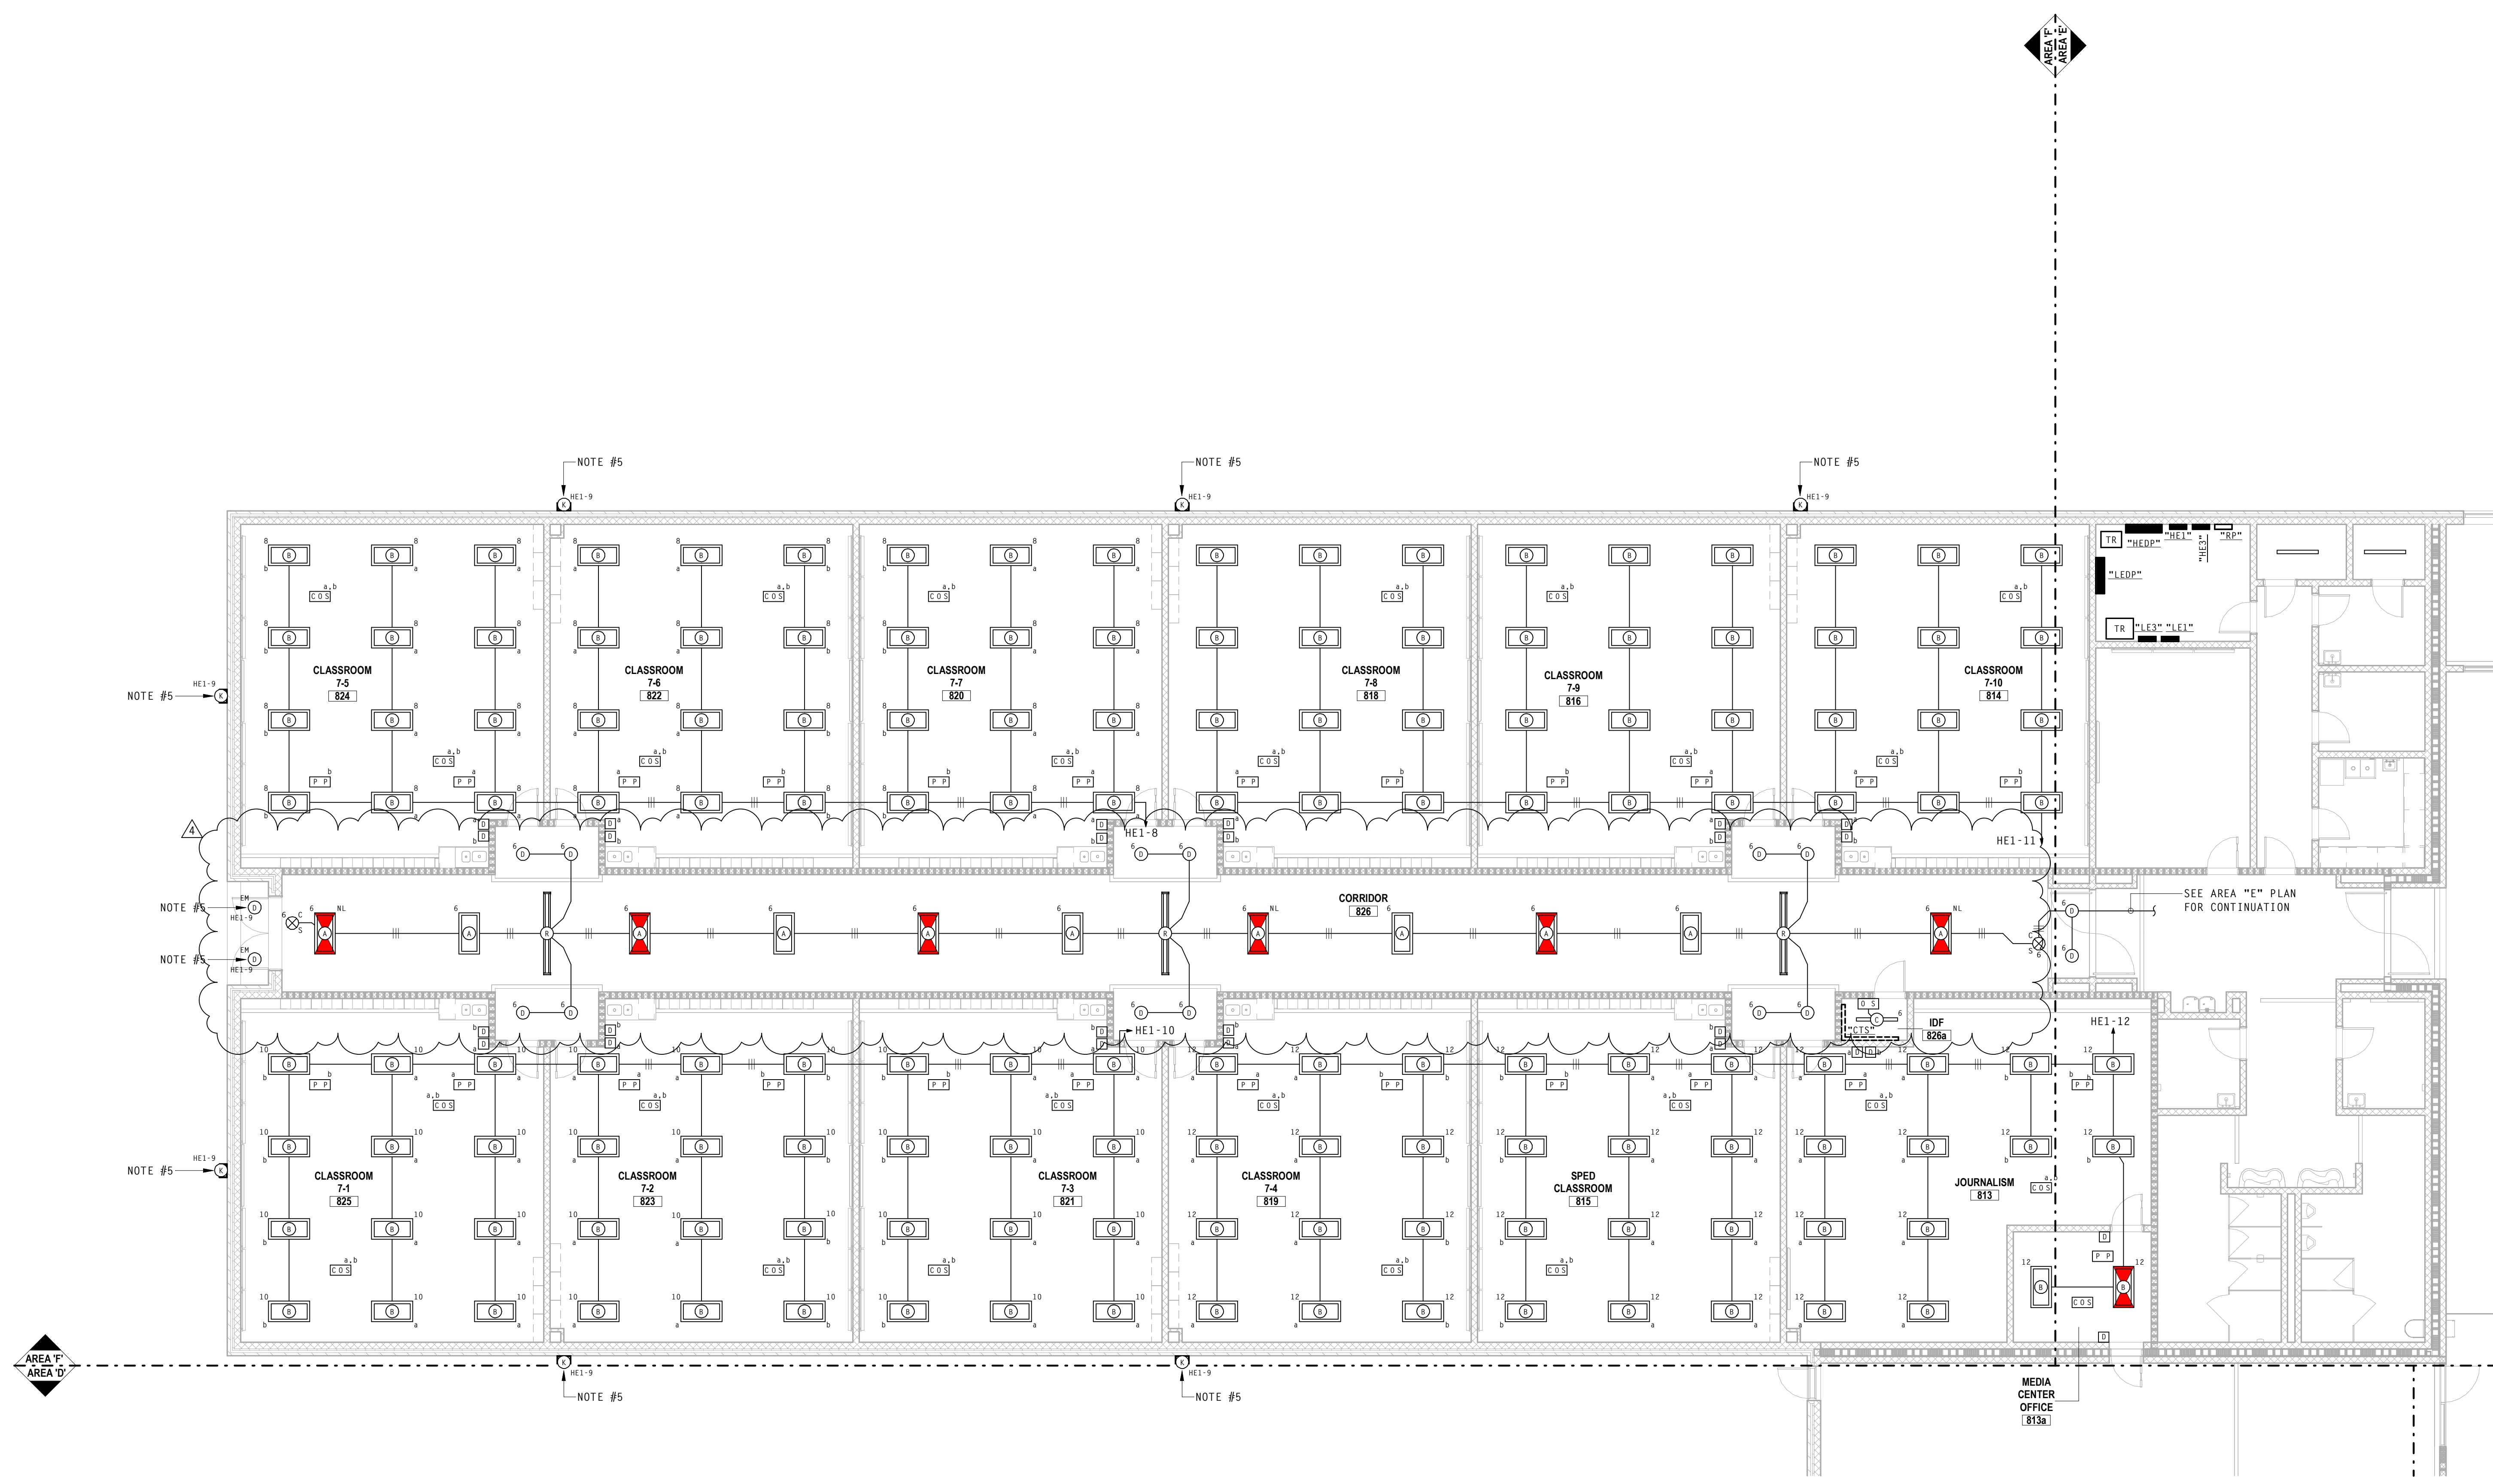


SECOND FLOOR PLAN - AREA 'F' - LIGHTING
 SCALE: 1/8" = 1'-0"

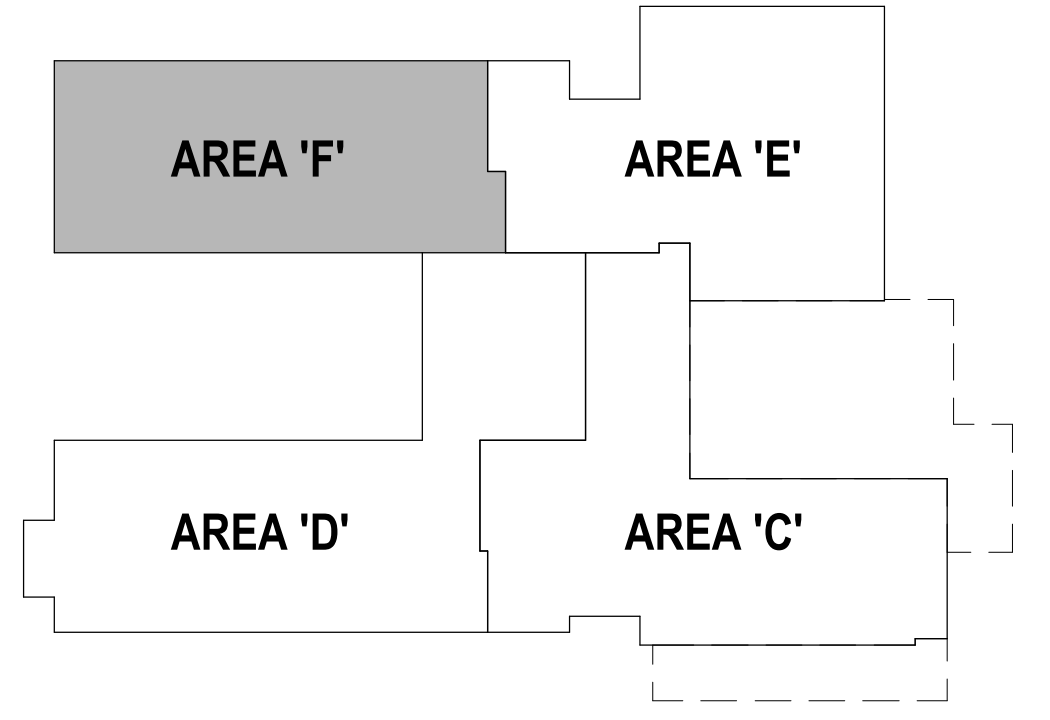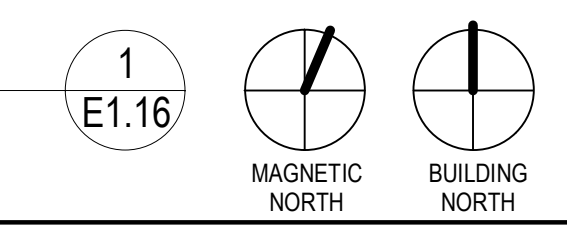

2ND FLOOR KEY MAP - AREA 'F'
 SCALE: 1" = 80'-0"

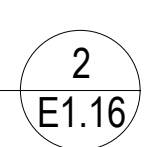

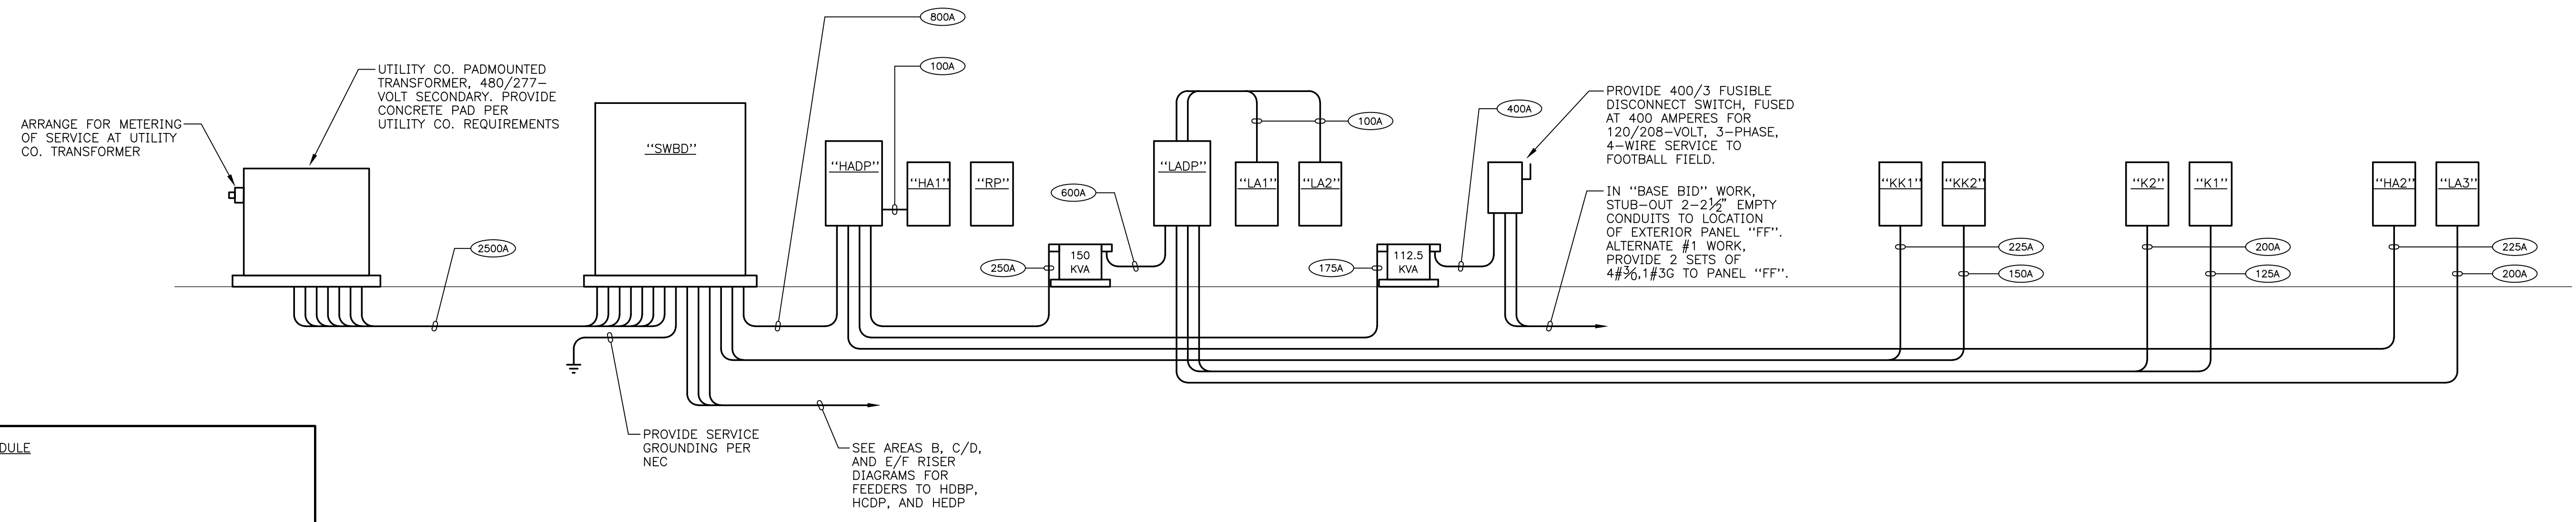

AREA "A" RISER DIAGRAM
N.T.S.

FEEDER WIRING SCHEDULE

RISER NOTATION	WIRING REQUIREMENTS
100A	1-1/2", 4#2, 1#8 G.
125A	2" 4#1, 1#6 G.
150A	2", 4#1/0, 1#6 G.
175A	2", 4#2/0, 1#6 G.
200A	2", 4#3/0, 1#6 G.
225A	2-1/2", 4#4/0, 1#4 G.
250A	2-1/2", 4#250 MCM, 1#4 G.
300A	3", 4#350 MCM, 1#4 G.
400A	3-1/2", 4#500 MCM, 1#3 G.
600A	2, 3-1/2", EACH WITH 4#350 MCM, 1#1 G.
800A	2, 3-1/2", EACH WITH 4#500 MCM, 1#1/0 G.
1000A	3, 3-1/2", EACH WITH 4#400 MCM, 1#2/0 G.

FEEDER WIRING NOTES:

- CONDUIT AND CONDUCTOR SIZES NOTED ABOVE ARE BASED UPON USING THHN/THWN COPPER CONDUCTORS.
- FEEDERS TO PRIMARY SIDE OF DRY-TYPE TRANSFORMERS (480-VOLT, 3-PHASE TO 120/208-VOLT, 3-PHASE, 4-WIRE) SHALL NOT REQUIRE NEUTRAL CONDUCTOR.

SERVICE WIRING SCHEDULE

RISER NOTATION	WIRING REQUIREMENTS
2500A	7-3 1/2", EACH WITH 4#500 MCM

SERVICE WIRING NOTES:


- CONDUIT AND CONDUCTOR SIZES NOTED ABOVE ARE BASED UPON USING THHN/THWN COPPER CONDUCTORS.

DRY-TYPE TRANSFORMER SECONDARY WIRING SCHEDULE


KVA RATING	AMPERE SIZE	WIRING REQUIREMENTS
75	250A	3", 4#250 MCM, 1#2 G.
112.5 KVA	400A	4", 4#600 MCM, 1#1/0 G.
150 KVA	600A	2-3 1/2", EACH WITH 4#350 MCM, 1#2/0 G.

DRY-TYPE TRANSFORMER SECONDARY WIRING NOTES:


- CONDUIT AND CONDUCTOR SIZES NOTED ABOVE ARE BASED UPON USING THHN/THWN COPPER CONDUCTORS.

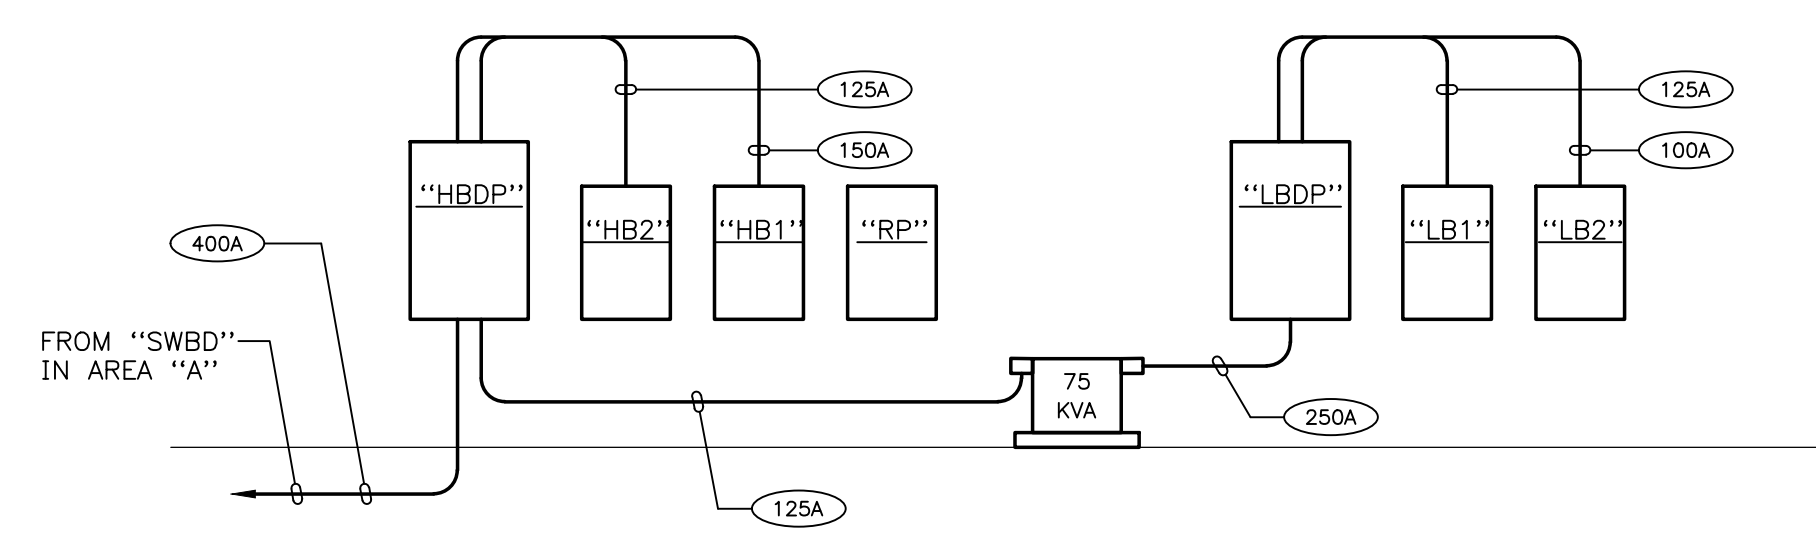


AREA "B" RISER DIAGRAM
N.T.S.

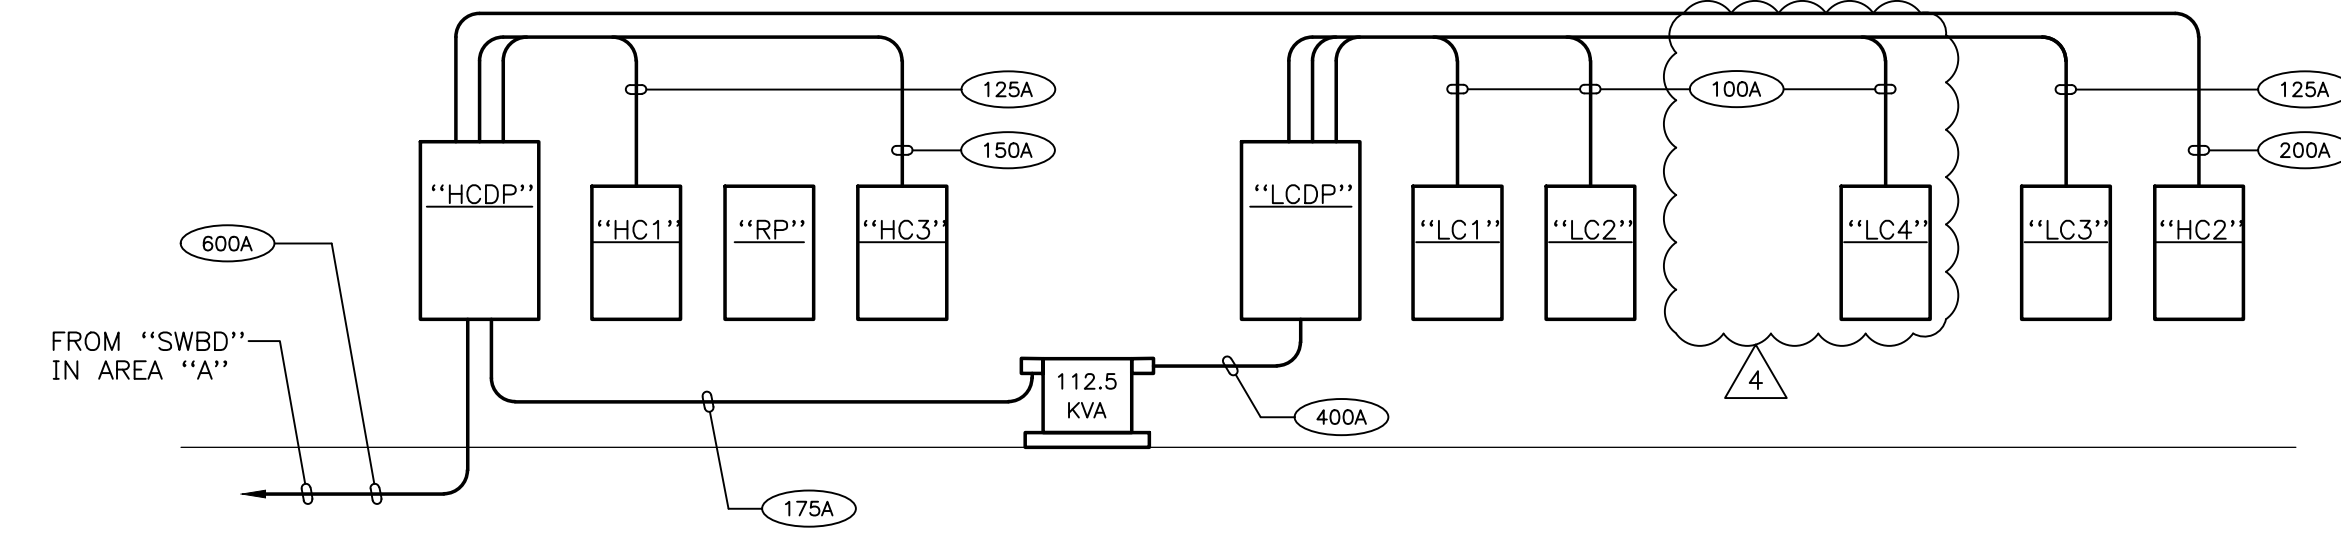

AREA "C/D" RISER DIAGRAM
N.T.S.

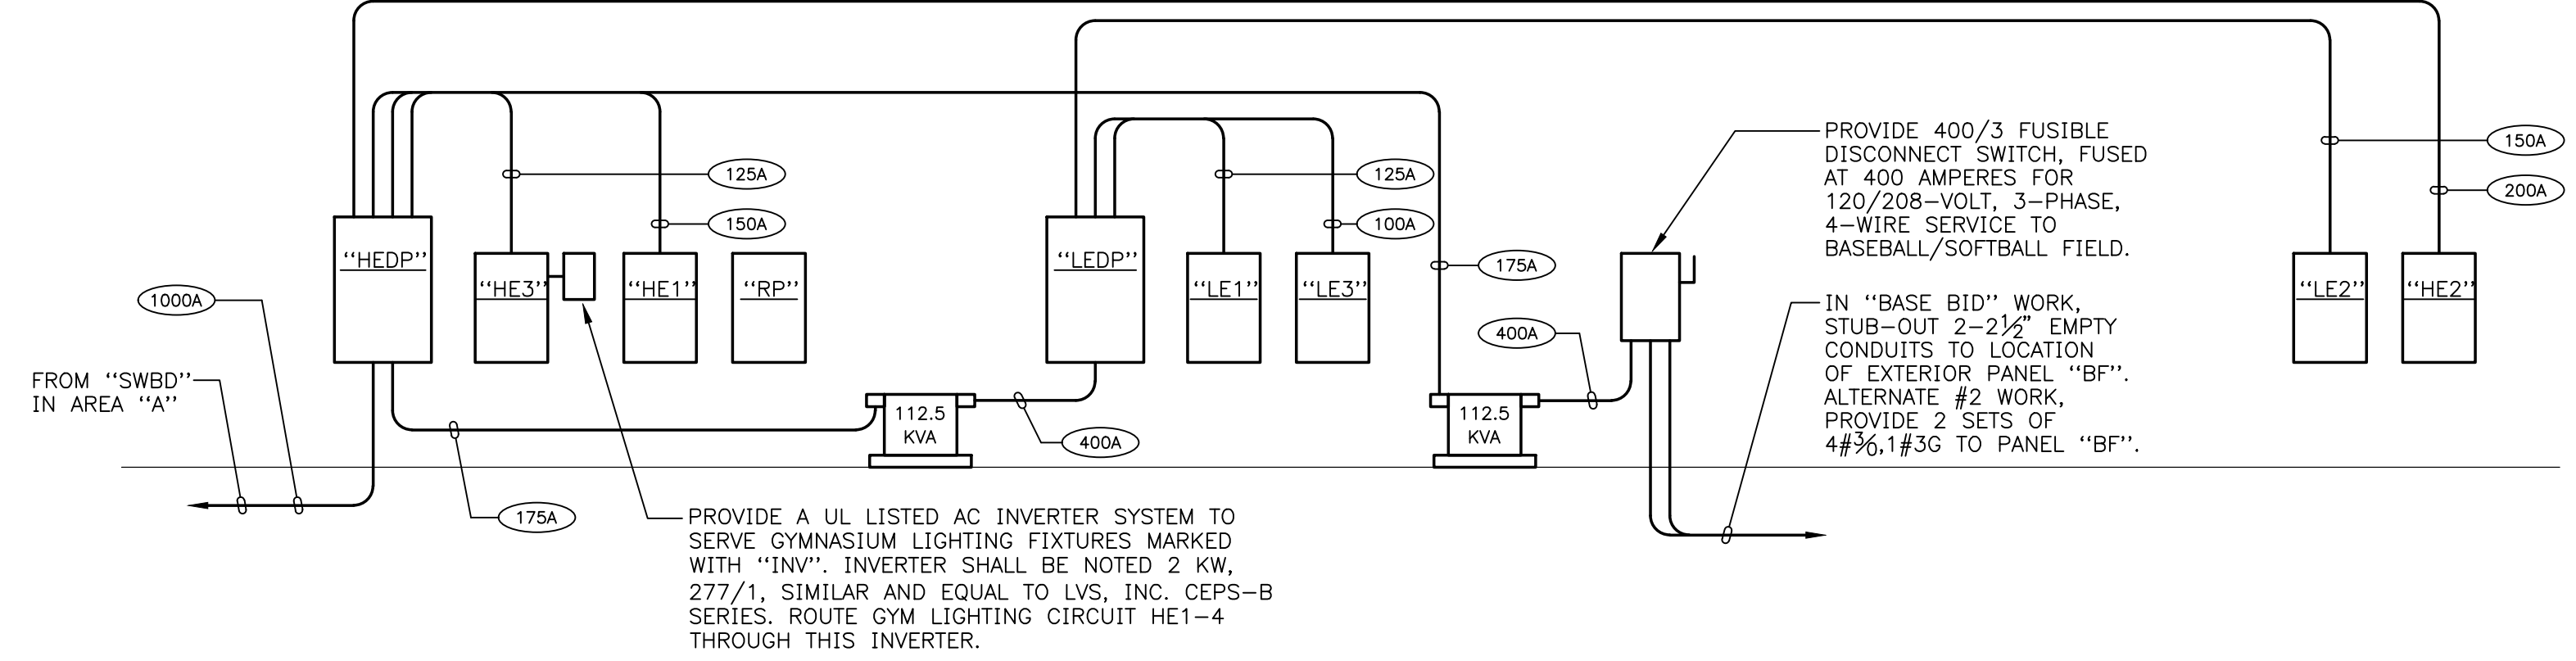


AREA "E/F" RISER DIAGRAM
N.T.S.

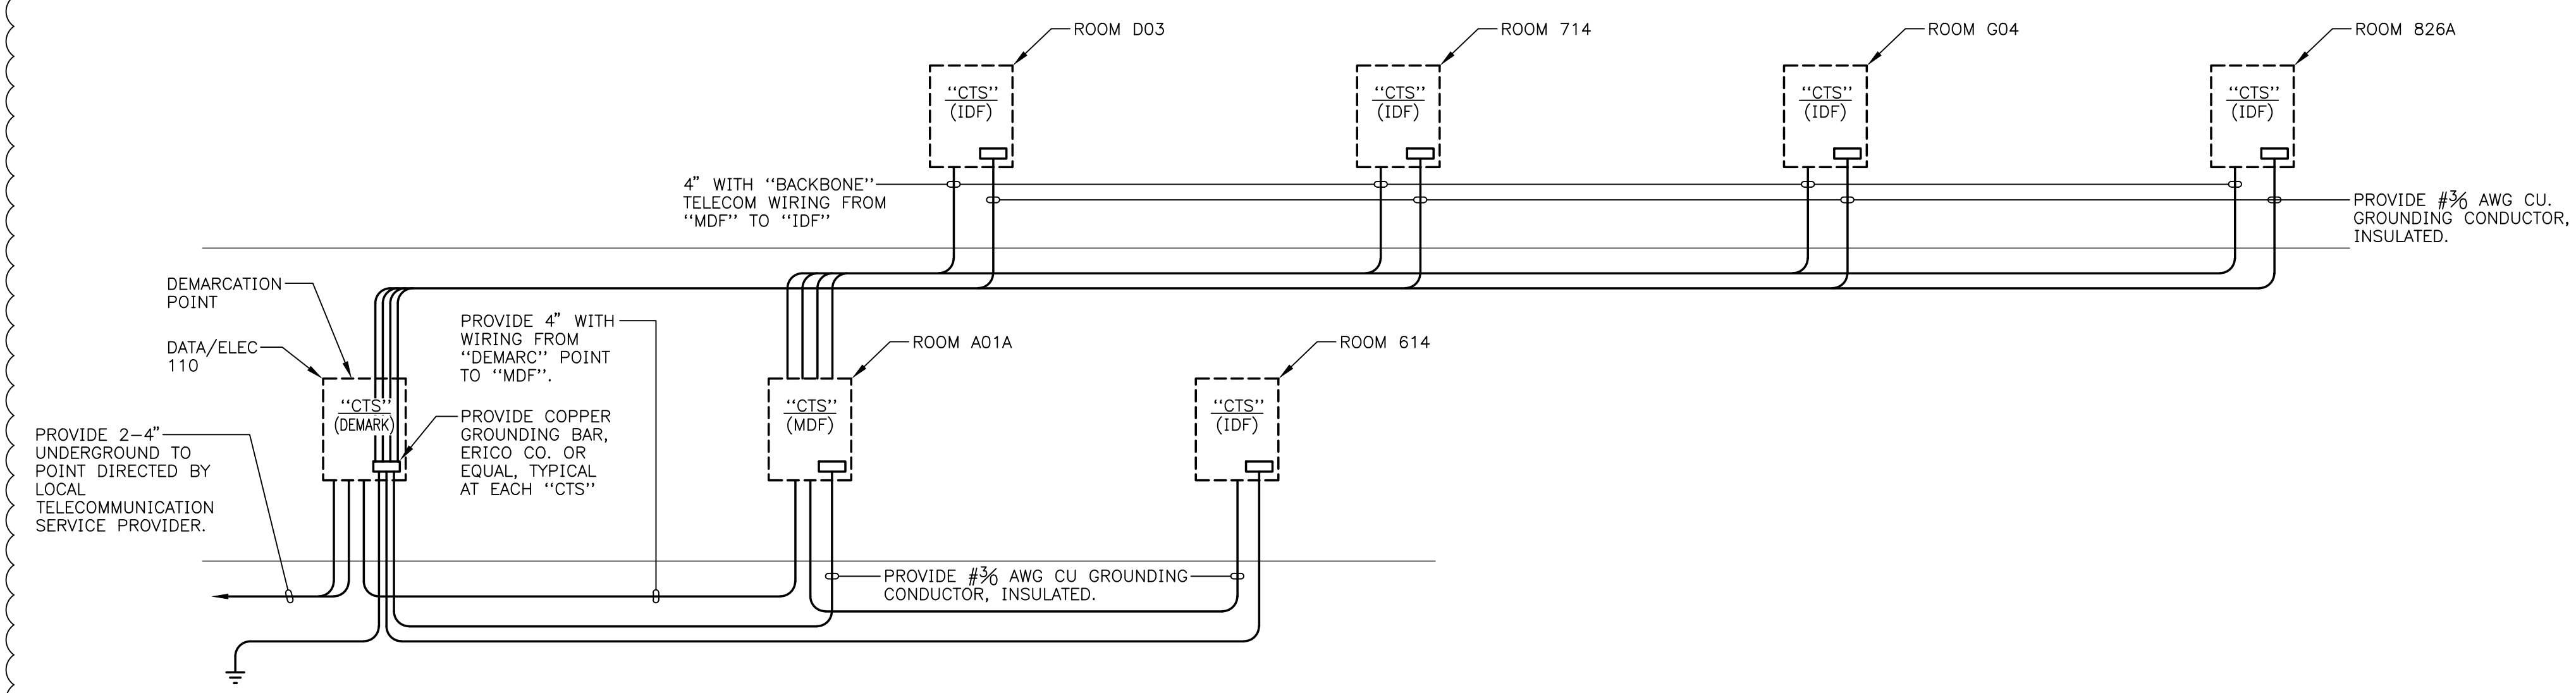

COMMUNICATIONS RISER DIAGRAM
N.T.S.

BACKBONE WIRING SCHEDULE:

- PROVIDE BACKBONE WIRING AS SET FORTH HEREINAFTER:
 - DEMARC "CTS" TO "MDF" - 24 STRAND MM FIBER, 50/125, OM3, 50 PAIR CAT 3 TRUNK TELEPHONE CABLE, RG-500 COAXIAL TRUNK LINE.
 - MDF TO EACH IDF: 12 STRAND MM FIBER, 50/125, OM3, 25 PAIR CAT 3 TRUNK TELEPHONE CABLE, INTERCOM AND SECURITY HOMERUN "BACKBONE" WIRING.

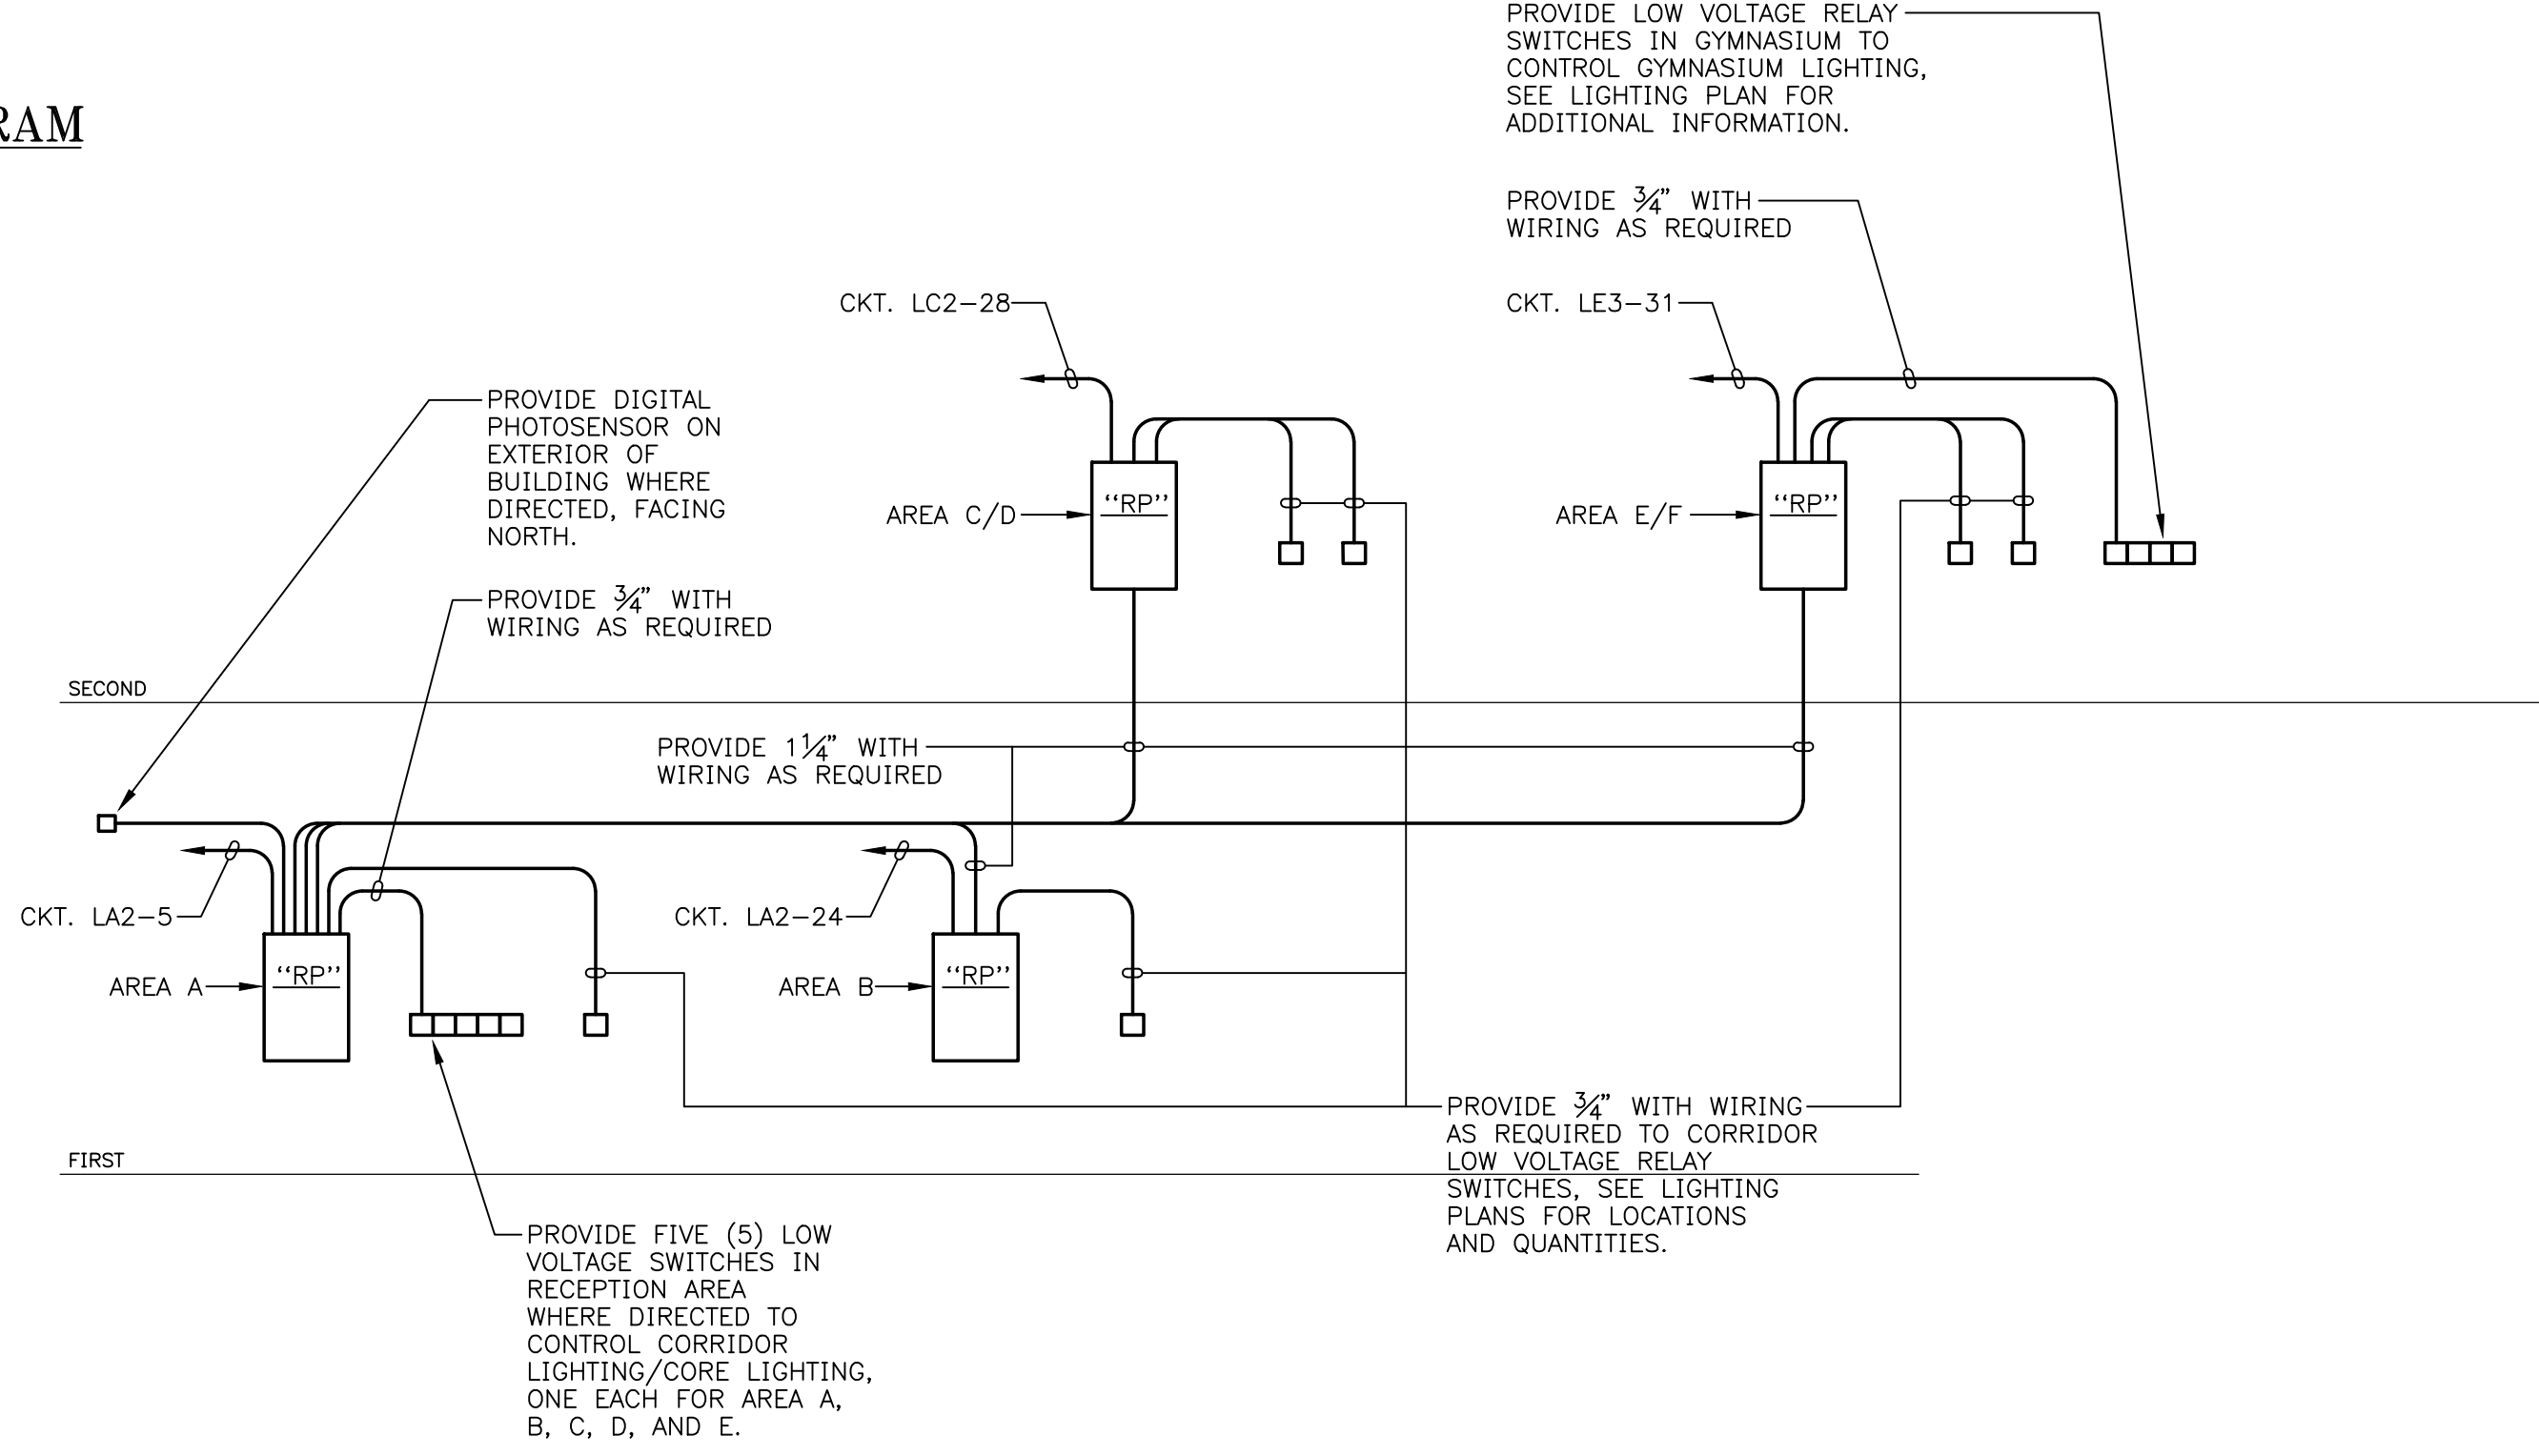

LIGHTING CONTROL RISER DIAGRAM
N.T.S.

RELAY PANEL SPECIFICATIONS

- FURNISH AND INSTALL SOLID STATE PROGRAMMABLE LOW VOLTAGE LIGHTING CONTROL RELAY PANELS WITH BUILT-IN 365 DAY ASTRONOMIC TIME SWITCH AS INDICATED ON DRAWINGS AND AS SET FORTH HEREINAFTER. "MASTER" RELAY PANEL SHALL BE LOCATED IN AREA A AND SHALL BE SIMILAR AND EQUAL TO ACUTY NLIGHT ARP SERIES PANEL CONTAINING SIXTEEN(16) RELAYS. OTHER RELAY PANELS INDICATED SHALL OPERATE AS "SLAVE" PANELS AND SHALL BE ACUTY NLIGHT ARP SERIES AS NOTED ON DRAWINGS, WITH RELAY QUANTITIES AS REQUIRED, WITH EACH RELAY PANEL HAVING A MINIMUM OF EIGHT RELAYS.
- INSTALLATION OF LIGHTING CONTROL SYSTEM SHALL BE IN STRICT ACCORDANCE WITH MANUFACTURE'S INSTRUCTIONS. PROVIDE FULL PROGRAMMING OF SYSTEM AND TRAINING OF OWNER'S DESIGNATED REPRESENTATIVE ON SITE BY AUTHORIZED SYSTEM TECHNICIAN.

E6.13 Union County Middle School - Feeder Diagram.dwg
J.E.D. 06/12/24 11:40 AM HD19394r(HD)




DATE: 09/15/2024
 PROJECT NO: 21074
 SBC NO: 540 / 001-05-2023 SP2

PROJECT REVISIONS

DATE	DESCRIPTION
2 5-31-24	ADD 001
4 6-14-24	ADD 003

THIS DRAWING IS THE PROPERTY OF THE LEWIS GROUP ARCHITECTS, INC. AND IS TO BE USED ONLY FOR THE PROJECT AND SITE SPECIFICALLY IDENTIFIED HEREIN. THIS DRAWING IS NOT TO BE USED ON ANY OTHER PROJECT WITHOUT THE WRITTEN PERMISSION OF THE LEWIS GROUP ARCHITECTS, INC. AND SHALL NOT BE REPRODUCED OR TRANSMITTED IN ANY FORM OR BY ANY MEANS, ELECTRONIC OR MECHANICAL, INCLUDING PHOTOCOPYING, RECORDING, OR BY ANY INFORMATION STORAGE AND RETRIEVAL SYSTEM.

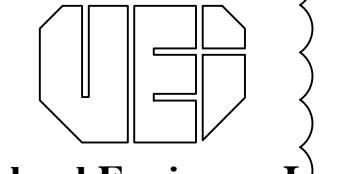

Vrecland Engineers Inc.
 3107 Sutherland Ave.
 P. O. Box 10648
 Knoxville, TN 37939
 PH: (865) 337-4481
 F: (865) 362-9199
 VEI Job No. 22116