



## **Pond Cleaning and Concrete Bottoms for Water Treatment Plant (WTP)**

**Project #1602**

**3/29/2018**

### **ADDENDUM no. 1**

#### **Corrections, Notes and Clarifications**

1. Correction to page 3 of RFB.

“...qualified ~~landscape~~ general contractor for the ~~median landscaping~~ pond cleaning and concrete bottom at WTP project”.

2. Correction to page 5 of RFB

“... On or before the deadline, 2:00 pm, ~~Wednesday, April 2nd~~, Thursday, April 5<sup>th</sup>, 2018 EST (local time)

3. Contract sample added to bid documents.

4. Contractor will be allowed to dispose sludge at City’s Waste Water Treatment Plant at no cost to the Contractor besides hauling. Contractor is to coordinate with City staff for plant access and hours of operation.

5. The lagoons are active and used to dump backwash water. Work must be performed in two stages dealing with Ponds 1 and 3 first and then Ponds 2 and 4 or vice versa. WTP facility will require one sludge lagoon and one backwash lagoon to remain in operation at all times during the construction period.


6. Contractor duration time has been changed to 60 calendar days from Notice to Proceed (NTP). Bid Form document has been revised to reflect this change.

7. There is no Payment and Performance Bond required on this project as noted on Item 18, Page 9 of RFB.


8. There are no Liquidated Damages on this project.

9. Revisions to plan view and section detail drawings to add saw cut contraction joints (CJ) on slab, geotextile fabric at bottom of #57 crushed stone and joint filler between existing concrete lining and new 6-in. slab. See attached drawing sheet 1 and 2.

# Plan View

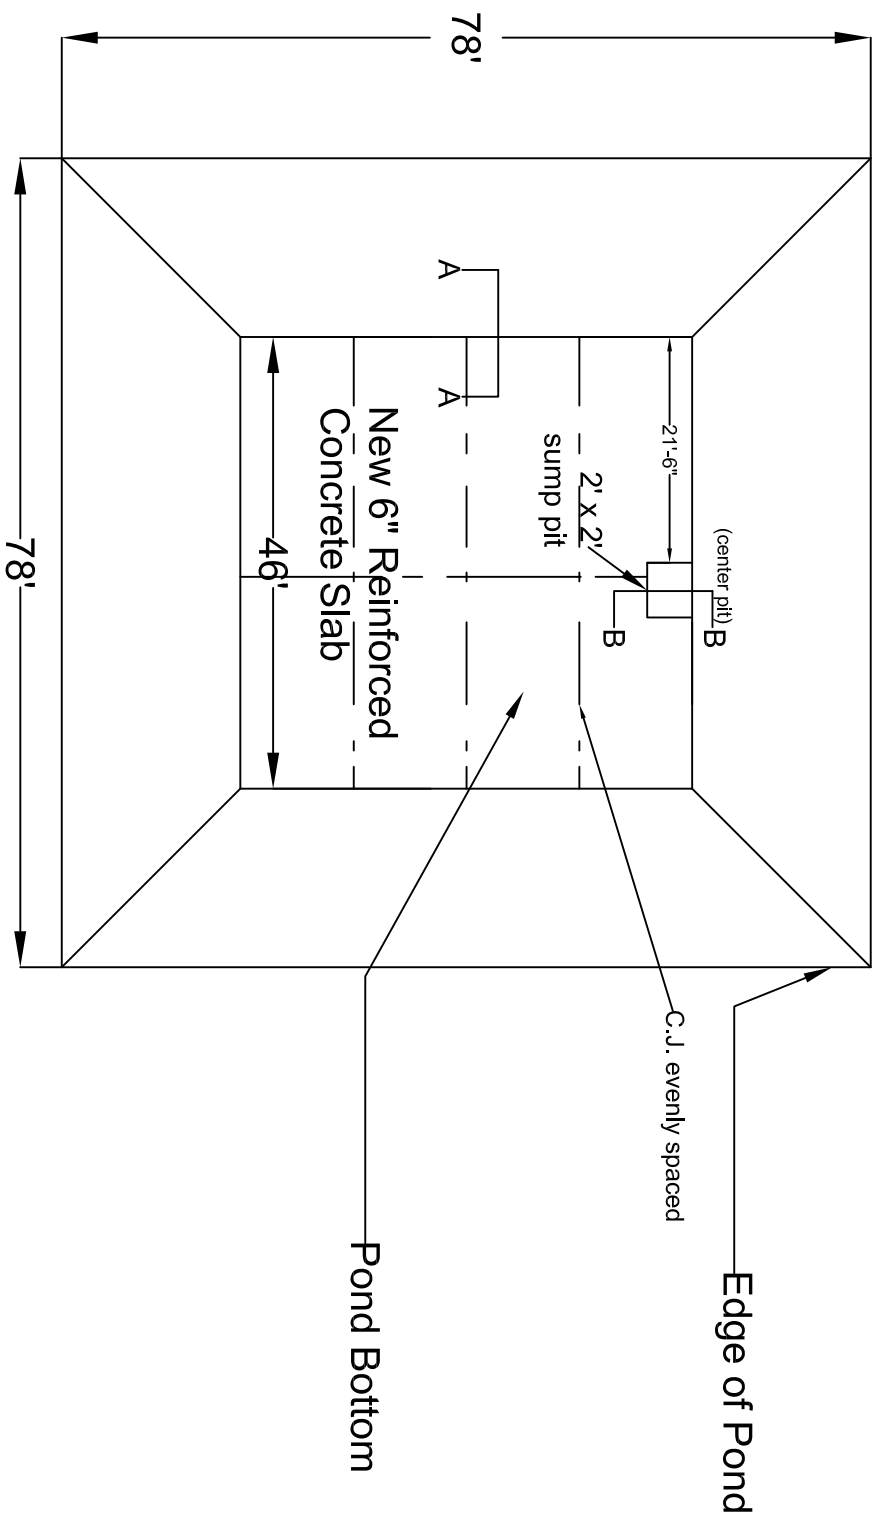

## Slab Detail

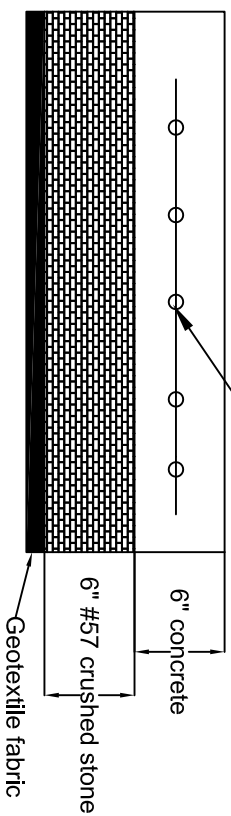

#4 @ 16" Both Directions

6" concrete

6" #57 crushed stone

Geotextile fabric


WTP Ponds 1 & 2 Backwash Lagoon

Scale: Not to Scale


Drawn By: Justin Mooney 3/16/18

Sheet: 1 of 2

# Section Detail A-A

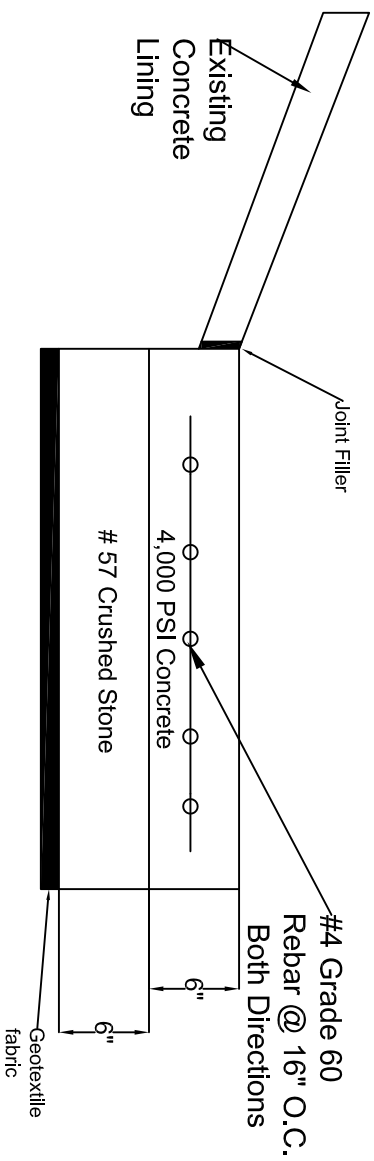

# Section Detail B-B

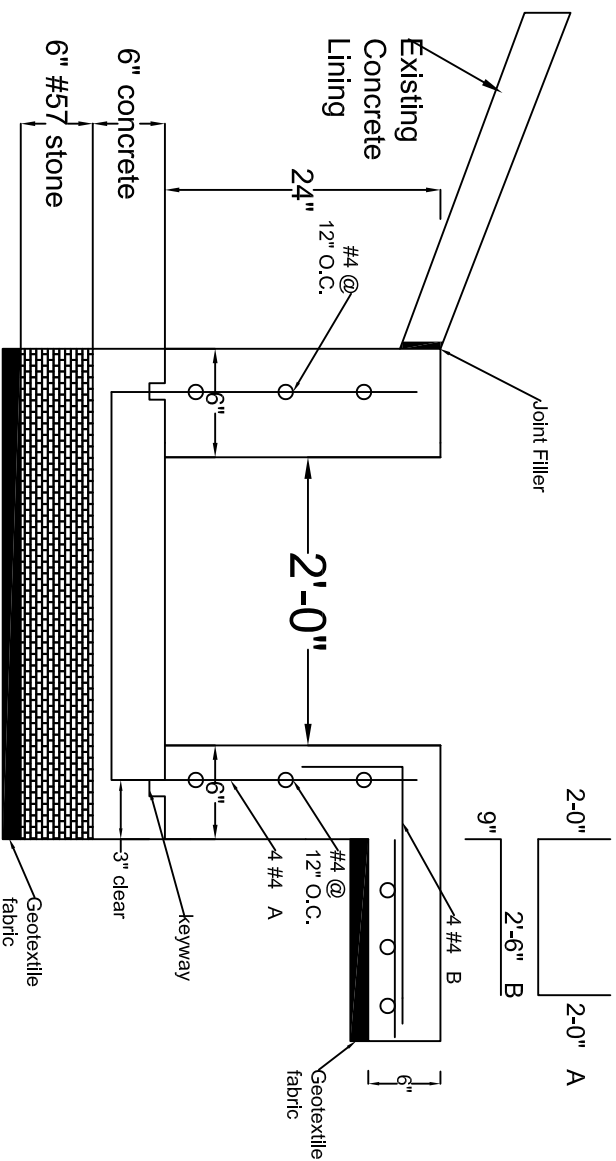

WTP Ponds 1 & 2 Backwash Lagoon
Scale: Not to Scale
Drawn By: Justin Mooney 3/16/18
Sheet: 2 of 2