ADDENDUM 003



DATE:	September 10, 2019
ADDENDUM NUMBER:	003
DG PROJECT NUMBER:	3050
PROJECT NAME:	APS Coyote Willow Family School – Phase 2
PROJECT ADDRESS:	7125 Irving Blvd NW, Albuquerque, NM 87114
ISSUED BY:	Wendy E.S. Caruso, AIA, Project Manager
NOTICE:	This addendum forms a part of the Contract Documents and modifies the Documents issued by The Hartman + Majewski Design Group and dated September 14, 2018. Acknowledge receipt of this Addendum in locations required on the Pricing Forms. Failure to do so may subject the Proposer to disqualification. All other provisions of the Contract Documents shall remain unchanged. This Addendum contains a total of Twenty-Nine (29) 8 ½" x 11" pages and Sixteen (16) 30" x 42" replacement sheets.

GENERAL CLARIFICATIONS:

- 1. Contractor to remove existing 6" thick concrete mow strip of approximately 45' in length and 16" wide along the west elevation where the new construction attaches to the existing building.
- 2. Per owner directive, PV over the parking lot at Coyote Willow is removed from this scope of work and will be provided thru a separate contract.
- What is the psi for the exterior, foundation and other concrete? 3. Question: Response: This question is answered in sect 4.A.(3) of the General Structural Notes
- 4. Question: On Sheet A111; Room 232, how many ovens? Response: 2 ovens
- 5. Question: A403, elev. F3, D3 and D4 show what appear to be paper towel dispensers and soap dispensers, is this correct? Yes these are paper towel and soap dispensers. Response:
- 6. Question: B3, F3/A401, E3/A402 and E1/A403 all show 58" marker boards with a 9" tack strip. Is this correct?
 - The design intent is for marker boards and tack strips to match existing phase. Response:
- 7. Question: Are room signs required at each room at each door? Response: Yes
- What is Allowance No. 1(HVAC equipment)? 8. Question: This has been removed in Addendum 003 Response:



9.	Question:	Section IV.B – "Submission of Price Proposal – Volume I" requires one original copy and one digital copy to be submitted by 9/17 at 3:00PM. Due to the nature of bid price development, most general contractors do not receive pricing from subcontractors until shortly before the bid deadline. This creates a challenge for general contractors to develop both a hard copy and digital copy of the Price Volume. If the original copy of Volume I is submitted by the stated deadline (9/17 at 3:00PM), would APS allow the "digital copy" of Volume I to be submitted with Volume II on the following day?
	Response:	It is acceptable to submit the digital copy of Volume 1 with Volume II o September 18, 2019 at 3:00PM. All information related to Volume 1 must be identical to the submitted documents delivered to APS on September 17, 2019. Digital copy submitted on September 18, 2019, must have both Volumes separated from each other.
10.	Question:	The Subcontract List and Assignment of Anti-Trust Claims Form identifies the Listing Threshold for this Project to be \$15,160.00. We believe this should be \$16,600, which is equal to one half of one percent of the of engineer's or architect's estimate of the total project cost, not including alternates. Please confirm
	Response:	\$16,600 is the correct amount for the Listing Threshold
11.	Question:	Partition types are showing "Prospec Decimal Drop" between layers of gypsum board. This product is no longer manufactured. Can we use St. Gobain Green glue instead?
	Response:	St. Gobain Green glue is acceptable for use in lieu of Prospec Decimal Drop.
12.	Question: Response:	Is the three year maintenance agreement going to be required? A three year maintenance agreement has been removed from scope.
13. 14.	Question: Response:	S101- At the tie in to the existing building7/SA 201where is this section? The correct reference is 7/S201.
14. 15.	Question:	S001 calls for 3000 PSI concrete at all interior floor slabs. Spec 033510.1.3.B.1 Polished Concrete calls for 4000 PSI. Which is correct?
	Response:	4000 PSI concrete at all interior floor slabs. Refer to revised Sheet S001 as attached to Addendum 003.
16.	Question: Response:	What is the status of the building permit? The project has been submitted to CID for review.
17.	Question:	M601 shows the kiln vent thru the exterior wall; M101, KN14, calls for the vent to be run thru the roof. Which is correct?
	Response:	Kiln vent to run thru the roof. Refer to the attached M601 as attached to Addendum 003.



18.	Question:	A111, KN 9 at Mech 219is this correct?	Albuquerque New Mexico 87106 T 505 242 6880 • F 505 242 6881
10.	Response:	No, this should be KN 8. Refer to A111 as attache	ed to Addendum 003.
19.	Question: Response:	A112 Room 231, has elevation referring to A404. Reference tags have been updated to correct thi attached to Addendum 003.	
20.	Question: Response:	Where are pencil sharpeners located? Refer to A111 as attached to Addendum 003.	
21.	Question: Response:	Is there a KNOX Box specification? No, a KNOX Box was installed in Phase 1 and is n	ot included in Phase 2 scope.
22.	Question: Response:	Is there a Bike Rack specification? A111, KN 9 at No, Bicycle racks were installed in Phase 1 and is	
23.	Question: Response:	F3/A402, what is KN 37? There is no KN 37. Note location has been correct to Addendum 003.	cted. Refer to A402 as attached
24.	Question: Response:	B3, F3/A401, E3/A402 and E1/A403 all show 58" strip. Is this correct? No, provide 48" marker board with a 1" tack strip boards installed in Phase 1.	
25.	Question: Response:	B3/A401, what is KN 32? This detail was removed. Refer to A401 as attac	hed to Addendum 003.
26.	Question: Response:	C1/A402, what is KN 39? This should be KN 33. Refer to A402 as attached	to Addendum 003.
27.	Question: Response:	F3/A402, B4/A401should this be A5/A402? The Refer to A401, A402, and A403 as attached to Ac	
28.	Question: Response:	Are room signs required at each room at each do Yes.	por?
29.	Question: Response:	A111, KN5, says to see A402 for elevationscan' Refer to A402 as attached to Addendum 003.	t find these elevations.
30.	Question: Response:	E5/A402, where is this elevation? There is no E5/A402. Refer to attached drawings	s for updated information.
31.	Question: Response:	B3/A401, where is the teaching wall? One in eac Yes, one per classroom. Refer to attached drawi	

DESIGN GROUP Architects • Engineers • Interior Design Planners • Urban Designers • LEED®	20
120 Vassar Drive SE Suite 100 Albuquerque New Mexico 87106 T 505 242 6880 • F 505 242 6881	62

т

32.	Question:	A1/I600 has sections C1 and C2 AI602, where is that sheet?	120 Vassar Drive SE Suite 100 Albuquerque New Mexico 87106 T 505 242 6880 • F 505 242 6881
	Response:	Refer to I600 as attached to Addendum 003	
33.	Question: Response:	A1/I600, KN 1, there are no keyed notes on this s Corner Guard. Refer to I600 as attached in Adde	
34.	Question:	Are Impact Fees Associated with this project? If a responsibility of the Contractor or the Owner? If responsibility of the Contractor, are the fees know the value?	the Impact Fees are the
	Response:	No impact fees are associated with this project.	
35.	Question:	The finish schedule and the RCP for the following 201,223,227,232 and 233. Which is correct?	g rooms don't match:
	Response:	the RCP is correct.	
36.	Question: Response:	Who is to pay for concrete and soils testing? Third party testing for concrete and soils will be	provided by owner.

PRIOR APPROVALS:

1. 07 4113.16 Standing-Seam Metal Roof Panels

A. The following manufactures have been approved to bid: Drexel Metals Standing Seam Roof System; DMC-200S

2. 26 5000 Lighting Equipment

Fixture Type	Approved Substitution
A	As Specified
В	HE Williams, Columbia, Acuity
B1	HE Williams, Columbia, Acuity
С	HE Williams, Columbia, Acuity
D	HE Williams, Columbia, Acuity
D1	HE Williams, Columbia, Acuity
E	HE Williams, Columbia, Acuity
E1	HE Williams, Columbia, Acuity
F	As Specified
G	Lightolier, Prescolite, Acuity
Н	HE Williams, NewStar
К	We-ef, Lumux
L	As Specified
Ν	As Specified
EM	Astralite
EM1	Mule, Exitronix, EELP
EM2	As Specified

Х	Daybrite, Exitronix	
X1	Mule, Exitronix, Acuity	



CHANGES TO SPECIFICATIONS:

Table of Contents:

- A. Delete Section 00 3300.
- B. Change Section 01 1883 to read as follows:

01 8113 SUSTAINABLE DESIGN REQUIREMENTS – LEED v4 FOR SCHOOLS

- A. Table 8113-01: Supplemental Requirements for LEEDv4 Indoor Environmental Quality Credits
- B. Table 8113-02: Supplemental Requirements for LEEDv4 Material and Resource Credits
- C. Supplement 8113-03: LEED v4 Material Cover Sheet
- D. Supplement 8113-04: LEEDv4 Checklist

00 0000 "APS Proposal Documents" RFP#20-011 RRR APENDIX C: Change listing threshold to read "Listing Threshold for this Project: \$16,600.00."

00 0000 "APS Proposal Documents" RFP#20-011 RRR APENDIX D: Replace BID PROPOSAL FOR LUMP SUM CONTRACT with BID PROPOSAL FOR LUMP SUM CONTRACT, attached.

00 0000 "APS Proposal Documents" RFP#20-011 RRR APENDIX I: Change qualification threshold for this project to read "Qualification Threshold for this Project: \$16,600.00."

00 0000 "APS Proposal Documents" RFP#20-011 RRR "INDEX TO TECHNICAL SPECIFICATIONS" make the following changes:

01 8113 SUSTAINABLE DESIGN REQUIREMENTS – LEED v4 FOR SCHOOLS add the following:

- A. Table 8113-01: Supplemental Requirements for LEEDv4 Indoor Environmental Quality Credits
- B. Table 8113-02: Supplemental Requirements for LEEDv4 Material and Resource Credits
- C. Supplement 8113-03: LEED v4 Material Cover Sheet
- D. Supplement 8113-04: LEEDv4 Checklist

Add the following sections:

07 9100 Preformed Joint Seals

32 1216 Asphalt Concrete Paving

- 05 5000 "Metal Fabrications":
 - A. Delete the 2 sections 05 5000.
 - B. Replace with section 05 5000 "Metal Fabrications", attached.

06 4500 "Custom Plastic-Laminate Casework":

A. Replace paragraph 1.4.D to read as follows:

D. Certification shall be evidenced through the application of AWI Quality Certification labels and/or the issuance of an AWI letter of certification for the project. QCP Registration #19.1881.



08 8000 "Glazing":

- A. Add this section, attached.
- 10 1100 "Visual Display Units":
 - A. Add paragraph 2.8.C.4 to read as follows:
 - 4. Flag Holder: Two for each room.
- 11 9519 "Pencil Sharpeners"
 - A. Add paragraph 2.1.C to read as follows:
 - C. Provide one pencil sharpener at each classroom.
 - B. Change paragraph 3.2.B to read as follows:
 - B. Mount pencil sharpener on wood mounting block according to manufacturer's written instructions.
 - B. Add paragraph 3.2.C to read as follows:
 - C. Mounting Height: Mount pencil sharpeners at height determined by Owner for each classroom.

CHANGES TO THE DRAWINGS:

Civil Sheets

C101 SITE PAVING PLAN

1. Replace entire sheet C101.

C501 CIVIL DETAILS

1. Replace entire sheet C501.

Structural Sheets

S001 GENERAL STRUCTURAL NOTES

1. Replace Sheet S001 in its entirety.

S101 FOUNDATION PLAN

1. Replace Sheet S101 in its entirety.

S201 FOUNDATION PLAN

1. Replace Sheet S201 in its entirety.

Architectural Sheets

A111 FLOOR PLAN – BUILDING DIMENSIONS

1. Replace Sheet A111 its entirety.

A112 FLOOR PLAN - PORTAL DIMENSIONS AND MARKERS

1. Replace Sheet A112 its entirety.

A401 CASEWORK SECTIONS AND INTERIOR ELEVATIONS

1. Replace Sheet A401 its entirety.

A402 ENLARGED PLANS AND INTERIOR ELEVATIOS

1. Replace Sheet A402 its entirety.

A403 CASEWORK SECTIONS AND INTERIOR ELEVATIONS

1. Replace Sheet A403 its entirety.

A502 DETAILS

1. Replace Sheet A502 its entirety.

A601 DOOR SCHEDULE, DOOR TYPE, DOOR AND WINDOW FRAMES

1. Replace Sheet A601 its entirety.

1600 ROOM FINISH LEGEND AND ENLARGED PLANS

1. Replace Sheet I600 its entirety.

Mechanical Sheets

SHEET M002

- 1. ADD: RELIEF HOOD RH-201.
- 2. Replace Sheet M002 its entirety.

<u>SHEET M101</u>

- 1. REVISE: Exhaust vent duct from Exhaust Fan EF-203, up thru roof, (was thru wall).
- 2. REVISE: Exhaust vent duct from Ceiling Exhaust Fan CEF-201, up thru roof, (was thru wall).
- 3. ADD: CO2 sensor into room: COLLABORATION AREA [231].
- 4. Replace Sheet M101 its entirety.

SHEET M601

- 1. REVISE: DETAIL M3: Kiln exhaust vent duct from Kiln mfgr supplied exhaust fan, shall be routed up thru roof, to Contractor provided / installed roof vent cap.
- 2. REVISE: DO NOT INSTALL Kiln Exhaust Vent Duct thru wall.
- 3. Replace Sheet M601 its entirety.

Electrical Sheets

SHEET E103

- 1. Unit CU-201
 - a. Relocated unit from outside the north wall of Elec 209 to exterior alcove outside of Tele/Com 210A. Refer to attached sketch SKE103a.



<u>SHEET E104</u>

1. Keyed Note 16 reference on the plan shall change to Keyed Note 15.



<u>SHEET E504</u>

- 1. Light Fixture Schedule
 - a. Fixture type "F" shall change to Fail-Safe #HVL8-4-LD4-2STD-35-UNV-0-EDC1-S.
 - b. Fixture type "X" delete brushed aluminum face, housing to be plastic and the finish shall change to white.

END OF ADDENDUM 003

BID PROPOSAL FOR LUMP SUM CONTRACT

Date of Proposal:
New Mexico State Contractor's License No.
License Classifications:
Resident Contractor's Preference Certificate No.
Veteran Resident Contractor Preference Certificate No Percent of preference qualified for:(10%). NOTE: Attach a copy of the valid certificate and documentation to validate percent preference.
NM DOL (Workforce Solutions) Certificate No.
Contractor's New Mexico Gross Receipts Tax No
Contractor's Federal Employee Identification No

FD+C Project No. 841

Project Name: Coyote Willow Family School – Phase 2

Proposal of (company name): —

(Hereinafter called the "Offeror") organized and existing under the laws of the State of New Mexico, doing business as a Corporation, Partnership or Individual. (Circle correct one).

To: Board of Education Albuquerque Municipal School District Number 12 Bernalillo and Sandoval Counties, New Mexico (hereinafter called "APS") for:

The construction of Coyote Willow Family School – Phase 2

The undersigned, as an authorized representative for the Offeror named above, in compliance with the Request for Proposals for the construction of a Coyote Willow Family School – Phase 2, FD+C Project No. 841, having examined the drawings and specifications, with related documents, and having examined the site of the proposed work, and being familiar with all of the conditions surrounding the construction of the proposed project, including the availability of labor, materials and supplies, hereby proposes to furnish all labor, materials and supplies, and to construct the project in accordance with the contract documents at the bids stated below. These bids are to cover all expenses incurred in performing the work required under the contract documents, of which this proposal is a part.

The undersigned Offeror's representative also acknowledges receipt of the following Addenda:

Addendum No: ____, dated ______, Addendum No: ____, dated ______

Addendum No: ____, dated ______, Addendum No: ____, dated _____

The following information is required for state reporting purposes only, and will not be used in evaluating or awarding the contract. Is project material offered grown, produced or wholly manufactured in New Mexico? (Yes/No) (Percentage; reference V-B-5 of the RFP)

Page 1 of 3

BID PROPOSAL FOR LUMP SUM CONTRACT

<u>BASE BID</u>: The Offeror agrees to perform all work for the construction of the Coyote Willow Family School – Phase 2, as described in the Project Manual and as shown on the Drawings for the following Base Bid.

(Amounts to be shown in both words and figures. In case of a discrepancy, the amount shown in words will govern, please print.) All sums will exclude NM Gross Receipts Tax.

The Work to be performed under this Contract shall be commenced not later than ten (10) consecutive days after the date of written Notice to Proceed, and that Substantial Completion shall be achieved not later than 220 calendar days after the date of written Notice to Proceed, except as hereafter extended by valid written Change Order by the Owner, for Base Bid.

Should the Contractor neglect, refuse, or otherwise fail to complete the Work within the time specified, the Contractor agrees to pay to the Owner in partial consideration for the award of this Contract the amount of One thousand Five hundred Dollars (\$1,500.00) per consecutive day, not as a penalty, but as liquidated damages for such breach of the Contract.

The price basis for this RFP is the bid proposed for the Base Bid, subject to the availability of funds. APS may award one or more Bid Lots and/or one or more Alternates at the sole discretion of APS, subject to availability of funds.

BASE BID:

(1) Base Bid:

Total Base Bid Lump Sum: _____

_____Dollars, (\$______)

Page 2 of 3

BID PROPOSAL FOR LUMP SUM CONTRACT

The Offeror understands that the contract will be awarded in accordance with the provisions of the Request for Proposals and that the Owner reserves the right to reject any or all proposals and to waive any technical irregularities.

The Offeror agrees that this bid will be good and may not be withdrawn for a period of forty- five (45) calendar days after the scheduled closing time for receiving bid proposals.

Upon receipt of written notice of acceptance of this Bid, Offeror will execute the final contract and deliver surety bonds as required by the Request for Proposals within seven calendar days. The PROPOSAL SECURITY attached in the sum of 5% of the amount proposed is: _____

	Dollars, (\$)
And will become the property of the Owner in the even forth herein, as liquidated damages for the delay and a	nt the contract and bonds are not executed within the time dditional expenses to the Owner caused thereby.
Respectfully Submitted,	
By :(Authorized Signature)	Date:
By :(Same Name, Printed or Typed)	
Title:	
Company:	
Address:	Phone:
	Zip:
Fax: Email:	
(Affix Corporate Seal if proposal is by Corporation)	

SECTION 05 5000

METAL FABRICATIONS

PART 1 - GENERAL

1.1 SUMMARY

- A. Section Includes:
 - 1. Steel framing and supports for mechanical and electrical equipment.
 - 2. Steel framing and supports for applications where framing and supports are not specified in other Sections.
- B. Products furnished, but not installed, under this Section include the following:
 - 1. Anchor bolts and steel pipe sleeves indicated to be cast into concrete.
 - 2. Steel weld plates and angles for casting into concrete for applications where they are not specified in other Sections.
- C. Related Requirements:
 - 1. Section 01 7419 "Construction Waste Management and Disposal".
 - 2. Section 01 8113 "Sustainable Design Requirements LEED v4 for Schools".
 - 3. Section 03 3000 "Cast-in-Place Concrete" for installing anchor bolts, steel pipe sleeves, slotted-channel inserts, wedge-type inserts, and other items cast into concrete.
 - 4. Section 05 1200 "Structural Steel Framing."

1.2 COORDINATION

- A. Coordinate selection of shop primers with topcoats to be applied over them. Comply with paint and coating manufacturers' written recommendations to ensure that shop primers and topcoats are compatible with one another.
- B. Coordinate installation of metal fabrications that are anchored to or that receive other work. Furnish setting drawings, templates, and directions for installing anchorages, including sleeves, concrete inserts, anchor bolts, and items with integral anchors, that are to be embedded in concrete or masonry. Deliver such items to Project site in time for installation.

1.3 ACTION SUBMITTALS

- A. Product Data: For the following:
 - 1. Metal nosings and treads.
 - 2. Grout.

ALBUQUERQUE PUBLIC SCHOOLS COYOTE WILLOW PHASE 2 ALBUQUERQUE, NEW MEXICO

- B. Sustainable Design Submittals:
 - 1. Refer to Section 01 8113 "Sustainable Design Requirements LEED v4 for Schools".
- C. Shop Drawings: Show fabrication and installation details. Include plans, elevations, sections, and details of metal fabrications and their connections. Show anchorage and accessory items.
- D. Samples for Verification: For each type and finish of extruded nosing.

1.4 QUALITY ASSURANCE

- A. Welding Qualifications: Qualify procedures and personnel according to AWS D1.1/D1.1M, "Structural Welding Code Steel."
 - 1. AWS D1.1/D1.1M, "Structural Welding Code Steel."
 - 2. AWS D1.2/D1.2M, "Structural Welding Code Aluminum."
 - 3. AWS D1.6/D1.6M, "Structural Welding Code Stainless Steel."

1.5 FIELD CONDITIONS

A. Field Measurements: Verify actual locations of walls and other construction contiguous with metal fabrications by field measurements before fabrication.

PART 2 - PRODUCTS

2.1 METALS

- A. Metal Surfaces, General: Provide materials with smooth, flat surfaces unless otherwise indicated. For metal fabrications exposed to view in the completed Work, provide materials without seam marks, roller marks, rolled trade names, or blemishes.
- B. Steel Plates, Shapes, and Bars: ASTM A 36/A 36M.
- C. Stainless-Steel Sheet, Strip, and Plate: ASTM A 240/A 240M or ASTM A 666, Type 304.
- D. Stainless-Steel Bars and Shapes: ASTM A 276, Type 304.
- E. Steel Tubing: ASTM A 500/A 500M, cold-formed steel tubing.
- F. Steel Pipe: ASTM A 53/A 53M, Standard Weight (Schedule 40) unless otherwise indicated.
- G. Slotted Channel Framing: Cold-formed metal box channels (struts) complying with MFMA-4.
 - 1. Size of Channels: 1-5/8 by 1-5/8 inches.
 - 2. Material: Galvanized steel, ASTM A 653/A 653M,, with G90 coating; 0.108-inch nominal thickness.

- 3. Material: Cold-rolled steel, ASTM A 1008/A 1008M, commercial steel, Type B; 0.0677inch minimum thickness; coated with rust-inhibitive, baked-on, acrylic enamel or hot-dip galvanized after fabrication.
- H. Aluminum Plate and Sheet: ASTM B 209, Alloy 6061-T6.
- I. Aluminum Extrusions: ASTM B 221, Alloy 6063-T6.
- J. Aluminum Castings: ASTM B 26/B 26M, Alloy 443.0-F.

2.2 FASTENERS

- A. General: Unless otherwise indicated, provide Type 304 stainless-steel fasteners for exterior use and zinc-plated fasteners with coating complying with ASTM B 633 or ASTM F 1941, Class Fe/Zn 5, at exterior walls. Select fasteners for type, grade, and class required.
 - 1. Provide stainless-steel fasteners for fastening aluminum.
 - 2. Provide stainless-steel fasteners for fastening stainless steel.
- B. Steel Bolts and Nuts: Regular hexagon-head bolts, ASTM A 307, Grade A; with hex nuts, ASTM A 563; and, where indicated, flat washers.
- C. Steel Bolts and Nuts: Regular hexagon-head bolts, ASTM A 325, Type 3; with hex nuts, ASTM A 563, Grade C3; and, where indicated, flat washers.
- D. Stainless-Steel Bolts and Nuts: Regular hexagon-head annealed stainless-steel bolts, ASTM F 593; with hex nuts, ASTM F 594; and, where indicated, flat washers; Alloy Group 1 (A1).
- E. Anchor Bolts: ASTM F 1554, Grade 36, of dimensions indicated; with nuts, ASTM A 563 (ASTM A 563M); and, where indicated, flat washers.
 - 1. Hot-dip galvanize or provide mechanically deposited, zinc coating where item being fastened is indicated to be galvanized.
- F. Anchors, General: Anchors capable of sustaining, without failure, a load equal to six times the load imposed when installed in unit masonry and four times the load imposed when installed in concrete, as determined by testing according to ASTM E 488/E 488M, conducted by a qualified independent testing agency.
- G. Cast-in-Place Anchors in Concrete: Either threaded type or wedge type unless otherwise indicated; galvanized ferrous castings, either ASTM A 47/A 47M malleable iron or ASTM A 27/A 27M cast steel. Provide bolts, washers, and shims as needed, all hot-dip galvanized per ASTM F 2329.

- H. Post-Installed Anchors: chemical anchors.
 - 1. Material for Interior Locations: Carbon-steel components zinc plated to comply with ASTM B 633 or ASTM F 1941 (ASTM F 1941M), Class Fe/Zn 5, unless otherwise indicated.
 - 2. Material for Exterior Locations and Where Stainless Steel Is Indicated: Alloy Group 1 (A1) stainless-steel bolts, ASTM F 593 (ASTM F 738M), and nuts, ASTM F 594 (ASTM F 836M).

2.3 MISCELLANEOUS MATERIALS

- A. Universal Shop Primer: Fast-curing, lead- and chromate-free, universal modified-alkyd primer complying with MPI#79 and compatible with topcoat.
 - 1. Use primer containing pigments that make it easily distinguishable from zinc-rich primer.
- B. Epoxy Zinc-Rich Primer: Complying with MPI#20 and compatible with topcoat.
- C. Shop Primer for Galvanized Steel: Primer formulated for exterior use over zinc-coated metal and compatible with finish paint systems indicated.
- D. Galvanizing Repair Paint: High-zinc-dust-content paint complying with SSPC-Paint 20 and compatible with paints specified to be used over it.
- E. Bituminous Paint: Cold-applied asphalt emulsion complying with ASTM D 1187/D 1187M.
- F. Nonshrink, Nonmetallic Grout: Factory-packaged, nonstaining, noncorrosive, nongaseous grout complying with ASTM C 1107/C 1107M. Provide grout specifically recommended by manufacturer for interior and exterior applications.
- G. For adhesives, sealants, paint and coatings applied on site within the vapor barrier, provide Product Data documentation including printed statement of VOC content.

2.4 FABRICATION, GENERAL

- A. Shop Assembly: Preassemble items in the shop to greatest extent possible. Disassemble units only as necessary for shipping and handling limitations. Use connections that maintain structural value of joined pieces. Clearly mark units for reassembly and coordinated installation.
- B. Cut, drill, and punch metals cleanly and accurately. Remove burrs and ease edges to a radius of approximately 1/32 inch (1 mm) unless otherwise indicated. Remove sharp or rough areas on exposed surfaces.
- C. Form bent-metal corners to smallest radius possible without causing grain separation or otherwise impairing work.
- D. Form exposed work with accurate angles and surfaces and straight edges.

- E. Weld corners and seams continuously to comply with the following:
 - 1. Use materials and methods that minimize distortion and develop strength and corrosion resistance of base metals.
 - 2. Obtain fusion without undercut or overlap.
 - 3. Remove welding flux immediately.
 - 4. At exposed connections, finish exposed welds and surfaces smooth and blended so no roughness shows after finishing and contour of welded surface matches that of adjacent surface.
- F. Form exposed connections with hairline joints, flush and smooth, using concealed fasteners or welds where possible. Where exposed fasteners are required, use Phillips flat-head (countersunk) fasteners unless otherwise indicated. Locate joints where least conspicuous.
- G. Fabricate seams and other connections that are exposed to weather in a manner to exclude water. Provide weep holes where water may accumulate.
- H. Cut, reinforce, drill, and tap metal fabrications as indicated to receive finish hardware, screws, and similar items.
- I. Provide for anchorage of type indicated; coordinate with supporting structure. Space anchoring devices to secure metal fabrications rigidly in place and to support indicated loads.

2.5 MISCELLANEOUS FRAMING AND SUPPORTS

- A. General: Provide steel framing and supports not specified in other Sections as needed to complete the Work.
- B. Fabricate units from steel shapes, plates, and bars of welded construction unless otherwise indicated. Fabricate to sizes, shapes, and profiles indicated and as necessary to receive adjacent construction.
 - 1. Fabricate units from slotted channel framing where indicated.
 - 2. Furnish inserts for units installed after concrete is placed.
- C. Galvanize miscellaneous framing and supports where indicated.
- D. Prime miscellaneous framing and supports with zinc-rich primer where indicated.

2.6 MISCELLANEOUS STEEL TRIM

A. Unless otherwise indicated, fabricate units from steel shapes, plates, and bars of profiles shown with continuously welded joints and smooth exposed edges. Miter corners and use concealed field splices where possible.

- B. Provide cutouts, fittings, and anchorages as needed to coordinate assembly and installation with other work.
 - 1. Provide with integrally welded steel strap anchors for embedding in concrete or masonry construction.
- C. Galvanize exterior miscellaneous steel trim.
- D. Prime miscellaneous steel trim with zinc-rich primer.

2.7 STEEL WELD PLATES AND ANGLES

A. Provide steel weld plates and angles not specified in other Sections, for items supported from concrete construction as needed to complete the Work. Provide each unit with no fewer than two integrally welded steel strap anchors for embedding in concrete.

2.8 FINISHES, GENERAL

- A. Finish metal fabrications after assembly.
- B. Finish exposed surfaces to remove tool and die marks and stretch lines, and to blend into surrounding surface.

2.9 STEEL AND IRON FINISHES

- A. Galvanizing: Hot-dip galvanize items as indicated to comply with ASTM A 153/A 153M for steel and iron hardware and with ASTM A 123/A 123M for other steel and iron products.
 - 1. Do not quench or apply post galvanizing treatments that might interfere with paint adhesion.
- B. Preparation for Shop Priming Galvanized Items: After galvanizing, thoroughly clean railings of grease, dirt, oil, flux, and other foreign matter, and treat with metallic phosphate process.
- C. Shop prime iron and steel items not indicated to be galvanized unless they are to be embedded in concrete, sprayed-on fireproofing, or masonry, or unless otherwise indicated.
 - 1. Shop prime with universal shop primer unless indicated.
- D. Preparation for Shop Priming: Prepare surfaces to comply with requirements indicated below:
 - 1. Exterior Items: SSPC-SP 6/NACE No. 3, "Commercial Blast Cleaning."
 - 2. Items Indicated to Receive Zinc-Rich Primer: SSPC-SP 6/NACE No. 3, "Commercial Blast Cleaning."
 - 3. Other Items: SSPC-SP 3, "Power Tool Cleaning."

- E. Shop Priming: Apply shop primer to comply with SSPC-PA 1, "Paint Application Specification No. 1: Shop, Field, and Maintenance Painting of Steel," for shop painting.
 - 1. Stripe paint corners, crevices, bolts, welds, and sharp edges.

2.10 ALUMINUM FINISHES

- A. As-Fabricated Finish: AA-M12.
- B. Clear Anodic Finish: AAMA 611, Class I, AA-M12C22A41 where indicated.

PART 3 - EXECUTION

3.1 INSTALLATION, GENERAL

- A. Cutting, Fitting, and Placement: Perform cutting, drilling, and fitting required for installing metal fabrications. Set metal fabrications accurately in location, alignment, and elevation; with edges and surfaces level, plumb, true, and free of rack; and measured from established lines and levels.
- B. Fit exposed connections accurately together to form hairline joints. Weld connections that are not to be left as exposed joints but cannot be shop welded because of shipping size limitations. Do not weld, cut, or abrade surfaces of exterior units that have been hot-dip galvanized after fabrication and are for bolted or screwed field connections.
- C. Field Welding: Comply with the following requirements:
 - 1. Use materials and methods that minimize distortion and develop strength and corrosion resistance of base metals.
 - 2. Obtain fusion without undercut or overlap.
 - 3. Remove welding flux immediately.
 - 4. At exposed connections, finish exposed welds and surfaces smooth and blended so no roughness shows after finishing and contour of welded surface matches that of adjacent surface.
- D. Fastening to In-Place Construction: Provide anchorage devices and fasteners where metal fabrications are required to be fastened to in-place construction. Provide threaded fasteners for use with concrete and masonry inserts, toggle bolts, through bolts, lag screws, wood screws, and other connectors.
- E. Provide temporary bracing or anchors in formwork for items that are to be built into concrete, masonry, or similar construction.
- F. Corrosion Protection: Coat concealed surfaces of aluminum that come into contact with grout, concrete, masonry, wood, or dissimilar metals with the following:
 - 1. Cast Aluminum: Heavy coat of bituminous paint.

2. Extruded Aluminum: Two coats of clear lacquer.

3.2 INSTALLING MISCELLANEOUS FRAMING AND SUPPORTS

A. General: Install framing and supports to comply with requirements of items being supported, including manufacturers' written instructions and requirements indicated on Shop Drawings.

3.3 ADJUSTING AND CLEANING

- A. Touchup Painting: Immediately after erection, clean field welds, bolted connections, and abraded areas. Paint uncoated and abraded areas with the same material as used for shop painting to comply with SSPC-PA 1 for touching up shop-painted surfaces.
 - 1. Apply by brush or spray to provide a minimum 2.0-mil (0.05-mm) dry film thickness.
- B. Galvanized Surfaces: Clean field welds, bolted connections, and abraded areas and repair galvanizing to comply with ASTM A 780/A 780M.

END OF SECTION 05 5000

SECTION 08 8000

GLAZING

PART 1 - GENERAL

1.1 SUMMARY

- A. Section includes:
 - 1. Glass for windows and doors.
 - 2. Glazing sealants and accessories.
- B. Related Sections:
 - 1. Section 01 8113 Part 1.5 for LEED product submittal requirements.

1.2 DEFINITIONS

- A. Glass Manufacturers: Firms that produce primary glass, fabricated glass, or both, as defined in referenced glazing publications.
- B. Glass Thicknesses: Indicated by thickness designations in millimeters according to ASTM C 1036.
- C. IBC: International Building Code.
- D. Interspace: Space between lites of an insulating-glass unit.

1.3 COORDINATION

A. Coordinate glazing channel dimensions to provide necessary bite on glass, minimum edge and face clearances, and adequate sealant thicknesses, with reasonable tolerances.

1.4 ACTION SUBMITTALS

- A. Product Data: For each type of product.
- B. Glass Samples: For each type of the following products; 12 inches square.
 - 1. Insulating glass.

ALBUQUERQUE PUBLIC SCHOOLS COYOTE WILLOW PHASE 2 ALBUQUERQUE, NEW MEXICO

C. Glazing Schedule: List glass types and thicknesses for each size opening and location. Use same designations indicated on Drawings.

1.5 INFORMATIONAL SUBMITTALS

- A. Product Certificates: For glass.
- B. Product Test Reports: For glass and glazing products, from manufacturer.
 - 1. For glazing sealants, provide test reports based on testing current sealant formulations within previous 36-month period.
- C. Preconstruction adhesion and compatibility test report.
- D. Sample Warranties: For special warranties.

1.6 QUALITY ASSURANCE

- A. Manufacturer Qualifications for Insulating-Glass Units with Sputter-Coated, Low-E Coatings: A qualified insulating-glass manufacturer who is approved by coated-glass manufacturer.
- B. Glass Testing Agency Qualifications: A qualified independent testing agency accredited according to the NFRC CAP 1 Certification Agency Program.
- C. Sealant Testing Agency Qualifications: An independent testing agency qualified according to ASTM C 1021 to conduct the testing indicated.

1.7 PRECONSTRUCTION TESTING

- A. Preconstruction Adhesion and Compatibility Testing: Test each glass product, tape sealant, gasket, glazing accessory, and glass-framing member for adhesion to and compatibility with elastomeric glazing sealants.
 - 1. Testing is not required if data are submitted based on previous testing of current sealant products and glazing materials matching those submitted.

1.8 DELIVERY, STORAGE, AND HANDLING

- A. Protect glazing materials according to manufacturer's written instructions. Prevent damage to glass and glazing materials from condensation, temperature changes, direct exposure to sun, or other causes.
- B. Comply with insulating-glass manufacturer's written instructions for venting and sealing units to avoid hermetic seal ruptures due to altitude change.

1.9 FIELD CONDITIONS

- A. Environmental Limitations: Do not proceed with glazing when ambient and substrate temperature conditions are outside limits permitted by glazing material manufacturers and when glazing channel substrates are wet from rain, frost, condensation, or other causes.
 - 1. Do not install glazing sealants when ambient and substrate temperature conditions are outside limits permitted by sealant manufacturer or are below 40 deg F.

1.10 WARRANTY

- A. Manufacturer's Special Warranty for Coated-Glass Products: Manufacturer's standard form in which coated-glass manufacturer agrees to replace coated-glass units that deteriorate within specified warranty period. Deterioration of coated glass is defined as defects developed from normal use that are not attributed to glass breakage or to maintaining and cleaning coated glass contrary to manufacturer's written instructions. Defects include peeling, cracking, and other indications of deterioration in coating.
 - 1. Warranty Period: 10 years from date of Substantial Completion.
- B. Manufacturer's Special Warranty for Laminated Glass: Manufacturer agrees to replace laminated-glass units that deteriorate within specified warranty period. Deterioration of laminated glass is defined as defects developed from normal use that are not attributed to glass breakage or to maintaining and cleaning laminated glass contrary to manufacturer's written instructions. Defects include edge separation, delamination materially obstructing vision through glass, and blemishes exceeding those allowed by referenced laminated-glass standard.
 - 1. Warranty Period: 10 years from date of Substantial Completion.
- C. Manufacturer's Special Warranty for Insulating Glass: Manufacturer agrees to replace insulating-glass units that deteriorate within specified warranty period. Deterioration of insulating glass is defined as failure of hermetic seal under normal use that is not attributed to glass breakage or to maintaining and cleaning insulating glass contrary to manufacturer's written instructions. Evidence of failure is the obstruction of vision by dust, moisture, or film on interior surfaces of glass.
 - 1. Warranty Period: 10 years from date of Substantial Completion.

PART 2 - PRODUCTS

2.1 LEED RELATED REQUIREMENTS

- A. Provide submittals as required by Section 01 8113 Supplemental Table(s):
 - 1. Submittal requirements for LEED v4 Materials and Resources Credits.
 - 2. Submittal requirements for LEED v4 Environmental Quality Credits.

2.2 MANUFACTURERS

- A. Source Limitations for Glass: Obtain from single source from single manufacturer for each glass type.
- B. Source Limitations for Glazing Accessories: Obtain from single source from single manufacturer for each product and installation method.

2.3 PERFORMANCE REQUIREMENTS

- A. General: Installed glazing systems shall withstand normal thermal movement and wind and impact loads (where applicable) without failure, including loss or glass breakage attributable to the following: defective manufacture, fabrication, or installation; failure of sealants or gaskets to remain watertight and airtight; deterioration of glazing materials; or other defects in construction.
- B. Safety Glazing: Where safety glazing is indicated, provide glazing that complies with 16 CFR 1201, Category II.
- C. Thermal and Optical Performance Properties: Provide glass with performance properties specified, as indicated in manufacturer's published test data, based on procedures indicated below:
 - 1. For monolithic-glass lites, properties are based on units with lites 6 mm thick.
 - 2. For laminated-glass lites, properties are based on products of construction indicated.
 - 3. For insulating-glass units, properties are based on units of thickness indicated for overall unit and for each lite.
 - 4. U-Factors: Center-of-glazing values, according to NFRC 100 and based on LBL's WINDOW 5.2 computer program, expressed as Btu/sq. ft. x h x deg F.
 - 5. Solar Heat-Gain Coefficient and Visible Transmittance: Center-of-glazing values, according to NFRC 200 and based on LBL's WINDOW 5.2 computer program.
 - 6. Visible Reflectance: Center-of-glazing values, according to NFRC 300.

2.4 GLASS PRODUCTS, GENERAL

- A. Glazing Publications: Comply with published recommendations of glass product manufacturers and organizations below unless more stringent requirements are indicated. See these publications for glazing terms not otherwise defined in this Section or in referenced standards.
 - 1. GANA Publications: "Laminated Glazing Reference Manual" and "Glazing Manual."
 - 2. IGMA Publication for Insulating Glass: SIGMA TM-3000, "North American Glazing Guidelines for Sealed Insulating Glass Units for Commercial and Residential Use."
- B. Safety Glazing Labeling: Where safety glazing is indicated, permanently mark glazing with certification label of the SGCC or another certification agency acceptable to authorities having jurisdiction or manufacturer. Label shall indicate manufacturer's name, type of glass, thickness, and safety glazing standard with which glass complies.

- C. Insulating-Glass Certification Program: Permanently marked either on spacers or on at least one component lite of units with appropriate certification label of IGCC.
- D. Thickness: Where glass thickness is indicated, it is a minimum. Provide glass that complies with performance requirements and is not less than the thickness indicated.
 - 1. Minimum Glass Thickness for Exterior Lites: 6 mm.
- E. Strength: Where heat-strengthened float glass is indicated, provide fully tempered float glass. Where fully tempered float glass is indicated, provide fully tempered float glass.

2.5 GLASS PRODUCTS

- A. Clear Annealed Float Glass: ASTM C 1036, Type I, Class 1 (clear), Quality-Q3.
- B. Fully Tempered Float Glass: ASTM C 1048, Kind FT (fully tempered), Condition A (uncoated) unless otherwise indicated, Type I, Class 1 (clear) or Class 2 (tinted) as indicated, Quality-Q3.
 - 1. Fabrication Process: By horizontal (roller-hearth) process with roll-wave distortion parallel to bottom edge of glass as installed unless otherwise indicated.

2.6 LAMINATED GLASS

- A. Laminated Glass: ASTM C 1172. Use materials that have a proven record of no tendency to bubble, discolor, or lose physical and mechanical properties after fabrication and installation.
 - 1. Construction: Laminate glass with polyvinyl butyral interlayer, ionomeric polymer interlayer, or cast-in-place and cured-transparent-resin interlayer to comply with interlayer manufacturer's written instructions.
 - 2. Interlayer Thickness: Provide thickness not less than that indicated and as needed to comply with requirements.
 - 3. Interlayer Color: Clear unless otherwise indicated.

2.7 INSULATING GLASS

- A. Insulating-Glass Units: Factory-assembled units consisting of sealed lites of glass separated by a dehydrated interspace, qualified according to ASTM E 2190.
 - 1. Sealing System: Dual seal, with manufacturer's standard primary and secondary sealants.
 - 2. Spacer: Manufacturer's standard spacer material and construction.
 - 3. Desiccant: Molecular sieve or silica gel, or a blend of both.

2.8 GLAZING SEALANTS

- A. General:
 - 1. Compatibility: Compatible with one another and with other materials they contact, including glass products, seals of insulating-glass units, and glazing channel substrates, under conditions of service and application, as demonstrated by sealant manufacturer based on testing and field experience.
 - 2. Suitability: Comply with sealant and glass manufacturers' written instructions for selecting glazing sealants suitable for applications indicated and for conditions existing at time of installation.
 - 3. Colors of Exposed Glazing Sealants: As selected by Architect from manufacturer's full range.
- B. Glazing Sealant: Neutral-curing silicone glazing sealant complying with ASTM C 920, Type S, Grade NS, Class 50, Use NT.
 - 1. Basis-of-Design Product: Subject to compliance with requirements, provide Pecora Corporation; 895 or a comparable product by one of the following:
 - a. BASF Corporation; Construction Systems.
 - b. Dow Corning Corporation.
 - c. GE Construction Sealants; Momentive Performance Materials Inc.
 - d. Pecora Corporation.
 - e. Sika Corporation.
 - f. Tremco Incorporated.
 - 2. Glazing Sealants: Sealant shall have a VOC content of 250 g/L or less.

2.9 MISCELLANEOUS GLAZING MATERIALS

- A. General: Provide products of material, size, and shape complying with referenced glazing standard, with requirements of manufacturers of glass and other glazing materials for application indicated, and with a proven record of compatibility with surfaces contacted in installation.
- B. Glazing Sealants: Sealant shall have a VOC content of 250 g/L or less.
- C. Cleaners, Primers, and Sealers: Types recommended by sealant or gasket manufacturer.
- D. Setting Blocks: Elastomeric material with a Shore, Type A durometer hardness of 85, plus or minus 5.
- E. Spacers: Elastomeric blocks or continuous extrusions of hardness required by glass manufacturer to maintain glass lites in place for installation indicated.

- F. Edge Blocks: Elastomeric material of hardness needed to limit glass lateral movement (side walking).
- G. Cylindrical Glazing Sealant Backing: ASTM C 1330, Type O (open-cell material), of size and density to control glazing sealant depth and otherwise produce optimum glazing sealant performance.

2.10 FABRICATION OF GLAZING UNITS

- A. Fabricate glazing units in sizes required to fit openings indicated for Project, with edge and face clearances, edge and surface conditions, and bite complying with written instructions of product manufacturer and referenced glazing publications, to comply with system performance requirements.
 - 1. Allow for thermal movements from ambient and surface temperature changes acting on glass framing members and glazing components.
 - a. Temperature Change: 120 deg F, ambient; 180 deg F, material surfaces.
- B. Grind smooth and polish exposed glass edges and corners.

PART 3 - EXECUTION

3.1 EXAMINATION

- A. Examine framing, glazing channels, and stops, with Installer present, for compliance with the following:
 - 1. Manufacturing and installation tolerances, including those for size, squareness, and offsets at corners.
 - 2. Presence and functioning of weep systems.
 - 3. Minimum required face and edge clearances.
 - 4. Effective sealing between joints of glass-framing members.
- B. Proceed with installation only after unsatisfactory conditions have been corrected and the following completed:
 - 1. Provide submittals as required by Section 01 8113 Supplemental Table.
 - a. Submittal Requirements for LEED v4 Environmental Quality Credits.

3.2 PREPARATION

A. Clean glazing channels and other framing members receiving glass immediately before glazing. Remove coatings not firmly bonded to substrates. B. Examine glazing units to locate exterior and interior surfaces. Label or mark units as needed so that exterior and interior surfaces are readily identifiable. Do not use materials that leave visible marks in the completed Work.

3.3 GLAZING, GENERAL

- A. Comply with combined written instructions of manufacturers of glass, sealants, gaskets, and other glazing materials, unless more stringent requirements are indicated, including those in referenced glazing publications.
- B. Protect glass edges from damage during handling and installation. Remove damaged glass from Project site and legally dispose of off Project site. Damaged glass includes glass with edge damage or other imperfections that, when installed, could weaken glass, impair performance, or impair appearance.
- C. Apply primers to joint surfaces where required for adhesion of sealants, as determined by preconstruction testing.
- D. Install setting blocks in sill rabbets, sized and located to comply with referenced glazing publications, unless otherwise required by glass manufacturer. Set blocks in thin course of compatible sealant suitable for heel bead.
- E. Do not exceed edge pressures stipulated by glass manufacturers for installing glass lites.
- F. Provide spacers for glass lites where length plus width is larger than 50 inches.
 - 1. Locate spacers directly opposite each other on both inside and outside faces of glass. Install correct size and spacing to preserve required face clearances, unless gaskets and glazing tapes are used that have demonstrated ability to maintain required face clearances and to comply with system performance requirements.
 - 2. Provide 1/8-inch minimum bite of spacers on glass and use thickness equal to sealant width. With glazing tape, use thickness slightly less than final compressed thickness of tape.
- G. Provide edge blocking where indicated or needed to prevent glass lites from moving sideways in glazing channel, as recommended in writing by glass manufacturer and according to requirements in referenced glazing publications.
- H. Set glass lites in each series with uniform pattern, draw, bow, and similar characteristics.
- I. Set glass lites with proper orientation so that coatings face exterior or interior as specified.
- J. Where wedge-shaped gaskets are driven into one side of channel to pressurize sealant or gasket on opposite side, provide adequate anchorage so gasket cannot walk out when installation is subjected to movement.
- K. Square cut wedge-shaped gaskets at corners and install gaskets in a manner recommended by gasket manufacturer to prevent corners from pulling away; seal corner joints and butt joints with sealant recommended by gasket manufacturer.

3.4 GASKET GLAZING (DRY)

- A. Cut compression gaskets to lengths recommended by gasket manufacturer to fit openings exactly, with allowance for stretch during installation.
- B. Insert soft compression gasket between glass and frame or fixed stop so it is securely in place with joints miter cut and bonded together at corners.
- C. Installation with Drive-in Wedge Gaskets: Center glass lites in openings on setting blocks, and press firmly against soft compression gasket by inserting dense compression gaskets formed and installed to lock in place against faces of removable stops. Start gasket applications at corners and work toward centers of openings. Compress gaskets to produce a weathertight seal without developing bending stresses in glass. Seal gasket joints with sealant recommended by gasket manufacturer.
- D. Installation with Pressure-Glazing Stops: Center glass lites in openings on setting blocks, and press firmly against soft compression gasket. Install dense compression gaskets and pressure-glazing stops, applying pressure uniformly to compression gaskets. Compress gaskets to produce a weathertight seal without developing bending stresses in glass. Seal gasket joints with sealant recommended by gasket manufacturer.
- E. Install gaskets so they protrude past face of glazing stops.

3.5 SEALANT GLAZING (WET)

- A. Install continuous spacers, or spacers combined with cylindrical sealant backing, between glass lites and glazing stops to maintain glass face clearances and to prevent sealant from extruding into glass channel and blocking weep systems until sealants cure. Secure spacers or spacers and backings in place and in position to control depth of installed sealant relative to edge clearance for optimum sealant performance.
- B. Force sealants into glazing channels to eliminate voids and to ensure complete wetting or bond of sealant to glass and channel surfaces.
- C. Tool exposed surfaces of sealants to provide a substantial wash away from glass.

3.6 CLEANING AND PROTECTION

- A. Immediately after installation remove nonpermanent labels and clean surfaces.
- B. Protect glass from contact with contaminating substances resulting from construction operations. Examine glass surfaces adjacent to or below exterior concrete and other masonry surfaces at frequent intervals during construction, but not less than once a month, for buildup of dirt, scum, alkaline deposits, or stains.
 - 1. If, despite such protection, contaminating substances do come into contact with glass, remove substances immediately as recommended in writing by glass manufacturer. Remove and replace glass that cannot be cleaned without damage to coatings.

ALBUQUERQUE PUBLIC SCHOOLS COYOTE WILLOW PHASE 2 ALBUQUERQUE, NEW MEXICO

- C. Remove and replace glass that is damaged during construction period.
- D. Wash glass on both exposed surfaces not more than four days before date scheduled for inspections that establish date of Substantial Completion. Wash glass as recommended in writing by glass manufacturer.

3.7 MONOLITHIC GLASS SCHEDULE

- A. Glass Type : Clear annealed, and fully tempered where indicated or where required by officials having jurisdiction, float glass.
 - 1. Minimum Thickness: 6 mm.
 - 2. Safety glazing required.

3.8 LAMINATED GLASS SCHEDULE


- A. Glass Type : Clear laminated glass with two plies of annealed, and fully tempered where indicated or where required by officials having jurisdiction, float glass.
 - 1. Minimum Thickness of Each Glass Ply: 3 mm.
 - 2. Interlayer Thickness: 0.030 inch.
 - 3. Safety glazing required.

3.9 INSULATING GLASS SCHEDULE

- A. Glass Type : Low-e-coated, clear insulating laminated glass.
 - 1. Overall Unit Thickness: 1 inch.
 - 2. Outdoor Lite: Clear laminated glass with two plies of float glass.
 - a. Thickness of Each Glass Ply: 3.0 mm.
 - b. Interlayer Thickness: 0.030 inch.
 - 3. Indoor Lite: Clear, fully tempered.
 - a. Thickness of Indoor Lite: 6.0 mm.
 - 4. Interspace Content: Air.
 - 5. Low-E Coating: Manufacturer's low-e coating on third surface.
 - 6. Visible Light Transmittance: 70 percent minimum.
 - 7. Winter Nighttime U-Factor: 0.29 maximum.
 - 8. Summer Daytime U-Factor: 0.28 maximum.
 - 9. Solar Heat Gain Coefficient: 0.38 maximum.
 - 10. Provide safety glazing labeling.
 - 11. Basis of Design Product: Solarban 60 as manufactured by PPG Industries, Inc. or approved equal.

END OF SECTION 08 8000

3050 08 8000 - GLAZING - 10

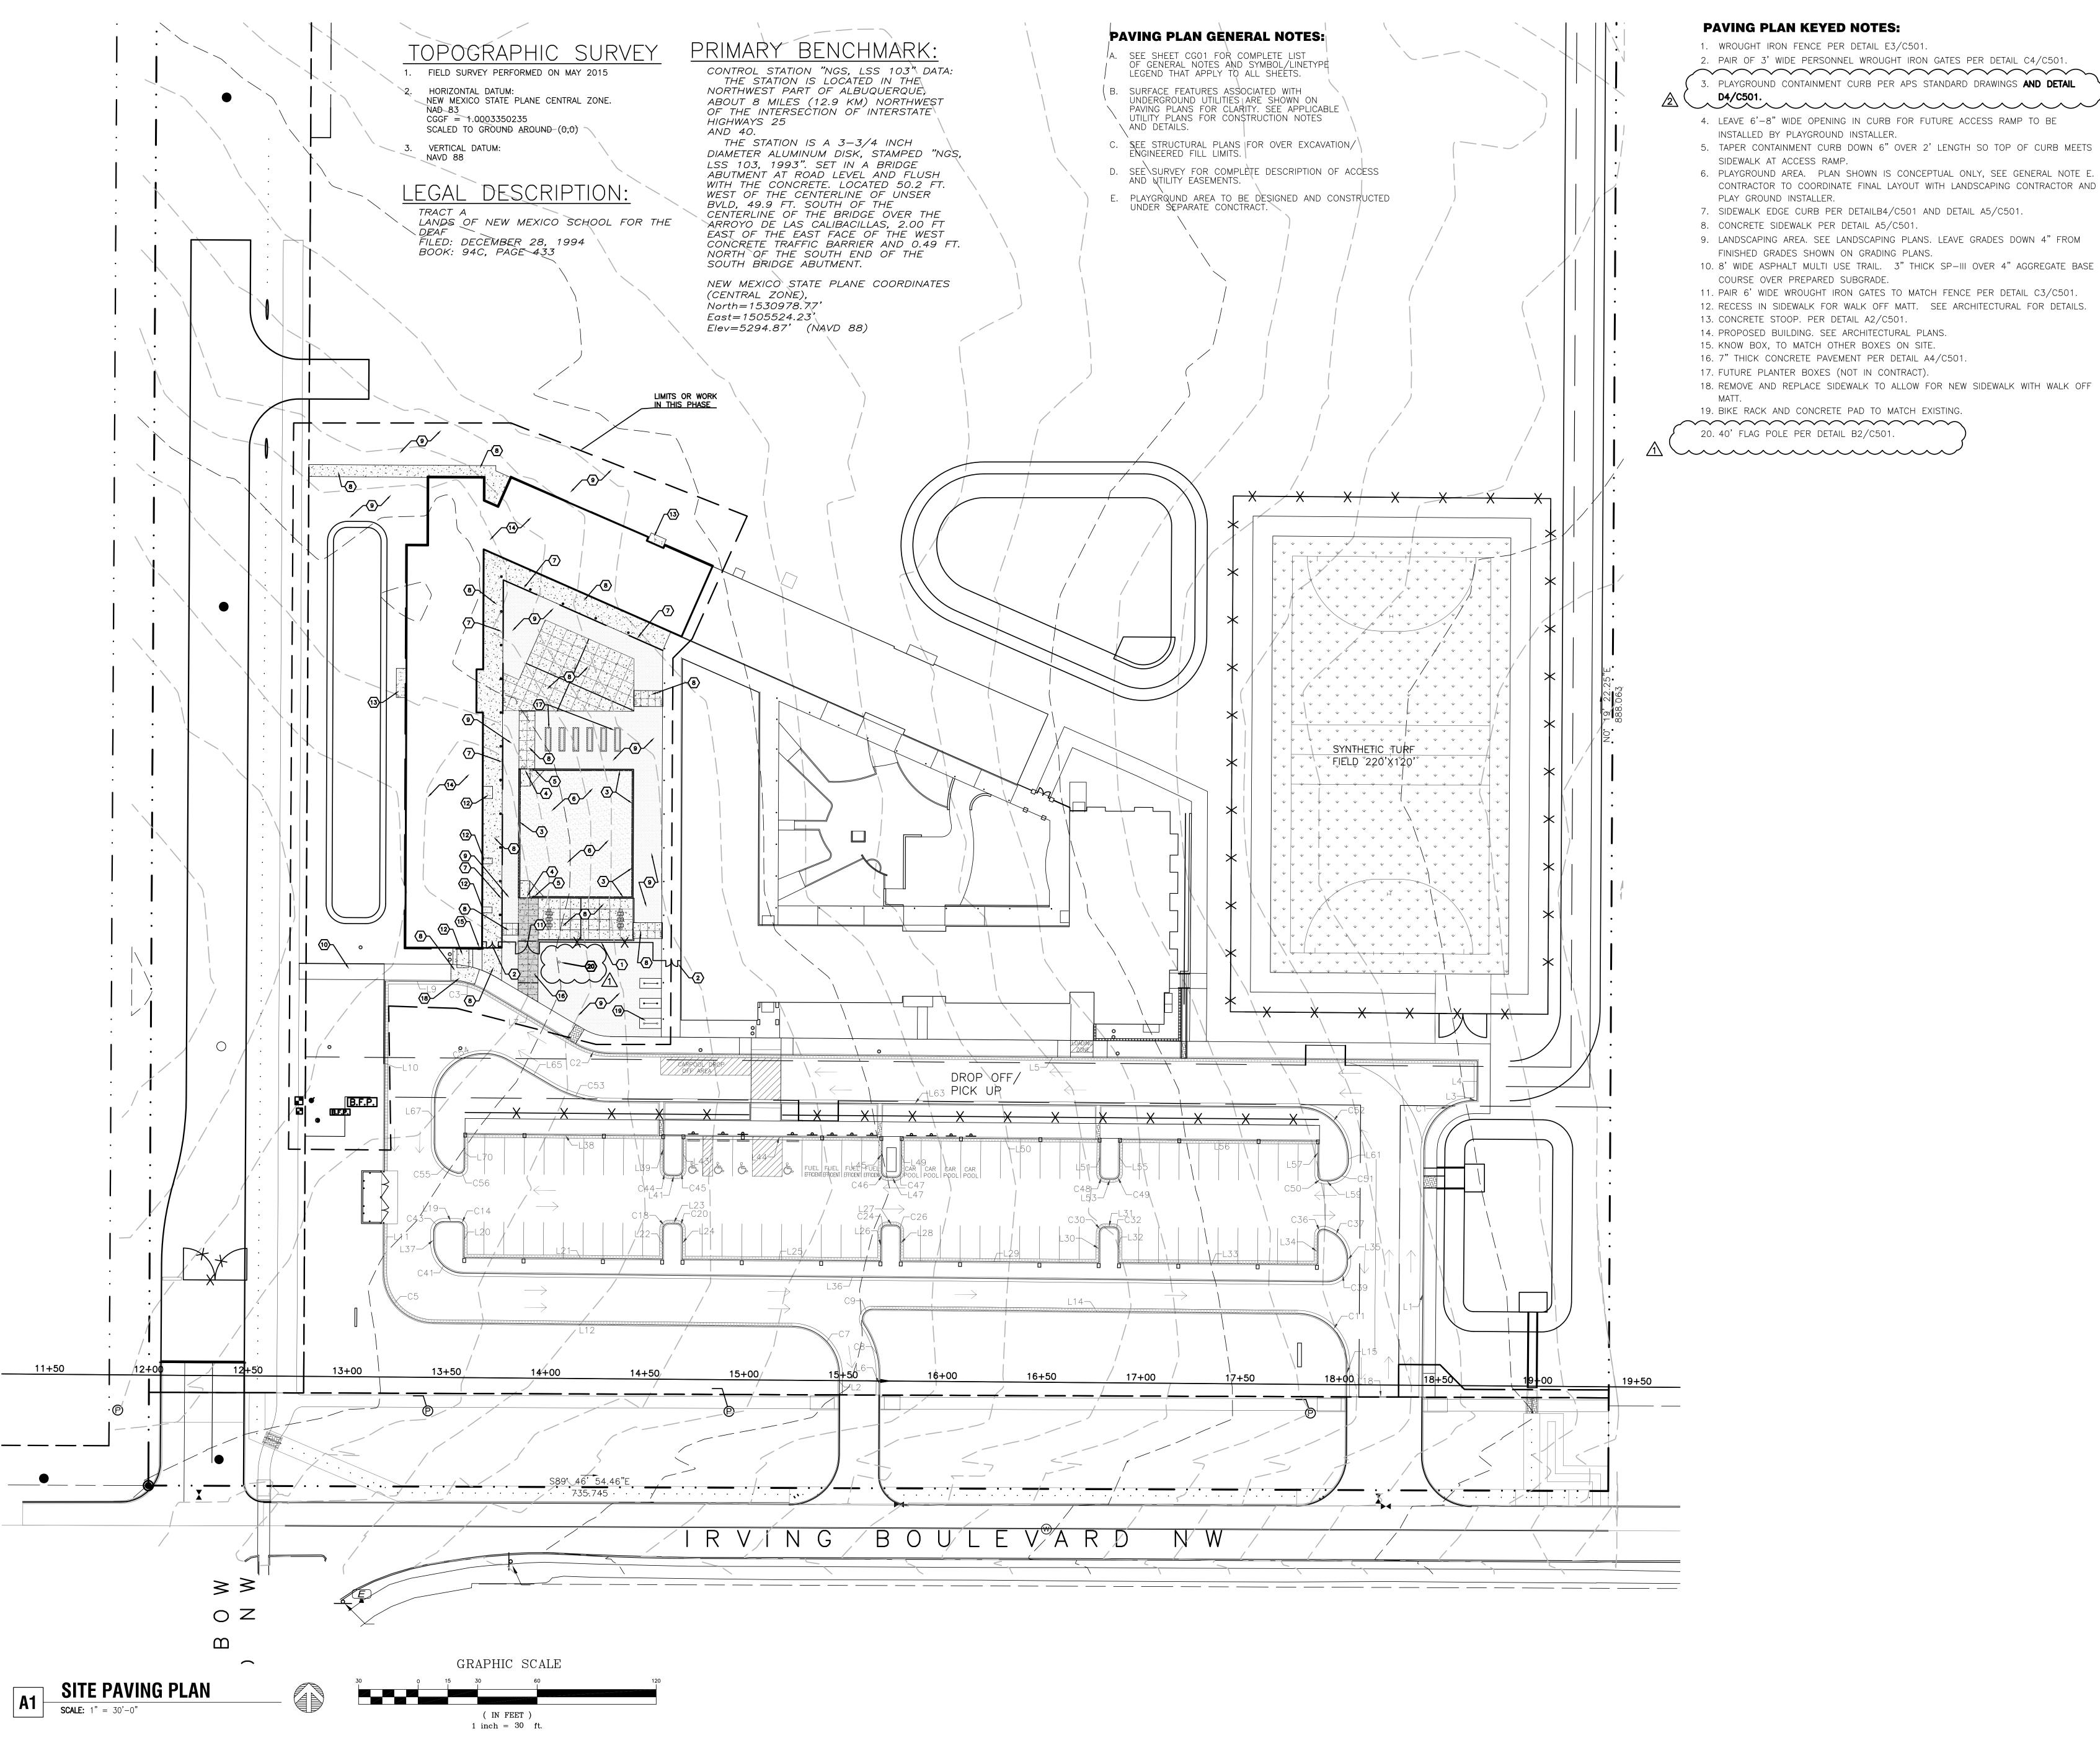




THE HARTMAN + MAJEWSKI Design Group ARCHITECTS · ENGINEERS · INTERIOR DESIGN PLANNERS · URBAN DESIGNERS · LEED @ 120 VASSAR DRIVE SE SUITE 100 ALBUQUERQUE, NEW MEXICO 87106 PHONE: 505.242.6880 FAX: 505.242.6881

CONSULTANT

STAMP



PROJECT NAME

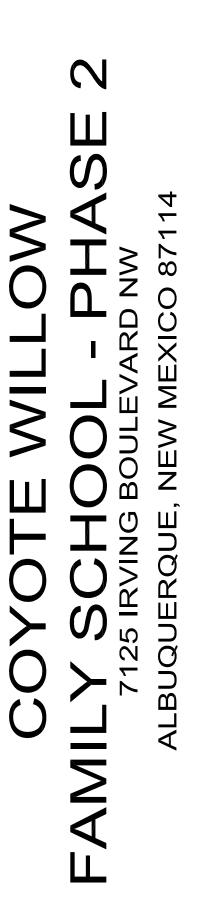


REV	REVISIONS				
NO.	DATE	DESCRIPTION			
1	8.30.19	ADDENDUM 002			
2	9.10.19	ADDENDUM 003			
COF	- PYRIGHT	DESIGN GROUP			
DES	DESIGNER: DAA				
	ECKED:	DAA			
DAT		08.16.2019			
SCA		1" = 30'-0"			
	3 NO.:	3050			
-) FILE:	3042 C101			
CAL		3042_0101 			
SHE	EET TITLE:				

SITE PAVING PLAN

SHEET NUMBER:

C101

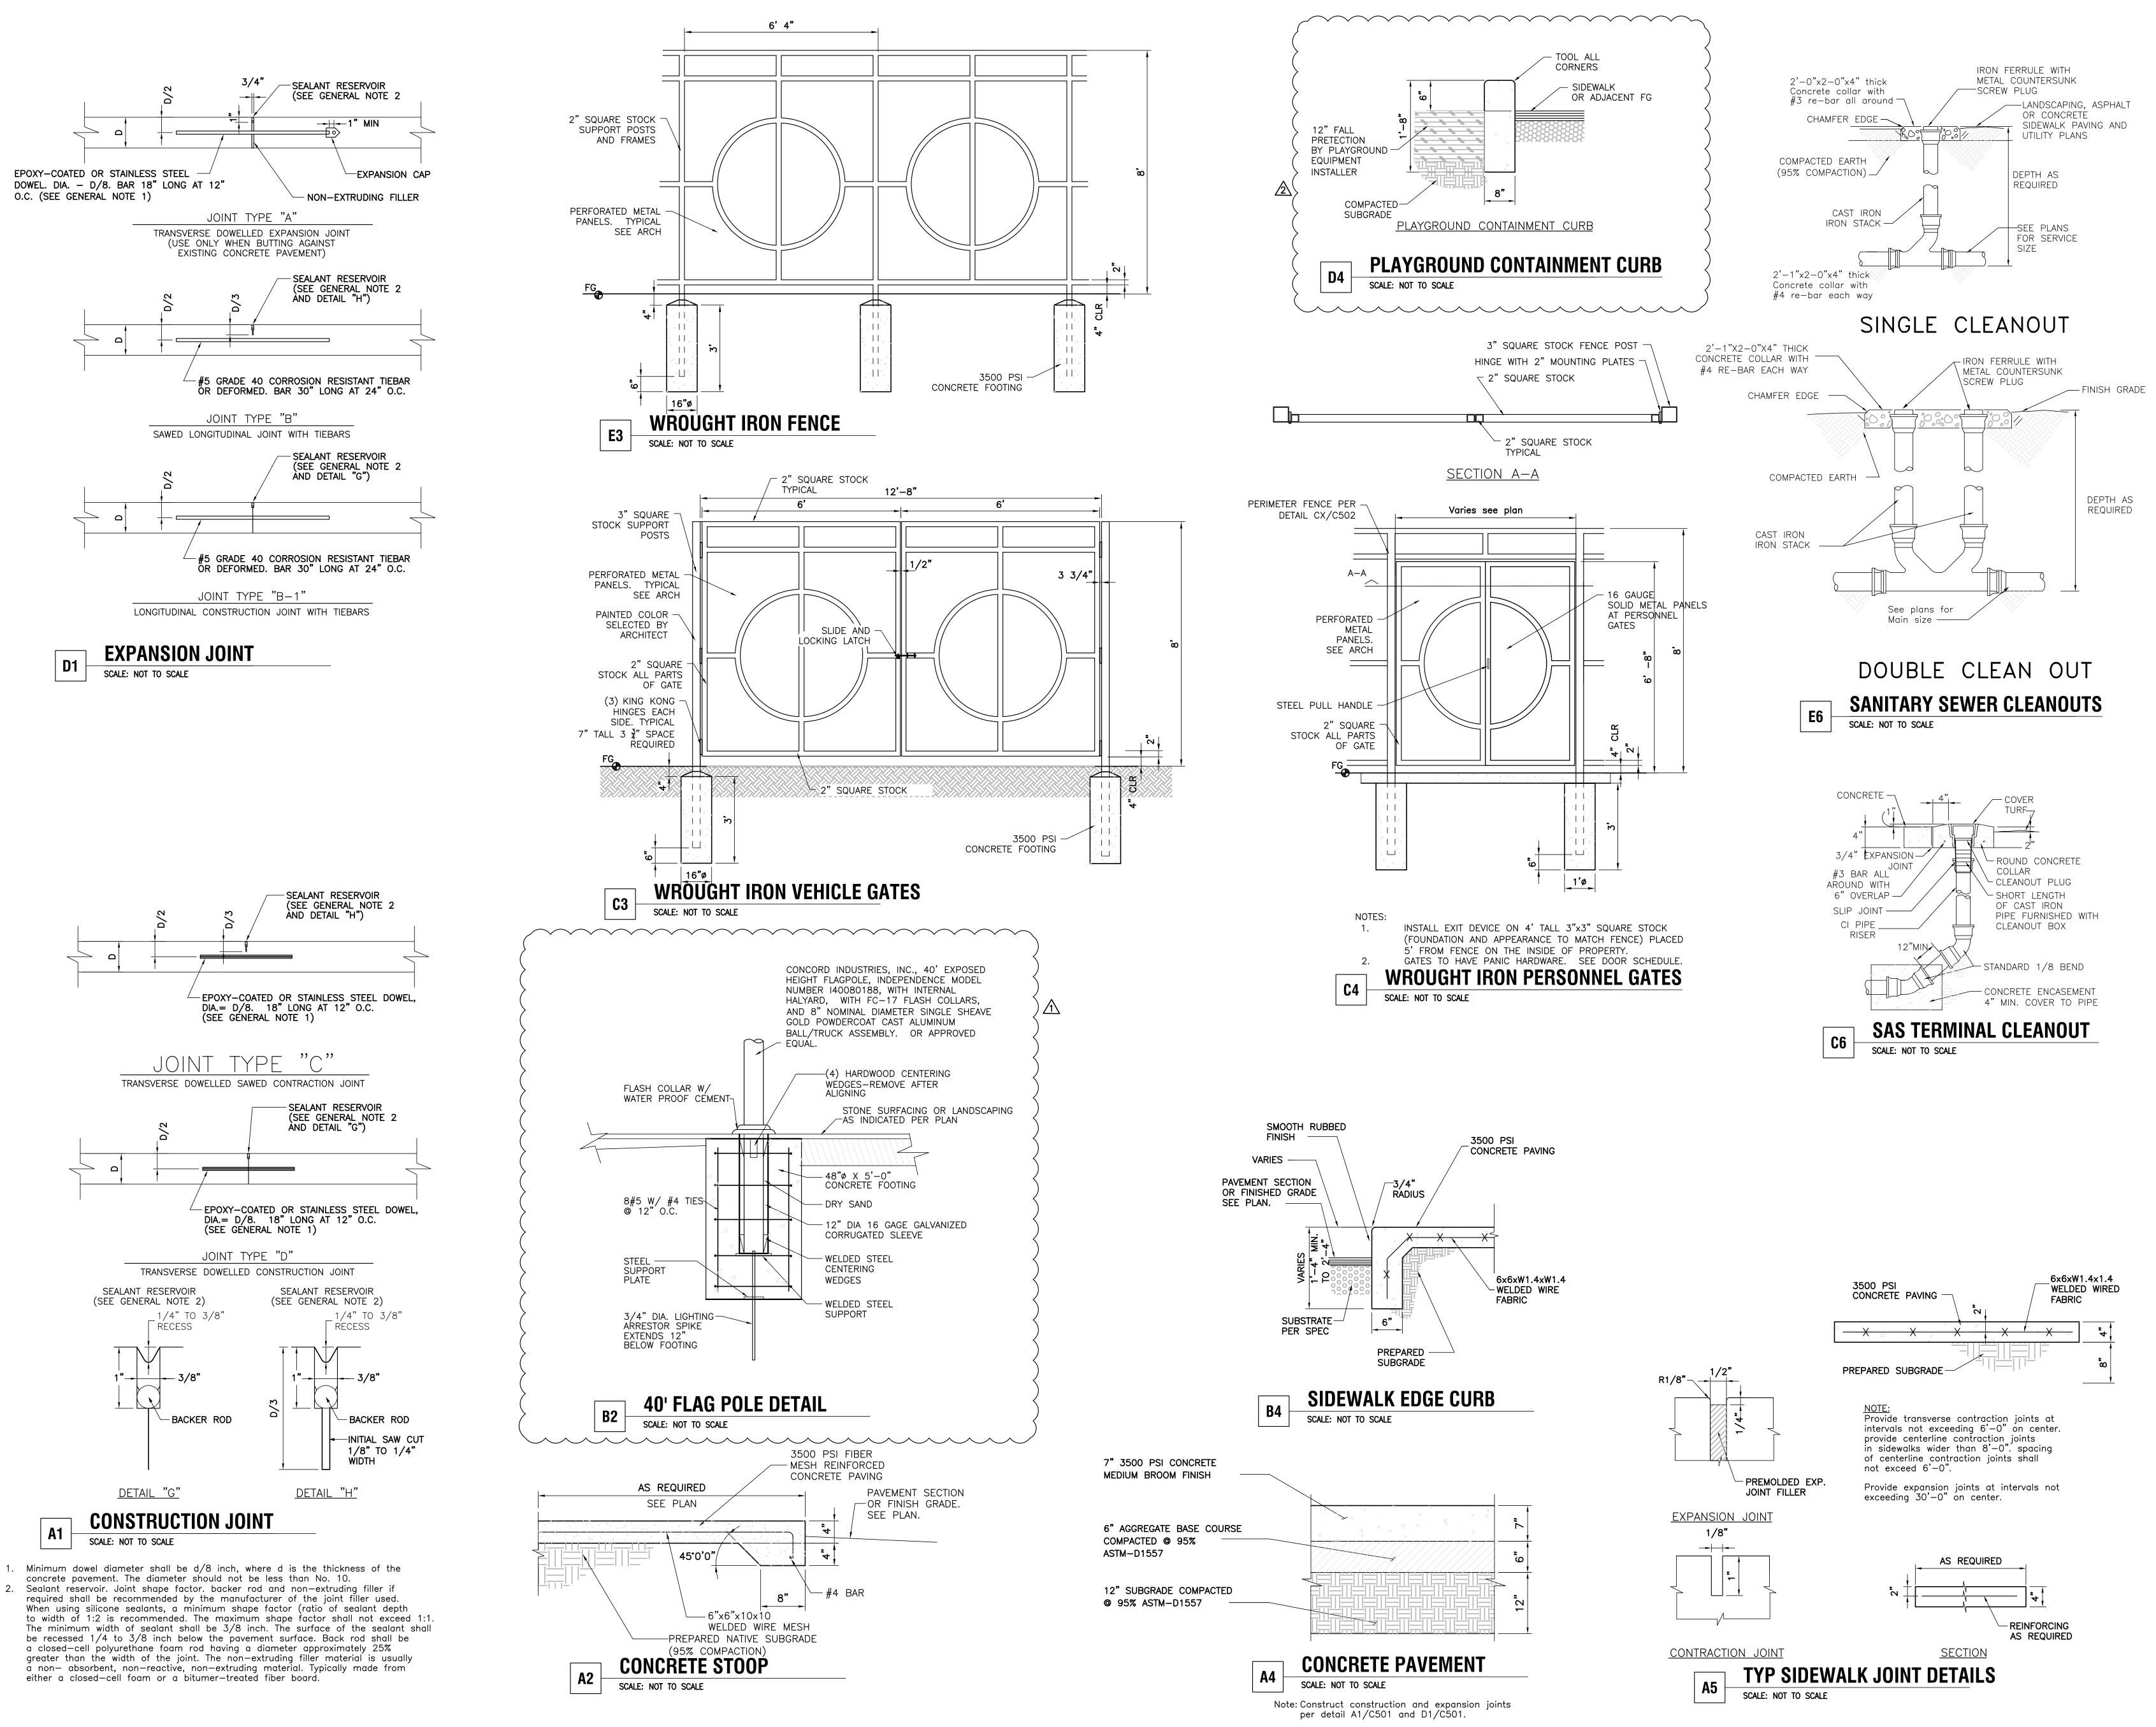



THE HARTMAN + MAJEWSKI ⊿т ESIGN (, Rouf ARCHITECTS ENGINEERS INTERIOR DESIGN PLANNERS URBAN DESIGNERS · LEED ® 120 VASSAR DRIVE SE SUITE 100 ALBUQUERQUE, NEW MEXICO 87106 PHONE: 505.242.6880 FAX: 505.242.6881

CONSULTANT

STAMP



PROJECT NAME



REVISIONS			
NO.	DATE	DESCRIPTION	
1	8.30.19	ADDENDUM 002	
2	9.10.19	ADDENDUM 003	
COF	PYRIGHT -	DESIGN GROUP	
DES	GNER:	DAA	
CHE	ECKED:	DAA	
DAT	E:	08.16.2019	
SCALE:		VARIES	
JOB	NO.:	3050	
CAE	FILE:	3042-C501	

SHEET TITLE: CIVIL DETAILS

SHEET NUMBER:

C501

F	GENERAL STRUCTURAL NOTES	
	1. CODES AND MANUALS:	(1) FOF
	International building code, 2015 Edition	THA
	AISC MANUAL OF STEEL CONSTRUCTION, 9TH EDITION	(8) BA
	AISI COLD FORMED STEEL MANUAL, CURRENT EDITION ACI BUILDING CODE REQUIREMENTS FOR REINFORCED CONCRETE, ACI-318	ACC
	AWS DI.I AND DI.3	IN C
	A. VERTICAL:	(9) REIN UNL
	LIVE LOAD	
	ROOF 20 PSF (1 _g =1.1) * LOAD HAS NOT BEEN REDUCED	C. STRUC (1) ALL
	B. HORIZONTAL LOADS:	
	(1) WIND* SIMPLIFIED PROCEDURE PER SECTION 1609,6	
	P = WIND PRESSURE × C Iw	(2) ALL CON
	WIND SPEED $V36=115$ MPH WIND PRESSURE : END ZONE 21.0 PSF	(3) ALL
	INTERIOR ZONE 13.9 PSF	GR4 (4) BO
E	HEIGHT & EXPOSURE ADJUSTMENT COEFFICIENT $C=1.40$ IMPORTANCE FACTOR IW = 1.15	NOT
	HORIZONTAL WIND LOAD: END ZONE 25.41 PSF	(5) ALI
	INTERIOR ZONE 16.82 PSF	(6) AN A36
	(2) SEISMIC* \vee = Sds W / (R/le) SPECTRAL ACCELERATIONS Ss = 0.475	BAS
	SI=0.143	(T) ALL DAI
	SITE CLASS C IMPORTANCE FACTOR le = 125	(8) ALI
	DESIGN SPECTRAL RESPONSE Sds = 0.380	DRI
	ONE SECOND PERIOD RESPONSE ACCEL. Sdl = 0.158	
	RESPONSE MODIFICATION COEFFICIENT $R = 4$ SEISMIC FORCE $\forall = 0.067 \times W$	IN C
	SEISMIC DESIGN CATEGORY = C	STR PAI
	* ALLOWABLE 1/3 STRESS INCREASE FOR WIND OR SEISMIC LOADING C. ALLOWABLE SOIL BEARING PRESSURE = 2000 PSF	D. LÌGHT
		(1) ALL
	3. GENERAL: A, THE CONTRACTOR SHALL VERIFY ALL DIMENSIONS IN THE FIELD.	"SF
	B. SHOP DRAWINGS SHALL BE FURNISHED AND REVIEWED BEFORE ANY FABRICA-	MEI (2) WA
	TION OR ERECTION IS STARTED. THE CONTRACTOR SHALL REVIEW AND	(E) ⁻
D	APPROVE SHOP DRAWINGS PRIOR TO SUBMITTAL TO THE ARCHITECT FOR REVIEW, POORLY EXECUTED SHOP DRAWINGS WILL BE REJECTED AND SHALL	CH. (3) PR
D	BE RESUBMITTED.	PR
	C. THE CONTRACTOR SHALL BE RESPONSIBLE FOR PROVIDING SAFE AND ADEQUATE SHORING FOR ALL PARTS OF THE STRUCTURE DURING CONSTRUCTION.	(4) LIG SH(
	D. TEMPORARY PROVISIONS SHALL BE MADE FOR STRUCTURAL STABILITY DURING	(5) AL
	CONSTRUCTION. THE STRUCTURE SHOWN ON THE DRAWINGS HAS BEEN	ANC
	DESIGNED FOR STABILITY UNDER FINAL CONFIGURATION. E. THE CONTRACTOR SHALL COORDINATE AND VERIFY ALL OPENINGS IN FLOORS,	EP
	ROOF, WALLS AND BEAMS WITH THE INDIVIDUAL TRADES.	E. WOOD
	F. NOTCHING OR CUTTING ANY STRUCTURAL MEMBER IN THE FIELD IS PROHIBITED. G. THE CONTRACTOR SHALL VERIFY THE SIZE AND LOCATION OF FOUNDATIONS	(1) ALL WIT
	UNDER MECHANICAL AND ELECTRICAL EQUIPMENT AS REQUIRED. NO CONCRETE	
	PADS SHALL BE LOCATED ON ROOF UNLESS SHOWN ON STRUCTURAL DRAWINGS. H. REMOVAL OF FORMS AND SHORING SHALL BE IN ACCORDANCE WITH ACI 347.	
	4. MATERIALS: A. CAST-IN-PLACE CONCRETE:	
	(1) ALL CONCRETE SHALL CONFORM TO THE SPECIFICATIONS FOR STRUCTURAL	(2) SA
	CONCRETE, ACI 301-96. (2) ALL EXPOSED EDGES OF CONCRETE SHALL HAVE A $^{3}_{4}$ " CHAMFER UNLESS	WIT
	NOTED OTHERWISE.	
С	(3) NORMALWEIGHT CONCRETE:	
Ũ	A, F'C = 4000 PSI @ 28 DAYS (AIR ENTRAINED) - ALL EXPOSED EXTERIOR CONCRETE FLAT WORK, (I.E. SLABS, EQUIPMENT PADS, ETC.).	
	B. F'C = 3000 PSI @ 28 DAYS (AIR ENTRAINED) - ALL INTERIOR CONCRETE	
	$\frac{2}{(C. F'C = 4000 PSI = 28 DAYS - ALL INTERIOR SLABS.)}$	(3) PR
	(4) THE CONTRACTOR SHALL NOT CAST FOUNDATIONS, GRADE BEAMS OR	PA Wit
	RETAINING WALLS AGAINST EXCAVATED VERTICAL SIDE SURFACES.	A,
	B. REINFORCING STEEL: (1) ALL REINFORCING STEEL SHALL BE FABRICATED AND PLACED IN	
	ACCORDANCE WITH THE BUILDING CODE REQUIREMENTS FOR REINFORCED	
	CONCRETE (ACI 318-99) AND THE STANDARD MANUAL (ACI 315-92).	
	(2) ALL REINFORCING STEEL SHALL CONFORM TO ASTM AG15 GRADE 60 EXCEPT STIRRUPS, TIES AND FIELD-BENT BARS WHICH SHALL CONFORM	В.
	TO ASTM A615 GRADE 40.	
	(3) ALL SLABS SHALL BE REINFORCED AS SHOWN ON THE DRAWINGS. (4) WHERE LAPPED SPLICES IN REINFORCING OCCUR, THE MINIMUM LAP	
	SHALL BE MADE AS FOLLOWS UNLESS NOTED OTHERWISE ON DRAWINGS:	
	A. VERTICAL REINFORCING:30 BAR DIA. OR 18" MINIMUM	
	B. HORIZONTAL REINFORCING:30 BAR DIA. OR 18" MINIMUM (5) ALL HORIZONTAL REINFORCING IN FOOTINGS AND WALLS SHALL	(4) PR A.
В	BE CONTINUOUS AROUND CORNERS OR HAVE CORNER BARS OF THE SAME	~*
J	SIZE AND SPACING AS THE HORIZONTAL BARS AND LAP A MINIMUM OF 30 BAR DIAMETERS OR 18 INCHES.	~
	(6) CONCRETE COVER FOR REINFORCING SHALL BE AS FOLLOWS UNLESS	B.
	OTHERWISE NOTED: A. CONCRETE CAST AGAINST AND PERMANENTLY EXPOSED TO EARTH	
	B. CONCRETE EXPOSED TO EARTH OR WEATHER:	C.
	1. BARS LARGER THAN NO. 5	(5) AF
	2. BARS NO. 5 OR SMALLER $1\frac{1}{2}$ "	А,
		B.

1

2

ORM TIES SHALL BE EITHER OF THE THREADED OR SNAP-OFF TYPE SO HAT NO METAL WILL BE LEFT WITHIN I INCH OF THE SURFACE OF THE WALL. AR SUPPORTS AND SPACERS FOR REINFORCING SHALL BE PROVIDED IN CCORDANCE WITH ACI 315-92. CHAIRS WITH 22 GA. SAND PLATES OR RECAST BLOCKS SHALL BE PROVIDED FOR ALL REINFORCING OF CONCRETE CONTACT WITH GRADE. REINFORCING SHALL BE SECURELY TIED TO SUPPORTS. EINFORCING SHALL NOT BE TACK WELDED OR WELDED IN ANY MANNER NLESS SPECIFICALLY DETAILED ON THE STRUCTURAL PLANS.

- ICTURAL AND MISCELLANEOUS STEEL:
- LL STRUCTURAL STEEL SHALL BE DETAILED AND FABRICATED IN ACCOR-ANCE WITH THE AISC "SPECIFICATION FOR THE DESIGN, FABRICATION ND ERECTION OF STRUCTURAL STEEL FOR BUILDINGS".
- LL STRUCTURAL AND MISCELLANEOUS STEEL MEMBERS, SHAPES AND ONNECTIONS SHALL CONFORM TO ASTM A36 UNLESS NOTED OTHERWISE. ALL COLD FORMED STRUCTURAL TUBING SHALL CONFORM TO ASTM A500. RADE B. FY=46 KSI
- BOLTS SHALL CONFORM TO ASTM A325 TENSION CONTROL BOLTS UNLESS OTED OTHERWISE, WITH SIZES AS SHOWN ON THE DRAWINGS. ALL BOLTS SHALL BE TIGHTENED SO AS TO SHEAR THE SPLINE OFF THE BOLT. ANCHOR BOLTS EMBEDDED IN CONCRETE SHALL BE ASTM A307 BOLTS OR 36 THREADED BARS, PROVIDE FLAT WASHERS BETWEEN ALL NUTS AND ASEPLATES.
- LL WELDING SHALL BE DONE IN ACCORDANCE WITH THE LATEST STAN-ARDS OF THE AWS STRUCTURAL WELDING CODE. ALL BOLT HOLES THAT ARE REQUIRED TO BE FIELD DRILLED SHALL BE
- RILLED WITH A MAG DRILL. FLAME CUTTING OF HOLES OR ENLARGING F UNFAIR HOLES WILL NOT BE ALLOWED. IEADED CONCRETE ANCHORS AND SHEAR CONNECTORS SHALL BE TYPE B,
- I CONFORMANCE WITH AWS D1.1 "STRUCTURAL WELDING CODE-STEEL" TRUCTURAL STEEL TO RECEIVE SHEAR CONNECTIONS SHALL BE FREE OF AINT. WELDING PRE QUALIFICATION REQUIRED.
- HTGAGE STRUCTURAL STEEL FRAMING (20 GAGE OR HEAVIER): LL LIGHTGAGE METAL FRAMING SHALL CONFORM TO AISI SPECIFICATION FOR THE DESIGN OF COLD-FORMED STEEL STRUCTURAL
- 1EMBERS", 2007. JALLS TO BE PROVIDED WITH MANUFACTURER'S STANDARD BRIDGING: EITHER WELDED $2\frac{1}{2}$ " X 18 GA, STUD OR CLIPPED COLD-ROLLED HANNEL $1\frac{1}{2}$ " X 16 GA.), PROVIDE BRIDGING AT 4'-0" O.C. MAXIMUM. PROVIDE ALL MISCELLANEOUS ACCESSORIES AND FOLLOW ERECTION
- PROCEDURES AS PER MANUFACTURER'S SPECIFICATIONS AND RECOMMENDATIONS. IGHTGAGE STEEL FRAMING SHALL MEET THE MINIMUM PROPERTIES AS HOWN IN THE STEEL STUD SCHEDULE.
- ALL TRACK SHALL BE DEEP LEG (1_2 " FLANGE), 18 GA. MINIMUM. TRACK SHALL BE ANCHORED TO SLAB WITH $\frac{1}{2}$ " DIA. \times 3½" EMBED EXPANSION SLEEVE OR POXY ANCHORS AT 4'-@" O.C. UNLESS SHOWN OTHERWISE ON PLANS.

D FRAMING:

- LL SAWN LUMBER EXCEPT STUDG SHALL BE HEM FIR, NO. 2 OR BETTER
- JITH THE FOLLOWING ALLOWABLE STRESSES: FB = 980 PS MAXIMUM FIBER STRESS IN BENDING (REP): FT = 500 PSI TENSION PARALLEL TO GRAIN: FC = 1250 PSI COMPRESSION PARALLEL TO GRAIN: FC = 405 PSI COMPRESSION PERPENDICULAR TO GRAIN: FV = 75 PSI HORIZONTAL SHEAR: E = 1,300,000 PSI MODULUS OF ELASTICITY: BAWN LUMBER USED FOR STUDS SHALL BE SPRUCE PINE FIR *2 OR BETTER JITH THE FOLLOWING ALLOWABLE STRESSES: FB = 775 PSI MAXIMUM FIBER STRESS IN BENDING (REP): FT = 325 PSI TENSION PARALLEL TO GRAIN: FC = 675 PS COMPRESSION PARALLEL TO GRAIN: FC = 425 PSI COMPRESSION PERPENDICULAR TO GRAIN: FV = 70 PSI HORIZONTAL SHEAR: E = 1200,000 PSI MODULUS OF ELASTICITY: PRE MANUFACTURED BEAMS, LINTELS & COLUMNS SHALL BE EITHER PARALLAM (PSL) OR MICROLLAM (ML) AS INDICATED ON THE PLAN AND JITH THE FOLLOWING ALLOWABLE STRESSES: PARALLAM: FB = 2900 PS MAXIMUM FLEXURAL STRESS: FC = 2900 PSI COMPRESSION PARALLEL TO GRAIN: FC = 650 PSI COMPRESSION PERPENDICULAR TO GRAIN: FV = 290 PSI HORIZONTAL SHEAR: E = 2,000,000 PSI MODULUS OF ELASTICITY: MICROLLAM FB = 2600 PSI MAXIMUM FLEXURAL STRESS: FC = 2310 PS1 COMPRESSION PARALLEL TO GRAIN: FC = 750 PSI
- COMPRESSION PERPENDICULAR TO GRAIN: FV = 285 PSI HORIZONTAL SHEAR: E = 1,900,000 PSI MODULUS OF ELASTICITY: PRE-ENGINEERED WOOD TRUSSES:
- TRUSSES SHALL BE DESIGNED AND FABRICATED WITH WOOD CHORDS AND WOOD WEBS IN ACCORDANCE WITH DESIGNS PREPARED BY A REGISTERED PROFESSIONAL ENGINEER.
- DESIGN STANDARDS SHALL CONFORM TO THE APPLICABLE PROVISIONS OF THE NATIONAL DESIGN SPECIFICATION FOR WOOD CONSTRUCTION AND THE DESIGN SPECIFICATION FOR METAL PLATE CONNECTED WOOD TRUSSES. ALL TRUSSES SHALL BE SECURELY BRACED BOTH DURING ERECTION
- AND AFTER PERMANENT INSTALLATION.
- APA SPAN RATED SHEATHING:
- PLYWOOD OR OSB ROOF AND WALL SHEATHING SHALL BE GRADE STRUCTURAL | AND MANUFACTURED WITH EXTERIOR GLUE.
- SEE PLAN FOR NAILING PATTERN AND THICKNESS OF SHEATHING.
- C. STAGGER JOINTS OF SHEATHING @ ROOF DECK.
- (6) CONNECTIONS:
- A. NAILING SHALL BE IN ACCORDANCE WITH THE IBC NAILING SCHEDULE, TABLE 2304,9,1 UNLESS OTHERWISE NOTED. COMMON OR BOX NAILS
- MAY BE USED EXCEPT WHERE OTHERWISE STATED. B. JOIST HANGERS SHALL BE BY SIMPSON CO. OR EQUAL WITH CONNECTIONS INSTALLED ACCORDING TO MANUFACTURER'S RECOMMENDATIONS.
- C. BOLTS SHALL BE ASTM A307 UNO ON PLANS.
- D. STEEL SIDE PLATES SHALL BE ASTM A36.

5. PER IBC SECTION 1704, SPECIAL INSPECTION IS REQUIRED FOR ITEMS:

- A. CONCRETE:
- (1) DURING THE TAKING ON TEST SPECIMANS.
- (2) DURING THE PLACEMENT OF ALL REINFORCED CONCRETE. B. BOLTS IN CONCRETE:

4

- (1) DURING THE PLACEMENT OF CONCRETE AROUND BOLTS. C. REINFORCING STEEL (PERIODIC):
- (1) DURING THE PLACEMENT OF REINFORCING STEEL FOR ALL CONCRETE REQUIRED TO HAVE SPECIAL INSPECTION NOTED ABOVE. D. WELDING:
- (1) VISUAL INSPECTION OF ALL FIELD WELDS. (2) NON-DESTRUCTIVE TESTING OF ALL COMPLETE PENETRATION WELDS.
- E. HIGH STRENGTH BOLTING: (1) VERIFICATION OF SNUG TIGHT BOLT INSTALLATION FOR A325N BOLTS. (2) VERIFICATION OF SLIP CRITICAL (SC) BOLTS AT ALL BRACED FRAMES.
- F. EXPANSION AND EPOXY BOLTS: (1) DURING THE PLACEMENT OF ALL EXPANSION AND EPOXY BOLTS, FOR
- VISUAL VERIFICATION OF HOLE DIAMETER AND DEPTH AND PLACEMENT OF BOLT AND/OR EPOXY. G. DUTIES AND RESPONSIBILITIES OF THE SPECIAL INSPECTOR:
- (1) THE SPECIAL INSPECTOR SHALL OBSERVE THE WORK ASSIGNED TO BE CERTAIN IT CONFORMS WITH THE APPROVED DESIGN DRAWINGS AND SPECIFICATION.
- (2) THE SPECIAL INSPECTOR SHALL FURNISH INSPECTION REPORTS TO THE BUILDING OFFICIAL, AND TO THE ENGINEER OF RECORD. H. SPECIAL INSPECTOR IS TO BE HIRED BY OWNER, NOT CONTRACTOR.

3

2	THE	FOLLOWING	

GENERAL FOUNDATION NOTES

I. GENERAL

- A. A SUBSURFACE SOIL INVESTIGATION HAS BEEN MADE BY GEO-TEST INC. A REPORT OF THAT INVESTIGATION DATED NOVEMBER 23, 2015 IS AVAILABLE FOR VIEWING AT THE OFFICE OF THE ARCHITECT.
- B. ADDITIONAL INFORMATION CONCERNING SPECIFIC SOIL CONDITIONS TO BE ENCOUNTERED IS AVAILABLE IN THE SOILS REPORT AND SHOULD BE REVIEWED.

2. FIELD OBSERVATION AND TESTS:

- A. THE CONTRACTOR WILL EMPLOY THE SERVICES OF A REGISTERED, LICENSED GEOTECHNICAL ENGINEER TO OBSERVE ALL CONTROLLED EARTHWORK. GEOTECHNICAL ENGINEER SHALL PROVIDE CONTINUOUS ON-SITE OBSERVATION BY EXPERIENCED PERSONNEL DURING INITIAL EXCAVATION, PLACEMENT AND COMPACTION OF STRUCTURAL FILL, AND FOUNDATION EXCAVATIONS. THE CONTRACTOR SHALL NOTIFY THE GEOTECHNICAL ENGINEER AT LEAST TWO WORKING DAYS IN ADVANCE OF ANY FIELD OPERATIONS REQUIRING OBSERVATION.
- B. TESTS OF MATERIALS SHALL BE MADE AT THE FOLLOWING MINIMUM RATES: 1. ONE FIELD DENSITY TEST PER EACH 5000 SQUARE FEET OF NATURAL GROUND PRIOR TO PLACING STRUCTURAL FILL WITH A MINIMUM OF 3 TESTS.
- 2. ONE FIELD DENSITY TEST PER EACH 150 CUBIC YARDS OF STRUCTURAL FILL PLACED OR EACH HORIZONTAL LAYER OF STRUCTURAL FILL, WHICHEVER IS GREATER.
- 3. ONE FIELD DENSITY TEST AT THE LOCATION OF EACH FOUNDATION STRUCTURAL ELEMENT IMMEDIATELY PROIR TO CONCRETE PLACEMENT OR PLACEMENT OF REINFORCING.
- 4. ONE MOISTURE-DENSITY CURVE FOR EACH TYPE OF MATERIAL USED, AS INDICATED BY SIEVE ANALYSIS AND PLASTICITY INDEX.
- C. THE GEOTECHNICAL ENGINEER SHALL SUBMIT THE RESULTS OF ALL REQUIRED TESTS.

3. CLEARING AND GRUBBING:

- A. REMOVE ALL BRUSH, RUBBISH, GRASS, AND GRASS ROOTS TO A DEPTH OF SIX INCHES FROM THE CONSTRUCTION AREA FOR A DISTANCE OF FIVE FEET OUTSIDE BUILDING LINES.
- B. REMOVE STUMPS, MATTED ROOTS AND ROOTS LARGER THAN 2 INCHES IN DIAMETER WITHIN 12 INCHES OF THE SURFACE OF AREAS ON WHICH FILL AND/ OR FOOTINGS ARE TO BE CONSTRUCTED.
- C. REMOVE ALL TOPSOIL FROM THE CONSTRUCTION AREA. THIS MATERIAL SHALL NOT BE USED AS FILL MATERIAL, BUT MAY BE STOCKPILED AND LATER USED IN THE TOP 6 INCHES OF FILL OUTSIDE THE BUILDING PAD.
- 4. SITE, SUBFLOOR AND BEARING SURFACE PREPARATION:
- A. A REPRESENTATIVE OF THE GEOTECHNICAL ENGINEER SHALL BE PRESENT TO CONFIRM COMPLETE EXCAVATION OF ANY UNCONTROLLED FILL OR SOFT AREAS.
- B. OVEREXCAVATE THE ENTIRE BUILDING AREA TO PROVIDE FOUNDATION BEARING ON A MINIMUM OF 1'-O" OF STRUCTURAL FILL. C. STRUCTURAL FILL PLACEMENT SHALL EXTEND LATERALLY BEYOND THE EDGE OF
- PERIMETER FOOTINGS A MINIMUM OF TWO (2) FEET. D. EXISTING ON-SITE SOILS MAY BE ACCEPTABLE AS STRUCTURAL FILL MATERIAL. HOWEVER, THESE SOILS MAY ALSO NEED TO BE BLENDED WITH IMPORTED MATERIAL
- TO MEET THE BELOW DESCRIBED GRADATION AND PLASTICITY INDEX REQUIREMENTS, APPROPRIATE TESTING IS REQUIRED TO VERIFY ACCEPTABILITY OF ON-SITE SOILS. E. PLACE ALL STRUCTURAL FILL IN APPROXIMATELY HORIZONTAL LAYERS NOT
- GREATER THAN EIGHT (8) INCHES IN THICKNESS, MOISTEN TO OPTIMUM MOISTURE CONTENT (+/- 2%) AND COMPACT TO DENSITY SPECIFIED HEREINAFTER.

5. STRUCTURAL FILL REQUIREMENTS: A. GRADATION (ASTM C136);

SRADATION (ASTA CIS	0/:
SIEVE SIZE	PERCENT PASSING BY WEIGHT

3"	100
NO. 4	60-100

- NO. 200 15-45
- B. MAXIMUM PLASTICITY INDEX NOT TO EXCEED 6
- C. MATERIAL LARGER THAN 3 INCHES SHALL NOT BE PLACED IN THE STRUCTURAL FILL. D. NO BRUGH, SOD, FROZEN MATERIAL OR OTHER UNSUITABLE MATERIAL SHALL BE PLACED IN THE STRUCTURAL FILL. MATERIAL SHALL BE PLACED IN SUCH
- A MANNER AS TO RESULT IN A UNIFORMLY COMPACTED FILL.
- 6. COMPACTION REQUIREMENTS:
- A. SUBGRADE SOILS AND STRUCTURAL FILL MATERIALS SHALL BE COMPACTED TO THE FOLLOWING PERCENTAGES OF THE ASTM D 1557 MAXIMUM DRY DENSITY AT +/- 2% OPTIMUM MOISTURE CONTENT.

MATERIAL	

-----STRUCTURAL FILL IN THE BUILDING AREA

SUBBASE FOR SLAB SUPPORT SUBGRADE BELOW STRUCTURAL FILL

MISCELLANEOUS BACKFILL

PERCENT COMPACTION ------

MINIMUM

4

5



SHEET NUMBER:

GENERAL STRUCTURAL NOTES

SHEET	TITLE:

DES	IGNER:	DLR
CHECKED:		MJW
DATE:		9.9.2019
SCALE:		
JOB NO.:		3050
CAD FILE:		

REVISIONS		
NO.	DATE	DESCRIPTION
1	8/29/19	ADDENDUM #2
2	9/9/19	ADDENDUM #3
	•	

COPYRIGHT - DESIGN GROUP





N

PROJECT NAME



THE HARTMAN + MAJEWSKI

DESIGN GROU

ARCHITECTS • ENGINEERS • INTERIOR DESIGN PLANNERS • URBAN DESIGNERS • LEED

120 VASSAR DRIVE SE SUITE 100

ALBUQUERQUE, NEW MEXICO 87106

PHONE: 505.242.6880 FAX: 505.242.6881

TTALES Structural Engineering Civil Engineering

6501 Americas Parkway NE • Suite 301 Albuquerque • New Mexico • 87110 881-3008 • Facsimile 881-4025

| 2

1


А

1

5201

B/F=100'-0'

2

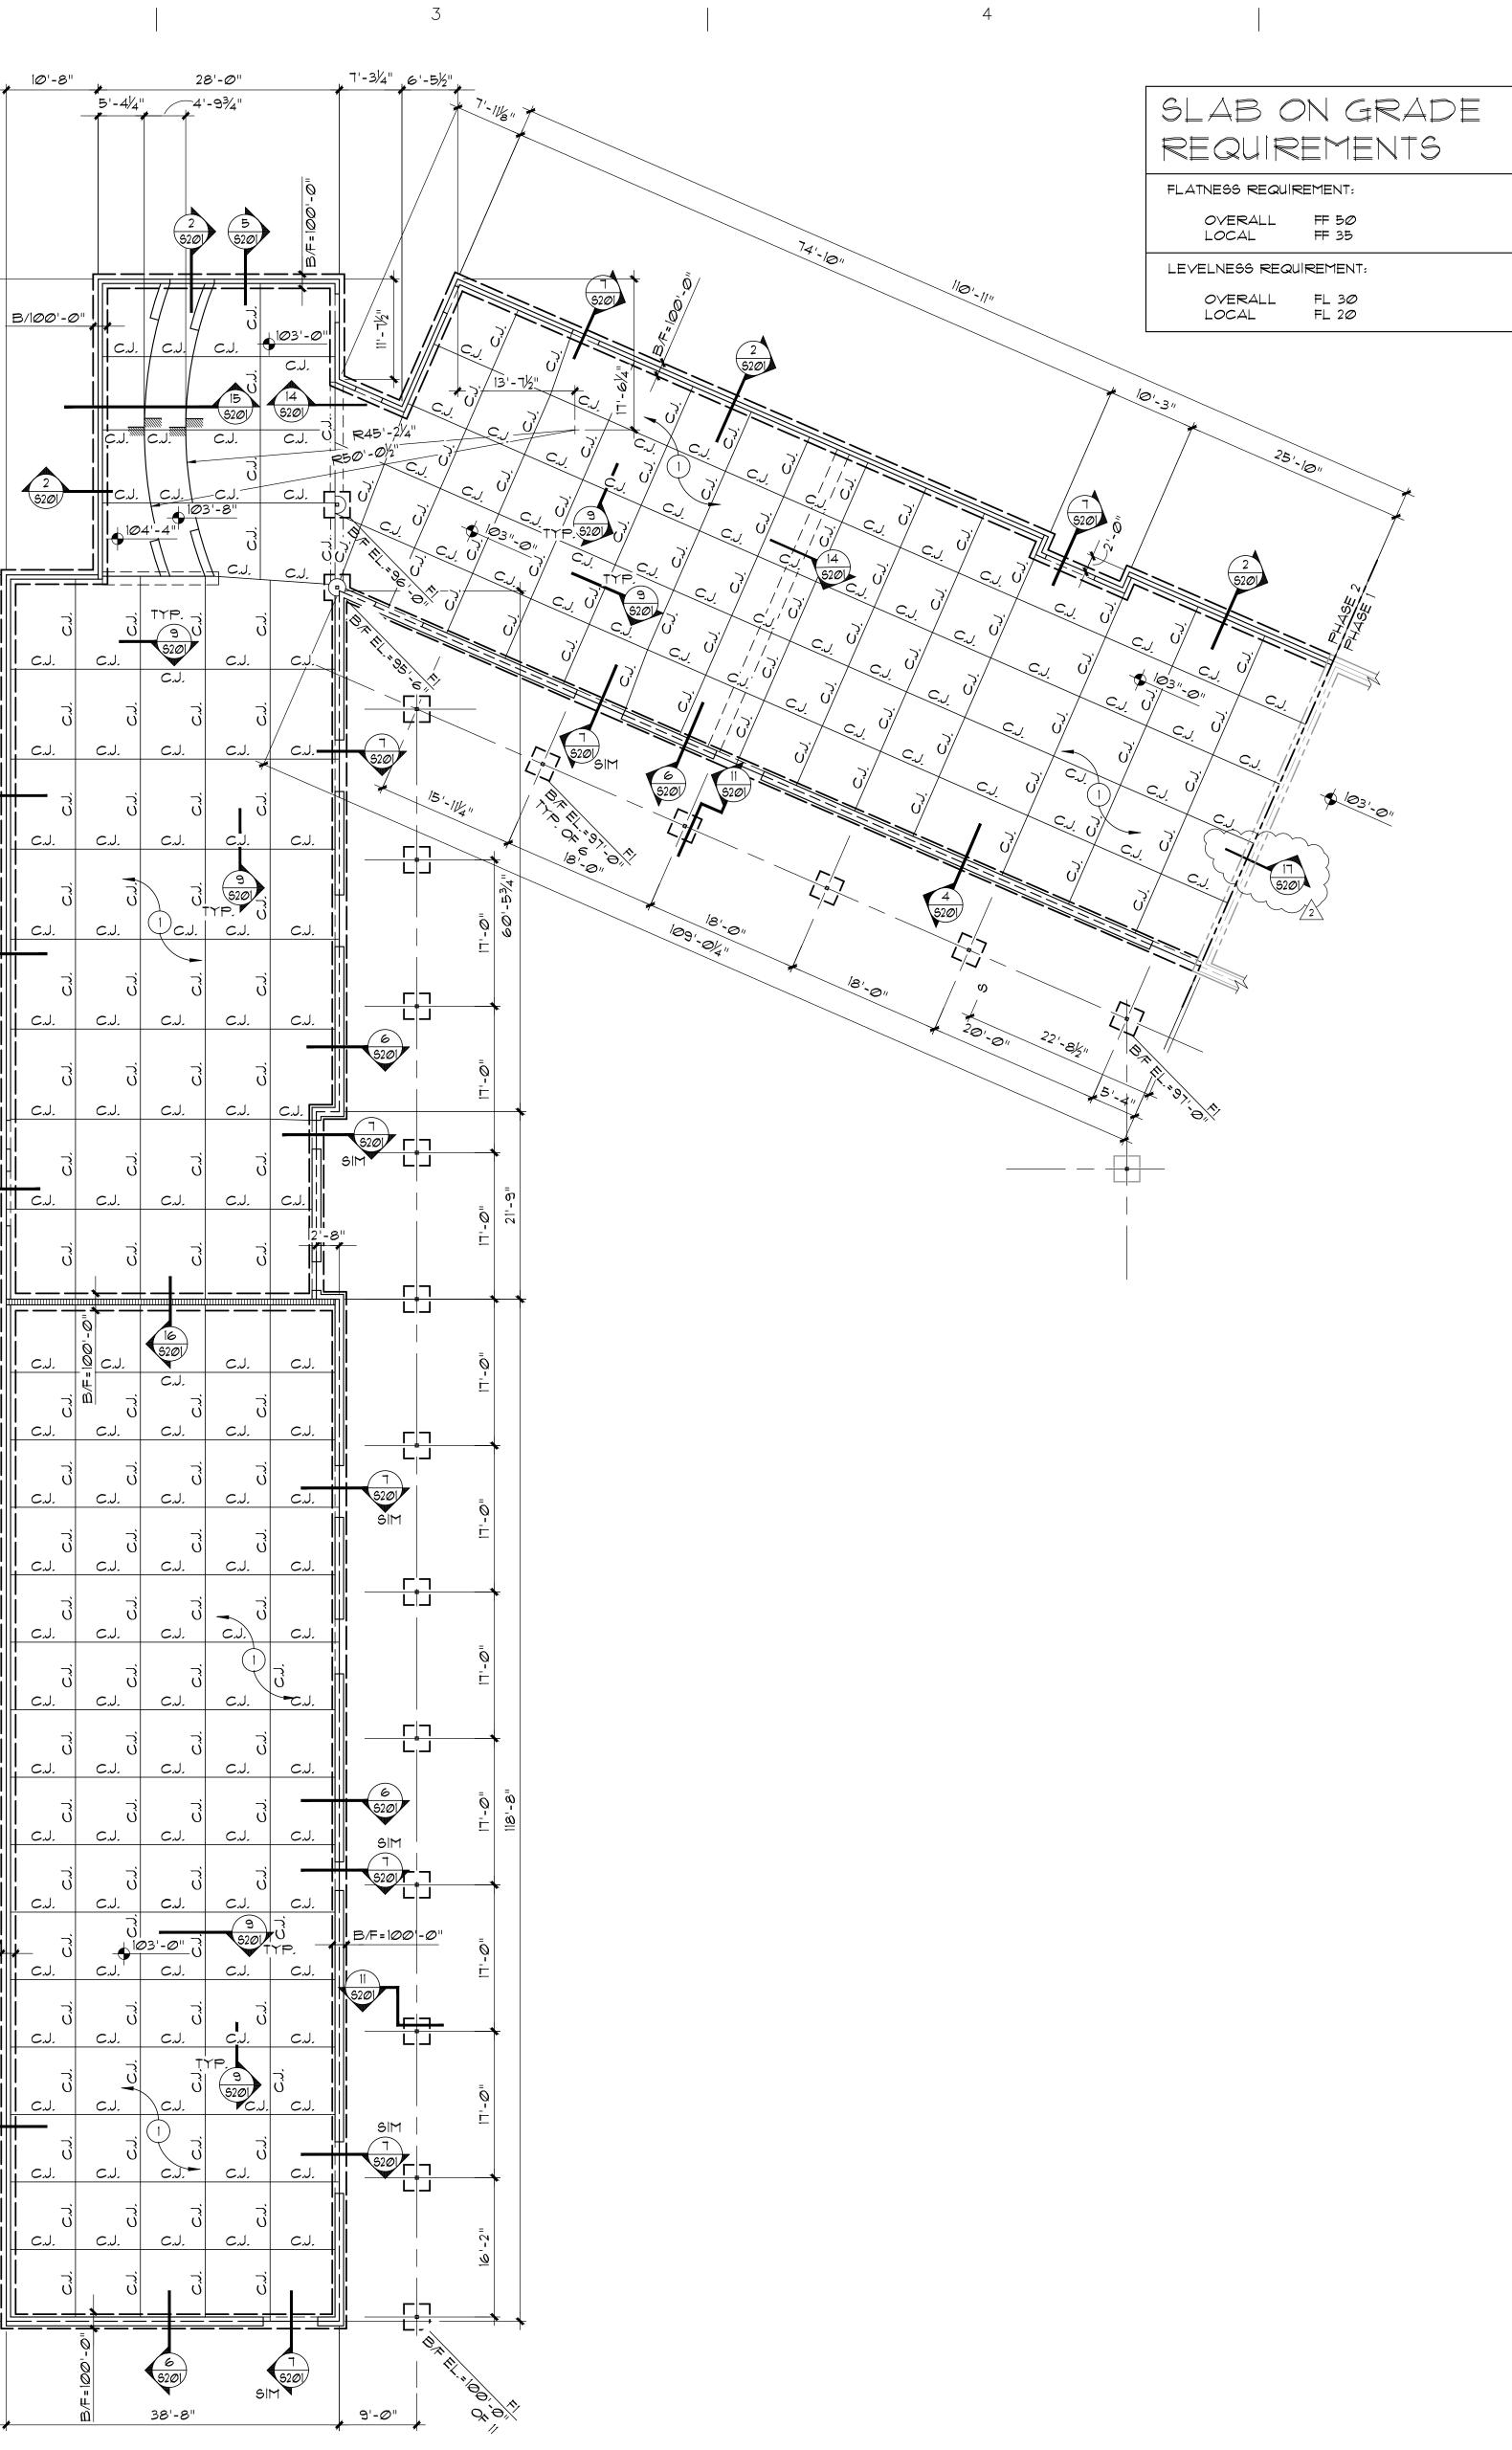

3

3

4

SLAB ON GRADE		
REQUIREMENTS		
FLATNESS REQUIREMENT:		
OVERALL FF 50 LOCAL FF 35		
LEVELNESS REQUIREMENT:		
OVERALL FL 30 LOCAL FL 20		

5

	6
GENERAL	NOTES

- A DIMENSIONS ARE TO EDGE OF CONCRETE STEM WALL OR FACE OF MASONRY (SEE 14/S-201 FOR ONE EXCEPTION) UNLESS NOTED OTHERWISE,
- B C.J. INDICATES CONTROL JOINTS IN THE CONCRETE SLAB, SEE SECTION 5/S201.
- C S B/F EL.=96'-0". B/F EL.=98'-0" S INDICATES STEP IN CONCRETE FOOTING. SEE 12/S201 FOR TYPICAL DETAIL.
- D M.C.J. INDICATES MASONRY CONTROL JOINT. SEE 4/5202 FOR TYPICAL DETAIL.


|--|

- 1. 4" CONCRETE SLAB REINFORCED WITH 6×6-W2.9×W2.9 W.W.F. OVER COMPACTED SUBGRADE, FIN. FLR.= SEE PLAN= M.S.L.E. SEE CIVIL.
- 2. LOCATION OF CHANGE IN FOUNDATION DETAIL.
- 3. 2-#4x4'-Ø" LONG CENTERED IN SLAB.


FOOTING SCHEDULE		
MARK	SIZE	REINFORCING
 ≓1	3'-0" SQ. x 1'-0" DP.	4-#4 E.W.
F2	4'-0" SQ. x 1'-0" DP.	5-#5 E.W.

5



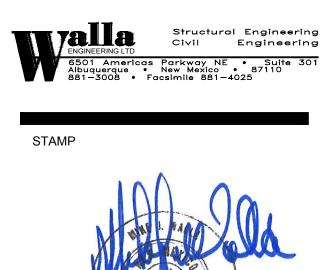

PROJECT NAME

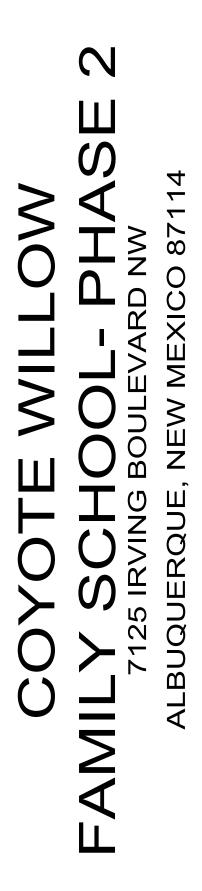

COPYRIGHT - DESIGN GROUP

REVISIONS		
NO.	DATE	DESCRIPTION
1	8/29/19	ADDENDUM #2
2	9/9/19	ADDENDUM #3
DES	GNER:	DLR
CHECKED:		MJW


DATE: SCALE: JOB NO.: 9.9.2019 3050 CAD FILE: SHEET TITLE:


FOUNDATION PLAN

SHEET NUMBER:



6

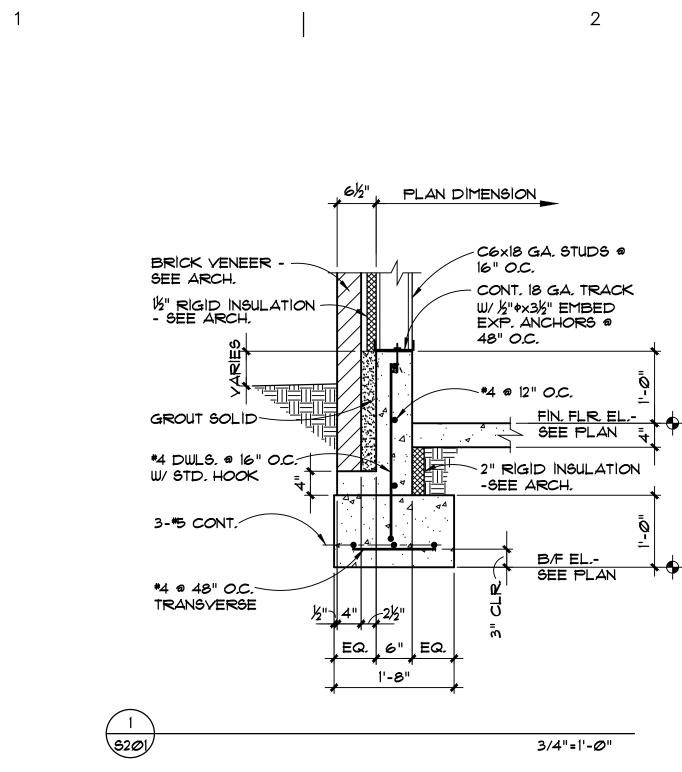

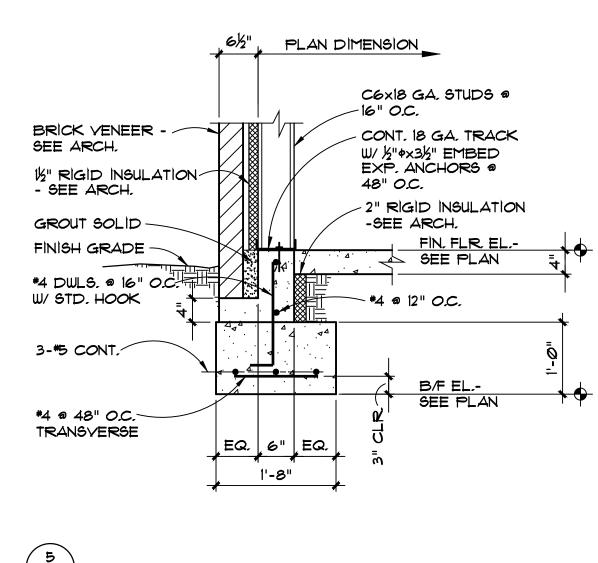

3/4"=1'-Ø"

3/4"=1'-Ø"

#4 @ 48" O.C.

 $\left(14 \right)$

5201

TRANVSERSE

DRILL AND EPOXY

O.C. INTO EXISTING

*4 DOWELS @ 16"

STEMWALL

SEE PLAN

5201

NEW SLAB -


9"

6"


1'-6"

EXISTING

5201

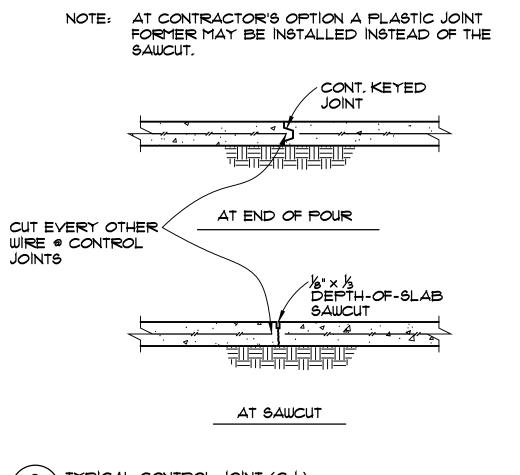

9 TYPICAL CONTROL JOINT (C.J.) 6201

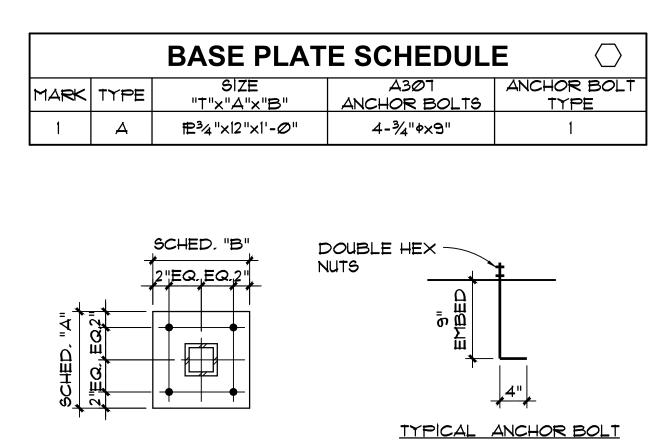

TYPE A

(13)

5201


1

Α

<u>type i</u>

3/4"=1'-Ø"

2

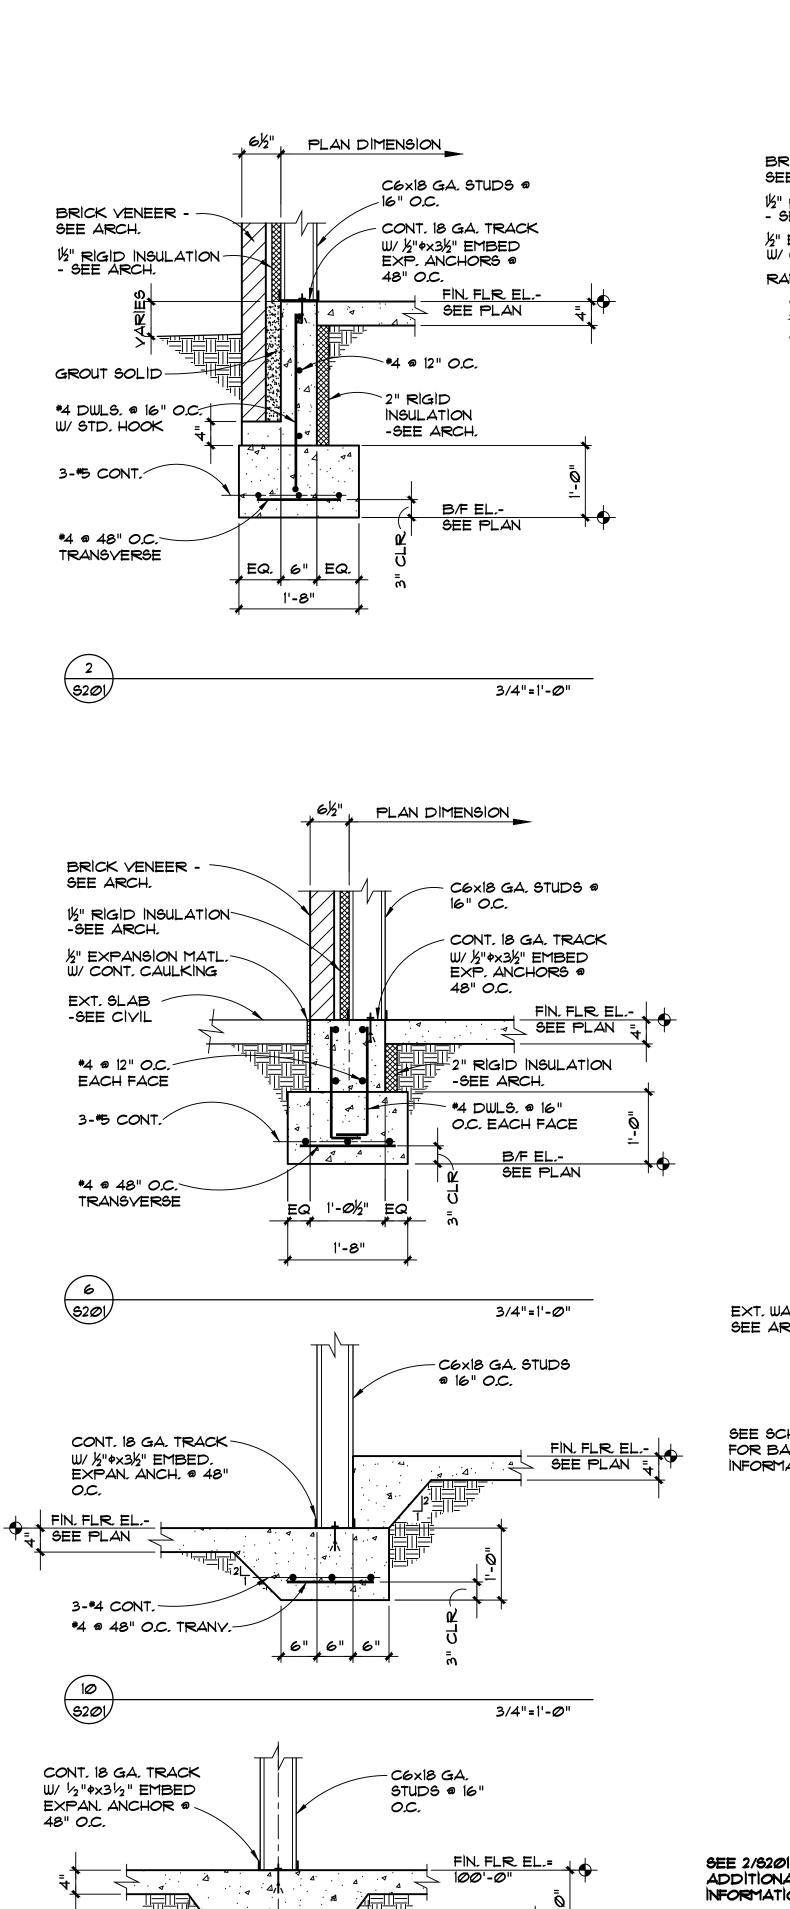

- 3-#4 CONT.

- EXISTING C6X18

GA STUDS @ 16"

FIN, FLR,

EL.-MATCH EXISTING


- EXISTING CONT.

3/4"=1'-Ø"

FOOTING

O.C.

3/4"=1'-Ø"

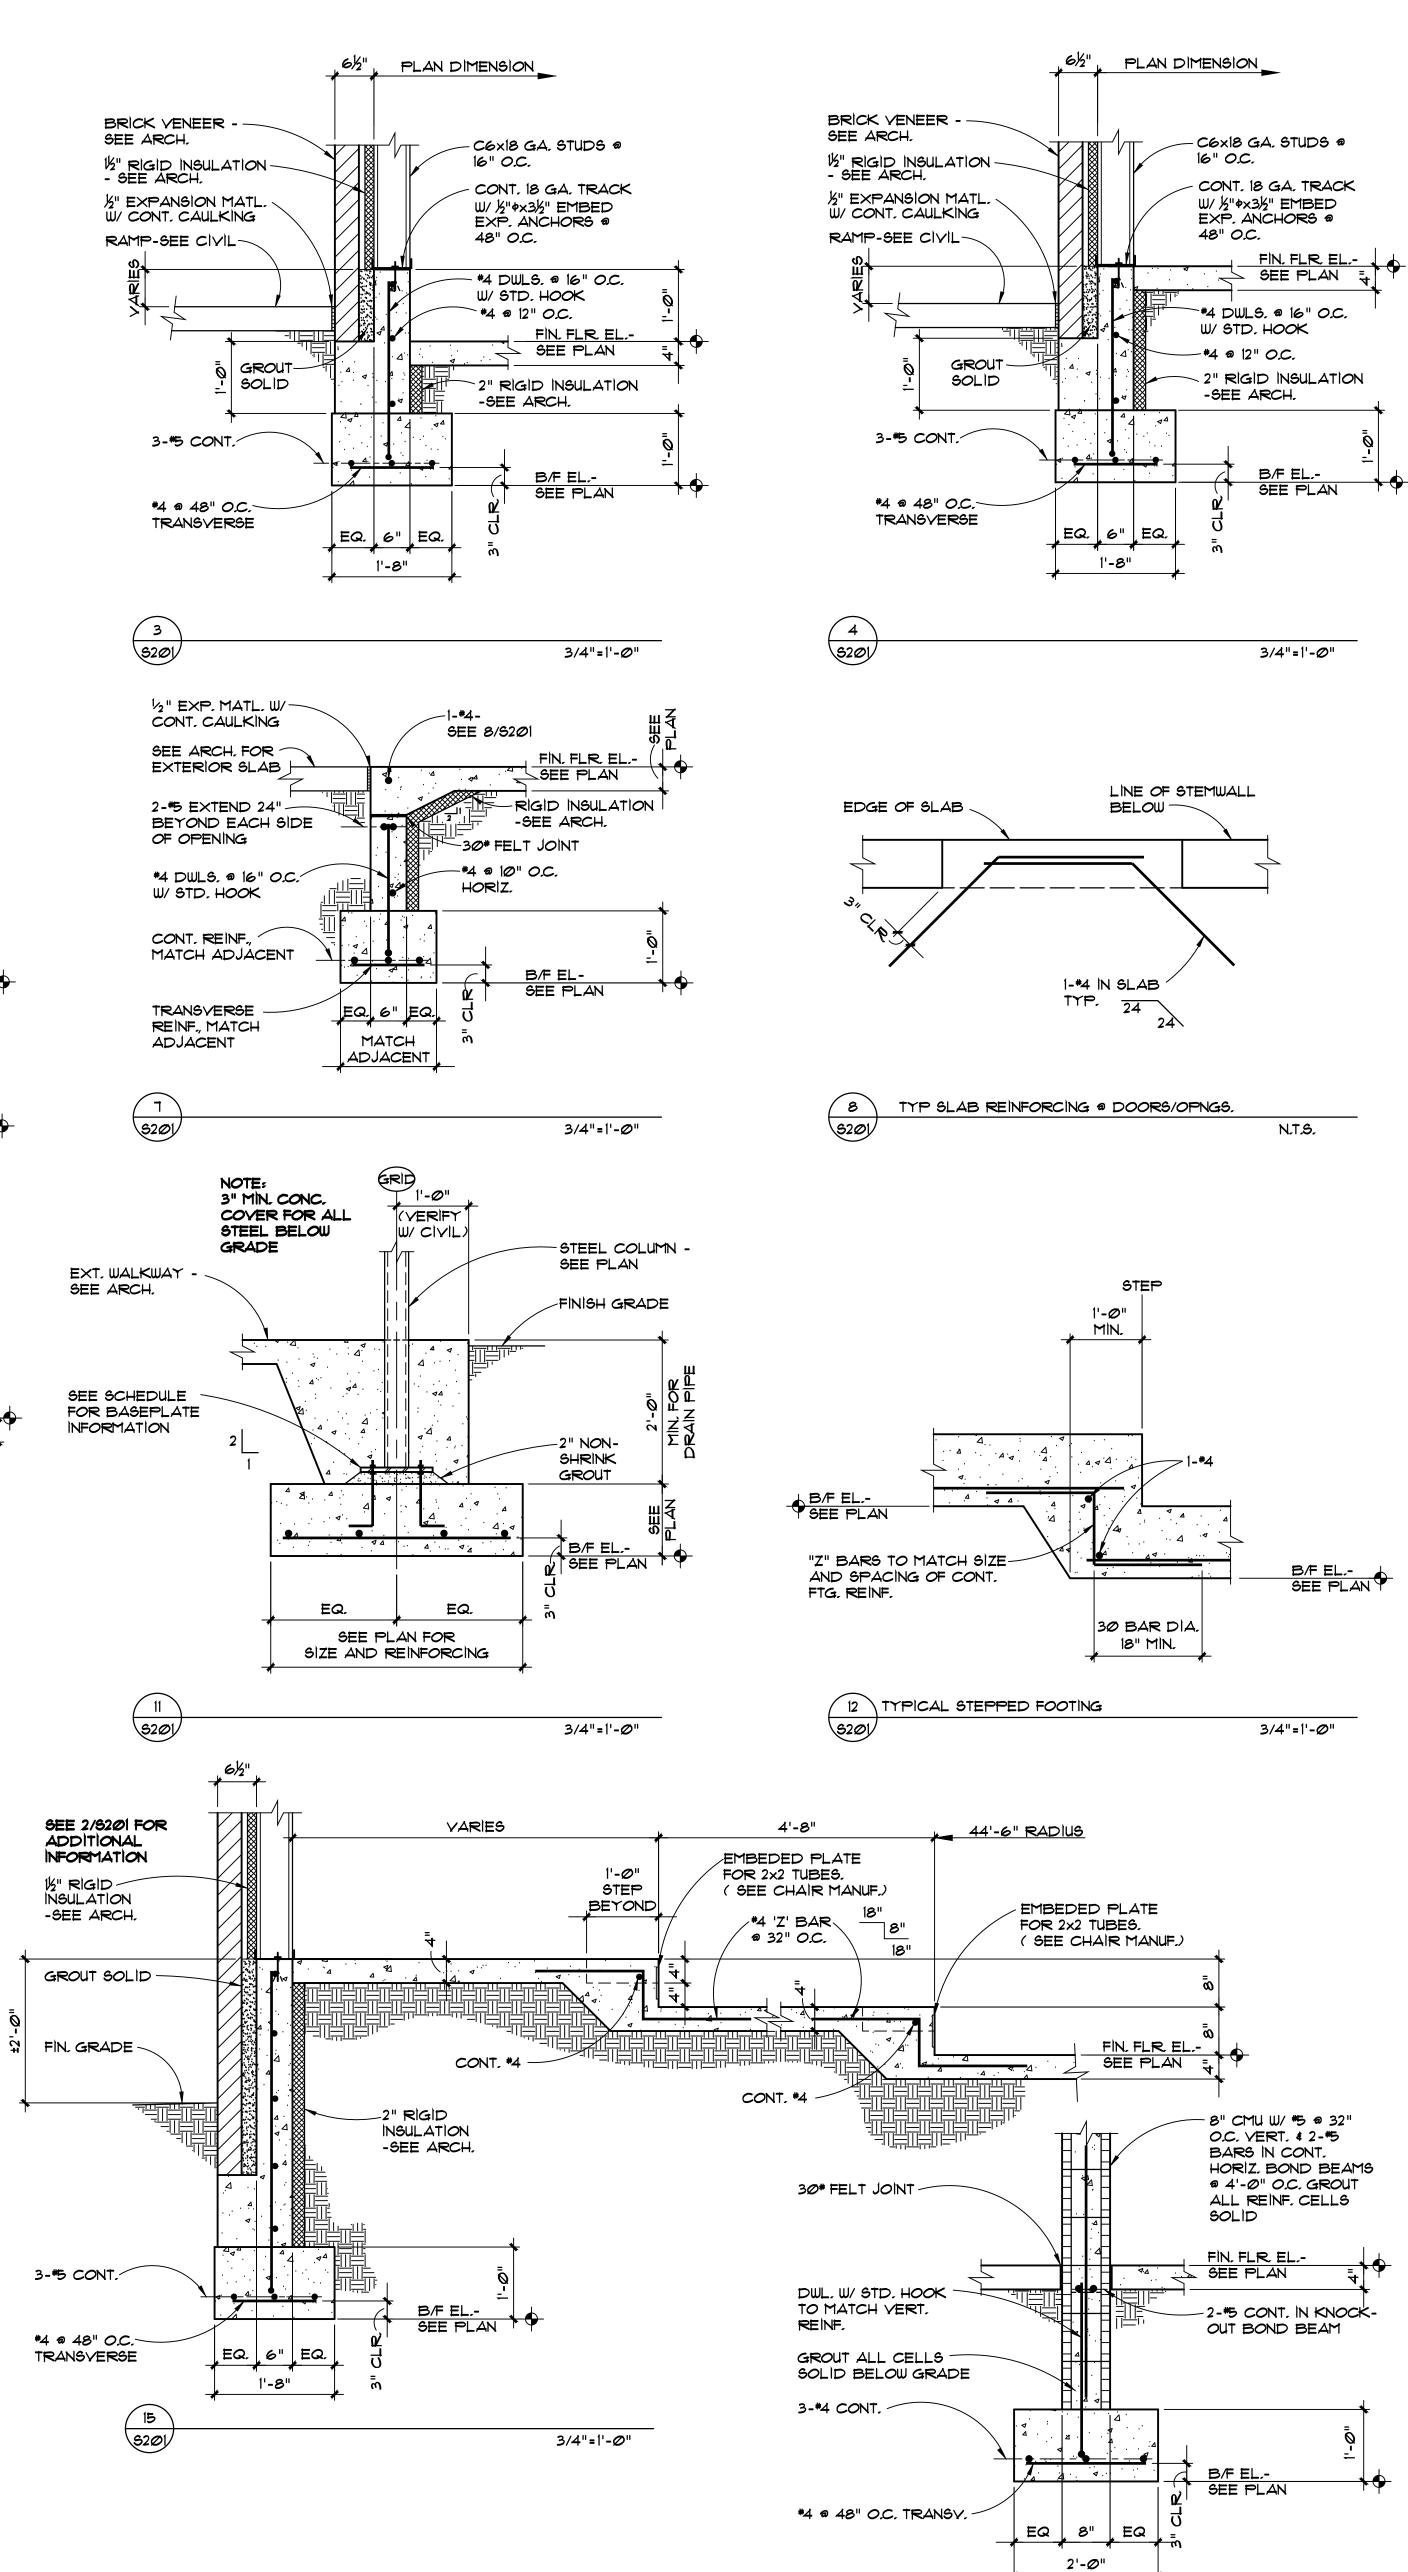

5

3

4

4

16 5201

6

3/4"=1'-Ø"




CONSULTANT



STAMP



PROJECT NAME

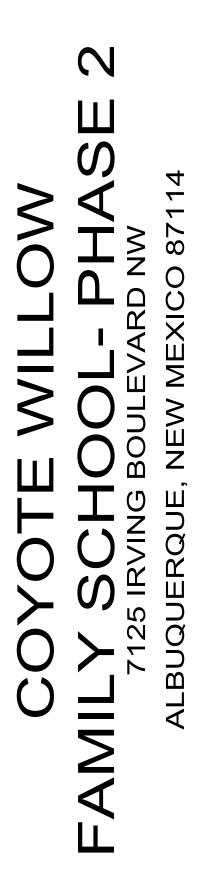

COPYRIGHT - DESIGN GROUP

REVI	SIONS	
NO.	DATE	DESCRIPTION
1	8/29/19	ADDENDUM #2
2	9/9/19	ADDENDUM #3
		·
		חוס

DESIGNER:	DLR
CHECKED:	MJW
DATE:	9.9.2019
SCALE:	
JOB NO.:	3050
CAD FILE:	

SHEET TITLE:

FOUNDATION SECTIONS & DETAILS





A2 FLOOR PLAN - BUILDING DIMENSIONS SCALE: 3/32"=1'-0"

F

19

GENERAL NOTES

5

- A. INTERIOR METAL STUD PARTITIONS TO BE A UNLESS OTHERWISE INDICATED. B. REFER TO SHEET G102 FOR PARTITION WALL TYPES.
- C. DRYWALL PARTITIONS ARE DIMENSIONED FACE OF STUD TO FACE OF STUD. D. DO NOT SCALE DRAWINGS. IF DIMENSIONS ARE IN QUESTION, REQUEST
- CLARIFICATION FROM THE ARCHITECT BEFORE CONTINUING WITH CONSTRUCTION. E. ELECTRICAL PANELS, FIRE EXTINGUISHERS CABINETS, ETC. LOCATED IN A RATED PARTITION SHALL BE BACKED WITH DRYWALL AS REQUIRED TO MAINTAIN FIRE
- RATING. F. CONCEAL PIPING IN DRYWALL. WHERE PIPING IS TOO LARGE, FUR-OUT WALLS
- MINIMUM TO CONCEAL PIPING. G. CONTRACTOR IS RESPONSIBLE FOR LOCATING AND PROVIDING NECESSARY WOOD BLOCKING OR METAL STRAPPING WITHIN WALLS FOR WALL MOUNTED CABINETS, MILLWORK, GRAB BARS, EQUIPMENT, ETC. COORDINATE LOCATION AND BLOCKING
- REQUIREMENTS WITH ARCHITECT WHERE NECESSARY. H. VERIFY LOCATION OF EQUIPMENT WITH OWNER PRIOR TO INSTALLATION.

KEYED NOTES

- SLOPED WALK, 1:20 SLOPE TYP.
 DOWNSPOUT FROM GUTTER ABOVE
- DRINKING FOUNTAIN
- 4. 3/4" CONCRETE SLAB DEPRESSION OUTSIDE ENTRY DOOR
 5. BUILT-IN COUNTERTOP. REFER TO A-402 FOR ELEVATIONS.
 6. PROVIDE SKUTT KILN KM-1227-3 PK, 208 VOLTS, OR EQUAL.
- DORMERS ABOVE, TYP. 8. MECHANICAL GRILLE
- 9. PROVIDE CRES COR QUIKTHERM 12 KW RETHERM OVEN MODEL RO-151-FW-UA-18D SERIES WARMING TOWER, OR EQUAL.
- 10. FULL HEIGHT WALL. 11. PROVIDE A 25 STUDENT EMERGENCY RESPONSE KIT, SCHOOL HEALTH #90844,
- OR EQUAL. 12. MANUAL PENCIL SHARPENER, TYPICAL. FINAL HEIGHT AND LOCATION TO BE
- APPROVED BY OWNER. 13. FLAG POLE HOLDER, TYPICAL, CONTRACTOR TO VERIFY LOCATIONS PRIOR TO
- INSTALL.

 $\sim\!\!\sim\!\!\sim\!\!\sim\!\!\sim\!\!\sim\!\!\sim$


D1. REMOVE EXISTING TUBE STEEL GATES AND FRAME. PATCH WALL TO MATCH EXISTING ADJACENT FINISH IN TEXTURE AND COLOR.



CONSULTANT




PROJECT NAME

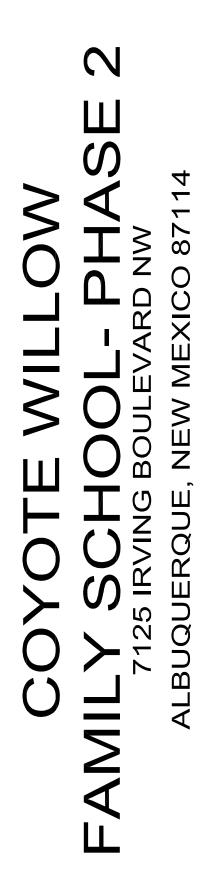


REVI	SIONS	
NO.	DATE	DESCRIPTION
$\overline{1}$	09/06/19	ADDENDUM 003
·		
COF	- PYRIGHT -	DESIGN GROUP
DES	GNER:	WESC
CHE	CKED:	WESC
DAT	E:	08.16.2019
SCA	LE:	3/32" = 1'-0"
JOB	NO.:	3050
CAE) FILE:	3050_A111
SHE	ET TITLE:	
FLC	OOR PLAN	


BUILDING DIMENSIONS

A111

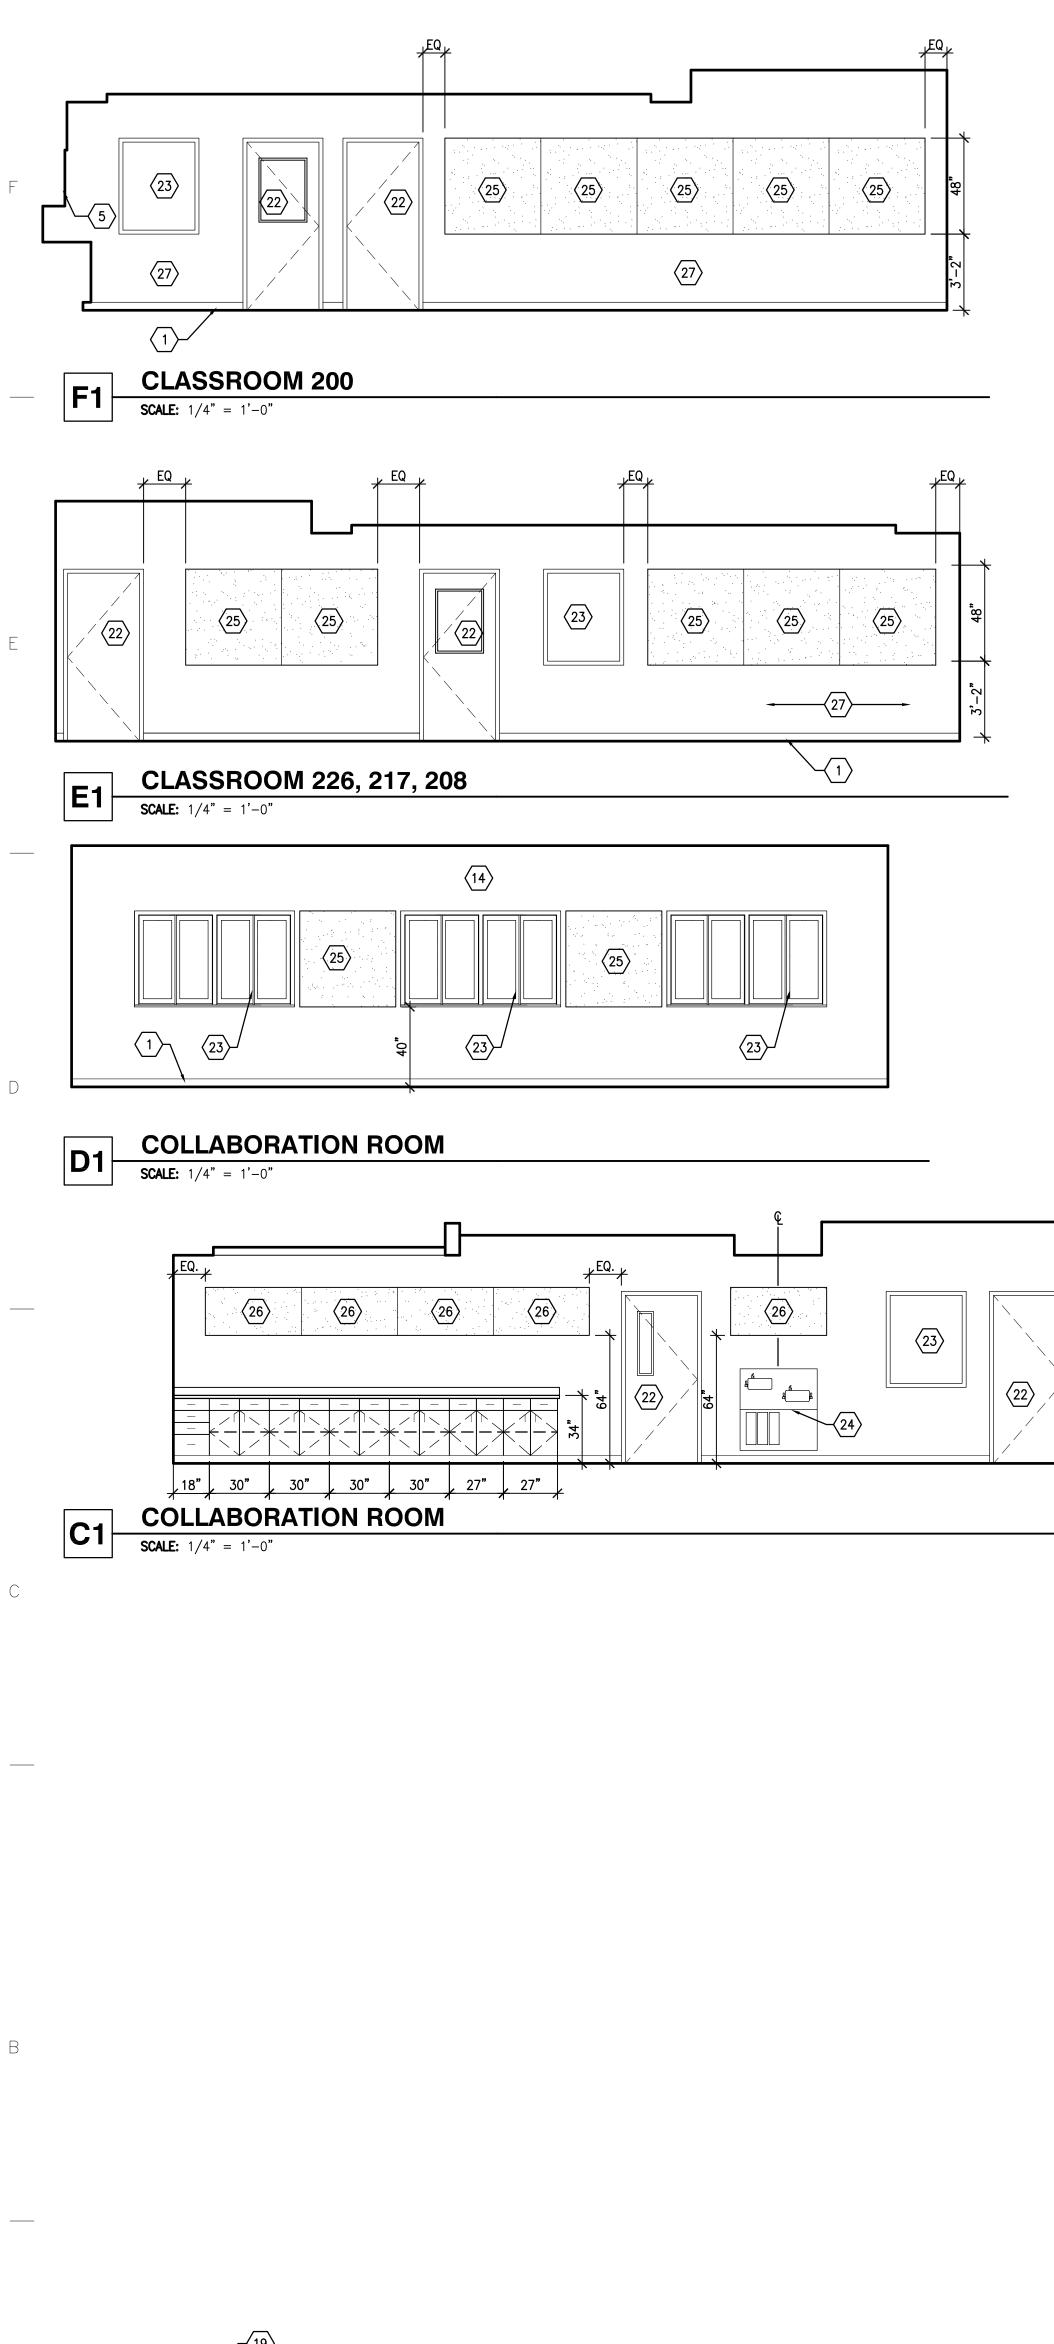

1

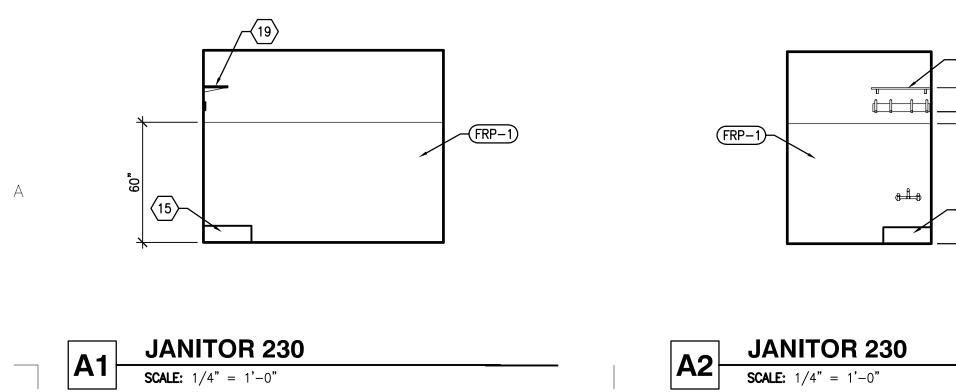

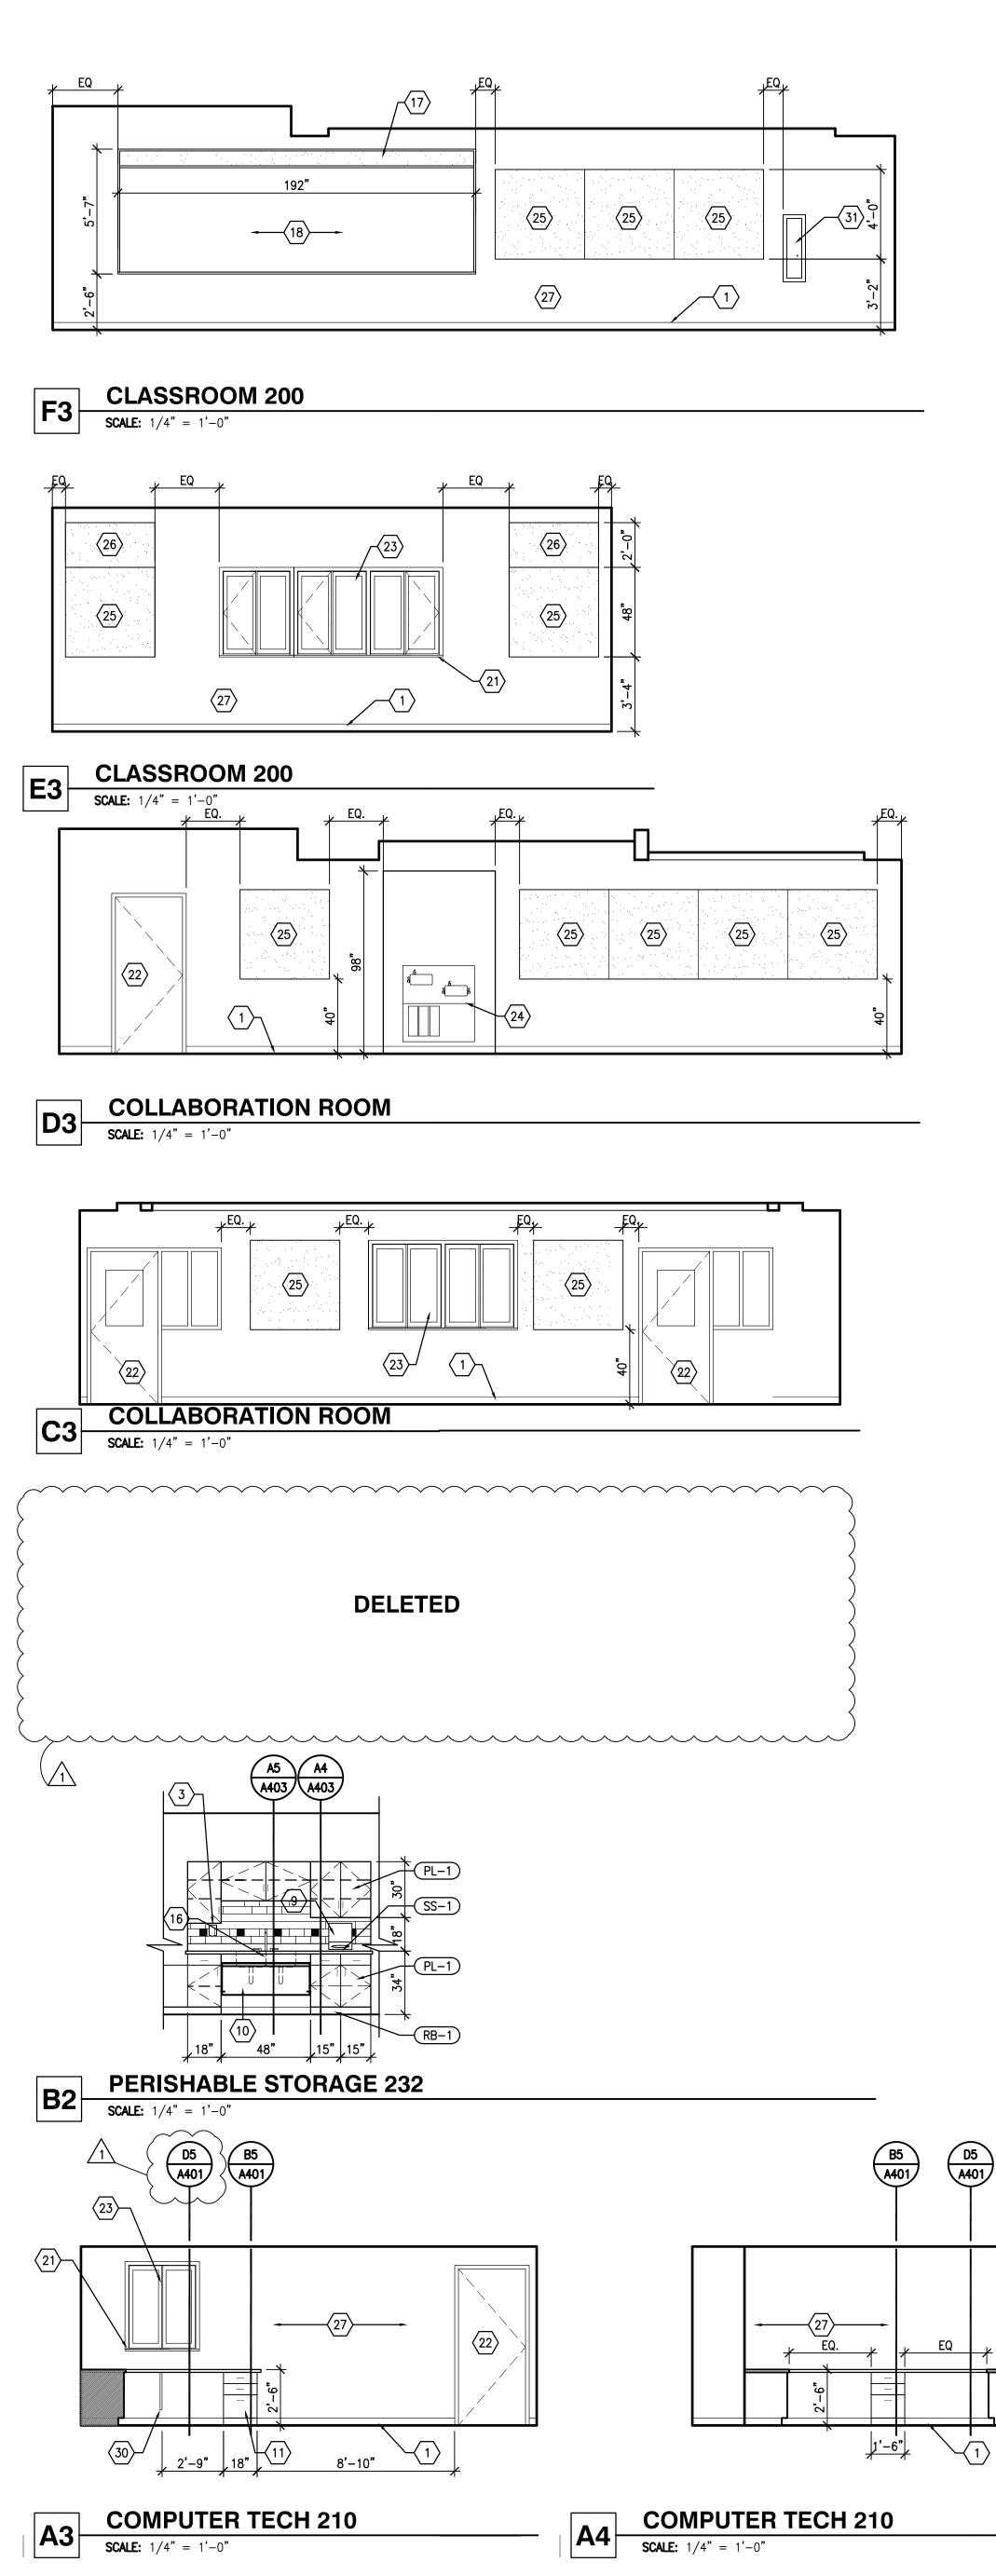

2

3

4


GENERAL NOTES

- A. ALL CHANGES IN FLOORING MATERIALS TO OCCUR AT MID-THRESHOLD OF INTERIOR DOORS.
- B. ALL ACCESS PANELS SHALL BE PAINTED TO MATCH ADJACENT SURFACES IF NOT FACTORY FINISHED TO MATCH.
- C. ALL TRANSITION STRIPS TO BE RUBBER TO MATCH RB-1 (UNLESS NOTED OTHERWISE). D. PROVIDE AND INSTALL NEW WINDOW SHADES AT ALL EXTERIOR WINDOWS. PROVIDE
- MANUALLY OPERATED SHADES BY MECHOSHADE SYSTEMS AT WINDOWS WITH HEAD
- HEIGHT OF 7'-2" A.F.F. OR LOWER AND MOTORIZED SHADES AT ALL DORMER WINDOWS, OR APPROVED EQUAL, U.N.O. ARCHITECT TO SELECT FROM
- MANUFACTURER'S FULL LINE OF COLORS AND MATERIALS. E. REFER TO SHEETS 1600 ENLARGED PLANS FOR LINOLEUM, RUBBER, AND FLOOR TILE PATTERNS. F. PLASTIC LAMINATE (PL):
- 1. EXPOSED AREAS TO BE PL-1 (UNLESS NOTED OTHERWISE).
- 2. ALL CASEWORK INTERIORS INCLUDING ALL SHELVING SURFACES TO RECEIVE WHITE MELAMINE FINISH. 3. ALL CASEWORK TO RECEIVE (3mm THICK) PVC ACCENT EDGING (COLOR TO
- MATCH PL-1) G. REFER TO PLANS, ELEVATIONS, AND/OR FINISH SCHEDULE FOR LOCATION OF
- ACCENT PAINT (PT). H. AT CERAMIC TILÈ WAINSCOT, PROVIDE BULLNOSED CORNERS. BULLNOSE AT TOP
- OF WAINSCOT, OUT/IN CORNERS, AND STRETCHERS, AS REQUIRED TO PROVIDE A CONSISTENT INSTALLATION.
- I. PROVIDE BULLNOSED CERAMIC TILE BORDER AROUND MIRROR AND TOILET ACCESSORIES THAT EXTEND ABOVE THE WAINSCOT, TYP.
- J. ALL CONCEALED BLOCKING, BACKING PANELS, AND ANY OTHER AREAS INDICATED _____ TO INCORPORATE THE USE OF FIRE RETARDANT TREATED WOOD. K. PROVIDE DRAWER AND DOOR LOCKS AT ALL CASEWORK LOCATIONS.

KEYED NOTES


- 1. BASE 2. NOT USED 3. SOAP DISPENSER
- 4. NOT USED 5. PLASTIC LAMINATE CASEWORK
- 6. NOT USED 7. NOT USED
- 8. NOT USED 9. PAPER TOWEL DISPENSER
- 10. SLOPED ADA PLASTIC LAMINATE REMOVABLE PANEL WITH SIDE WALL CLIPS. FIELD VERIFY WITH PLUMBING FIXTURE. 11. DRAWERS
- 12. NOT USED 13. NOT USED
- 14. PAINT 15. JANITORS SINK
- 16. SINK 17. TACK/MAP RAIL
- 18. ALUMINUM FRAMED DRY ERASE MARKER BOARD WITH FULL WIDTH TRAY 19. SHELF/MOP HOLDER
- 20. NOT USED 21. SOLID SURFACE WINDOW SILL
- 22. DOOR AND FRAME 23. WINDOW AND FRAME 24. DRINKING FOUNTAINS
- 25. 4'-0" X 4'-0" TACKABLE WALL PANELS, NUMBER AND SPACING AS SHOWN 26. 2'-0" X 4'-0" TACKABLE WALL PANELS, NUMBER AND SPACING AS SHOWN 27. REFER TO FINISH SCHEDULE FOR WALL FINISH 28. 5/8" GYP. BD. OVER METAL STUDS
- 29. SOLID SURFACE COUNTER TOP 30. METAL HEAVY DUTY BRACE

31. FIRE EXTINGUISHER CABINET

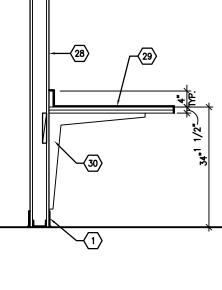


5

DE	CASEWORK SECTION
05	SCALE: $3/4$ " = 1'-0"

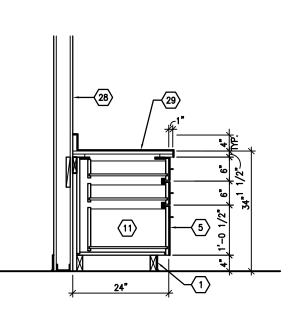



CASEWORK SECTION SCALE: 3/4" = 1'-0"

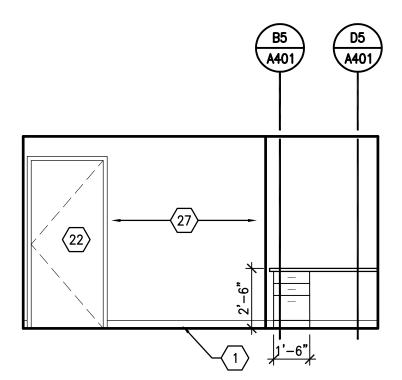




THE HARTMAN + MAJEWSKI Design Group ARCHITECTS · ENGINEERS · INTERIOR DESIGN PLANNERS · URBAN DESIGNERS · LEED © 120 VASSAR DRIVE SE SUITE 100 ALBUQUERQUE, NEW MEXICO 87106 PHONE: 505.242.6880 FAX: 505.242.6881

CONSULTANT






PROJECT NAME

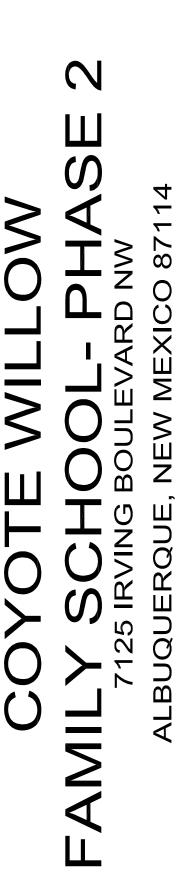



REVI	SIONS	
NO.	DATE	DESCRIPTION
1	09/06/19	ADDENDUM 003
COF	PYRIGHT -	DESIGN GROUP
DES	GNER:	WESC
CHE	CKED:	WESC
DAT	E:	08.16.2019
SCA	LE:	3/4" = 1'-0"
JOB	NO.:	3050
CAE	FILE:	3050_A401


SHEET TITLE: CASEWORK SECTIONS INTERIOR ELEVATIONS




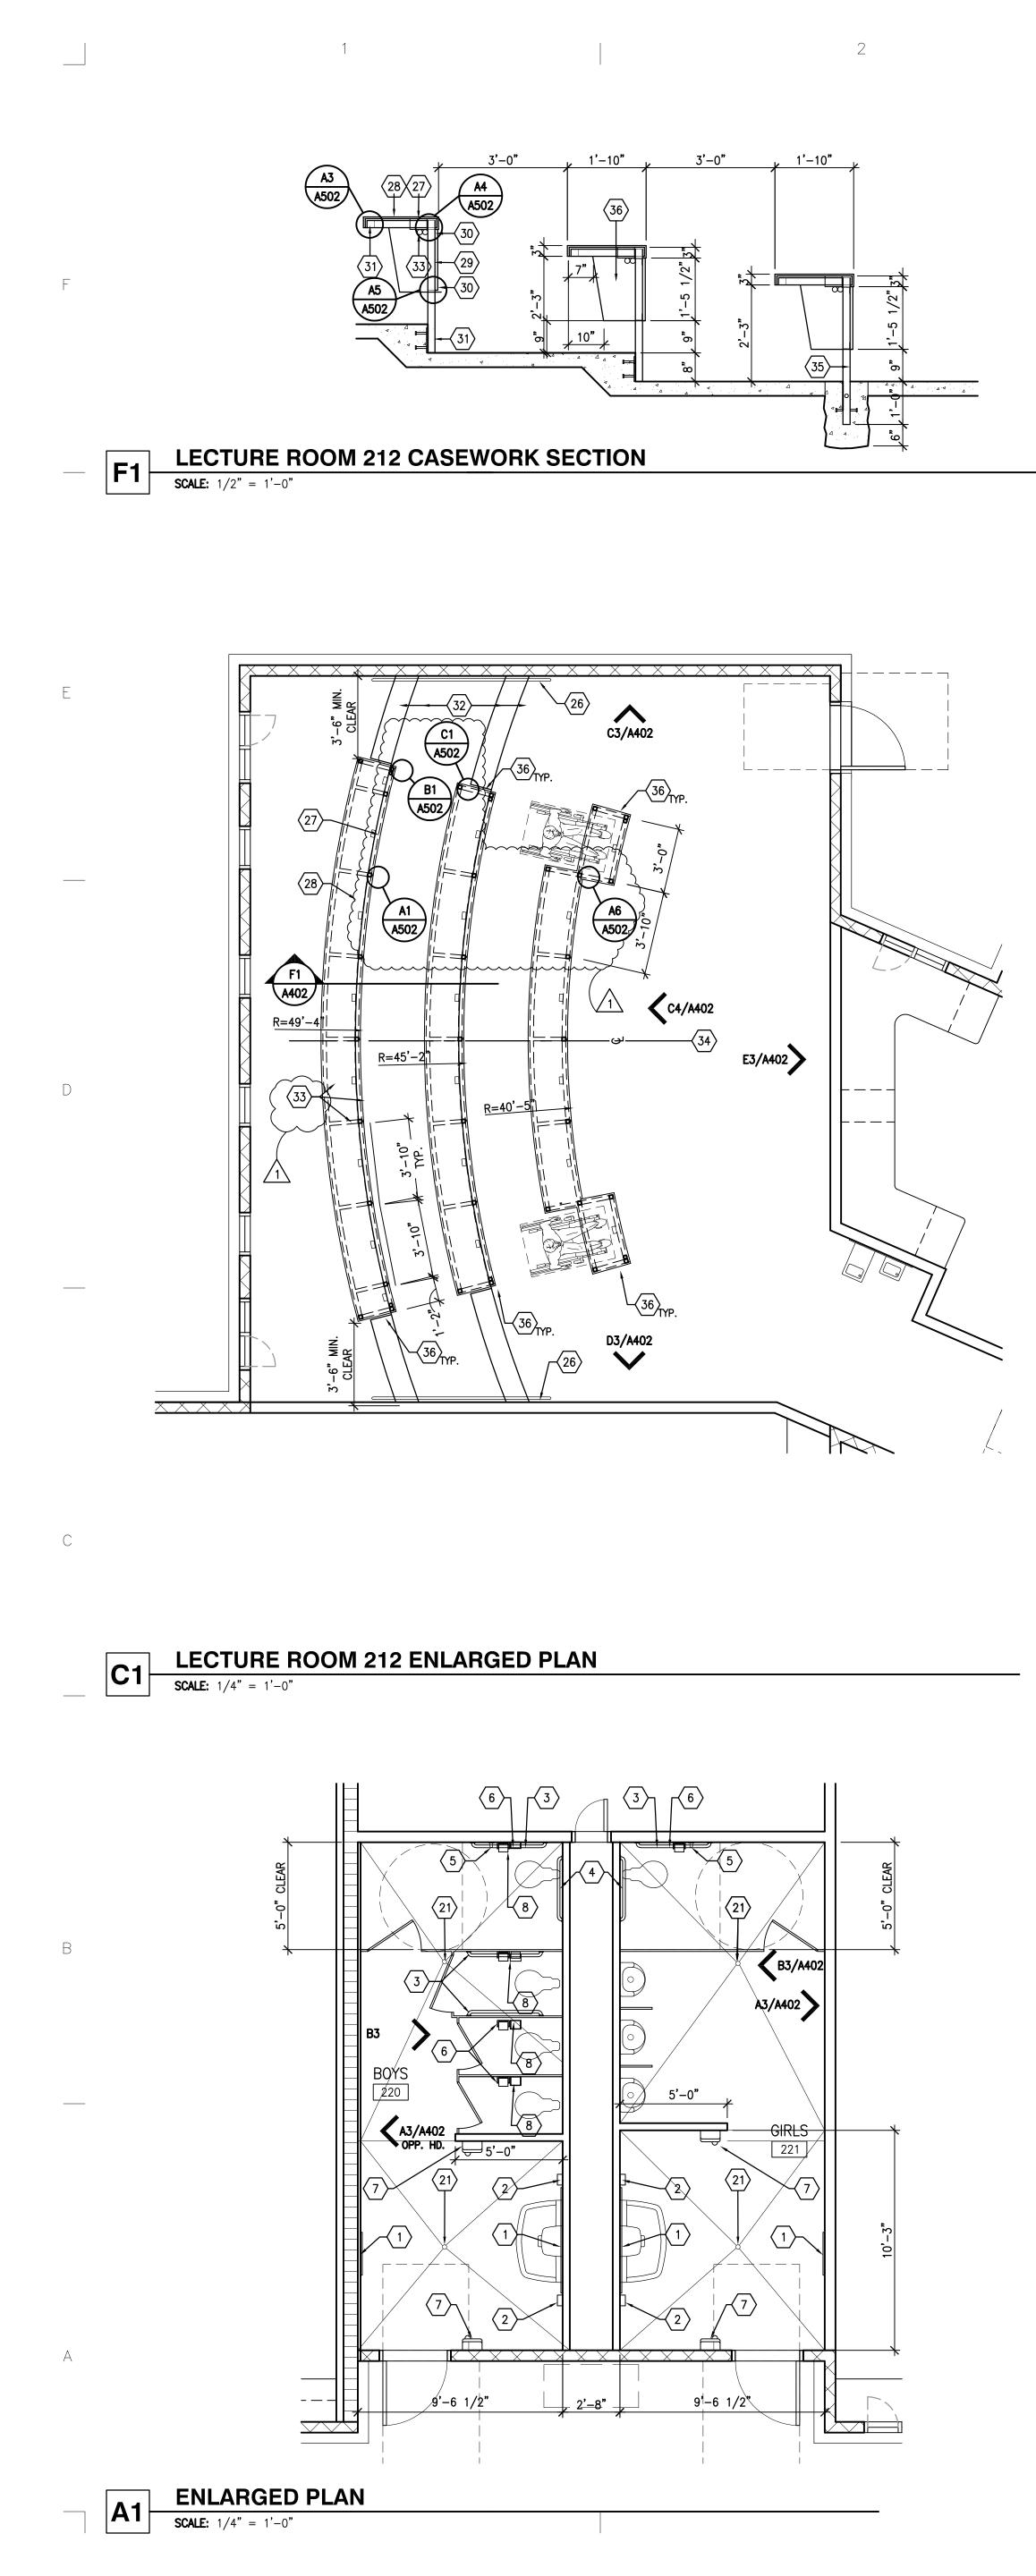

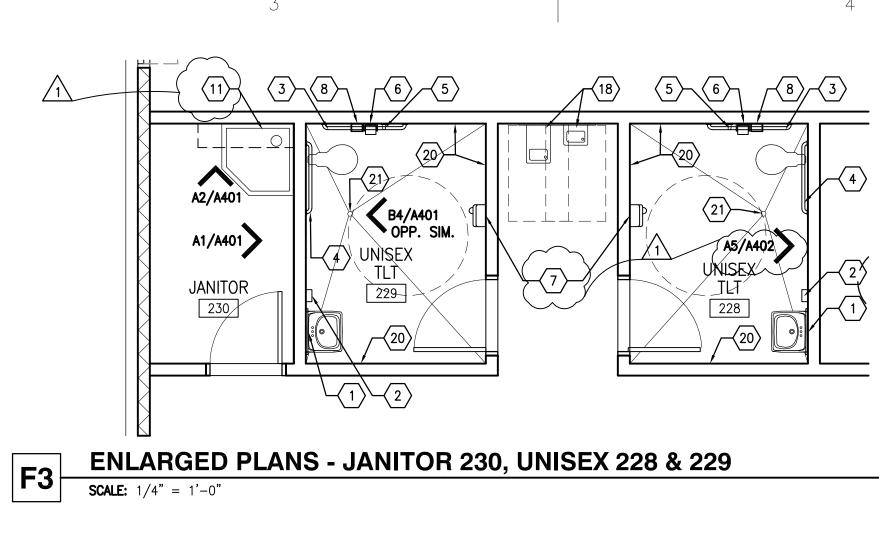

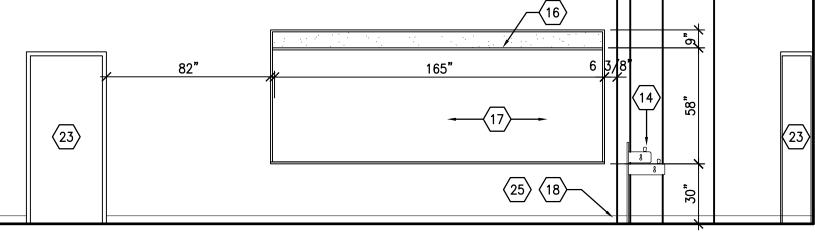


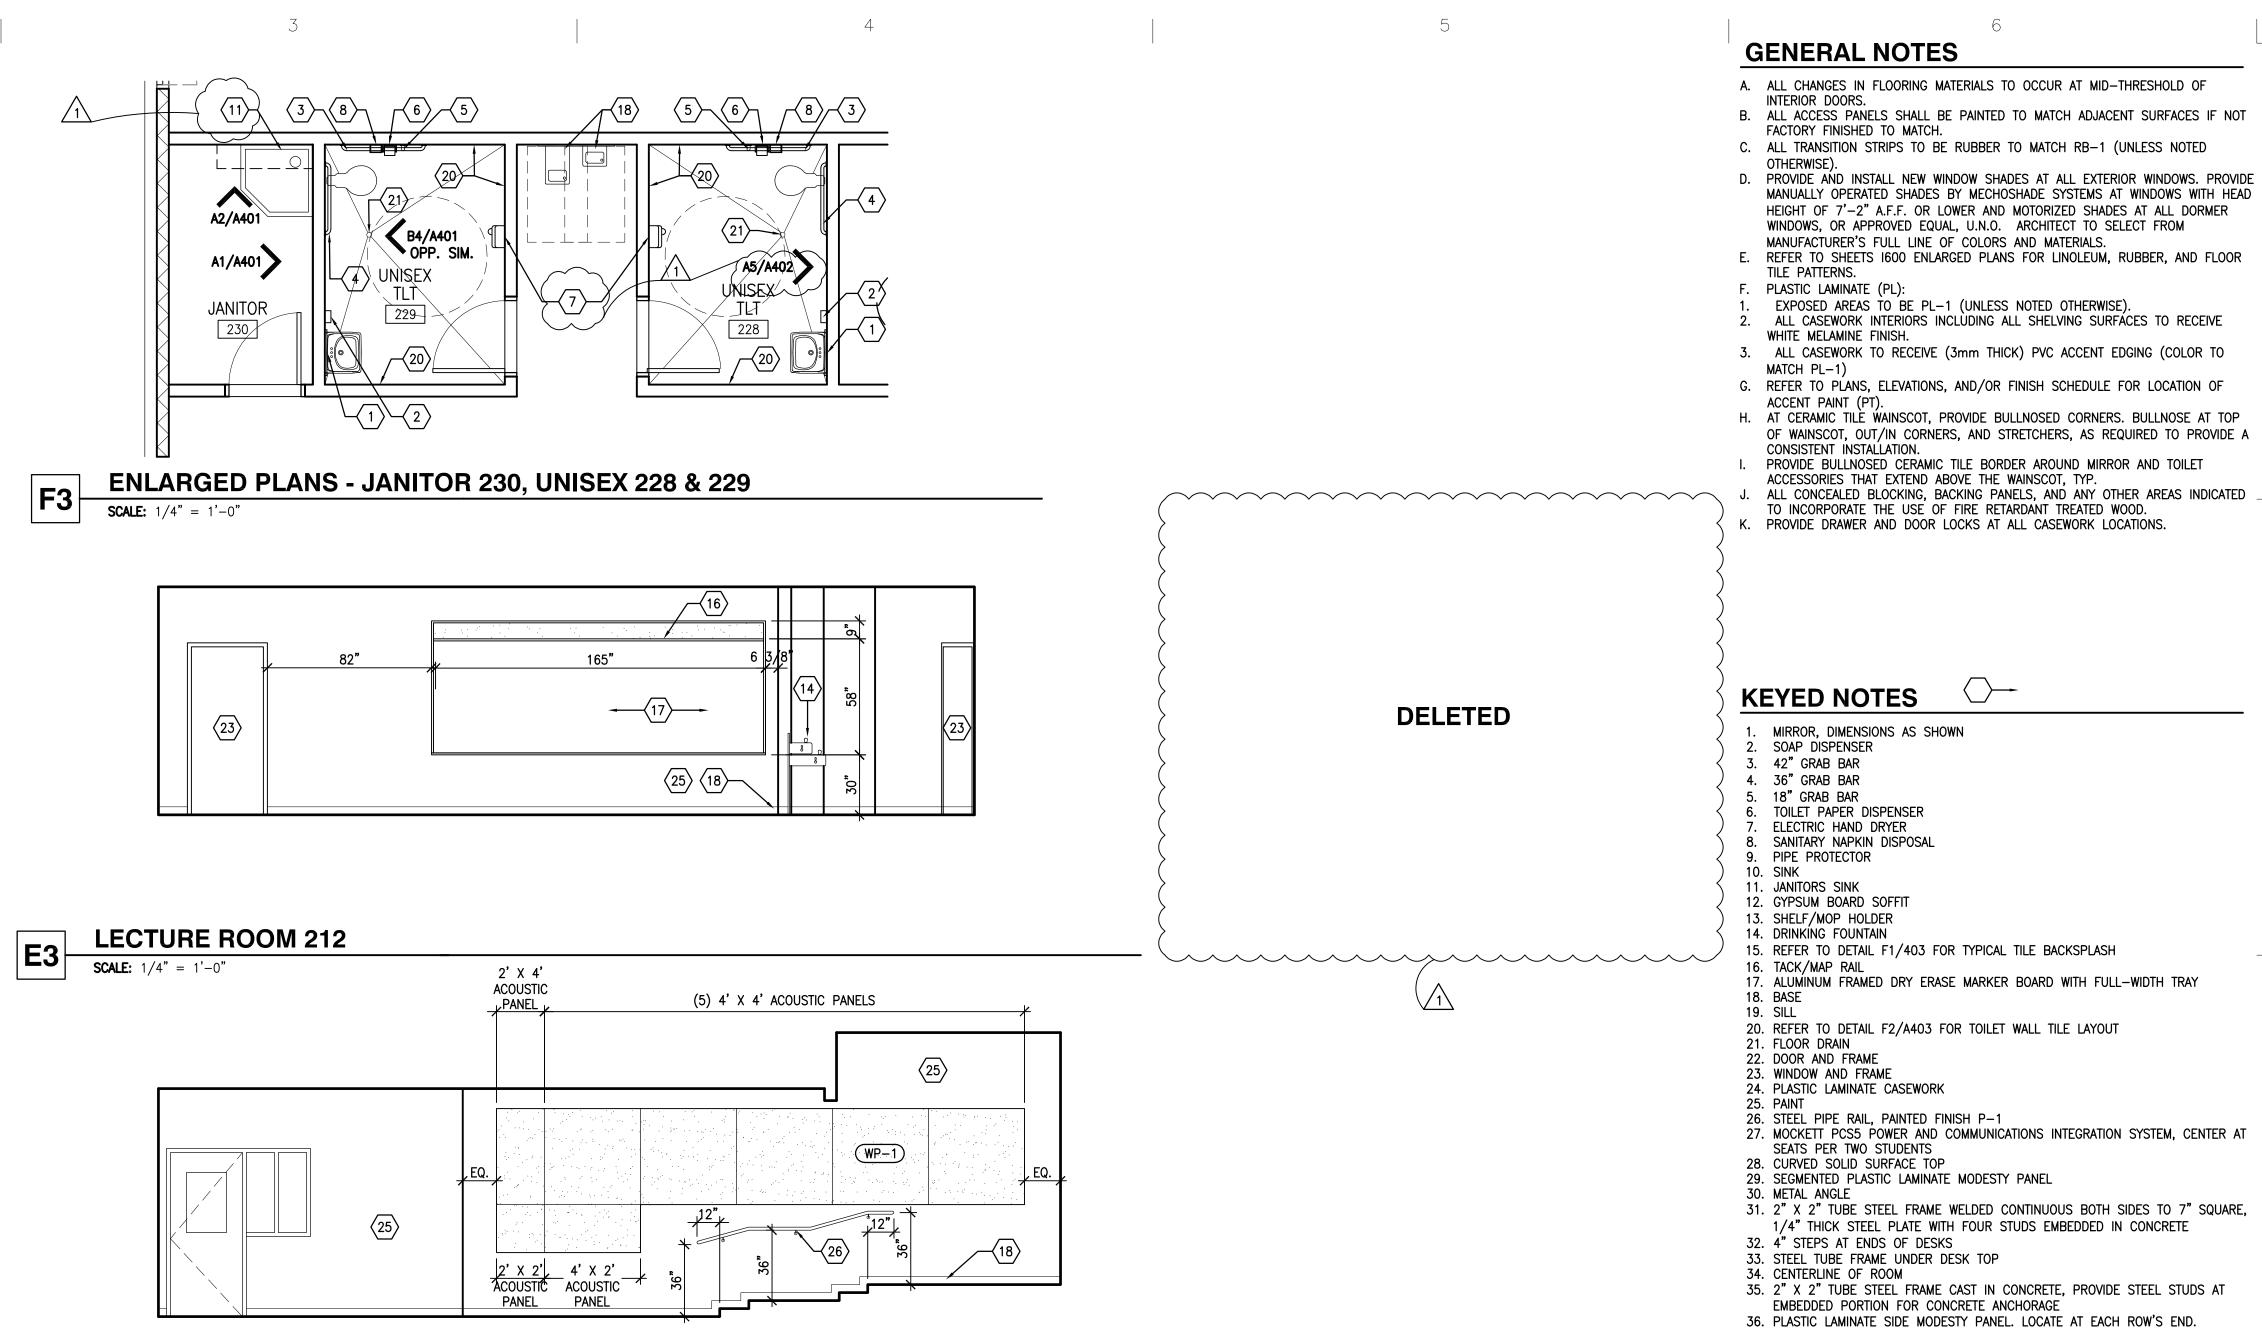

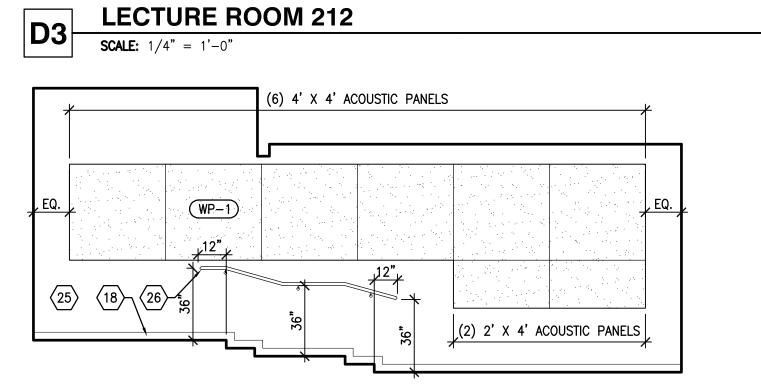

┑╵╷╵('Ҏ<u></u>╡

EQ. / EQ. / EQ. / EQ. / EQ. / EQ.

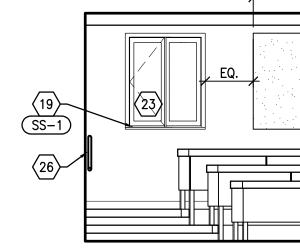





LECTURE ROOM 212 **SCALE:** 1/4" = 1'-0"

/MIN.

, 60" MIN. CLR.

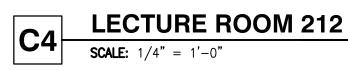



B4

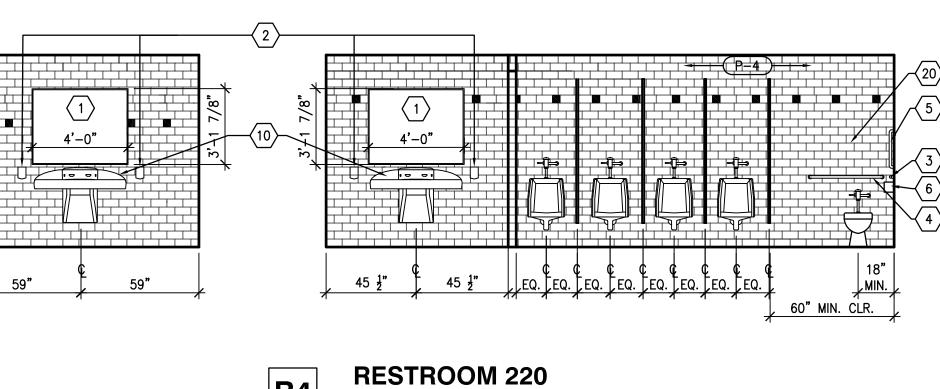


SCALE: 1/4" = 1'-0"



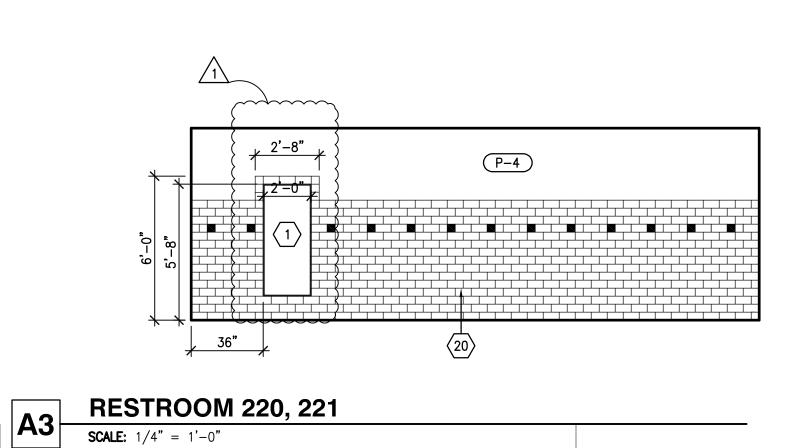

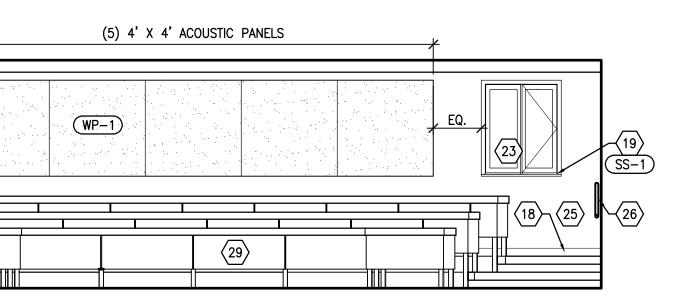


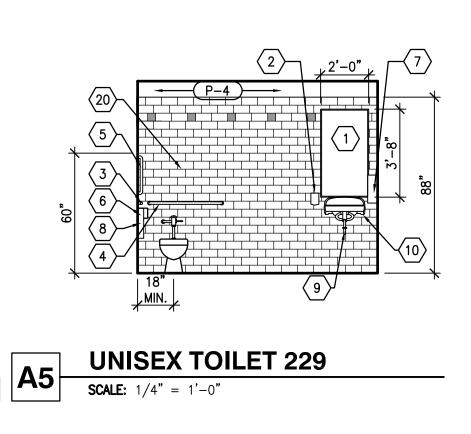




THE HARTMAN + MAJEWSKI **J**ESIGN **G**ROUP ARCHITECTS · ENGINEERS · INTERIOR DESIGN PLANNERS URBAN DESIGNERS
 LEED 120 VASSAR DRIVE SE SUITE 100 ALBUQUERQUE, NEW MEXICO 87106 PHONE: 505.242.6880 FAX: 505.242.6881

CONSULTANT

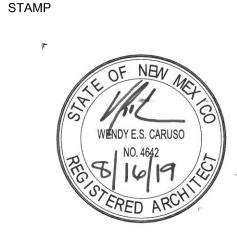

PROJECT NAME

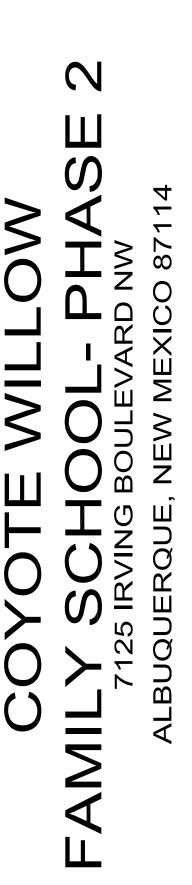


REVI	SIONS	
NO.	DATE	DESCRIPTION
1	09/06/19	ADDENDUM 003
COF	PYRIGHT -	DESIGN GROUP
DES	GNER:	ESC
CHE	CKED:	WESC
DAT	E:	08.16.2019
SCA	LE:	1/4" = 1'-0"
JOB	NO.:	3050
CAE	FILE:	3050_A402

SHEET TITLE: ENLARGED PLANS


INTERIOR ELEVATIONS



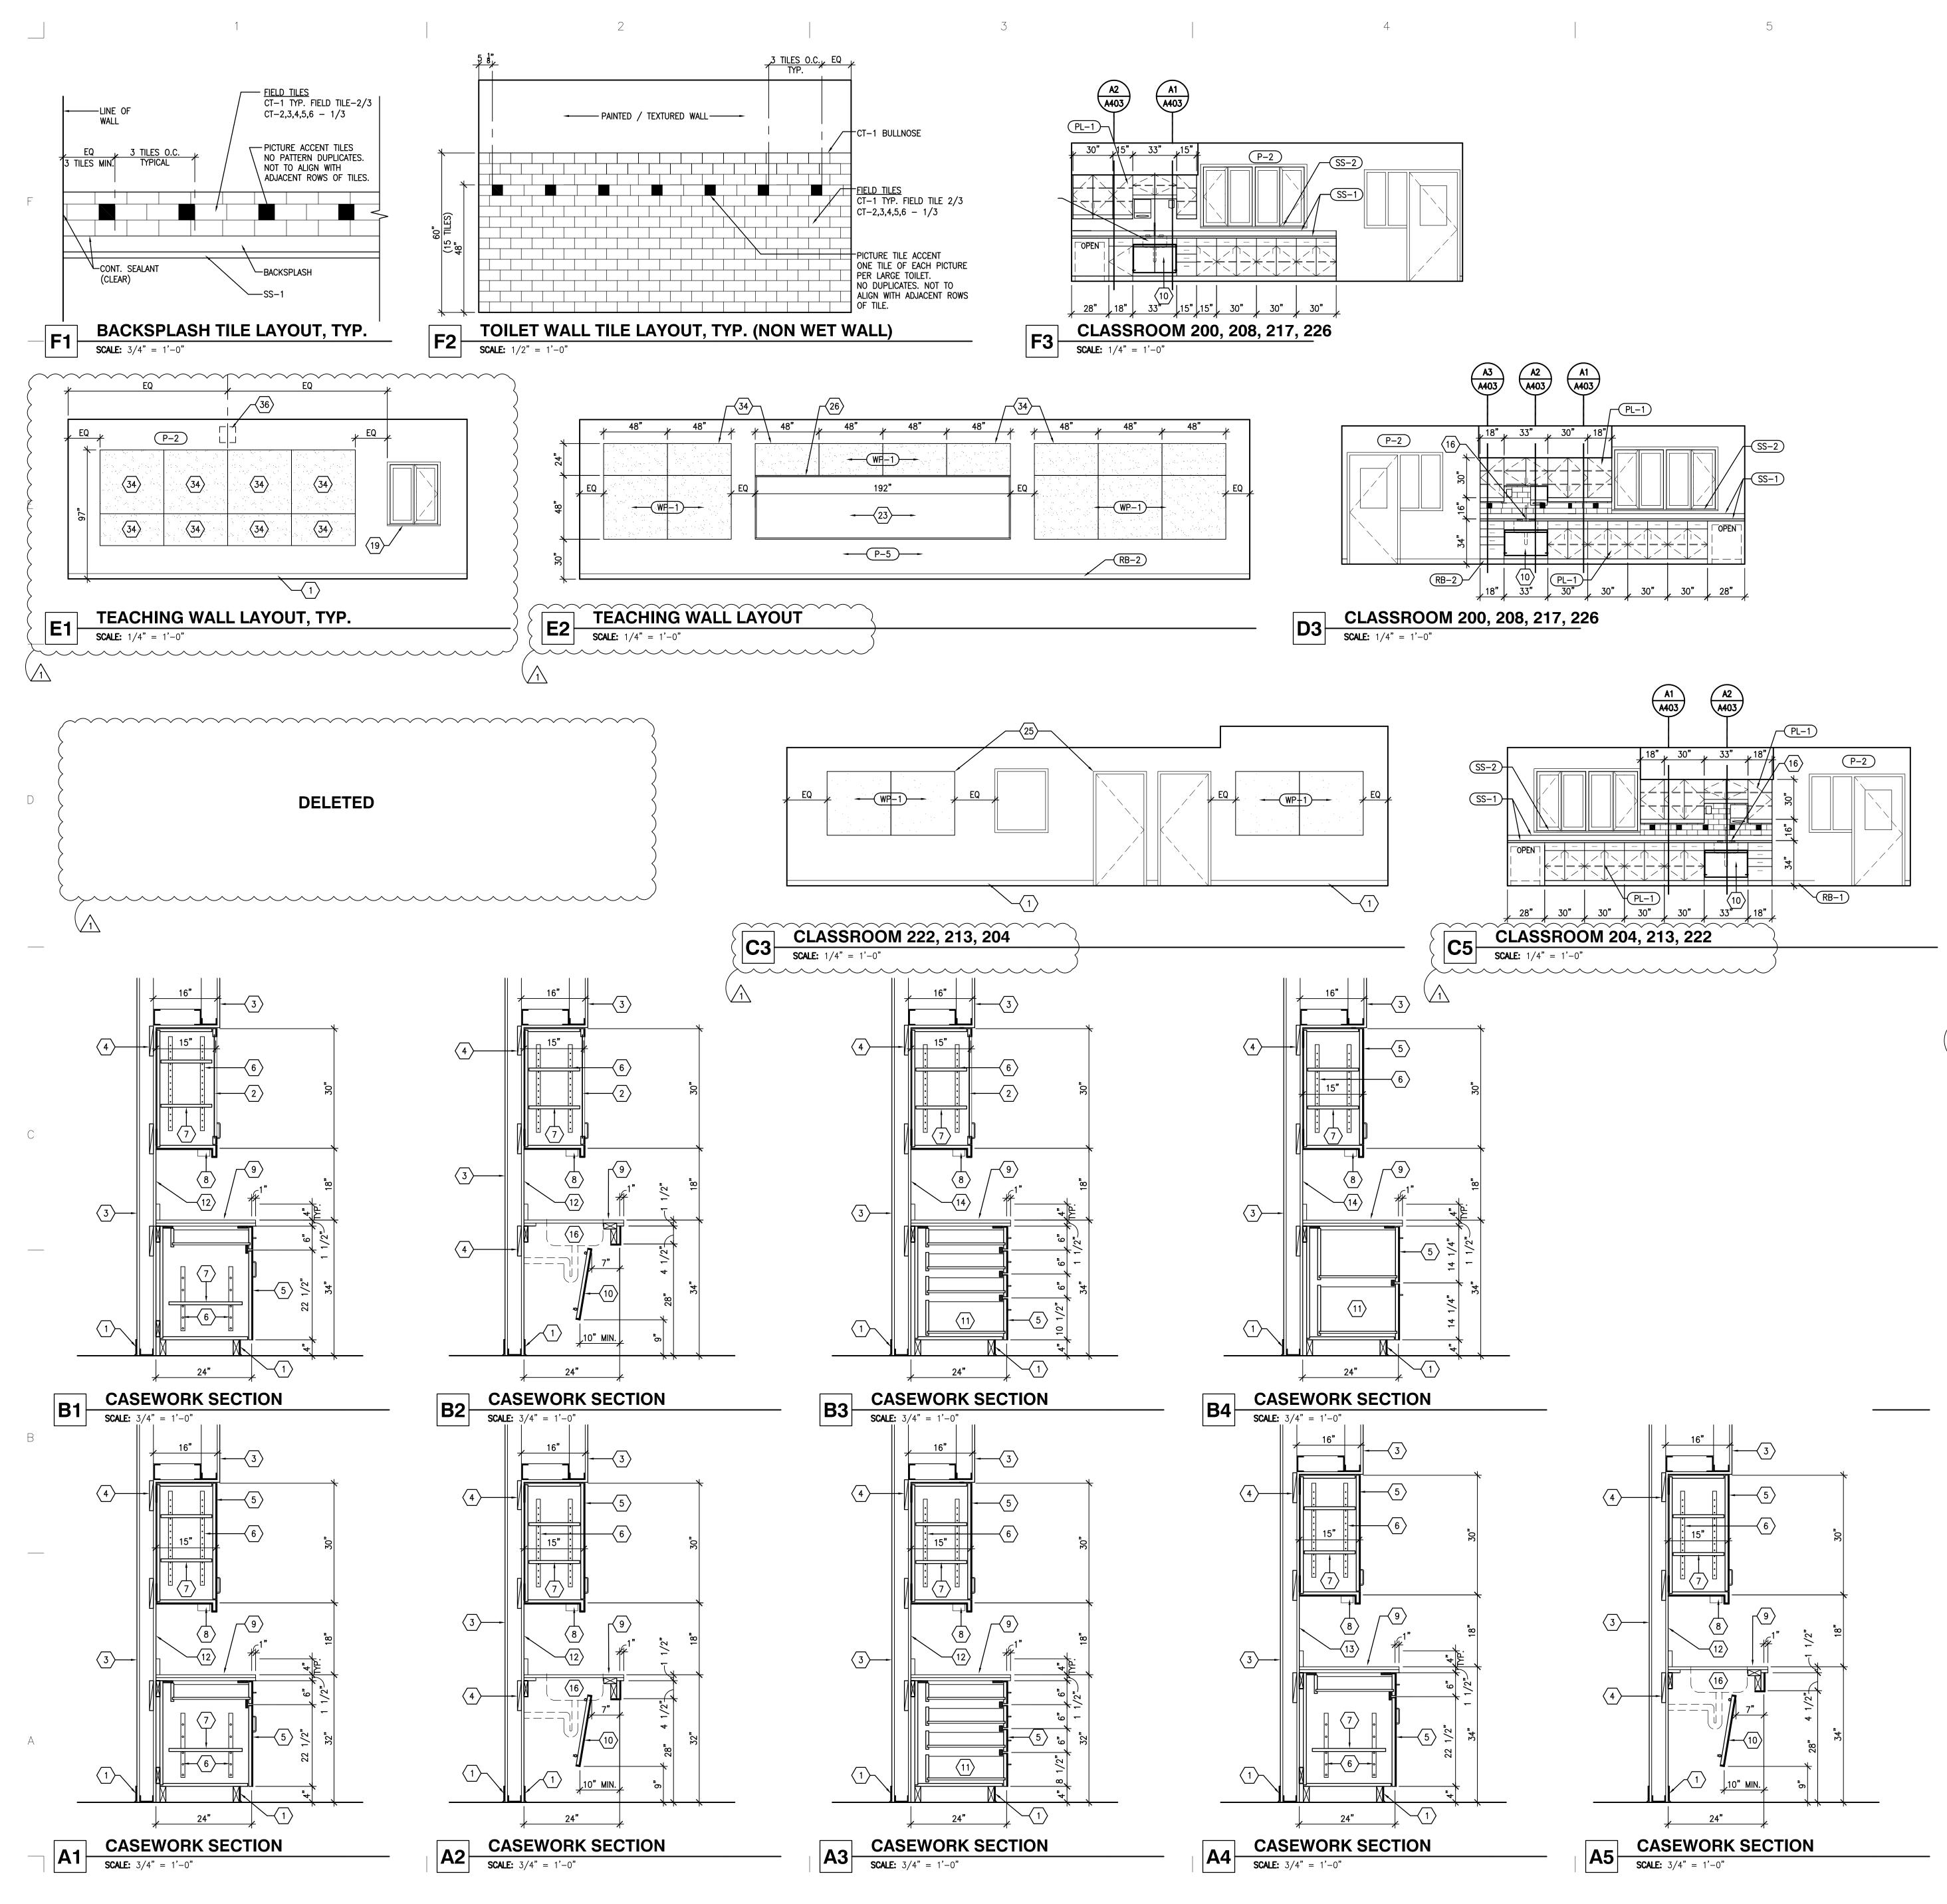

GENERAL NOTES

- A. ALL CHANGES IN FLOORING MATERIALS TO OCCUR AT MID-THRESHOLD OF INTERIOR DOORS.
- B. ALL ACCESS PANELS SHALL BE PAINTED TO MATCH ADJACENT SURFACES IF NOT FACTORY FINISHED TO MATCH.
- C. ALL TRANSITION STRIPS TO BE RUBBER TO MATCH RB-1 (UNLESS NOTED OTHERWISE). D. PROVIDE AND INSTALL NEW WINDOW SHADES AT ALL EXTERIOR WINDOWS. PROVIDE
- MANUALLY OPERATED SHADES BY MECHOSHADE SYSTEMS AT WINDOWS WITH HEAD HEIGHT OF 7'-2" A.F.F. OR LOWER AND MOTORIZED SHADES AT ALL DORMER
- WINDOWS, OR APPROVED EQUAL, U.N.O. ARCHITECT TO SELECT FROM MANUFACTURER'S FULL LINE OF COLORS AND MATERIALS. E. REFER TO SHEETS 1600 ENLARGED PLANS FOR LINOLEUM, RUBBER, AND FLOOR TILE PATTERNS.
- F. PLASTIC LAMINATE (PL): EXPOSED AREAS TO BE PL-1 (UNLESS NOTED OTHERWISE).
- ALL CASEWORK INTERIORS INCLUDING ALL SHELVING SURFÁCES TO RECEIVE WHITE MELAMINE FINISH.
- 3. ALL CASEWORK TO RECEIVE (3mm THICK) PVC ACCENT EDGING (COLOR TO MATCH PL-1)
- G. REFER TO PLANS, ELEVATIONS, AND/OR FINISH SCHEDULE FOR LOCATION OF ACCENT PAINT (PT).
- H. AT CERAMIC TILÈ WAINSCOT, PROVIDE BULLNOSED CORNERS. BULLNOSE AT TOP OF WAINSCOT, OUT/IN CORNERS, AND STRETCHERS, AS REQUIRED TO PROVIDE A CONSISTENT INSTALLATION.
- I. PROVIDE BULLNOSED CERAMIC TILE BORDER AROUND MIRROR AND TOILET ACCESSORIES THAT EXTEND ABOVE THE WAINSCOT, TYP. J. ALL CONCEALED BLOCKING, BACKING PANELS, AND ANY OTHER AREAS INDICATED

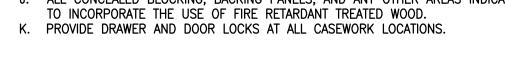



\frown **KEYED NOTES**

- 1. BASE AS SCHEDULED. 2. 1/4" TEMPERED GLASS.
- 3. 5/8" GYP. BD. OVER METAL STUDS. 4. 1"x8" SOLID PRESSURE TREATED WOOD BLOCKING BETWEEN STUDS.
- 5. PLASTIC LAMINATE CASEWORK. 6. RECESSED METAL STANDARDS WITH CLIPS.
- 7. 3/4" ADJUSTABLE SHELVES. 8. UNDER CABINET LIGHTS.
- 9. SOLID SURFACE COUNTERTOP AND BACKSPLASH. 10. SLOPED ADA PLASTIC LAMINATE REMOVEABLE PANEL WITH SIDE WALL CLIPS. 11. DRAWERS.
- 12. CERAMIC TILE OVER TILE BACKER BOARD. VARIES. REFER TO ELEVATIONS AND SCHEDULE.
 WALLCOVERING AS SCHEDULED.
 5/8" GYP. BD.
 SINK.
- 17. WOOD STUD WALL. 18. PROVIDE 3/4" FINS FOR SUPPORT OF TOP SHELF.

- PROVIDE 3/4 FINS FOR SUPPORT OF TOP SHELF.
 SOLID SURFACE.
 3/4"x3/4" ALUMINUM ANGLE.
 HORIZONTAL BRACE.
 TACK/MAP RAIL.
 ALUMINUM FRAMED DRY ERASEMARKER BOARD WITH FULL WIDTH TRAY.
 CONTINUOUS ALUMINUM EDGE. 25. ALIGN. 26. MAP RAIL.
- 27. 8" WIDE x 44" LONG 3/8" TEMPERED GLASS SHELF. 28. WALL SCONCE.
- 29. RECESSED SHELF TRACK SYSTEM. 30. SUPPORT BRACKET.
- 31. (1) LAYER 1/2" GYP. BD. OVER PARTITION. 32. 5/8" GYP. BD. OVER 6" METAL STUDS.

32. 578 GTP. BD. OVER 6 METAL STODS. 33. CORNER BEAD. 34. ACOUSTIC WALL PANEL. 35. PLASTIC LAMINATE OVER ALL EXPOSED SURFACES. 36. CLOCK

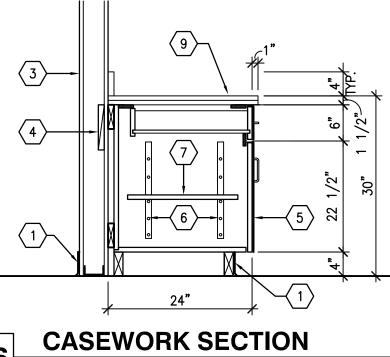

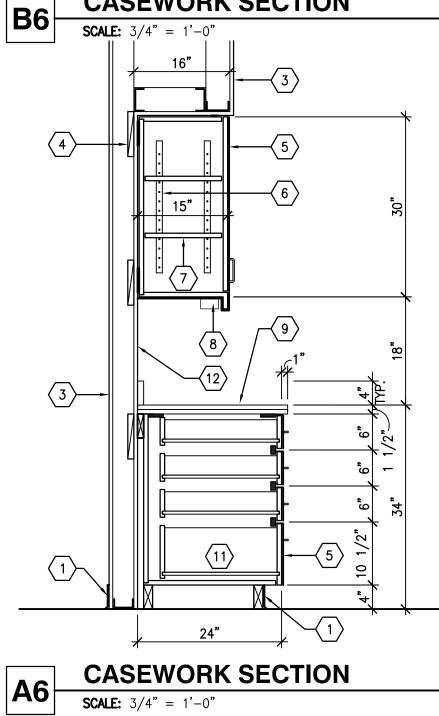




THE HARTMAN + MAJEWSKI JESIGN GROUP ARCHITECTS · ENGINEERS INTERIOR DESIGN PLANNERS URBAN DESIGNERS · LEED @ 120 VASSAR DRIVE SE SUITE 100 ALBUQUERQUE, NEW MEXICO 87106 PHONE: 505.242.6880 FAX: 505.242.6881

CONSULTANT






PROJECT NAME

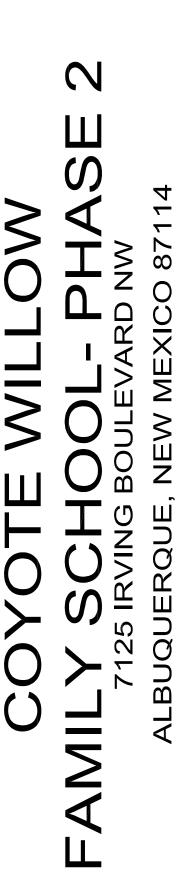

REVI	SIONS	
NO.	DATE	DESCRIPTION
$\overline{\Lambda}$	09/06/19	ADDENDUM 003
COF	PYRIGHT -	DESIGN GROUP
DES	GNER:	ESC
CHE	CKED:	WESC
DAT	E:	08.16.2019
SCA	LE:	3/4" = 1'-0"
JOB	NO.:	3050
CAE	FILE:	3042_A403

SHEET TITLE: CASEWORK SECTIONS INTERIOR ELEVATIONS



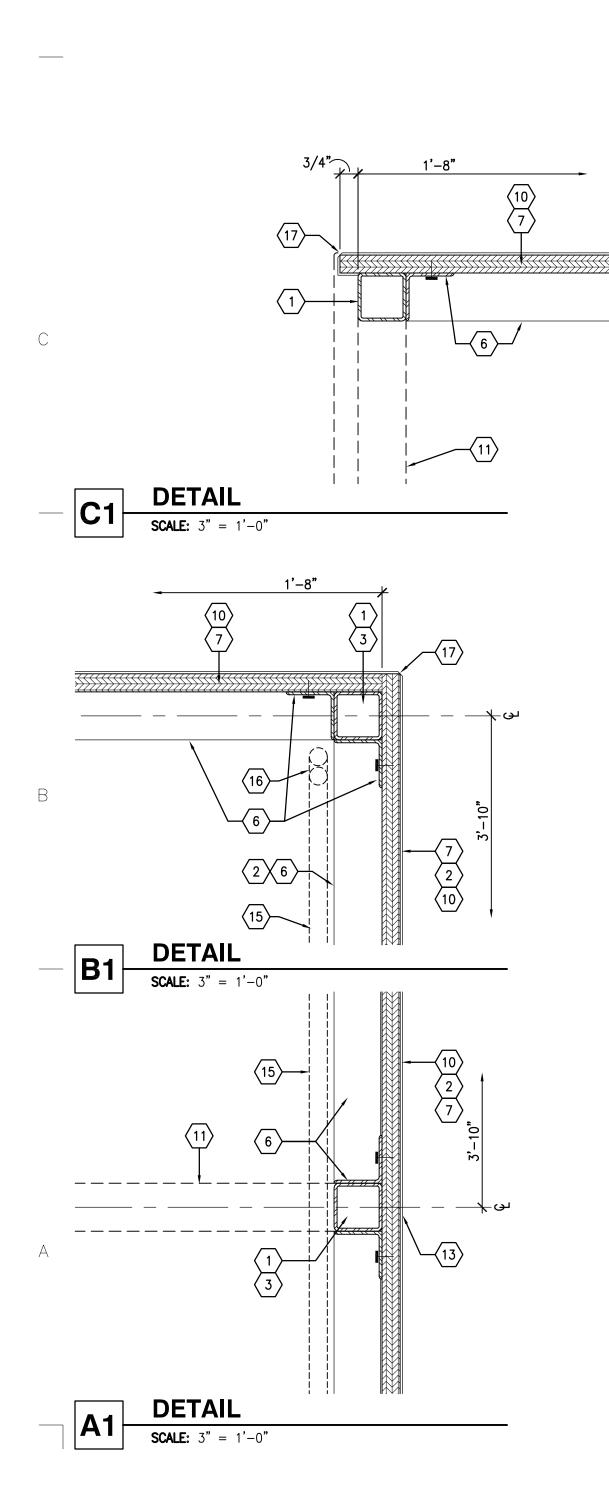







1

F

E

D














2


| 3

4

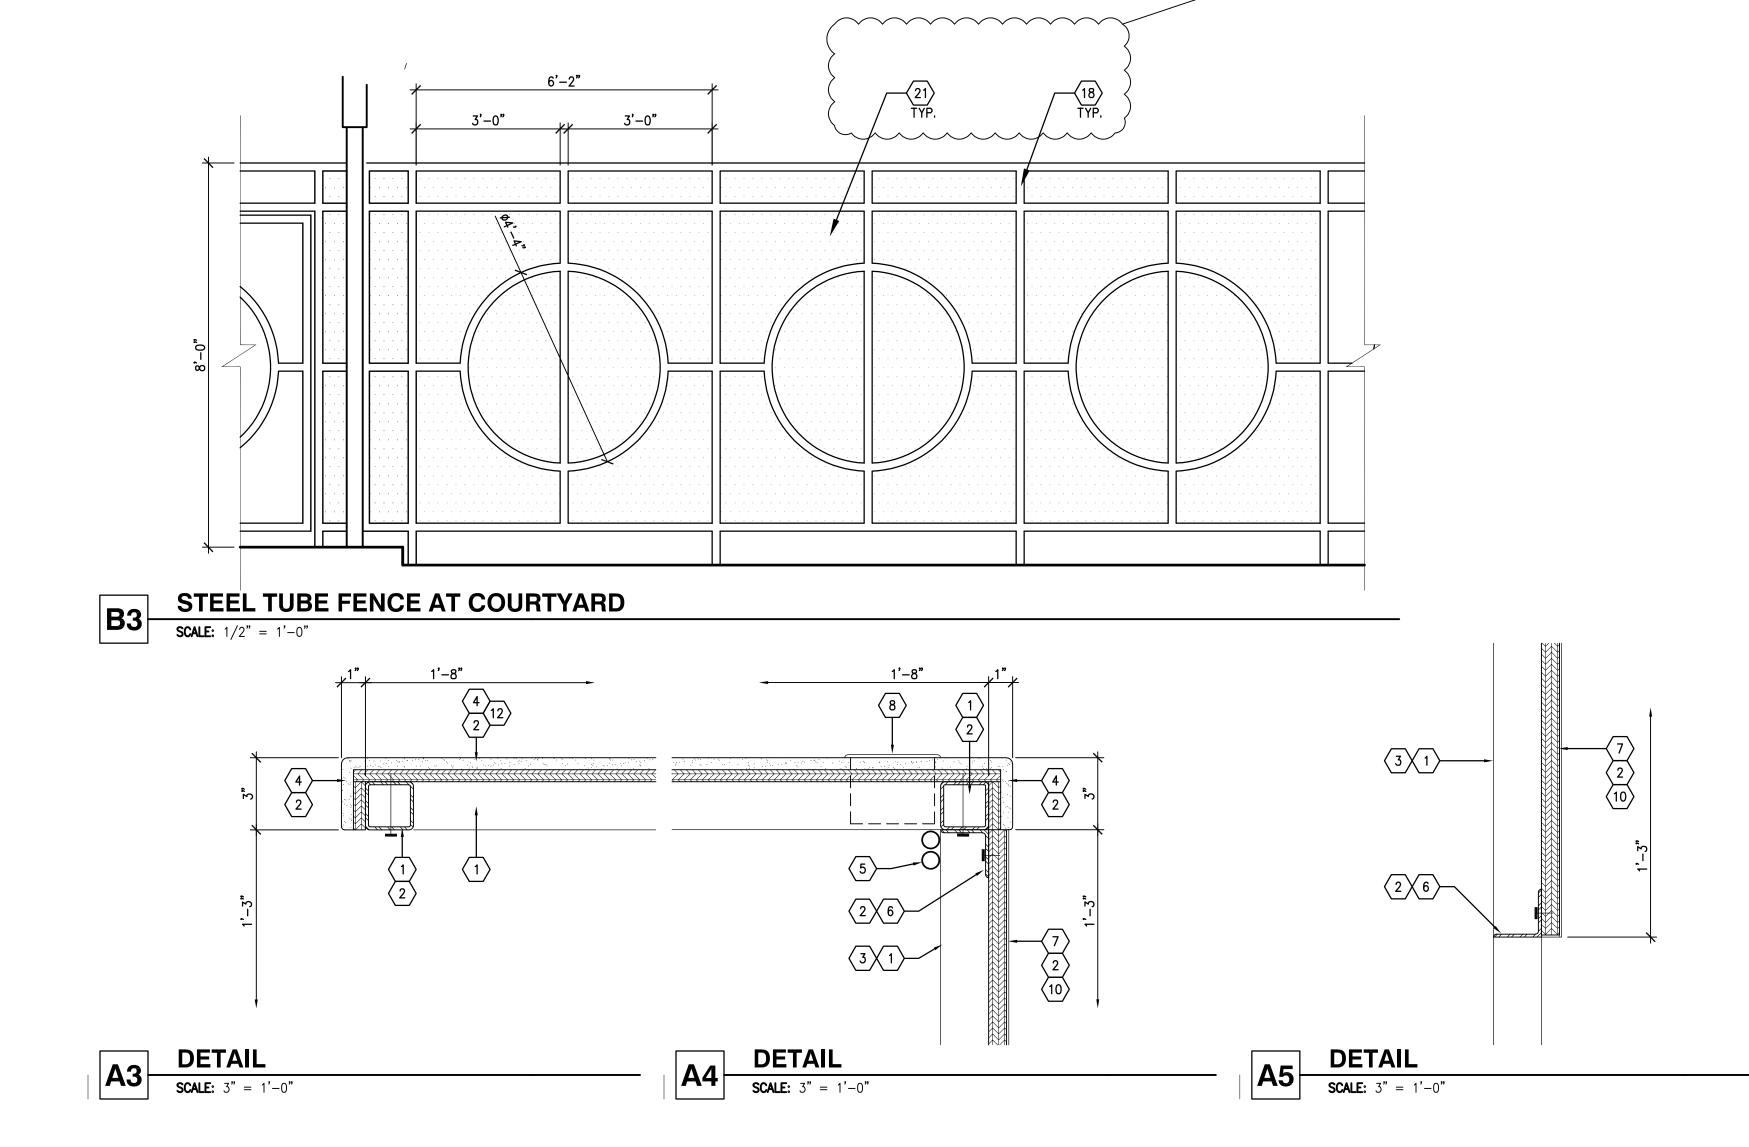


KEYED NOTES

- WELDED 2x2x10 GA. STEEL TUBE FRAME CURVED
- POSTS ANCHORED TO CONCRETE BELOW
- 4. 1/2" SOLID SURFACE OVER 1/2" PLYWOOD
 5. ELECTRICAL POWER AND COMPUTER CONDUITS 6. 2x2x1/8" CONTINUOUS STEEL ANGLE WELDED TO FRAME
- 7. PLASTIC LAMINATE COVERED 3/4" PLYWOOD PANEL ANCHORED TO
- ANGLES WITH GLUE AND 3/4" SCREWS AT 8" O.C. 8. POWER AND COMMUNICATIONS INTEGRATION SYSTEM BOX, MOCKETT PCS36B/U1-94 - MEDIUM POP UP POWER GROMMET (2 POWER, 1 DATA, DUAL USB CHARGER), OR EQUAL AS APPROVED BY ARCHITECT.
- 9. ANCHORED TO SLAB WITH BASE PLATE AND ANCHOR BOLTS 10. COVER ALL EXPOSED SIDES AND EDGES 11. FRAME ABOVE
- 12. ATTACH TO FRAME WITH GLUE AND 2-1/2" SCREWS 13. PANEL JOINT
- 14. 2x3x1/8" STEEL ANGLE WELDED TO FRAME 15. ROUTÉ CONDUIT ALONG INSIDE OF TOP FRAME
- 16. CONDUIT RISERS FOR POWER AND COMMUNICATIONS FROM SLAB BELOW 17. PROVIDE A 45° EDGE AT ALL OUTSIDE CORNERS
- 18. 2" STEEL TUBE 19. STEEL PERFORATED PANEL TO MATCH EXISTING PANEL BELOW
- 20. ATTACH TO WALL TO MATCH EXISTING ATTACHMENT, TYP. 21. 16 GA. STEEL PERFORATED PANEL (5/8% OPEN AREA, 1/4" DIAMETER HOLES, 5/16" STAGGERED CENTERS) WELDED TO STEEL
- TUBE. 22. CONTINUOUS BEAD OF WELD, GRIND SMOOTH.
- 23. 1/4" SQUARE STEEL BAR.

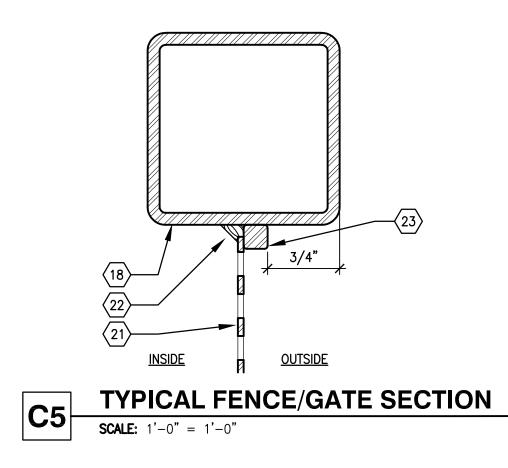

5

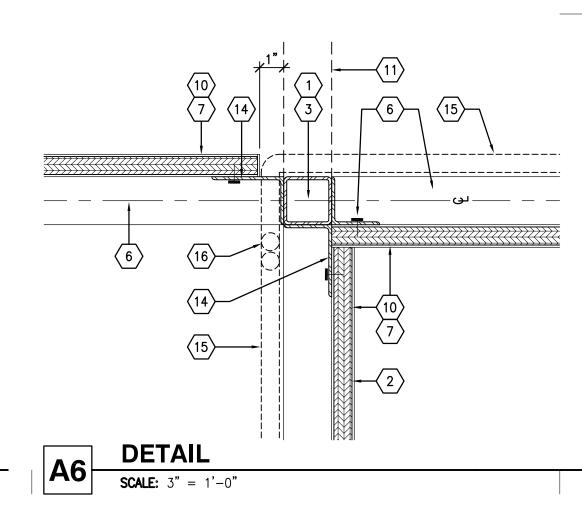




THE HARTMAN + MAJEWSKI Design Group ARCHITECTS · ENGINEERS · INTERIOR DESIGN PLANNERS · URBAN DESIGNERS · LEED © 120 VASSAR DRIVE SE SUITE 100 ALBUQUERQUE, NEW MEXICO 87106 PHONE: 505.242.6880 FAX: 505.242.6881

CONSULTANT

STAMP



PROJECT NAME

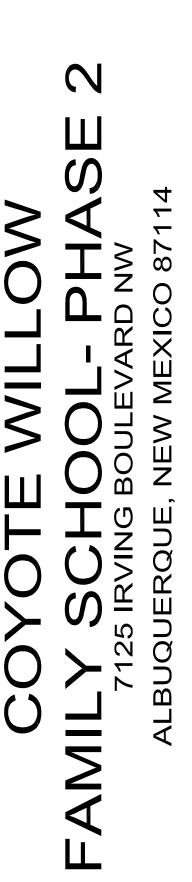


REVI	SIONS	
NO.	DATE	DESCRIPTION
$\overline{1}$	09/06/19	ADDENDUM 003
COF	PYRIGHT -	DESIGN GROUP
DES	GNER:	WESC
CHE	ECKED:	WESC
DAT	E:	08.16.2019
SCA	LE:	AS INDICATED
JOB	NO.:	3050
CAE	FILE:	3050_A501

SHEET TITLE: DETAILS



				D	DOR S	SCHE		E			
		DOO	R					FRAI	ME		
NO.	ROOM	SIZE	TYPE	MAT.	GLAZ.	TYPE	MAT.	HEAD	JAMB	THRESH.	
200	CLASSROOM	3'-0" x 7'-0" x 1 3/4"	D	НМ	$\langle 1 \rangle$	D	НМ	F3/A501	E5/A501	B5/A501	_
201	MECHANICAL	PAIR 3'-0"x7'-0"x1 3/4"		HM	-	A	HM		F5/A501	B5/A501	45 M
202	CLOSET	3'-0" x 7'-0" x 1 3/4"	B	WD		A	НМ	B3/A501	B3/A501	_	_
203	TEACHER WORKROOM	3'-0" x 7'-0" x 1 3/4"		WD	$\langle 1 \rangle$	A	НМ	,	, B3/A501	_	_
200	CLASSROOM	,					1154		,		
		3'-0" x 7'-0" x 1 3/4" 3'-0" x 7'-0" x 1 3/4"		HM WD	$\begin{pmatrix} 1 \\ 1 \end{pmatrix}$	D A	HM HM	/	E5/A501 B3/A501	B5/A501 –	 -
205	TEACHER WORKROOM	3'-0" x 7'-0" x 1 3/4"		WD		A	НМ		B3/A501		
205A 206	TEACHER WORKROOM	,									
200	CLOSET	3'-0" x 7'-0" x 1 3/4" 3'-0" x 7'-0" x 1 3/4"		WD WD		A A	HM HM	,	B3/A501 B3/A501	-	-
208	CLASSROOM	, 							· ·		
200		3'-0" x 7'-0" x 1 3/4" 3'-0" x 7'-0" x 1 3/4"		HM HM		D A	HM HM	· ·	E5/A501 E5/A501	B5/A501 B5/A501	- 45 M
200		$3'-0" \times 7'-0" \times 1 3/4"$		WD		A	НМ		B3/A501		
210 210A	COMPUTER TECH	$3'-0" \times 7'-0" \times 1 3/4"$		HM		A	НМ	,	B3/A501		
210A 211		$3'-0" \times 7'-0" \times 1 3/4"$			-	D	нм 		,	B5/A501	
	ENTRY	$3'-0'' \times 7'-0'' \times 1 3/4''$		HM HM			нм НМ	,	E5/A501	B5/A501 B5/A501	
212	LECTURE	, 				A		,	E5/A501		
213	CLASSROOM	3'-0" x 7'-0" x 1 3/4" 3'-0" x 7'-0" x 1 3/4"	_	HM		D	HM	- /	E5/A501	B5/A501	-
214	TEACHER WORKROOM	$3'-0" \times 7'-0" \times 1 3/4"$		WD WD	$\langle 1 \rangle$	A	HM HM		B3/A501 B3/A501	_	-
214A	TEACHER WORKROOM	$3'-0" \times 7'-0" \times 1 3/4"$		WD		A A	HM		B3/A501	-	-
215	CLOSET	,						-			
216	CLOSET	3'-0" x 7'-0" x 1 ³ / ₄ "	B	WD		A	HM		F3/A501	-	-
217	CLASSROOM	3'-0" x 7'-0" x 1 ³ / ₄ "	D	НМ	$\langle 1 \rangle$	D	HM	1 '	F5/A501	B5/A501	-
218	ELECTRICAL	$3'-0" \times 7'-0" \times 1\frac{3}{4}"$	С	НМ		A	HM	F5/A501	E5/A501 F5/A501	B5/A501	45 MII
219	MECHANICAL	PAIR 3'-0"x7'-0"x1¾"	A	НМ	_	A	HM	F5/A501	E5/A501 F5/A501	B5/A501	45 MI
219A	MECHANICAL	1'-8" x 7'-0" x 1¾"	A	НМ	_	A	HM	F4/A501	F4/A501	-	45 MI
220	BOYS RESTROOM	$3'-0" \times 7'-0" \times 1\frac{3}{4}"$	A	НМ	_	A	HM	F5/A501	F5/A501	B5/A501	_
221	GIRLS RESTROOM	$3'-0" \times 7'-0" \times 1\frac{3}{4}"$	A	НМ	-	В	HM	F5/A501	F5/A501	B5/A501	90 MI
222	CLASSROOM	3'-0" x 7'-0" x 1¾"	D	НМ	$\langle 1 \rangle$	D	HM	F5/A501	F5/A501 B4/A501	B5/A501	_
223	TEACHER WORKROOM	3'-0" x 7'-0" x 1 ³ /4"	В	WD	_	A	HM		F3/A501	B5/A501	_
223A	TEACHER WORKROOM	3'-0" x 7'-0" x 1 ³ / ₄ "	В	WD	_	A	HM	F3/A501	F3/A501	B5/A501	-
224	CLOSET	3'-0" x 7'-0" x 1¾"	В	WD	_	A	НМ	F3/A501	F3/A501	_	-
225	CLOSET	3'-0" x 7'-0" x 1¾"	В	WD		A	НМ		F3/A501	_	- 1
226	CLASSROOM	PAIR 3'-0"x7'-0"x1¾"	D	НМ		D	НМ	F3/A501	F5/A501 B4/A501	B5/A501	-
227	KILN	3'-0" x 7'-0" x 1 ³ /4"	A	НМ	-	В	НМ		E5/A501 E5/A501	B5/A501	45 MI
228	UNISEX TLT	$3'-0" \times 7'-0" \times 1\frac{3}{4}"$	A	НМ	4	A	НМ		F5/A501 F4/A501	_	1
229	UNISEX TLT	3'-0" x 7'-0" x 1 ³ /4"	A	НМ		A	НМ	F3/A501	F3/A501	_	_
230	JANITOR	$3'-0" \times 7'-0" \times 1\frac{3}{4}"$	A	НМ	_	A	НМ	,	F3/A501	_	
231	COLLABORATION AREA	$3'-0" \times 7'-0" \times 1\frac{3}{4}"$	D	НМ		D	HM	,	/ F5/A501 B4/A501	B5/A501	-
231A	COLLABORATION AREA	$3'-0" \times 7'-0" \times 1\frac{3}{4}"$	D	НМ	$\langle 1 \rangle$	D	HM	, F3/A501	F5/A501	, B5/A501	_
232	PERISHABLE AREA	PAIR 3'-0"x6'-7"x2"	D	HM	$\langle 1 \rangle$	A	HM		F5/A501	B5/A501	-
232A	PERISHABLE AREA	3'-0" x 7'-0" x 1¾"	A	НМ	$\left\langle 1 \right\rangle$	A	НМ	F3/A501	F3/A501		_
233	COUNSELOR	3'-0" x 7'-0" x 1¾"	В	WD	$\langle 1 \rangle$	A	НМ		, F3/A501		_
G103	GATE	PAIR 3'-6"x6'-7"x2"	G	STL		E	STL	_	_	_	-
$\sim\sim$	GATE	PAIR 3'-6"x6'-7"x2"	G	STL	<u> </u>	Ē	STL		_	_	

А

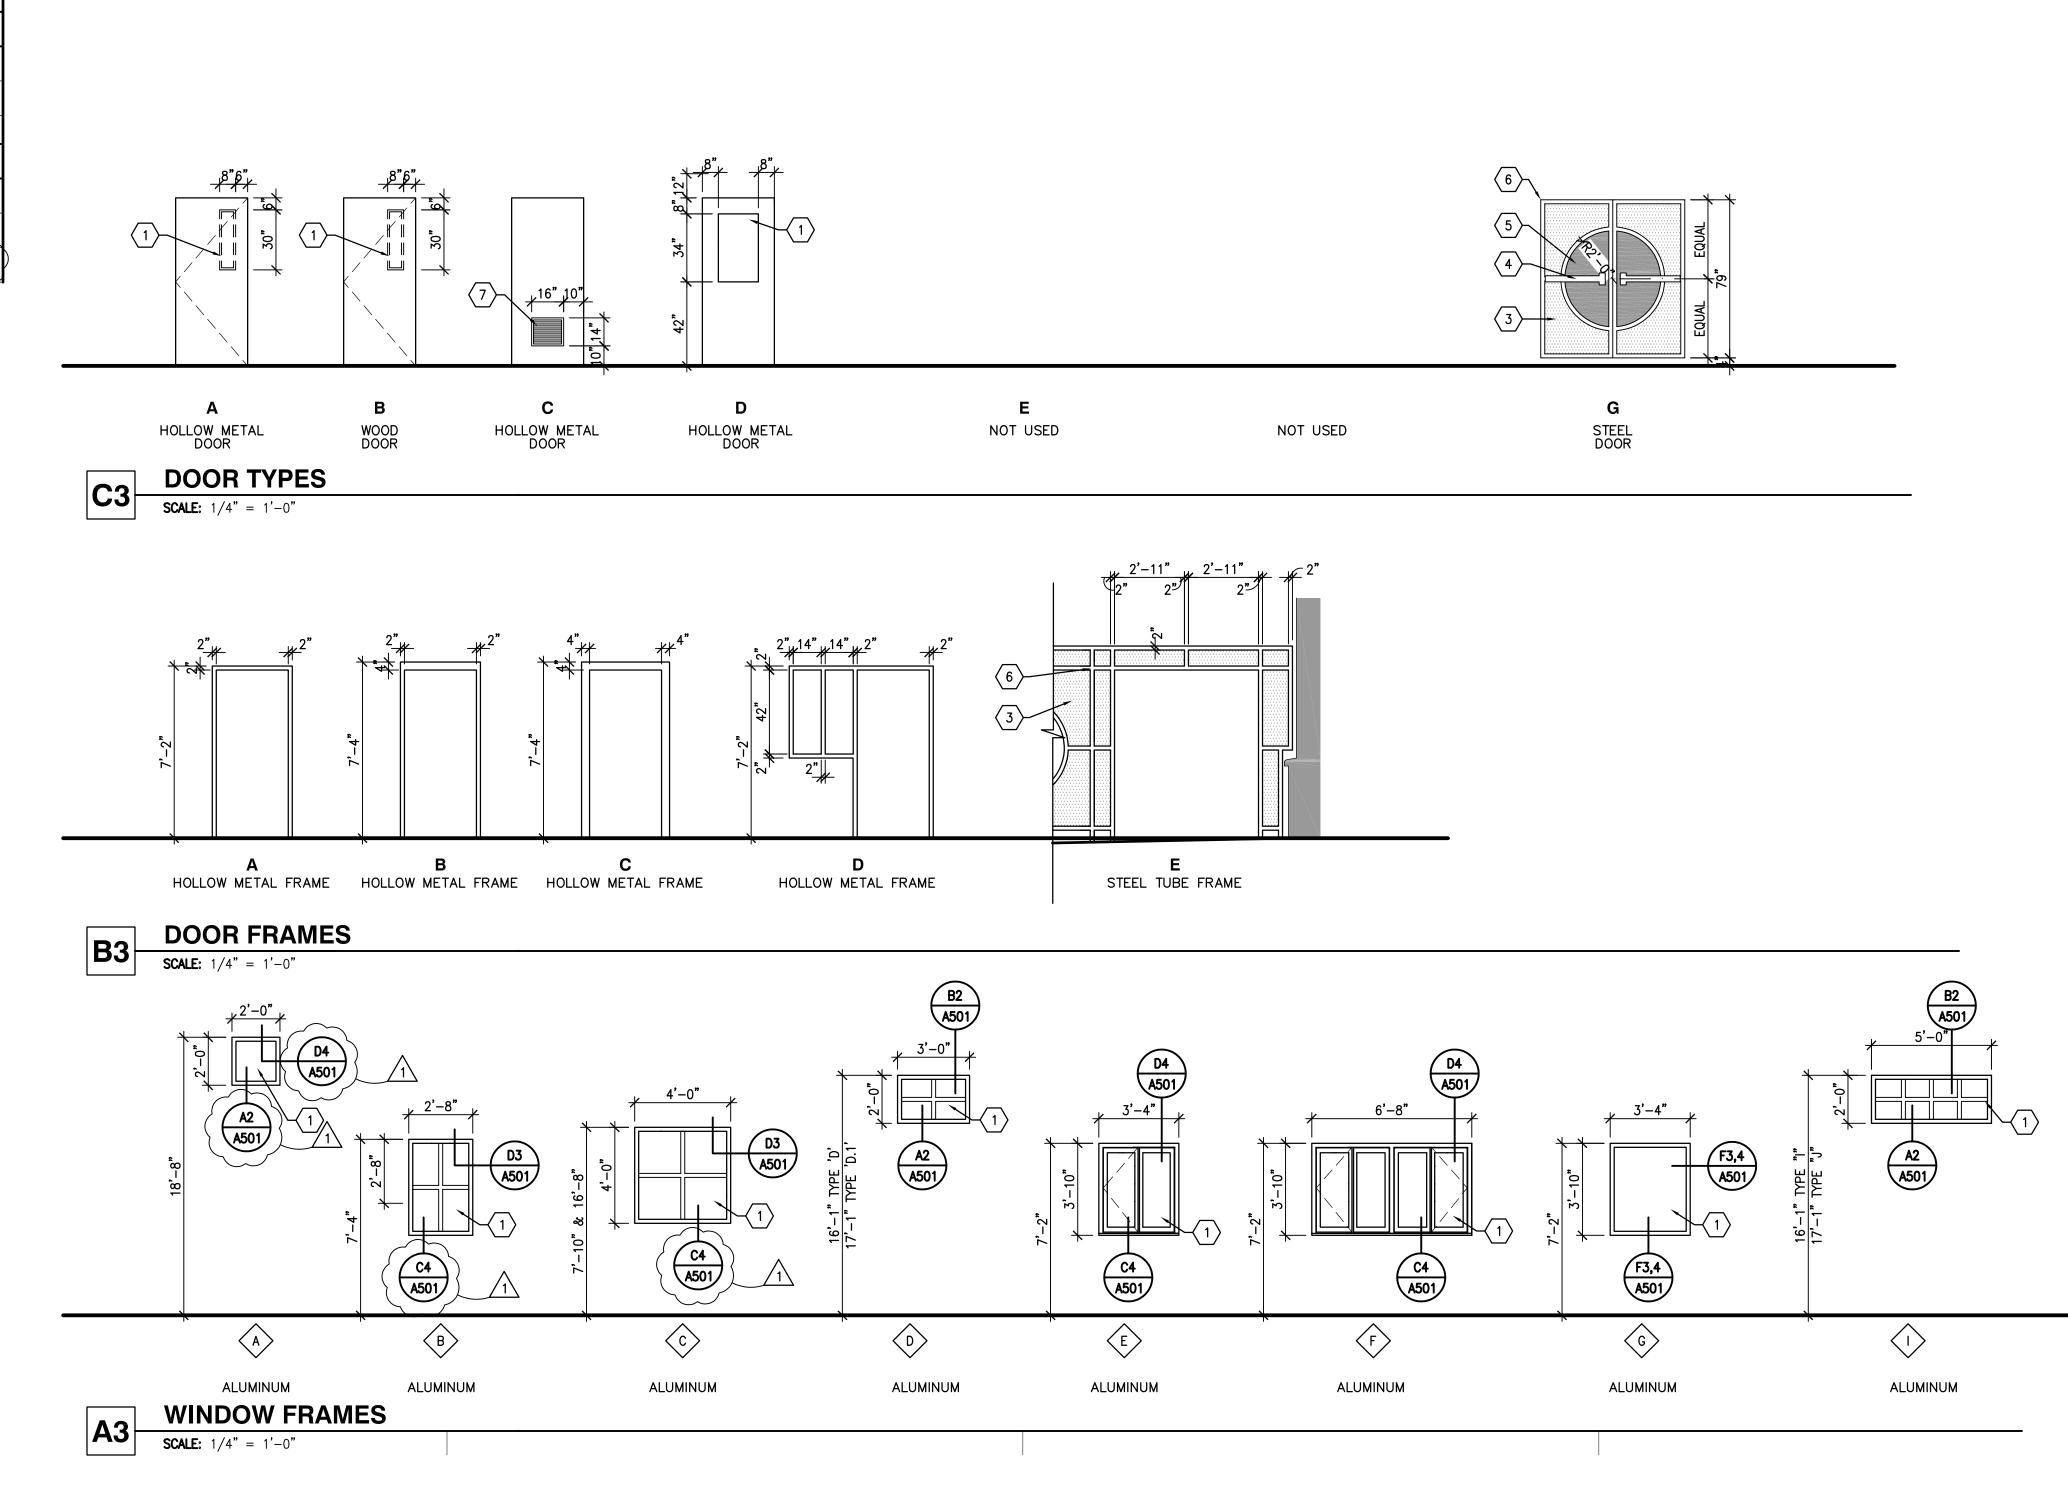

.3

4

KEYED NOTES

5

- 1. 1" LAMINATED/TEMPERED GLASS
- 2. SMOKE SEAL 3. 16 GA. STEEL PERFORATED PANEL (58% OPEN AREA, 1/4" DIAMETER HOLES, 5/16" STAGGERED CENTERS) WELDED TO STEEL TUBE 4. EXIT DEVICE. PROVIDE FRAME SUPPORT.

- STEEL PLATE
 SQUARE STEEL TUBE, ALL WELDS GROUND SMOOTH, PRIMED AND PAINTED, COLOR TO BE SELECTED BY ARCHITECT
 DOOR LOUVER. PAINT TO MATCH DOOR.




THE HARTMAN + MAJEWSKI Design Group ARCHITECTS · ENGINEERS · INTERIOR DESIGN PLANNERS · URBAN DESIGNERS · LEED @ 120 VASSAR DRIVE SE SUITE 100 ALBUQUERQUE, NEW MEXICO 87106 PHONE: 505.242.6880 FAX: 505.242.6881

CONSULTANT



PROJECT NAME

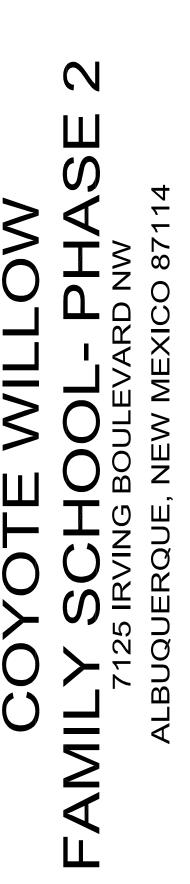


REV	SIONS	
NO.	DATE	DESCRIPTION
1	09/06/19	ADDENDUM 003
COF	YRIGHT -	DESIGN GROUP
DES	GNER:	WESC
CHE	CKED:	WESC
DAT	E:	08.16.2019
SCA	LE:	1/4" = 1'-0"
JOB	NO.:	3050
CAE	FILE:	3050_601
SHE	ET TITLE:	

SHEET TITLE: DOOR SCHEDULE DOOR TYPES DOOR AND WINDOW FRAMES





			1		2
			FINIS	H LEGEND	
			FLOOR I	INISHES	
MATERIA	MARK	AL	COLOR	MANUFACTURER	COMMENTS
CARPET TIL	CPT-1	E.	KLASS ROOM: SOCIAL STUDIES COLOR: 178149 SCHMICK	INTERFACE FLOR	CLASSROOMS
CARPET TIL	CPT-2	.E	KLASS ROOM: STUDENT COUNCIL COLOR: 178133 SCHMICK	INTERFACE FLOR	TEACHER WORKROOMS
SEALED CONCR	SC-1	RETE	NO COLOR		MECHANICAL, ELECTRICAL AN
POLISHED CONC	PC-1	CRETE	NO COLOR		JANITOR ROOMS
ENTRANCE M	WO-1	IAT	MILL FINISH ALUMINUM	C/S PEDISYSTEMS-PEDITRED SA	RECESSED SLAB
WALK OFF M	WO-2	IAT	SUPERFLOR: COLOR TBD	INTERFACE	INTERIOR ONLY
			BASE F	INISHES	
MATERIA	MARK	AL	COLOR	MANUFACTURER	COMMENTS
RUBBER BAS	RB-1	SE	CHARCOAL WG 20	JOHNSONITE	4" BASE SIZE
			WALL F	INISHES	
MATERIAL	MARK		COLOR	MANUFACTURER	COMMENTS
PORCELAIN TILE	CT-1	NATURAL	HUES ECO BODY: IVORY QF24	DALTILE	4.25 X 8.5 TILE (TALC BOD
PORCELAIN TILE	CT-2	NATURAL	HUES ECO BODY: FERN QF80	DALTILE	4.25 X 8.5 TILE (TALC BOD
PORCELAIN TILE	CT-3	NATURAL	HUES ECO BODY: AEGEAN QF41	DALTILE	4.25 X 8.5 TILE (TALC BOD
PORCELAIN TILE	CT-4	NATURAL	HUES ECO BODY: ATLANTIS QF43	DALTILE	4.25 X 8.5 TILE (TALC BOD
PORCELAIN TILE NATURAL HUES ECO BODY: DIJON QF73		HUES ECO BODY: DIJON QF73	DALTILE	4.25 X 8.5 TILE (TALC BOD	
PORCELAIN TILE	CT-6	NATURAL	HUES ECO BODY: MANGO QF71	DALTILE	4.25 X 8.5 TILE (TALC BOD
PORCELAIN TILE	CT-7	IVORY QF	24 W/CUSTOM GRAPHIC PRINT	DALTILE	4.25 X 4.25 TILE (TALC BO
GROUT	GT-1	ALABASTE	R #333	CUSTOM BUILDING PRODUCTS	USE WITH CT
FIBER REIN. PANEL	FRP-1	TBD		MARLITE	
PAINT	P-1		NA DEW339	DUNN EDWARDS	FIELD
PAINT	P-2		OOT DE5521	DUNN EDWARDS	
PAINT	P-3	MONTEGO	BAY DE5739	DUNN EDWARDS	_
PAINT	P-4	GOLDEN F	RETRIEVER DE5318	DUNN EDWARDS	
PAINT	P-5	YAMS DES		DUNN EDWARDS	_
PAINT	P-6	SPANISH	PEANUT DE5180	DUNN EDWARDS	
PAINT	P-8	TOASTED	MARSHMALLOW DE6165	DUNN EDWARDS	_
PAINT	P-9	MATCH EX	XISTING METAL ROOF	DUNN EDWARDS	COLUMNS, DOWNSPOUTS, SOFFITS AND EAVES
PAINT	P-10	MATCH E	XISTING EXTERIOR DOORS AND	DUNN EDWARDS	EXTERIOR CLASSROOM DOOR AND DOOR FRAMES
			MICSELI	ANEOUS	
MATERIAL	MARK		COLOR	MANUFACTURER	COMMENTS
LAMINATE	PL-1	MANITOBA	MAPLE 7911-60	WILSONART LAMINATE	CASEWORK
SOLID SURFACE	SS-1	NATURAL	GRAY	CORIAN	COUNTERTOPS
SOLID SURFACE	SS-2	BISQUE		CORIAN	WINDOW SILL
WALL PANEL	WP-1		COPPERSMITH #59-54	ECO ART BY HYTEX	CLASSROOMS
WALL PANEL	WP-2	FLAGSTON	NE COPPERSMITH #59-53	ECO ART BY HYTEX	LECTURE
CHAIR RAIL	CR-1	STAINED \	WOOD GOLDEN OAK #68	BENJAMIN MOORE BENWOOD	4" WIDE- WAITING AREA
			CEILING	FINISHES	
MATERIA	MARK	AL	COLOR	MANUFACTURER	COMMENTS
ACOUSTIC CEILING	ACT-1	PANELS	SCHOOL ZONE – FINE FISSURED WHITE, HIGH NRC/HIGH CAC	ARMSTRONG	WHITE, 15/16" PRELUDE SUSPENSION SYSTEM
ACOUSTIC CEILING	ACT-2	PANELS	FINE FISSURED - WHITE	ARMSTRONG	WHITE, 15/16" PRELUDE SUSPENSION SYSTEM
	GYP-1	CEILING	TEXTURED, PAINTED	_	PT-1, UNLESS NOTED OTHERWISE
STAINED WOOD	SW-1		MATCH EXISTING	BENJAMIN MOORE - BENWOOD	EXPOSED WOOD PLANKS AND BE
ACOL GYP	ACT-1 ACT-2 GYP-1	USTIC CEILING USTIC CEILING SUM BOARD	USTIC CEILING PANELS USTIC CEILING PANELS SUM BOARD CEILING	USTIC CEILING PANELS SCHOOL ZONE – FINE FISSURED WHITE, HIGH NRC/HIGH CAC USTIC CEILING PANELS FINE FISSURED – WHITE SUM BOARD CEILING TEXTURED, PAINTED	USTIC CEILING PANELS SCHOOL ZONE – FINE FISSURED WHITE, HIGH NRC/HIGH CAC ARMSTRONG USTIC CEILING PANELS FINE FISSURED – WHITE ARMSTRONG SUM BOARD CEILING TEXTURED, PAINTED –

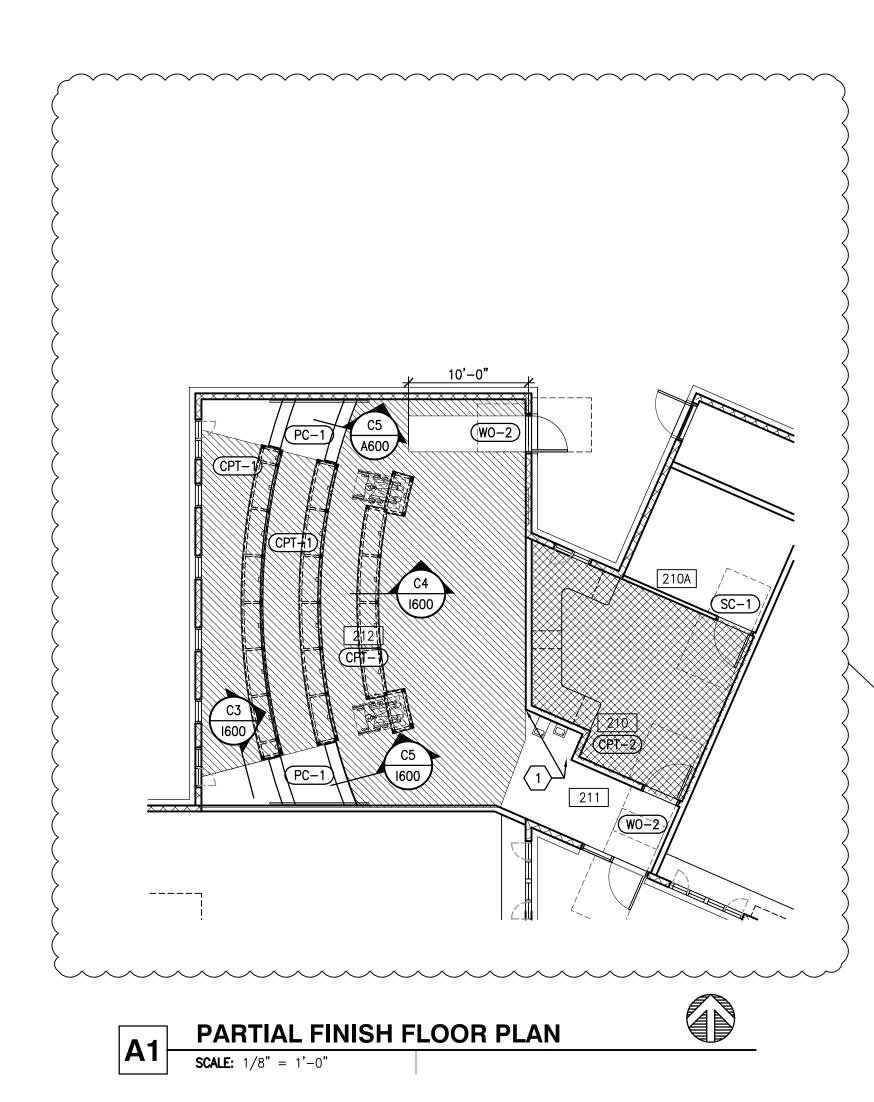


3

					FINISH	SCHED	ULE			
			DAGE		WA	LLS		CASE	NORK	Γ
NO	ROOM NAMES	FLOOR	BASE	N	E	S	w	CABINETS	COUNTER	
200	CLASSROOM	CPT-1/PC-1	RB-1	P-1	P-2	P-1/CT	P-3	PL-1	SS-1	
201	MECHANICAL	SC-1	RB-1	P-1	P-1	P-1	P-1	_	_	Ī
202	CLOSET	SC-1	RB-1	P-1	P-1	P-1	P-1	-	_	Ī
203	TEACHER WORKROOM	CPT-2	RB-1	P-1	P-1	P-1	P-6	_	_	
204	CLASSROOM	CPT-1/PC-1	RB-1	P-1	P-4	P-1/CT	P-5	PL-1	SS-1	Ī
205	TEACHER WORKROOM	CPT-2	RB-1	P-1	P-1	P-1	P-6	_	_	
206	CLOSET	PC-1	RB-1	P-1	P-1	P-1	P-1	_	_	I
207	CLOSET	PC-1	RB-1	P-1	P-1	P-1	P-1	_	_	
208	CLASSROOM	CPT-1/PC-1	RB-1	P-1	P-2	P-1/CT	P-3	PL-1	SS-1	Ī
209	ELECTRICAL	SC-1	RB-1	P-1	P-1	P-1	P-1	_	_	Ī
210	COMPUTER TECH	CPT-2	RB-1	P-1	P-1	P-1	P-1	_	_	Ī
210A	TELE/COM	SC-1	RB-1	P-1	P-1	P-1	P-1	-	_	Ī
211	ENTRY	WO-2	RB-1	P-6	P-1	P-6	-	-	_	Ī
212	LECTURE	CPT-1/PC-1	RB-1	P-8	P-8	P-8	P-3	-	_	Ī
213	CLASSROOM	CPT-1/PC-1	RB-1	P-3	P-1/CT	P-2	P-1	PL-1	SS-1	Ī
214	TEACHER WORKROOM	CPT-2	RB-1	P-1	P-1	P-6	P-1	_	_	Ī
215	CLOSET	PC-1	RB-1	P-1	P-1	P-1	P-1	_	_	Ī
216	CLOSET	PC-1	RB-1	P-1	P-1	P-1	P-1	_	_	
217	CLASSROOM	CPT-1/PC-1	RB-1	P-5	P-1/CT	P-4	P-1	PL-1	SS-1	
218	ELECTRICAL	SC-1	RB-1	P-1	P-1	P-1	P-1	_	_	
219	MECHANICAL	SC-1	RB-1	P-1	P-1	P-1	P-1	_	-	Ī
220	BOYS RESTROOM	PC-1	СТ	P-3/CT	P-1/CT	P-3/CT	P-1/CT	_	_	Ī
221	GIRLS RESTROOM	PC-1	СТ	P-5/CT	P-1/CT	P-5/CT	P-1/CT	_	_	Ī
222	CLASSROOM	CPT-1/PC-1	RB-1	P-3	P-1/CT	P-2	P-1	PL-1	SS-1	Ī
223	TEACHER WORKROOM	CPT-2	RB-1	P-6	P-1	P-1	P-1	_	_	Ī
224	CLOSET	PC-1	RB-1	P-1	P-1	P-1	P-1	_	-	Ī
225	CLOSET	PC-1	RB-1	P-1	P-1	P-1	P-1	-	_	Ī
226	CLASSROOM	PC-1	RB-1	P-5	P-1/CT	P-4	P-1	PL-1	SS-1	Ī
227	KILN	SC-1	RB-1	P-1	P-1	P-1	P-2	_	_	
228	UNISEX TOILET	PC-1	СТ	P-1/CT	P-3/CT	P-1/CT	P-1/CT	_	_	Ī
229	UNISEX TOILET	PC-1	СТ	P-1/CT	P-3/CT	P-1/CT	P-1/CT	_	_	t
230	JANITOR	SC-1	RB-1	P-1/FRP-1	P-1/FRP-1	P-1/FRP-1	P-1/FRP-1	_	_	t
231	COLABORATION	PC-1	RB-1	P-1	P-5	P-1/CT	P-5	PL-1	SS-1	t
232	PERISHABLE STORAGE	PC-1	RB-1	P-1/CT	P-1	P-1	P-1	_	_	t
233	COUNSELOR	CPT-2	RB-1	P-1	P-5	P-1	P-1	_	_	t

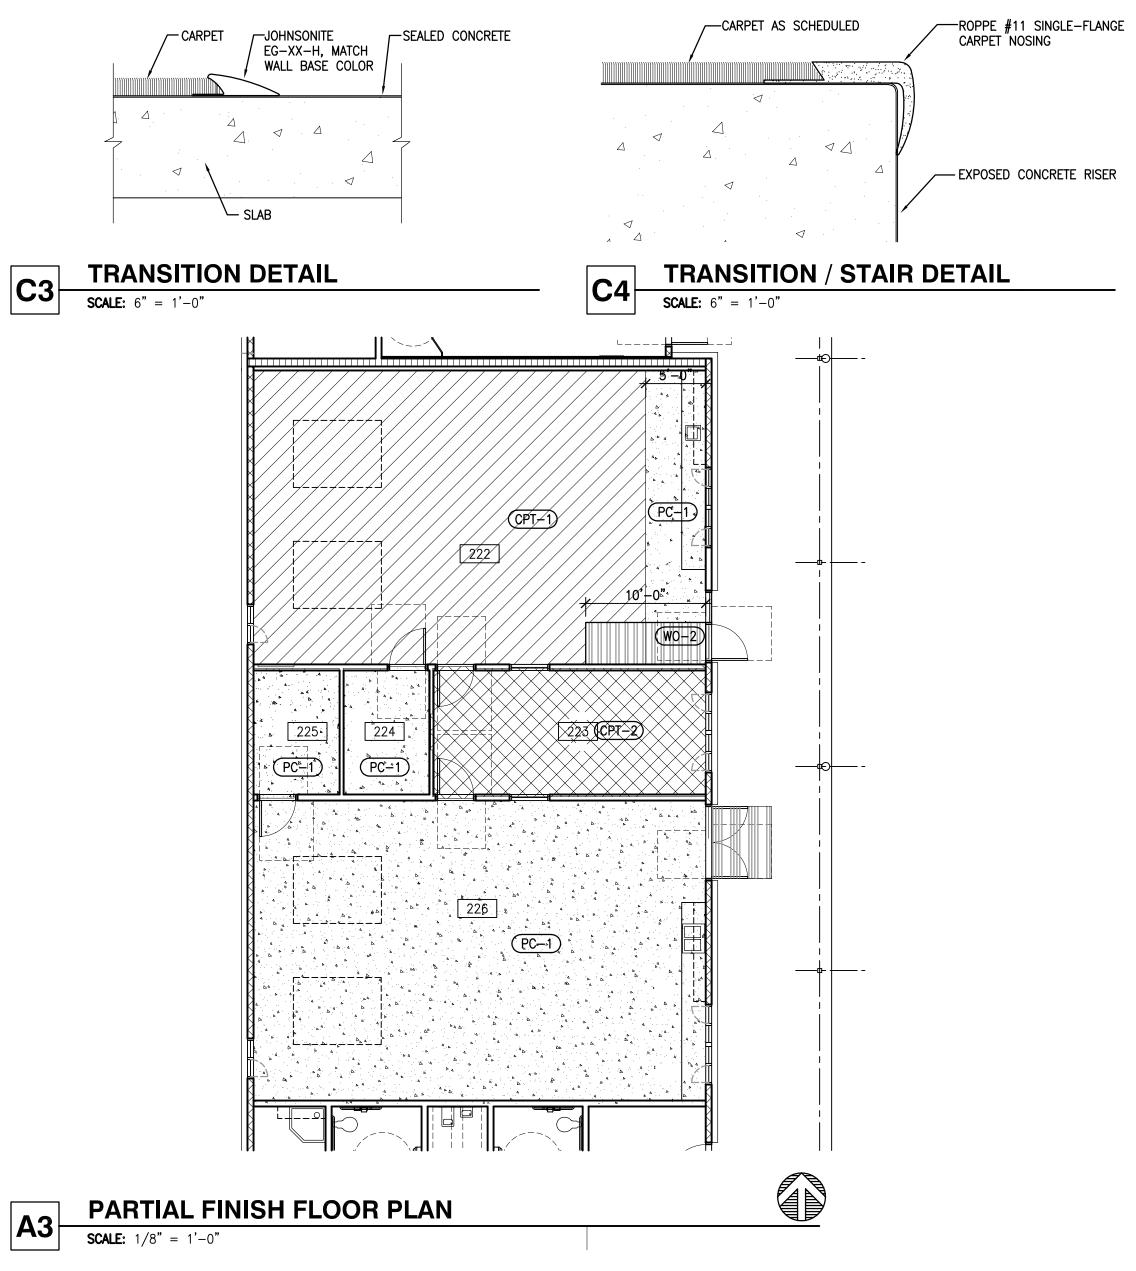

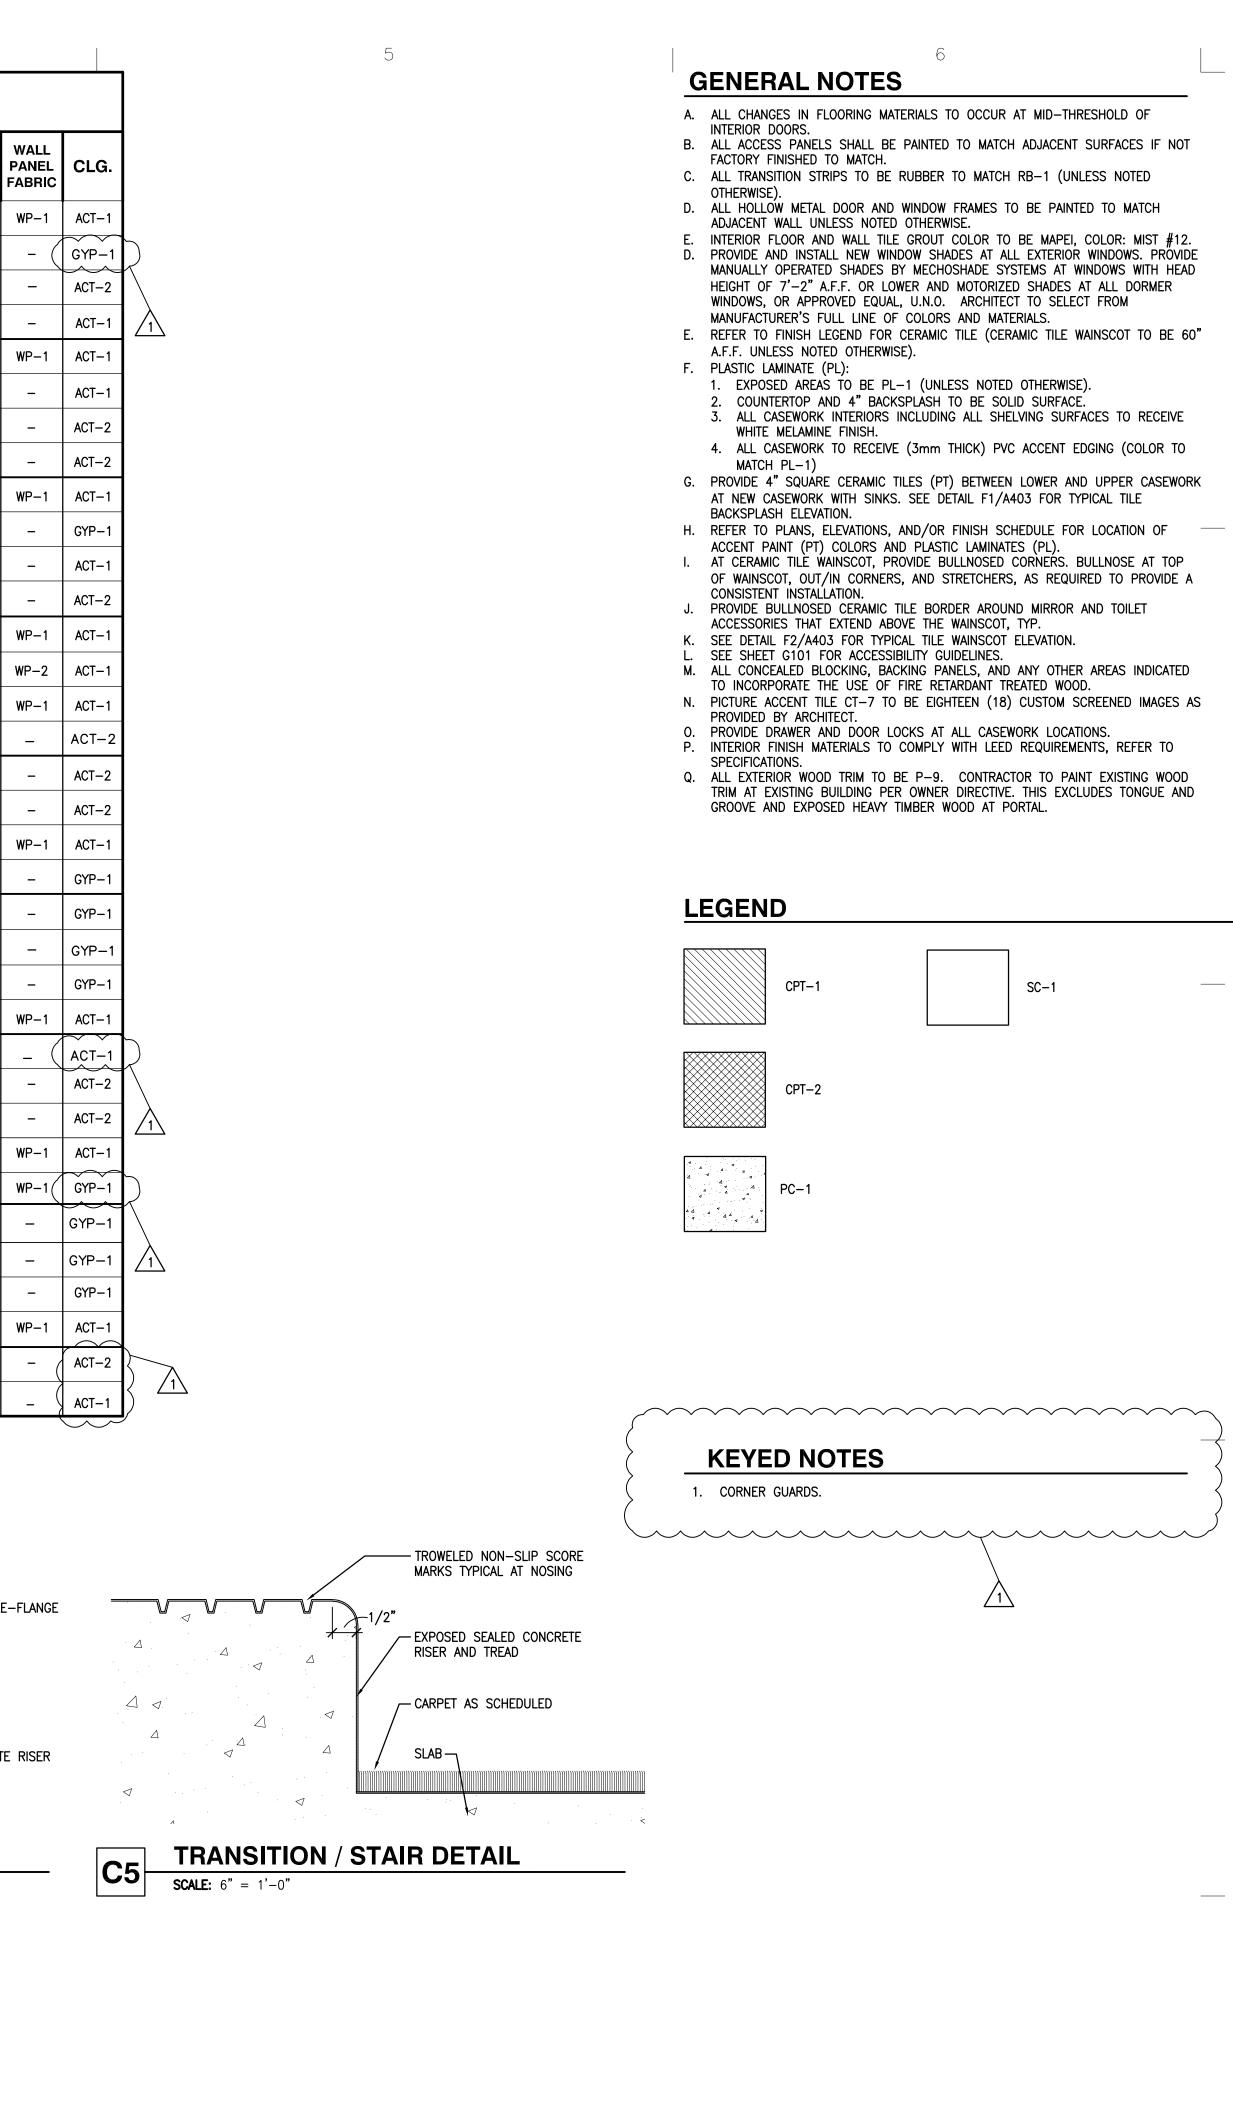

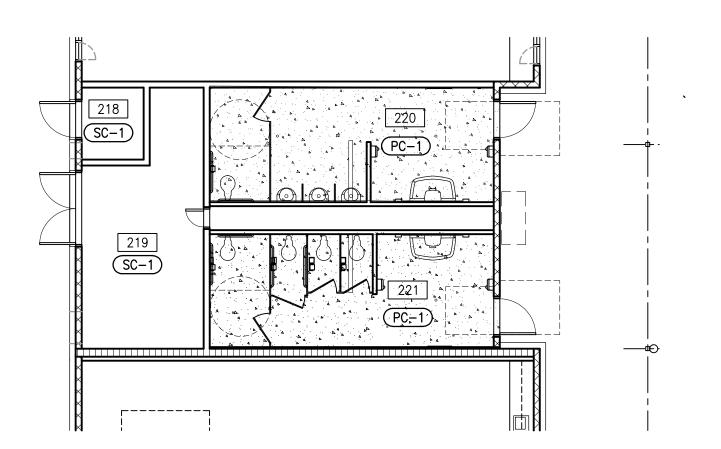

A5-




THE HARTMAN + MAJEWSKI DESIGN GROUP ARCHITECTS · ENGINEERS · INTERIOR DESIGN PLANNERS · URBAN DESIGNERS · LEED • 120 VASSAR DRIVE SE SUITE 100 ALBUQUERQUE, NEW MEXICO 87106 PHONE : 505.242.6880 FAX : 505.242.6881

CONSULTANT

STAMP



PROJECT NAME

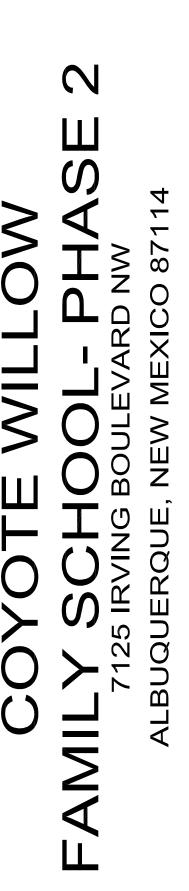

REVI	REVISIONS					
NO.	DATE	DESCRIPTION				
1	09/06/19	ADDENDUM 003				
COF	- PYRIGHT -	DESIGN GROUP				
DES	GNER:	АМ				
CHE	ECKED:	WESC				
DAT	E:	08.16.2019				
SCA	LE:	N.T.S.				
JOB	8 NO.:	3050				
CAE	FILE:	3042_1600				
SHE	ET TITLE:					

ROOM FINISH LEGEND



ווטן	FUS	SER, F	REGI	STE	R & GRILLE SCHEDULE
EXHAUS STEEL G GRILLES SYMBOL WHICH G AS REQU FASTENI BY PRIO REGISTE	, REGISTERS T/RETURN RI RILLES, REG , REGISTERS ON THE DRA OVERNS IN JIRED TO SU NG FRAMES R APPROVAL RS, AND DIF	EGISTERS OF BISTERS, AND S, AND DIFFU AWINGS. ALL THE EVENT C PPORT CEILI . EQUIPMENT . ONLY. (ALL S	R GRILLES WH DIFFUSERS SERS SHALL SYMBOLS SH DF A CONFLIC NG MOUNTED MANUFACTU SECURITY GF QUIRING FIRE	HERE HEA SHALL BE BE FINISH IALL BE CO CT. DISCRE O GRILLES JRED BY F RILLES AN	ICATED OF STEEL OR ALUMINUM, AS NOTED. ONLY ALUMINUM SHALL BE USED ON AVY CONCENTRATIONS OF MOISTURE ARE PRESENT (I.E. SHOWER ROOMS, CARTWASHER, E PROVIDED WITH ZINC PHOSPHATE PRIME COAT AND BAKED WHITE ENAMEL FINISH. ALUM HED WITH BAKED WHITE ENAMEL. THE TYPE OF GRILLE, REGISTER, OR DIFFUSER IS SHOW COORDINATED BY THE CONTRACTOR WITH THE ARCHITECTURAL ROOM FINISH SCHEDULE, REPANCIES WILL BE CLEARLY NOTED ON THE SUBMITTALS. FURNISH ADDITIONAL T-BAR FR/ S, REGISTERS, AND DIFFUSERS. ALL UNITS SHALL BE PROVIDED WITH CONCEALED TYPE PRICE, KRUEGER, AND TITUS, ARE ACCEPTABLE. OTHER MANUFACTURERS SHALL BE ACCI ND REGISTERS SHALL BE SUBMITTED FOR APPROVAL PRIOR TO BID SUBMITTAL.) GRILLES, ON DAMPER ASSEMBLIES SHALL BE INSTALLED IN ACCORDANCE WITH THE SPECIFICATION
SYMBOL	-	MODEL	USE	TYPE	COMMENTS
S1	TITUS (or equal)	TMS series	SUPPLY DIFFUSER	LAY-IN	CEILING SUPPLY DIFFUSER: STEEL, STAMPED FACE, LAY-IN TYPE FRAME FOR T-BAR CEILING MOUNTING, ROUND NECK, ADJUSTABLE PANEL VANED WITH ADJUSTABLE PATTERN TABS, AND REMOVABLE CORE. TITUS TMS-3; PRICE SCDA; KRUEGER 1400-23, OR APPROVED EQUAL. WHITE POWDER COAT FINISH, OR COLOR AS SELECTED BY ARCHITECT.
S2	TITUS (or equal)	TMS series	SUPPLY DIFFUSER		M CEILING SUPPLY DIFFUSER: STEEL, STAMPED FACE, SURFACE TYPE FRAME FOR GYPSUM BOARD CEILING MOUNTING, ROUND NECK, ADJUSTABLE PANEL VANED WITH ADJUSTABLE PATTERN TABS AND REMOVABLE CORE. TITUS TMS-3; PRICE SCDA; KRUEGER 1400-22, OR APPROVED EQUAL. WHITE POWDER COAT FINISH, OR COLOR AS SELECTED BY ARCHITECT.
R1	TITUS (or equal)	50F series	RETURN GRILLE	LAY-IN	CEILING RETURN OR TRANSFER GRILLE: ALUMINUM CONSTRUCTION, 1/2"x1/2"x1/2" SQUARE EGGCRATE CORE WITH LAY-IN TYPE FRAME FOR T-BAR CEILING MOUNTING AND CONCEALED FASTENING. PRICE 80-TB; KRUEGER EGC-F23, TITUS 50F, OR APPROVED EQUAL.
R2	TITUS (or equal)	50F series	RETURN GRILLE	GYPSUM BOARD	M CEILING RETURN OR TRANSFER GRILLE: ALUMINUM CONSTRUCTION, 1/2"x1/2"x1/2" SQUARE EGGCRATE CORE WITH BORDER/FRAME FOR GYPSUM BOARD CEILING MOUNTING AND CONCEALED FASTENING. TITUS 50F; PRICE 80-TB; KRUEGER EGC-F23, OR APPROVED EQUAL.
E1	TITUS (or equal)	50F series	EXHAUST GRILLE		CEILING RETURN OR TRANSFER GRILLE: ALUMINUM CONSTRUCTION, 1/2"x1/2"x1/2" SQUARE EGGCRATE CORE WITH BORDER/FRAME FOR GYPSUM BOARD CEILING MOUNTING AND CONCEALED FASTENING. TITUS 50F; PRICE 80-TB; KRUEGER EGC-F23, OR APPROVED EQUAL.
	.OUV	ER S	CHEI	DUL	E
		URER MODE	L USE	TYI SIDE	Image: Performance of the system Comments Image: Performance of the system Wall LOUVER: Image: Performance of the system HIGH PERFORMANCE, 6035T5 EXTRUDED ALUMINUM CONSTRUCTION, 4" DEEP FLANGED FRAME WITH "J" TYPE DRAINABLE BLADES AT 45 DEG. AND SPACED AT 4" CENTERS, (APPROX.). Image: Performance of the system Image: Performance of the system SYMBOI	MANUFACT GREENHI (or equa	URER MODE ECK ESJ-4 al)	EL USE 401 WALL LOUVE	TYI SIDE R	COMMENTS WALL LOUVER: • HIGH PERFORMANCE, 6035T5 EXTRUDED ALUMINUM CONSTRUCTION, 4" DEEP FLANGED FRAME WITH "J" TYPE DRAINABLE BLADES AT 45 DEG. AND SPACED AT 4" CENTERS, (APPROX.). • ALUMINUM BIRDSCREEN SECURED TO INSIDE OF LOUVER. • SIZES AS SHOWN ON DRAWINGS. • FINISH PER ARCHITECTURAL RECOMMENDATIONS. • AMCA CERTIFIED • GREENHECK MODEL ESJ-401, OR APPROVED EQUAL.
SYMBOI	MANUFACT GREENHE (or equa	URER MODE ECK ESJ-4 al)	EL USE 101 WALL LOUVE	TYI SIDE R	YPE COMMENTS WALL WALL LOUVER: WALL - HIGH PERFORMANCE, 6035T5 EXTRUDED ALUMINUM CONSTRUCTION, 4" DEEP FLANGED FRAME WITH "J" TYPE DRAINABLE BLADES AT 45 DEG. AND SPACED AT 4" CENTERS, (APPROX.). • ALUMINUM BIRDSCREEN SECURED TO INSIDE OF LOUVER. • SIZES AS SHOWN ON DRAWINGS. • FINISH PER ARCHITECTURAL RECOMMENDATIONS. • AMCA CERTIFIED • GREENHECK MODEL ESJ-401, OR APPROVED EQUAL. OR SCHEDULE INE AIR PRESS LOSS DYNAMIC INSERTION LOSS GENERATED NOISE
	MANUFACT GREENHE (or equa	URER MODE ECK ESJ-4 al)	EL USE 401 WALL LOUVE	UAT	YPE COMMENTS WALL HOUVER: • HIGH PERFORMANCE, 6035T5 EXTRUDED ALUMINUM CONSTRUCTION, 4" DEEP FLANGED FRAME WITH "J" TYPE DRAINABLE BLADES AT 45 DEG. AND SPACED AT 4" CENTERS, (APPROX.). • ALUMINUM BIRDSCREEN SECURED TO INSIDE OF LOUVER. • SIZES AS SHOWN ON DRAWINGS. • FINISH PER ARCHITECTURAL RECOMMENDATIONS. • AMCA CERTIFIED • GREENHECK MODEL ESJ-401, OR APPROVED EQUAL. FOR SCHEDULE INE AIR PRESS LOSS (in w.c.) INE AIR FLOW PRESS LOSS (in w.c.) INE AIR FLOW PRESS LOSS (in w.c.) DYNAMIC INSERTION LOSS GENERATED NOISE
SYMBOI L1 SYMBO SYMBO SA-20 • SILENG • ABSOF ACOUS • ACOUS • ACOUS	MANUFACT GREENHE (or equa SOUN COL SERV 1 [200] CLA CER INLET A RPTIVE SILEN STIC FIBERG TRUCTION CI STIC FIBERG TRUCTION CI STIC MEDIA: MOSETTING I	URER MODE ECK ESJ-4 al) AD AT ASSROM ND OUTLET C NCERS SHALL ELASS MEDIA LASS 1: 22GA SHALL BE SH RESIN. GLASS	LUSE WALL LOUVE	UAT SIDE R UAT CENTERLII LENGTH 36" S SHALL E F SOLID S D. CASING DRGANIC C L BE PAC	Image: Provide the system AIR PRESS Dynamic insertion Loss Bine AIR FLOW PRESS Dynamic insertion Loss Bine AIR FLOW PRESS Dynamic insertion Loss Bine AIR PRESS Commentation of the work of the
SYMBOI L1 SYMBO SYMBO SA-20 • SILENG • ABSOF ACOUS • ACOUS • ACOUS • ACOUS	MANUFACT GREENHE (or equa SOUN CONTRACTION	URER MODE ECK al) ID AT ASSROM ND OUTLET C NCERS SHALL ELASS MEDIA LASS 1: 22GA SHALL BE SH RESIN. GLASS Y SHALL BE C	LUSE WALL LOUVE	TYI SIDE R SIDE UAT CENTERLII LENGTH 36" S SHALL E F SOLID S D. CASING DRGANIC C L BE PAC WITH THA	AIR AIR PRESS Dynamic insertion Loss INE FLOW VELOCITY CSS INE FLOW VELOCITY CSSS INE FLOW VELOCITY CSS
SYMBOI L1 SYMBO SYMBO SA-20 • SILENG • ABSOF ACOUS • ACOUS • ACOUS • ACOUS	MANUFACT GREENHE (or equa COUN COUNT COUN	URER MODE ECK ESJ-4 al) DDAT ADAT ASSROM ND OUTLET C NCERS SHALI LASS MEDIA LASS MEDIA LASS 1: 22GA SHALL BE SH RESIN. GLASS Y SHALL BE OF RESIN. GLASS Y SHALL BE OF RESIN. GLASS Y SHALL BE OF RESIN. GLASS Y SHALL BE OF TYPE NO.	EL USE 101 WALL LOUVE TEN MFGR: PRICE MODEL#: RM36-1D CONNECTIONS L CONSIST OF AS REQUIRED OD SC S FIBER SHAL CONSISTENT DD SC E CFM	S SHALL E SIDE UDAT CENTERLII LENGTH 36" S SHALL E SOLID S D CASING D CASING D CASING D CASING C CASING C CASING C CASING C C S SHALL E S C C S S S S S S S S S S S S S S S S	YPE COMMENTS WALL 14 UOUVER: • High PERFORMANCE, 6035T5 EXTRUDED ALUMINUM CONSTRUCTION DEG, AND SPACED AT 4" CENTERS, (APPROX.). • • JEEF FLANGED FRAME WITH "J" TYPE DRAINABLE BLADES AT 45 DEG, AND SPACED AT 4" CENTERS, (APPROX.). • • JEEF FLANGED FRAME WITH "J" TYPE DRAINABLE BLADES AT 45 DEG, AND SPACED AT 4" CENTERS, (APPROX.). • • SIZES AS SHOWN ON DRAWINGS. • • • FINISH PER ARCHITECTURAL RECOMMENDATIONS. • • • AMCA CERTIFIED • GREENHECK MODEL ESJ-401, OR APPROVED EQUAL. • ON A MICA CERTIFIED • ORE SCHEDULE USS DYNAMIC INSERTION LOSS GENERATED NOISE INE FLOW VELOCITY PRESS LOSS DYNAMIC INSERTION LOSS (CFM) VELOCITY PRESS COSS GENERATED NOISE H 1.1250 +918 0.04 4 7 16 32 47 42 26 BE EQUAL TO THE DUCT SIZES SHOWN ON THE DRAWINGS. STEEL CASINGS, PERFORATED SHEET METAL LINERS, AND ABSORPTIVE */// 42 26 1/266GA GALVANIZED PERFORATED LINER. CASS FIBER WITH LONG, RESILIENT FIBERS, BONDED WITH */// 42 26 2/266GA G

А

	1 2	3	4 6
	DIFFUSER, REGISTER & GRILLE SCHEDULE	EXHAUST FAN, DIRECT DRIVE SCHEDULE	WATER SOURCE HEAT PUMP SCHEDULE:
	STRUES SHALL BE FARRICATED OF STEEL OR ALUMINUM. AS NOTED. ONLY ALUMINUM SHALL BE USED ON EXPLICITINE TURN REGISTERS AND DEFUSERS SHALL BE FARRICATED OF STEEL OR ALUMINUM. AS NOTED. ONLY ALUMINUM SHALL BE USED ON EXPLICITINE TURN REGISTERS AND DEFUSERS SHALL BE COORDINATED BY THE CONTRACTOR WITH THE ARCHITERS BY THE CONTRACTOR WITH THE ARCHITERS AND DEFUSERS SHALL BE COORDINATED BY THE CONTRACTOR WITH THE ARCHITERS TO DEFUSERS SHALL BE SOLOND BY WHICH GOVERNO IN THE GRAVINGS SHALL BE COORDINATED BY THE CONTRACTOR WITH THE ARCHITERS AND DEFUSERS SHALL BE COORDINATED BY THE CONTRACTOR WITH THE ARCHITER ADDITIONAL THERE SHALL BE WHICH GOVERNO IN THE DEFUSERS SHALL BE COORDINATED BY THE CONTRACTOR WITH THE ARCHITER AND TOTOLIC TREES SHALL BE SHALL SOLUTION TO A CONTRICT DESCREPANCES SHALL BE USED TATES TO ALL REGISTERS AND DEFUSERS SHALL BE ADDITIONAL THERE AND PARTINES RAME DEFUSERS SHALL BE USED THE COARDEN. THE TYPE TRANSPORTATION ADDITIONAL THE ARCHITER AND TO ACCURATE AND THE CONTRACTOR AND THE ARCHITER AND TRANSPORTATION ADDITIONAL THE ARCHITER SHALL BE USED TO ACCURATE AND THE SOLUTION ADDITION. THE ARCHITER AND TRANSPORTATION ADDITIONAL THE ARCHITER SHALL BE USED TO ACCURATE AND THE SOLUTION. THE ARCHITER AND THE ACCURATE AND THE SOLUTION ADDITION TO ACCURATE AND THE SOLUTION. THE ARCHITER AND THE ACCURATE AND THE SOLUTION ADDITION TO ACCURATE AND THE SOLUTION. THE ARCHITER AND THE ACCURATE AND THE SOLUTION ADDITION. THE ARCHITE AND THE ACCURATE AND THE SOLUTION. THE SOLUTION ADDITION THE ARCHITER AND THE ACCURATE AND THE SOLUTION. THE ARCHITER AND THE ACCURATE AND THE SOLUTION. THE ARCHITER AND THE ACCURATE AND THE SOLUTION. THE ARCHITER AND THE ACCURATE AND T	AMCA CERTIFIED FURNISH WITTE WITTE ACCESSORIES WITTOR WITTE WITTOR WITTE Image: Comparison of the com	ITNALE EFFICIENCY SUPPLY FM FLUD / WATER COOL/IG HEATING ELECTROL Infig Model April Ap
AC-201 TELECOM [210A] MM_W48524A (wall mounted) 509 NA 2 21,400 23,000 3.15 0.24 CU-201 4MXW8524A (20/60/1 16.0 18.5 18.0 20/60/1 20 MISELLAPOUS ITENSATION DOWN TO 0°F CI RABILITY DOWN TO 0°F CI RABILITY D	INDEL CFM (CFM) (FPM) (in w.c.) Generated Noise SA-201 [200] CLASSROOM RM36-1D 36" +1,250 +918 0.04 4 7 1 63 41 200 40 38 32 47 42 26 17 • SILENCER INLET AND OUTLET CONNECTIONS SHALL BE EQUAL TO THE DUCT SIZES SHOWN ON THE DRAWINGS. • Assochrifter Shall as Required. • Oot Struction CLASS 1: 226A GALVANIZED CASING / 26GA GALVANIZED PERFORATED LINER. • Acoustric riberdias shall be Shoth-free INORGANIC GLASS FIBER WITH THONG. RESILENT FIBERS, BONDED WITH THERMOSETTING RESIN, GLASS FIBER SHALL BE PACKED WITH A MINIMUM 10% COMPRESSION TO ELIMINATE VOIDS AND SETTLING; DENSITY SHALL BE CONSISTENT WITH THAT USED TO GENERATE CATALOGED TEST DATA SYMBOL GREENHECK TYPE CFM THROAT DIMENSIONS FREE PRESS.THROAT WEIGHT X 14" ROOF CURB: MATCH ROOF PITCH/SLOPE SYMBOL GREENHECK TYPE CFM THROAT DIMENSIONS FREE PRESS.THROAT WEIGHT X 14" ROOF CURB: MATCH ROOF PITCH/SLOPE GACWART DAMPER GRAVITY Windol MODEL NO. IV X H AREA DROO <td< td=""><td>WALL BRACKET COMPLETE SINGLE POINT CONNECTION. NOTE: ALL DISCONNECTS AND LINE VOLTAGE WIRING BY ELECTRICAL CONTRACTOR ALL DISCONNECTS AND LINE VOLTAGE WIRING BY ELECTRICAL CONTRACTOR SERVICE MFG'R YOULTAGE ALL DISCONNECTS AND LINE VOLTAGE WIRING BY ELECTRICAL CONTRACTOR SERVICE MFG'R YOULTAGE YOULTAGE</td><td></td></td<>	WALL BRACKET COMPLETE SINGLE POINT CONNECTION. NOTE: ALL DISCONNECTS AND LINE VOLTAGE WIRING BY ELECTRICAL CONTRACTOR ALL DISCONNECTS AND LINE VOLTAGE WIRING BY ELECTRICAL CONTRACTOR SERVICE MFG'R YOULTAGE ALL DISCONNECTS AND LINE VOLTAGE WIRING BY ELECTRICAL CONTRACTOR SERVICE MFG'R YOULTAGE	




CONSULTANT

FEG
ArSed Engineering Group, LLC.
4700 Lincoln Road, NE Suite 101 Albuquerque, NM 87109 505.761.3100

STAMP



PROJECT NAME

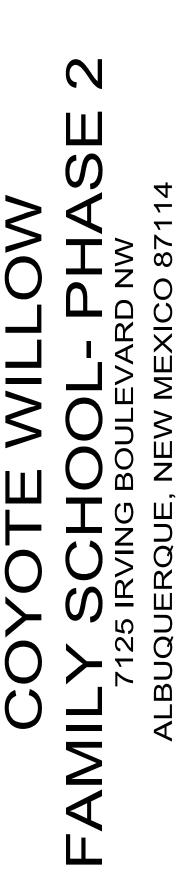


REVISIONS					
NO.	DATE	DESCRIPTION			
<u>/1</u>	09.10.19	ADDENDA #003			
COPYRIGHT - DESIGN GROUP					
DES	GNER:	DT			
CHECKED:		BA			
DAT	E:	08.16.2019			
SCALE:		none			
JOB NO.:		3050			
CAD FILE:		3050_M001			

SHEET TITLE: MECHANICAL

EQUIPMENT SCHEDULES



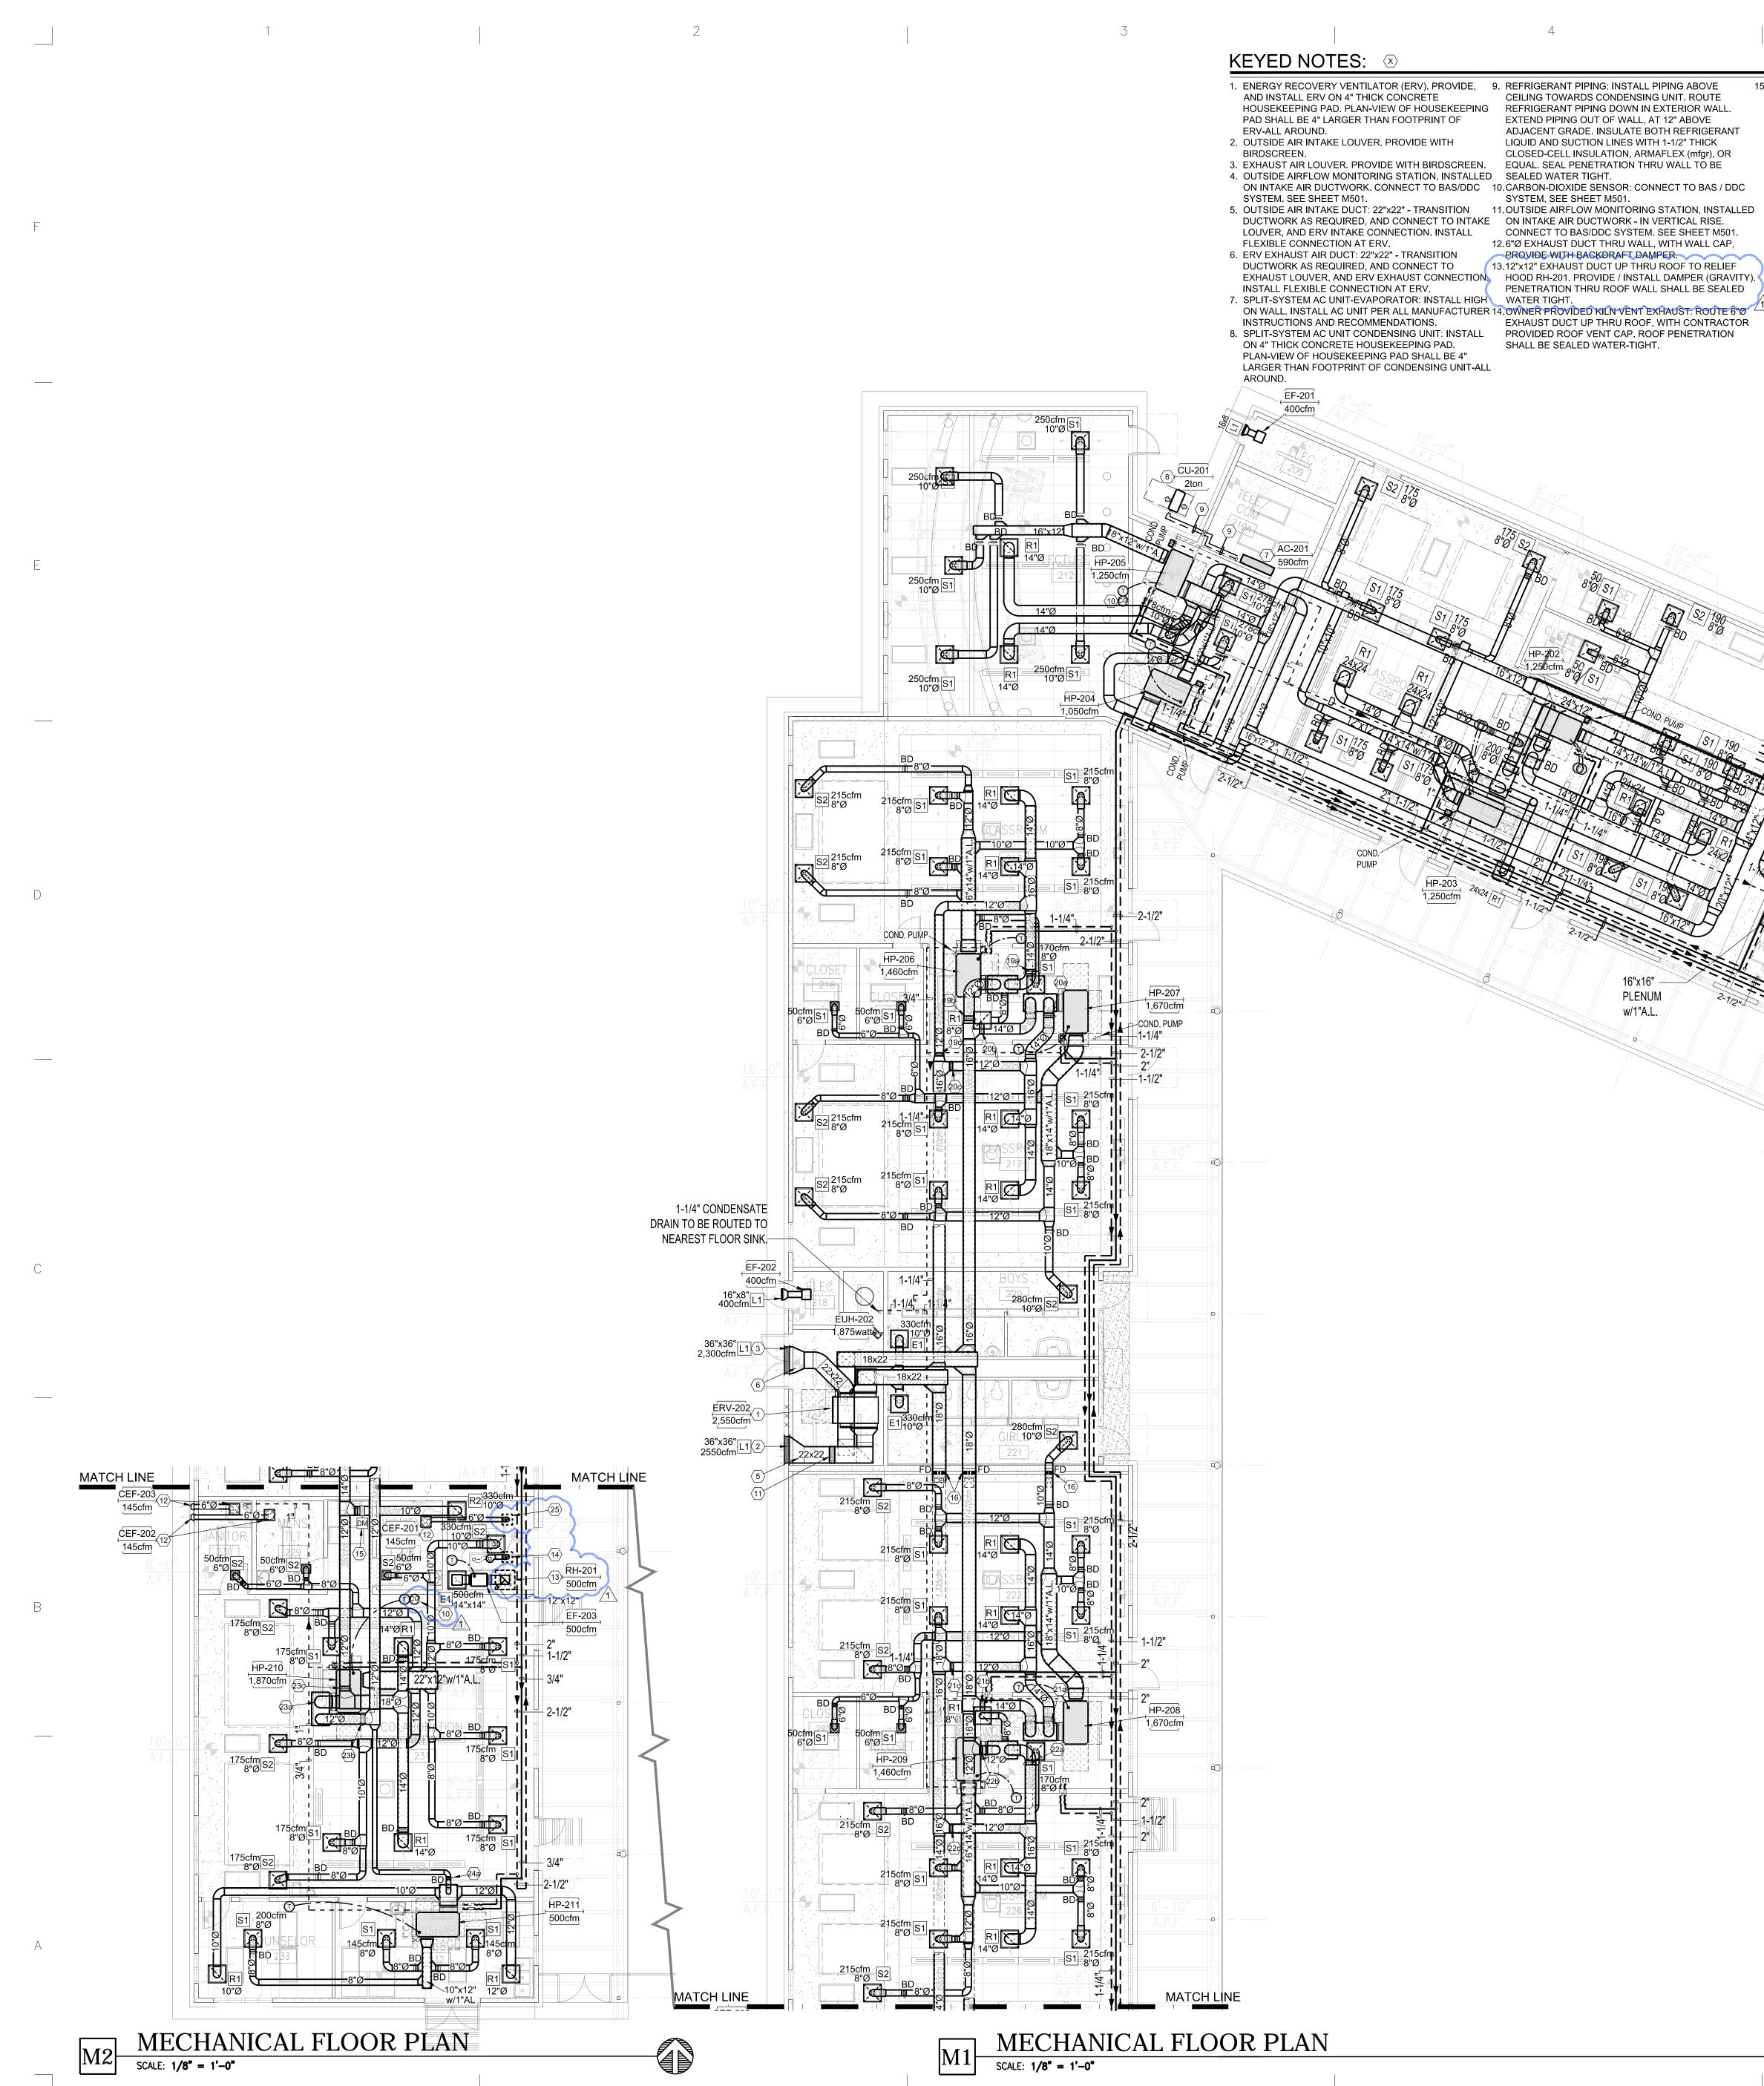

15. OPERATION OF KILN ROOM [227]: INSTALL MOTORIZED DAMPER IN EXHAUST DUCT AT DOOR. CONNECTED TO ERV-202 EXHAUST. SEQUENCE OF OPERATION(S): a. NORMAL OPERATION OF KILN ROOM [227]: -- KILN EQUIPMENT IS ENABLED "OFF". - SUPPLY AIR TO KILN ROOM IS SUPPLIED AT 330CFM (from HP-210). - MOTORIZED DAMPER IN EXHAUST DUCT SHALL ROOM SHALL T&B'd TO BE 350CFM, (PROVIDES 6% NEGATIVE PRESSURE).

- SUPPLY AIR TO KILN ROOM IS SUPPLIED AT 330CFM (from HP-210). - WHEN KILN IS "ON", AND IF TEMPERATURE IN KILN ROOM [227] RISES ABOVE 78°F, (USER ADJUSTABLE), EXHAUST FAN EF-203 SHALL BE ENABLED TO BE "ON".


- MOTORIZED DAMPER INSTALLED IN EXHAUST DUCT SHALL BE ENABLED TO BE "CLOSED". - EXHAUST FAN EF-203 IS SPECIFIED TO BE 500CFM, SUPPLY AIR TO ROOM IS 330CFM, (PROVIDES FOR 33% NEGATIVE PRESSURE).

- 16.FIRE DAMPER w/FUSIBLE LINK. PROVIDE ACCESS KILN ROOM [227]. EXHAUST AIR FROM KILN ROOM IS 17. EXISTING HPS MANIFOLD (INSTALLED IN PHASE 1 PROJECT). CONNECT TWO (2)-2-1/2" HPS LINES TO SPARE CONNECTIONS, AND ROUTE AS SHOWN. 18.EXISTING HPR MANIFOLD (INSTALLED IN PHASE 1 PROJECT). CONNECT TWO (2)-2-1/2" HPR LINES TO SPARE CONNECTIONS, AND ROUTE AS SHOWN.
- THE FOLLOWING -BE ENABLED "OPEN". EXHAUST AIR FROM KILN a. RETURN AIR (to hp-unit): T&B RA TO BE 860 CFM. b. OUTSIDE AIR (to hp-unit): T&B OA TO BE 430 CFM. c. EXHAUST AIR (from space): T&B EA TO BE 405 CFM. - EXHAUST FAN EF-203 SHALL BE ENABLED "OFF". 20.<u>HP-207</u>: INSTALL BALANCING DAMPER AND T&B PER b. WHEN KILN EQUIPMENT IS ENABLED TO BE "ON": THE FOLLOWING a. RETURN AIR (to hp-unit): T&B RA TO BE 1,040 CFM.
 - b. OUTSIDE AIR (to hp-unit): T&B OA TO BE 630 CFM. c. EXHAUST AIR (from space): T&B EA TO BE 250 CFM. 21.HP-208: INSTALL BALANCING DAMPER AND T&B PER THE FOLLOWING a. RETURN AIR (to hp-unit): T&B RA TO BE 1,040 CFM.
 - b. OUTSIDE AIR (to hp-unit): T&B OA TO BE 630 CFM. c. EXHAUST AIR (from space): T&B EA TO BE 250 CFM. 22.<u>HP-209</u>: INSTALL BALANCING DAMPER AND T&B PER THE FOLLOWING a. RETURN AIR (to hp-unit): T&B RA TO BE 860 CFM.
 - b. OUTSIDE AIR (to hp-unit): T&B OA TO BE 430 CFM. c. EXHAUST AIR (from space): T&B EA TO BE 405 CFM.

23.<u>HP-210</u>: INSTALL BALANCING DAMPER AND T&B PER THE FOLLOWING a. RETURN AIR (to hp-unit): T&B RA TO BE 1,010 CFM. b. OUTSIDE AIR (to hp-unit): T&B OA TO BE 370 CFM. c. EXHAUST AIR (from space): T&B EA TO BE 350 CFM. 24.<u>HP-211</u>: INSTALL BALANCING DAMPER AND T&B PER THE FOLLOWING a. OUTSIDE AIR (to hp-unit): T&B OA TO BE 40 CFM. 19. HP-206: INSTALL BALANCING DAMPER AND T&B PER 25.6"Ø EXHAUST DUCT, UP THRU ROOF TO ROOF VENT CAP. ROOF PENETRATION SHALL BE SEALED

and the second th

WATER-TIGHT.

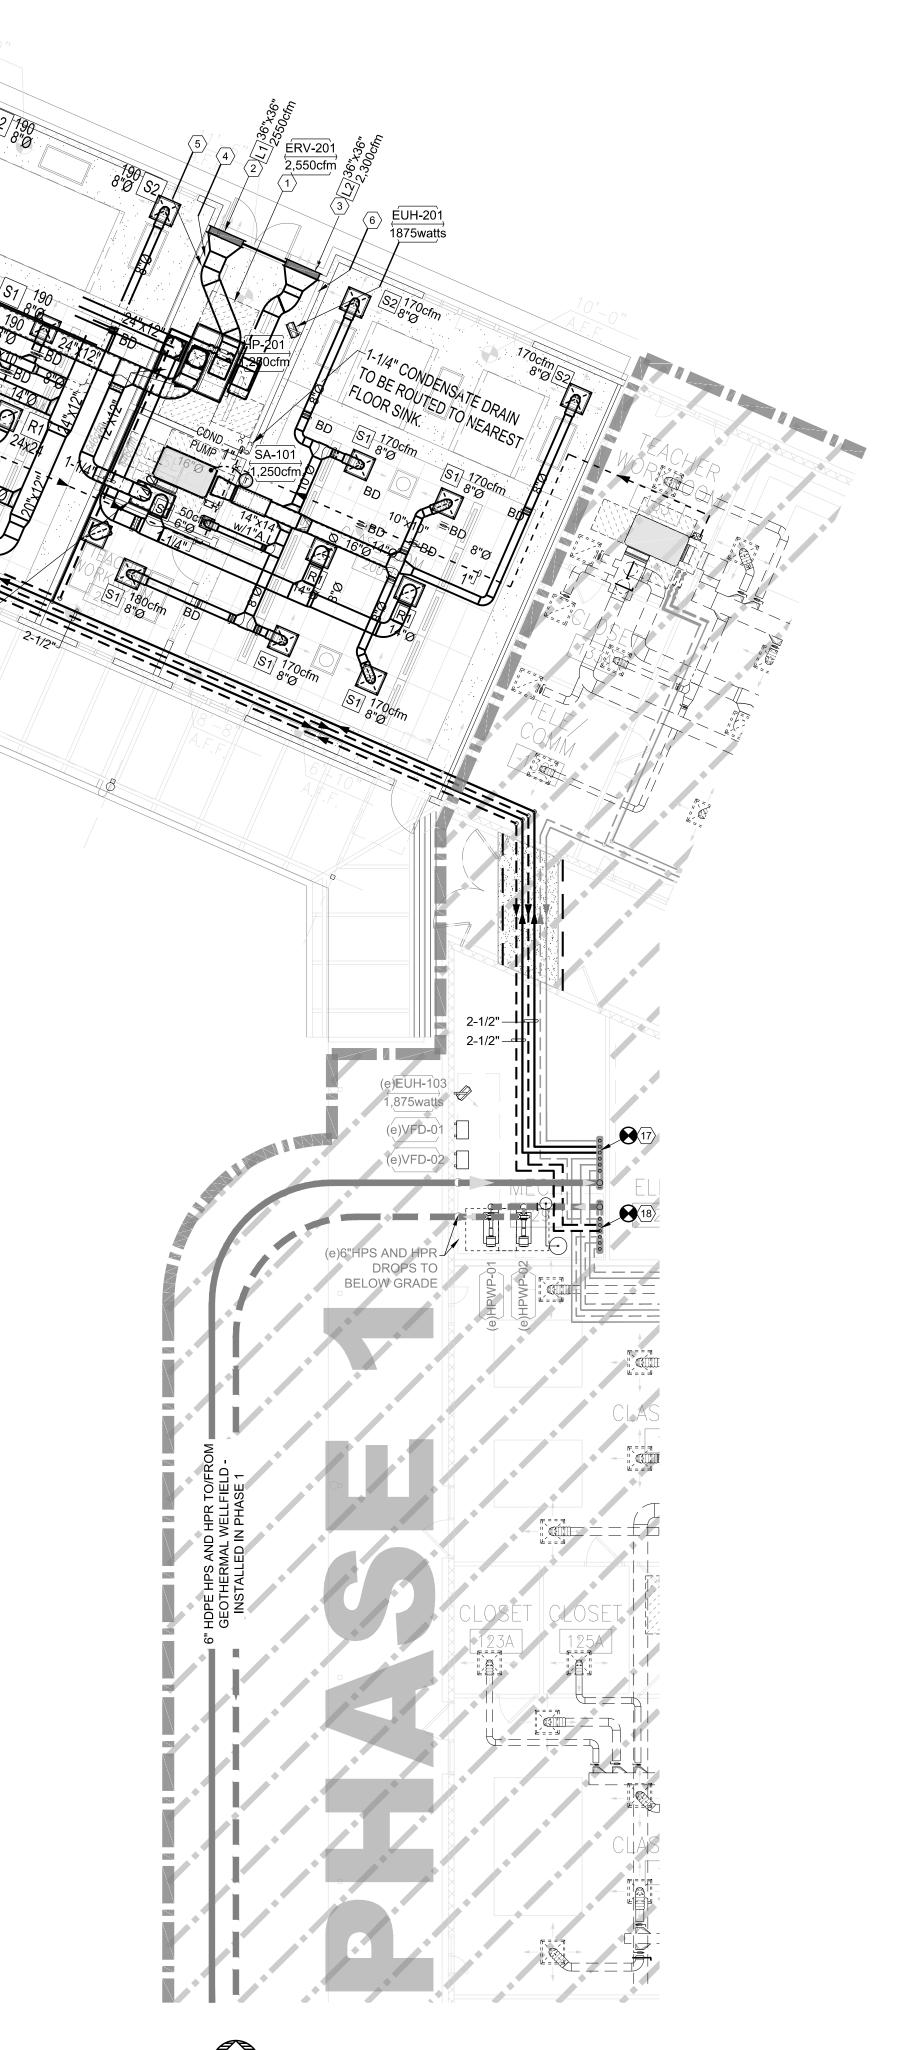




Arsed Engineering Group, LLC. 4700 Lincoln Road, NE | Suite 101 | Albuquerque, NM 87109 | 505.761.3100

STAMP




PROJECT NAME

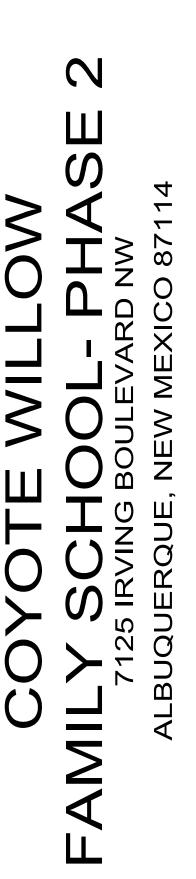

REVI	REVISIONS					
NO.	DATE	DESCRIPTION				
	09.10.19	ADDENDA #003				
COF	COPYRIGHT - DESIGN GROUP					
DES	GNER:	JS				
CHE	CKED:	ВА				
DAT	E:	08.16.2019				
SCA	LE:	1/8" = 1'-0"				
JOB	NO.:	3050				
CAD FILE:		3050-M101				
CUE						

SHEET TITLE: MECHANICAL - HVAC FLOOR PLAN



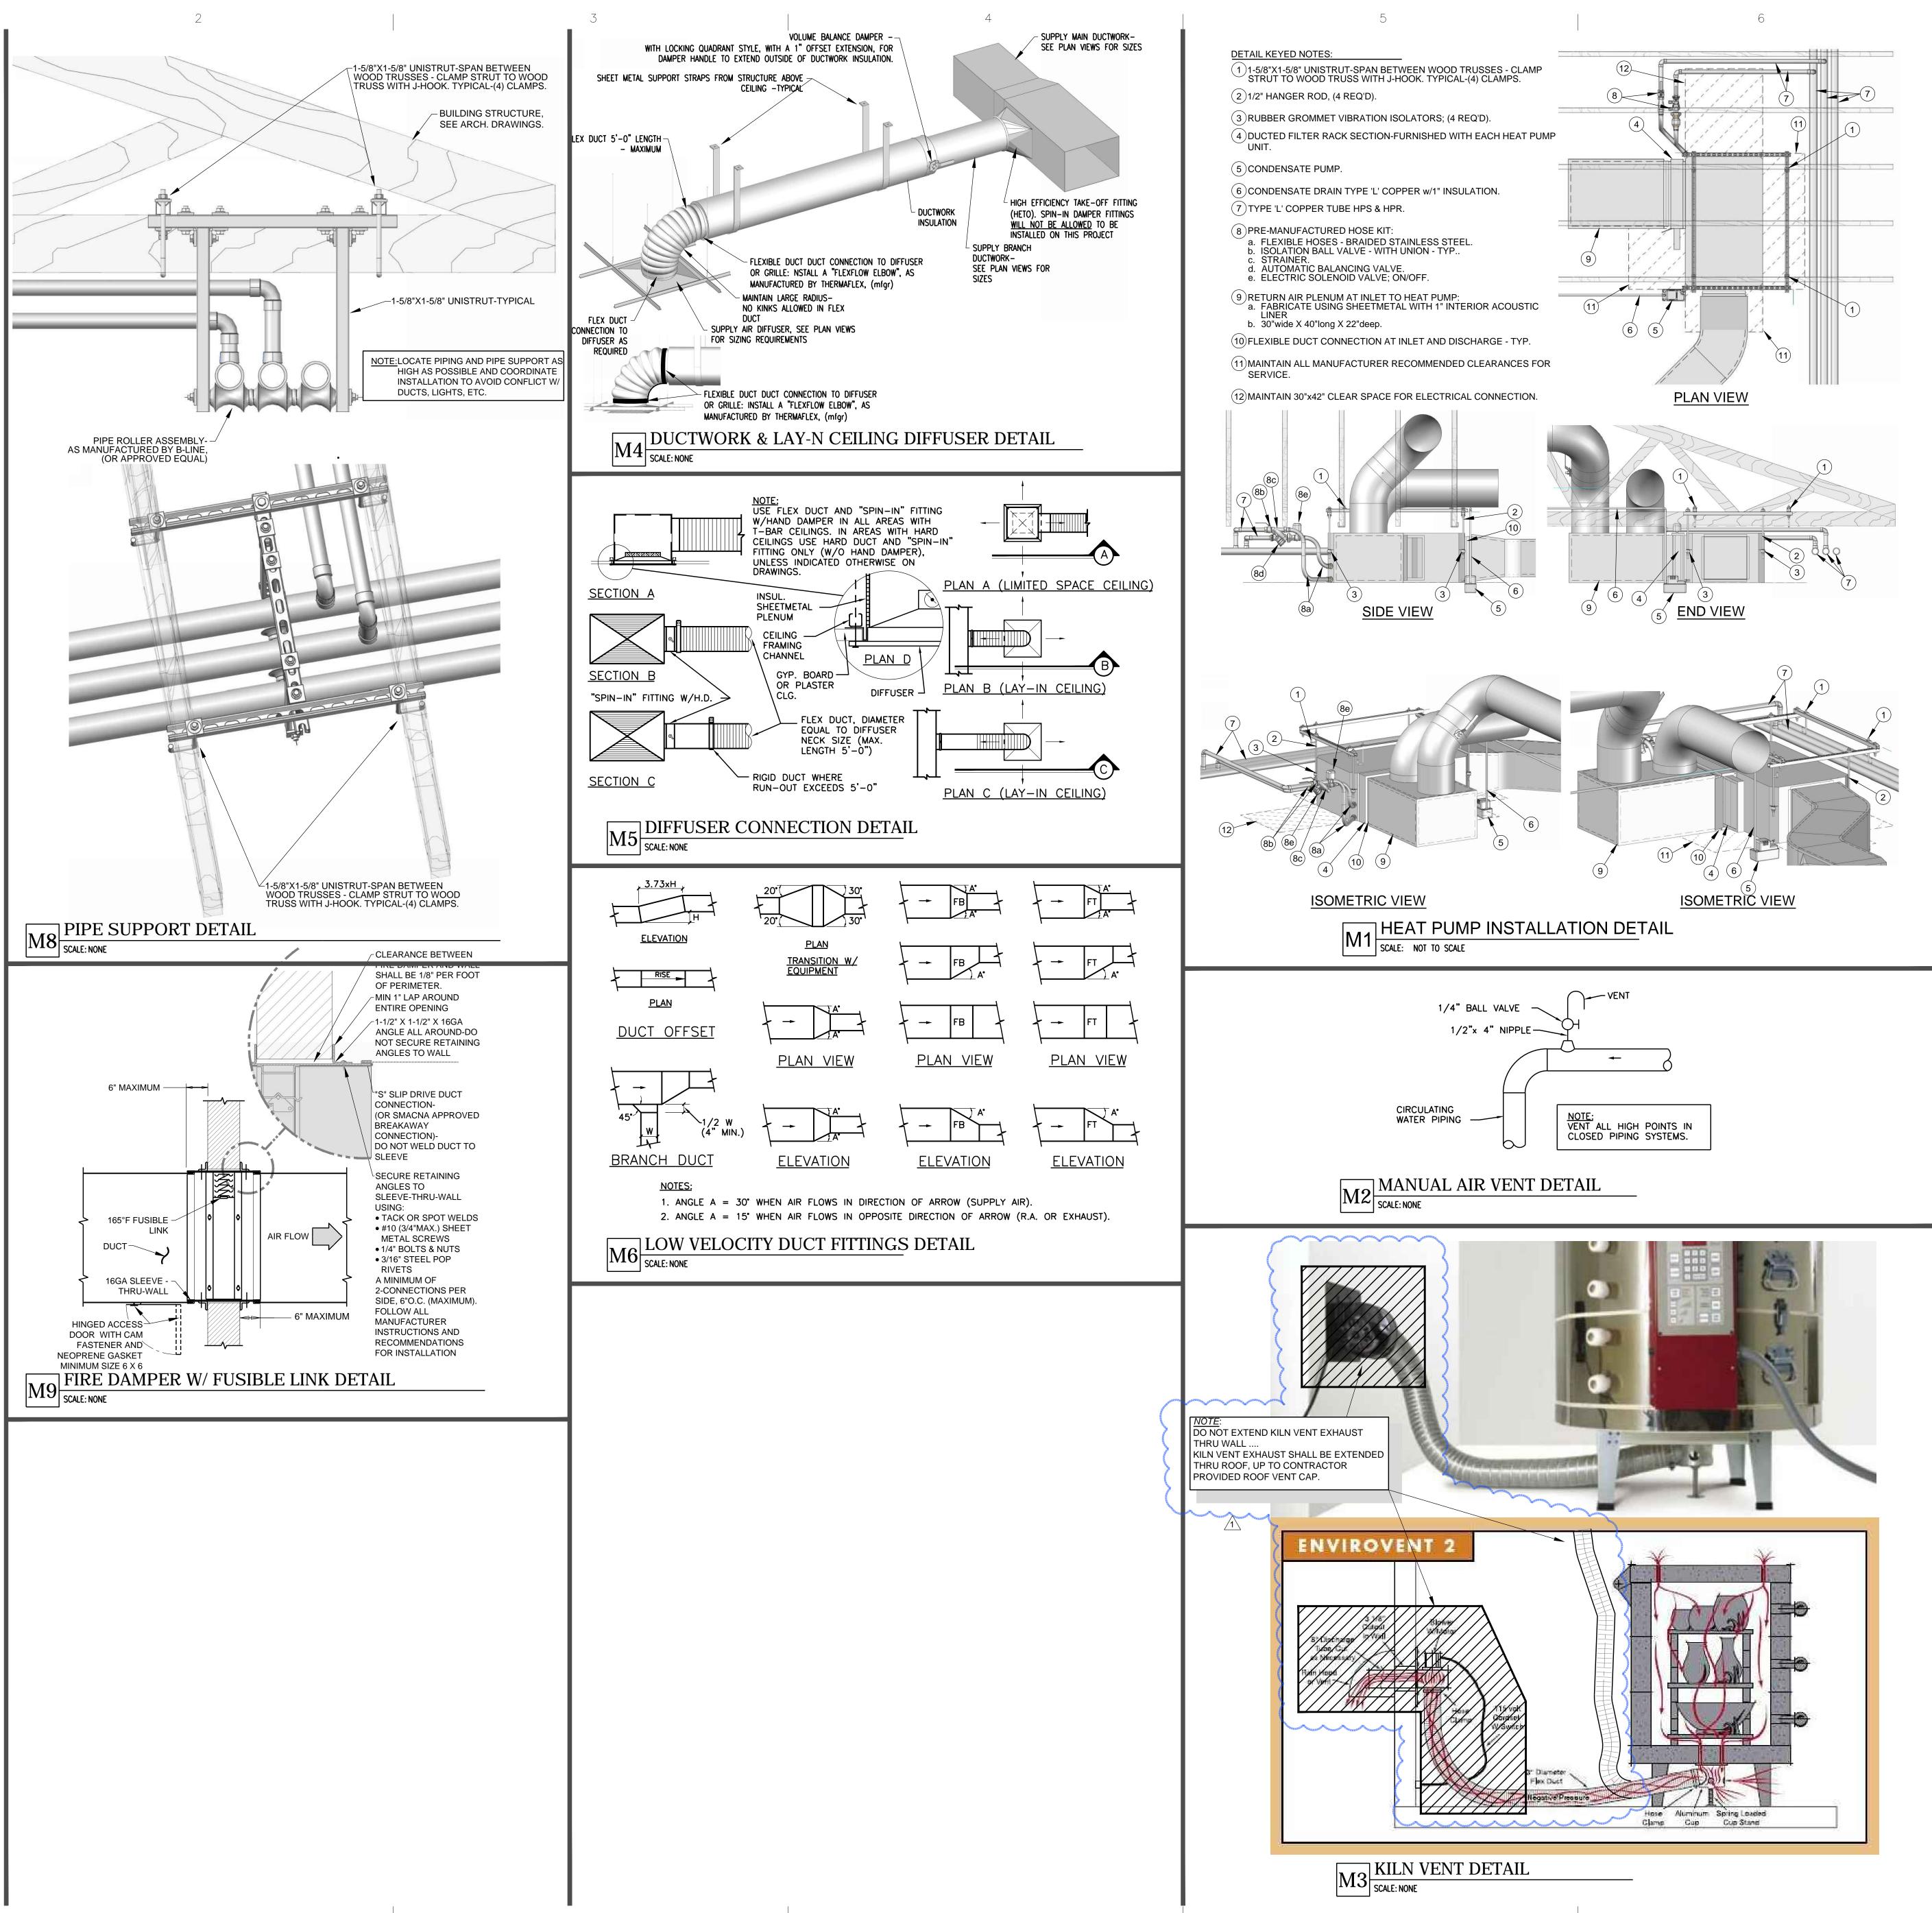

- E D

- В
- A




CONSULTANT

EC
ArSed Engineering Group, LLC.
4700 Lincoln Road, NE Suite 101 Albuquerque, NM 87109 505.761.3100

STAMP



PROJECT NAME

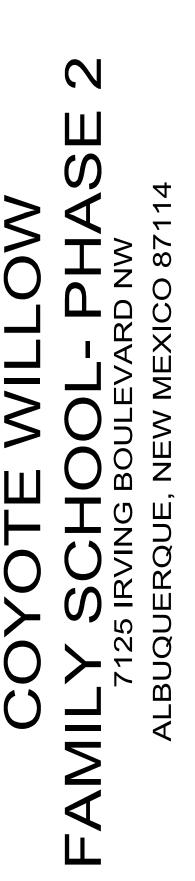


REVISIONS						
NO.	DATE	DESCRIPTION				
	09.10.19	ADDENDA #003				
COF	- PYRIGHT -	DESIGN GROUP				
DES	GNER:	DT				
CHE	CKED:	BA				
DAT	E:	08.16.2019				
SCA	LE:	none				
JOB NO.:		3050				
CAD FILE:		3050 M601				
<u></u>						

SHEET TITLE: MECHANICAL DETAILS

SHEET NUMBER:

M601

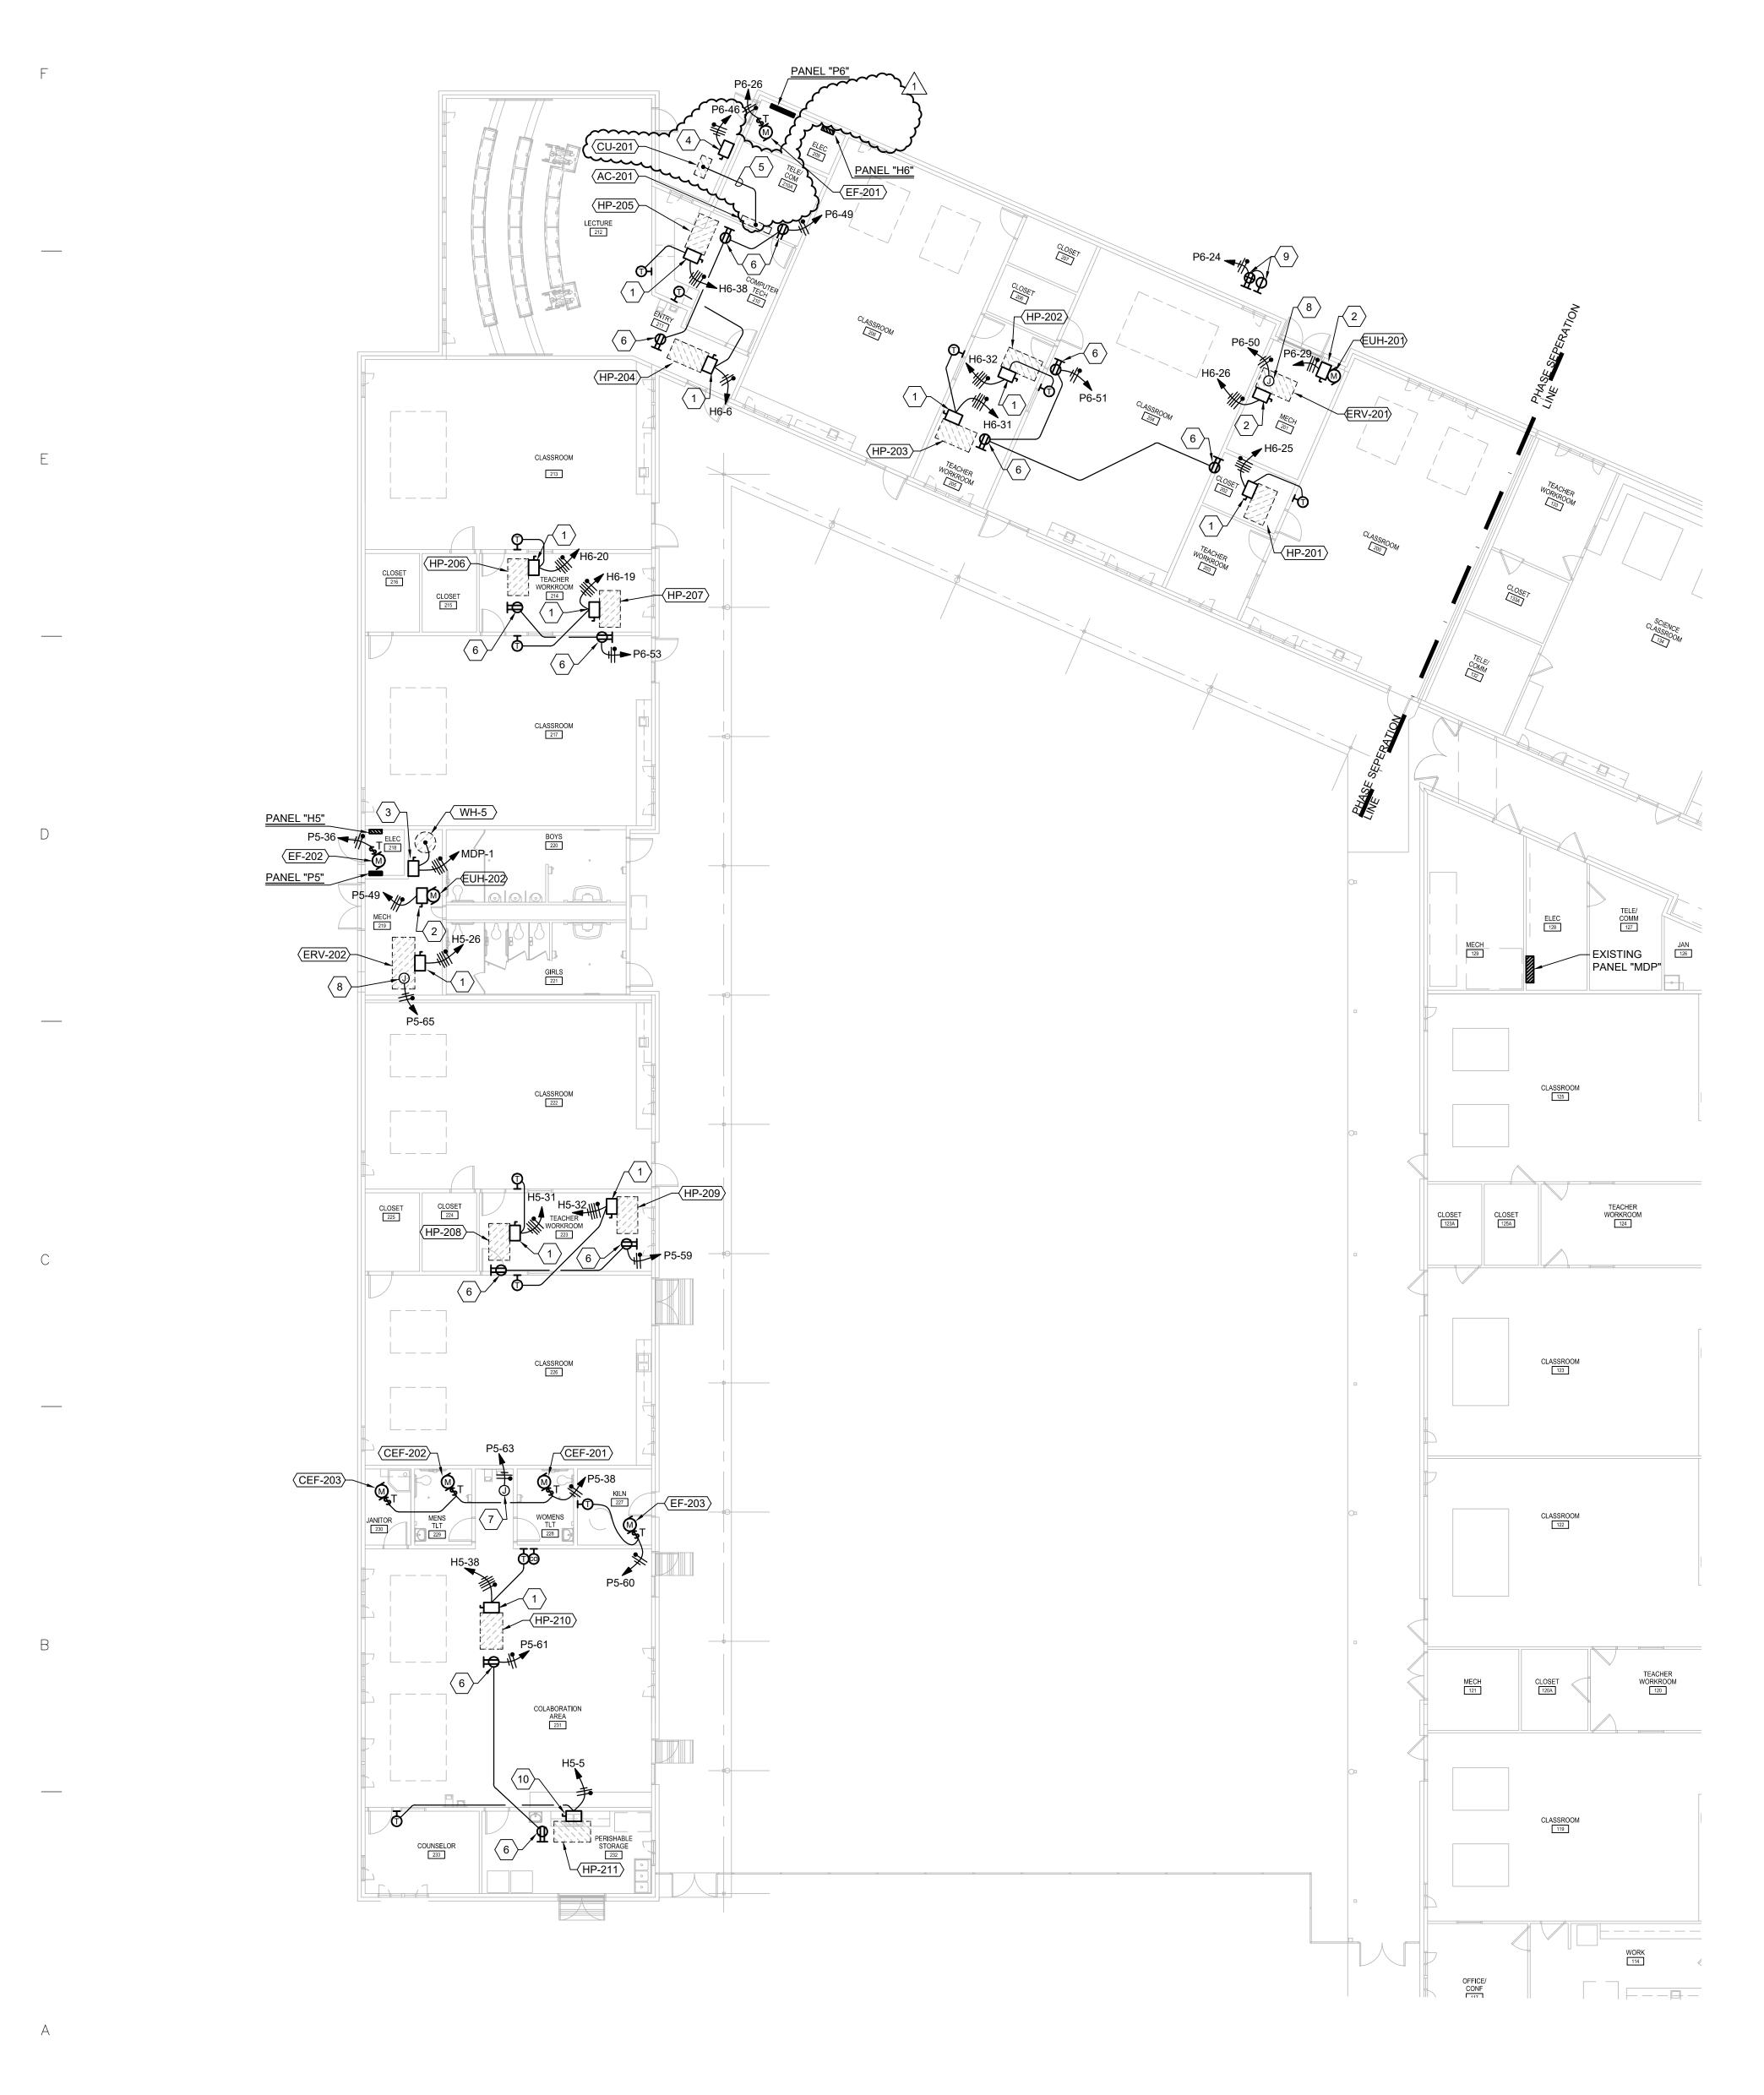

A2 **POWER PLAN** SCALE: 3/32" = 1'-0"

1 2

3 4 5

KEYED NOTES \bigcirc

 600V-30A-3P-4W PLUS SOLID NEUTRAL, FUSIBLE DISCONNECT SWITCH. FUSE AS RECOMMENDED BY UNIT MANUFACTURER. USE #10 CONDUCTORS THROUGHOUT CIRCUIT.


6

- 240V-30A-2P-4W PLUS SOLID NEUTRAL, FUSIBLE DISCONNECT SWITCH. FUSE AS RECOMMENDED BY UNIT MANUFACTURER. USE #10 CONDUCTORS THROUGHOUT CIRCUIT.
- 600V-100A-3P-4W-PLUS SOLID NEUTRAL, FUSIBLE DISCONNECT SWITCH. FUSE AS RECOMMENDED BY UNIT MANUFACTURER. USE #4 CONDUCTORS THROUGHOUT CIRCUIT.
- 4. 240V-30A-2P-3W PLUS SOLID NEUTRAL, RAIN TIGHT, FUSIBLE DISCONNECT SWITCH. FUSE AS RECOMMENDED BY UNIT MANUFACTURER.
- 5. 3#12 AND 1#12 GROUND IN 3/4" CONDUIT FOR POWER CONNECTION. EXTEND AND ADDITIONAL 1/2" CONDUIT WITH PULLWIRE FOR CONTROLS INTERCONNECTION.
- RECEPTACLE FOR CONNECTION OF CONDENSATE PUMP (M) FOR ASSOCIATED HEAT PUMP UNIT. COORDINATE LOCATION WITH MECHANICAL CONTRACTOR PRIOR TO ROUGH-IN.
- JUNCTION BOX FOR CONNECTION OF MOTORIZED DAMPER. COORDINATE LOCATION WITH MECHANICAL CONTRACTOR PRIOR TO ROUGH-IN.
 INNETION BOX FOR ROWER CONVERTION TO RULET OMOLE DETECTOR. COORDINATE
- JUNCTION BOX FOR POWER CONNECTION TO DUCT SMOKE DETECTOR. COORDINATE LOCATION WITH MECHANICAL CONTRACTOR PRIOR TO ROUGH-IN.
 PROVIDE AND INSTALL (1) GFCI DUPLEX RECEPTACLE AND (1) SIMPLEX RECEPTACLE FOR CONNECTION OF 'HOT BOX' COORDINATE LOCATION WITH LANDSCAPE
- CONTRACTOR PRIOR TO ROUGH-IN. 10. 600V-30A-3P-4W PLUS SOLID NEUTRAL, FUSIBLE DISCONNECT SWITCH. FUSE AS RECOMMENDED BY UNIT MANUFACTURER.

C THE HARTMAN + MAJEWSKI Design Group ARCHITECTS • ENGINEERS • INTERIOR DESIGN PLANNERS • URBAN DESIGNERS • LEED @ 120 VASSAR DRIVE SE SUITE 100 ALBUQUERQUE, NEW MEXICO 87106 PHONE: 505.242.6880 FAX: 505.242.6881 CONSULTANT THE RESPONSE GROUP, INC. An Electrical Engineering Corporation 11930 Menaul N.E. Suite 214 Albuquerque, New Mexico 87112 Phone:(505) 323-7629 Fax:(505) 323-7594 E-mail: theresponsegroup@trg-inc.net STAMP

19265

PROJECT NAME

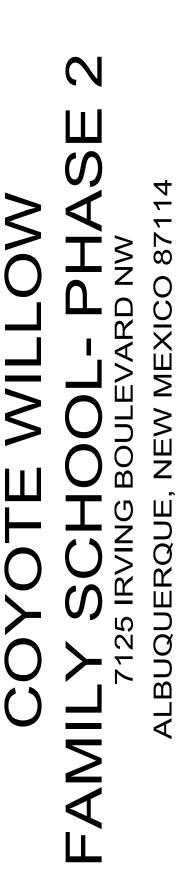

REVI	SIONS				
NO.	DATE	DESCRIPTION			
1	09/09/19	ADDENDUM #3			
COF	YRIGHT -	DESIGN GROUP			
DESIGNER:		RW			
CHECKED:		DDR			
DAT	E:	08.16.2019			
SCALE:		3/32" = 1'-0"			
JOB NO.:		3050			
CAD FILE:		·			

SHEET TITLE: POWER PLAN

SHEET NUMBER:

E103