

# STRUCTURAL NOTES

## GENERAL NOTES:

- The Governing Code for this project is the Florida Building Code, Seventh Edition (2020). This Code prescribes which Edition of each referenced standard applies to this project.
- To the best of our knowledge, the Structural drawings and specifications comply with the applicable requirements of the Governing Building Code.
- Construction is to comply with the requirements of the Governing Building Code and all other applicable Federal, State, and local Codes, Standards, Regulations and Laws.
- The Structural documents are to be used in conjunction with the Architectural documents. Use these notes in conjunction with the project specifications. If a conflict exist, notify the Architect.
- Details labeled "Typical" apply to all situations that are the same or similar to those specifically referenced, whether or not they are keyed in at each location. Questions regarding the applicability of typical details shall be resolved by the Architect.
- Openings shown on Structural drawings are only pictorial. See the Architectural and M.E.P. drawings for the size and location of openings in the structure.
- Contractors who discover discrepancies, omissions or variations in the contract documents during bidding shall immediately notify the Architect. The Architect will resolve the condition and issue a written clarification.
- The General Contractor shall coordinate all contract documents with field conditions and dimensions and project shop drawings prior to construction. Do not scale drawings; use only printed dimensions. Report any discrepancies in writing to the Architect prior to proceeding with work. Do not change size or location of Structural members without written instructions from the Structural Engineer or record.
- The contractor shall protect adjacent property, his own work and the public from harm. The contractor is solely responsible for construction means and methods, and jobsite safety including all OSHA requirements.
- The Structure is designed to be structurally sound when completed. Prior to completion, the Contractor is responsible for stability and temporary bracing, including, but not limited to, masonry walls. Wherever the Contractor is unsure of these requirements, the Contractor shall retain a Florida Licensed Engineer to design and inspect the temporary bracing and stability of the Structure.

## DESIGN SUPERIMPOSED LOADS:

| Occupancy          | LIVE LOAD                            | LIVE LOAD RED | DEAD LOAD |
|--------------------|--------------------------------------|---------------|-----------|
| Roof               | 20 PSF                               | 12 PSF        | 5 PSF     |
| Floor              | 100 PSF                              |               | 20 PSF    |
| Floor (Point Load) | 8,000 lbs. over 20"x40" CONTACT AREA |               |           |

## DESIGN WIND LOADS:

|                           |                             |
|---------------------------|-----------------------------|
| Governing Code            | ASCE 7-16                   |
| Basic Wind Speed          | Vult= 160 MPH/Vasd= 124 MPH |
| Risk Category             | II                          |
| Building Enclosure        | Partially Enclosed; Open    |
| Directionality Factor     | Kd = 0.85                   |
| Exposure                  | C                           |
| Mean Roof Height          | 34 FEET                     |
| Serviceability Wind Speed | Vasd= 124 MPH               |

## FLOOD DESIGN:

|                                    |                |
|------------------------------------|----------------|
| Flood Design Class                 | 2              |
| Elevation of Proposed Lowest Floor | 24'-6" NAVD 88 |

## RAIN DESIGN:

|                |           |
|----------------|-----------|
| Rain Load      | 0 PSF     |
| Rain Intensity | 4.5 in/hr |

## EXCAVATION, BACKFILL AND DEWATERING:

- The Contractor is solely responsible for all excavation procedures including lagging, shoring, and protection of adjacent property, structures, streets and utilities in accordance with the requirements of the local Building Department and OSHA regulations. Do not excavate within one foot of the angle of repose of any soil bearing foundation unless the foundation is properly protected against settlement.
- Do not backfill against walls until 7 days after the walls are braced by the Structure or are temporarily braced. Do not backfill cantilevered retaining walls until concrete is 14 days old. Do not backfill until after completion and inspection of any waterproofing.
- The Contractor is responsible for the disposal of all accumulated water in a manner that does not inconvenience or damage the work.

## SHALLOW FOUNDATIONS:

- Foundation design, soil preparation and compaction are based on geotechnical investigation, data and recommendations in report #21-109 by Andersen Andre Consulting Engineers, Inc., dated March 23, 2021.
- Footings sizes and reinforcing are based on an allowable soil bearing capacity of 2,500 psf. All footings shall bear on compacted fill, natural soil or rock prepared per the geotechnical report.
- Subgrade preparation shall be field controlled and tested by a licensed soils Engineer in accordance with the geotechnical report. At completion, that Engineer shall prepare and submit to the owner, Architect, contractor and Structural Engineer a signed and sealed letter indicating that the recommendations of the geotechnical report have been followed.
- Center all footings under their respective columns or walls, u.o.n.

## SLABS ON GRADE:

- Refer to geotechnical report for subgrade preparation more than 12" below bottom of slab.
- Above subgrade, use fill containing not more than 10% passing #200 sieve and maximum 1 inch diameter. Compact to 95% of maximum dry density as determined by modified proctor ASTM D-1557. Each layer of fill shall not exceed 6" loose thickness. Compact prior to placement of the next layer.
- Fill placement and compaction shall be monitored and accepted by the testing agency. Take a min. of one field density test (ASTM D-1556 or D-2922) for each 2,500 square feet of each layer. The testing agency shall randomly select test locations.
- For interior slabs place 10 mil polyethylene sheeting between soil and bottom of slab. Do not use any sheeting below exterior concrete slabs.
- In sidewalks and walkways, locate isolation joints at 20 ft. o.c. maximum score and tool between isolation joints in equal bays of 5 ft. or less.
- See the Architectural drawings for slab on grade depressions and other requirements.

## REINFORCED CONCRETE:

- Comply with ACI 301 and 318.
- Provide Structural Concrete with a minimum ultimate Compressive Design Strength of 4,000 psi in 28 days (max. w/cm=0.45).
- Use normal weight concrete for all Structural Members. u.o.n.
- Provide ASTM A-615 Grade 60 reinforcing steel. Weldable Rebar shall be ASTM-706, Grade 60 per AWS D.1. Reinforcing shall be accurately placed, rigidly supported and firmly tied in place, with appropriate bar supports and spacers. Lap bottom steel over supports and top steel at midspan (u.o.n.). Hook discontinuous ends of all top bars and all bars in walls, u.o.n. Provide cover over reinforcing as follows:

| Element                  | bottom | top    | sides  |
|--------------------------|--------|--------|--------|
| Footings                 | 3"     | 2"     | 3"     |
| Slabs on Grade           | 2"     | 1"     | 2"     |
| Slabs Above Grade        | 3/4"   | 3/4"   | 1"     |
| Slabs Exposed to Weather | 1 1/2" | 1 1/2" | 1 1/2" |
| Walls Retaining Fill     | -      | -      | 2"     |
| Walls Above Grade        | -      | -      | 1"     |

- Tension Development Length and Lap Splice Lengths shall be per schedule.
- Where specified, provide plain, cold-drawn electrically-welded wire reinforcement conforming to ASTM A-185. Supply in flat sheets only. Lap splice two cross wire spacing.
- In addition to specified reinforcing, provide 1 tons of reinforcing bars to be detailed, fabricated, delivered to site and placed as directed by the Architect/Engineer to account for unforeseeable conditions.
- Utilities shall not penetrate beams or columns but may pass through slabs and walls individually, u.o.n. For openings 24" long or less, cut reinforcing and replace along-side opening with splice bars of equivalent area with 48 bar dia. lap. Prepare and submit shop drawings for openings longer than 24". For rectangular openings 12" long or longer, add 1#5 x 6' mid depth diagonal at all 4 corners.
- Where reinforcing steel congestion permits, conduit and pipes up to 1" diameter may be embedded in concrete per ACI 318, section 6.3. Space at 3 diameters o.c. Place between outer layers of reinforcing if conduits are significantly congested, additional reinforcing perpendicular to piping may be required. Requests to embed larger pipes shall be accompanied by a detailed description and be submitted to the Architect for evaluation.
- Provide construction joints in accordance with ACI 318, section 6.4. Provide keyways and adequate dowels. Submit drawings showing location of construction joints and direction of pour for review.
- Provide 3/4" chamfer for all exposed corners.
- Provide reinforcing steel placing with a set of Structural Drawings for field reference. Inspect reinforcing steel placement from Structural Drawings.

| MIN. LAP SPLICE LENGTH SCHEDULE |          |     |     |     |     |     |     |     |     |  |
|---------------------------------|----------|-----|-----|-----|-----|-----|-----|-----|-----|--|
| BAR TYPE                        | BAR SIZE |     |     |     |     |     |     |     |     |  |
|                                 | #3       | #4  | #5  | #6  | #7  | #8  | #9  | #10 | #11 |  |
| 48 BAR DIAMETER                 | 18"      | 24" | 30" | 36" | 42" | 48" | 54" | 61" | 68" |  |
| FOOTINGS                        | 16"      | 16" | 19" | 23" | 33" | 37" | 42" | 47" | 53" |  |
| COLUMNS                         | -        | -   | 19" | 23" | 33" | 39" | 49" | 60" | 72" |  |
| WALLS                           | 16"      | 19" | 23" | 33" | 39" | 49" | 60" | -   | -   |  |
| SLABS                           | 16"      | 19" | 28" | 37" | 60" | 74" | -   | -   | -   |  |
| BEAMS (TOP)                     | -        | -   | 25" | 29" | 43" | 51" | 63" | 78" | 93" |  |
| BEAMS (MID. & BOT.)             | -        | -   | 19" | 23" | 33" | 39" | 49" | 60" | 72" |  |
| STIRRUPS                        | 16"      | 16" | 19" | 23" | -   | -   | -   | -   | -   |  |
| MASONRY FILLED CELLS (f'm=2500) | -        | -   | 24" | 44" | 60" | -   | -   | -   | -   |  |

## CONCRETE MASONRY:

- Construct masonry in accordance ACI 530/ASCE 5, "Building Code Requirements for Masonry Structures"; and ACI 530.1/ASCE 6, "Specifications for Masonry Structures".
- The structure is supported by **NON-LOAD bearing** walls, u.o.n. Erect masonry prior to casting concrete columns.  
Use 50% solid, nominal 8"x8"x16", concrete masonry units conforming to ASTM C90. block net area compressive strength shall be 3,750 psi. Lay up units in running bond. Sawcut units which are not in multiples of 8". Units shall be at least 8" long. Bond corners by lapping ends 8" in successive vertical courses. Design of walls is based on a f'm of 2,500 psi.
- Use type S mortar in accordance with ASTM C270 except use type M mortar below grade. Head and bed joints shall be 3/8" for the thickness of the face shell. Webs are to be fully mortared in all courses of piers, columns and pilasters; in the starting course; and where an adjacent cell is to be grouted. Remove mortar protrusions extending 1/2" or more into cells to be grouted.
- Use standard W1.7 horizontal ladder type joint reinforcing in every other course. Joint reinforcing and anchors in exterior walls shall conform to ASTM A153 Class B2, with a coating thickness of 1.50 oz/sf; conform to ASTM A 641 in interior walls. Overlap discontinuous ends 6". Use prefabricated corners and tees. Extend joint reinforcing a minimum of 4" into tie columns.
- Use fine grout conforming to ASTM C476, with a minimum compressive strength of 2,500 psi in 28 days. Aggregate to conform to ASTM C404 for fine grout, with slump of 8" to 10". Grout all masonry containing reinforcing. All cells of 4 hour rated walls, and where indicated on the drawings. Allow mortar to cure 24 hours prior to grouting. Provide cleanout openings at the base of cells containing reinforcing steel to clean the cell and to tie the vertical bar to the dowel. In high-lift grouting, Use 4'-0" (max.) lifts, with 1/2 hour to 1 hour between lifts. Vibrate each lift and reconsolidate the previous lift.
- Use ASTM A-615 grade 60 reinforcing steel. Reinforce walls where indicated on the drawings and at all intersections, each side of openings and at the ends of walls. Use bar spacers at 10 ft. o.c. where grout pour height exceeds 10 ft.
- At bond/tie beam corners and intersections, place 1 #5 x 5'-0" T & B corner bar, with 30" legs each way, at the exterior face.
- Beams not scheduled are min. 8" x 12" tie beams with 2 #5 bars top and bottom and #3 ties spaced at 48" o.c. typical and 4 ties at 12" o.c. at ends and intersections, u.o.n. Columns not scheduled are min. 8" x 12" tie columns with 4 #5 vertical bars and #2 ties at 12" o.c. use 30" lap splices. Hook all bars at discontinuous ends.
- Reinforced masonry wall construction shall be inspected by an Engineer or Architect in accordance with ACI 530.1/ASCE 6.
- Where anchor bolts, wedge anchors or anchors set in epoxy are set in a masonry wall, fill cells with grout for bolted course, one course above and two courses below.
- Provide lintels or headers with min. 8" bearing over all masonry openings.
- Use pressure-treated wood for wood in contact with masonry.

## STRUCTURAL STEEL:

- Fabricate and erect structural steel in conformance AISC "Specification for the design, fabrication and erection of structural steel for buildings", with commentary, and all OSHA requirements.
- Structural steel shapes shall be fabricated from the following materials:
  - Rolled W and WT shapes: ASTM A992, grade 50.
  - Rolled M, S, C and MC shapes and Angles: ASTM A36, Fy=36 ksi.
  - Plates and bars: ASTM A36, Fy=36 ksi.
  - Cold-formed hollow structural sections (HSS):
    - Round sections: ASTM A500, grade C, Fy=46 ksi.
    - Square and rectangular sections: ASTM A500, grade B, Fy=46 ksi.
  - Steel pipe: ASTM A53, type E or S, grade B, Fy=35 ksi.
- All shop and field welding shall conform to the AWS D1.1 structural welding code by the American Welding Society. Use E70 series welding electrodes, u.o.n. where necessary, remove galvanizing or primer prior to welding. Use E80 Series for Weldable Rebar.
  - Typical bolts used in structural connections for this project are 5/8" diameter and 3/4" diameter A325N.
  - Tighten bearing-type bolts (A-325N, A-325X, A-490N, and A-490X) to the snug tight condition as follows:
    - Bolts shall be placed in all holes, with washers positioned as required and nuts threaded to complete the assembly.
    - Compacting the joint to the snug-tight condition shall progress systematically from the most rigid part of the joint.
    - The snug-tightened condition is the tightness that is attained with a few impacts of an impact wrench or the full effort of an ironworker using an ordinary spud wrench.
    - More than one cycle through the bolt pattern may be required to achieve the snug-tightened joint.
  - Provide hardened washers conforming to ASTM F436 and place under the part being turned.
  - Do not reuse or retighten bolts which have been fully tightened. Use only non-galvanized nuts and bolts that are clean, rust-free, and well lubricated. Bolts and nuts shall be wax dipped by the bolt supplier or lubricated with Johnson's stick wax 140. Cleaning and lubrication of ASTM F1852 twist-off-type tension-control bolts is not permitted.
  - Where slotted holes are used to accommodate thermal movement, notify the Architect if bolt is expected to hit the end of slot, based on temperature at time of installation.
  - Store fastener components in sealed containers until ready for use. Reseal open containers to prevent contamination by moisture or other deleterious substances. Store closed containers from dirt and moisture in a protective shelter. Take from protective storage only as many fastener components as are anticipated to be installed during the work shift. Fastener components that are not incorporated into the work shall be returned to protective storage at the end of the work shift. Fasteners from open containers and fasteners that accumulate rust or dirt shall not be used and shall be immediately and permanently removed from the project site.
- Use A-307 bolts for all erection bolts and bolts less than 3/4" diameter, u.o.n. Anchor rods shall be ASTM F1554 grade 55 with supplementary requirement S1, threaded with nuts and washers each end.
- Cut, drill, or punch holes perpendicular to metal surfaces. Ream holes that must be enlarged to admit bolts as permitted by architect. Do not enlarge unfair holes by burning or using drift pins.
- See Architectural and Mechanical drawings for miscellaneous steel not shown on the Structural drawings.
- Refer to the Architectural drawings for painting and fireproofing of structural steel. Provide a minimum of one shop coat of paint for exposed structural steel U.N.O. Steel exposed to the atmosphere or elements shall receive a second shop coat of paint or be field painted in addition to the initial shop coat with lead, graphite or asphalt paint or other approved coating compatible with the shop coat. Do not paint steel surfaces in contact with fireproofing or embedded in concrete. Steel elements that are hot-dipped galvanized do not require shop and field painting.

## COLD FORM STEEL FRAMING:

- All field cutting of studs must be done by sawing or shearing. Torch cutting of cold-formed members is unacceptable.
- No notching or coping of studs is allowed, unless stated within this drawing package.
- Ends of studs must seat firmly in runner track, which have full bearing on structure.
- Framing fabricator is to ensure punch out alignment when assembling lateral bracing and field cutting studs to length. Lateral bracing must be installed at the time the wall is erected. Failure to install bracing at this time may compromise the structural integrity of the building.
- Temporary bracing shall be provided and remain in place until work is completely stabilized.
- Framing shall be galvanized G60 and conform to ASTM A653 with a minimum yield of 33 ksi for studs 20-18 gage; 50 ksi for 16-12 gage.

## CHEMICAL ADHESIVE FOR ANCHORING REINFORCING BARS, THREADED BARS AND ANCHOR BOLTS:

- Use an epoxy, acrylic or polyester resin adhesive system such as the HiHi Hi HY200, ITW Rammed/Red Head Epcon A7 or C6 injection system, Powers Rawl Power-Fast System, Simpson Strong-Tie AT or ET, Allied Fastener Allied Gold A-1000, or accepted equivalent. Follow manufacturer's specifications for use and installation.
- Confirm the absence of reinforcing steel by drilling a 1/4" diameter pilot hole for each anchor. Do not cut reinforcing steel without approval of the Structural Engineer.
- Refer to manufacturer's installation instructions for appropriate drill size. Thoroughly clean hole including removal of dust prior to filling with epoxy.
- Provide anchor embedment, spacing and edge distance as shown on the drawings.
- Threaded rods are A-36 galvanized steel, u.o.n.

## SHOP DRAWINGS AND OTHER SUBMITTALS:



- Submit specific components, such as columns, footings, etc., in a single package. Submit similar floors together.
- On first submittal, clearly flag and cloud all differences from the contract documents. On resubmittals, flag and cloud all changes and additions to previous submittal; only clouded items will be reviewed.
- Submittals for special structural, load-carrying items that are required by codes or standards to resist forces must be prepared by, or under the direct supervision of, a delegated engineer as follows:

| SHOP DRAWING SUBMITTAL REQUIREMENTS   |                              |                      |                                |                                    |
|---------------------------------------|------------------------------|----------------------|--------------------------------|------------------------------------|
| COMPONENT                             | DRAWINGS/<br>MATERIAL SHEETS | PRODUCT<br>APPROVALS | SIGNED &<br>SEALED<br>DRAWINGS | SIGNED &<br>SEALED<br>CALCULATIONS |
| REINFORCEMENT                         | X                            |                      |                                |                                    |
| MASONRY                               | X                            |                      |                                |                                    |
| PRECAST LINTELS                       | X                            | X                    |                                |                                    |
| CONCRETE MIXES                        | X                            |                      |                                |                                    |
| CONCRETE ACCESSORIES                  | X                            |                      |                                |                                    |
| EPOXY, EXPANSION, OR<br>SCREW ANCHORS | X                            |                      |                                |                                    |
| RAILINGS                              |                              |                      | X                              | X                                  |
| DOORS/WINDOWS/LOUVERS                 |                              | X                    | X                              | X                                  |
| PREFABRICATED BUILDING                |                              |                      | X                              | X                                  |

- A delegated Engineer is defined as a Florida licensed Engineer who specializes in and undertakes the design of structural components or structural systems included in a specific submittal prepared for this project and is an employee or officer of, or consultant to, the contractor or fabricator responsible for the submittal. The delegated Engineer shall sign, seal and date the submittal, including calculations and drawings.
- The trade contractor is responsible for confirming and correlating dimensions at the job sites, for tolerances, clearances, quantities, fabrication processes and techniques of construction, coordination of the work with other trades and full compliance with the contract documents.
- The general contractor/construction manager shall review and approve submittals and shall sign and date each drawing prior to submitting to the Architect. This approval is to confirm that the submittal is complete, complies with the submittal requirements and is coordinated with field dimensions, other trades, erection sequencing and constructibility.
- The structural Engineer reviews submittals to confirm that the submittal is in general conformance with the design concept presented in the contract documents. Quantities and dimensions are not checked. Notations on submittals do not authorize changes to the contract sum. Checking of the submittal by the Structural Engineer shall not relieve the contractor of responsibility for deviations from the contract documents and from errors or omissions in the submittal.
- In addition to the above, the structural Engineer's review of delegated Engineer submittals is limited to verifying that the specified structural submittal has been furnished, signed and sealed by the delegated Engineer and that the delegated Engineer has understood the design intent and used the specified structural criteria. No detailed check of calculations will be made. The delegated Engineer is solely responsible for their design, including but not limited to the accuracy of their calculations and compliance with the applicable codes and standards.
- CAD files of Structural Drawings may be used as an aid in preparing shop drawings only upon the contractor signing an agreement.

| FOOTING SCHEDULE |                   |             |           |      |           |                    |
|------------------|-------------------|-------------|-----------|------|-----------|--------------------|
| MARK             | SIZE<br>WxLxD     | REINFORCING |           |      |           | REMARKS            |
|                  |                   | BOTTOM      |           | TOP  |           |                    |
|                  |                   | L.W.        | S.W.      | L.W. | S.W.      |                    |
| TE-16            | 16"xCONT.x16"     | 2#5         |           | #5   | #4 AT 12" | THICKENED EDGE     |
| MF-18            | 18"xCONT.x24"     | 2#5         |           |      |           | MONOLITHIC FOOTING |
| MF-24            | 24"xCONT.x24"     | 3#5         | #5 AT 6"  | 3#5  | #4 AT 12" | MONOLITHIC FOOTING |
| WF-36            | 36"xCONT.x12"     | 4#5         | #5 AT 12" |      |           |                    |
| WF-60            | *                 | *           | *         | *    | *         | *REFER TO 2/S-302  |
| F6.0             | 6'-0"x6'-0"x12"   | 6#5         | 6#5       | 6#5  | 6#5       |                    |
| MF5.0            | 5'-0"x5'-0"x24"   | 5#5         | 5#5       | 5#5  | 5#5       | MONOLITHIC FOOTING |
| MF6.0            | 6'-0"x6'-0"x24"   | 6#5         | 6#5       | 6#5  | 6#5       | MONOLITHIC FOOTING |
| MF7.0            | 7'-0"x7'-0"x24"   | 7#5         | 7#5       | 7#5  | 7#5       | MONOLITHIC FOOTING |
| MF11.0           | 11'-0"x11'-0"x24" | 11#5        | 11#5      | 11#5 | 11#5      | MONOLITHIC FOOTING |
| MF14.5           | 14'-6"x14'-6"x24" | 15#5        | 15#5      | 15#5 | 15#5      | MONOLITHIC FOOTING |
| MF18.0           | 18'-0"x18'-0"x24" | 18#5        | 18#5      | 18#5 | 18#5      | MONOLITHIC FOOTING |
| MF24.5           | 24'-6"x24'-6"x24" | 25#5        | 25#5      | 25#5 | 25#5      | MONOLITHIC FOOTING |
| MF17x24.5        | 17'-0"x24'-6"x24" | 17#5        | 25#5      | 17#5 | 25#5      | MONOLITHIC FOOTING |


| TIE COLUMN SCHEDULE |                 |             |          |            |                 |
|---------------------|-----------------|-------------|----------|------------|-----------------|
| MARK                | SIZE<br>"B X D" | REINFORCING |          |            | REMARKS         |
|                     |                 | DOWELS      | VERTICAL | TIES       |                 |
| C-1                 | 8"x16"          | 3#6         | 6#6      | #3 AT 8" * | * + (1) HAIRPIN |
| C-2                 | 8"x32"          | 5#6         | 10#6     | #3 AT 8" * | * + (3) HAIRPIN |

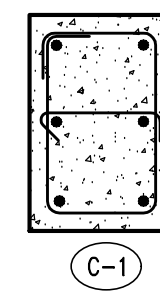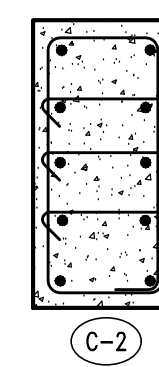


|   |            |   |            |   |          |
|---|------------|---|------------|---|----------|
| KIMLEY-HORN & ASSOCIATES, INC.                                    |            | KIMLEY-HORN & ASSOCIATES, INC.                          |            | KIMLEY-HORN & ASSOCIATES, INC.                          |          |
| 355 ALHAMBRA CIRCLE, SUITE 1400, CORAL GABLES, FL 33134           |            | 355 ALHAMBRA CIRCLE, SUITE 1400, CORAL GABLES, FL 33134 |            | 355 ALHAMBRA CIRCLE, SUITE 1400, CORAL GABLES, FL 33134 |          |
| PHONE: 305-673-2025   |            | PHONE: 305-673-2025                                     |            | PHONE: 305-673-2025                                     |          |
| WWW.KIMLEY-HORN.COM   |            | WWW.KIMLEY-HORN.COM                                     |            | WWW.KIMLEY-HORN.COM                                     |          |
| REGISTRY #68  |            | REGISTRY #68  |            | REGISTRY #68  |          |
| LICENSED PROFESSIONAL   |            | LICENSED PROFESSIONAL                                   |            | LICENSED PROFESSIONAL                                   |          |
| KHA PROJECT   | 14-3228000 | DATE  | APRIL 2021 | SCALE   | AS SHOWN |
| DESIGNED BY   | JF         | DRAWN BY  | WR         | CHECKED BY  | JF       |
| GENERAL NOTES   |            |   |            |   |          |
| IRC LANDFILL PREPARED FOR INDIAN RIVER COUNTY INDIAN RIVER COUNTY |            |   |            |   |          |
| SHEET NUMBER 5-000  |            |   |            |   |          |

This document, together with the concepts and design presented herein, is intended only for the specific purpose and client for which it was prepared. Reuse of and improper reliance on this document without written authorization and adaptation by Kimley-Horn and Associates, Inc. shall be without liability to Kimley-Horn and Associates, Inc.


This document, together with the concepts and designs presented herein, as an instrument of service, is intended only for the specific purpose and client for which it was prepared. Reuse of and improper reliance on this document without written authorization and adaptation by Kimley-Horn and Associates, Inc. shall be without liability to Kimley-Horn and Associates, Inc.

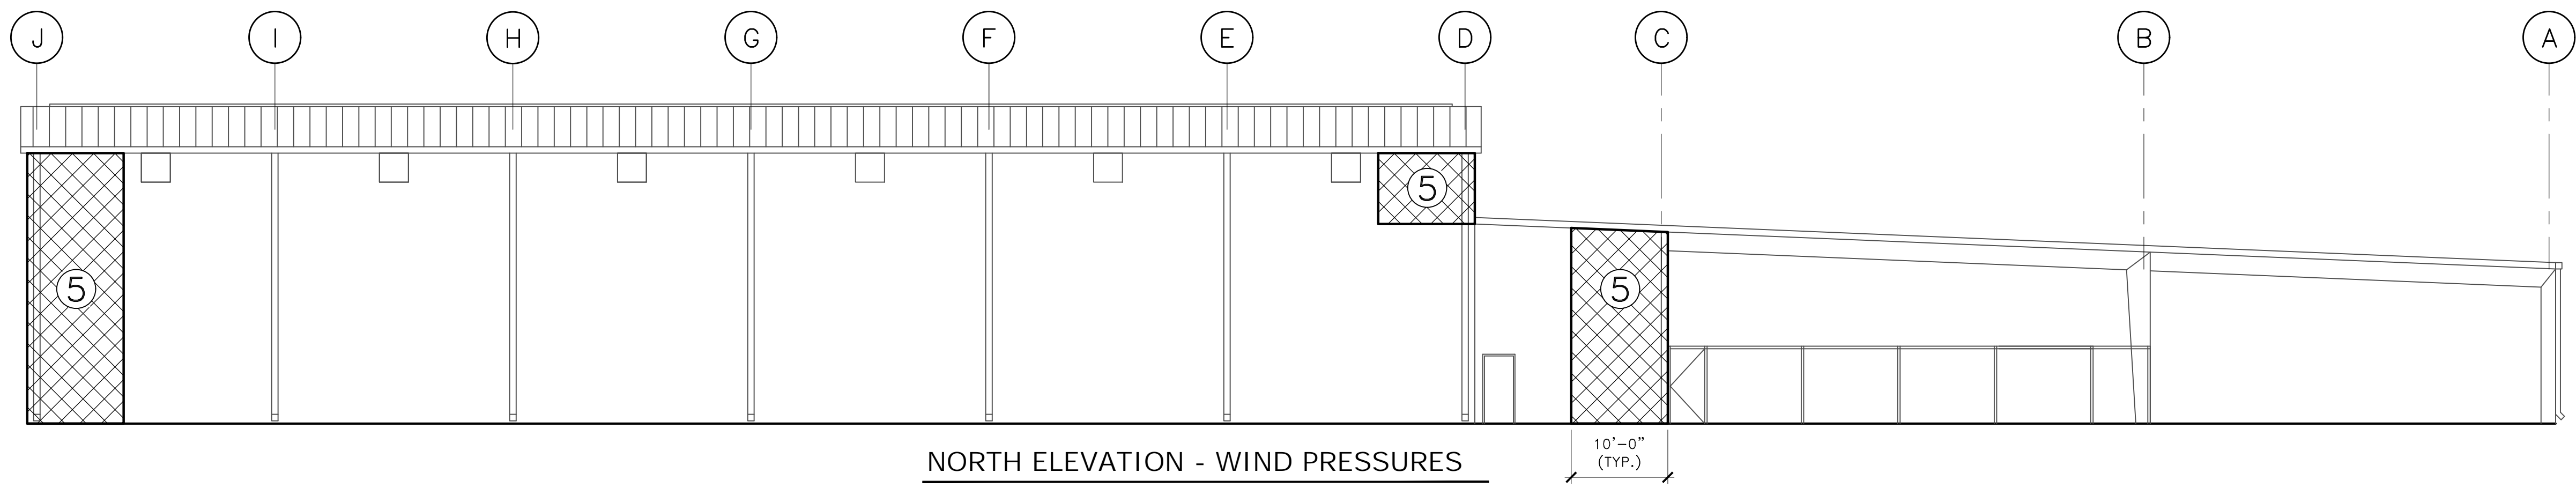


NORTH ELEVATION - WIND PRESSURES

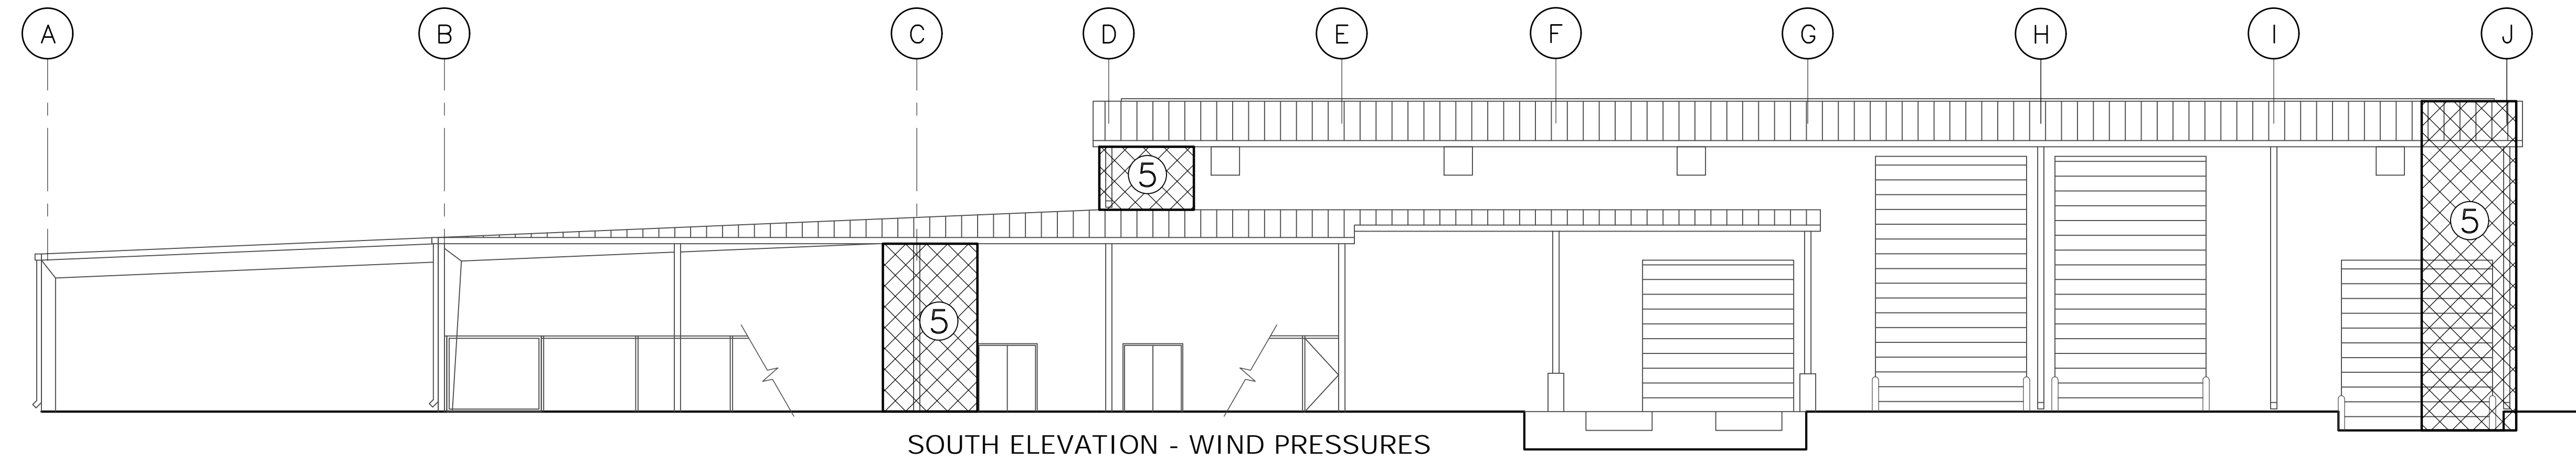

SOUTH ELEVATION - WIND PRESSURES

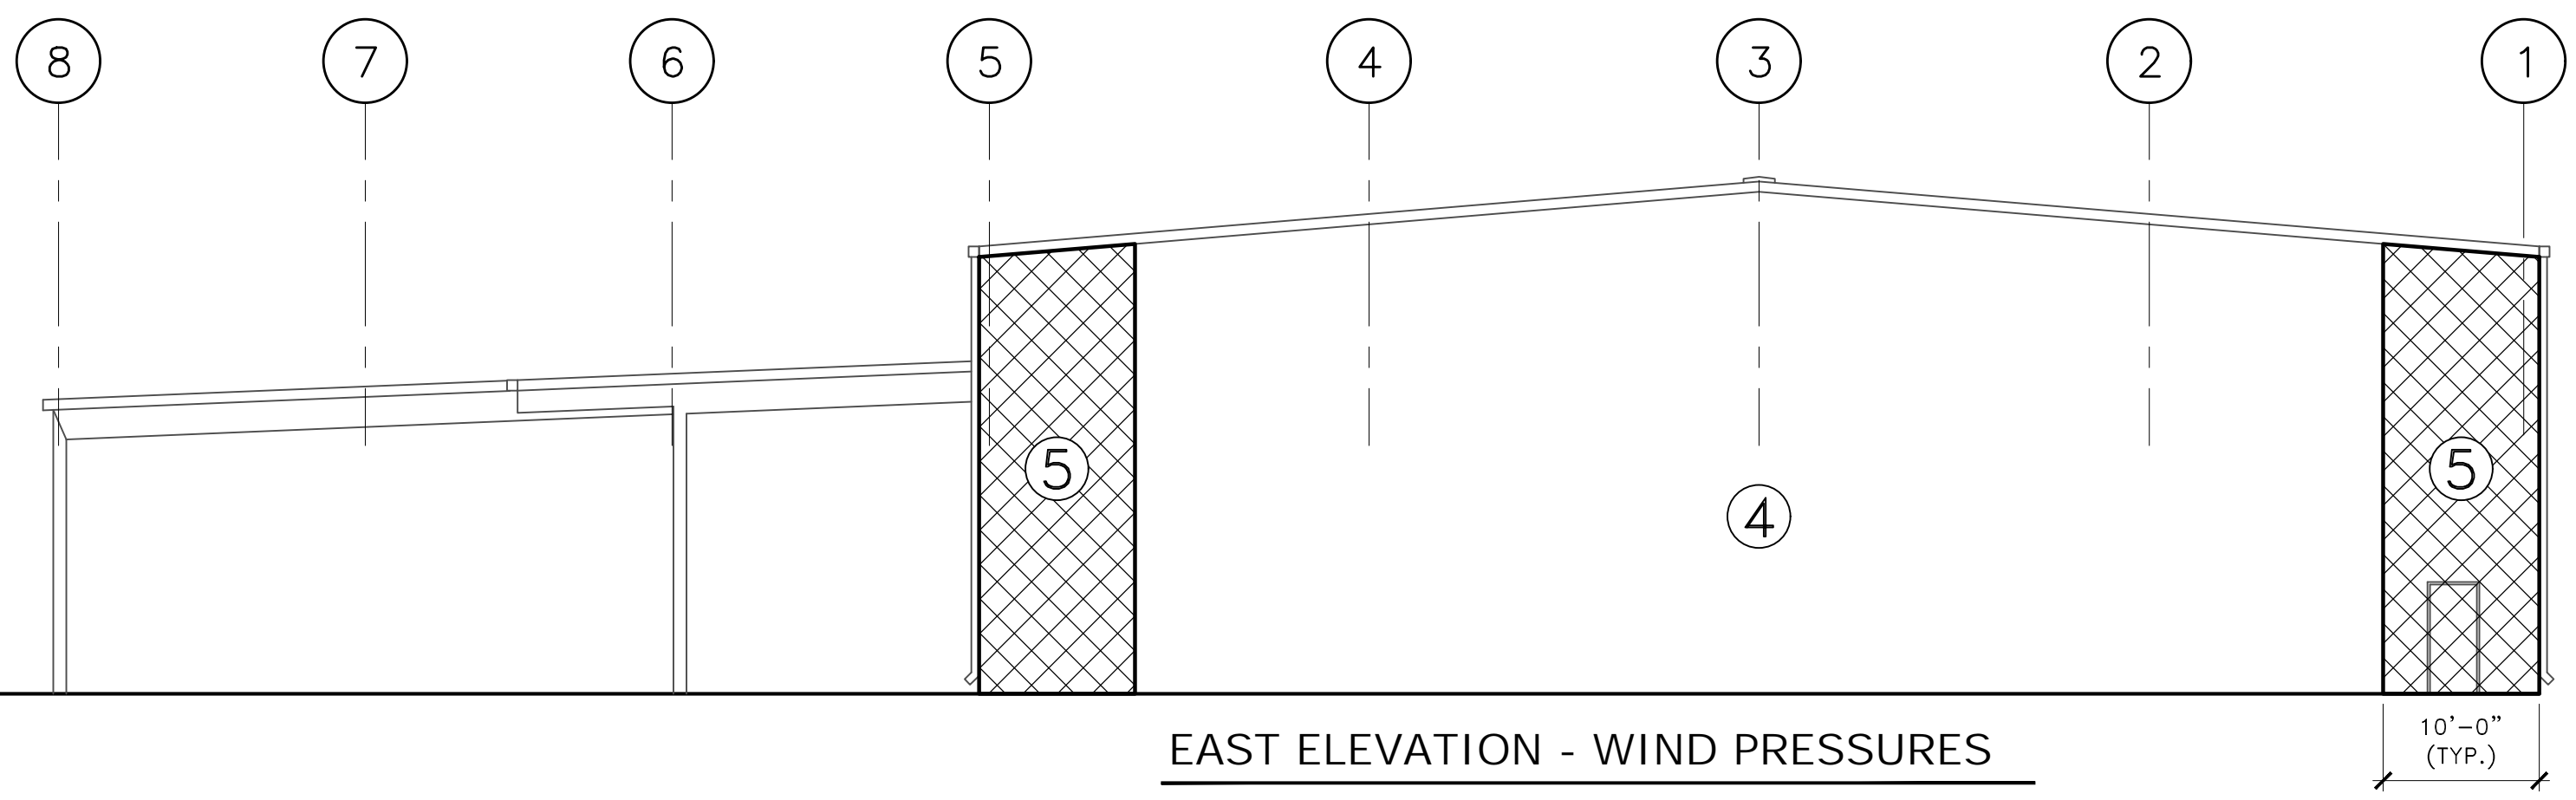

EAST ELEVATION - WIND PRESSURES

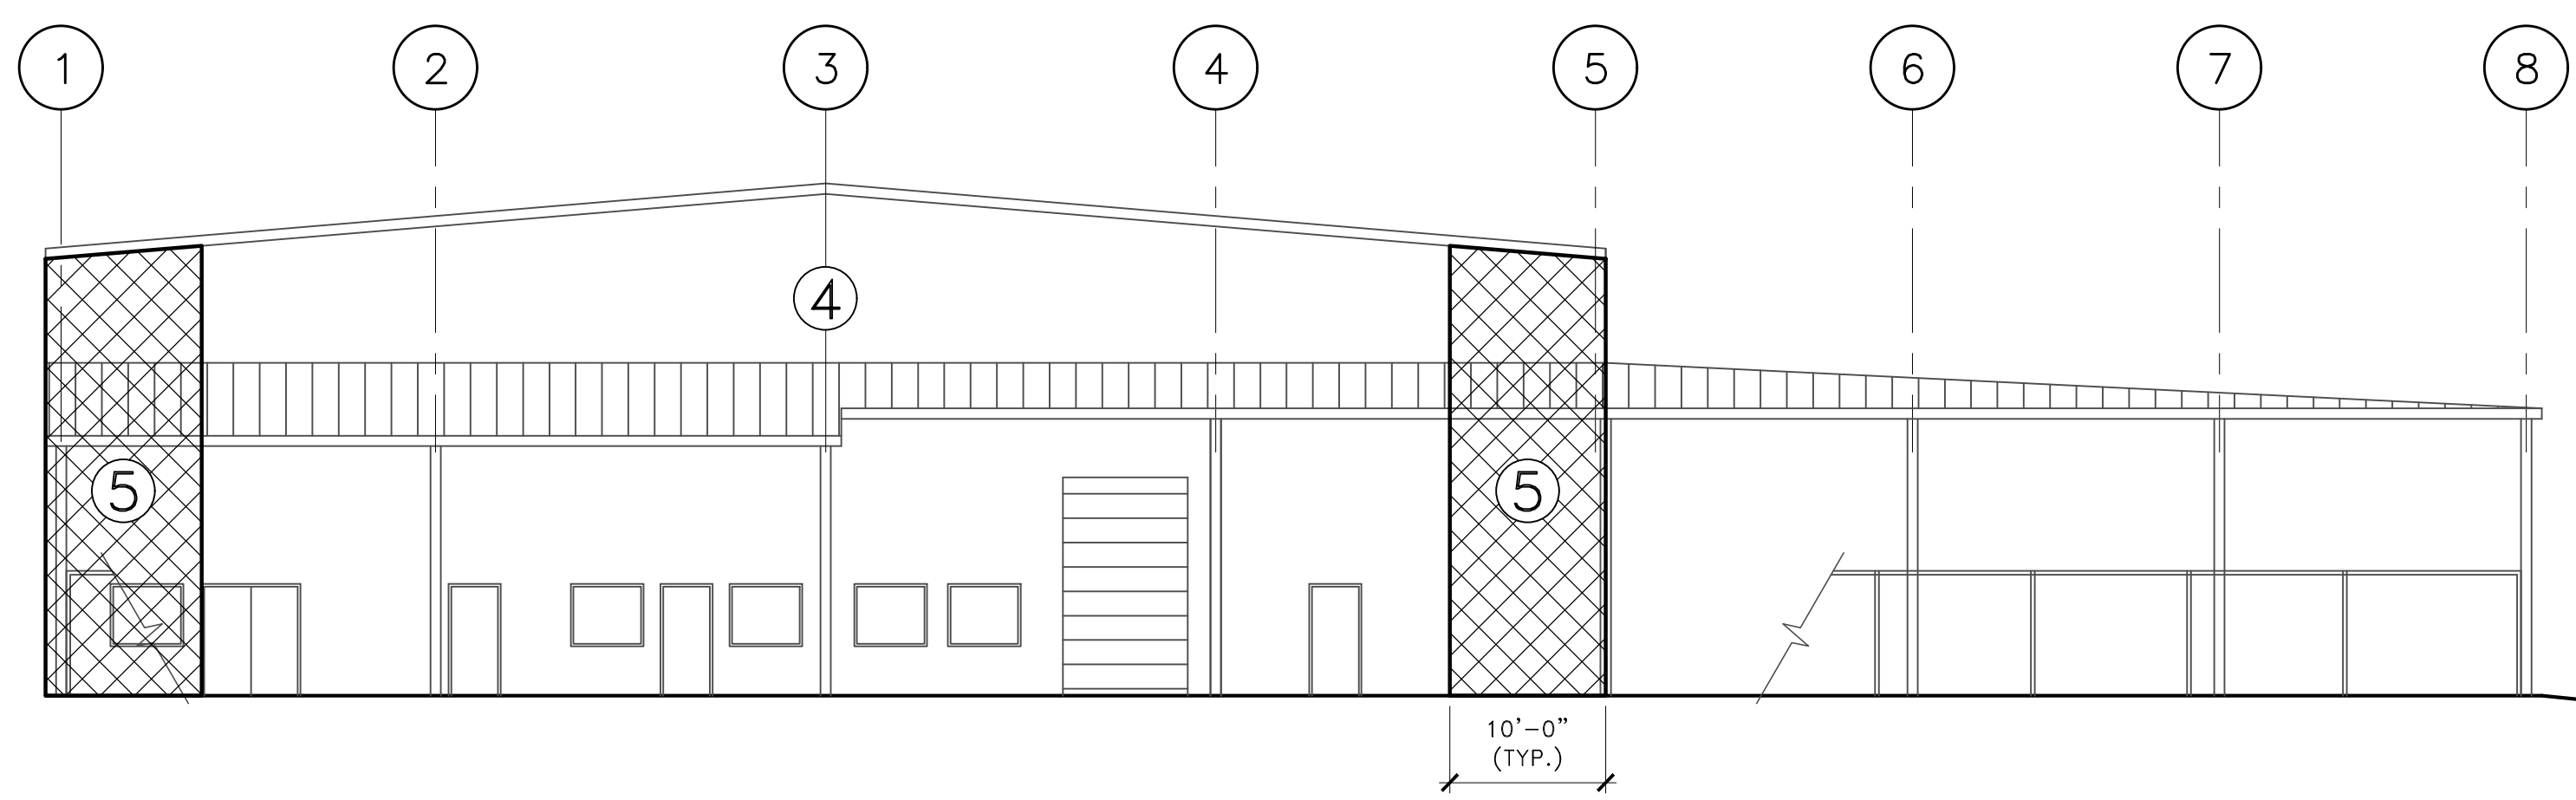

WEST ELEVATION - WIND PRESSURES

| ASD WIND LOAD WALL PRESSURES Kd=0.85 |              |       |              |       |
|--------------------------------------|--------------|-------|--------------|-------|
| TRIBUTARY AREA                       | ZONE 4 (PSF) |       | ZONE 5 (PSF) |       |
|                                      | (+)          | (-)   | (+)          | (-)   |
| WINDOW                               | +46.9        | -49.9 | +46.9        | -58.6 |
| DOOR                                 | +45.4        | -48.3 | +45.4        | -55.5 |
| 0 sf to 19 sf                        | +46.9        | -49.9 | +46.9        | -58.6 |
| 20 sf to 29 sf                       | +45.4        | -48.3 | +45.4        | -55.5 |
| 30 sf to 49 sf                       | +44.5        | -47.4 | +44.5        | -53.7 |
| 50 sf to 99 sf                       | +43.3        | -46.3 | +43.3        | -51.4 |
| 100 sf to 199 sf                     | +41.8        | -44.7 | +41.8        | -48.3 |

- NOTES:
1. REFER TO DIAGRAM FOR LOCATION OF ZONE ④ AND ⑤.
  2. VALUES INDICATED CAN BE INTERPOLATED.
  3. FOR Kd = 1.0, MULTIPLY VALUES BY 1.18.
  4. FOR ULTIMATE VALUES, MULTIPLY VALUES IN TABLE BY 1.67.

| NO. | REVISIONS | DATE | BY |
|-----|-----------|------|----|
|     |           |      |    |
|     |           |      |    |


**Kimley-Horn**  
 © 2021 KIMLEY-HORN AND ASSOCIATES, INC.  
 355 ALHAMBRA CIRCLE, SUITE 1400, CORAL GABLES, FL 33134  
 PHONE: 305-673-2025  
 WWW.KIMLEY-HORN.COM REGISTRY 696

LICENSED PROFESSIONAL  
 KHA PROJECT 143228000  
 DATE APRIL 2021  
 SCALE AS SHOWN  
 DESIGNED BY JF  
 DRAWN BY WR  
 CHECKED BY JF  
 DATE:


**ELEVATIONS WIND PRESSURE DIAGRAMS**

IRC LANDFILL  
 PREPARED FOR  
 INDIAN RIVER COUNTY  
 INDIAN RIVER COUNTY

This document, together with the concepts and designs presented herein, as an instrument of service, is intended only for the specific purpose and client for which it was prepared. Reuse of and improper reliance on this document without written authorization and adaptation by Kimley-Horn and Associates, Inc. shall be without liability to Kimley-Horn and Associates, Inc.

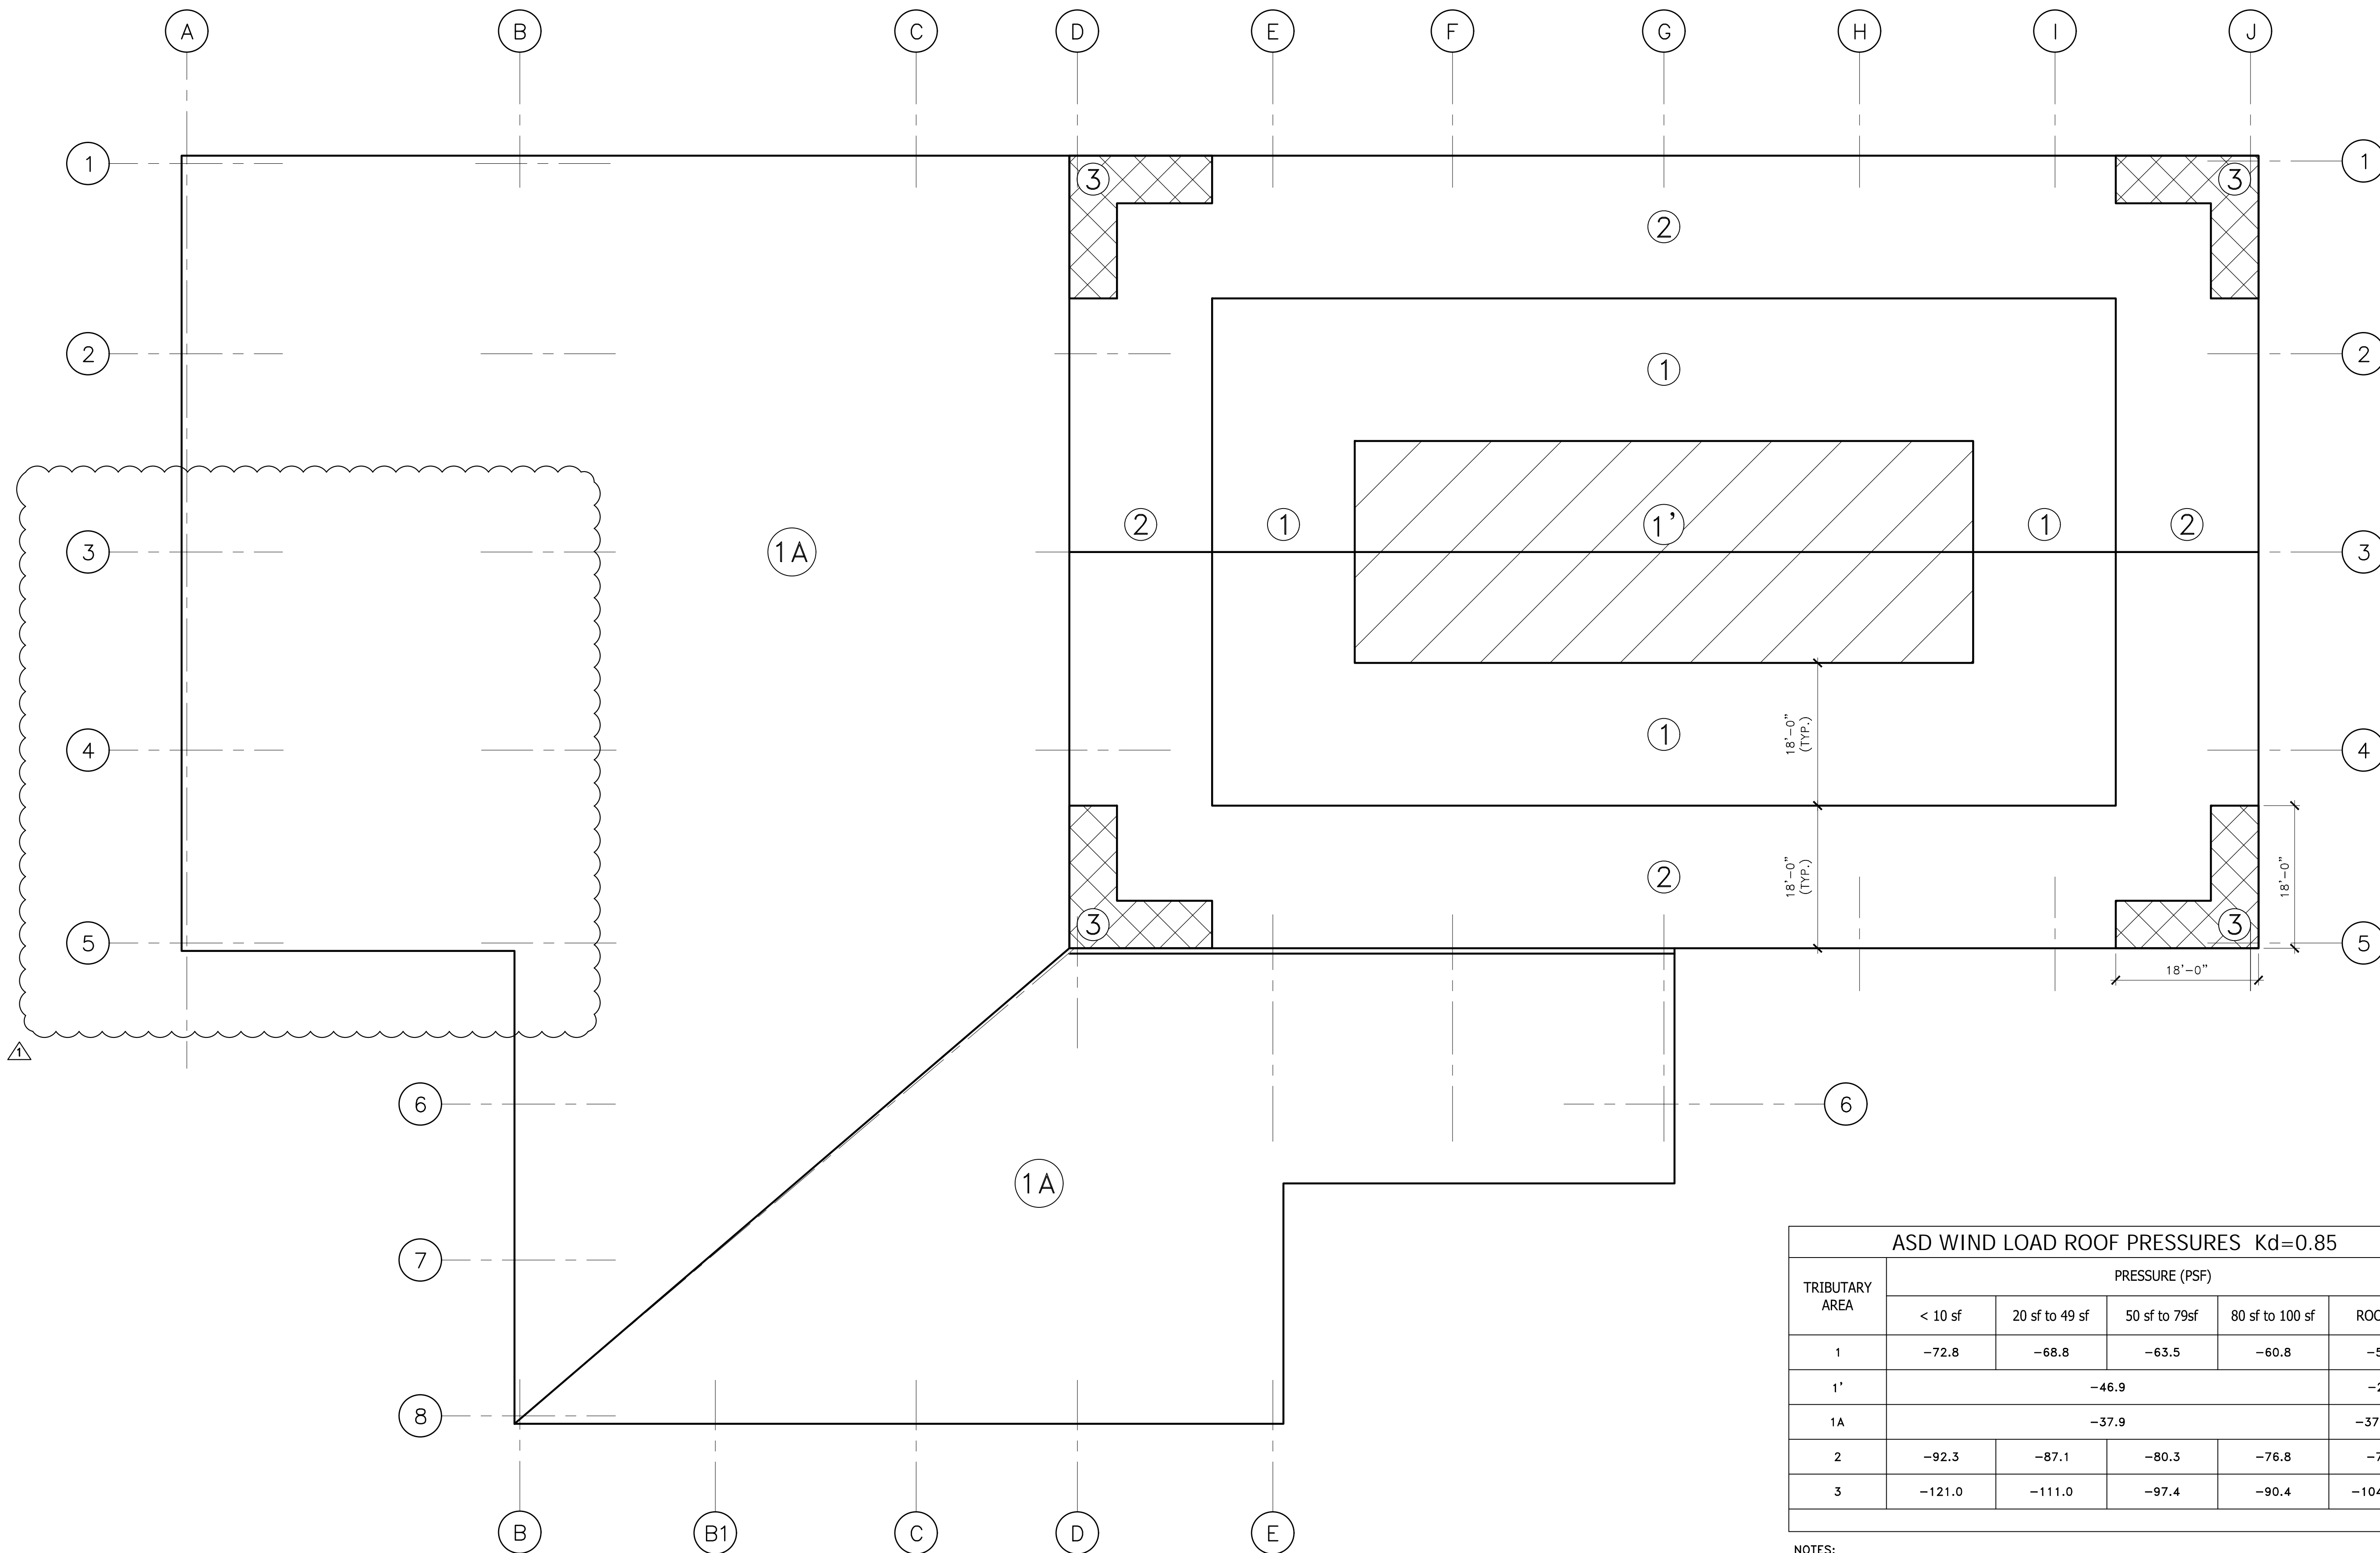

ROOF WIND PRESSURE DIAGRAM

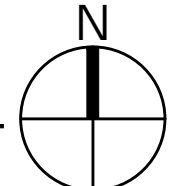

| ASD WIND LOAD ROOF PRESSURES Kd=0.85 |                |                |               |                 |           |
|--------------------------------------|----------------|----------------|---------------|-----------------|-----------|
| TRIBUTARY AREA                       | PRESSURE (PSF) |                |               |                 |           |
|                                      | < 10 sf        | 20 sf to 49 sf | 50 sf to 79sf | 80 sf to 100 sf | ROOFING   |
| 1                                    | -72.8          | -68.8          | -63.5         | -60.8           | -55.0     |
| 1'                                   | -46.9          |                |               |                 | -29.1     |
| 1A                                   | -37.9          |                |               |                 | -37.9000  |
| 2                                    | -92.3          | -87.1          | -80.3         | -76.8           | -74.5     |
| 3                                    | -121.0         | -111.0         | -97.4         | -90.4           | -104.0000 |

- NOTES:
- FOR Kd = 1.0, MULTIPLY VALUES BY 1.18.
  - THE FIGURES SHOWN REPRESENT GROSS VALUES. TO OBTAIN NET UPLIFT VALUES ONLY 10 PSF OF DEAD LOAD SHALL BE DEDUCTED FROM THEM.
  - FOR ULTIMATE VALUES, MULTIPLY VALUES IN TABLE BY 1.67.

| OWNER CHANGES | No. | REVISIONS | DATE | BY |
|---------------|-----|-----------|------|----|
|               |     |           |      |    |
|               |     |           |      |    |
|               |     |           |      |    |
|               |     |           |      |    |

**Kimley-Horn**  
 © 2021 KIMLEY-HORN AND ASSOCIATES, INC.  
 355 ALHAMBRA CIRCLE, SUITE 1400, CORAL GABLES, FL 33134  
 PHONE: 305-673-2025  
 WWW.KIMLEY-HORN.COM REGISTRY 696

LICENSED PROFESSIONAL  
 KHA PROJECT 143228000  
 DATE APRIL 2021  
 SCALE AS SHOWN  
 DESIGNED BY JF  
 DRAWN BY WR  
 CHECKED BY JF


**IRC LANDFILL  
 PREPARED FOR  
 INDIAN RIVER COUNTY  
 INDIAN RIVER COUNTY  
 FL**

SHEET NUMBER  
**9-102**

11/16/2021 JF



This document, together with the concepts and designs presented herein, as an instrument of service, is intended only for the specific purpose and client for which it was prepared. Reuse of and improper reliance on this document without written authorization and adaptation by Kimley-Horn and Associates, Inc. shall be without liability to Kimley-Horn and Associates, Inc.

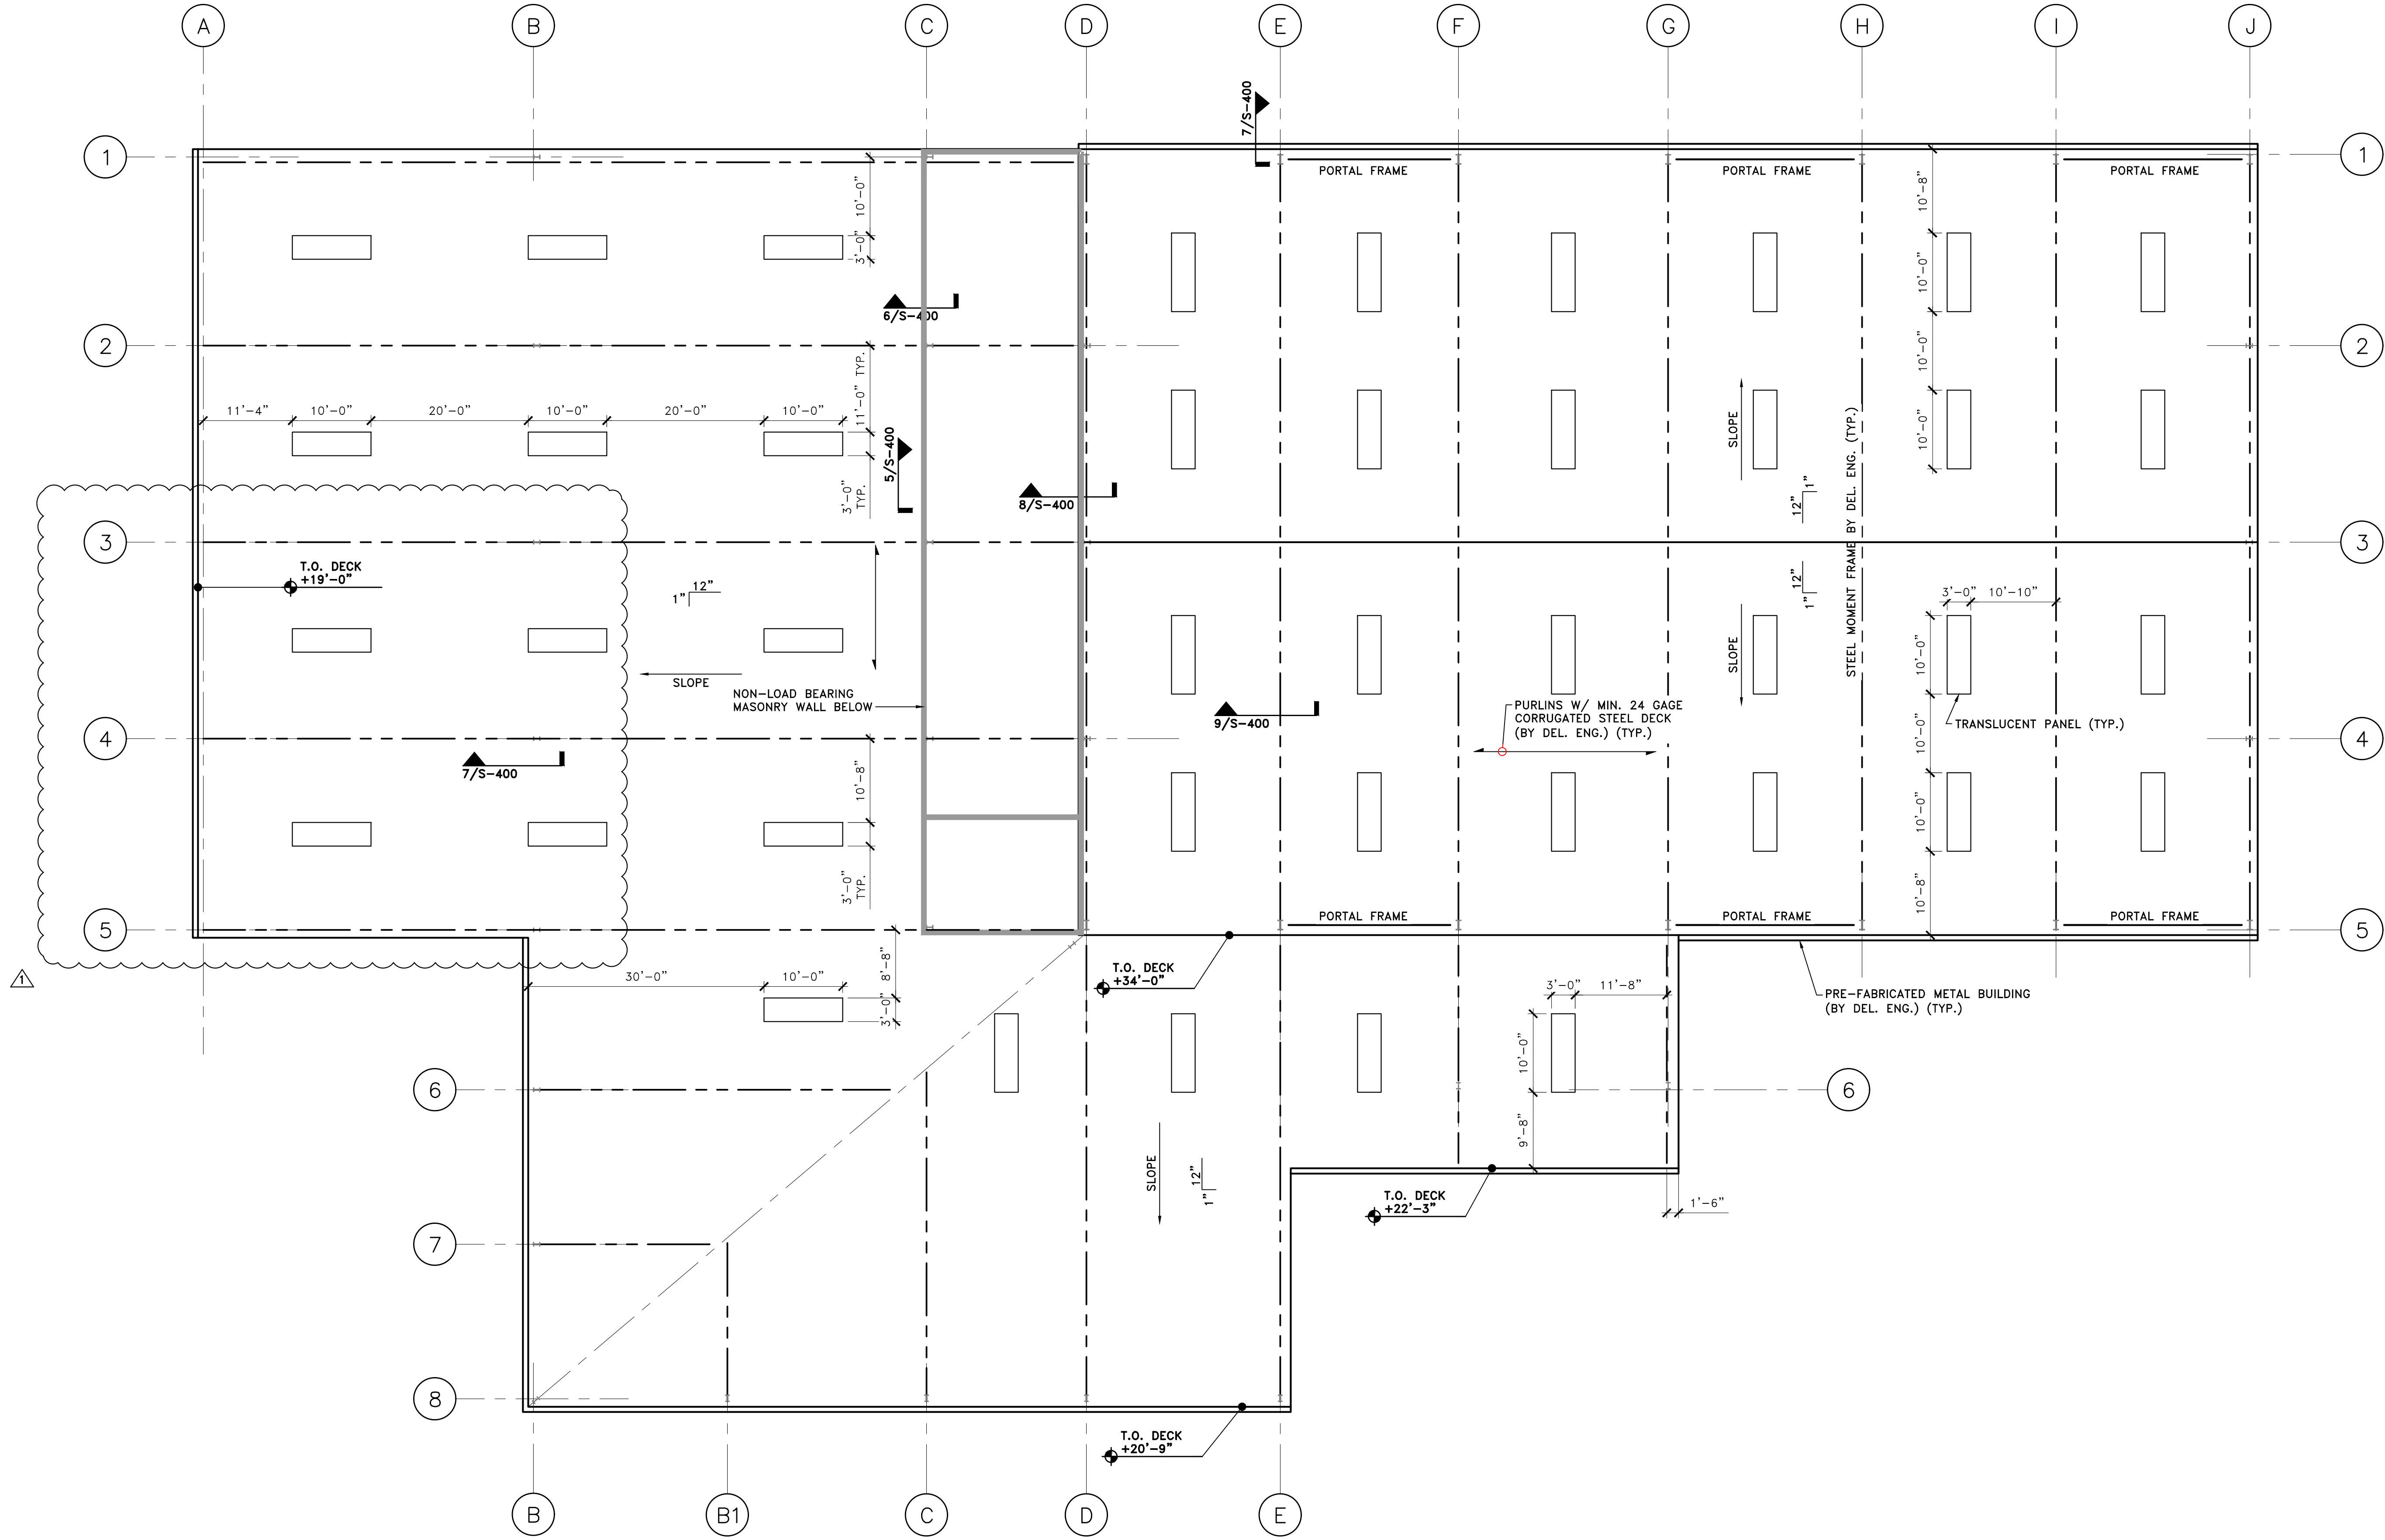


- ROOF PLAN NOTES:**
- ELEVATION +0'-0" = +24.5 NAVD 88
  - FOR GENERAL NOTES, SEE SHEET S-000.
  - COORD. ALL SLOPES AND ELEVATIONS W/ ARCH. DWGS.

**LEGEND:**


|  |                                  |
|--|----------------------------------|
|  | PORTAL FRAME BEAM (BY DEL. ENG.) |
|  | STEEL FRAME BEAM (BY DEL. ENG.)  |
|  | STEEL COLUMN (BY DEL. ENG.)      |
|  | NON-LOAD BEARING MASONRY WALL    |
|  | PURLIN FRAMING (BY DEL. ENG.)    |
|  | ROOF SLOPE                       |

**ROOF FRAMING PLAN**  
SCALE: 3/32"=1'-0"

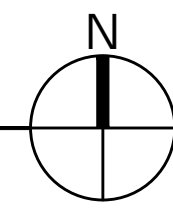


| <p><b>IRC LANDFILL</b><br/>PREPARED FOR<br/><b>INDIAN RIVER COUNTY</b><br/>INDIAN RIVER COUNTY FL</p>   | <p><b>ROOF FRAMING PLAN</b></p>                     |           |      |---|---|-----------|------|----|--|--|--|--|--|--|--|--|--|--|--|--|--|--|--|--|----------------------|
| <p>KHA PROJECT: 143228000<br/>DATE: APRIL 2021<br/>SCALE: AS SHOWN<br/>DESIGNED BY: JF<br/>DRAWN BY: WR<br/>CHECKED BY: JF</p>  | <p>LICENSED PROFESSIONAL: _____<br/>DATE: _____</p> |           |      | <p>© 2021 KIMLEY-HORN AND ASSOCIATES, INC.<br/>355 ALHAMBRA CIRCLE, SUITE 1400, CORAL GABLES, FL 33134<br/>PHONE: 305-673-2025<br/>WWW.KIMLEY-HORN.COM REGISTRY 696</p>   |   |           | <p>OWNER CHANGES</p> <table border="1" style="width: 100%; border-collapse: collapse;"> <thead> <tr> <th>No.</th> <th>REVISIONS</th> <th>DATE</th> <th>BY</th> </tr> </thead> <tbody> <tr><td> </td><td> </td><td> </td><td> </td></tr> <tr><td> </td><td> </td><td> </td><td> </td></tr> <tr><td> </td><td> </td><td> </td><td> </td></tr> <tr><td> </td><td> </td><td> </td><td> </td></tr> </tbody> </table> | No.   | REVISIONS | DATE | BY |  |  |  |  |  |  |  |  |  |  |  |  |  |  |  |  | <p>11/16/2021 JF</p> |
| No.   | REVISIONS   | DATE      | BY   |    |  |  |  |  |  |  |  |  |  |  |  |  |  |  |  |  |                      |
|   |   |           |      |    |  |  |  |  |  |  |  |  |  |  |  |  |  |  |  |  |                      |
|   |   |           |      |    |  |  |  |  |  |  |  |  |  |  |  |  |  |  |  |  |                      |
|   |   |           |      |    |  |  |  |  |  |  |  |  |  |  |  |  |  |  |  |  |                      |
|   |   |           |      |    |  |  |  |  |  |  |  |  |  |  |  |  |  |  |  |  |                      |


This document, together with the concepts and design presented herein, is intended only for the specific purpose and client for which it was prepared. Reuse of and improper reliance on this document without written authorization and adaptation by Kimley-Horn and Associates, Inc. shall be without liability to Kimley-Horn and Associates, Inc.

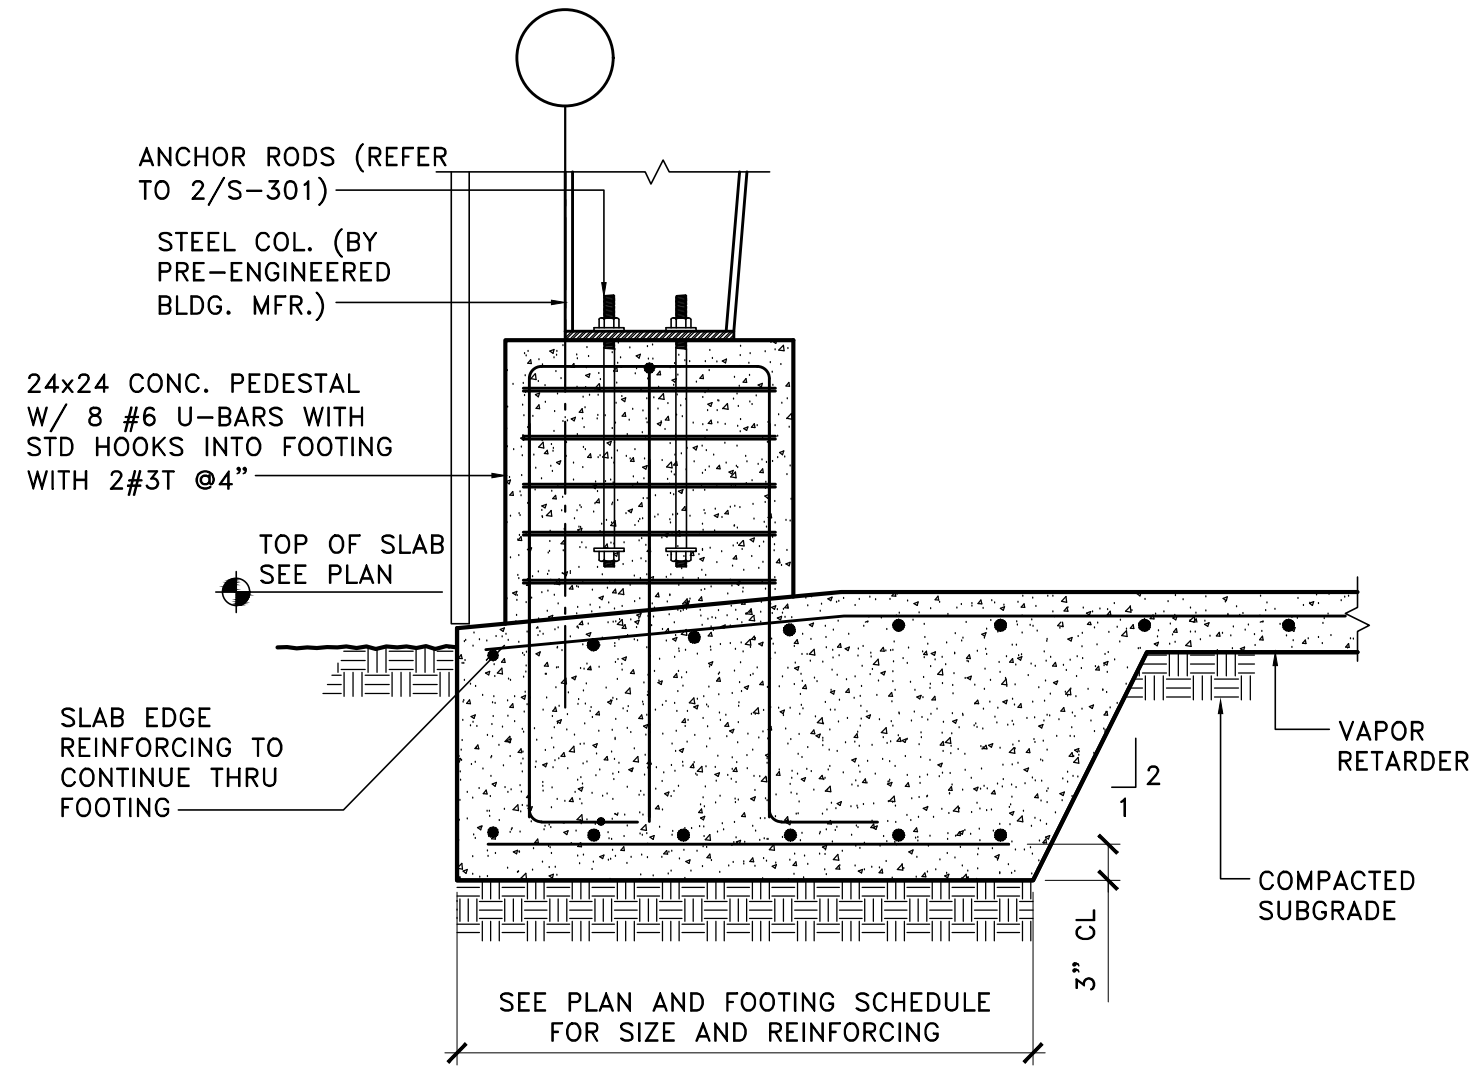


**11** TYP. PEDESTAL AT GL J  
SCALE: 3/4"=1'-0"

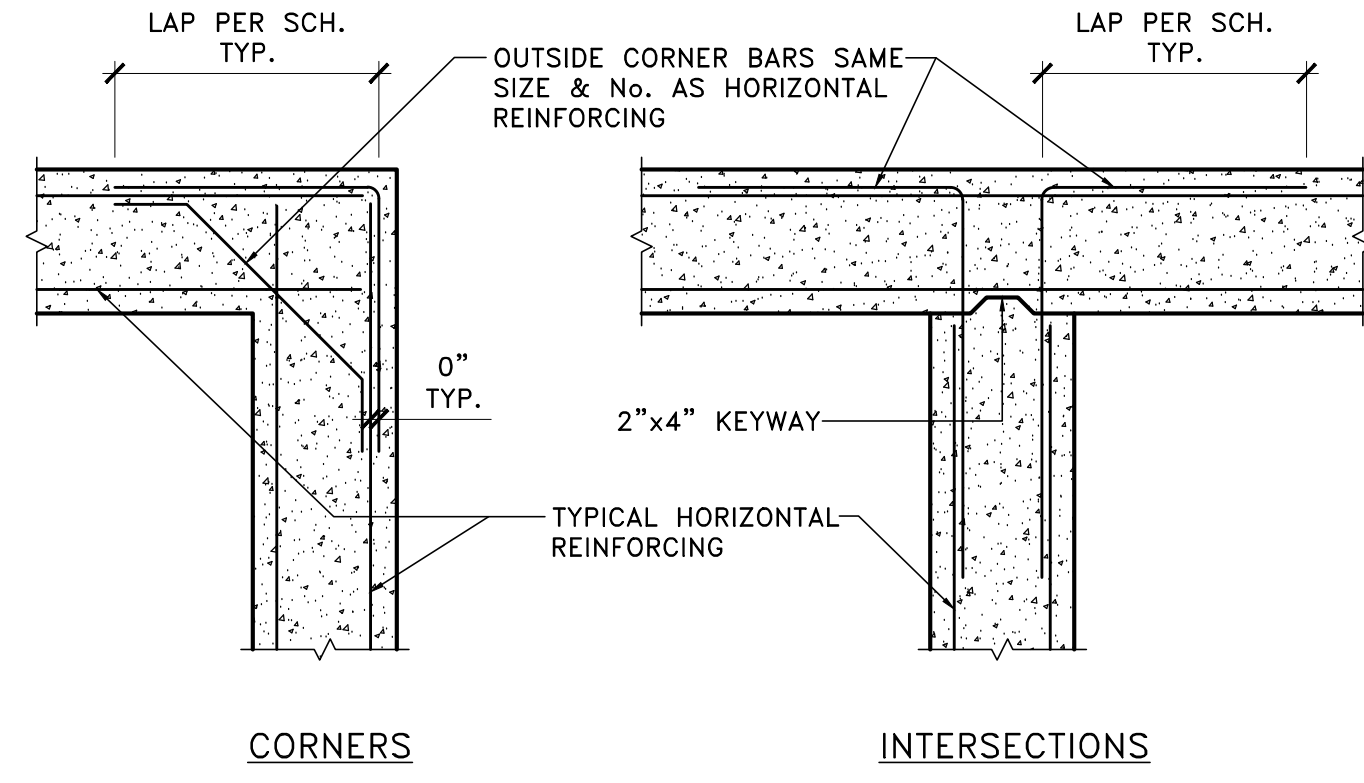


**10** TYPICAL HORIZONTAL REINFORCING  
CONCRETE TIE BEAMS, WALLS, AND FOOTINGS

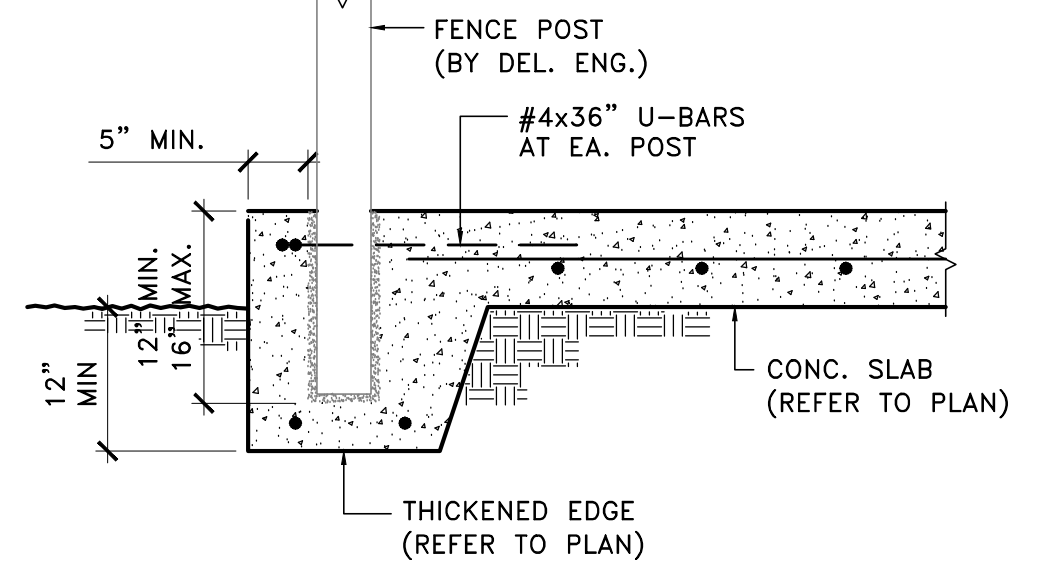


**9** TYP. FENCE POST CONN.  
SCALE: 3/4"=1'-0"

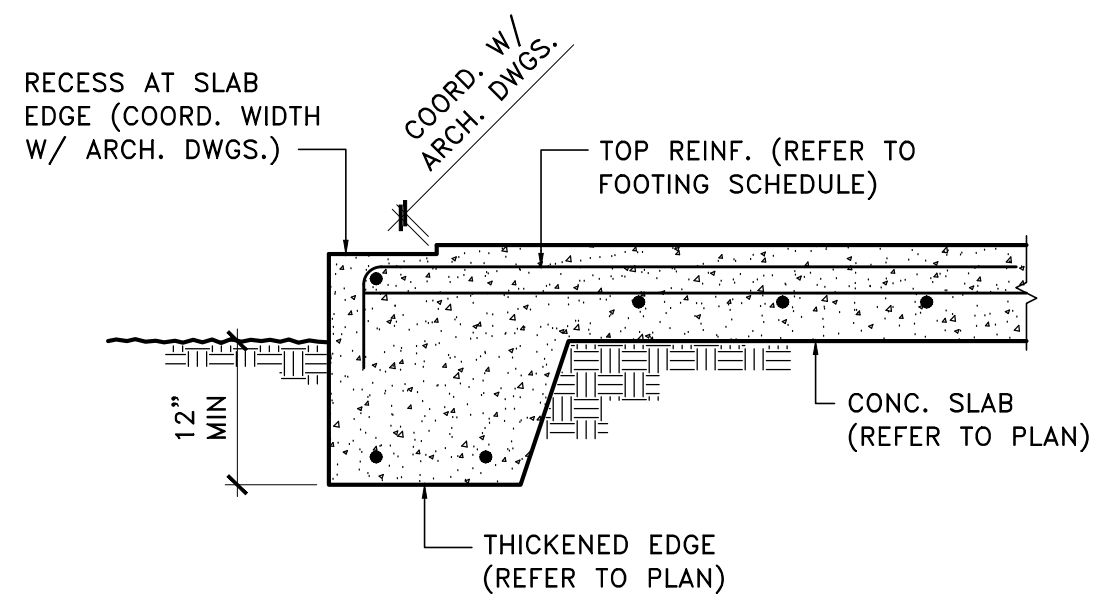


**8** TYP. SLAB EDGE AT DOOR  
SCALE: 3/4"=1'-0"

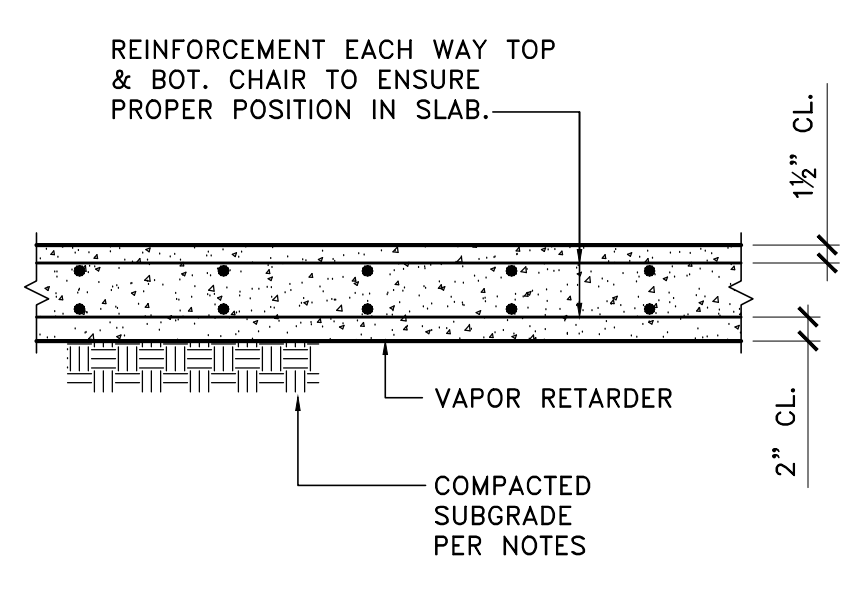


**7** TYP. CONC. SLAB-ON-GRADE  
NTS

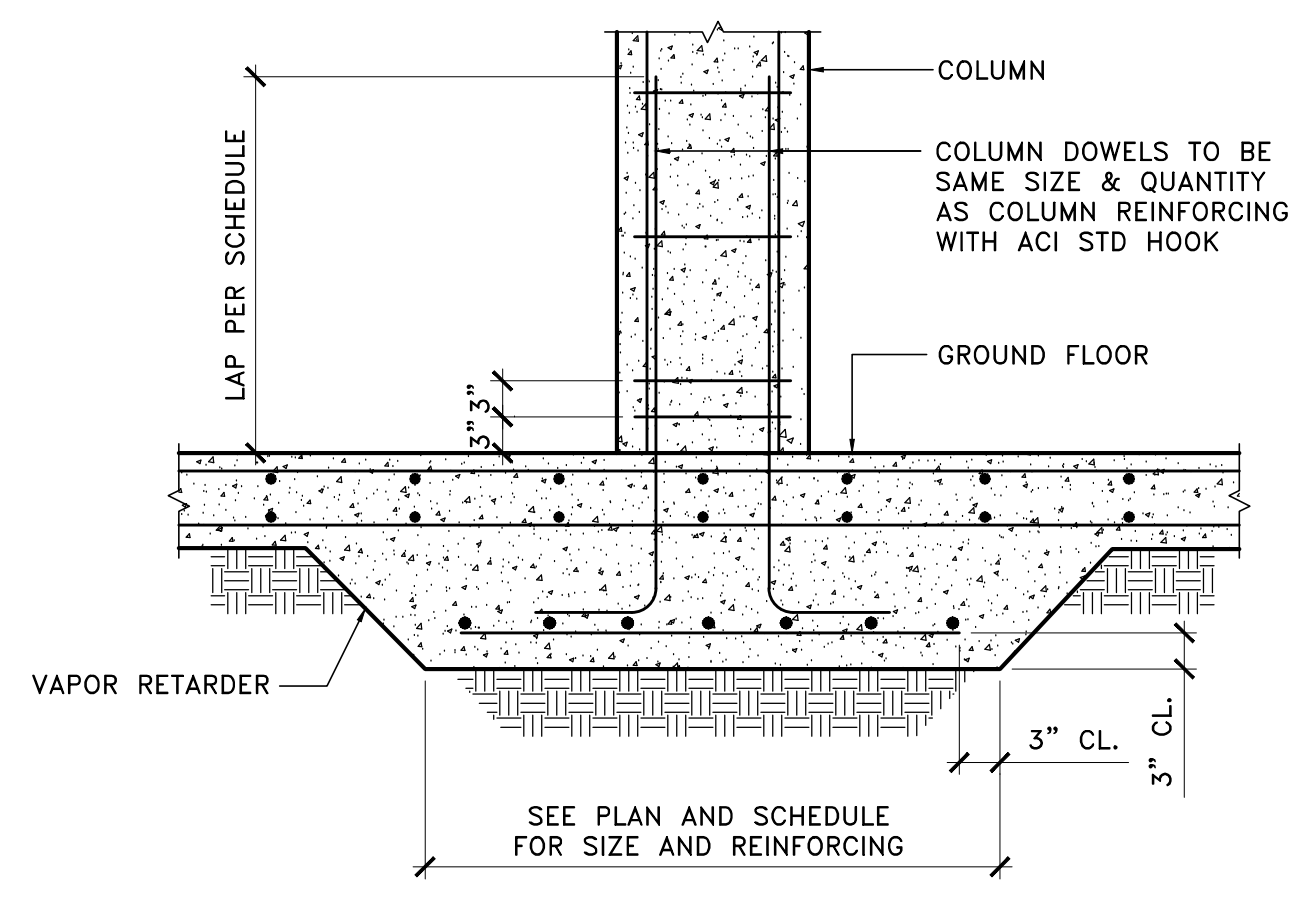


**6** TYP. COL. TO FOOTING  
SCALE: 3/4"=1'-0"

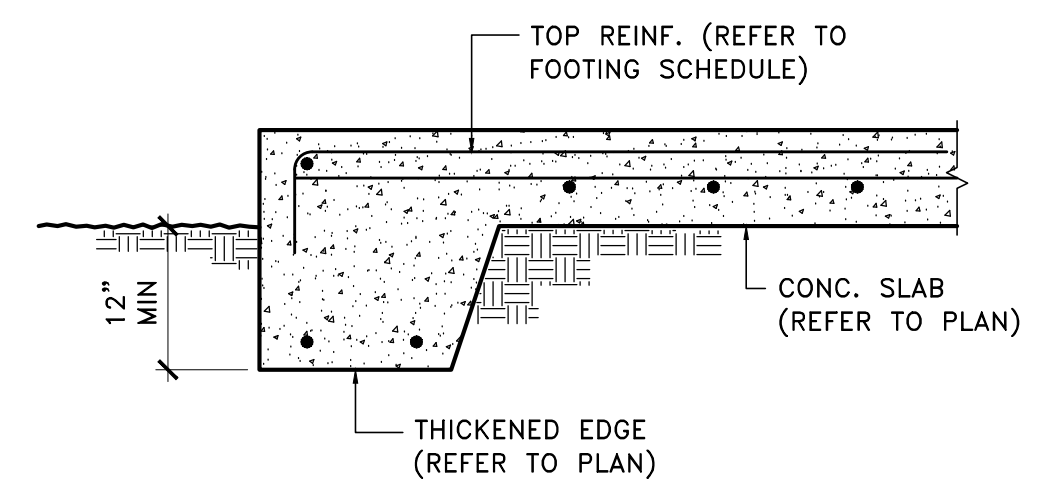

**5** TYP. SLAB EDGE  
SCALE: 3/4"=1'-0"

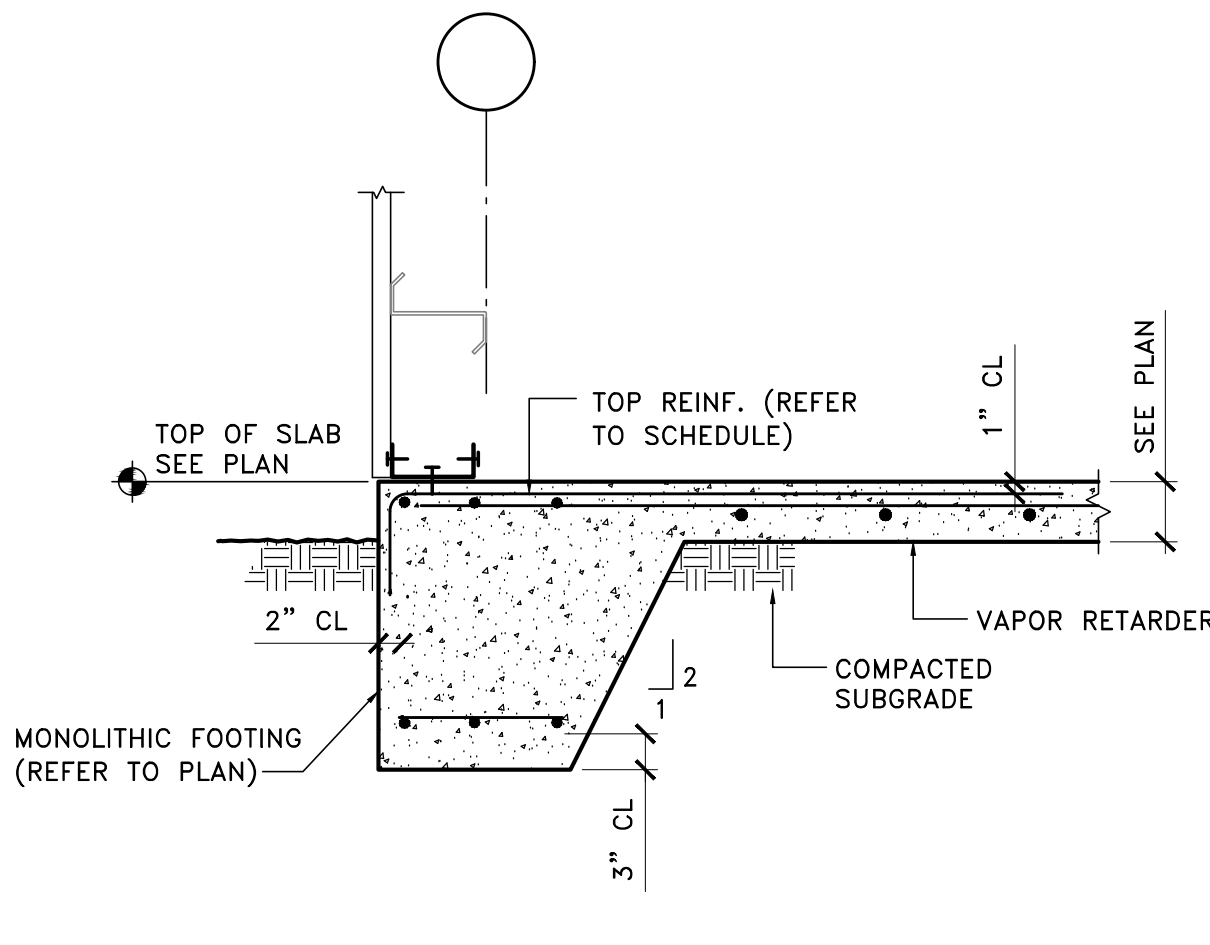


**4** TYP. BLDG. SLAB EDGE  
SCALE: 3/4"=1'-0"

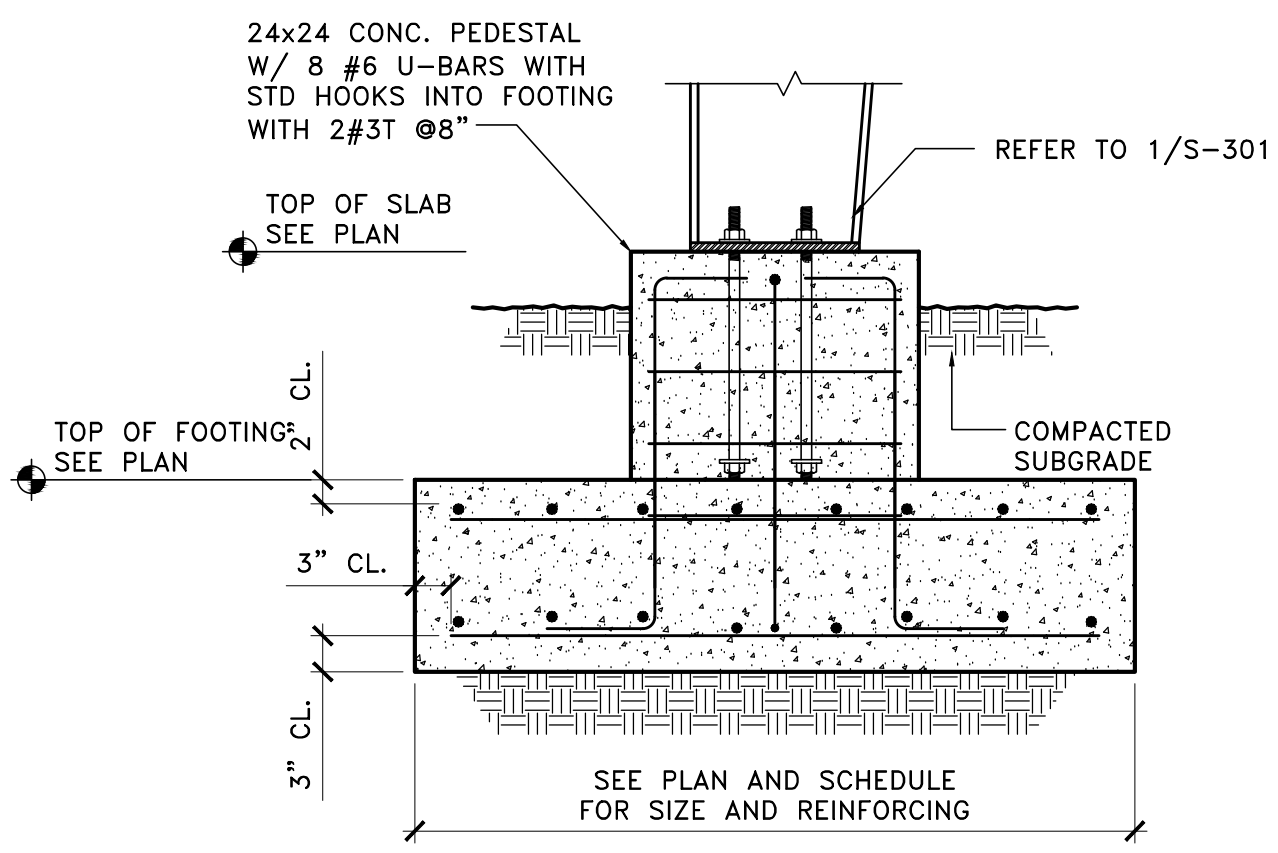


**3** TYP. COL. TO FOOTING  
SCALE: 3/4"=1'-0"

| ANCHOR BOLT SCHEDULE |             |              |
|----------------------|-------------|--------------|
| MARK                 | ANCHOR BOLT | BOLT PATTERN |
| A                    | 4 - 3/4"    | 2 x 2        |
| B                    | 6 - 1"      | 2 x 3        |
| C                    | 6 - 3/4"    | 2 x 3        |
| D                    | 6 - 3/4"    | 2 x 3        |
| E                    | 8 - 1"      | 2 x 4        |

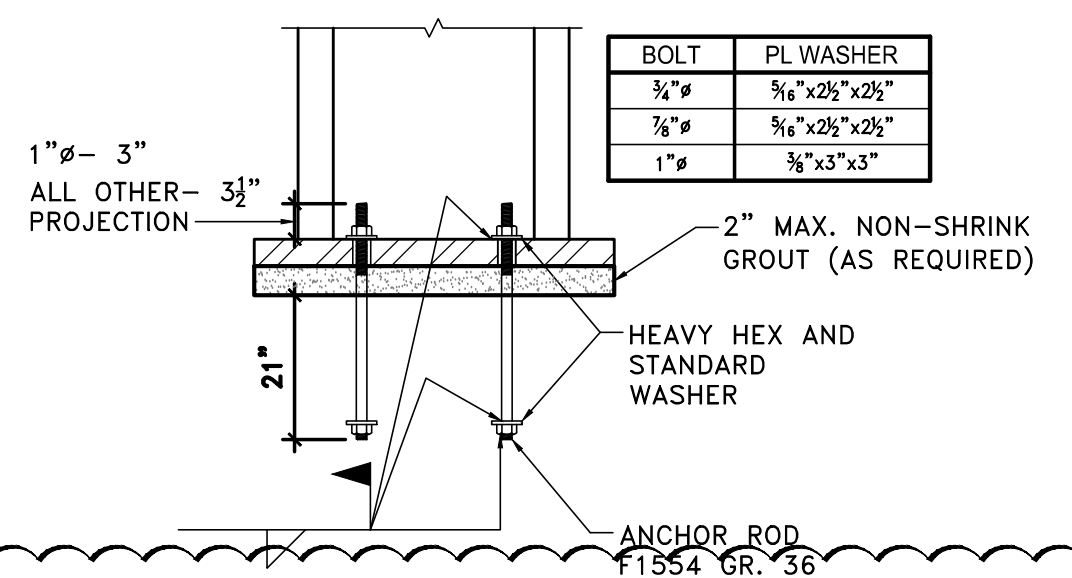

**2** TYP. ANCHOR RODS  
NTS

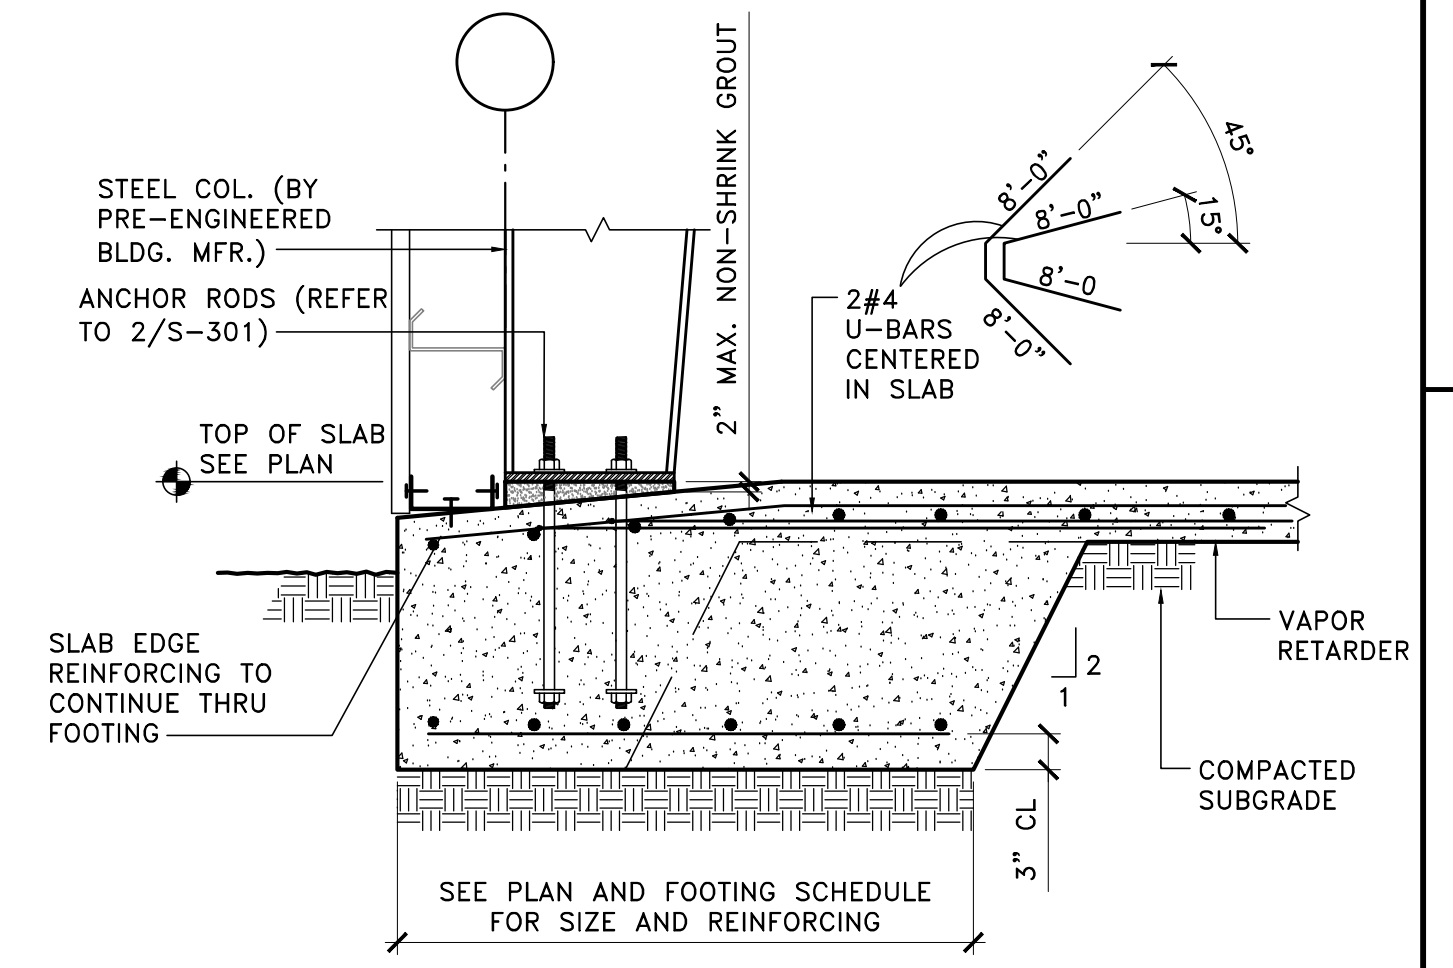

**1** TYP. FOOTING AT COL.  
SCALE: 3/4"=1'-0"

12/02/2021 JF

BIDDING REVISION

NO.

REVISIONS

DATE

**Kimley-Horn**

© 2021 KIMLEY-HORN AND ASSOCIATES, INC.  
355 ALHAMBRA CIRCLE, SUITE 1400, CORAL GABLES, FL 33134  
PHONE: 305-673-2025  
WWW.KIMLEY-HORN.COM

LICENSED PROFESSIONAL

KHA PROJECT 143228000

DATE APRIL 2021

SCALE AS SHOWN

DESIGNED BY JF

DRAWN BY WR

CHECKED BY JF


DATE:

FOUNDATION SECTIONS


IRC LANDFILL PREPARED FOR INDIAN RIVER COUNTY INDIAN RIVER COUNTY FL

SHEET NUMBER S-300


This document, together with the concepts and design presented herein, is intended only for the specific purpose and client for which it was prepared. Reuse of and improper reliance on this document without written authorization and adaptation by Kimley-Horn and Associates, Inc. shall be without liability to Kimley-Horn and Associates, Inc.

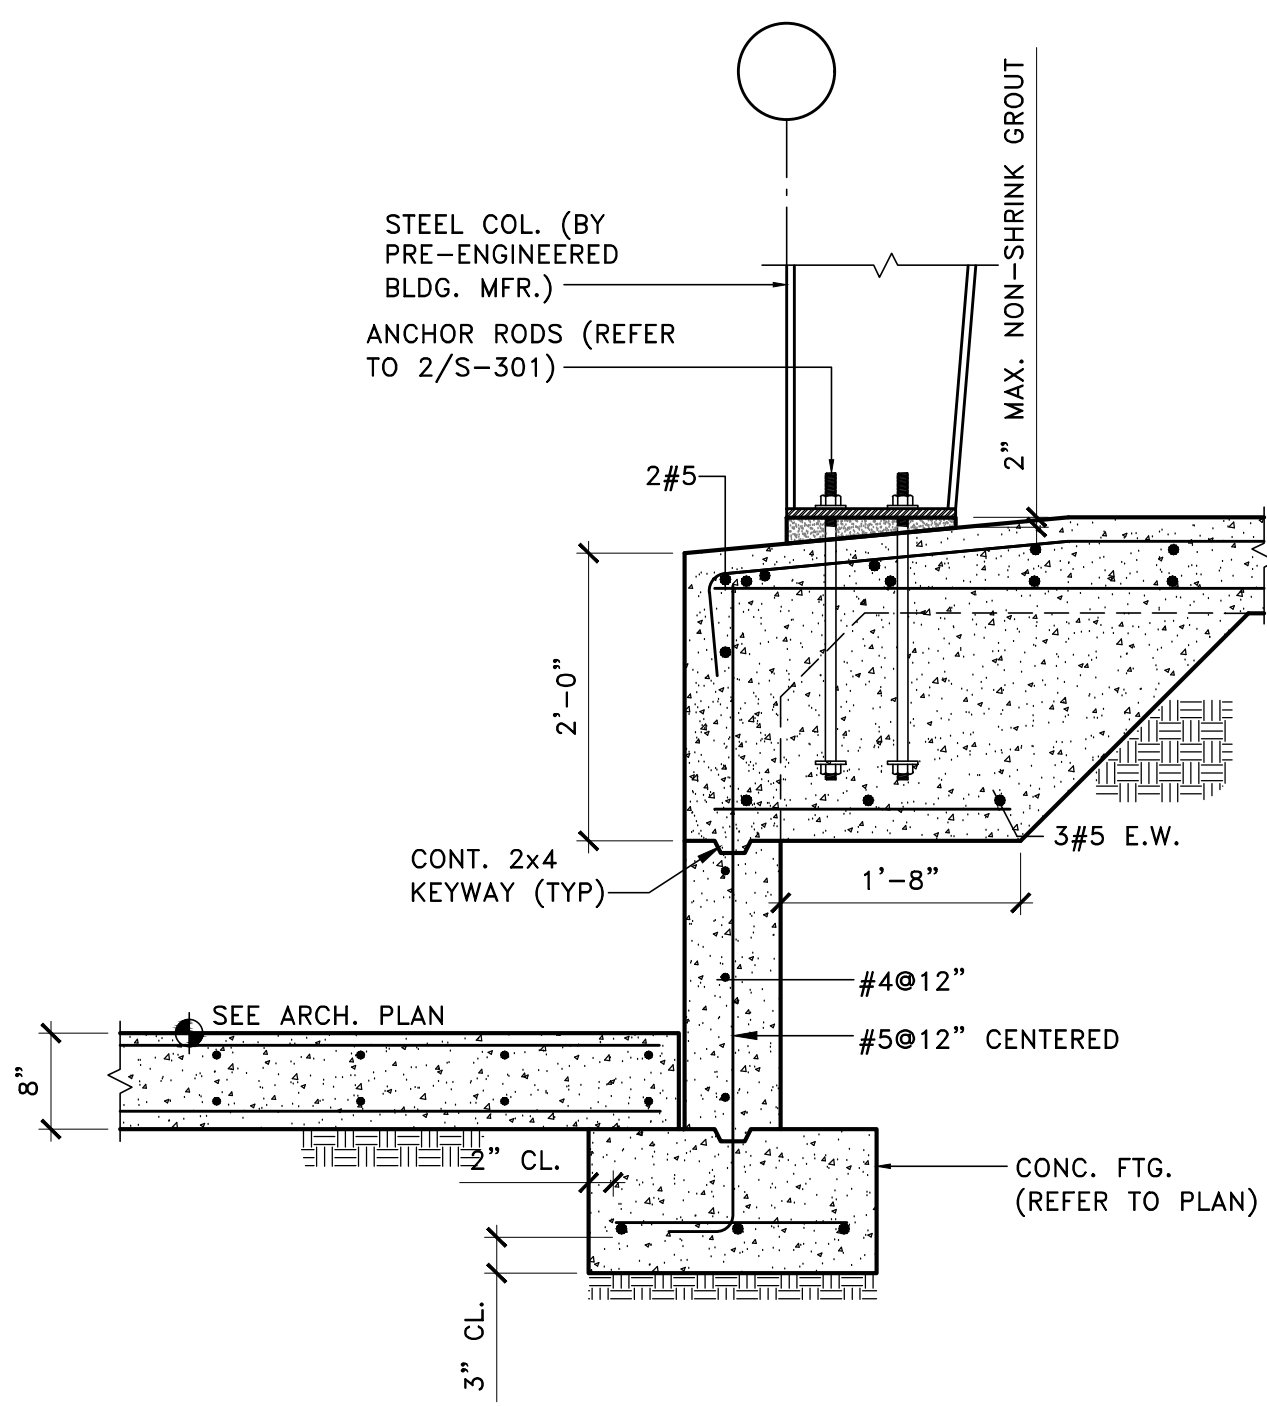


**4 COLUMN AT LOADING DOCK**  
SCALE: 3/4"=1'-0"

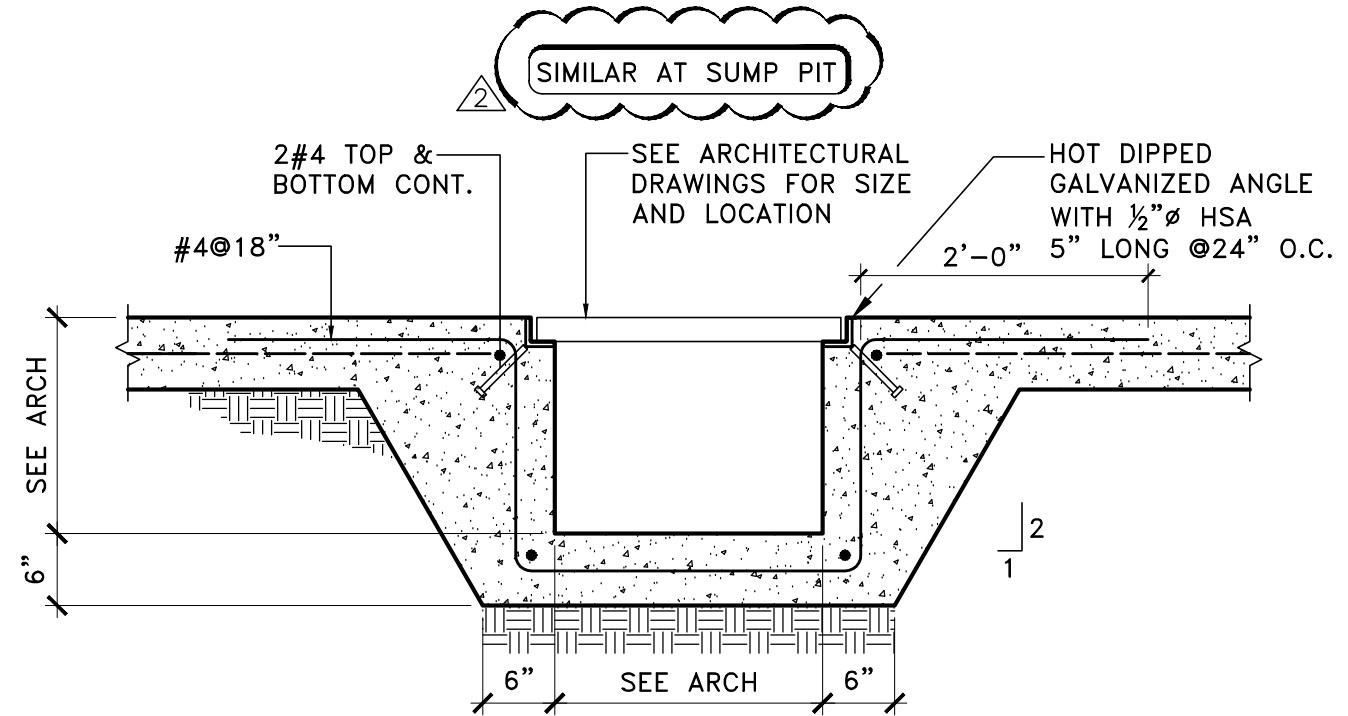


**3 TYP. TRENCH DRAIN**  
SCALE: 3/4"=1'-0"

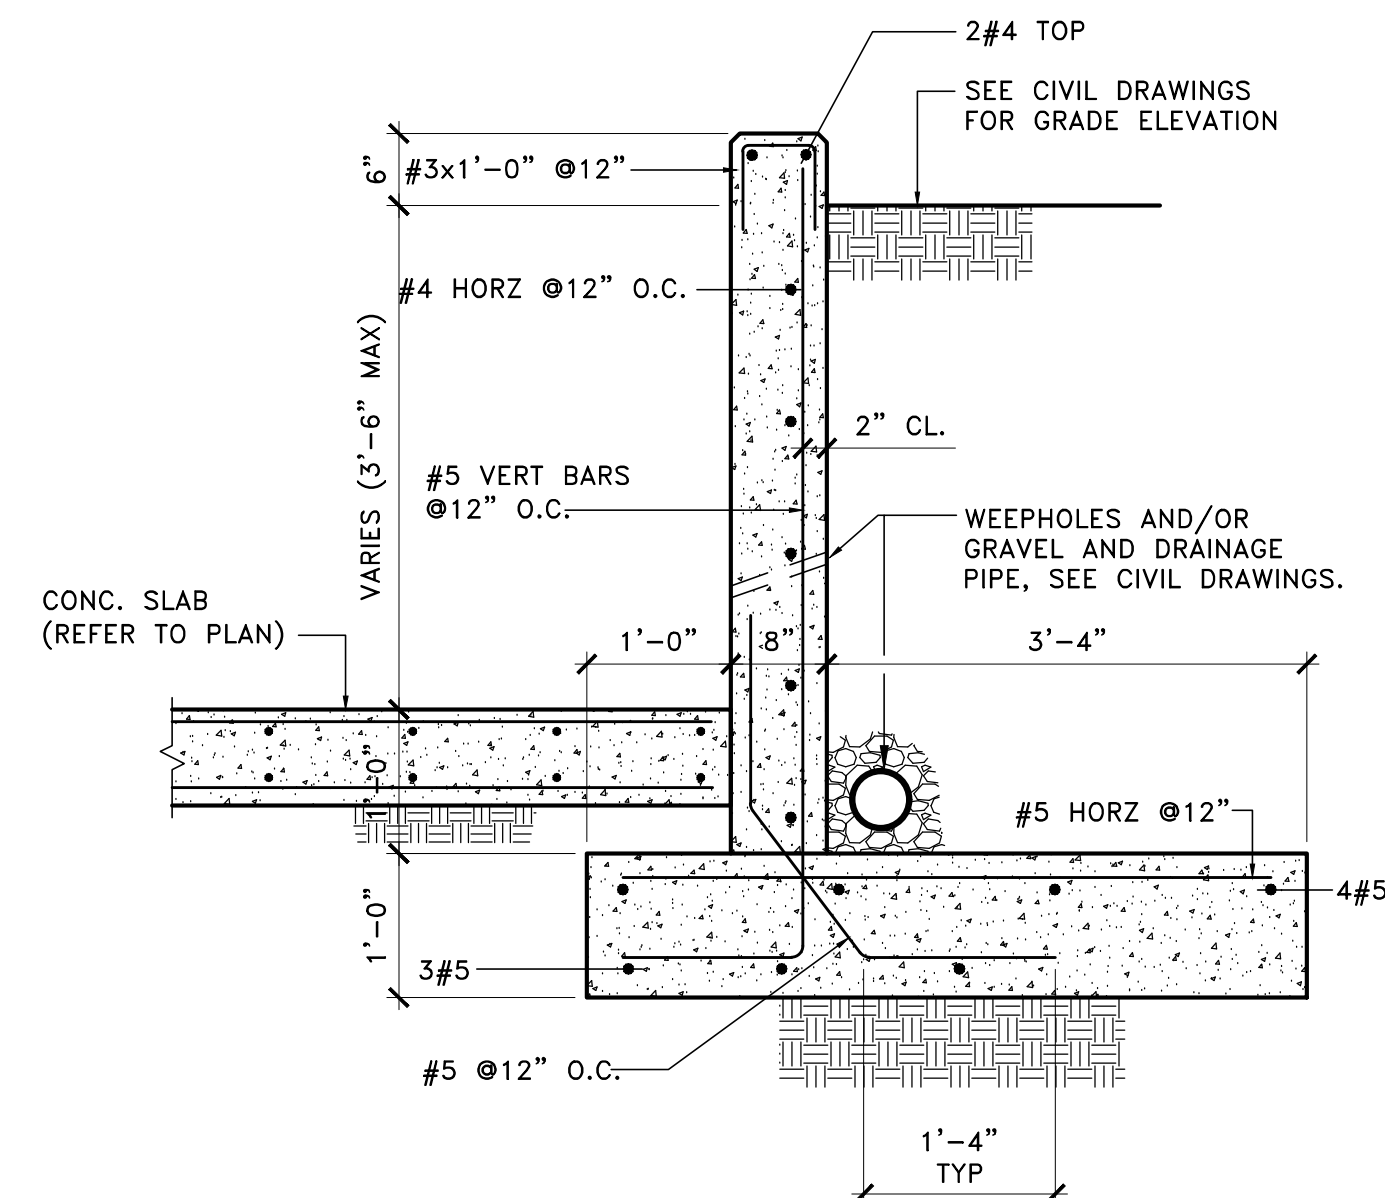

**2 TYP. RETAINING WALL**  
AT LOADING DOCK  
SCALE: 3/4"=1'-0"

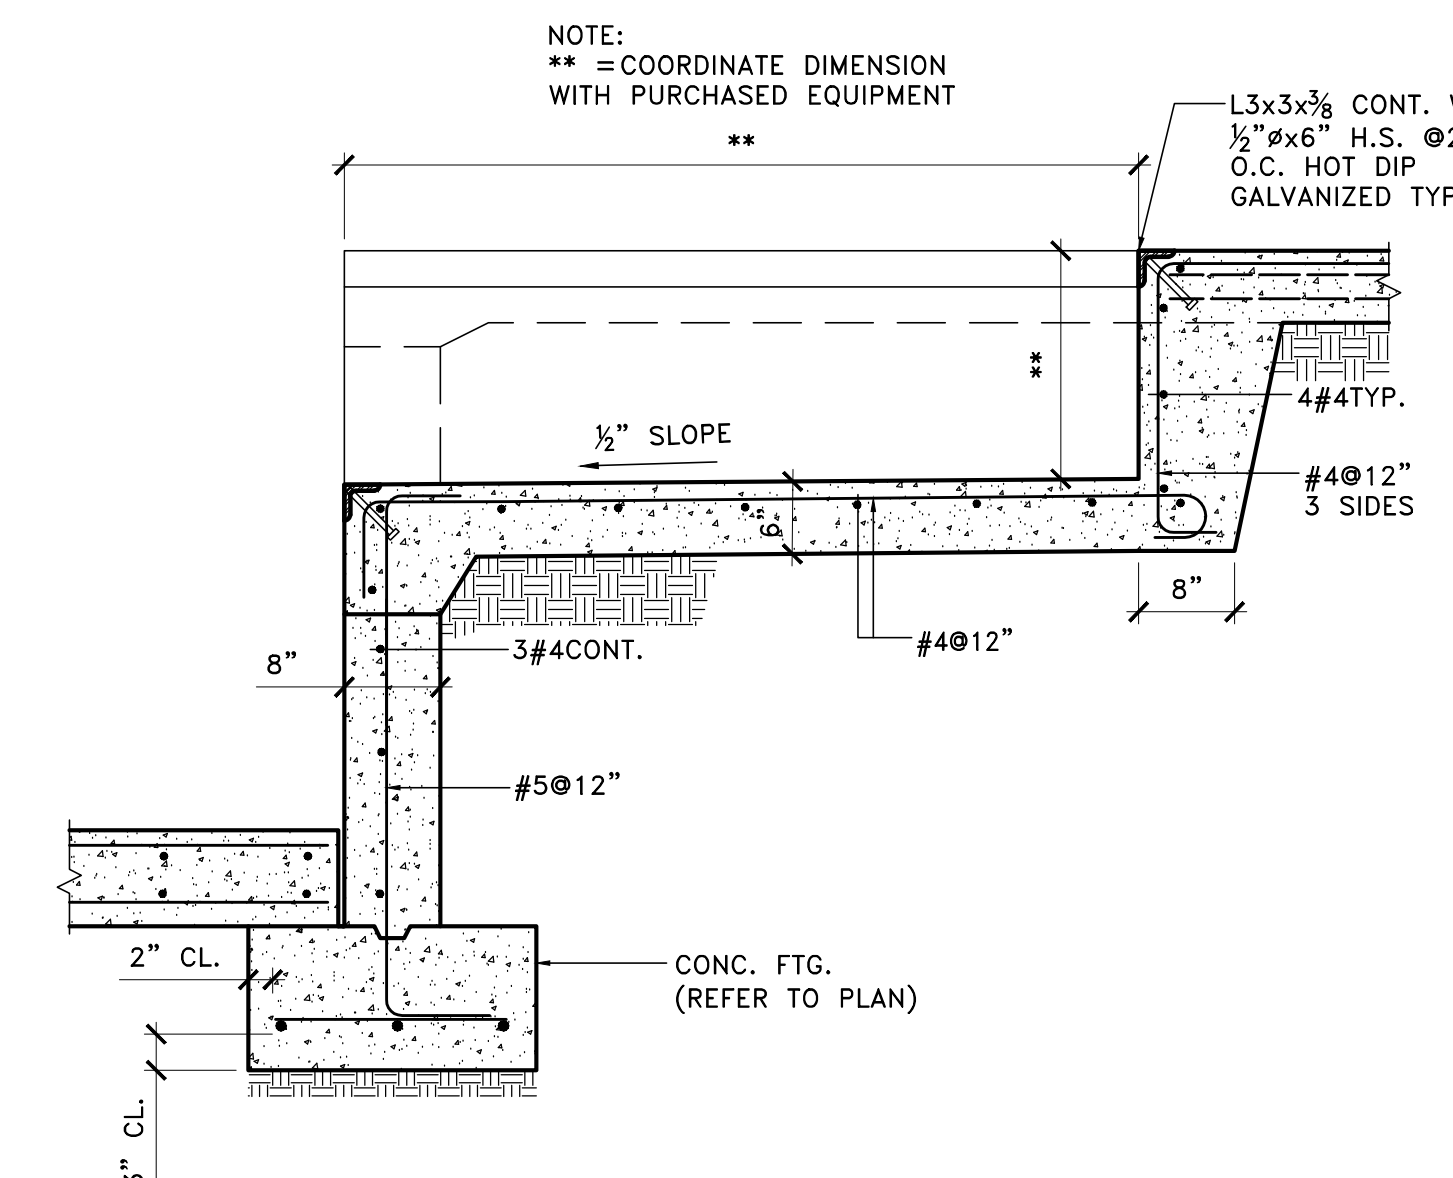

**1 TYP. LOADING DOCK**  
SCALE: 3/4"=1'-0"

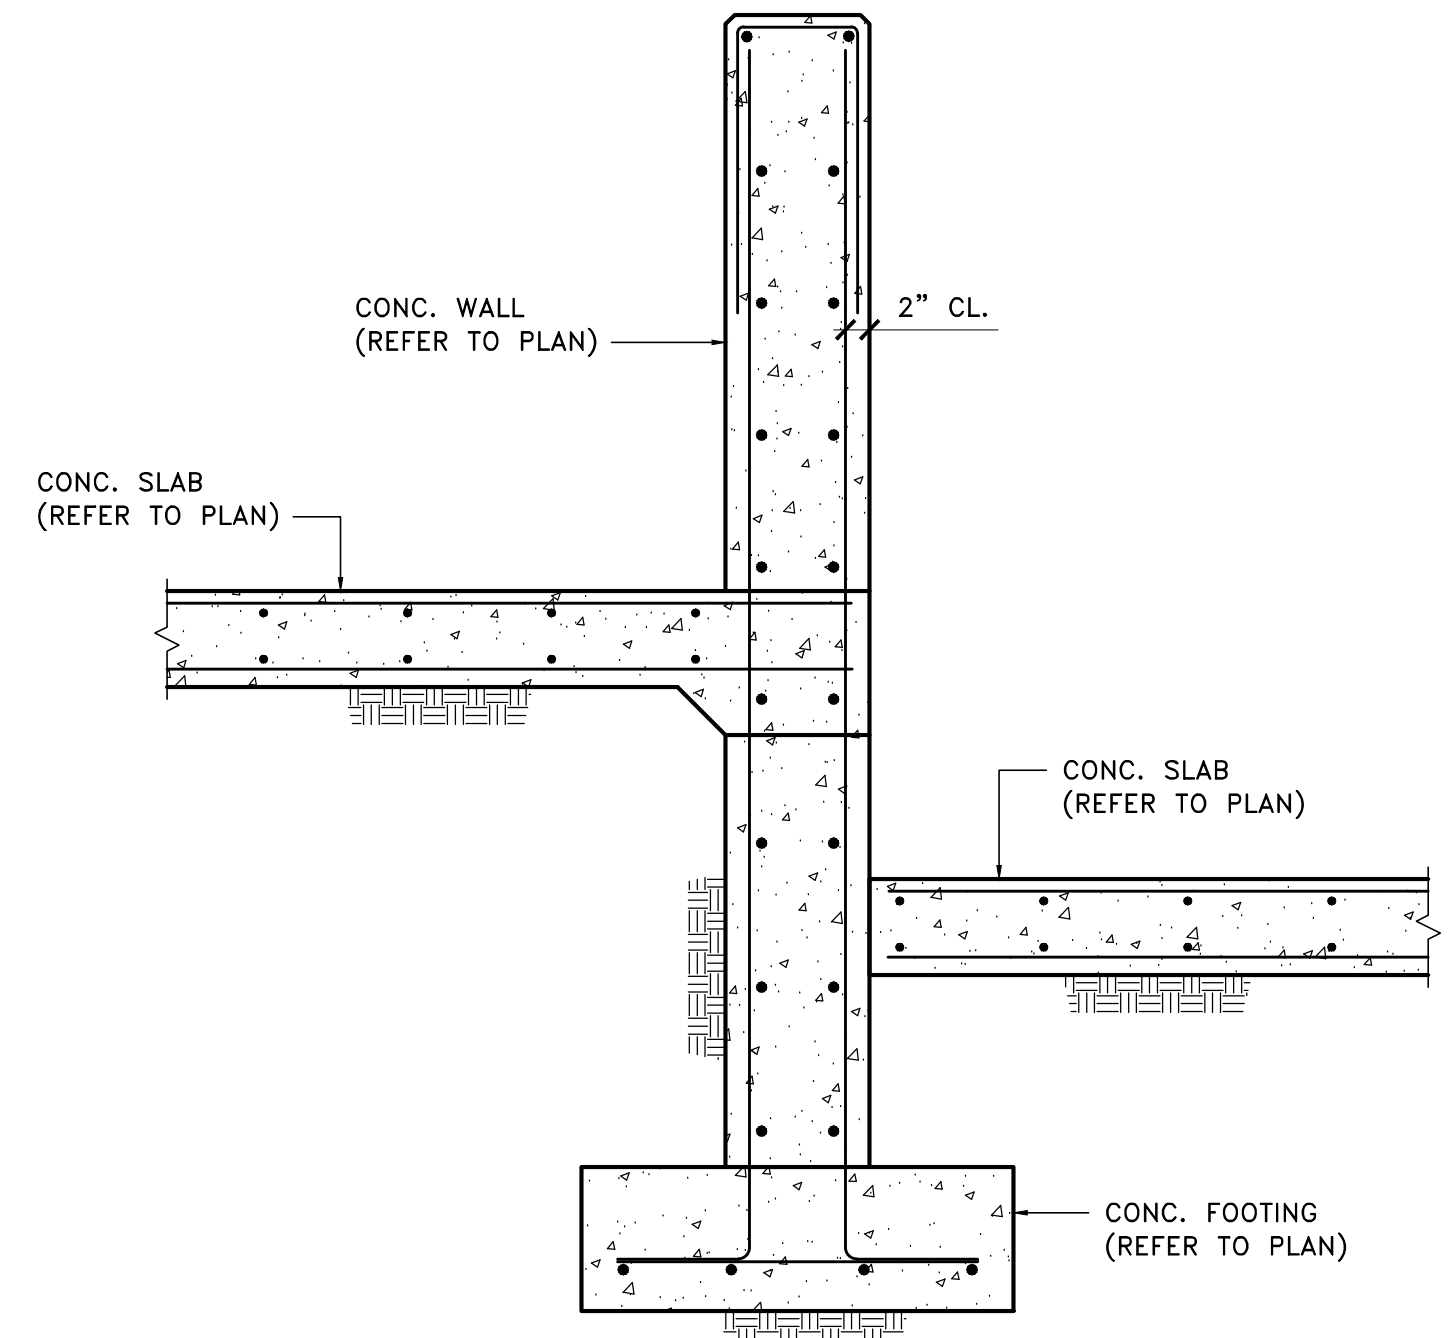

**5 INTERIOR CONC. WALL**  
SCALE: 3/4"=1'-0"

|   |                    |  |
|---|--------------------|--|
| <b>Kimley &gt;&gt;&gt; Horn</b>                                   |                    | © 2021 KIMLEY-HORN AND ASSOCIATES, INC.<br>355 ALHAMBRA CIRCLE, SUITE 1400, CORAL GABLES, FL 33134<br>PHONE: 305-673-2025<br>WWW.KIMLEY-HORN.COM |
| LICENSED PROFESSIONAL   |                    | REVISIONS  |
| KHA PROJECT<br>14-3228000   | DATE<br>APRIL 2021 | BIDDING REVISION   |
| SCALE<br>AS SHOWN   | DESIGNED BY<br>JF  | No.  |
| DRAWN BY<br>WR  | CHECKED BY<br>JF   | No.  |
|   |                    | DATE   |
| <b>FOUNDATION SECTIONS</b>  |                    | REVISIONS  |
| <b>IRC LANDFILL</b><br>PREPARED FOR<br><b>INDIAN RIVER COUNTY</b> |                    | INDIAN RIVER COUNTY  |
| SHEET NUMBER<br><b>S-301</b>                                      |                    | DATE<br>BY   |





# INDIAN RIVER COUNTY HOUSEHOLD HAZARDOUS WASTE AND RECYCLING FACILITY Indian River County, FL

## PROJECT INFORMATION

### SUMMARY OF WORK:

- CONSTRUCT NEW HOUSEHOLD HAZARDOUS WASTE AND SINGLE-STREAM RECYCLING FACILITY.
- CONSTRUCT SITE IMPROVEMENTS INCLUDING PAVING, DRAINAGE, UTILITIES AND LANDSCAPING.

### CODES IN EFFECT:

WORK SHALL BE DESIGNED IN FULL COMPLIANCE WITH THE LATEST EDITION OF THE APPLICABLE SECTIONS OF THE FOLLOWING CODES, STANDARDS AND GUIDELINES. IN CASE OF A CONFLICT BETWEEN CODES, THE MOST STRINGENT CONDITION SHALL APPLY. ADDITIONAL CODE REFERENCES MAY BE FOUND IN EACH OF THE ENGINEERING DISCIPLINES.

- FLORIDA BUILDING CODE, SEVENTH EDITION (2020)
- FLORIDA MECHANICAL CODE, SEVENTH EDITION (2020)
- FLORIDA ELECTRICAL CODE, SEVENTH EDITION (2020)
- FLORIDA PLUMBING CODE, SEVENTH EDITION (2020)
- FLORIDA FIRE PREVENTION CODE, SEVENTH EDITION (2020)
- NFPA 70 - NATIONAL ELECTRIC CODE 2017

## FLORIDA PRODUCT APPROVALS

THE FOLLOWING PRODUCTS ARE TO BE CONSIDERED THE BASIS OF DESIGN AND SHALL BE INSTALLED IN STRICT ACCORDANCE WITH THE MANUFACTURER'S INSTRUCTIONS AS SPECIFIED IN THE APPLICABLE FLORIDA APPROVAL CODE DOCUMENTATION. ANY PROPOSED CHANGE OF PRODUCTS SHALL BE SUBMITTED FOR CONSIDERATION WITH FLORIDA APPROVAL CODE INFORMATION.

### STOREFRONT (FIXED) WINDOWS

- KAWNEER IR501, FLORIDA APPROVAL NO.: 8787.2.

### EXTERIOR SWINGING METAL DOORS

- TELL MANUFACTURING OUT-SWINGING STEEL DOOR SYSTEM, FLORIDA APPROVAL NO.: FL 22211.2

### EXTERIOR COILING DOORS

- BEST ROLLING DOOR, INC. MIAMI-DADE N.O.A. NO.: 17-1031.07 FLORIDA APPROVAL NO.: 10706-R3

### METAL ROOFING AND SIDING PANELS

- 26 GA. PBR ROOF PANELS, FLORIDA APPROVAL NO.: FL 6617.2
- 26 GA. PBR WALL PANELS, FLORIDA APPROVAL NO.: 7548.1

### TRANSLUCENT PANELS

- TRANSLUCENT ROOF PANELS BY GLASTEEL, FLORIDA APPROVAL NO.: FL15531-R4
- TRANSLUCENT WALL PANELS BY GLASTEEL, FLORIDA APPROVAL NO.: FL5614-R6

### METAL LOUVERS

- GREENHECK EVH-501D STATIONARY LOUVER
- MIAMI-DADE N.O.A. NO.: 15-0415.05
- APPROVAL NO.: FL 19277.1

## VICINITY MAP



## CONTACT INFORMATION

### CIVIL ENGINEER OF RECORD

### LANDSCAPE ARCHITECT

### STRUCTURAL ENGINEER OF RECORD:

KIMLEY-HORN AND ASSOCIATES, INC.  
355 ALHAMBRA CIRCLE, SUITE 1400  
CORAL GABLES, FL 33134  
PHONE: (305) 673-2025

### ARCHITECT OF RECORD:

### MARCOS IBARGUEN, RA

### CMK DESIGN STUDIO, INC.

6822 22ND AVE, N. #148

ST. PETERSBURG, FL 33710

PHONE: (813) 362-6381

### M/E/P/FP ENGINEER OF RECORD:

### TODD WILSON & JOE GIRGENTI

### WILSON & GIRGENTI, LLC

PO BOX 1377

SAFETY HARBOR, FL 34695

PHONE: (813) 855-3330

## BUILDING AND FIRE CODE ANALYSIS

Based on the Florida Building Code (FBC), 2020 (Seventh) Edition and the Florida Fire Prevention Code (FFPC), 2020 (Seventh) Edition, and NFPA 101, Life Safety Code, 2018 Edition.

### OCCUPANCY

GROUP S-1, STORAGE, MODERATE HAZARD PER FBC 311.2  
MIXED STORAGE AND OFFICE PER FFPC/NFPA 101: 6.1.13.1.

### CONSTRUCTION TYPE

VB, NON-COMBUSTIBLE, PER FBC SECTION 602.2; FULLY SPRINKLED

### ALLOWABLE AREA (FBC SECTION 506.2)

UNLIMITED

### PROPOSED AREA

28,750 SF COMPLIES

### ALLOWABLE HEIGHT (FBC TABLE 503)

UNLIMITED

### PROPOSED HEIGHT

HEIGHT PROPOSED: 35 FEET AT RIDGE. COMPLIES

### REQUIRED SEPARATION OF OCCUPANCIES (FBC TABLE 508.4 AND FFPC/NFPA 101:6.1.14.1 EXCEPTION 3)

GROUP B TO GROUP S-1 - NO SEPARATION REQUIRED

### PROPOSED SEPARATION OF OCCUPANCIES

NO SEPARATION PROPOSED BETWEEN GROUP B AND GROUP S-1. COMPLIES

### REQUIRED SEPARATION FOR H-2 STORAGE ROOM (NFPA 30: 9.9.1)

2-HOUR SEPARATION WALL; 90-MINUTE "B" LABEL DOORS

### PROPOSED SEPARATION FOR H-2 STORAGE ROOM.

2-HOUR SEPARATION WALL; 90-MINUTE "B" LABEL DOORS. COMPLIES

### OCCUPANT LOAD (TABLE 1004.5)

SEE LIFE SAFETY PLAN LS101. MAX. COMBINED OCCUPANT LOAD = 100

### REQUIRED MEANS OF EGRESS:

ALL EXIT DOORS SHALL COMPLY WITH FFPC/NFPA 101:7.2.1.  
ALL HANDRAILS, GUARDRAILS AND RAMPS SHALL COMPLY WITH FFPC/NFPA 101:7.2.2.

REQUIRED NUMBER AND PLACEMENT OF EXITS PER FBC SECTION 1006.2 AND FFPC/NFPA 101:7.4.1 AND 7.5.1.3.2: TWO EXITS PLACED A DISTANCE APART NOT LESS THAN ONE-HALF THE LENGTH OF THE MAXIMUM OVERALL DIAGONAL DIMENSION OF THE AREA SERVED.

### REQUIRED EGRESS WIDTH PER OCCUPANT (FBC SECT. 1005, FFPC/NFPA 101:7.3), SPRINKLED:

DOORS: 0.2 INCHES  
0.2 X 100 = 20 INCHES

### PROPOSED EXITS

FIRST FLOOR: 4 EXITS, 136 INCHES, COMPLIES  
PROPOSED PLACEMENT OF EXITS COMPLIES - SEE LIFE SAFETY PLANS

### MAXIMUM ALLOWABLE TRAVEL DISTANCE TO EXITS (FBC TABLE 1016.1, FFPC/NFPA 101:42.2.6)

GROUP S-1, SPRINKLED: 400 FEET

NOTE: MAX. TRAVEL DISTANCE N/A IF FLAMMABLE LIQUIDS ARE STORED IN ACCORDANCE WITH NFPA 30.

### PROPOSED MAXIMUM TRAVEL DISTANCE TO EXITS

GROUP S-1, SPRINKLED: 114 FEET COMPLIES: SEE LIFE SAFETY PLANS

NOTE: FLAMMABLE LIQUIDS SHALL BE STORED IN ACCORDANCE WITH NFPA 30, COMPLIES.

### MAXIMUM COMMON PATH OF TRAVEL TO EXITS (FBC TABLE 1016.1, FFPC/NFPA 101:42.2.5)

GROUP S-1, SPRINKLED: 100 FEET

### PROPOSED COMMON PATH OF TRAVEL TO EXITS:

NOT APPLICABLE - NO COMMON PATH OF TRAVEL PROPOSED. COMPLIES: SEE LIFE SAFETY PLANS

### PLUMBING FIXTURES REQUIRED PER F.P.C. 403.1:

PER FPC TABLE 403.1: 1 WC (WOMEN), 1 LAV (WOMEN), 1 WC (MEN), 1 LAV (MEN), 1 DF, 1 SERVICE SINK  
FIXTURES PROVIDED: 1 WC (WOMEN), 1 LAV (WOMEN), 1 WC 1 (MEN), 1 LAV (MEN), 2 DF, 2 SERVICE SINKS

### ADDITIONAL FFPC CODE ANALYSIS

#### Previous Use:

- Vacant.

#### Proposed Use:

- Collection and transfer of household hazardous waste and single-stream recycling.

#### Hazard Classification per FFPC 101:6.2.2.3

- Ordinary Hazard, all areas

#### Fire Alarm requirement

- Per FFPC 101:40.3.4.1, a fire alarm system is required.
- See Electrical drawings for fire alarm system proposed.

#### Fire Sprinkler System requirement

- Per NFPA, facility must be fully sprinklered. See Fire Protection drawings for compliance.

## SHEET INDEX

|       |  |
|-------|--|
| G000  | COVER SHEET                              |
| C100  | CIVIL COVER SHEET                        |
| C110  | GENERAL NOTES                            |
| C200  | DEMOLITION NOTES                         |
| C210  | DEMOLITION PLAN I                        |
| C211  | DEMOLITION PLAN II                       |
| C300  | EROSION CONTROL NOTES                    |
| C310  | EROSION CONTROL PLAN I                   |
| C311  | EROSION CONTROL PLAN II                  |
| C320  | EROSION CONTROL DETAILS                  |
| C400  | OVERALL SITE PLAN                        |
| C410  | SITE PLAN I                              |
| C411  | SITE PLAN II                             |
| C412  | SITE PLAN DETAILS                        |
| C420  | MANEUVERABILITY                          |
| C450  | FIRE ACCESS PLAN                         |
| C510  | PAVING, GRADING AND DRAINAGE PLAN        |
| C511  | PAVING, GRADING AND DRAINAGE PLAN II     |
| C512  | PAVING, GRADING AND DRAINAGE DETAILS     |
| C513  | PAVING, GRADING AND DRAINAGE DETAILS II  |
| C514  | PAVING, GRADING AND DRAINAGE DETAILS III |
| C515  | PAVING, GRADING AND DRAINAGE DETAILS IV  |
| C520  | RETENTION AREAS CROSS SECTION            |
| C521  | RETENTION AREAS CROSS SECTION            |
| C710  | WATER AND SEWER PLANS I                  |
| C711  | WATER AND SEWER PLANS II                 |
| C712  | INDIAN RIVER COUNTY WATER DETAILS        |
| C713  | INDIAN RIVER COUNTY WATER DETAILS        |
| C714  | INDIAN RIVER COUNTY WATER DETAILS        |
| C715  | INDIAN RIVER COUNTY WATER DETAILS        |
| C800  | LIGHTING PLAN                            |
| L000  | LANDSCAPE COVER SHEET                    |
| L100  | TREE DISPOSITION PLAN                    |
| L150  | TREE DISPOSITION NOTES & DETAILS         |
| L200  | LANDSCAPE PLAN                           |
| L201  | LANDSCAPE REQUIREMENTS                   |
| L250  | LANDSCAPE DETAILS                        |
| L251  | LANDSCAPE NOTES & SPECIFICATIONS         |
| L300  | IRRIGATION PLANS                         |
| L350  | IRRIGATION SPECIFICATIONS                |
| L351  | IRRIGATION SPECIFICATIONS                |
| L352  | IRRIGATION DETAILS                       |
| L353  | IRRIGATION DETAILS                       |
| LS101 | LIFE SAFETY PLAN                         |
| A001  | LEGEND AND GENERAL INFORMATION           |
| A101  | FLOOR PLAN                               |
| A102  | ROOF PLAN                                |
| A103  | CEILING PLAN                             |
| A201  | ELEVATIONS                               |
| A202  | ELEVATIONS                               |
| A203  | SECTIONS                                 |
| A401  | DETAILS                                  |
| A601  | ENLARGED PLANS & INTERIOR ELEVATIONS     |
| A602  | ENLARGED PLANS & INTERIOR ELEVATIONS     |
| A701  | WALL TYPES, DOOR & FINISH SCHEDULE       |
| A702  | WINDOW SCHEDULE AND DETAILS              |
| S000  | GENERAL NOTES AND SCHEDULES              |
| S101  | ELEVATION WIND PRESSURE DIAGRAMS         |
| S102  | ROOF WIND PRESSURE DIAGRAM               |
| S200  | FOUNDATION AND SLAB ON GRADE PLAN        |
| S201  | ROOF FRAMING PLAN                        |
| S300  | FOUNDATION SECTIONS                      |
| S301  | FOUNDATION SECTIONS                      |
| S400  | MASONRY AND ROOF SECTIONS                |
| M101  | MECHANICAL NOTES                         |
| M102  | MECHANICAL PLAN                          |
| M103  | MECHANICAL SCHEDULES                     |
| M104  | MECHANICAL DETAILS                       |
| P101  | PLUMBING LEGEND AND NOTES                |
| P102  | OVERALL PLUMBING PLAN                    |
| P103  | OVERALL SUPPLY RISER                     |
| P104  | OVERALL SANITARY RISER                   |
| P105  | PARTIAL PLUMBING SUPPLY PLAN             |
| P106  | PARTIAL PLUMBING SANITARY PLAN           |
| P107  | PLUMBING SCHEDULES AND DETAILS           |
| P108  | PLUMBING DETAILS                         |
| E000  | ELECTRICAL NOTES & DETAILS               |
| E101  | LIGHTING PLAN                            |
| E201  | ELECTRICAL PLAN                          |
| E300  | RISER DIAGRAM & PANEL SCHEDULES          |
| FP100 | DETAILS & NOTES                          |
| FP101 | FIRE PROTECTION PLAN - SECTION A         |
| FP102 | FIRE PROTECTION PLAN - SECTION B         |
| FP103 | HYDRAULIC SITE REFERENCE PLAN            |

PRE-ENGINEERED METAL BUILDING DRAWINGS  
SUBMITTED SEPARATELY

**CMK**  
Design Studio

CMK Design Studio, Inc.  
Planning & Design of the Built Environment

6822 22nd Ave. N. #148  
St. Petersburg, Florida 33710  
Ph: 813.362.6381

FL LIC. NO.: AA20002003  
marcos@cmkdesignstudio.com



MARCOS IBARGUEN  
AR 13117

Drawings Not Valid Unless Signed,  
Sealed & Dated by Registered Professional

THIS ITEM HAS BEEN ELECTRONICALLY SIGNED  
AND SEALED BY MARCOS  
IBARGUEN, ARCHITECT, ON THE DATE AND/OR  
TIME SHOWN USING A DIGITAL SIGNATURE.  
PRINTED COPIES OF THIS DOCUMENT ARE NOT  
CONSIDERED SIGNED AND SEALED AND THE  
SIGNATURE MUST BE VERIFIED ON ANY  
ELECTRONIC COPIES.

INDIAN RIVER COUNTY LANDFILL  
HOUSEHOLD HAZARDOUS WASTE  
AND RECYCLING FACILITY  
Indian River County, Florida

| NO. | REVISIONS                      | DATE     |
|-----|--------------------------------|----------|
| 1   | PLAN REVIEW & OWNER<br>CHANGES | 10/19/21 |

JOB NO.

**2016**

ISSUE DATE:


7/2/2021

DRAWN BY:

MI

SHEET TITLE  
**COVER  
SHEET**  
SHEET NO.  
**G000**

PERMIT SET

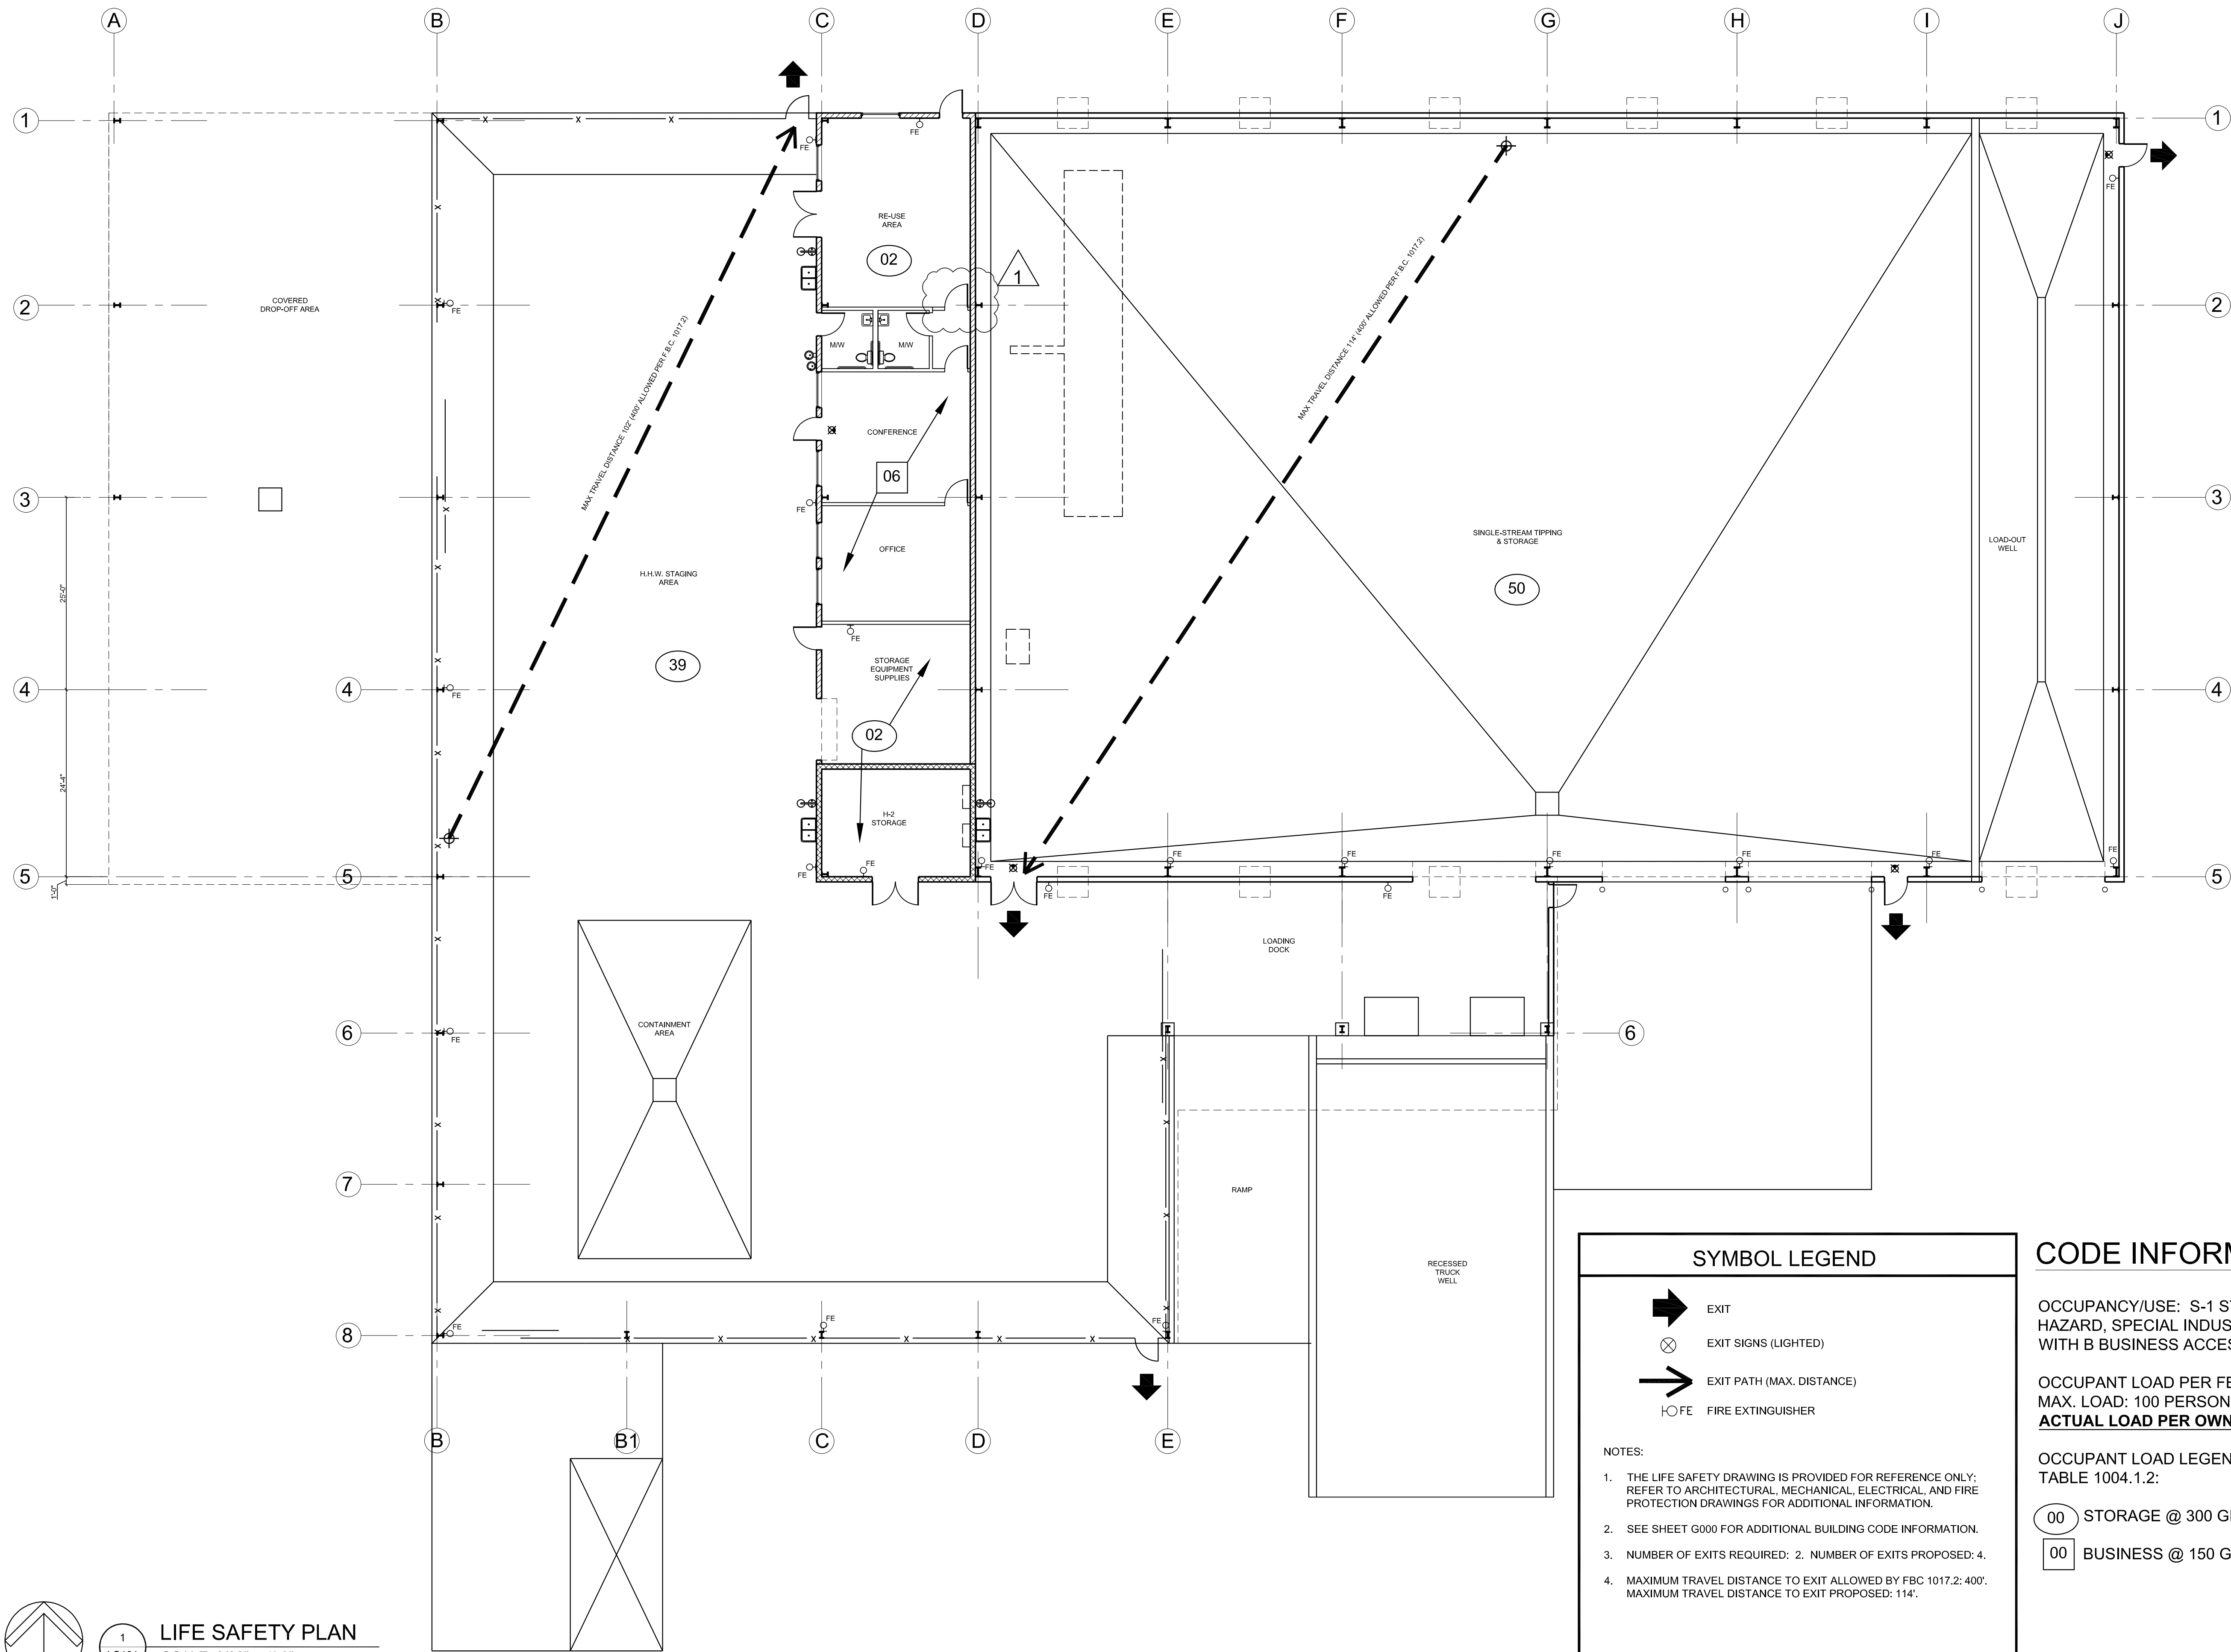

1  
LS101  
**LIFE SAFETY PLAN**  
SCALE: 3/32" = 1'-0"

**SYMBOL LEGEND**

- EXIT
- EXIT SIGNS (LIGHTED)
- EXIT PATH (MAX. DISTANCE)
- FIRE EXTINGUISHER

NOTES:

- THE LIFE SAFETY DRAWING IS PROVIDED FOR REFERENCE ONLY; REFER TO ARCHITECTURAL, MECHANICAL, ELECTRICAL, AND FIRE PROTECTION DRAWINGS FOR ADDITIONAL INFORMATION.
- SEE SHEET G000 FOR ADDITIONAL BUILDING CODE INFORMATION.
- NUMBER OF EXITS REQUIRED: 2. NUMBER OF EXITS PROPOSED: 4.
- MAXIMUM TRAVEL DISTANCE TO EXIT ALLOWED BY FBC 1017.2: 400'. MAXIMUM TRAVEL DISTANCE TO EXIT PROPOSED: 114'.

**CODE INFORMATION**

OCCUPANCY/USE: S-1 STORAGE - MODERATE HAZARD, SPECIAL INDUSTRIAL OCCUPANCY, WITH B BUSINESS ACCESSORY USE

OCCUPANT LOAD PER FBC 1004.5:  
MAX. LOAD: 100 PERSONS  
**ACTUAL LOAD PER OWNER: 10 PERSONS**

OCCUPANT LOAD LEGEND W/LOADS PER FBC TABLE 1004.1.2:

- 00 STORAGE @ 300 GROSS, 28,200/300 = 94
- 00 BUSINESS @ 150 GROSS, 790/150 = 6

PERMIT SET



CMK Design Studio, Inc.  
Planning & Design of the Built Environment  
6822 22nd Ave. N. #148  
St. Petersburg, Florida 33710  
Ph: 813.362.6381  
FL LIC. NO.: AA2002003  
marcos@cmkdesignstudio.com



MARCOS IBARCUIEN  
AR 13117  
Drawing Not Valid Unless Signed, Sealed & Dated by Registered Professional  
THIS ITEM HAS BEEN ELECTRONICALLY SIGNED AND SEALED BY MARCOS IBARCUIEN ARCHITECT, ON THE DATE AND/OR TIME SHOWN USING A DIGITAL SIGNATURE. PRINTED COPIES OF THIS DOCUMENT ARE NOT CONSIDERED SIGNED AND SEALED AND THE SIGNATURE MUST BE VERIFIED ON ANY ELECTRONIC COPIES.

INDIAN RIVER COUNTY LANDFILL HOUSEHOLD HAZARDOUS WASTE AND RECYCLING FACILITY  
Indian River County, Florida

| NO. | REVISIONS                   | DATE     |
|-----|-----------------------------|----------|
| 1   | PLAN REVIEW & OWNER CHANGES | 10/19/21 |

JOB NO.  
**2016**


ISSUE DATE:  
7/2/2021

DRAWN BY:  
MI

SHEET TITLE  
LIFE SAFETY PLAN

SHEET NO.  
**LS101**



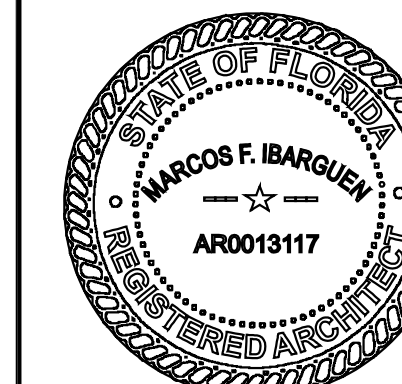

MARCOS IBARQUEN  
AR 13117

Sealed & Signed by Registered Professional  
THIS ITEM HAS BEEN ELECTRONICALLY SIGNED  
AND SEALED BY MARCOS  
IBARQUEN ARCHITECT, ON THE DATE AND/OR  
TIME SHOWN USING A DIGITAL SIGNATURE.  
PRINTED COPIES OF THIS DOCUMENT ARE NOT  
CONSIDERED SIGNED AND SEALED AND THE  
SIGNATURE MUST BE VERIFIED ON ANY  
ELECTRONIC COPIES.

**INDIAN RIVER COUNTY LANDFILL  
HOUSEHOLD HAZARDOUS WASTE  
AND RECYCLING FACILITY**  
Indian River County, Florida

| NO. | REVISIONS                   | DATE     |
|-----|-----------------------------|----------|
| 1   | PLAN REVIEW & OWNER CHANGES | 10/19/21 |

NO. 1  
10/19/21

JOB NO.  
**2016**


ISSUE DATE:  
7/2/2021

DRAWN BY:  
MI

SHEET TITLE  
FLOOR PLAN

SHEET NO.  
**A101**

PERMIT SET

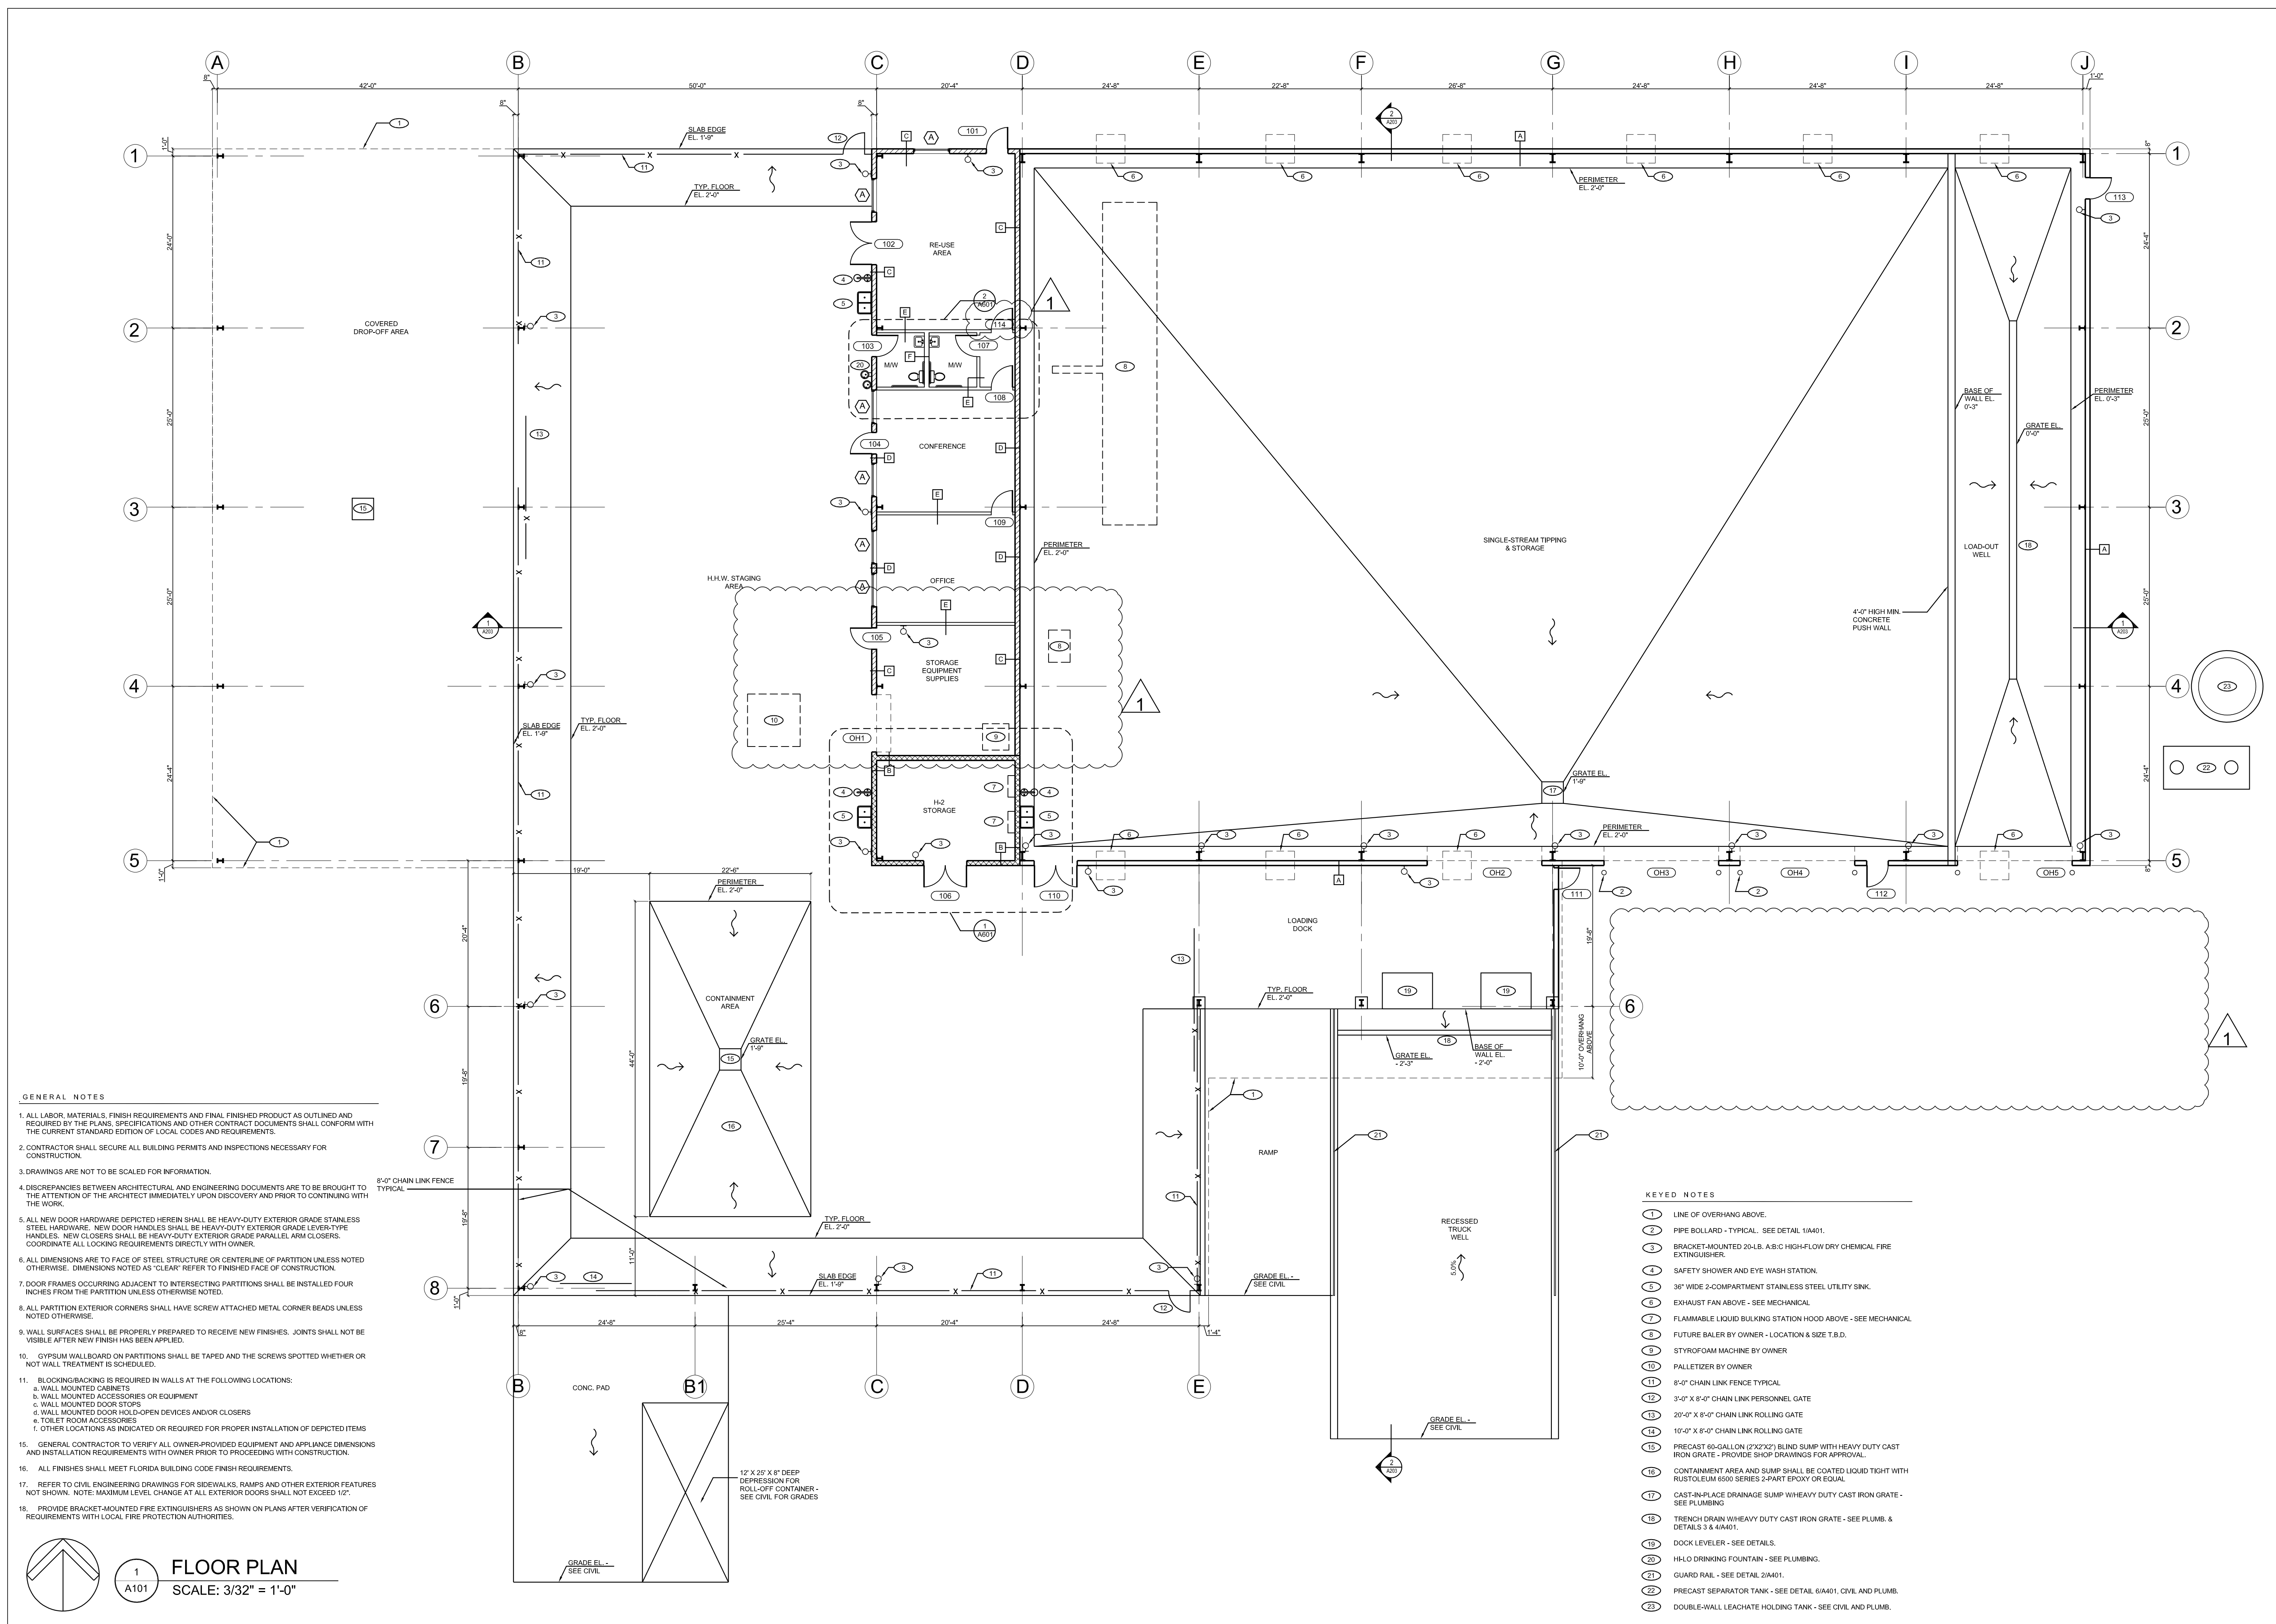


**GENERAL NOTES**

- ALL LABOR, MATERIALS, FINISH REQUIREMENTS AND FINAL FINISHED PRODUCT AS OUTLINED AND REQUIRED BY THE PLANS, SPECIFICATIONS AND OTHER CONTRACT DOCUMENTS SHALL CONFORM WITH THE CURRENT STANDARD EDITION OF LOCAL CODES AND REQUIREMENTS.
- CONTRACTOR SHALL SECURE ALL BUILDING PERMITS AND INSPECTIONS NECESSARY FOR CONSTRUCTION.
- DRAWINGS ARE NOT TO BE SCALED FOR INFORMATION.
- DISCREPANCIES BETWEEN ARCHITECTURAL AND ENGINEERING DOCUMENTS ARE TO BE BROUGHT TO THE ATTENTION OF THE ARCHITECT IMMEDIATELY UPON DISCOVERY AND PRIOR TO CONTINUING WITH THE WORK.
- ALL NEW DOOR HARDWARE DEPICTED HEREIN SHALL BE HEAVY-DUTY EXTERIOR GRADE STAINLESS STEEL HARDWARE. NEW DOOR HANDLES SHALL BE HEAVY-DUTY EXTERIOR GRADE LEVER-TYPE HANDLES. NEW CLOSERS SHALL BE HEAVY-DUTY EXTERIOR GRADE PARALLEL ARM CLOSERS. COORDINATE ALL LOCKING REQUIREMENTS DIRECTLY WITH OWNER.
- ALL DIMENSIONS ARE TO FACE OF STEEL STRUCTURE OR CENTERLINE OF PARTITION UNLESS NOTED OTHERWISE. DIMENSIONS NOTED AS "CLEAR" REFER TO FINISHED FACE OF CONSTRUCTION.
- DOOR FRAMES OCCURRING ADJACENT TO INTERSECTING PARTITIONS SHALL BE INSTALLED FOUR INCHES FROM THE PARTITION UNLESS OTHERWISE NOTED.
- ALL PARTITION EXTERIOR CORNERS SHALL HAVE SCREW ATTACHED METAL CORNER BEADS UNLESS NOTED OTHERWISE.
- WALL SURFACES SHALL BE PROPERLY PREPARED TO RECEIVE NEW FINISHES. JOINTS SHALL NOT BE VISIBLE AFTER NEW FINISH HAS BEEN APPLIED.
- CYSIUM WALLBOARD ON PARTITIONS SHALL BE TAPED AND THE SCREWS SPOTTED WHETHER OR NOT WALL TREATMENT IS SCHEDULED.
- BLOCKING/BACKING IS REQUIRED IN WALLS AT THE FOLLOWING LOCATIONS:
  - WALL MOUNTED CABINETS
  - WALL MOUNTED EQUIPMENT OR EQUIPMENT
  - WALL MOUNTED DOOR STOPS
  - WALL MOUNTED DOOR HOLD-OPEN DEVICES AND/OR CLOSERS
  - TOILET ROOM ACCESSORIES
 1. OTHER LOCATIONS AS INDICATED OR REQUIRED FOR PROPER INSTALLATION OF DEPICTED ITEMS
- GENERAL CONTRACTOR TO VERIFY ALL OWNER-PROVIDED EQUIPMENT AND APPLIANCE DIMENSIONS AND INSTALLATION REQUIREMENTS WITH OWNER PRIOR TO PROCEEDING WITH CONSTRUCTION.
- ALL FINISHES SHALL MEET FLORIDA BUILDING CODE FINISH REQUIREMENTS.
- REFER TO CIVIL ENGINEERING DRAWINGS FOR SIDEWALKS, RAMPS AND OTHER EXTERIOR FEATURES NOT SHOWN. NOTE: MAXIMUM LEVEL CHANGE AT ALL EXTERIOR DOORS NOT EXCEED 1/2".
- PROVIDE BRACKET-MOUNTED FIRE EXTINGUISHERS AS SHOWN ON PLANS AFTER VERIFICATION OF REQUIREMENTS WITH LOCAL FIRE PROTECTION AUTHORITIES.

**KEYED NOTES**

- LINE OF OVERHANG ABOVE.
- PIPE BOLLARD - TYPICAL. SEE DETAIL 1/A401.
- BRACKET MOUNTED 20-LB. A/B/C HIGH-FLOW DRY CHEMICAL FIRE EXTINGUISHER.
- SAFETY SHOWER AND EYE WASH STATION.
- 36" WIDE 2-COMPARTMENT STAINLESS STEEL UTILITY SINK.
- EXHAUST FAN ABOVE - SEE MECHANICAL.
- FLAMMABLE LIQUID BULKING STATION HOOD ABOVE - SEE MECHANICAL.
- FUTURE BALER BY OWNER - LOCATION & SIZE T.B.D.
- STYROFOAM MACHINE BY OWNER.
- PALLETIZER BY OWNER.
- 8'-0" CHAIN LINK FENCE TYPICAL.
- 3'-0" X 8'-0" CHAIN LINK PERSONNEL GATE.
- 20'-0" X 8'-0" CHAIN LINK ROLLING GATE.
- 10'-0" X 8'-0" CHAIN LINK ROLLING GATE.
- PRECAST 60-GALLON (2'X2'X2') BLIND SUMP WITH HEAVY DUTY CAST IRON GRATE - PROVIDE SHOP DRAWINGS FOR APPROVAL.
- CONTAINMENT AREA AND SUMP SHALL BE COATED LIQUID TIGHT WITH RUSTOLEUM 6500 SERIES 2-PART EPOXY OR EQUAL.
- CAST-IN-PLACE DRAINAGE SUMP W/HEAVY DUTY CAST IRON GRATE - SEE PLUMBING.
- TRENCH DRAIN W/HEAVY DUTY CAST IRON GRATE - SEE PLUMB. & DETAILS 3 & 4/A401.
- DOCK LEVELER - SEE DETAILS.
- H2O DRINKING FOUNTAIN - SEE PLUMBING.
- GUARD RAIL - SEE DETAIL 2/A401.
- PRECAST SEPARATOR TANK - SEE DETAIL 6/A401. CIVIL AND PLUMB.
- DOUBLE-WALL LEACHATE HOLDING TANK - SEE CIVIL AND PLUMB.

**FLOOR PLAN**  
SCALE: 3/32" = 1'-0"

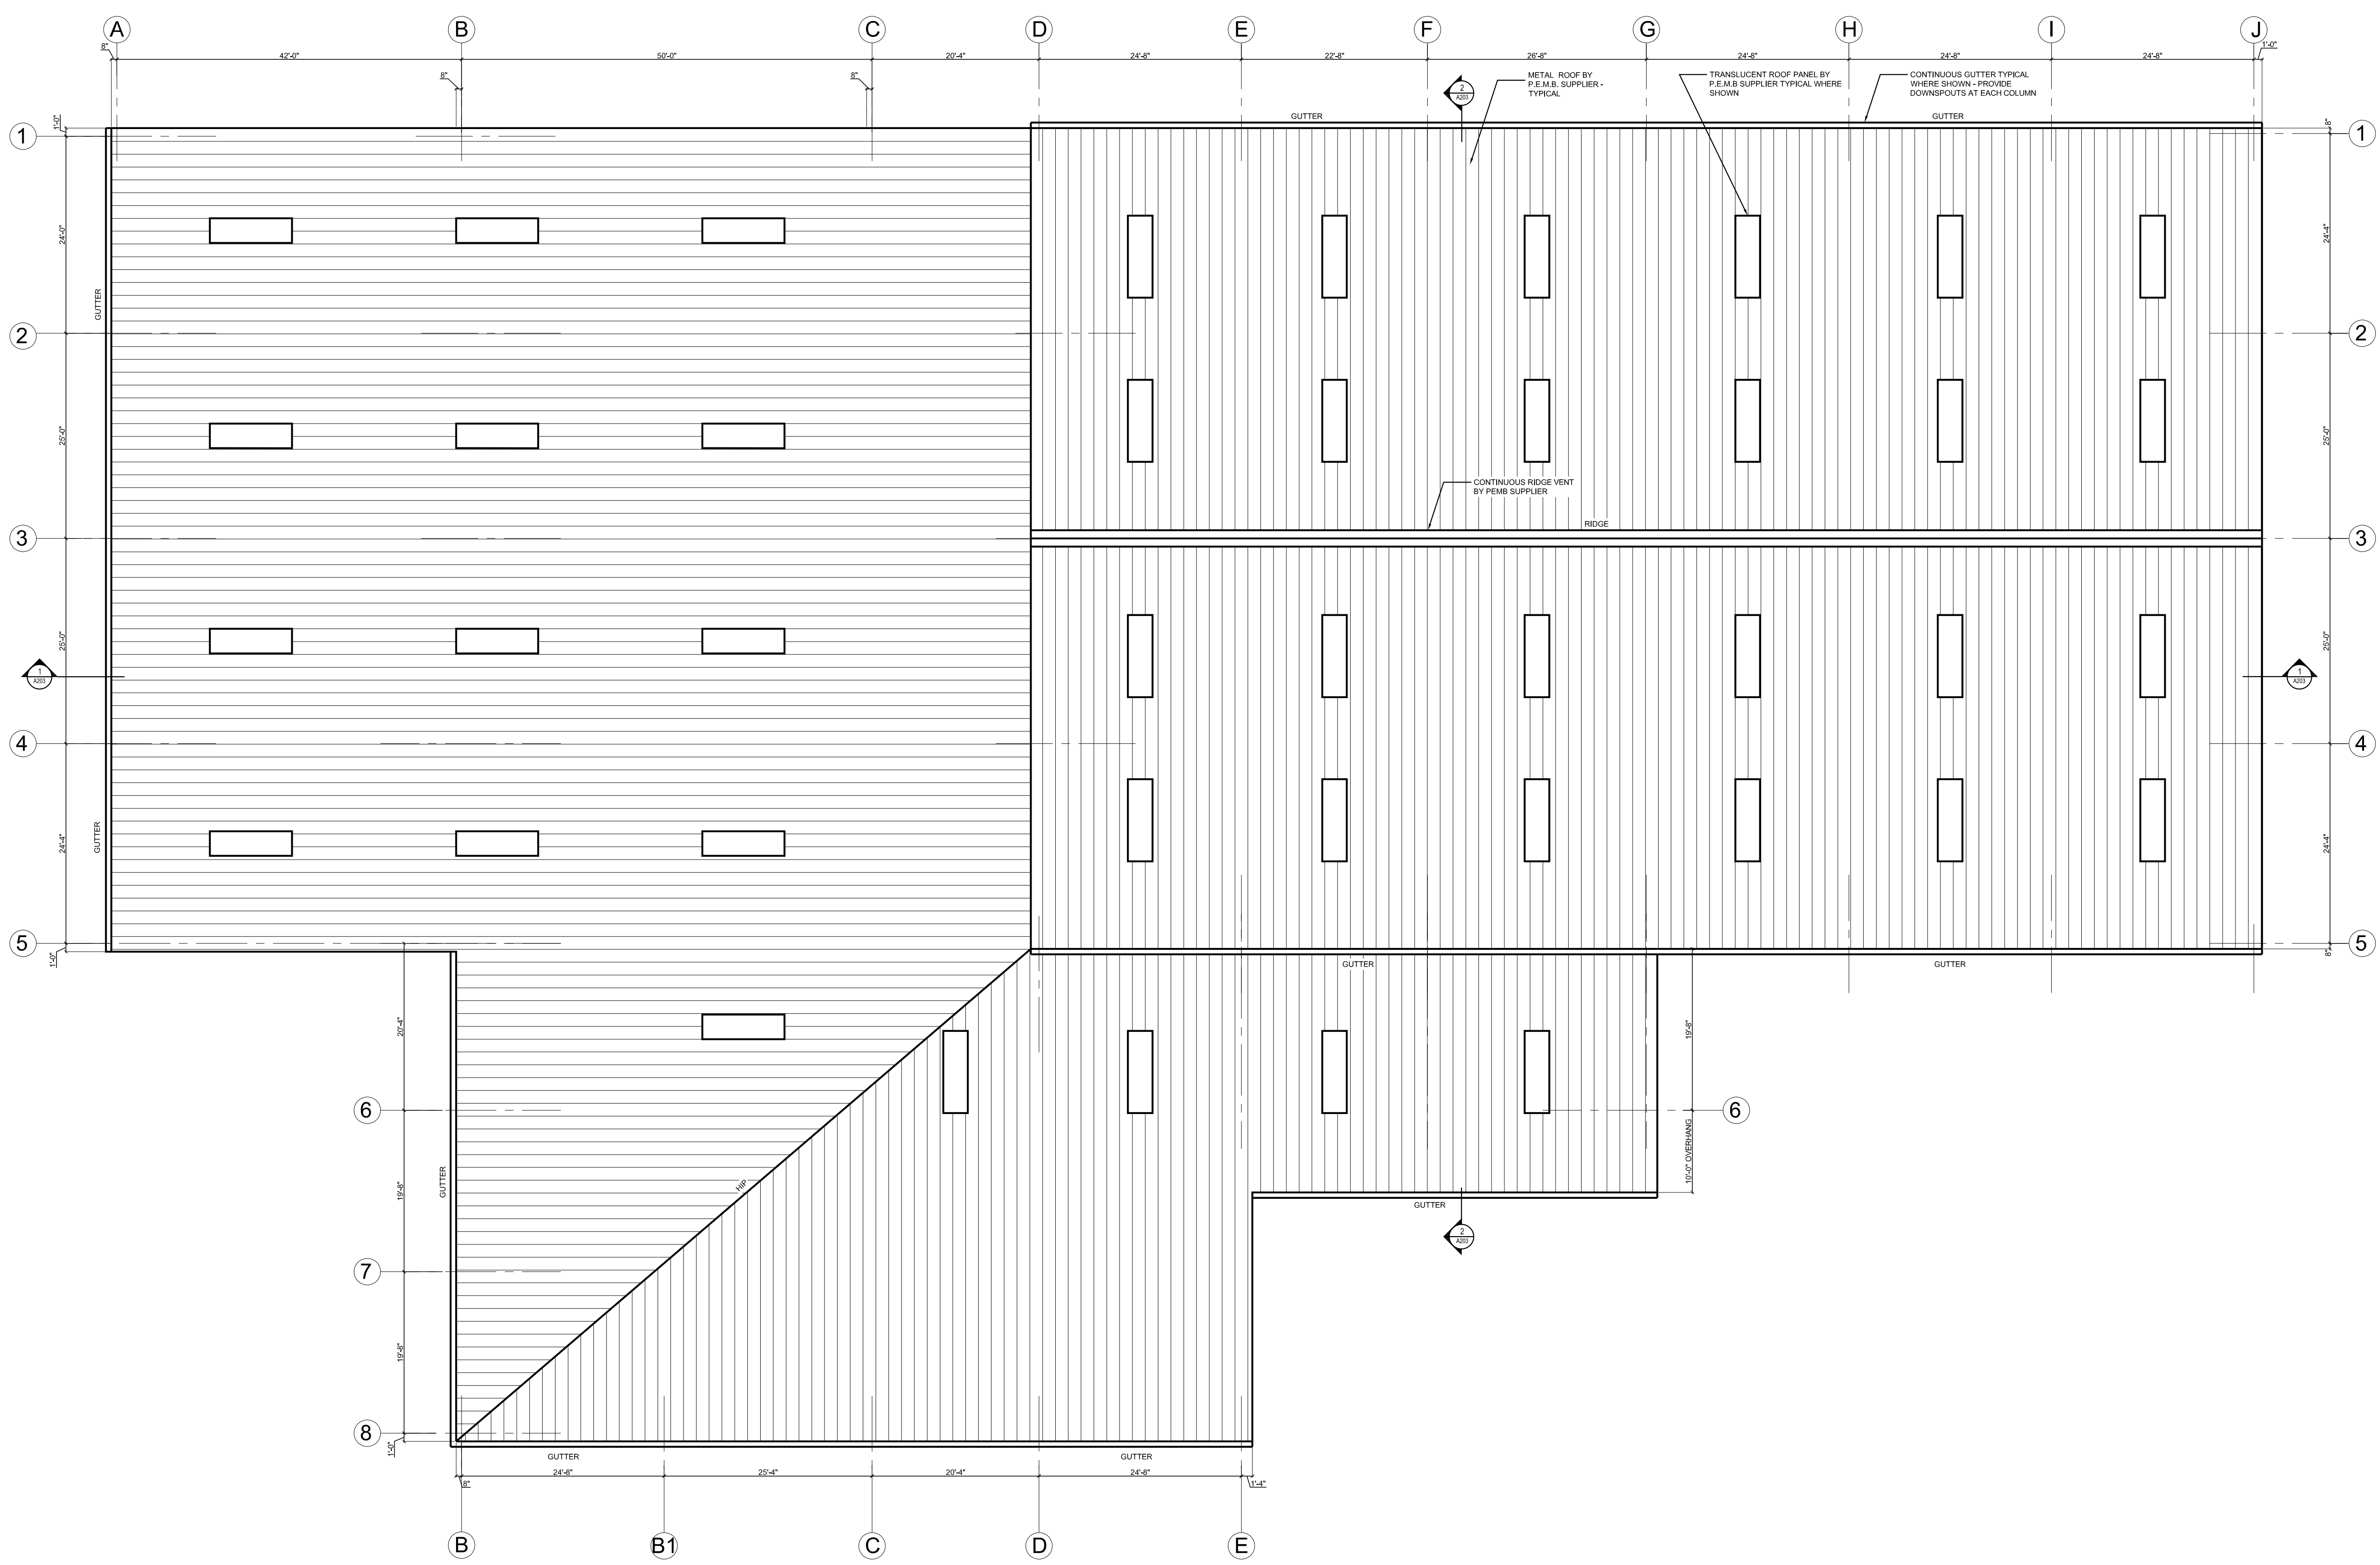

**CMK Design Studio, Inc.**  
 Planning & Design of the Built Environment  
 6822 22nd Ave. N. #148  
 St. Petersburg, Florida 33710  
 Ph: 813.362.6381  
 FL LIC. NO.: AA20002003  
 marcos@cmkdesignstudio.com



**MARCOS IBARQUEN**  
 AR 13117  
Drawing Not Valid Unless Signed, Sealed & Dated by Registered Professional  
 THIS ITEM HAS BEEN ELECTRONICALLY SIGNED AND SEALED BY MARCOS IBARQUEN ARCHITECT, ON THE DATE AND/OR TIME SHOWN USING A DIGITAL SIGNATURE. PRINTED COPIES OF THIS DOCUMENT ARE NOT CONSIDERED SIGNED AND SEALED AND THE SIGNATURE MUST BE VERIFIED ON ANY ELECTRONIC COPIES.

**INDIAN RIVER COUNTY LANDFILL  
 HOUSEHOLD HAZARDOUS WASTE  
 AND RECYCLING FACILITY**  
 Indian River County, Florida

| NO. | REVISIONS | DATE |
|-----|-----------|------|
|     |           |      |
|     |           |      |
JOB NO.  
**2016**  
 ISSUE DATE:  
 7/2/2021  
 DRAWN BY:  
 MI

SHEET TITLE  
 ROOF PLAN  
 SHEET NO.  
**A102**

**PERMIT SET**



THIS ITEM HAS BEEN ELECTRONICALLY SIGNED  
AND SEALED BY MARCOS  
IBARCUIEN ARCHITECT, ON THE DATE AND/OR  
TIME SHOWN USING A DIGITAL SIGNATURE.  
PRINTED COPIES OF THIS DOCUMENT ARE NOT  
CONSIDERED SIGNED AND SEALED AND THE  
SIGNATURE MUST BE VERIFIED ON ANY  
ELECTRONIC COPIES.

**INDIAN RIVER COUNTY LANDFILL  
HOUSEHOLD HAZARDOUS WASTE  
AND RECYCLING FACILITY**  
Indian River County, Florida

| NO. | REVISIONS                      | DATE     |
|-----|--------------------------------|----------|
| 1   | PLAN REVIEW & OWNER<br>CHANGES | 10/19/21 |

JOB NO.  
**2016**


ISSUE DATE:  
7/2/2021

DRAWN BY:  
MI

SHEET TITLE  
CEILING PLAN

SHEET NO.  
**A103**

PERMIT SET

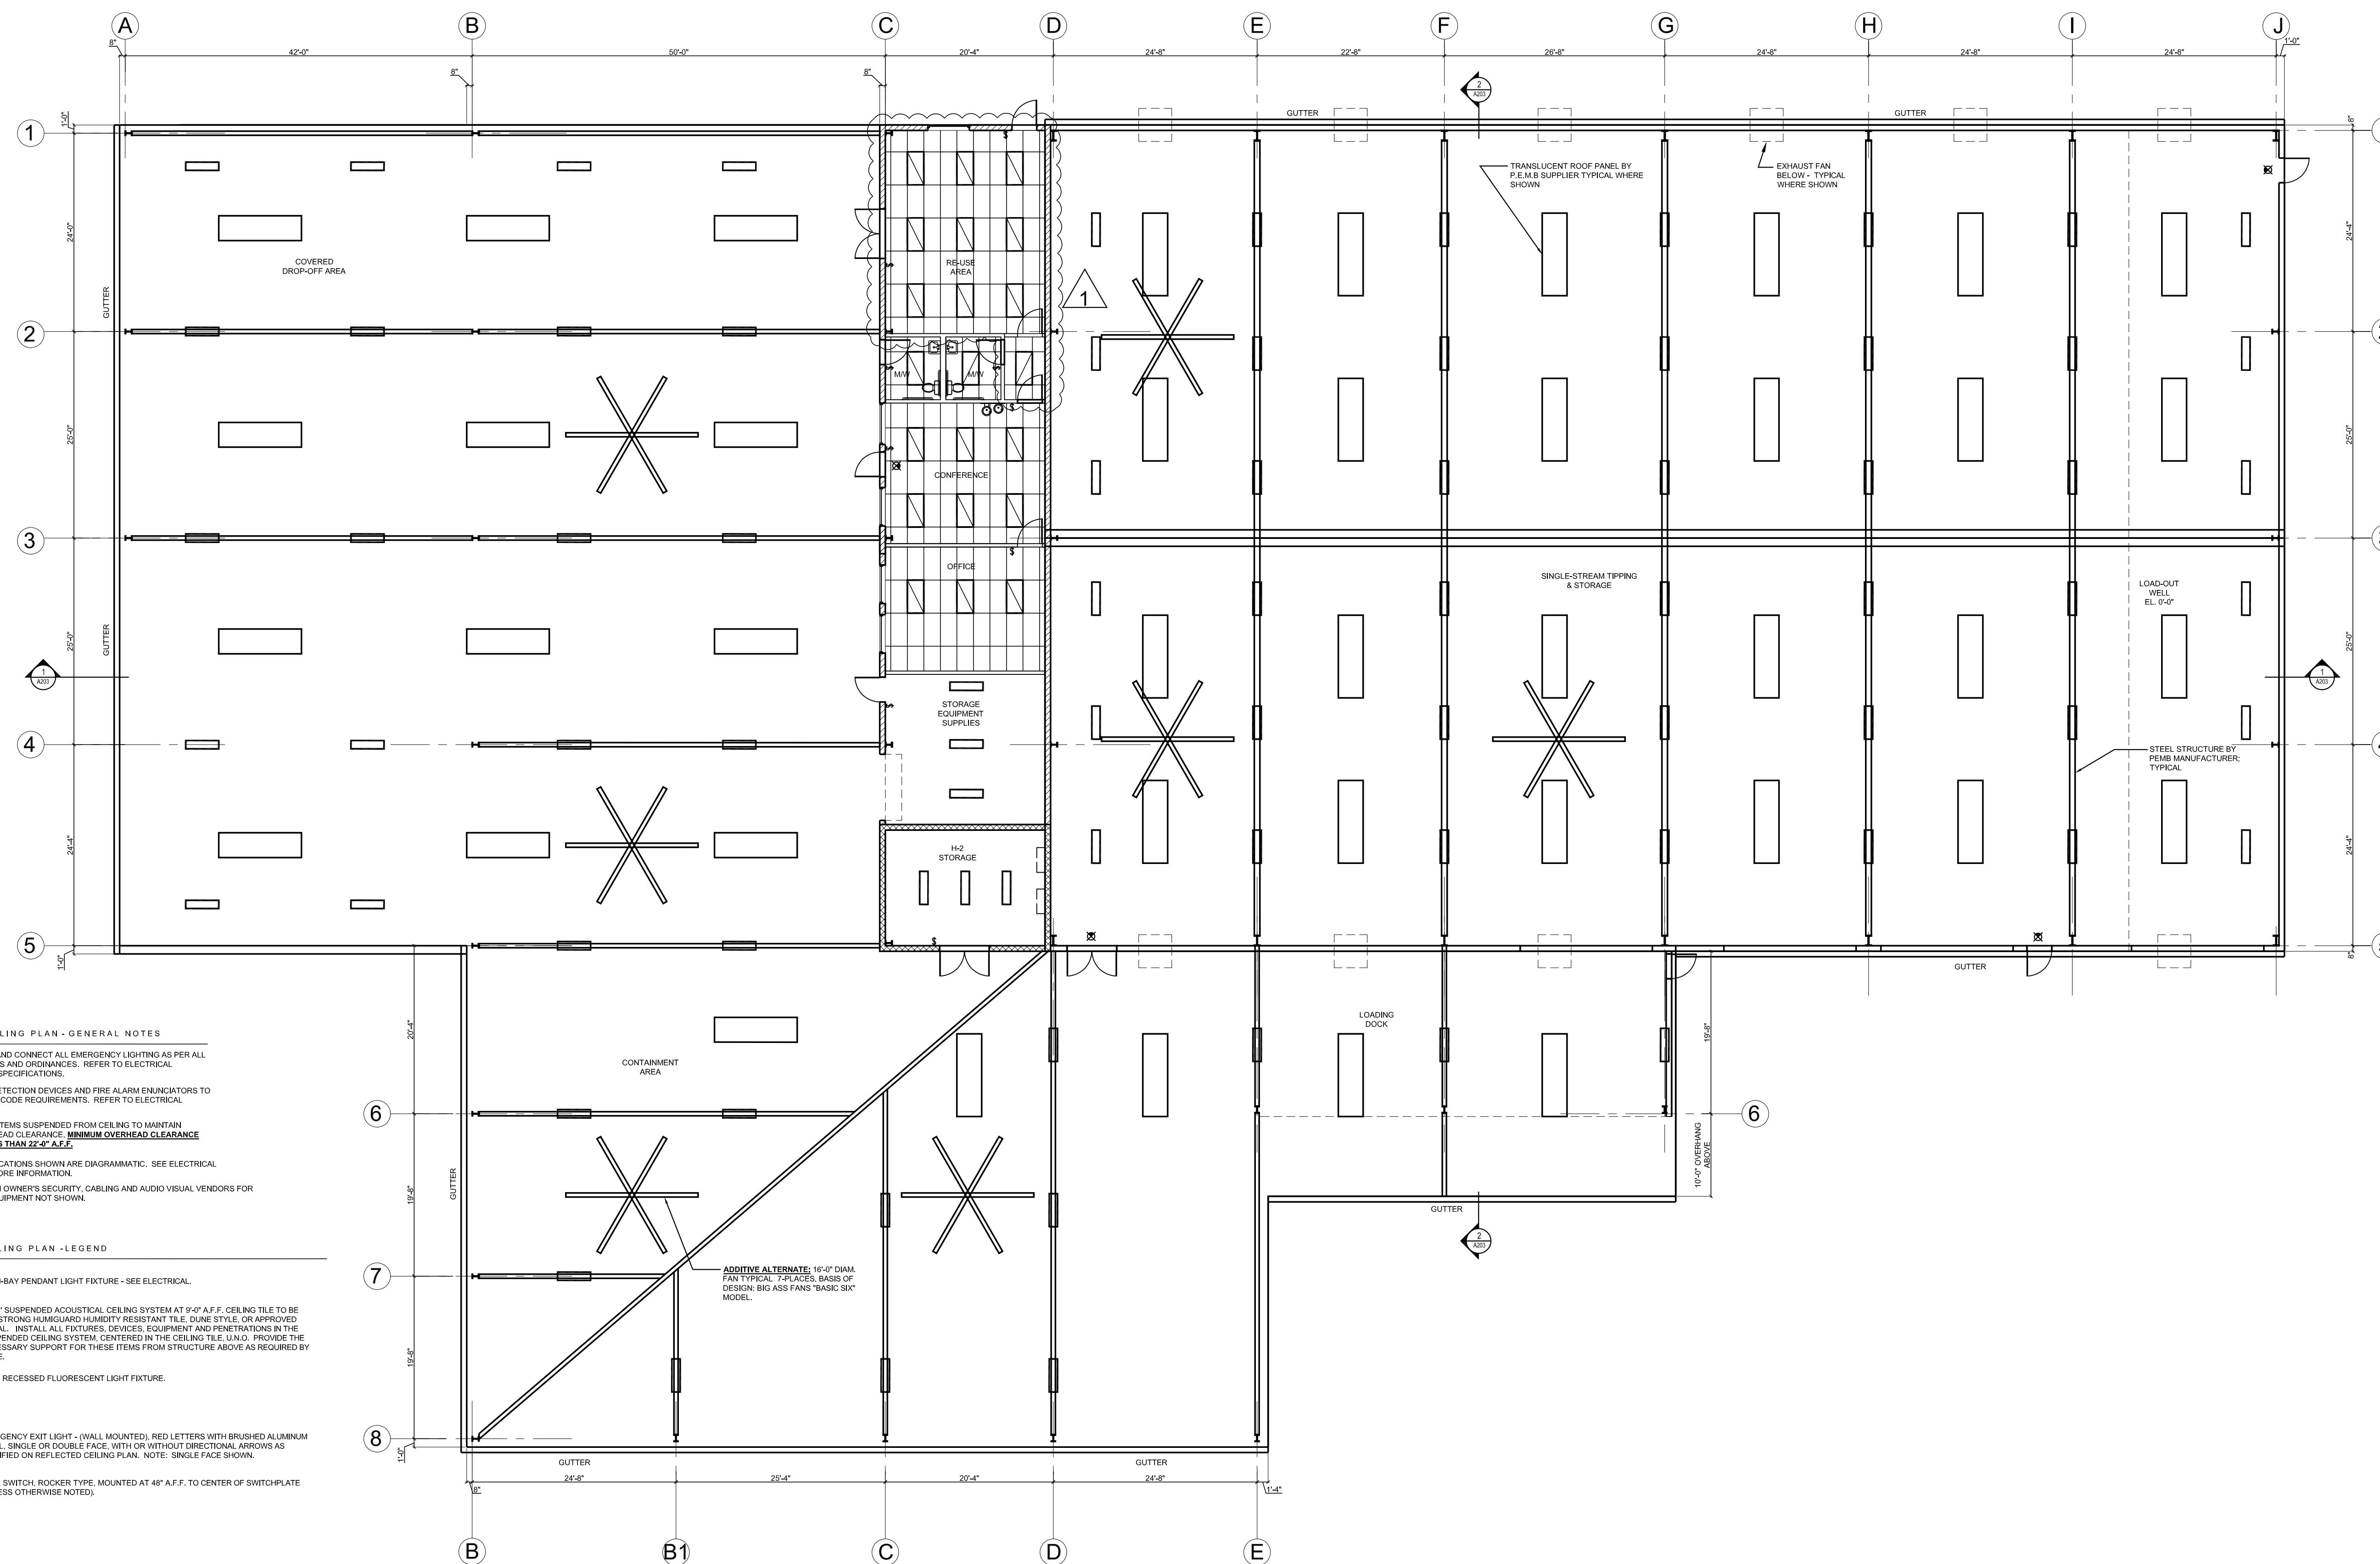


**REFLECTED CEILING PLAN - GENERAL NOTES**

- SUPPLY, INSTALL AND CONNECT ALL EMERGENCY LIGHTING AS PER ALL APPLICABLE CODES AND ORDINANCES. REFER TO ELECTRICAL DOCUMENTS FOR SPECIFICATIONS.
- INSTALL SMOKE DETECTION DEVICES AND FIRE ALARM INDICATORS TO COMPLY WITH ALL CODE REQUIREMENTS. REFER TO ELECTRICAL DOCUMENTS.
- COORDINATE ALL ITEMS SUSPENDED FROM CEILING TO MAINTAIN REQUIRED OVERHEAD CLEARANCE. **MINIMUM OVERHEAD CLEARANCE SHALL BE NO LESS THAN 22'-0" A.F.F.**
- LIGHT FIXTURE LOCATIONS SHOWN ARE DIAGRAMMATIC. SEE ELECTRICAL DRAWINGS FOR MORE INFORMATION.
- COORDINATE WITH OWNER'S SECURITY, CABLING AND AUDIO VISUAL VENDORS FOR LOCATIONS OF EQUIPMENT NOT SHOWN.


**REFLECTED CEILING PLAN - LEGEND**

- HIGH-BAY PENDANT LIGHT FIXTURE - SEE ELECTRICAL.
- 2' x 4' SUSPENDED ACOUSTICAL CEILING SYSTEM AT 9'-0" A.F.F. CEILING TILE TO BE ARMSTRONG HURRICANE HURDLE RESISTANT TILE, DUNE STYLE, OR APPROVED EQUAL. INSTALL ALL FIXTURES, DEVICES, EQUIPMENT AND PENETRATIONS IN THE SUSPENDED CEILING SYSTEM, CENTERED IN THE CEILING TILE UNLESS OTHERWISE NOTED. PROVIDE THE NECESSARY SUPPORT FOR THESE ITEMS FROM STRUCTURE ABOVE AS REQUIRED BY CODE.
- 2' x 4' RECESSED FLUORESCENT LIGHT FIXTURE.
- EMERGENCY EXIT LIGHT - (WALL MOUNTED), RED LETTERS WITH BRUSHED ALUMINUM PANEL, SINGLE OR DOUBLE FACE, WITH OR WITHOUT DIRECTIONAL ARROWS AS SPECIFIED ON REFLECTED CEILING PLAN. NOTE: SINGLE FACE SHOWN.
- WALL SWITCH, ROCKER TYPE, MOUNTED AT 48" A.F.F. TO CENTER OF SWITCHPLATE (UNLESS OTHERWISE NOTED).

1  
A103 **CEILING PLAN**  
SCALE: 3/32" = 1'-0"

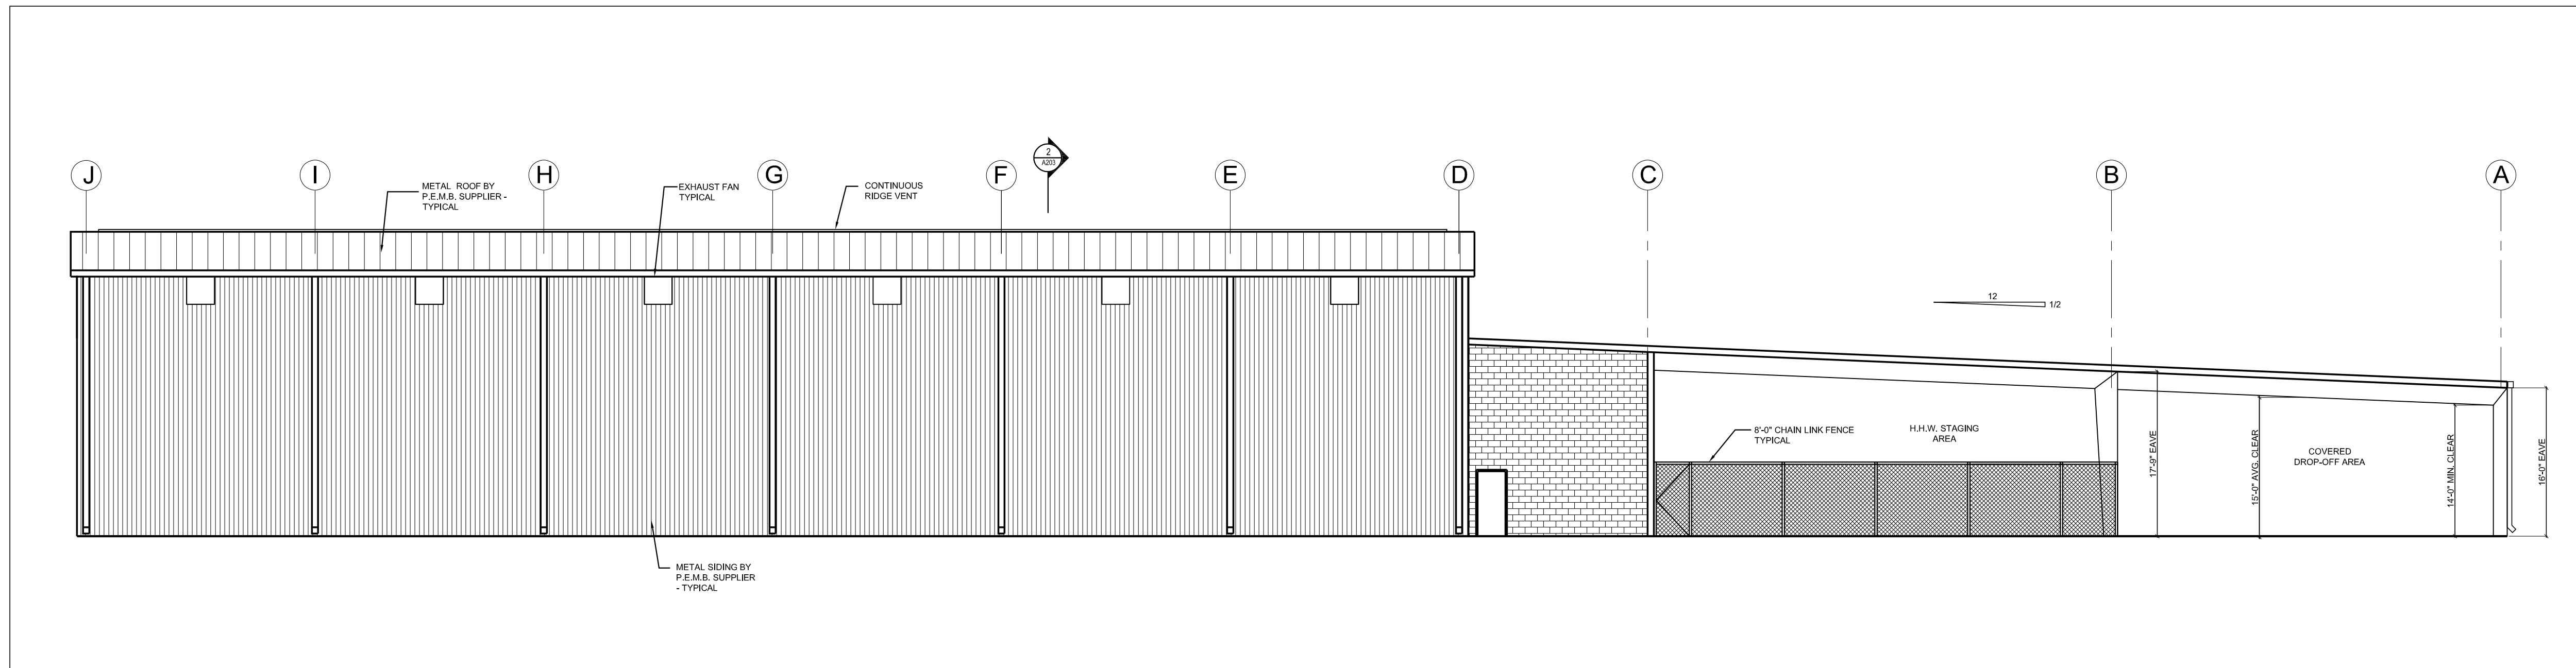


1 NORTH ELEVATION  
 SCALE: 3/32" = 1'-0"

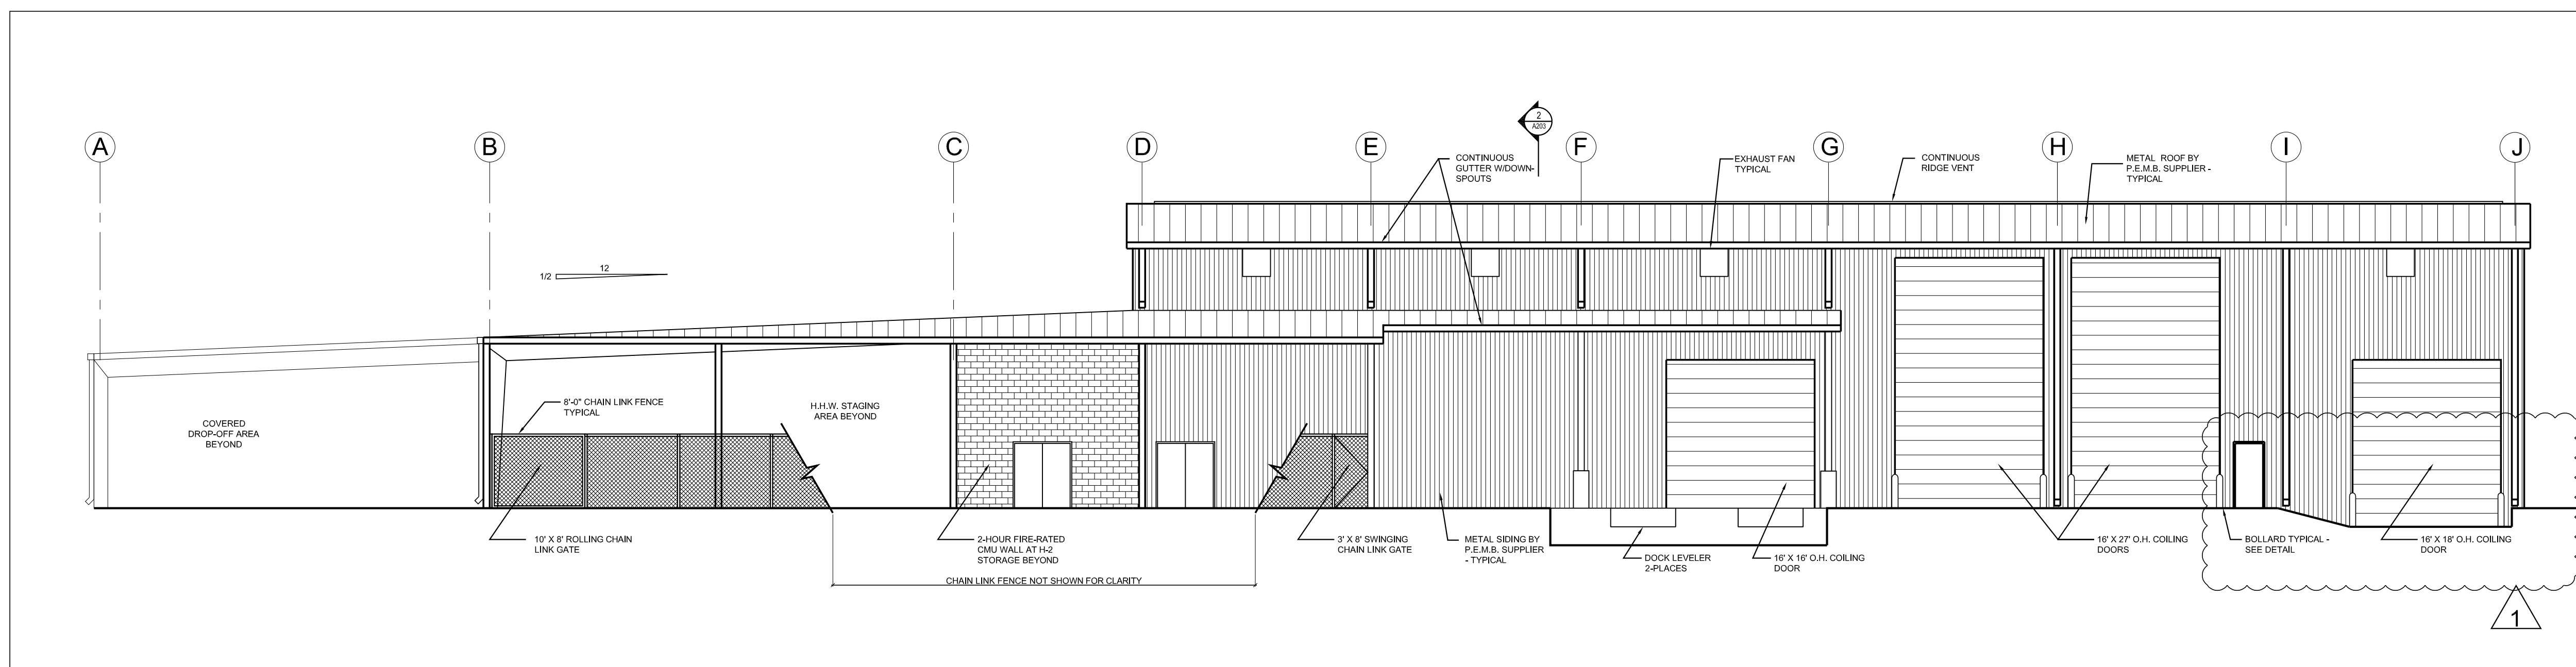

2 SOUTH ELEVATION  
 SCALE: 3/32" = 1'-0"



CMK Design Studio, Inc.  
 Planning & Design of the Built Environment  
 6822 22nd Ave. N. #148  
 St. Petersburg, Florida 33710  
 Ph: 813.362.6381  
 FL LIC. NO.: AA2002003  
 marcos@cmkdesignstudio.com

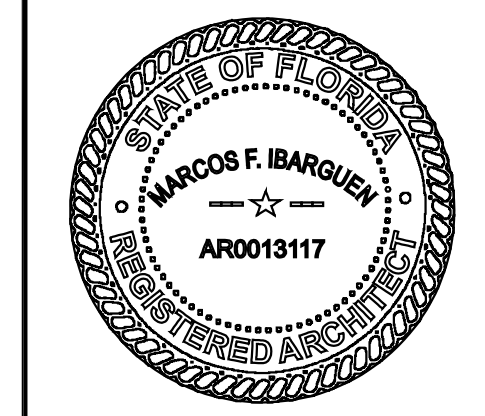

MARCOS IBARCUIEN  
 AR 13117  
 Drawing Not Valid Unless Signed,  
 Sealed & Dated by Registered Professional  
 THIS ITEM HAS BEEN ELECTRONICALLY SIGNED  
 AND SEALED BY MARCOS  
 IBARCUIEN ARCHITECT, ON THE DATE AND/OR  
 TIME SHOWN USING A DIGITAL SIGNATURE.  
 PRINTED COPIES OF THIS DOCUMENT ARE NOT  
 CONSIDERED SIGNED AND SEALED AND THE  
 SIGNATURE MUST BE VERIFIED ON ANY  
 ELECTRONIC COPIES.


INDIAN RIVER COUNTY LANDFILL  
 HOUSEHOLD HAZARDOUS WASTE  
 AND RECYCLING FACILITY  
 Indian River County, Florida

| NO. | REVISIONS                   | DATE     |
|-----|-----------------------------|----------|
| 1   | PLAN REVIEW & OWNER CHANGES | 10/19/21 |
|     |                             |          |
|     |                             |          |
|     |                             |          |
|     |                             |          |


JOB NO.  
**2016**  
 ISSUE DATE:  
 7/2/2021  
 DRAWN BY:  
 MI

SHEET TITLE  
 ELEVATIONS  
 SHEET NO.  
**A201**


PERMIT SET

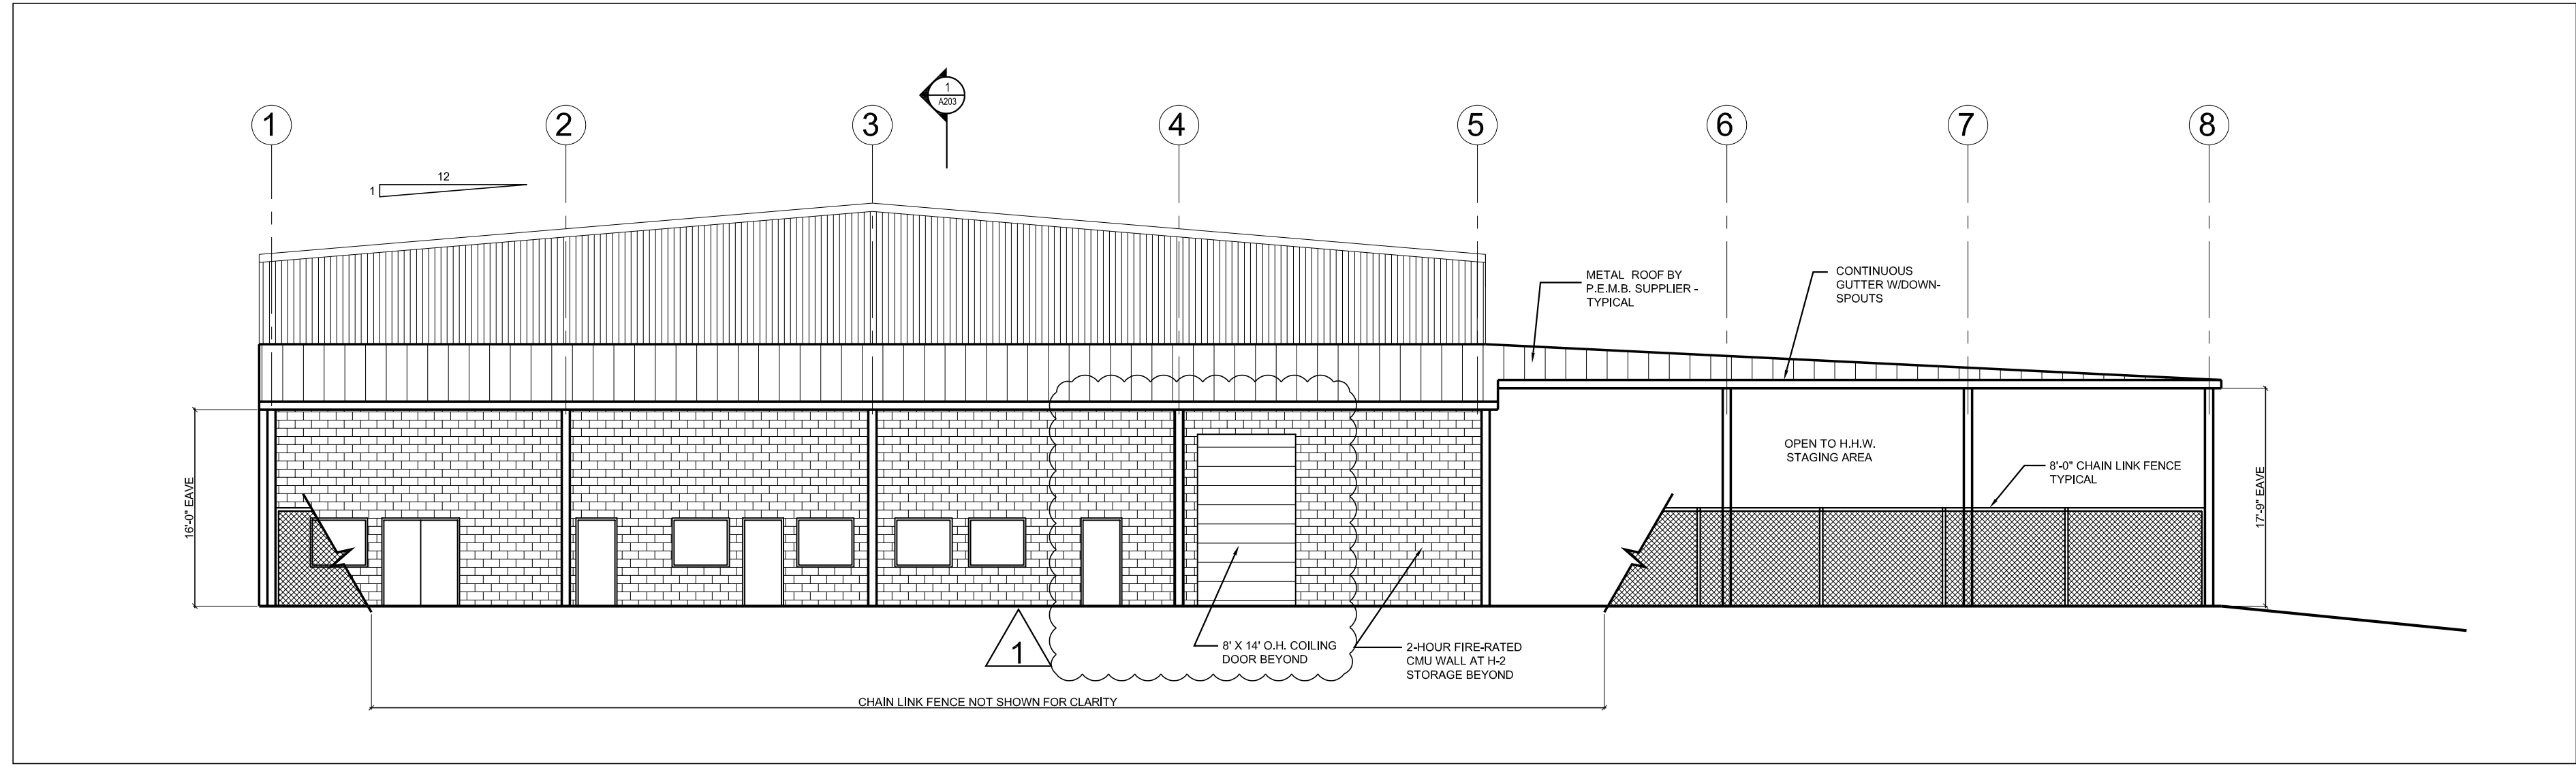

1 WEST ELEVATION (WEATHER SCREEN NOT SHOWN)  
SCALE: 3/32" = 1'-0"

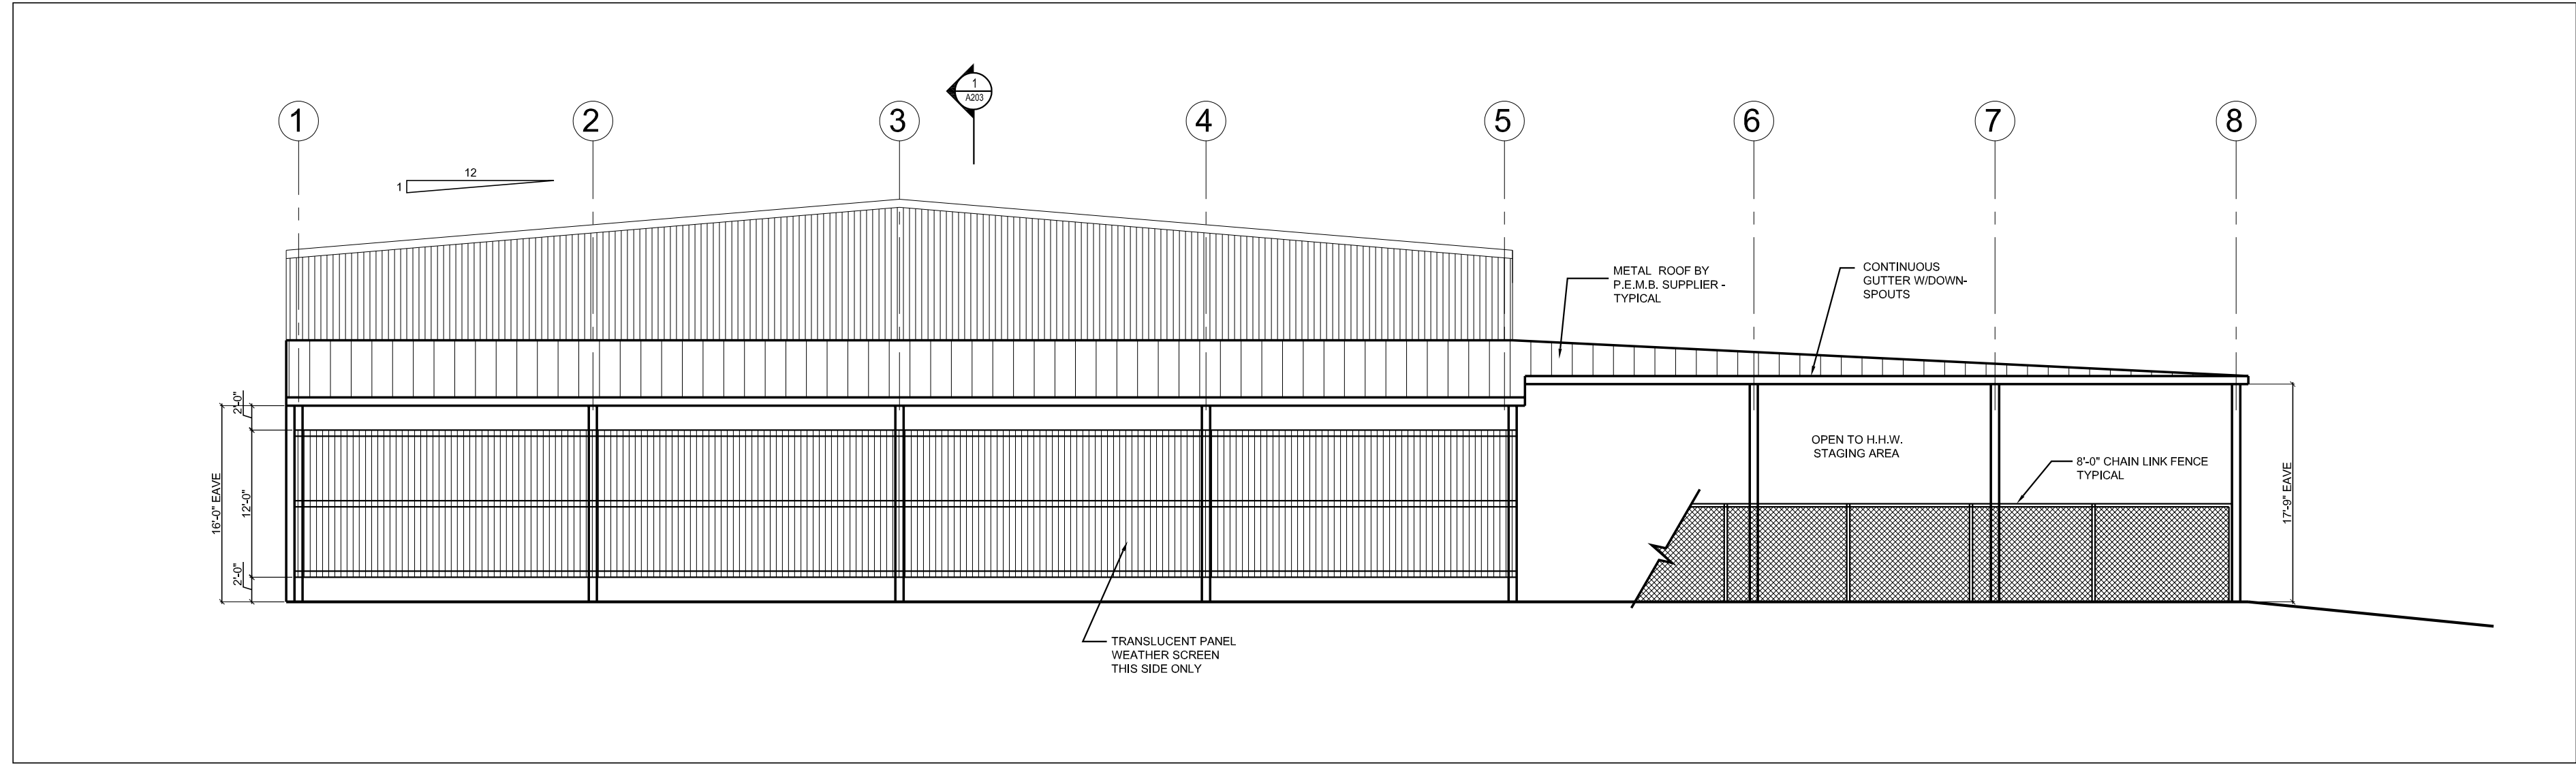

2 WEST ELEVATION (WITH WEATHER SCREEN)  
SCALE: 3/32" = 1'-0"

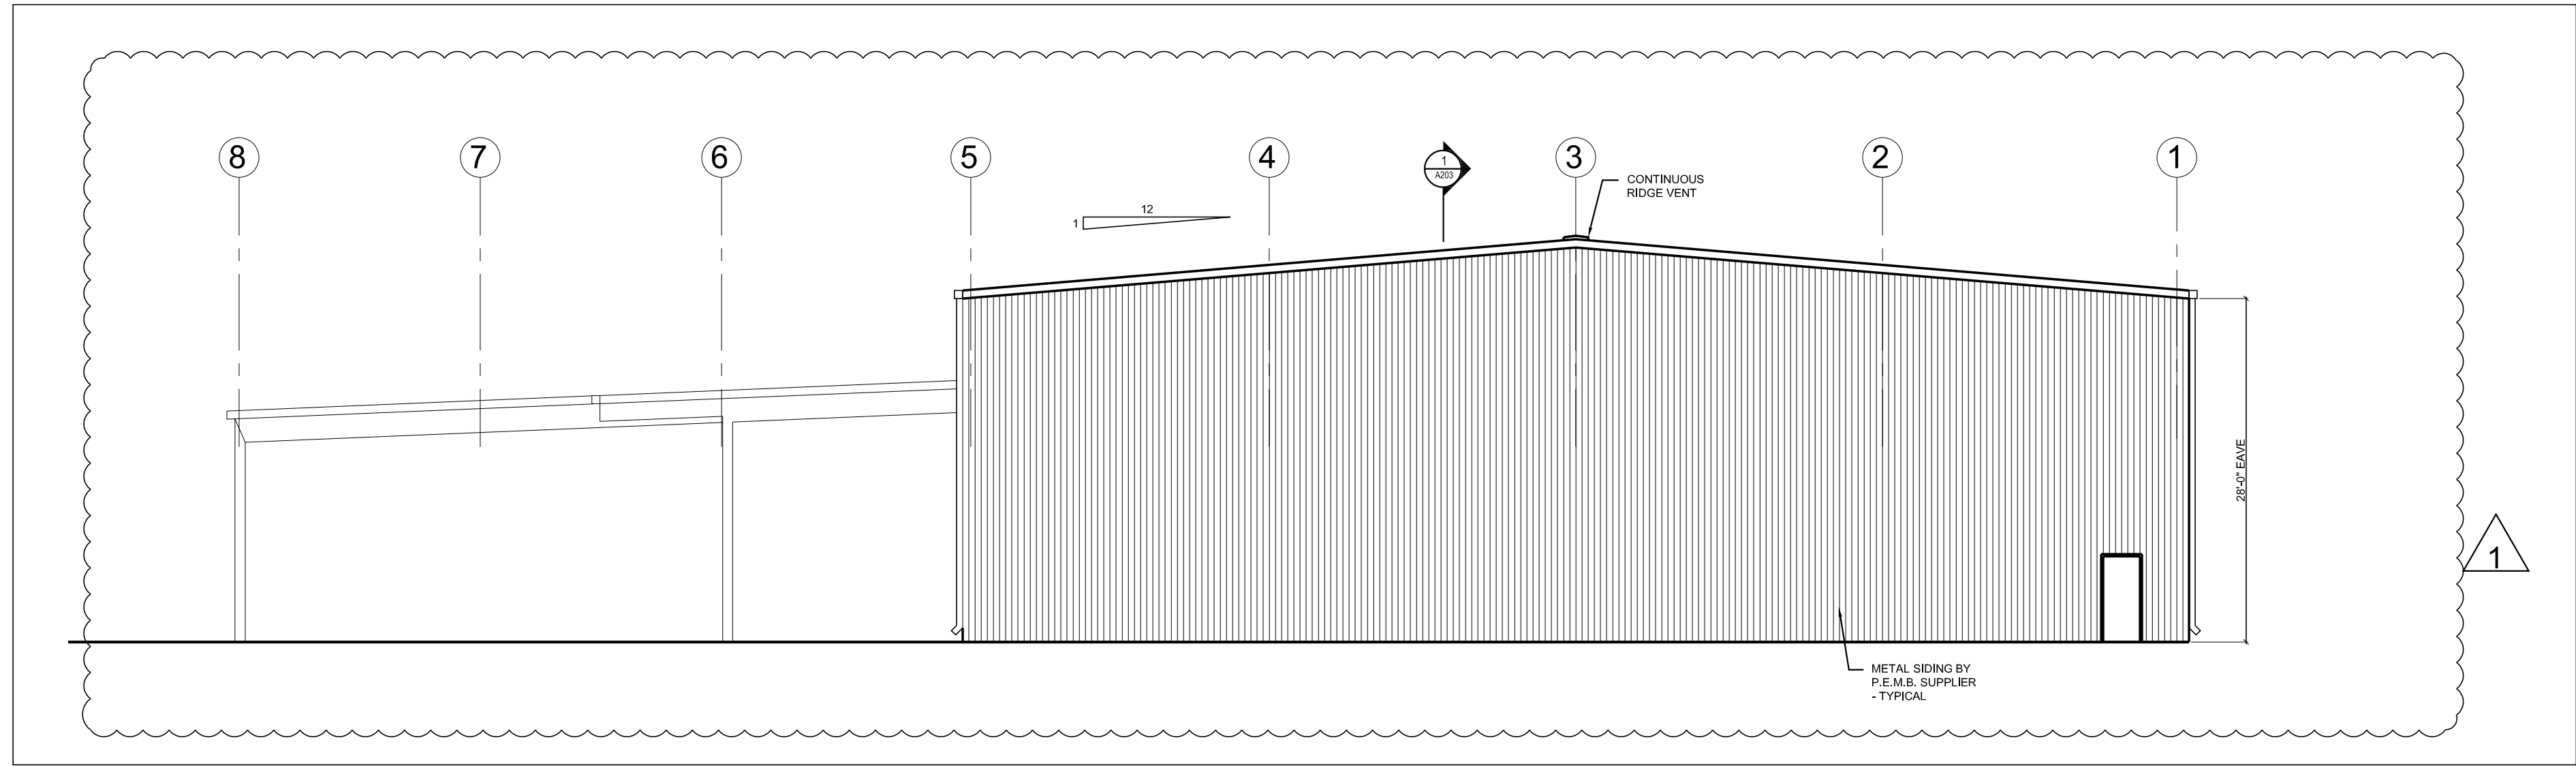

3 EAST ELEVATION  
SCALE: 3/32" = 1'-0"



INDIAN RIVER COUNTY LANDFILL  
HOUSEHOLD HAZARDOUS WASTE  
AND RECYCLING FACILITY  
Indian River County, Florida

| NO. | REVISIONS                   | DATE     |
|-----|-----------------------------|----------|
| 1   | PLAN REVIEW & OWNER CHANGES | 10/19/21 |

JOB NO.

**2016**

ISSUE DATE:

7/2/2021

DRAWN BY:

MI


PERMIT SET

SHEET TITLE  
ELEVATIONS


SHEET NO.

**A202**



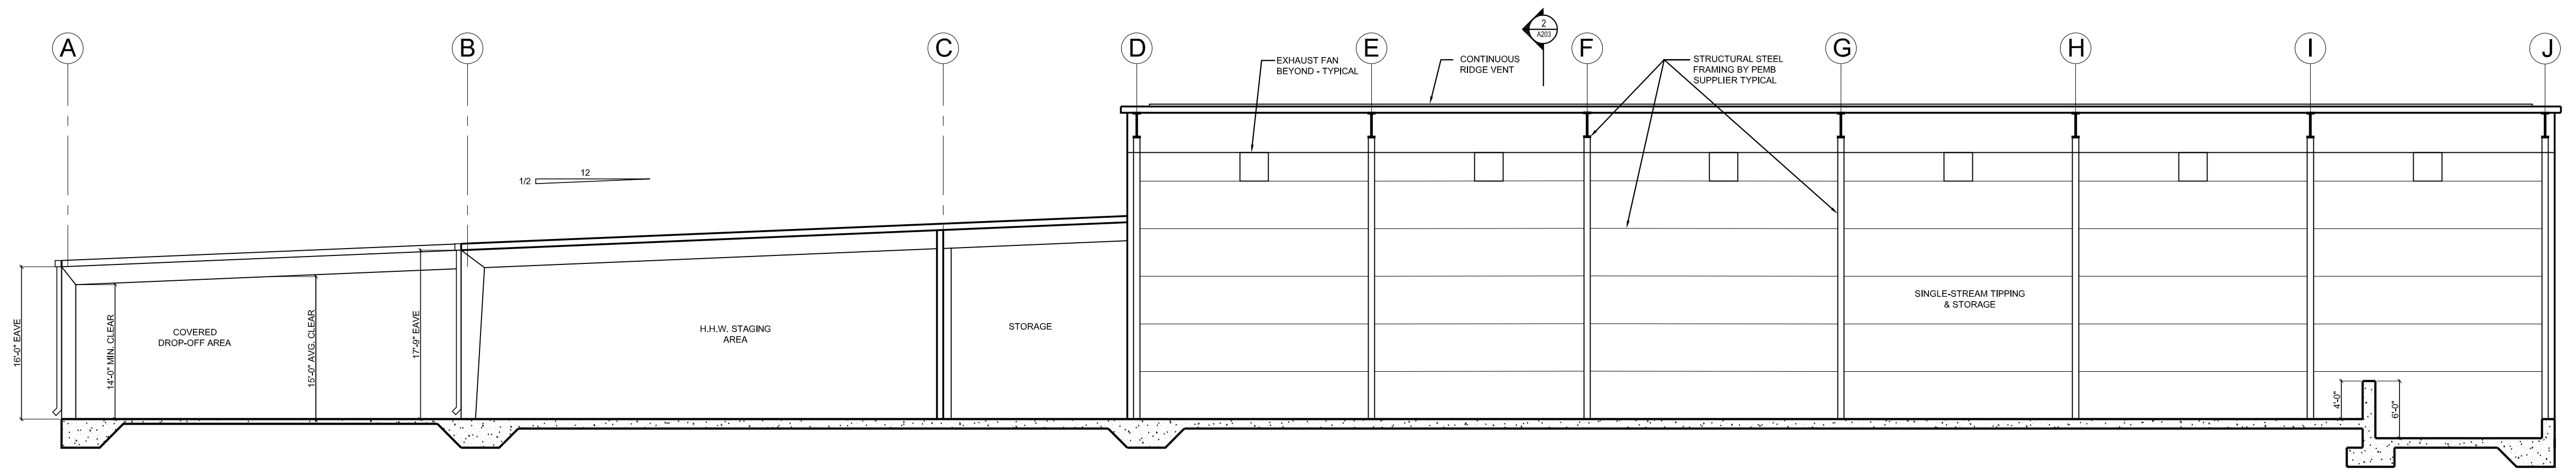

1 LONGITUDINAL BUILDING SECTION  
SCALE: 3/32" = 1'-0"

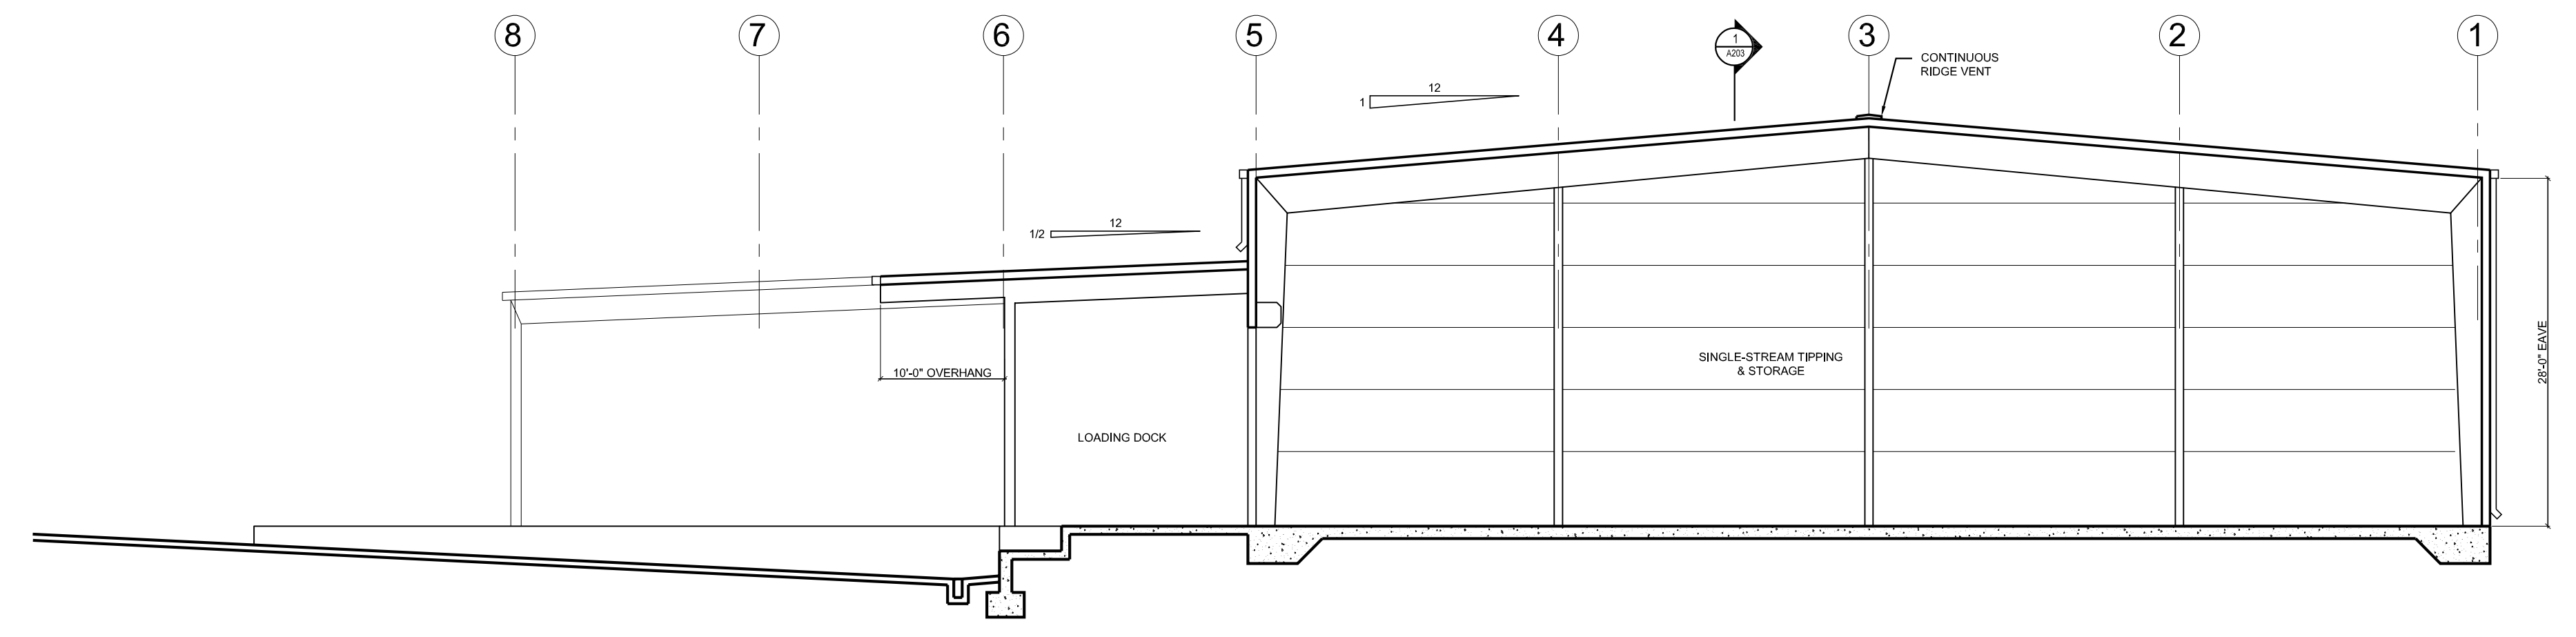

2 BUILDING CROSS SECTION  
SCALE: 3/32" = 1'-0"



CMK Design Studio, Inc.  
Planning & Design of the Built Environment  
6822 22nd Ave. N. #148  
St. Petersburg, Florida 33710  
Ph: 813.362.6381  
FL LIC. NO.: AA2002003  
marcos@cmkdesignstudio.com



MARCOS IBARCUIEN  
AR 13117  
Drawing Not Valid Unless Signed,  
Sealed & Dated by Registered Professional

THIS ITEM HAS BEEN ELECTRONICALLY SIGNED  
AND SEALED BY MARCOS  
IBARCUIEN ARCHITECT, ON THE DATE AND/OR  
TIME SHOWN USING A DIGITAL SIGNATURE.  
PRINTED COPIES OF THIS DOCUMENT ARE NOT  
CONSIDERED SIGNED AND SEALED AND THE  
SIGNATURE MUST BE VERIFIED ON ANY  
ELECTRONIC COPIES.

INDIAN RIVER COUNTY LANDFILL  
HOUSEHOLD HAZARDOUS WASTE  
AND RECYCLING FACILITY  
Indian River County, Florida

| NO. | REVISIONS | DATE |
|-----|-----------|------|
|     |           |      |
|     |           |      |

JOB NO.  
**2016**

ISSUE DATE:  
7/2/2021


DRAWN BY:  
MI

SHEET TITLE  
BUILDING SECTIONS  
SHEET NO.  
**A203**


PERMIT SET

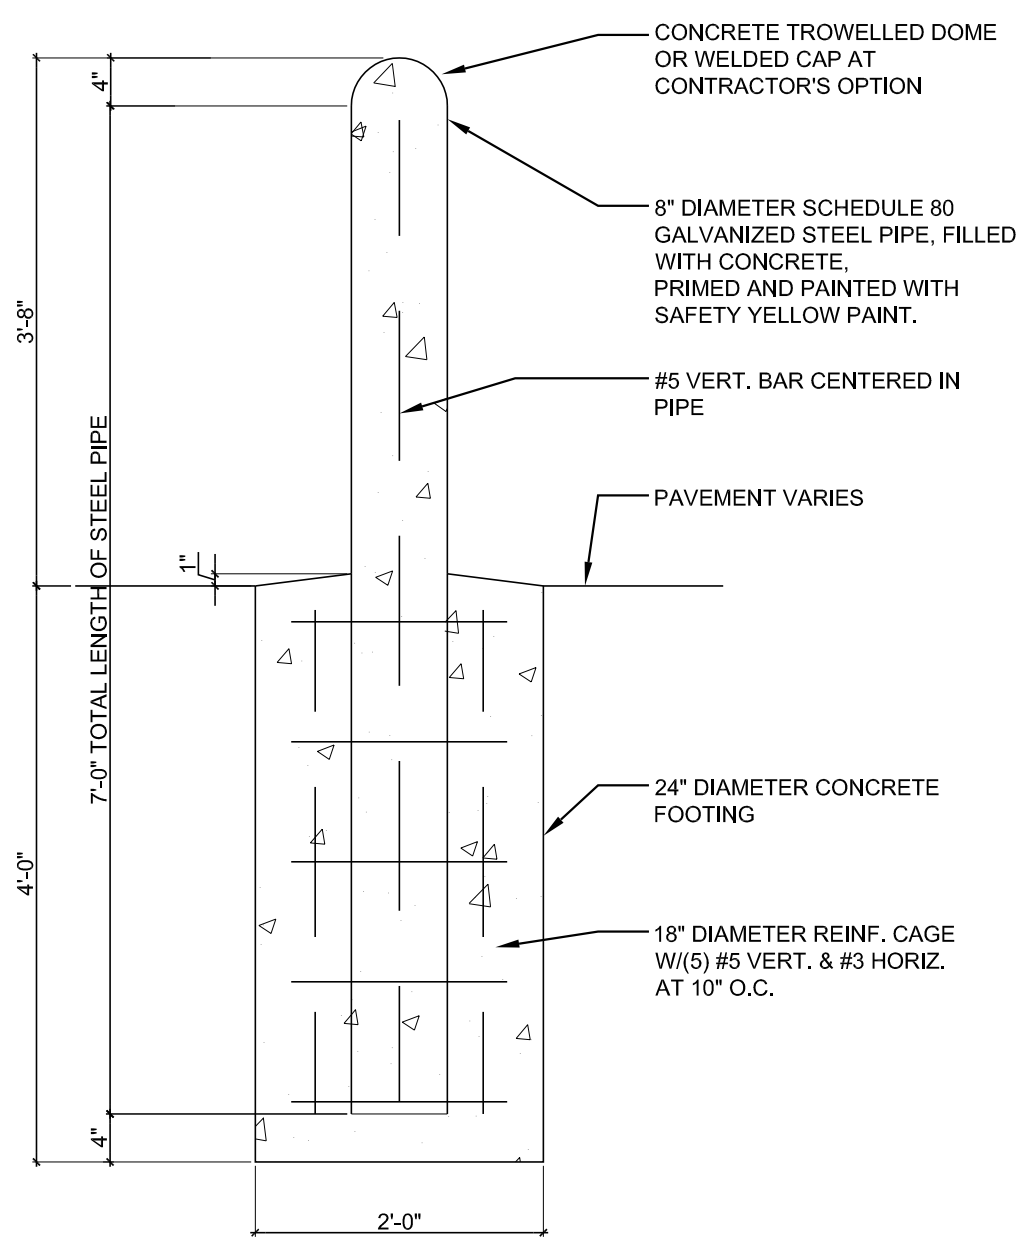


1 TYPICAL BOLLARD DETAIL  
SCALE: 3/4" = 1'-0"

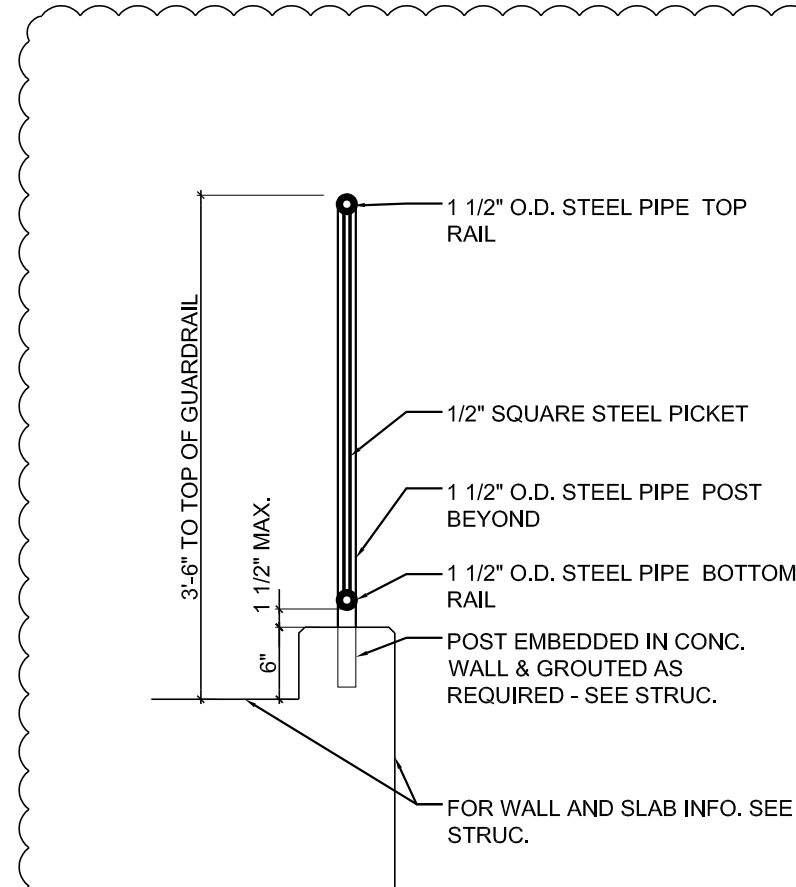


2 GUARD RAIL DETAIL  
SCALE: 3/4" = 1'-0"

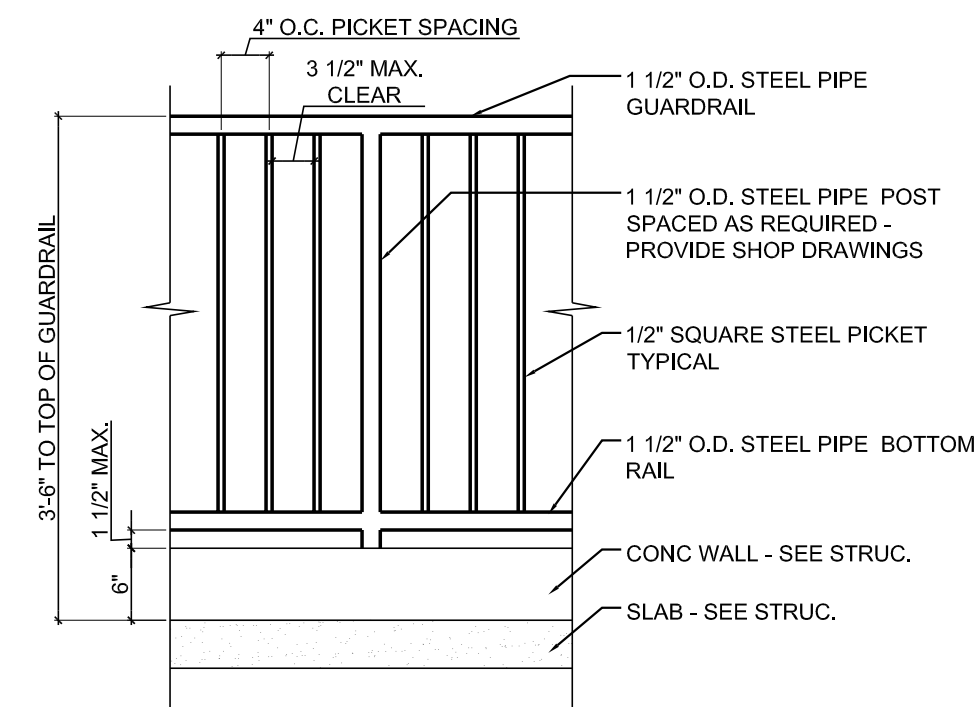


- NOTES:
1. GUARDRAIL SHALL BE INSTALLED IN ANY AREA WHERE LEVEL CHANGE EXCEEDS 30" EXCEPT AT LOADING DOCKS - SEE PLANS
  2. ALL STEEL TO BE WELDED WITH JOINTS GROUND SMOOTH.
  3. ALL STEEL TO BE PAINTED SAFETY YELLOW WITH RUST-INHIBITING PAINT.
  4. SUBMIT SHOP DRAWINGS FOR APPROVAL.

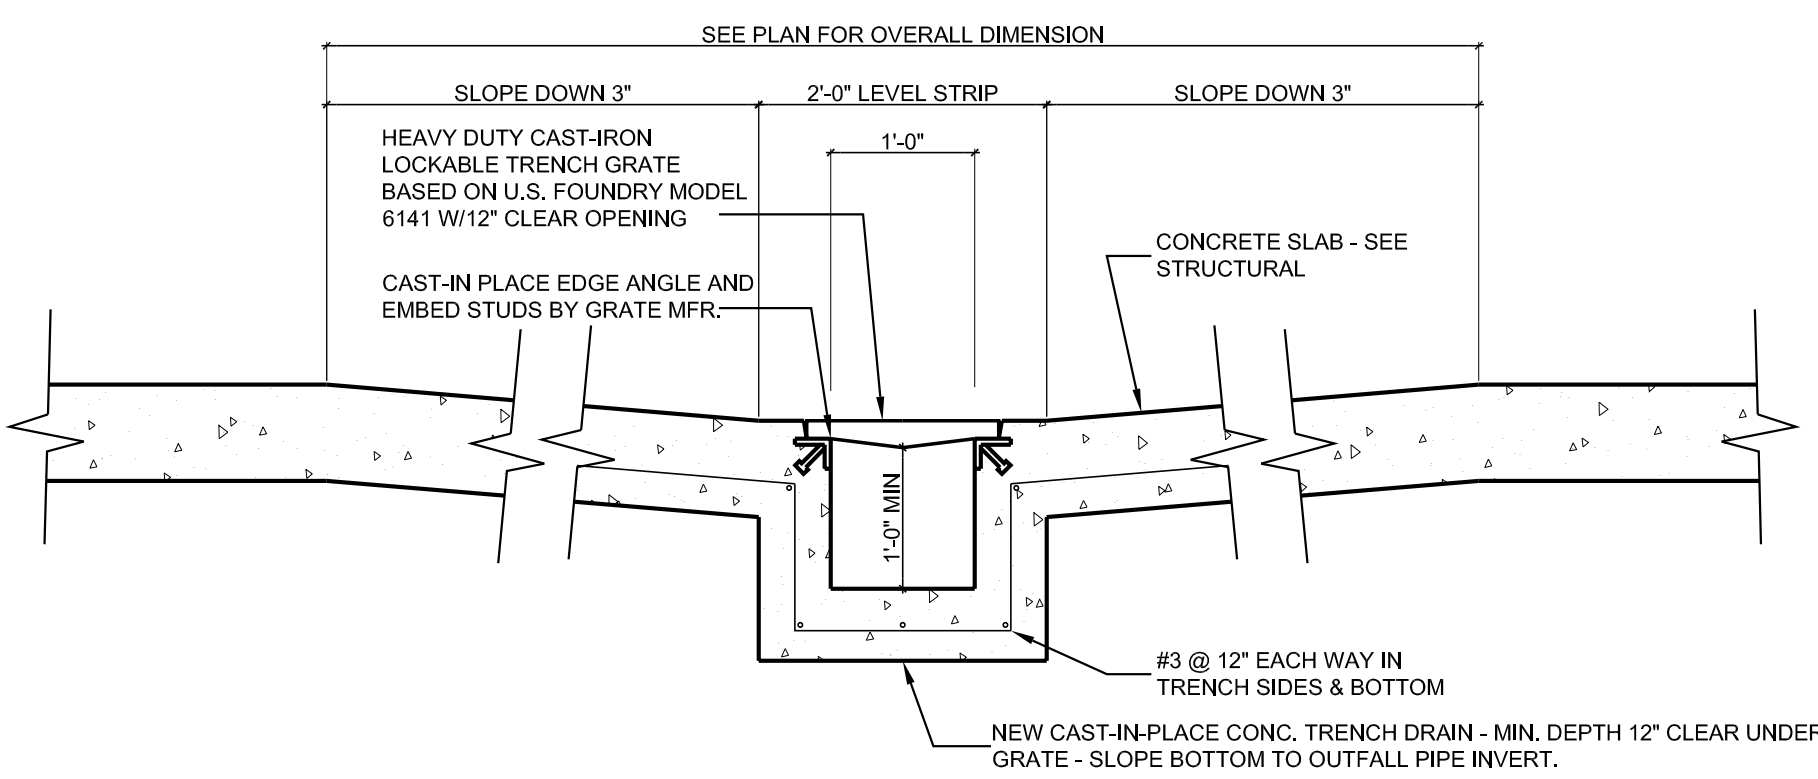


4 TRENCH DRAIN CROSS SECTION  
SCALE: 3/4" = 1'-0"

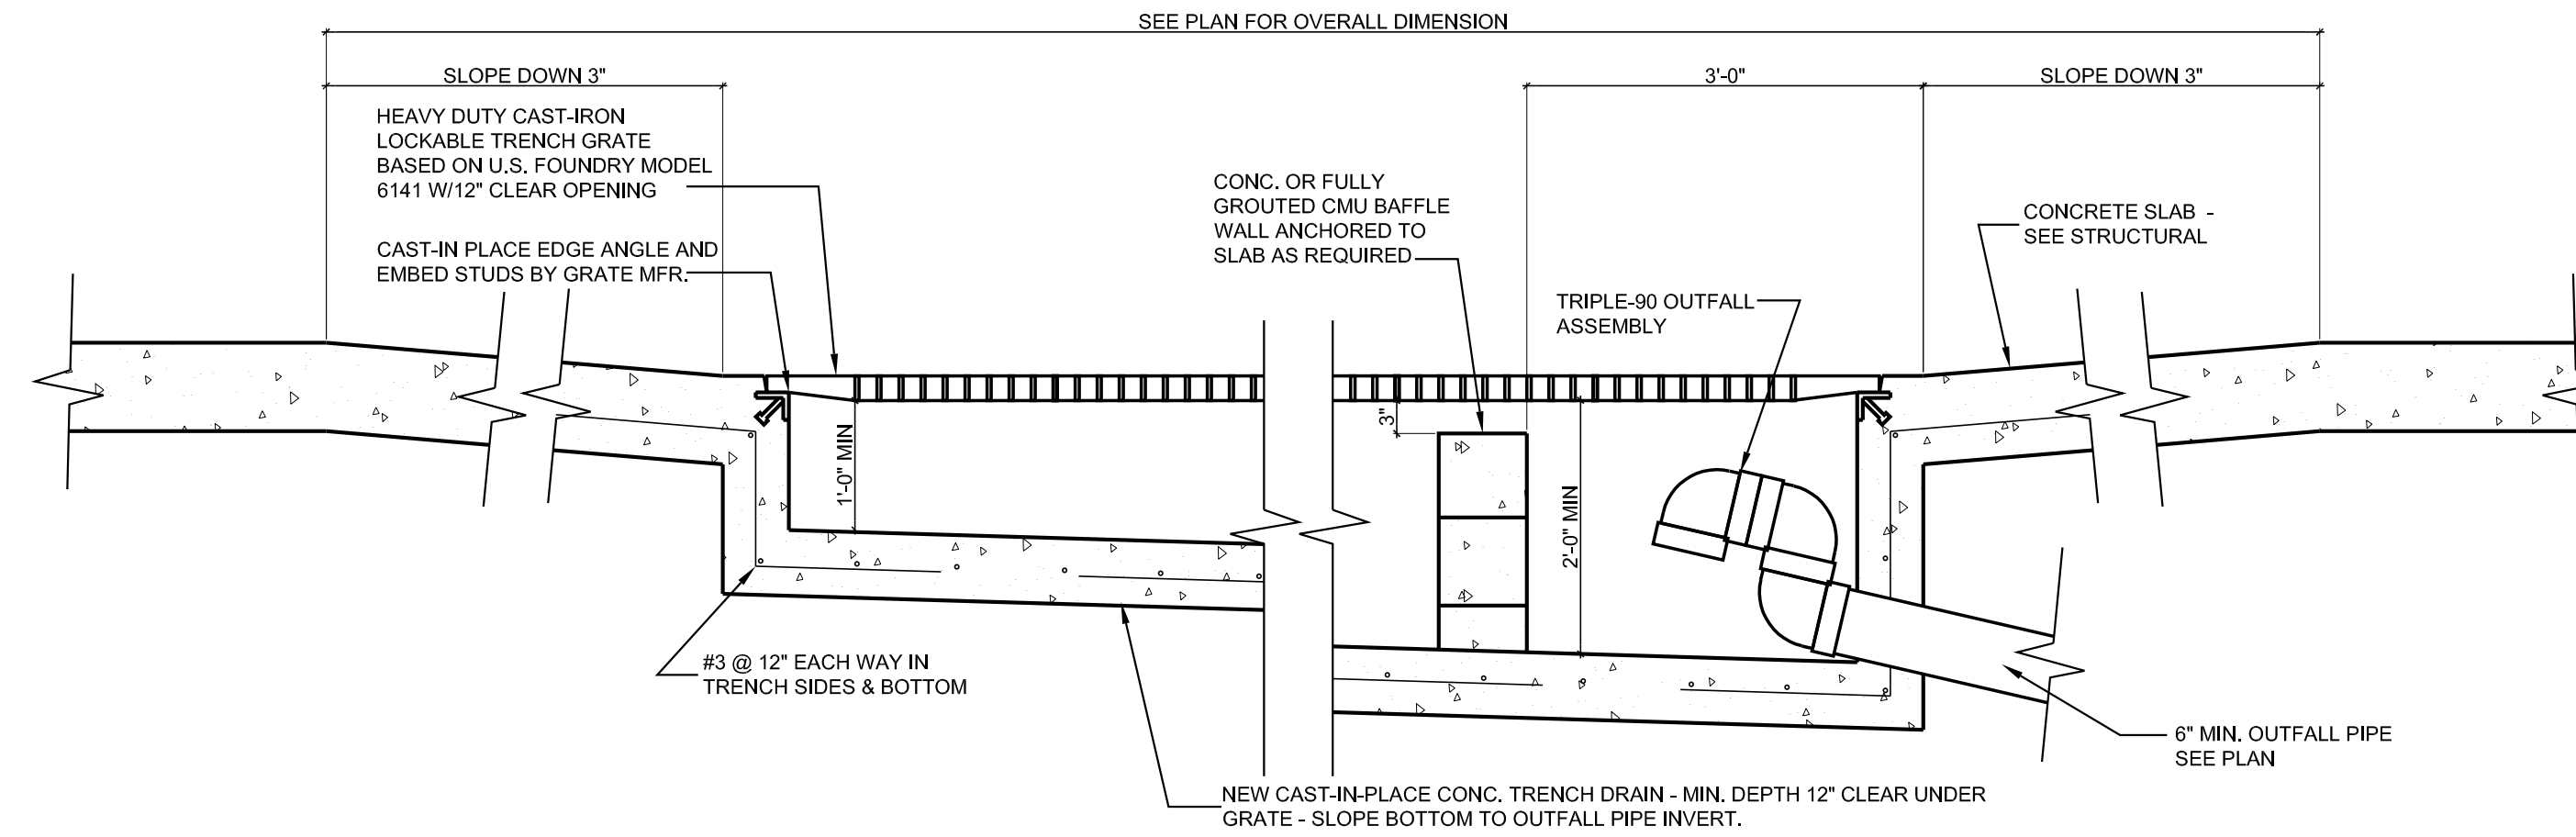

3 TRENCH DRAIN LONG SECTION  
SCALE: 3/4" = 1'-0"

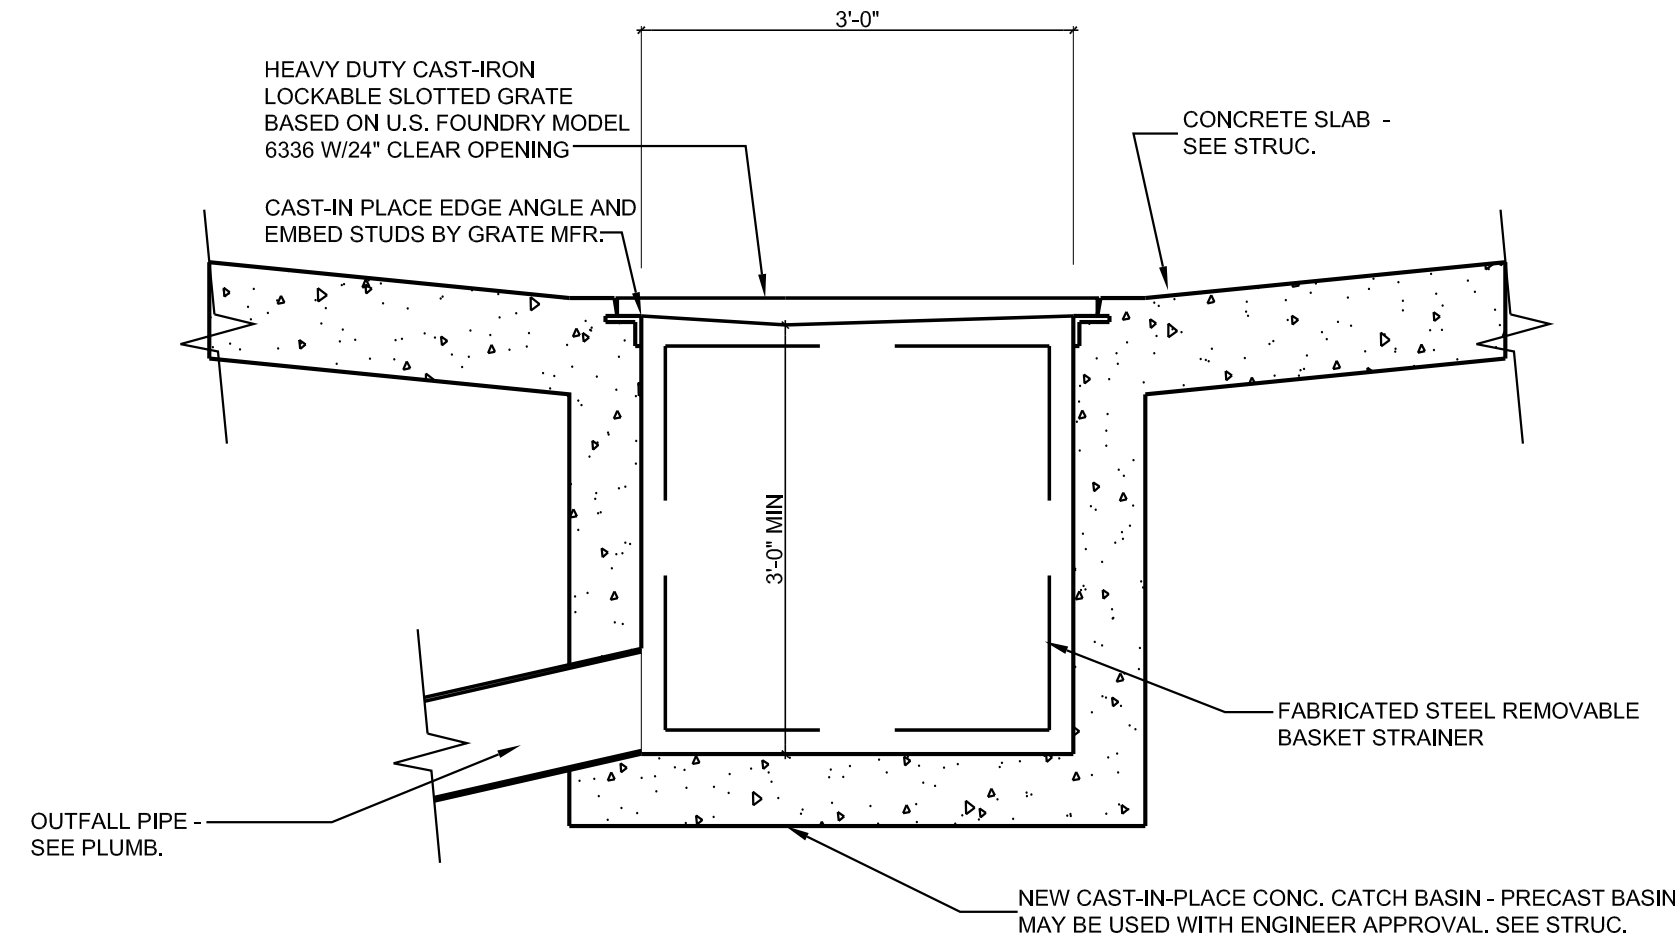

5 CATCH BASIN DETAIL  
SCALE: 3/4" = 1'-0"

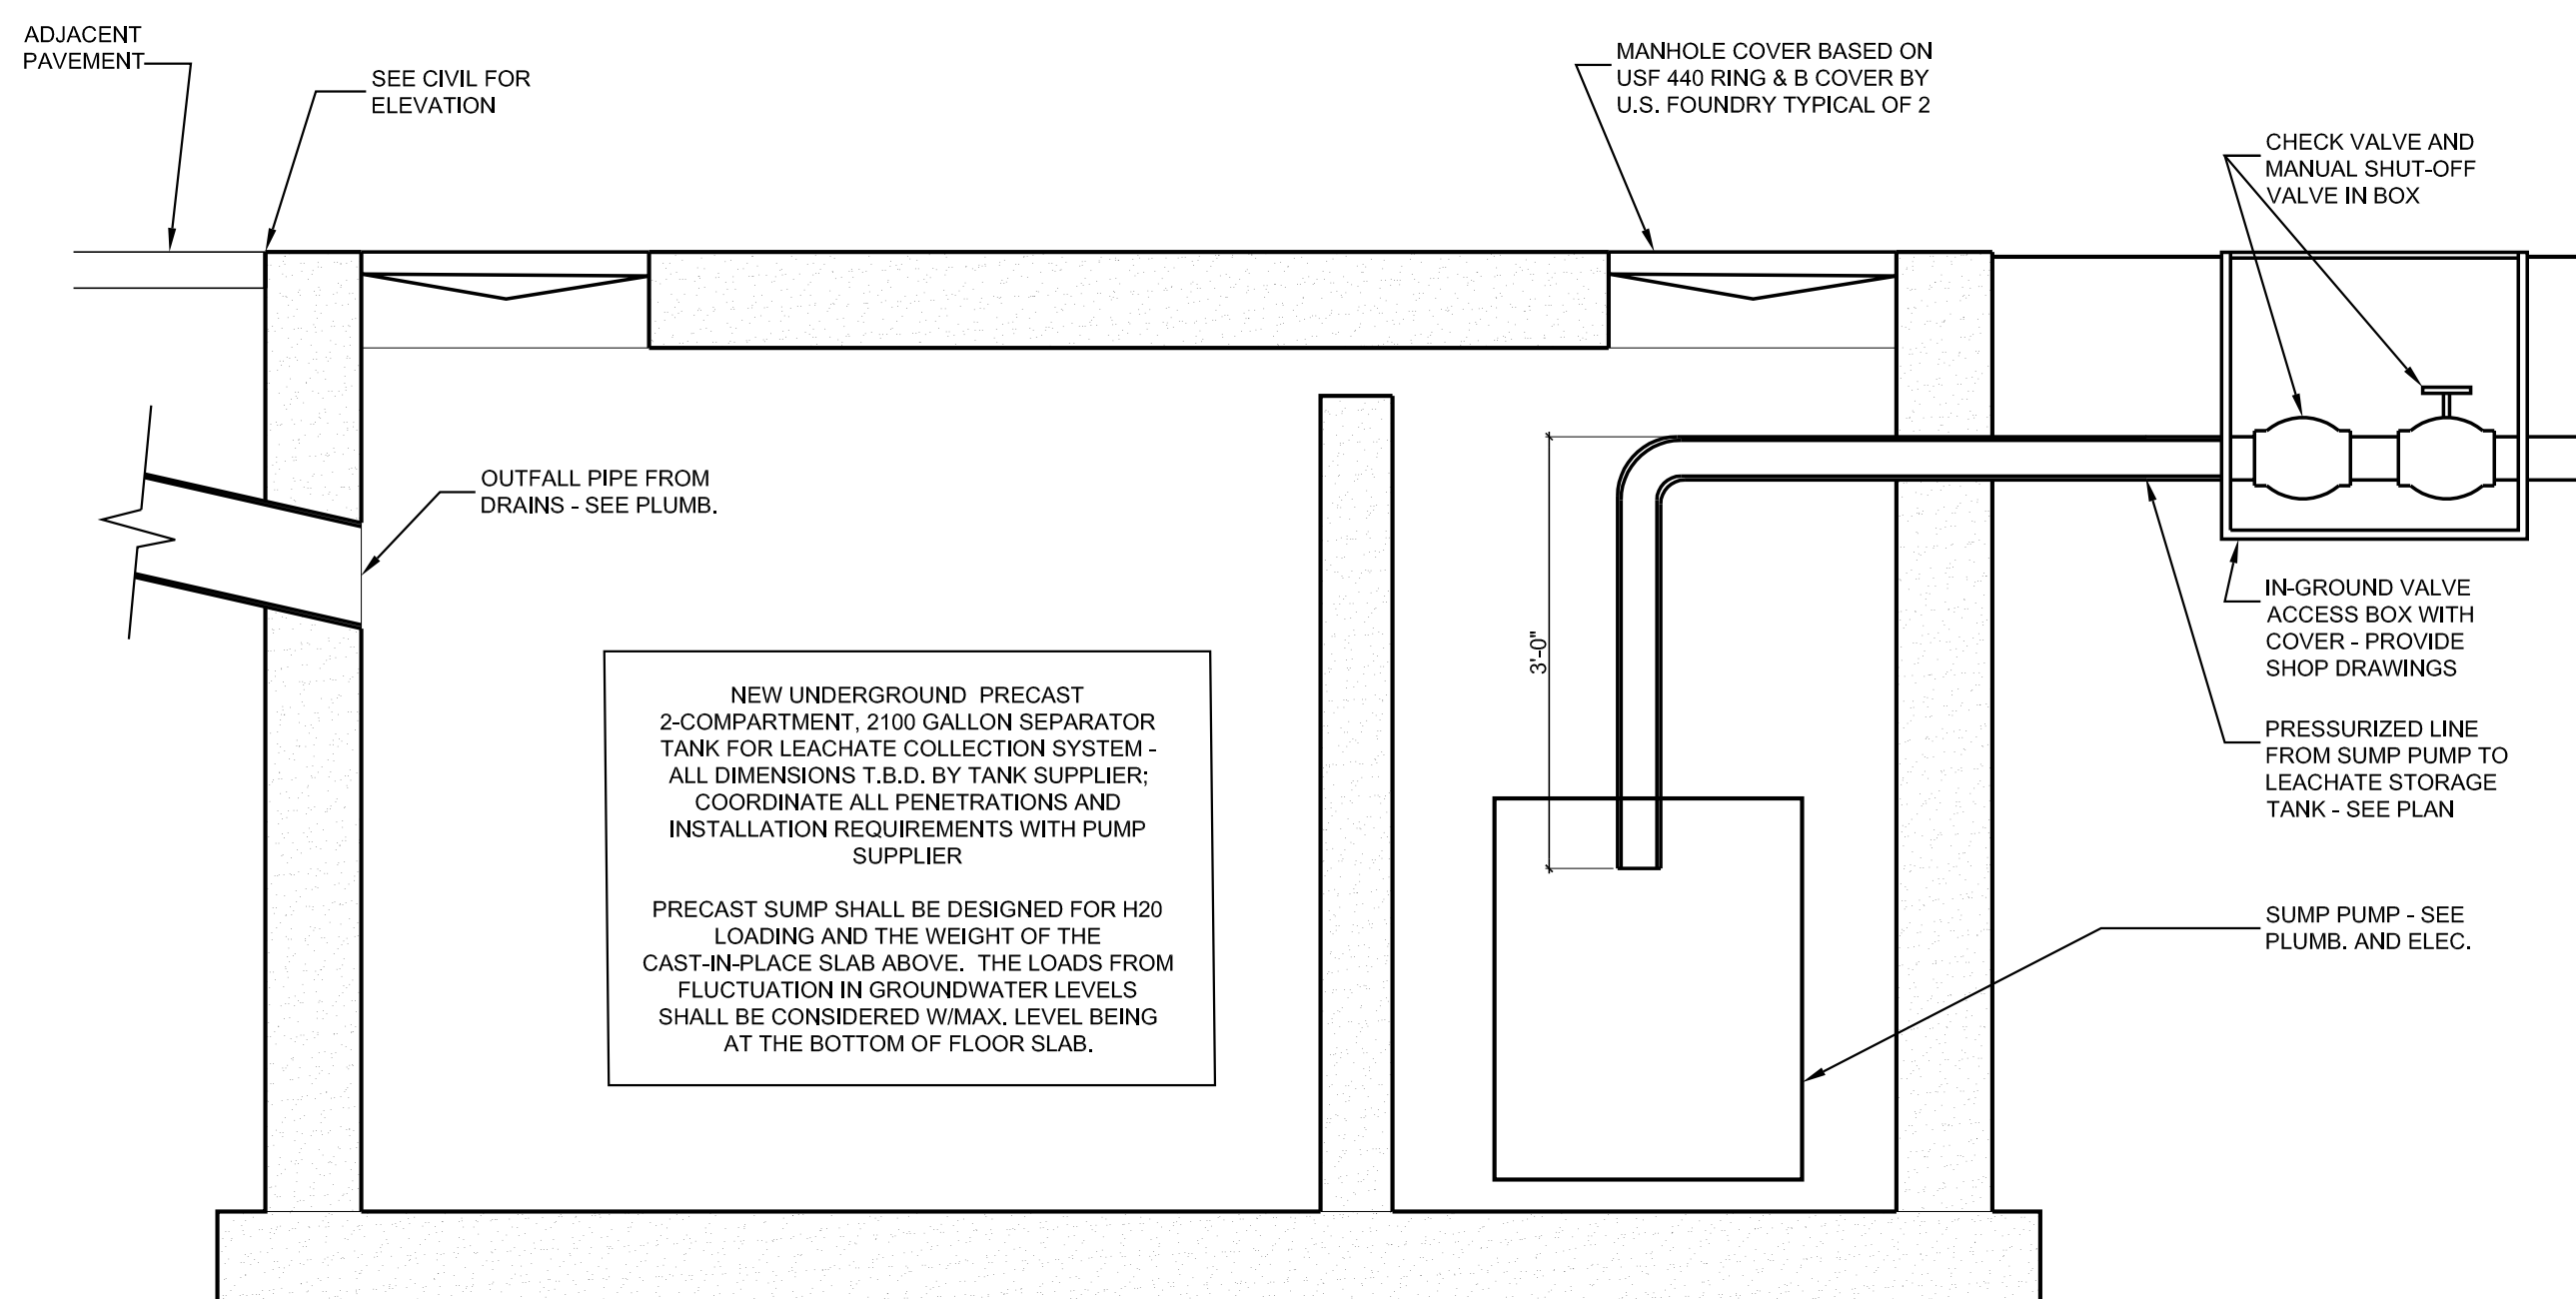

6 LEACHATE SEPARATOR TANK  
SCALE: 3/4" = 1'-0"



THIS ITEM HAS BEEN ELECTRONICALLY SIGNED AND SEALED BY MARCOS IBARQUEN ARCHITECT, ON THE DATE AND/OR TIME SHOWN USING A DIGITAL SIGNATURE. PRINTED COPIES OF THIS DOCUMENT ARE NOT CONSIDERED SIGNED AND SEALED AND THE SIGNATURE MUST BE VERIFIED ON ANY ELECTRONIC COPIES.

| NO. | REVISIONS                   | DATE     |
|-----|-----------------------------|----------|
| 1   | PLAN REVIEW & OWNER CHANGES | 10/19/21 |


JOB NO.  
**2016**

ISSUE DATE:  
7/2/2021


DRAWN BY:  
MI

SHEET TITLE  
SECTIONS & DETAILS  
SHEET NO.  
**A401**

PERMIT SET

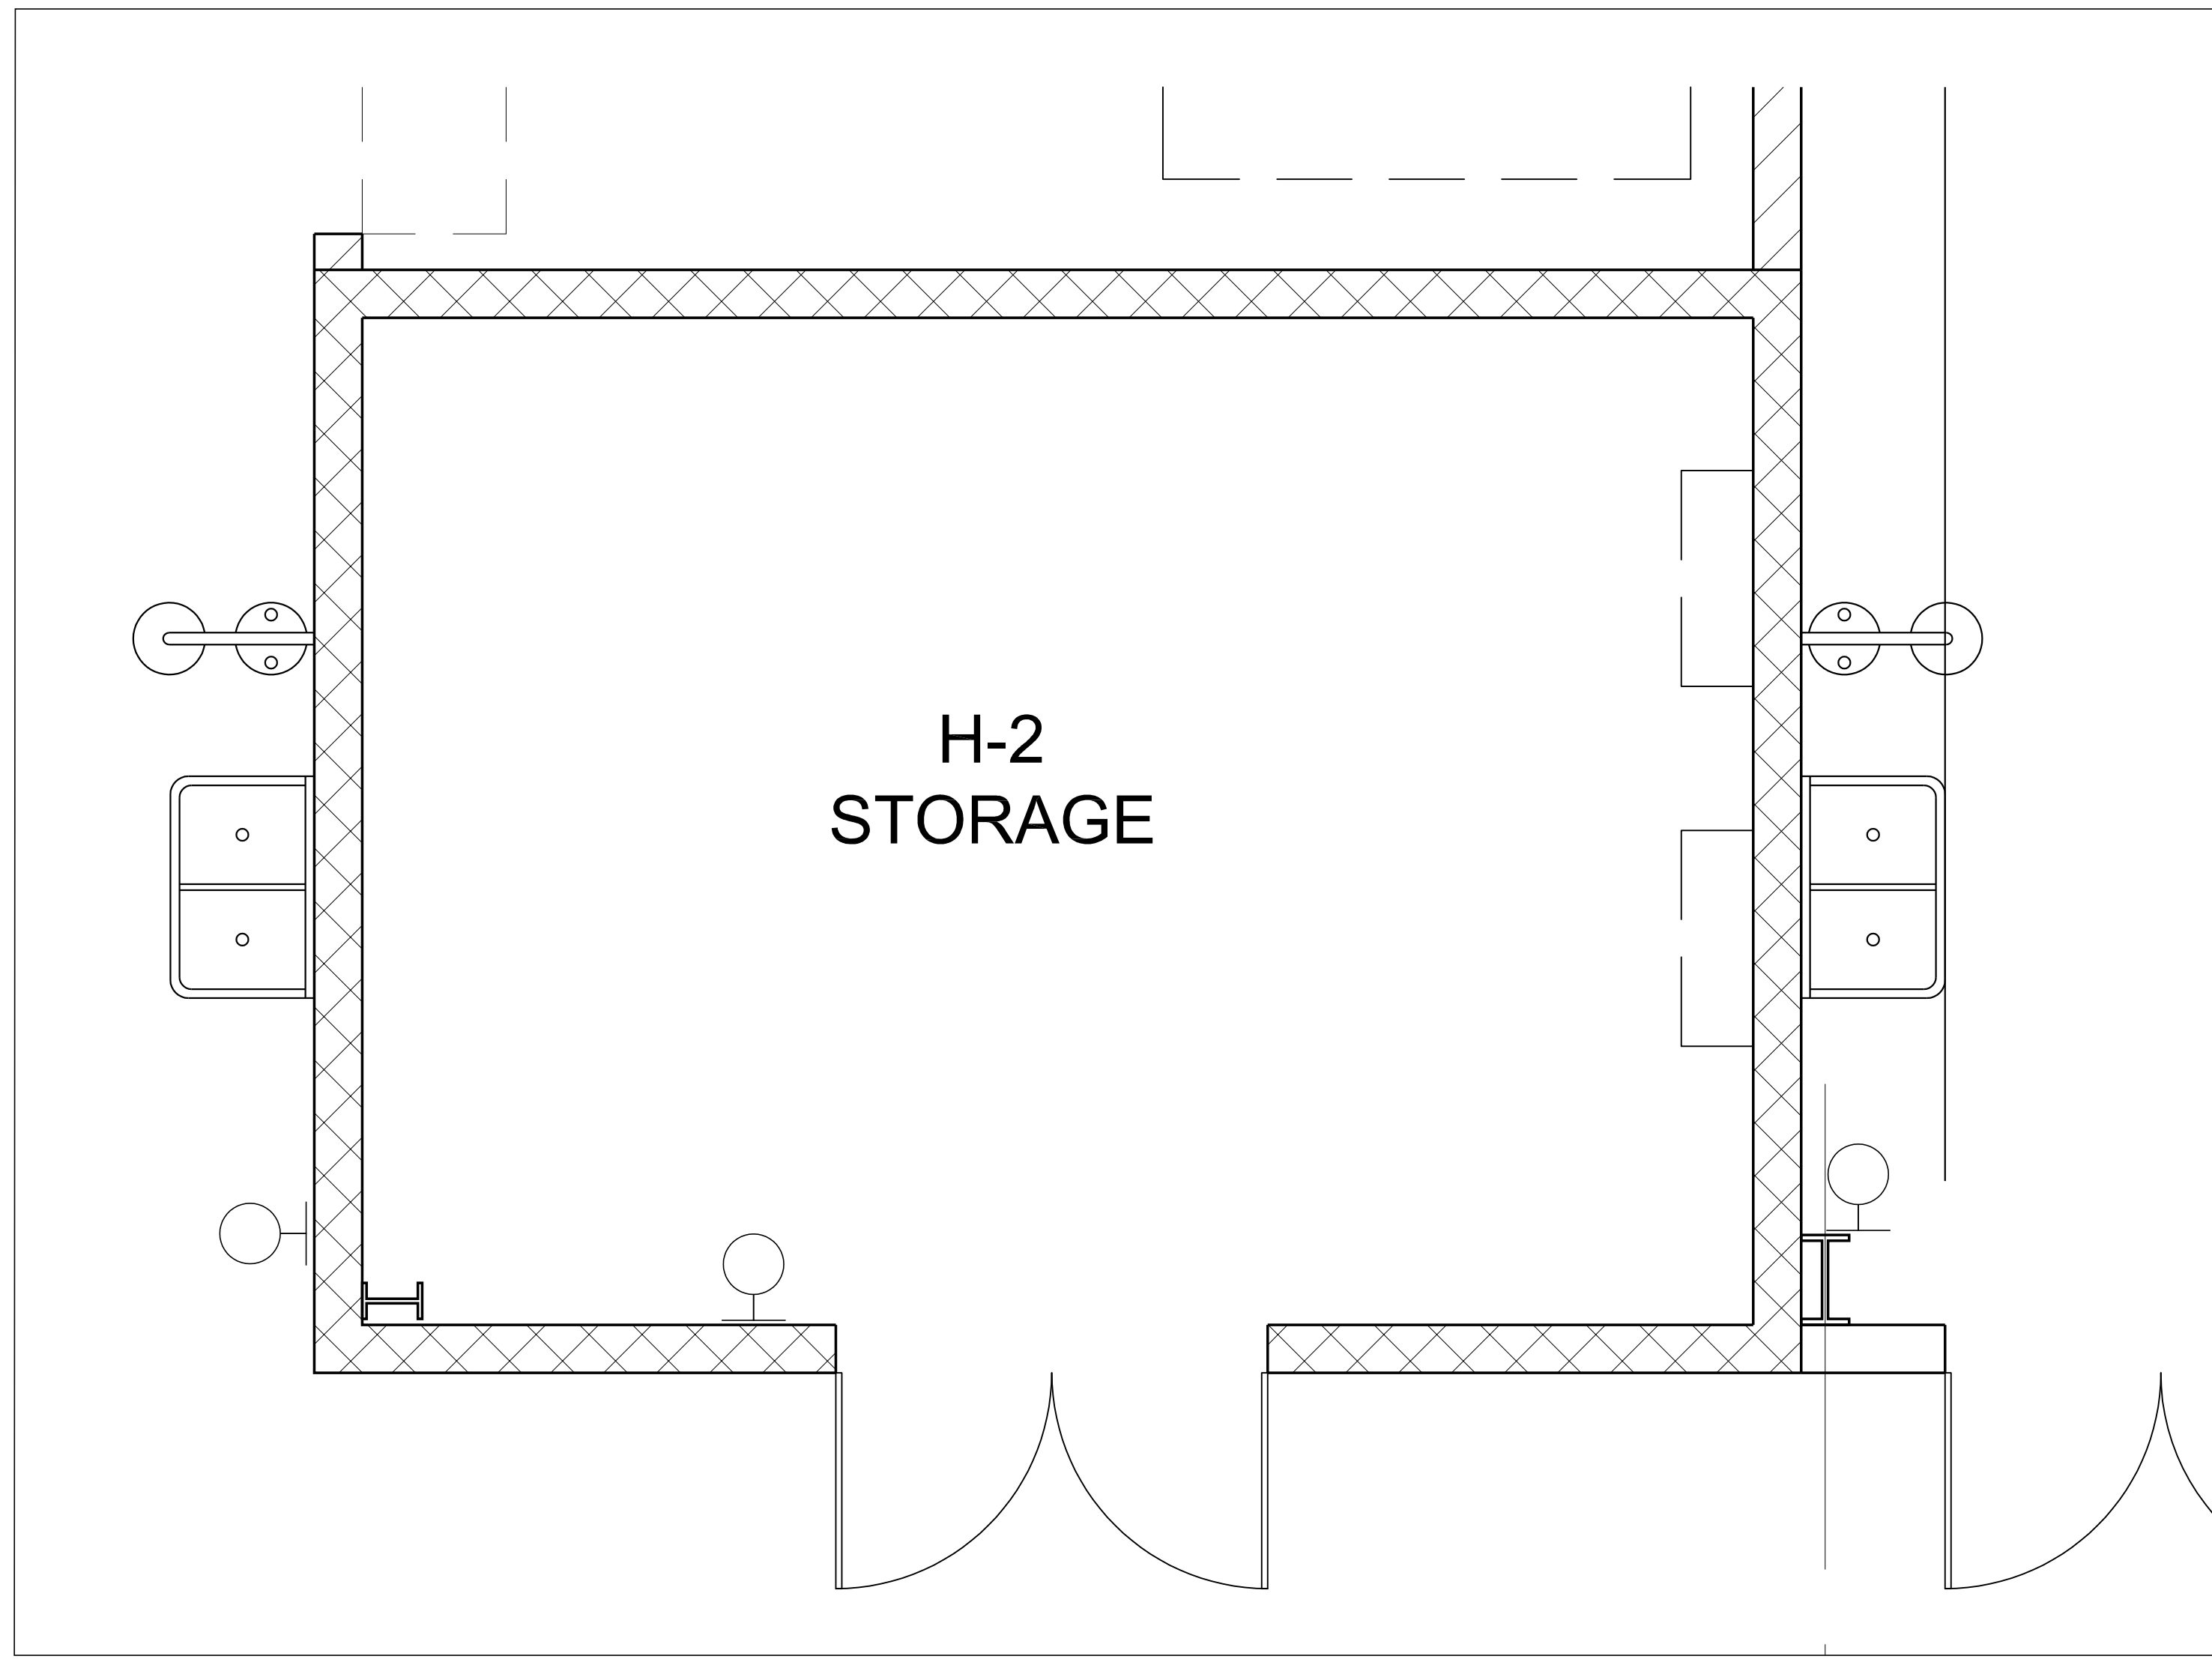

1 ENLARGED PLAN AT H2 STORAGE  
SCALE: 1/2" = 1'-0"

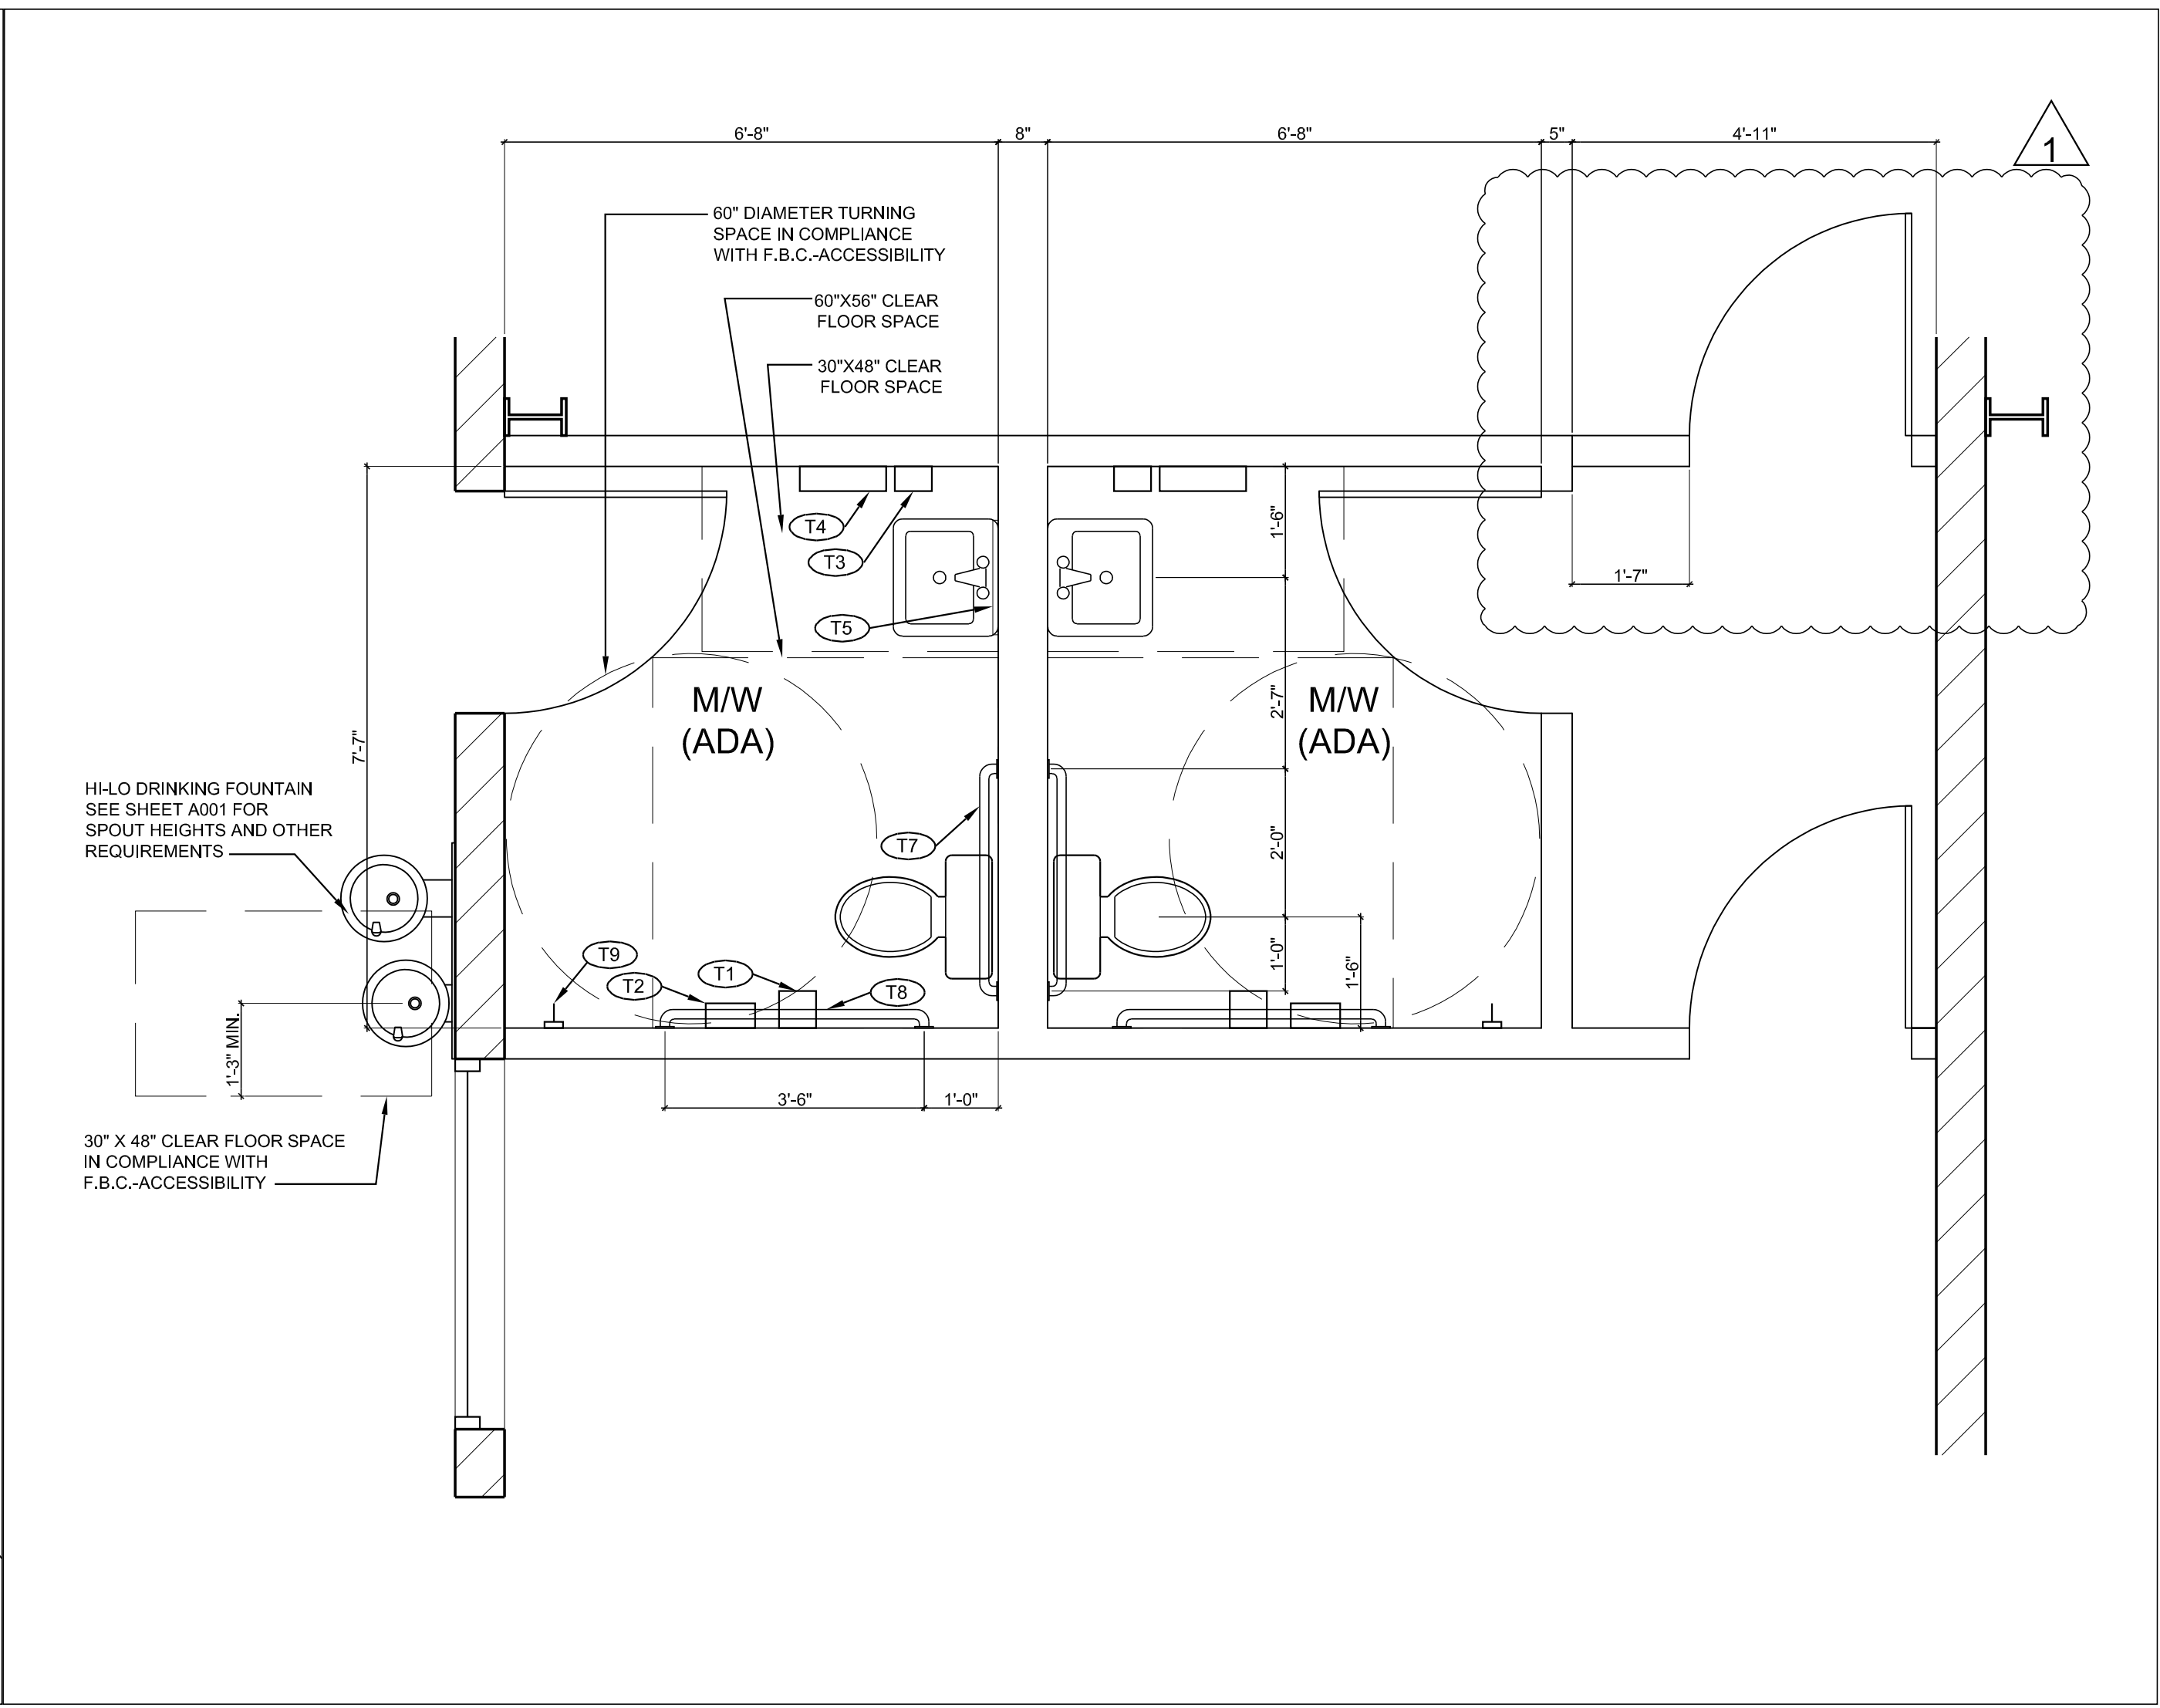

2 ENLARGED PLAN AT RESTROOMS  
SCALE: 1/2" = 1'-0"

| TOILET ACCESSORY SCHEDULE |                    |   |                             |         |
|---------------------------|--------------------|---|-----------------------------|---------|
| MARK                      | MANUF./MODEL #     | ACCESSORY   | MOUNTING HEIGHT (A.F.F.)    | REMARKS |
| T1                        | ASI 0030           | SURFACE MOUNTED DOUBLE ROLL TOILET TISSUE DISPENSER | 29" A.F.F. TO TOP OF PART   |         |
| T2                        | ASI 0852           | SURFACE MOUNTED NAPKIN DISPOSAL CABINET             | 30" A.F.F. TO OPERABLE PART | (1)     |
| T3                        | ASI 9343           | SURFACE MOUNTED SOAP DISPENSER                      |                             |         |
| T4                        | ASI 0462-AD9       | SURFACE MOUNTED COMPACT TOWEL DISPENSER & WASTE     | 46" A.F.F. TO OPERABLE PART |         |
| T5                        | ASI 0690 - 20 X 30 | STAINLESS STEEL FRAMED MIRROR                       | CENTER OVER SINK            |         |
| T6                        | NOT USED           |   |                             |         |
| T7                        | ASI 3801-36"       | GRAB BAR  | 33" - 36" A.F.F.            |         |
| T8                        | ASI 3801-42"       | GRAB BAR  | 33" - 36" A.F.F.            |         |
| T9                        | ASI 0751           | HEAVY DUTY CLOTHES HOOK                             |                             |         |

NOTES:  
 -REFER TO FLOOR PLAN FOR ADDITIONAL LOCATIONS.  
 -MODEL NUMBERS ARE BASED ON ASI (AMERICAN SPECIALTIES, INC.)  
 -WASHROOM ACCESSORIES. ACCEPTABLE PRODUCTS INCLUDE BOBRICK.  
 -SEE SHEET A001 FOR ADDITIONAL INFORMATION ON MOUNTING REQUIREMENTS.

REMARKS:  
 (1) MOUNT ADJACENT TO TOILET PAPER HOLDER

**DIMENSIONING NOTE:**  
 ALL DIMENSIONS ON THIS SHEET ARE "CLEAR" DIMENSIONS. COORDINATE WITH CENTERLINE DIMENSIONS SHOWN ELSEWHERE AND WITH WALL CONSTRUCTION DETAILS ON DRAWING A701 AND A.D.A. CLEARANCES ON DRAWING A001.

**A.D.A. NOTE:**  
 SEE DRAWING A001 FOR MOUNTING HEIGHTS, CLEARANCES AND OTHER INFORMATION REQUIRED FOR COMPLIANCE WITH A.D.A. AND THE FLORIDA BUILDING CODE - ACCESSIBILITY.



CMK Design Studio, Inc.  
 Planning & Design of the Built Environment  
 6822 22nd Ave. N. #148  
 St. Petersburg, Florida 33710  
 Ph: 813.362.6381  
 FL LIC. NO.: AA2002003  
 marcos@cmkdesignstudio.com



MARCOS IBARQUEN  
 AR 13117  
 Drawing Not Valid Unless Signed, Sealed & Dated by Registered Professional  
 THIS ITEM HAS BEEN ELECTRONICALLY SIGNED AND SEALED BY MARCOS IBARQUEN/ARCHITECT, ON THE DATE AND/OR TIME SHOWN USING A DIGITAL SIGNATURE. PRINTED COPIES OF THIS DOCUMENT ARE NOT CONSIDERED SIGNED AND SEALED AND THE SIGNATURE MUST BE VERIFIED ON ANY ELECTRONIC COPIES.


INDIAN RIVER COUNTY LANDFILL HOUSEHOLD HAZARDOUS WASTE AND RECYCLING FACILITY  
 Indian River County, Florida

| NO. | REVISIONS                   | DATE     |
|-----|-----------------------------|----------|
| 1   | PLAN REVIEW & OWNER CHANGES | 10/19/21 |

JOB NO.  
**2016**  
 ISSUE DATE:  
 7/2/2021  
 DRAWN BY:  
 MI

SHEET TITLE  
 ENLARGED PLANS AND INTERIOR ELEVATIONS  
 SHEET NO.  
**A601**



PERMIT SET

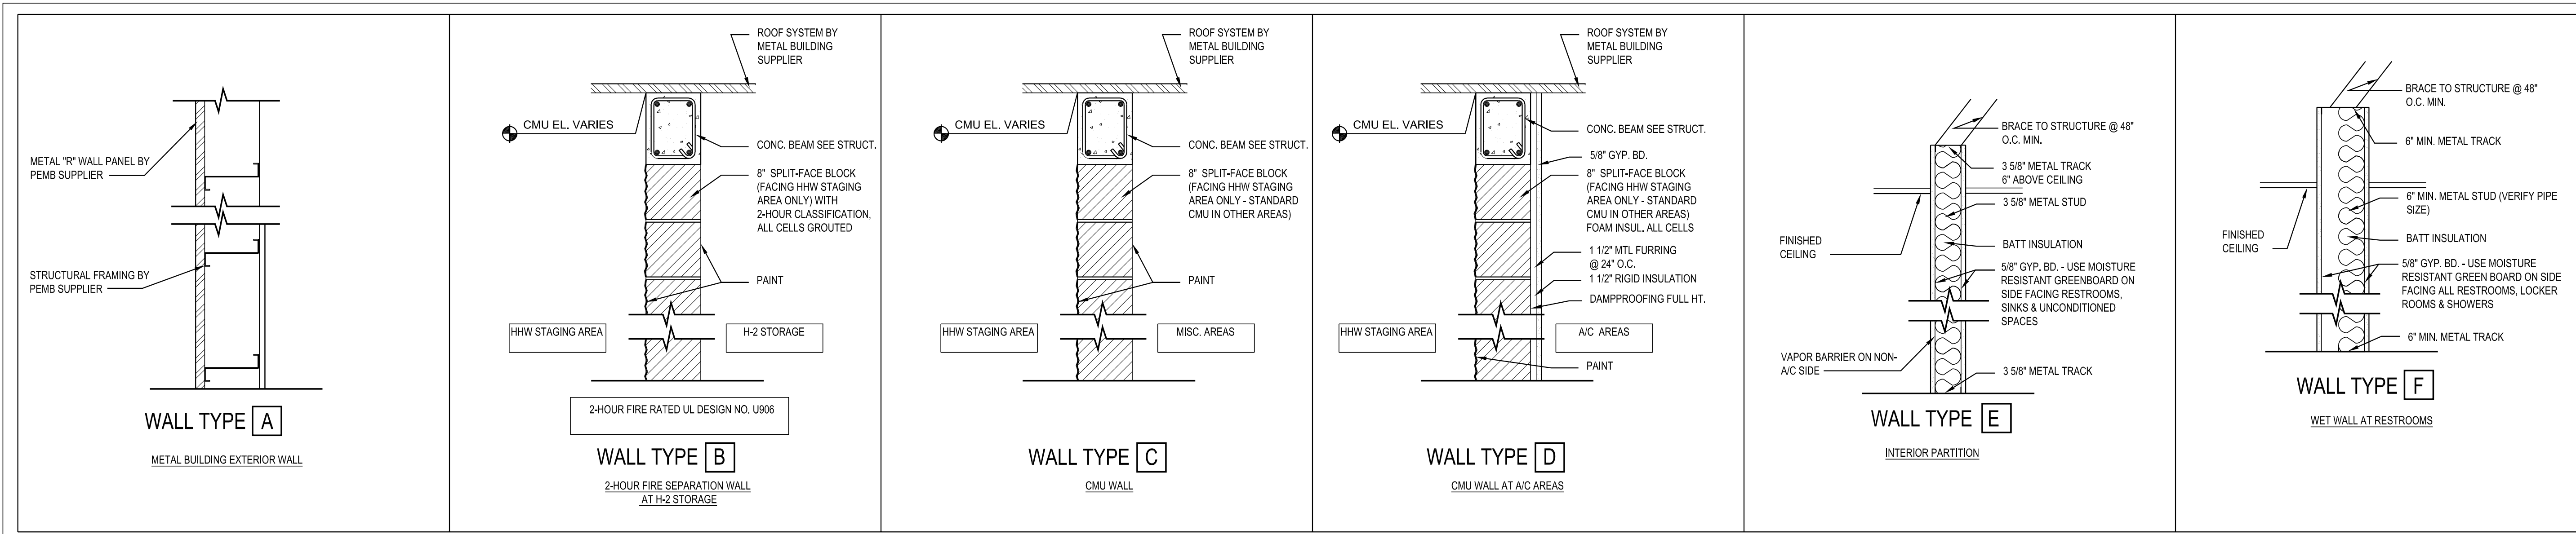

1 WALL TYPES  
SCALE: 1" = 1'-0"

| DOOR SCHEDULE  |           |            |                   |      |      |       |                   |                       |        |        |         |            |                        |           |
|----------------|-----------|------------|-------------------|------|------|-------|-------------------|-----------------------|--------|--------|---------|------------|------------------------|-----------|
| ROOM NAME      | ROOM NUM. | DOOR SYMB. | SIZE              | TYPE | MAT. | FRAME | FINISH DOOR/FRAME | DETAILS               |        |        | HDW GRP | FIRE LABEL | FLORIDA PRODUCT APPVL. | REMARKS   |
|                |           |            |                   |      |      |       |                   | HEAD                  | SILL   | JAMB   |         |            |                        |           |
| RE-USE AREA    |           | 101        | 3'-0" X 7'-0"     | A    | HM   | A     | P                 | 5/A702                | 6/A702 | 5/A702 | 1       |            | 22211.2                |           |
| RE-USE AREA    |           | 102        | PR. 3'-0" X 7'-0" | A    | HM   | A     | P                 | 5/A702                | 6/A702 | 5/A702 | 1A      |            | 22211.2                |           |
| M/W            |           | 103        | 3'-0" X 7'-0"     | A    | HM   | A     | P                 | 5/A702                | 6/A702 | 5/A702 | 4       |            | 22211.2                |           |
| CONF           |           | 104        | 3'-0" X 7'-0"     | A    | HM   | A     | P                 | 5/A702                | 6/A702 | 5/A702 | 1       |            | 22211.2                |           |
| STORAGE        |           | 105        | 3'-0" X 7'-0"     | A    | HM   | A     | P                 | 5/A702                | 6/A702 | 5/A702 | 1       | 1          | 22211.2                |           |
| H-2 STORAGE    |           | 106        | PR. 3'-0" X 7'-0" | A    | HM   | A     | P                 | 5/A702                | 6/A702 | 5/A702 | 3       | 90-MIN"B"  | 22211.2                |           |
| M/W            |           | 107        | 3'-0" X 7'-0"     | A    | HM   | A     | P                 | 3/A701                | --     | 3/A701 | 4       |            |                        |           |
| CONF           |           | 108        | 3'-0" X 7'-0"     | A    | HM   | A     | P                 | 3/A701                | --     | 3/A701 | 2       |            |                        |           |
| OFFICE         |           | 109        | 3'-0" X 7'-0"     | A    | HM   | A     | P                 | 3/A701                | --     | 3/A701 | 2       |            |                        |           |
| SINGLE STREAM  |           | 110        | PR. 3'-0" X 7'-0" | A    | HM   | A     | P                 | SEE P.E.M.B. DRAWINGS |        |        | 1A      |            | 22211.2                |           |
| LOADING DOCK   |           | 111        | 3'-0" X 7'-0"     | A    | HM   | A     | P                 | SEE P.E.M.B. DRAWINGS |        |        | 1       |            | 22211.2                |           |
| SINGLE STREAM  |           | 112        | 3'-0" X 7'-0"     | A    | HM   | A     | P                 | SEE P.E.M.B. DRAWINGS |        |        | 1       |            | 22211.2                |           |
| LOAD-OUT WELL  |           | 113        | 3'-0" X 7'-0"     | A    | HM   | A     | P                 | SEE P.E.M.B. DRAWINGS |        |        | 1       | 1          | 22211.2                |           |
| RE-USE AREA    |           | 114        | 3'-0" X 7'-0"     | A    | HM   | A     | P                 | 3/A701                | --     | 3/A701 | 2       | 1          |                        |           |
| OVERHEAD DOORS |           |            |                   |      |      |       |                   |                       |        |        |         |            |                        |           |
| STORAGE        |           | OH1        | 8'-0" X 14'-0"    |      |      |       |                   |                       |        |        |         |            | 10706-R3               | MOTOR OP. |
| SINGLE-STREAM  |           | OH2        | 16'-0" X 16'-0"   |      |      |       |                   |                       |        |        |         |            | 10706-R3               | MOTOR OP. |
| SINGLE-STREAM  |           | OH3        | 16'-0" X 27'-0"   |      |      |       |                   |                       |        |        |         |            | 10706-R3               | MOTOR OP. |
| SINGLE-STREAM  |           | OH4        | 16'-0" X 27'-0"   |      |      |       |                   |                       |        |        |         |            | 10706-R3               | MOTOR OP. |
| LOAD-OUT WELL  |           | OH5        | 16'-0" X 18'-0"   |      |      |       |                   |                       |        |        |         |            | 10706-R3               | MOTOR OP. |

| DOOR NOTES & LEGEND        |  |
|----------------------------|--|
| <b>MATERIAL</b>            | <b>NOTES</b>   |
| HM HOLLOW METAL, INSULATED | 1. ALL THRESHOLDS SHALL BE A.D.A. COMPLIANT WITH MAX ELEVATION CHANGE OF 1/2". |
| <b>FINISH</b>              | 2. VERIFY ALL LOCKING REQUIREMENTS WITH OWNER.                                 |
| P PAINTED                  |  |

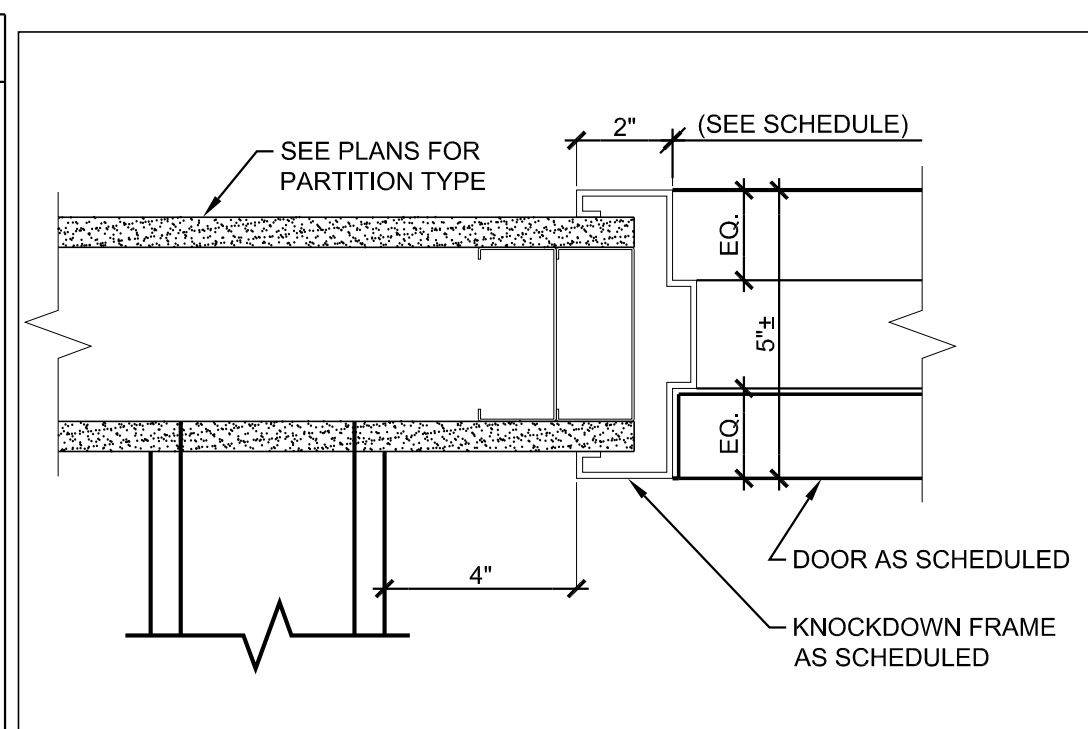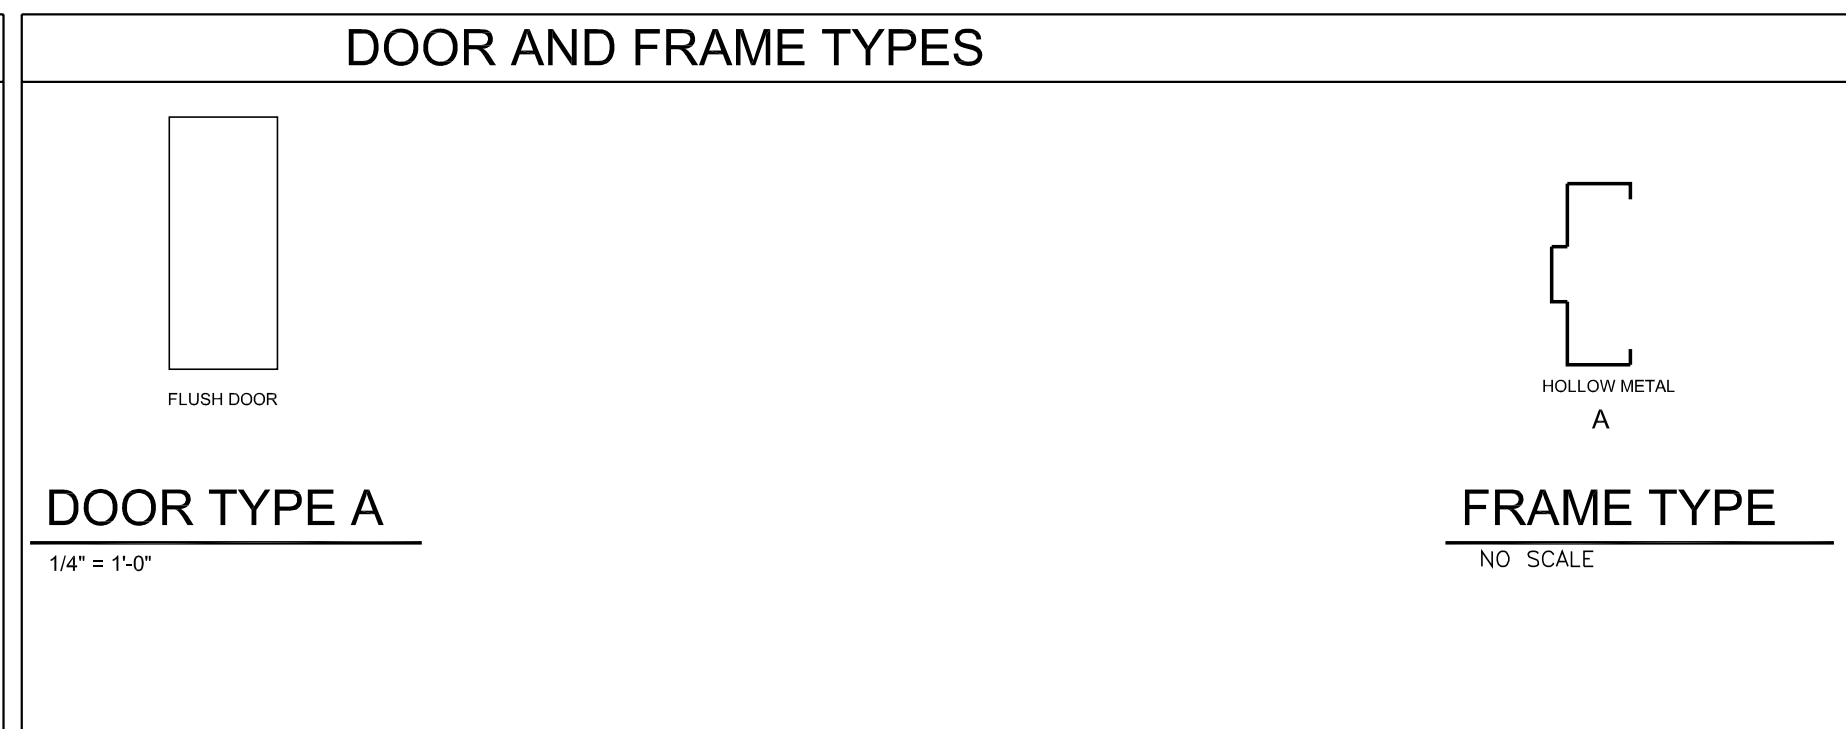

2 DOOR SCHEDULE  
SCALE: N/A

3 DOOR JAMB/HEAD DETAIL  
SCALE: 3" = 1'-0"

**FINISH NOTES:**

- FIELD CHECK AND VERIFY ALL DIMENSIONS AND CONDITIONS PRIOR TO ORDERING MATERIALS.
- FINISH SCHEDULE PROVIDED AS "BASIS OF DESIGN" AND FOR PRICING PURPOSES. PROVIDE SAMPLES OF ALL SELECTIONS TO OWNER FOR APPROVAL PRIOR TO PROCEEDING WITH THE WORK.
- ADHERE TO ALL CURRENT MANUFACTURER WRITTEN SPECIFICATIONS FOR APPROVED INSTALLATION METHODS (INCLUDING, BUT NOT LIMITED TO, ADHESIVE TYPES, CUTTING METHODS, SEALERS AND PRIMERS)
- ALL PAINT SHALL BE APPLIED IN ACCORDANCE WITH THE MANUFACTURER'S WRITTEN SPECIFICATIONS FOR THE PARTICULAR SURFACE. TWO (2) FINISH COATS MINIMUM APPLICATION AFTER ONE PRIME COAT MINIMUM.
- ALL CHANGES IN FLOOR FINISH MATERIALS OCCURRING AT DOORWAYS SHALL BE AT THE CENTERLINE OF THE DOORWAY. PROVIDE TRANSITION ACCESSORIES AS REQUIRED.
- PATCH ALL HOLES IN SURFACES TO BE PAINTED PRIOR TO PRIMING.

**FINISH SCHEDULE:**

- ALL AIR-CONDITIONED ROOMS:
- FLOORS: VINYL TILE TO BE SELECTED FROM STANDARD PRODUCTS SUBMITTED BY CONTRACTOR.
  - TYPICAL WALLS: PAINT P-1
  - RESTROOM WALLS: F.R.P. PANELING TO 48" A.F.F., PAINT P-1 ABOVE
  - BASE: VINYL BASE
  - DOORS AND DOOR FRAMES: PAINT P-1
  - CEILINGS: SEE CEILING PLAN

- HHW STAGING, H-2 STORAGE AND SINGLE-STREAM BUILDING:
- FLOORS: SEALED CONCRETE, LIGHT BROOM FINISH
  - CMU WALLS: PAINT P-2
  - METAL BUILDING WALLS: N/A
  - BASE: N/A
  - DOORS AND DOOR FRAMES: PAINT P-2
  - CEILINGS: N/A

**FINISH SCHEDULE BASIS OF DESIGN:**

- VINYL WALL BASE:  
BURKE FLOORING 502 BROWN 4" COVE
- PAINT P-1:  
COLOR MATCH: BENJAMIN MOORE LINEN SAND 2151-60  
EPOXY COATING
- PAINT P-2:  
EXTERIOR GRADE LATEX T.B.D. COLOR MATCH TO PEMB PANELS OR AS DIRECTED BY OWNER.

4 FINISH SCHEDULE AND NOTES  
SCALE: N/A



CMK Design Studio, Inc.  
Planning & Design of the Built Environment  
6822 22nd Ave. N. #148  
St. Petersburg, Florida 33710  
Ph: 813.362.6381  
FL LIC. NO.: AA20002003  
marcos@cmkdesignstudio.com



MARCOS F. IBARQUEN  
AR 13117  
Drawing Not Valid Unless Signed, Sealed & Dated by Registered Professional

THIS ITEM HAS BEEN ELECTRONICALLY SIGNED AND SEALED BY MARCOS F. IBARQUEN ARCHITECT, ON THE DATE AND/OR TIME SHOWN USING A DIGITAL SIGNATURE. PRINTED COPIES OF THIS DOCUMENT ARE NOT CONSIDERED SIGNED AND SEALED AND THE SIGNATURE MUST BE VERIFIED ON ANY ELECTRONIC COPIES.

INDIAN RIVER COUNTY LANDFILL  
HOUSEHOLD HAZARDOUS WASTE  
AND RECYCLING FACILITY  
Indian River County, Florida

| NO. | REVISIONS                   | DATE     |
|-----|-----------------------------|----------|
| 1   | PLAN REVIEW & OWNER CHANGES | 10/19/21 |

JOB NO.  
**2016**  
ISSUE DATE:  
7/2/2021  
DRAWN BY:  
MI

SHEET TITLE  
WALL TYPES, DOOR &  
FINISH SCHEDULE  
SHEET NO.  
**A701**

PERMIT SET



MARCOS IBARQUEN  
AR 13117  
Drawing Not Valid Unless Signed,  
Sealed & Dated by Registered Professional  
THIS ITEM HAS BEEN ELECTRONICALLY SIGNED  
AND SEALED BY MARCOS  
IBARQUEN ARCHITECT, ON THE DATE AND/OR  
TIME SHOWN USING A DIGITAL SIGNATURE.  
PRINTED COPIES OF THIS DOCUMENT ARE NOT  
CONSIDERED SIGNED AND SEALED AND THE  
SIGNATURE MUST BE VERIFIED ON ANY  
ELECTRONIC COPIES.

INDIAN RIVER COUNTY LANDFILL  
HOUSEHOLD HAZARDOUS WASTE  
AND RECYCLING FACILITY  
Indian River County, Florida

| NO. | REVISIONS | DATE |
|-----|-----------|------|
|     |           |      |
|     |           |      |
JOB NO.  
**2016**  
ISSUE DATE:  
7/2/2021  
DRAWN BY:  
MI

SHEET TITLE  
WINDOW SCHEDULE  
AND DETAILS  
SHEET NO.  
**A702**

PERMIT SET

**WINDOW TYPE A**  
1/4" = 1'-0"

**WINDOW NOTES & LEGEND**

- ALL EXTERIOR GLAZING SHALL BE IMPACT RESISTANT IN ACCORDANCE WITH FLORIDA BUILDING CODE AND PRODUCT APPROVALS. EXTERIOR GLAZING CHARACTERISTICS SHALL BE AS FOLLOWS (SEE ALSO GLAZING DIAGRAM ON THIS SHEET):
  - DOUBLE-GLAZED WINDOWS: LAMINATED GLASS OUTER PANE W/P.V.B. INTERLAYER; TOTAL THICKNESS 1 5/16".
  - ALL VISION GLAZING SHALL HAVE TINTED INTERLAYER.
  - INTERLAYER TINT SHALL BE SELECTED FROM MANUFACTURER'S STANDARD COLORS.
- BASIS OF DESIGN FOR STOREFRONT WINDOW SYSTEM IS KAWNEER IR501. SEE SHEET G000 FOR APPLICABLE FLORIDA PRODUCT APPROVAL NUMBERS. NO SUBSTITUTION OF ALTERNATE PRODUCTS WILL BE PERMITTED WITHOUT DOCUMENTATION OF EQUIVALENT PERFORMANCE AND SUBMISSION OF FLORIDA PRODUCT APPROVAL INFORMATION FOR THE PROPOSED ALTERNATE PRODUCTS.
- ALL STOREFRONT FRAMES SHALL BE ALUMINUM WITH A POWDER-COAT FINISH; COLOR TO BE SELECTED FROM MANUFACTURER'S STANDARD COLORS.
- SEE STRUCTURAL DRAWINGS FOR WIND LOAD INFORMATION.
- DIMENSIONS SHOWN REFER TO MASONRY ROUGH OPENINGS. SUPPLIER SHALL VERIFY REQUIRED MEASUREMENTS AND SUBMIT FULL SHOP DRAWINGS FOR REVIEW PRIOR TO MANUFACTURING WINDOWS.


**WINDOW SCHEDULE**

| WINDOW TYPE | LOCATION ZONE | DESIGN PRESSURE | FLORIDA PRODUCT APPROVAL | APPROVAL DATE | NOA #      | MANUFACTURER | MODEL # | OPENING SIZE  | FRAME DETAILS |        |        |
|-------------|---------------|-----------------|--------------------------|---------------|------------|--------------|---------|---------------|---------------|--------|--------|
|             |               |                 |                          |               |            |              |         |               | HEAD          | SILL   | JAMB   |
| A           | 5             | +/- 65 psf      | FL 8787.2                | 11/02/2017    | 11-0915.06 | KAWNEER      | IR501   | 5'-0" X 4'-0" | 3/A702        | 4/A702 | 3/A702 |


**GLAZING CHARACTERISTICS**

1 WINDOW TYPES  
SCALE: 1/4" = 1'-0"


2 WINDOW SCHEDULE  
SCALE: N/A

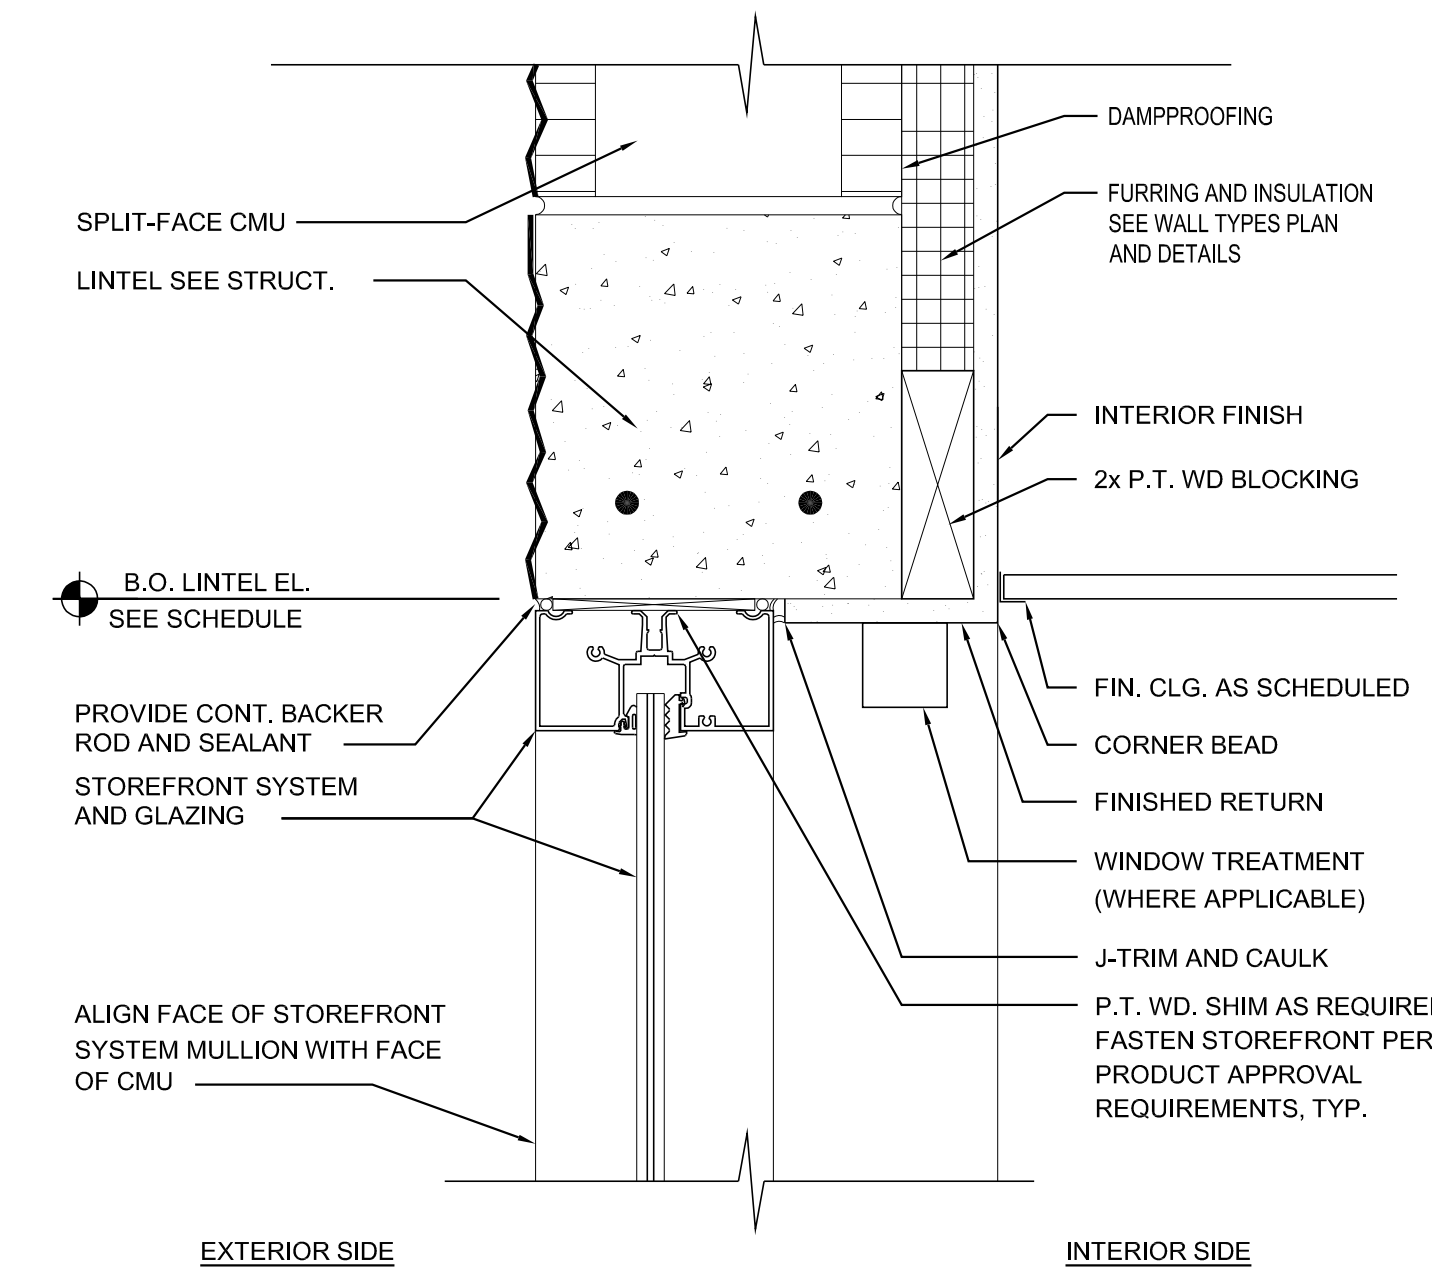


3 STOREFRONT HEAD/JAMB  
SCALE: 3" = 1'-0"

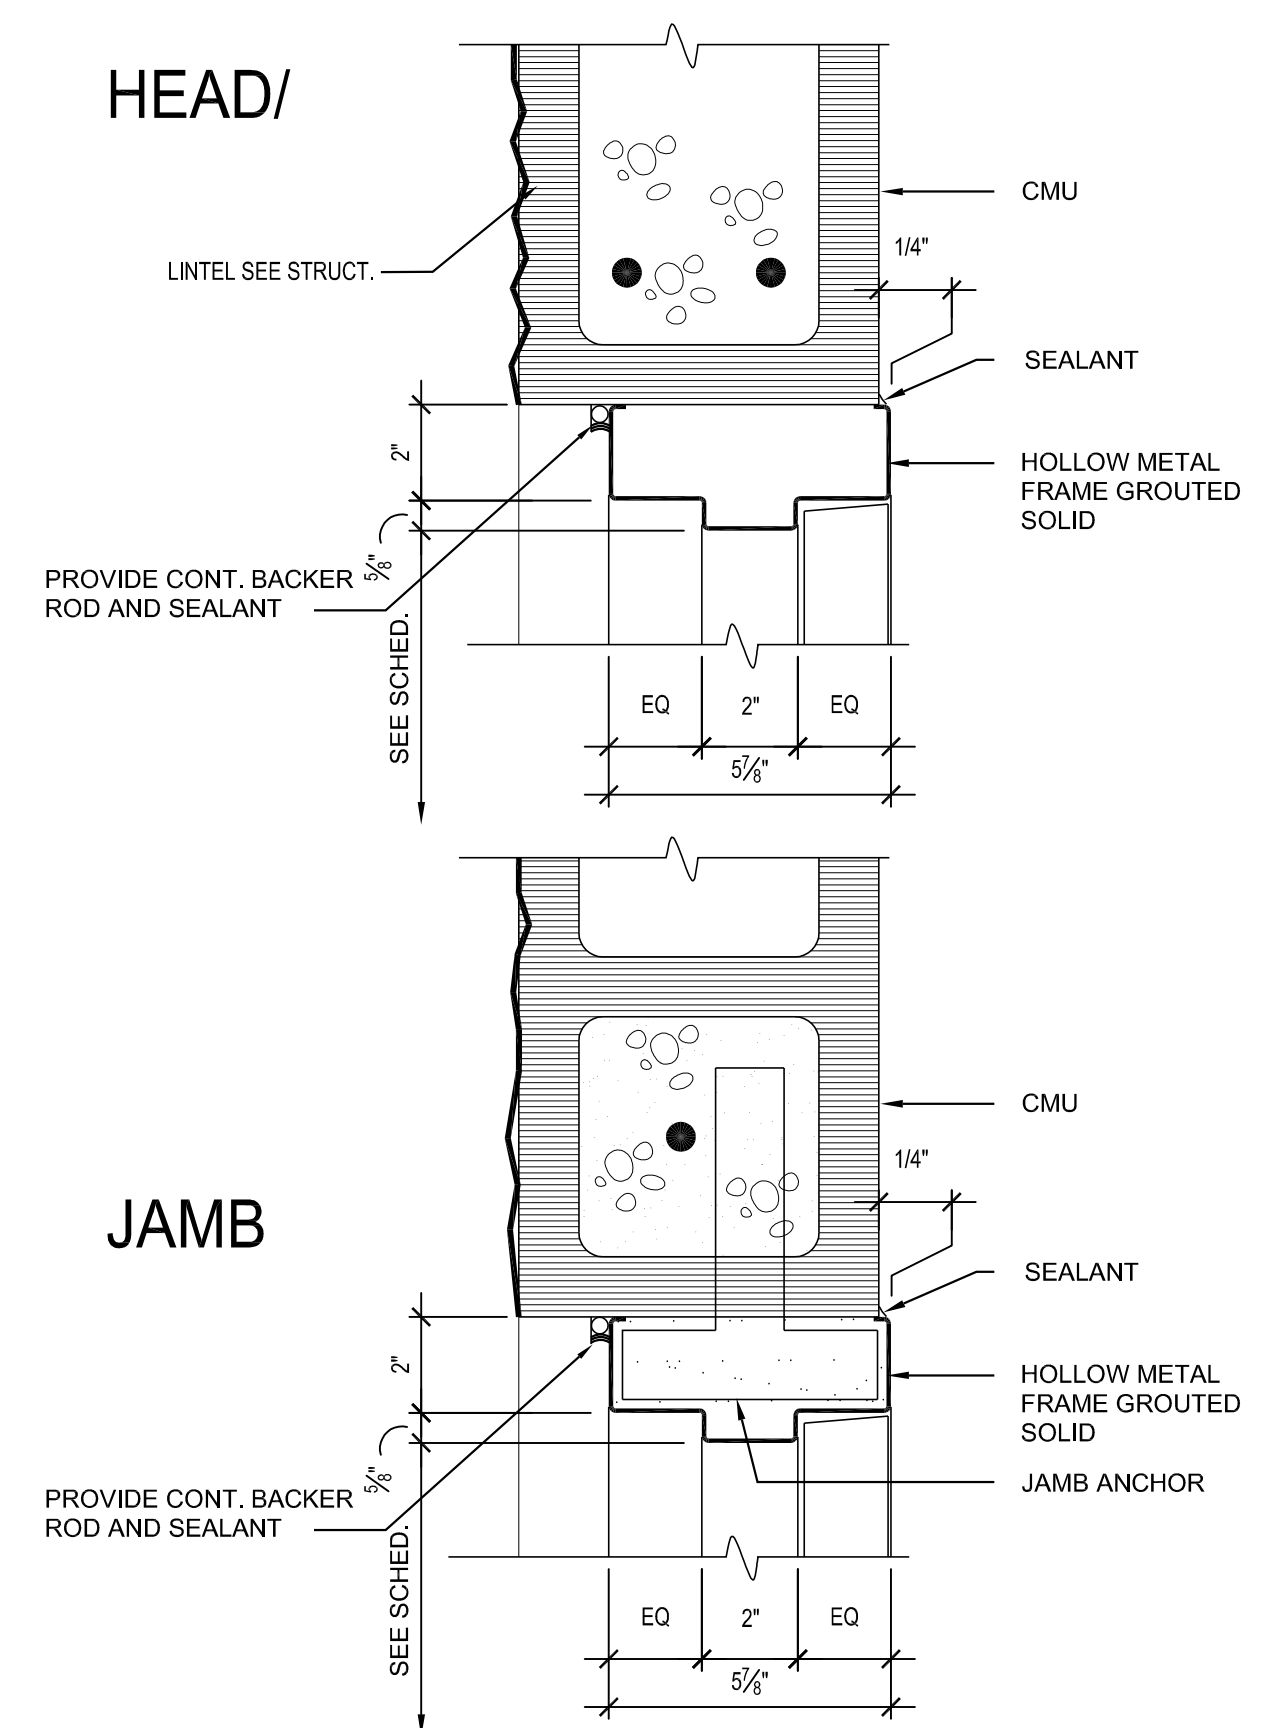

5 DOOR HEAD/JAMB  
SCALE: 3" = 1'-0"

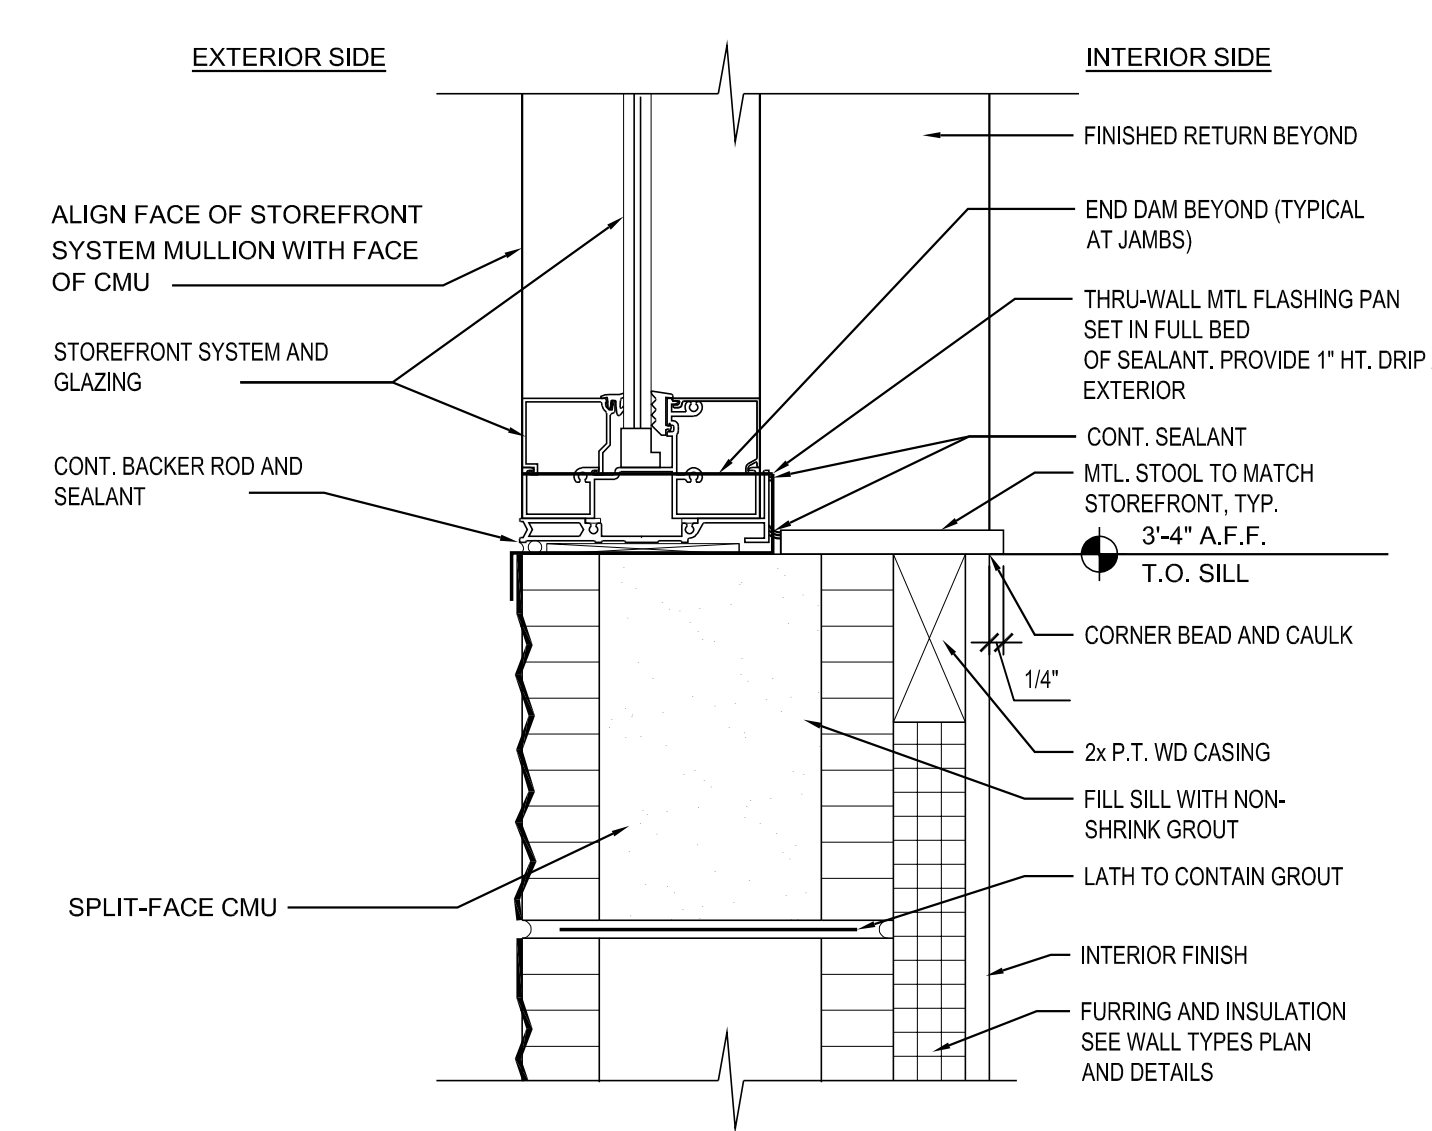

4 STOREFRONT SILL  
SCALE: 3" = 1'-0"

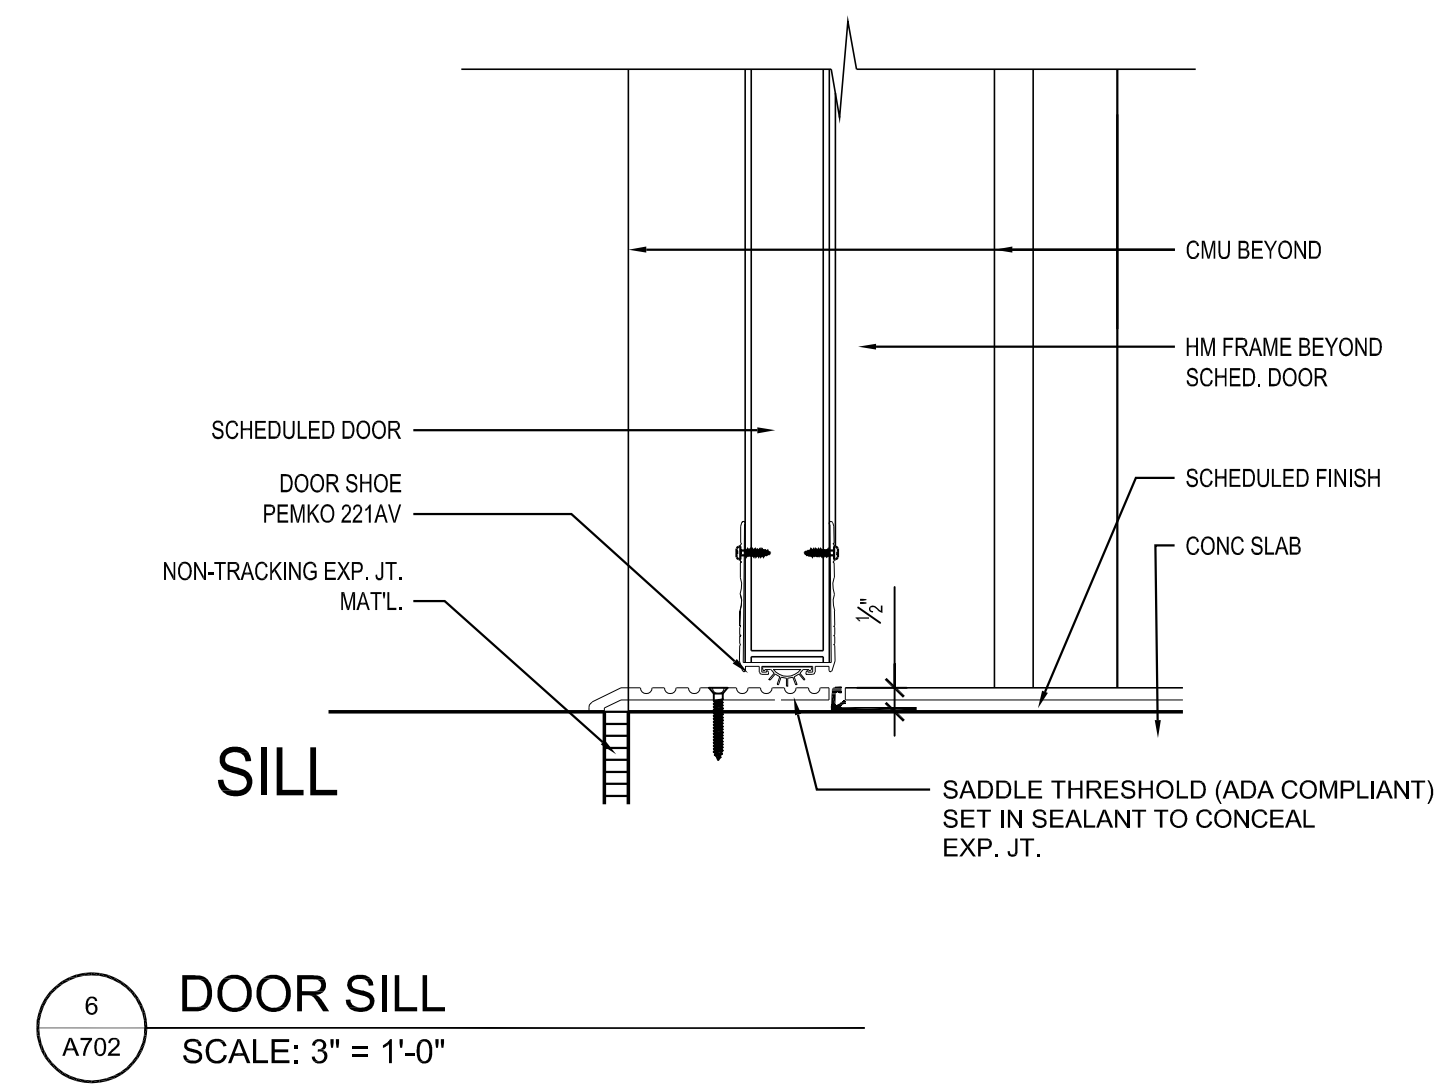

6 DOOR SILL  
SCALE: 3" = 1'-0"





Plotted By: Rodriguez, Rebecca - Sheet Set: IRC LANDFILL - Layout: C-200 - DEMOLITION NOTES - November 17, 2021 - 10:38:54am - K:\vmb-civil\14-3228000 - irc-irh-walk-and-recycling-facility\CIVIL\CADD\plansheets\C-200-DEMOLITION NOTES.dwg  
 This document, together with the concepts and designs presented herein, is intended only for the specific purpose and client for which it was prepared. Reuse of and improper reliance on this document without written authorization and adaptation by Kimley-Horn and Associates, Inc. shall be without liability to Kimley-Horn and Associates, Inc.

## DEMOLITION NOTES AND SPECIFICATIONS:

SHOULD ANY SECTION OF THESE DEMOLITION NOTES BE IN DIRECT CONFLICT WITH THE PROVISIONS OR TECHNICAL SPECIFICATIONS CONTAINED IN THE CONTRACT DOCUMENTS FOR THIS PROJECT, THE MORE STRINGENT OF THE TWO SHALL GOVERN.

### I. GENERAL

- FOR THIS PROJECT, "OWNER" SHALL MEAN INDIAN RIVER COUNTY. "SURVEY" SHALL MEAN THE BOUNDARY SURVEY PREPARED BY MASTELLER, MOLER & TAYLOR, INC. AND "ENGINEER" SHALL MEAN THE ENGINEER OF RECORD.
- EXISTING CONDITIONS, UTILITIES, STRUCTURES AND OTHER IMPROVEMENTS, AS SHOWN ON THE DEMOLITION DRAWINGS, WERE TAKEN FROM THE SURVEY (PREPARED BY MASTELLER, MOLER & TAYLOR, INC. LAST AMENDED ON 8/21/20), AND FROM INFORMATION PROVIDED BY UTILITY COMPANIES. AN ATTEMPT HAS BEEN MADE TO SHOW ALL EXISTING STRUCTURES, UTILITIES, DRIVES, WALKS, ETC., IN THEIR APPROXIMATE LOCATION. OTHERS MAY EXIST AND MAY BE FOUND UPON VISITING THE SITE. IT WILL BE THE RESPONSIBILITY OF THE CONTRACTOR TO ACCURATELY LOCATE ALL FACILITIES AND TO DETERMINE THEIR EXTENT. IF SUCH FACILITIES OBSTRUCT THE PROGRESS OF THE WORK AND ARE NOT INDICATED TO BE REMOVED OR RELOCATED, THEY SHALL BE REMOVED OR RELOCATED ONLY AS DIRECTED BY THE OWNER, ARCHITECT, OR ENGINEER OF RECORD, AT NO ADDITIONAL COST TO THE OWNER.
- ORGANIZE AND PERFORM DEMOLITION WORK TO AVOID DAMAGE TO CONSTRUCTION INTENDED TO REMAIN. ANY COMPONENTS INTENDED TO REMAIN BUT DAMAGED DURING DEMOLITION WILL BE REPLACED, NEW, BY THE CONTRACTOR AT THE CONTRACTOR'S EXPENSE.
- DEMOLITION AND REMOVAL OPERATIONS SHALL BE CONDUCTED IN AN EXPEDIENT MANNER, WITH PRECAUTIONS TAKEN TO PREVENT THE DEMOLITION SITE FROM BEING A NUISANCE.
- PERFORM REMOVAL AND DEMOLITION IN ACCORDANCE WITH DEMOLITION SCHEDULE (REFER TO SECTION IV.) AND TAKE NECESSARY PRECAUTIONS TO PROTECT EXISTING ADJACENT BUILDINGS, FURNISHINGS, AND EQUIPMENT. NOTIFY THE ENGINEER OF ANY CONDITIONS THAT MAY AFFECT THE SAFETY OF OCCUPANTS OF ADJACENT BUILDINGS, THE NORMAL USE OF THESE FACILITIES, OR THE PHYSICAL CONDITION OF THE STRUCTURES.
- ALL EXISTING UTILITIES OUTSIDE THE PROPERTY BOUNDARIES ARE TO REMAIN, UNLESS OTHERWISE NOTED. ALL DEMOLITION WORK SHALL BE VERIFIED AGAINST PROPOSED WORK.
- PRIOR TO DEMOLITION ACTIVITIES, IT SHALL BE THE CONTRACTOR'S RESPONSIBILITY TO CONTACT ALL AFFECTED UTILITY COMPANIES IN ORDER TO COORDINATE THE DEACTIVATION OF ALL EXISTING UTILITY LINES WITHIN THE PROPERTY. ONCE ALL ONSITE UTILITIES HAVE BEEN DEACTIVATED, ALL LINES SHALL BE CUT AND CAPPED INSIDE THE PROPERTY LINE, AND REMOVED (UNLESS OTHERWISE INDICATED).
- THE CONTRACTOR SHALL USE EXTREME CAUTION IN REMOVING ANY STRUCTURES AND UTILITIES ABOVE AND BELOW GRADE TO PREVENT DAMAGE TO EXISTING UTILITIES WHICH ARE TO REMAIN IN SERVICE. ANY DAMAGE TO EXISTING PIPELINES, UTILITIES, ETC., CAUSED BY THE CONTRACTOR SHALL BE REPAIRED, AT THE CONTRACTOR'S EXPENSE, IN A MANNER ACCEPTABLE TO THE PARTY IN OWNERSHIP OF THE DAMAGED PROPERTY. THE CONTRACTOR SHALL REPORT ANY EXISTING DAMAGE PRIOR TO BEGINNING WORK. IN THE EVENT OF ACCIDENTAL DISRUPTION OF UTILITIES OR THE DISCOVERY OF PREVIOUSLY UNKNOWN UTILITIES, CONTRACTOR MUST NOTIFY THE AFFECTED UTILITY COMPANY AND THE ENGINEER, THE UTILITY COMPANY, ENGINEER, AND CONTRACTOR MUST FIRST AGREE ON A PLAN TO CORRECT THE SITUATION OR IDENTIFY THE UTILITY SERVICE LINE. ALL ASSOCIATED COSTS SHALL BE INCURRED AT THE CONTRACTOR'S EXPENSE.
- NO LIGHTING MAY BE REMOVED FROM PUBLIC STREETS UNTIL PROPOSED LIGHTING IS FULLY IN PLACE. OTHERWISE CONTRACTOR SHALL INSTALL A TEMPORARY LIGHTING SYSTEM, SO THAT NO AREA USED BY THE PUBLIC WILL HAVE LESS LIGHTING THAN CURRENTLY EXISTS.
- EXISTING WORK NOT SPECIFIED FOR REMOVAL WHICH IS TEMPORARILY REMOVED, DAMAGED, EXPOSED, OR IN ANY WAY DISTURBED OR ALTERED BY REMOVAL WORK SHALL BE REPAIRED, PATCHED OR REPLACED, AT THE CONTRACTOR'S EXPENSE, TO THE ENGINEER'S SATISFACTION.
- TITLE AND RESPONSIBILITY OF MATERIALS AND EQUIPMENT TO BE REMOVED, EXCEPT SALVAGEABLE EQUIPMENT TO BE RETAINED BY THE OWNER, IS VESTED TO THE CONTRACTOR UPON RECEIPT OF NOTICE TO PROCEED. THE OWNER WILL NOT BE RESPONSIBLE FOR THE CONDITION, LOSS OR DAMAGE TO SUCH MATERIALS AND EQUIPMENT AFTER NOTICE TO PROCEED.
- IT IS THE CONTRACTOR'S RESPONSIBILITY TO:
  - PROTECT ALL EXISTING STRUCTURAL ELEMENTS TO REMAIN DURING DEMOLITION
  - IF APPLICABLE, PROVIDE A TEMPORARY PATCH AND REPAIR TO ALL SURFACES AFFECTED BY DEMOLITION WHICH ARE TO BE RECONSTRUCTED AS PART OF THIS PROJECT.
  - EXIST. CONC. OR ASPHALT PAVEMENT TO BE REMOVED SHALL BE SAW-CUT IN NEAT, STRAIGHT LINES.
  - EXIST. IRRIGATION LINES WITHIN THE LIMITS OF DEMOLITION TO BE REMOVED.
  - ALL EXISTING WIRE, IRON, CHAIN LINK, WOOD FENCES ARE TO REMAIN UNLESS OTHERWISE SPECIFIED.
  - NO ELECTRIC POLE, STREET LIGHT, WATER MET/VALVE, FIRE HYDRANT ETC. WILL BE REMOVED WITHIN THE ROADWAY RIGHT OF WAY LINES.
  - REFER TO LANDSCAPE PLANS FOR ALL EXIST. TREES.
  - EXIST. MONITORING WELLS TO REMAIN AND BE PROTECTED AT ALL TIMES.
  - ALL EXISTING SURVEY REFERENCES AND MARKERS SHALL REMAIN IN PLACE OR BE REPLACED AT NO ADDITIONAL COST TO THE OWNER.

### II. DESCRIPTION

- PROVIDE ALL LABOR, MATERIALS, EQUIPMENT, SERVICES, ETC., NECESSARY AND INCIDENTAL TO THE COMPLETION OF ALL SITE DEMOLITION AND CLEARING WORK AS SHOWN ON THE DRAWINGS AND SPECIFIED HEREIN, INCLUDING THE LEGAL TRANSPORT AND OFF-SITE DISPOSAL OF DEMOLITION DEBRIS.
- ALL ONSITE WORK INCLUDED CONSISTS OF, BUT IS NOT LIMITED TO, THE FOLLOWING:
  - FULL-DEPTH REMOVAL OF EXISTING SIDEWALKS, DRIVES, CURBS, PAVEMENT, ETC.
  - CLEARING SITE OF DEMOLITION DEBRIS.
  - REMOVAL FROM SITE AND DISPOSAL OF ALL EXCESS AND UNUSABLE MATERIAL.
  - COORDINATION WITH ALL UTILITY COMPANIES/OWNERS PRIOR TO DEACTIVATION.

### III. APPLICABLE CODES

- DEMOLITION AND TRANSPORTATION OF DEBRIS SHALL COMPLY WITH APPLICABLE LOCAL, STATE, AND FEDERAL CODES AND REGULATIONS GOVERNING THESE OPERATIONS. THE CONTRACTOR SHALL OBTAIN AND PAY FOR ANY PERMITS, BONDS, LICENSES, ETC., REQUIRED FOR DEMOLITION AND CLEARING WORK.
- ANY WORK WITHIN PUBLIC RIGHT-OF-WAY SHALL BE DONE IN ACCORDANCE WITH THE REQUIREMENTS OF THE INDIAN RIVER COUNTY PUBLIC WORKS DEPARTMENT, FLORIDA DEPARTMENT OF TRANSPORTATION, AND OTHER GOVERNMENTAL AGENCIES HAVING JURISDICTION, AND SHALL NOT BEGIN UNTIL THE CONTRACTOR HAS NOTIFIED, AND ALL REQUIRED PERMITS HAVE BEEN OBTAINED FROM, THESE GOVERNING AUTHORITIES.

### IV. SEQUENCING AND SCHEDULING

- AREAS ADJACENT TO DEMOLITION AND REMOVAL WORK MAY BE OCCUPIED BUT THE ACTIVITIES IN THOSE AREAS CANNOT BE INTERRUPTED OR DISTURBED DURING NORMAL WORKING HOURS. DEMOLITION SCHEDULE SHALL BE COORDINATED WITH ALL ADJACENT PROPERTY OWNERS AND ANY OTHER PARTIES WHOSE DAILY ACTIVITIES WOULD BE AFFECTED BY THE DEMOLITION WORK.
- COORDINATE WITH APPLICABLE UTILITY COMPANIES FOR UTILITY LINE REMOVAL, CAPPING AND UTILITY SHUTDOWNS NECESSITATED BY REMOVAL WORK.
- AREAS ADJACENT TO DEMOLITION AND REMOVAL WORK MAY BE OCCUPIED BUT THE ACTIVITIES IN THOSE AREAS CANNOT BE INTERRUPTED OR DISTURBED DURING NORMAL WORKING HOURS. DEMOLITION SCHEDULE SHALL BE COORDINATED WITH ALL ADJACENT PROPERTY OWNERS AND ANY OTHER PARTIES WHOSE DAILY ACTIVITIES WOULD BE AFFECTED BY THE DEMOLITION WORK.
- DISPOSITION OF DEMOLISHED MATERIALS BY BURNING IS NOT PERMITTED.

### V. ENVIRONMENTAL PROTECTION


- CONTROL AMOUNT OF DUST RESULTING FROM CONSTRUCTION OR DEMOLITION TO PREVENT SPREAD OF DUST TO OTHER BUILDINGS AND TO AVOID CREATION OF A NUISANCE IN SURROUNDING AREAS. USE OF WATER TO CONTROL DUST WILL NOT BE PERMITTED WHEN IT WILL RESULT IN, OR CREATE, HAZARDOUS OR OBJECTIONABLE CONDITIONS SUCH AS FLOODING.
- NOISE PRODUCING ACTIVITIES SHALL BE HELD TO A MINIMUM. INTERNAL COMBUSTION ENGINES AND COMPRESSORS, ETC., SHALL BE EQUIPPED WITH MUFFLERS TO REDUCE NOISE TO A MINIMUM. COMPLY WITH ALL NOISE ABATEMENT ORDINANCES.
- THE USE OF EXPLOSIVES WILL NOT BE PERMITTED.
- DISPOSITION OF DEMOLISHED MATERIALS BY BURNING IS NOT PERMITTED.
- ALL CLEARING SHALL BE PERFORMED IN A MANNER SUCH AS TO PREVENT ANY WASH-OFF OF SOILS AND DEBRIS FROM THE SITE INTO PUBLIC RIGHT-OF-WAY STREAMS, AND/OR STORM DRAINAGE SYSTEMS. APPROPRIATE SEDIMENTATION PONDS, DIKES, COLLARS, AND FILTER MEDIA SHALL BE EMPLOYED IN ACCORDANCE WITH THE EROSION CONTROL PLANS TO INSURE COMPLIANCE WITH THESE REQUIREMENTS, WHERE A SPECIFIC STATUTE GOVERNS THESE PROCEDURES, SUCH STATUTE SHALL BE COMPLIED WITH IN ITS ENTIRETY.
- DURING THE ENTIRE COURSE OF OPERATIONS, ALL EXISTING DRAINAGE WAYS, BOTH INTO AND FROM THE PROJECT AREA SHALL BE MAINTAINED IN A FUNCTIONAL CONDITION, AND BE CLEANED AS NECESSARY.
- AT ALL TIMES DURING THE CLEARING OPERATION, THE EXPOSED AREAS OF SUBGRADE SHALL BE MAINTAINED IN A CONDITION COMPATIBLE WITH POSITIVE DRAINAGE OF THE WORK AREA. NO WATER WILL BE PERMITTED TO STAND IN OPEN EXCAVATIONS. ALL STORMWATER RUNOFF SHALL BE CONTAINED WITHIN THE SITE. FAILURE TO MAINTAIN SUCH DRAINAGE SHALL BE CONSIDERED ADEQUATE CAUSE FOR THE ENGINEER, OWNER, OR INSPECTOR TO ORDER TEMPORARY SUSPENSION OF THE WORK. ALL ASSOCIATED COSTS SHALL BE INCURRED AT THE CONTRACTOR'S EXPENSE.
- PROVIDE SUITABLE AND FUNCTIONAL DRAINAGE BY OPENING DITCHES, FILTER DRAINS, TEMPORARY CUT-OFF LINES, ETC., AND ERECT TEMPORARY PROTECTIVE STRUCTURES WHERE NECESSARY. ALL EMBANKMENTS SHALL BE BACK-BLADED AND SUITABLY SEALED TO PROTECT AGAINST ADVERSE WEATHER CONDITIONS.
- THE CONTRACTOR SHALL TAKE ALL NECESSARY PRECAUTIONS WHEN REMOVING ABANDONED AND DE-ENERGIZED MATERIALS. IF ASBESTOS PIPES ARE ENCOUNTERED, THE CONTRACTOR WILL TAKE ALL NECESSARY ABATEMENT STEPS AS REQUIRED BY GOVERNING REGULATIONS TO SAFELY REMOVE AND DISPOSE OF SAID FACILITIES. THE CONTRACTOR SHALL NOTIFY THE ENGINEER IMMEDIATELY UPON DISCOVERY OF SAID MATERIALS.

### VI. TRAFFIC MAINTENANCE

- CONTRACTOR SHALL FOLLOW THE MORE STRINGENT AND APPLICABLE PROCEDURE OUT OF THE FLORIDA DEPARTMENT OF TRANSPORTATION AND/OR INDIAN RIVER COUNTY PUBLIC WORKS MAINTENANCE OF TRAFFIC PROCEDURES DURING DEMOLITION IN PUBLIC RIGHT-OF-WAYS AND PRIVATE DRIVEWAYS, PEDESTRIAN PATHS, AND ROADWAYS (FDOT INDEX 600 SERIES).
- THE CONTRACTOR SHALL PROVIDE ADEQUATE BRACING, SHORING, TEMPORARY CROSSOVER FOR PEDESTRIAN AND VEHICULAR TRAFFIC INCLUDING PLATING, GUARDRAILS, LAMPS, WARNING SIGNS, FLAGS, ETC. AS REQUIRED BY AGENCIES HAVING JURISDICTION, AND SHALL NOT REMOVE THESE UNTIL THE NEED FOR PROTECTION CEASES.
- THE CONTRACTOR MAY NOT CLOSE ANY SIDEWALKS WITHOUT PROVIDING ALTERNATE ROUTES IN ACCORDANCE WITH FDOT INDEX 660 AND AUTHORIZATION FROM AGENCIES HAVING JURISDICTION.
- CONDUCT REMOVAL OPERATIONS SO THAT TRAFFIC IS MAINTAINED ALONG EXISTING STREETS AND WALKS. KEEP PAVED STREETS AND WALKWAYS CLEAN AND FREE OF DEBRIS. REMOVE MATERIAL AND OTHER MATTER TRACKED OR FALLEN ONTO TRAFFIC SURFACES.

### VII. CLEAN UP

- REMOVE DEMOLISHED CONSTRUCTION MATERIALS AND RELATED DEBRIS FROM THE SITE ON A REGULAR BASIS. ACCUMULATION OF DEBRIS ON THE SITE WILL NOT BE PERMITTED. SELLING OF SALVAGEABLE MATERIALS IS NOT PERMITTED AT THE SITE. LEED RELATED SALVAGEABLE MATERIALS MUST BE DOCUMENTED BY THE CONTRACTOR.
- REMOVE MATERIALS, INCLUDING DEBRIS AND DUST, AND DISPOSE OF LEGALLY OFF SITE. NO DEBRIS SHALL BE BURNED OR BURIED ON THE SITE AS A MEANS OF DISPOSAL. USE METHODS APPROVED BY THE REGULATORY AGENCIES PRIOR TO BEGINNING CLEANUP OPERATIONS. USE OF BLOWERS TO DISTRIBUTE DUST WILL NOT BE PERMITTED.
- MATERIAL DESIGNATED FOR REMOVAL SHALL BECOME THE PROPERTY OF THE CONTRACTOR.

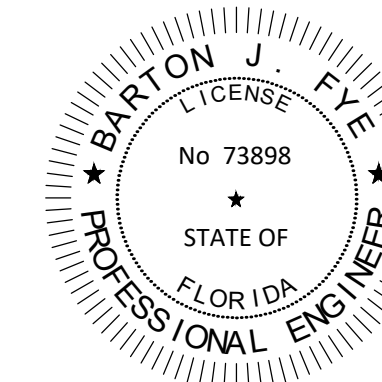

This item has been digitally signed and sealed by Barton J. Fye, P.E. on the date adjacent to the seal.

Printed copies of this document are not considered signed and sealed and the signature must be verified on any electronic copies.

Date: 11/17/2021



Call 811 or www.sunshine811.com two full business days before digging to have utilities located and marked.

Check positive response codes before you dig!

IRC LANDFILL  
PREPARED FOR  
INDIAN RIVER COUNTY

DEMOLITION NOTES

INDIAN RIVER COUNTY  
FL

SHEET NUMBER  
C-200

LICENSED PROFESSIONAL

KHA PROJECT  
14-3228000

DATE  
JULY 2021

SCALE AS SHOWN

DESIGNED BY MRC

DRAWN BY RMR

CHECKED BY BF

DATE:

**Kimley»Horn**

© 2021 KIMLEY-HORN AND ASSOCIATES, INC.  
355 ALHAMBRA CIRCLE, SUITE 1400, CORAL GABLES, FL 33134  
PHONE: 305-673-2025  
WWW.KIMLEY-HORN.COM | REGISTRY 696

REVISIONS


No.

DATE



BY



Plotted By: Rebecca, Sheet: Set: IRC LANDFILL, Layout: C-210, DEMOLITION PLAN, November 17, 2021, 10:38:12am, k:\mb\_civil\143228000 - rc\_hrw and recycling facility\CADD\plansheets\C-210 DEMOLITION PLAN.dwg  
 This document, together with the concepts and designs presented herein, is intended only for the specific purpose and client for which it was prepared. Reuse of and improper reliance on this document without written authorization and adaptation by Kimley-Horn and Associates, Inc. shall be without liability to Kimley-Horn and Associates, Inc.

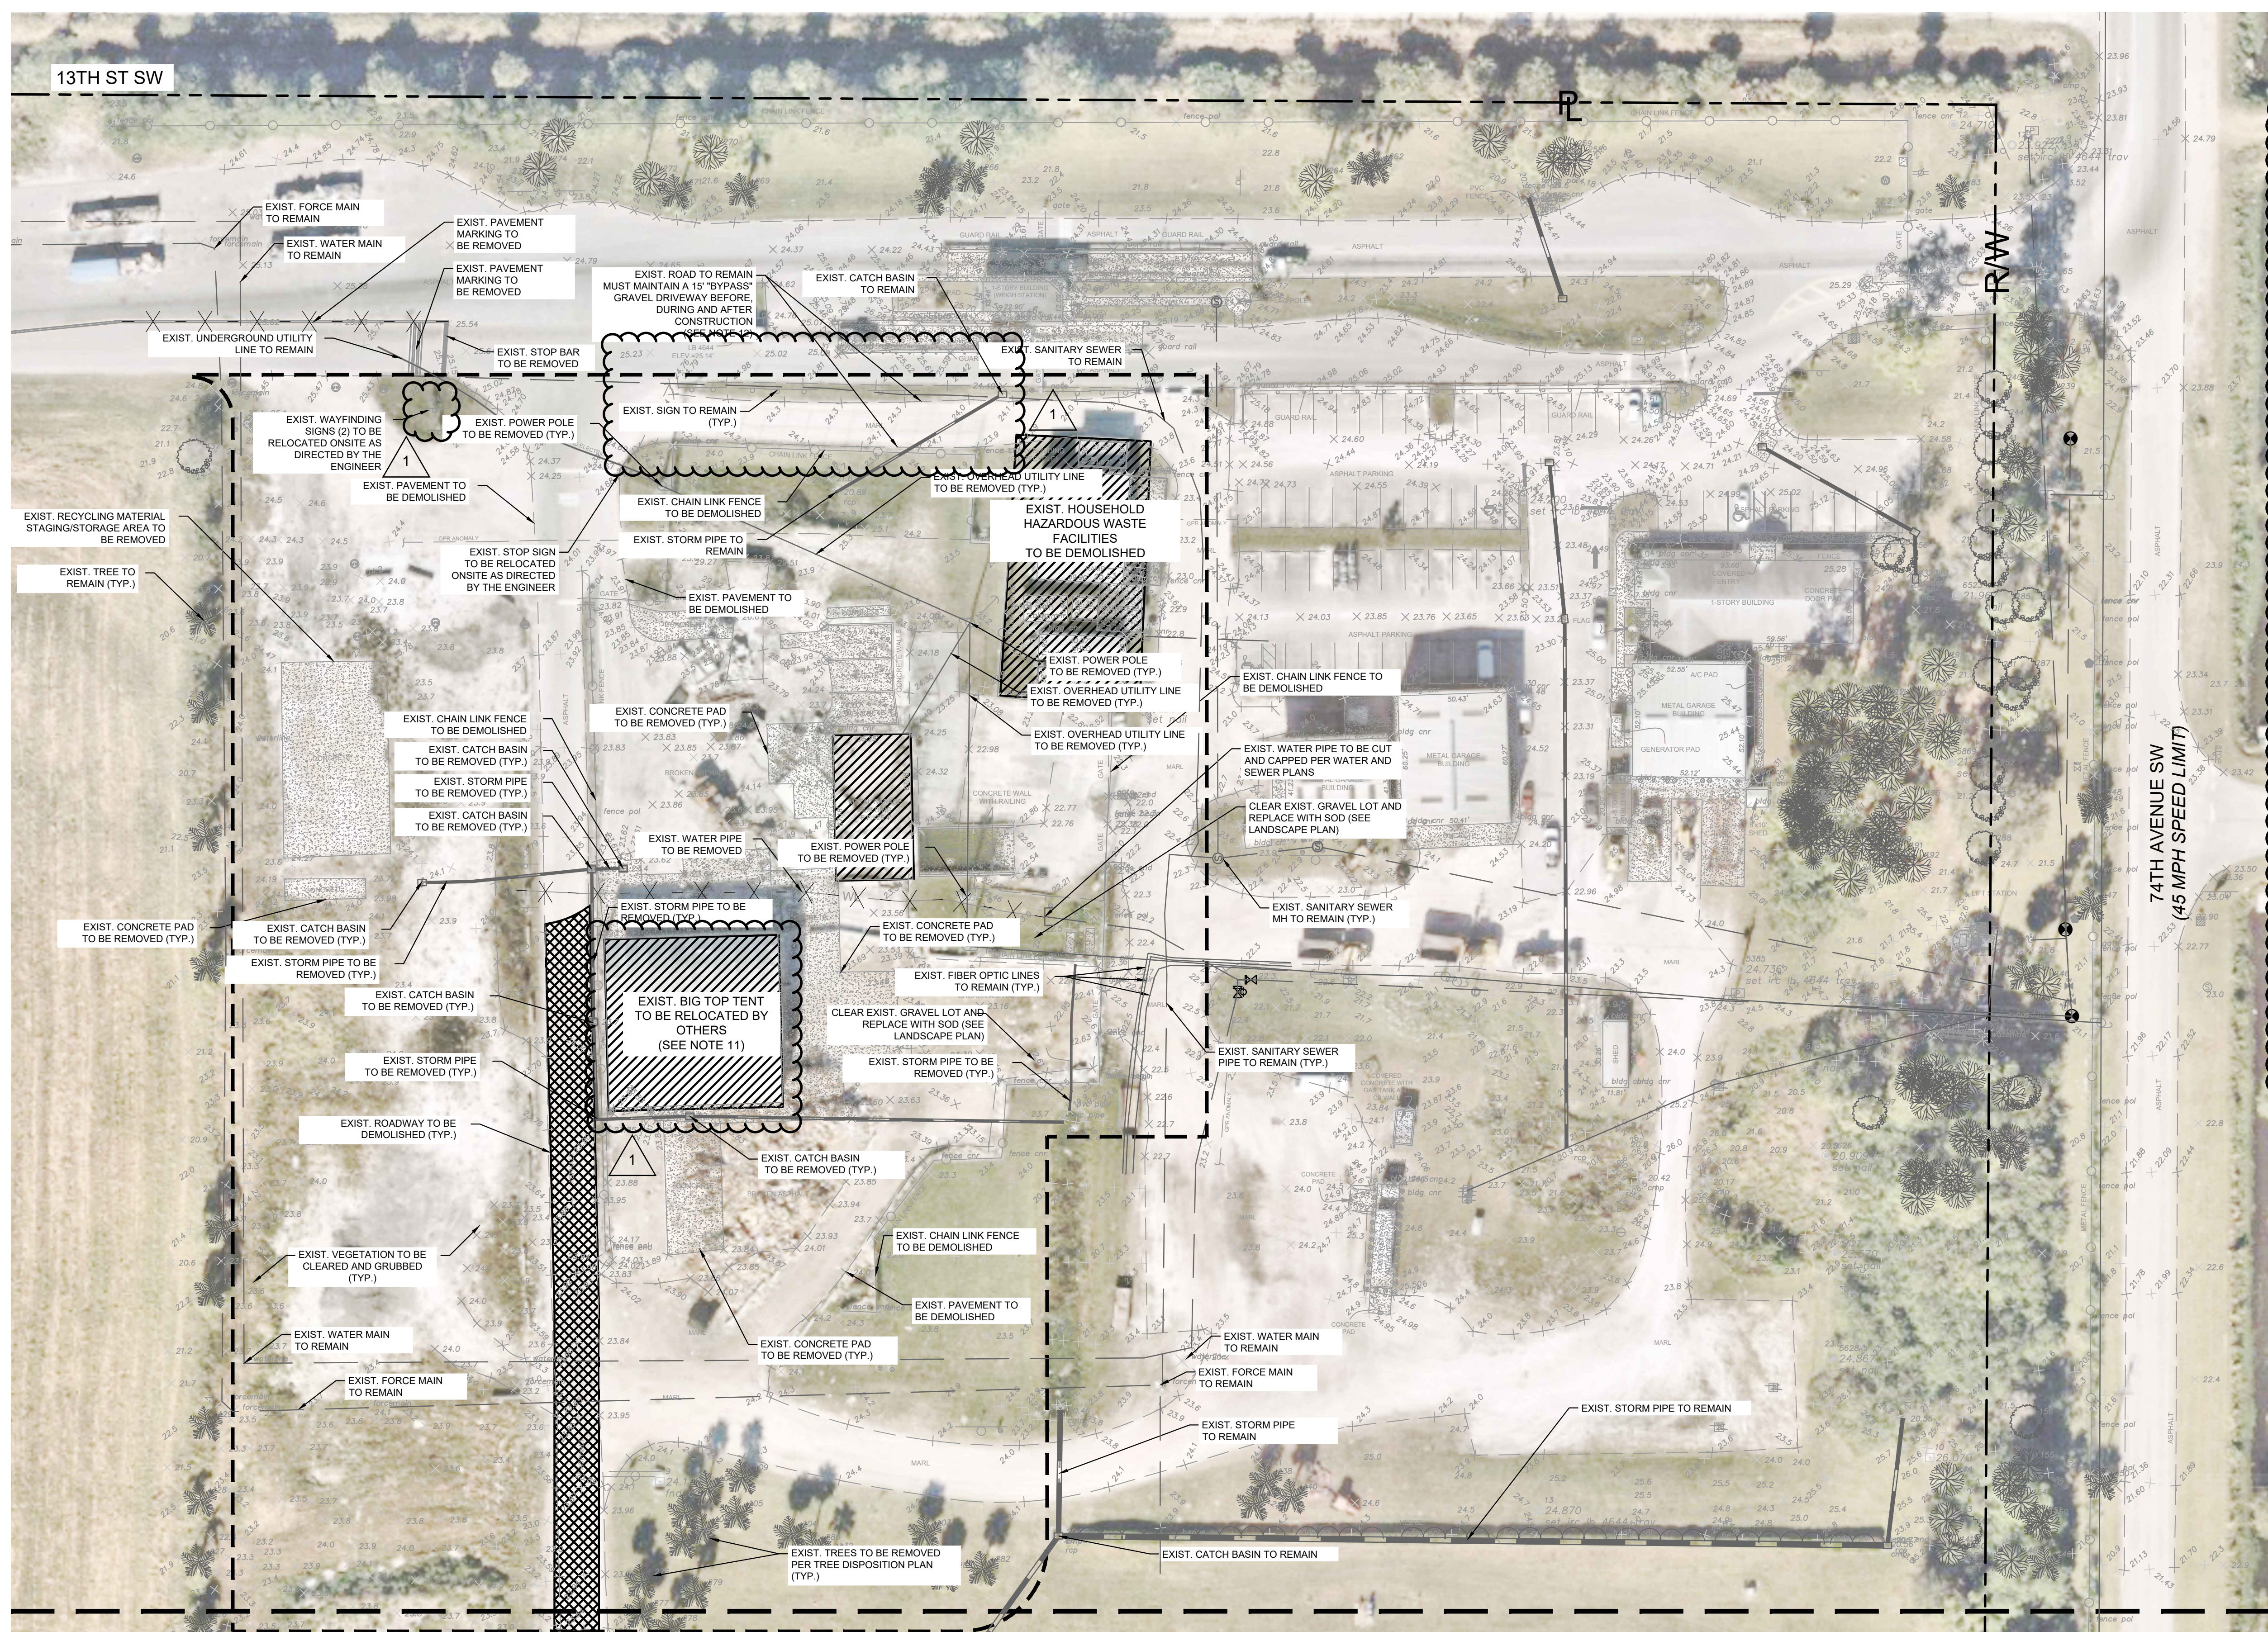

SEE SHEET C-211 FOR CONTINUATION

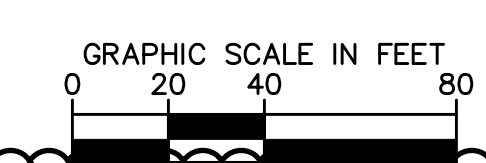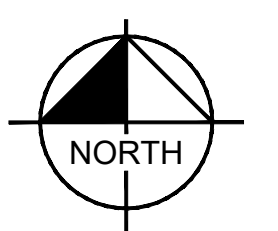


**LEGEND**

- RIGHT-OF-WAY LINE / PROPERTY LINE
- LIMITS OF DEMOLITION AREA
- EXIST. FIRE HYDRANT ASSEMBLY
- EXIST. LIGHT POLES
- EXIST. SAN. SEWER MANHOLE
- EXIST. STORM MANHOLE
- EXIST. WATER GATE VALVE
- EXIST. GRAVEL ROAD

**NOTES**

1. THE INTENT OF THE DEMOLITION PLAN IS TO DEPICT ALL EXISTING FEATURES THAT ENCUMBER THE PROPOSED CONSTRUCTION AREA AND ARE SCHEDULED FOR REMOVAL. SOME INCIDENTAL ITEMS MAY HAVE BEEN INADVERTENTLY OMITTED FROM THE PLAN. THE CONTRACTOR IS ENCOURAGED TO THOROUGHLY INSPECT THE SITE AS WELL AS REVIEW THE PLANS AND SPECIFICATIONS PRIOR TO SUBMITTING PRICING. CONTRACTOR WILL NOT RECEIVE ADDITIONAL COMPENSATION FOR INCIDENTAL ITEMS NOT SHOWN ON THIS DEMOLITION PLAN.
2. SEE SHEET C-510 FOR LIMITS AND GRADING OF RESURFACED DRIVEWAYS AND ENTRANCES. ADDITIONAL DEMOLITION MAY BE REQUIRED.
3. SEE SHEET C-310 FOR INLET PROTECTION AND EROSION PREVENTION MEASURES TO BE IN PLACE PRIOR TO DEMOLITION ACTIVITIES.
4. CONTRACTOR TO CONFIRM EXISTING DEMO LIMITS AND SITE GRADING PRIOR TO CONSTRUCTION.
5. CONTRACTOR TO SAWCUT WHEN REMOVING EXIST. PAVEMENT THAT IS ADJACENT TO EXIST. PAVEMENT THAT IS TO REMAIN. CONTRACTOR IS RESPONSIBLE FOR REPAIRS TO EXISTING CONCRETE OR ASPHALT TO REMAIN IF DAMAGED DURING CONSTRUCTION.
6. EXISTING TREES TO BE REMOVED SEE LANDSCAPE PLANS FOR TREE DISPOSITION (TYP.)
7. EVERYTHING WITHIN THE DEMOLITION AREA IS TO BE REMOVED INCLUDING UNDERGROUND UTILITIES UNLESS NOTED OTHERWISE.
8. ALL DEMOLITION IN THE PUBLIC RIGHT-OF-WAY WILL REQUIRE A SEPARATE RIGHT-OF-WAY CONSTRUCTION PERMIT.
10. IF MONITORING WELLS ARE ENCOUNTERED, THE ENGINEER OF RECORD IS TO BE NOTIFIED OF THE LOCATION(S).
11. EXIST. BIG TOP TENT TO BE RELOCATED SOUTH TO EXISTING 80' X 240' CONCRETE PAD BY OTHERS. ANY REMAINING FACILITIES, FOUNDATIONS OR OTHER EXISTING APURTANCES AFTER RELOCATION SHALL BE DEMOLISHED.
12. CONTRACTOR SHALL COORDINATE FINAL GRAVEL ROAD LAYOUT WITH ENGINEER IN THE FIELD DURING CONSTRUCTION.



|  |   |   |   |  |
|--|---|---|---|--|
|  | © 2021 KIMLEY-HORN AND ASSOCIATES, INC.<br>355 ALHAMBRA CIRCLE, SUITE 1400, CORAL GABLES, FL 33154<br>PHONE: 305-673-2025<br>WWW.KIMLEY-HORN.COM REGISTRY 696 | DEMOLITION PLAN I<br>SHEET NUMBER<br><b>C-210</b> | PREPARED FOR<br><b>INDIAN RIVER COUNTY</b><br>INDIAN RIVER COUNTY<br>FL | DATE: JULY 2021<br>SCALE: AS SHOWN<br>DESIGNED BY: MRC<br>DRAWN BY: RMR<br>CHECKED BY: BF<br>DATE: |
|--|---|---|---|--|

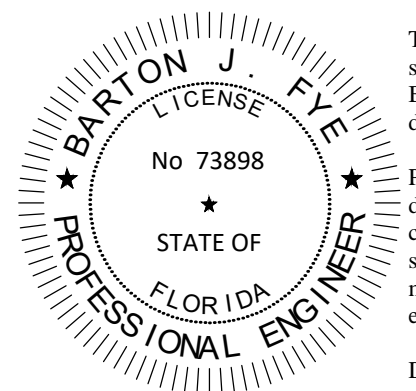

This item has been digitally signed and sealed by Barton J. Fye, P.E. on the date adjacent to the seal.  
 Printed copies of this document are not considered signed and sealed and the signature must be verified on any electronic copies.  
 Date: 11/17/2021

Call 811 or www.sunshine811.com two full business days before digging to have utilities located and marked.  
 Check positive response codes before you dig!

SEE SHEET C-210 FOR CONTINUATION

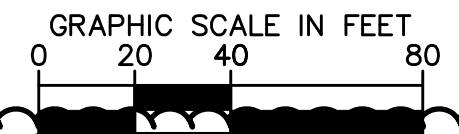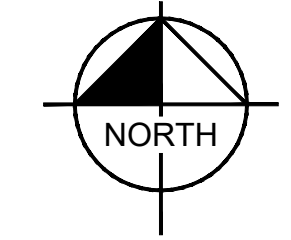

1



**LEGEND**

- RIGHT-OF-WAY LINE / PROPERTY LINE
- LIMITS OF DEMOLITION AREA
- EXIST. FIRE HYDRANT ASSEMBLY
- EXIST. LIGHT POLES
- EXIST. SAN. SEWER MANHOLE
- EXIST. STORM MANHOLE
- EXIST. WATER GATE VALVE
- EXIST. GRAVEL ROAD

**NOTES**

1. THE INTENT OF THE DEMOLITION PLAN IS TO DEPICT ALL EXISTING FEATURES THAT ENCUMBER THE PROPOSED CONSTRUCTION AREA AND ARE SCHEDULED FOR REMOVAL. SOME INCIDENTAL ITEMS MAY HAVE BEEN INADVERTENTLY OMITTED FROM THE PLAN. THE CONTRACTOR IS ENCOURAGED TO THOROUGHLY INSPECT THE SITE AS WELL AS REVIEW THE PLANS AND SPECIFICATIONS PRIOR TO SUBMITTING PRICING. CONTRACTOR WILL NOT RECEIVE ADDITIONAL COMPENSATION FOR INCIDENTAL ITEMS NOT SHOWN ON THIS DEMOLITION PLAN.
2. SEE SHEET C-510 FOR LIMITS AND GRADING OF RESURFACED DRIVEWAYS AND ENTRANCES. ADDITIONAL DEMOLITION MAY BE REQUIRED.
3. SEE SHEET C-310 FOR INLET PROTECTION AND EROSION PREVENTION MEASURES TO BE IN PLACE PRIOR TO DEMOLITION ACTIVITIES.
4. CONTRACTOR TO CONFIRM EXISTING DEMO LIMITS AND SITE GRADING PRIOR TO CONSTRUCTION.
5. CONTRACTOR TO SAWCUT WHEN REMOVING EXIST. PAVEMENT THAT IS ADJACENT TO EXIST. PAVEMENT THAT IS TO REMAIN. CONTRACTOR IS RESPONSIBLE FOR REPAIRS TO EXISTING CONCRETE OR ASPHALT TO REMAIN IF DAMAGED DURING CONSTRUCTION.
6. EXISTING TREES TO BE REMOVED SEE LANDSCAPE PLANS FOR TREE DISPOSITION (TYP.)
7. EVERYTHING WITHIN THE DEMOLITION AREA IS TO BE REMOVED INCLUDING UNDERGROUND UTILITIES UNLESS NOTED OTHERWISE.
8. ALL DEMOLITION IN THE PUBLIC RIGHT-OF-WAY WILL REQUIRE A SEPARATE RIGHT-OF-WAY CONSTRUCTION PERMIT.
9. IF MONITORING WELLS ARE ENCOUNTERED, THE ENGINEER OF RECORD IS TO BE NOTIFIED OF THE LOCATION(S).
10. EXIST. BIG TOP TENT TO BE RELOCATED SOUTH TO EXISTING 80' X 240' CONCRETE PAD BY OTHERS. ANY REMAINING FACILITIES, FOUNDATIONS OR OTHER EXISTING APPURTENANCES AFTER RELOCATION SHALL BE DEMOLISHED.
11. CONTRACTOR SHALL COORDINATE FINAL GRAVEL ROAD LAYOUT WITH ENGINEER IN THE FIELD DURING CONSTRUCTION.

Plotted By: Rodriguez, Rebecca - Sheet Set: IRC LANDFILL - Layout: C-211 - DEMOLITION PLAN - November 17, 2021 - 10:39:17am - k:\vmb-civil\143228000 - irc.thw and recycling - facility\CIVIL\CADD\plansheets\C-210 - DEMOLITION PLAN.dwg  
 This document, together with the concepts and designs presented herein, is intended only for the specific purpose and client for which it was prepared. Reuse of and improper reliance on this document without written authorization and adaptation by Kimley-Horn and Associates, Inc. shall be without liability to Kimley-Horn and Associates, Inc.


| NO. | REVISIONS | DATE | BY |
|-----|-----------|------|----|
|     |           |      |    |
|     |           |      |    |
**Kimley >>> Horn**  
 © 2021 KIMLEY-HORN AND ASSOCIATES, INC.  
 355 ALHAMBRA CIRCLE, SUITE 1400, CORAL GABLES, FL 33154  
 PHONE: 305-673-2025  
 WWW.KIMLEY-HORN.COM REGISTRY 696

|             |           |
|-------------|-----------|
| KHA PROJECT | 143228000 |
| DATE        | JULY 2021 |
| SCALE       | AS SHOWN  |
| DESIGNED BY | MRC       |
| DRAWN BY    | RMR       |
| CHECKED BY  | BF        |
| DATE:       |           |

**DEMOLITION PLAN II**

IRC LANDFILL  
 PREPARED FOR  
 INDIAN RIVER COUNTY  
 INDIAN RIVER  
 COUNTY  
 SHEET NUMBER  
**C-211**

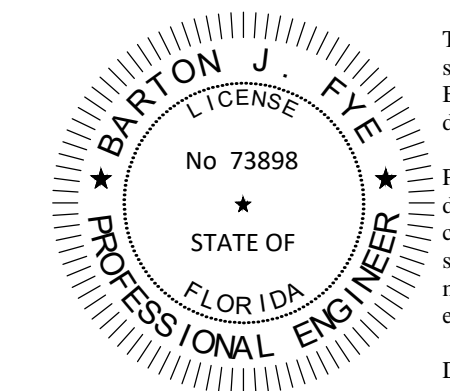

This item has been digitally signed and sealed by Barton J. Fye, P.E. on the date adjacent to the seal.  
 Printed copies of this document are not considered signed and sealed and the signature must be verified on any electronic copies.  
 Date: 11/17/2021

**Sunshine811**  
 Call 811 or www.sunshine811.com two full business days before digging to have utilities located and marked.  
 Check positive response codes before you dig!

### BEST MANAGEMENT PRACTICES (BMPs):

THIS PLAN HAS BEEN PREPARED TO ENSURE COMPLIANCE WITH APPROPRIATE CONDITIONS OF THE INDIAN RIVER COUNTY LAND DEVELOPMENT REGULATIONS, THE RULES OF THE FLORIDA DEPARTMENT OF ENVIRONMENTAL PROTECTION (FDEP), CHAPTER 17-25, F.A.C., ST. JOHNS RIVER WATER MANAGEMENT DISTRICT (SRWMD), CHAPTER 40D-4, F.A.C. AND THE UNITED STATES ENVIRONMENTAL PROTECTION AGENCY (EPA) DOCUMENT NO. EPA 832/R-92-005 (SEPTEMBER 1992). THE PLAN ADDRESSES THE FOLLOWING:

- A. PREVENT LOSS OF SOIL DURING CONSTRUCTION BY STORMWATER RUNOFF AND/OR WIND EROSION, INCLUDING PROTECTING TOPSOIL BY STOCKPILING FOR REUSE.
- B. SEDIMENTATION PROTECTION OF STORM SEWER OR RECEIVING STREAM.
- C. PREVENT POLLUTING THE AIR WITH DUST AND PARTICULATE MATTER. THE VARIOUS TECHNIQUES OR ACTIONS IDENTIFIED UNDER EACH SECTION INDICATE THE APPROPRIATE SITUATION WHEN THE TECHNIQUES SHOULD BE EMPLOYED. ALSO IDENTIFIED IS A CROSS-REFERENCE TO A DIAGRAM OR FIGURE REPRESENTING THE TECHNIQUE. IT SHOULD BE NOTED THAT THE MEASURES IDENTIFIED ON THIS PLAN ARE ONLY SUGGESTED BMP(S). THE CONTRACTOR SHALL PROVIDE POLLUTION PREVENTION AND EROSION CONTROL MEASURES AS SPECIFIED IN ACCORDANCE WITH THE CURRENT FLORIDA DEPARTMENT OF ENVIRONMENTAL PROTECTION NATIONAL POLLUTION DISCHARGE ELIMINATION SYSTEM (NPDES) REQUIREMENTS. CONTRACTOR SHALL PREPARE REQUIRED NPDES DOCUMENTATION AND OBTAIN PERMIT PRIOR TO COMMENCEMENT OF CONSTRUCTION. IT IS THE SOLE RESPONSIBILITY OF THE CONTRACTOR TO PREPARE THE REQUIRED NPDES DOCUMENT AND OBTAIN THE NPDES PERMIT. ALL COST ASSOCIATED WITH SUCH WORK SHALL BE DEEMED INCIDENTAL TO THE PROJECT LUMP SUM COST.

### GENERAL EROSION CONTROL NOTES:

- A. THE STORM WATER POLLUTION PREVENTION PLAN (SWPPP) IS COMPRISED OF THIS DRAWING, THE STANDARD DETAILS, THE NPDES PERMIT (TO BE OBTAINED BY CONTRACTOR) AND ALL SUBSEQUENT REPORTS AND RELATED DOCUMENTS.
- B. ALL CONTRACTORS AND SUBCONTRACTORS INVOLVED WITH STORM WATER POLLUTION PREVENTION SHALL OBTAIN A COPY OF THIS DRAWING AND THE STATE OF FLORIDA NATIONAL POLLUTANT DISCHARGE ELIMINATION SYSTEM GENERAL PERMIT (NPDES PERMIT) AND BECOME FAMILIAR WITH THEIR CONTENTS.
- C. CONTRACTOR SHALL IMPLEMENT BEST MANAGEMENT PRACTICES (BMP) IN ALL CONSTRUCTION ACTIVITIES INCLUDING BUT NOT LIMITED TO THE FOLLOWING:
  - 1. FUEL SPILLS AND LEAKS PREVENTION
  - 2. PREVENT/REDUCE VEHICLE AND EQUIPMENT WASHING AND STEAM CLEANING
  - 3. TIRE TREATMENT MAINTENANCE AND REPAIR
  - 4. PROPER OUTDOOR LOADING/UNLOADING OF MATERIALS
  - 5. PREVENT/REDUCE OUTDOOR STORAGE OF RAW MATERIALS, PRODUCTS, AND BY-PRODUCTS
  - 6. SOLID WASTE MANAGEMENT
  - 7. HAZARDOUS WASTE MANAGEMENT
  - 8. CONCRETE WASTE MANAGEMENT
  - 9. SANDBLASTING WASTE MANAGEMENT
  - 10. STRUCTURE CONSTRUCTION AND PAINTING
  - 11. SPILL PREVENTION AND CONTROL
  - 12. CONTAMINATED SOIL MANAGEMENT
  - 13. SANITARY/SEPTIC WASTE MANAGEMENT
  - 14. SOIL EROSION CONTROL
  - 15. STORM WATER TURBIDITY MANAGEMENT

ADDITIONAL BEST MANAGEMENT PRACTICES SHALL BE IMPLEMENTED AS DICTATED BY CONDITIONS AT NO ADDITIONAL COST TO THE OWNER THROUGHOUT ALL PHASES OF CONSTRUCTION.

- D. BEST MANAGEMENT PRACTICES (BMPs) AND CONTROLS SHALL CONFORM TO FEDERAL, STATE, OR LOCAL REQUIREMENTS OR MANUAL OF PRACTICE, AS APPLICABLE. CONTRACTOR SHALL IMPLEMENT ADDITIONAL CONTROLS AS DIRECTED BY PERMITTING AGENCY OR OWNER.
- E. SITE MAP MUST CLEARLY DELINEATE ALL STATE WATERS. CONTRACTOR MUST MAINTAIN ALL PERMITS FOR ANY CONSTRUCTION ACTIVITY IMPACTING STATE WATERS OR REGULATED WETLANDS ON SITE AT ALL TIMES.
- F. CONTRACTOR SHALL MINIMIZE CLEARING TO THE MAXIMUM EXTENT PRACTICAL OR AS REQUIRED BY THE GENERAL PERMIT.
- G. CONTRACTOR SHALL BEGIN CLEARING AND GRUBBING THOSE PORTIONS OF THE SITE NECESSARY TO IMPLEMENT PERIMETER CONTROL MEASURES. CLEARING AND GRUBBING FOR THE REMAINING PORTIONS OF THE PROPOSED SITE SHALL COMMENCE ONCE PERIMETER CONTROLS ARE IN PLACE. PERIMETER CONTROLS SHALL BE ACTIVELY MAINTAINED UNTIL SAID AREAS HAVE BEEN STABILIZED AND SHALL BE REMOVED ONCE FINAL STABILIZATION IS COMPLETE.
- H. GENERAL EROSION CONTROL BMPs SHALL BE EMPLOYED TO MINIMIZE SOIL EROSION AND POTENTIAL LAKE SLOPE CAVE-INS. WHILE THE VARIOUS TECHNIQUES REQUIRED WILL BE SITE AND PLAN SPECIFIC, THEY SHOULD BE EMPLOYED AS SOON AS POSSIBLE DURING CONSTRUCTION.
- I. ON-SITE & OFF-SITE SOIL STOCKPILE AND BORROW AREAS SHALL BE PROTECTED FROM EROSION AND SEDIMENTATION THROUGH IMPLEMENTATION OF BEST MANAGEMENT PRACTICES. STOCKPILE AND BORROW AREA LOCATIONS SHALL BE NOTED ON THE SITE MAP AND PERMITTED IN ACCORDANCE WITH GENERAL PERMIT REQUIREMENTS.
- J. TOPSOIL CANNOT BE STOCKPILED INSIDE THE PROPERTY FOR REFUSE.
- K. SURFACE WATER QUALITY SHALL BE MAINTAINED BY EMPLOYING THE FOLLOWING BMP'S IN THE CONSTRUCTION PLANNING AND CONSTRUCTION OF ALL IMPROVEMENTS.

### STORM WATER EROSION CONTROL PRACTICES:

- A. CONTRACTORS OR SUBCONTRACTORS WILL BE RESPONSIBLE FOR REMOVING SEDIMENT IN THE DETENTION POND AND ANY SEDIMENT THAT MAY HAVE COLLECTED IN THE STORM SEWER DRAINAGE SYSTEMS IN CONJUNCTION WITH THE STABILIZATION OF THE SITE.
- B. SLOPES SHALL BE LEFT IN A ROUGHENED CONDITION DURING THE GRADING PHASE TO REDUCE RUNOFF VELOCITIES AND EROSION.
- C. DUE TO THE GRADE CHANGES DURING THE DEVELOPMENT OF THE PROJECT, THE CONTRACTOR SHALL BE RESPONSIBLE FOR ADJUSTING THE EROSION CONTROL MEASURES (SILT FENCES, ETC.) TO PREVENT EROSION.
- D. WHERE PRACTICAL, STORMWATER SHALL BE CONVEYED BY SWALES.
- E. EROSION CONTROL MEASURES SHALL BE EMPLOYED TO MINIMIZE TURBIDITY OF SURFACE WATERS LOCATED DOWNSTREAM OF ANY CONSTRUCTION ACTIVITY. WHILE THE VARIOUS MEASURES REQUIRED WILL BE SITE SPECIFIC, THEY SHALL BE EMPLOYED AS NEEDED IN ACCORDANCE WITH THE FOLLOWING:
  - 1. IN GENERAL, EROSION SHALL BE CONTROLLED AT THE FURTHEST PRACTICAL UPSTREAM LOCATION.
  - 2. STORMWATER INLETS SHALL BE PROTECTED DURING CONSTRUCTION. PROTECTION MEASURES SHALL BE EMPLOYED AS SOON AS PRACTICAL DURING THE VARIOUS STAGES OF INLET CONSTRUCTION. SILT BARRIERS SHALL REMAIN IN PLACE UNTIL SODDING AROUND INLETS IS COMPLETE.
  - 3. A TEMPORARY SEDIMENT TRAP SHOULD BE CONSTRUCTED TO DETAIN SEDIMENT-LADEN RUNOFF FROM DISTURBED AREAS.
- F. SILT BARRIERS, ANY SILT WHICH ACCUMULATES BEHIND THE BARRIERS, AND ANY FILL USED TO ANCHOR THE BARRIERS SHALL BE REMOVED PROMPTLY AFTER THE END OF THE MAINTENANCE PERIOD SPECIFIED FOR THE BARRIERS.
- G. SLOPES OF BANKS OF RETENTION/DETENTION PONDS SHALL BE CONSTRUCTED NOT STEEPER THAN 3H:1V FROM TOP OF BANK TO TWO FEET BELOW NORMAL WATER LEVEL, AS APPLICABLE.
- H. SOO SHALL BE PLACED FOR A 2-FOOT WIDE STRIP ADJOINING ALL CURBING AND AROUND ALL INLETS. SOO SHALL BE PLACED BEFORE SILT BARRIERS ARE REMOVED.
- I. WHERE REQUIRED TO PREVENT EROSION FROM SHEET FLOW ACROSS BARE GROUND FROM ENTERING A LAKE OR SWALE, A TEMPORARY SEDIMENT SUMP SHALL BE CONSTRUCTED.
- J. FILTER FABRIC SHOULD BE USED FOR STORM DRAIN INLET PROTECTION BEFORE FINAL STABILIZATION.

### WIND EROSION CONTROL PRACTICES:

- A. WIND EROSION SHALL BE CONTROLLED BY EMPLOYING THE FOLLOWING METHODS AS NECESSARY AND APPROPRIATE:
  - 1. BARE EARTH AREAS SHALL BE WATERED DURING CONSTRUCTION AS NECESSARY TO MINIMIZE THE TRANSPORT OF FUGITIVE DUST. IT MAY BE NECESSARY TO LIMIT CONSTRUCTION VEHICLE SPEED IF BARE EARTH HAS NOT BEEN EFFECTIVELY WATERED. IN NO CASE SHALL FUGITIVE DUST BE ALLOWED TO LEAVE THE SITE UNDER CONSTRUCTION.
  - 2. DISTURBED PORTIONS OF THE SITE WHERE CONSTRUCTION ACTIVITY HAS PERMANENTLY STOPPED SHALL BE PERMANENTLY SEEDED (SEE PERMANENT STABILIZATION PRACTICES FOR DETAILS). THESE AREAS SHALL BE SEEDED NO LATER THAN 14 DAYS AFTER THE LAST CONSTRUCTION ACTIVITY OCCURRING IN THESE AREAS. REFER TO THE GRADING PLAN AND/OR LANDSCAPE PLAN TO CLARIFY SITE DEVELOPMENT AREAS NOT CONTINUALLY SCHEDULED FOR CONSTRUCTION ACTIVITIES SHALL BE COVERED WITH HAY OR OVERSEEDED AND PERIODICALLY WATERED SUFFICIENTLY TO STABILIZE THE TEMPORARY GROUNDCOVER (SEE TEMPORARY STABILIZATION PRACTICES FOR DETAILS).
  - 3. AT ANY TIME BOTH DURING AND AFTER SITE CONSTRUCTION THAT WATERING AND/OR VEGETATION ARE NOT EFFECTIVE IN CONTROLLING WIND EROSION AND/OR TRANSPORT OF FUGITIVE DUST, OTHER METHODS AS ARE NECESSARY FOR SUCH CONTROL SHALL BE EMPLOYED. THESE METHODS SHOULD INCLUDE ERECTION OF DUST CONTROL FENCES. A 6-FT GEOTEXTILE FILTER FIBER SHOULD BE HANGING AGAINST THE EXISTING CHAIN LINK FENCE AND GATE.
- B. ALL DUST ON THE SITE SHALL BE CONTROLLED. THE USE OF MOTOR OILS AND OTHER PETROLEUM BASED OR TOXIC LIQUIDS FOR DUST SUPPRESSION OPERATIONS IS PROHIBITED.

### STABILIZATION PRACTICES:

- A. TEMPORARY STABILIZATION – TOPSOIL STOCK PILES AND DISTURBED PORTIONS OF THE SITE WHERE CONSTRUCTION ACTIVITY TEMPORARILY CEASE FOR AT LEAST 21 DAYS, SHALL BE STABILIZED WITH TEMPORARY SEED AND MULCH WITHIN 14 DAYS OF THE LAST CONSTRUCTION ACTIVITY IN THAT AREA. THE TEMPORARY SEED REQUIRED CAN BE FOUND IN TABLE 1.65 A OF THE FLORIDA DEVELOPMENT MANUAL. PRIOR TO SEEDING, WHERE SOILS ARE ACIDIC 2 TONS OF PULVERIZED AGRICULTURAL LIMESTONE SHOULD BE ADDED PER ACRE AND 450 POUNDS OF 10-20-20 FERTILIZER SHALL BE APPLIED TO EACH ACRE. AFTER SEEDING, EACH AREA SHALL BE IMMEDIATELY MULCHED WITH STRAW OR EQUIVALENT EQUAL. AREAS OF THE SITE WHICH ARE TEMPORARILY STABILIZED BY APPLYING GEOTEXTILE AND STONE SUB-BASE UNTIL BITUMINOUS PAVEMENT CAN BE APPLIED.
- B. PERMANENT STABILIZATION – DISTURBED PORTIONS OF THE SITE WHERE CONSTRUCTION ACTIVITIES PERMANENTLY CEASES SHALL BE STABILIZED WITH PERMANENT SEED NO LATER THAN 14 DAYS AFTER THE LAST CONSTRUCTION ACTIVITY. THE APPROPRIATE PERMANENT SEED MIX CAN BE FOUND IN TABLES 1.66A, 1.66B AND 1.66C OF THE FLORIDA DEVELOPMENT MANUAL. PRIOR TO SEEDING, 2 TONS/ACRE OF FINELY GROUND AGRICULTURAL LIMESTONE AND THE PROPER FERTILIZER SHOULD BE APPLIED TO EACH ACRE TO PROVIDE PLANT NUTRIENTS. AFTER SEEDING, EACH AREA SHALL BE MULCHED IMMEDIATELY.
- C. STABILIZATION WILL BE INITIATED ON ALL DISTURBED AREAS WITHIN 14 DAYS OF WORK CEASING, UNLESS CONSTRUCTION ACTIVITY WILL RESUME IN THAT AREA WITHIN 21 DAYS AFTER WORK STOPPAGE. THE TEMPORARY SEDIMENT SUMP SHALL REMAIN IN PLACE UNTIL VEGETATION IS ESTABLISHED ON THE GROUND DRAINING TO THE SUMP.
- D. CONTRACTOR TO ENSURE THAT EXISTING VEGETATION ON OR ADJACENT TO THE PROPOSED SITE IS PRESERVED AND DISTURBED PORTIONS OF THE SITE ARE STABILIZED. STABILIZATION PRACTICES SHOULD BE INITIATED AS SOON AS PRACTICAL, BUT IN NO CASE MORE THAN 7 DAYS WHERE CONSTRUCTION HAS TEMPORARILY CEASED.
- E. ALL CONSTRUCTION SHALL BE STABILIZED AT THE END OF EACH WORKING DAY. THIS INCLUDES BACKFILLING OF TRENCHES FOR UTILITY CONSTRUCTION AND PLACEMENT OF GRAVEL OR BITUMINOUS PAVING FOR ROAD CONSTRUCTION.
- F. SHALL BE IN ACCORDANCE WITH DEP DOCUMENT NO. 62-621.300(4)(g)

### SPILL CONTROL PRACTICES:

- IN ADDITION TO THE GOOD HOUSEKEEPING AND MATERIAL MANAGEMENT PRACTICES DISCUSSED IN THE PREVIOUS SECTIONS OF THIS PLAN, THE FOLLOWING PRACTICES SHALL BE FOLLOWED FOR SPILL PREVENTION AND CLEANUP:
- A. SPILL CLEANUP INFORMATION SHALL BE POSTED ON SITE TO INFORM EMPLOYEES ABOUT CLEANUP PROCEDURES AND RESOURCES.
  - B. THE FOLLOWING CLEAN-UP EQUIPMENT MUST BE KEPT ON-SITE NEAR THE MATERIAL STORAGE AREA: GLOVES, MOPS, RAGS, BROOMS, DUST PANS, SAND, SAWDUST, LIQUID ABSORBER, GOGGLES, AND TRASH CONTAINERS.
  - C. SUFFICIENT OIL AND GREASE ABSORBING MATERIALS AND FLOTATION BOOMS SHALL BE MAINTAINED ONSITE AND READILY AVAILABLE TO CONTAIN AND CLEAN-UP FUEL OR CHEMICAL SPILLS AND LEAKS.
  - D. ALL SPILLS SHALL BE CLEANED UP AS SOON AS POSSIBLE.
  - E. WHEN CLEANING A SPILL, THE AREA SHOULD BE WELL VENTILATED AND THE EMPLOYEE SHALL WEAR PROPER PROTECTIVE COVERING TO PREVENT INJURY.
  - F. TOXIC SPILLS MUST BE REPORTED TO THE PROPER AUTHORITY REGARDLESS OF THE SIZE OF THE SPILL.
  - G. AFTER A SPILL, THE PREVENTION PLAN SHALL BE REVIEWED AND CHANGED TO PREVENT FURTHER SIMILAR SPILLS FROM OCCURRING. THE CAUSE OF THE SPILL, MEASURES TO PREVENT IT, AND HOW TO CLEAN THE SPILL UP SHALL BE RECORDED.
  - H. THE SUPERINTENDENT SHALL BE THE SPILL PREVENTION AND CLEANUP COORDINATOR AND IS RESPONSIBLE FOR THE DAY TO DAY SITE OPERATIONS. THE SUPERINTENDENT ALSO OVERSEES THE SPILL PREVENTION PLAN AND SHALL BE RESPONSIBLE FOR EDUCATING THE EMPLOYEES ABOUT SPILL PREVENTION AND CLEANUP PROCEDURES.

### STRUCTURAL PRACTICES:

- A. EARTH DIKE – IF REQUIRED, AN EARTH DIKE SHALL BE CONSTRUCTED ALONG THE SITE PERIMETER. A PORTION OF THE DIKE SHALL DIVERT RUN-ON AROUND THE CONSTRUCTION SITE. THE REMAINING PORTION OF THE DIKE SHALL COLLECT RUNOFF FROM THE DISTURBED AREA AND DIRECT THE RUNOFF TO THE SEDIMENT BASIN.
- B. SEDIMENT BASIN – A SEDIMENT BASIN SHALL BE CONSTRUCTED IN THE COMMON DRAINAGE AREA FOR THE SITE. ALL SEDIMENT COLLECTED IN THE BASIN MUST BE REMOVED FROM THE BASIN UPON COMPLETION OF CONSTRUCTION. SEDIMENT FROM THE BASIN MAY BE USED AS FILL ON THE SITE IF IT IS SUITABLE SOIL.
- C. SHALL BE IN ACCORDANCE WITH DEP DOCUMENT NO. 62-621.300(4)(g)

### WASTE DISPOSAL:

- A. WASTE MATERIALS – ALL WASTE MATERIALS SHALL BE COLLECTED AND STORED IN A METAL DUMPSTER WITH A SECURE LID IN ACCORDANCE WITH ALL LOCAL AND STATE LAWS. ALL TRASH AND CONSTRUCTION DEBRIS FROM THE SITE SHALL BE DEPOSITED IN THE DUMPSTER. THE SUPERINTENDENT SHALL COORDINATE WITH THE LOCAL UTILITIES TO HAVE THE DUMPSTER EMPTIED AT LEAST TWICE A WEEK AND THE WASTE TAKEN TO AN APPROPRIATE LANDFILL. NO CONSTRUCTION WASTE MATERIALS SHALL BE BURIED ON SITE. THE SUPERINTENDENT SHALL ORGANIZE TRAINING FOR THE EMPLOYEES IN THE PROPER PRACTICES WHEN DEALING WITH WASTE MATERIALS. THE SUPERINTENDENT SHALL BE RESPONSIBLE FOR POSTING AND ENFORCING WASTE MATERIAL PROCEDURES.
- B. HAZARDOUS WASTE – HAZARDOUS WASTE MATERIALS SHALL BE DISPOSED OF IN ACCORDANCE WITH ALL LOCAL AND STATE LAWS OR AS DIRECTED BY THE MANUFACTURER. THE SUPERINTENDENT SHALL ORGANIZE THE PROPER TRAINING FOR EMPLOYEES IN THE PROPER PRACTICES WHEN DEALING WITH HAZARDOUS WASTE MATERIALS. THESE PROCEDURES SHALL BE POSTED ON THE SITE. THE PERSON WHO MANAGES THE SITE SHALL BE RESPONSIBLE FOR ENFORCING THE PROCEDURES.
- C. SANITARY WASTE – SANITARY WASTE SHALL BE COLLECTED AND DISPOSED OF IN ACCORDANCE WITH ALL LOCAL AND STATE LAWS. THE SUPERINTENDENT SHALL COORDINATE WITH THE LOCAL UTILITY FOR COLLECTION OF THE SANITARY WASTE AT LEAST THREE TIMES A WEEK TO PREVENT SPILLAGE ONTO THE SITE.
- D. RUBBISH, TRASH, GARBAGE, LITTER, OR OTHER SUCH MATERIALS SHALL BE DEPOSITED INTO SEALED CONTAINERS. MATERIALS SHALL BE PREVENTED FROM LEAVING THE PREMISES THROUGH THE ACTION OF WIND OR STORM WATER DISCHARGE INTO DRAINAGE DITCHES OR WATERS OF THE STATE.
- E. ANY CONSTRUCTION DEBRIS GENERATED AS A RESULT OF THIS PROJECT WILL BE DISPOSED OF OFF-SITE AT AN APPROPRIATE WASTE FACILITY.
- F. CONCRETE WASHOUT LOCATIONS WILL BE PROVIDED IN AREAS WHERE THE DISPOSAL MATERIALS WILL BE CONTAINED TO PREVENT DISCHARGE OUTSIDE OF THE PROJECT LIMITS AND INTO THE WATERWAYS.

### OFFSITE TRACKING:

- A. STABILIZED CONSTRUCTION ENTRANCE SHALL BE PROVIDED TO REDUCE SEDIMENT TRACKING OFFSITE. THE MAJOR ROAD CONNECTED TO THE PROJECT SHALL BE CLEANED ONCE A DAY TO REMOVE ANY EXCESS MUDD, DIRT OR ROCK RESULTING FROM CONSTRUCTION TRAFFIC. ALL TRUCKS HAULING MATERIALS OFFSITE SHALL BE COVERED WITH A TARP/AULIN.
- B. GENERAL CONTRACTOR SHALL DENOTE ON PLAN THE TEMPORARY PARKING AND STORAGE AREA WHICH SHALL ALSO BE USED AS THE EQUIPMENT MAINTENANCE AND CLEANING AREA. EMPLOYEE PARKING AREA, AND AREA FOR LOCATION OF PORTABLE FACILITIES, OFFICE, TRAILERS, AND TOILET FACILITIES, HEAVY CONSTRUCTION EQUIPMENT PARKING AND MAINTENANCE AREAS SHALL BE DESIGNED TO PREVENT OIL, GREASE, AND LUBRICANTS FROM ENTERING SITE DRAINAGE FEATURES INCLUDING STORMWATER COLLECTION AND TREATMENT SYSTEMS. CONTRACTORS SHALL PROVIDE BROAD DIKES, HAY BALES OR SILT SCREENS AROUND, AND SEDIMENT SUMPS WITHIN, SUCH AREAS AS REQUIRED TO CONTAIN SPILLS OF OIL, GREASE OR LUBRICANTS. CONTRACTORS SHALL HAVE AVAILABLE, AND SHALL USE, ABSORBENT FILTER PADS TO CLEAN UP SPILLS AS SOON AS POSSIBLE AFTER OCCURRENCE.
- C. ALL WASH WATER FROM CONCRETE TRUCKS, VEHICLE CLEANING, EQUIPMENT CLEANING, ETC. SHALL BE DETAINED ON SITE AND SHALL BE PROPERLY TREATED OR DISPOSED.
- D. IF THE ACTION OF VEHICLES TRAVELING OVER THE GRAVEL CONSTRUCTION ENTRANCES IS NOT SUFFICIENT TO REMOVE THE MAJORITY OF DIRT OR MUD, THEN THE TIRES MUST BE WASHED BEFORE THE VEHICLES ENTER A PUBLIC ROAD. IF WASHING IS USED, PROVISIONS MUST BE MADE TO INTERCEPT THE WASH WATER AND TRAP THE SEDIMENT BEFORE IT IS CARRIED OFF THE SITE.
- E. ALL MATERIALS SPILLED, DROPPED, WASHED, OR TRACKED FROM VEHICLES ONTO ROADWAYS OR INTO STORM DRAINS MUST BE REMOVED IMMEDIATELY.

### INSPECTION AND MAINTENANCE:

- A. ALL MEASURES STATED ON THIS EROSION AND SEDIMENT CONTROL PLAN, AND IN THE STORM WATER POLLUTION PREVENTION PLAN, SHALL BE MAINTAINED IN FULLY FUNCTIONAL CONDITION UNTIL NO LONGER REQUIRED FOR A COMPLETE END OF PROJECT OR FINAL STABILIZATION OF THE SITE. ALL EROSION AND SEDIMENTATION CONTROL MEASURES SHALL BE CHECKED BY A QUALIFIED PERSON AT LEAST ONCE EVERY SEVEN CALENDAR DAYS AND WITHIN 24 HOURS OF THE END OF A 0.5" RAINFALL EVENT, AND CLEANED AND REPAIRED IN ACCORDANCE WITH THE FOLLOWING:
  - A. INLET PROTECTION DEVICES AND BARRIERS SHALL BE REPAIRED OR REPLACED IF THEY SHOW SIGNS OF UNDERMINING, OR DETERIORATION.
  - B. ALL SEEDED AREAS SHALL BE CHECKED REGULARLY TO SEE THAT A GOOD STAND IS MAINTAINED. AREAS SHOULD BE FERTILIZED, WATERED, AND RESEEDED AS NEEEDED.
  - C. THE SILT FENCE SHALL BE INSPECTED PERIODICALLY FOR HEIGHT OF SEDIMENT AND CONDITION OF FENCE. SILT FENCES SHALL BE REPAIRED TO THEIR ORIGINAL CONDITIONS IF DAMAGED. SEDIMENT SHALL BE REMOVED FROM THE SILT FENCES WHEN IT REACHES ONE-THIRD THE HEIGHT OF THE SILT FENCE.
  - D. THE CONSTRUCTION ENTRANCES SHALL BE MAINTAINED IN A CONDITION WHICH WILL PREVENT TRACKING OR FLOW OF MUD ONTO PUBLIC RIGHTS-OF-WAY. THIS MAY REQUIRE PERIODIC TOP DRESSING OF THE CONSTRUCTION ENTRANCES AS CONDITIONS DEMAND.
  - E. THE TEMPORARY PARKING AND STORAGE AREA SHALL BE KEPT IN GOOD CONDITION (SUITABLE FOR PARKING AND STORAGE). THIS MAY REQUIRE PERIODIC TOP DRESSING OF THE TEMPORARY PARKING AS CONDITIONS DEMAND.
  - F. OUTLET STRUCTURES IN THE SEDIMENTATION BASINS SHALL BE MAINTAINED IN OPERATIONAL CONDITIONS AT ALL TIMES. THE SEDIMENT BASINS/DITCHES SHALL BE CHECKED MONTHLY FOR DEPTH OF SEDIMENT. SEDIMENT SHALL BE REMOVED FROM SEDIMENT BASINS OR TRAPS WHEN THE DESIGN CAPACITY HAS BEEN REDUCED BY 10% AND AFTER CONSTRUCTION IS COMPLETE.
  - G. ALL MAINTENANCE OPERATIONS SHALL BE DONE IN A TIMELY MANNER BUT IN NO CASE LATER THAN SEVEN CALENDAR DAYS FOLLOWING THE INSPECTION.
  - H. DIVERSION DIKES SHALL BE INSPECTED MONTHLY. ANY BREACHES SHALL BE PROMPTLY REPAIRED.
  - I. A MAINTENANCE REPORT SHALL BE COMPLETED DAILY AFTER EACH INSPECTION OF THE SEDIMENT AND EROSION CONTROL METHODS. THE REPORTS SHALL BE FILED IN AN ORGANIZED MANNER AND RETAINED ON-SITE DURING CONSTRUCTION. AFTER CONSTRUCTION IS COMPLETED, THE REPORTS SHALL BE SAVED FOR AT LEAST THREE YEARS. THE REPORTS SHALL BE AVAILABLE FOR ANY AGENCY THAT HAS JURISDICTION OVER EROSION CONTROL.
  - J. ALL REPAIRS MUST BE MADE WITHIN 24 HOURS OF REPORT.
  - K. THE SUPERINTENDENT SHALL ORGANIZE THE TRAINING FOR INSPECTION PROCEDURES AND PROPER EROSION CONTROL METHODS FOR EMPLOYEES THAT COMPLETE INSPECTIONS AND REPORTS.

### SPILL PREVENTION AND CONTROL:

- A. THE FOLLOWING ARE THE MATERIAL MANAGEMENT PRACTICES THAT WILL BE USED TO REDUCE THE RISK OF SPILLS OR OTHER ACCIDENTAL EXPOSURE OF MATERIALS AND SUBSTANCES TO STORM WATER RUNOFF.
  - 1. SUPERINTENDENT SHALL INSPECT PROJECT AREA DAILY FOR PROPER STORAGE, USE, AND DISPOSAL OF CONSTRUCTION MATERIALS.
  - 2. STORE ONLY ENOUGH MATERIAL ON SITE FOR PROJECT COMPLETION.
  - 3. ALL SUBSTANCES SHOULD BE USED BEFORE DISPOSAL OF CONTAINER.
  - 4. ALL CONSTRUCTION MATERIALS STORED SHALL BE ORGANIZED AND IN THE PROPER CONTAINER AND IF POSSIBLE, STORED UNDER A ROOF OR PROTECTIVE COVER.
  - 5. PRODUCTS SHALL NOT BE MIXED UNLESS DIRECTED BY THE MANUFACTURER.
  - 6. ALL PRODUCTS SHALL BE USED AND DISPOSED OF ACCORDING TO THE MANUFACTURER'S RECOMMENDATIONS.
- B. HAZARDOUS PRODUCTS
  - 1. MATERIALS SHOULD BE KEPT IN ORIGINAL CONTAINER WITH LABELS UNLESS THE ORIGINAL CONTAINERS CANNOT BE RESEALED. IF ORIGINAL CONTAINERS CANNOT BE USED, LABELS AND PRODUCT INFORMATION SHALL BE SAVED.
  - 2. PROPER DISPOSAL PRACTICES SHALL ALWAYS BE FOLLOWED IN ACCORDANCE WITH MANUFACTURER AND LOCAL/STATE REGULATIONS.
- C. PRODUCT SPECIFIC PRACTICES
  - 1. PETROLEUM PRODUCTS MUST BE STORED IN PROPER CONTAINERS AND CLEARLY LABELED. VEHICLES CONTAINING PETROLEUM PRODUCTS SHALL BE PERIODICALLY INSPECTED FOR LEAKS. PRECAUTIONS SHALL BE TAKEN TO AVOID LEAKAGE OF PETROLEUM PRODUCTS ON SITE.
  - 2. THE MINIMUM AMOUNT OF FERTILIZER SHALL BE USED AND MIXED INTO THE SOIL IN ORDER TO LIMIT EXPOSURE TO STORM WATER. FERTILIZERS SHALL BE STORED IN A COVERED SHED. THE CONTENTS OF ANY PARTIALLY USED BAGS OF FERTILIZER SHALL BE TRANSFERRED TO A SEALABLE PLASTIC BIN TO AVOID SPILLS.
  - 3. PAINT CONTAINERS SHALL BE SEALED AND STORED WHEN NOT IN USE. EXCESS PAINT MUST BE DISPOSED OF IN AN APPROVED MANNER.
  - 4. CONCRETE TRUCKS SHALL NOT BE ALLOWED TO WASH OUT OR DISCHARGE SURPLUS CONCRETE OR DRUM WASH WATER ON THE SITE.

### PROJECT DESCRIPTION:

- PROJECT LOCATION: 1325 74TH AVENUE SW, VERO BEACH, FL 32968
1. PROJECT LIMITS: TOTAL PROJECT AREA IS APPROXIMATELY 4.4 ACRES. THE TOTAL DISTURBED AREA IS APPROXIMATELY ACRES ONSITE.
  2. CONSTRUCTION ACTIVITY: CONSTRUCTION OF RECYCLING FACILITY, PARKING AREA, SIDEWALKS, LANDSCAPING, UTILITIES, AND DRAINAGE SYSTEM.
  3. MAJOR SOIL DISTURBING ACTIVITIES: CLEARING AND GRUBBING, INSTALLATION OF DRAINAGE SYSTEM, INSTALLATION OF UTILITIES
  4. DEWATERING ACTIVITIES: DEWATERING IS ANTICIPATED FOR THIS SITE.
  5. SOIL CHARACTERISTICS: THE SOIL TYPE WITHIN THE PROJECT'S LIMIT OF DISTURBANCE IS CLASSIFIED AS FILL IN.
  6. RUNOFF COEFFICIENTS: EXISTING: 0.65  
DURING CONSTRUCTION: 0.65  
PROPOSED: 0.85

### SEQUENCE OF CONSTRUCTION:


- SEQUENCE OF SOIL DISTURBING ACTIVITIES AND IMPLEMENTATION OF CONTROLS:
1. PRIOR TO COMMENCEMENT OF ANY EARTH DISTURBING ACTIVITIES, INCLUDING CLEARING AND GRUBBING, INSTALL EROSION CONTROL MEASURES IN ACCORDANCE WITH THE EROSION CONTROL PLAN, STANDARD DETAILS, NPDES REQUIREMENTS, AND INDIAN RIVER COUNTY PUBLIC WORKS ENGINEERING STANDARD FOR DESIGN AND CONSTRUCTION MANUAL.
  2. BEGIN CLEARING AND GRUBBING.
  3. INSTALL DRAINAGE SYSTEM, INCLUDING: CONCRETE INLETS, DRAINAGE PIPES AND MANHOLES.
  4. INSTALL INLET PROTECTION AND ROCK BAGS ON ALL INLETS AND MANHOLES IN THE LOCATIONS SHOWN ON THE PLANS AND PER THE STANDARD DETAILS PROVIDED AND INDIAN RIVER COUNTY PUBLIC WORKS ENGINEERING STANDARD FOR DESIGN AND CONSTRUCTION MANUAL.
  5. PREPARE SUBBASE MATERIAL.
  6. BEGIN ASPHALT AND CONCRETE INSTALLATION.
  7. AFTER COMPLETION OF SITE WORK, BEGIN SITE STABILIZATION AND PERMANENT SEEDING.
  8. ONCE SITE STABILIZATION IS COMPLETE, CONTRACTOR TO CLEAN ALL CONSTRUCTION DEBRIS FROM CONSTRUCTION SITE.
  9. ONCE A UNIFORM 70% VEGETATIVE COVER OF PERENNIAL VEGETATION IS ACHIEVED ACROSS THE ENTIRE DISTURBED AREA THE REMOVAL OF TEMPORARY EROSION CONTROL MEASURES MAY BEGIN.

|   |                       |             |            |      |           |       |          |             |     |          |     |            |    |       |  |    |
|---|-----------------------|-------------|------------|------|-----------|-------|----------|-------------|-----|----------|-----|------------|----|-------|--|----|
| KIMLEY-HORN & ASSOCIATES, INC.<br>355 ALHAMBRA CIRCLE, SUITE 1400, CORAL GABLES, FL 33134<br>PHONE: 305-673-2025<br>WWW.KIMLEY-HORN.COM | LICENSED PROFESSIONAL | KHA PROJECT | 14-3228000 | DATE | JULY 2021 | SCALE | AS SHOWN | DESIGNED BY | MRC | DRAWN BY | RMR | CHECKED BY | BF | DATE: |  |    |
|   |                       |             |            |      |           |       |          |             |     |          |     |            |    |       |  | FL |
|   |                       |             |            |      |           |       |          |             |     |          |     |            |    |       |  |    |

**EROSION CONTROL NOTES**

IRC LANDFILL  
PREPARED FOR  
INDIAN RIVER COUNTY

SHEET NUMBER  
**C-300**

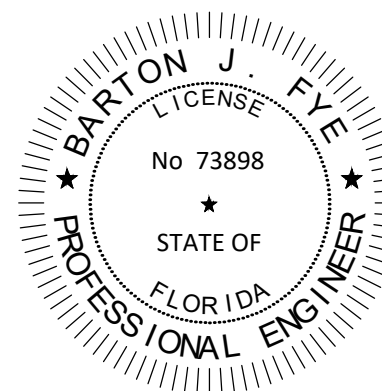

This item has been digitally signed and sealed by Barton J. Fye, P.E. on the date adjacent to the seal.


Printed copies of this document are not considered signed and sealed and the signature must be verified on any electronic copies.

Date: 11/17/2021


Call 811 or www.sunshine811.com two full business days before digging to have utilities located and marked.

Check positive response codes before you dig!

Plotted By: Rodriguez, Rebecca - Sheet Set: IRC LANDFILL - Layout: C-310 EROSION CONTROL PLAN - November 17, 2021 - 11:22:21am - K:\vmb-civil\143228000 - irc.lhw and recycling facility\CADD\plansheets\C-310 EROSION CONTROL PLAN.dwg  
 This document, together with the concepts and designs presented herein, is intended only for the specific purpose and client for which it was prepared. Reuse of and improper reliance on this document without written authorization and adaptation by Kimley-Horn and Associates, Inc. shall be without liability to Kimley-Horn and Associates, Inc.

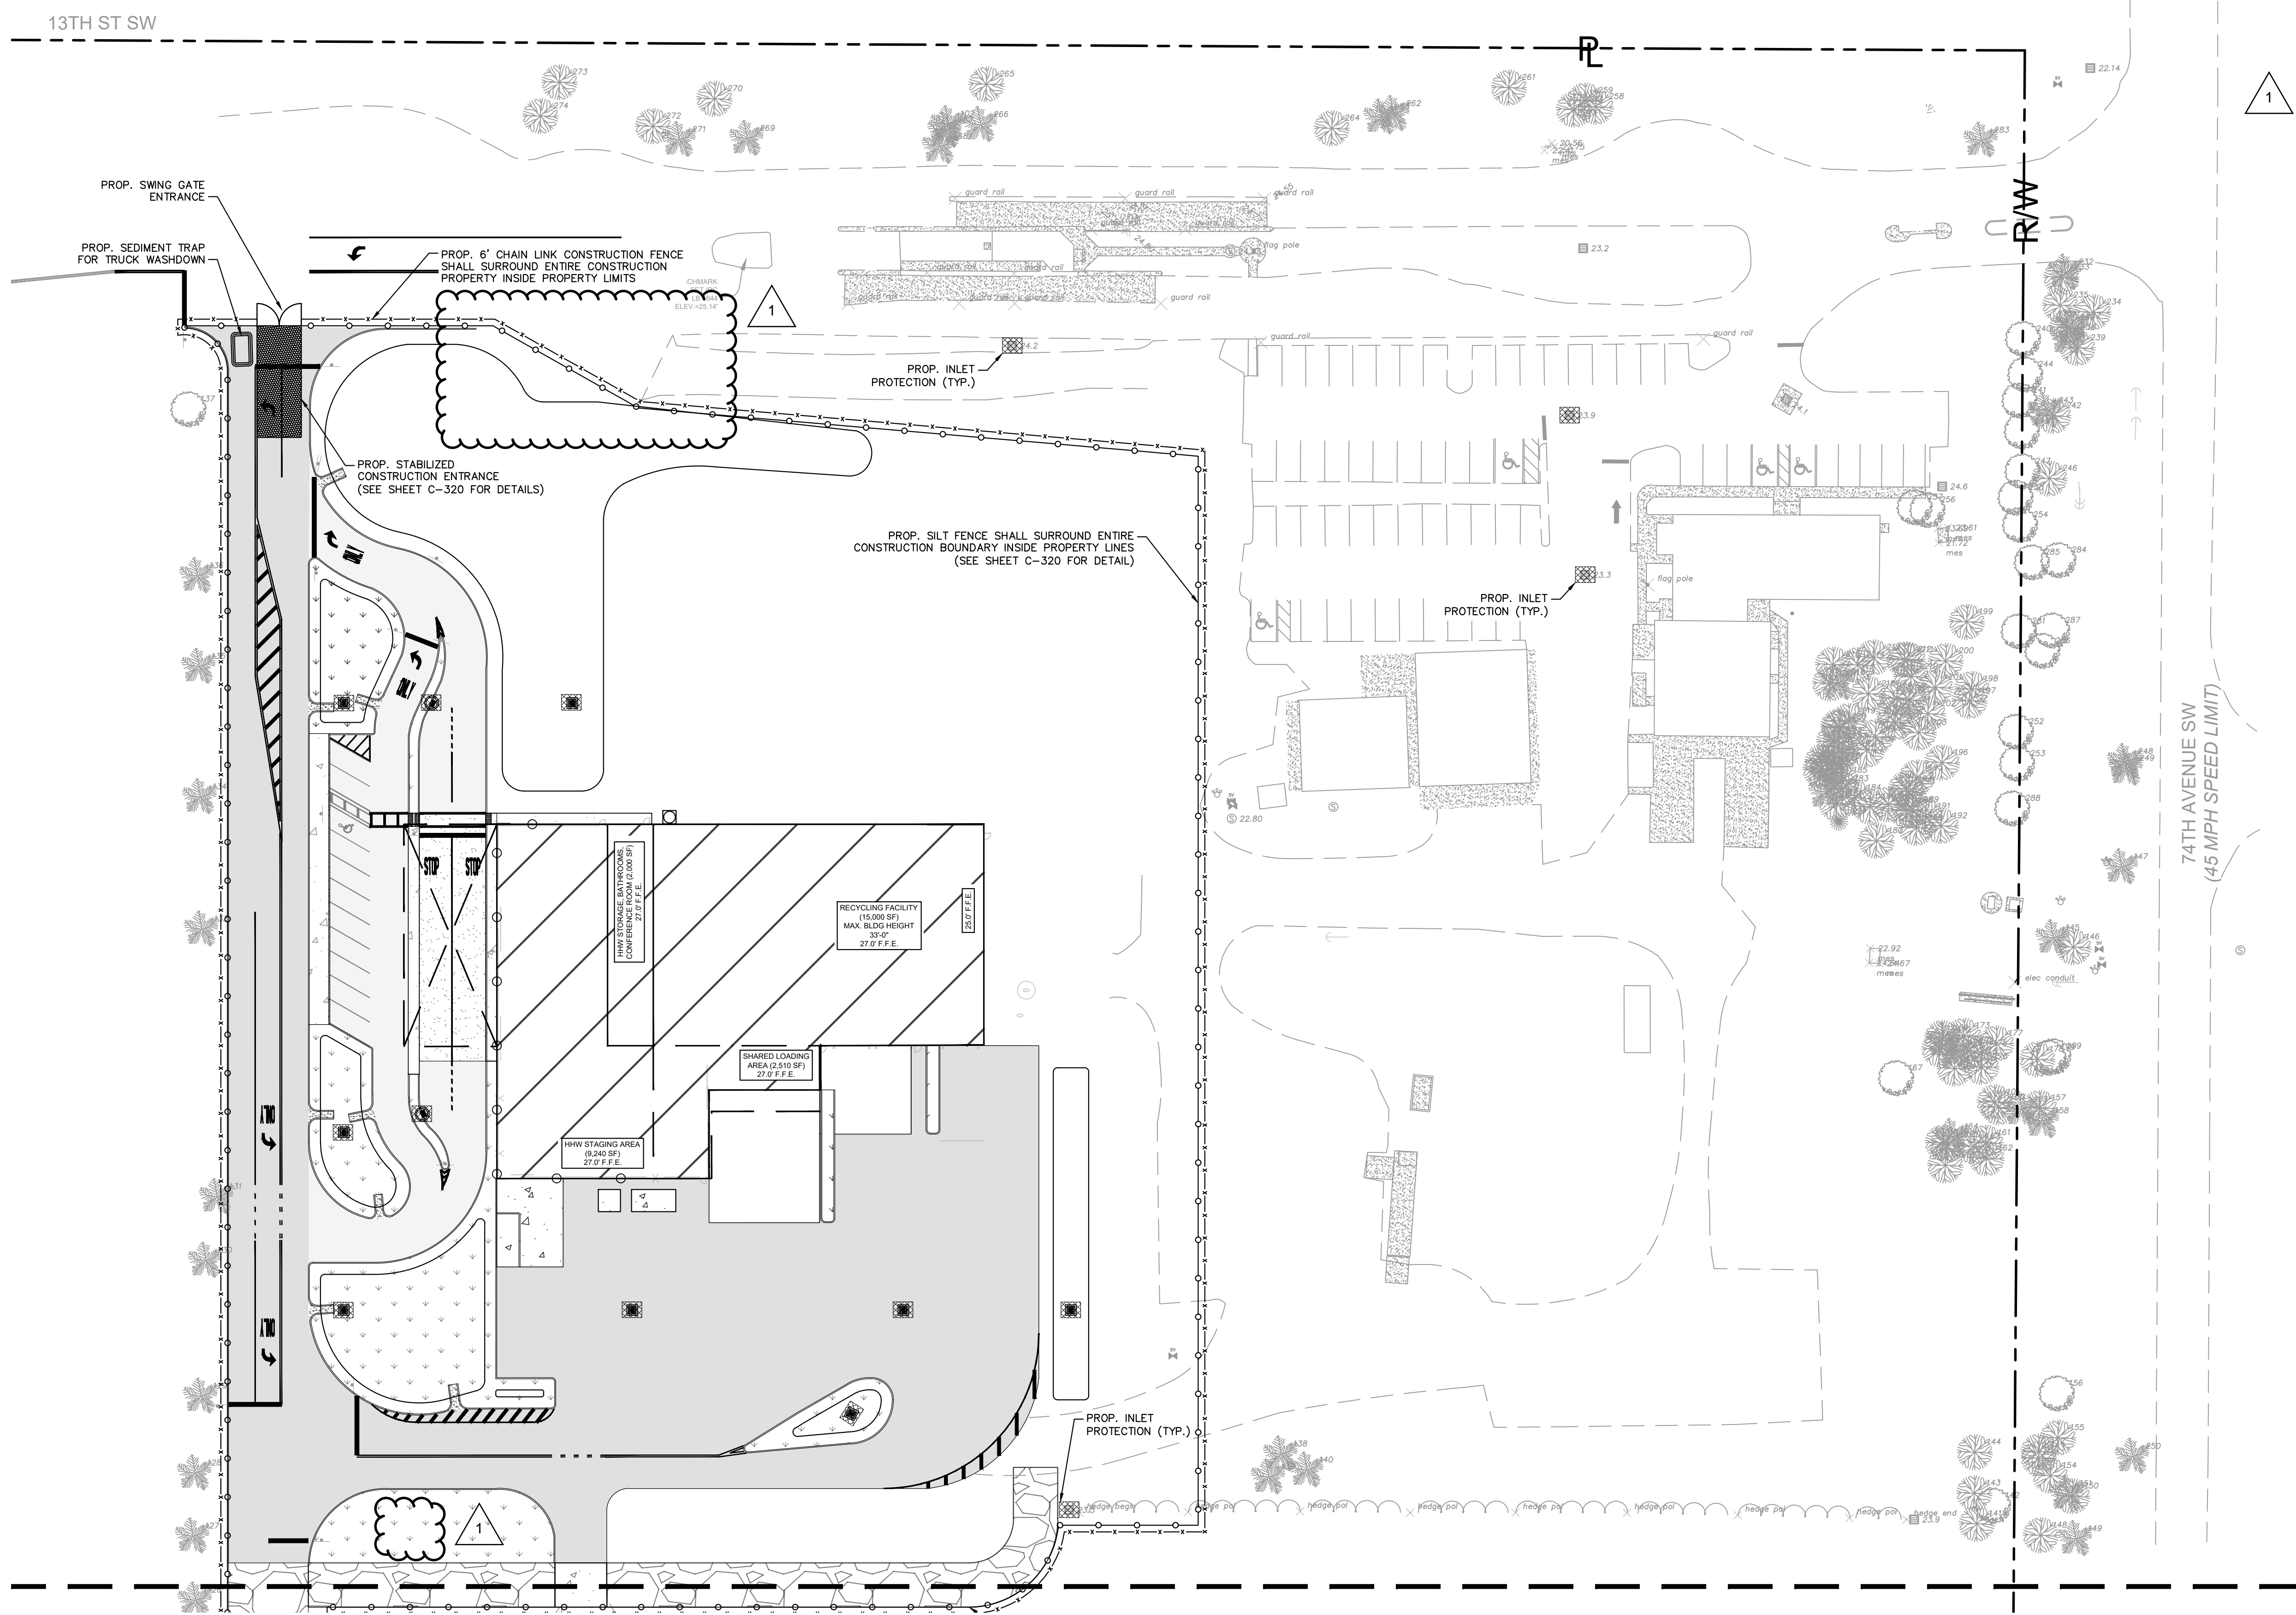


SEE SHEET C-311 FOR CONTINUATION

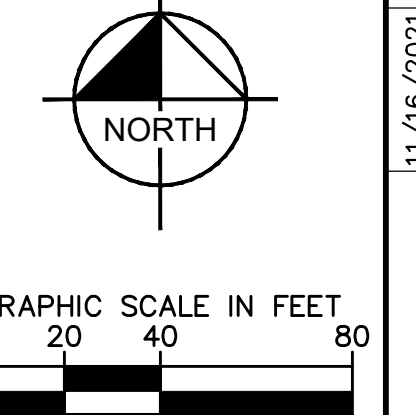

**LEGEND**

- RIGHT-OF-WAY LINE / PROPERTY LINE
- PROP. BUILDING
- PROP. HEAVY DUTY ASPHALT
- PROP. STANDARD DUTY ASPHALT
- PROP. LANDSCAPE AREA
- PROP. CONC. SIDEWALK
- PROP. STANDARD DUTY CONC.
- PROP. HEAVY DUTY CONC.
- EXIST. GRAVEL ROAD
- SEDIMENT BARRIER CONTROL FOR STORM STRUCTURE (SEE SHEET C-320 FOR DETAIL)
- PROP. STABILIZED CONSTRUCTION ENTRANCE
- PROP. GRAVEL ROAD
- PROP. 6' CHAIN LINK CONSTRUCTION FENCE WITH DUST SCREEN
- PROP. 6' CHAIN LINK CONSTRUCTION FENCE WITH DUST SCREEN

74TH AVENUE SW  
(45 MPH SPEED LIMIT)

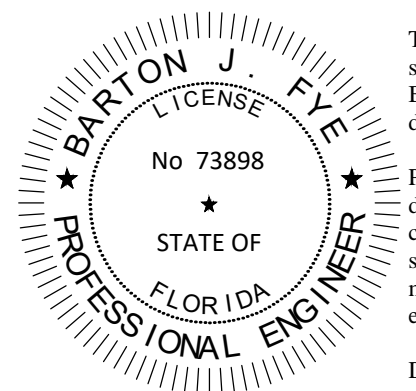


This item has been digitally signed and sealed by Barton J. Fye, P.E. on the date adjacent to the seal.  
 Printed copies of this document are not considered signed and sealed and the signature must be verified on any electronic copies.  
 Date: 11/17/2021

**Sunshine811**  
 Call 811 or www.sunshine811.com two full business days before digging to have utilities located and marked.  
 Check positive response codes before you dig!

|  |            |           |           |            |          |
|--|------------|-----------|-----------|------------|----------|
| OWNER CHANGES  | No.        | REVISIONS | DATE      | BY         |          |
|  |            |           |           |            |          |
| <p><b>Kimley &amp; Horn</b><br/>         © 2021 KIMLEY-HORN AND ASSOCIATES, INC.<br/>         355 ALHAMBRA CIRCLE, SUITE 1400, CORAL GABLES, FL 33134<br/>         PHONE: 305-673-2025<br/>         WWW.KIMLEY-HORN.COM REGISTRY 696</p> |            |           |           |            |          |
| LICENSED PROFESSIONAL  |            |           |           |            |          |
| KHA PROJECT  | 14-3228000 | DATE      | JULY 2021 | SCALE      | AS SHOWN |
| DESIGNED BY  | MRC        | DRAWN BY  | RMR       | CHECKED BY | BF       |
| <b>EROSION CONTROL PLAN I</b>  |            | FL        |           |            |          |
| <b>IRC LANDFILL PREPARED FOR INDIAN RIVER COUNTY</b>   |            | FL        |           |            |          |
| SHEET NUMBER <b>C-310</b>  |            |           |           |            |          |

Plotted By: Rodriguez, Rebecca - Sheet Set: IRC LANDFILL - Layout: C-311. EROSION CONTROL PLAN - November 17, 2021 - 11:22:23am - K:\vmb-civil\CADD\plansheets\C-311 EROSION CONTROL PLAN.dwg  
 This document, together with the concepts and designs presented herein, is intended only for the specific purpose and client for which it was prepared. Reuse of and improper reliance on this document without written authorization and adaptation by Kimley-Horn and Associates, Inc. shall be without liability to Kimley-Horn and Associates, Inc.




SEE SHEET C-310 FOR CONTINUATION

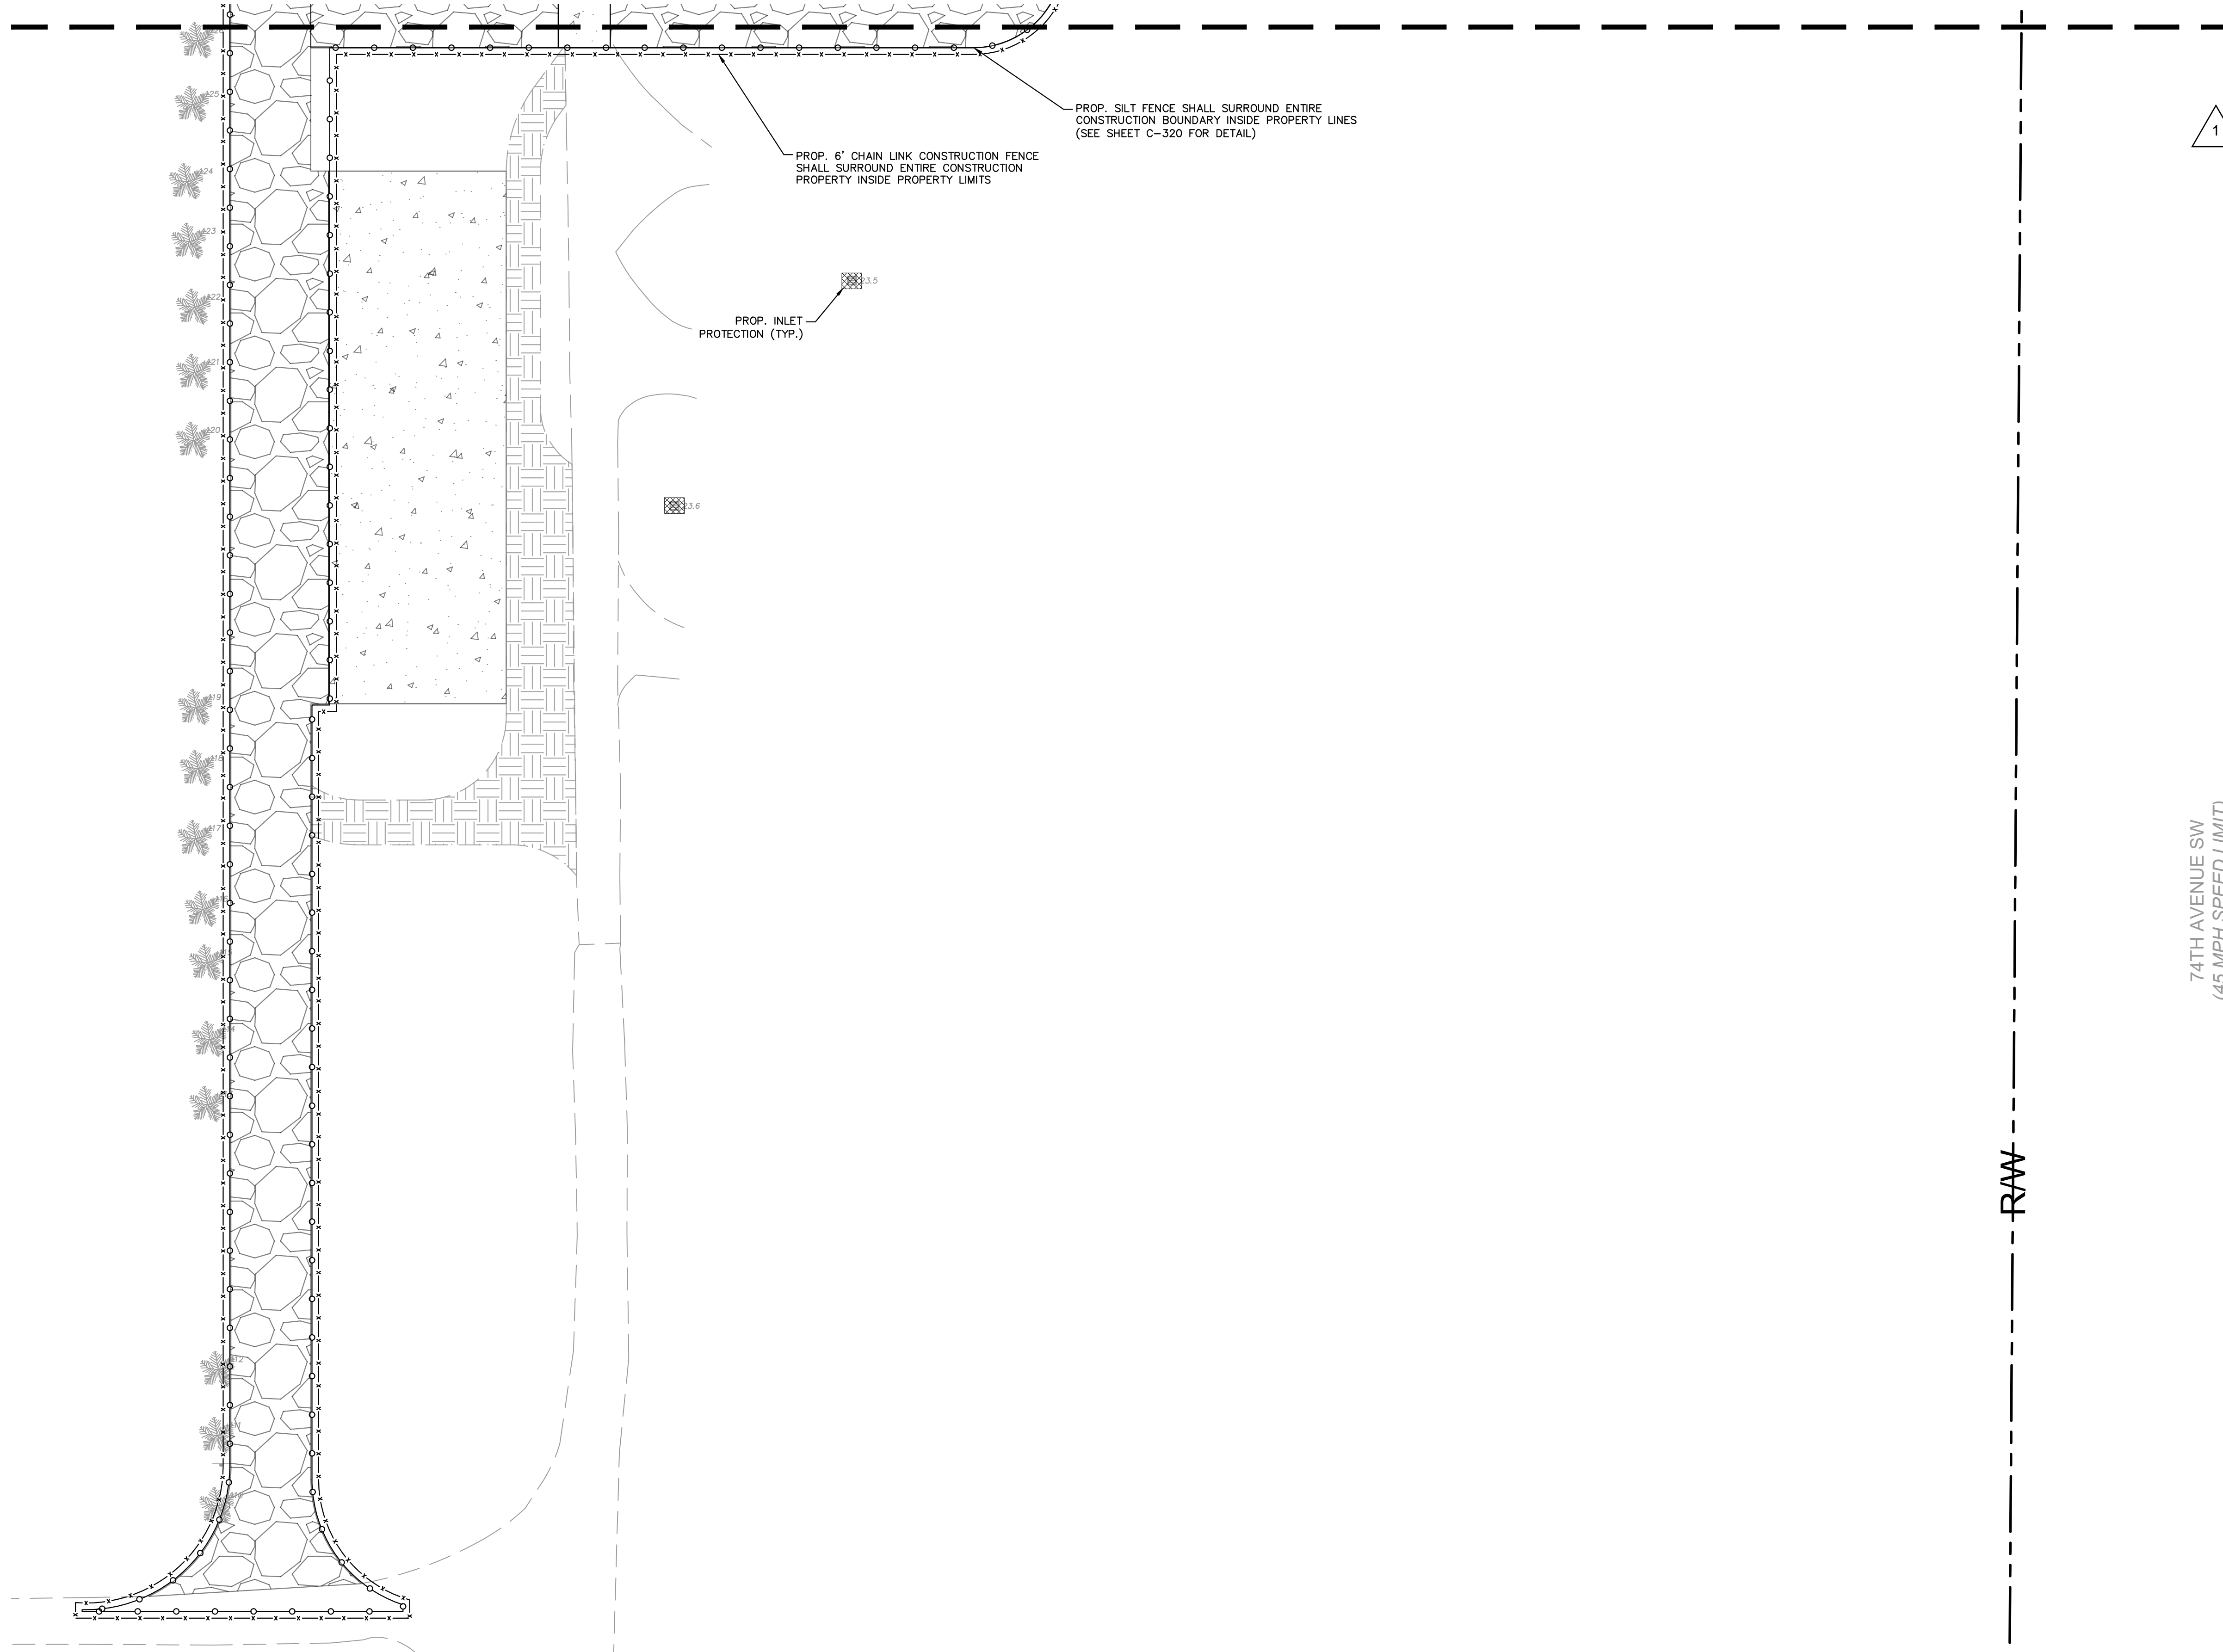

74TH AVENUE SW  
(45 MPH SPEED LIMIT)

**LEGEND**

- RIGHT-OF-WAY LINE / PROPERTY LINE
- PROP. BUILDING
- PROP. HEAVY DUTY ASPHALT
- PROP. STANDARD DUTY ASPHALT
- PROP. LANDSCAPE AREA
- PROP. CONC. SIDEWALK
- PROP. STANDARD DUTY CONC.
- PROP. HEAVY DUTY CONC.
- EXIST. GRAVEL ROAD
- SEDIMENT BARRIER CONTROL FOR STORM STRUCTURE (SEE SHEET C-320 FOR DETAIL)
- PROP. STABILIZED CONSTRUCTION ENTRANCE
- PROP. GRAVEL ROAD
- PROP. 6' CHAIN LINK CONSTRUCTION FENCE WITH DUST SCREEN
- PROP. 6' CHAIN LINK CONSTRUCTION FENCE WITH DUST SCREEN








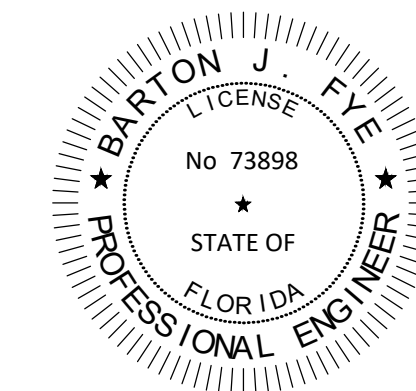
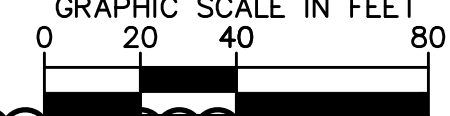
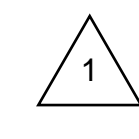


This item has been digitally signed and sealed by Barton J. Fye, P.E. on the date adjacent to the seal.  
 Printed copies of this document are not considered signed and sealed and the signature must be verified on any electronic copies.  
 Date: 11/17/2021

**Sunshine811**  
 Call 811 or www.sunshine811.com two full business days before digging to have utilities located and marked.  
 Check positive response codes before you dig!

|  |     |                            |      |                              |
|--|-----|----------------------------|------|------------------------------|
| OWNER CHANGES  | No. | REVISIONS                  | DATE | BY                           |
|  |     |                            |      |                              |
| KHA PROJECT<br>14-3228000<br>DATE<br>JULY 2021<br>SCALE AS SHOWN<br>DESIGNED BY MRC<br>DRAWN BY RMR<br>CHECKED BY<br>DATE: |     | LICENSED PROFESSIONAL<br>  |      | 11/16/2021 JF                |
| IRC LANDFILL<br>PREPARED FOR<br>INDIAN RIVER COUNTY<br>INDIAN RIVER COUNTY<br>FL   |     | EROSION CONTROL<br>PLAN II |      | SHEET NUMBER<br><b>C-311</b> |

Plotted By: Rebecca, Sheet: Set: IRC LANDFILL - LOYD C-320 EROSION CONTROL DETAILS November 17, 2021, 10:39:50am K:\vmb-civil\143228000 - irc hhw and recycling facilities\civil\CADD\plansheets\C-320 EROSION CONTROL DETAILS.dwg  
 This document, together with the concepts and designs presented herein, is intended only for the specific purpose and client for which it was prepared. Reuse of and improper reliance on this document without written authorization and adaptation by Kimley-Horn and Associates, Inc. shall be without liability to Kimley-Horn and Associates, Inc.

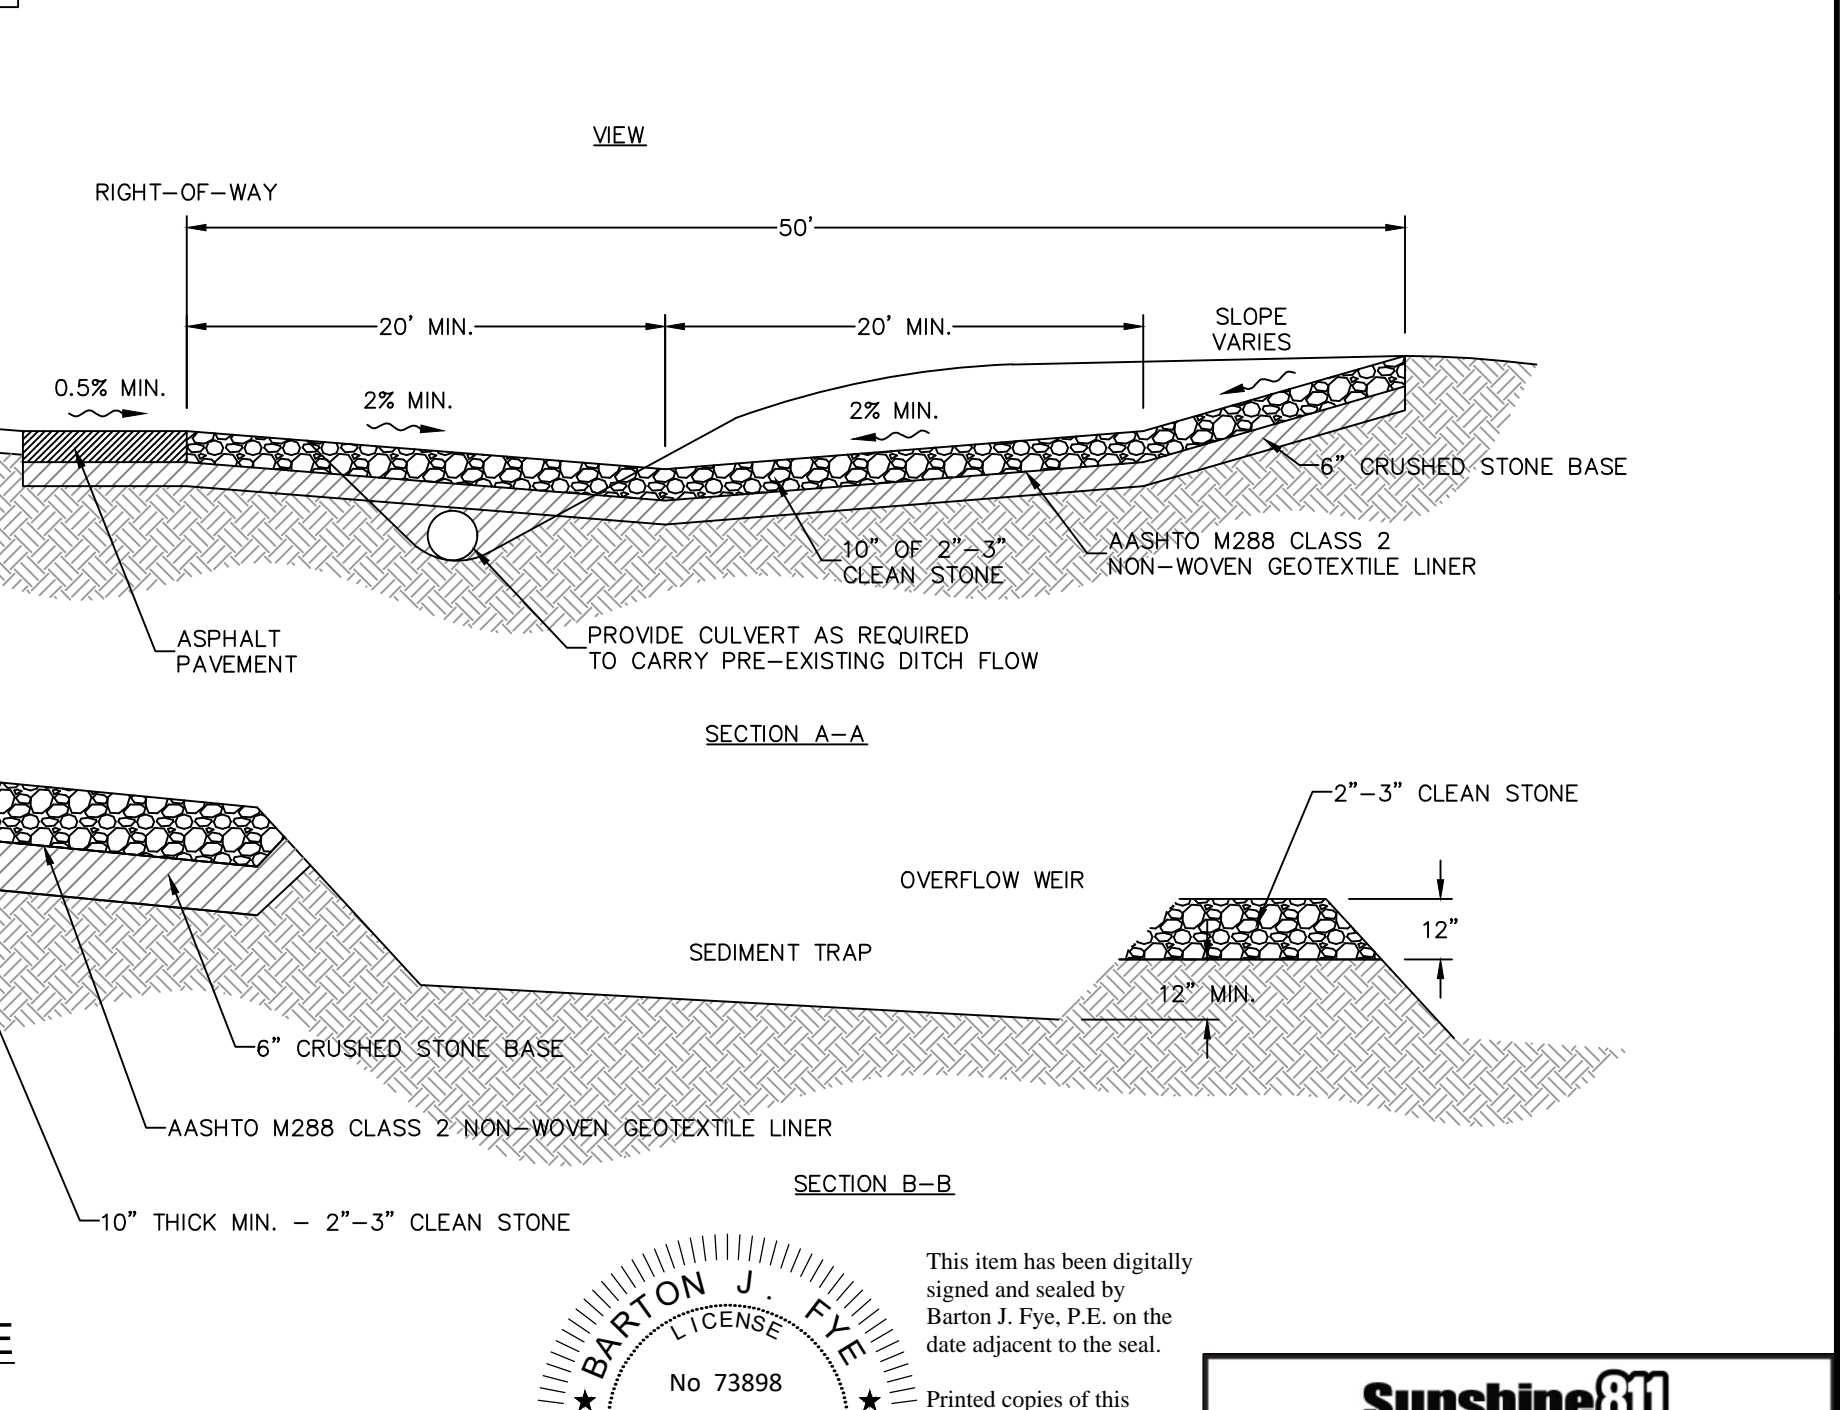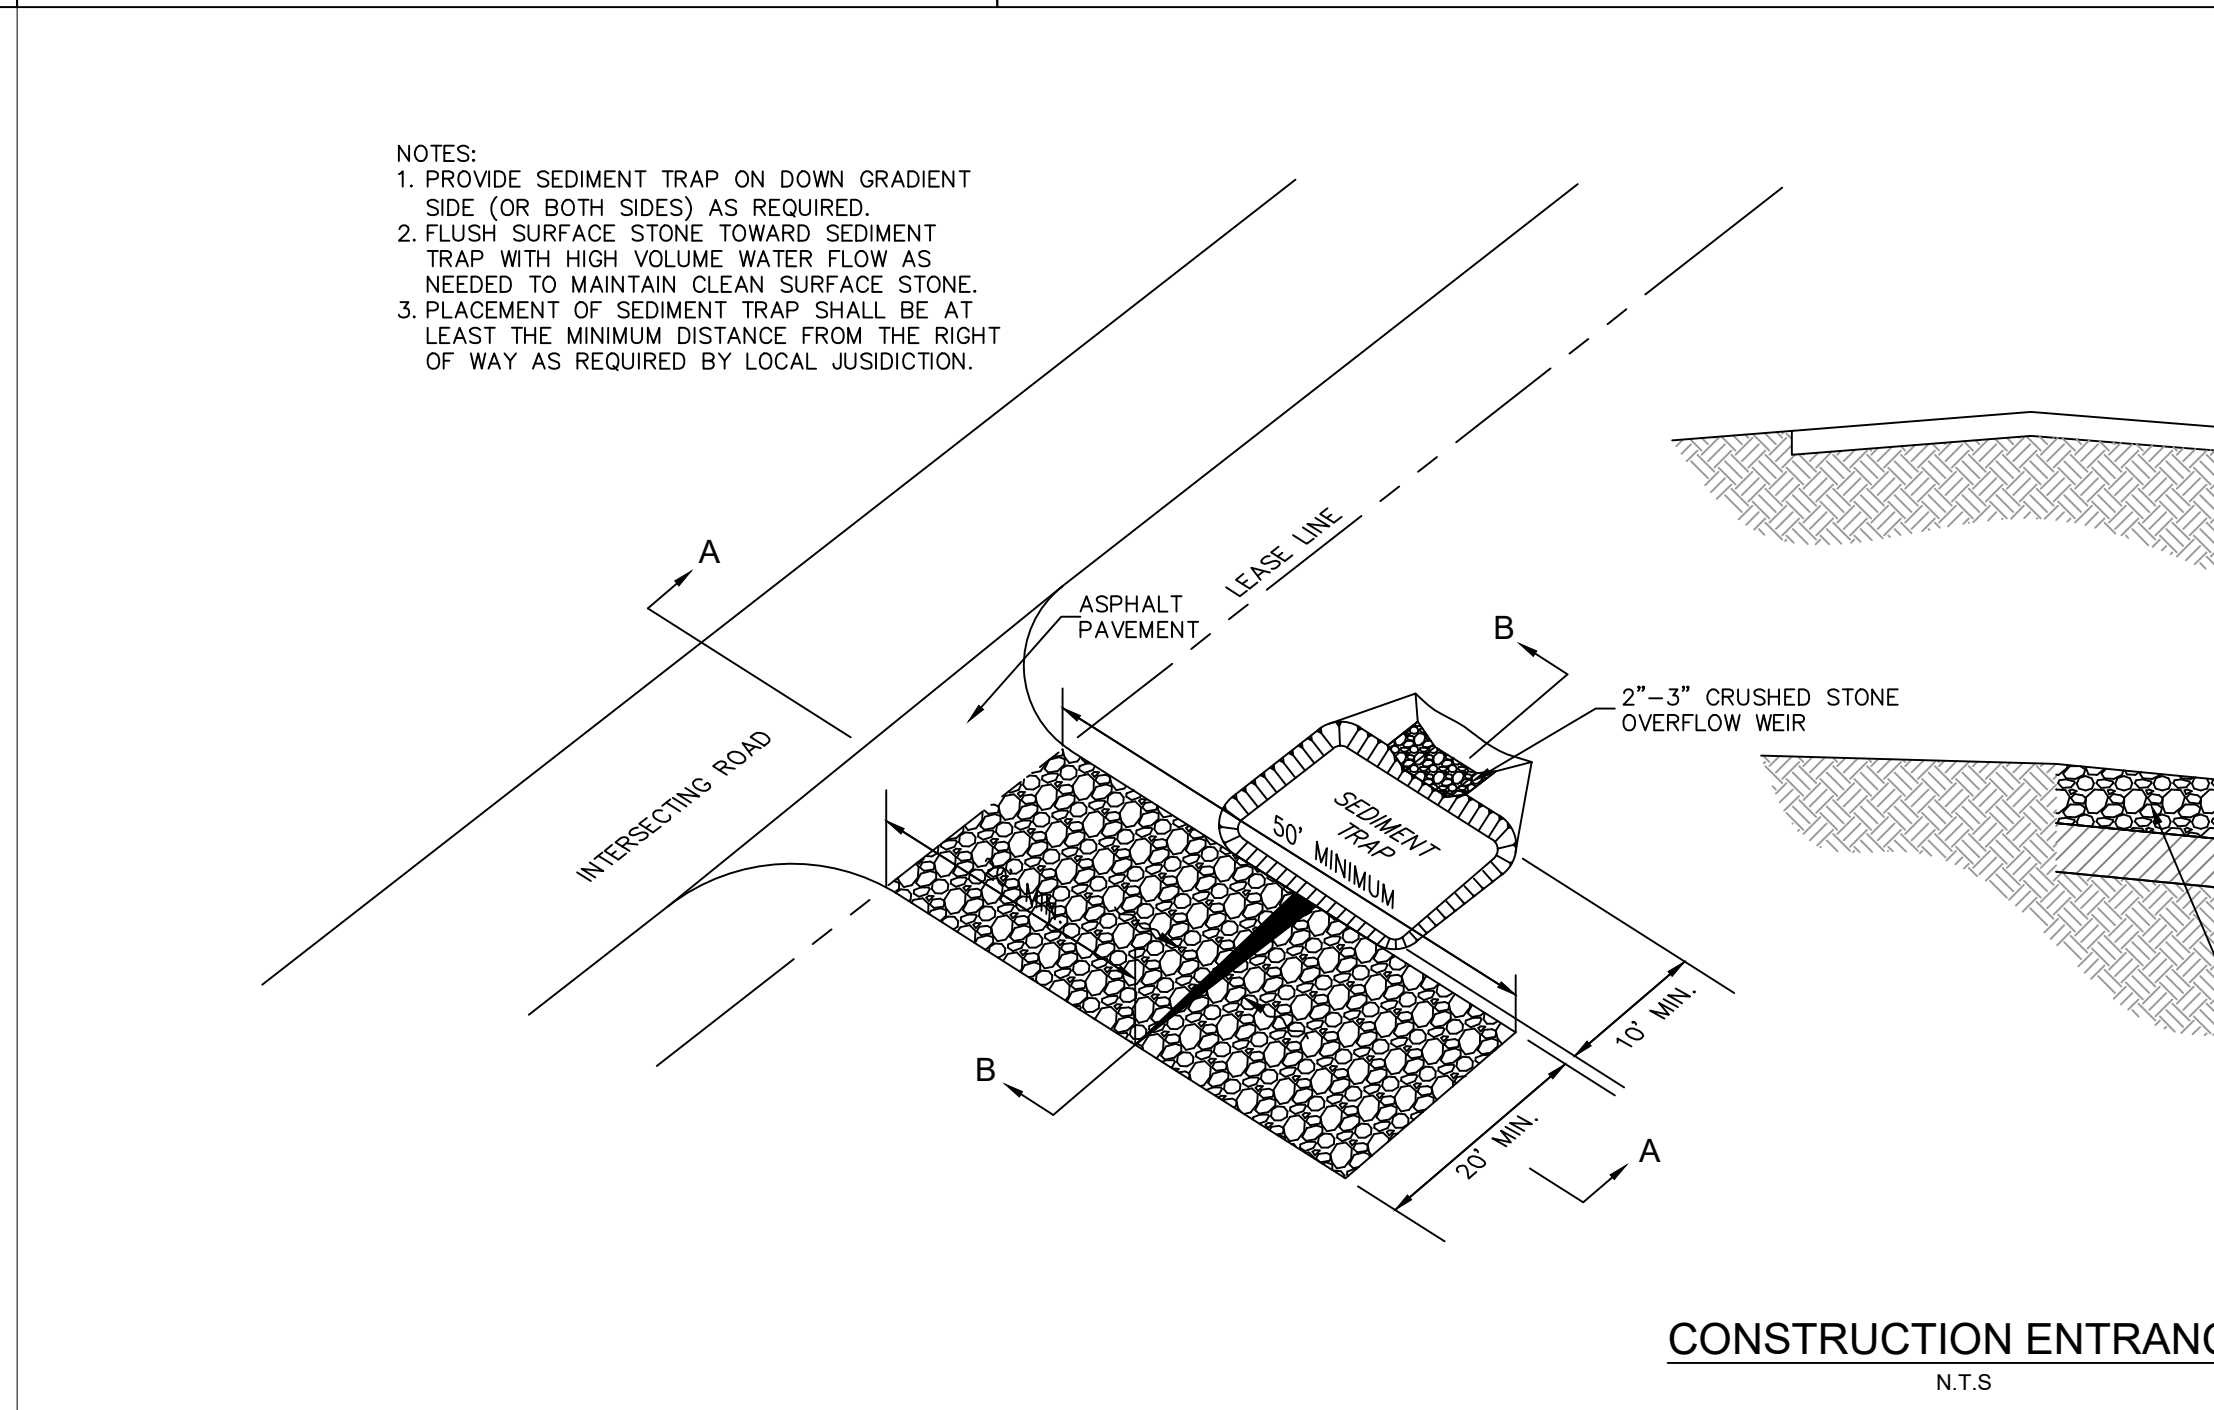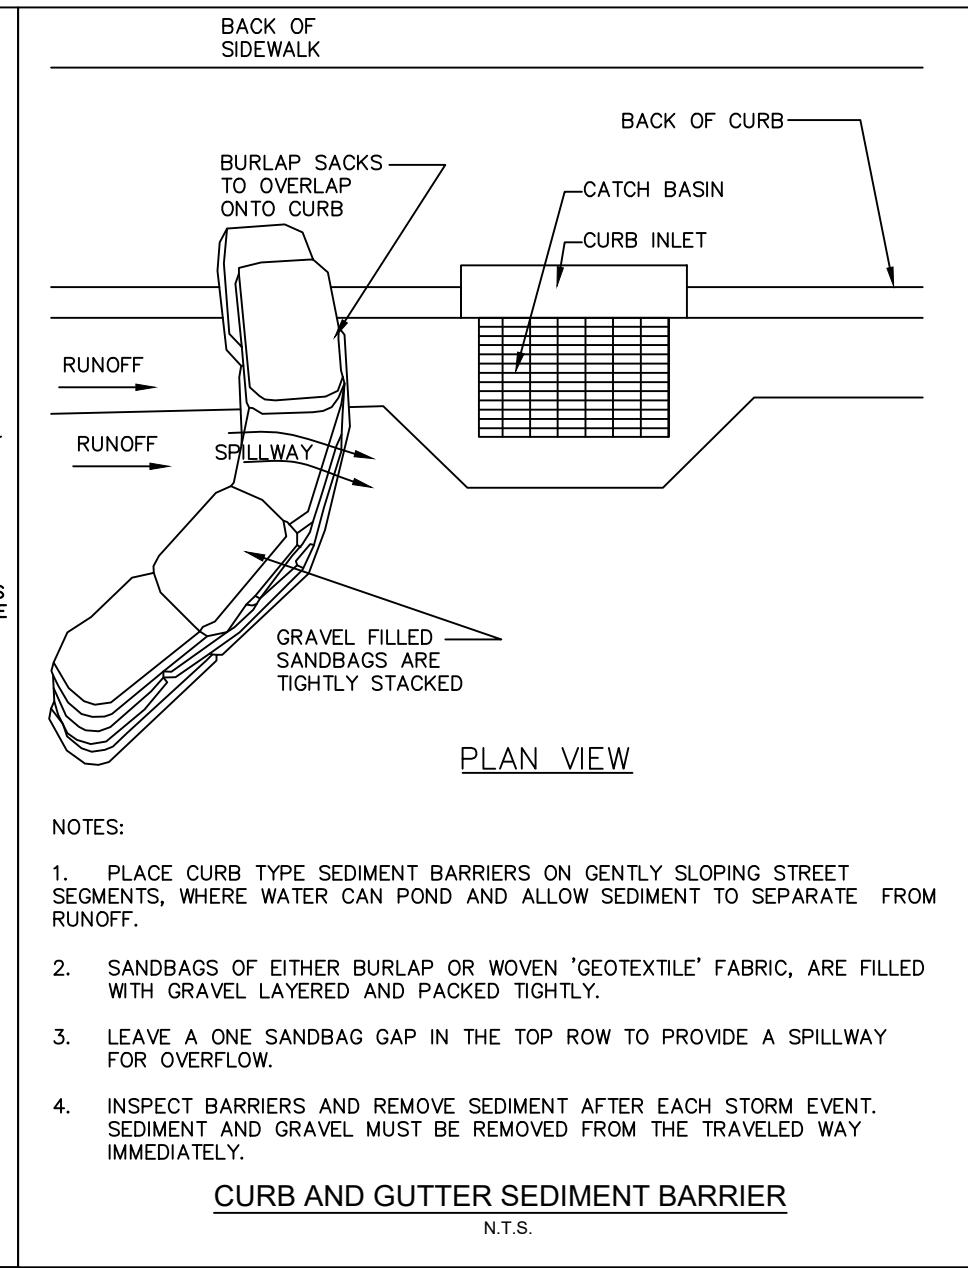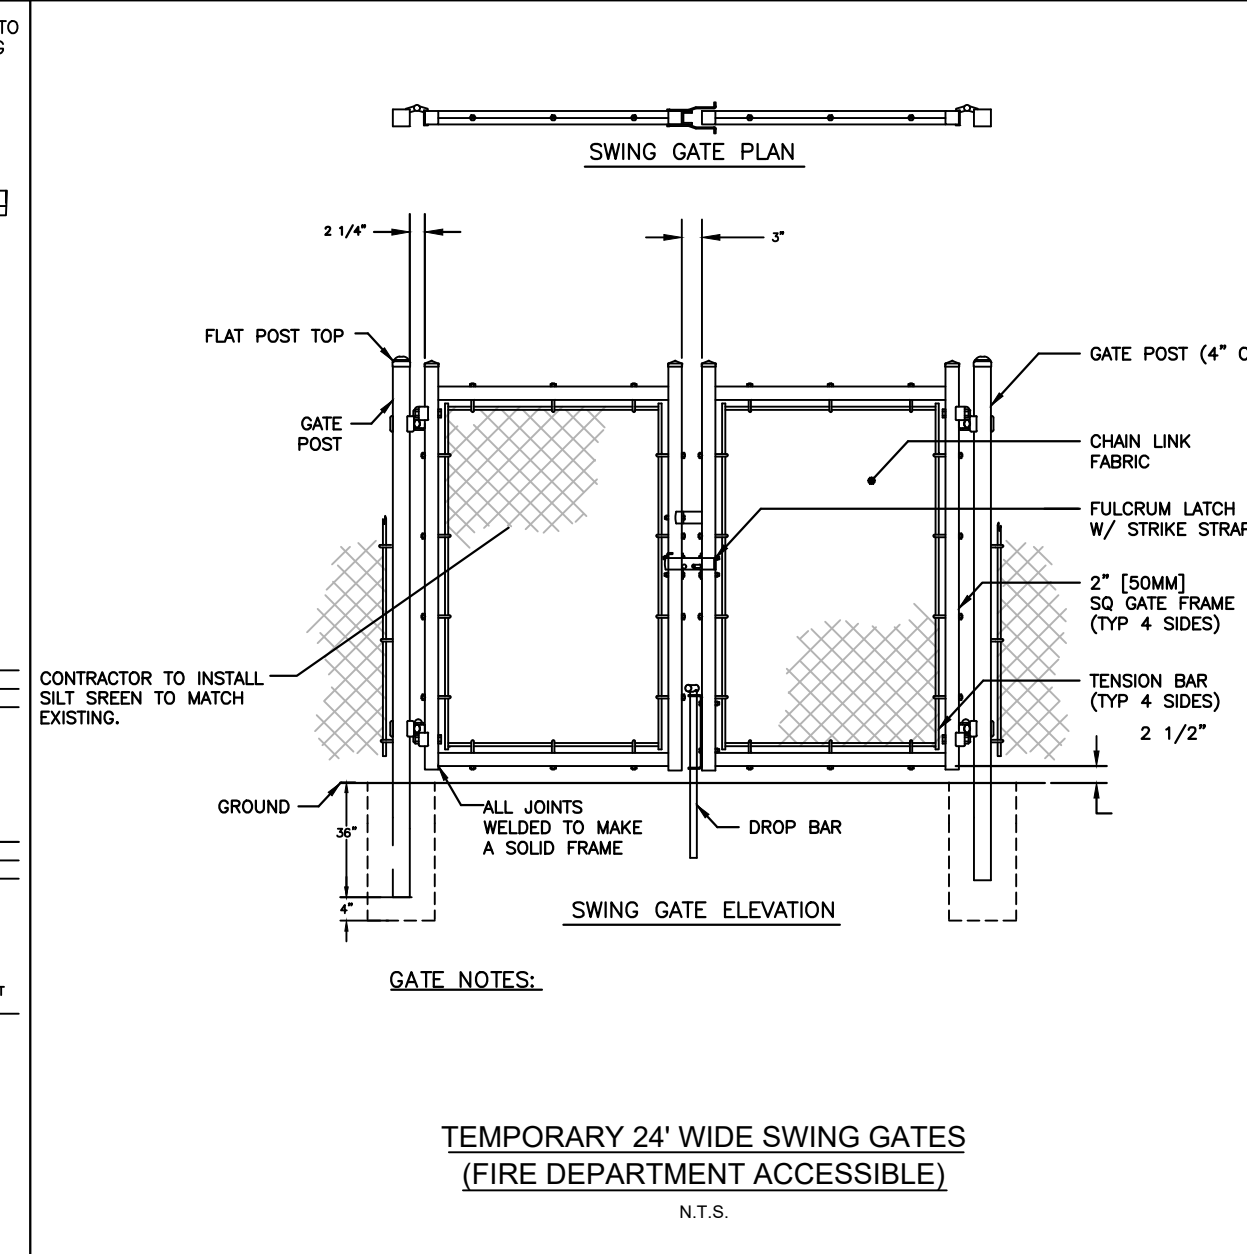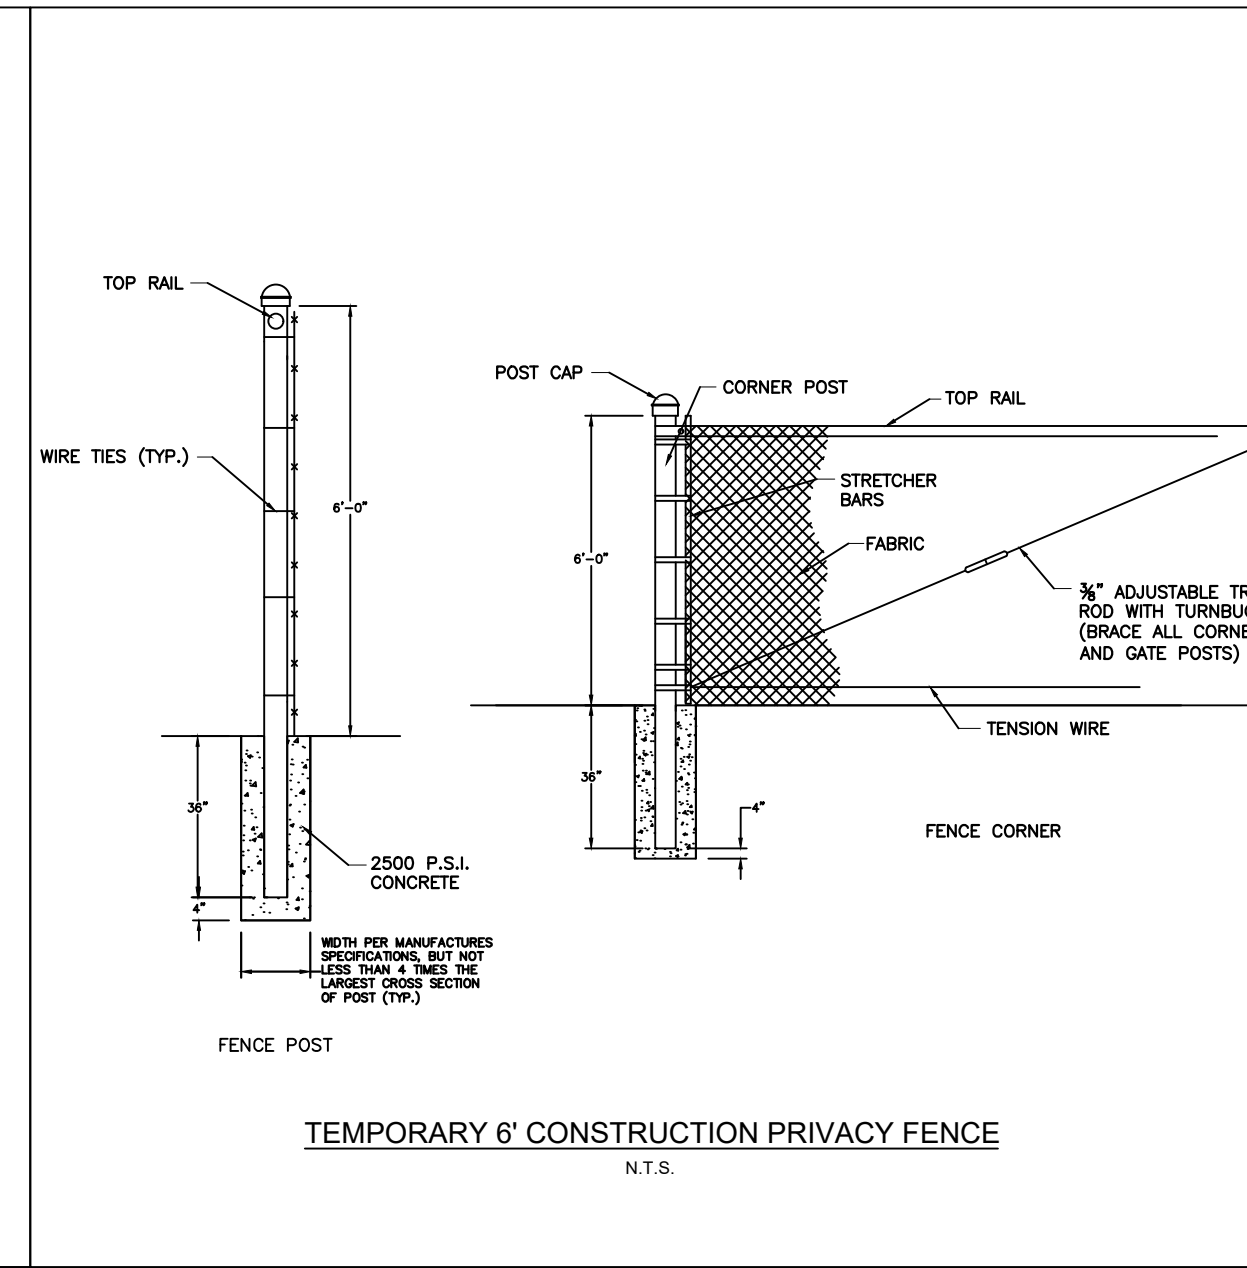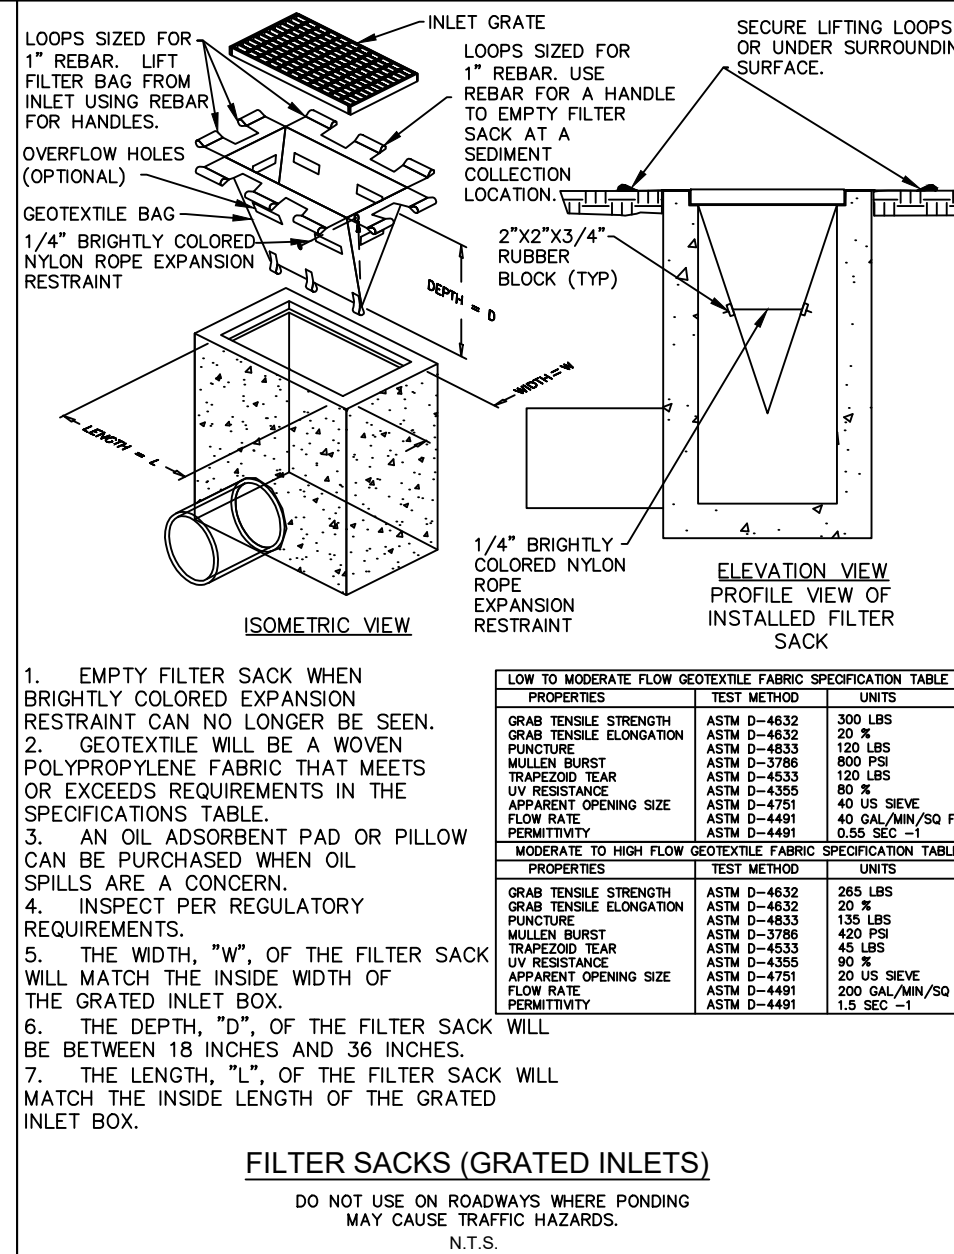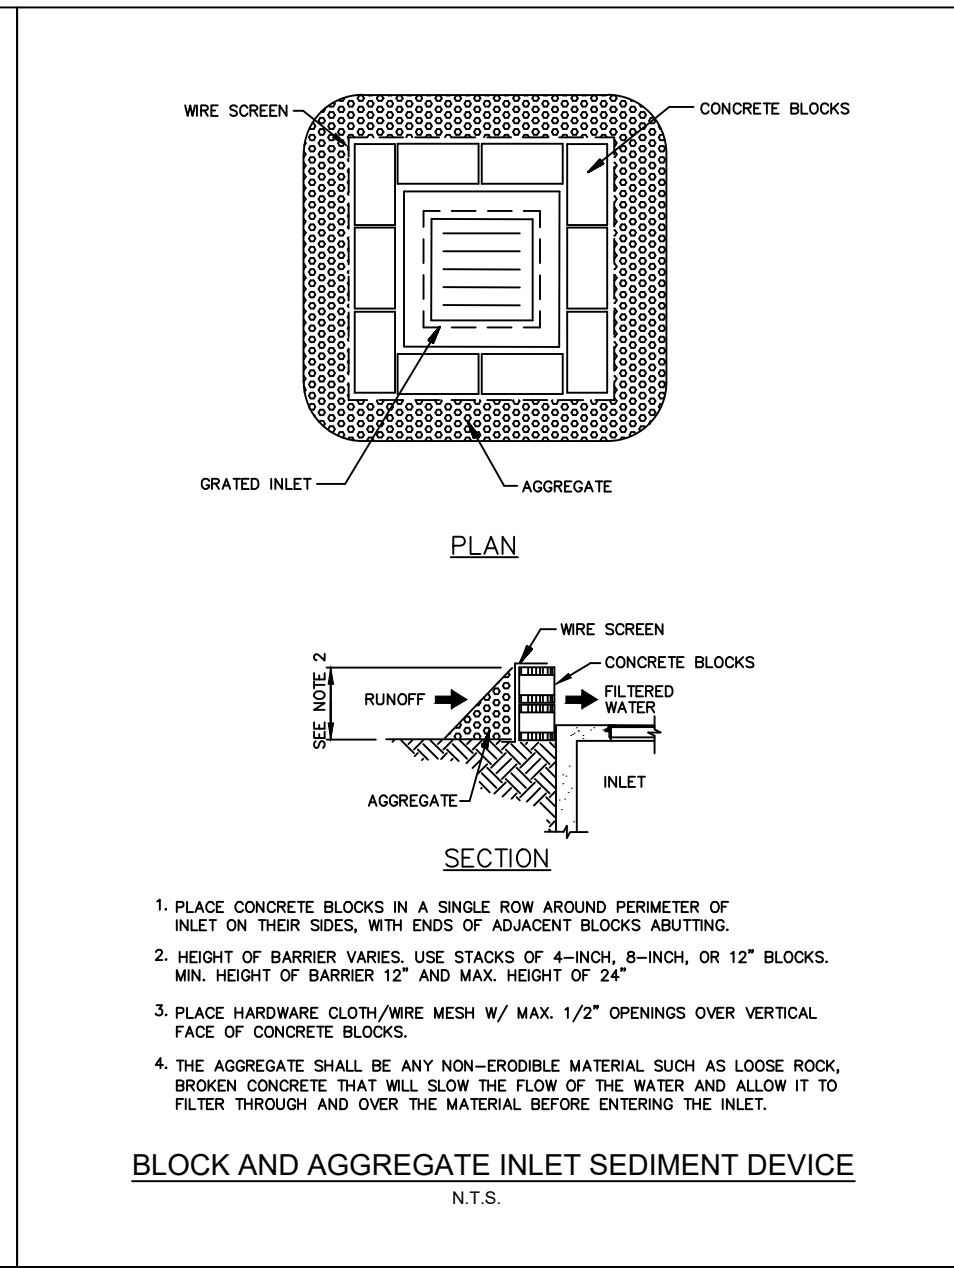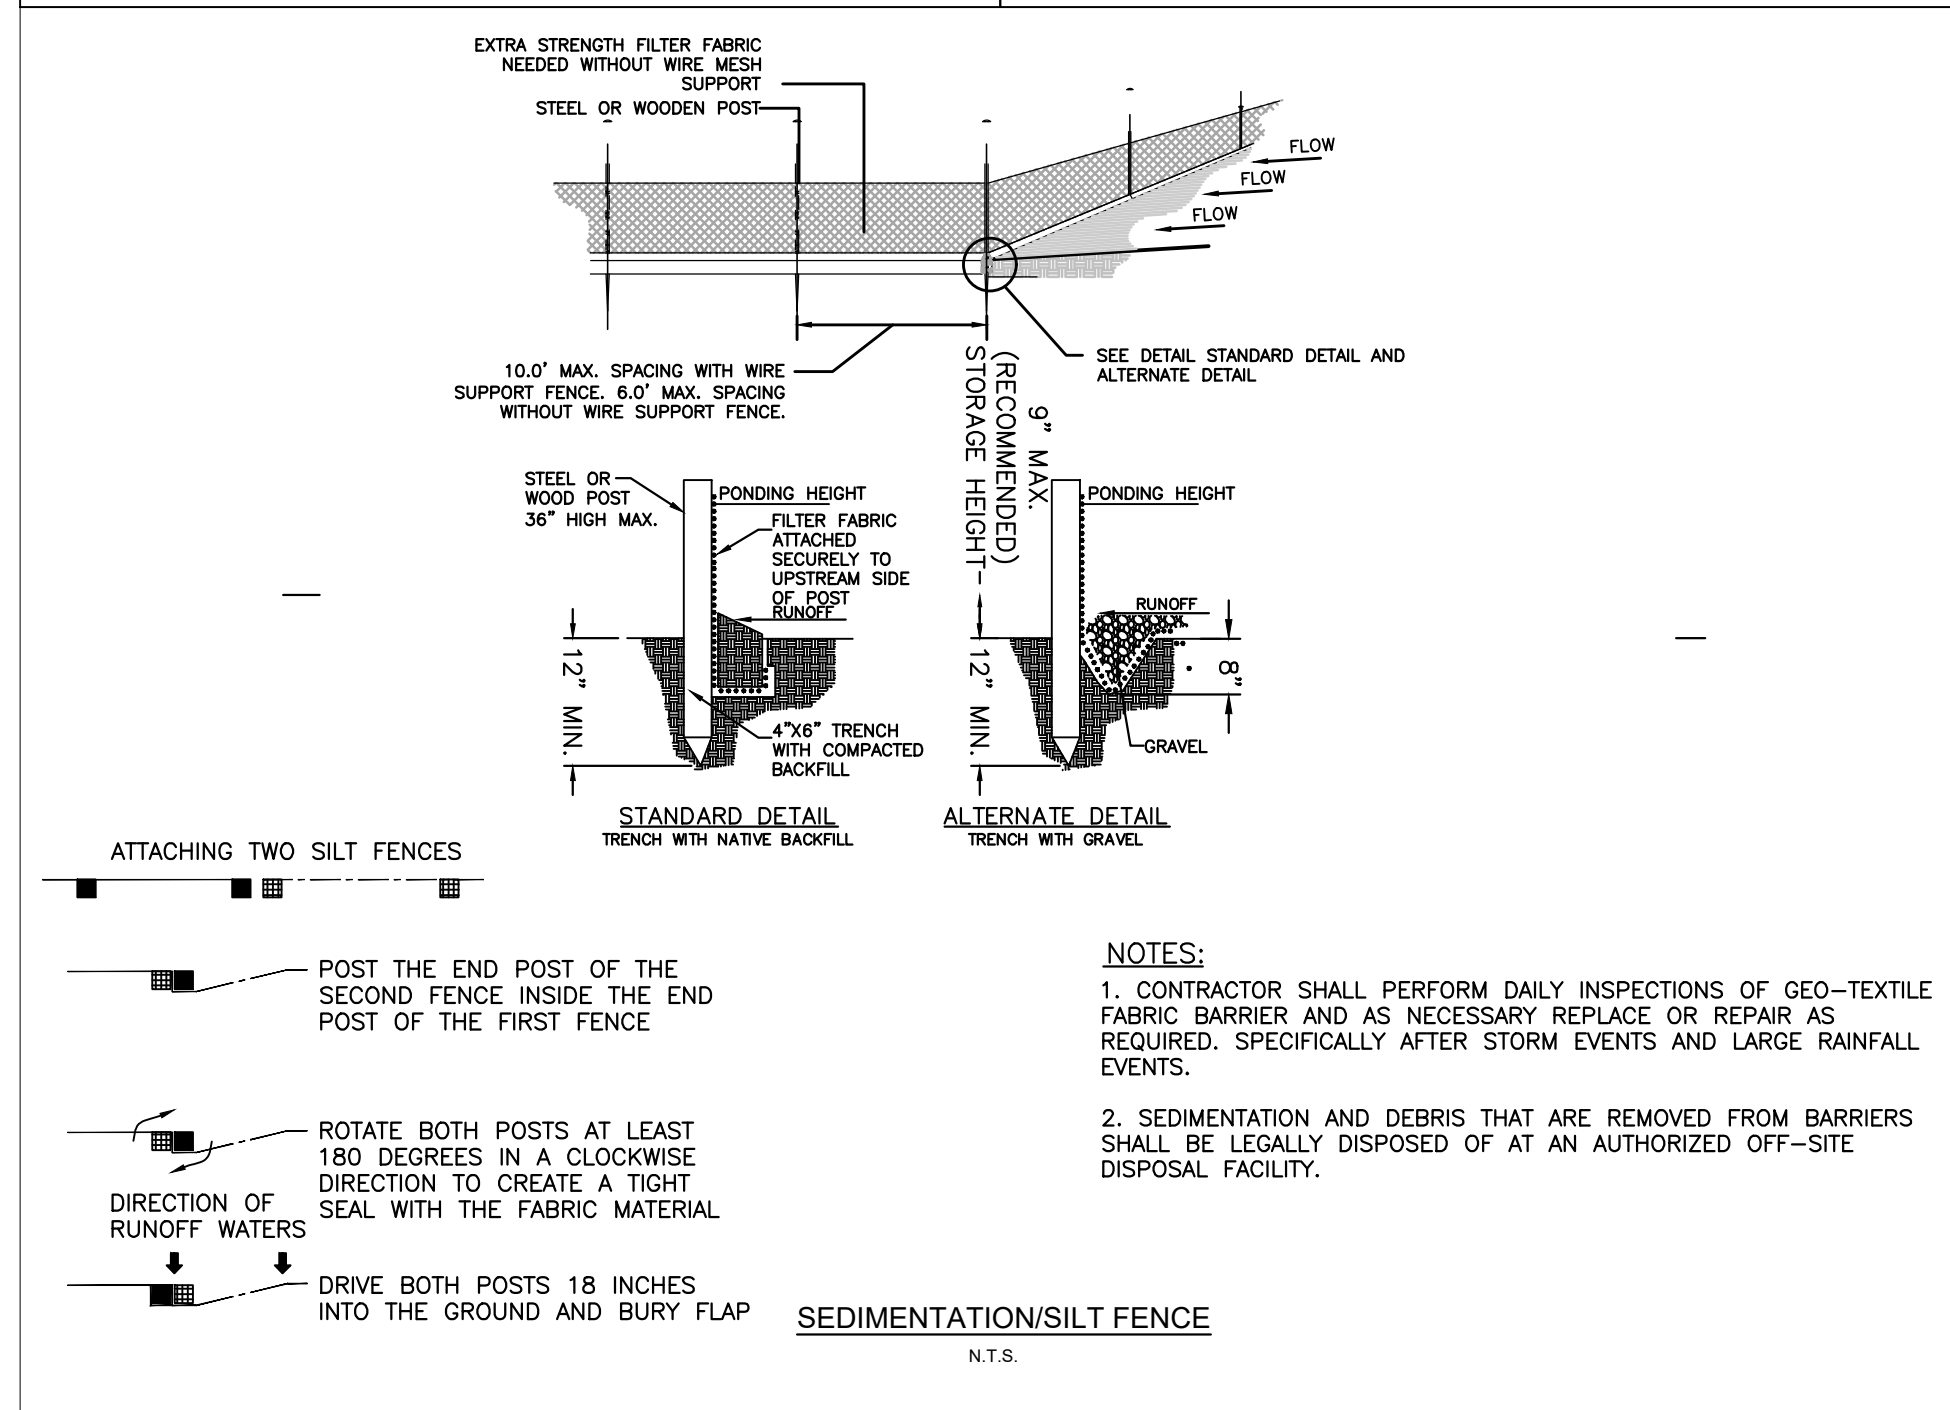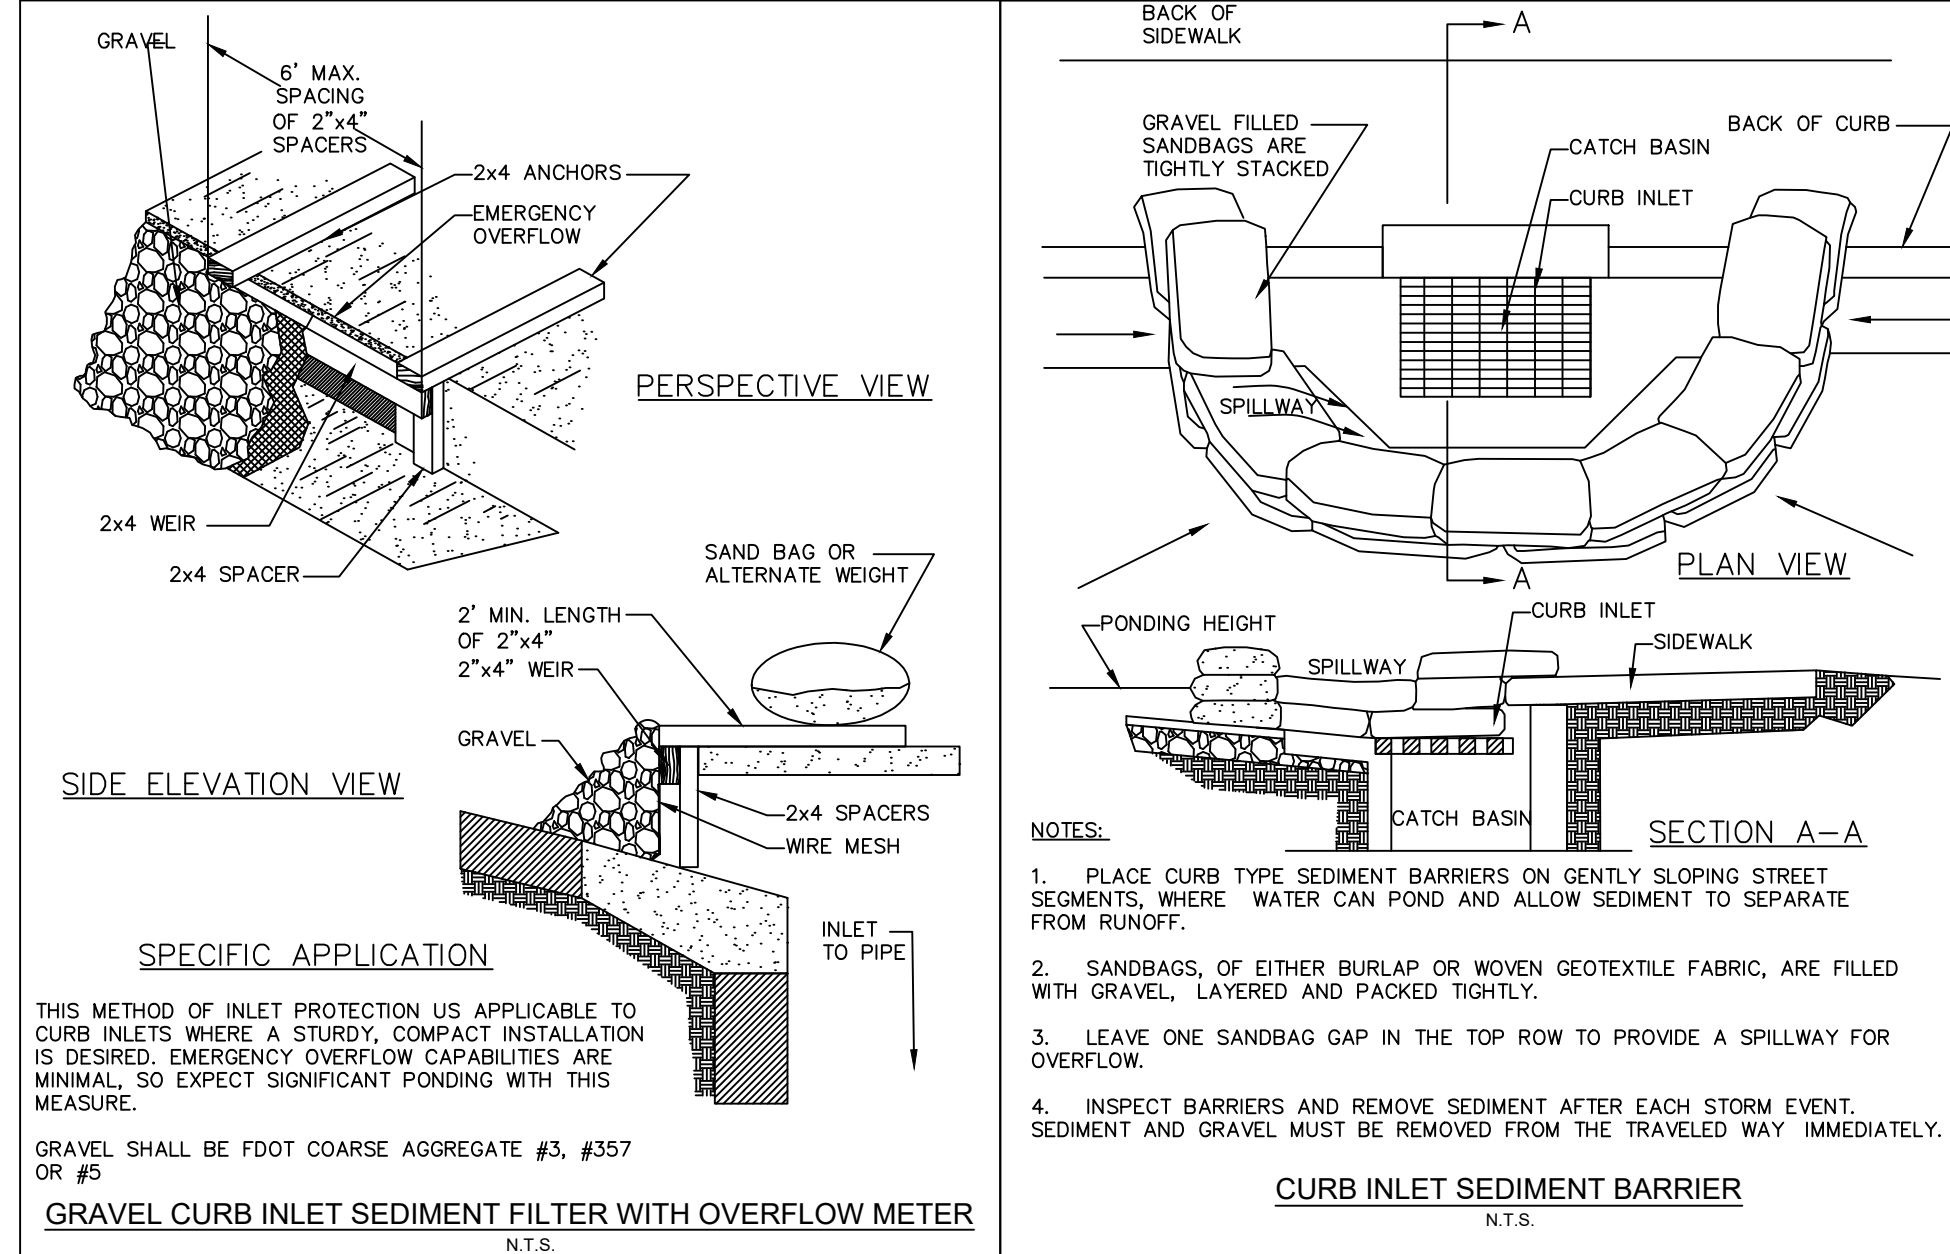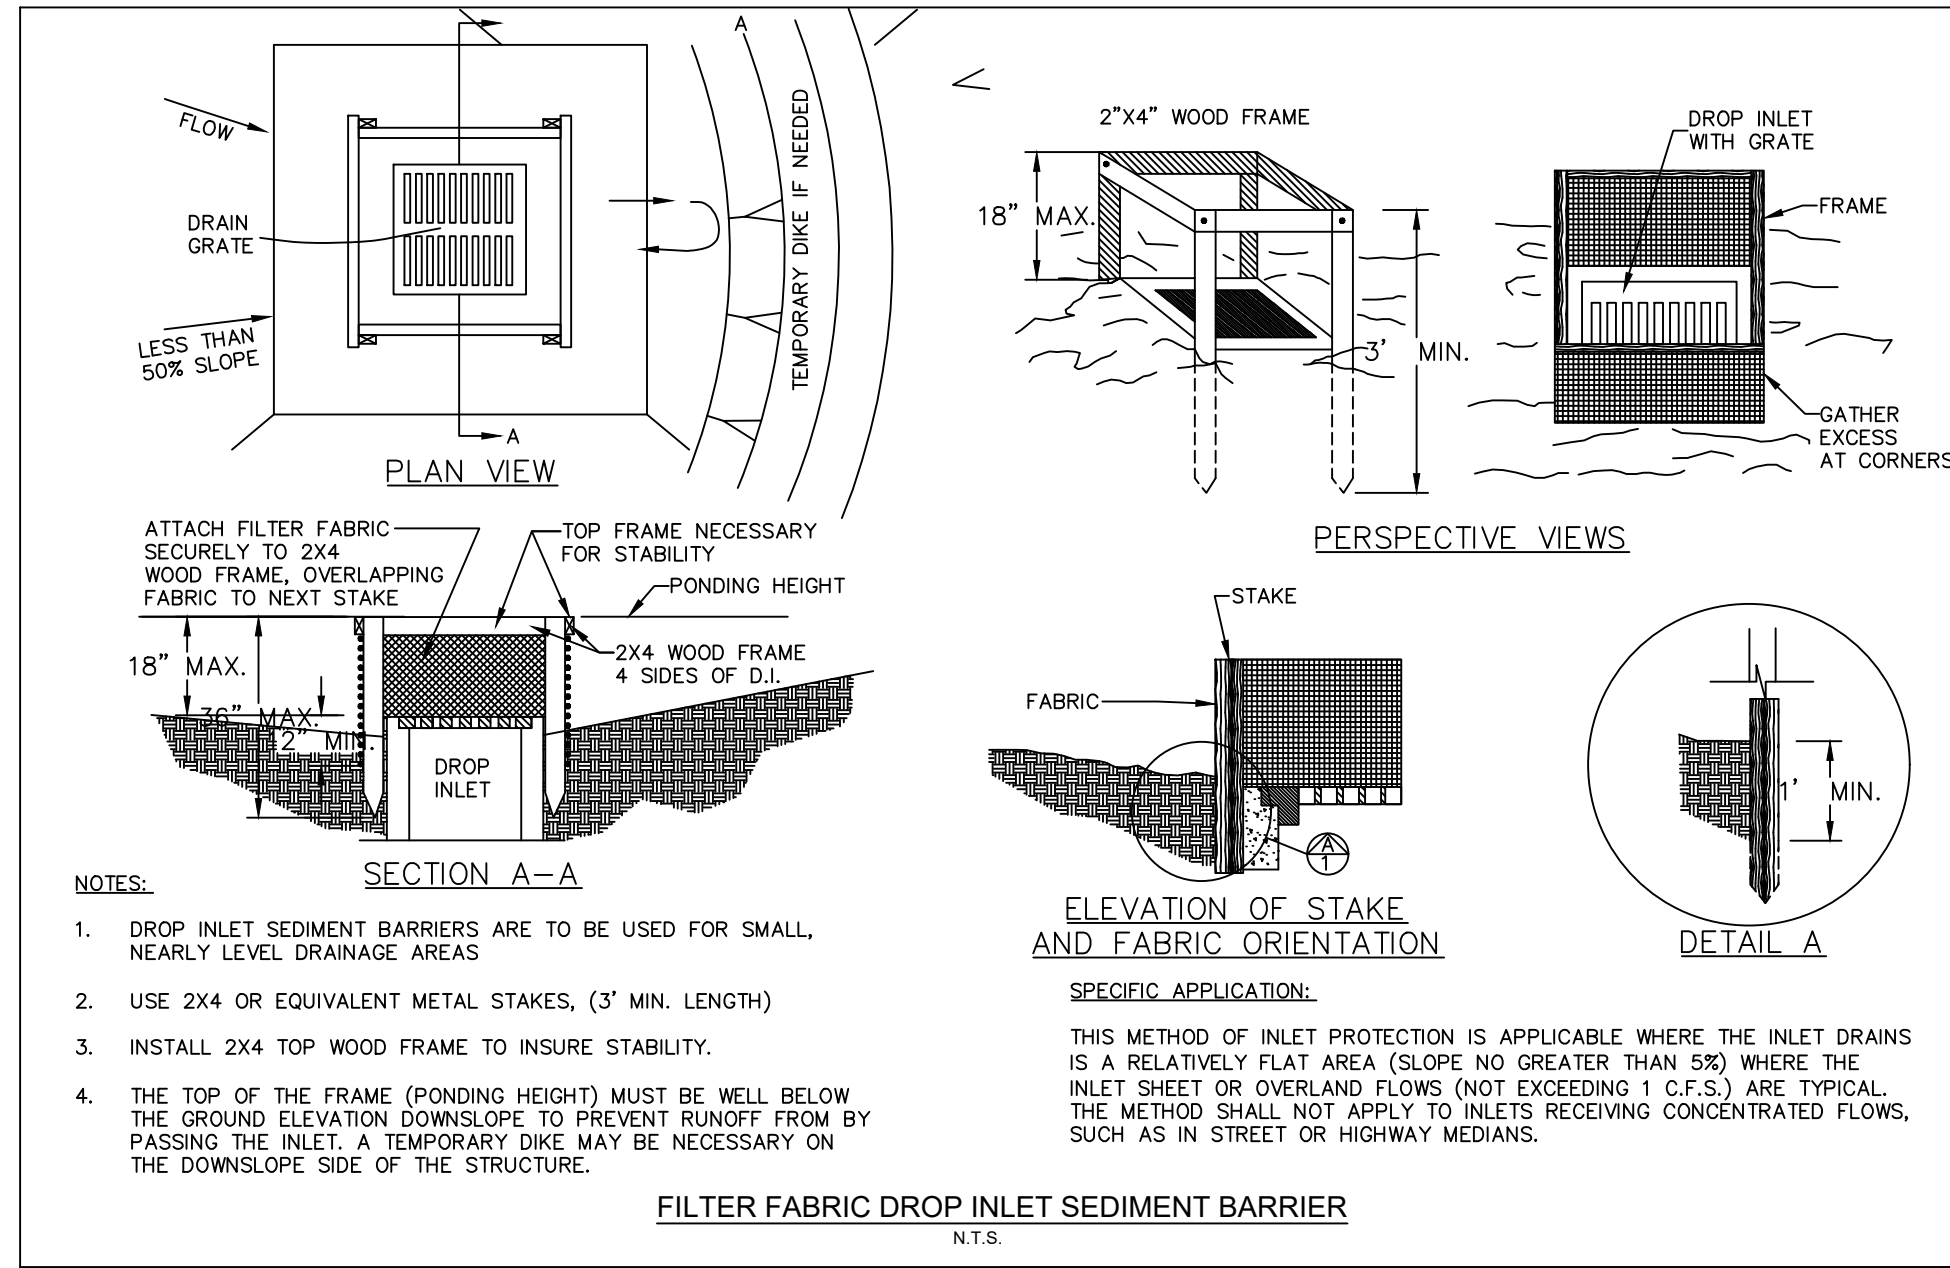

**Kimley-Horn**  
 © 2021 KIMLEY-HORN AND ASSOCIATES, INC.  
 355 ALHAMBRA CIRCLE, SUITE 1400, CORAL GABLES, FL 33134  
 PHONE: 305-673-2025  
 WWW.KIMLEY-HORN.COM REGISTRY: 696

KHA PROJECT  
14-3228000

DATE  
JULY 2021

SCALE  
AS SHOWN

DESIGNED BY  
MRC

DRAWN BY  
RMR

CHECKED BY  
BF

DATE:

**EROSION CONTROL DETAILS**

**IRC LANDFILL PREPARED FOR INDIAN RIVER COUNTY**

FL

SHEET NUMBER  
**C-320**


This item has been digitally signed and sealed by Barton J. Fye, P.E. on the date adjacent to the seal.

Printed copies of this document are not considered signed and sealed and the signature must be verified on any electronic copies.

DATE: 11/17/2021

**Sunshine811**  
 Call 811 or www.sunshine811.com two full business days before digging to have utilities located and marked.  
 Check positive response codes before you dig!

Plotted By: Rodriguez, Rebecca Sheet Set: IRC LANDFILL Layout: OVERALL SITE PLAN November 17, 2021 10:40:03am c:\vmb-civil\43228000 - irc thw and recycling facility\CIVIL\CADD\plansheets\C-410 Site Plan.dwg  
 This document, together with the concepts and designs presented herein, is intended only for the specific purpose and client for which it was prepared. Reuse of and improper reliance on this document without written authorization and adaptation by Kimley-Horn and Associates, Inc. shall be without liability to Kimley-Horn and Associates, Inc.

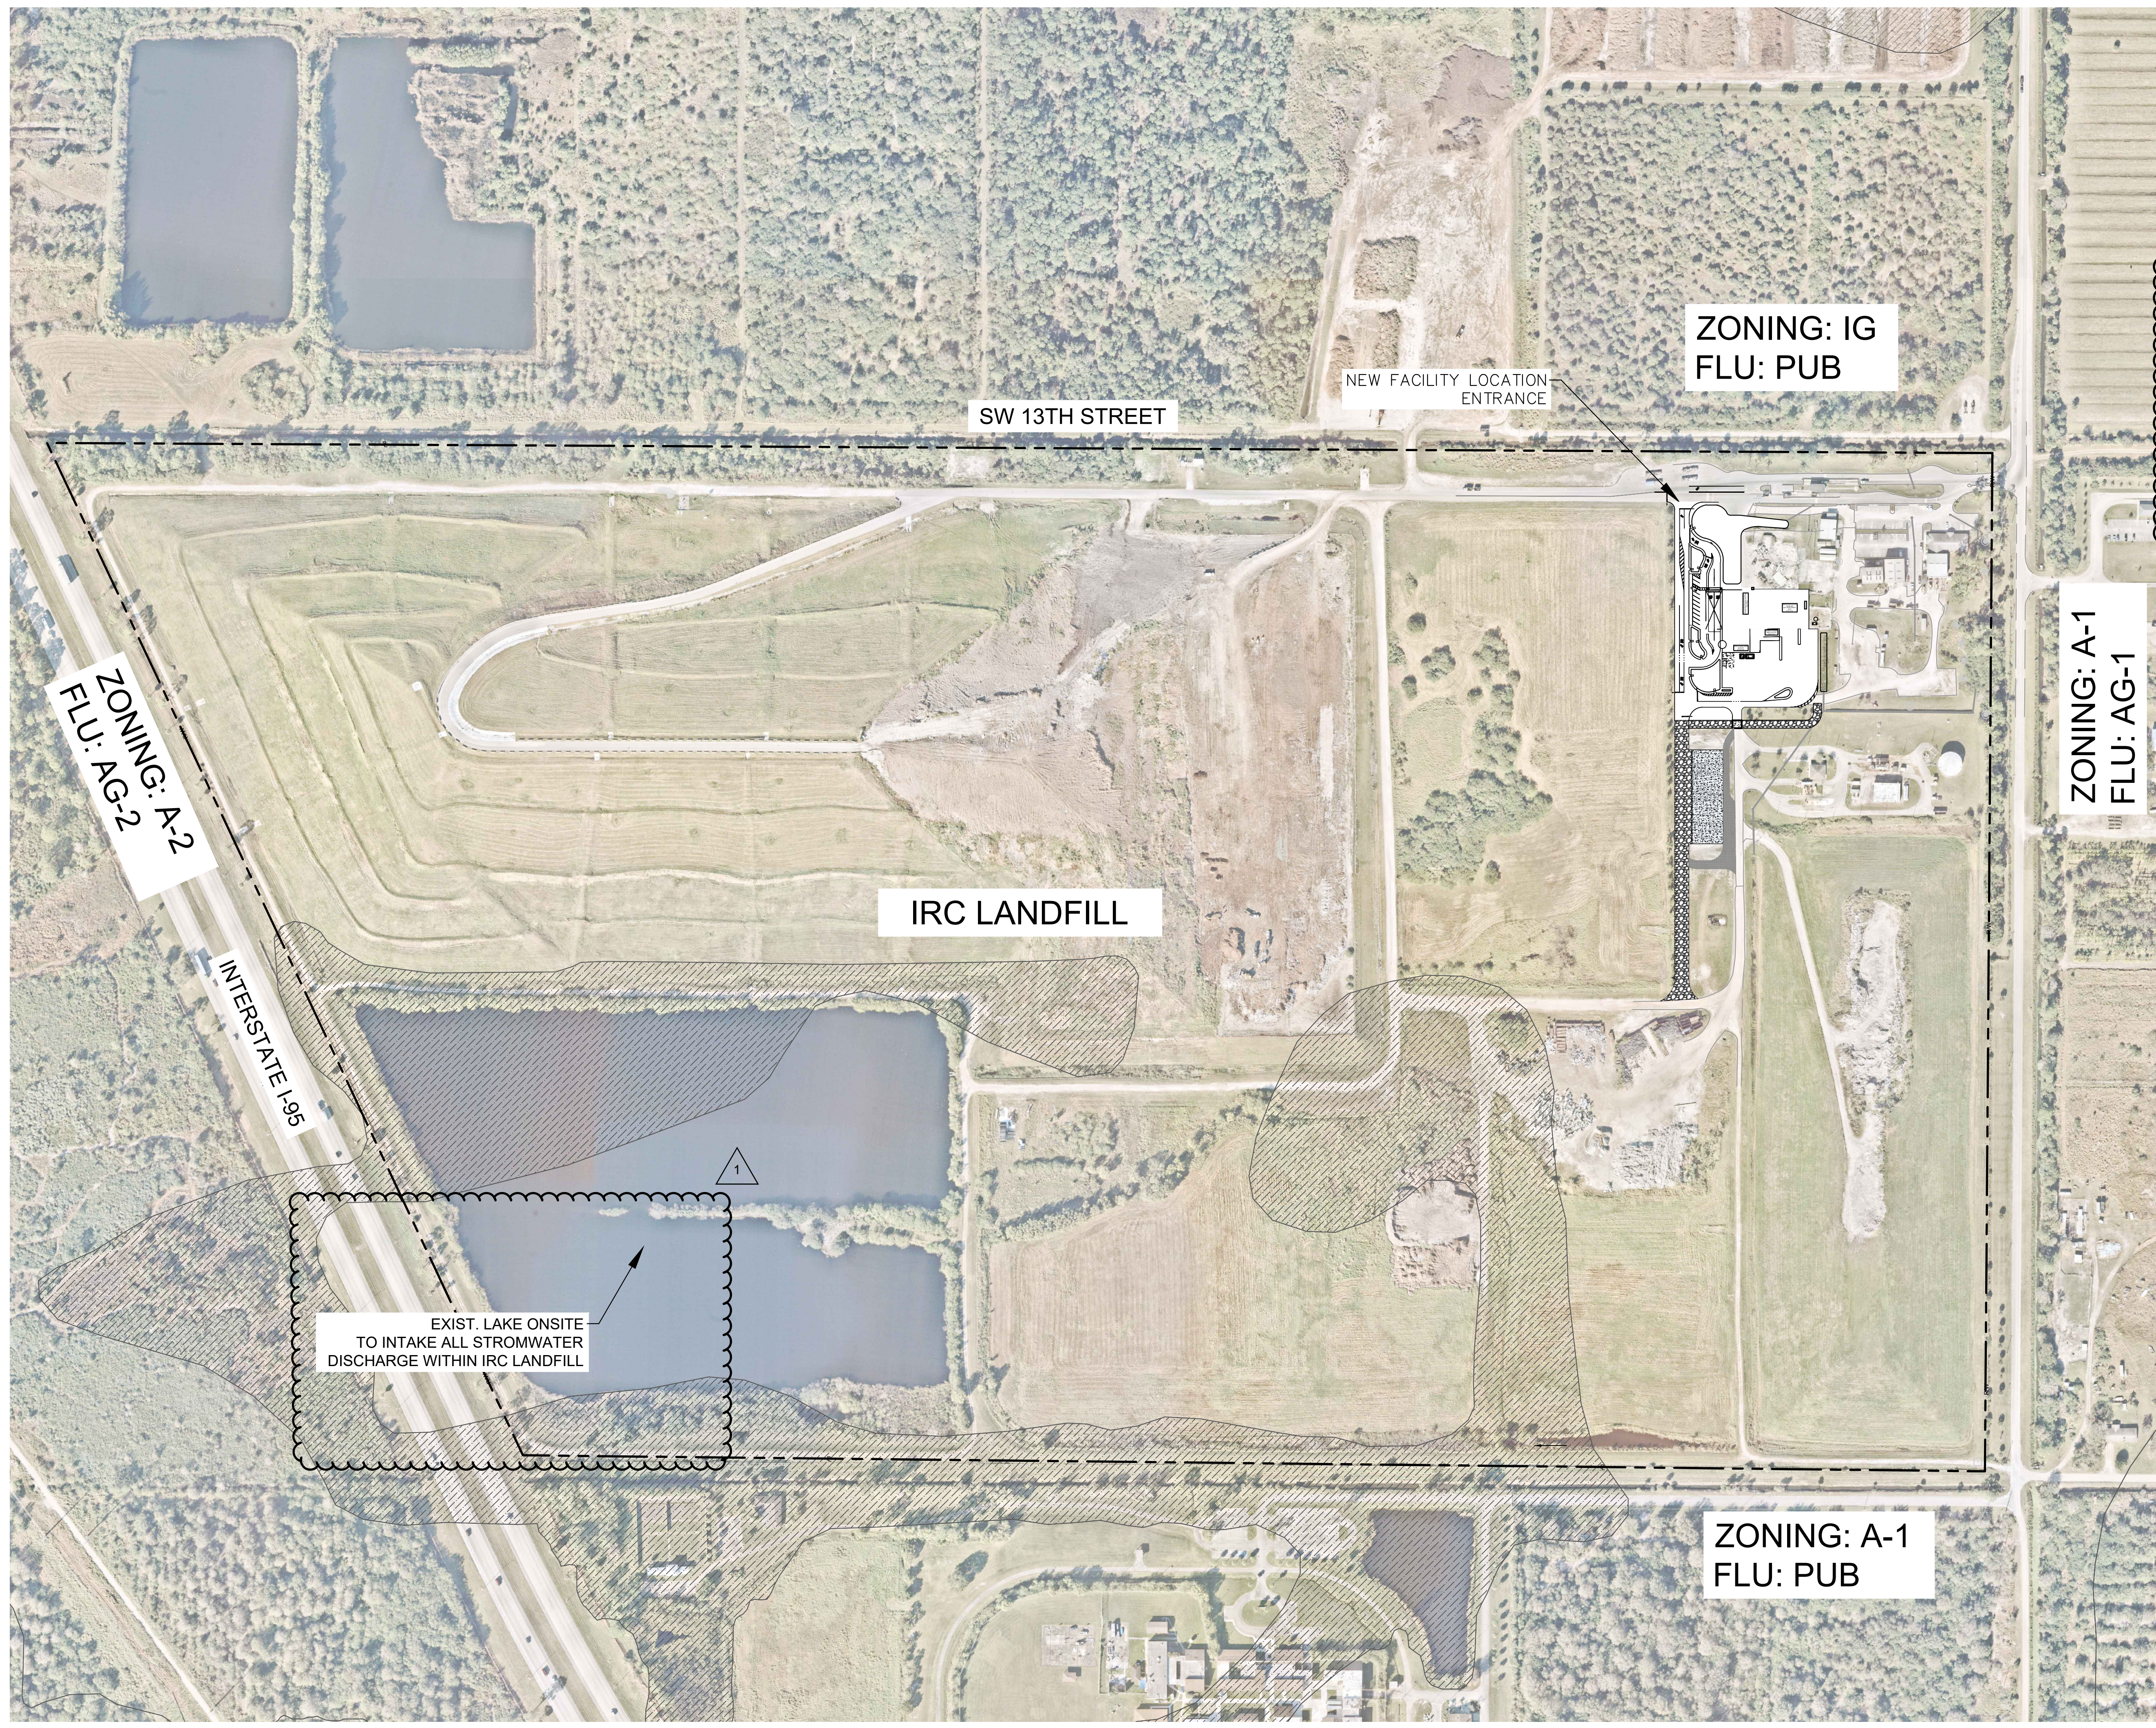


**LEGEND**

- RAW — P — RIGHT-OF-WAY LINE / PROPERTY LINE
- ▨ FEMA HAZARDOUS FLOOD ZONE A F.I.R.M. NO.: 12061C0355H

**NOTES**

- 74TH AVE SW POSTED SPEED LIMIT = 45MPH
- PROPOSED INTERCONNECTED DRAINAGE SYSTEM WILL CONNECT TO THE EXISTING STORM PIPE AS DESIGNATED ON PLAN SHEET.

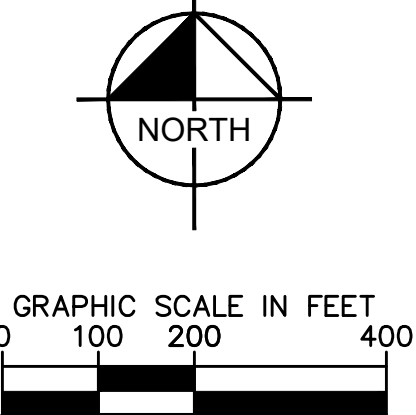


| NO. | REVISIONS | DATE | BY |
|-----|-----------|------|----|
|     |           |      |    |
|     |           |      |    |
**Kimley & Horn**  
 © 2021 KIMLEY-HORN AND ASSOCIATES, INC.  
 355 ALHAMBRA CIRCLE, SUITE 1400, CORAL GABLES, FL 33134  
 PHONE: 305-673-2025  
 WWW.KIMLEY-HORN.COM REGISTRY 696

|             |           |
|-------------|-----------|
| KHA PROJECT | 143228000 |
| DATE        | JULY 2021 |
| SCALE       | AS SHOWN  |
| DESIGNED BY | MRC       |
| DRAWN BY    | RMR       |
| CHECKED BY  | BF        |
| DATE:       |           |


**OVERALL SITE PLAN**

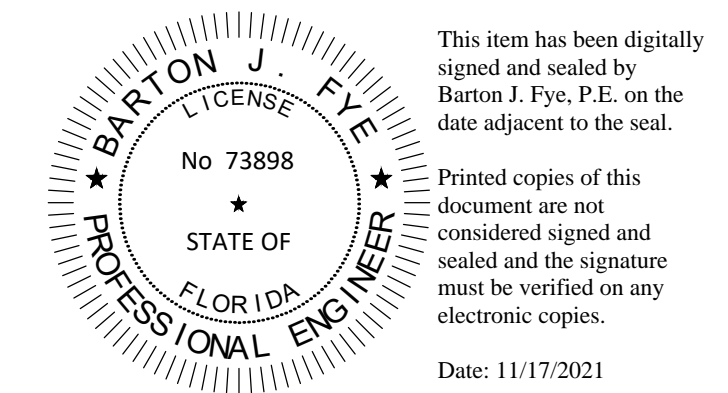


**Sunshine811**  
 Call 811 or www.sunshine811.com two full business days before digging to have utilities located and marked.  
 Check positive response codes before you dig!

**IRC LANDFILL**  
 PREPARED FOR  
**INDIAN RIVER COUNTY**  
 INDIAN RIVER COUNTY  
 FL  
 SHEET NUMBER  
**C-400**

Plotted By: Rodriguez, Rebecca - Sheet Set: IRC LANDFILL - LAYOUT C-410 SITE PLAN - November 17, 2021 10:40:08am - K:\vmb-civil\143228000 - irc hhw and recycling facility\CADD\plansets\C-410 Site Plan.dwg  
 This document, together with the concepts and designs presented herein, is intended only for the specific purpose and client for which it was prepared. Reuse of and improper reliance on this document without written authorization and adaptation by Kimley-Horn and Associates, Inc. shall be without liability to Kimley-Horn and Associates, Inc.

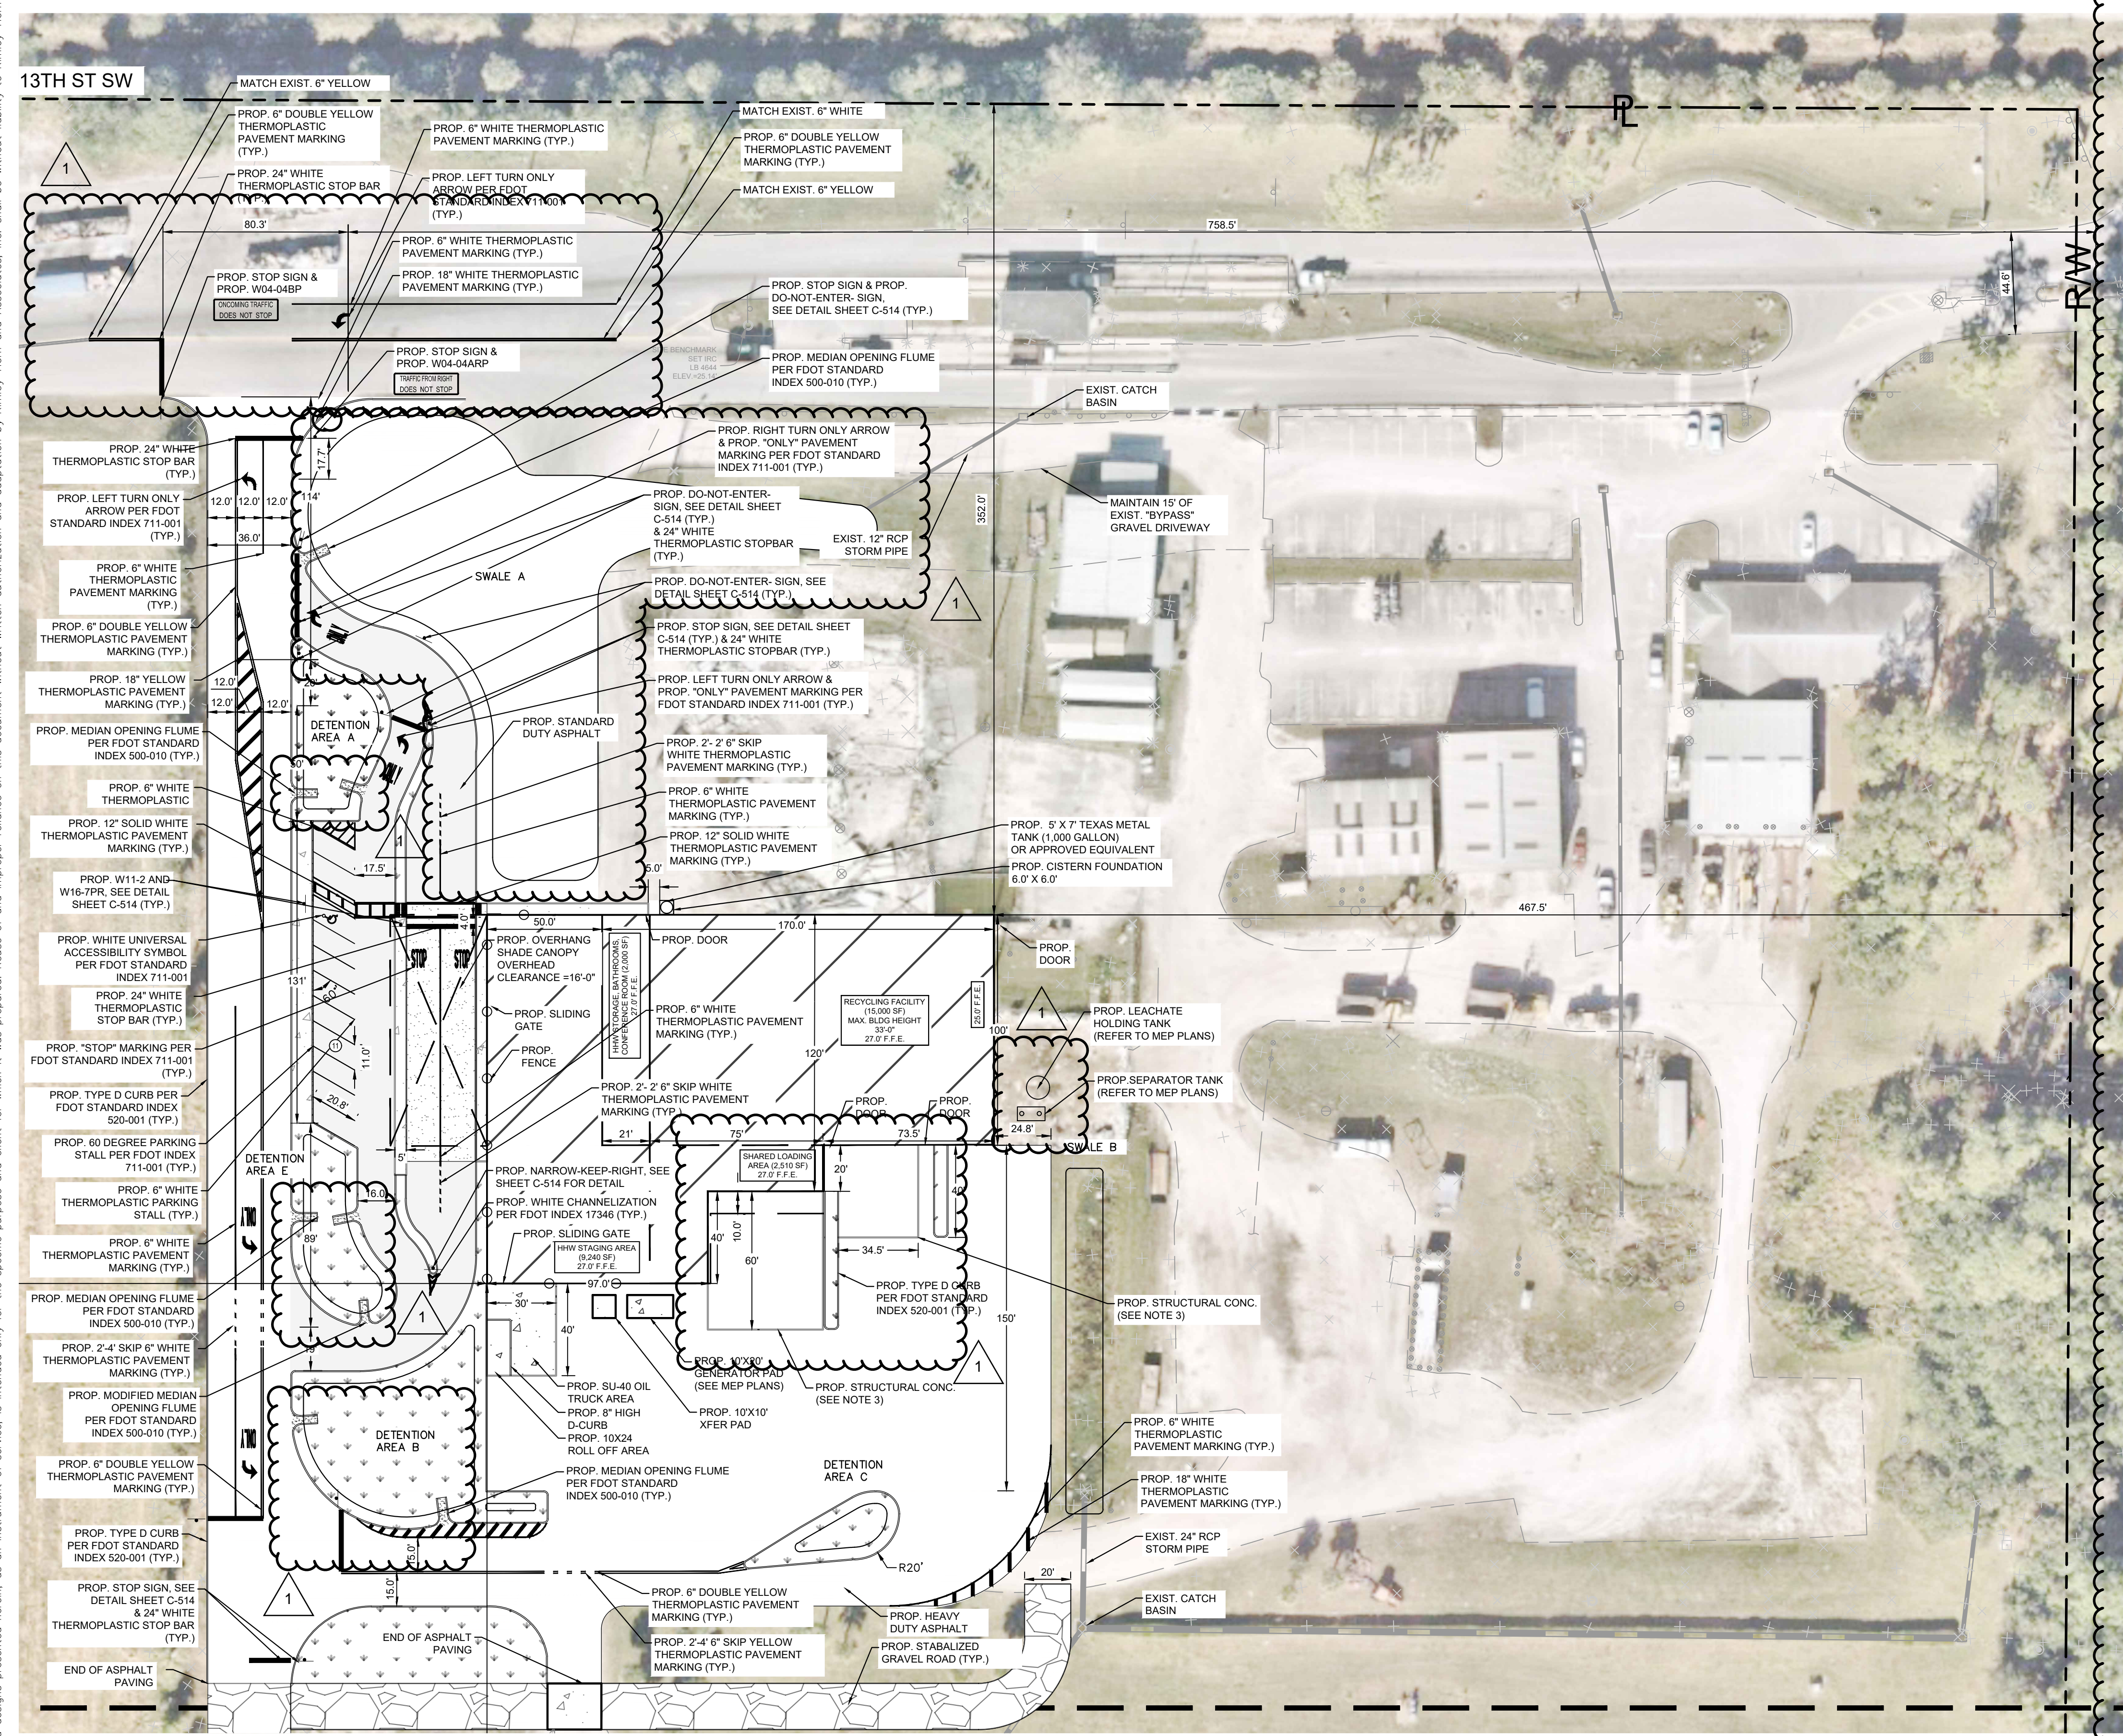


SEE SHEET C-411 FOR CONTINUATION

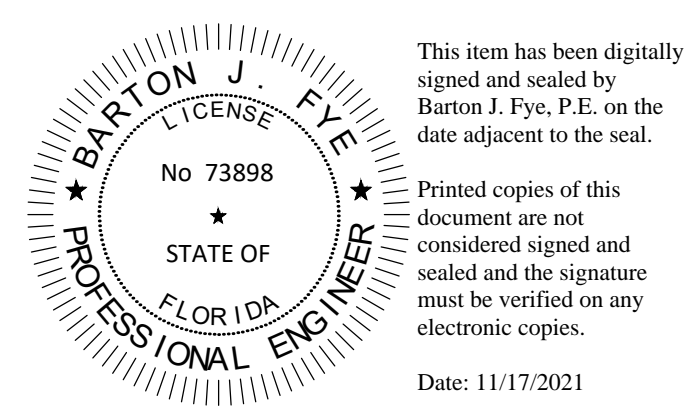

**LEGEND**

- RIGHT-OF-WAY LINE / PROPERTY LINE
- PROP. BUILDING
- PROP. GRAVEL ROAD
- PROP. HEAVY DUTY ASPHALT
- PROP. STANDARD DUTY ASPHALT
- PROP. LANDSCAPE AREA
- PROP. STANDARD DUTY CONC.
- PROP. HEAVY DUTY CONC.
- PROP. CONC. SIDEWALK
- EXIST. GRAVEL ROAD

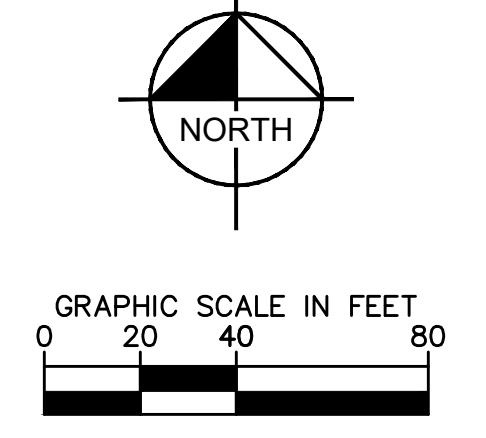

**NOTES:**

- STANDARD DUTY ASPHALT TO BE INSTALLED ONLY IN THE PEDESTRIAN PARKING LOT & DROP-OFF AREA.
- HEAVY DUTY ASPHALT TO BE INSTALLED ONLY IN THE TRUCK COURT AND THE NORTHERN/SOUTHERN ACCESS ROAD.
- REFER TO ARCHITECTURAL AND STRUCTURAL PLANS FOR CONCRETE PAVEMENT DETAIL.
- ALL MEDIAN OPENING FLUMES TO BE CONSTRUCTED TO EXTEND DOWN TO THE BOTTOM OF ALL PONDS AND SWALES.
- CONTRACTOR SHALL DIRECT ENTERING AND EXITING SEMI TRUCKS LOADED FOR DELIVERY AT THE EXISTING 80' X 240' CONCRETE PAD. SEMI TRUCKS LOADED AT THE EXISTING 80' X 240' CONCRETE PAD ARE ROUTED FOR DELIVERY TO ST. LUCIE COUNTY. A TEMPORARY TRAFFIC PLAN FOR THESE ACTIVITIES SHALL BE PROVIDED BY THE CONTRACTOR.

**PROJECT LOCATION**  
 1325 74TH AVENUE SW, VERO BEACH, FL 32968  
 SECTION 25, TOWNSHIP 33, RANGE 38, INDIAN RIVER COUNTY, FL  
 TAX PARCEL ID: 33-28-25-00001-0090-00001.0

**BENCHMARK NOTE:**  
 THE PRIMARY BENCHMARK UTILIZED FOR THIS SURVEY IS IRC BM267009, ELEVATION 20.50'

**UTILITY PROVIDERS**  
 THE PROJECT WILL BE SERVED BY:  
 WATER/SEWER INDIAN RIVER COUNTY  
 ELECTRIC FLORIDA POWER AND LIGHT

**FLOOD ELEVATION**  
 F.I.R.M NO.: 12061C0355H  
 EFFECTIVE DATE: 12/04/2012  
 SPECIAL FLOOD HAZARD AREA ZONE: ZONE X/ZONE A  
 BASE FLOOD ELEVATION: N/A

**BUILDING HEIGHT**  
 BUILDING HEIGHT: 33.0' (MAX. 35.0' ALLOWED)

**SITE AREA**  
 BUILDING COVERAGE AREA: 28,750 SQ FT 0.66 (AC) 8% (MAX. 20% ALLOWED)  
 IMPERVIOUS AREA: 100,277 SQ FT 2.86 (AC) 32%  
 PERVIOUS AREA: 230,965 SQ FT 5.34 (AC) 60%  
 GREEN OPEN SPACE: 220,618 SQ FT 5.10 (AC) 57%  
 GRAVEL ROAD: 10,348 SQ FT 0.24 (AC) 3%  
 TOTAL AREA: 387,860 SQ FT 8.9 (AC) 100%

**ZONING**  
 EXISTING: A-1 (AGRICULTURAL-1)  
 PROPOSED: A-1 (AGRICULTURAL-1)  
 ADJACENT PROPERTIES:  
 NORTH IG (GENERAL INDUSTRIAL DISTRICT)  
 SOUTH A-1 (AGRICULTURAL-1)  
 EAST A-1 (AGRICULTURAL-1)  
 WEST A-2 (AGRICULTURAL-2)  
**FUTURE LAND USE**  
 EXISTING: PUB (PUBLIC FACILITIES)  
 PROPOSED: PUB (PUBLIC FACILITIES)  
 ADJACENT PROPERTIES:  
 NORTH C/1 (COMMERCIAL/INDUSTRIAL)  
 SOUTH PUB (PUBLIC FACILITIES)  
 EAST AG-1 (AGRICULTURAL-1 (1 UNIT/5 ACRES))  
 WEST AG-2 (AGRICULTURAL-2 (1 UNIT/10 ACRES))

**PERIMETER SETBACK**

|              | REQUIRED | PROPOSED   |
|--------------|----------|------------|
| NORTH (SIDE) | 30 FT    | 352 FT     |
| EAST (FRONT) | 30 FT    | 467.5 FT   |
| SOUTH (SIDE) | 30 FT    | 2,085.5 FT |
| WEST (REAR)  | 30 FT    | 4,029 FT   |

**PARKING SPACE SUMMARY**

|            | REQUIRED | PROPOSED |
|------------|----------|----------|
| STANDARD   | N/A      | 10       |
| ACCESSIBLE | N/A      | 1        |
| TOTAL      | N/A      | 11       |

- PARKING SPACE NOTES**
- ALL PARKING SPACES WITH THE EXCEPTION OF HANDICAPPED PARKING SPACES SHALL BE STRIPED IN WHITE RETRO-REFLECTIVE PAINT AND BE IN ACCORDANCE WITH THE FLORIDA DEPARTMENT OF TRANSPORTATION (FDOT) STANDARD SPECIFICATIONS FOR ROAD & BRIDGE CONSTRUCTION, 2016, SECTION 710.
  - ALL HANDICAPPED PARKING SPACES SHALL BE PROPERLY SIGNED AND STRIPED IN ACCORDANCE WITH THE FDOT STANDARD INDEX 17346, 2016 EDITION.
  - ALL COMPACT SPACES SHALL BE MARKED "COMPACT" ON THE STALL OR TIRE STOP.
- PAVEMENT MARKINGS NOTES**
- SIGNS AND PAVEMENT MARKINGS ARE TO CONFORM TO THE MANUAL OF UNIFORM TRAFFIC CONTROL DEVICES AND THE INDIAN RIVER COUNTY TYPICAL DRAWINGS FOR ROADWAY SIGNING, STRIPING & GEOMETRICS.
  - FIRE LANES SHALL BE MARKED WITH FREE STANDING SIGNS, MARKED CURBS, OR SIDEWALKS HAVING THE WORDS "FIRE LANE - NO PARKING" PAINTED WITH A CONTRASTING COLOR AT A SIZE AND SPACING APPROVED BY THE FIRE DIVISION.
  - HANDICAP STALL PARKING SHALL MEET THE REQUIREMENTS OF FDOT STANDARD DESIGN INDEX 17346 "SPECIAL MARKING AREAS", LATEST EDITION.
  - ALL PARKING STALL WIDTHS SHALL BE DIMENSIONED FROM CENTERLINE TO CENTERLINE OF THE WHITE STRIPES.
  - MINIMUM SPACE BETWEEN STOP BAR AND CROSSWALKS SHALL BE 4'.
  - ALL PARKING SPACES WITH EXCEPTION OF THE HANDICAPPED PARKING SPACES SHALL BE STRIPED IN WHITE, RETRO-REFLECTIVE TRAFFIC PAINT AND BE IN ACCORDANCE WITH THE FLORIDA DEPARTMENT OF TRANSPORTATION (FDOT) STANDARD SPECIFICATIONS FOR ROAD & BRIDGE CONSTRUCTION, LATEST EDITION, SECTION 710.

**STORMWATER DETENTION**  
 DRY DETENTION AREA: 203,32 SQ FT (0.47 AC)

**JURISDICTIONAL AGENCY PERMITS**

INDIAN RIVER COUNTY

- TYPE "B" STORMWATER PERMIT
- TREE REMOVAL PERMIT
- UTILITY CONSTRUCTION PERMIT(UCP)
- IRC LAND CLEARING
- IRC MAJOR SITE PLAN
- WATER
- WASTEWATER

FLORIDA DEP

**NET NEW TRIP GENERATION SUMMARY**

| DEVELOPMENT SCENARIO   | AVERAGE WEEKDAY DAILY GENERATION |
|------------------------|----------------------------------|
| EXISTING DEVELOPMENT   | 56 VEHICLES TRIPS                |
| PROPOSED REDEVELOPMENT | 133 VEHICLE TRIPS                |
| NET NEW REDEVELOPMENT  | 77 VEHICLE TRIPS                 |

**CONSTRUCTION TIMETABLE**

|                           |                |
|---------------------------|----------------|
| CONSTRUCTION COMMENCEMENT | SEPTEMBER 2021 |
| CONSTRUCTION COMPLETION   | MARCH 2022     |

OWNER CHANGES

| No. | REVISIONS | DATE | BY |
|-----|-----------|------|----|
|     |           |      |    |

**Kimley & Horn**  
 LICENSED PROFESSIONAL ENGINEER  
 © 2021 KIMLEY-HORN AND ASSOCIATES, INC.  
 355 ALHAMBRA CIRCLE, SUITE 1400, CORAL GABLES, FL 33134  
 PHONE: 305-673-2025  
 WWW.KIMLEY-HORN.COM REGISTRY: 696

KHA PROJECT 14-3228000  
 DATE JULY 2021  
 SCALE AS SHOWN  
 DESIGNED BY MRG  
 DRAWN BY RMR  
 CHECKED BY BF

**SITE PLAN I**

IRC LANDFILL  
 PREPARED FOR  
 INDIAN RIVER COUNTY  
 INDIAN RIVER COUNTY  
 SHEET NUMBER  
**C-410**

**Sunshine811**  
 Call 811 or www.sunshine811.com two full business days before digging to have utilities located and marked.  
 Check positive response codes before you dig!



SEE SHEET C-410 FOR CONTINUATION



**LEGEND**

- RAW — RIGHT-OF-WAY LINE / PROPERTY LINE
- ▨ PROP. BUILDING
- ▨ PROP. GRAVEL ROAD
- ▨ PROP. HEAVY DUTY ASPHALT
- ▨ PROP. STANDARD DUTY ASPHALT
- ▨ PROP. LANDSCAPE AREA
- ▨ PROP. STANDARD DUTY CONC.
- ▨ PROP. HEAVY DUTY CONC.
- ▨ PROP. CONC. SIDEWALK
- ▨ EXIST. GRAVEL ROAD

GRAPHIC SCALE IN FEET: 0, 20, 40, 80

NORTH








Plotted By: Rodriguez, Rebecca - Sheet Set: IRC LANDFILL - Layout: C-411 - SITE PLAN - November 17, 2021 - 10:40:13am - K:\vmb-civil\43228000 - irc hwh and recycling facility\CADD\plansheets\C-410 Site Plan.dwg  
 This document, together with the concepts and designs presented herein, is intended only for the specific purpose and client for which it was prepared. Reuse of and improper reliance on this document without written authorization and adaptation by Kimley-Horn and Associates, Inc. shall be without liability to Kimley-Horn and Associates, Inc.

This item has been digitally signed and sealed by Barton J. Fye, P.E. on the date adjacent to the seal.  
 Printed copies of this document are not considered signed and sealed and the signature must be verified on any electronic copies.  
 Date: 11/17/2021

**Sunshine811**  
 Call 811 or www.sunshine811.com two full business days before digging to have utilities located and marked.  
 Check positive response codes before you dig!

|   |  |   |                              |     |           |
|---|--|---|------------------------------|-----|-----------|
| KHA PROJECT<br>14-3228000<br>DATE<br>JULY 2021<br>SCALE AS SHOWN<br>DESIGNED BY MRG<br>DRAWN BY RMR<br>CHECKED BY _____ DATE: _____ | LICENSED PROFESSIONAL<br>_____<br>_____<br>_____ | <b>Kimley &amp; Horn</b><br>© 2021 KIMLEY-HORN AND ASSOCIATES, INC.<br>355 ALHAMBRA CIRCLE, SUITE 1400, CORAL GABLES, FL 33154<br>PHONE: 305-673-2025<br>WWW.KIMLEY-HORN.COM REGISTRY 696 | 11/16/2021                   | JF  |           |
|   |  |   | OWNER CHANGES                | NO. | REVISIONS |
| <b>SITE PLAN II</b>   |  | IRC LANDFILL<br>PREPARED FOR<br>INDIAN RIVER COUNTY<br>INDIAN RIVER COUNTY<br>FL  | SHEET NUMBER<br><b>C-411</b> |     |           |

Plotted By: Rodriguez, Rebecca - Sheet Set: IRC LANDFILL - Layout: C-412 SITE PLAN DETAILS - November 17, 2021 - 10:40:23am - k:\vmb-civil\143228000 - irc lhw and recycling facility\civil\CADD\plansheets\C-412 SITE PLAN DETAILS.dwg  
 This document, together with the concepts and designs presented herein, is intended only for the specific purpose and client for which it was prepared. Reuse of and improper reliance on this document without written authorization and adaptation by Kimley-Horn and Associates, Inc. shall be without liability to Kimley-Horn and Associates, Inc.

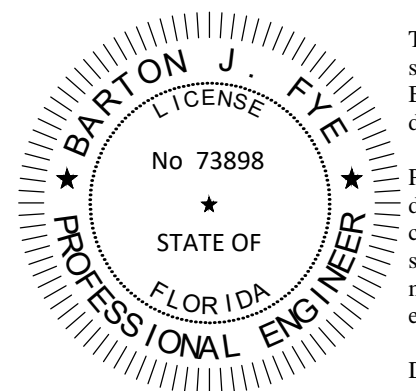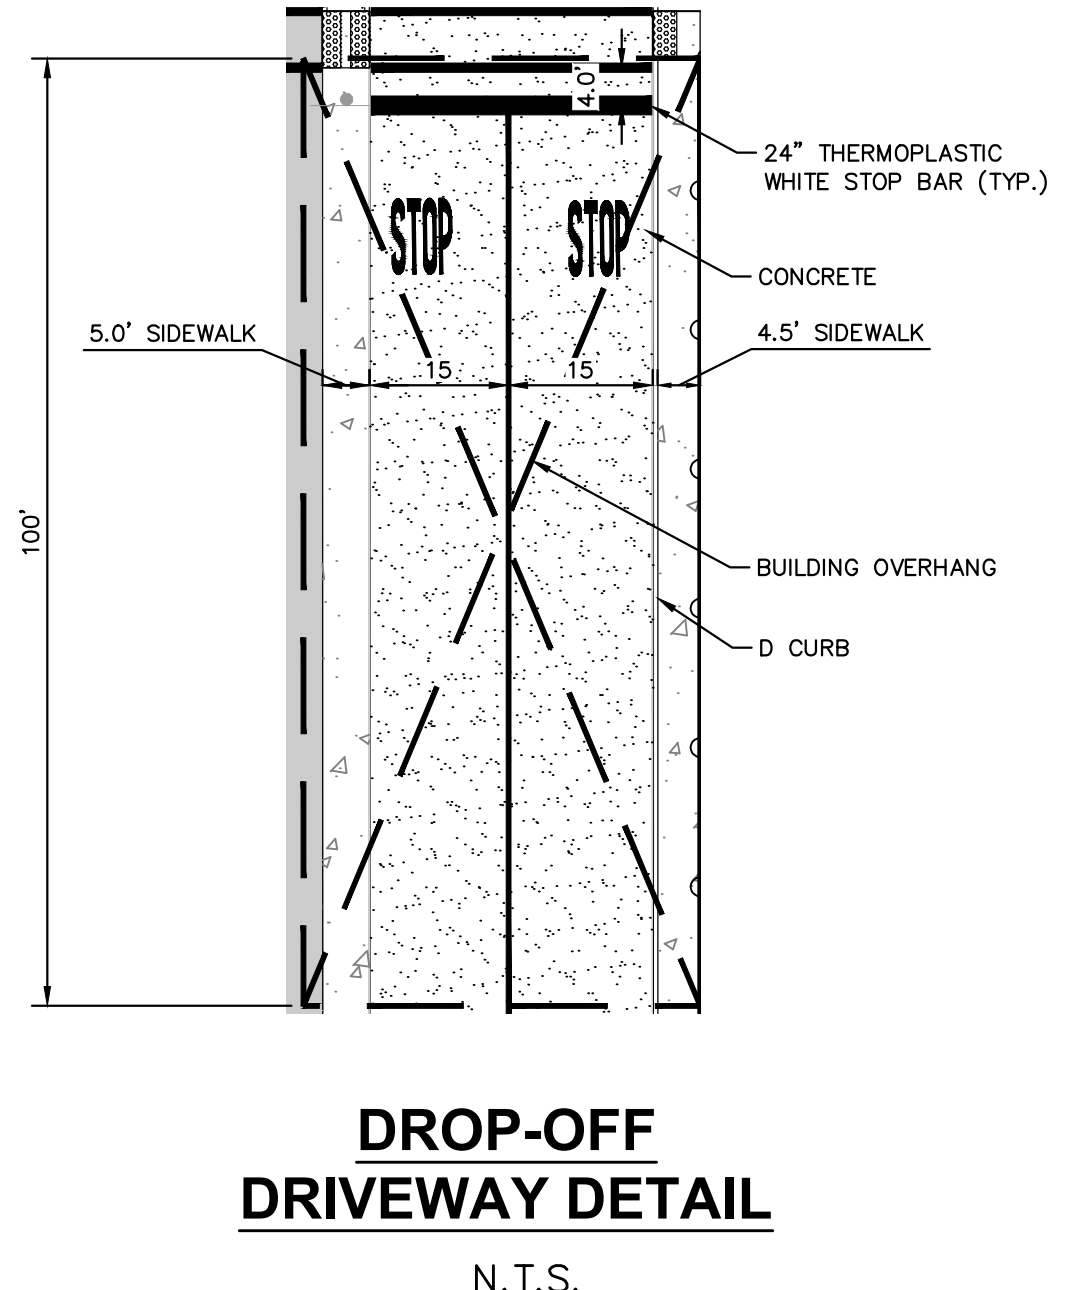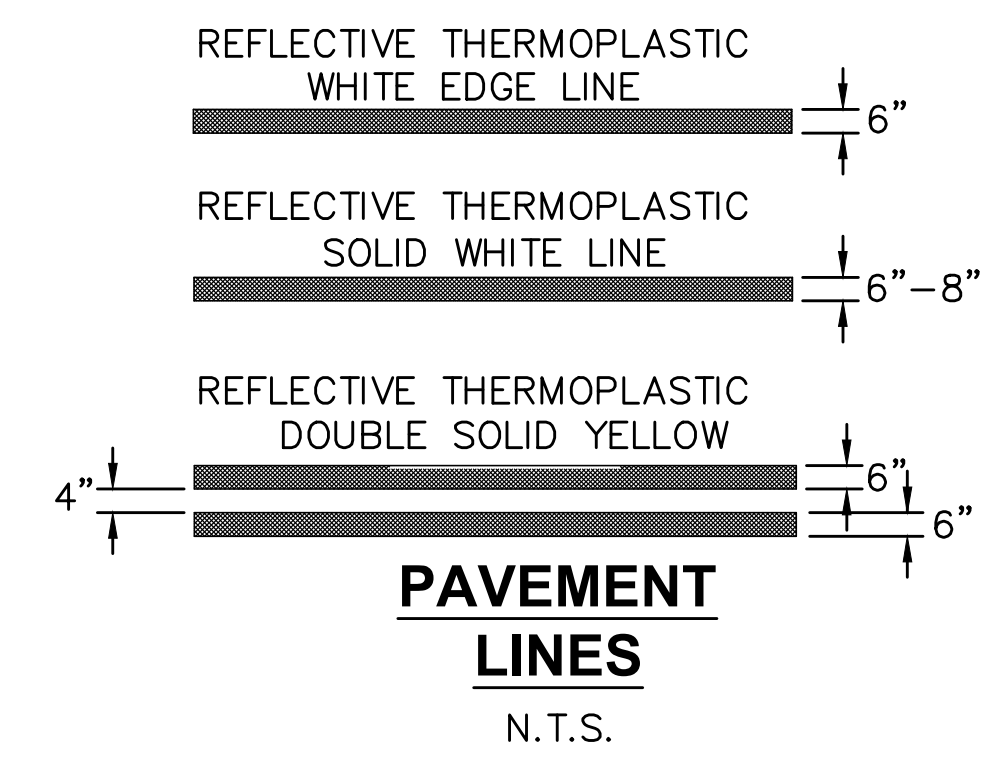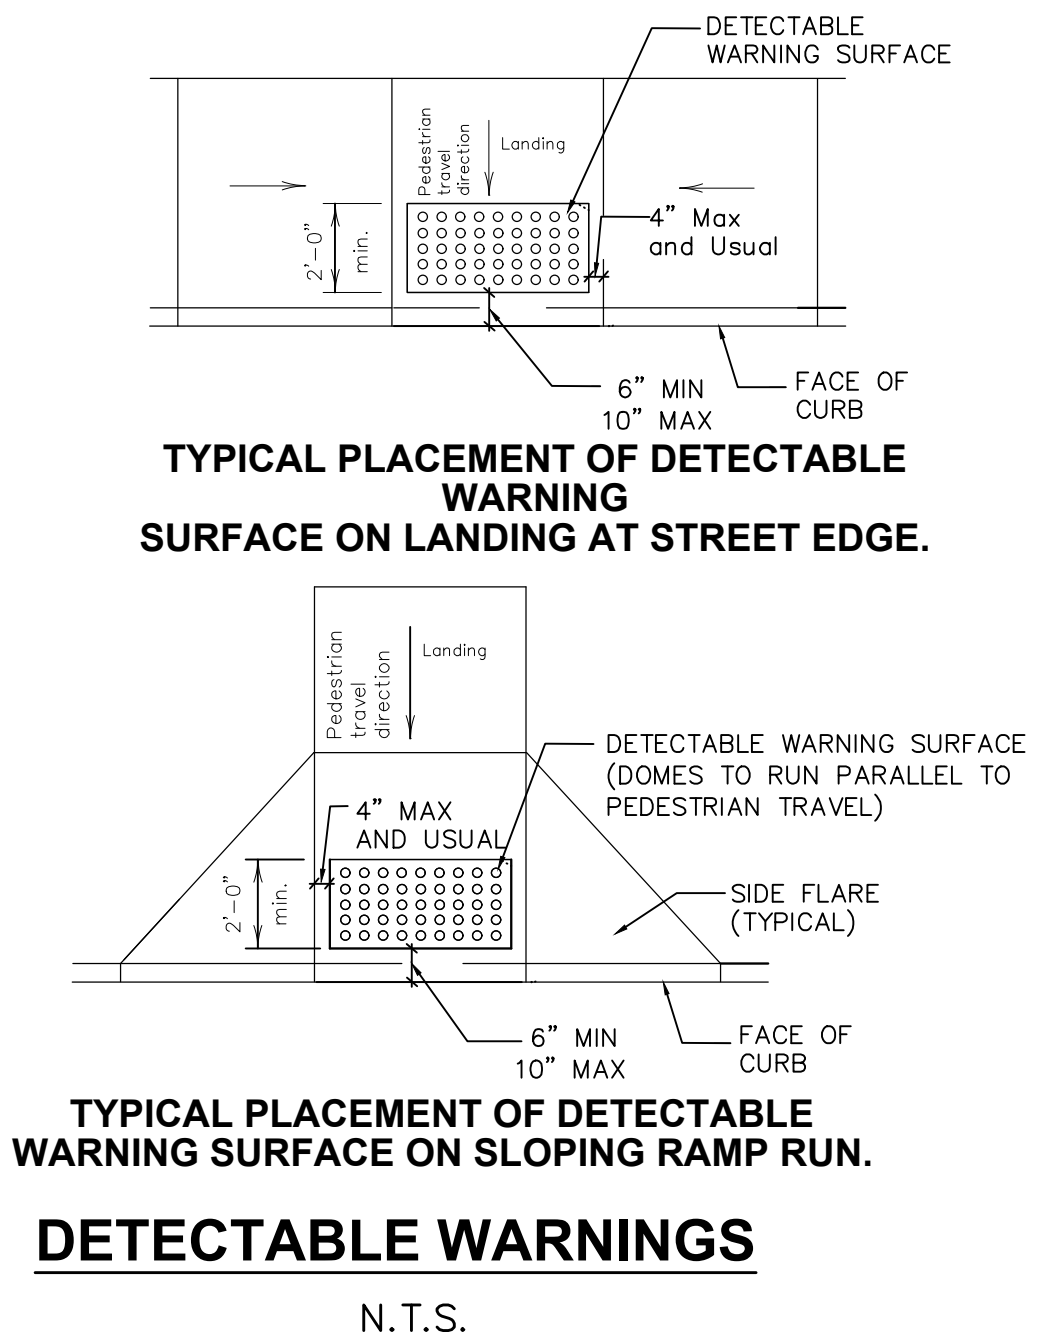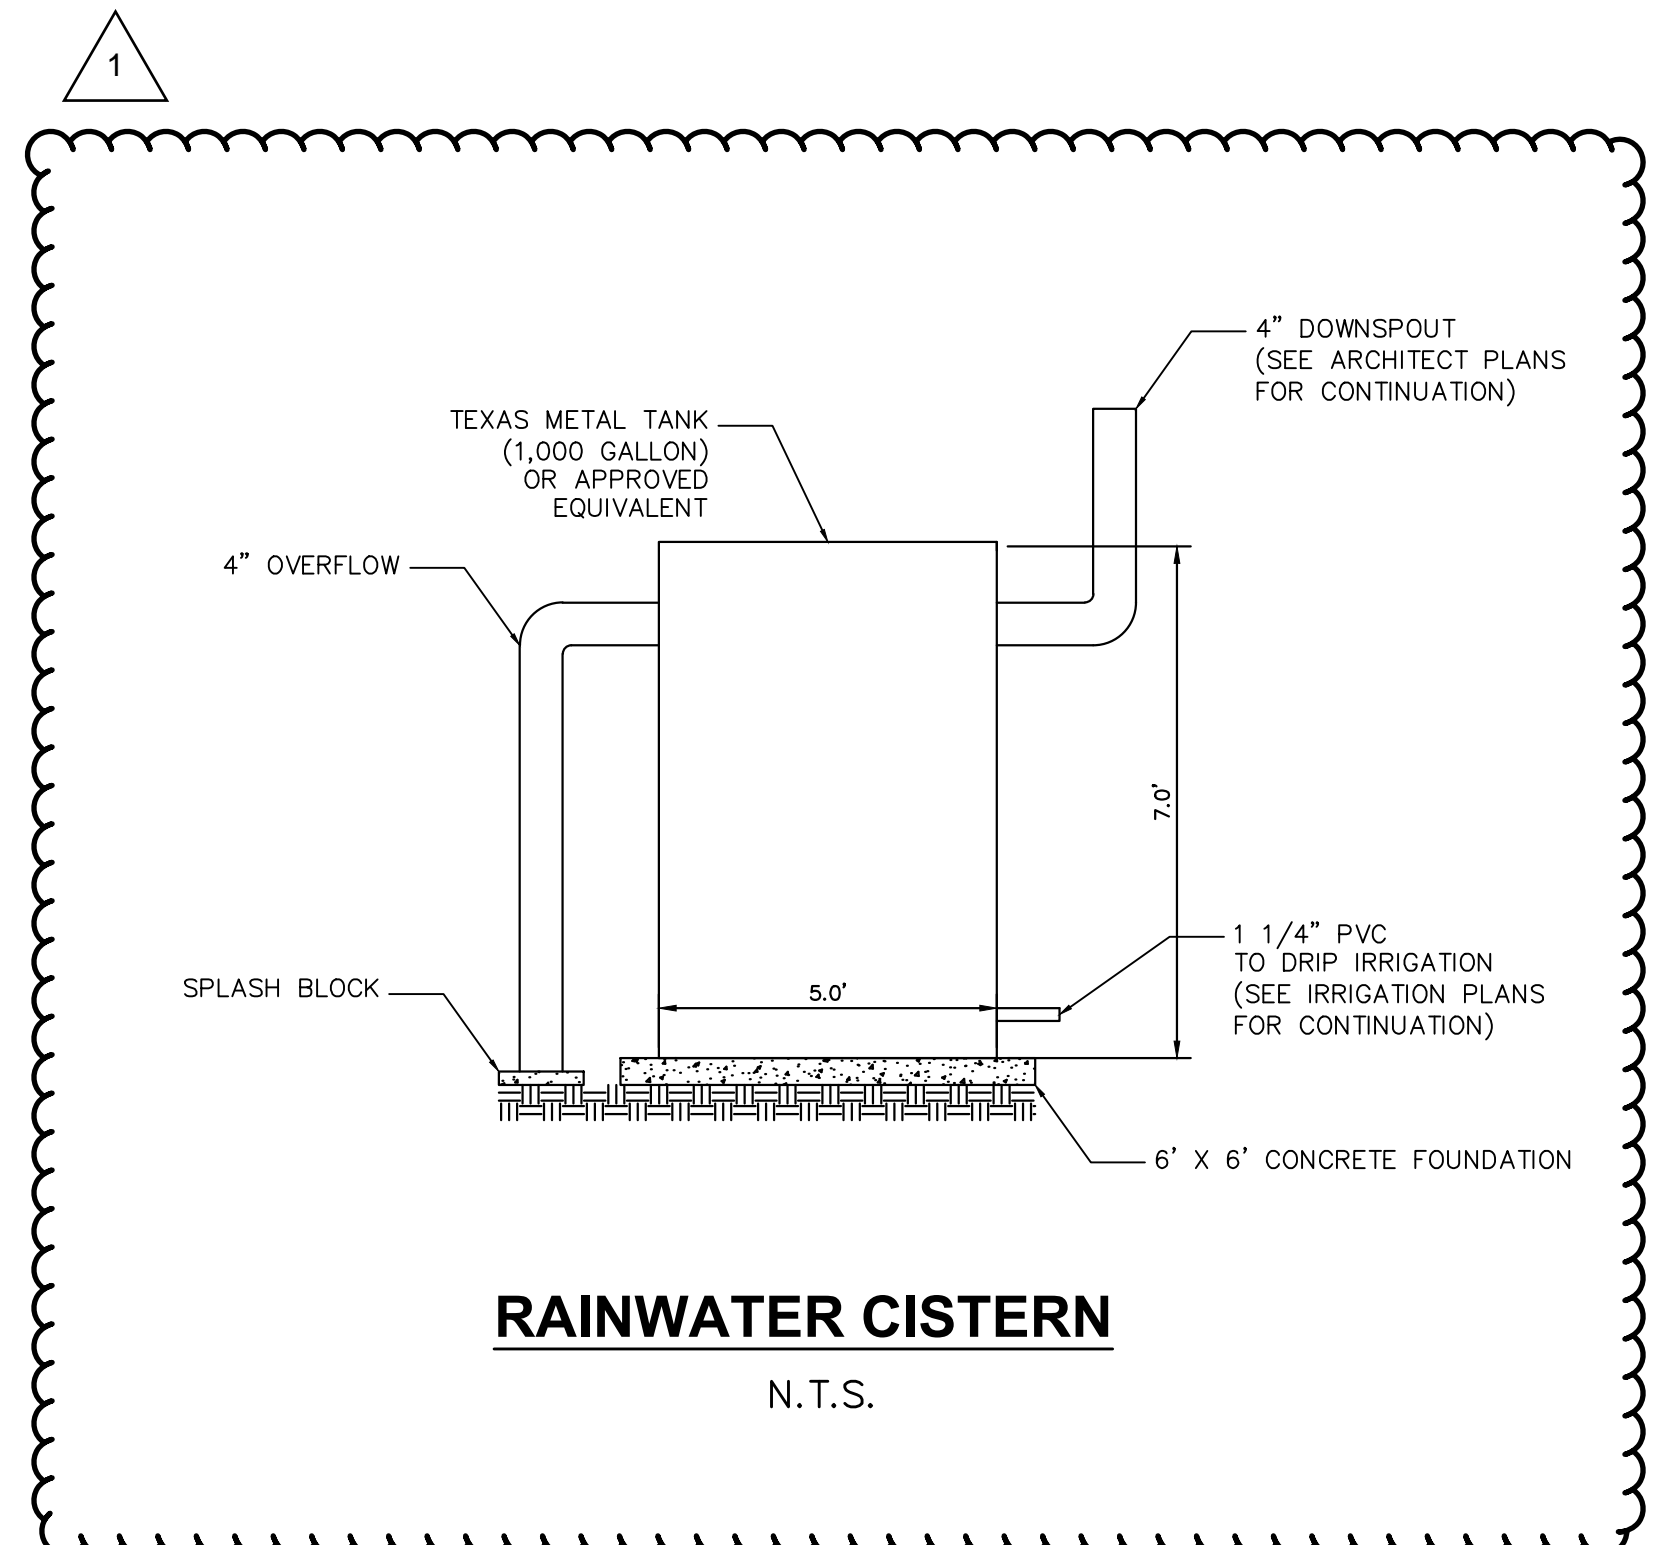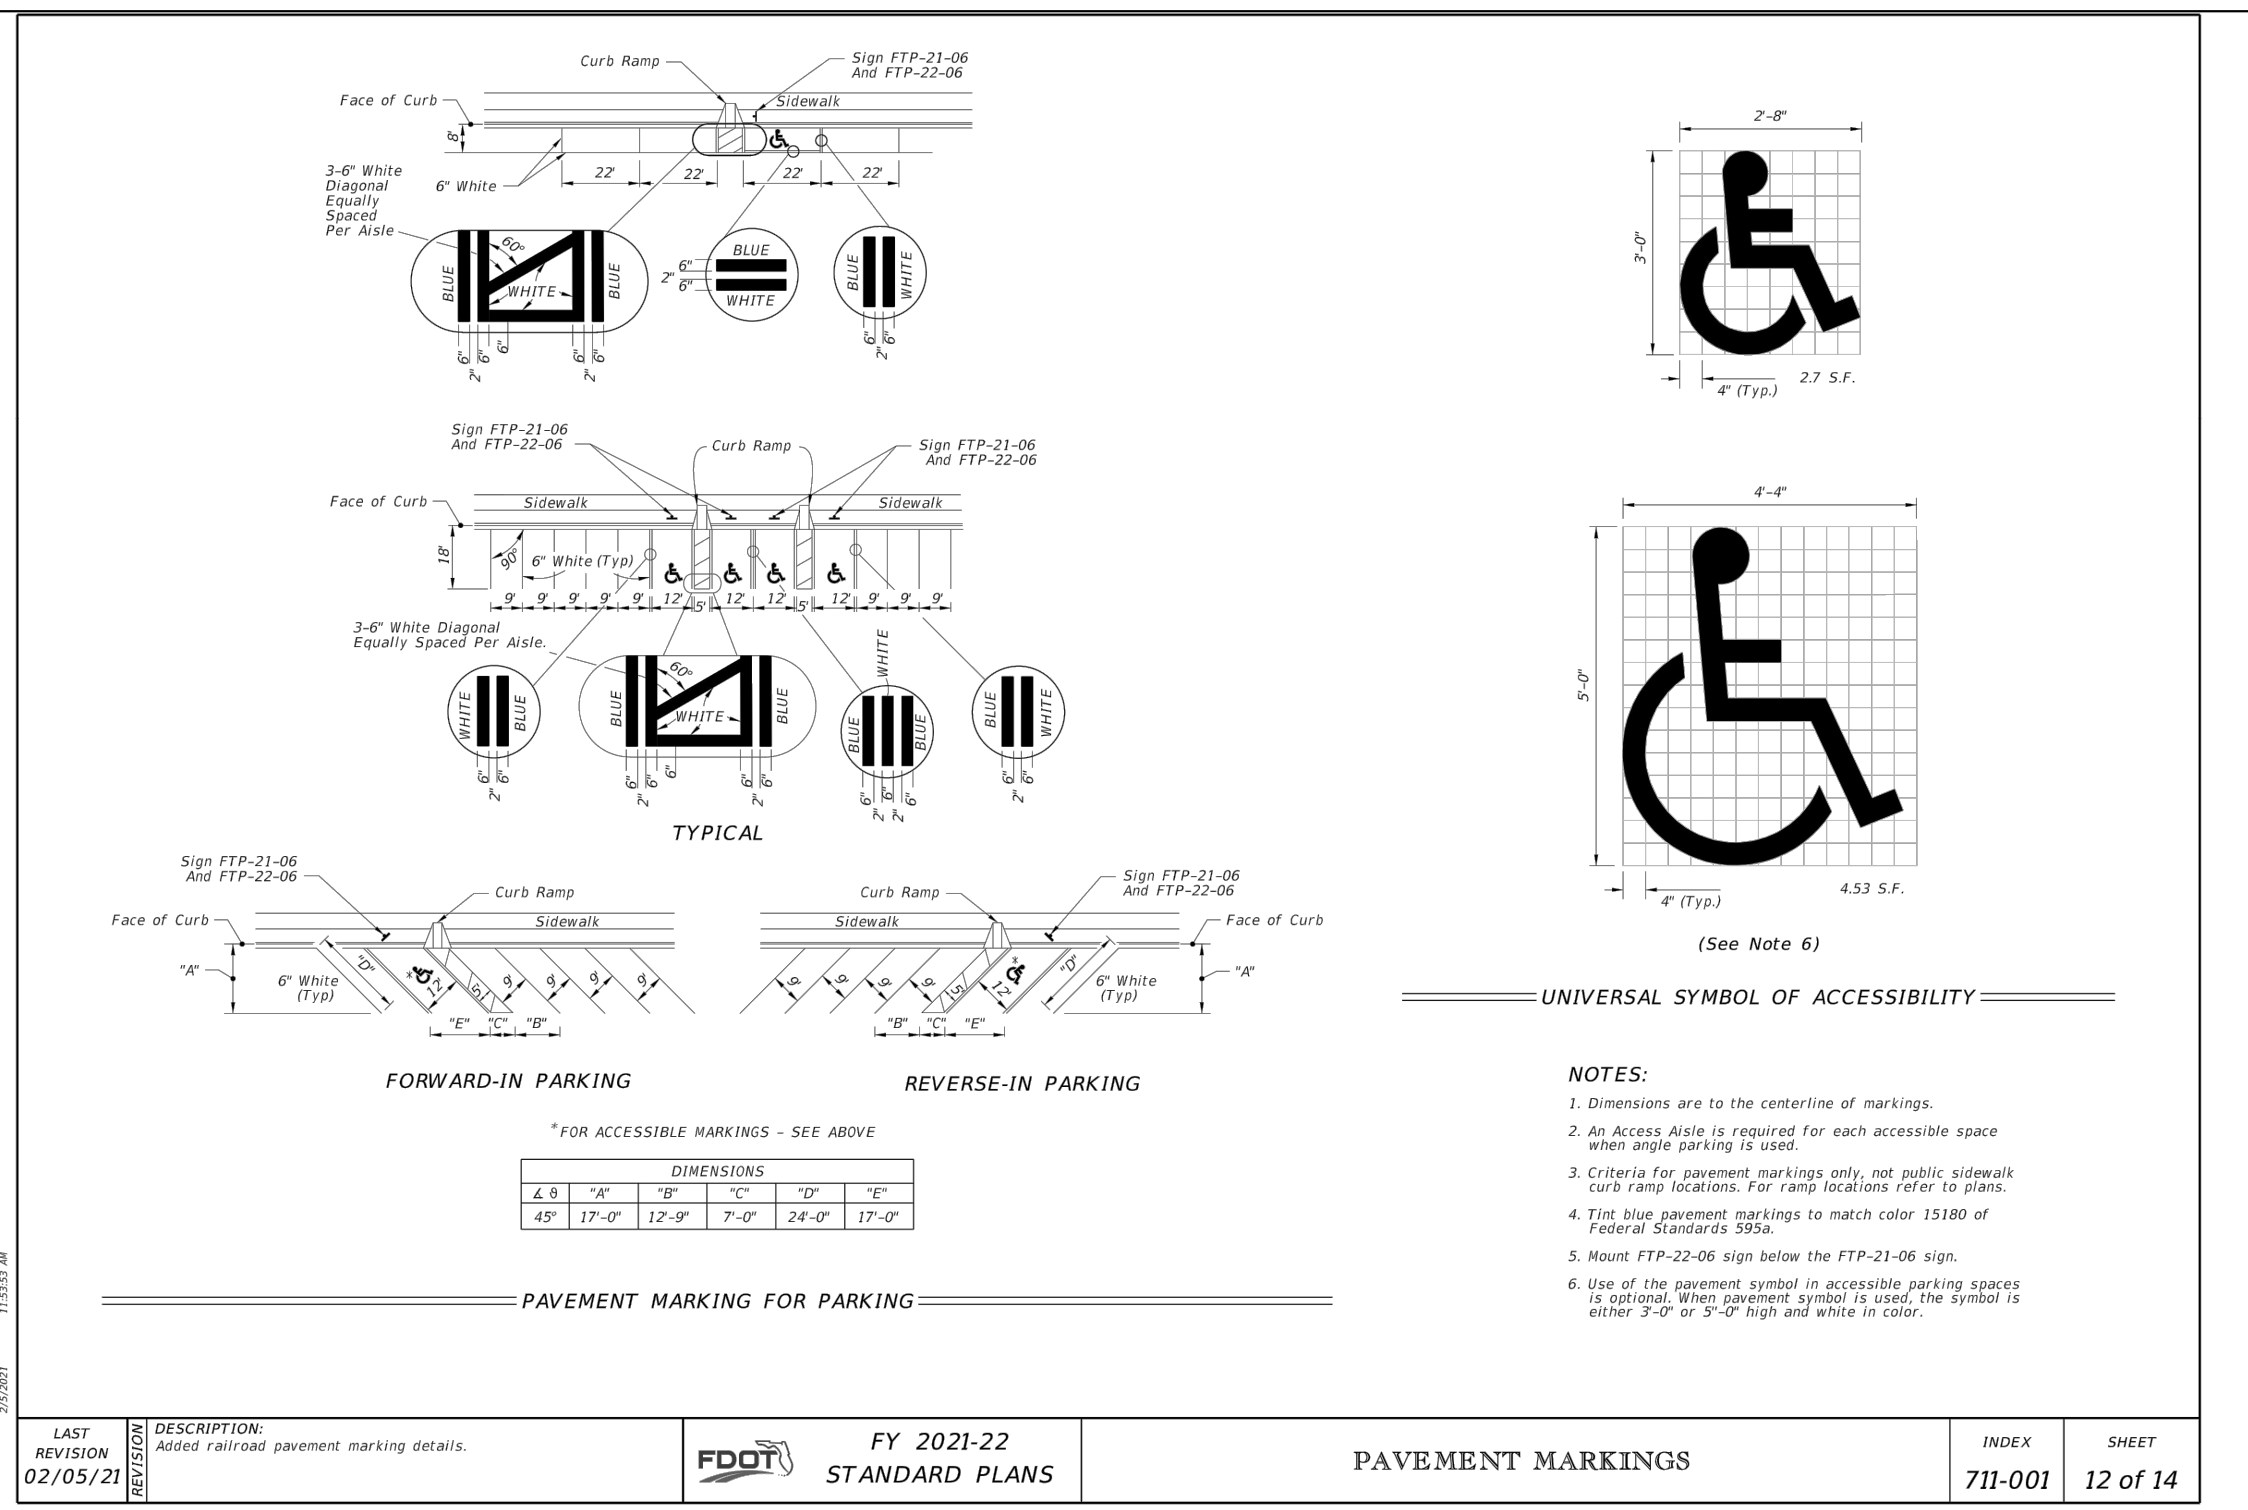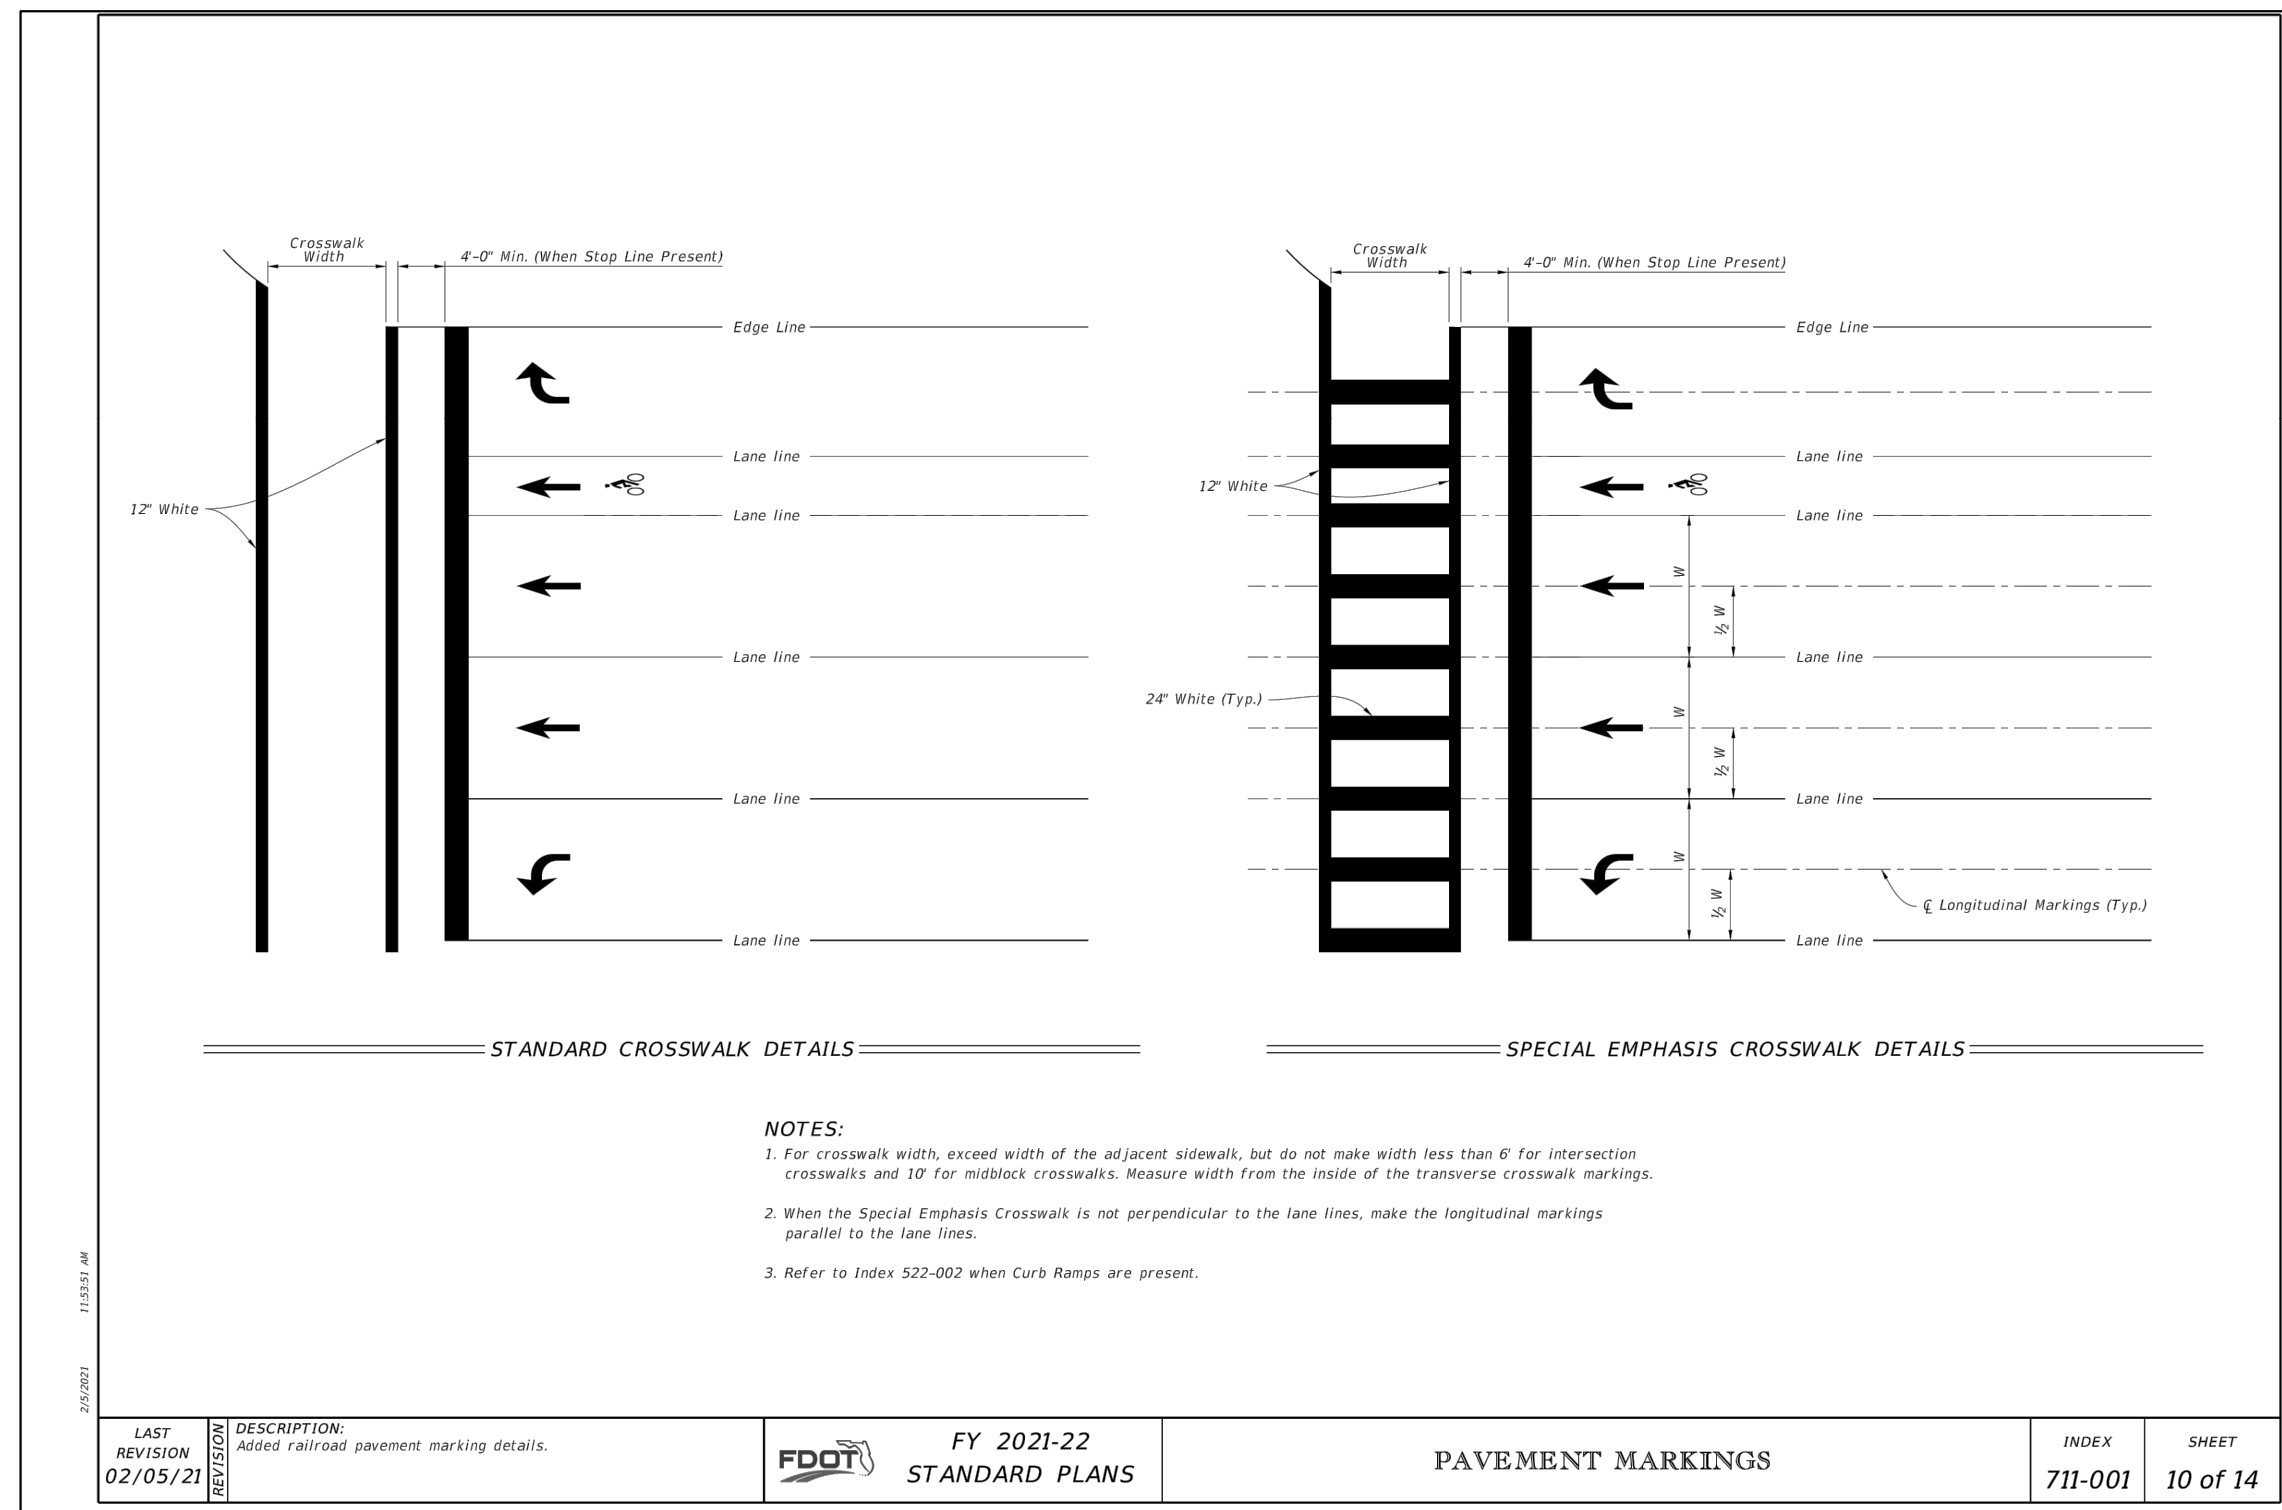

This item has been digitally signed and sealed by Barton J. Fye, P.E. on the date adjacent to the seal.

Printed copies of this document are not considered signed and sealed and the signature must be verified on any electronic copies.

Date: 11/17/2021

**Sunshine811**

Call 811 or www.sunshine811.com two full business days before digging to have utilities located and marked.

Check positive response codes before you dig!

**OWNER CHANGES**

| No. | REVISIONS | DATE |
|-----|-----------|------|
|     |           |      |

**Kimley-Horn**

© 2021 KIMLEY-HORN AND ASSOCIATES, INC.  
 355 ALHAMBRA CIRCLE, SUITE 1400, CORAL GABLES, FL 33134  
 PHONE: 305-673-2025  
 WWW.KIMLEY-HORN.COM REGISTRY 696

LICENSED PROFESSIONAL

KHA PROJECT 14-3228000

DATE JULY 2021

SCALE AS SHOWN

DESIGNED BY MRG

DRAWN BY RMR

CHECKED BY BF

DATE:





**SITE PLAN DETAILS**

IRC LANDFILL PREPARED FOR INDIAN RIVER COUNTY

INDIAN RIVER COUNTY

SHEET NUMBER **C-412**

Plotted By: Rodriguez, Rebecca - Sheet Set: IRC LANDFILL - Layout: C-420 MANEUVERABILITY - November 17, 2021 - 10:40:44am - k:\vmb-civil\143228000 - frc-hhw-and-recycling-facility\CIVIL\CADD\plansheets\C-420 MANEUVERABILITY.dwg  
 This document, together with the concepts and designs presented herein, is intended only for the specific purpose and client for which it was prepared. Reuse of and improper reliance on this document without written authorization and adaptation by Kimley-Horn and Associates, Inc. shall be without liability to Kimley-Horn and Associates, Inc.

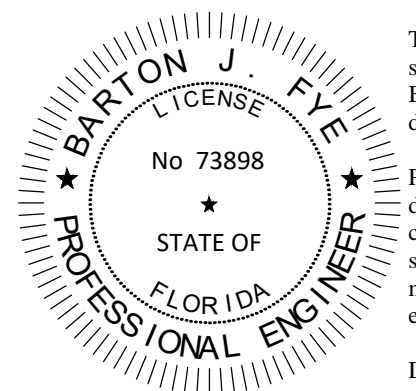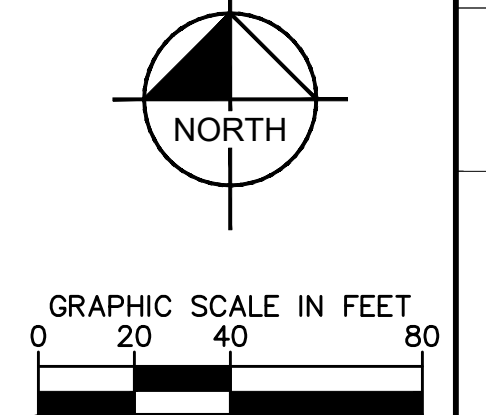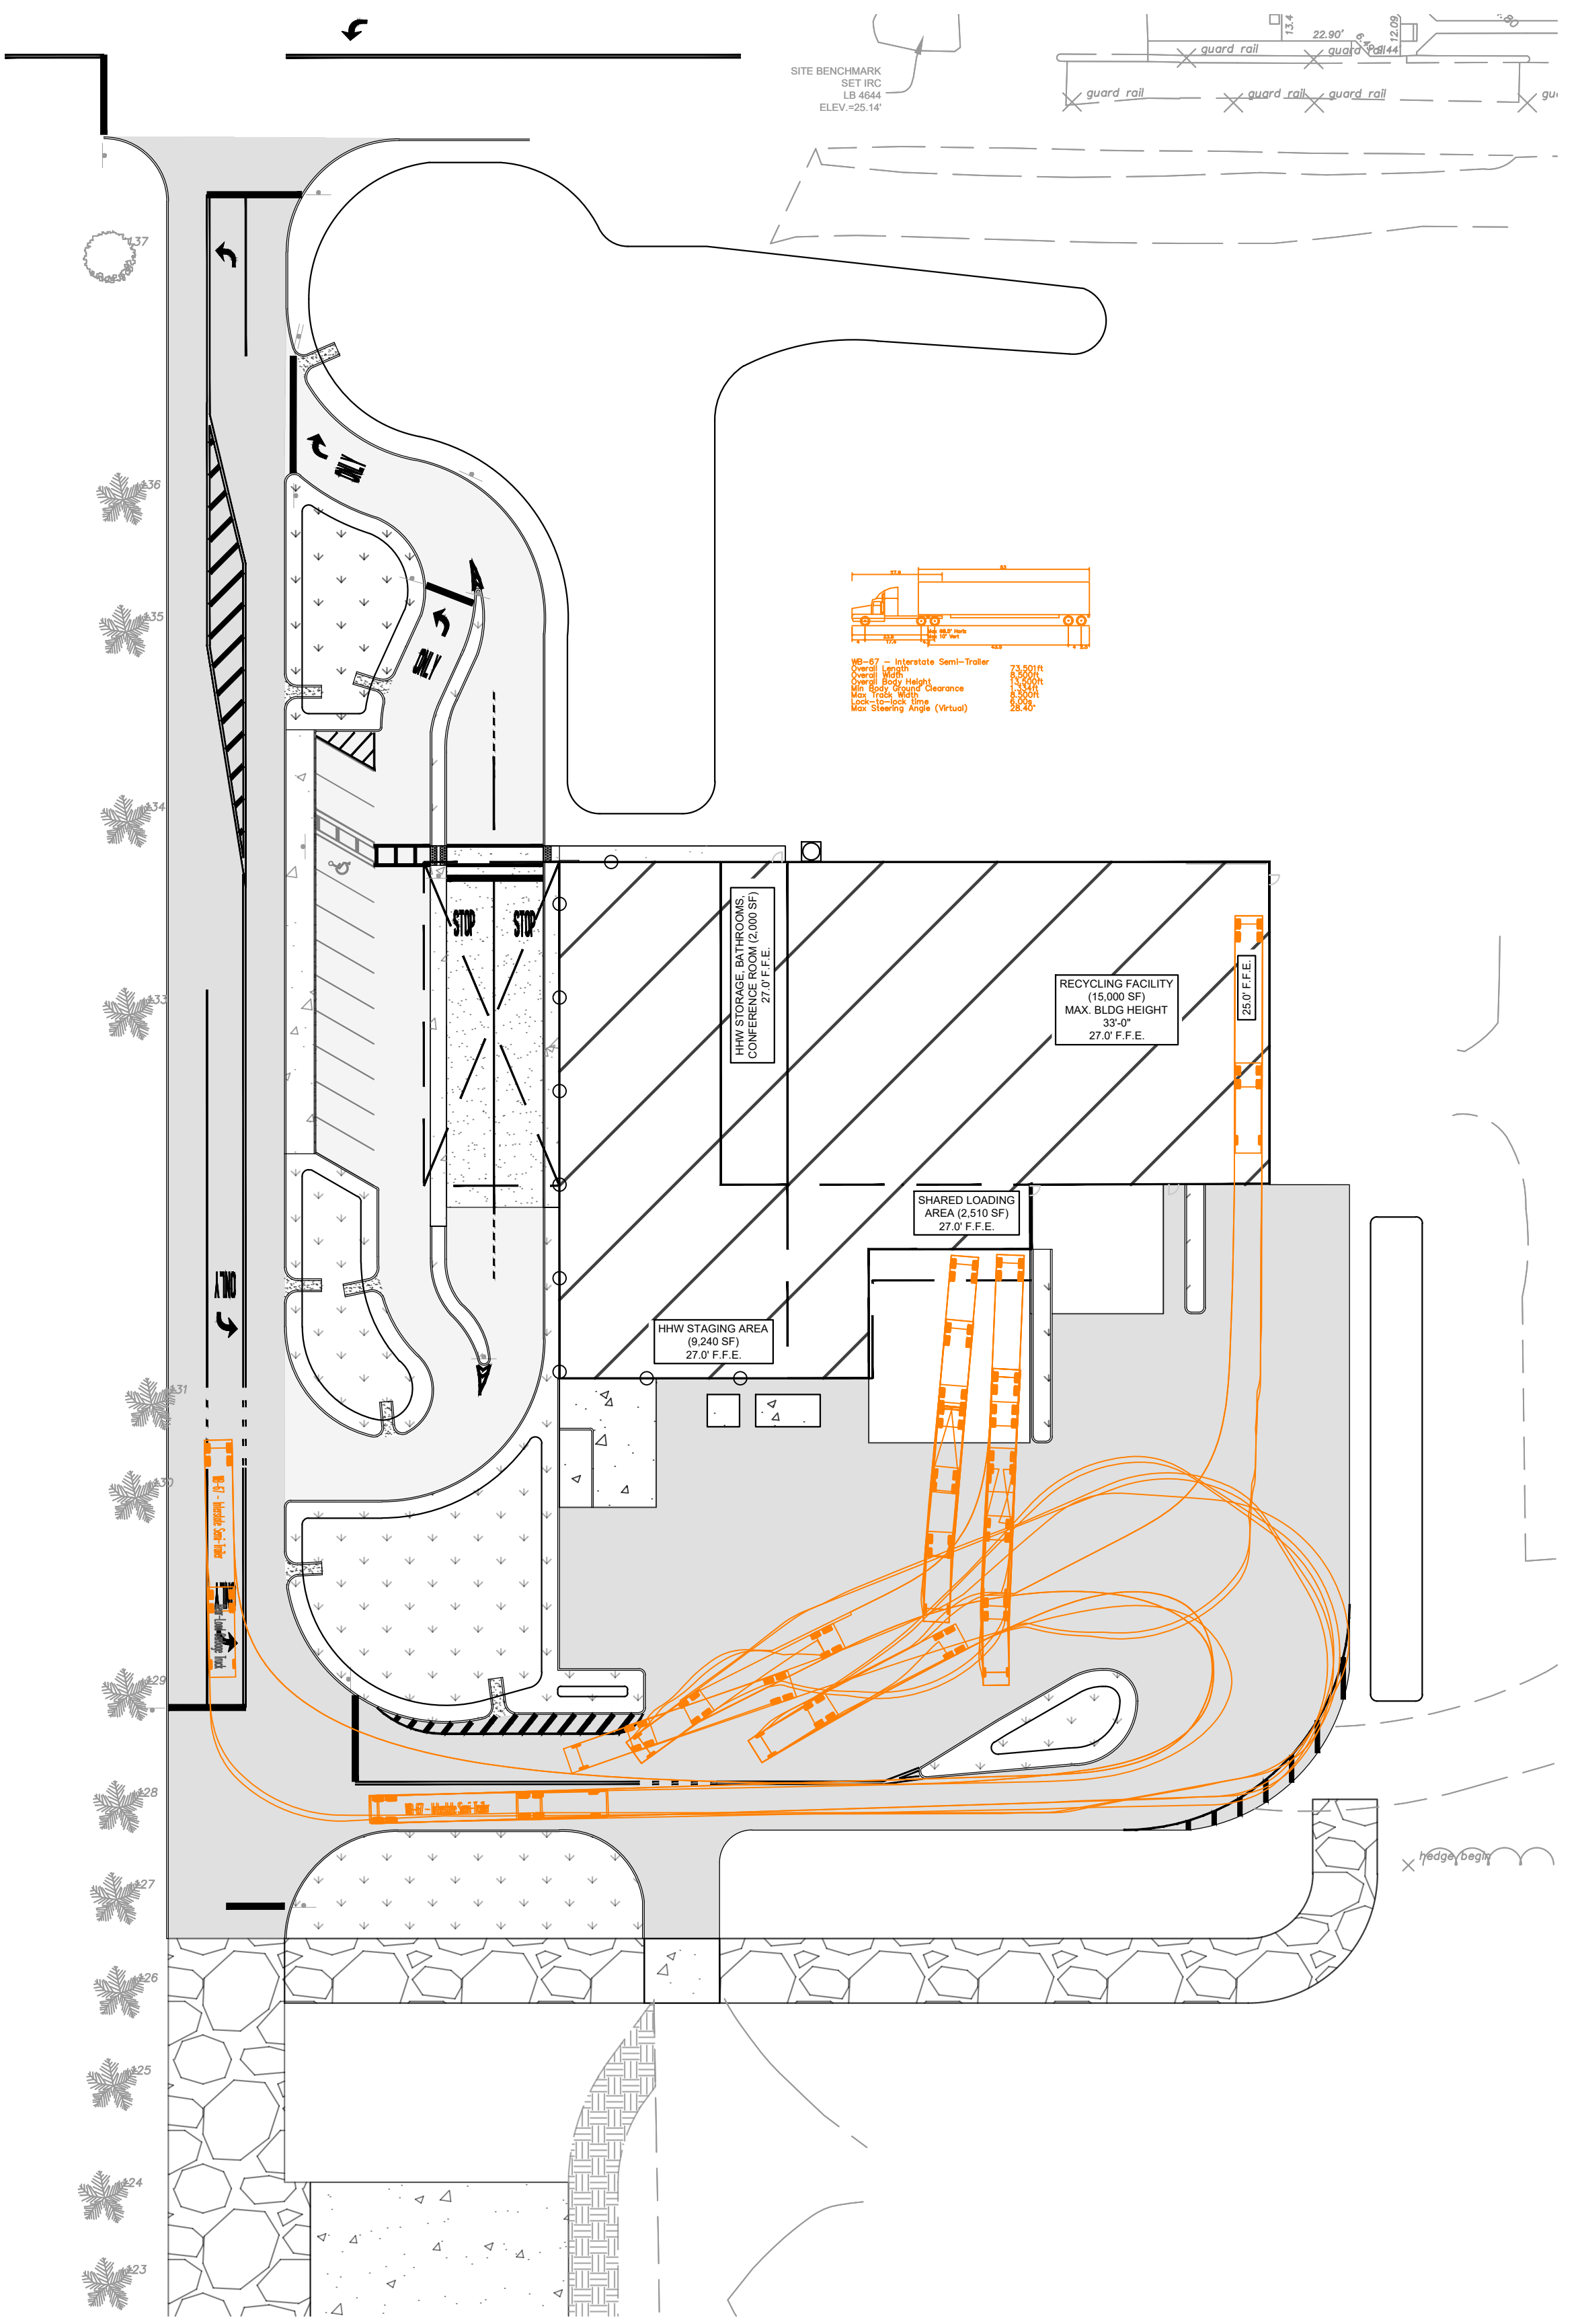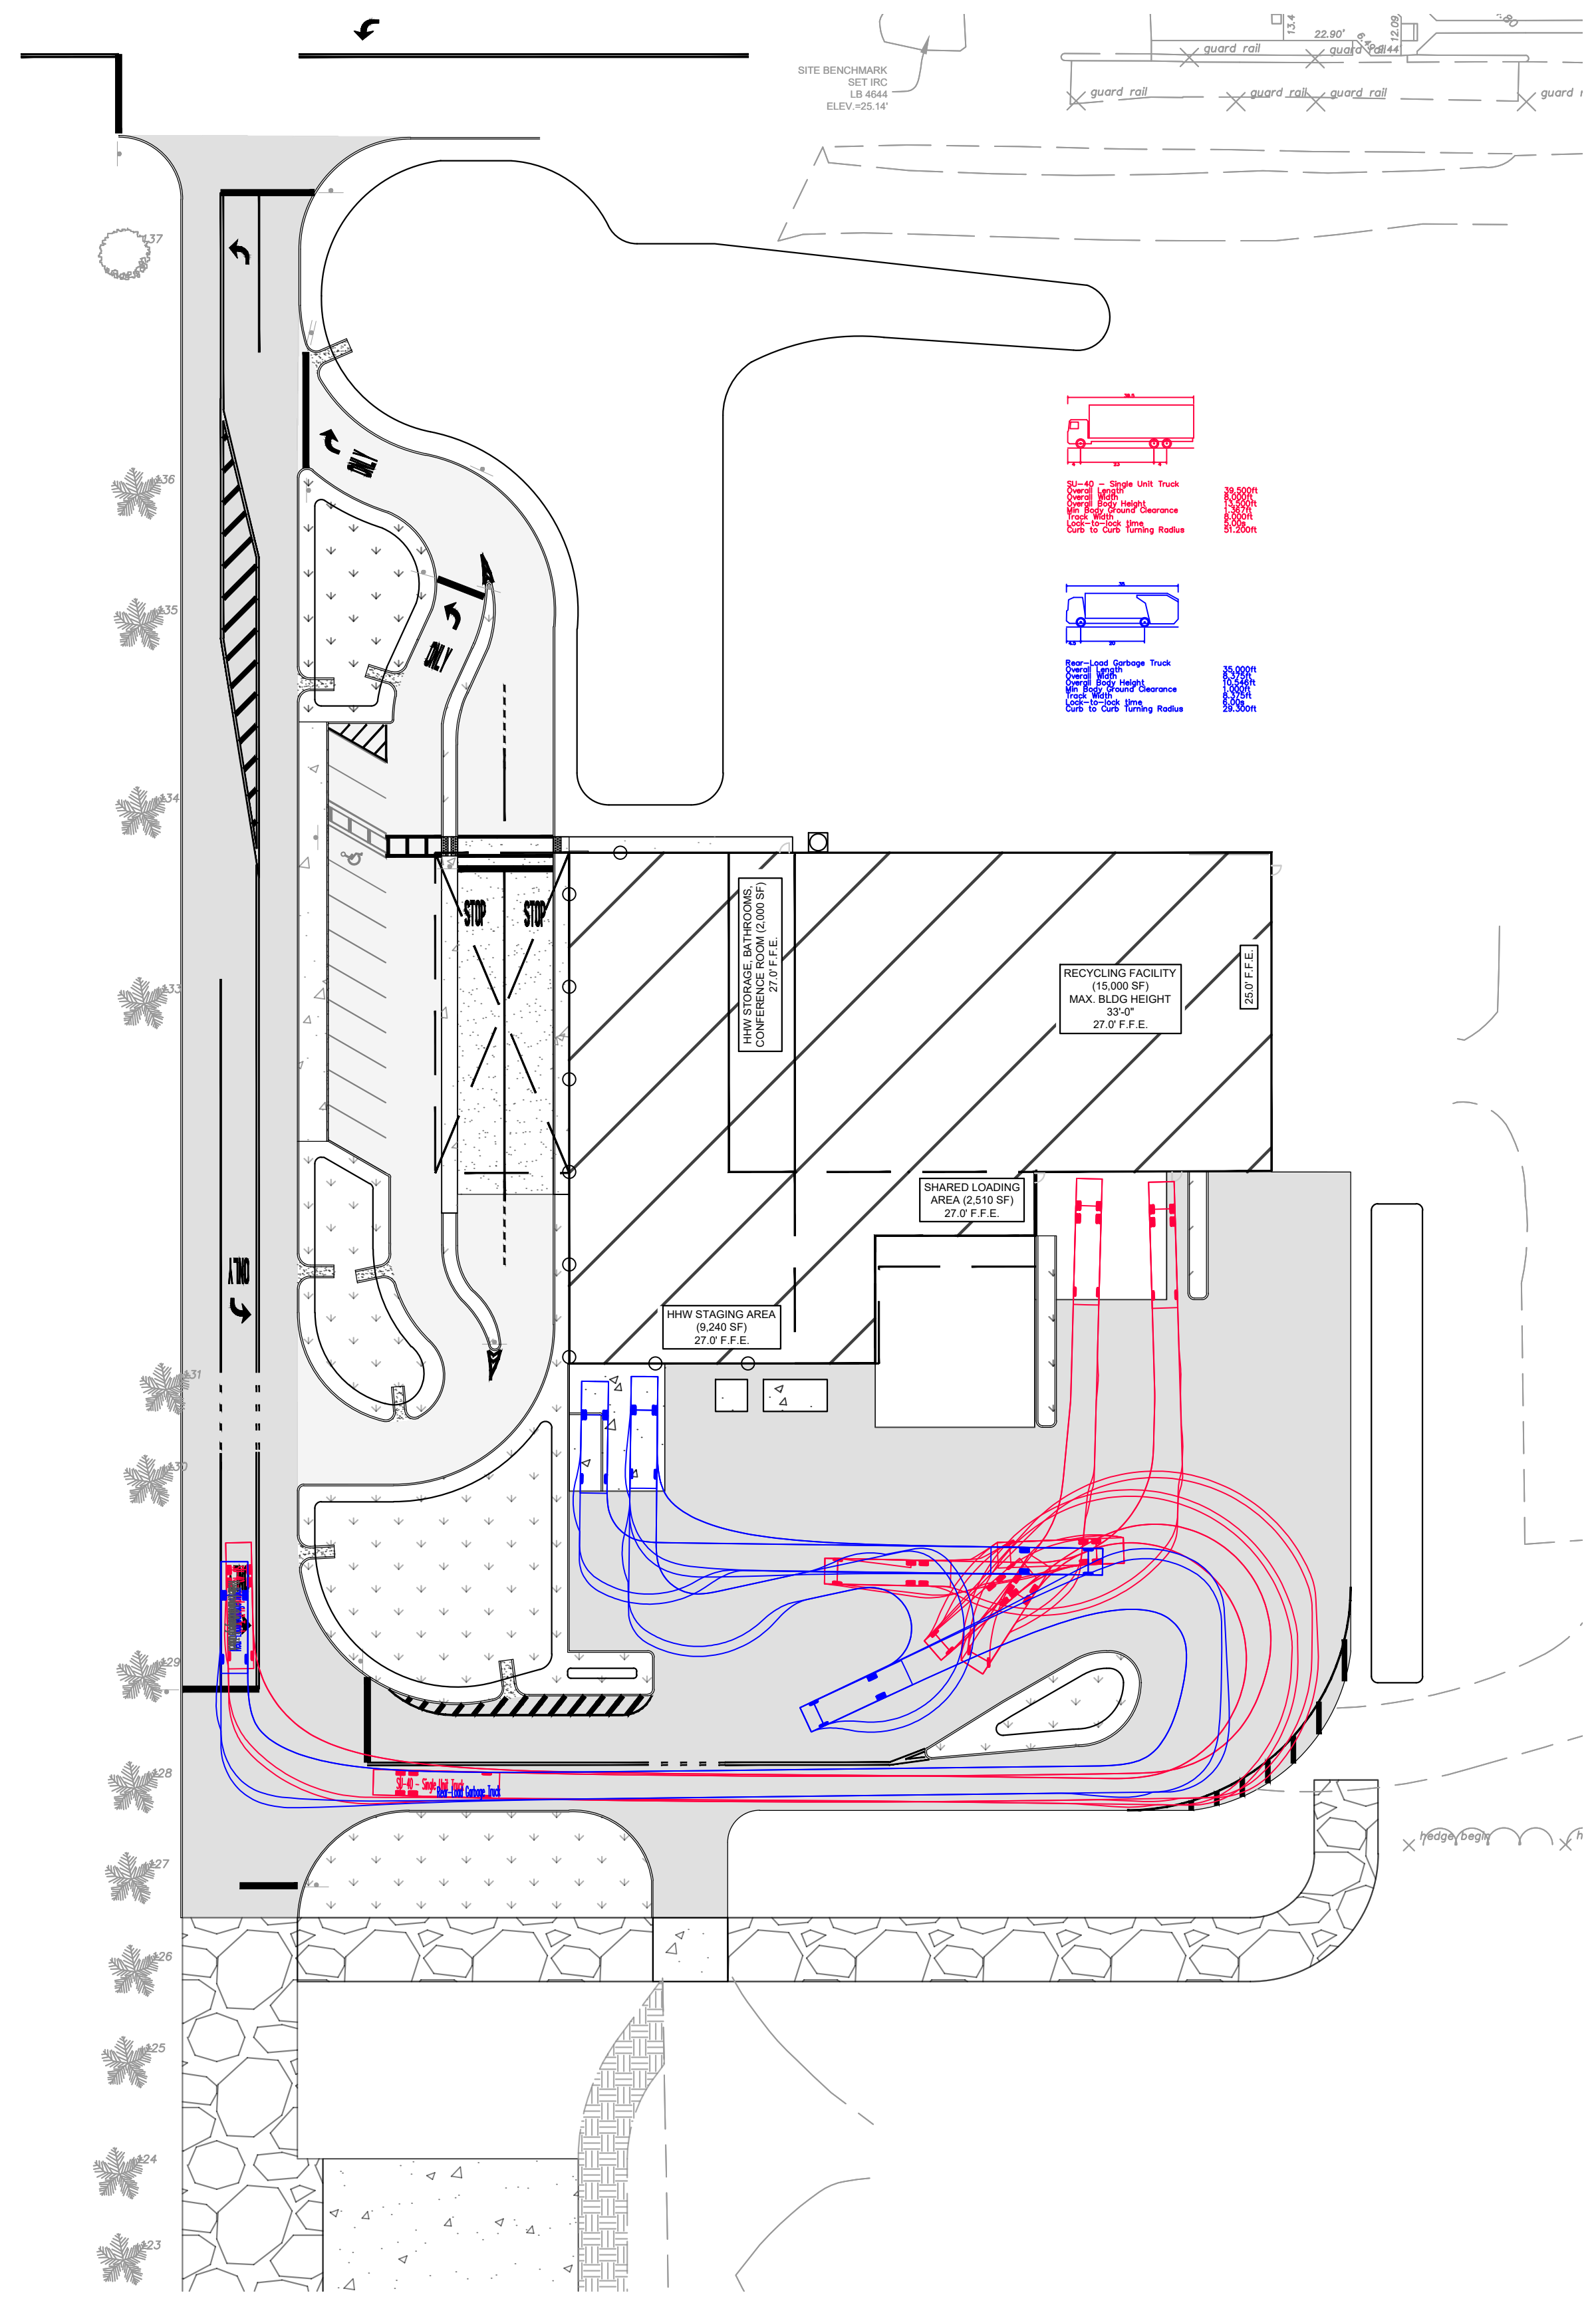

This item has been digitally signed and sealed by Barton J. Fye, P.E. on the date adjacent to the seal.  
 Printed copies of this document are not considered signed and sealed and the signature must be verified on any electronic copies.  
 Date: 11/17/2021

**Sunshine811**  
 Call 811 or www.sunshine811.com two full business days before digging to have utilities located and marked.  
 Check positive response codes before you dig!

| No. | REVISIONS | DATE | BY |
|-----|-----------|------|----|
|     |           |      |    |
|     |           |      |    |
|     |           |      |    |
|     |           |      |    |

**Kimley-Horn**  
 © 2021 KIMLEY-HORN AND ASSOCIATES, INC.  
 355 ALHAMBRA CIRCLE, SUITE 1400, CORAL GABLES, FL 33134  
 PHONE: 305-673-2025  
 WWW.KIMLEY-HORN.COM REGISTRY 696

LICENSED PROFESSIONAL


|             |            |
|-------------|------------|
| KHA PROJECT | 14-3228000 |
| DATE        | JULY 2021  |
| SCALE       | AS SHOWN   |
| DESIGNED BY | MRC        |
| DRAWN BY    | MRC        |
| CHECKED BY  | BF         |
| DATE:       |            |

**MANEUVERABILITY**

IRC LANDFILL  
 PREPARED FOR  
 INDIAN RIVER COUNTY  
 INDIAN RIVER COUNTY, FL

SHEET NUMBER  
**C-420**

Plotted By: Rodriguez, Rebecca - Sheet Set: IRC LANDFILL - Layout: C-450 - FIRE ACCESS PLAN - November 17, 2021 - 10:40:59am - k:\vmb-civil\143228000 - irc.lhw.and.recycling.facility\CIVIL\CADD\plansheets\C-450 - FIRE ACCESS PLAN.dwg  
This document, together with the concepts and designs presented herein, is intended only for the specific purpose and client for which it was prepared. Reuse of and improper reliance on this document without written authorization and adaptation by Kimley-Horn and Associates, Inc. shall be without liability to Kimley-Horn and Associates, Inc.

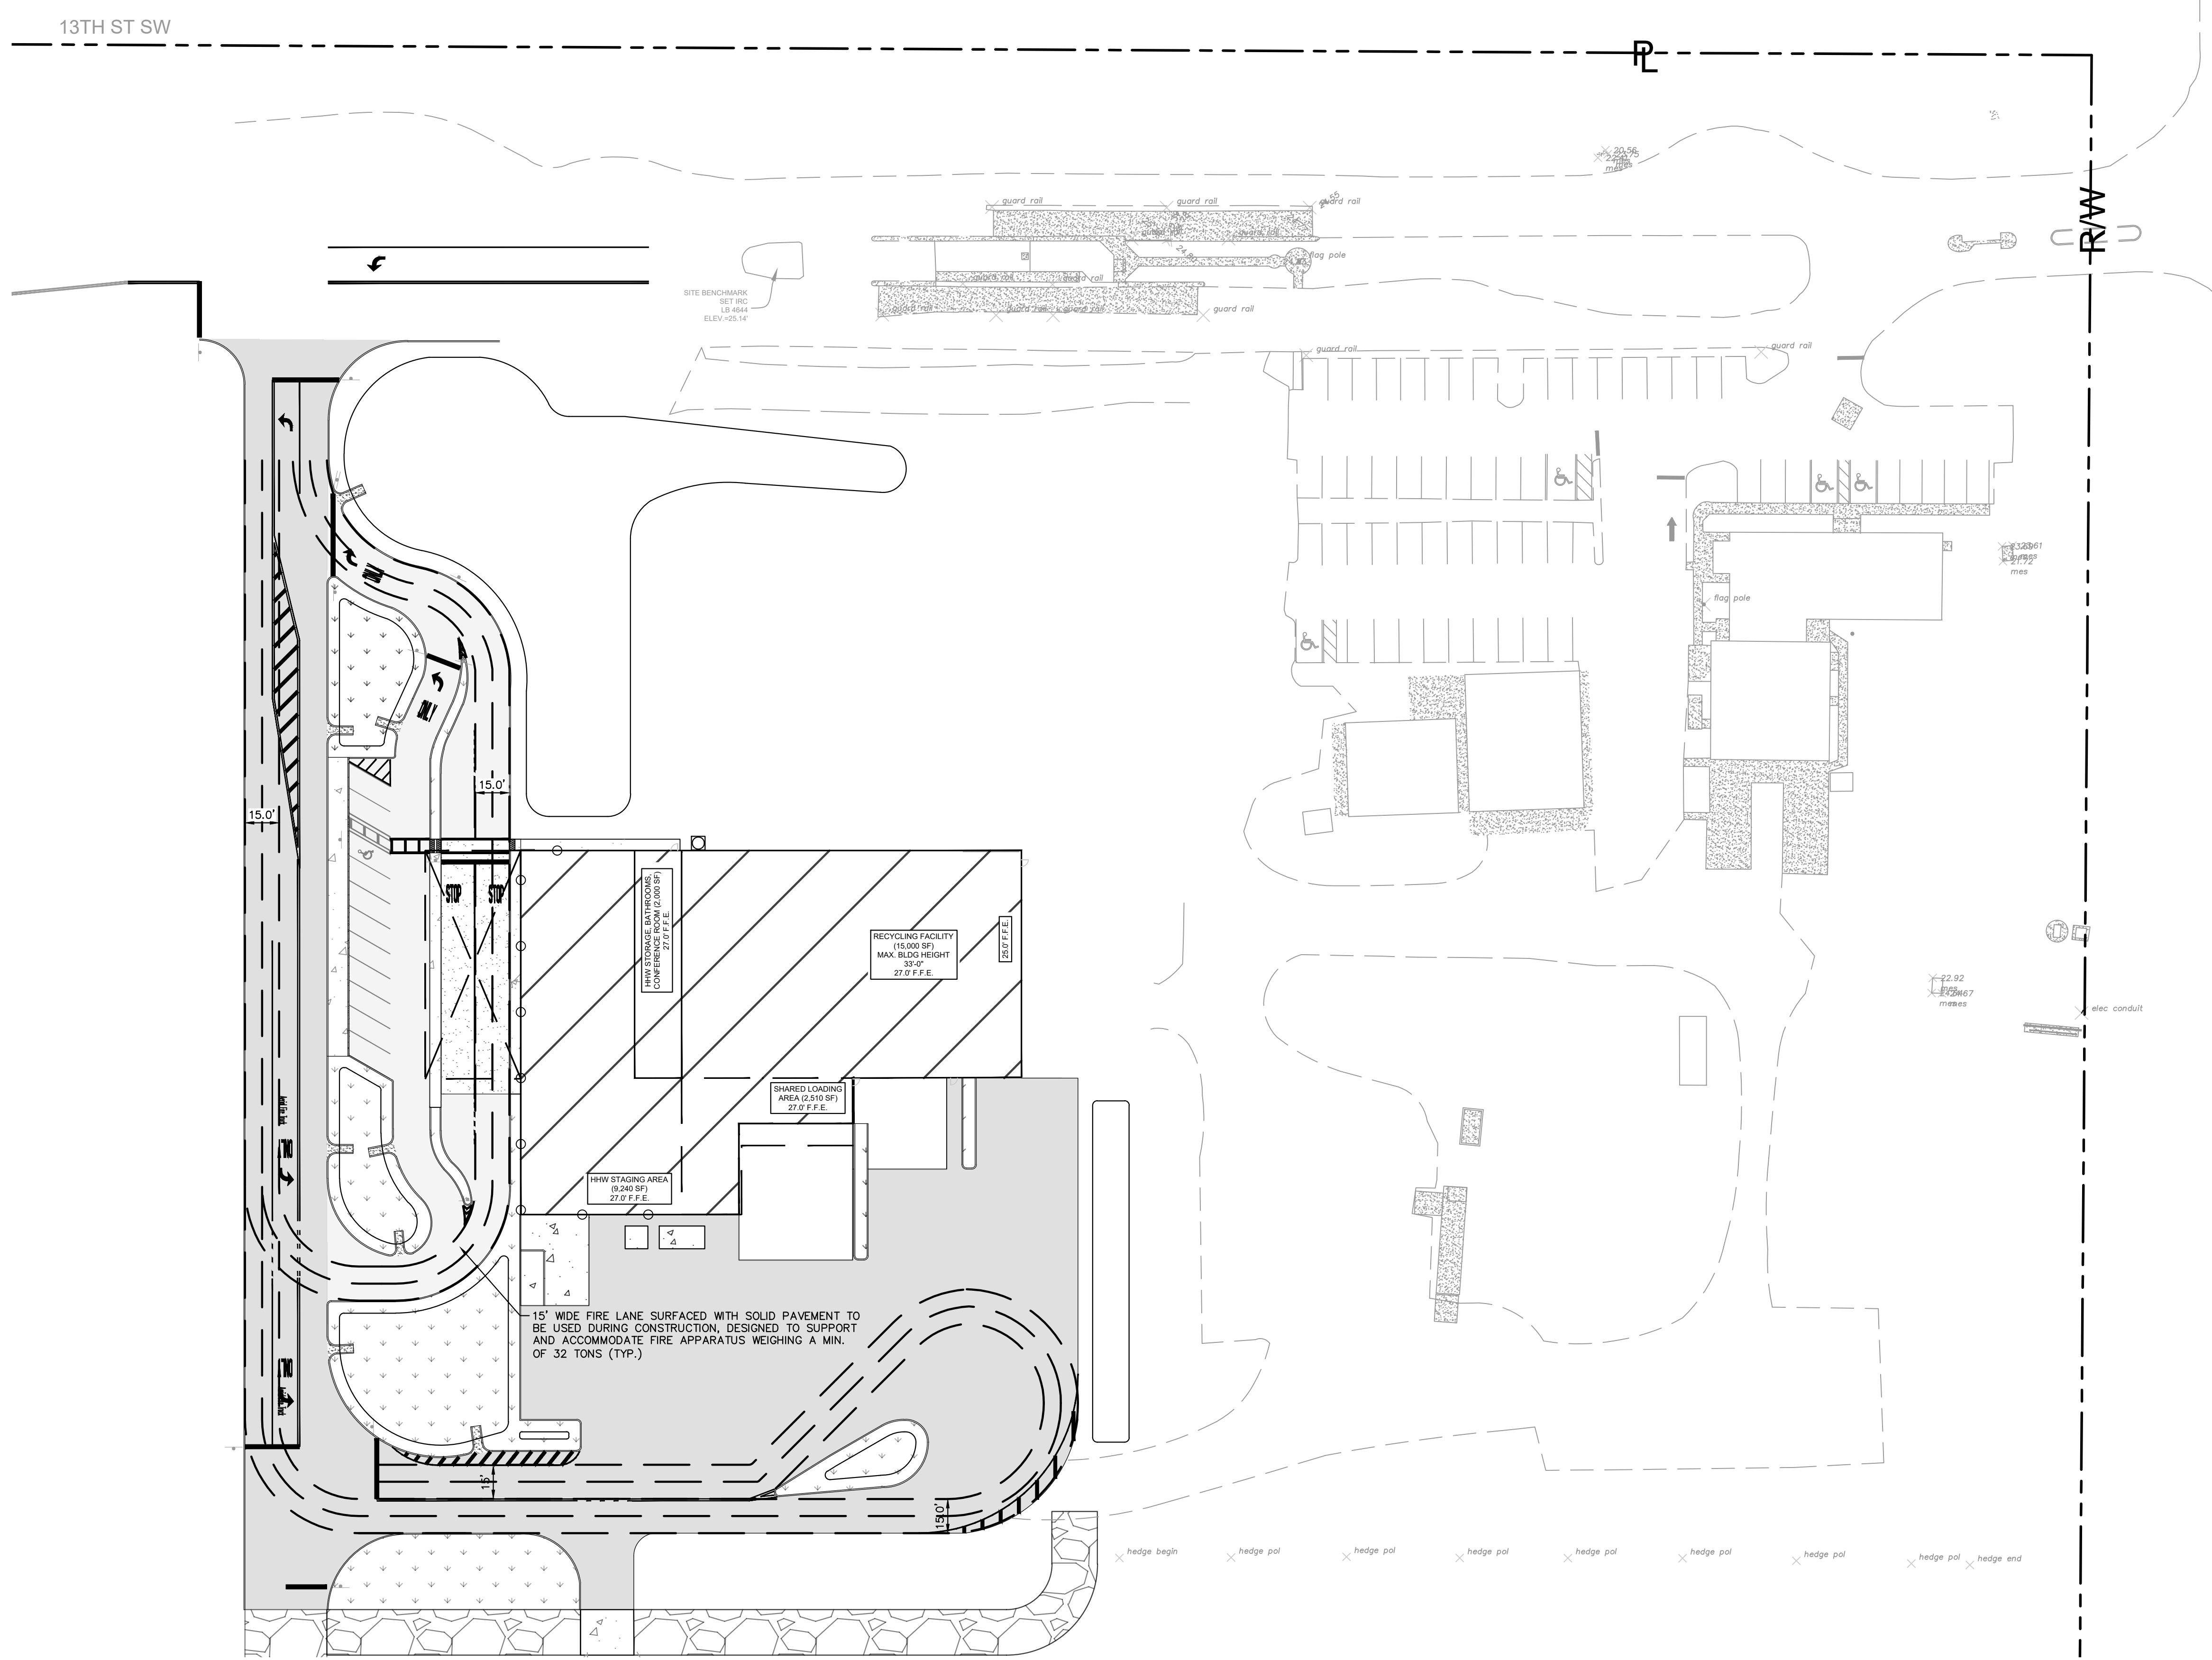

74TH AVENUE SW  
(45 MPH SPEED LIMIT)

**LEGEND**

- RAW - PL RIGHT-OF-WAY LINE / PROPERTY LINE
- [Hatched Pattern] PROP. BUILDING
- [Stippled Pattern] PROP. GRAVEL ROAD
- [Dark Grey] PROP. HEAVY DUTY ASPHALT
- [Light Grey] PROP. STANDARD DUTY ASPHALT
- [White with Dotted] PROP. LANDSCAPE AREA
- [Medium Grey] PROP. STANDARD DUTY CONC.
- [Dark Stippled] PROP. HEAVY DUTY CONC.
- [Light Stippled] PROP. CONC. SIDEWALK

GRAPHIC SCALE IN FEET  
0 20 40 80

NORTH

1


15' WIDE FIRE LANE SURFACED WITH SOLID PAVEMENT TO BE USED DURING CONSTRUCTION, DESIGNED TO SUPPORT AND ACCOMMODATE FIRE APPARATUS WEIGHING A MIN. OF 32 TONS (TYP.)

HHW STAGING AREA  
(9,240 SF)  
27'-0" F.F.E.

SHARED LOADING AREA  
(22,910 SF)  
27'-0" F.F.E.

RECYCLING FACILITY  
(15,000 SF)  
MAX. BUILDING HEIGHT  
33'-0"  
27'-0" F.F.E.

LANDSCAPE PATIOLINO  
CONFERENCE ROOM (2,000 SF)  
20'-0" F.F.E.

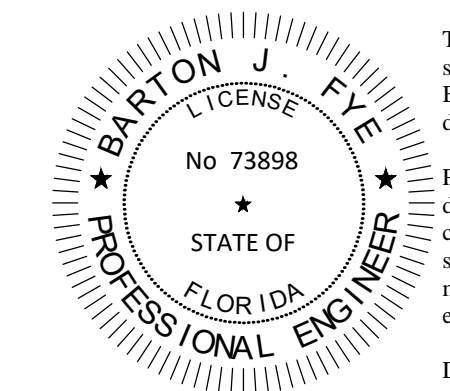

This item has been digitally signed and sealed by Barton J. Fye, P.E. on the date adjacent to the seal.  
Printed copies of this document are not considered signed and sealed and the signature must be verified on any electronic copies.  
Date: 11/17/2021





Call 811 or www.sunshine811.com two full business days before digging to have utilities located and marked.  
Check positive response codes before you dig!

|   |            |       |
|---|------------|-------|
| OWNER CHANGES   | 11/16/2021 | JF    |
|   |            |       |
| LICENSED PROFESSIONAL   |            |       |
| KHA PROJECT   | 14-3228000 |       |
| DATE  | JULY 2021  |       |
| SCALE   | AS SHOWN   |       |
| DESIGNED BY   | MRC        |       |
| DRAWN BY  | RMR        |       |
| CHECKED BY  | BF         |       |
|   |            | DATE: |
| <b>FIRE ACCESS PLAN</b>   |            |       |
| IRC LANDFILL<br>PREPARED FOR<br>INDIAN RIVER COUNTY<br>INDIAN RIVER COUNTY FL |            |       |
| SHEET NUMBER  | C-450      |       |

**Kimley-Horn**  
© 2021 KIMLEY-HORN AND ASSOCIATES, INC.  
355 ALHAMBRA CIRCLE, SUITE 1400, CORAL GABLES, FL 33134  
PHONE: 305-673-2025  
WWW.KIMLEY-HORN.COM REGISTRY 696

| NO. | REVISIONS | DATE | BY |
|-----|-----------|------|----|
|     |           |      |    |

Plotted By: Rodriguez, Rebecca Sheet: IRC LANDFILL Layout: C-500 OVERALL DRAINAGE PLAN November 17, 2021 10:41:12am K:\vmb\_civil\143228000 - Irc Inhw and recycling facility\CIVIL\CADD\plansheets\C-500 OVERALL DRAINAGE PLAN.dwg  
This document, together with the concepts and designs presented herein, is intended only for the specific purpose and client for which it was prepared. Reuse of and improper reliance on this document without written authorization and adaptation by Kimley-Horn and Associates, Inc. shall be without liability to Kimley-Horn and Associates, Inc.

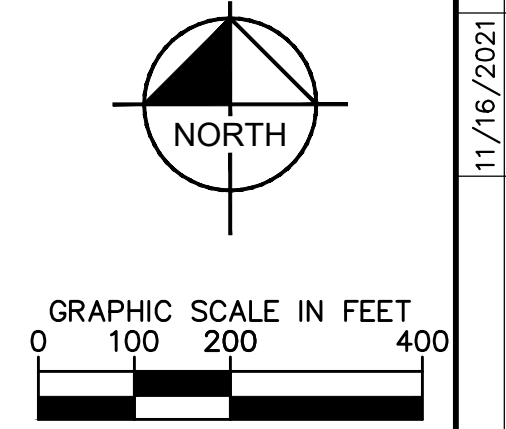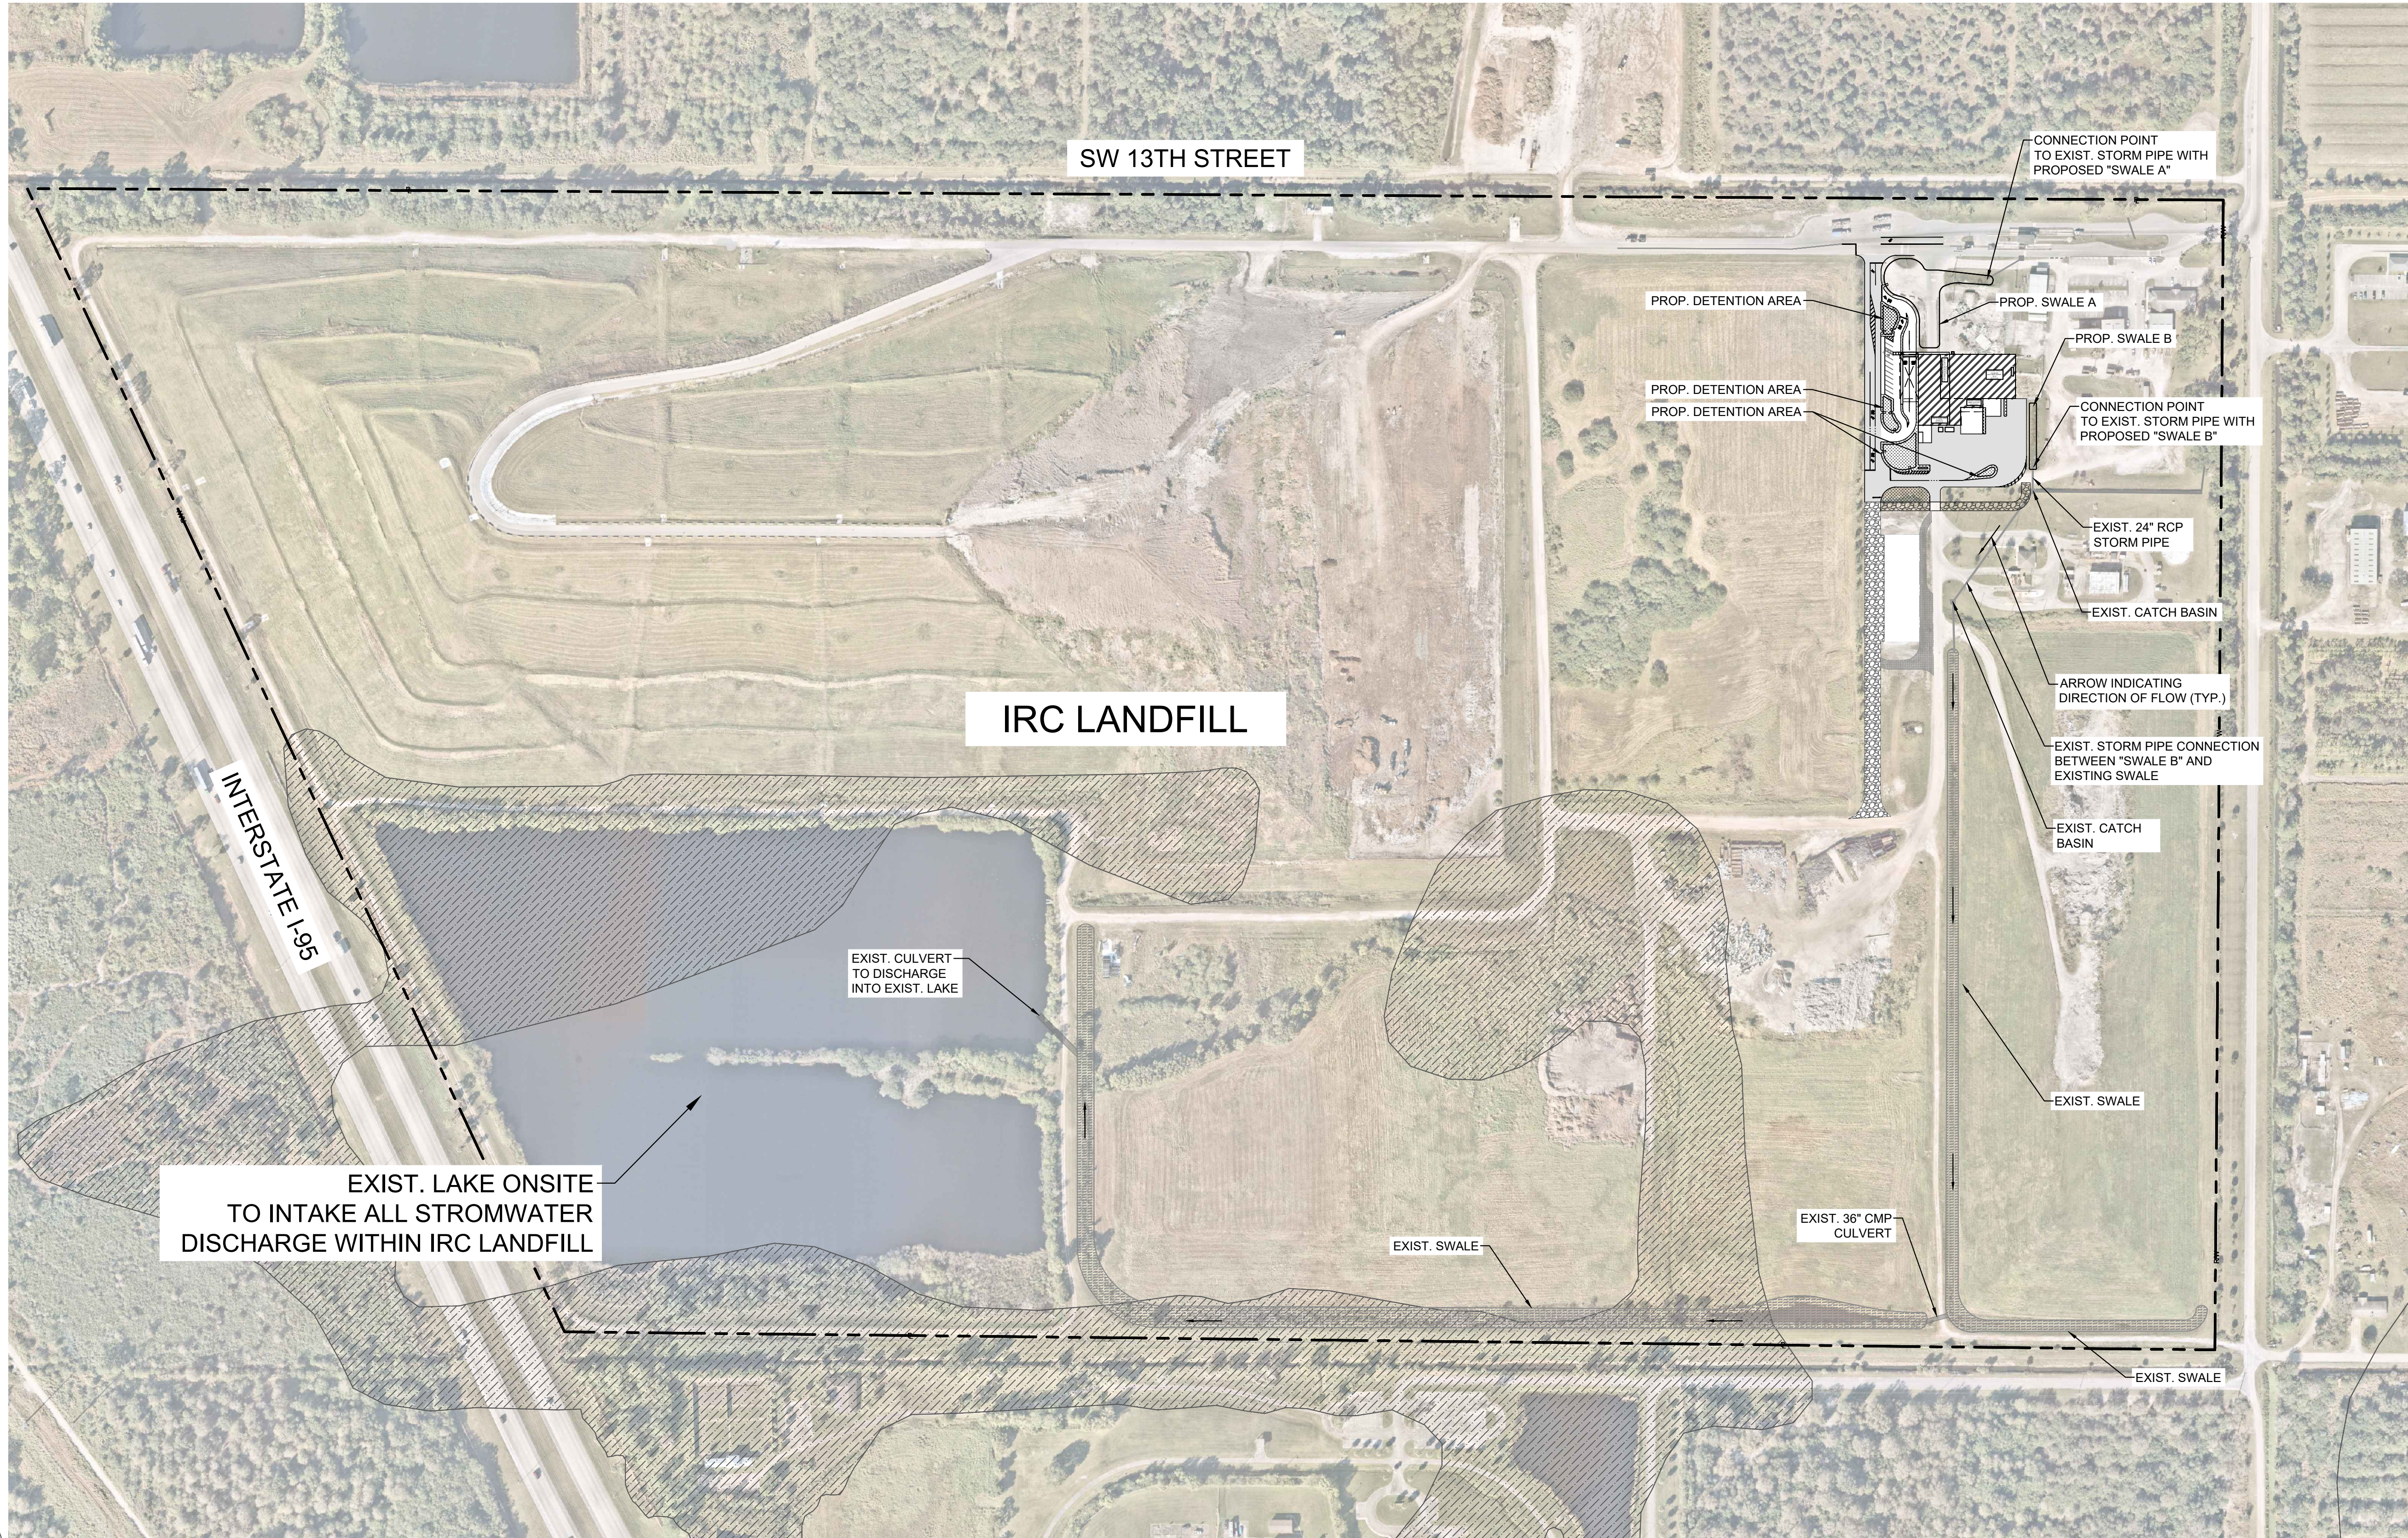

**LEGEND**

- RIGHT-OF-WAY LINE / PROPERTY LINE
- FEMA HAZARDOUS FLOOD ZONE A F.I.R.M. NO.: 12061C0355H

**NOTES**

- 74TH AVE SW POSTED SPEED LIMIT = 45MPH
- PROPOSED INTERCONNECTED DRAINAGE SYSTEM WILL CONNECT TO THE EXISTING STORM PIPE AS DESIGNATED ON PLAN SHEET.


| OWNER CHANGES | No. | REVISIONS | DATE | BY |
|---------------|-----|-----------|------|----|
|               |     |           |      |    |
|               |     |           |      |    |
|               |     |           |      |    |
|               |     |           |      |    |

**Kimley-Horn**  
© 2021 KIMLEY-HORN AND ASSOCIATES, INC.  
355 ALHAMBRA CIRCLE, SUITE 1400, CORAL GABLES, FL 33134  
PHONE: 305-673-2025  
WWW.KIMLEY-HORN.COM REGISTRY 696

| LICENSED PROFESSIONAL | KHA PROJECT | DATE      | SCALE    | DESIGNED BY | DRAWN BY | CHECKED BY | DATE |
|-----------------------|-------------|-----------|----------|-------------|----------|------------|------|
|                       | 14-3228000  | JULY 2021 | AS SHOWN | MRC         | RMR      | BF         |      |

**OVERALL DRAINAGE PLAN**

IRC LANDFILL  
PREPARED FOR  
INDIAN RIVER COUNTY  
INDIAN RIVER COUNTY FL


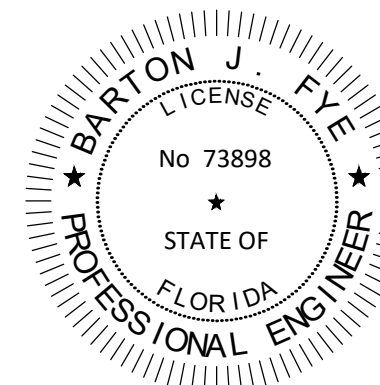


This item has been digitally signed and sealed by Barton J. Fye, P.E. on the date adjacent to the seal.  
Printed copies of this document are not considered signed and sealed and the signature must be verified on any electronic copies.  
Date: 11/17/2021

**Sunshine811**  
Call 811 or www.sunshine811.com two full business days before digging to have utilities located and marked.  
Check positive response codes before you dig!

SHEET NUMBER  
**C-500**

Plotted By: Rebecca Rodriguez, Rebecca Rodriguez, Sheet Set: IRC LANDFILL, Layout: C-510 PAVING, GRADING AND DRAINAGE PLAN, November 17, 2021, 11:22:53am, K:\vnt\civil\143228000 - Irc hnd and recycling facility\CADD\plansheets\C-510 PAVING, GRADING AND DRAINAGE DETAILS.dwg  
 This document, together with the concepts and designs presented herein, is intended only for the specific purpose and client for which it was prepared. Reuse of this document without written authorization and adaptation by Kimley-Horn and Associates, Inc. shall be without liability to Kimley-Horn and Associates, Inc.

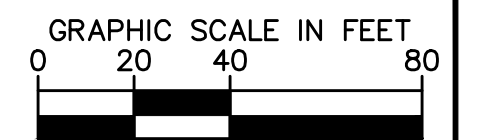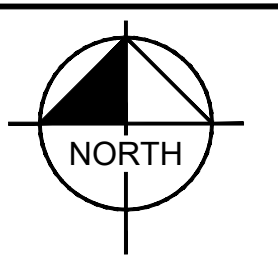

**LEGEND**

- RIGHT-OF-WAY LINE / PROPERTY LINE
- HIGH POINT (H.P.)
- FLOW ARROW
- PROP. BUILDING
- PROP. GRAVEL ROAD
- PROP. HEAVY DUTY ASPHALT
- PROP. STANDARD DUTY ASPHALT
- PROP. LANDSCAPE AREA
- PROP. STANDARD DUTY CONC.
- PROP. HEAVY DUTY CONC.
- PROP. CONC. SIDEWALK
- PROP. MATCH EXISTING ELEVATION
- PROP. ELEVATION
- PROP. TOP OF POND ELEVATION
- PROP. BOTTOM OF POND ELEVATION


**NOTES:**

1. CONTRACTOR TO CONSTRUCT DRAINAGE STRUCTURES WITH USF GRATES, RIMS AND COVERS AS CALLED OUT OR APPROVED EQUAL. SHOP DRAWINGS ARE TO BE PROVIDED TO ENGINEER PRIOR TO ANY CONSTRUCTION.
2. CONTRACTOR TO REFER TO FDOT DESIGN STANDARD (AND NOT LIMITED TO) INDEXES 200, 201, 210, 211, 214, 232 & 233 FOR MANHOLE, INLET AND GRATE SPECIFICATIONS.
3. ALL DRAINAGE STRUCTURES SHALL BE CONSTRUCTED WITH (4) SIDING BEARING HEAVY DUTY H-20 RATED TRAFFIC RIMS AND GRATES.
4. CONTRACTOR TO VERIFY ALL EXISTING UTILITY RINGS AND COVERS ON SITE ARE HEAVY DUTY TRAFFIC RATED. TO REPLACE DEFICIENT RINGS AND COVERS WITH HEAVY DUTY TRAFFIC RATED RINGS AND COVERS. CONTRACTOR TO ADJUST RIM ELEVATIONS TO MATCH PROPOSED FINISHED GRADE OF ANY EXISTING UTILITIES TO REMAIN THAT CHANGE IN ELEVATION DURING CONSTRUCTION.
5. ALL CLEANOUT COVERS SHOULD BE RATED FOR HEAVY DUTY TRAFFIC.
6. ALL EXISTING PAVEMENT AND CONCRETE TO BE JOINED SHALL BE SAWCUT.
7. SIDEWALKS AND CROSSWALKS SHALL NOT EXCEED 2% CROSS SLOPE NOR 5% LONGITUDINAL. GRADES IN ACCESSIBLE PARKING SPACES SHALL NOT EXCEED 2% IN ANY DIRECTION. IN CASES OF SIDEWALK AT BUILDING ENTRANCES, GRADES SHALL NOT EXCEED 2% IN ANY DIRECTION. ACCESSIBLE CURB RAMPS SHALL NOT EXCEED 8" IN LENGTH, 6" RISE, AND 1:12 SLOPE. LANDINGS ASSOCIATED WITH RAMPS AND AT CHANGES IN DIRECTION SHALL BE MINIMUM 60"X60" AND SHALL NOT EXCEED 2% SLOPE IN ANY DIRECTION. MINIMUM GRADE ON SIDEWALKS IN THE FIRST TEN (10) FEET ADJACENT TO BUILDINGS SHALL BE 1.5% MINIMUM.
8. SPOT ELEVATIONS ARE AT FACE OF CURB AND EDGE OF PAVEMENT UNLESS OTHERWISE NOTED.
9. EXISTING GRADES AND DRAINAGE HAVE BEEN TAKEN FROM A SURVEY PREPARED BY MASTELLER, MOLER & TAYLOR, INC. DATED MARCH 5, 2020. THE ELEVATIONS SHOWN HEREON ARE BASED ON THE NORTH AMERICAN VERTICAL DATUM (NAVD) OF 1988. THE PRIMARY BENCHMARK UTILIZED IS IRC BM267009, ELEV. = 20.50'. SITE BENCHMARKS ARE AS SHOWN.

10. HOPE STORM PIPE-CONTRACTOR IS RESPONSIBLE FOR OBTAINING THE STORM DRAINAGE PIPE INSTALLATION MANUAL AND SPECIFICATIONS AND COMPLYING WITH ALL MANUFACTURER'S INSTALLATION PROCEDURES AND REQUIREMENTS. TESTING OF BACKFILL MATERIAL AND COMPACTION OF BACKFILL MATERIAL IS THE CONTRACTOR'S RESPONSIBILITY.
11. ROOF DRAIN CONNECTIONS TO DRAINAGE PIPE SHALL BE AS FOLLOWS:
  - 11.1 FOR ADS N-12 CORRUGATED POLYETHYLENE DRAINAGE PIPE USE ADS DUAL WALL BRICATED REDUCING SADDLE TEE#24" DIAMETER.
  - 11.2 FOR RCP DRAINAGE PIPE MAKE CONNECTION PER FDOT INDEX#280, CONCRETE COLLAR FOR JOINING MAINLINE PIPE AND STUB PIPE DETAIL.
  - 11.3 NOTIFY CONSULTANT FOR CONNECTION METHOD TO STEEL PIPE.
  - 11.4 ALL DRAINAGE PIPE JOINTS SHALL BE FILTER FABRIC WRAPPED PER FDOT INDEX #280. ALL DRAINAGE PIPE JOINTS NEED TO BE FILTER FABRIC WRAPPED REGARDLESS OF MATERIAL.
  - 11.5 EXISTING STORM INLETS AND PIPES ON PROPERTY TO BE JETTED AND CLEANED PRIOR TO ENGINEER'S ACCEPTANCE OF SYSTEM.
12. CONTRACTOR SHALL COORDINATE PAVING IMPROVEMENTS TO AVOID TIRE MARKS FROM CONSTRUCTION ACTIVITY. FINAL PAVING SHALL BE AS SMOOTH AS POSSIBLE AND FREE FROM ANY MARKS, SCRAPES, GOUGES, TIRE MARKS, ETC. CAUSED DURING CONSTRUCTION ACTIVITY.
13. CONTRACTOR TO ENSURE POSITIVE RUNOFF FROM THE BUILDING. PAVING SHALL BE FREE OF PONDING AND MAINTAIN POSITIVE OFFFALL TO THE DRAINAGE SYSTEM. CONTRACTOR SHALL FIELD VERIFY EXISTING DRAINAGE PATTERNS AND TIE-IN GRADES AND ALERT OWNER AND ENGINEER SHOULD ANY CONFLICTS ARISE.
14. DURING CONSTRUCTION AND AFTER FINAL GRADING, NO SURFACE WATER RUNOFF MAY BE DIRECTED TO ADJACENT PROPERTIES, AND ALL SURFACE WATER RUNOFF MUST BE ROUTED TO APPROVED DRAINAGE FACILITIES OR BE RETAINED ON SITE. ALL RUNOFF FROM THE SITE, BOTH DURING AND AFTER CONSTRUCTION, MUST BE FREE OF POLLUTANTS, INCLUDING SEDIMENT, PRIOR TO DISCHARGE.
15. ALL SLOPES STEEPER THAN 6:1 SHALL BE SODDED.
16. ALL SIDEWALKS BEHIND AND ADJACENT TO LANDSCAPE ISLANDS WILL BE SLOPED TO PREVENT STANDING WATER ALONG THE LANDSCAPE ISLAND.
17. ALL MEDIAN OPENING FLUMES TO BE CONSTRUCTED PER FOOT STANDARD INDEX 600-10 AND EXTEND DOWN TO THE BOTTOM OF ALL PONDS AND SWALES, UNLESS OTHERWISE NOTED.
18. EACH PUMP IN THE DUPLEX SUMP PUMP MUST HAVE A DISCHARGE RATE OF 80 GPM @ 5' TDH.


13TH ST SW

74TH AVENUE SW  
(45 MPH SPEED LIMIT)

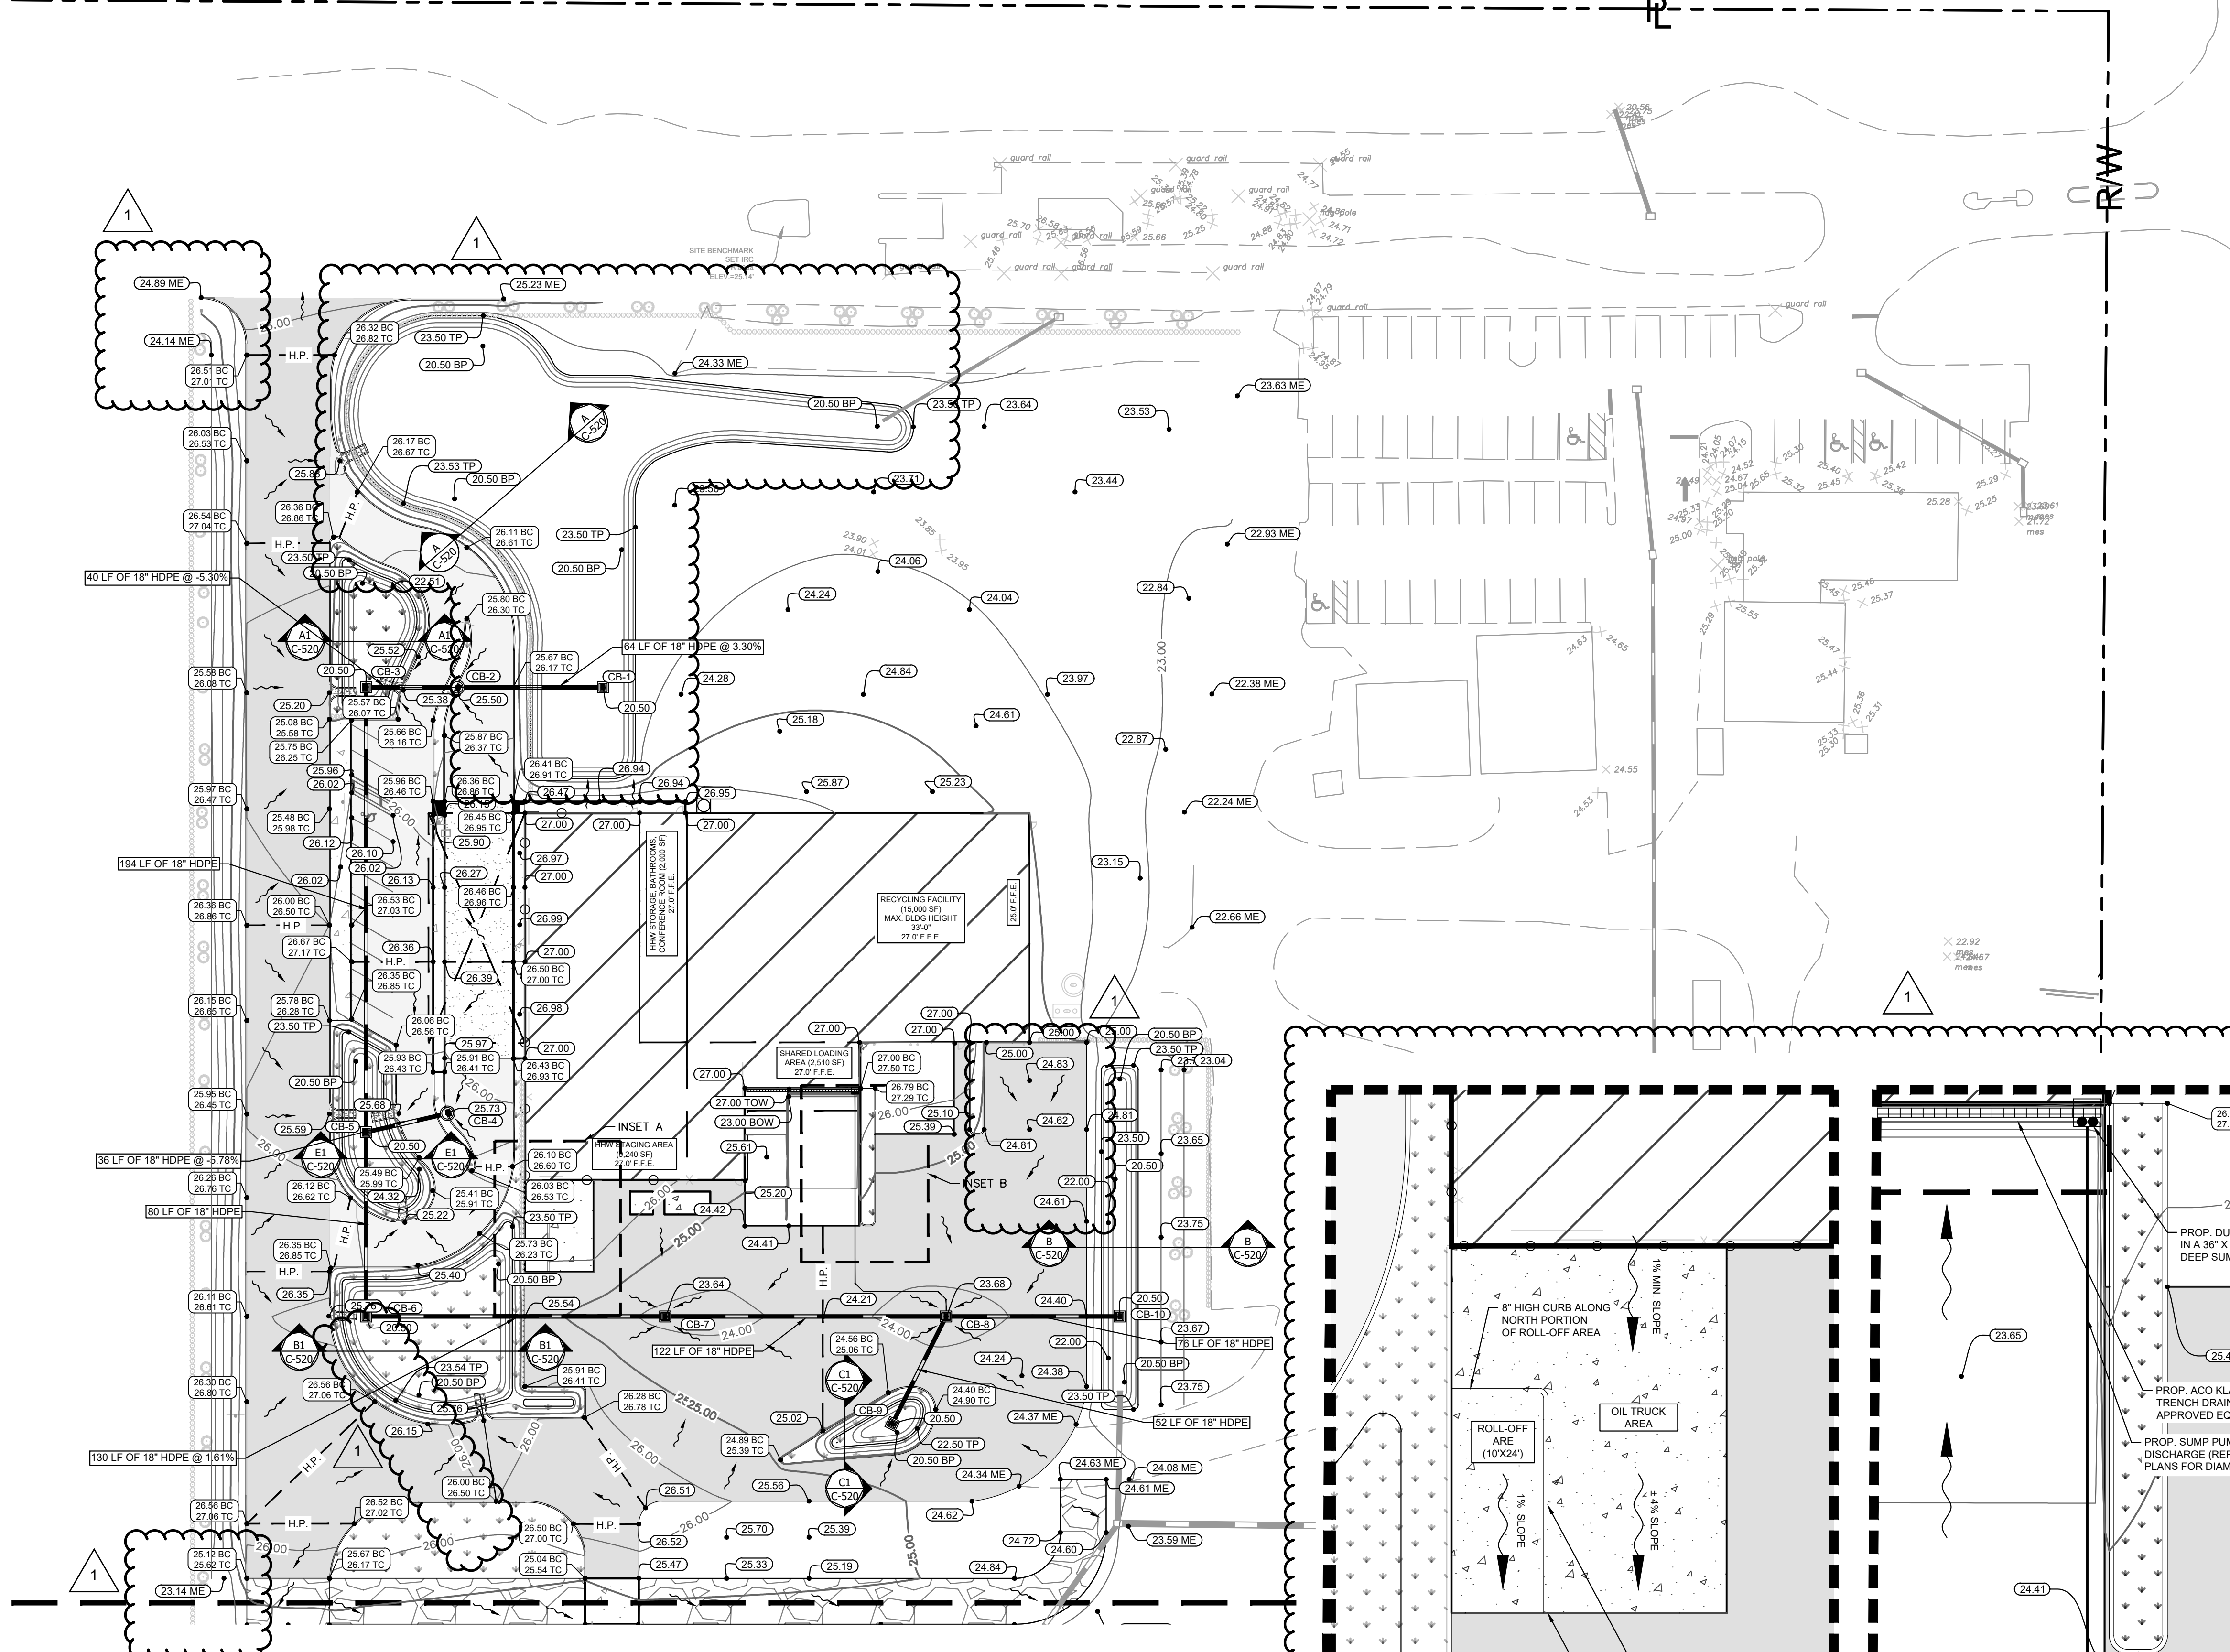

SEE SHEET C-511 FOR CONTINUATION

This item has been digitally signed and sealed by Barton J. Fye, P.E. on the date adjacent to the seal.  
 Printed copies of this document are not considered signed and sealed and the signature must be verified on any electronic copies.  
 Date: 11/17/2021

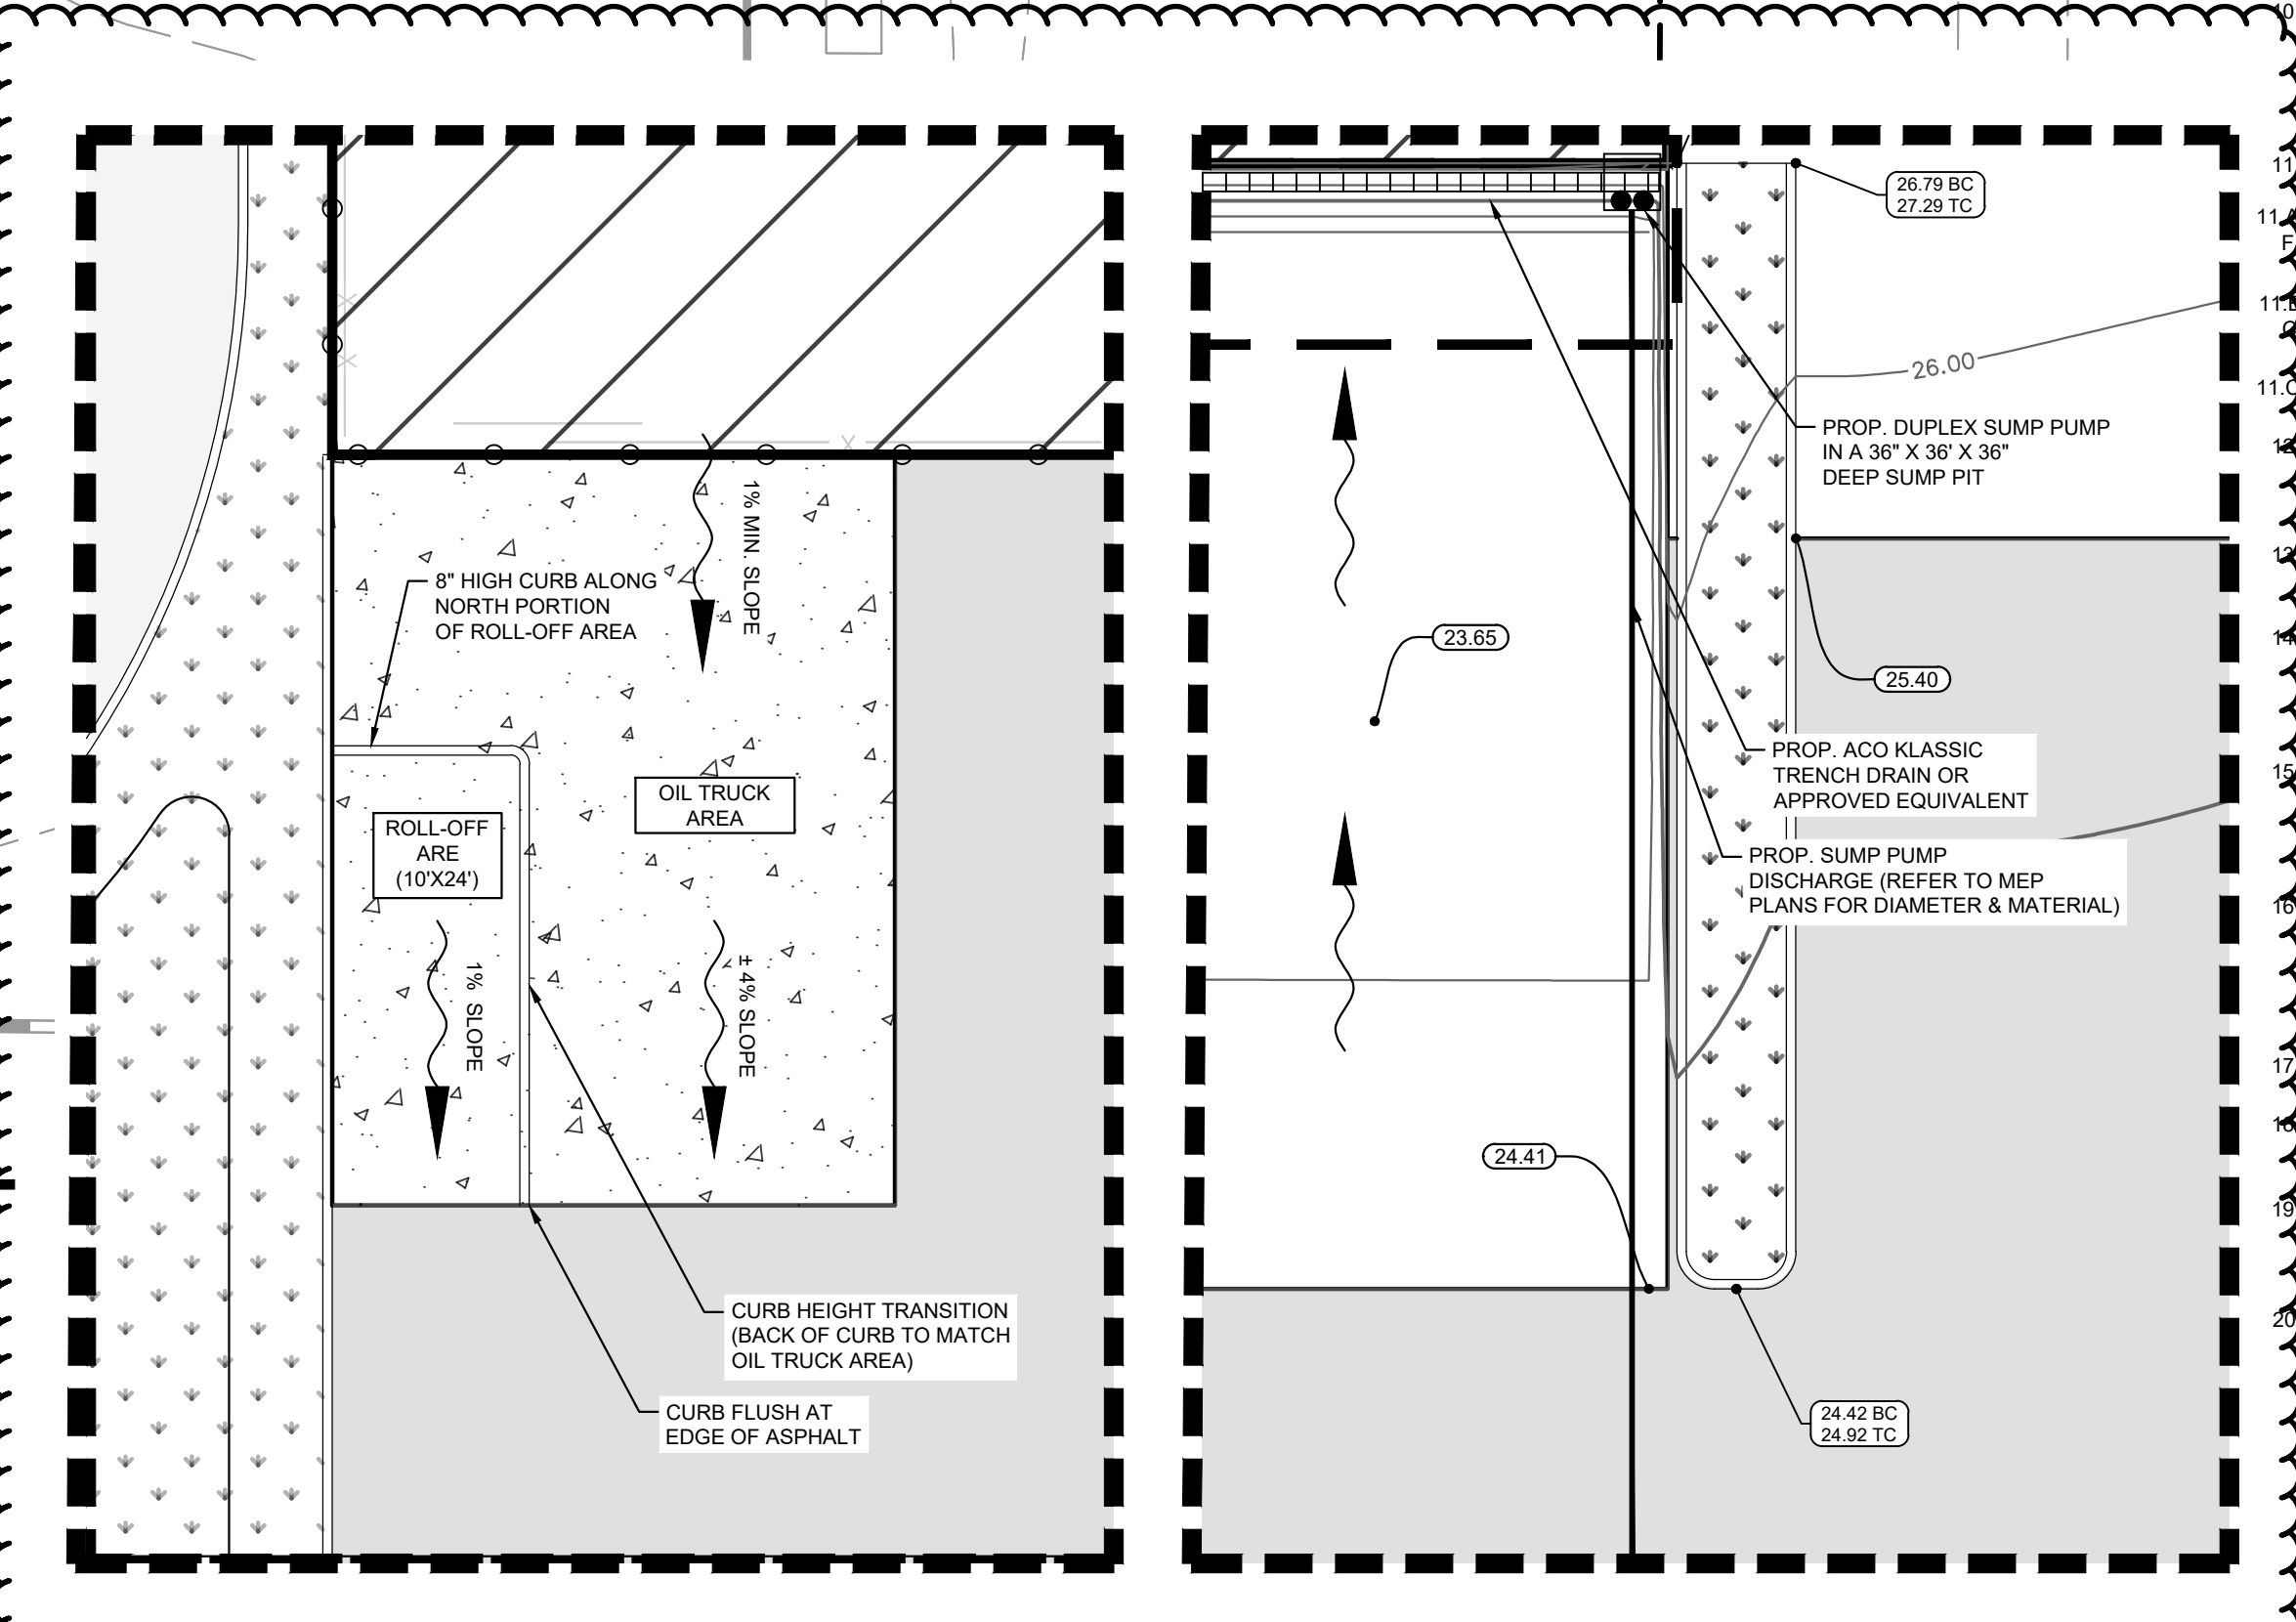

INSET A  
1" = 10'

INSET B  
1" = 10'



Call 811 or www.sunshine811.com two full business days before digging to have utilities located and marked.  
 Check positive response codes before you dig!

| OWNER CHANGES  |                           | 11/16/2021        |                   |   |                 |                  |       |     |      |    |  |  |  |  |  |  |  |  |  |
|--|---------------------------|-------------------|-------------------|---|-----------------|------------------|-------|-----|------|----|--|--|--|--|--|--|--|--|--|
| LICENSED PROFESSIONAL  | KHA PROJECT<br>14-3228000 | DATE<br>JULY 2021 | SCALE<br>AS SHOWN | DESIGNED BY<br>MRC  | DRAWN BY<br>RMR | CHECKED BY<br>BF | DATE: |     |      |    |  |  |  |  |  |  |  |  |  |
| <h2 style="margin: 0;">PAVING, GRADING AND DRAINAGE PLAN</h2>  |                           |                   |                   | <h2 style="margin: 0;">IRC LANDFILL</h2>  |                 |                  |       |     |      |    |  |  |  |  |  |  |  |  |  |
| <p style="margin: 0;">PREPARED FOR<br/>INDIAN RIVER COUNTY</p> |                           |                   |                   | <p style="margin: 0;">INDIAN RIVER COUNTY</p>   |                 |                  |       |     |      |    |  |  |  |  |  |  |  |  |  |
| <p style="margin: 0;">SHEET NUMBER<br/><b>C-510</b></p>        |                           |                   |                   | <p style="margin: 0;">REVISIONS</p> <table border="1" style="width: 100%; border-collapse: collapse;"> <thead> <tr> <th>No.</th> <th>DATE</th> <th>BY</th> </tr> </thead> <tbody> <tr><td> </td><td> </td><td> </td></tr> <tr><td> </td><td> </td><td> </td></tr> <tr><td> </td><td> </td><td> </td></tr> </tbody> </table> |                 |                  |       | No. | DATE | BY |  |  |  |  |  |  |  |  |  |
| No.  | DATE                      | BY                |                   |   |                 |                  |       |     |      |    |  |  |  |  |  |  |  |  |  |
|  |                           |                   |                   |   |                 |                  |       |     |      |    |  |  |  |  |  |  |  |  |  |
Kimley-Horn


© 2021 KIMLEY-HORN AND ASSOCIATES, INC.  
 355 ALHAMBRA CIRCLE, SUITE 1400, CORAL GABLES, FL 33154  
 PHONE: 305-673-2025  
 WWW.KIMLEY-HORN.COM REGISTRY 696

SEE SHEET C-510 FOR CONTINUATION

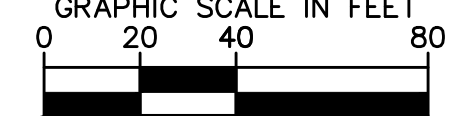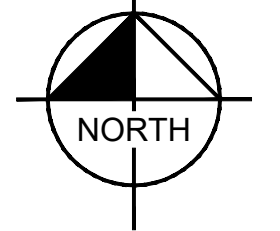


**LEGEND**

- RAW** - RIGHT-OF-WAY LINE / PROPERTY LINE
- H.P.** - HIGH POINT (H.P.)
- FLOW ARROW
- PROP. BUILDING
- PROP. GRAVEL ROAD
- PROP. HEAVY DUTY ASPHALT
- PROP. STANDARD DUTY ASPHALT
- PROP. LANDSCAPE AREA
- PROP. STANDARD DUTY CONC.
- PROP. HEAVY DUTY CONC.
- PROP. CONC. SIDEWALK
- PROP. MATCH EXISTING ELEVATION
- PROP. ELEVATION
- PROP. TOP OF POND ELEVATION
- PROP. BOTTOM OF POND ELEVATION

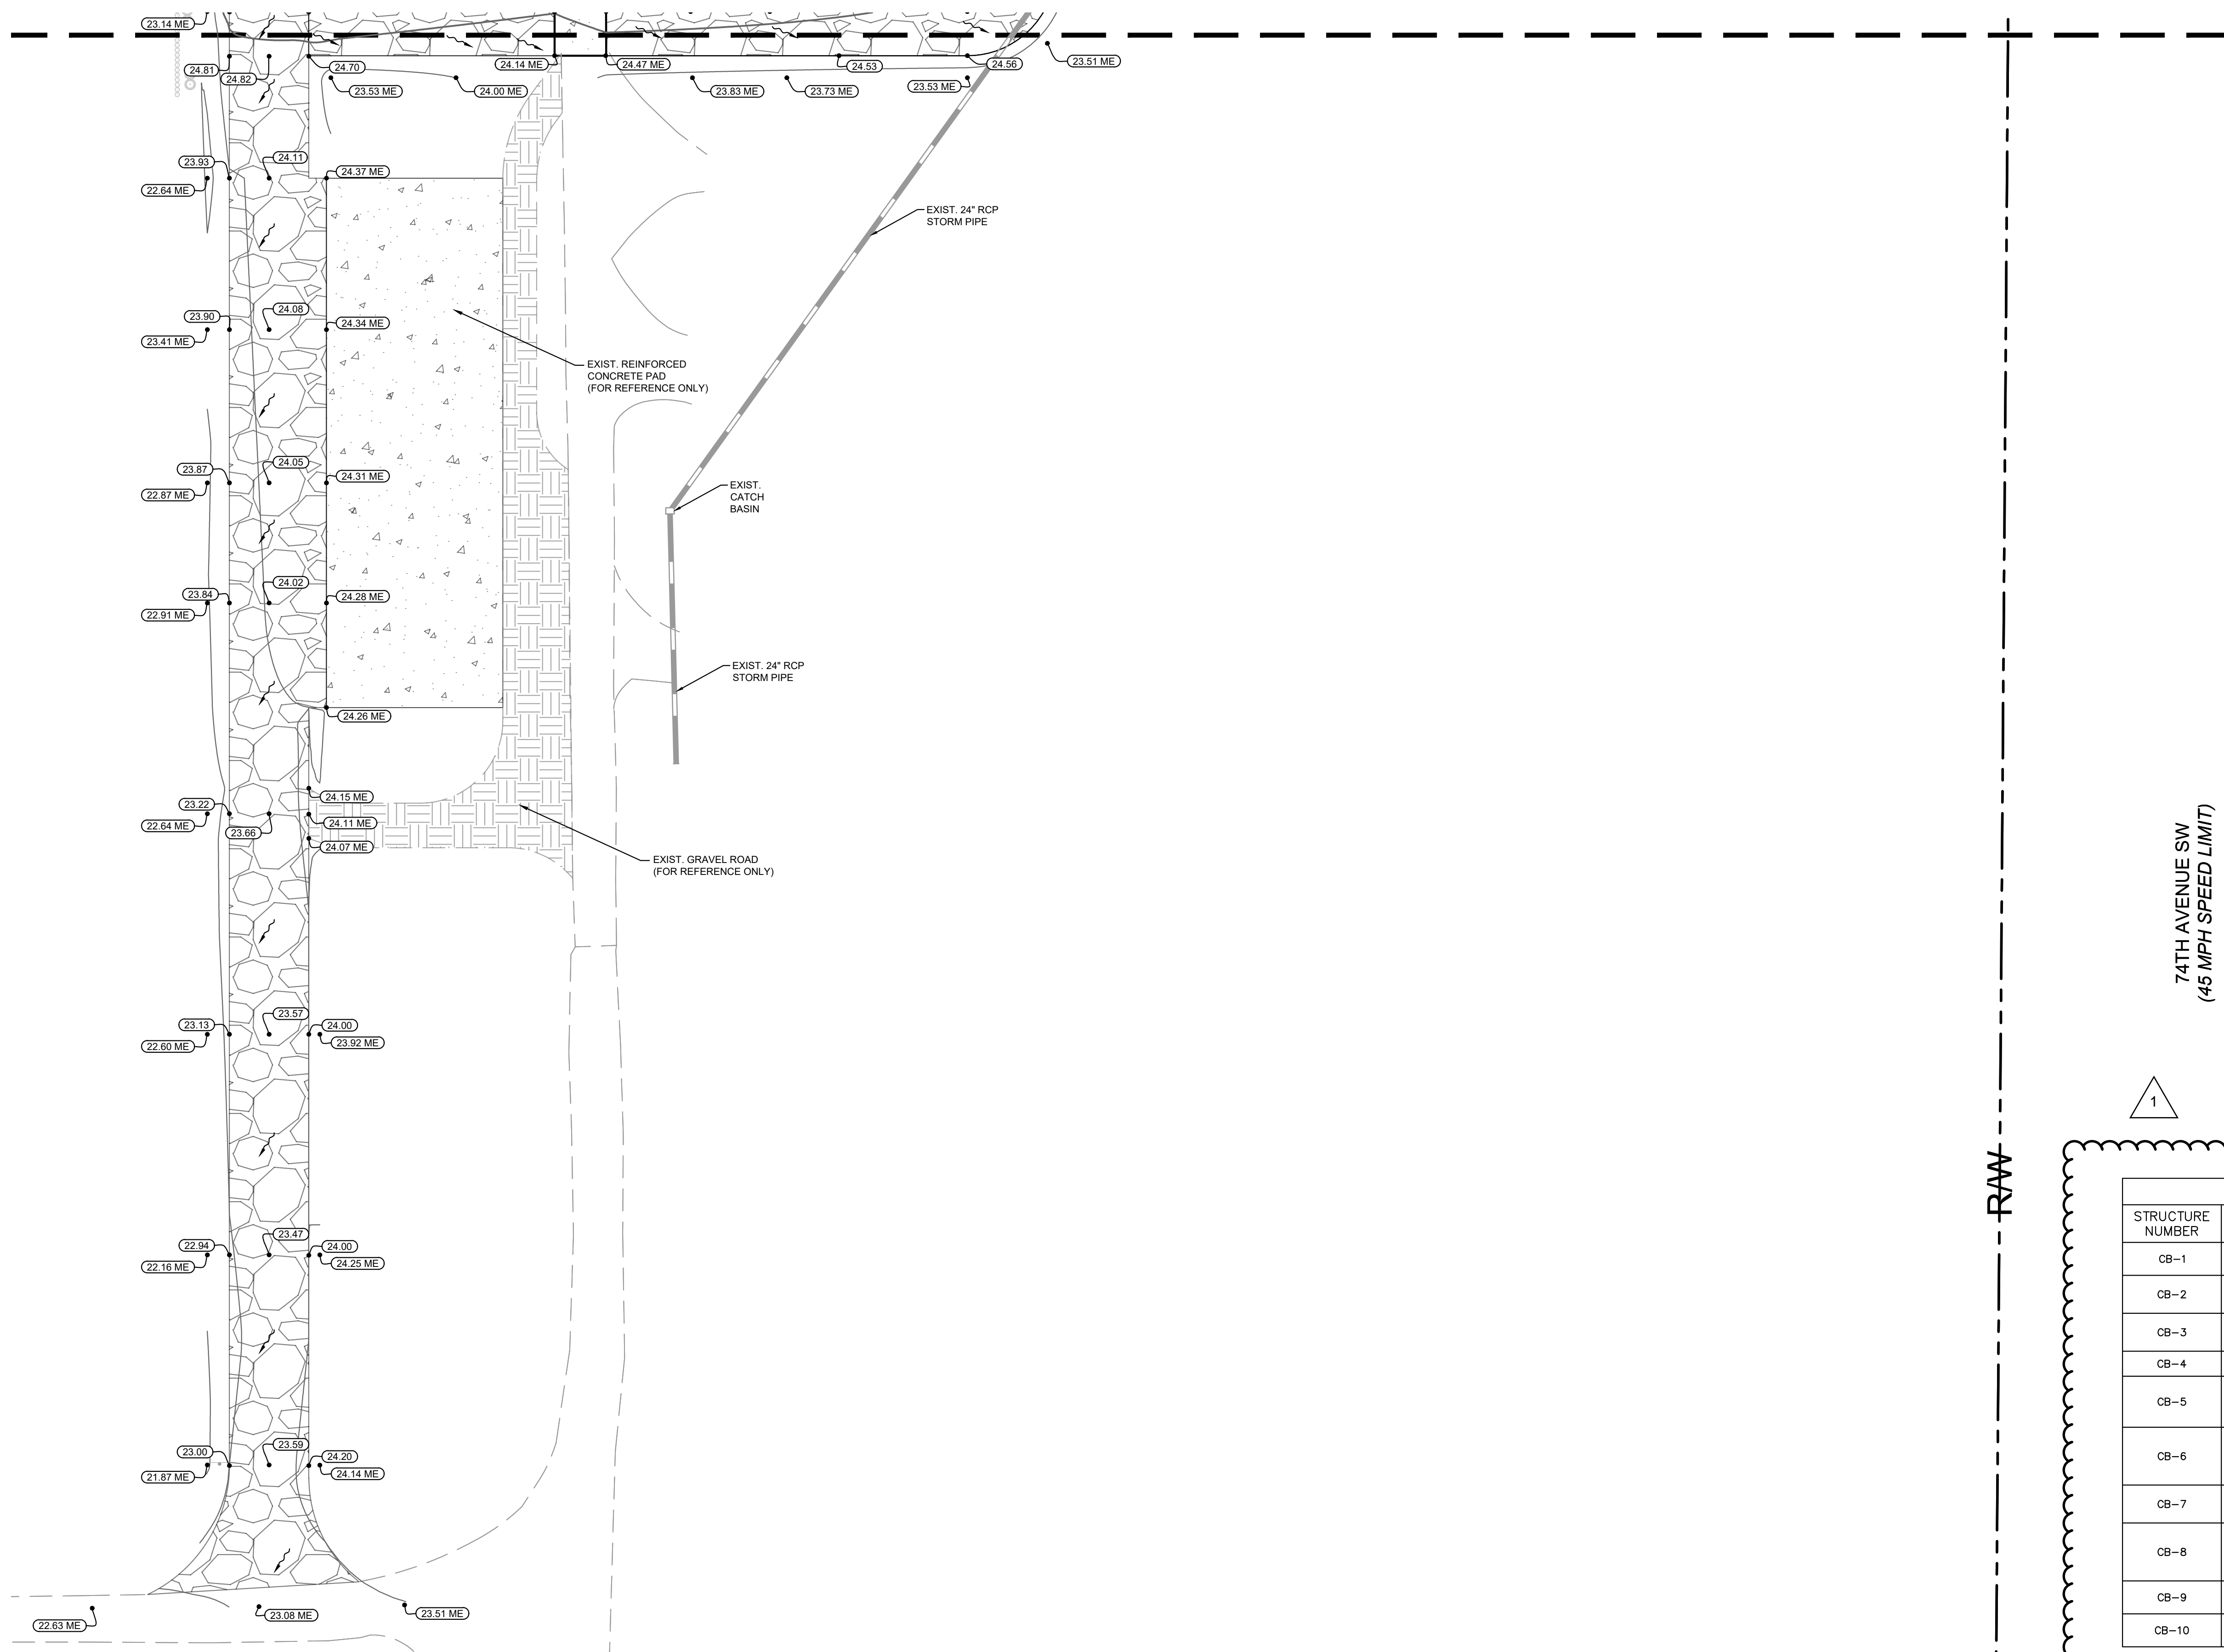


74TH AVENUE SW  
(45 MPH SPEED LIMIT)

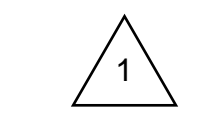

| DRAINAGE STRUCTURE TABLE |  |               |  |
|--------------------------|--|---------------|--|
| STRUCTURE NUMBER         | STRUCTURE TYPE   | RIM ELEVATION | INVERT ELEVATION   |
| CB-1                     | PRECAST DITCH BOTTOM INLET - TYPE C 10 FT. OR LESS   | RIM = 20.50   | (18") 17.00 (W)  |
| CB-2                     | PROP. P9 CURB INLET PER FDOT   | RIM = 25.50   | (18") 19.10 (W) .<br>(18") 19.10 (E) .                       |
| CB-3                     | PRECAST DITCH BOTTOM INLET - TYPE C 10 FT. OR LESS   | RIM = 20.50   | (18") 17.00 (E) .<br>(18") 17.00 (S) .                       |
| CB-4                     | PROP. P9 CURB INLET PER FDOT   | RIM = 25.73   | (18") 19.10 (W) .  |
| CB-5                     | PRECAST DITCH BOTTOM INLET - TYPE C 10 FT. OR LESS   | RIM = 20.50   | (18") 17.00 (N) .<br>(18") 17.00 (E) .<br>(18") 17.00 (S) .  |
| CB-6                     | PRECAST DITCH BOTTOM INLET - TYPE C 10 FT. OR LESS WITH 60" TYPE J BOTTOM PER FDOT INDEX 425-010 | RIM = 20.50   | (18") 17.00 (E) .<br>(18") 17.00 (N) .                       |
| CB-7                     | PRECAST DITCH BOTTOM INLET - TYPE C 10 FT. OR LESS   | RIM = 23.62   | (18") 19.10 (E) .<br>(18") 19.10 (W) .                       |
| CB-8                     | PRECAST DITCH BOTTOM INLET - TYPE C 10 FT. OR LESS WITH 60" TYPE J BOTTOM PER FDOT INDEX 425-010 | RIM = 23.68   | (18") 17.00 (SW) .<br>(18") 19.10 (W) .<br>(18") 17.00 (E) . |
| CB-9                     | PRECAST DITCH BOTTOM INLET - TYPE C 10 FT. OR LESS   | RIM = 20.50   | (18") 17.00 (NE)   |
| CB-10                    | PRECAST DITCH BOTTOM INLET - TYPE C 10 FT. OR LESS   | RIM = 20.50   | (18") 17.00 (W)  |

\*POLLUTION PREVENTION BAFFLE REQUIRED

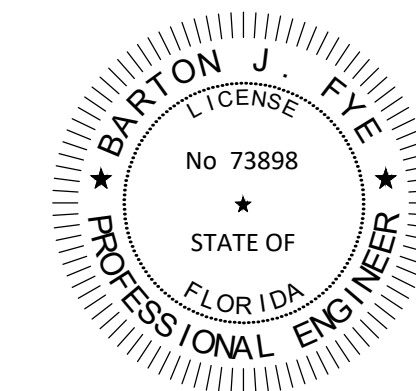

This item has been digitally signed and sealed by Barton J. Fye, P.E. on the date adjacent to the seal.

Printed copies of this document are not considered signed and sealed and the signature must be verified on any electronic copies.  
Date: 11/17/2021





Call 811 or www.sunshine811.com two full business days before digging to have utilities located and marked.  
Check positive response codes before you dig!

Plotted By: Rodriguez, Rebecca - Sheet Set: IRC LANDFILL - Layout: C-511 PAVING, GRADING AND DRAINAGE PLAN II - November 17, 2021 11:23:01am - K:\mb\_civil\143228000 - irc\_hwa\_and\_recycling\_facility\CADD\plansheets\C-512 PAVING, GRADING AND DRAINAGE DETAILS.dwg  
 This document, together with the concepts and designs presented herein, is intended only for the specific purpose and client for which it was prepared. Reuse of and improper reliance on this document without written authorization and adaptation by Kimley-Horn and Associates, Inc. shall be without liability to Kimley-Horn and Associates, Inc.

|   |   |
|---|---|
| <p>© 2021 KIMLEY-HORN AND ASSOCIATES, INC.<br/>355 ALHAMBRA CIRCLE, SUITE 1400, CORAL GABLES, FL 33134<br/>PHONE: 305-673-2025<br/>WWW.KIMLEY-HORN.COM REGISTRY 696</p> | 11/16/2021 JF<br>OWNER CHANGES<br>REVISIONS<br>No. _____ DATE _____<br>BY _____ |
| KHA PROJECT<br>14-3228000<br>DATE<br>JULY 2021<br>SCALE AS SHOWN<br>DESIGNED BY MRG<br>DRAWN BY RMR<br>CHECKED BY _____ DATE: _____                                     | LICENSED PROFESSIONAL<br>_____<br>_____<br>_____                                |
| IRC LANDFILL<br>PREPARED FOR<br>INDIAN RIVER COUNTY<br>INDIAN RIVER COUNTY<br>FL  | PAVING, GRADING AND<br>DRAINAGE PLAN II   |
| SHEET NUMBER<br><b>C-511</b>  | DATE<br>11/17/2021  |

Plotted By: Rodriguez, Rebecca - Sheet Set: IRC LANDFILL - Layout: C-512 - INTENTIONALLY LEFT BLANK - November 17, 2021 - 10:41:49pm - k:\mb-civil\143228000 - irc\_lhw\_and\_recycling\_facility\civil\CADD\plansheets\C-512\_PAVING, GRADING AND DRAINAGE DETAILS.dwg  
 This document, together with the concepts and designs presented herein, as an instrument of service, is intended only for the specific purpose and client for which it was prepared. Reuse of and improper reliance on this document without written authorization and adaptation by Kimley-Horn and Associates, Inc. shall be without liability to Kimley-Horn and Associates, Inc.

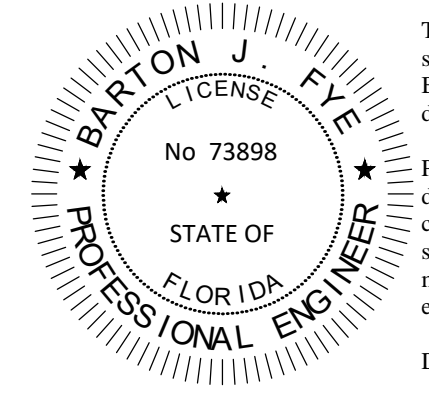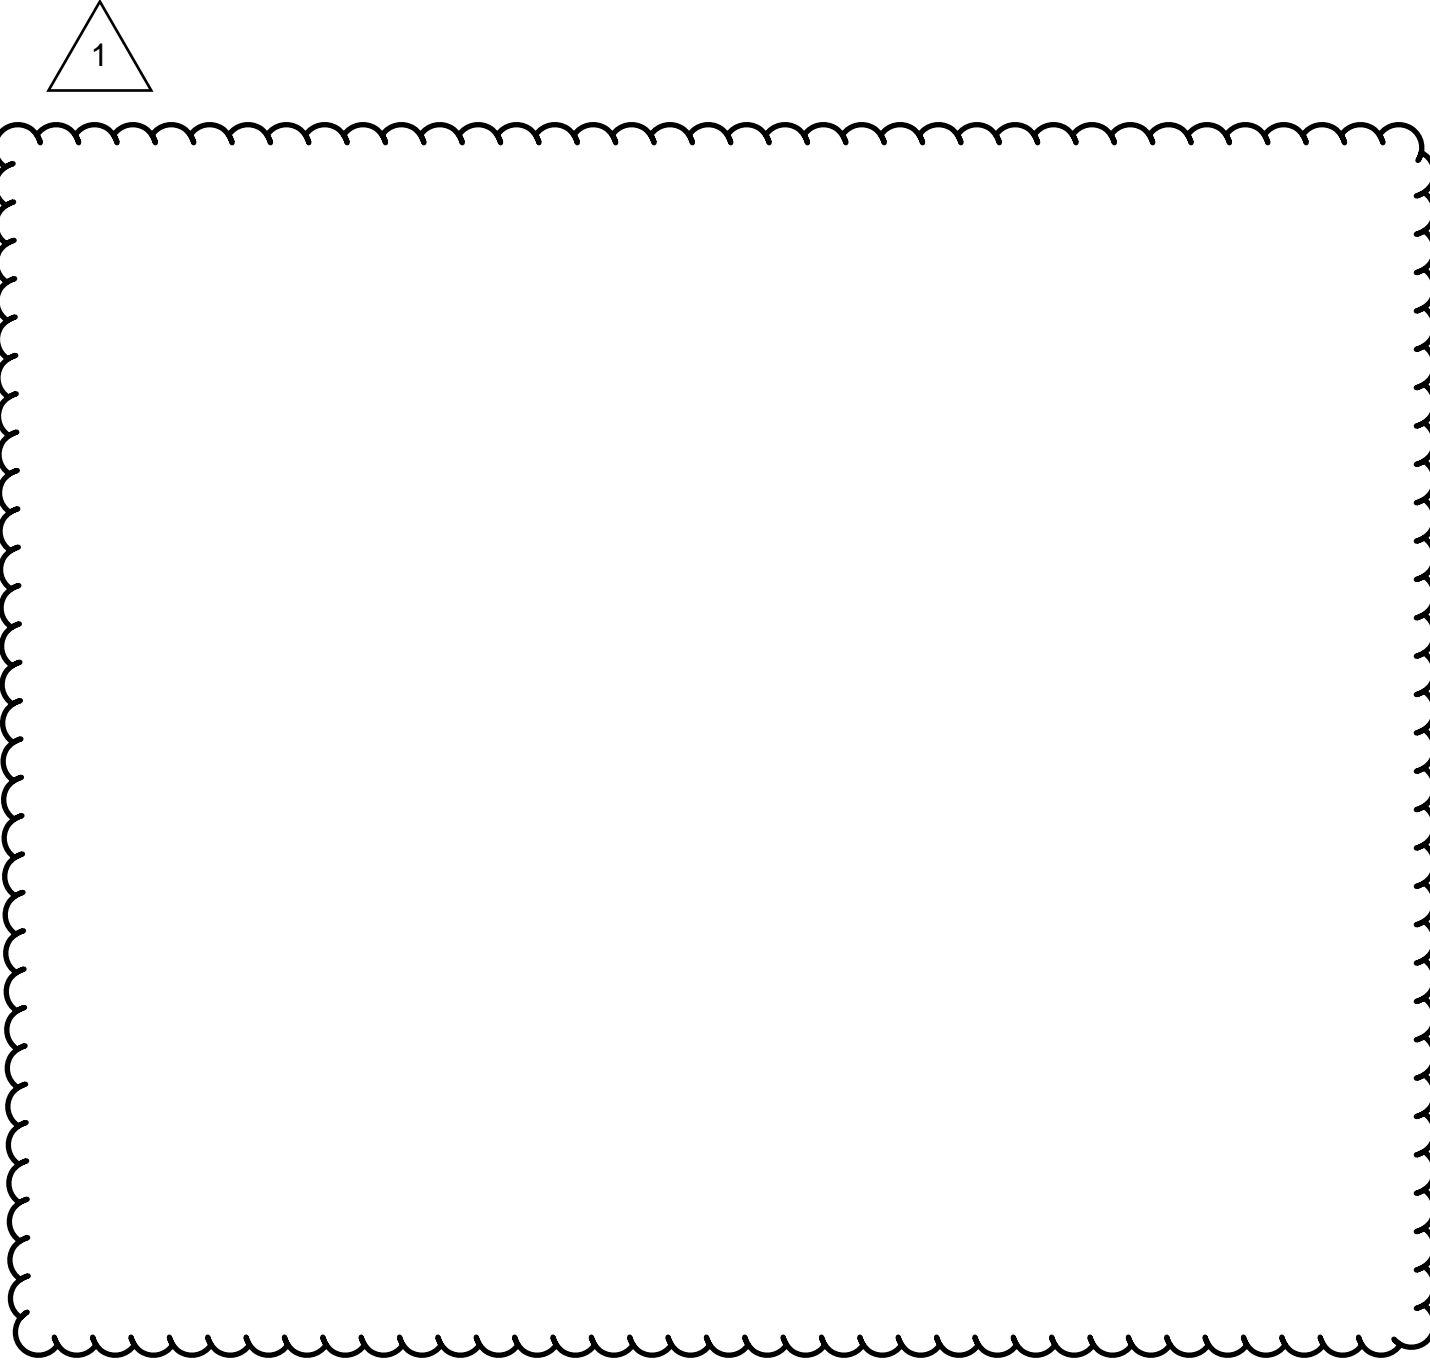

This item has been digitally signed and sealed by Barton J. Fye, P.E. on the date adjacent to the seal.  
 Printed copies of this document are not considered signed and sealed and the signature must be verified on any electronic copies.  
 Date: 11/17/2021

**Sunshine811**  
 Call 811 or [www.sunshine811.com](http://www.sunshine811.com) two full business days before digging to have utilities located and marked.  
 Check positive response codes before you dig!

IRC LANDFILL  
 PREPARED FOR  
 INDIAN RIVER COUNTY  
 INDIAN RIVER COUNTY  
 FL

PAVING, GRADING AND DRAINAGE DETAILS

|             |            |
|-------------|------------|
| KHA PROJECT | 14-3228000 |
| DATE        | JULY 2021  |
| SCALE       | AS SHOWN   |
| DESIGNED BY | MRC        |
| DRAWN BY    | RMR        |
| CHECKED BY  | BF         |

LICENSED PROFESSIONAL

**Kimley-Horn**  
 © 2021 KIMLEY-HORN AND ASSOCIATES, INC.  
 355 ALHAMBRA CIRCLE, SUITE 1400, CORAL GABLES, FL 33134  
 PHONE: 305-673-2025  
 WWW.KIMLEY-HORN.COM    REGISTRY #696

| OWNER CHANGES |           | 11/16/2021 | JF |
|---------------|-----------|------------|----|
| No.           | REVISIONS | DATE       | BY |
|               |           |            |    |
|               |           |            |    |
SHEET NUMBER  
**C-512**



# ROADWAY PAVING, GRADING, AND DRAINAGE

## GENERAL

It is intended that the Florida Department of Transportation "Standard Specifications for Road and Bridge Construction" (latest edition) be used where applicable for various work, and that where such wording therein refers to the State of Florida and its Department of Transportation and personnel, such wording is intended to be replaced with that wording which would provide proper terminology, thereby making such "Standard Specifications for Road and Bridge Construction" as the Standard Specifications for this project.

If within that particular section another section, article or paragraph is referred to, it shall be part of the Standard Specifications also.

All work shall be performed in a workmanlike manner and shall conform with all applicable City, County, State and Federal Regulations and/or Codes. The Contractor shall also be responsible for obtaining all permits and licenses required to begin work.

The Contractor shall give the Engineer 24 hours notice prior to requesting required inspections and shall supply all equipment necessary to properly test and inspect the completed work.

The Contractor shall guarantee all work and materials for a period of one year from the date of project acceptance, during which time all faulty construction and/or materials shall be corrected at the Contractor's expense.

## GENERAL NOTES

The Contractor shall be responsible for protecting all existing above-ground, underground, and on the surface structures and utilities against the construction operation that may cause damage to said facility. The Contractor shall be responsible consequential damages resulting from lack of protection.

The locations of existing underground utilities are shown in an approximate way only and have not been independently verified by the Owner or its representative. The Contractor shall determine the exact location of all existing utilities before commencing work, and agree to be fully responsible for any and all damages which might be occasioned by the Contractor's failure to exactly locate and preserve any and all underground utilities.

The Contractor shall give adequate notification to all affected utility owners for removal, relocation, and alteration of their existing facilities.

Where encountered, unsuitable material shall be removed to a depth and area determined by the Engineer and backfilled with clean granular sand or select material approved by the Engineer. Backfilling shall be in layers not greater than 8" thickness and compacted to 100 percent of the maximum density as determined by AASHTO T-99-C.

Contractor is responsible for checking actual site conditions before starting construction.

Street or highway restoration work is to be done as per local or state agency having jurisdiction.

The Contractor shall comply with all rules and regulations of the State, County and City authorities regarding closing or restricting the use of public streets or highways.

Traffic control on all county and state highway rights-of-way shall meet the requirements of the Manual of Uniform Traffic Control Devices (U.S. DOT/FHA) and the requirements of the state and any local agency having jurisdiction.

## CLEARING AND GRUBBING

All trees, brush, stumps, roots, grass, weeds, rubbish, and other obstructions resting on or lying within 12" below finished grade or subgrade shall be completely removed for the full width of all pavement, swales, utility easements and drainage easements. All work shall be performed in accordance with Section 110 of the Standard Specifications.

## DISTURBED AREAS

All areas disturbed within right-of-way by construction shall be sodded as specified below:

Sodding:

Within the limits delineated in the plans, the Contractor shall, after final grading and cleanup, establish a stand of grass by furnishing and placing sod in accordance with Section 575 of the Standard Specifications. The Contractor shall water the sodded area to maintain moisture levels for optimum growth to assure a healthy stand of grass. Sod shall be Bahia grass sod. Sod shall be rolled and top dressed as required by the engineer.

## GRADING

Contractor shall perform all necessary grading to achieve the typical road sections as per plan. All workmanship shall be in accordance with the Standard Specifications.

## STAKING

If construction staking is performed by the Owner, loss or disturbance of control points due to negligence by the Contractor will be replaced at the Contractor's expense.

## STABILIZING

Stabilized subgrade shall be constructed to the Florida bearing value as per plan for the depth and limits shown on the plan, and in accordance with Section 160 of the Standard Specifications.

All stabilized areas shall be compacted to at least 98% of the maximum density as determined by AASHTO T-180.

## ROCK BASE

Rock base shall be constructed of either limerock material in accordance with Section 911 or cemented coquina shell material in accordance with Section 915 of the Standard Specifications.

Limerock base shall be constructed in accordance with Section 200 and cemented coquina shell base shall be constructed in accordance with Section 230 of the Standard Specifications. Contractor shall provide rock pit certification for cemented coquina shell material.

Rock base shall be constructed to the depth and limits as shown on the plan. The rock base shall be compacted to at least 98% of the maximum density as determined by AASHTO T-180 and shall be primed.

## PRIME AND TACK COAT

Prime and tack coats for the base course shall be in accordance with Section 954.10 of the Indian River County Land Development Regulations and Section 300 of the Standard Specifications.

## ASPHALTIC CONCRETE SURFACE COURSE (ACSC)

Asphaltic Concrete Surface Course (ACSC) shall be constructed for the depth and limits shown on Sheet C-301, and in accordance with Sections 320, 330, and 334 of the Standard Specifications unless otherwise specified.

## SIGNING AND PAVEMENT MARKING

All parking spaces, with the exception of the handicapped parking spaces, shall be marked in white, retro-reflective traffic paint and be in accordance with the Florida Department of Transportation (FDOT) Standard Specifications for Road and Bridge Construction (latest edition).

All handicapped parking spaces shall be properly signed and marked in accordance with FDOT Standard Index 17346 (latest edition).

## TESTING

The Contractor shall retain the services of an Owner approved independent testing laboratory to conduct all required tests on subgrade, base and surface course materials. Test results must be submitted prior to any request for payment on the above items.

The schedule for testing the pavement shall be as follows:

1. Subgrade:
  - a. Florida bearing value test shall be taken at intervals of not more than 200 feet, or closer as may be necessary in the event of variations in subsoil conditions.
  - b. Density tests shall be taken at intervals of not more than 200 feet or closer as may be necessary.
2. Base:
  - a. Density tests shall be taken at intervals of not more than 500 feet or closer as may be necessary.

All testing shall be taken in a staggered sampling pattern from a point 12 inches inside the left edge, to the center, to a point 12 inches inside the right edge of the item tested.


If any test indicates that the work does not meet the specifications, the substandard item shall be reworked or corrected and retested, at the Contractor's expense, until the provisions of these specifications are met.

All passing tests shall be paid for by the Owner. All failing tests shall be paid for by the Contractor.

| RAMP LOCATION           | MINIMUM DIMENSION |     |
|-------------------------|-------------------|-----|
|                         | A                 | B   |
| AT OUTSWING DOOR        | 44"               | 60" |
| AT INSWING/SLIDING DOOR | 44"               | 48" |
| NO DOORWAY              | 36"               | 36" |

### NOTES:

1. ALL ACCESSIBLE COMPONENTS CONSTRUCTED AS PART OF THESE PLANS SHALL COMPLY WITH CHAPTER 11 OF THE FLORIDA BUILDING CODE.
2. ACCESSIBLE ROUTE TO ACCESSIBLE SPACES, BUILDING ENTRANCES, AND PUBLIC STREETS SHALL NOT EXCEED 5% RUNNING SLOPE AND 2% CROSS SLOPE.
3. CHANGE IN ELEVATION WITHIN THE ACCESSIBLE ROUTE IS NOT TO EXCEED 1/2" WITHOUT A CURB RAMP.
4. UNLESS OTHERWISE SHOWN ON THE PLANS, THE MINIMUM CLEAR ROUTE SHALL BE 36" WIDE WITH A 60"x60" PASSING SPACE EVERY 200 FEET.
5. ACCESSIBLE ROUTES THROUGH PLANTERS SHALL BE LEVEL WITH THE SURROUNDING PAVEMENT OR PROVIDE CURB RAMP AT EACH END WITH A MINIMUM 48" LEVEL LANDING IN BETWEEN.
6. THE ACCESSIBLE ROUTE IN FRONT OF PULL-IN PARKING SHALL BE A MINIMUM OF 44" WIDE AND NOT REDUCED BY VEHICLE OVERHANGS, CURBING, SIGN POSTS, OR OTHER OBSTRUCTIONS.
7. ANY WALK THAT CROSSES OR ADJOINS A VEHICULAR WAY NOT SEPARATED BY CURBS, RAILINGS, OR OTHER ELEMENTS SHALL BE DEFINED BY A CONTINUOUS 36" WIDE DETECTABLE WARNING.
8. SPECIAL RAMP RULES APPLY FOR ANY RISE GREATER THAN 6" INCLUDING BUT NOT LIMITED TO RESTRICTION ON SLOPE, TOTAL RISE BETWEEN LANDINGS, AND USE OF HANDRAILS, PER F.B.C. 11-4.8.
9. PUBLIC SIDEWALK CURB RAMPS CONSTRUCTED WITHIN A PUBLIC RIGHT-OF-WAY, IN ABSENCE OF LOCAL ROADWAY GUIDELINES, SHALL MEET THE REQUIREMENTS OF F.D.O.T INDEX 304.
10. CURB RAMPS SHALL HAVE A DETECTABLE WARNING EXTENDING THE FULL WIDTH AND DEPTH OF THE RAMP.
11. DETECTABLE WARNINGS SHALL CONSIST OF EXPOSED AGGREGATE CONCRETE, CUSHIONED SURFACES MADE OF RUBBER OR PLASTIC, OR RAISED STRIPS. GROOVED SURFACES ON OUTDOOR CURB RAMPS ARE NOT PERMITTED. VERIFY LOCAL REQUIREMENTS WITH THE BUILDING DEPARTMENT.

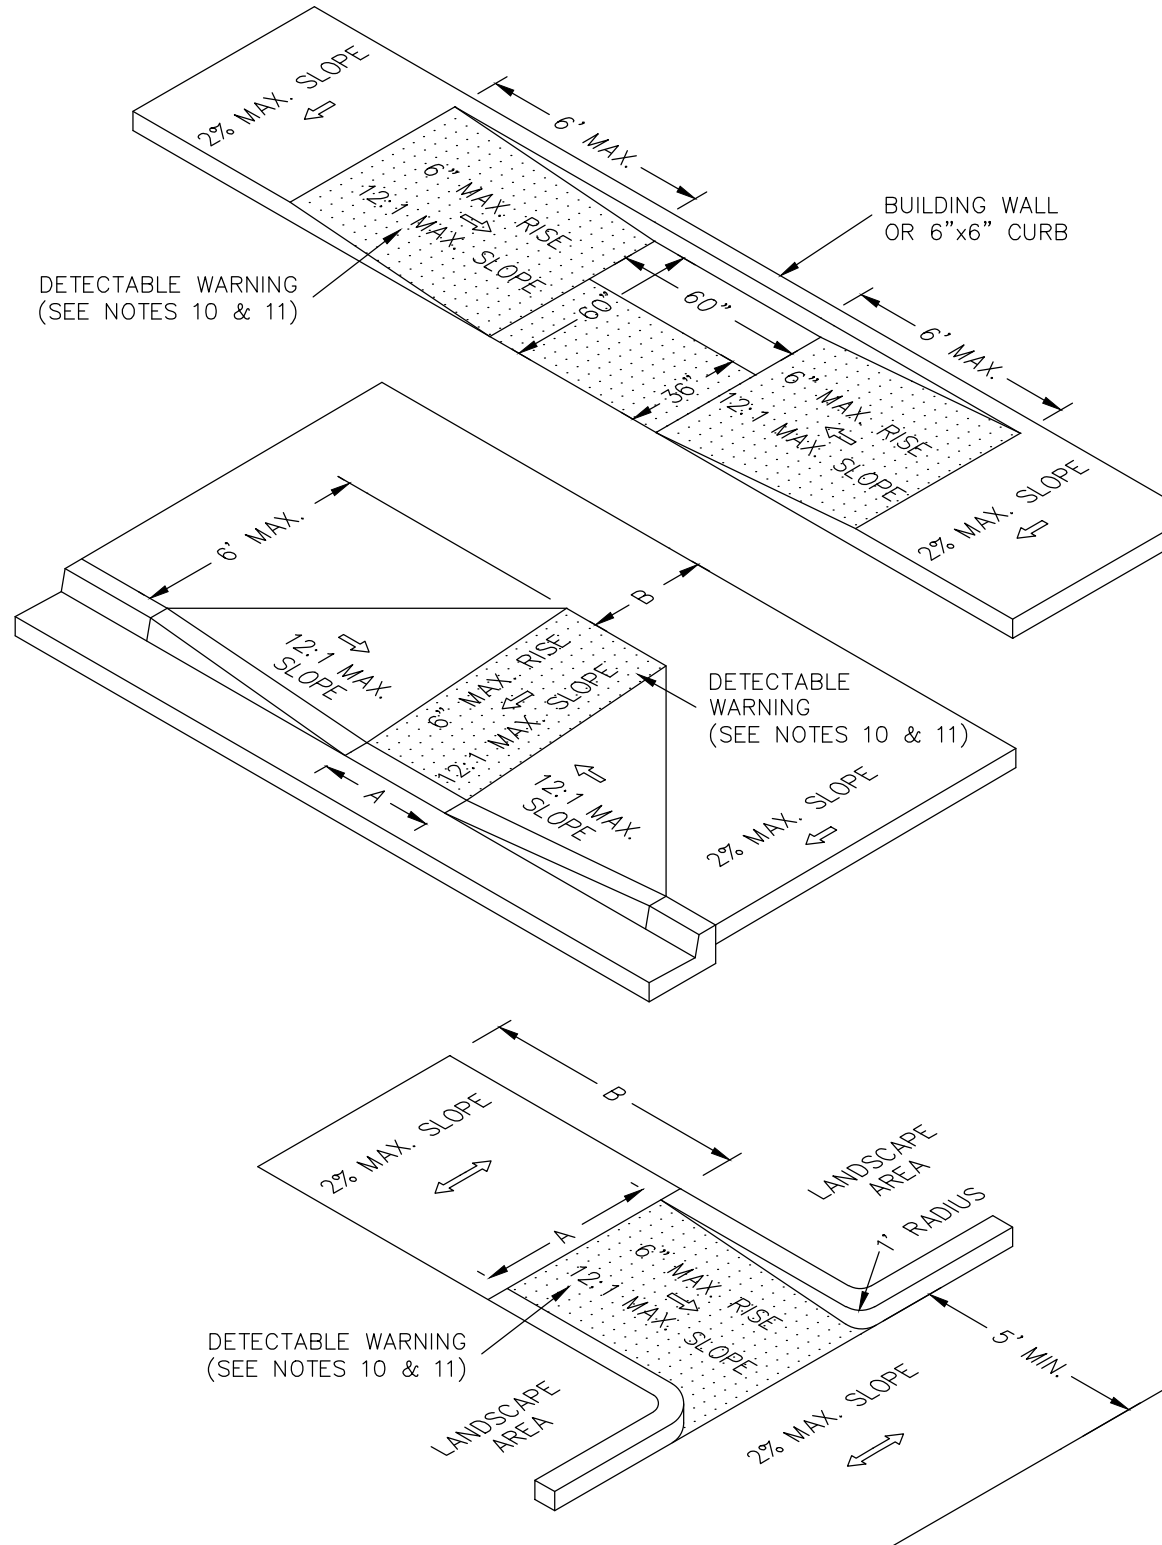

## ACCESSIBLE RAMPS

N.T.S.

## CLEAN-UP

The Contractor must provide clean-up of excess construction material upon completion of the project. The site must be left in a neat, clean, graded condition.

## DRAINAGE SPECIFICATIONS

Storm inlets and manholes shall be constructed in general accordance with Section 425 of the Standard Specifications.

All reinforcing steel to be ASTM A 615 (latest revision) Grade 40 Fyp=40,000 PSI, and shall be handled and placed in accordance with ACI 318 (latest revision).

Precast concrete manholes and storm inlets to be used (only after the Engineer's review of the manufacturer's shop drawings).

Storm sewer construction shall in accordance with Section 430 and related sections of the Standard Specifications.

## CONCRETE

Unless otherwise specified or indicated, all concrete shall have a minimum compressive strength at 28 days of 3000 psi. All work shall comply with the current edition of the American Concrete Institute (ACI) building code and the applicable building codes having jurisdiction in the area.

## PRECAST INLETS

All storm inlets shall be precast reinforced concrete in accordance with the details shown herein the project details. Type II Portland Cement shall be used in the concrete mix. Concrete shall have a minimum compressive strength at 28 days of 4000 psi.

## CULVERT PIPES

Reinforced Concrete Pipe (RCP) shall be in accordance with Section 449 of the Standard Specifications.

Corrugated Aluminum Pipe (CAP) shall be in accordance with Section 945 the Standard Specifications.

High density polyethylene pipe (HDPE) shall be in accordance with Section 948 of the Standard Specs.

## CONSTRUCTION OBSERVATION

The Contractor shall notify the Engineer prior to periods of the following construction activities so that the Engineer can notify the County or State to be present for construction observations:

- I. Drainage
  - A. Laying of Pipe (before backfill)
  - B. All drainage structures and pipe laying completed
  - C. Construction and stabilization of retention areas and swales
  - D. Seeding, mulch, and sodding in areas where erosion is evident or where plans so identify
- II. Utilities (U-2 permits or development order)
  - A. Pipe laying within County or State rights-of-way
  - B. Jack and boring in County or State rights-of-way
  - C. Restoration of all rights-of-way
- III. Concrete
  - A. Completion of forming for curbing, sidewalk, and retaining walls before placement of concrete
- IV. Pavement
  - A. Line and grade (Certification)
  - B. Sub-base (prior to adding base material)
  - C. Base (prior to priming and sand seal)
  - D. Base (after priming, sand seal, and before placing asphalt)
  - E. Asphalt or concrete (while paving is in progress)
  - F. Turn out construction on to County or State road (above inspections apply)
  - G. Test results on sub-base
  - H. Final project observation

## INSPECTION AND TESTING

Lamping of the completed sewer system will be performed after complete backfilling and the laying of the roadway base. The lamping will determine that the lines have been laid to accurate line and grade. At the time of lamping, the line shall be clean and dry. A final inspection will be held after roadway is completed to verify that the system has not been damaged. All line appearances not meeting specifications or reasonable standards shall be repaired or replaced.


The Engineer may require a color T.V. survey and may require an exfiltration/infiltration test prior to acceptance. The survey and testing shall be at the Contractor's expense.

### INSPECTIONS:

- The Contractor shall notify the engineer of record at least 48 hours prior to beginning construction and prior to the inspection of the following items:
- 1.) Storm Drainage
  - 2.) Sanitary Sewer
  - 3.) Water System
  - 4.) Subgrade - Submit and have approved densities prior to placement of rock.
  - 5.) Limerock Base - have approved densities and as-builts prior to the placement of asphalt.
  - 6.) Asphaltic Concrete
  - 7.) Final walk-through Inspection

## RECORD DRAWINGS

The Contractor shall maintain Record Drawings on the project site at all times which shall be annotated by the Contractor depicting any changes made in the field which differ from the contract drawings. Record Drawings shall include, but not be limited to, culvert lengths, invert and top elevations of storm sewer, manholes, inlets, and control structures. The Contractor shall submit complete and final Record Drawings in AutoCAD to the Engineer upon completion of the project and prior to final inspection and final payment. Record Drawings shall be certified by the Contractors, Engineer, or Surveyor registered in the State of Florida

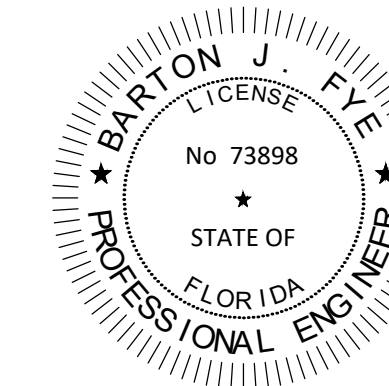

This item has been digitally signed and sealed by Barton J. Fye, P.E. on the date adjacent to the seal.

Printed copies of this document are not considered signed and sealed and the signature must be verified on any electronic copies.

Date: 11/17/2021



Call 811 or www.sunshine811.com two full business days before digging to have utilities located and marked.

Check positive response codes before you dig!

**Kimley»Horn**  
 © 2021 KIMLEY-HORN AND ASSOCIATES, INC.  
 355 ALHAMBRA CIRCLE, SUITE 1400, CORAL GABLES, FL 33134  
 PHONE: 305-673-2025  
 WWW.KIMLEY-HORN.COM REGISTRY 696


|                           |                       |
|---------------------------|-----------------------|
| KHA PROJECT<br>14-3228000 | LICENSED PROFESSIONAL |
|                           | DATE<br>JULY 2021     |
| SCALE AS SHOWN            | DESIGNED BY MRC       |
| DRAWN BY RMR              | CHECKED BY BF         |
|                           | DATE:                 |

**PAVING, GRADING AND DRAINAGE DETAILS II**


**IRC LANDFILL PREPARED FOR INDIAN RIVER COUNTY**

SHEET NUMBER  
**C-513**


Plotted By: Rebecca, Sheet Set: IRC LANDFILL, Layout: C-513 PAVING, GRADING AND DRAINAGE DETAILS II, November 17, 2021, 10:42:03am, K:\mbs-civil\143228000 - irc hhw and recycling facility\civil\CADD\plansheets\C-514 PAVING, GRADING AND DRAINAGE DETAILS III.dwg  
 This document, together with the concepts and designs presented herein, is intended only for the specific purpose and client for which it was prepared. Reuse or improper reliance on this document without written authorization and adaptation by Kimley-Horn and Associates, Inc. shall be without liability to Kimley-Horn and Associates, Inc.

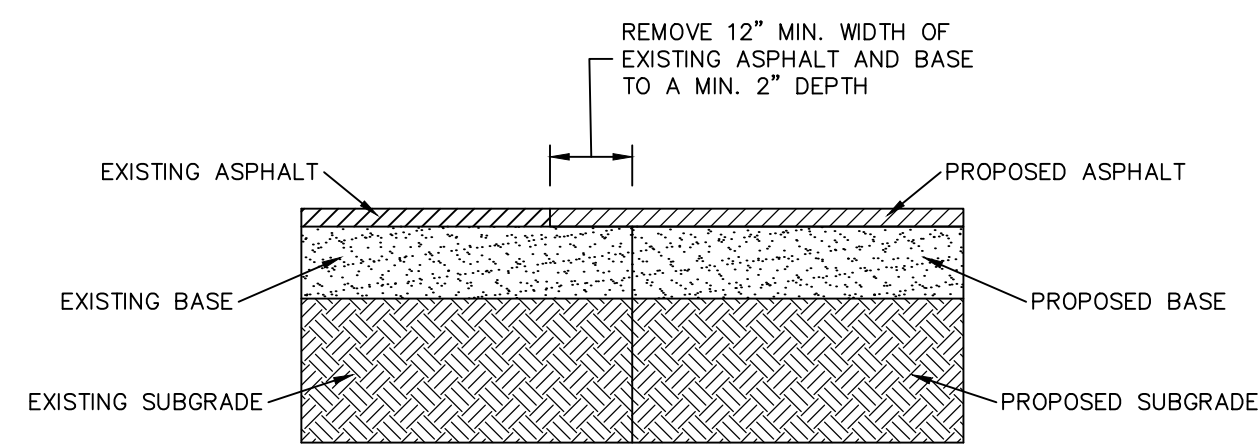


**SAW-CUT**  
N.T.S.

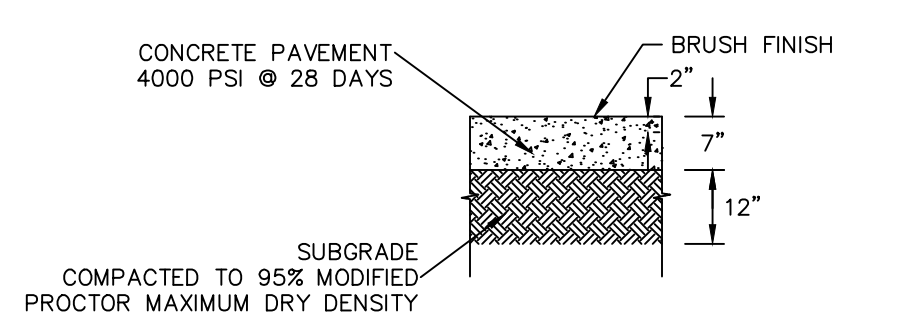


**HEAVY DUTY CONCRETE**  
N.T.S.

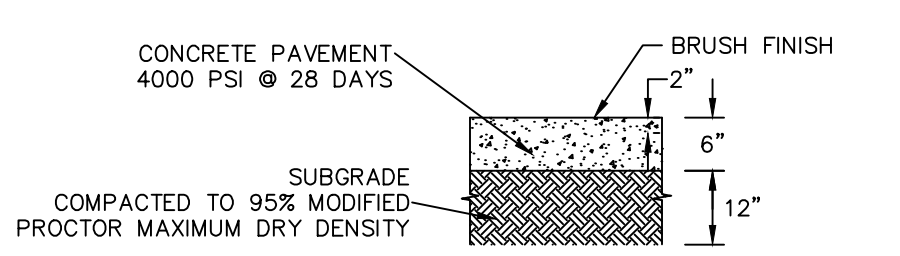

**STANDARD DUTY CONCRETE**  
N.T.S.

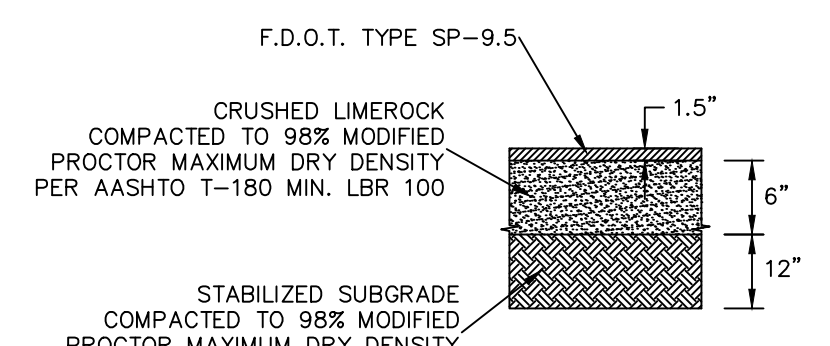


**STANDARD DUTY ASPHALT**  
N.T.S.

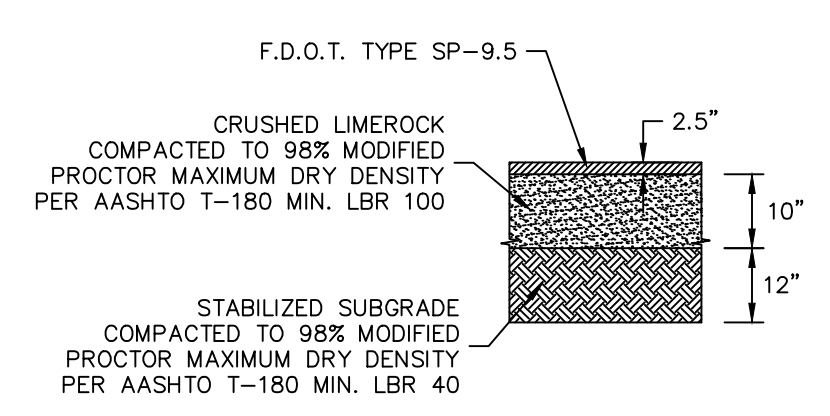


**HEAVY DUTY ASPHALT**  
N.T.S.

**PAVEMENT NOTES:**


- CONTRACTOR TO REFER TO THE GEOTECHNICAL REPORT FOR SITE WORK SPECIFICATIONS.
- CORE WEARING SURFACE OF ASPHALT PAVEMENT TO EVALUATE MATERIAL THICKNESS AND COMPOSITION AT A MINIMUM FREQUENCY OF 3,000 SF OR TWO LOCATIONS PER DAY'S PRODUCTION.
- MATERIALS USED IN PAVEMENT CONSTRUCTION SHALL COMPLY WITH FDOT STANDARD SPECIFICATIONS FOR ROAD AND BRIDGE CONSTRUCTION, LATEST EDITION.
- COMPACTION AND TESTING SHALL BE PER SECTION 13 OF THE GEOTECHNICAL REPORT.
- ALL PARKING LOT SUBGRADE SOILS SHALL BE COMPACTED TO AT LEAST 95% OF THE MODIFIED PROCTOR - MAX DRY DENSITY (ASTM D 1557) TO A DEPTH AT LEAST 2' BELOW BOTTOM OF BASE, OR THE FULL DEPTH OF NEW FILL AND THE TOP 12 INCHES OF EXISTING SUBGRADE SOILS, WHICHEVER IS GREATER.

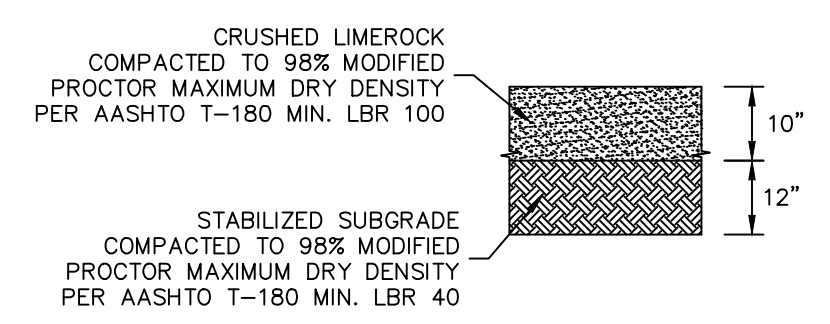


**GRAVEL ROAD DETAIL**  
N.T.S.

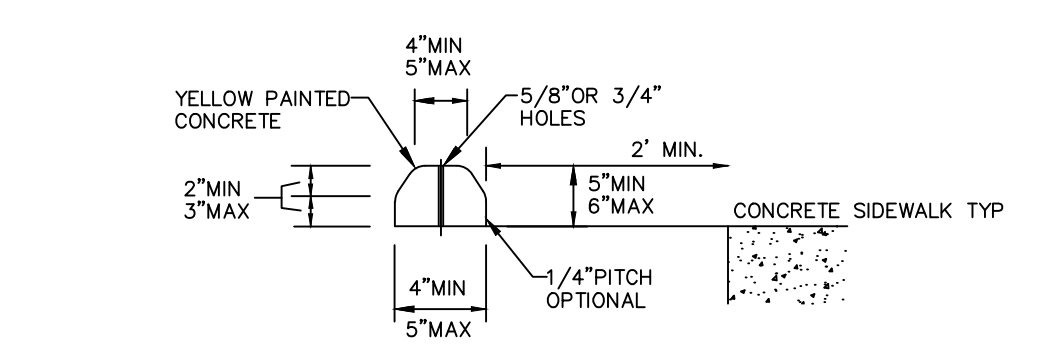

**CONCRETE WHEEL STOP**  
N.T.S.

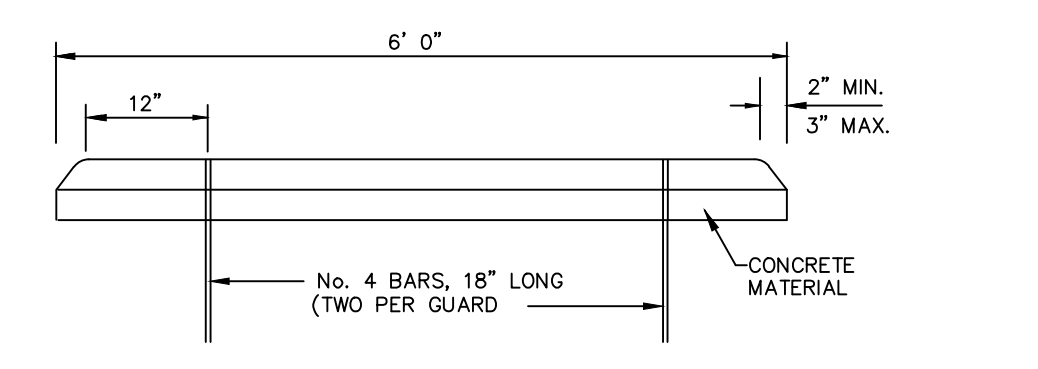


WHEEL STOPS SHALL BE DEPARTMENT OF TRANSPORTATION CLASS "1" CONCRETE, WITH A COMPRESSIVE STRENGTH OF 3,000 PSI.

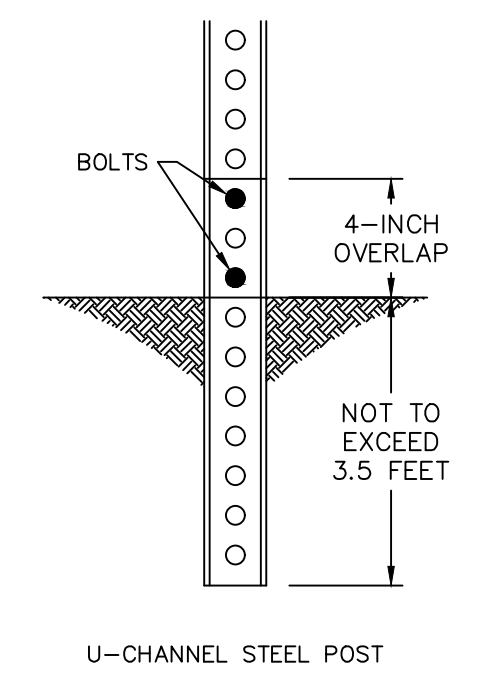

**SIGN POST**  
N.T.S.


**NOTE:**

- THE U-CHANNEL ROLLED, MILD, CARBON STEEL POST WILL BEND, BREAK, OR PULL OUT OF THE GROUND WHEN IT IS HIT.
- THE POST SHOULD BE DRIVEN INTO THE GROUND AND NOT ENCASED IN CONCRETE. DRIVE POSTS INTO THE GROUND NO MORE THAN 3.5 FEET TO MAKE IT EASIER TO PULL OUT DAMAGED POSTS.
- SPLICES CAN BE PURCHASED COMMERCIALY TO INSTALL AT GROUND LEVEL. THEY ALLOW THE POST TO BREAK OFF ON IMPACT. THESE DEVICES IMPROVE SAFETY WHEN THE POST IS HIT AND WILL MAKE REPAIR EASIER.

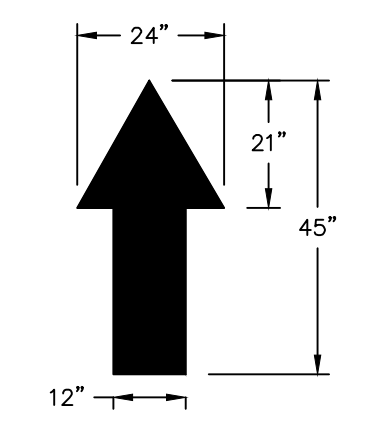


**NOTE:** ALL TRAFFIC FLOW ARROWS TO BE 90 MIL EXTRUDED THERMOPLASTIC.

**ON-SITE TRAFFIC FLOW ARROW**  
N.T.S.

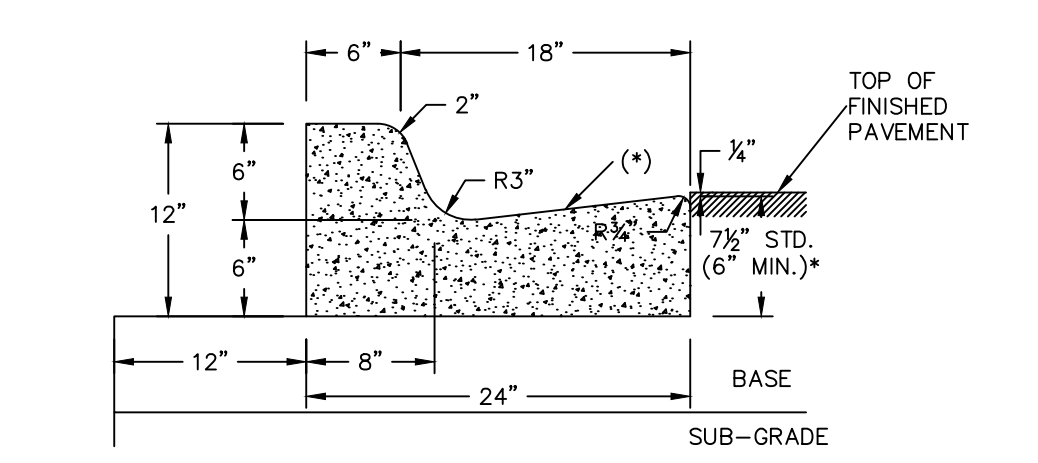


**TYPE "F" CURB AND GUTTER**  
N.T.S.


\* WHEN USED ON HIGH SIDE OF ROADWAYS, THE CROSS SLOPE OF THE GUTTER SHALL MATCH THE CROSS SLOPE OF THE ADJACENT PAVEMENT AND THE THICKNESS OF THE LIP SHALL BE 6" UNLESS OTHERWISE SHOWN ON THE PLANS. ASPHALT SURFACE ON HIGH SIDE TO BE FLUSH WITH TOP OF CURB OR CURB & GUTTER.

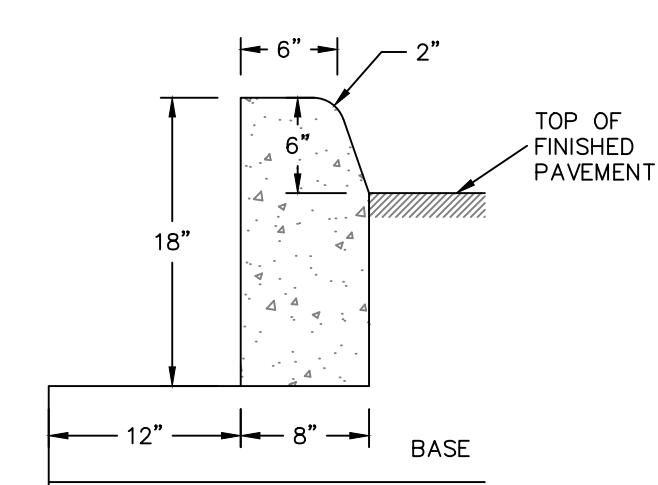

**TYPE "D" CURB**  
N.T.S.



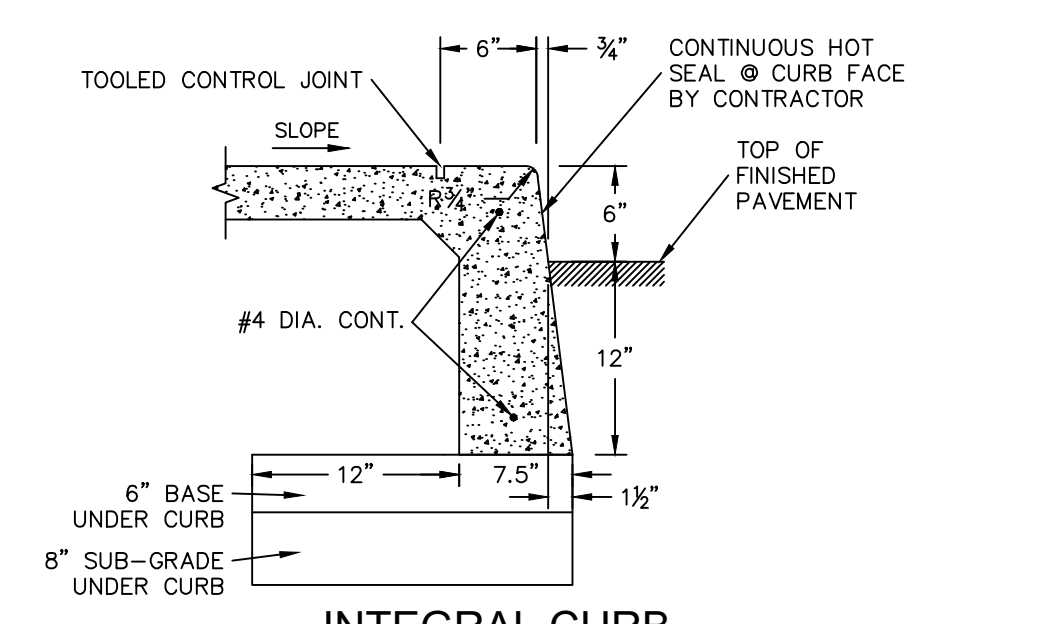


**INTEGRAL CURB**  
N.T.S.

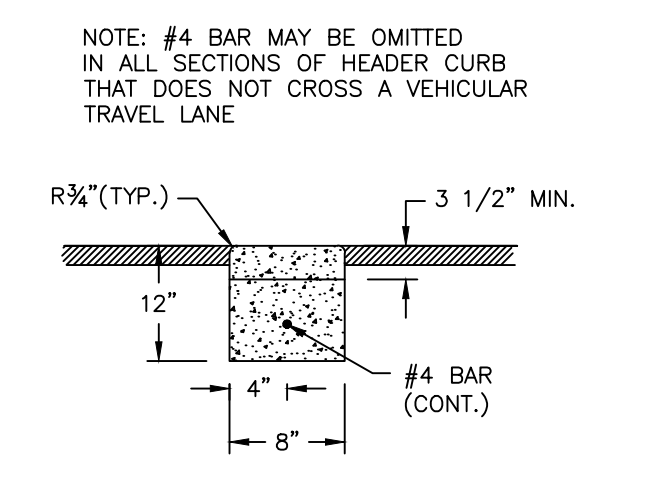


**FLUSH HEADER CURB**  
N.T.S.

**NOTE:** #4 BAR MAY BE OMITTED IN ALL SECTIONS OF HEADER CURB THAT DOES NOT CROSS A VEHICULAR TRAVEL LANE

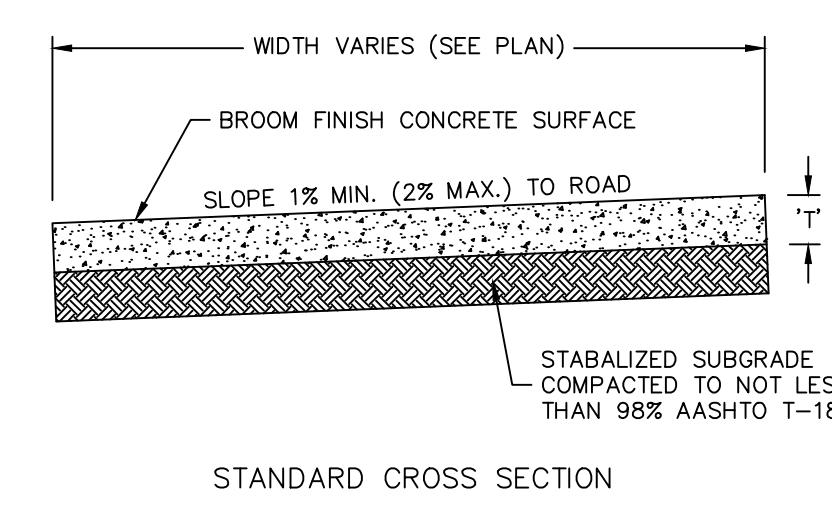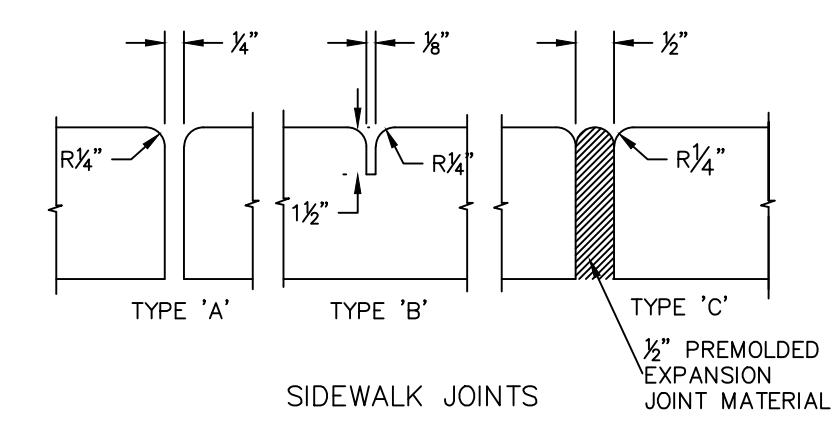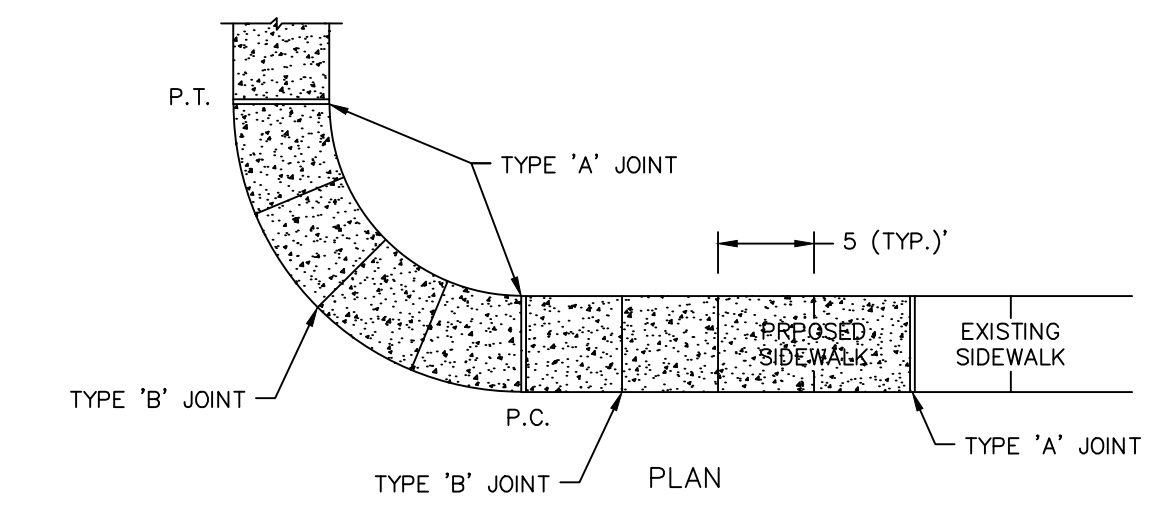


**STANDARD CROSS SECTION**

**CONCRETE SIDEWALK**  
N.T.S.

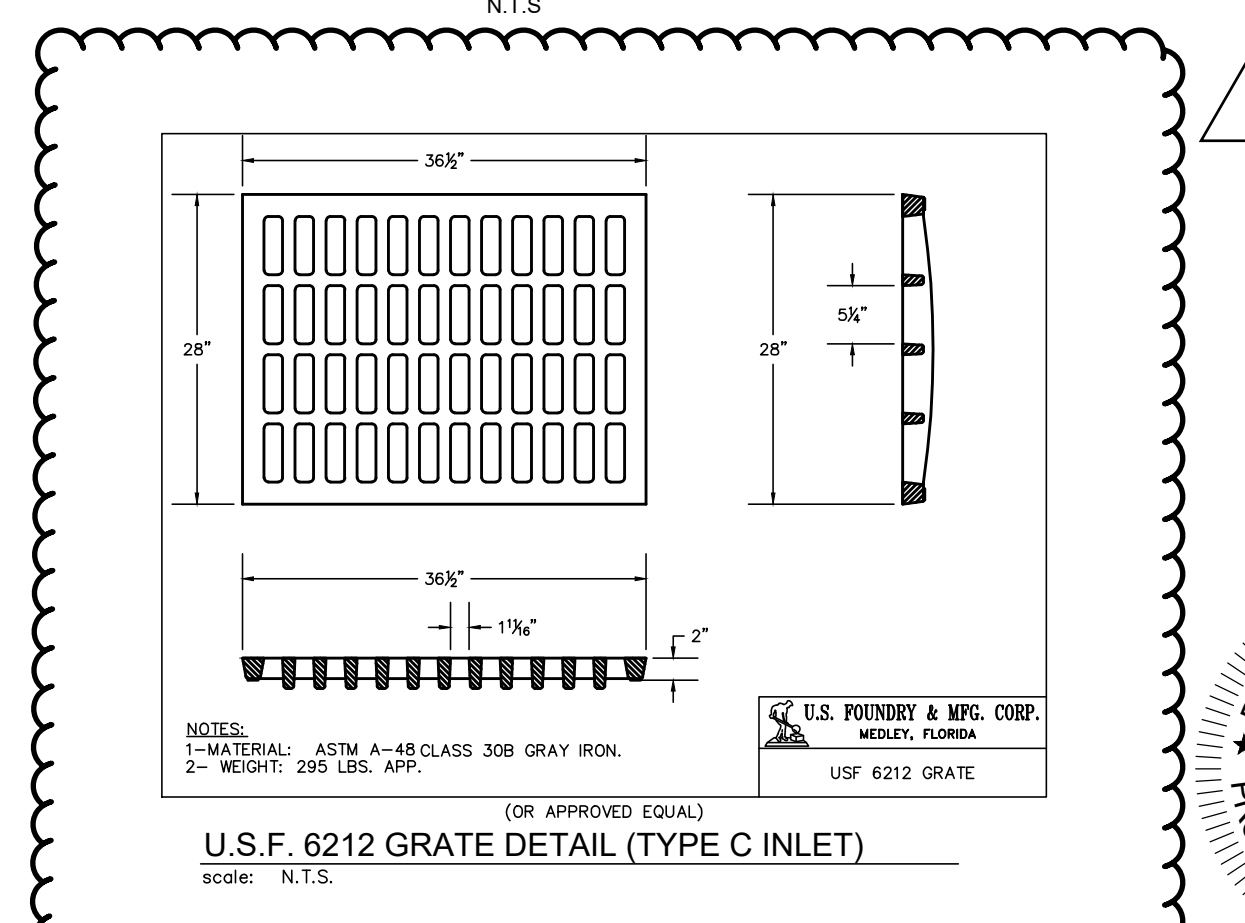


**U.S.F. 6212 GRATE DETAIL (TYPE C INLET)**  
scale: N.T.S.


**NOTES:**  
1-MATERIAL: ASTM A-48 CLASS 30B GRAY IRON.  
2-WEIGHT: 295 LBS. APP.  
(OR APPROVED EQUAL)  
U.S. FOUNDRY & MFG. CORP. WELBY, FLORIDA USF 6212 GRATE

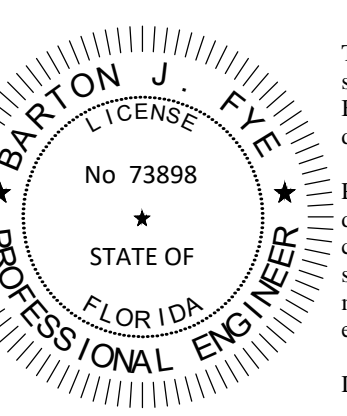


This item has been digitally signed and sealed by Barton J. Fye, P.E. on the date adjacent to the seal.  
Printed copies of this document are not considered signed and sealed and the signature must be verified on any electronic copies.  
Date: 11/17/2021

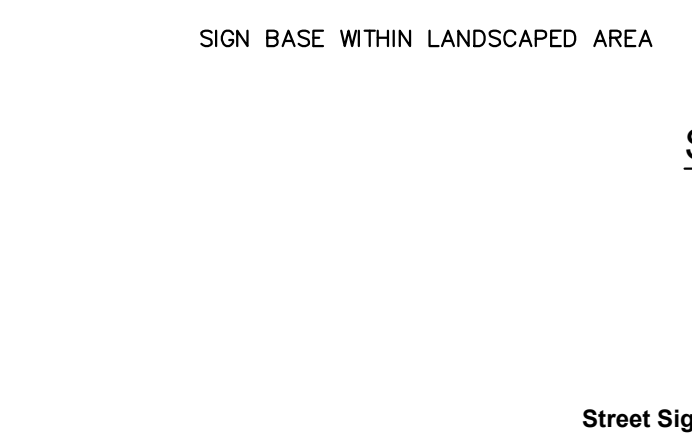


**SIGN BASE**  
N.T.S.

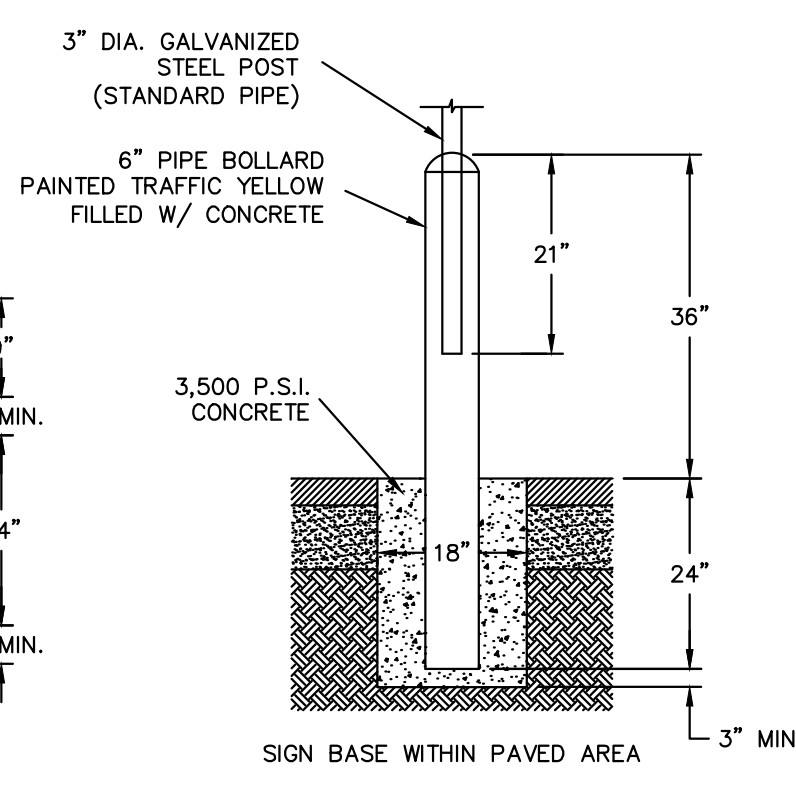

**NOTE:** SIGNS INSTALLED WITHIN SIDEWALKS SHALL BE SET DIRECTLY IN THE CONCRETE AND SHALL UTILIZE A 3" DIAMETER SIGN POST PER THE SPECIFICATIONS.

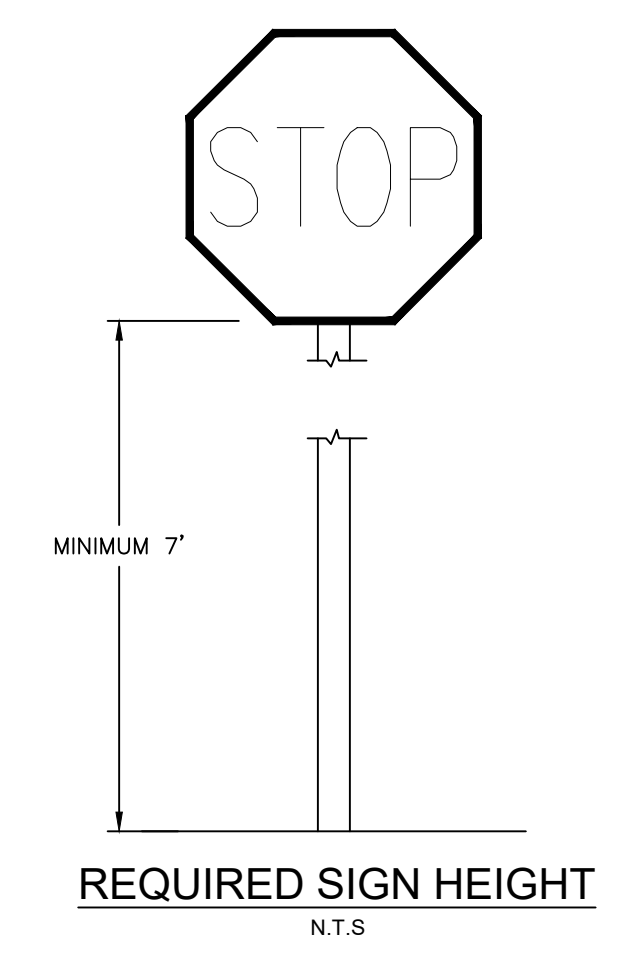

**ACCESSIBLE PARKING SIGN**  
N.T.S.

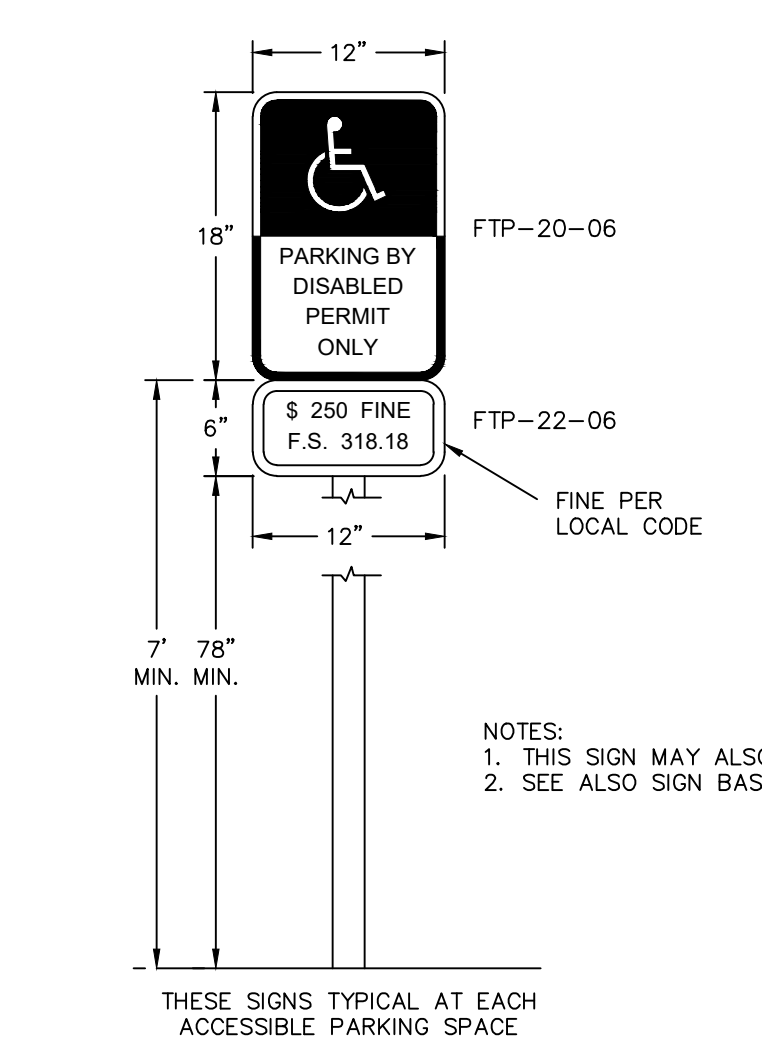

**NOTES:**  
1. THIS SIGN MAY ALSO BE WALL MOUNTED  
2. SEE ALSO SIGN BASE DETAILS

| TABLE OF SIDEWALK JOINTS |   |
|--------------------------|---|
| TYPE                     | LOCATION  |
| 'A'                      | 100' MAX. SPACING, P.C./P.T. OF CURVES, JUNCTION OF EXISTING AND NEW SIDEWALKS. |
| 'B'                      | 5'-0" CENTER TO CENTER  |
| 'C'                      | WHERE SIDEWALK ABUTS CONCRETE CURBS, DRIVEWAYS AND SIMILAR STRUCTURES.          |

| TABLE OF SIDEWALK THICKNESS       |           |
|-----------------------------------|-----------|
| LOCATION                          | THICKNESS |
| PEDESTRIAN ONLY AREAS             | 4"        |
| DRIVEWAYS AND OTHER TRAFFIC AREAS | 6"        |

**NOTE:**

- ALL SIDEWALK STREET CROSSINGS MUST MEET THE REQUIREMENTS OF THE AMERICAN DISABILITIES ACT (ADA) COMPLIANCE GUIDE. TRANSITIONS FROM RAMPS TO WALKS, GUTTERS, OR STREETS SHALL BE FLUSH AND FREE OF ABRUPT CHANGES.
- SIDEWALK CONCRETE CONTAIN FIBERGLASS REINFORCEMENT.

**Sign Legend:**

- TYPICAL 30° STOP SIGN
- DO NOT ENTER SIGN
- PEDESTRIANS SIGN
- DOWNWARD ARROW
- NARROW KEEP RIGHT SIGN

**STREET SIGN DETAILS**  
N.T.S.



Call 811 or www.sunshine811.com two full business days before digging to have utilities located and marked.  
Check positive response codes before you dig!

| NO. | REVISIONS | DATE | BY |
|-----|-----------|------|----|
|     |           |      |    |

**Kimley-Horn**  
© 2021 KIMLEY-HORN AND ASSOCIATES, INC.  
355 ALHAMBRA CIRCLE, SUITE 1400, CORAL GABLES, FL 33134  
PHONE: 305-673-2025  
WWW.KIMLEY-HORN.COM REGISTRY 696

| LICENSED PROFESSIONAL  |                 |
|------------------------|-----------------|
| KHA PROJECT 14-3228000 | DATE JULY 2021  |
| SCALE AS SHOWN         | DESIGNED BY MRC |
| DRAWN BY RMR           | CHECKED BY BF   |



**PAVING, GRADING AND DRAINAGE DETAILS III**

**IRC LANDFILL PREPARED FOR INDIAN RIVER COUNTY**

SHEET NUMBER **C-514**

Plotted By: Rodriguez, Rebecca - Sheet Set: IRC LANDFILL - Layout: C-515 PAVING, GRADING AND DRAINAGE DETAILS IV - November 17, 2021 - 10:42:10am - K:\vmb-e\civil\43228000 - Fc hhw and recycling facility\CIVIL\CADD\plan sheets\C-515 PAVING, GRADING AND DRAINAGE DETAILS IV.dwg  
 This document, together with the concepts and designs presented herein, as an instrument of service, is intended only for the specific purpose and client for which it was prepared. Reuse of and improper reliance on this document without written authorization and adaptation by Kimley-Horn and Associates, Inc. shall be without liability to Kimley-Horn and Associates, Inc.

1

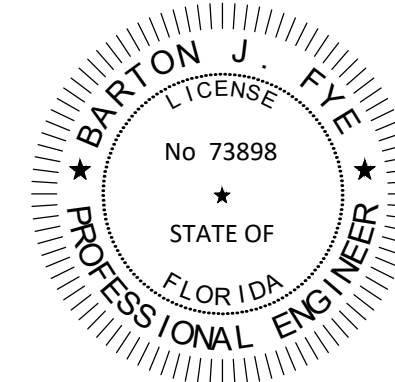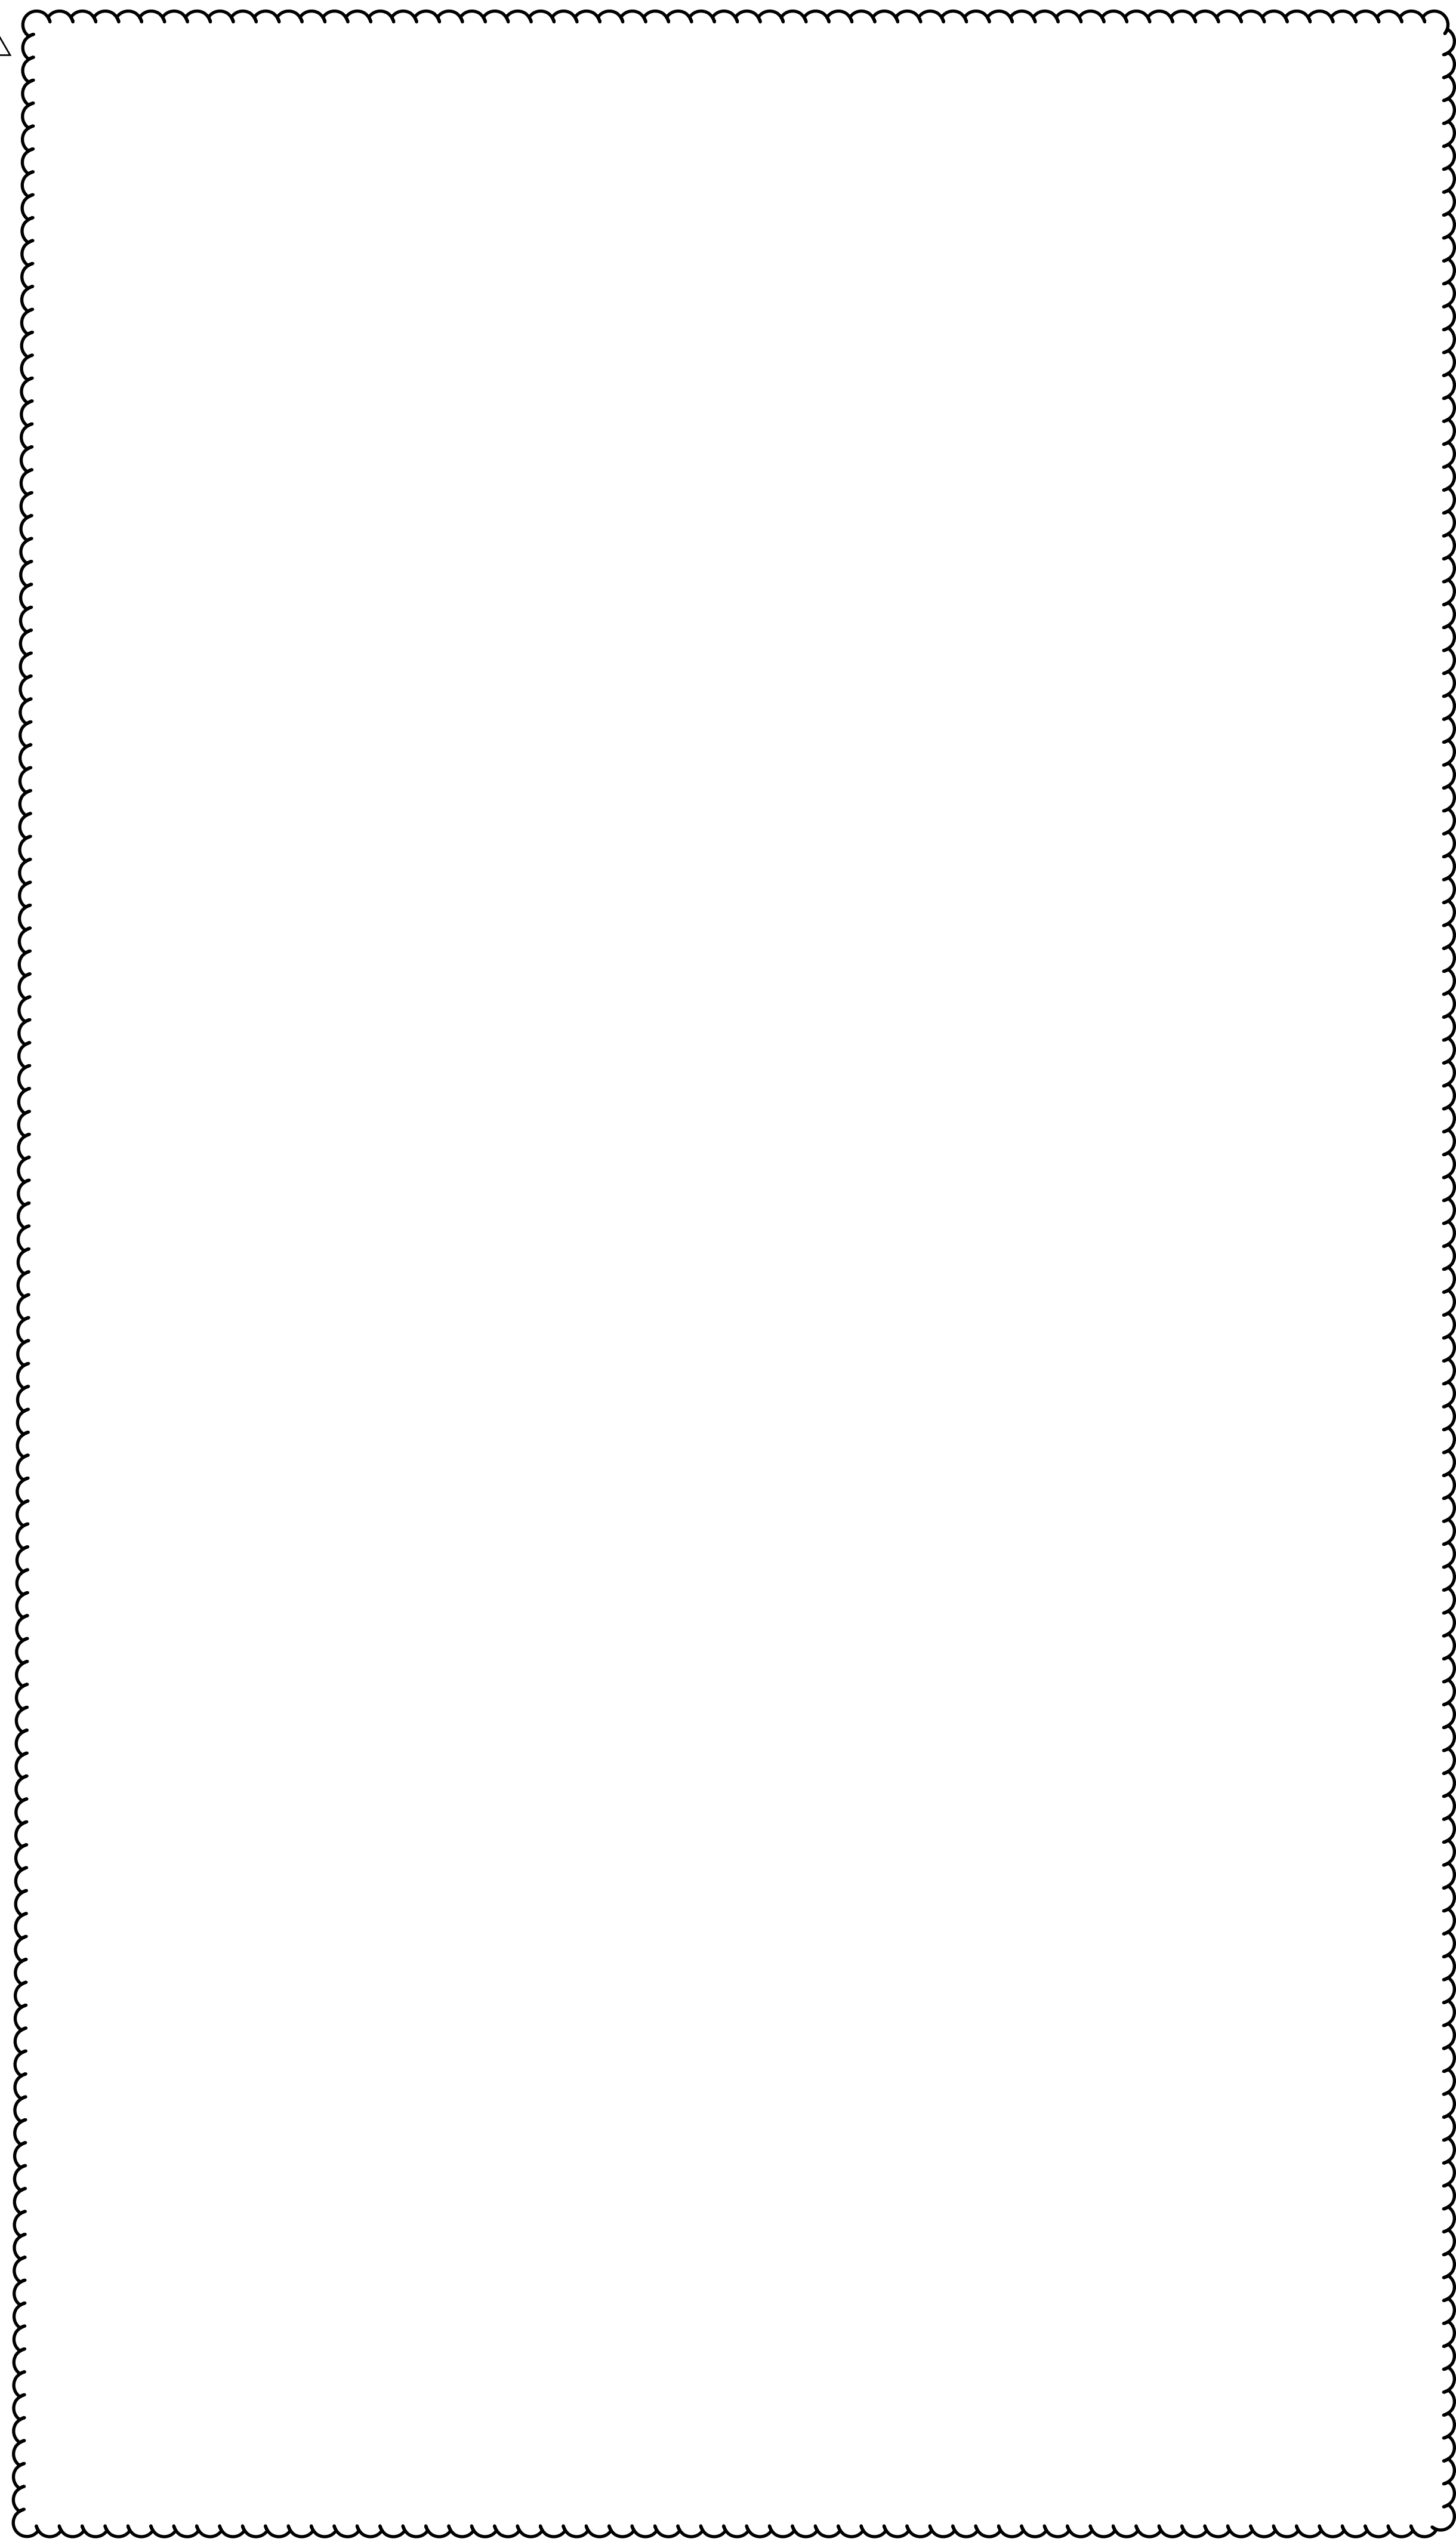

This item has been digitally signed and sealed by Barton J. Fye, P.E. on the date adjacent to the seal.  
 Printed copies of this document are not considered signed and sealed and the signature must be verified on any electronic copies.  
 Date: 11/17/2021

**Sunshine811**  
 Call 811 or www.sunshine811.com two full business days before digging to have utilities located and marked.  
 Check positive response codes before you dig!

IRC LANDFILL  
 PREPARED FOR  
 INDIAN RIVER COUNTY  
 INDIAN RIVER COUNTY  
 FL

PAVING, GRADING  
 AND DRAINAGE  
 DETAILS IV

KHA PROJECT  
 14-3228000  
 DATE  
 JULY 2021  
 SCALE AS SHOWN  
 DESIGNED BY MRC  
 DRAWN BY RMR  
 CHECKED BY BF








LICENSED PROFESSIONAL  
 \_\_\_\_\_  
 DATE:

**Kimley»Horn**  
 © 2021 KIMLEY-HORN AND ASSOCIATES, INC.  
 355 ALHAMBRA CIRCLE, SUITE 1400, CORAL GABLES, FL 33134  
 PHONE: 305-673-2025  
 WWW.KIMLEY-HORN.COM REGISTRY 696

| OWNER CHANGES |           | 11/16/2021 | JF |
|---------------|-----------|------------|----|
| No.           | REVISIONS | DATE       | BY |
|               |           |            |    |
|               |           |            |    |
SHEET NUMBER  
**C-515**

Plotted By: Rodriguez, Rebecca - Sheet Set: IRC LANDFILL - Layout: C-520 RETENTION AREAS CROSS SECTION - November 17, 2021 - 10:42:18am - K:\vmb-civil\43228000 - irc-landfill-recycling-facility\civil\cadd\plansheets\C-521 RETENTION AREAS CROSS SECTION.dwg  
 This document, together with the concepts and designs presented herein, is intended only for the specific purpose and client for which it was prepared. Reuse of and improper reliance on this document without written authorization and adaptation by Kimley-Horn and Associates, Inc. shall be without liability to Kimley-Horn and Associates, Inc.

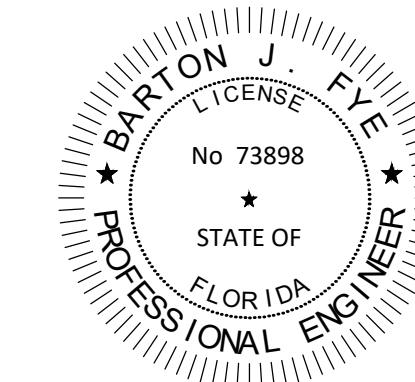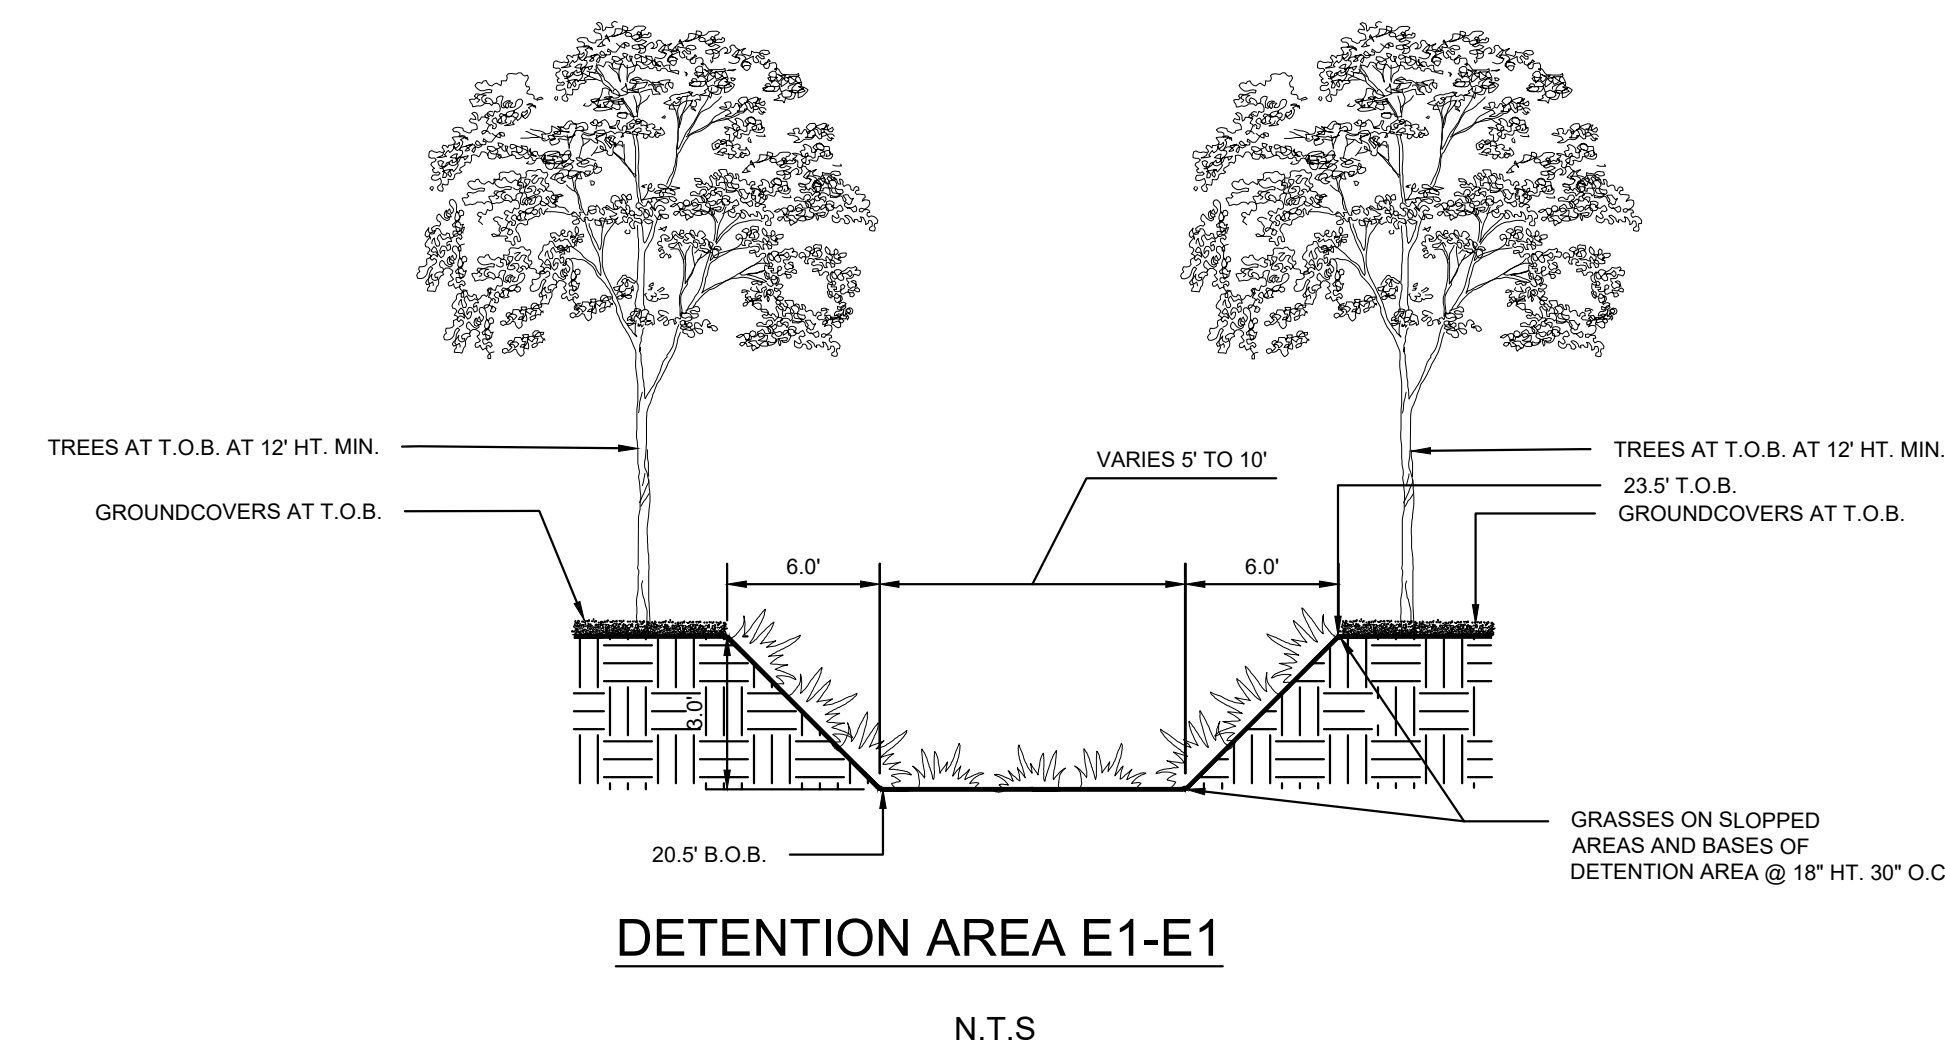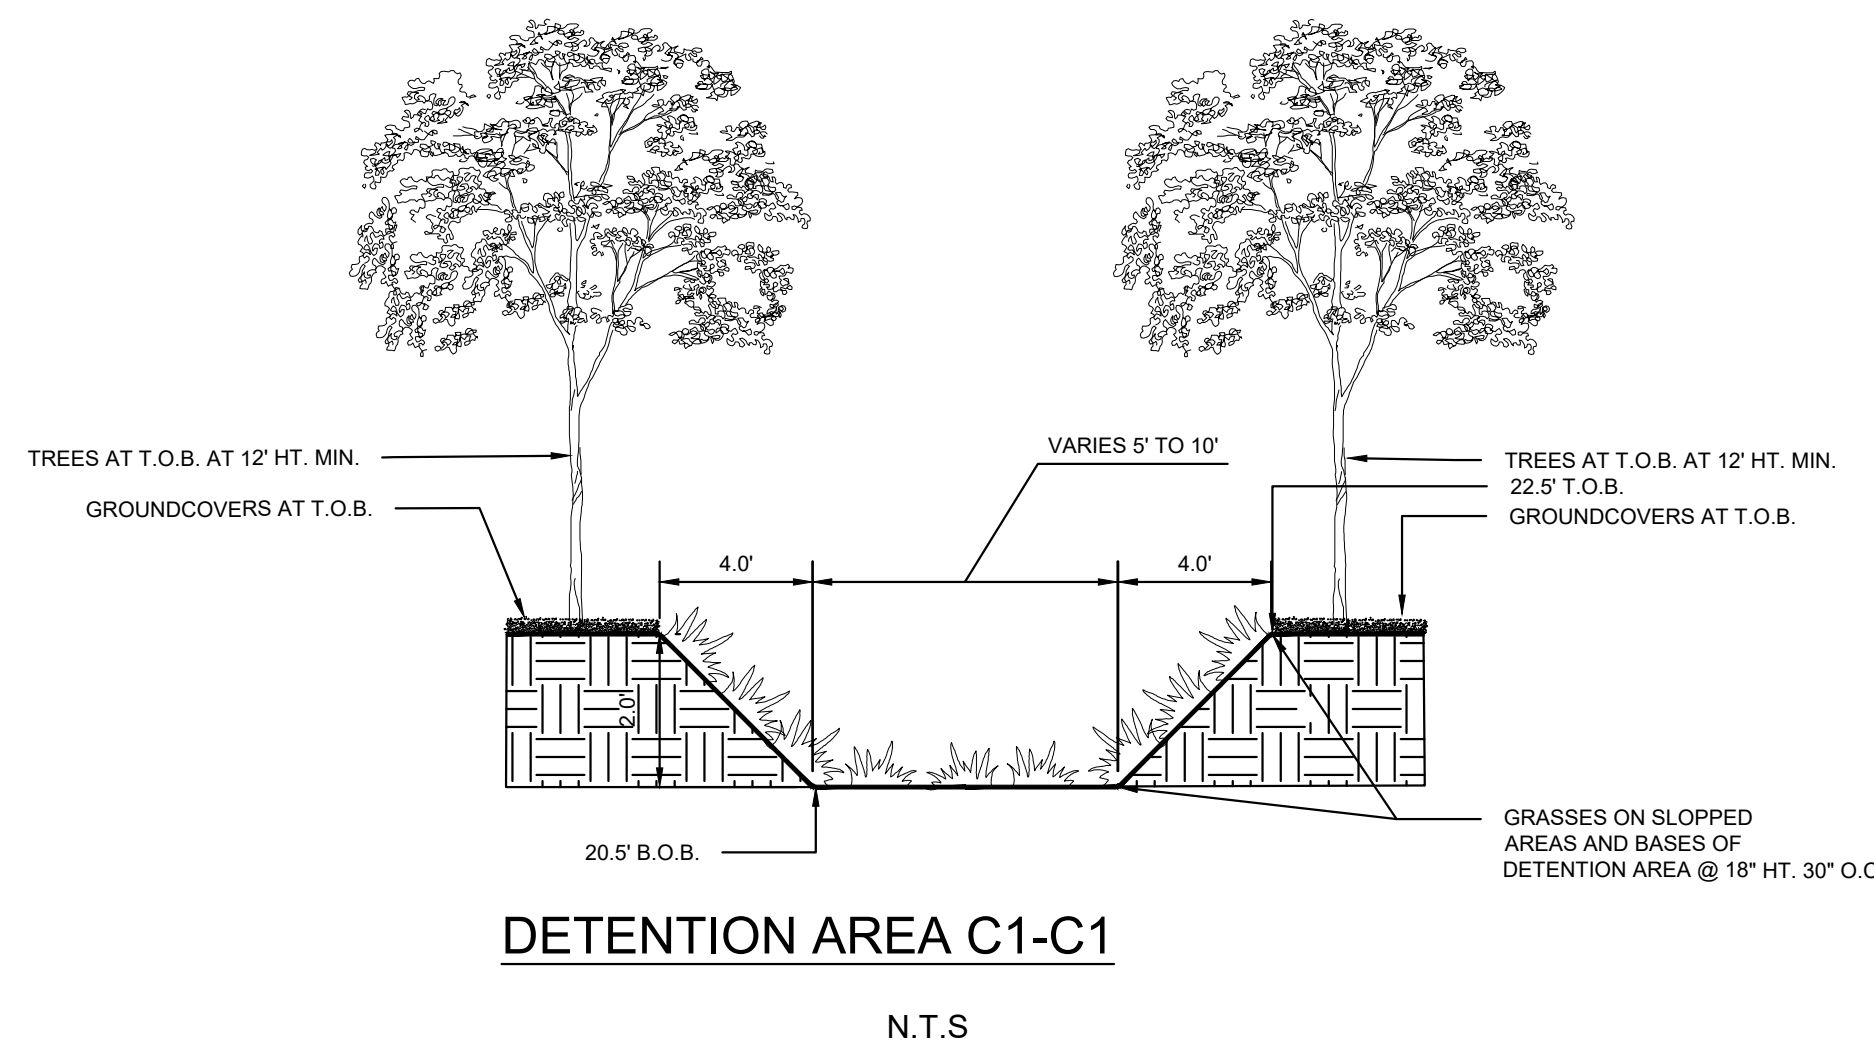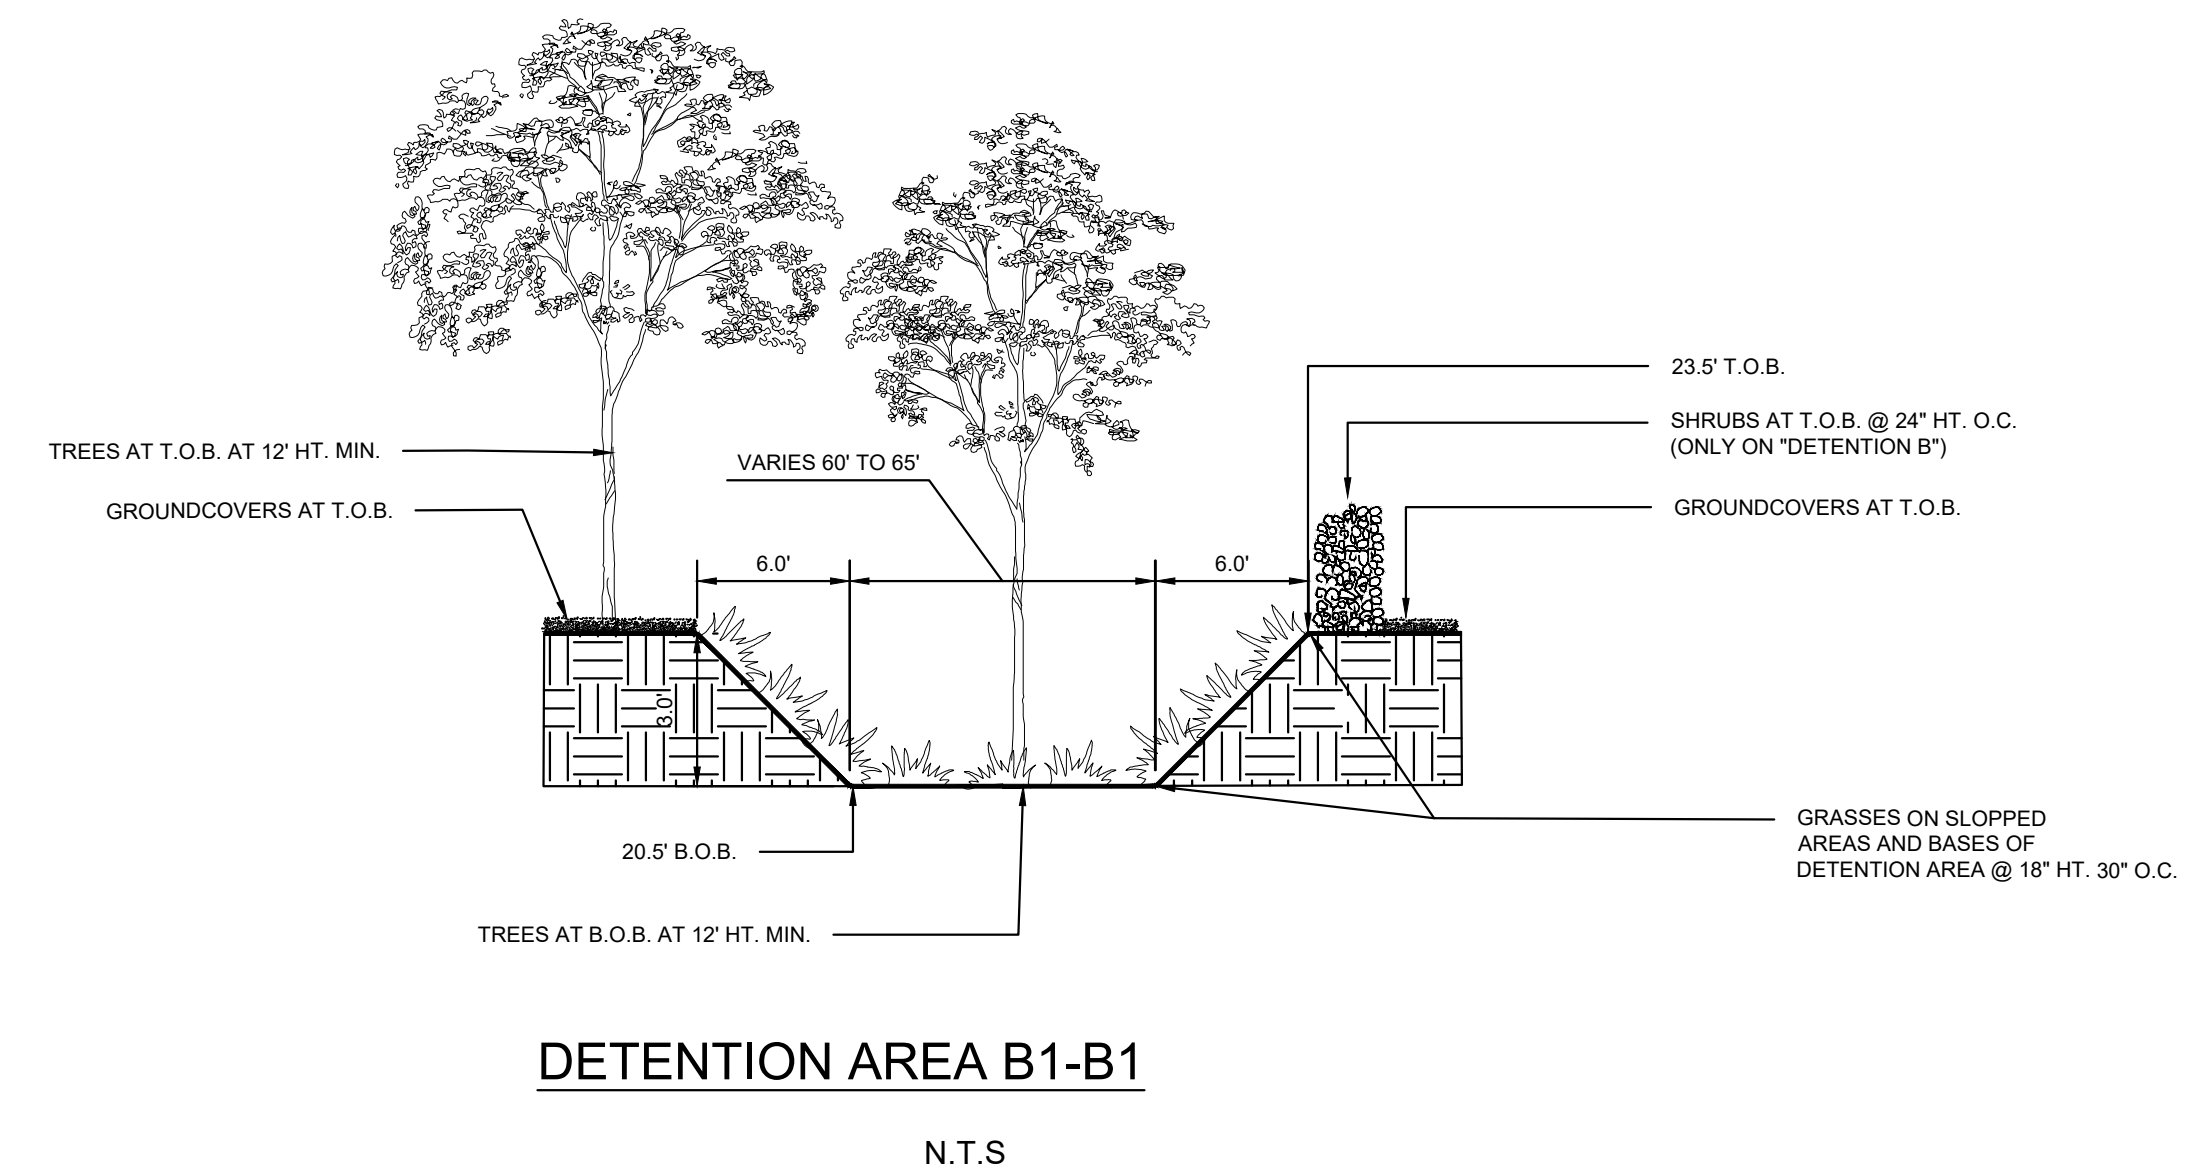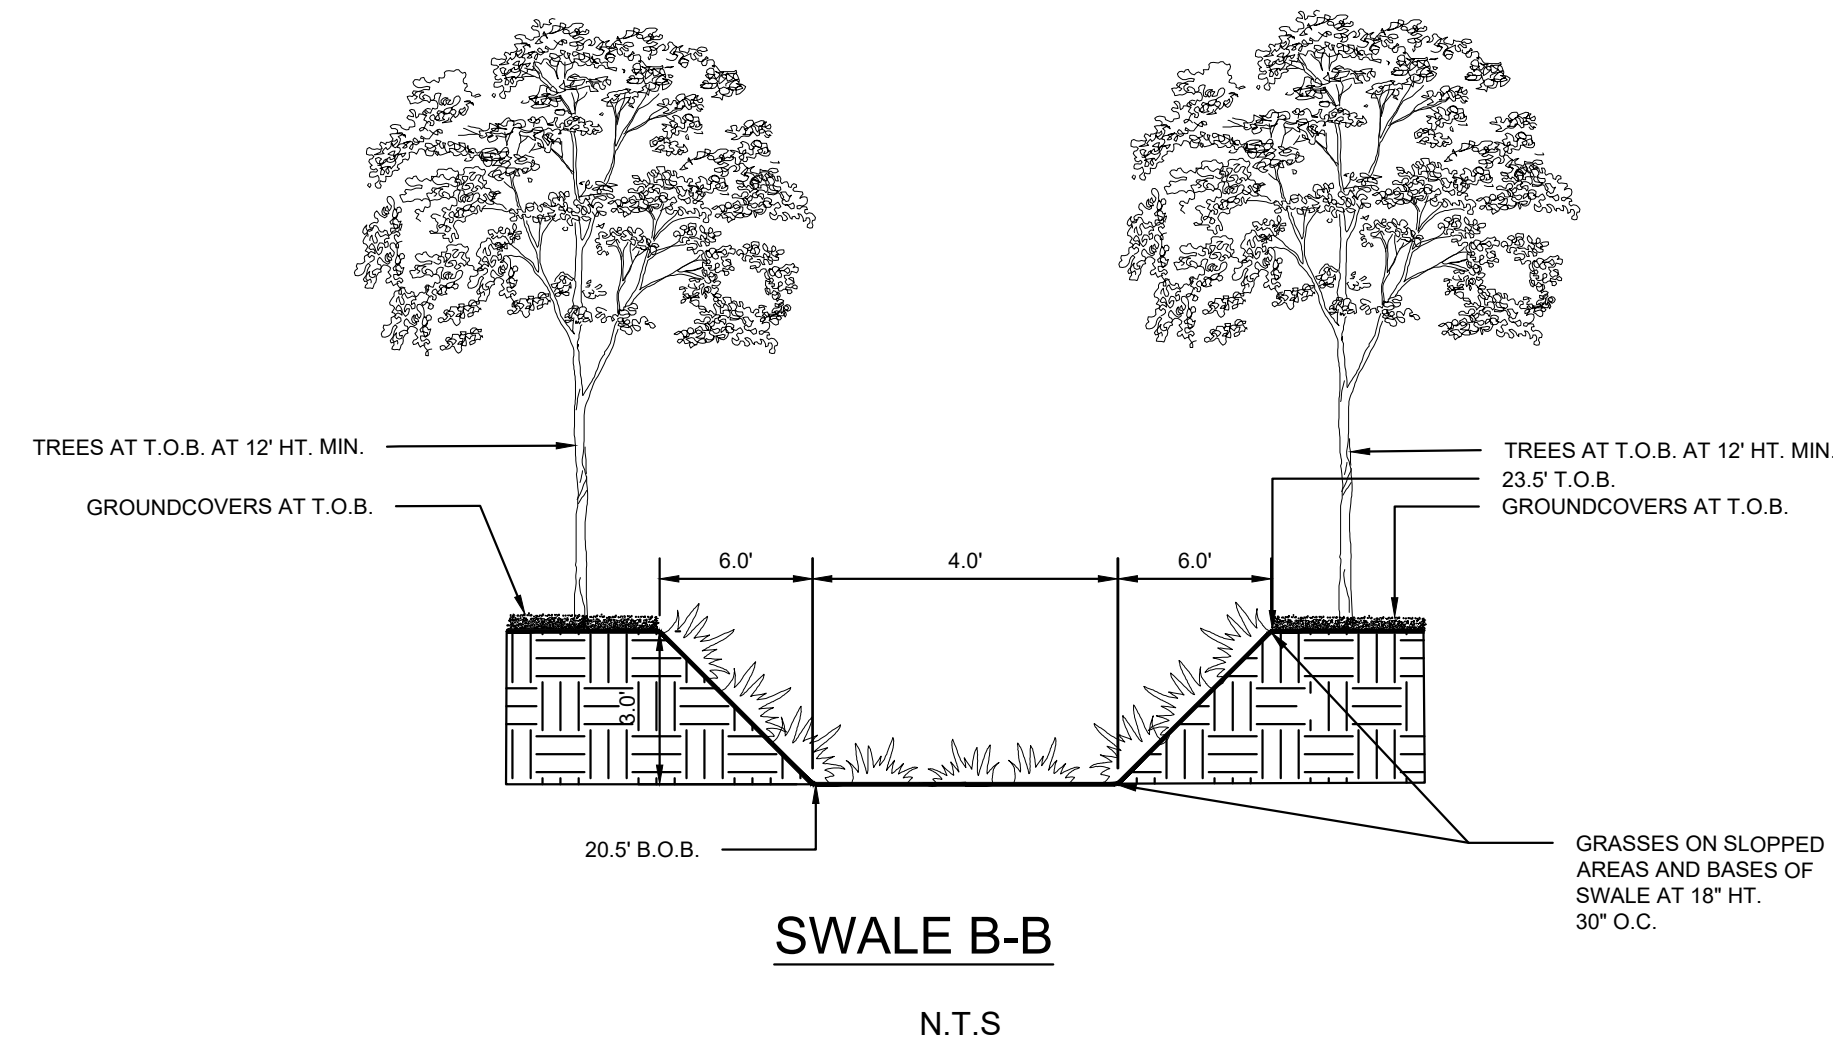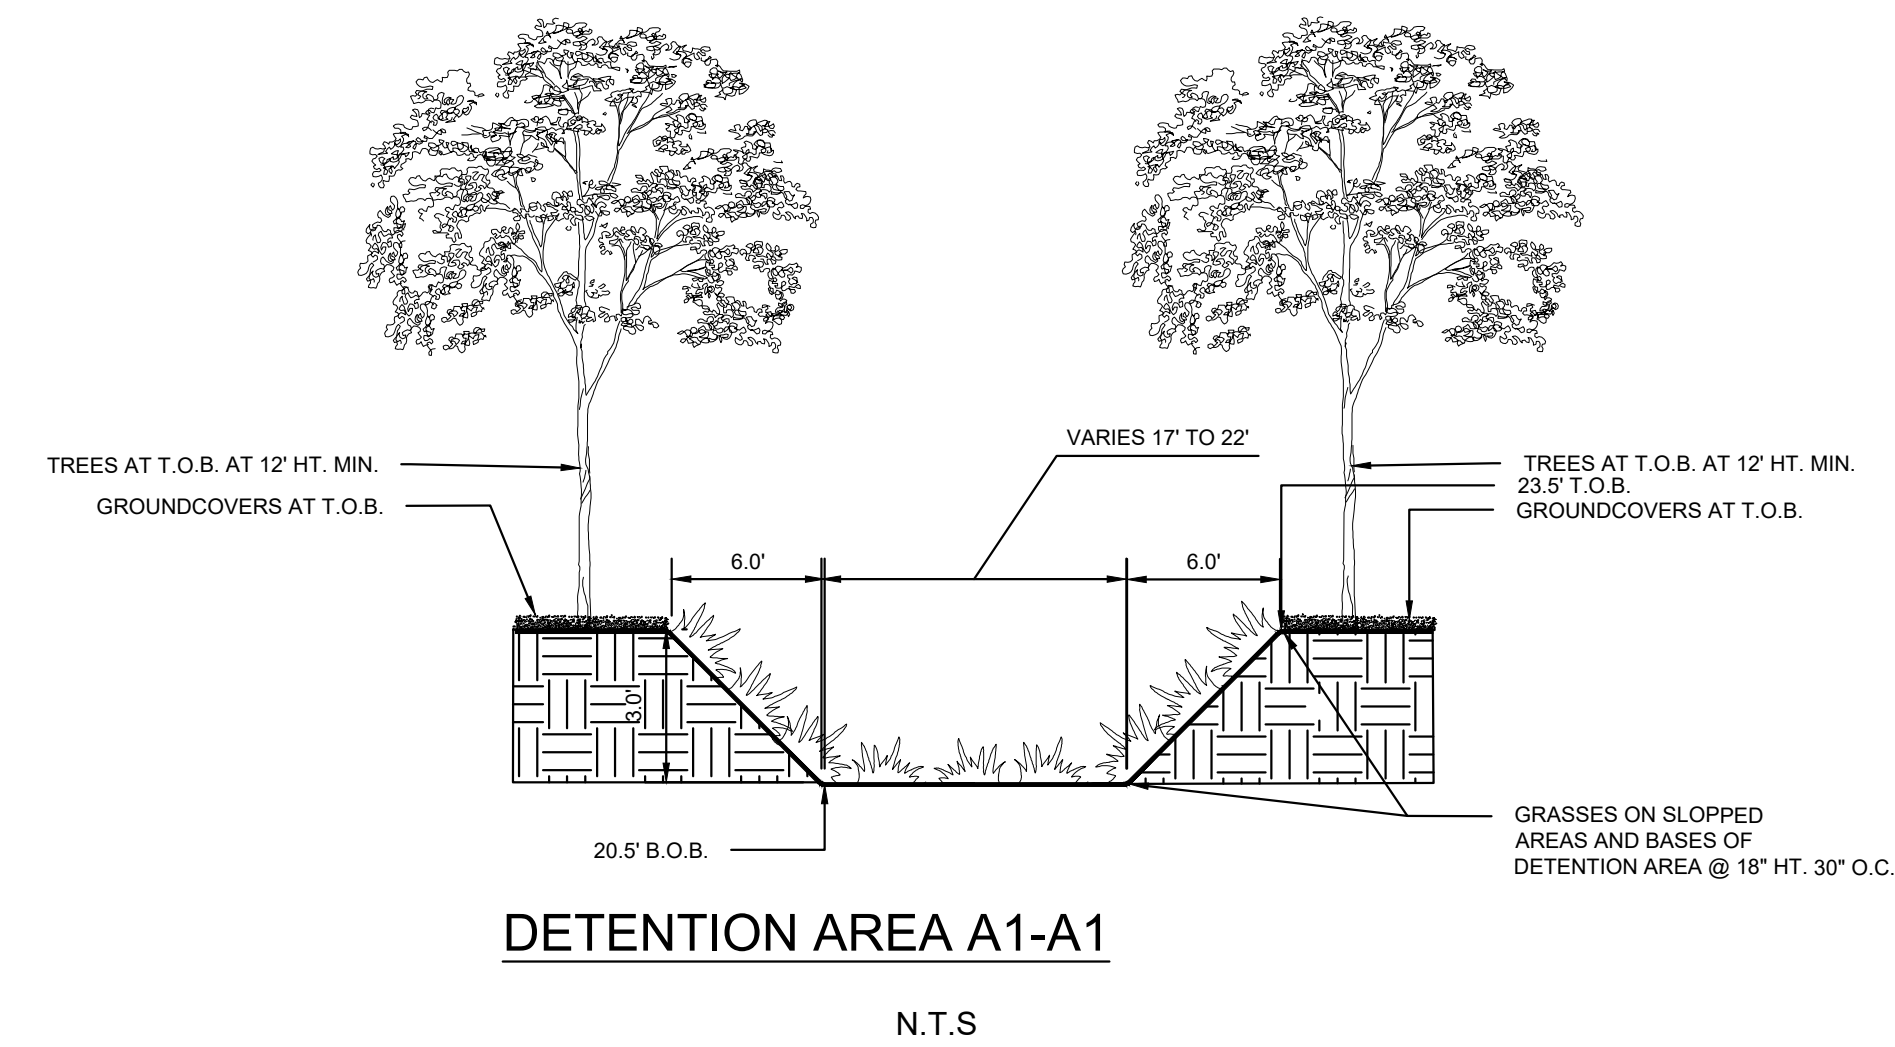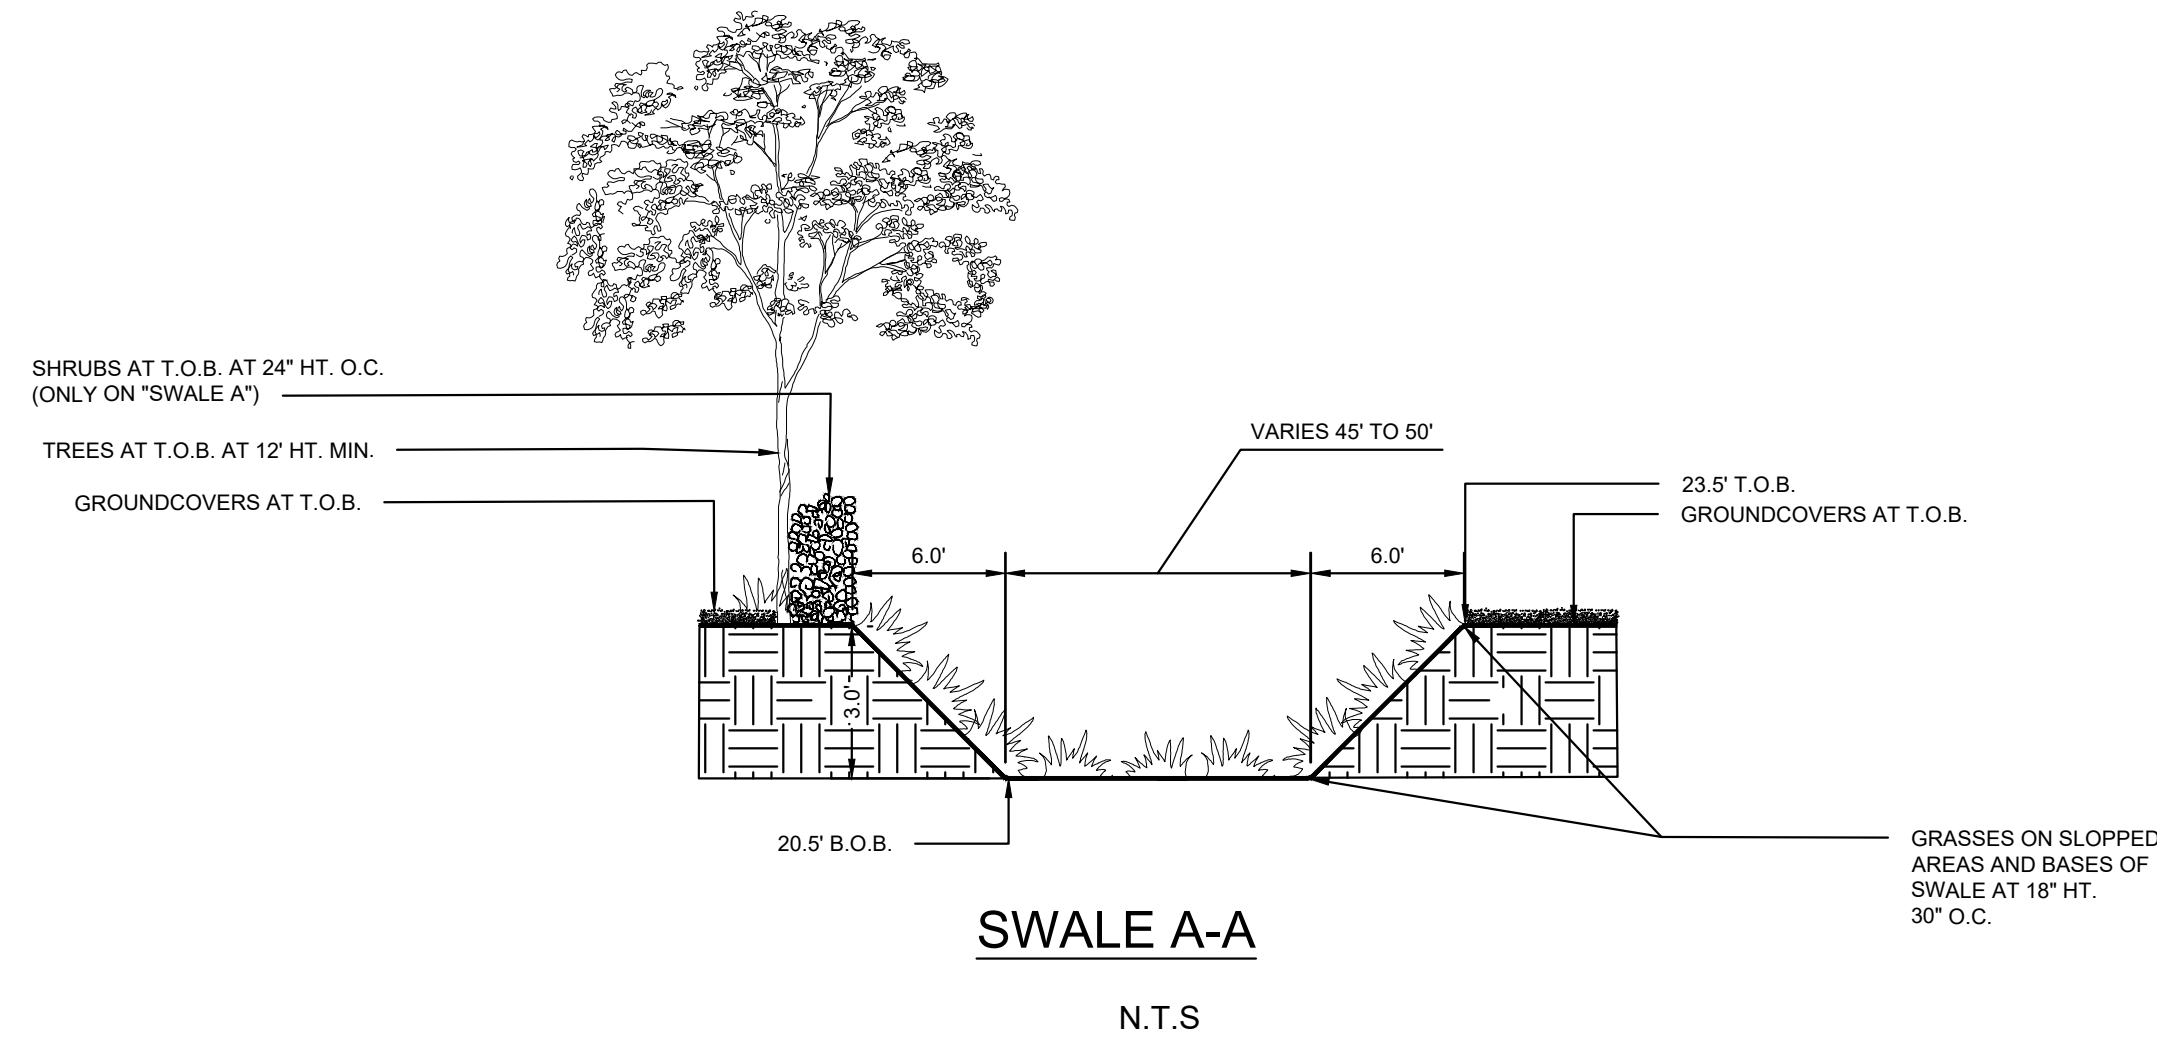

This item has been digitally signed and sealed by Barton J. Fye, P.E. on the date adjacent to the seal.  
 Printed copies of this document are not considered signed and sealed and the signature must be verified on any electronic copies.  
 Date: 11/17/2021

**Sunshine811**  
 Call 811 or www.sunshine811.com two full business days before digging to have utilities located and marked.  
 Check positive response codes before you dig!

|     |           |      |    |
|-----|-----------|------|----|
| NO. | REVISIONS | DATE | BY |
|     |           |      |    |

**Kimley-Horn**  
 © 2021 KIMLEY-HORN AND ASSOCIATES, INC.  
 355 ALHAMBRA CIRCLE, SUITE 1400, CORAL GABLES, FL 33134  
 PHONE: 305-673-2025  
 WWW.KIMLEY-HORN.COM REGISTRY 696

|                       |            |
|-----------------------|------------|
| LICENSED PROFESSIONAL |            |
| KHA PROJECT           | 14-3228000 |
| DATE                  | JULY 2021  |
| SCALE                 | AS SHOWN   |
| DESIGNED BY           | MRC        |
| DRAWN BY              | RMR        |
| CHECKED BY            |            |
| DATE:                 |            |


**RETENTION AREAS  
 CROSS SECTION**

IRC LANDFILL  
 PREPARED FOR  
 INDIAN RIVER COUNTY  
 INDIAN RIVER COUNTY  
 FL



SHEET NUMBER  
**C-520**

Plotted By: Rodriguez, Rebecca - Sheet Set: IRC LANDFILL - Layout: C-521 - RETENTION AREAS CROSS SECTION - November 17, 2021 - 10:42:18am - K:\mhb-civil\43228000 - irc-hw and recycling facility\CIVIL\CADD\plansheets\C-521 - RETENTION AREAS CROSS SECTION.dwg  
This document, together with the concepts and designs presented herein, is intended only for the specific purpose and client for which it was prepared. Reuse of and improper reliance on this document without written authorization and adaptation by Kimley-Horn and Associates, Inc. shall be without liability to Kimley-Horn and Associates, Inc.

1

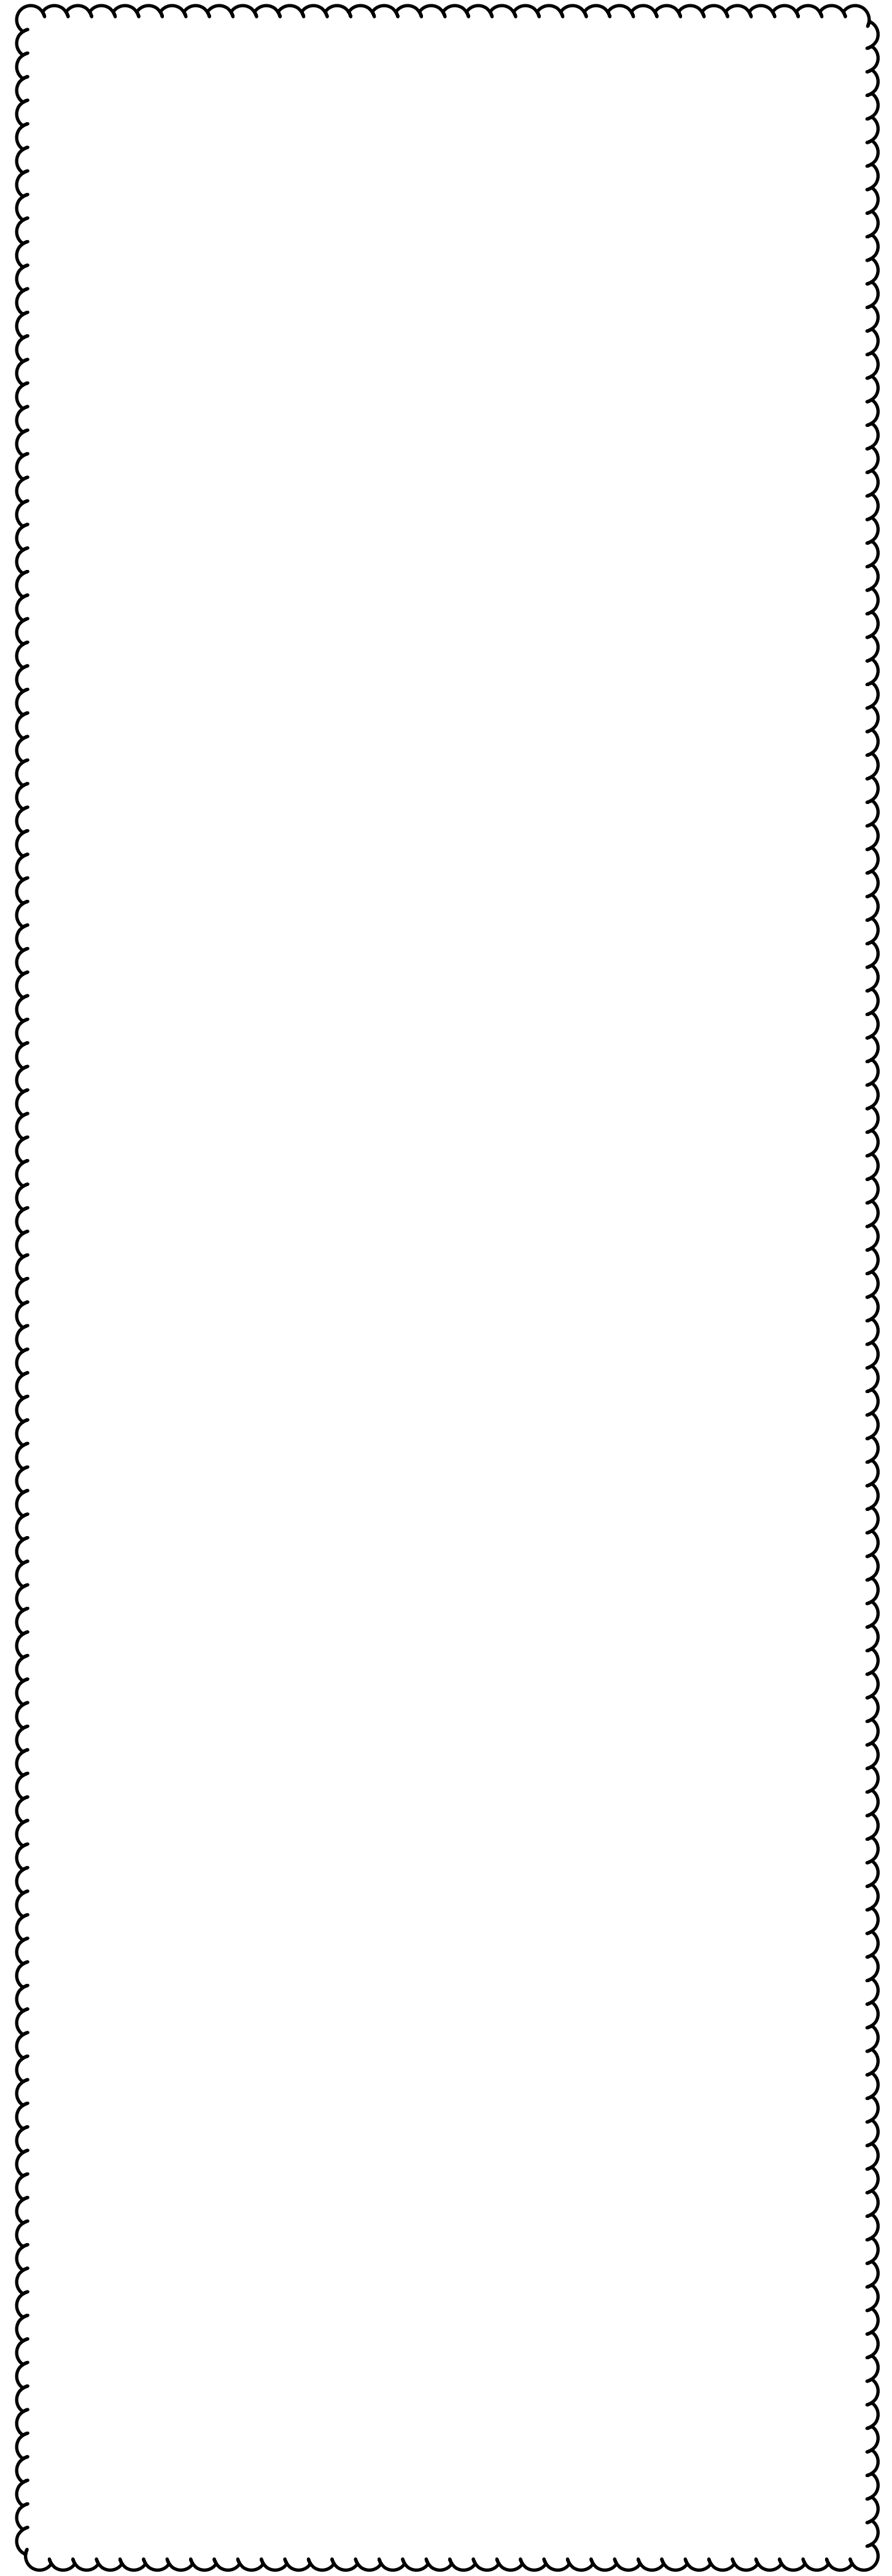

1

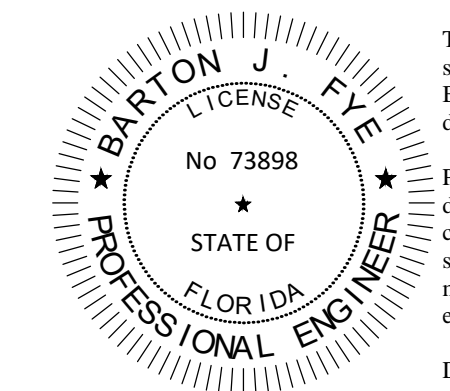
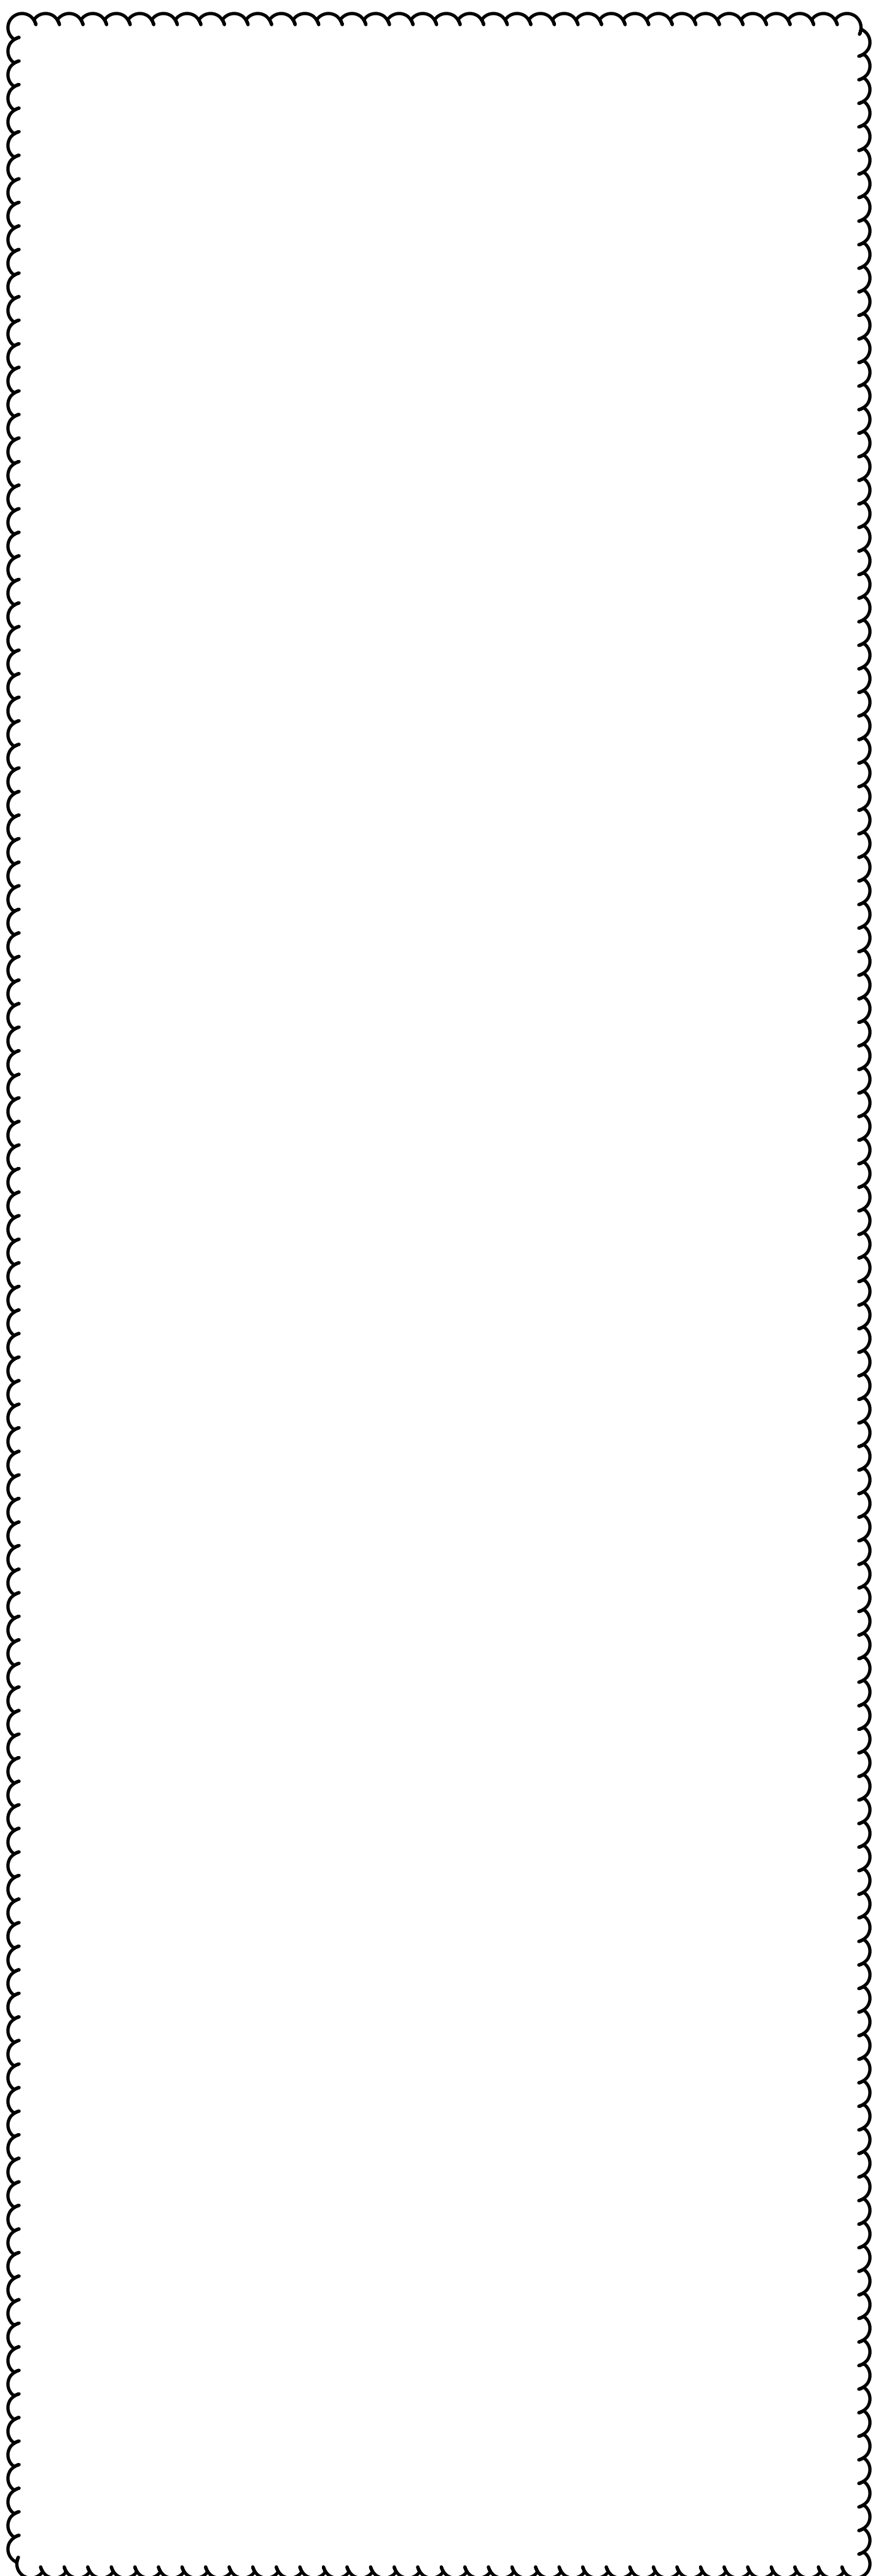


This item has been digitally signed and sealed by Barton J. Fye, P.E. on the date adjacent to the seal.  
Printed copies of this document are not considered signed and sealed and the signature must be verified on any electronic copies.  
Date: 11/17/2021

**Sunshine811**  
Call 811 or www.sunshine811.com two full business days before digging to have utilities located and marked.  
*Check positive response codes before you dig!*


|                              |   |  |  |                           |                       |   |               |            |    |
|------------------------------|---|--|--|---------------------------|-----------------------|---|---------------|------------|----|
| SHEET NUMBER<br><b>C-521</b> | INDIAN RIVER COUNTY<br>INDIAN RIVER<br>FL | <b>IRC LANDFILL<br/>PREPARED FOR<br/>INDIAN RIVER COUNTY</b> | <b>RETENTION AREAS<br/>CROSS SECTION</b> | KHA PROJECT<br>14-3228000 | LICENSED PROFESSIONAL | <b>Kimley»Horn</b><br>© 2021 KIMLEY-HORN AND ASSOCIATES, INC.<br>355 ALHAMBRA CIRCLE, SUITE 1400, CORAL GABLES, FL 33134<br>PHONE: 305-673-2025<br>WWW.KIMLEY-HORN.COM REGISTRY 696 | OWNER CHANGES | 11/16/2021 | JF |
|                              |   |  |  | DATE<br>JULY 2021         | SCALE AS SHOWN        |   |               |            |    |

Plotted By: Rodriguez, Rebecca - Sheet Set: IRC LANDFILL - Layout: C-710 WATER AND SEWER PLANS - November 17, 2021 11:23:10am - k:\vmb-civil\43228000 - frc haw and recycling facility\CIVIL\CADD\plansheets\C-700 WATER AND SEWER PLANS.dwg  
 This document, together with the concepts and designs presented herein, is intended only for the specific purpose and client for which it was prepared. Reuse of and improper reliance on this document without written authorization and adaptation by Kimley-Horn and Associates, Inc. shall be without liability to Kimley-Horn and Associates, Inc.

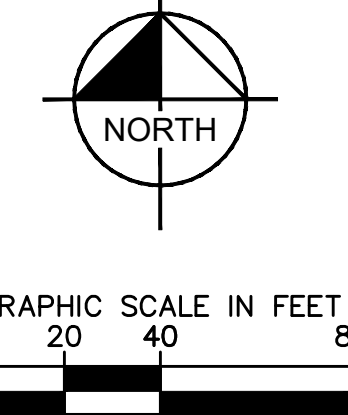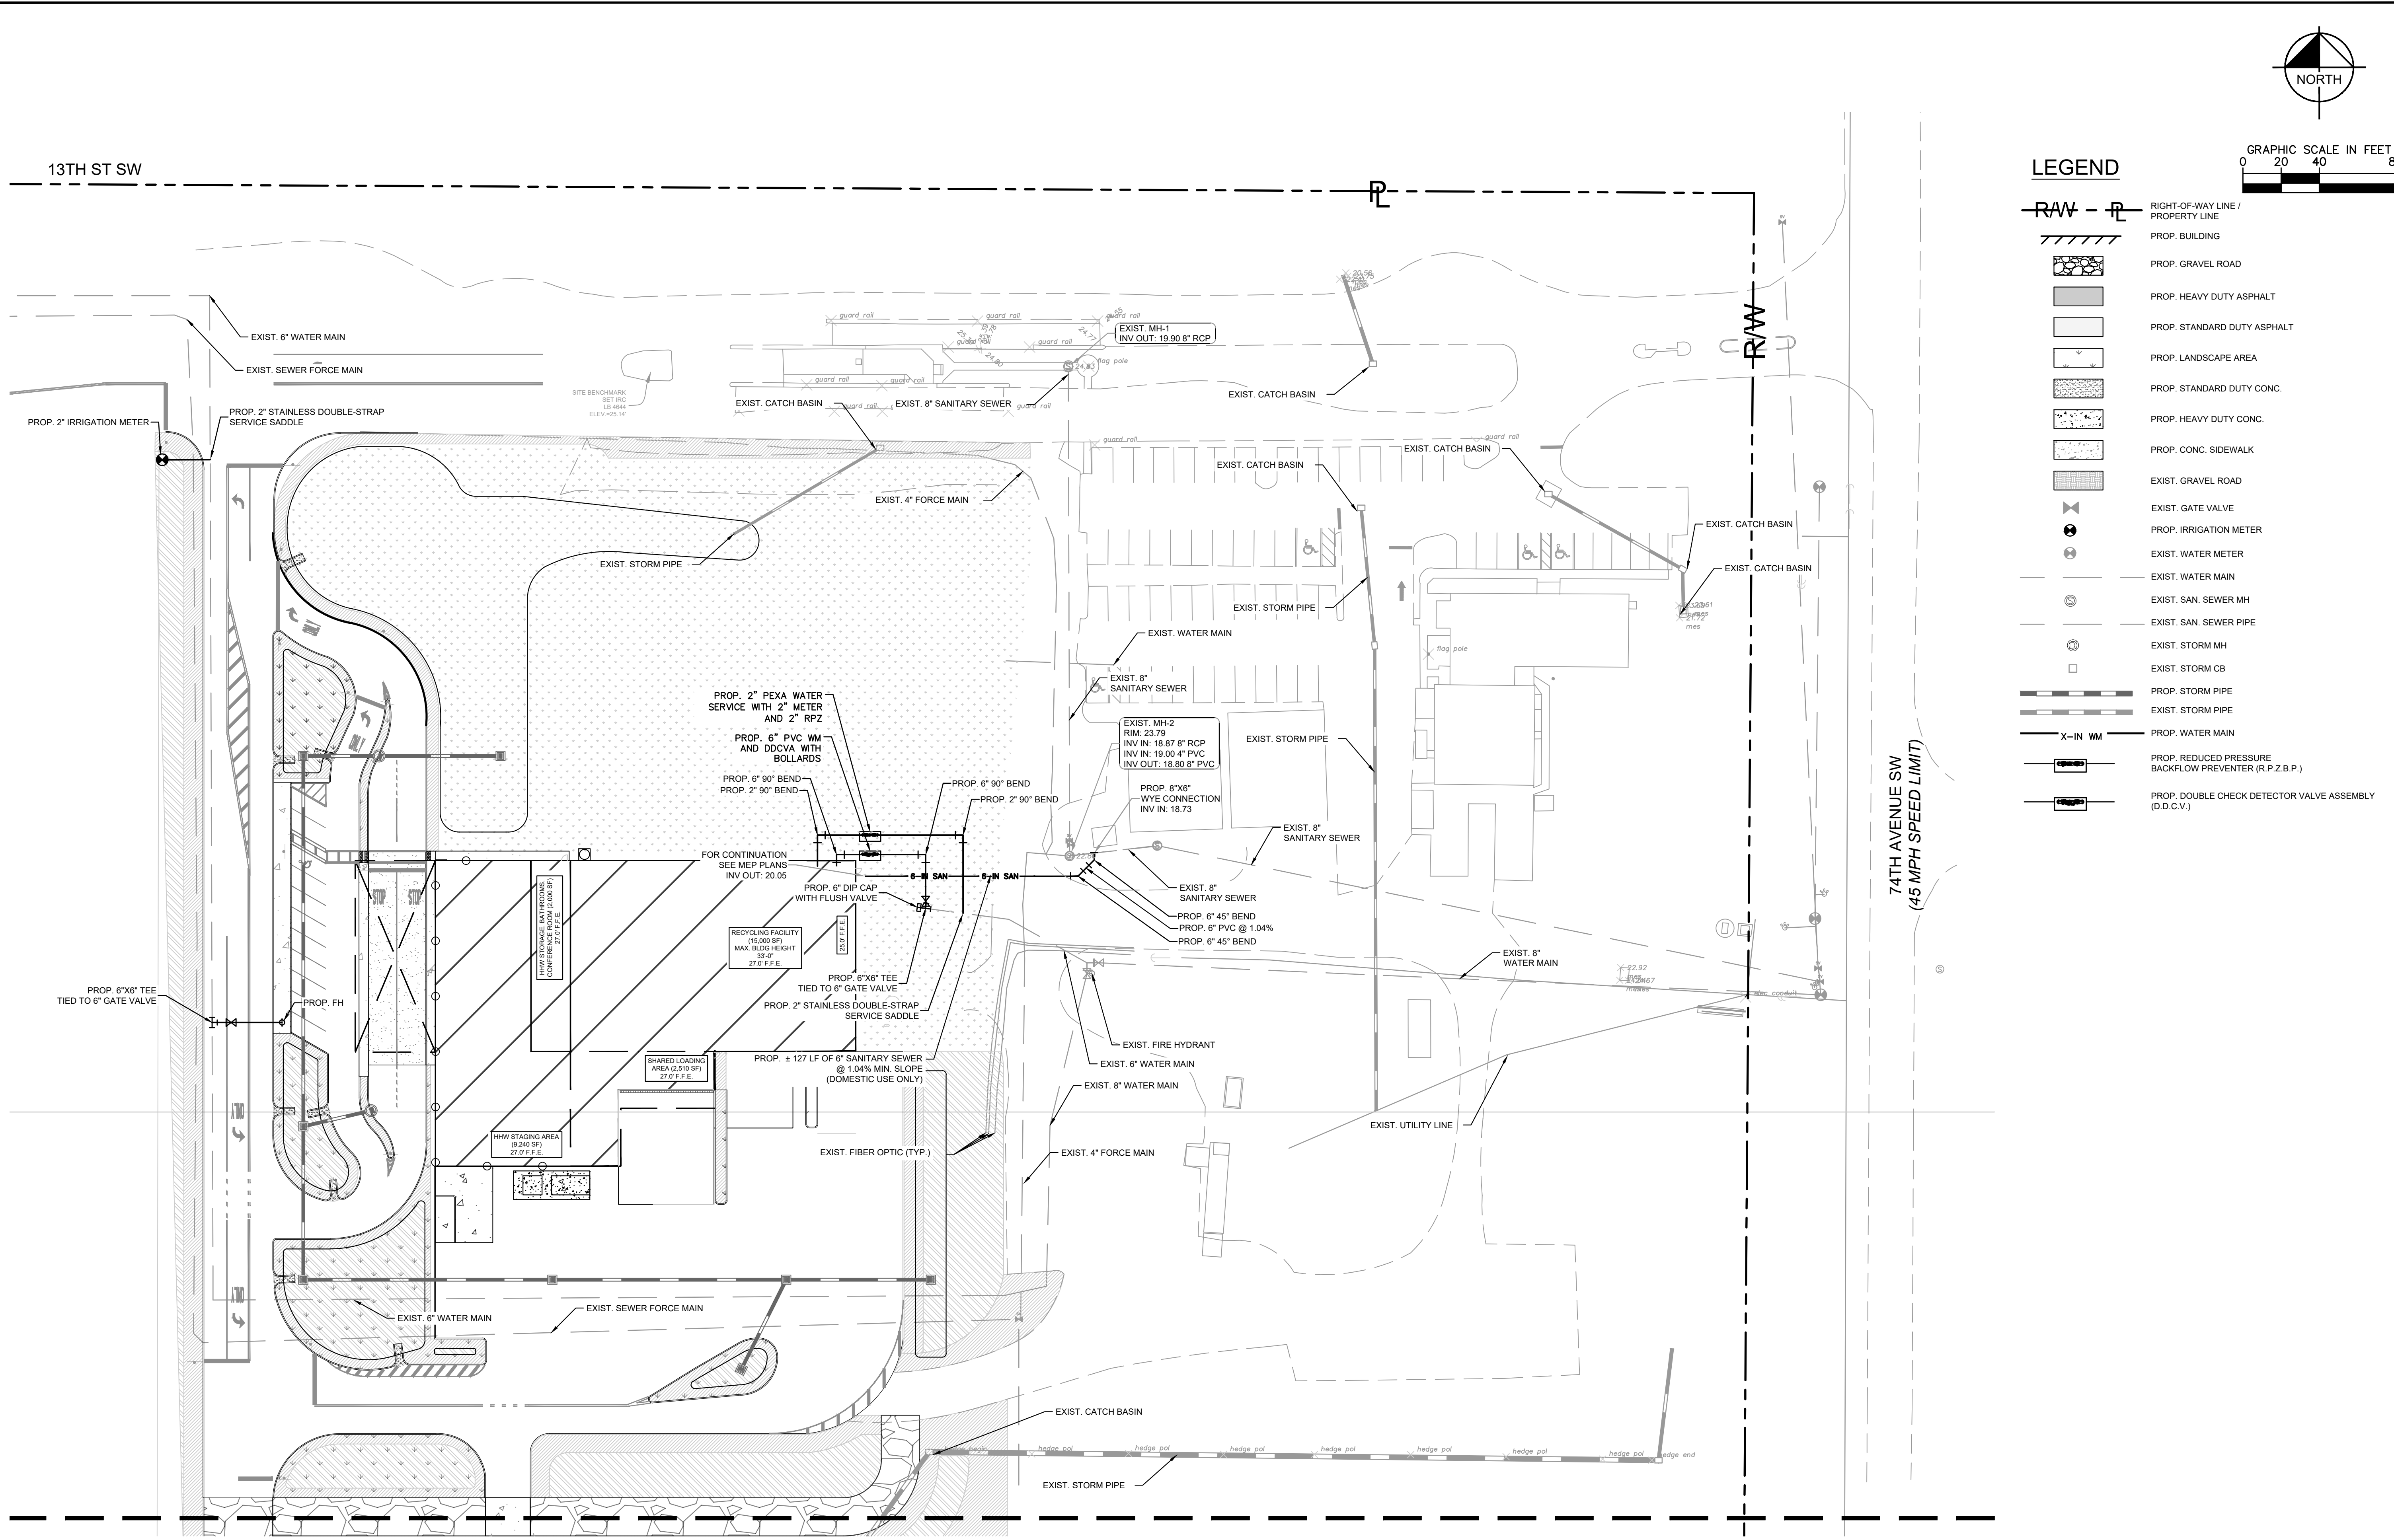

| LEGEND |  |
|--------|--|
|        | RIGHT-OF-WAY LINE / PROPERTY LINE                      |
|        | PROP. BUILDING   |
|        | PROP. GRAVEL ROAD                                      |
|        | PROP. HEAVY DUTY ASPHALT                               |
|        | PROP. STANDARD DUTY ASPHALT                            |
|        | PROP. LANDSCAPE AREA                                   |
|        | PROP. STANDARD DUTY CONC.                              |
|        | PROP. HEAVY DUTY CONC.                                 |
|        | PROP. CONC. SIDEWALK                                   |
|        | EXIST. GRAVEL ROAD                                     |
|        | EXIST. GATE VALVE                                      |
|        | PROP. IRRIGATION METER                                 |
|        | EXIST. WATER METER                                     |
|        | EXIST. WATER MAIN                                      |
|        | EXIST. SAN. SEWER MH                                   |
|        | EXIST. SAN. SEWER PIPE                                 |
|        | EXIST. STORM MH  |
|        | EXIST. STORM CB  |
|        | PROP. STORM PIPE                                       |
|        | EXIST. STORM PIPE                                      |
|        | PROP. WATER MAIN                                       |
|        | PROP. REDUCED PRESSURE BACKFLOW PREVENTER (R.P.Z.B.P.) |
|        | PROP. DOUBLE CHECK DETECTOR VALVE ASSEMBLY (D.C.C.V.)  |

SEE SHEET C-711 FOR CONTINUATION

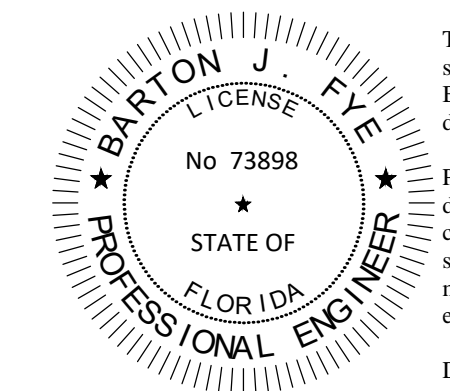


This item has been digitally signed and sealed by Barton J. Fye, P.E. on the date adjacent to the seal.  
 Printed copies of this document are not considered signed and sealed and the signature must be verified on any electronic copies.  
 Date: 11/17/2021

**Sunshine811**  
 Call 811 or www.sunshine811.com two full business days before digging to have utilities located and marked.  
 Check positive response codes before you dig!

|   |   |                            |   |                              |  |
|---|---|----------------------------|---|------------------------------|--|
| <b>Kimley-Horn</b><br>© 2021 KIMLEY-HORN AND ASSOCIATES, INC.<br>355 ALHAMBRA CIRCLE, SUITE 1400, CORAL GABLES, FL 33134<br>PHONE: 305-673-2025<br>WWW.KIMLEY-HORN.COM REGISTRY 696 | LICENSED PROFESSIONAL<br>KHA PROJECT<br>14-3228000<br>DATE<br>JULY 2021<br>SCALE AS SHOWN<br>DESIGNED BY MRG<br>DRAWN BY RMR<br>CHECKED BY BF | WATER AND SEWER<br>PLANS I | IRC LANDFILL<br>PREPARED FOR<br>INDIAN RIVER COUNTY | SHEET NUMBER<br><b>C-710</b> | REVISIONS<br>No. _____<br>BY _____<br>DATE _____ |
|   | FL  | INDIAN RIVER COUNTY        | FL  | DATE                         | BY   |

Plotted By: Rodriguez, Rebecca - Sheet Set: IRC LANDFILL - Layout: C-711 - WATER AND SEWER PLANS - November 17, 2021 - 11:24:20am - k:\ymbb-civil\43228000 - irc haw and recycling facility\CIVIL\CADD\plansheets\C-700 WATER AND SEWER PLANS.dwg  
 This document, together with the concepts and designs presented herein, is intended only for the specific purpose and client for which it was prepared. Reuse of and improper reliance on this document without written authorization and adaptation by Kimley-Horn and Associates, Inc. shall be without liability to Kimley-Horn and Associates, Inc.

SEE SHEET C-710 FOR CONTINUATION

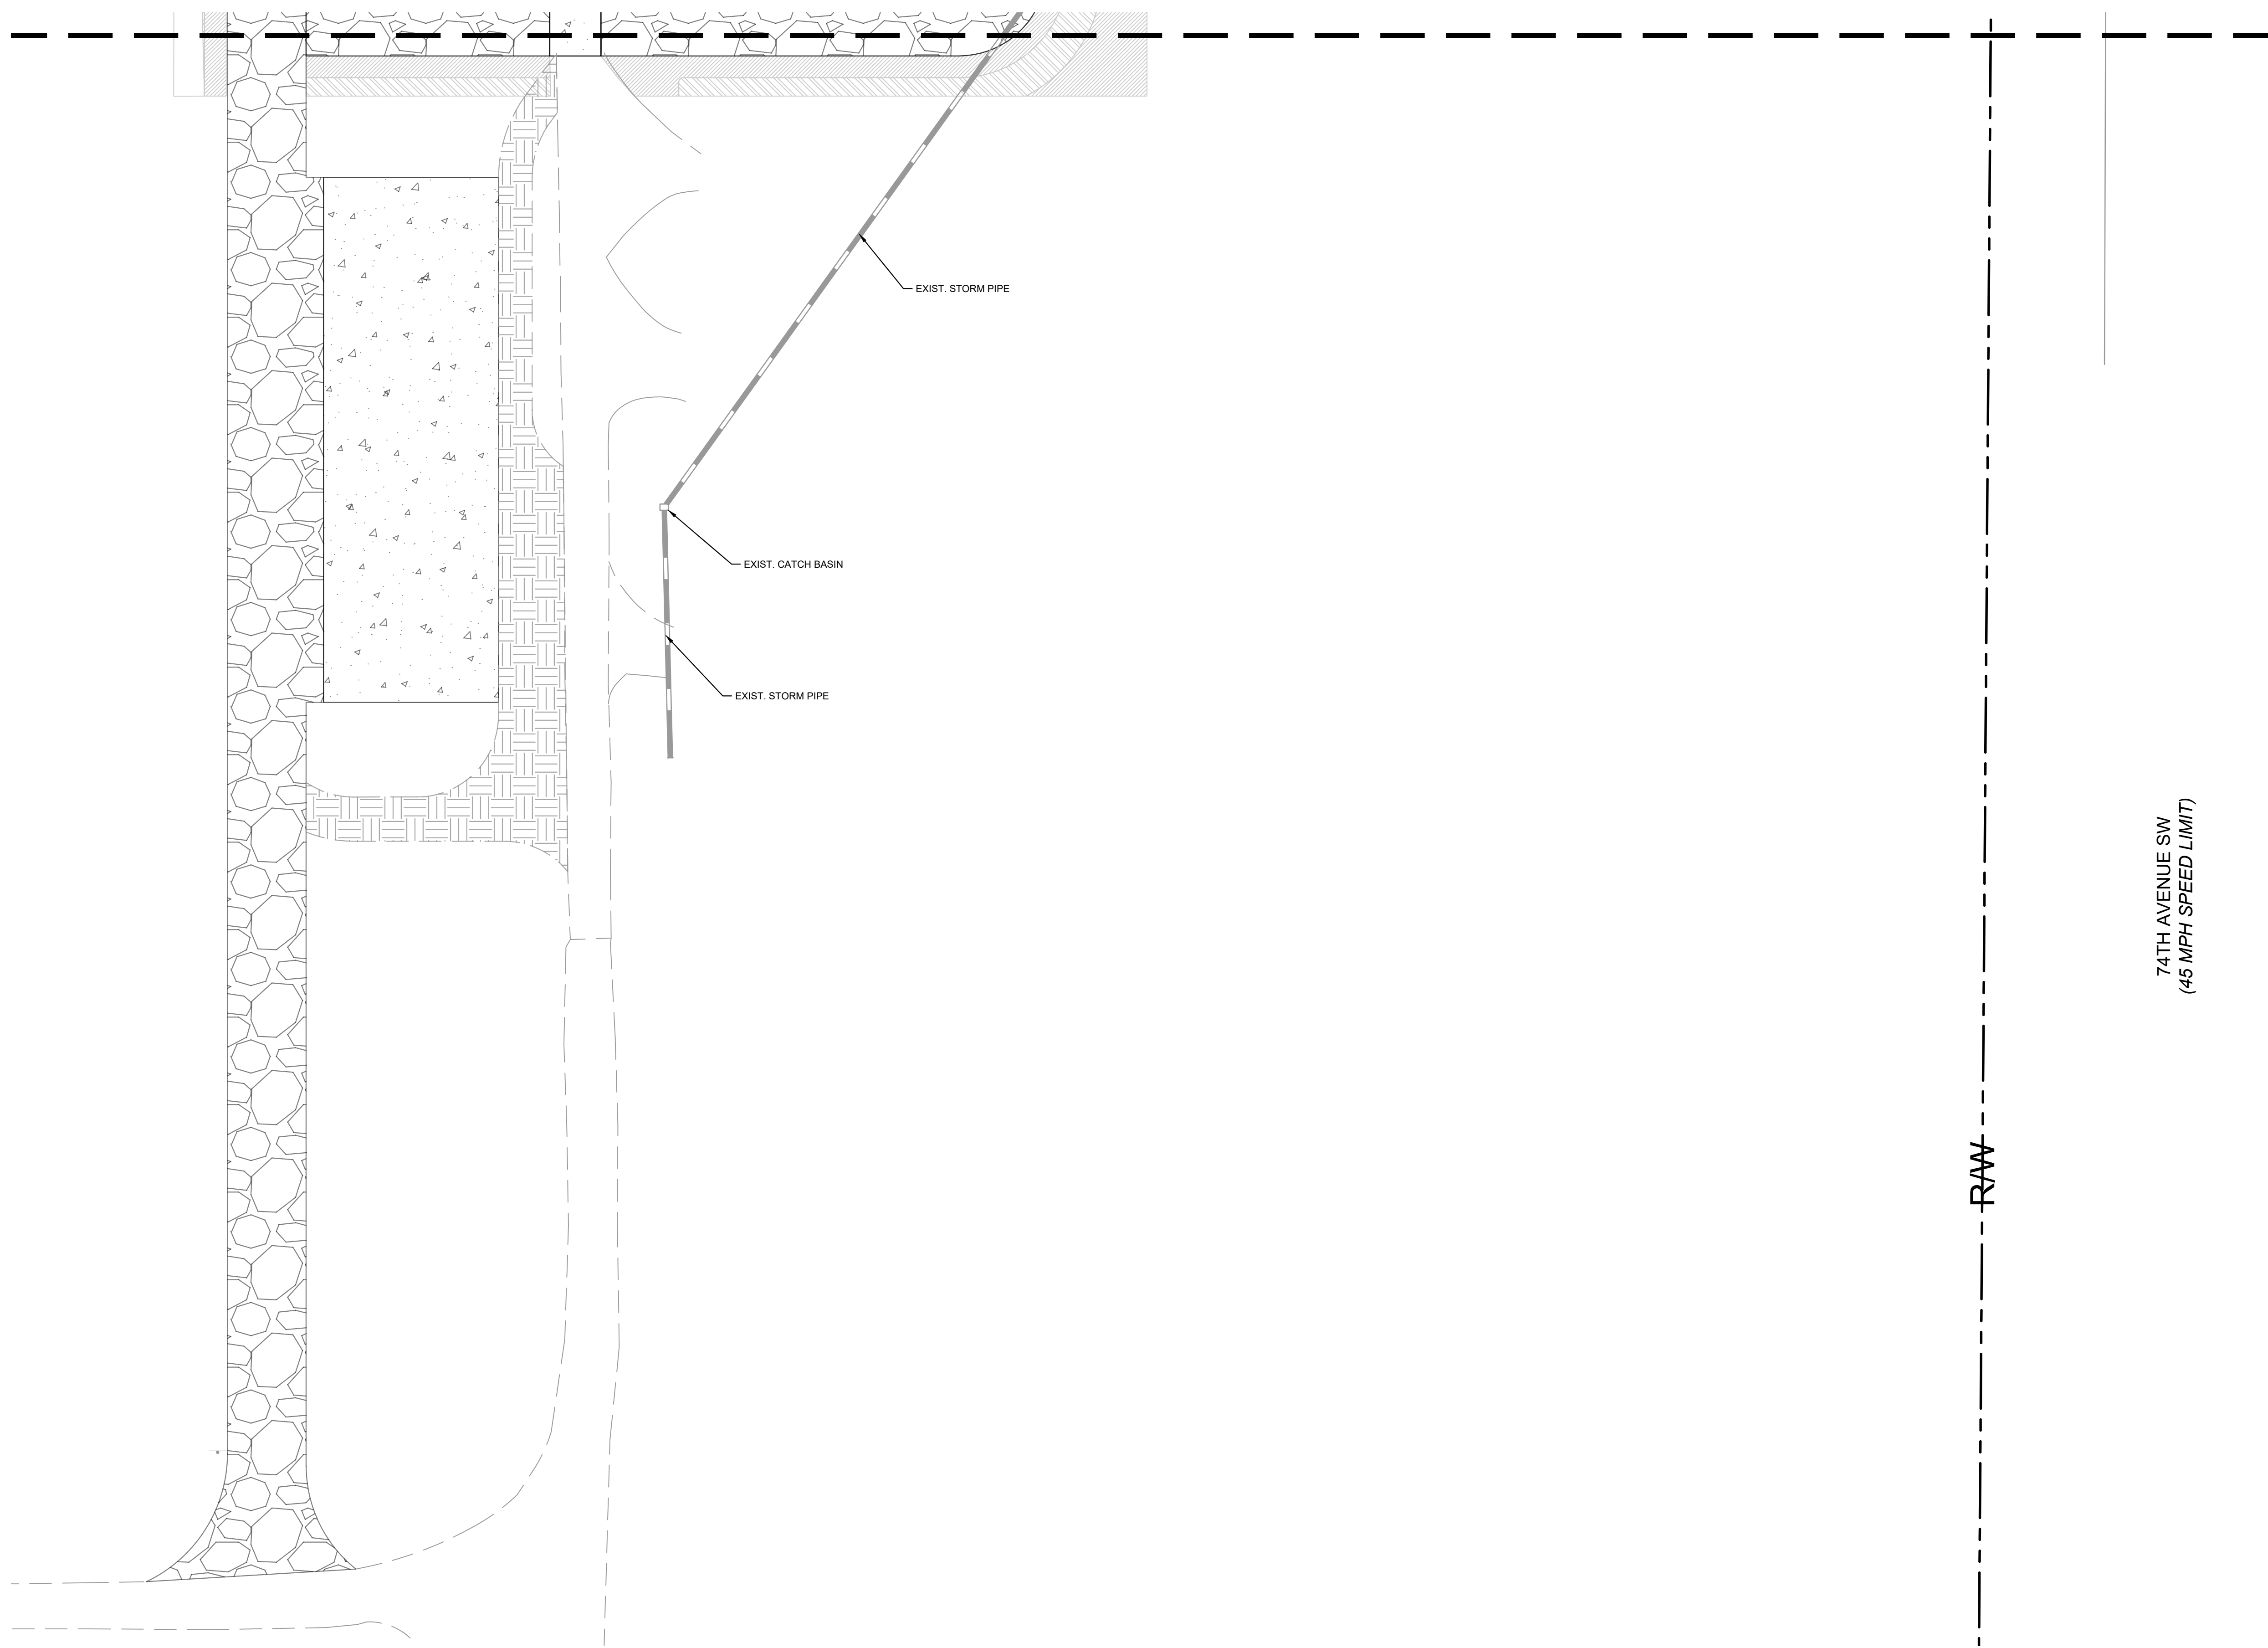

74TH AVENUE SW  
(45 MPH SPEED LIMIT)

**LEGEND**

- RIGHT-OF-WAY LINE / PROPERTY LINE
- PROP. BUILDING
- PROP. GRAVEL ROAD
- PROP. HEAVY DUTY ASPHALT
- PROP. STANDARD DUTY ASPHALT
- PROP. LANDSCAPE AREA
- PROP. STANDARD DUTY CONC.
- PROP. HEAVY DUTY CONC.
- PROP. CONC. SIDEWALK
- EXIST. GRAVEL ROAD
- EXIST. GATE VALVE
- PROP. IRRIGATION METER
- EXIST. WATER METER
- EXIST. WATER MAIN
- EXIST. SAN. SEWER MH
- EXIST. SAN. SEWER PIPE
- EXIST. STORM MH
- EXIST. STORM CB
- PROP. STORM PIPE
- EXIST. STORM PIPE
- PROP. WATER MAIN
- PROP. REDUCED PRESSURE BACKFLOW PREVENTER (R.P.Z.B.P.)
- PROP. DOUBLE CHECK DETECTOR VALVE ASSEMBLY (D.D.C.V.)

**NORTH**

GRAPHIC SCALE IN FEET

0 20 40 80

STATE OF FLORIDA  
 PROFESSIONAL ENGINEER  
 LICENSE  
 No. 73898  
 BARTON J. FYE

This item has been digitally signed and sealed by Barton J. Fye, P.E. on the date adjacent to the seal.

Printed copies of this document are not considered signed and sealed and the signature must be verified on any electronic copies.

Date: 11/17/2021

**Sunshine811**

Call 811 or www.sunshine811.com two full business days before digging to have utilities located and marked.





















Check positive response codes before you dig!

|   |                   |                       |                   |
|---|-------------------|-----------------------|-------------------|
| KHA PROJECT<br>14-3228000                     |                   | LICENSED PROFESSIONAL |                   |
| DATE<br>JULY 2021                             | SCALE<br>AS SHOWN | DESIGNED BY<br>MRC    | CHECKED BY<br>RMR |
| WATER AND SEWER PLANS II                      |                   | DATE:                 |                   |
| IRC LANDFILL PREPARED FOR INDIAN RIVER COUNTY |                   | DATE:                 |                   |
| SHEET NUMBER<br><b>C-711</b>                  |                   | DATE:                 |                   |
| INDIAN RIVER COUNTY                           |                   | REVISIONS             |                   |
| FL  |                   | No.                   |                   |
|   |                   | BY                    |                   |
|   |                   | DATE                  |                   |

**Kimley-Horn**

© 2021 KIMLEY-HORN AND ASSOCIATES, INC.  
 355 ALHAMBRA CIRCLE, SUITE 1400, CORAL GABLES, FL 33134  
 PHONE: 305-673-2025  
 WWW.KIMLEY-HORN.COM REGISTRY 696

Plotted By: Rebecca, Rebecca - Sheet Set: IRC LANDFILL - 10/10/2021 - 10:42:50am - K:\amb-civil\143228000 - irc thw and recycling facility\DWG\CADD\plansheets\C-712 INDIAN RIVER COUNTY WATER DETAILS.dwg  
 This document, together with the concepts and designs presented herein, is intended only for the specific purpose and client for which it was prepared. Reuse of and improper reliance on this document without written authorization and adaptation by Kimley-Horn and Associates, Inc. shall be without liability to Kimley-Horn and Associates, Inc.

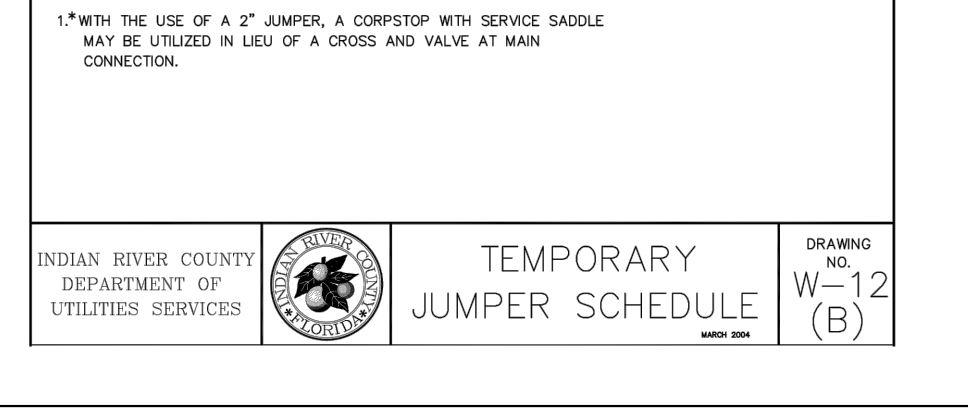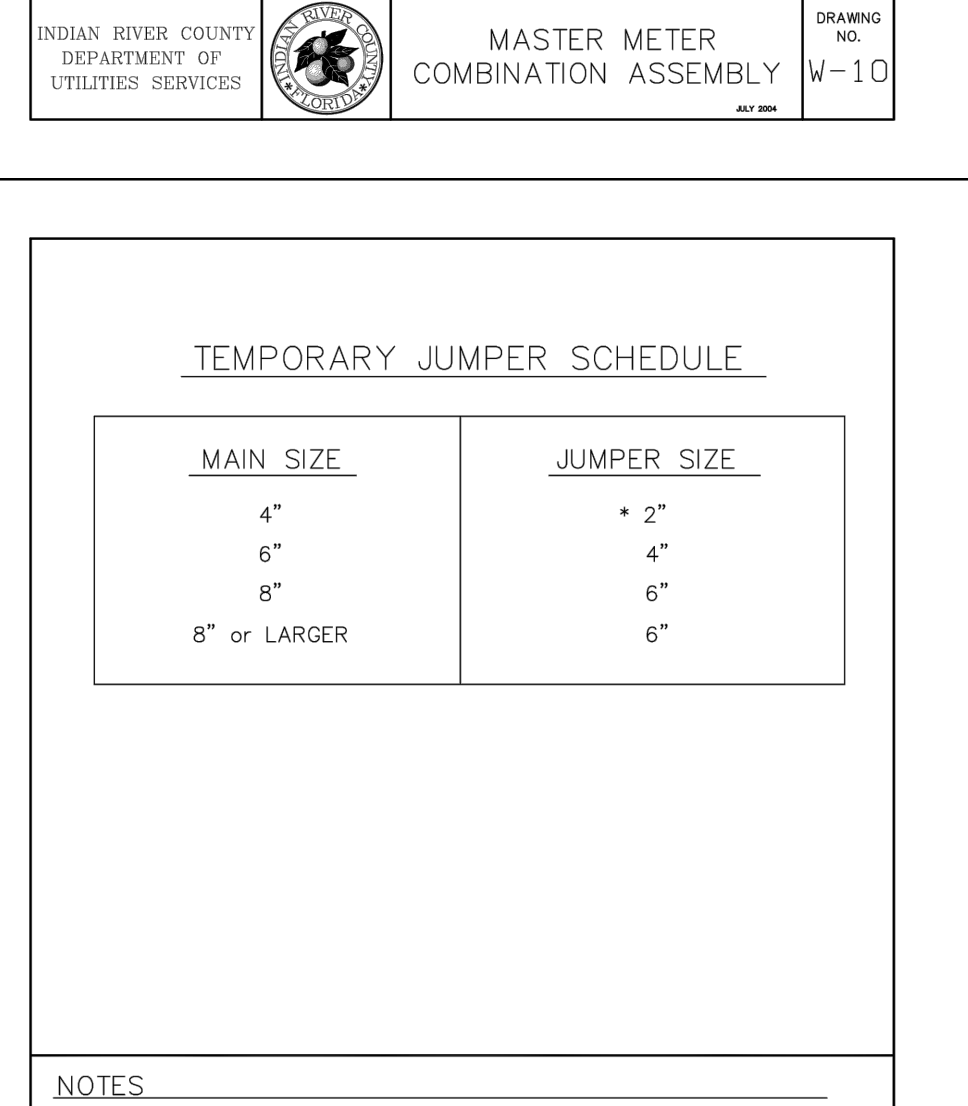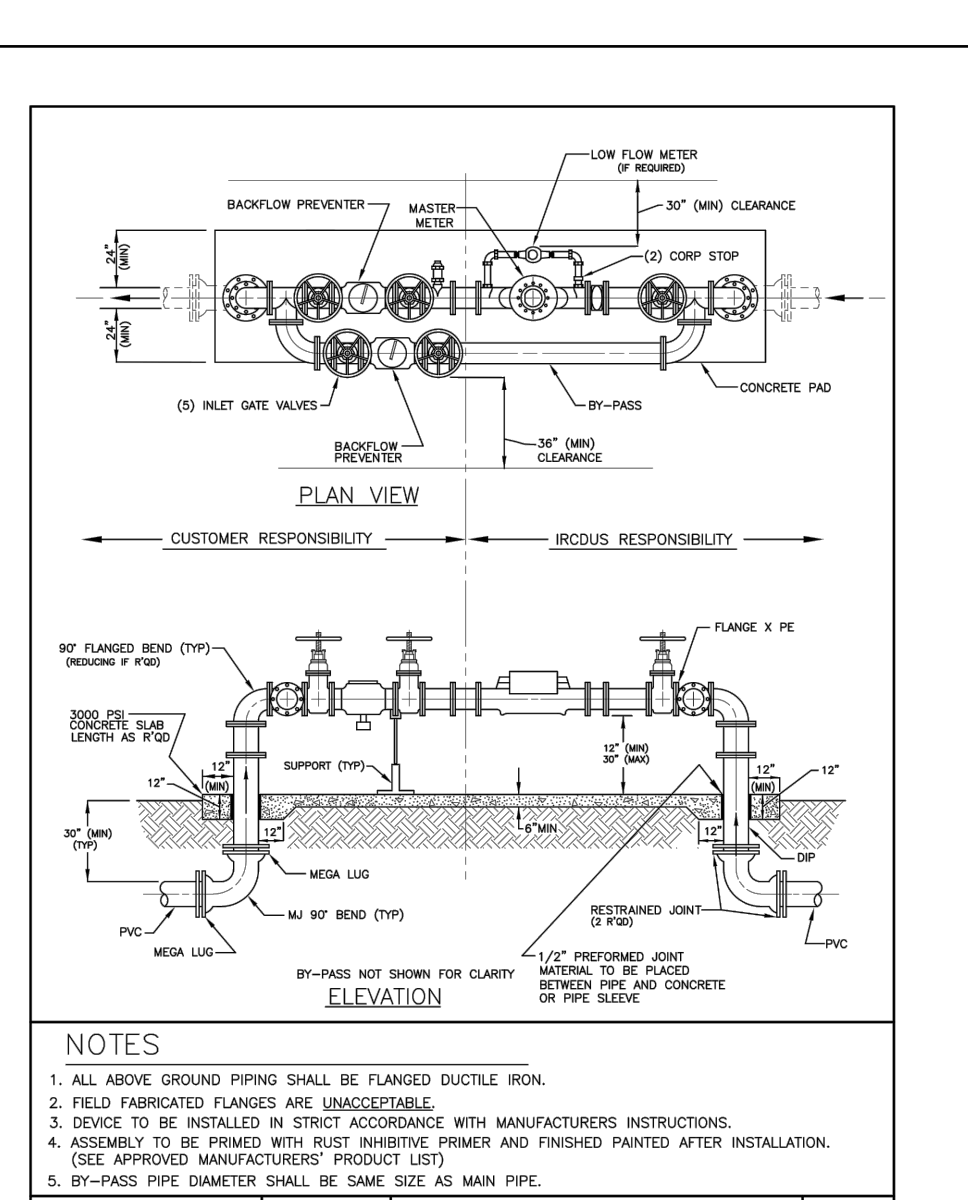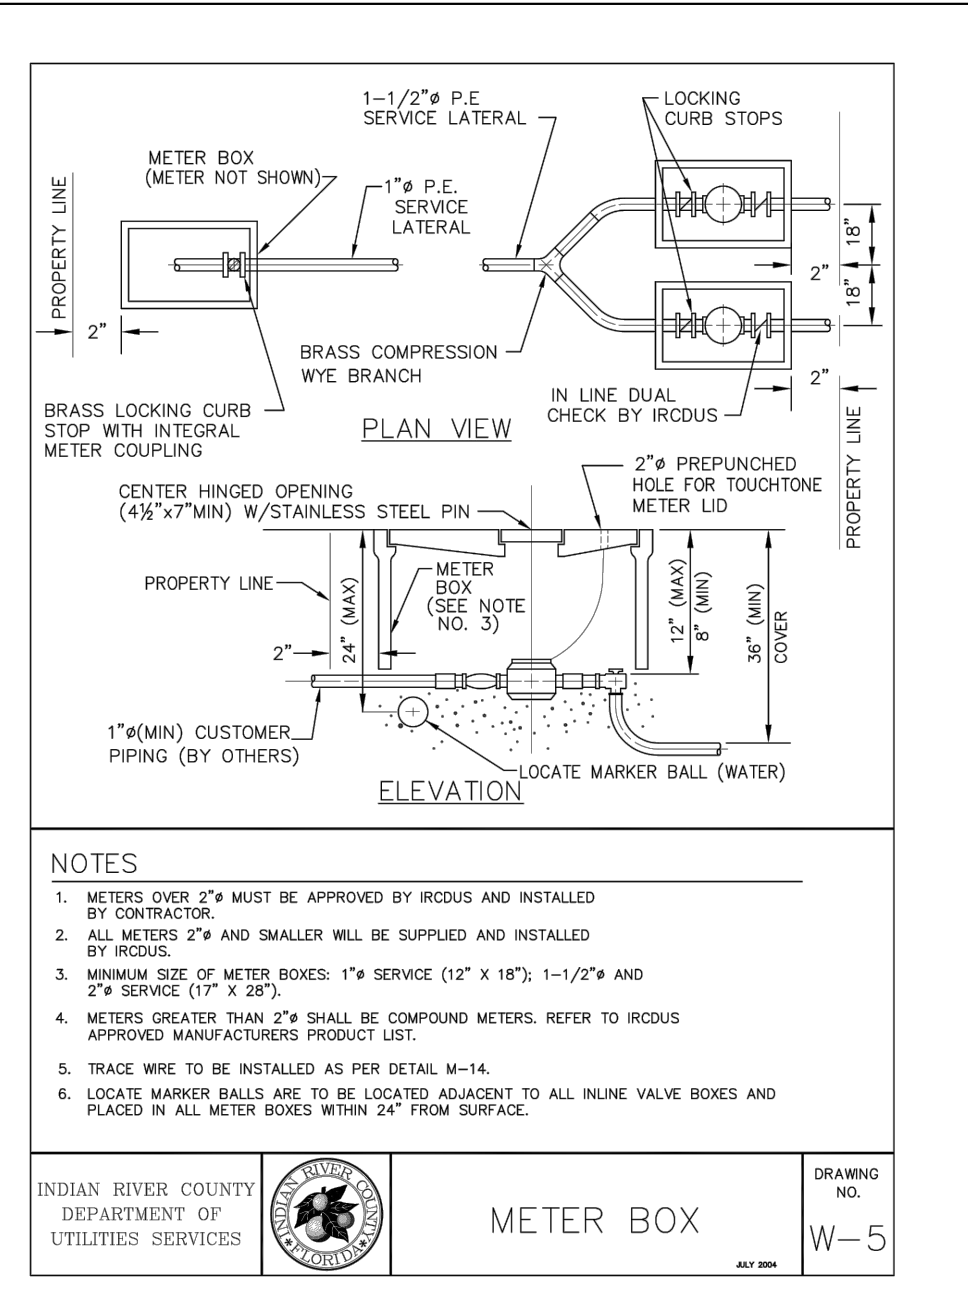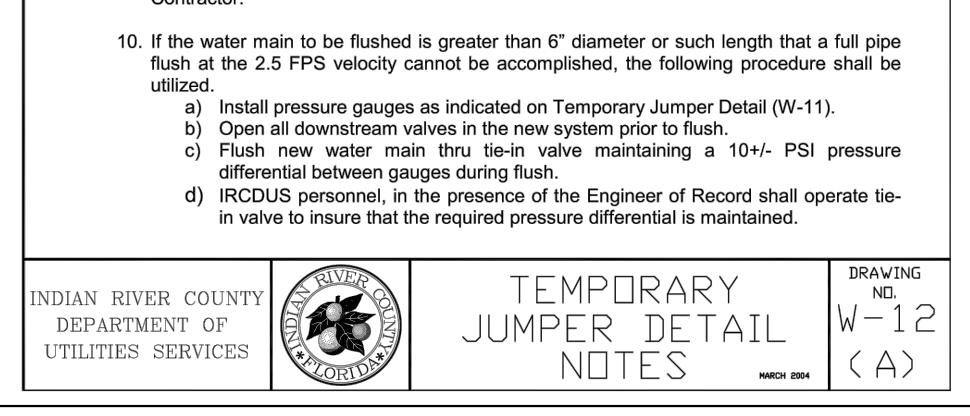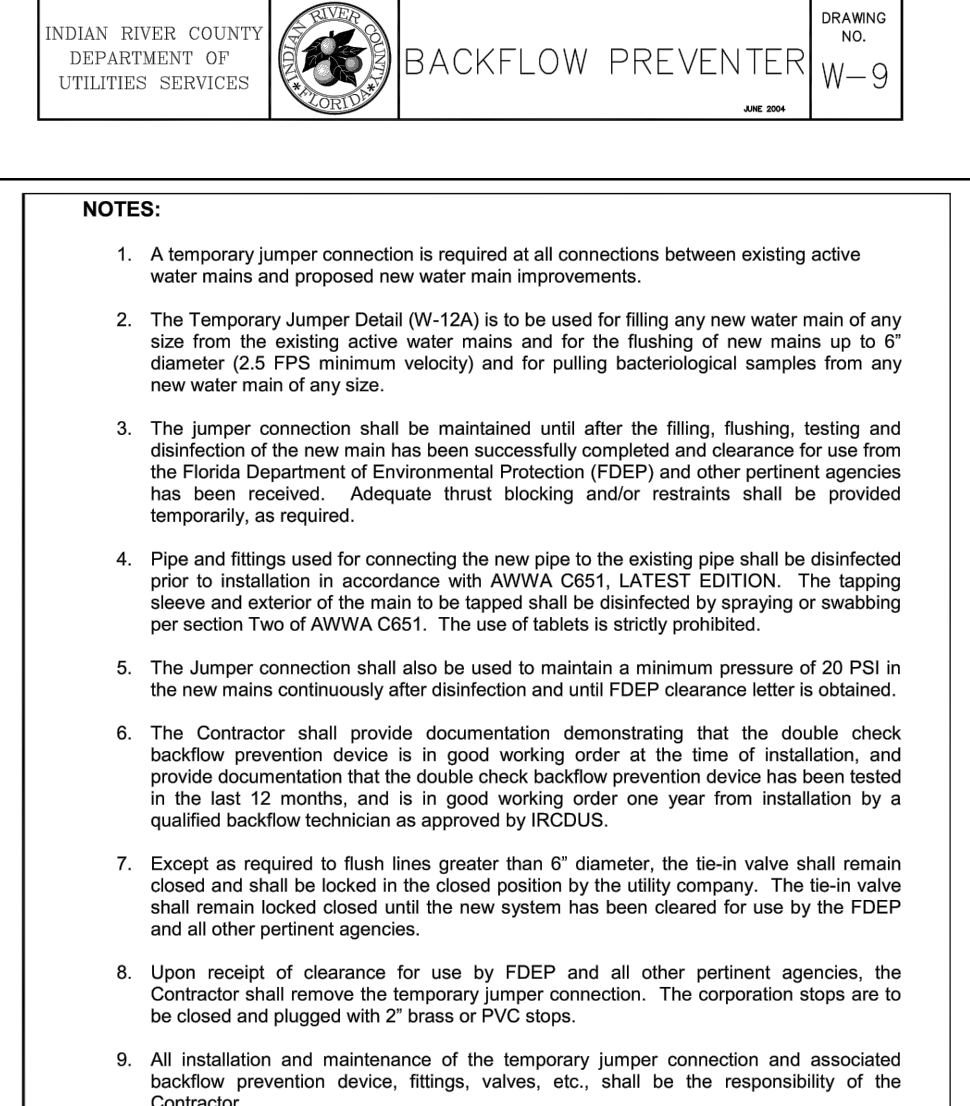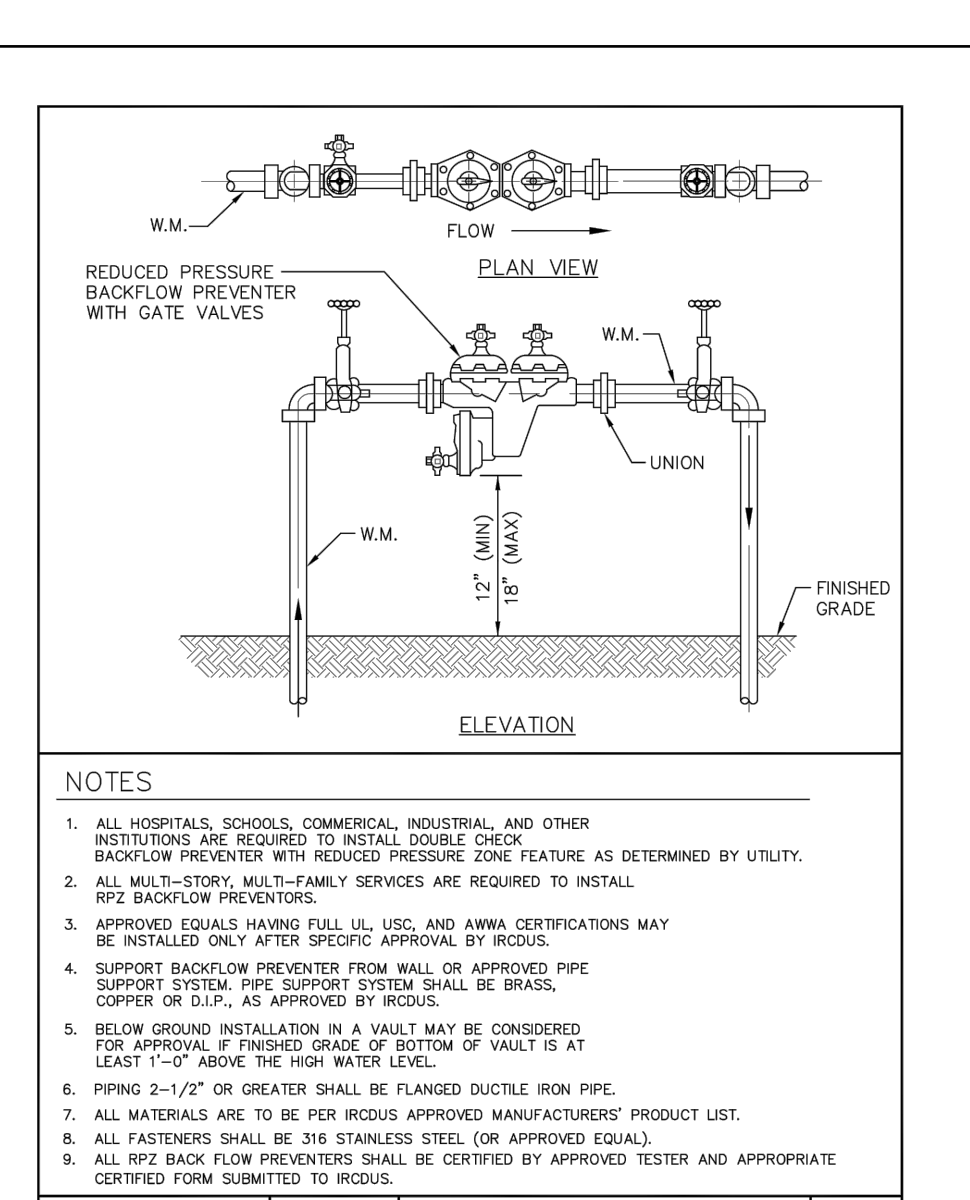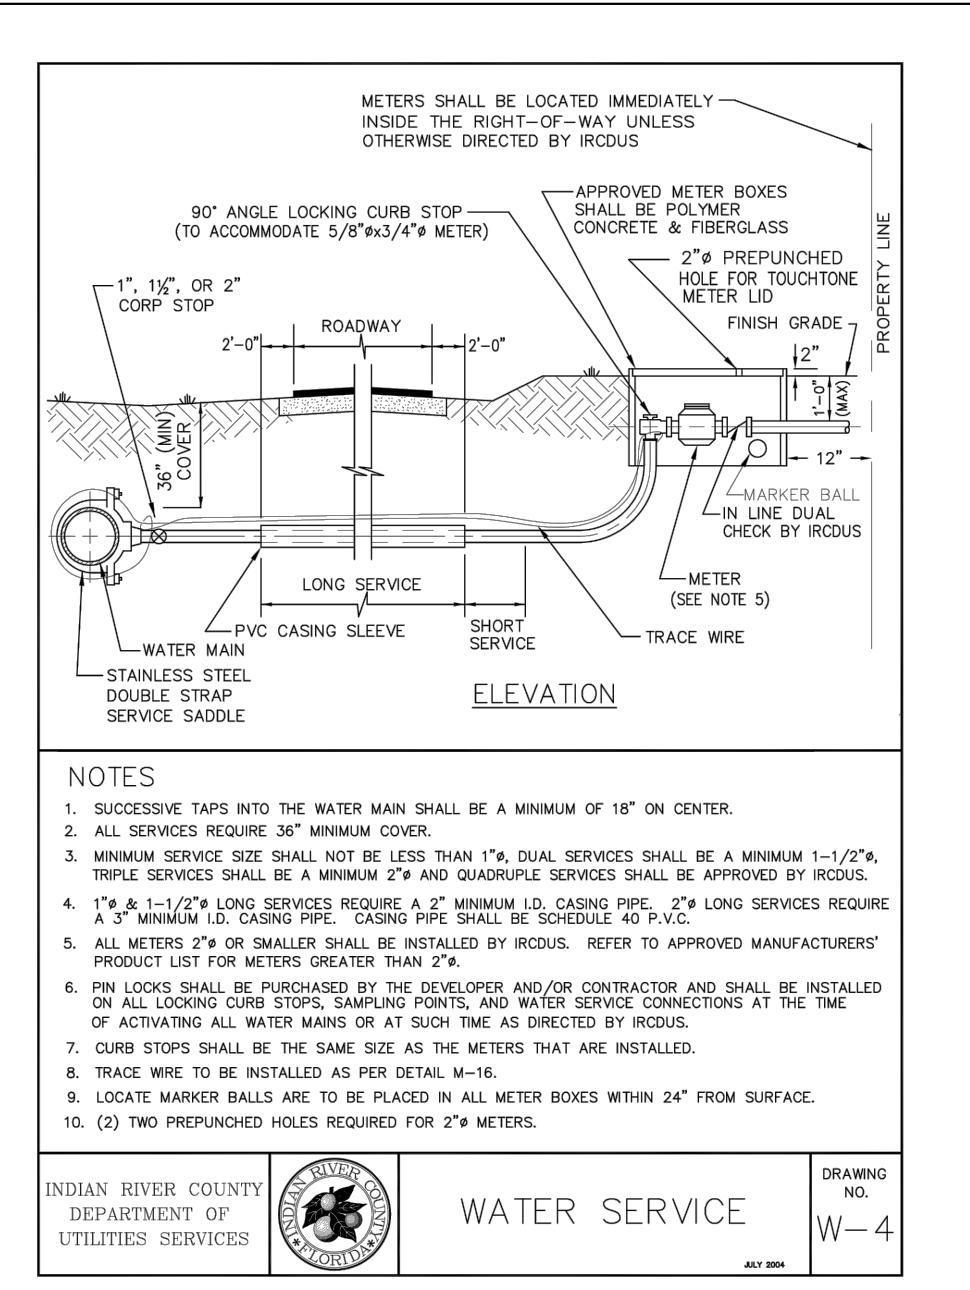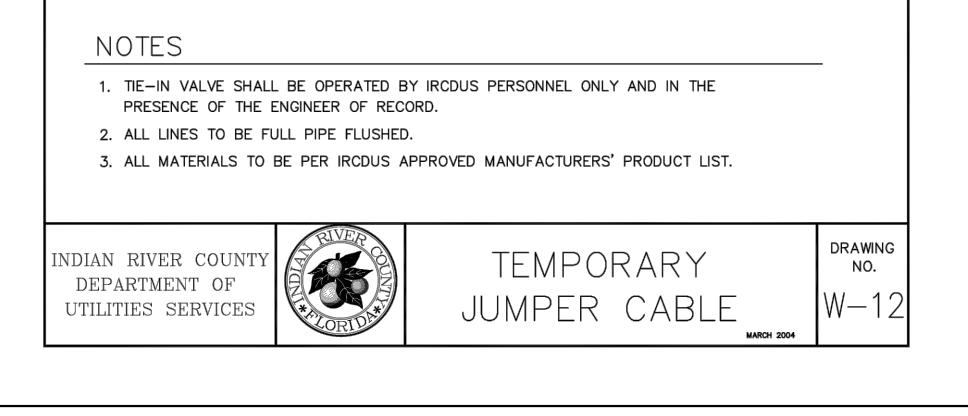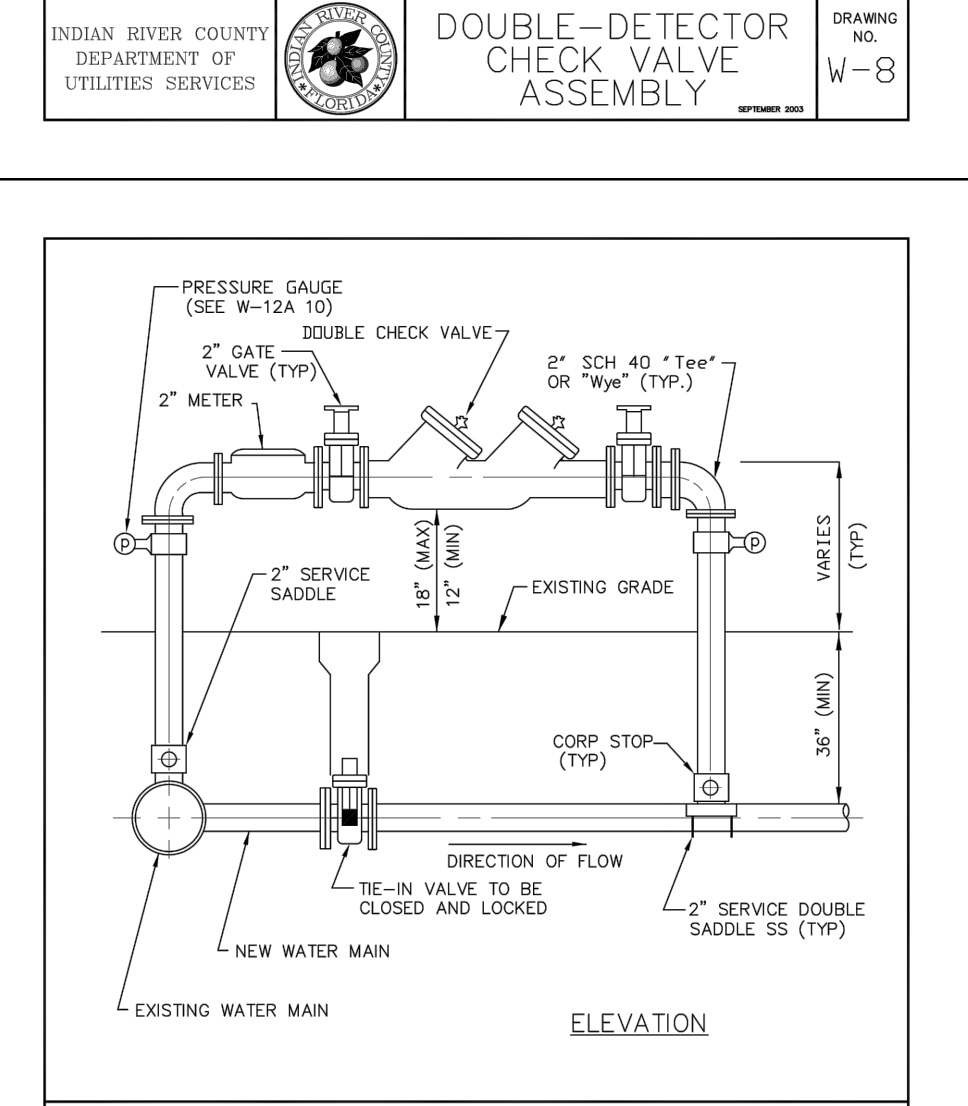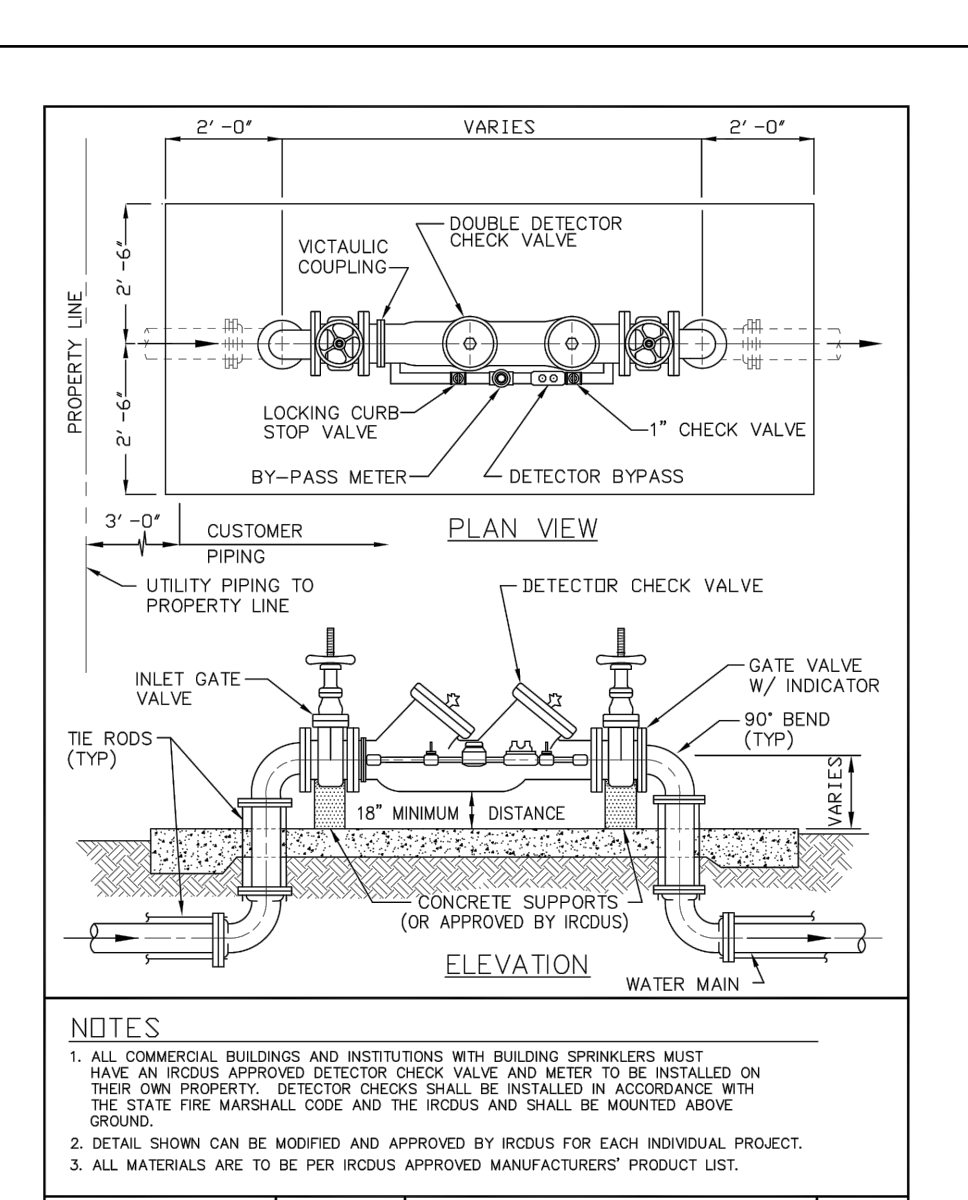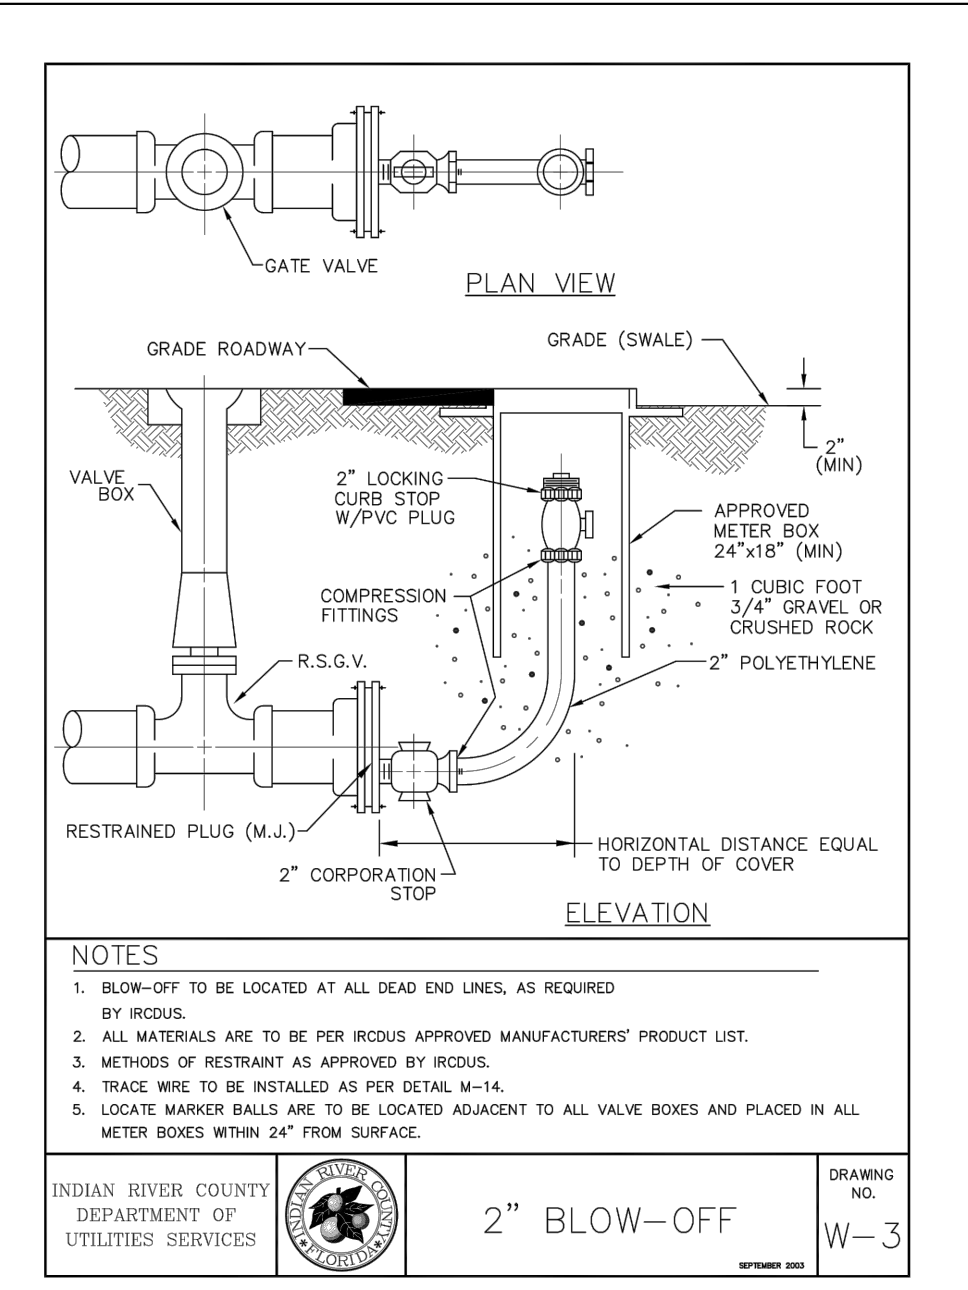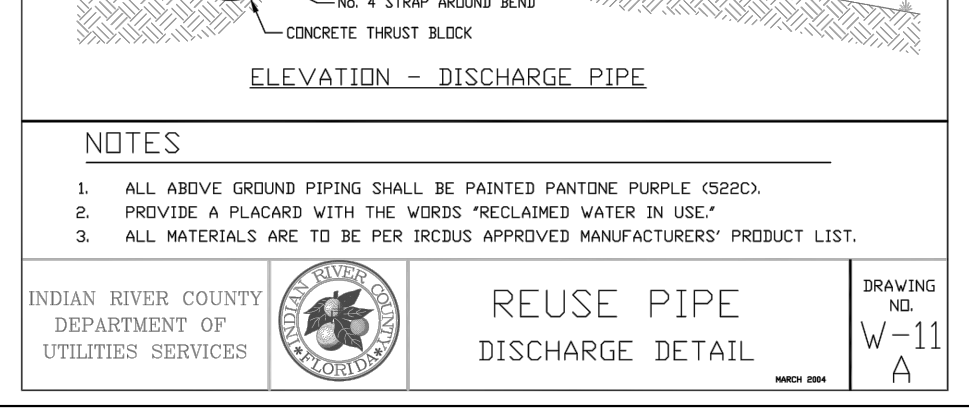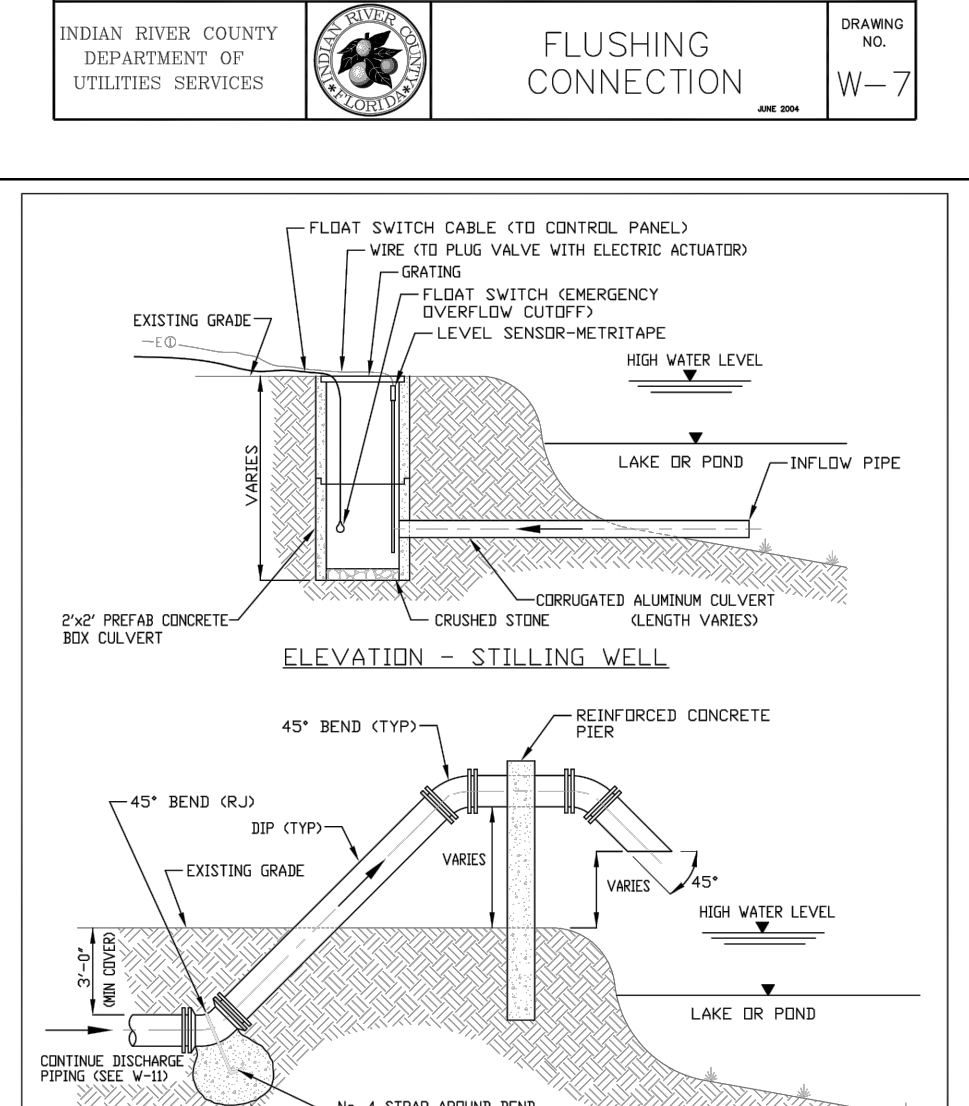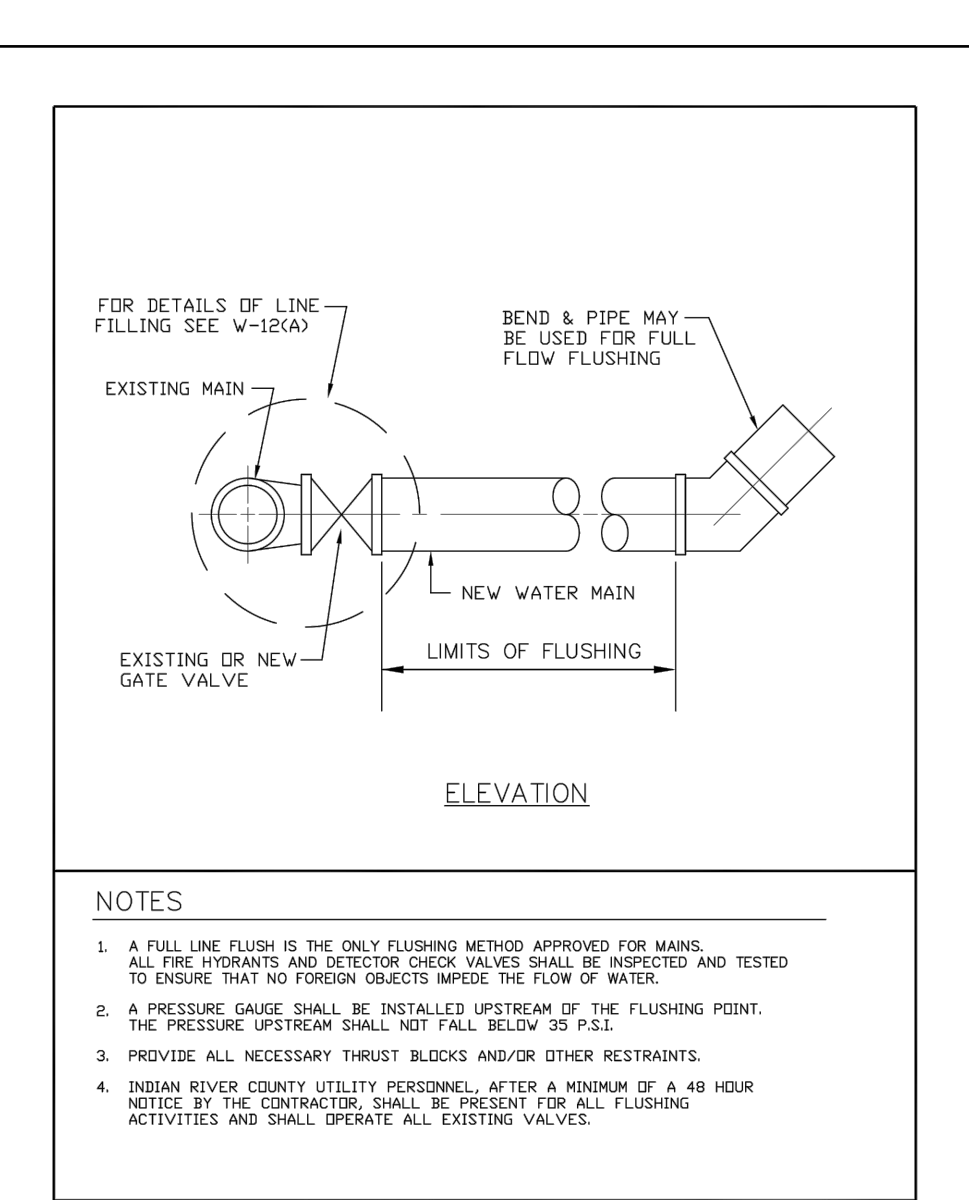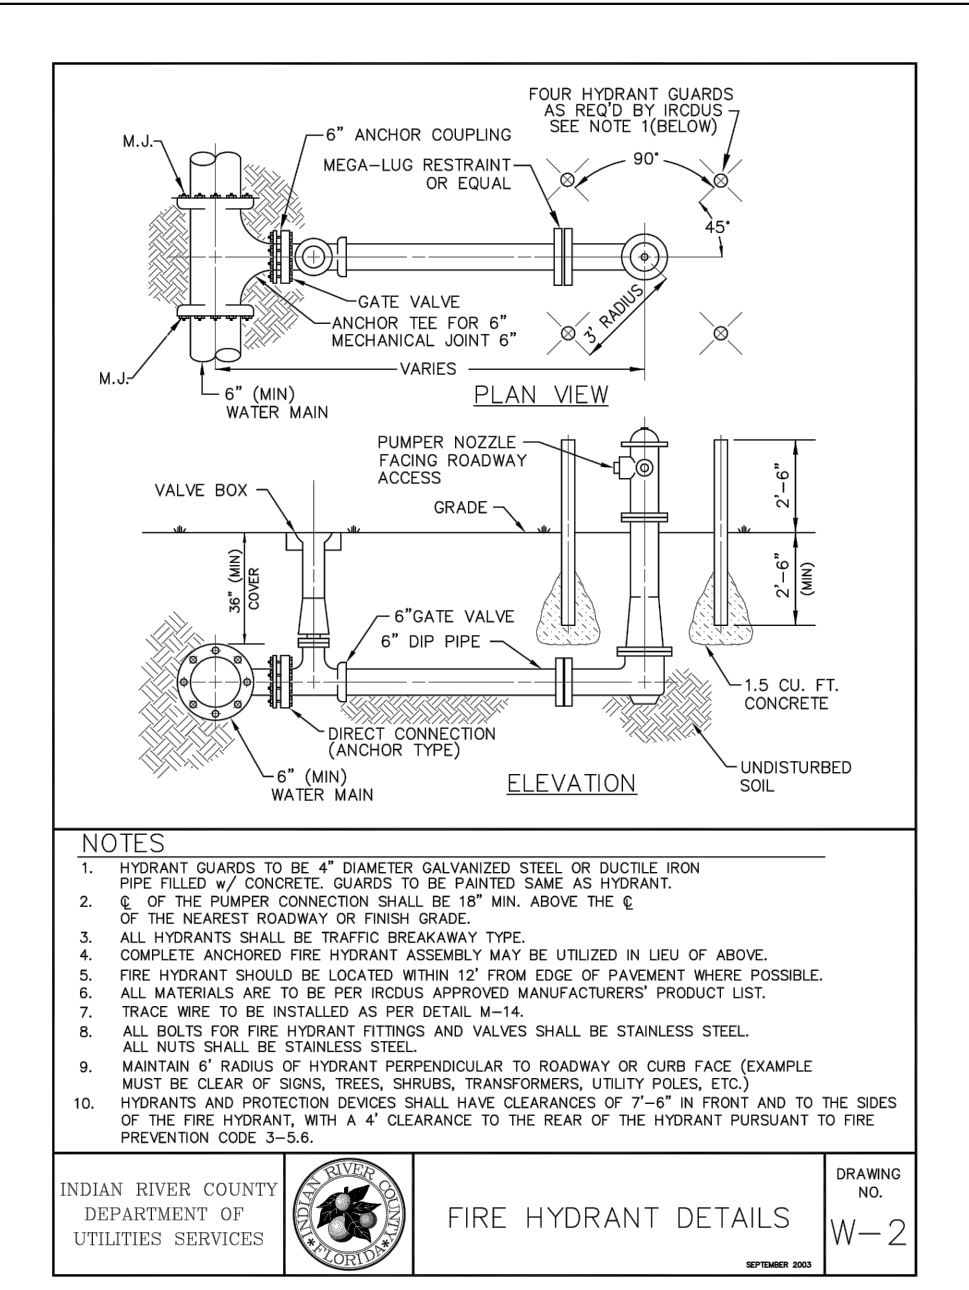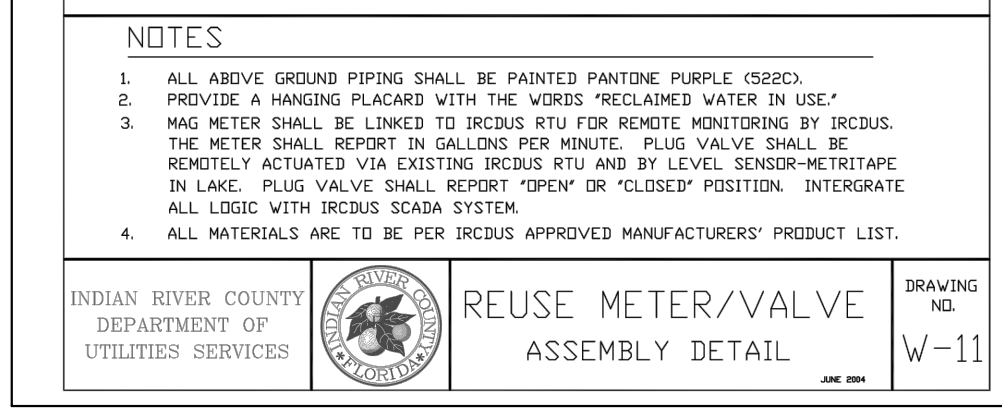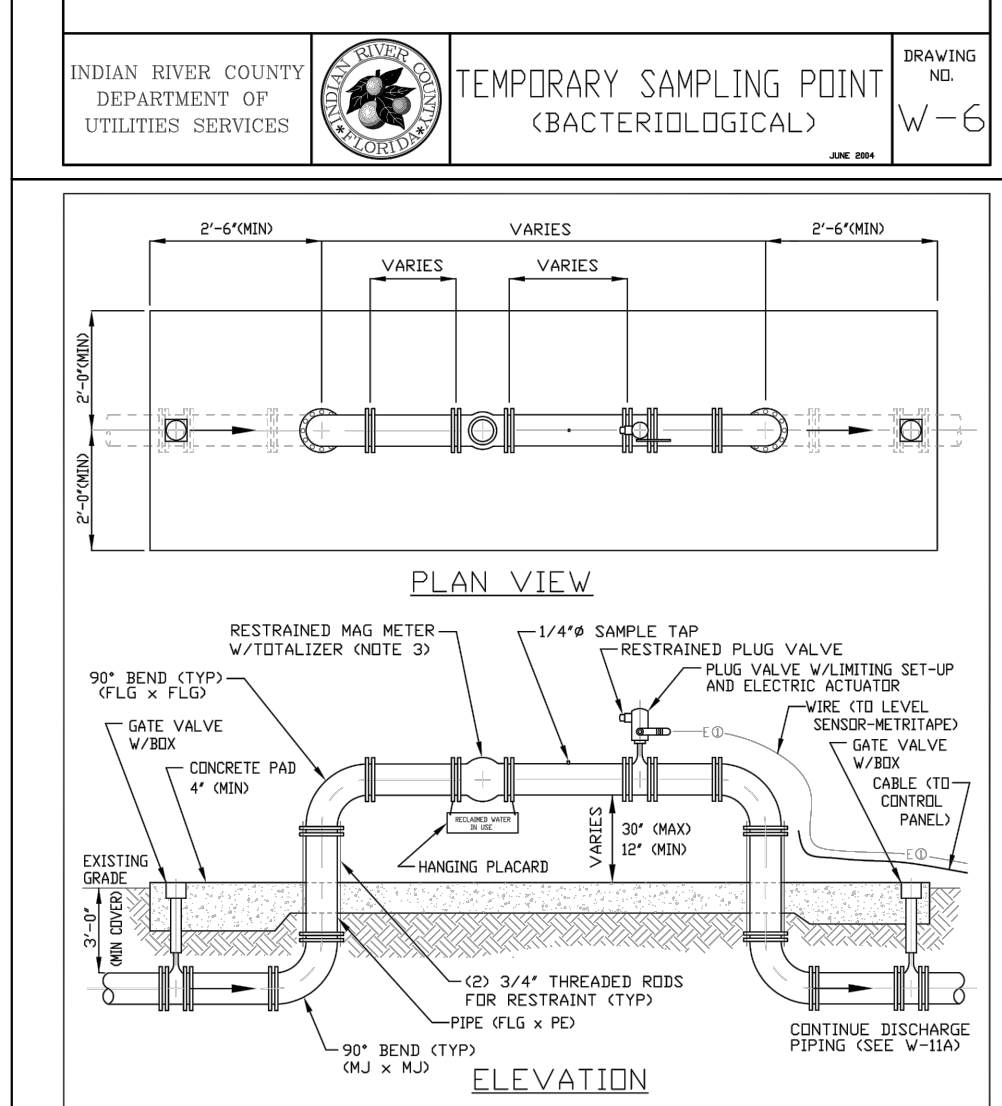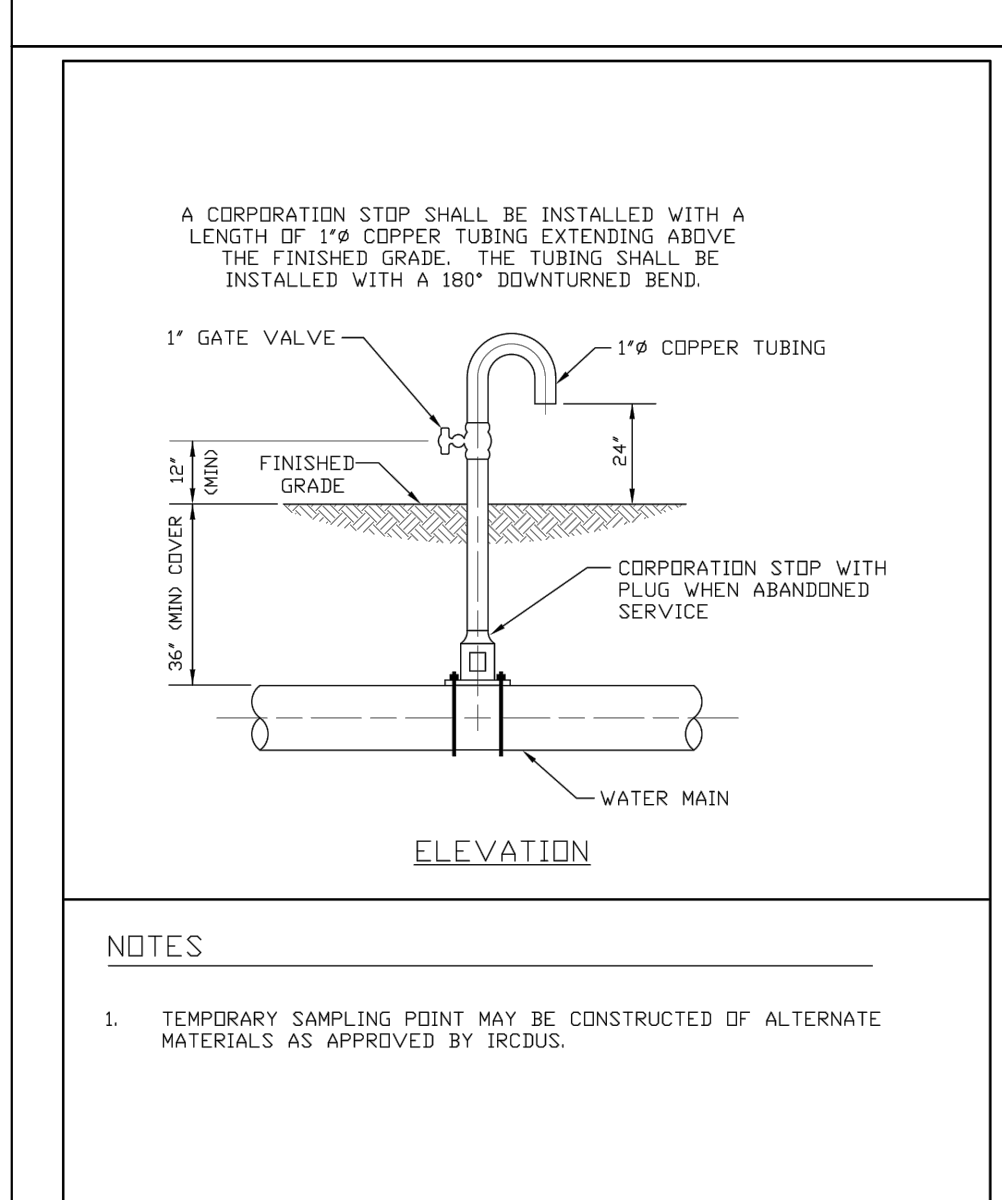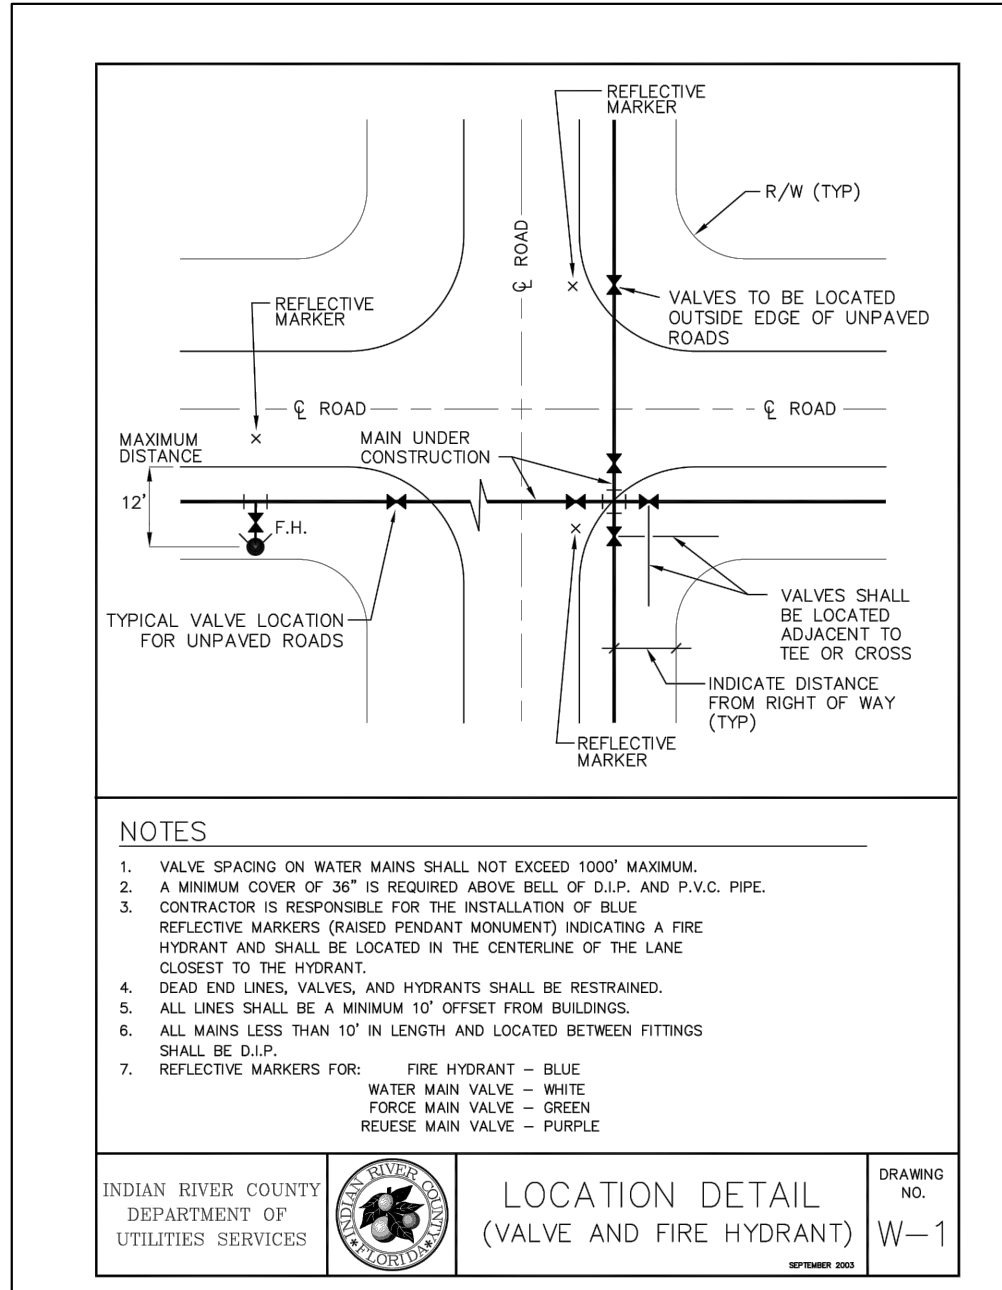

INDIAN RIVER COUNTY DEPARTMENT OF UTILITIES SERVICES  
 DRAWING NO. W-1

INDIAN RIVER COUNTY DEPARTMENT OF UTILITIES SERVICES  
 DRAWING NO. W-2

INDIAN RIVER COUNTY DEPARTMENT OF UTILITIES SERVICES  
 DRAWING NO. W-3

INDIAN RIVER COUNTY DEPARTMENT OF UTILITIES SERVICES  
 DRAWING NO. W-4

INDIAN RIVER COUNTY DEPARTMENT OF UTILITIES SERVICES  
 DRAWING NO. W-5

INDIAN RIVER COUNTY DEPARTMENT OF UTILITIES SERVICES  
 DRAWING NO. W-6

INDIAN RIVER COUNTY DEPARTMENT OF UTILITIES SERVICES  
 DRAWING NO. W-7

INDIAN RIVER COUNTY DEPARTMENT OF UTILITIES SERVICES  
 DRAWING NO. W-8

INDIAN RIVER COUNTY DEPARTMENT OF UTILITIES SERVICES  
 DRAWING NO. W-9

INDIAN RIVER COUNTY DEPARTMENT OF UTILITIES SERVICES  
 DRAWING NO. W-10

INDIAN RIVER COUNTY DEPARTMENT OF UTILITIES SERVICES  
 DRAWING NO. W-11

INDIAN RIVER COUNTY DEPARTMENT OF UTILITIES SERVICES  
 DRAWING NO. W-11

INDIAN RIVER COUNTY DEPARTMENT OF UTILITIES SERVICES  
 DRAWING NO. W-12

INDIAN RIVER COUNTY DEPARTMENT OF UTILITIES SERVICES  
 DRAWING NO. W-12

INDIAN RIVER COUNTY DEPARTMENT OF UTILITIES SERVICES  
 DRAWING NO. W-12

|     |           |      |
|-----|-----------|------|
| NO. | REVISIONS | DATE |
|     |           |      |

**Kimley-Horn**  
 © 2021 KIMLEY-HORN AND ASSOCIATES, INC.  
 355 ALHAMBRA CIRCLE, SUITE 1400, CORAL GABLES, FL 33134  
 PHONE: 305-673-2025  
 WWW.KIMLEY-HORN.COM REGISTRY 696


LICENSED PROFESSIONAL  
 KHA PROJECT 14-3228000  
 DATE JULY 2021  
 SCALE AS SHOWN  
 DESIGNED BY MRC  
 DRAWN BY RMR  
 CHECKED BY BF

INDIAN RIVER COUNTY WATER  
 COUNTY WATER  
 DETAILS

INDIAN RIVER COUNTY  
 PREPARED FOR  
 IRC LANDFILL  
 SHEET NUMBER  
 C-712

















**Sunshine811**  
 Call 811 or www.sunshine811.com two full business days before digging to have utilities located and marked.  
 Check positive response codes before you dig!

This item has been digitally signed and sealed by the State of Florida. The date adjacent to the seal.  
 Printed copies of this document are not considered signed and sealed and the signature must be verified on any electronic copies.  
 Date: 11/17/2021

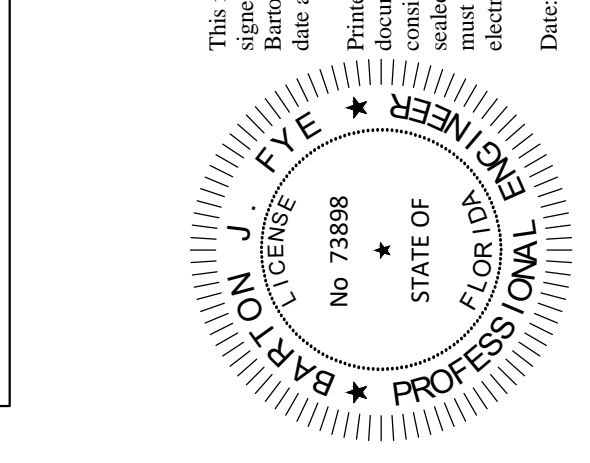



Plotted By: Rodriguez, Rebecca - Sheet Set: IRC LANDFILL - Layout: C-713 INDIAN RIVER COUNTY SEWER DETAILS - November 17, 2021 - 10:43:04am - K:\mb-clvl\143228000 - irc shrw and recycling - 0611\A\CADD\plansheets\C-713 INDIAN RIVER COUNTY SEWER DETAILS.dwg - This document, together with the concepts and designs presented herein, is intended only for the specific purpose and client for which it was prepared. Reuse of and improper reliance on this document without written authorization and adaptation by Kimley-Horn and Associates, Inc. shall be without liability to Kimley-Horn and Associates, Inc.

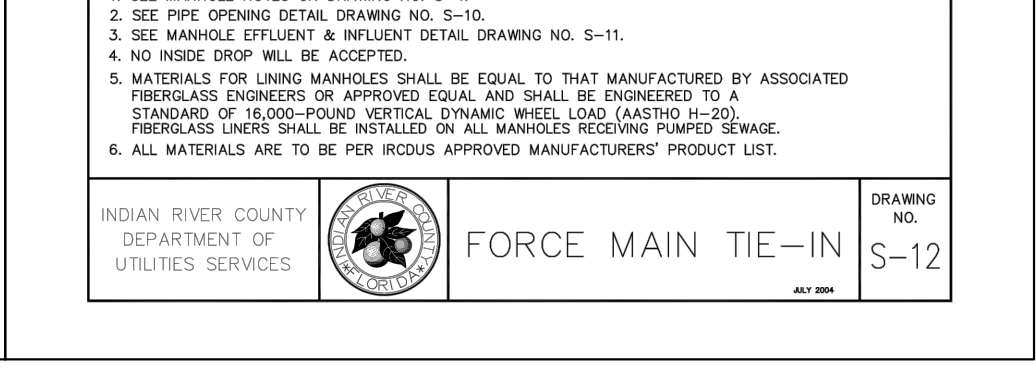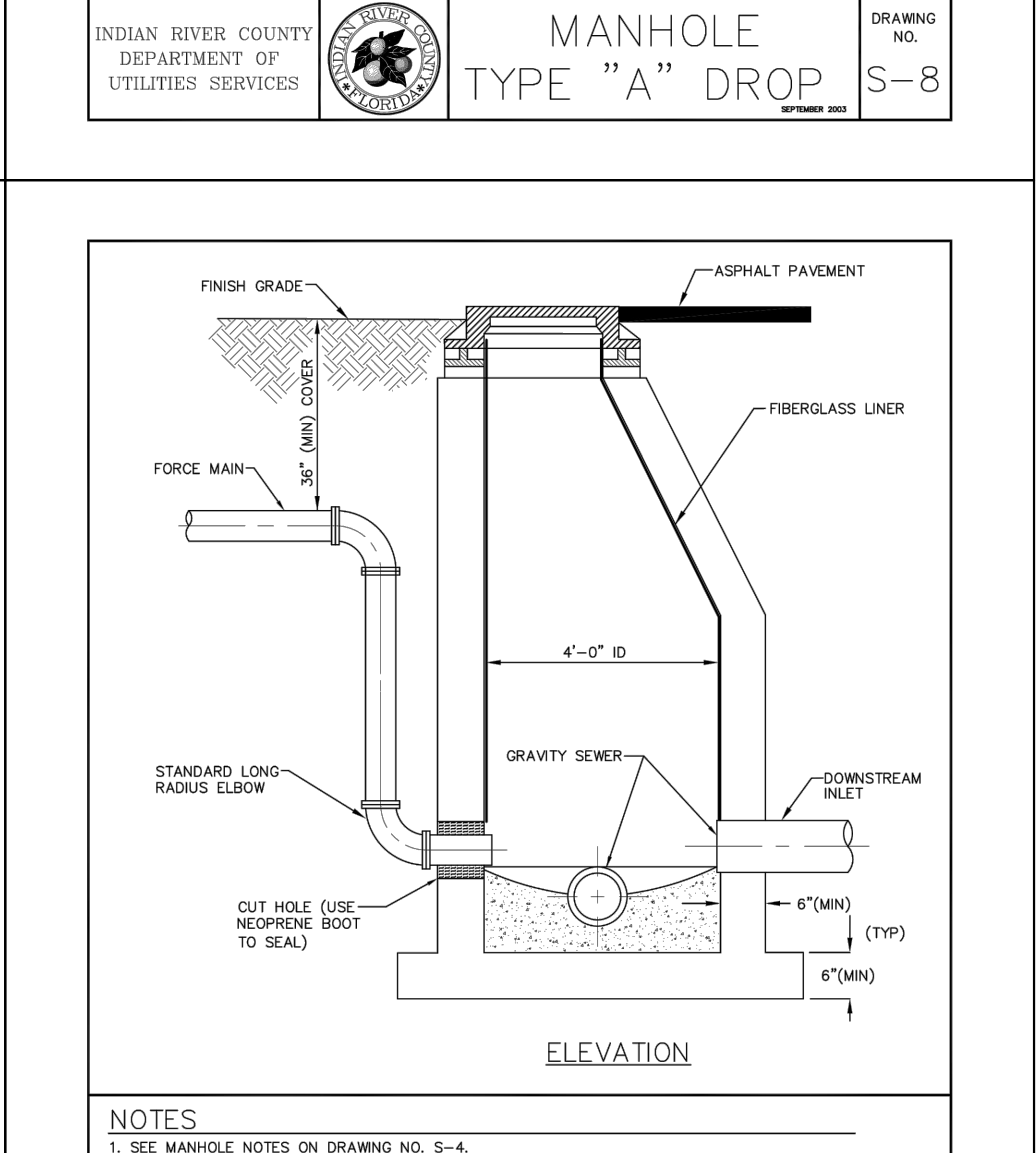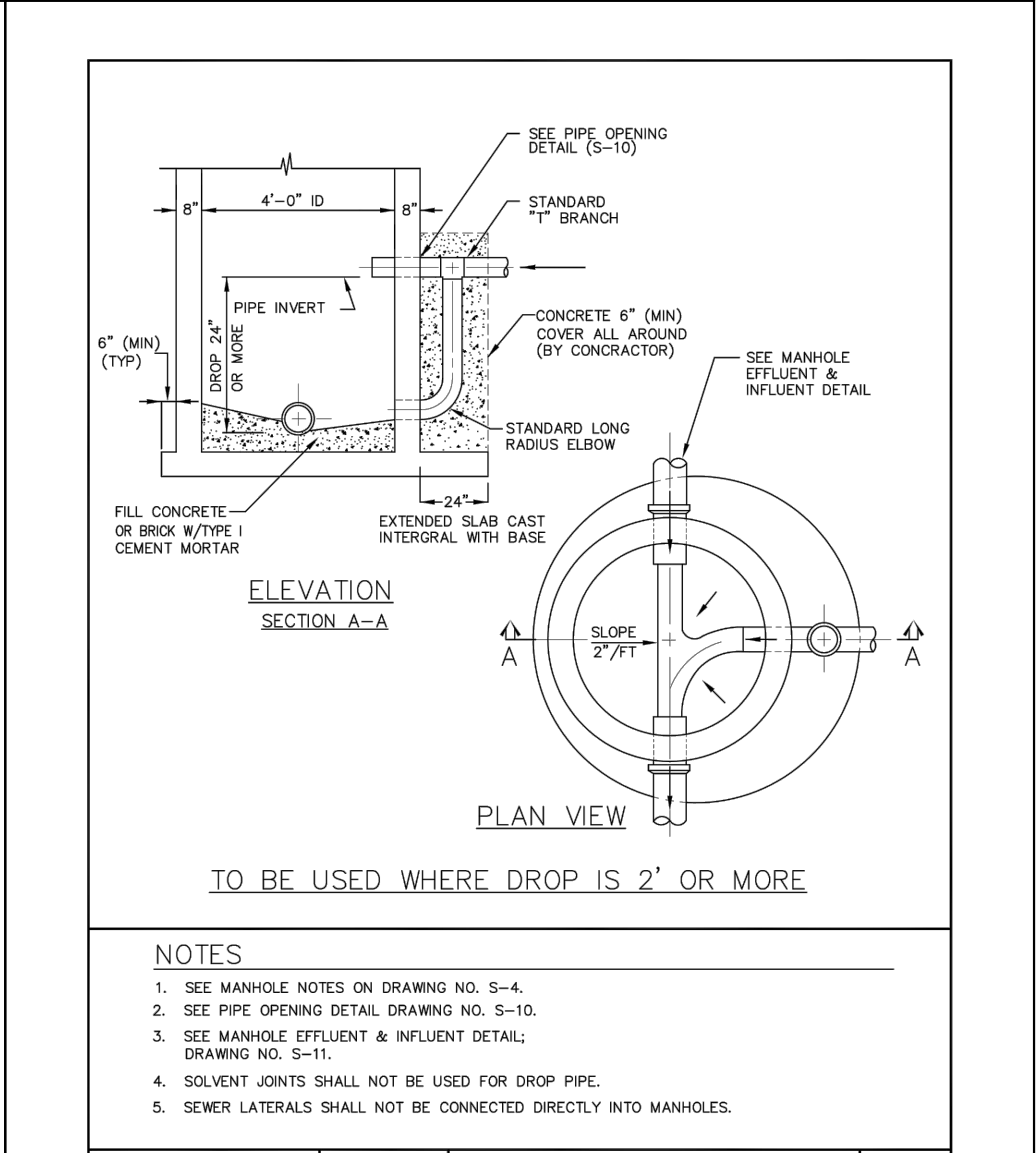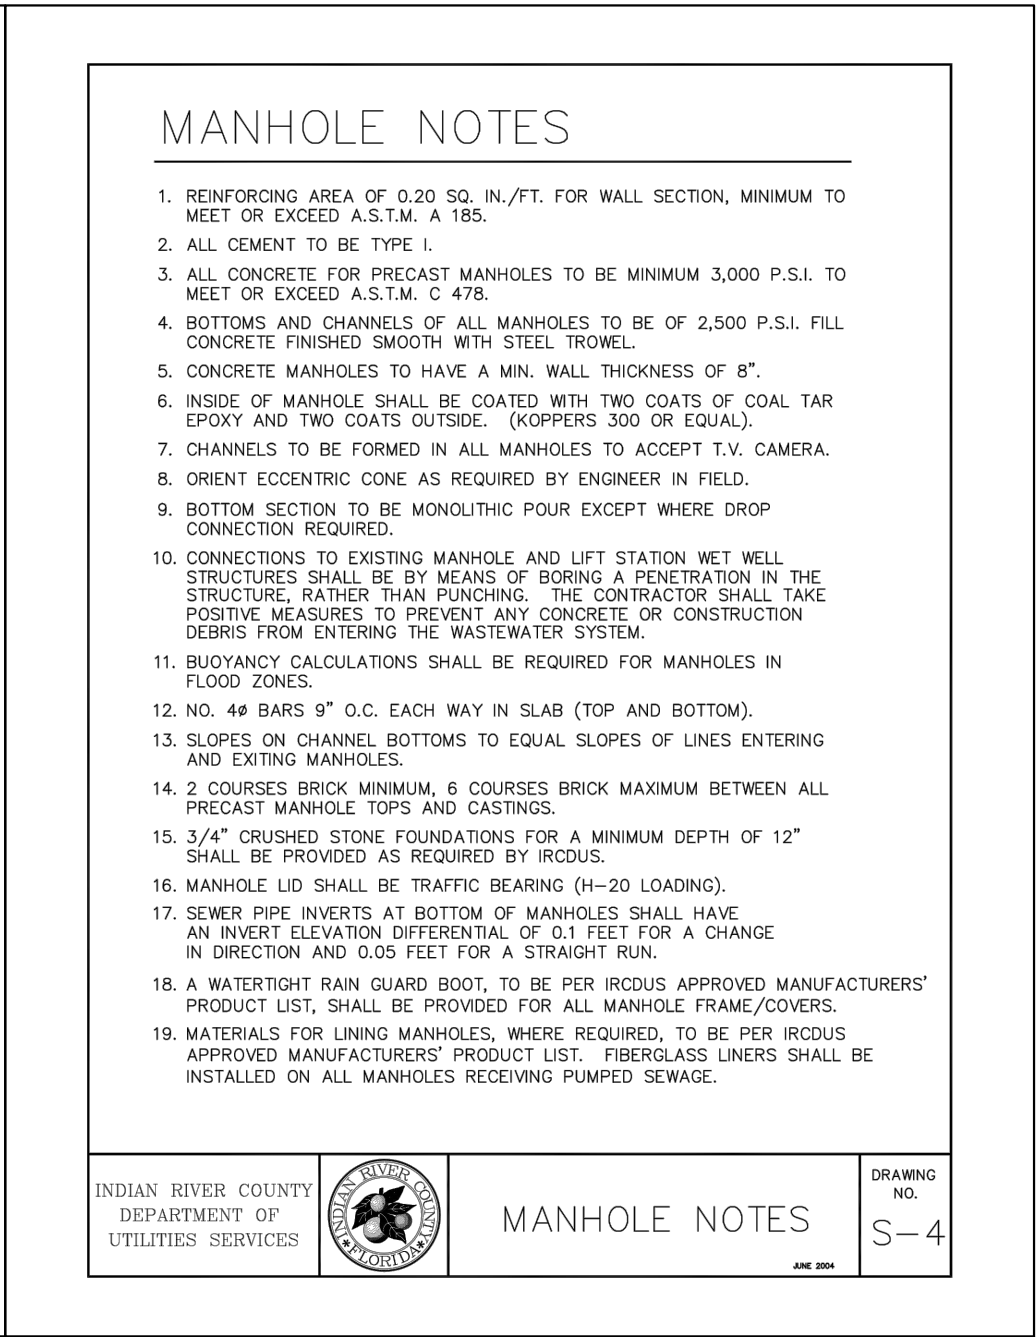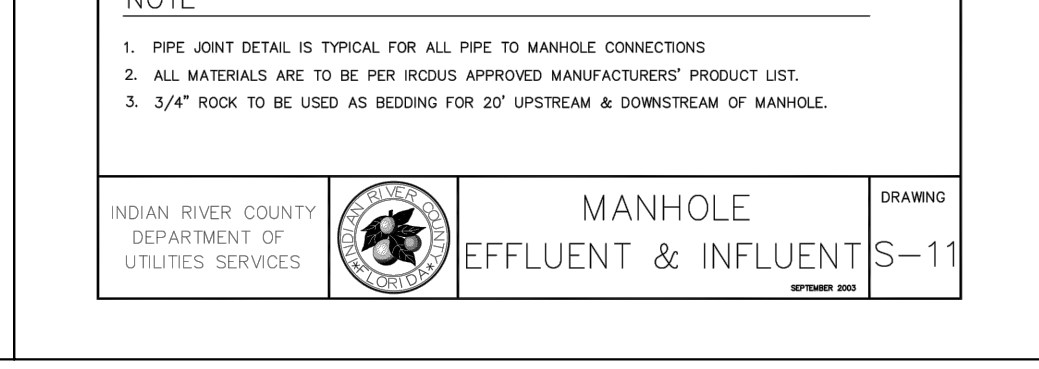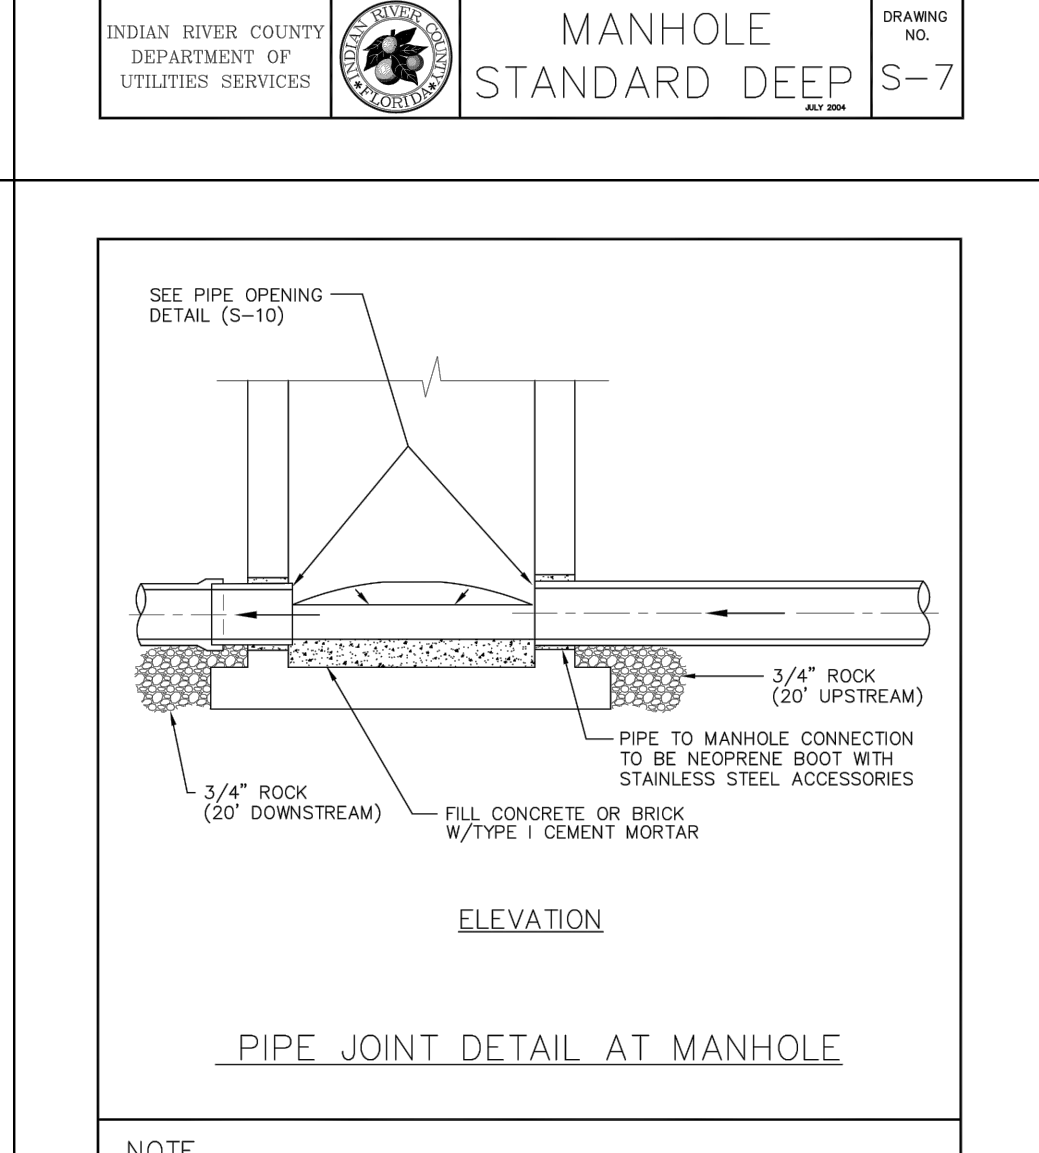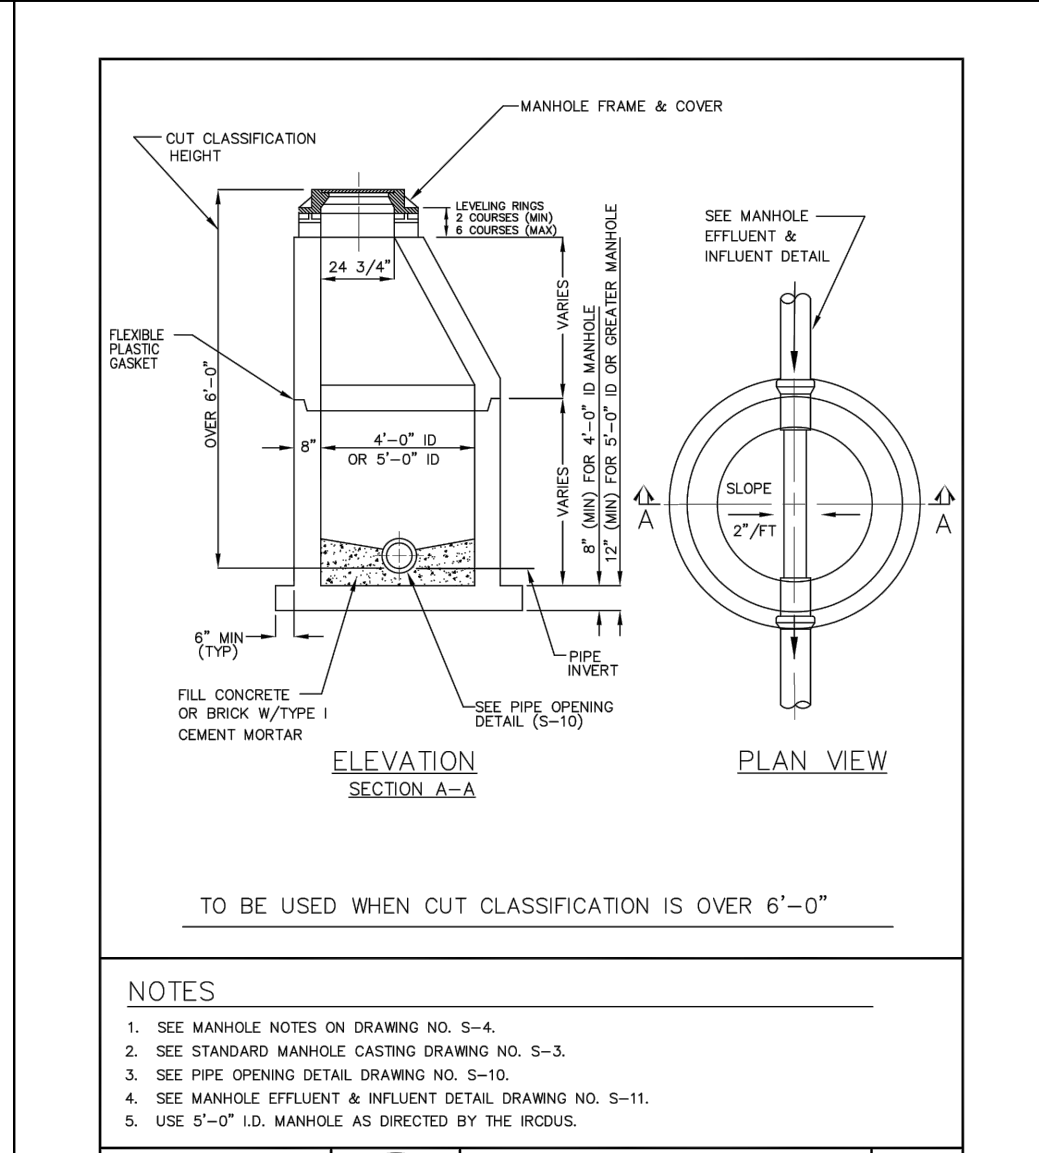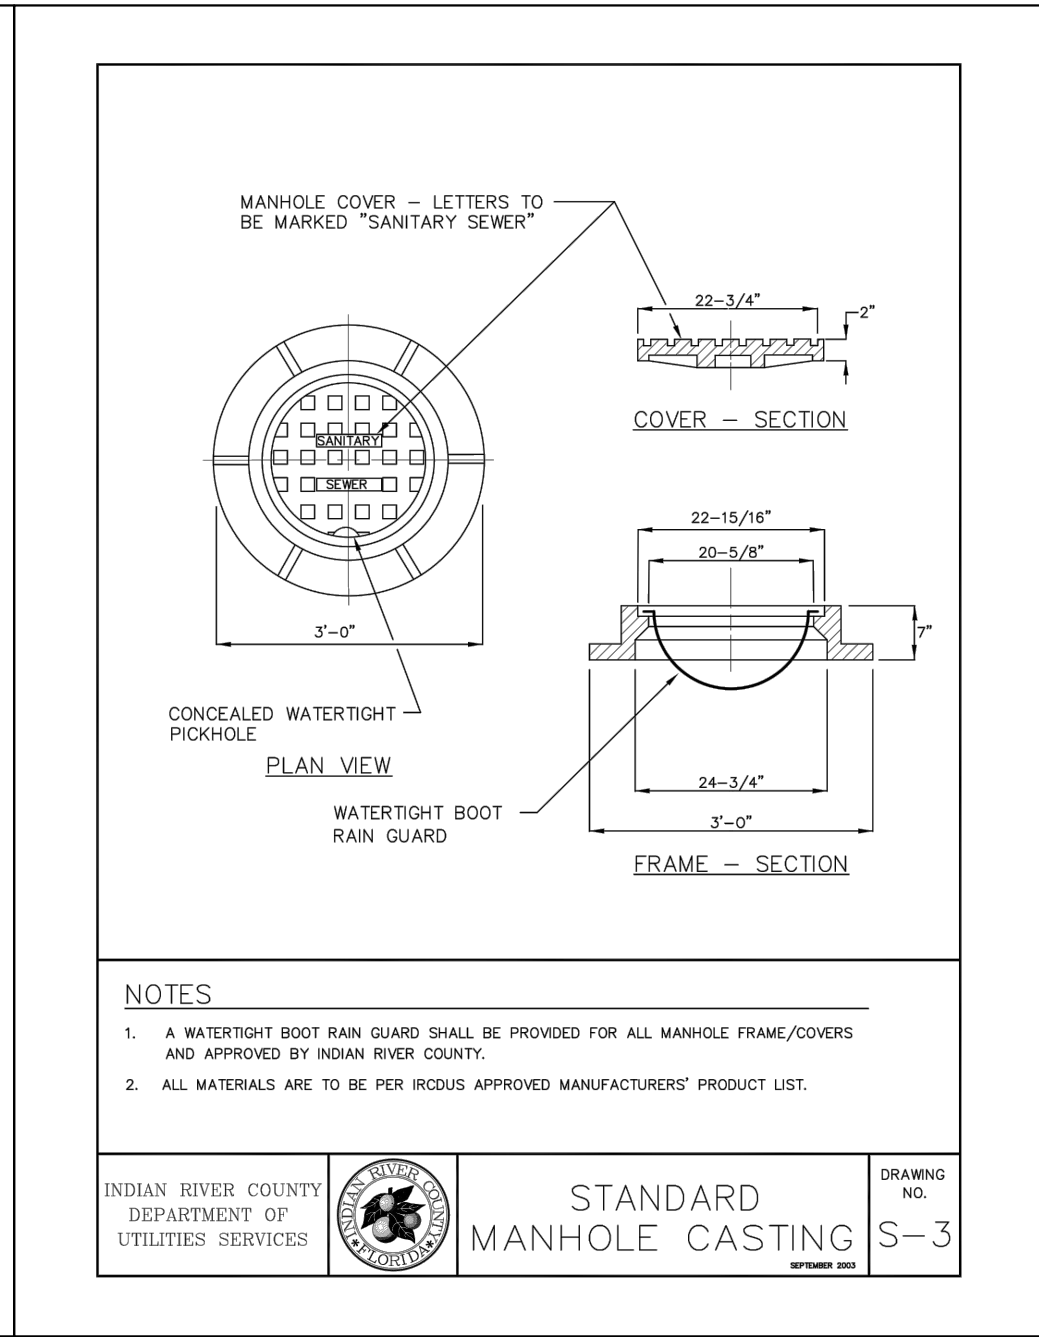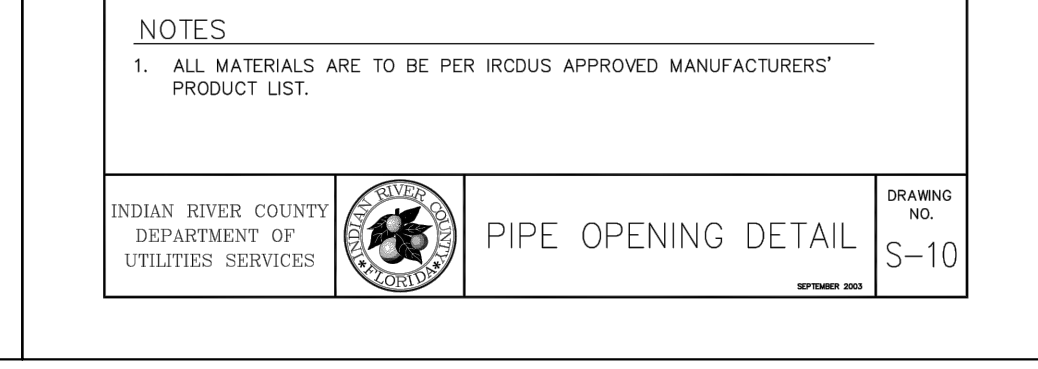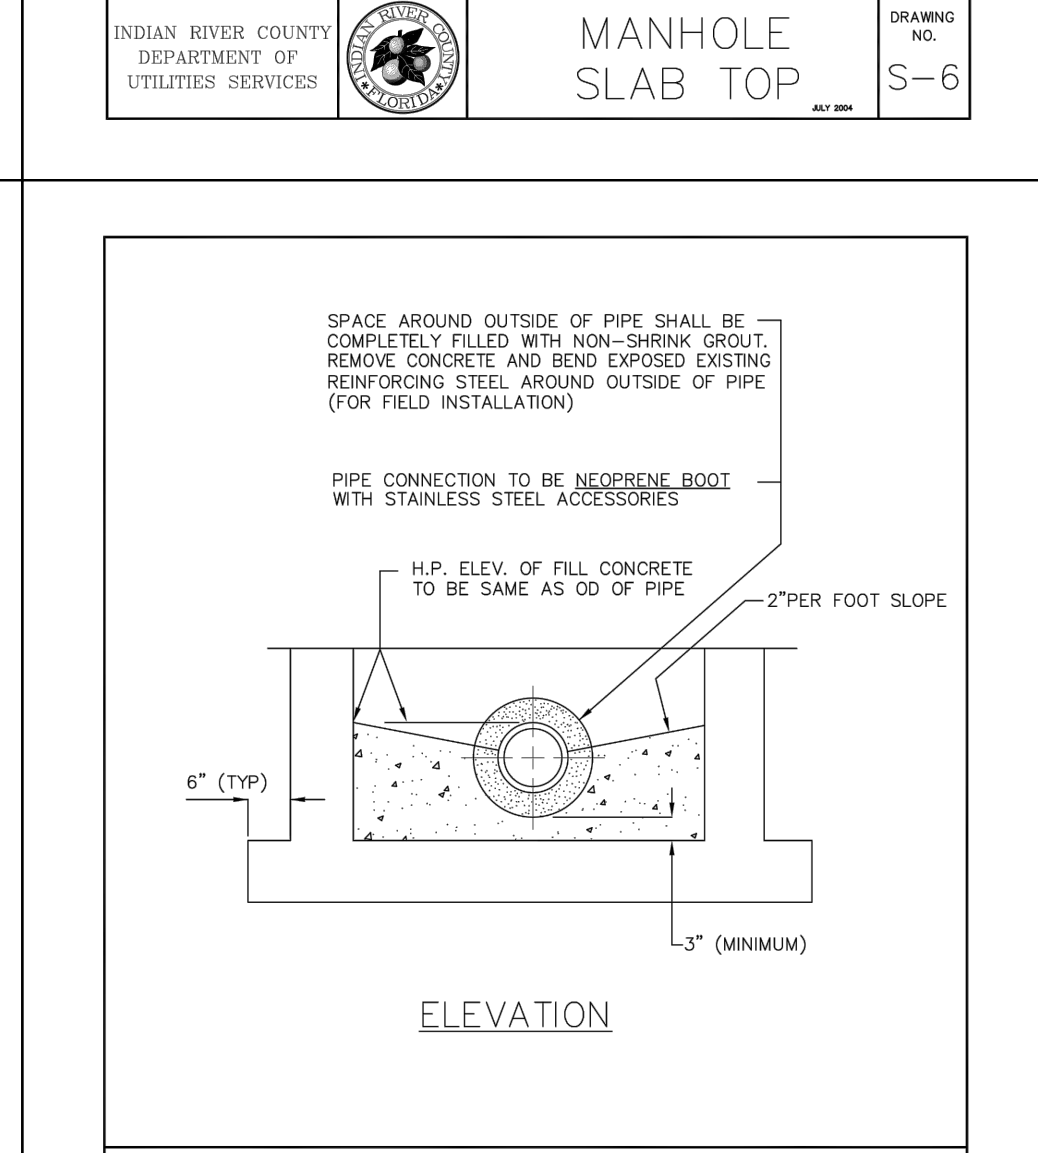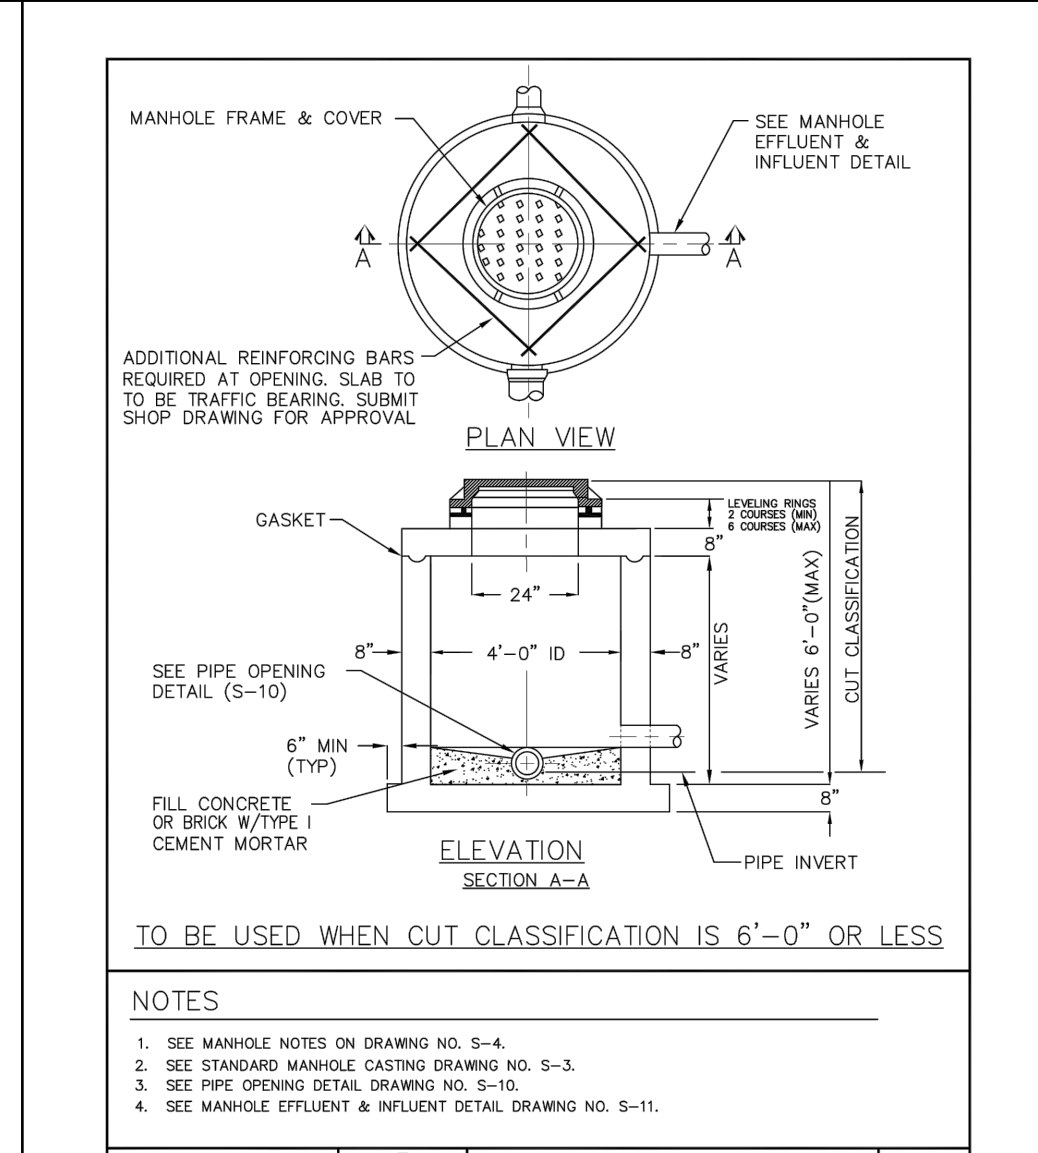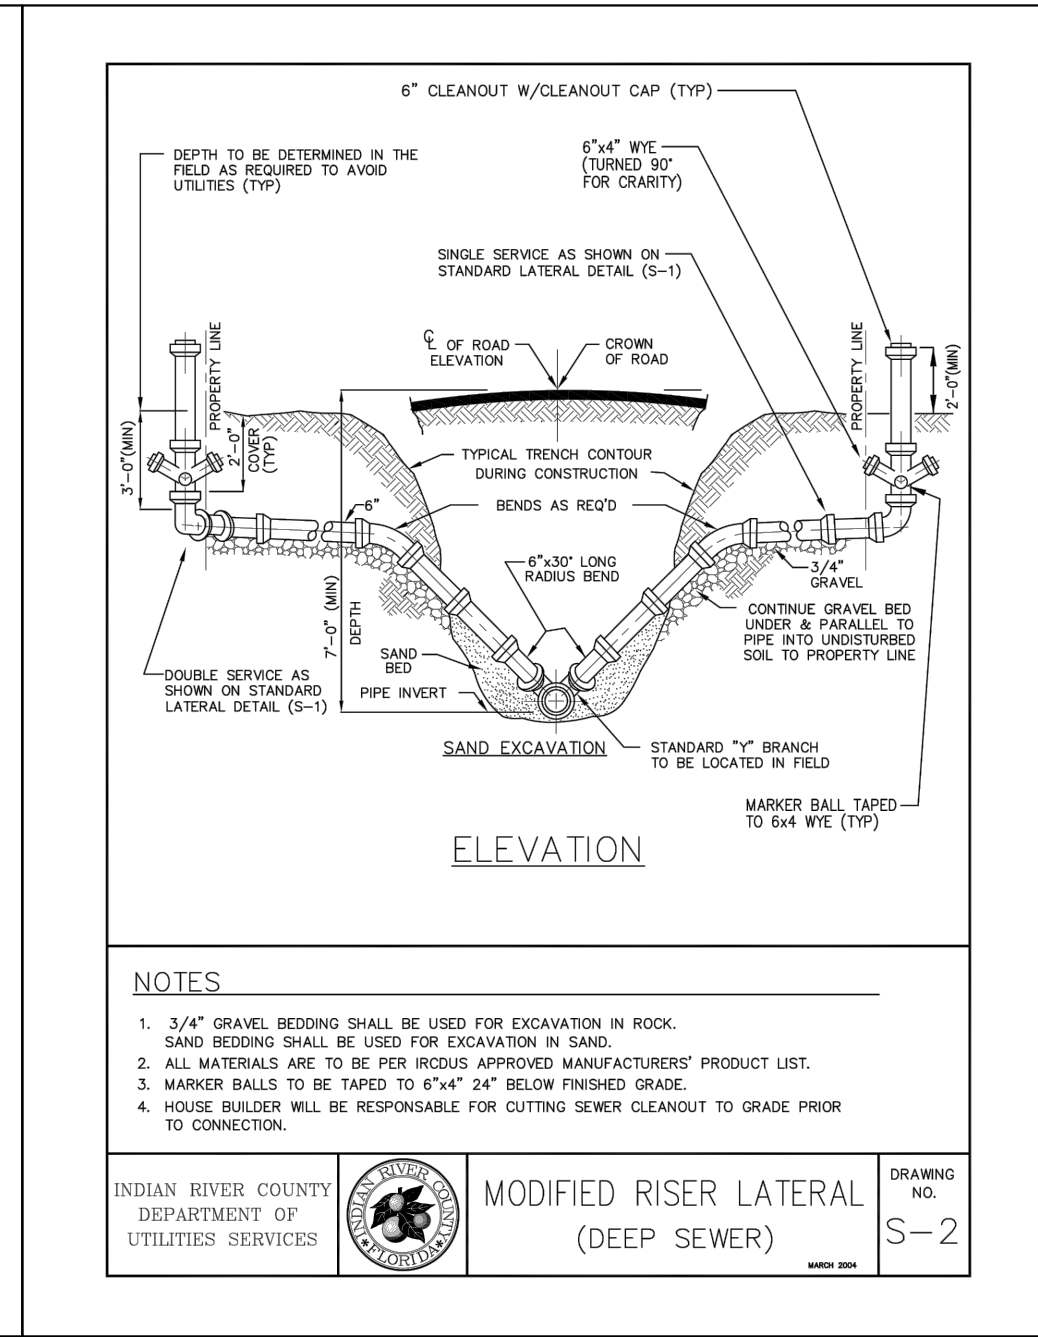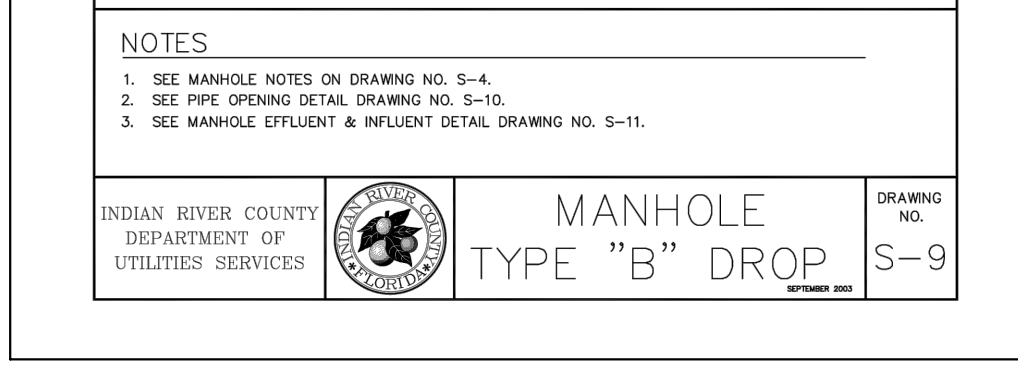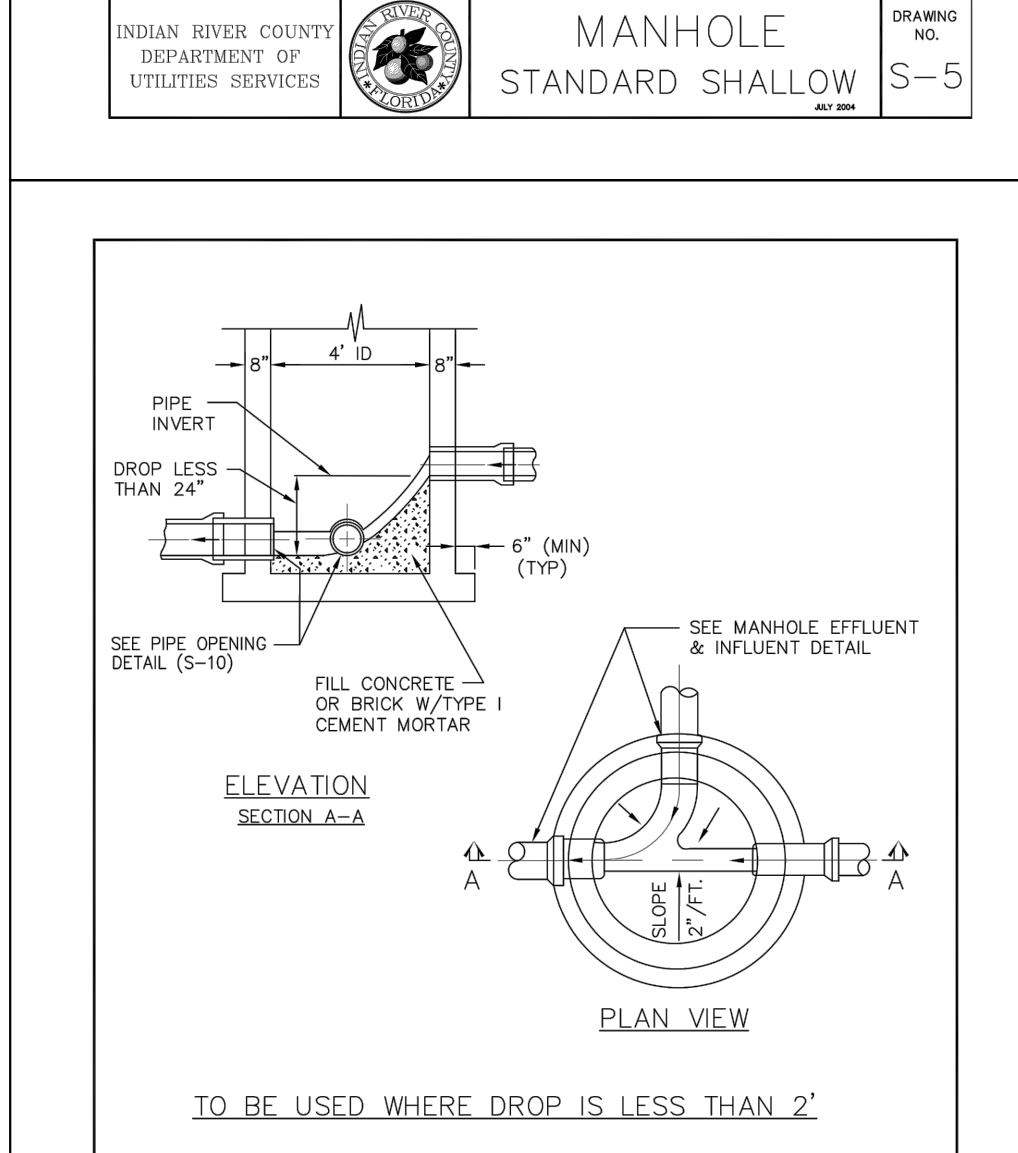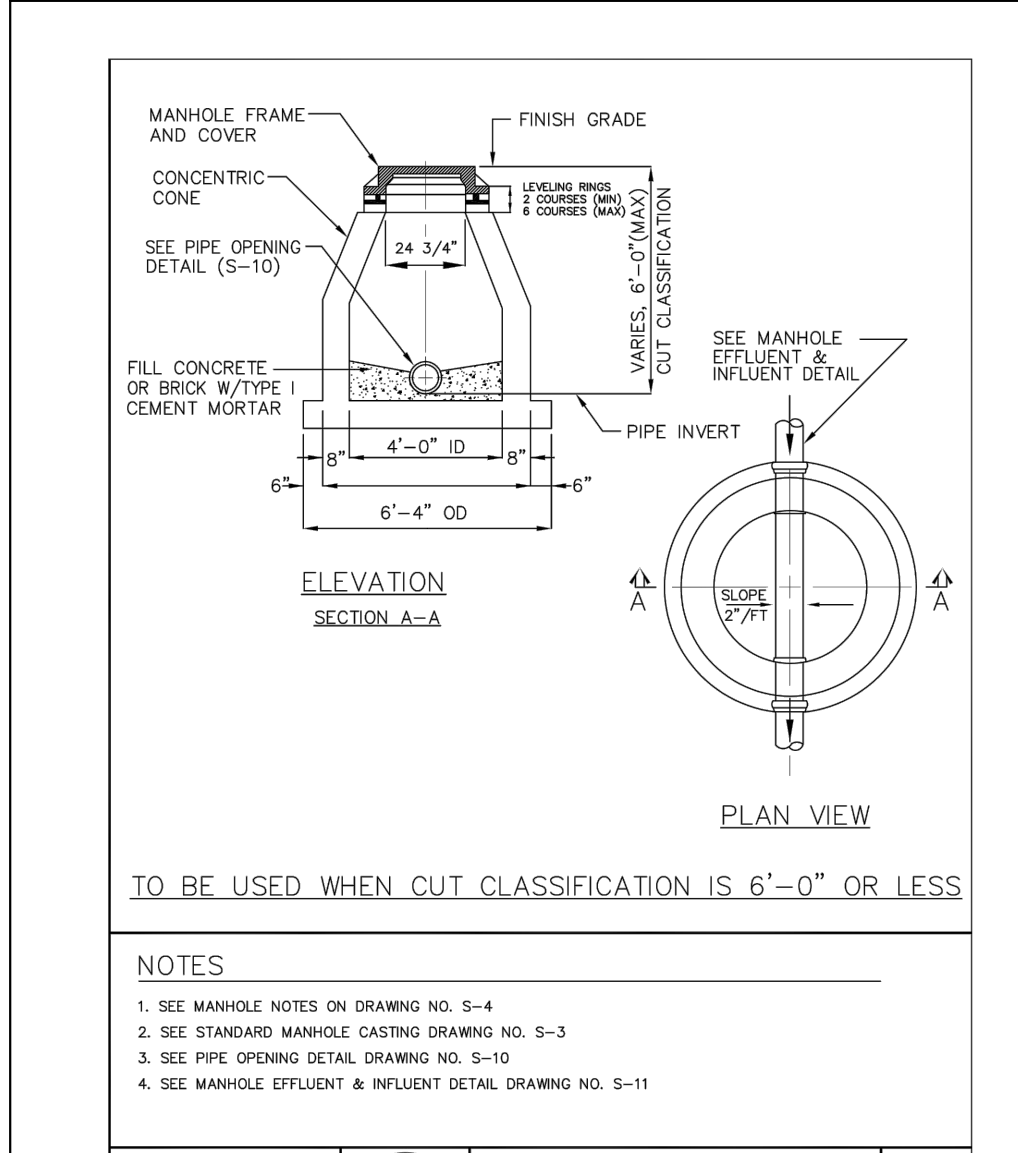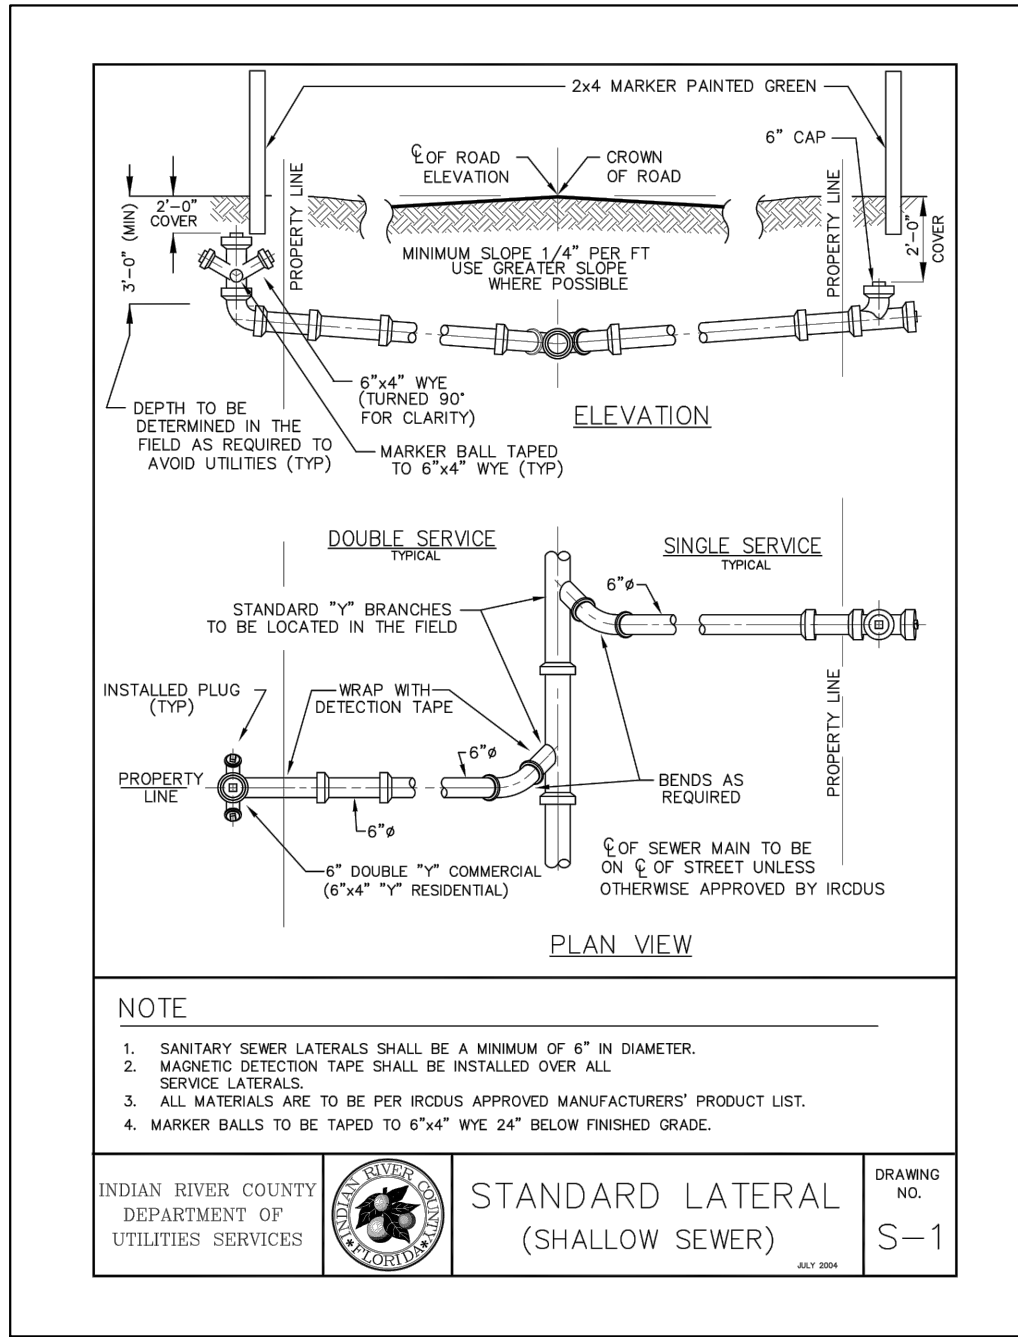

MANHOLE NOTES

1. REINFORCING AREA OF 0.20 SQ. IN./FT. FOR WALL SECTION, MINIMUM TO MEET OR EXCEED A.S.T.M. A 185.
2. ALL CEMENT TO BE TYPE I.
3. ALL CONCRETE FOR PRECAST MANHOLES TO BE MINIMUM 3,000 P.S.I. TO MEET OR EXCEED A.S.T.M. C 478.
4. BOTTOMS AND CHANNELS OF ALL MANHOLES TO BE OF 2,500 P.S.I. FILL CONCRETE FINISHED SMOOTH WITH STEEL TROWEL.
5. CONCRETE MANHOLES TO HAVE A MIN. WALL THICKNESS OF 6".
6. INSIDE OF MANHOLE SHALL BE COATED WITH TWO COATS OF COAL TAR EPXY AND TWO COATS OUTSIDE. (KOPERS 300 OR EQUAL).
7. CHANNELS TO BE FORMED IN ALL MANHOLES TO ACCEPT TV. CAMERA.
8. ORIENT ECCENTRIC CONE AS REQUIRED BY ENGINEER IN FIELD.
9. BOTTOM SECTION TO BE MONOLITHIC POUR EXCEPT WHERE DROP CONNECTION REQUIRED.
10. CONNECTIONS TO EXISTING MANHOLE AND LIFT STATION WET WELL STRUCTURES SHALL BE BY MEANS OF BORING A PENETRATION IN THE STRUCTURE RATHER THAN PRINCING. THE CONTRACTOR SHALL TAKE POSITIVE MEASURES TO PREVENT ANY CONCRETE OR CONSTRUCTION DEBRIS FROM ENTERING THE WASTEWATER SYSTEM.
11. BUOYANCY CALCULATIONS SHALL BE REQUIRED FOR MANHOLES IN FLOOD ZONES.
12. NO. 48 BARS 9" O.C. EACH WAY IN SLAB (TOP AND BOTTOM).
13. SLOPES ON CHANNEL BOTTOMS TO EQUAL SLOPES OF LINES ENTERING AND EXITING MANHOLES.
14. 2 COURSES BRICK MINIMUM, 6 COURSES BRICK MAXIMUM BETWEEN ALL PRECAST MANHOLE TOPS AND CASTINGS.
15. 3/4" CRUSHED STONE FOUNDATIONS FOR A MINIMUM DEPTH OF 12" SHALL BE PROVIDED AS REQUIRED BY IRCOUS.
16. MANHOLE LID SHALL BE TRAFFIC BEARING (H-20 LOADING).
17. SEWER PIPE INVERTS AT BOTTOM OF MANHOLES SHALL HAVE AN INVERT ELEVATION DIFFERENTIAL OF 0.1 FEET FOR A CHANGE IN DIRECTION AND 0.05 FEET FOR A STRAIGHT RUN.
18. A WATERTIGHT RAIN GUARD BOOT TO BE PER IRCOUS APPROVED MANUFACTURERS' PRODUCT LIST, SHALL BE PROVIDED FOR ALL MANHOLE FRAME/COVERS.
19. MATERIALS FOR LINING MANHOLES, WHERE REQUIRED, TO BE PER IRCOUS APPROVED MANUFACTURERS' PRODUCT LIST. FIBERGLASS LINERS SHALL BE INSTALLED ON ALL MANHOLES RECEIVING PUMPED SEWAGE.


|     |           |      |    |
|-----|-----------|------|----|
| NO. | REVISIONS | DATE | BY |
|     |           |      |    |

**Kimley-Horn**  
 © 2021 KIMLEY-HORN AND ASSOCIATES, INC.  
 355 ALHAMBRA CIRCLE, SUITE 1400, CORAL GABLES, FL 33134  
 PHONE: 305-673-2025  
 WWW.KIMLEY-HORN.COM REGISTRY 696

LICENSED PROFESSIONAL  
 KHA PROJECT 143228000  
 DATE JULY 2021  
 SCALE AS SHOWN  
 DESIGNED BY MRC  
 DRAWN BY RMR  
 CHECKED BY BF  
 DATE:

INDIAN RIVER COUNTY SEWER DETAILS








IRC LANDFILL PREPARED FOR INDIAN RIVER COUNTY

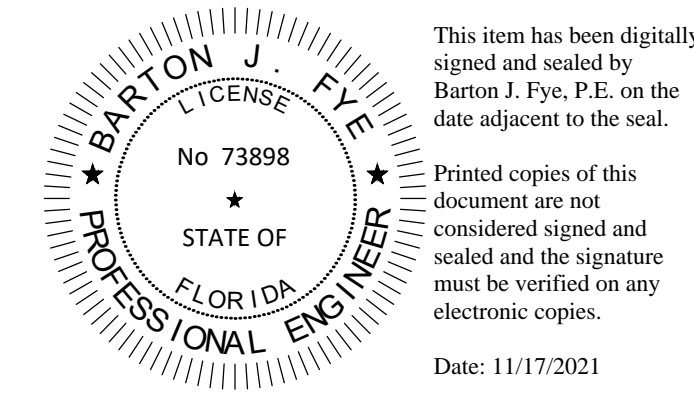

This item has been digitally signed and sealed by Barton J. Fye, P.E. on the date adjacent to the seal.  
 Printed copies of this document are not considered signed and sealed and the signature must be verified on any electronic copies.  
 Date: 11/17/2021

**Sunshine811**  
 Call 811 or www.sunshine811.com two full business days before digging to have utilities located and marked.  
 Check positive response codes before you dig!






Plotted By: Rebecca, Sheet: Set: IRC LANDFILL - 714, INDIAN RIVER COUNTY SEWER DETAILS, November 17, 2021, 10:43:07 AM, K:\mb-cl\143228000 - irc sww and recycling details\143228000.dwg, K:\mb-cl\143228000 - irc sww and recycling details\143228000.dwg, INDIAN RIVER COUNTY SEWER DETAILS.dwg, inc shall be without liability to Kimley-Horn and Associates, Inc.

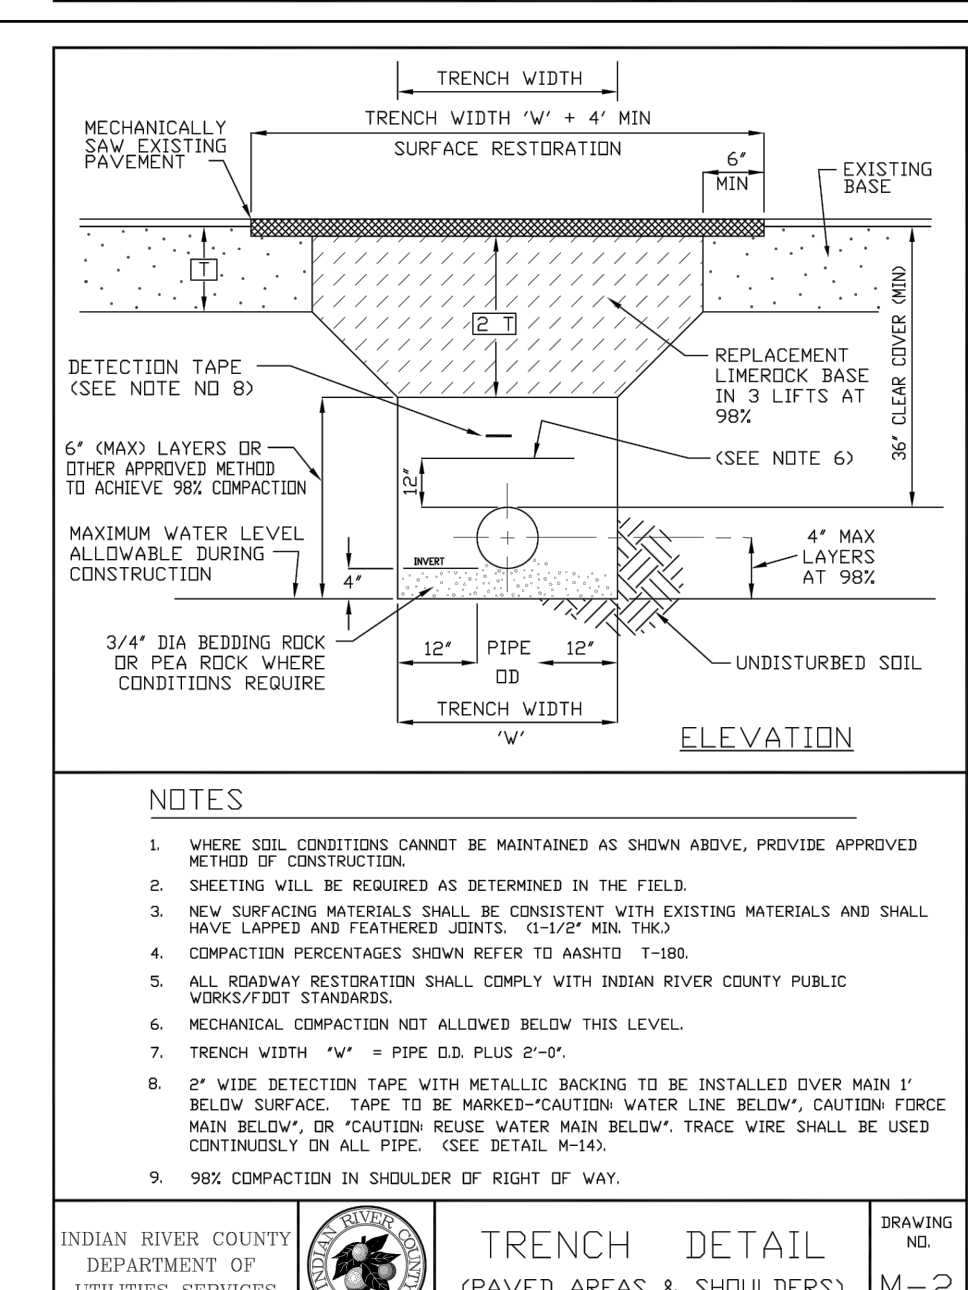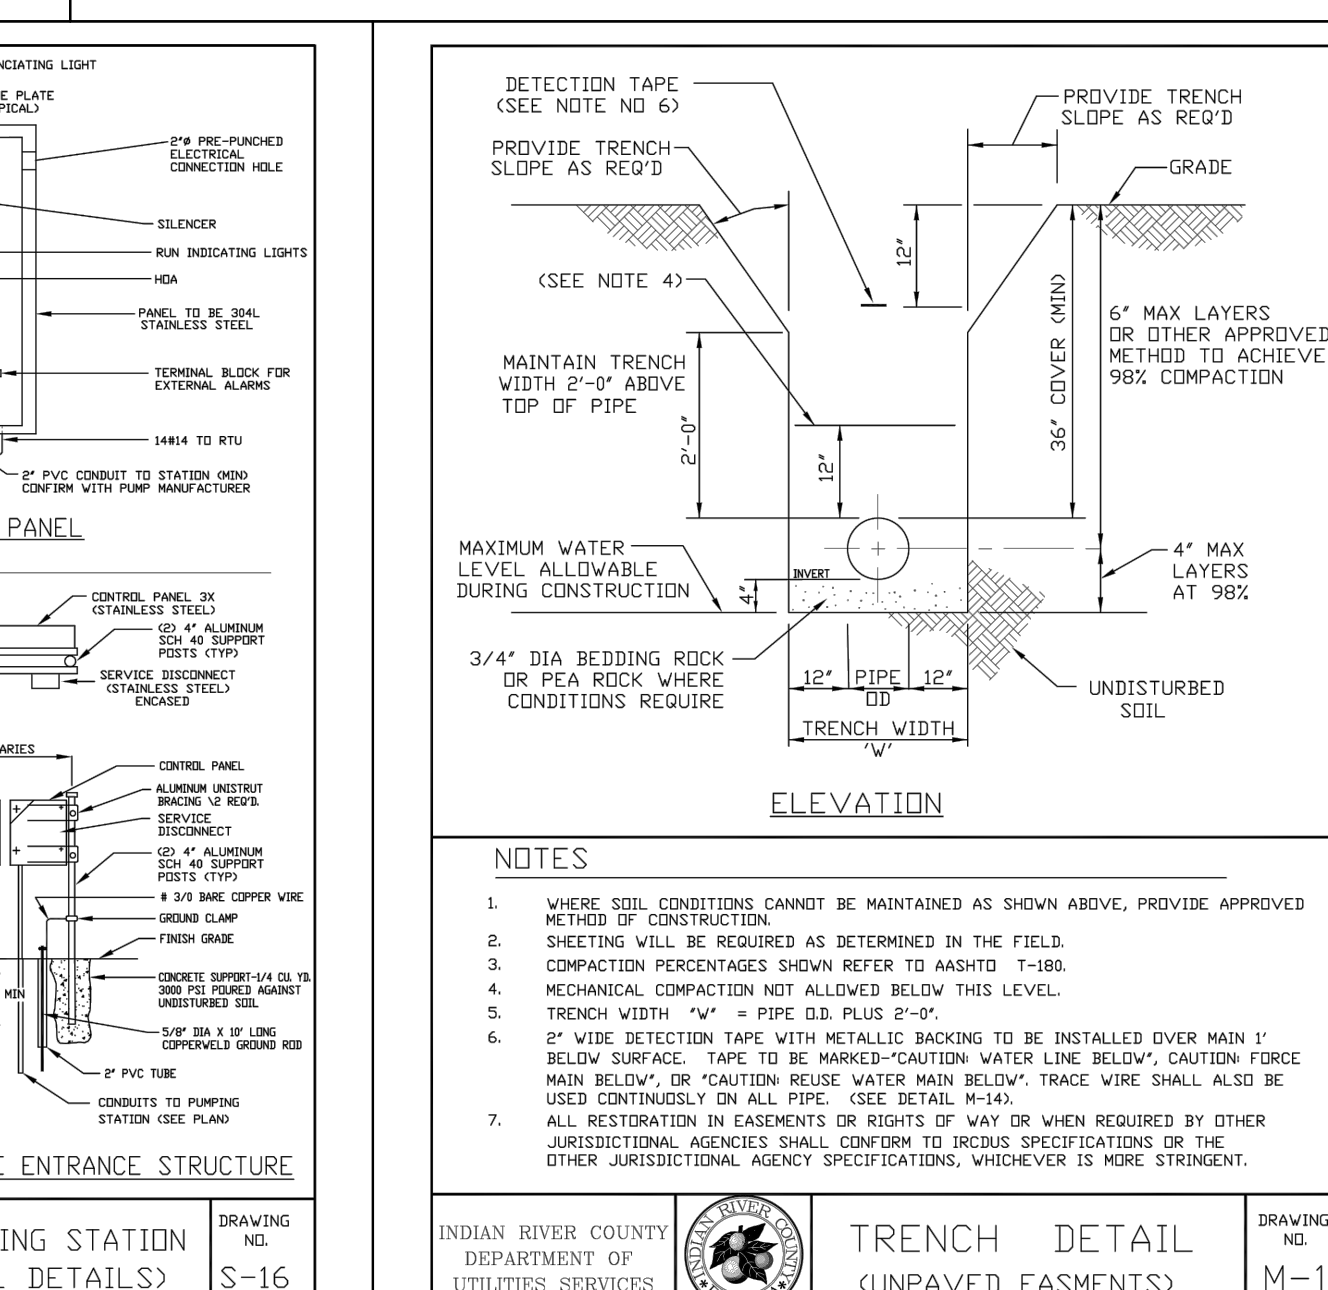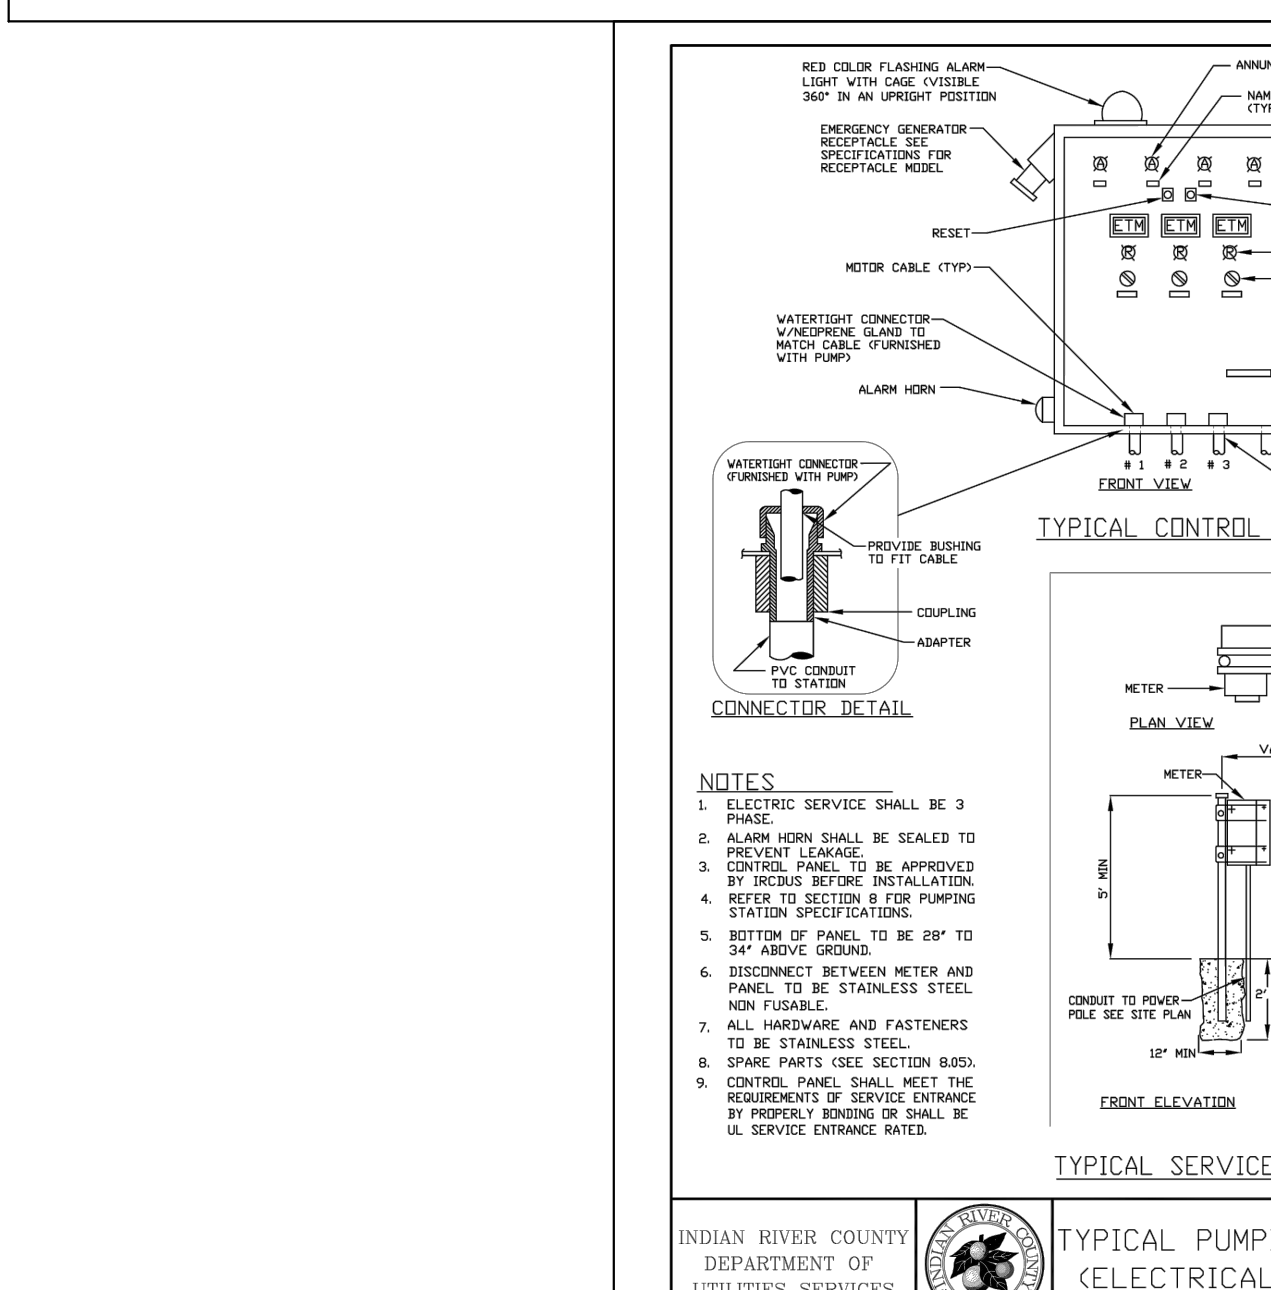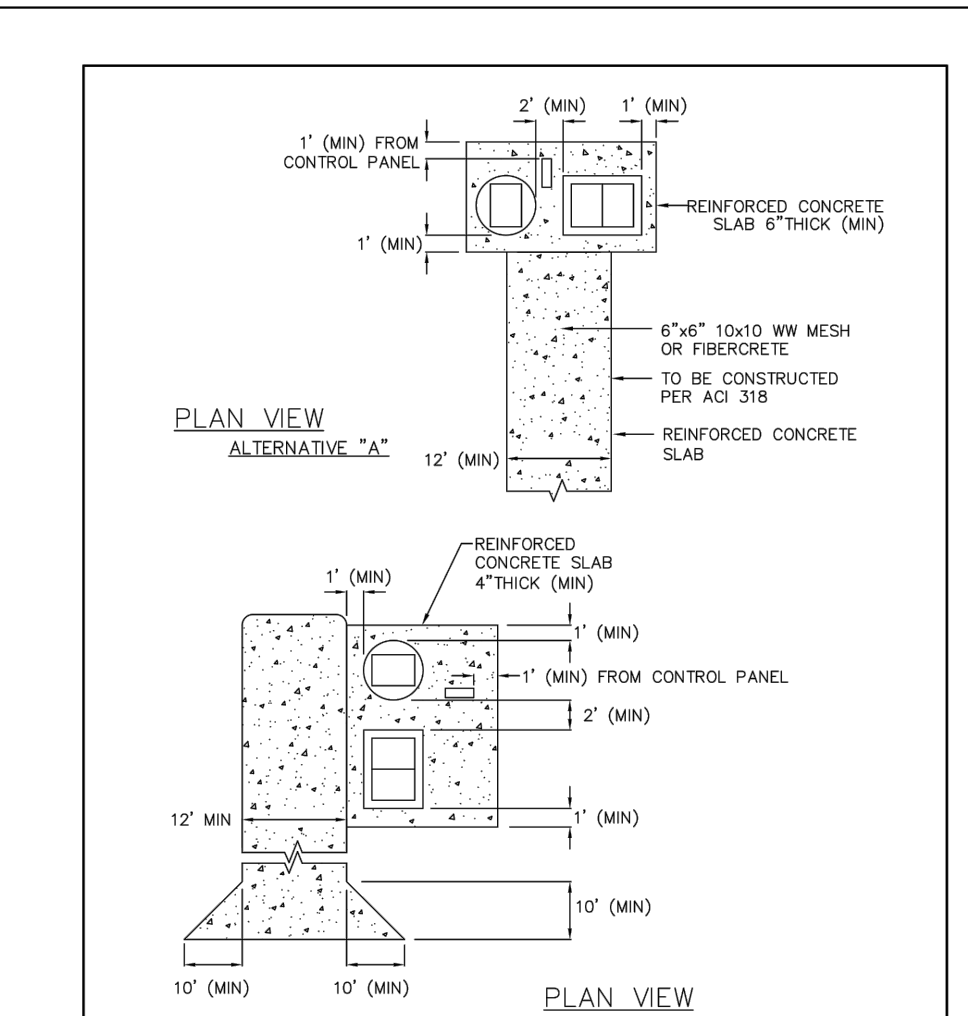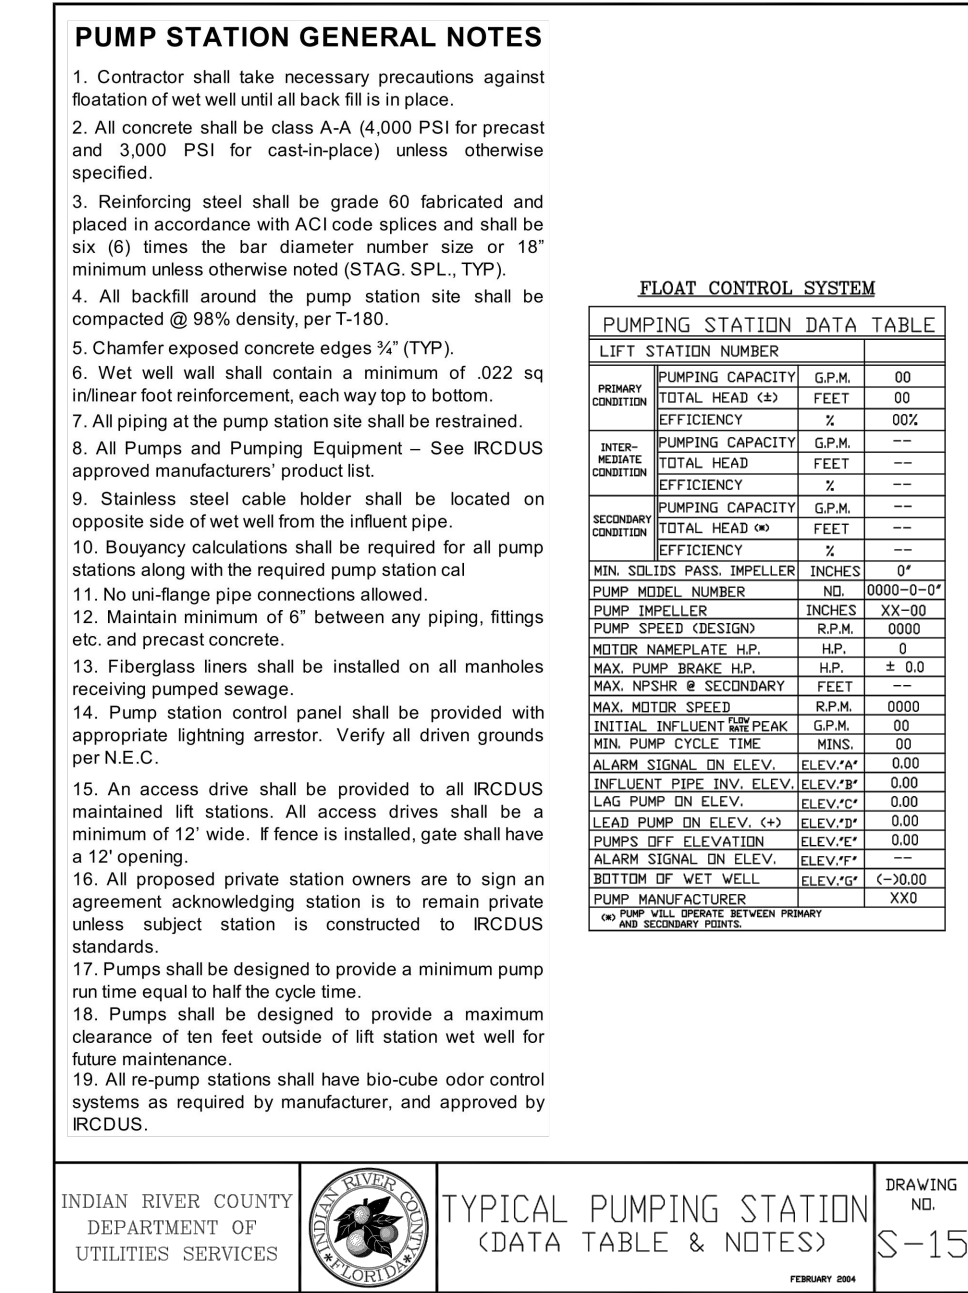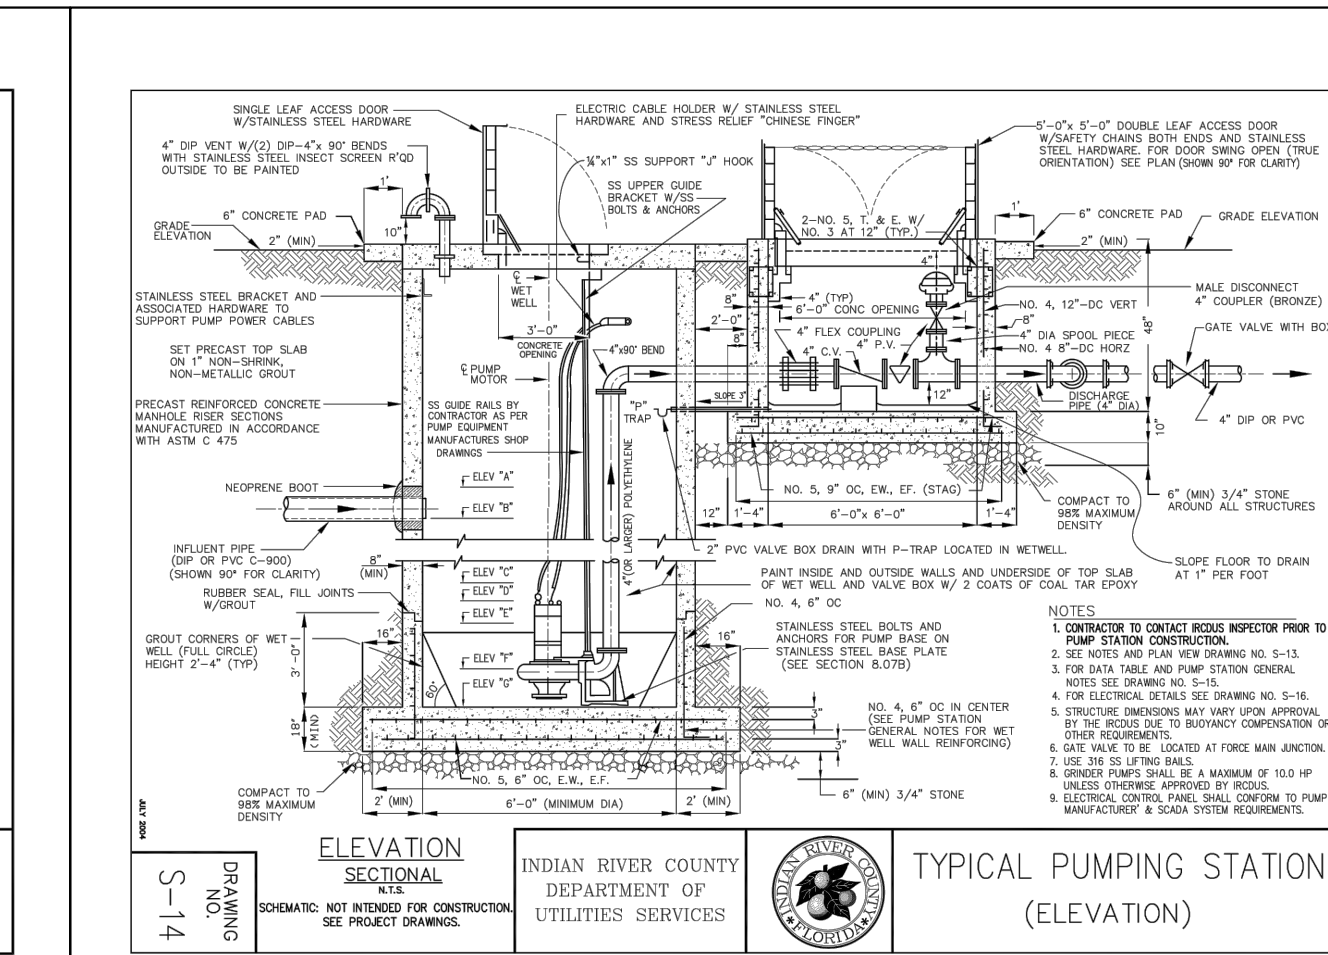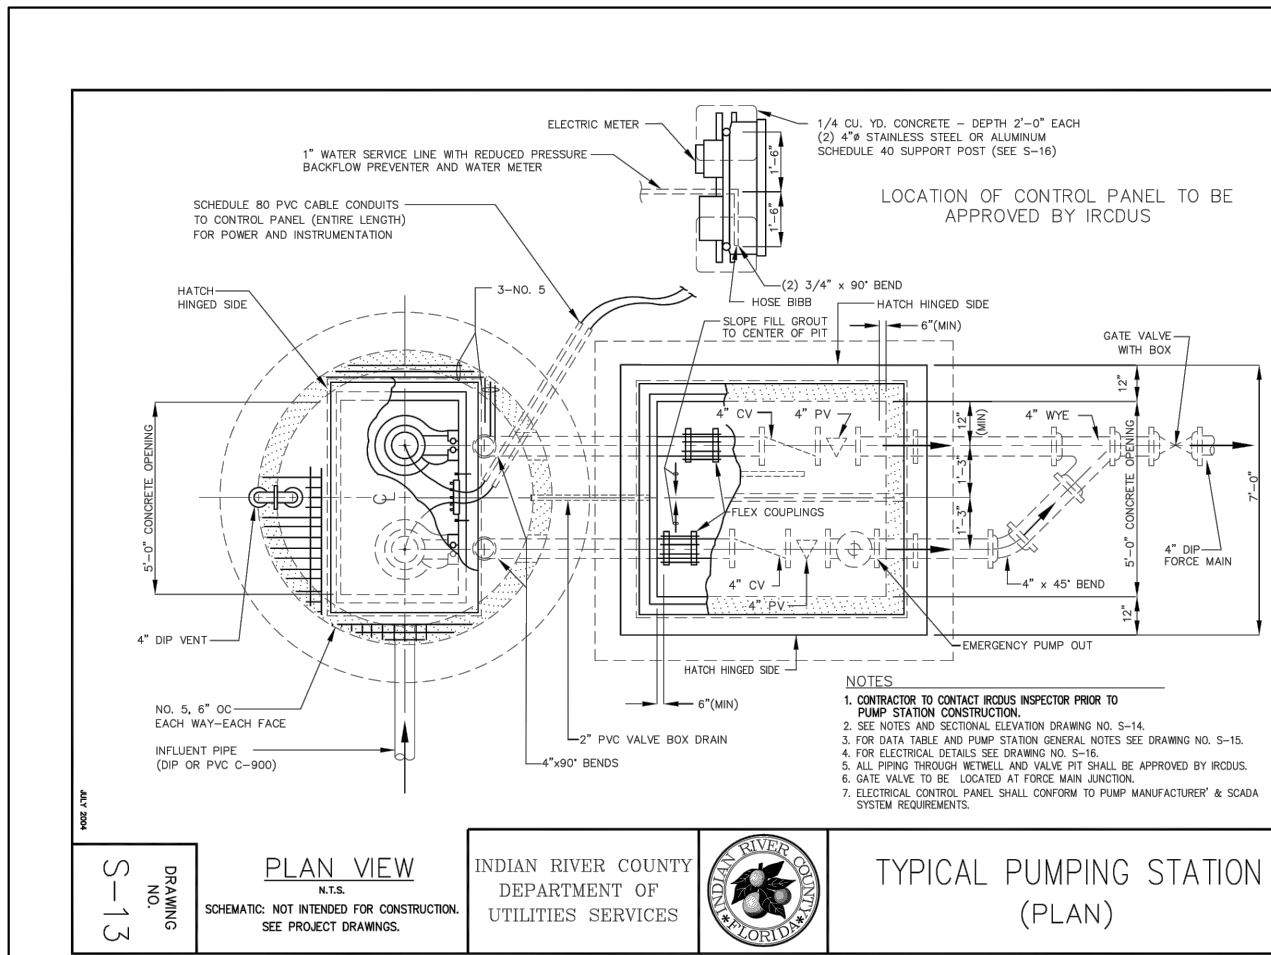


**RESTRAINING SCHEDULE AND NOTES**

| RESTRAINED LENGTH IN FEET EACH SIDE OF PIPE DIAMETER (INCHES) | D. I. P. |     |         |         | P. V. C. |     |         |         | RESTRAINED LENGTH IN FEET FOR REDUCER |     |     |     |     |     |     |     |     |
|---|----------|-----|---------|---------|----------|-----|---------|---------|---------------------------------------|-----|-----|-----|-----|-----|-----|-----|-----|
|   | 90"      | 45" | 22 1/2" | 11 1/4" | 90"      | 45" | 22 1/2" | 11 1/4" | 3"                                    | 4"  | 6"  | 8"  | 10" | 12" | 16" | 24" | 30" |
| 4"  | 30       | 15  | 10      | 5       | 40       | 20  | 10      | 5       | 0                                     | 0   | 0   | 0   | 0   | 0   | 0   | 0   | 0   |
| 6"  | 35       | 15  | 10      | 5       | 50       | 25  | 10      | 5       | 4                                     | 0   | 0   | 0   | 0   | 0   | 0   | 0   | 0   |
| 8"  | 55       | 25  | 10      | 5       | 80       | 35  | 20      | 10      | 6                                     | 50  | 45  | 0   | 0   | 0   | 0   | 0   | 0   |
| 10"   | 65       | 30  | 15      | 10      | 90       | 40  | 20      | 10      | 8                                     | 75  | 70  | 40  | 0   | 0   | 0   | 0   | 0   |
| 12"   | 80       | 35  | 20      | 10      | 100      | 50  | 25      | 10      | 10                                    | 95  | 90  | 70  | 40  | 0   | 0   | 0   | 0   |
| 16"   | 95       | 40  | 20      | 10      | 130      | 55  | 30      | 15      | 12                                    | 120 | 115 | 100 | 75  | 40  | 0   | 0   | 0   |
| 18"   | 120      | 50  | 25      | 15      | 165      | 70  | 35      | 20      | 16                                    | 160 | 155 | 140 | 120 | 100 | 70  | 0   | 0   |
| 20"   | 150      | 65  | 30      | 15      | 200      | 85  | 40      | 20      | 20                                    | 200 | 195 | 170 | 150 | 130 | 75  | 0   | 0   |
| 24"   | 180      | 75  | 35      | 20      | 230      | 95  | 45      | 25      | 24                                    | 230 | 225 | 195 | 170 | 150 | 90  | 50  | 0   |
| 30"   | 190      | 80  | 40      | 20      | 250      | 105 | 50      | 25      | 30                                    | 250 | 245 | 215 | 185 | 170 | 160 | 120 | 70  |
| 36"   | 220      | 95  | 45      | 25      | 0        | 0   | 0       | 0       | 36                                    | 225 | 220 | 215 | 210 | 205 | 195 | 180 | 150 |
| 48"   | 245      | 105 | 50      | 25      | 0        | 0   | 0       | 0       | 48                                    | 245 | 240 | 235 | 230 | 220 | 200 | 180 | 155 |
| 48"   | 260      | 120 | 60      | 30      | 0        | 0   | 0       | 0       | 48                                    | 255 | 250 | 245 | 240 | 235 | 235 | 235 | 195 |

INDIAN RIVER COUNTY DEPARTMENT OF UTILITIES SERVICES  
RESTRAINING SCHEDULE AND NOTES  
DRAWING NO. M-3

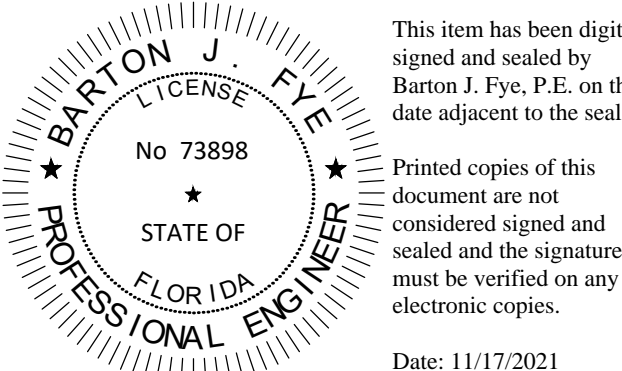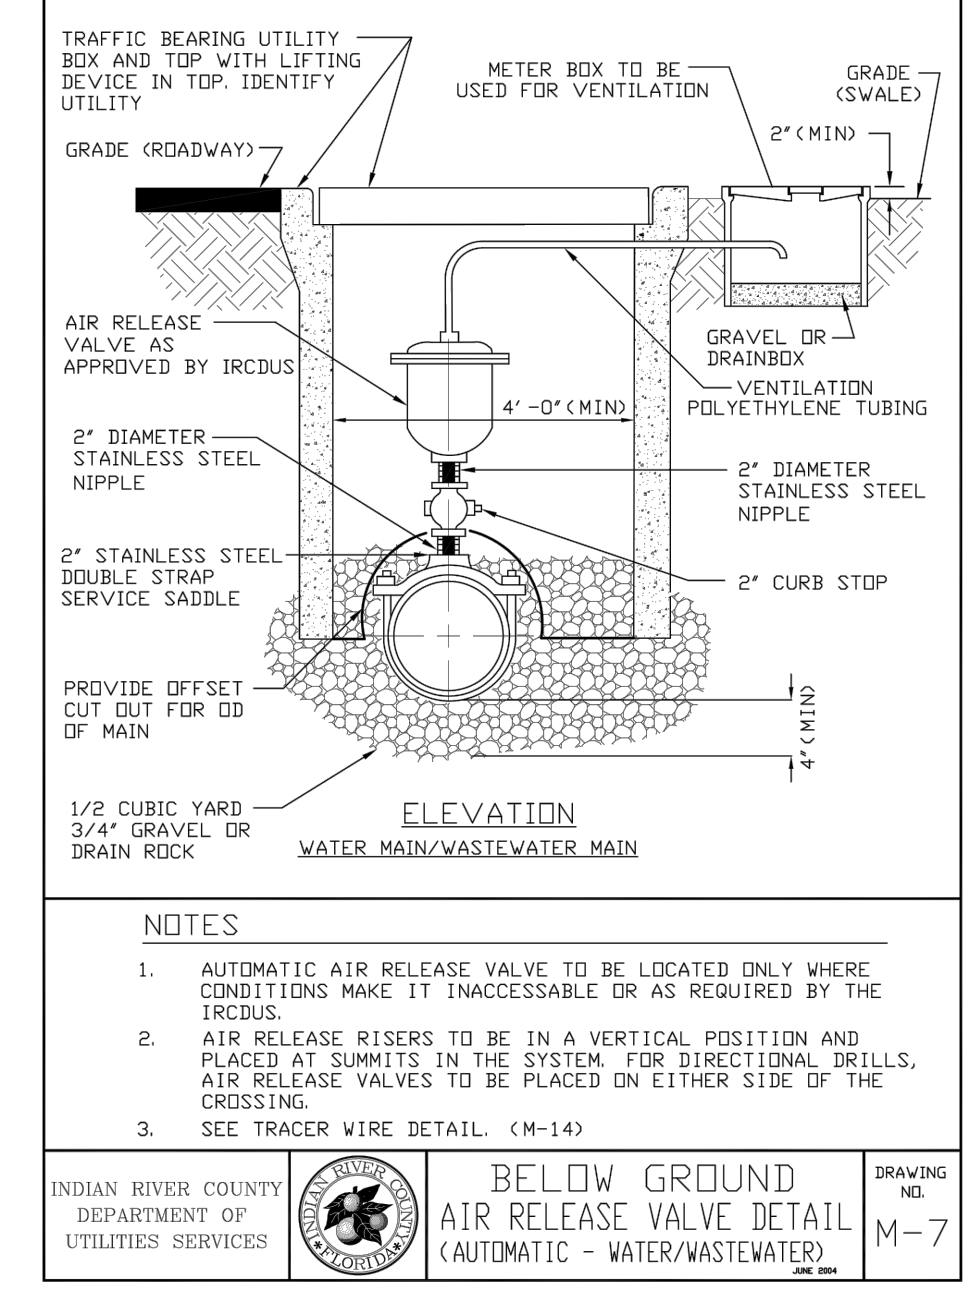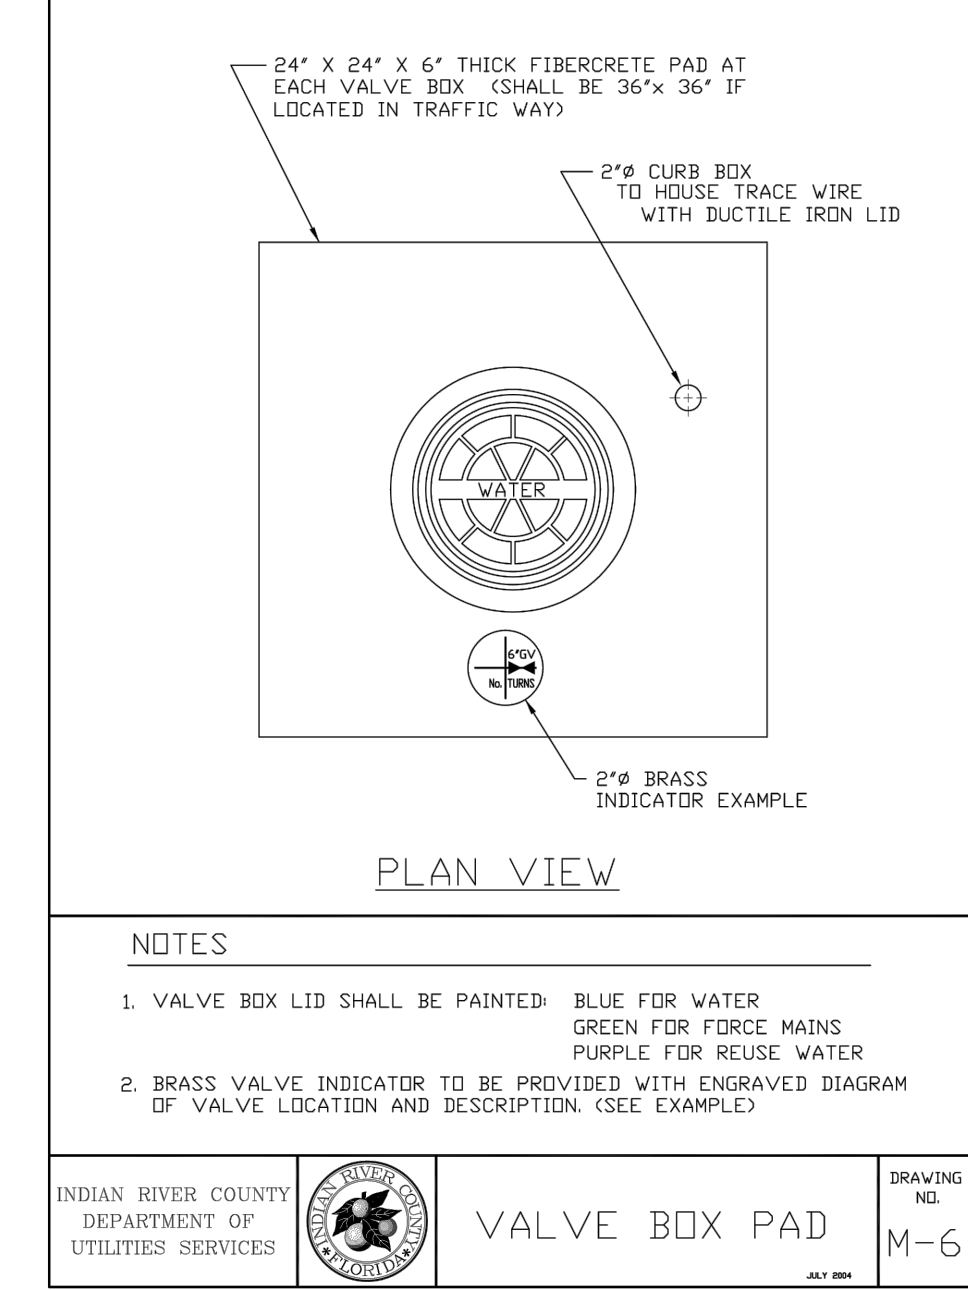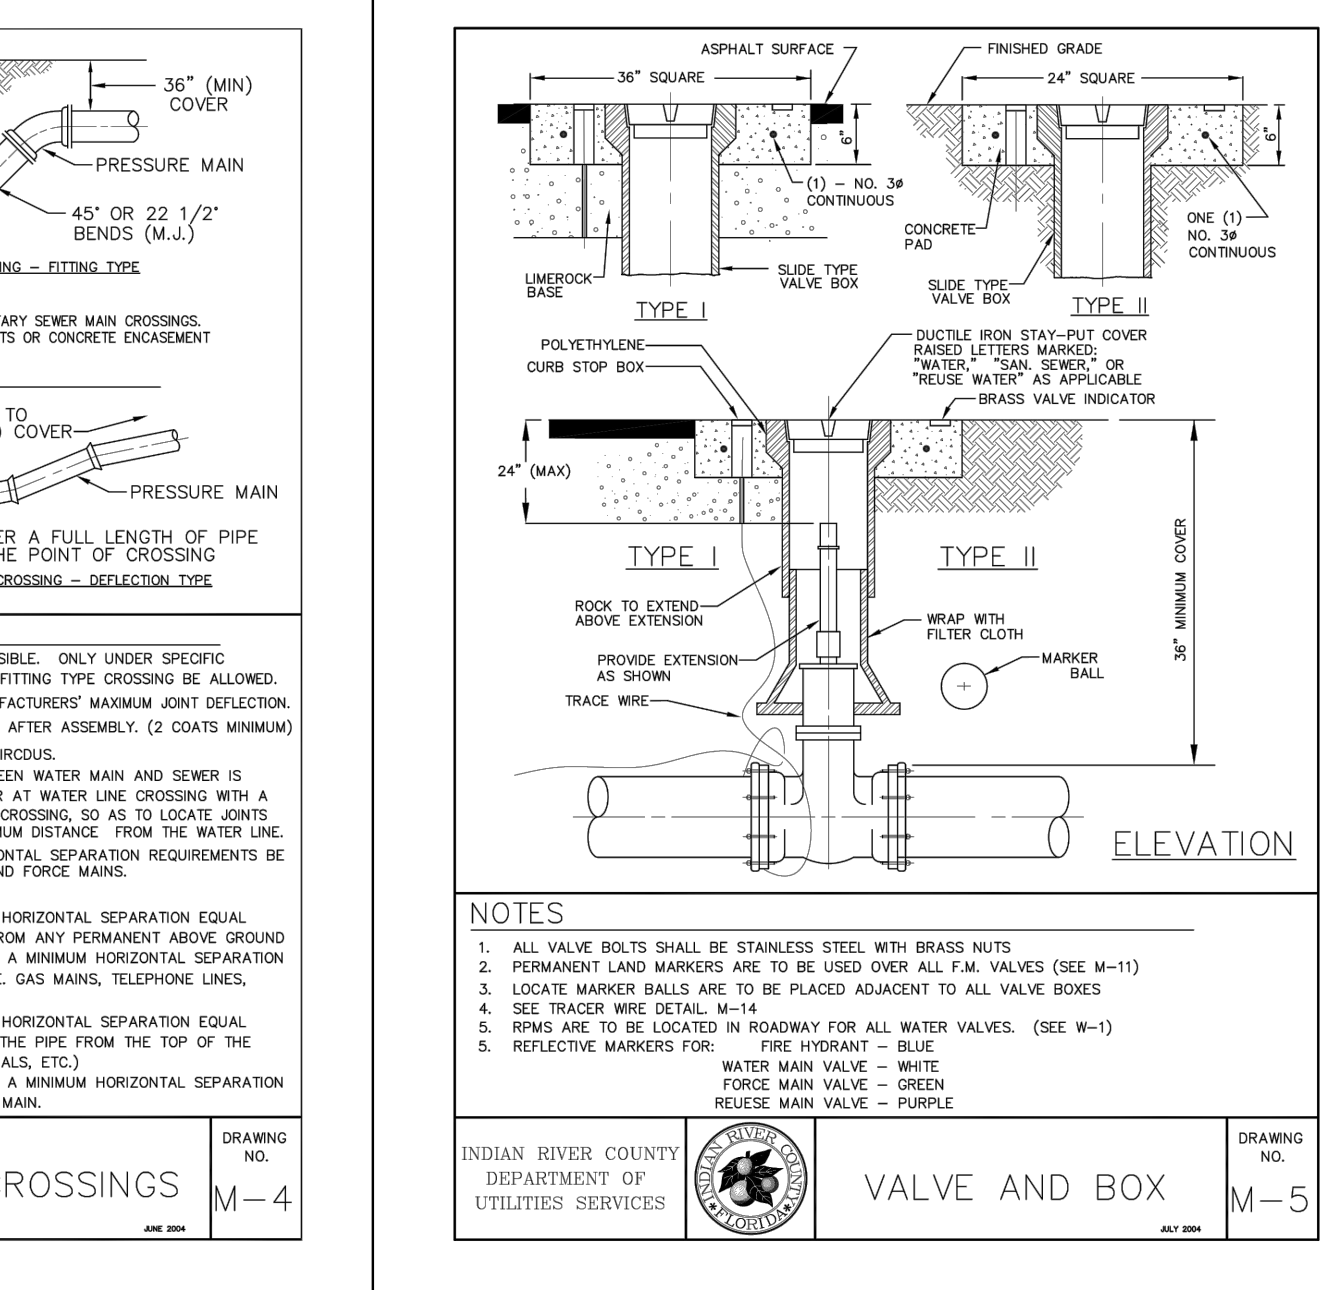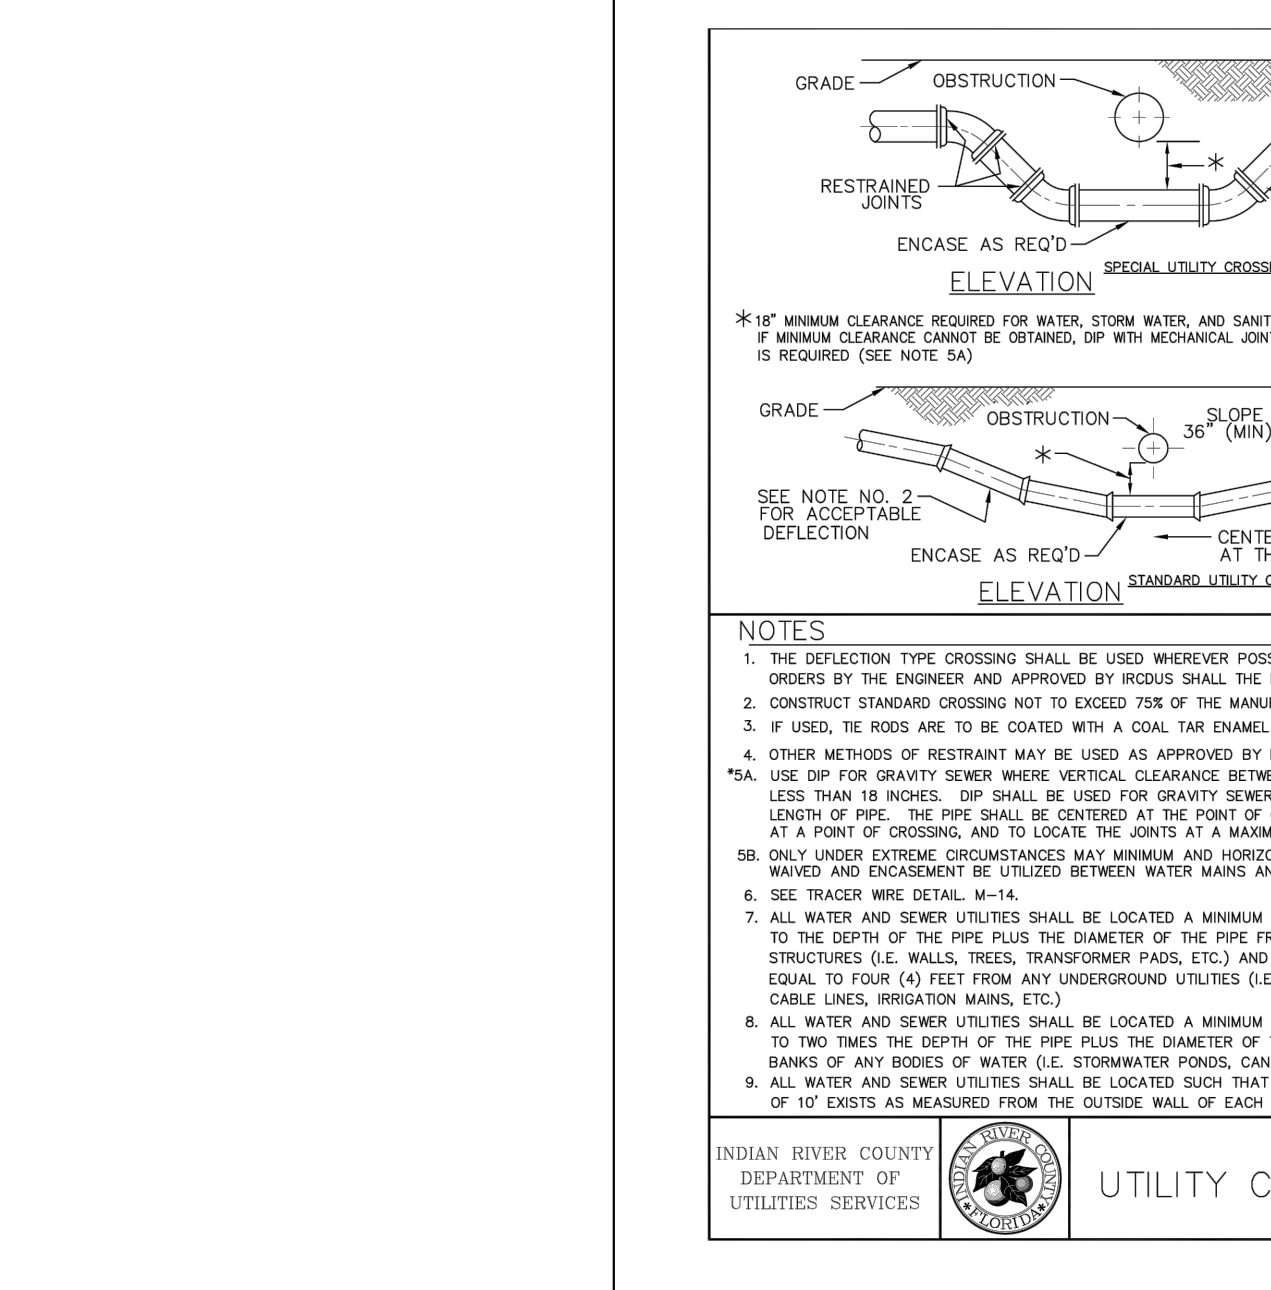

Call 811 or www.sunshine811.com two full business days before digging to have utilities located and marked.  
Check positive response codes before you dig!

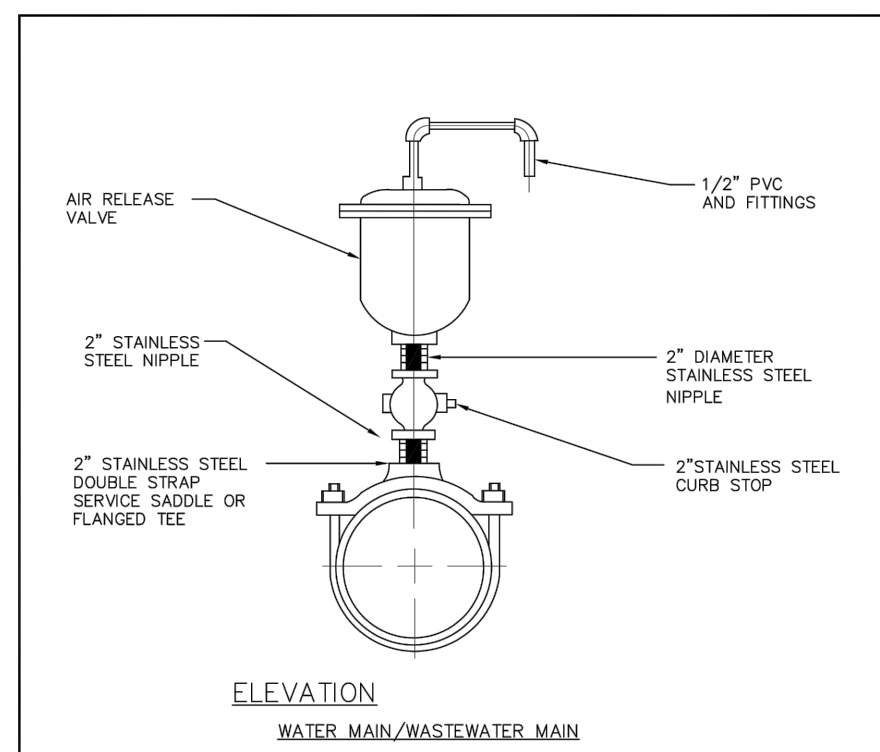


**NOTES**

1. AUTOMATIC AIR RELEASE VALVE TO BE LOCATED ONLY WHERE CONDITIONS MAKE IT INACCESSIBLE OR AS REQUIRED BY THE IRCUS.
2. AIR RELEASE RISERS TO BE IN A VERTICAL POSITION AND PLACED AT SUMMITS IN THE SYSTEM. FOR DIRECTIONAL DRILLS, AIR RELEASE VALVES TO BE PLACED ON EITHER SIDE OF THE CROSSING.
3. SEE TRACER WIRE DETAIL, M-14.
4. IF FORCE MAIN IS 6" OR LARGER A 4" TAP AND AIR RELEASE VALVE SHALL BE USED.

INDIAN RIVER COUNTY DEPARTMENT OF UTILITIES SERVICES

**AIR RELEASE VALVE DETAIL  
4" ABOVE GROUND  
(AUTOMATIC - WATER/WASTEWATER)**

DRAWING NO. **M-8**

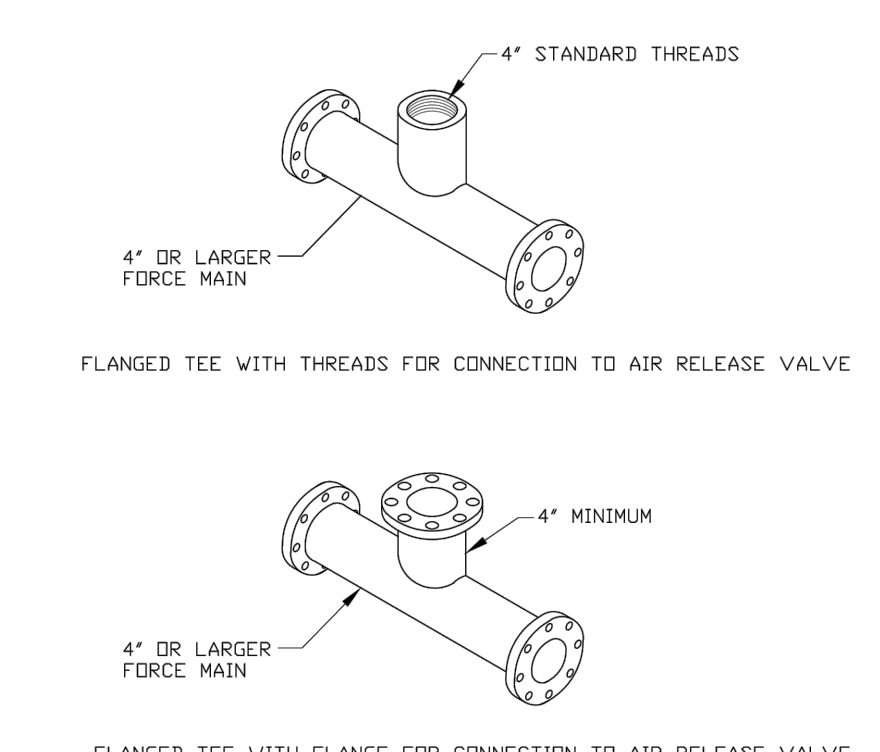


**NOTES**

1. IF FORCE MAIN IS 6" OR LARGER A 4" TAP AND AIR RELEASE VALVE SHALL BE USED.
2. SEE M-8 FOR AIR RELEASE VALVE DETAIL.
3. SEE TRACER WIRE DETAIL, M-14.

INDIAN RIVER COUNTY DEPARTMENT OF UTILITIES SERVICES

**FLANGED TEE FOR ABOVE GROUND AIR RELEASE VALVES**

DRAWING NO. **M-8 (A)**

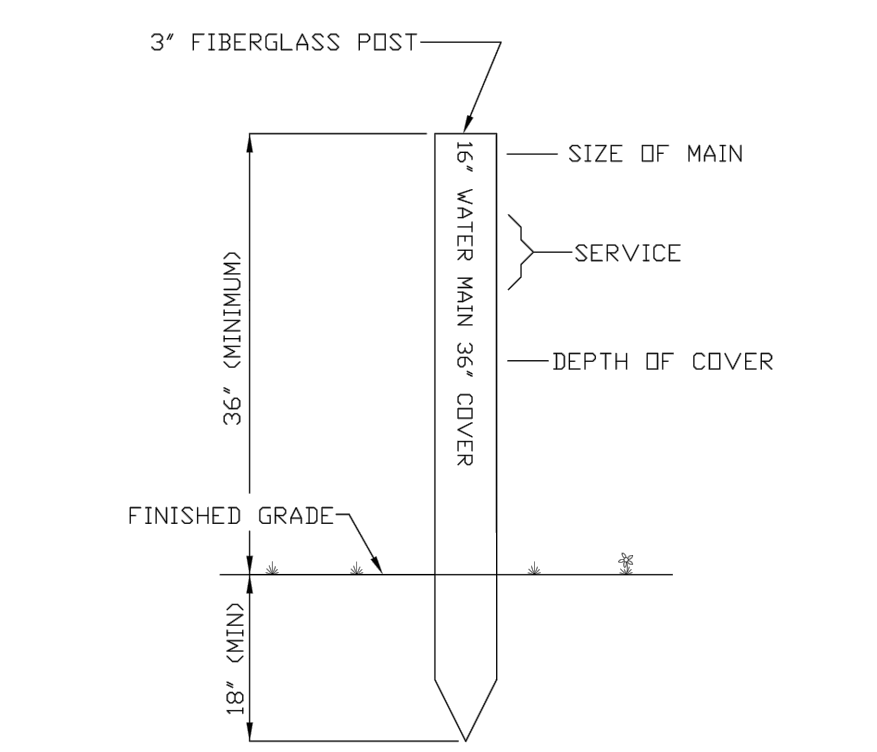


**NOTES**

1. MARKER TO BE PLACED DIRECTLY OVER PIPE.
2. MARKER TO BE USED AT ALL CANAL CROSSING AND AS DIRECTED BY IRCUS.
3. MARKER TO BE USED OVER WATER MAIN VALVES, FORCE MAIN VALVES AND RE-USE MAIN VALVES.
4. ALL MATERIALS ARE TO BE PER IRCUS APPROVED MANUFACTURERS' PRODUCTS LIST.

INDIAN RIVER COUNTY DEPARTMENT OF UTILITIES SERVICES

**PERMANENT LAND MARKER**

DRAWING NO. **M-9**

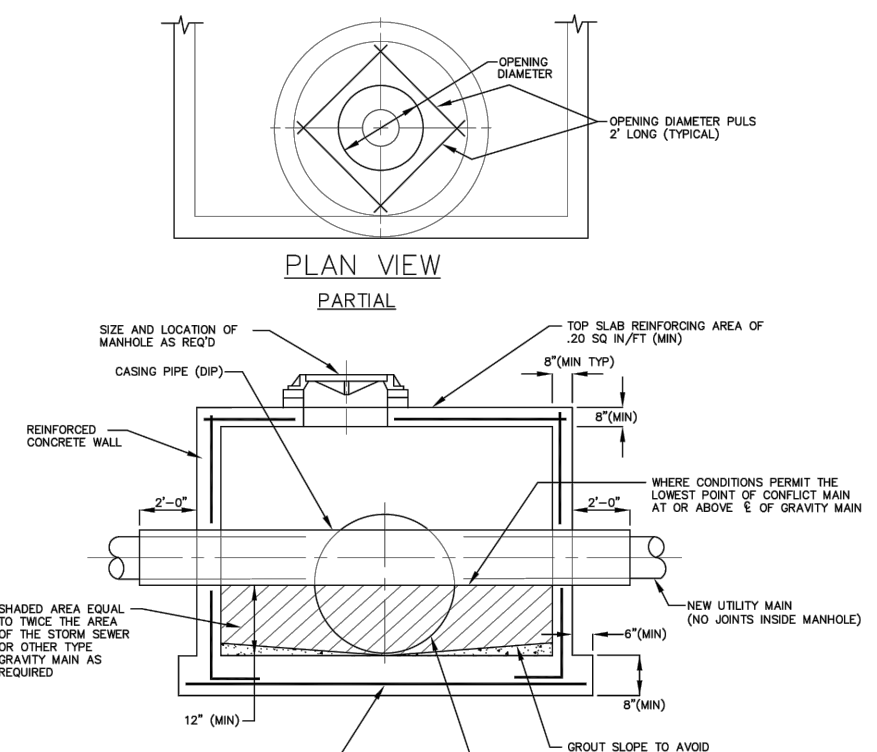


**NOTES**

1. CONFLICT MANHOLES WILL BE ALLOWED WHERE DESIGN PROBLEMS AND ECONOMICS PROVE THEM TO BE THE ONLY VIABLE SOLUTION AS APPROVED BY IRCUS.
2. CONFLICT MANHOLES WILL NOT BE ALLOWED FOR WATER MAINS CROSSING GRAVITY WASTEWATER SYSTEMS.
3. REFER TO M-12 FOR CASING SIZE.

INDIAN RIVER COUNTY DEPARTMENT OF UTILITIES SERVICES

**CONFLICT MANHOLE**

DRAWING NO. **M-10**

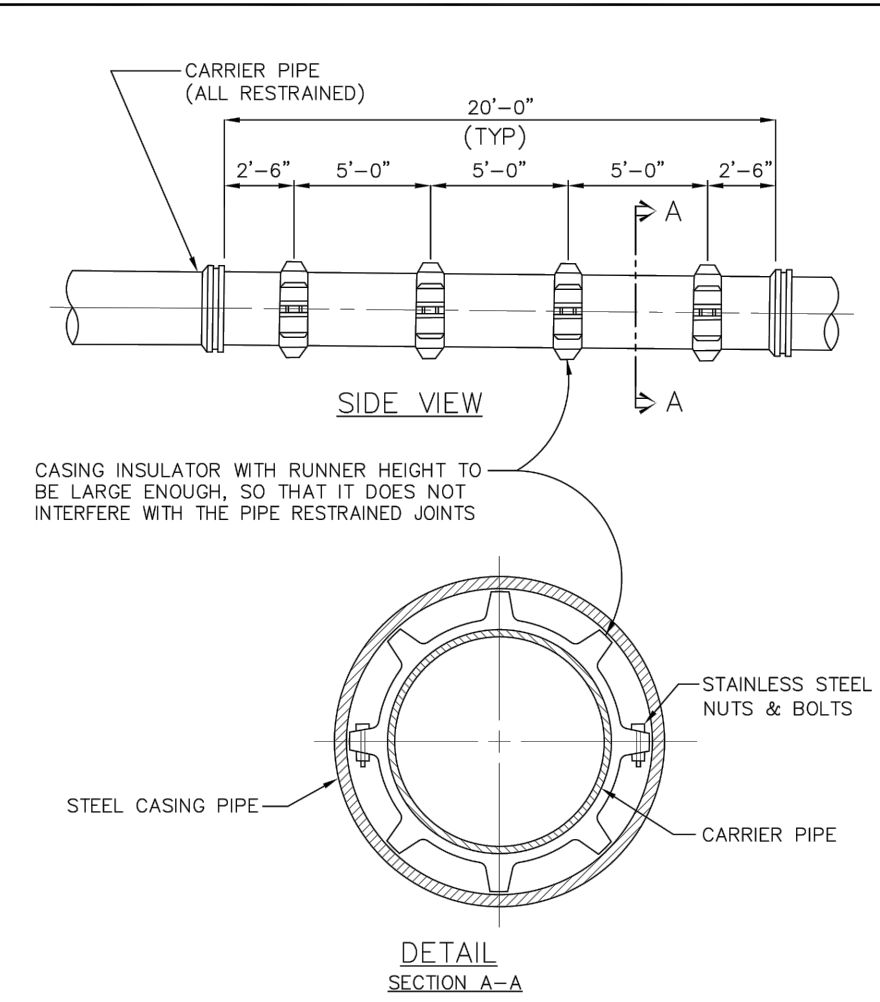


**NOTES**

1. NUMBER OF INSULATORS AS PER MANUFACTURERS' SPECIFICATIONS.

INDIAN RIVER COUNTY DEPARTMENT OF UTILITIES SERVICES

**JACK AND BORE  
(BLOCKING DETAIL)**

DRAWING NO. **M-11**

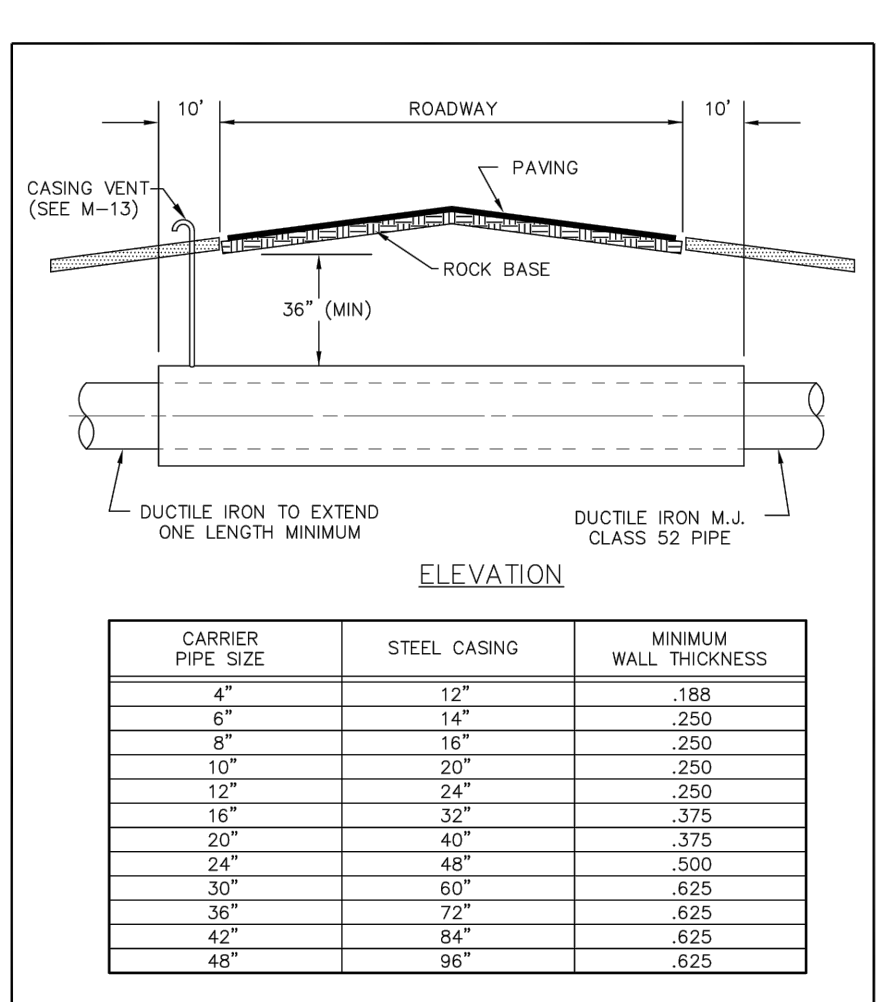

**NOTE**


1. IF RETAINER BLAGS ARE REQUIRED, THE CASING SIZE SHALL BE ADJUSTED ACCORDINGLY.

| CARRIER PIPE SIZE | STEEL CASING | MINIMUM WALL THICKNESS |
|-------------------|--------------|------------------------|
| 4"                | 12"          | .188                   |
| 6"                | 14"          | .250                   |
| 8"                | 16"          | .250                   |
| 10"               | 20"          | .250                   |
| 12"               | 24"          | .250                   |
| 16"               | 32"          | .375                   |
| 20"               | 40"          | .375                   |
| 24"               | 48"          | .500                   |
| 30"               | 60"          | .625                   |
| 36"               | 72"          | .625                   |
| 42"               | 84"          | .625                   |
| 48"               | 96"          | .625                   |

INDIAN RIVER COUNTY DEPARTMENT OF UTILITIES SERVICES

**CASING INSTALLATION DETAILS**

DRAWING NO. **M-12**

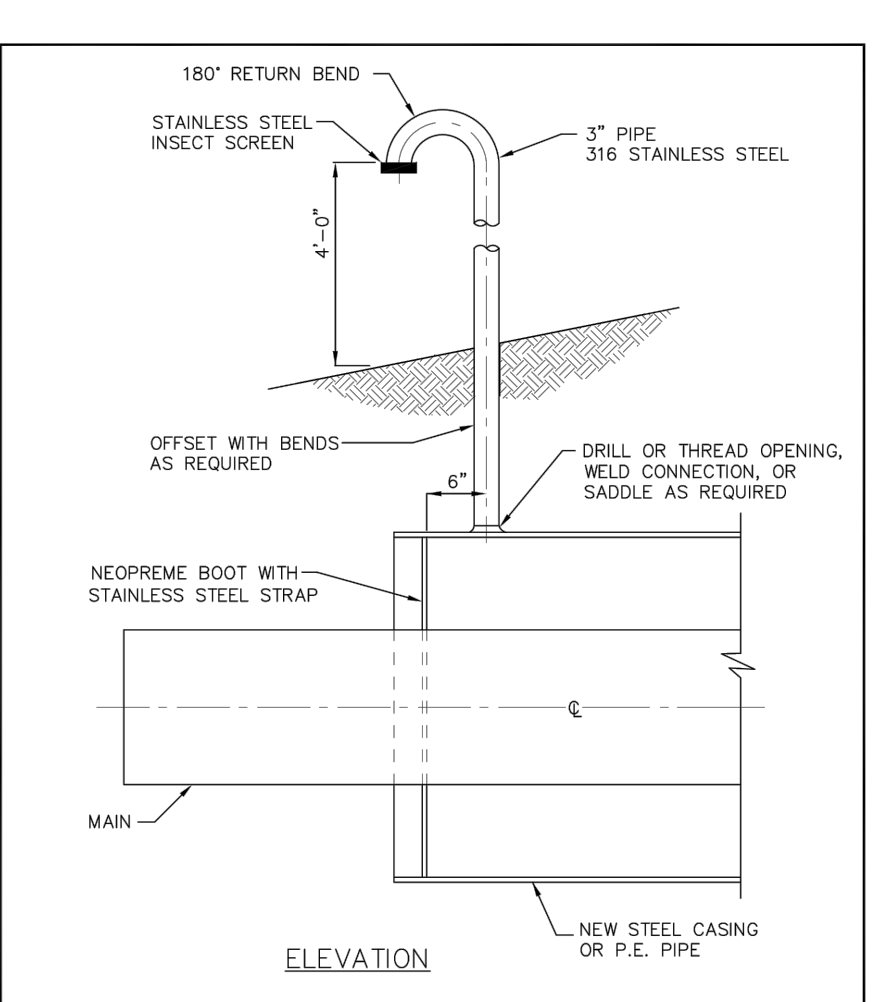


**NOTE**

1. LOCATION OF CASING VENTS TO BE DETERMINED BY THE ENGINEER IN THE FIELD. CONTRACTOR TO PROVIDE FITTINGS AS REQUIRED.

INDIAN RIVER COUNTY DEPARTMENT OF UTILITIES SERVICES

**JACK AND BORE  
(CASING VENT)**

DRAWING NO. **M-13**

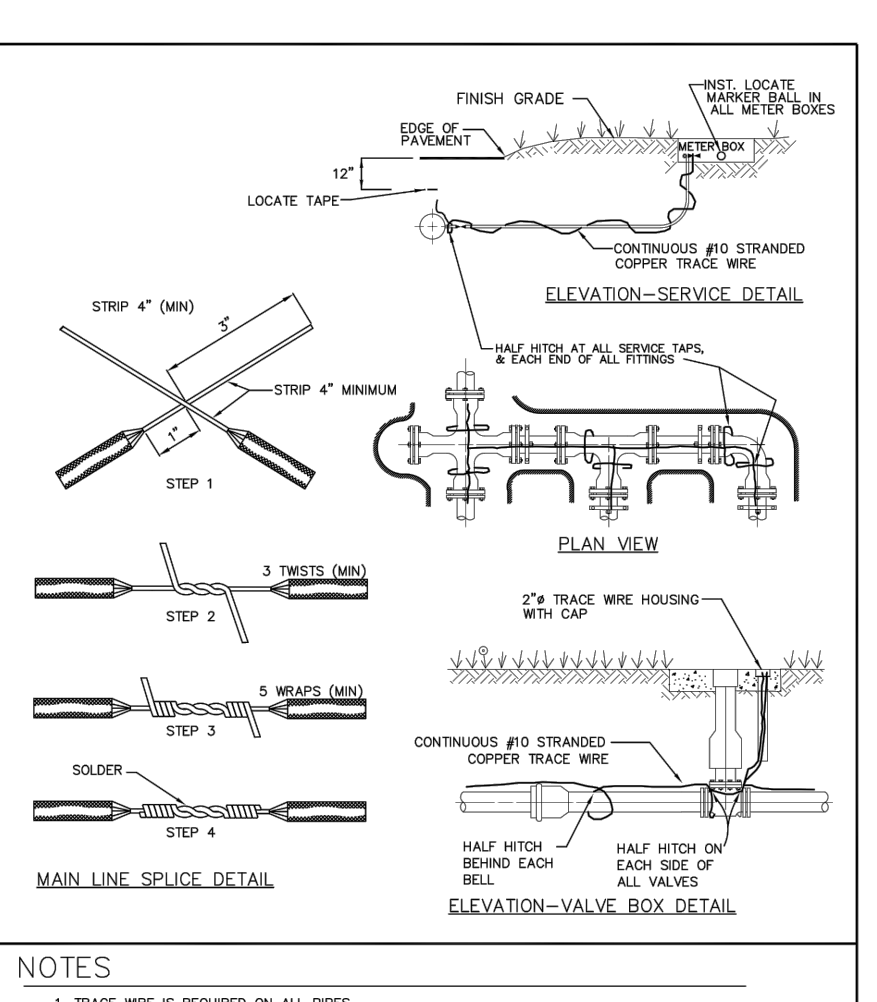


**NOTES**

1. TRACE WIRE IS REQUIRED ON ALL PIPES.
2. INCLUDE ALL COST OF MATERIAL & LABOR IN PRICE OF PIPE.
3. CONTRACTOR RESPONSIBLE FOR CONTINUITY THROUGHOUT ENTIRE PROJECT OF ALL TRACE WIRE.
4. ALL SPIRIZ CONNECTIONS ARE TO BE NOT SOLDERED (50/50 RESIN CORE). WRAP #12 ALUMINUM LATHER, SPC. COVER WITH WATERPROOFING COMPANION AND HEAT SHRINK WRAP.
5. ALL SOLDER JOINTS WILL BE WATERPROOFED WITH HEAT SHRINK WRAP.
6. ALL MATERIALS ARE TO BE PER IRCUS APPROVED MANUFACTURERS' PRODUCT LIST.

INDIAN RIVER COUNTY DEPARTMENT OF UTILITIES SERVICES

**TRACE WIRE DETAILS**

DRAWING NO. **M-14**

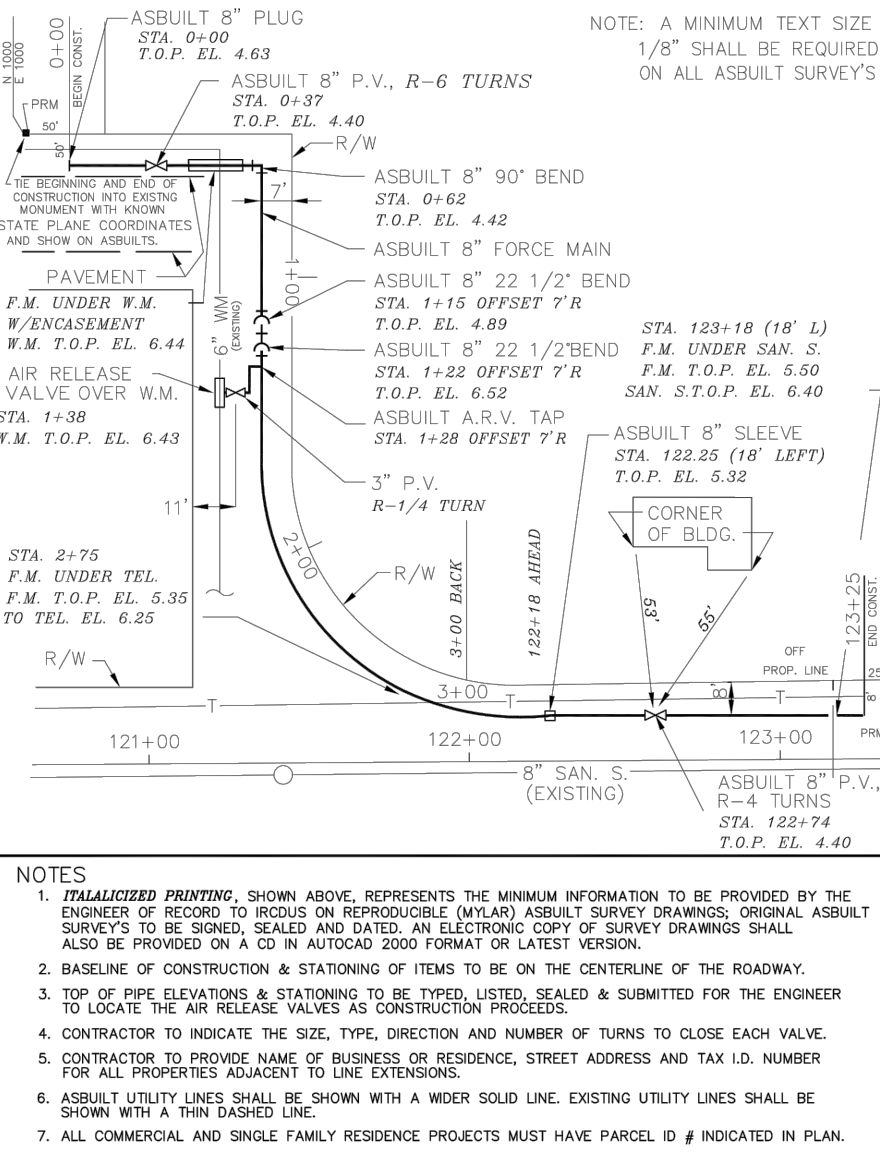

INDIAN RIVER COUNTY DEPARTMENT OF UTILITIES SERVICES

**AS-BUILT DRAWING  
(EXAMPLE)**

DRAWING NO. **M-15**

**INDIAN RIVER COUNTY DEPARTMENT OF UTILITIES SERVICES AS-BUILT REQUIREMENTS**

1. All as-built drawings (24"x36") shall state in 1" lettering "AS-BUILT" located in the bottom right hand side of the drawing original and/or copies, along with the as-built date.
2. All state plane coordinates shall be based on the Florida State Plane Horizontal data (East Zone), or Florida High Precision Geodetic Network (superstation) and NAD 83/1990 - final adjustment.
3. All elevations shown shall be based on 1929 NGVD.
4. All incoming as-built drawings (24"x36") shall be received on a CD, as an electronic copy, AutoCad 2000 format, with a tie to a minimum of two (2) state plane coordinates. (NOTE: Prior to submitting the electronic copy, one (1) copy of each as-built shall be submitted for review and approval. After all approvals, a (24"x36") Mylar reproducible along with five (5) signed and sealed copies of each as-built shall be submitted.)
5. All engineering or surveying as-built drawings shall be tied to a minimum of one (1) permanent reference monument (P.R.M.) that shall be tied to a minimum of one (1) section corner or one-quarter (1/4) section corner whichever is closest to the project. State plane coordinates shall be physically shown on the drawing next to the P.R.M. uses.
6. All utility as-built construction located within the rights-of-way, easements and alike shall be tied to the respective rights-of-way, easements, etc., every 1,000 feet and change of direction.
7. All utility as-built construction plans that are located within a distance of one (1) mile from any Indian River County Global Positioning System (G.P.S.) control project monuments shall be tied into the project from one (1) on-site Permanent Reference Monument (P.R.M.) subdivision Corner, or site plan project corner.
8. All as-builts shall clearly depict as-built utility lines that were constructed along with their respective easement (if required). As-builts will not be accepted unless the verbiage "Proposed" and/or "To Be Constructed" have been revised to read "AS-BUILT". As-built Construction drawings with, to be constructed terminology, will not be accepted.
9. All as-builts shall be certified by the project engineer or contracting surveyor.
10. All projects, which utilize lift stations, shall specify on plans as to whether or not subject lift stations are to remain private or are to be dedicated to the county.
11. All fire hydrants and valves shall be located with state plane coordinates and shall be identified on the as-built.
12. All as-builts shall be complete and approved before commencement of field test.

INDIAN RIVER COUNTY DEPARTMENT OF UTILITIES SERVICES

**AS-BUILT REQUIREMENTS**

DRAWING NO. **M-16**

**INDIAN RIVER COUNTY DEPARTMENT OF UTILITIES SERVICES SURVEY REQUIREMENTS**

1. All Construction and/or Route surveys shall meet the minimum requirements of the Chapter 61G67, Florida Administration Code Pursuant to section 472 of the Florida Statutes.
2. All state plane coordinates shall be based on the Florida State Plane Horizontal data (East Zone), or Florida High Precision Geodetic Network (superstation) and NAD 83/1990 - final adjustment.
3. All elevations shown shall be based on 1929 NGVD.
4. All incoming route construction survey drawings shall be received on a CD, as an electronic copy, AutoCad 2000 format, with a tie to a minimum of two (2) state plane coordinates. (NOTE: Prior to submitting the electronic copy, one (1) copy of each as-built (24"x36") shall be submitted for review and approval. After all approvals, a (24"x36") Mylar reproducible along with five (5) signed and sealed copies of each as-built shall be submitted.
5. All construction surveys shall be tied to a minimum of one (1) permanent reference monument (P.R.M.) at the end of each project. One P.R.M. shall be tied to a minimum of one (1) section corner or one-quarter (1/4) section corner whichever is closest to the project. State plane coordinates shall be physically shown on the drawing next to the P.R.M. used.
6. All surveys that are required for the use of engineering design, and are located within a distance of one (1) mile from any Indian River County Global Positioning System (G.P.S.) control project monuments, shall be tied into the GPS monitoring the one (1) permanent reference point or the subdivision corner that is along the survey route and shall then be tied to the survey base line.
7. Horizontal Control Monumentation for utility lines shall be a minimum of two (2) points at a maximum of 1,400 feet between points and shown on all plans.
8. Vertical Control (when required) for linear utility lines, such as sewer, shall have a maximum of 1,100 feet between existing construction or established benchmarks.

INDIAN RIVER COUNTY DEPARTMENT OF UTILITIES SERVICES

**CONSTRUCTION/ROUTE SURVEY REQUIREMENTS**

DRAWING NO. **M-16 (A)**


**GENERAL INFORMATION TO BE SHOWN ON AS-BUILT AND SURVEY DRAWINGS**

1. Existing right-of-way limits and/or easements within the limits of construction.
2. Survey baseline stationing every 100', control points set every 500', and at angle change of direction.
3. Show cross section elevations at grade every 100' for gravity sewer line construction and 500' for water line and force main construction. Elevations that reflect any significant change in grade between the previously stated footage shall be shown on plans.
4. Existing parcels, tracts, and lot corner locations shown with front footage dimensions per plat when plotted. If construction project is along back of lots, then show back lot dimensions.
5. EXISTING ROADWAY EDGE OF PAVEMENT OR EDGE OF DIRT ROAD.
6. Existing utilities as located in field (water, sewer, telephone, electric, cable TV, etc.) (NOTE: Sunshine One to be contacted by surveying firm prior to survey locate, with the intent of county excavation.)
7. Existing utilities as associated with number 5 above (example: valves, meters, manholes, etc.).
8. Existing curbs, driveway widths and types.
9. Existing drainage pipe crossings and driveway culverts (type, sizes and invert elevations).
10. Existing swales and/or ditches and elevations every 100' at top and bottom if within area of construction.
11. Existing fences.
12. Existing trees and/or shrubbery.
13. All other non-movable items such as mailboxes, flag poles, etc.
14. All street names.

INDIAN RIVER COUNTY DEPARTMENT OF UTILITIES SERVICES

**AS-BUILT/SURVEY REQUIREMENTS**

DRAWING NO. **M-16 (B)**

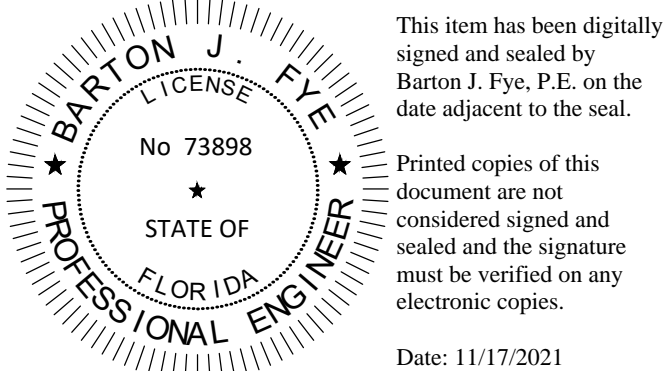

This item has been digitally signed and sealed by Barton J. Fye, P.E. on the date adjacent to the seal.

Printed copies of this document are not considered signed and sealed and the signature must be verified on any electronic copies.


Date: 11/17/2021

**Sunshine 811**

Call 811 or www.sunshine811.com two full business days before digging to have utilities located and marked.

Check positive response codes before you dig!

Plotted By: Rodriguez, Rebecca - Sheet Set: IRC LANDFILL - Layout: C-800 LIGHTING PLAN - November 17, 2021 - 10:43:22am - k:\vmb-civil\143228000 - frc-hw-and-recycling-facility\CADD\plan\shasta\C-800 Lighting Plan.dwg  
 This document, together with the concepts and designs presented herein, is intended only for the specific purpose and client for which it was prepared. Reuse of and improper reliance on this document without written authorization and adaptation by Kimley-Horn and Associates, Inc. shall be without liability to Kimley-Horn and Associates, Inc.

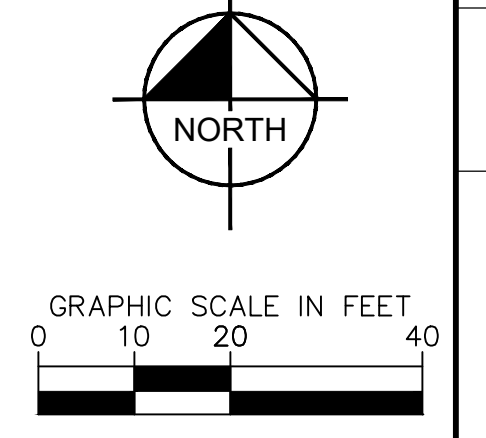

**LEGEND:**


- R/W --- P/L R/W OR PROPERTY LINE
- CENTERLINE
- SANITARY SEWER
- \*X.X FOOTCANDLES
- PROP. STANDARD DUTY CONC.
- PROP. CONC. SIDEWALK

NOTES:  
 1. ALL MOUNTING HEIGHTS REFERENCED ARE TO TOP OF BRACKET/FIXTURE.

| Label               | CalcType    | Units | Avg  | Max  | Min  | Avg/Min | Max/Min |
|---------------------|-------------|-------|------|------|------|---------|---------|
| North Building Face | Illuminance | Fc    | 1.79 | 5.70 | 0.00 | N/A     | N/A     |
| South Building Face | Illuminance | Fc    | 1.09 | 4.30 | 0.00 | N/A     | N/A     |
| West Building Face  | Illuminance | Fc    | 0.80 | 0.00 | 0.00 | N/A     | N/A     |
| East Building Face  | Illuminance | Fc    | 1.2  | 5.10 | 0.00 | N/A     | N/A     |

| Symbol | Qty | Catalog Number           | Total Lamp Lumens | LLF  |
|--------|-----|--------------------------|-------------------|------|
|        | 4   | WDG4_LED_P4_70CRI_R3_50  | 20,163.10         | 0.85 |
|        | 7   | WDG2_LED_P3_50K_80CRI_VW | 3,206.30          | 0.85 |

| Type | Manufacturer      | Catalog No.              | Mounting            | Lamp  | Remarks                  |
|------|-------------------|--------------------------|---------------------|-------|--------------------------|
| PL1  | LITHONIA LIGHTING | WDG2_LED_P3_50K_80CRI_VW | WALL MOUNTED 17'-0" | 5000K | SINGLE WALL SCONCE LIGHT |
| PL2  | LITHONIA LIGHTING | WDG4_LED_P4_70CRI_R3_50  | WALL MOUNTED 25'-0" | 5000K | SINGLE WALL SCONCE LIGHT |
| PL3  | LITHONIA LIGHTING | WDG4_LED_P4_70CRI_R3_50  | WALL MOUNTED 25'-0" | 5000K | SINGLE WALL SCONCE LIGHT |
| PL4  | LITHONIA LIGHTING | WDG4_LED_P4_70CRI_R3_50  | WALL MOUNTED 25'-0" | 5000K | SINGLE WALL SCONCE LIGHT |
| PL5  | LITHONIA LIGHTING | WDG2_LED_P3_50K_80CRI_VW | WALL MOUNTED 20'-0" | 5000K | SINGLE WALL SCONCE LIGHT |
| PL6  | LITHONIA LIGHTING | WDG4_LED_P4_70CRI_R3_50  | WALL MOUNTED 25'-0" | 5000K | SINGLE WALL SCONCE LIGHT |
| PL7  | LITHONIA LIGHTING | WDG2_LED_P3_50K_80CRI_VW | WALL MOUNTED 15'-0" | 5000K | SINGLE WALL SCONCE LIGHT |
| PL8  | LITHONIA LIGHTING | WDG2_LED_P3_50K_80CRI_VW | WALL MOUNTED 14'-0" | 5000K | SINGLE WALL SCONCE LIGHT |
| PL9  | LITHONIA LIGHTING | WDG2_LED_P3_50K_80CRI_VW | WALL MOUNTED 14'-0" | 5000K | SINGLE WALL SCONCE LIGHT |
| PL10 | LITHONIA LIGHTING | WDG2_LED_P3_50K_80CRI_VW | WALL MOUNTED 14'-0" | 5000K | SINGLE WALL SCONCE LIGHT |
| PL11 | LITHONIA LIGHTING | WDG2_LED_P3_50K_80CRI_VW | WALL MOUNTED 14'-0" | 5000K | SINGLE WALL SCONCE LIGHT |

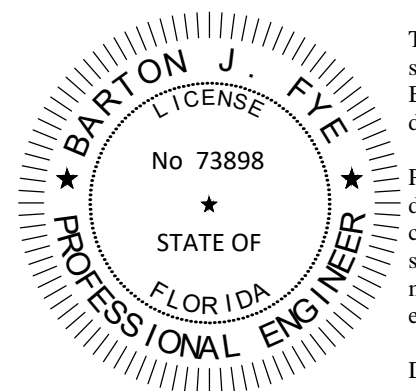


This item has been digitally signed and sealed by Barton J. Fye, P.E. on the date adjacent to the seal.

Printed copies of this document are not considered signed and sealed and the signature must be verified on any electronic copies.  
 Date: 11/17/2021



Call 811 or www.sunshine811.com two full business days before digging to have utilities located and marked.  
 Check positive response codes before you dig!

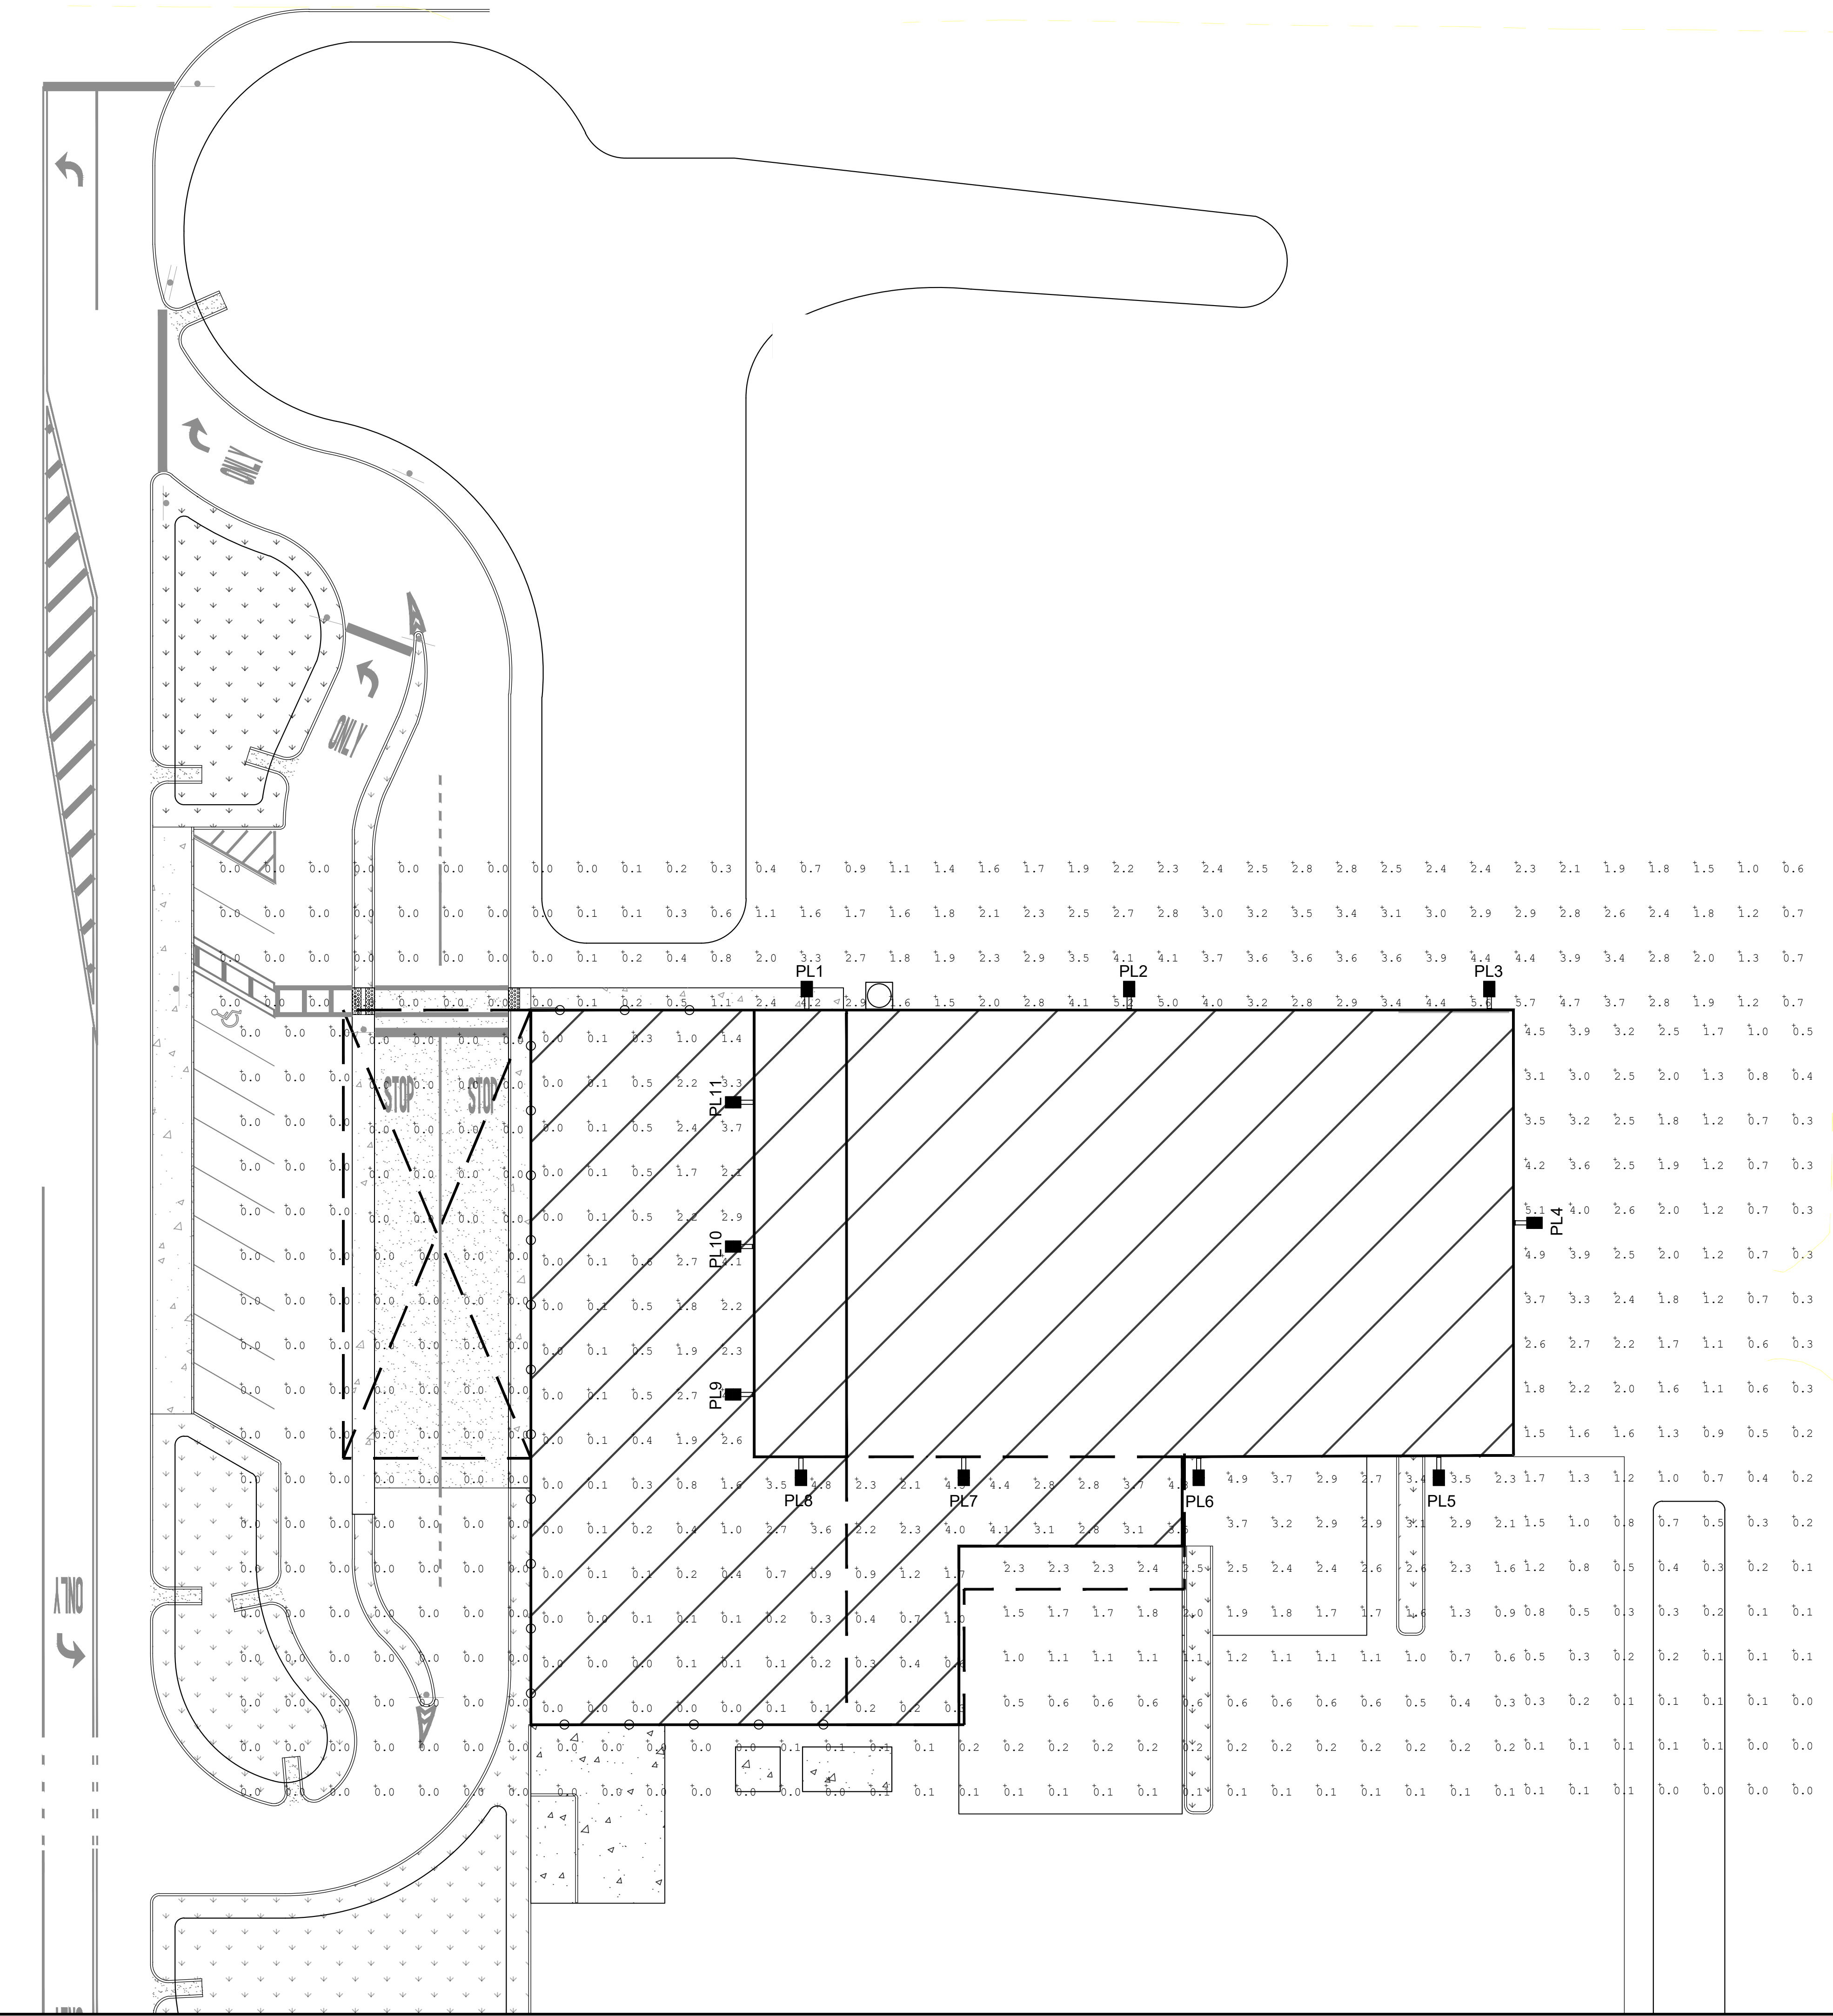

| No. | REVISIONS | DATE | BY |
|-----|-----------|------|----|
|     |           |      |    |

**Kimley & Horn**  
 © 2021 KIMLEY-HORN AND ASSOCIATES, INC.  
 355 ALHAMBRA CIRCLE, SUITE 1400, CORAL GABLES, FL 33134  
 PHONE: 305-673-2025  
 WWW.KIMLEY-HORN.COM REGISTRY 696

LICENSED PROFESSIONAL  
 KHA PROJECT 14-3228000  
 DATE JULY 2021  
 SCALE AS SHOWN  
 DESIGNED BY A/JL  
 DRAWN BY M/IC  
 CHECKED BY A/JL DATE:

**LIGHTING PLAN**

IRC LANDFILL  
 PREPARED FOR  
 INDIAN RIVER COUNTY  
 INDIAN RIVER COUNTY  
 SHEET NUMBER  
**C-800**


GENERAL ELECTRICAL NOTES

- 1. CONTRACTOR SHALL VERIFY JOB SITE CONDITIONS DURING THE BIDDING PERIOD TO OBTAIN THE SCOPE OF ELECTRICAL WORK INVOLVED...
2. CONTRACTOR MAY COMBINE WIRES IN ONE CONDUIT FOR CONVENIENCE OF INSTALLATION...
4. ALL ELECTRICAL EQUIPMENT IS SHOWN DIAGRAMMATICALLY...
7. WHEN BRANCH CIRCUIT LENGTH EXCEEDS 75 FEET FROM PANEL, WIRING SHALL BE INCREASED TO #10 AWG...
17. THE FIRE ALARM CONTRACTOR SHALL PERFORM A SITE VISIT PRIOR TO BID.

ELECTRICAL SYMBOLS LEGEND table with 4 columns: SYMBOLS, LEGEND, SYMBOLS, LEGEND. Includes symbols for lighting fixtures, switches, outlets, transformers, and fire alarm components.

NOTE: NOT ALL SYMBOLS ARE USED.

8-RELAY CAPACITY LP-8 RELAY PANEL

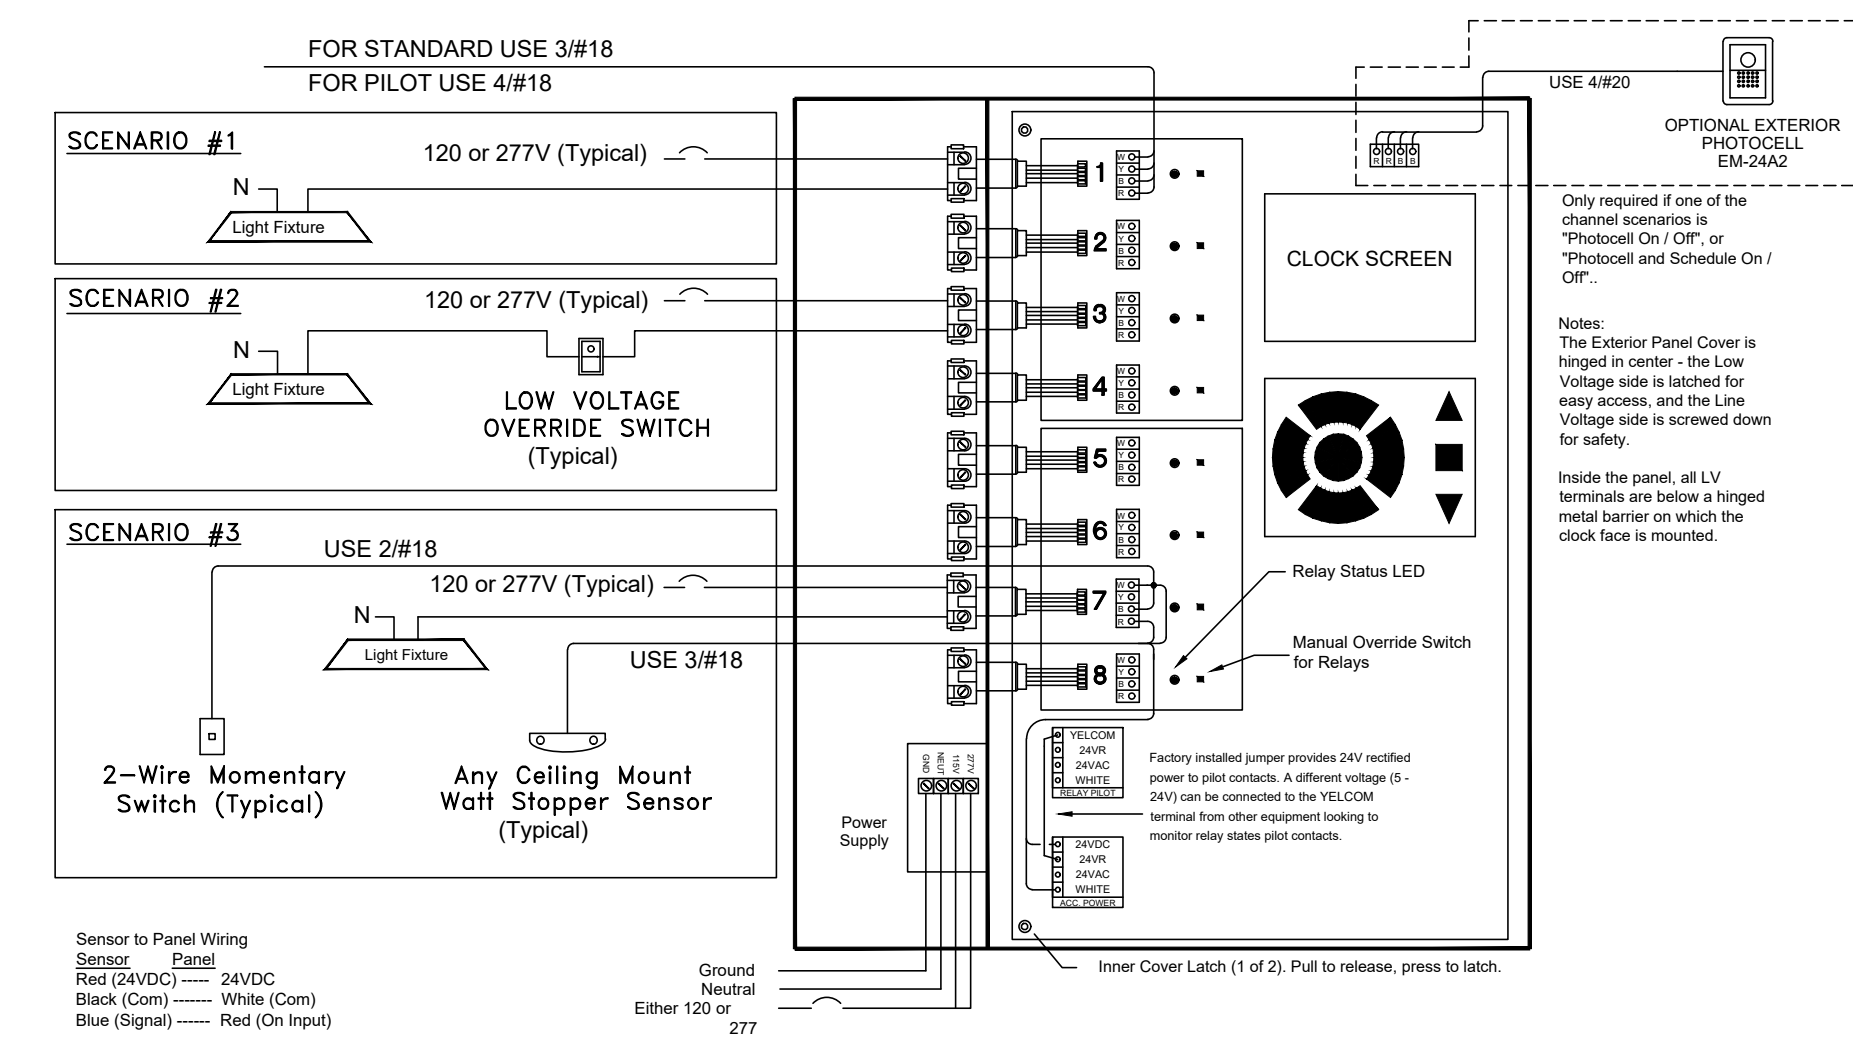

Wattstopper LP-8 Relay Panel

NOTE: (8) RELAYS SHOWN. SEE DRAWINGS FOR TOTAL RELAY REQUIREMENT.

Specifications: Provide a single relay panel with up to 8 relays. Each relay to be individually scheduled through an easy to use integral clock with a backlit 8-line LCD display.

Panel enclosure to be NEMA 1, rated for environments from 32 - 130°F, 5 - 95% RH non-condensing. Panel to come with a split cover which has the high voltage side must be unscrewed to access the relays...

Each relay can be controlled remotely by external switches or motion detectors. Switches can be 2- or 3-wire, momentary or maintained low voltage devices. Motion detectors must provide a 24VDC pilot signal to control the relays.

All programming to be entered via a simple keypad. Each relay can be programmed independently, or relays can be grouped together in firmware to follow the same channel schedule.


- (1) Manual On / Sched Off
(2) Scheduled On/Off
(3) Manual ON /AS Switch Off (for use with AS-100 switches)
(4) Photocell On/Off
(5) Photo & Sched On/Off
(6) Astronomic On/Off
(7) Astro and Sched On/Off

The LCD screen should normally show the current time and date, as well as sunrise and sunset times for that day. Relay channels can also be monitored from the display to see their status - either ON, OFF, or MIXED.

Panel to be The Watt Stopper's (800-852-2778) LP8 panel and must be UL Listed 916, meet local energy codes (California CEC), and have a 1 year warranty.

RATED THRU WALL PIPE PENETRATION NTS

System No. W-L-8010
May 19, 2005
F Ratings - 1 & 2 Hr (See Item 1)
T Ratings - 1/4, 3/4, 1, 1-1/2 and 1-3/4 Hr (See Items 2 & 3)

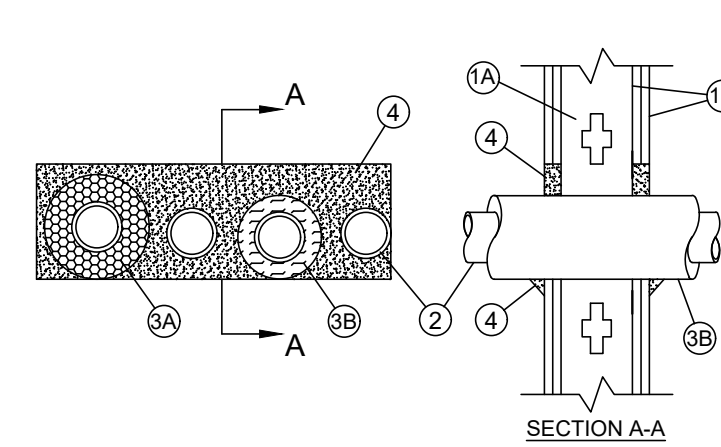

1. Wall Assembly - The 1 or 2 hr fire-rated gypsum wallboard/stud wall assembly shall be constructed of the materials and in the manner specified in the individual U300, U400 or V400 Series Wall and Partition Designs in the UL Fire Resistance Directory and shall include the following construction features:

A. Studs - Wall framing may consist of either wood studs or steel channel studs. Wood studs to consist of nom 2 in. by 4 in. (51 mm to max 102 mm) lumber spaced 16 in. (406 mm) OC. Steel studs to be min 3-8/8 in. (92 mm) wide and spaced max 24 in. (610 mm) OC.

B. Gypsum Board - Nom 5/8 in. (16 mm) thick gypsum wallboard, as specified in the individual Wall and Partition Design. Max area of opening is 65-1/4 sq. in. (421 cm2) with max dimension of 14-1/2 in. (368 mm).

C. Pipe Penetrants - Multiple metallic pipes, conduits, tubings or cables to be installed within the firestop system. Min clearance between penetrants is 1/2 in. (12.7 mm). Penetrants to be installed with firestop material meeting the above specifications and bearing the UL Classification Marking with a Flame Spread Index of 25 or less and a Smoke Developed Index of 50 or less may be used.

D. Through Penetrants - Multiple metallic pipes, conduits, tubings or cables to be installed within the firestop system. Min clearance between penetrants is 1/2 in. (12.7 mm). Penetrants to be installed with firestop material meeting the above specifications and bearing the UL Classification Marking with a Flame Spread Index of 25 or less and a Smoke Developed Index of 50 or less may be used.

E. Steel Pipe - Nom 2 in. (51 mm) diam (or smaller) Schedule 5 (or heavier) steel pipe.

F. Conduit - Nom 2 in. (51 mm) diam (or smaller) steel electrical metallic tubing or steel conduit.

G. Copper Tubing - Nom 2 in. (51 mm) diam (or smaller) Type L (or heavier) copper tubing.

H. Copper Pipe - Nom 2 in. (51 mm) diam (or smaller) Regular (or heavier) copper pipe.

I. Fire Alarm Annunciator Panel - Max of four pipes, conduits or tubing to be installed within the opening. The space between pipes, conduits or tubing and periphery of opening shall be min 1-3/16 in. (30 mm) for uninsulated copper tubes and copper pipes (Items 2C and 2D) and 0 in. (point contact) for insulated copper tubes and copper pipes and un-insulated steel pipes and conduit (Item 2B). The space between pipes, conduits or tubing and periphery of opening shall be max 1-5/16 in. (33 mm). Pipe, conduit or tubing to be rigidly supported on both sides of floor or wall assembly. The following types and sizes of metallic pipes, conduits or tubing may be used:

1. Wall Assembly - The 1 or 2 hr fire-rated gypsum wallboard/stud wall assembly shall be constructed of the materials and in the manner specified in the individual U300, U400 or V400 Series Wall and Partition Designs in the UL Fire Resistance Directory and shall include the following construction features:

2. Through Penetrants - Multiple metallic pipes, conduits, tubings or cables to be installed within the firestop system. Min clearance between penetrants is 1/2 in. (12.7 mm). Penetrants to be installed with firestop material meeting the above specifications and bearing the UL Classification Marking with a Flame Spread Index of 25 or less and a Smoke Developed Index of 50 or less may be used.

3. Pipe Insulation (Optional) - The following types of pipe insulation may be used: A. Pipe Covering - Nom 1-1/2 in. (38 mm) (or thinner) hollow cylindrical heavy density glass fiber units jacketed on the outside with an all service jacket. Longitudinal joints sealed with metal fasteners or factory applied self-sealing lap tape. Transverse joints secured with metal fasteners or with butt tape supplied with the product.


B. Tube Insulation - Plastics - Nom 3/4 in. (19 mm) thick acrylonitrile butadiene/polyvinyl chloride (AB/PVC) flexible foam furnished in the form of tubing. The annular space between the insulated pipe and the edge of the through opening shall be min 0 in. (point contact).

7. FIRE ALARM SYSTEM EQUIPMENT SHALL BE AN ANALOG ADDRESSABLE SYSTEM WITH THE CAPABILITY OF EXPANSION.

8. SECOND POWER SUPPLY CAPACITY SHALL BE 24 HOURS STANDBY WITH 15 MINUTES ALARM.

RATED FLOOR PIPE PENETRATION NTS

System No. C-AJ-8072
September 07, 2004
F Rating - 2 Hr
T Ratings - 0, 1/4, 1/2, & 1 Hr (See Item 2)

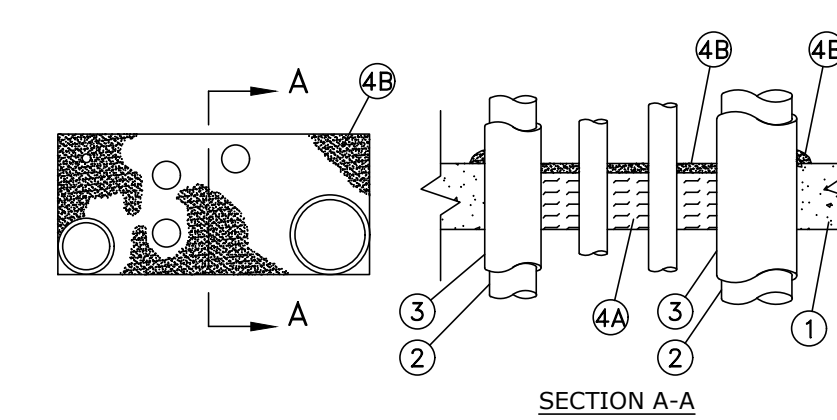

1. Floor or Wall Assembly - Min 4-1/2 in. thick reinforced lightweight or normal weight (100-150 pcf) concrete floor or min 5 in. thick reinforced lightweight or normal weight concrete wall. Wall may also be constructed of any UL Classified Concrete Blocks\*. Max area of opening 84 square in., with max dimension of 14 in.

2. Through Penetrants - Multiple metallic pipes, conduits, tubings or cables to be installed within the firestop system. Min clearance between penetrants is 1/2 in. (12.7 mm). Penetrants to be installed with firestop material meeting the above specifications and bearing the UL Classification Marking with a Flame Spread Index of 25 or less and a Smoke Developed Index of 50 or less may be used.

3. Pipe Insulation (Optional) - The following types of pipe insulation may be used: A. Pipe Covering - Nom 1-1/2 in. (38 mm) (or thinner) hollow cylindrical heavy density glass fiber units jacketed on the outside with an all service jacket. Longitudinal joints sealed with metal fasteners or factory applied self-sealing lap tape. Transverse joints secured with metal fasteners or with butt tape supplied with the product.

B. Tube Insulation - Plastics - Nom 3/4 in. (19 mm) thick acrylonitrile butadiene/polyvinyl chloride (AB/PVC) flexible foam furnished in the form of tubing. The annular space between the insulated pipe and the edge of the through opening shall be min 0 in. (point contact).

4. Firestop System - The details of the firestop system shall be as follows: A. Packing Material - Min 4 in. thickness of min 4 pcf mineral wool batt insulation firmly packed into opening as a permanent form. Packing material to be recessed from top surface of floor or from both surfaces of wall as well as required to accommodate the required thickness of fill material.

B. Fill, Void or Cavity Materials - Caulk or Sealant - Min 1/2 in. thickness of fill material applied within the annulus, flush with top surface of floor or with both surfaces of wall. Min 1/2 in. diam bead of caulk or sealant applied to the concrete/penetrant interface at the point contact location on the top surface of floor or both surfaces of wall.

C. Fire Alarm Annunciator Panel - Max of four pipes, conduits or tubing to be installed within the opening. The space between pipes, conduits or tubing and periphery of opening shall be min 1-3/16 in. (30 mm) for un-insulated copper tubes and copper pipes (Items 2C and 2D) and 0 in. (point contact) for insulated copper tubes and copper pipes and un-insulated steel pipes and conduit (Item 2B). The space between pipes, conduits or tubing and periphery of opening shall be max 1-5/16 in. (33 mm). Pipe, conduit or tubing to be rigidly supported on both sides of floor or wall assembly. The following types and sizes of metallic pipes, conduits or tubing may be used:

1. Wall Assembly - The 1 or 2 hr fire-rated gypsum wallboard/stud wall assembly shall be constructed of the materials and in the manner specified in the individual U300, U400 or V400 Series Wall and Partition Designs in the UL Fire Resistance Directory and shall include the following construction features:

2. Through Penetrants - Multiple metallic pipes, conduits, tubings or cables to be installed within the firestop system. Min clearance between penetrants is 1/2 in. (12.7 mm). Penetrants to be installed with firestop material meeting the above specifications and bearing the UL Classification Marking with a Flame Spread Index of 25 or less and a Smoke Developed Index of 50 or less may be used.

3. Pipe Insulation (Optional) - The following types of pipe insulation may be used: A. Pipe Covering - Nom 1-1/2 in. (38 mm) (or thinner) hollow cylindrical heavy density glass fiber units jacketed on the outside with an all service jacket. Longitudinal joints sealed with metal fasteners or factory applied self-sealing lap tape. Transverse joints secured with metal fasteners or with butt tape supplied with the product.

B. Tube Insulation - Plastics - Nom 3/4 in. (19 mm) thick acrylonitrile butadiene/polyvinyl chloride (AB/PVC) flexible foam furnished in the form of tubing. The annular space between the insulated pipe and the edge of the through opening shall be min 0 in. (point contact).

4. Firestop System - The details of the firestop system shall be as follows: A. Packing Material - Min 4 in. thickness of min 4 pcf mineral wool batt insulation firmly packed into opening as a permanent form. Packing material to be recessed from top surface of floor or from both surfaces of wall as well as required to accommodate the required thickness of fill material.

B. Fill, Void or Cavity Materials - Caulk or Sealant - Min 1/2 in. thickness of fill material applied within the annulus, flush with top surface of floor or with both surfaces of wall. Min 1/2 in. diam bead of caulk or sealant applied to the concrete/penetrant interface at the point contact location on the top surface of floor or both surfaces of wall.

C. Fire Alarm Annunciator Panel - Max of four pipes, conduits or tubing to be installed within the opening. The space between pipes, conduits or tubing and periphery of opening shall be min 1-3/16 in. (30 mm) for un-insulated copper tubes and copper pipes (Items 2C and 2D) and 0 in. (point contact) for insulated copper tubes and copper pipes and un-insulated steel pipes and conduit (Item 2B). The space between pipes, conduits or tubing and periphery of opening shall be max 1-5/16 in. (33 mm). Pipe, conduit or tubing to be rigidly supported on both sides of floor or wall assembly. The following types and sizes of metallic pipes, conduits or tubing may be used:


1. Wall Assembly - The 1 or 2 hr fire-rated gypsum wallboard/stud wall assembly shall be constructed of the materials and in the manner specified in the individual U300, U400 or V400 Series Wall and Partition Designs in the UL Fire Resistance Directory and shall include the following construction features:

2. Through Penetrants - Multiple metallic pipes, conduits, tubings or cables to be installed within the firestop system. Min clearance between penetrants is 1/2 in. (12.7 mm). Penetrants to be installed with firestop material meeting the above specifications and bearing the UL Classification Marking with a Flame Spread Index of 25 or less and a Smoke Developed Index of 50 or less may be used.

3. Pipe Insulation (Optional) - The following types of pipe insulation may be used: A. Pipe Covering - Nom 1-1/2 in. (38 mm) (or thinner) hollow cylindrical heavy density glass fiber units jacketed on the outside with an all service jacket. Longitudinal joints sealed with metal fasteners or factory applied self-sealing lap tape. Transverse joints secured with metal fasteners or with butt tape supplied with the product.

B. Tube Insulation - Plastics - Nom 3/4 in. (19 mm) thick acrylonitrile butadiene/polyvinyl chloride (AB/PVC) flexible foam furnished in the form of tubing. The annular space between the insulated pipe and the edge of the through opening shall be min 0 in. (point contact).

4. Firestop System - The details of the firestop system shall be as follows: A. Packing Material - Min 4 in. thickness of min 4 pcf mineral wool batt insulation firmly packed into opening as a permanent form. Packing material to be recessed from top surface of floor or from both surfaces of wall as well as required to accommodate the required thickness of fill material.

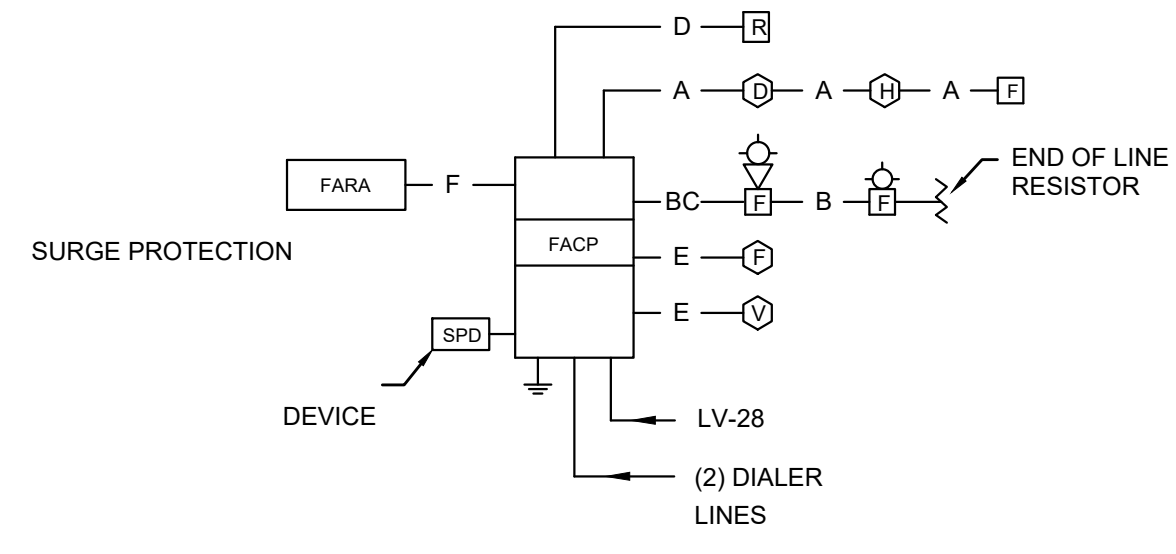

FIRE ALARM RISER NTS

FIRE ALARM SYSTEM - WIRING SCHEDULE table with columns for Conductors and Description, listing wire types like 2C #18 SHIELDED TWISTED PAIR and components like ADDRESSABLE INITIATION DEVICES.

ILSON ARGENTI ENGINEERING logo and address: 1408 N WESTSHORE BLVD, STE. 506 TAMPA, FL 33607. WORKWITHHG.COM 813.855.3330

CMK Design Studio logo and address: 6822 22nd Ave. N, #148 St. Petersburg, Florida 33710. PH: 813.362.6381. marcos@cmkdesignstudio.com

NICHOLAS LETO, No. 22245 Drawing Not Valid Unless Signed, Sealed & Dated by Registered Professional

INDIAN RIVER COUNTY LANDFILL HOUSEHOLD HAZARDOUS WASTE AND RECYCLING FACILITY Indian River County, Florida

NO. REVISIONS DATE table with entries for FIELD COORD

INDIAN RIVER COUNTY LANDFILL  
HOUSEHOLD HAZARDOUS WASTE  
AND RECYCLING FACILITY  
Indian River County, Florida


| NO. | REVISIONS          | DATE       |
|-----|--------------------|------------|
| 1   | FIELD COORDINATION | 05.15.2021 |
| 2   | FIELD COORDINATION | 11.05.2021 |

JOB NO.  
**2016**

ISSUE DATE:  
07/07/2021

DRAWN BY:  
WG

SHEET TITLE  
LIGHTING PLAN  
SHEET NO.  
**E101**

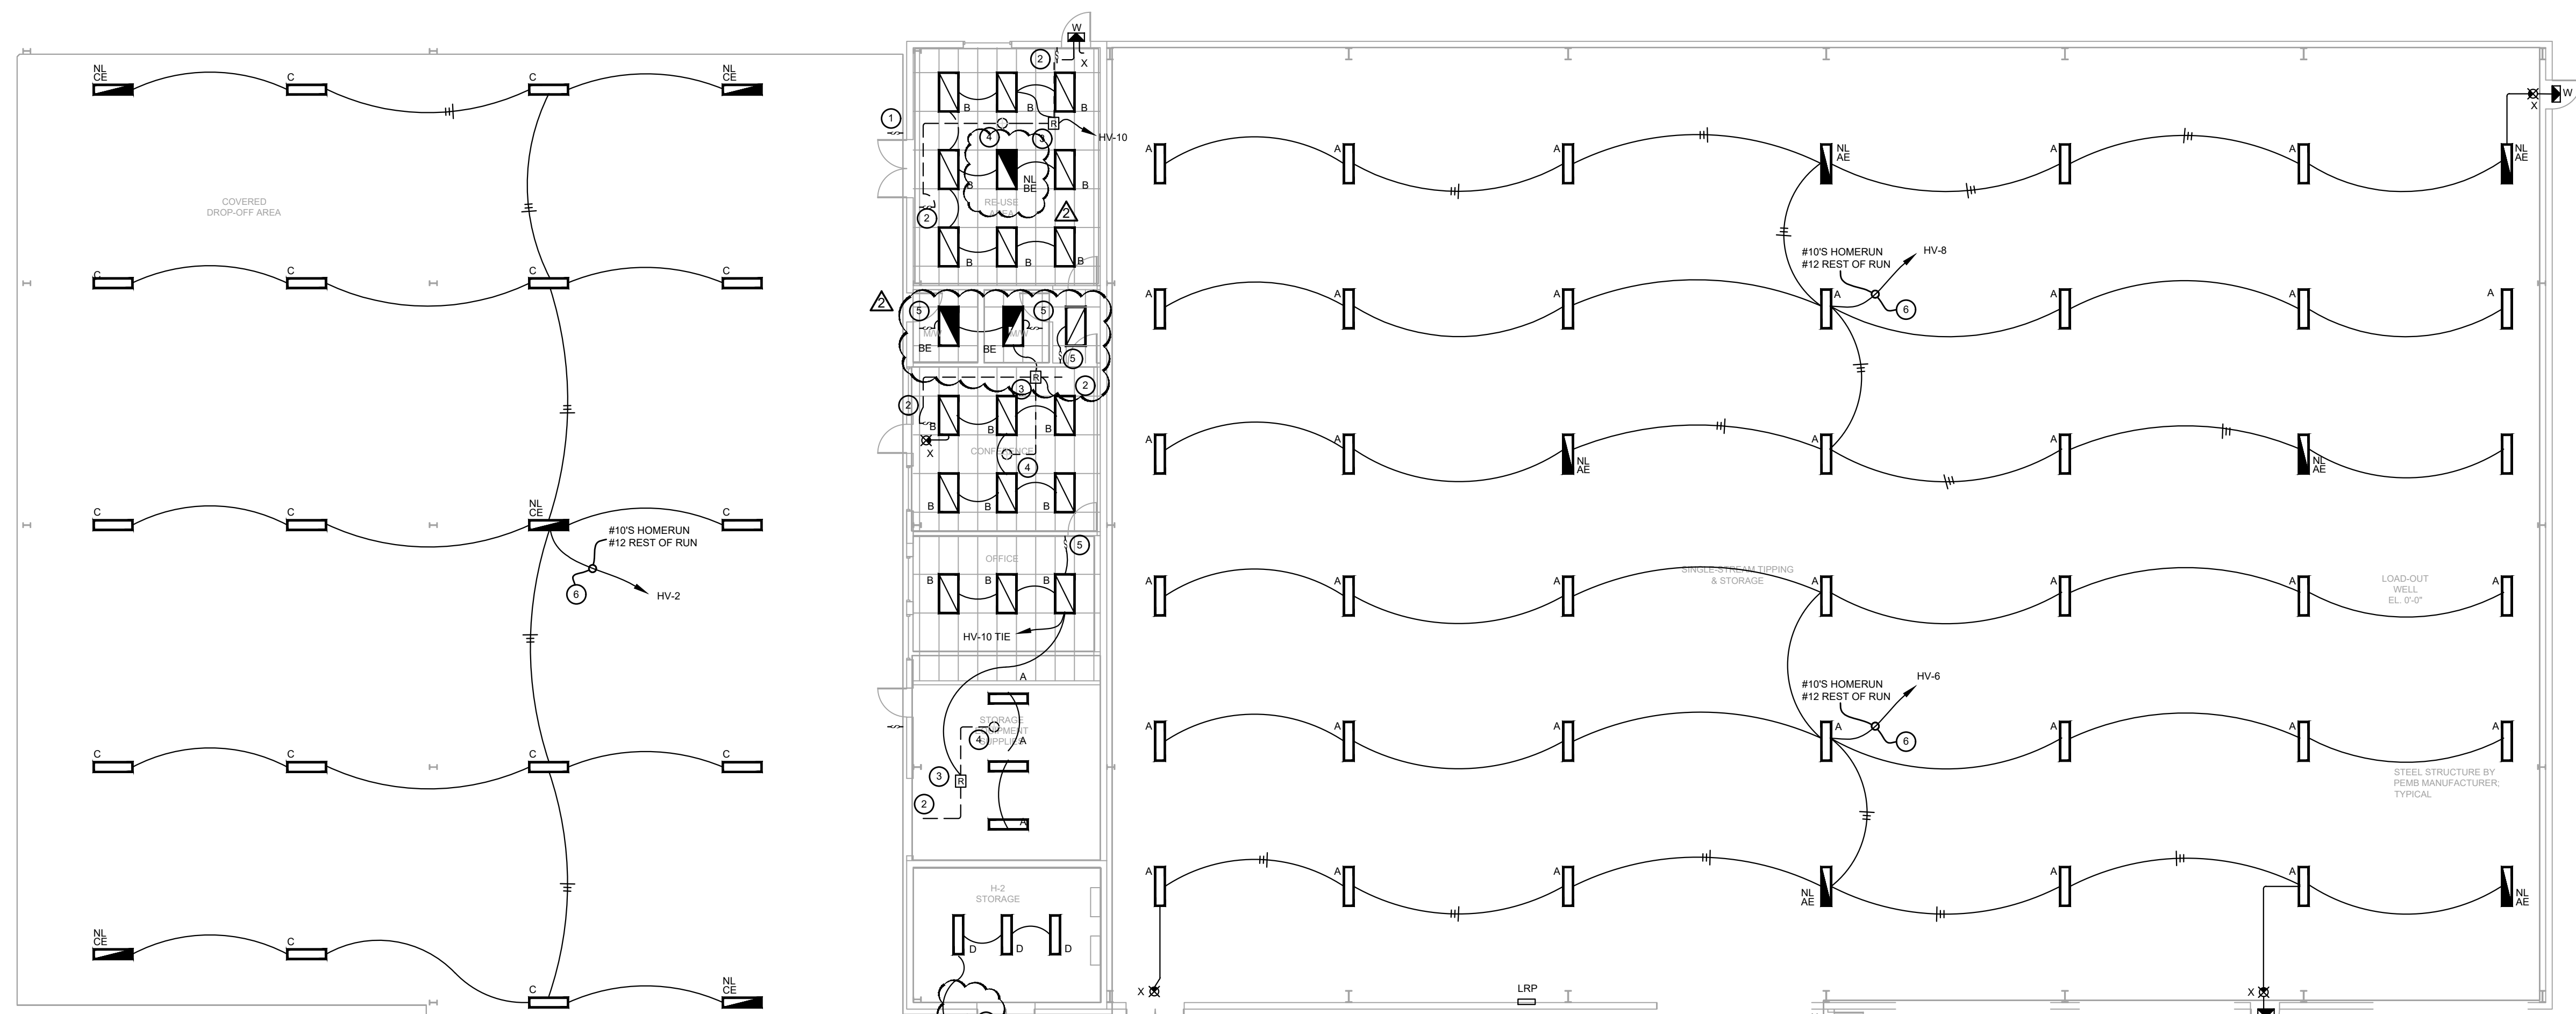


**LIGHTING NOTES**

1. LOW VOLTAGE MANUAL OVERRIDE SWITCHES FOR WATTSTOPER LP-8 LIGHTING CONTROL PANEL. VERIFY EXACT LOCATION WITH OWNER PRIOR INSTALLATION.
2. ON/OFF OVERRIDE SWITCH MODEL nPODM.
3. LOW VOLTAGE POWER PACK. SENSOR SWITCH nPP16 SA. REFER TO CONTROL DIAGRAMS ON THIS SHEET.
4. PROVIDE NEW CEILING/PENDANT/SURFACE MOUNTED, LOW-VOLTAGE, EXTENDED RANGE, DUAL-TECHNOLOGY, LIGHTING OCCUPANCY SENSOR. SENSOR SWITCH MODEL #nCM-PDT-10.
5. PROVIDE NEW WALL MOUNTED, SINGLE-POLE, LINE-VOLTAGE, STANDARD RANGE, DUAL-TECHNOLOGY, LIGHTING OCCUPANCY SENSOR WITH BUILT-IN MANUAL OVERRIDE. SENSOR SWITCH MODEL #WSX-PDT.
6. ROUTE CIRCUIT THROUGH LIGHTING RELAY PANEL (LRP) LIGHTING RELAY PANEL SHALL BE LOCATED NEXT TO ELECTRICAL PANELS AS SHOWN. CONTRACTOR TO CARRY EXTRA HOT CONDUCTOR FOR EMERGENCY AND NIGHT LIGHT FIXTURES. SEE LIGHTING RELAY PANEL DETAIL ON SHEET 'E000'.
7. PROVIDE 120V/1P SNAP SWITCH. THE CONTRACTOR SHALL PROVIDE A RIGID CONDUIT WITH A SEAL OFF ON THE CONDUIT THAT IS DUCTED INTO THE "H-2-STORAGE ROOM". ALL ELECTRICAL EQUIPMENT MUST BE LISTED AS EXPLOSION-PROOF.


FIXTURE, SWITCHING & DEVICE SUFFIXES:  
E = EXISTING  
R = RELOCATED  
RE = RELOCATE EXISTING  
N = NEW  
3 = 3-WAY SWITCHES  
D = DIMMER. PROVIDE FIXTURE COMPATIBLE DIMMER SWITCH.  
a,b,...etc = LOWER CASE LETTERS INDICATE CONTROL GROUPS.  
NL- NIGHT LIGHT

NOTES: ALL DEVICES ARE NEW UNLESS INDICATED OTHERWISE.

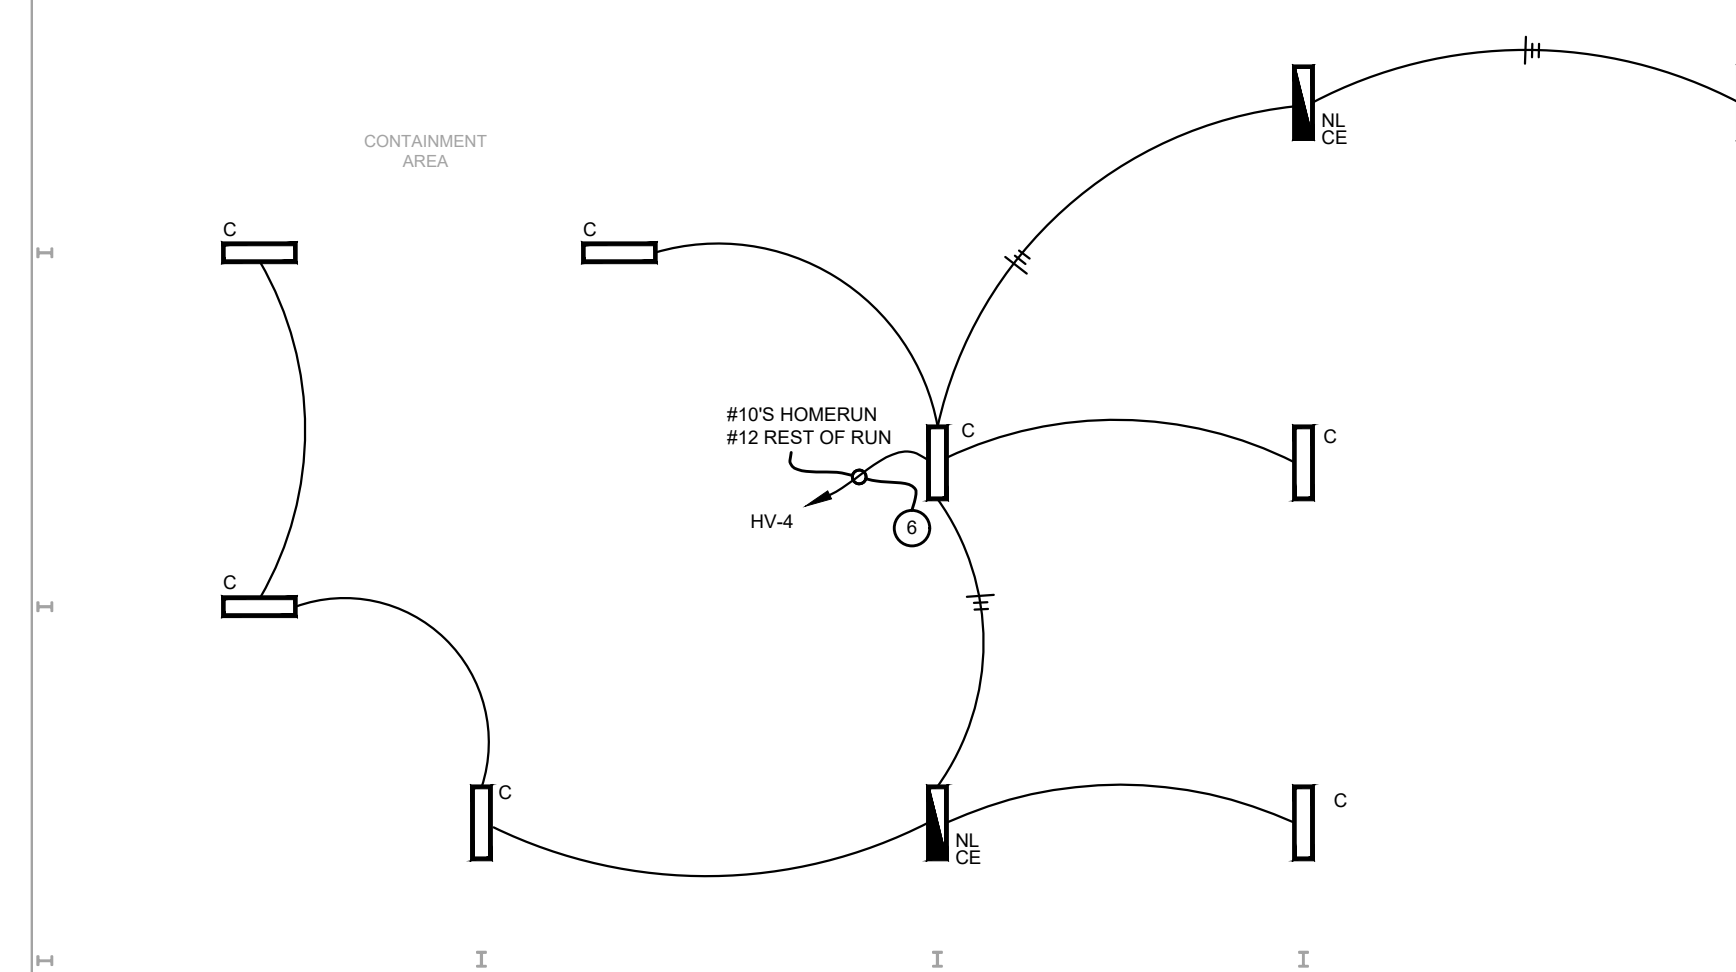

LIGHTING CONTROL WITH TWO SWITCHES  
SCALE: NONE

**LIGHTING PLAN**  
SCALE: 3/32" = 1'-0"

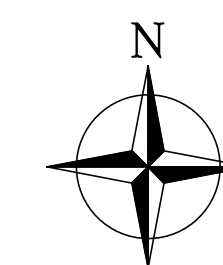

**LIGHTING FIXTURE SCHEDULE**

| TYPE | MANUFACTURER       | CATALOG NO.                  | MOUNTING             | VOLT | LAMP           | REMARKS   | SELECTION |
|------|--------------------|------------------------------|----------------------|------|----------------|---|-----------|
| A    | COLUMBIA LIGHTING  | CHB2-40MH-FA-EDU             | SUSPENDED AT 16' AFF | 277  | LED 170W 4000K | COLUMBIA LED HIGHBAY LIGHT FIXTURE  |           |
| AE   |                    |                              |                      |      |                | SAME AS 'A' FIXTURE. PROVIDE NEW 90-MIN BATTERY BACKUP IN FIXTURE.                          |           |
| B    | COLUMBIA LIGHTING  | CBT24-LS40-4400L             | LAY-IN GRID          | 277  | LED 50W 4000K  | 2X4 LED LIGHT FIXTURE   |           |
| BE   |                    |                              |                      |      |                | SAME AS 'B' FIXTURE. PROVIDE NEW 90-MIN BATTERY BACKUP IN FIXTURE.                          |           |
| C    | COLUMBIA LIGHTING  | CHB2-40MH-FA-EDU-DAMP LISTED | SUSPENDED AT 16' AFF | 277  | LED 170W 4000K | COLUMBIA LED HIGHBAY LIGHT FIXTURE (DAMP LISTED)  |           |
| CE   |                    |                              |                      |      |                | SAME AS 'C' FIXTURE. PROVIDE NEW 90-MIN BATTERY BACKUP IN FIXTURE.                          |           |
| D    | SOLAS RAY LIGHTING | HJL141-060-40-U-4JSPM        | SUSPENDED AT 16' AFF | 277  | LED 60W 4000K  | EXPLOSION PROOF LIGHT FIXTURE   |           |
| W    | MCGRAW-EDISON      | TO BE SELECTED BY OWNER      | SURFACE              | 120  | 67W MAX        | LARGE EXTERIOR WALL PACK FIXTURE WITH BUILT IN 90-MIN BATTERY BACKUP AND PHOTOCELL CONTROL. |           |
| X    |                    |                              | SURFACE CEILING      | 277  | 11W LED        | EXIT SIGN WITH 90-MIN BATTERY BACKUP IN FIXTURE.  |           |



PERMIT SET

INDIAN RIVER COUNTY LANDFILL  
HOUSEHOLD HAZARDOUS WASTE  
AND RECYCLING FACILITY  
Indian River County, Florida

| NO. | REVISIONS          | DATE       |
|-----|--------------------|------------|
| ▲   | FIELD COORDINATION | 05/15/2021 |
| ▲   | FIELD COORDINATION | 11/05/2021 |

JOB NO.  
**2016**

ISSUE DATE:  
07/07/2021

DRAWN BY:  
WG



SHEET TITLE  
ELECTRICAL PLAN

SHEET NO.  
**E201**

PERMIT SET

C.O.A. #28759  
**GILSON**  
IRGENTING  
ENGINEERING  
1408 N WESTSHORE BLVD,  
STE. 506 TAMPA, FL 33607  
WORKWITHWG.COM  
813.855.3330

**ELECTRICAL PLAN**  
SCALE: 3/32" = 1'-0"

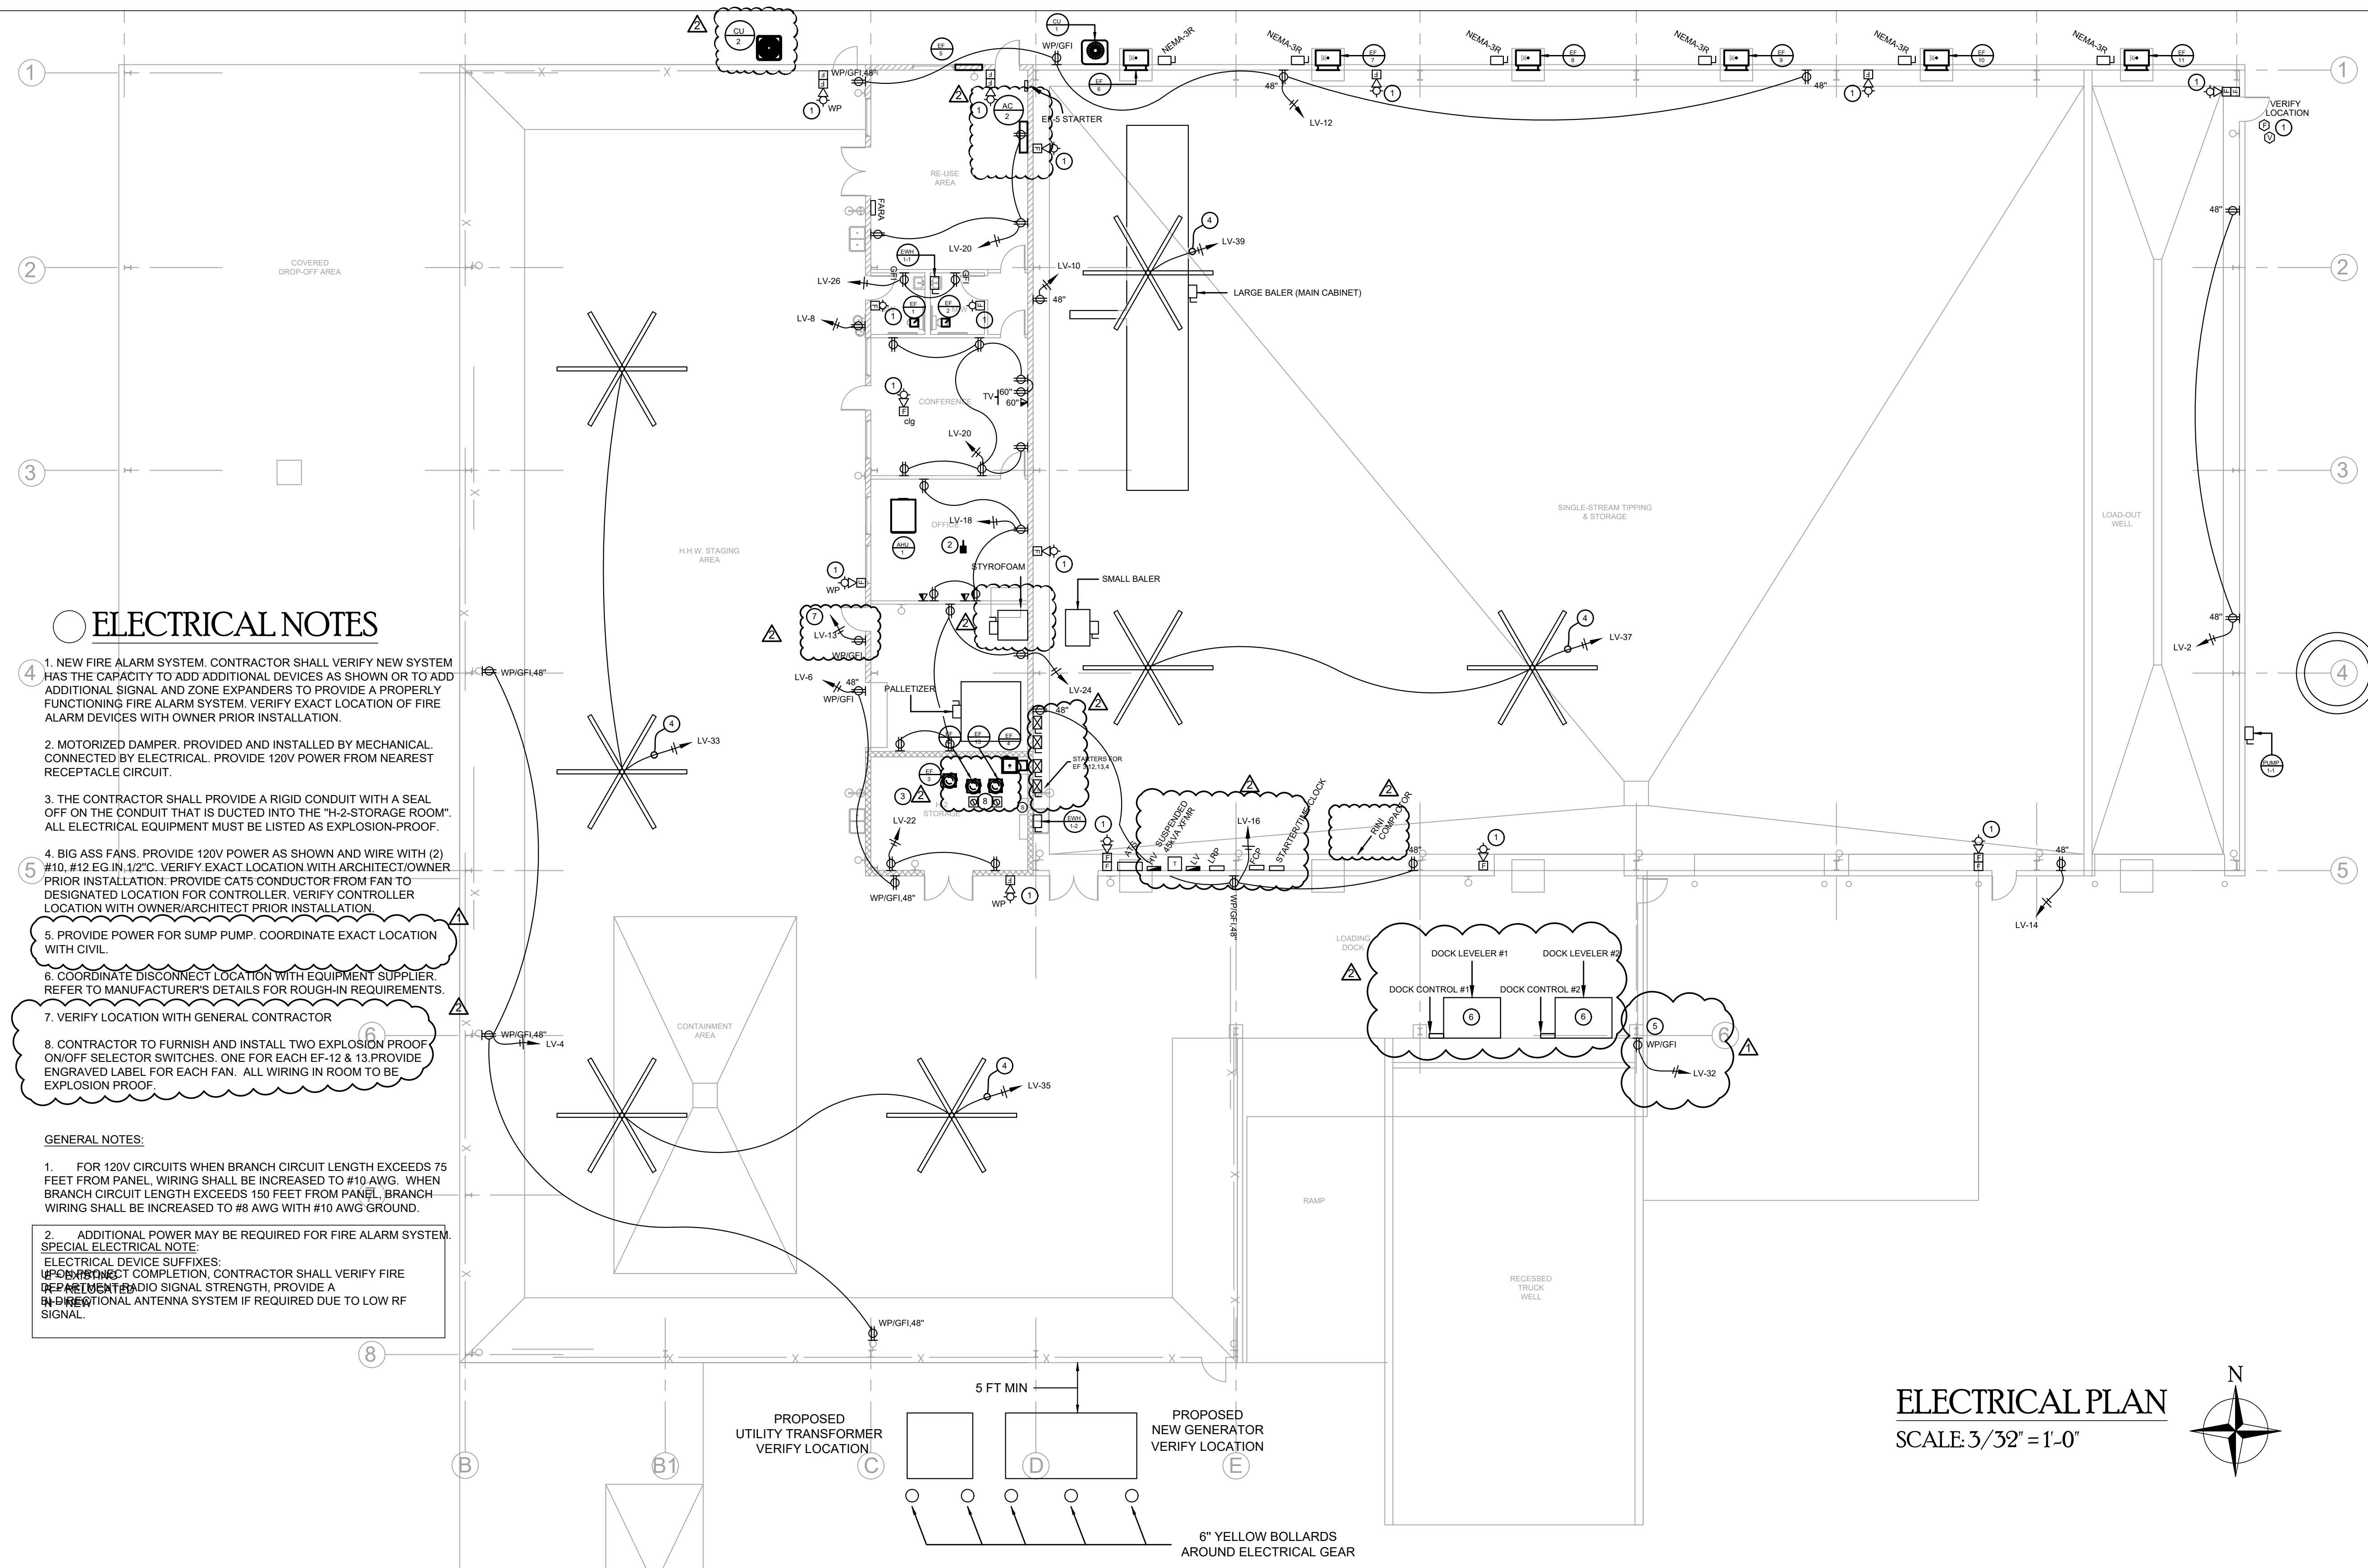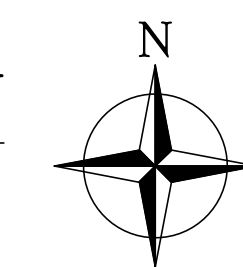

**ELECTRICAL NOTES**

1. NEW FIRE ALARM SYSTEM. CONTRACTOR SHALL VERIFY NEW SYSTEM HAS THE CAPACITY TO ADD ADDITIONAL DEVICES AS SHOWN OR TO ADD ADDITIONAL SIGNAL AND ZONE EXPANDERS TO PROVIDE A PROPERLY FUNCTIONING FIRE ALARM SYSTEM. VERIFY EXACT LOCATION OF FIRE ALARM DEVICES WITH OWNER PRIOR INSTALLATION.
2. MOTORIZED DAMPER. PROVIDED AND INSTALLED BY MECHANICAL. CONNECTED BY ELECTRICAL. PROVIDE 120V POWER FROM NEAREST RECEPTACLE CIRCUIT.
3. THE CONTRACTOR SHALL PROVIDE A RIGID CONDUIT WITH A SEAL OFF ON THE CONDUIT THAT IS DUCTED INTO THE "H-2-STORAGE ROOM". ALL ELECTRICAL EQUIPMENT MUST BE LISTED AS EXPLOSION-PROOF.
4. BIG ASS FANS. PROVIDE 120V POWER AS SHOWN AND WIRE WITH (2) #10, #12 EG IN 1/2" C. VERIFY EXACT LOCATION WITH ARCHITECT/OWNER PRIOR INSTALLATION. PROVIDE CAT5 CONDUCTOR FROM FAN TO DESIGNATED LOCATION FOR CONTROLLER. VERIFY CONTROLLER LOCATION WITH OWNER/ARCHITECT PRIOR INSTALLATION.
5. PROVIDE POWER FOR SUMP PUMP. COORDINATE EXACT LOCATION WITH CIVIL.
6. COORDINATE DISCONNECT LOCATION WITH EQUIPMENT SUPPLIER. REFER TO MANUFACTURER'S DETAILS FOR ROUGH-IN REQUIREMENTS.
7. VERIFY LOCATION WITH GENERAL CONTRACTOR
8. CONTRACTOR TO FURNISH AND INSTALL TWO EXPLOSION PROOF ON/OFF SELECTOR SWITCHES. ONE FOR EACH EF-12 & 13. PROVIDE ENGRAVED LABEL FOR EACH FAN. ALL WIRING IN ROOM TO BE EXPLOSION PROOF.

**GENERAL NOTES:**


1. FOR 120V CIRCUITS WHEN BRANCH CIRCUIT LENGTH EXCEEDS 75 FEET FROM PANEL. WIRING SHALL BE INCREASED TO #10 AWG. WHEN BRANCH CIRCUIT LENGTH EXCEEDS 150 FEET FROM PANEL, BRANCH WIRING SHALL BE INCREASED TO #8 AWG WITH #10 AWG GROUND.

2. ADDITIONAL POWER MAY BE REQUIRED FOR FIRE ALARM SYSTEM.  
**SPECIAL ELECTRICAL NOTE:**  
ELECTRICAL DEVICE SUFFIXES:  
UPON COMPLETION, CONTRACTOR SHALL VERIFY FIRE DEPARTMENT RADIO SIGNAL STRENGTH. PROVIDE A DIRECTIONAL ANTENNA SYSTEM IF REQUIRED DUE TO LOW RF SIGNAL.

**SPECIAL ELECTRICAL NOTE:**  
SEE SHEET E300 FOR MECHANICAL SCHEDULE.

| DESCRIPTION       | ELECTRICAL CHARACTERISTICS |       | CIRCUIT DESIGNATION |    | BREAKER | FEEDER      | EQUIP. GROUND | CONDUIT | DISCONNECT SWITCH | REMARKS |        |                   |              |
|-------------------|----------------------------|-------|---------------------|----|---------|-------------|---------------|---------|-------------------|---------|--------|-------------------|--------------|
|                   | VOLTS                      | PHASE | KW                  | HP | MCA     | AMPS        | POLES         |         |                   |         |        |                   |              |
| LARGE BALER       | 460                        | 3     |                     | 83 | 132.9   | HV-1,3,5    | 200           | 3       | (3) #1/0          | #6      | 2"     | DIRECT CONNECTION | SEE NOTE 1,2 |
| SMALL BALER       | 480                        | 3     |                     | 10 | 17.5    | HV-7,9,11   | 25            | 3       | (3) #12           | #12     | 1/2"   | DIRECT CONNECTION | SEE NOTE 1,2 |
| STYROFOAM MACHINE | 208                        | 3     |                     |    | 48.0    | LV-1,3,5    | 50            | 3       | (3) #6            | #10     | 3/4"   | 60A/2P/NF/NEMA-1  | SEE NOTE 1   |
| PALLETIZER        | 120                        | 1     |                     |    | 15.0    | LV-7        | 20            | 1       | (2) #12           | #12     | 1/2" C | 30A/2P/NF/NEMA-1  | SEE NOTE 1   |
| DOCK LEVELER #1   | 120                        | 1     |                     |    | 15.0    | LV-9        | 20            | 1       | (2) #12           | #12     | 1/2"   | 20A/1P/NF/NEMA-1  | SEE NOTE 1   |
| DOCK LEVELER #2   | 120                        | 1     |                     |    | 15.0    | LV-11       | 20            | 1       | (2) #12           | #12     | 1/2"   | 20A/1P/NF/NEMA-1  | SEE NOTE 1   |
| STRETCH WRAP      | 120                        | 1     |                     |    | 15.0    | LV-13       | 20            | 1       | (2) #12           | #12     | 1/2"   | 30A/2P/NF/NEMA-1  | SEE NOTE 1   |
| RUNI COMPACTOR    | 460                        | 3     |                     | 10 | 21.0    | HV-31,33,35 | 40            | 3       | (3) #6            | #10     | 3/4"   | 30A/3P/NF/NEMA-1  | SEE NOTE 1   |

**NOTES:**

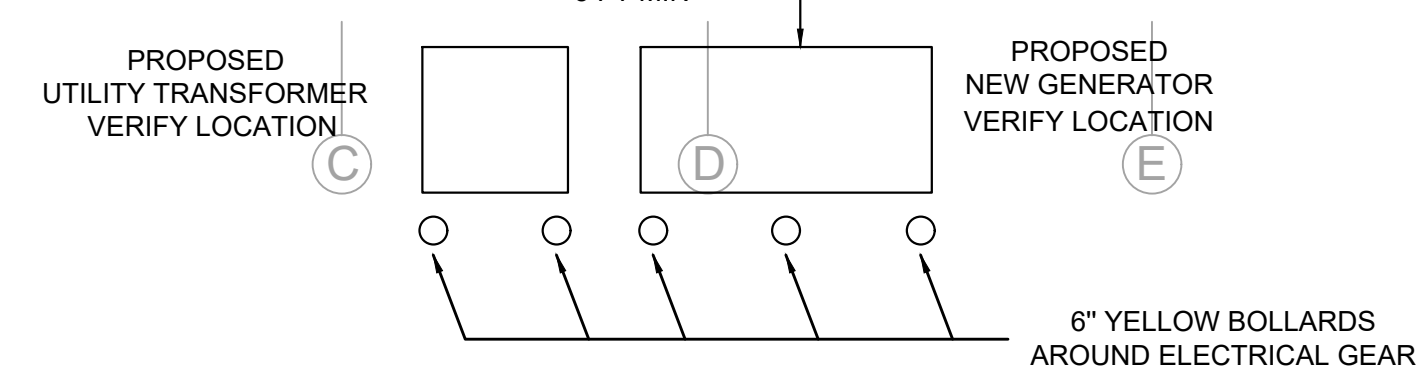

**RISER NOTES**

- NEW 277/480/3Ø CT METER. COORDINATE WITH LOCAL UTILITY. PROVIDE LIGHTING ARRESTOR AND GROUND PER LOCAL UTILITY REQUIREMENTS. CT METER ENCLOSURE TO BE FURNISHED AND INSTALLED BY THE CONTRACTOR. MOUNT CT METER ENCLOSURE ON A 4X4 CONCRETE PEDESTAL ADJACENT TO THE ENCLOSURE.
- PROVIDE (4) #500 MCM IN 3" CONDUIT.
- PROVIDE NEW 400A, 277/480V/3Ø SERVICE ENTRANCE RATED AUTOMATIC TRANSFER SWITCH WITH A 400A MAIN CIRCUIT BREAKER ON UTILITY SOURCE. SWITCH SHALL BE 3-POLE, IN NEMA-3R ENCLOSURE. ATS SHALL SERVE AS THE NEW MAIN DISCONNECT FOR THE BUILDING. BOND NEUTRAL AND GROUND AT ATS.
- PROVIDE #1/0 GROUNDING ELECTRODE CONDUCTOR TO 5/8" X 10" COPPER CLAD GROUND RODS. BOND NEUTRAL AND GROUND IN ATS. SEE DETAIL THIS SHEET.
- PROVIDE (4) #500 MCM, #3 EG IN 3-1/2" CONDUIT.
- PROVIDE (3) #1, #6 EG IN 1-1/2".
- PROVIDE (4) #250, #2 GEC IN 2-1/2".
- 277/480V/3Ø, 250kW DIESEL GENERATOR WITH NEMA-3R SOUND ENCLOSURE AND SUB-BASE FUEL TANK AND 400A 80% RATED OUTPUT BREAKER. COORDINATE EXACT LOCATION WITH OWNER. GENERATOR SHALL COMPLY WITH NEC ARTICLE 702 (OPTIONAL STANDBY SYSTEMS). CONTRACTOR SHALL PROVIDE GENERATOR PAD. PROVIDE 48 HOUR FUEL TANK.

- PROVIDE (4) #500 MCM, #3 EG IN 3-1/2" CONDUIT.
- NOT USED.
- PROVIDE 1" C FOR NEW GENERATOR START CIRCUIT. USE (2) #12, #12 EG WITH TWO STRANDED TWISTED PAIRS FOR GENERATOR ANNUNCIATION AND GENERATOR EPO. SIZE AS REQUIRED PER MANUFACTURER. ANNUNCIATOR AND EPO SHALL BE LOCATED BY OWNER IN A LOCATION EASILY MONITORED. VERIFY EXACT LOCATIONS WITH TENANT.
- PROVIDE A 120V, 20A/1P CIRCUIT FOR BATTERY CHARGER. PROVIDE A 208V, 20A/2P CIRCUIT FOR BLOCK HEATER. WIRE EACH WITH (2) #12, #12 EG IN 3/4".
- (2) 5/8" X 10" COPPER CLAD GROUND RODS. BOND GENERATOR ENCLOSURE TO GROUND RODS. GENERATOR IS NOT A SEPARATELY DERIVED SOURCE.
- (2) 3/4" X 10" CONDUIT FOR GENERATOR EPO BUTTON. SIZE PER MANUFACTURER REQUIREMENTS. EPO BUTTON SHALL BE LOCATED WITHIN GENERATOR REACH. VERIFY LOCATION WITH OWNER PRIOR TO INSTALLATION.

| MECHANICAL EQUIPMENT SCHEDULE |                            |       |     |    |                     |                      |         |               |         |                   |                    |     |
|-------------------------------|----------------------------|-------|-----|----|---------------------|----------------------|---------|---------------|---------|-------------------|--------------------|-----|
| DESCRIPTION                   | ELECTRICAL CHARACTERISTICS |       |     |    | CIRCUIT DESIGNATION | BREAKER AMPS / POLES | FEEDER  | EQUIP. GROUND | CONDUIT | DISCONNECT SWITCH | REMARKS            |     |
|                               | VOLTS                      | PHASE | KW  | HP |                     |                      |         |               |         |                   |                    | MCA |
| AHU-1                         | 480                        | 3     | 10  |    | 19.3 HV-25,27,29    | 20 3                 | (3) #12 | #12           | 1/2"    | 30A/3P/NF/NEMA-1  | SEE NOTE 1         |     |
| CU-1                          | 480                        | 3     |     |    | 21.5 HV-13,15,17    | 30 3                 | (3) #10 | #12           | 1/2"    | 30A/3P/NF/NEMA-3R | SEE NOTE 1,3       |     |
| EF-3, EF-4, EF-12, EF-13      | 480                        | 3     |     |    | 4.0 HV-19,21,23     | 15 3                 | (3) #12 | #12           | 1/2"    | PROVIDED BY MECH  | SEE NOTE 1,2,3,5,6 |     |
| EF-6 & EF-7 & EF-8            | 480                        | 3     |     | 1  | 2.6 HV-37,39,41     | 15 3                 | (3) #12 | #12           | 1/2"    | 30A/3P/NF/NEMA-3R | SEE NOTE 1,4       |     |
| EF-9 & EF-10 & EF-11          | 480                        | 3     |     | 1  | 2.6 HV-32,34,36     | 15 3                 | (3) #12 | #12           | 1/2"    | 30A/3P/NF/NEMA-3R | SEE NOTE 1,4       |     |
| PUMP 1-1                      | 208                        | 1     |     | 1  | 8.0 LV-29,31        | 20 2                 | (2) #12 | #12           | 1/2"    | 30A/2P/NF/NEMA-3R |                    |     |
| EW1 1-1                       | 208                        | 1     | 3.6 |    | 17.3 LV-25,27       | 20 2                 | (2) #12 | #12           | 1/2"    | 30A/2P/NF/NEMA-1  |                    |     |
| EW1 1-2                       | 277                        | 1     | 8   |    | 28.8 HV-12          | 30 1                 | (2) #10 | #10           | 3/4"    | 30A/2P/NF/NEMA-1  |                    |     |
| AC-2                          | 208                        | 1     |     |    | 18.0 LV-15,17       | 30 2                 | (2) #10 | #10           | 3/4"    | 30A/2P/NF/NEMA-3R |                    |     |
| EF-5                          | 480                        | 3     |     |    | 0.5 HV-38,40,42     | 15 3                 | (3) #12 | #12           | 1/2"    | 30A/3P/NF/NEMA-3R | SEE NOTE 1,5       |     |

**NOTES:**

- SEE MECHANICAL PLANS FOR CONTROL INFORMATION.
- MECHANICAL CONTRACTOR TO FURNISH EXPLOSION PROOF DISCONNECTS FOR EF-3, EF-4, EF-12, EF-13. INSTALLED BY ELECTRICAL CONTRACTOR.
- PROVIDE WPI/GFI 120V, 20A GENERAL MAINTENANCE RECEPTACLE WITH IN 25' OF UNIT AS REQUIRED. PROVIDE POWER FROM NEAREST GENERAL RECEPTACLE CIRCUIT.
- CONTRACTOR TO VERIFY BRANCH CIRCUIT CONTAINS NO MORE THAN (6) RECEPTACLES.
- CONTRACTOR TO FURNISH AND INSTALL A SIZE "0" STARTER WITH OVERLOADS, 120V COIL, HOA SWITCH IN COVER, IN A NEMA 1 ENCLOSURE. CONTRACTOR TO FURNISH AND INSTALL A 24 HOUR TIME CLOCK TO CONTROL ALL FANS. TIME CLOCK TO CONTROL ALL FOUR FANS TOGETHER.
- FOR EF-3 & EF-4 CONTRACTOR TO FURNISH AND INSTALL A SIZE "0" COMBINATION NON FUSED STARTER WITH OVERLOADS, 480V COIL, IN A NEMA 1 ENCLOSURE. STARTER TO BE IN ON AT ALL TIMES.
- FOR EF-12 & EF-13. CONTRACTOR TO FURNISH AND INSTALL A SIZE "0" COMBINATION NON FUSED STARTER WITH OVERLOADS, 120V COIL, IN A NEMA-1 ENCLOSURE. SEE NOTE/ ON PLANS FOR CONTROLS.



| NEW PANEL LV VOLTAGE 120 / 208 V SIZE 225A MCB CABINET SURFACE NEMA-1 SQR OR EQUAL PHASE 3 PH 225A BUS RATING 10,000 AIC RATED |                   |      |   |               |       |       |     |   |    |               |   |      |      |      |                 |       |
|--|-------------------|------|---|---------------|-------|-------|-----|---|----|---------------|---|------|------|------|-----------------|-------|
| NOTES  | REMARKS           | AMPS | P | VA PHASE LOAD |       |       | BUS |   |    | VA PHASE LOAD |   |      | AMPS | P    | REMARKS         | NOTES |
|  |                   |      |   | A             | B     | C     | A   | B | C  | A             | B | C    |      |      |                 |       |
|  | STYROFOAM MACHINE | 50   | 3 | 4621          |       |       | 1   | X | 2  |               |   | 360  | 20   | 1    | GENERAL REC     |       |
|  |                   |      |   |               | 4621  |       |     | 3 | X  | 4             |   | 1080 | 20   | 1    | GENERAL REC     |       |
|  | PALLETIZER        | 20   | 1 | 1800          |       |       | 7   | X | 8  |               |   | 360  | 20   | 1    | DRINKING FTN    |       |
|  | DOCK LEVELER #1   | 20   | 1 |               | 1800  |       | 9   | X | 10 |               |   | 1080 | 20   | 1    | GENERAL REC     |       |
|  | DOCK LEVELER #2   | 20   | 1 |               |       | 1800  | 11  | X | 12 |               |   | 1080 | 20   | 1    | GENERAL REC     |       |
|  | STRETCH WRAP      | 20   | 1 | 1800          |       |       | 13  | X | 14 |               |   | 1080 | 20   | 1    | GENERAL REC     |       |
|  | AC-1              | 30   | 2 |               | 1500  |       | 15  | X | 16 |               |   | 1080 | 20   | 1    | GENERAL REC     |       |
|  | SPARE             | 20   | 1 |               |       | 1500  | 17  | X | 18 |               |   | 1080 | 20   | 1    | CONF RM REC     |       |
|  | SPARE             | 20   | 1 |               |       |       | 19  | X | 20 |               |   | 1080 | 20   | 1    | OFFICE RM REC   |       |
|  | SPARE             | 20   | 1 |               |       |       | 21  | X | 22 |               |   | 360  | 20   | 1    | H-2 STORAGE REC |       |
|  | SPARE             | 20   | 1 |               |       |       | 23  | X | 24 |               |   | 1080 | 20   | 1    | STORAGE REC     |       |
|  | EW1 1-1           | 20   | 2 | 1800          |       |       | 25  | X | 26 |               |   | 360  | 20   | 1    | RESTROOM REC    |       |
|  |                   |      |   | 1800          |       |       | 27  | X | 28 |               |   | 1080 | 20   | 1    | RESTROOM REC    |       |
|  | PUMP 1-1          | 20   | 2 |               | 832   |       | 29  | X | 30 |               |   | 1080 | 20   | 1    | FACT STARTERS   |       |
|  |                   |      |   | 832           |       |       | 31  | X | 32 |               |   | 1200 | 20   | 1    | SUMP PUMP       |       |
|  | BIG ASS FANS      | 20   | 1 |               | 1500  |       | 33  | X | 34 |               |   |      | 20   | 1    | SPARE           |       |
|  | BIG ASS FANS      | 20   | 1 |               |       | 1500  | 35  | X | 36 |               |   |      | 20   | 1    | SPARE           |       |
|  | BIG ASS FANS      | 20   | 1 | 1500          |       |       | 37  | X | 38 |               |   |      | 20   | 1    | SPARE           |       |
|  | BIG ASS FANS      | 20   | 1 |               | 750   |       | 39  | X | 40 |               |   |      | 20   | 1    | SPARE           |       |
|  | SPARE             | 20   | 1 |               |       |       | 41  | X | 42 |               |   |      | 20   | 1    | SPARE           |       |
|  | TOTAL             |      |   | 12353         | 11971 | 10253 |     |   |    |               |   | 4440 | 4680 | 5400 | TOTAL           |       |

NOTE: CONTRACTOR IS RESPONSIBLE FOR UPDATING ALL PANEL SCHEDULES WITH CURRENT DESCRIPTIONS OF ALL BRANCH CIRCUIT DESIGNATIONS.

| TABULATION        | TOTAL LOAD | DEMAND FACTOR | DEMAND LOAD |
|-------------------|------------|---------------|-------------|
| MEASURED LIGHTING |            |               |             |
| COOLING           |            |               |             |
| HEATING           |            |               |             |
| RECEPTACLE        | 13320      | 0.88          | 11660       |
| MISCELLANEOUS     | 35776      | 1.00          | 35776       |
| KITCHEN EQUIP     |            |               |             |
| LARGEST MOTOR     |            |               |             |
| TOTAL DEMAND LOAD |            |               | 47436 VA    |
| TOTAL DEMAND AMPS |            |               | 131.7 A     |

**GENERATOR FUEL TANK CALCULATION:**

GENERATOR SIZE: 250kW/313kVA  
 FUEL CONSUMPTION AT 100% LOAD: 18.5 GAL/HR  
 18.5 GAL/HR X 8HR = 148 GAL.  
 TANK SIZE = 372 GAL.

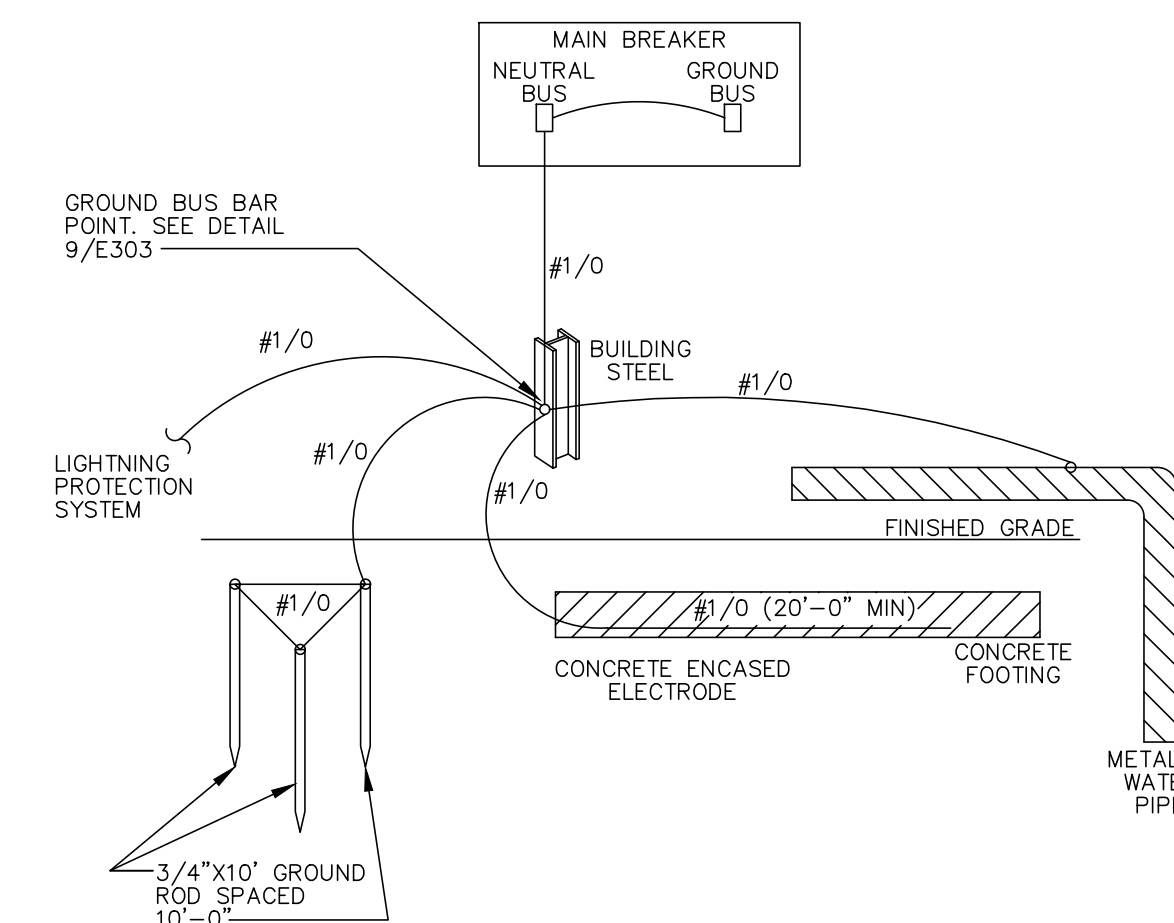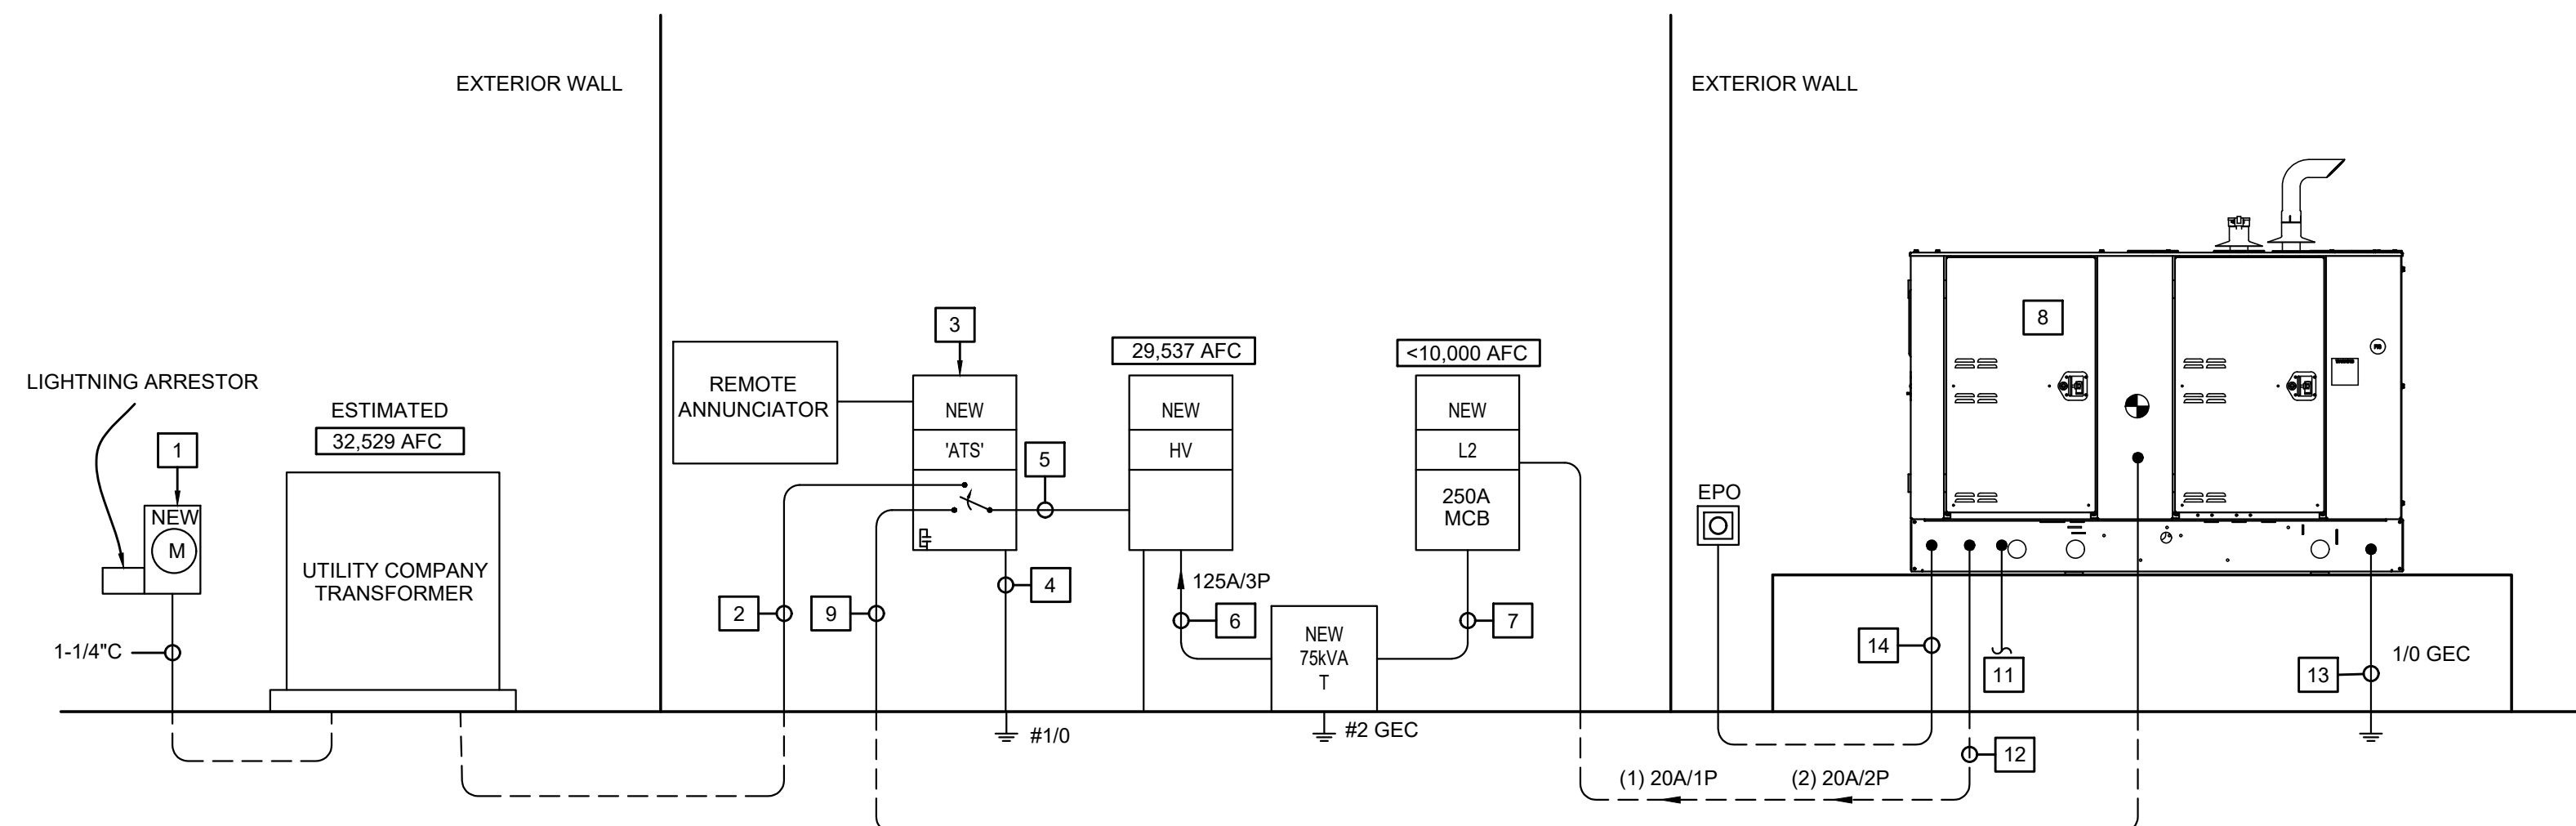

**SERVICE GROUNDING DIAGRAM**  
 SCALE: NONE

REFER TO SPECIFICATIONS FOR ADDITIONAL REQUIREMENTS

C.O.A. #28759  
**GILSON IERGENTI**  
 ENGINEERING  
 1408 N WESTSHORE BLVD,  
 STE. 506 TAMPA, FL 33607  
 WORKWITHWG.COM  
 813.855.3330



CMK Design Studio, Inc.  
 Planning & Design of the Built Environment

6822 22nd Ave. N. #148  
 St. Petersburg, Florida 33710  
 Ph: 813.362.6381

FL LIC. NO.: AA26002603  
 marcos@cmkdesignstudio.com

NICHOLAS C. LEIO, No. 29245

Drawing Not Valid Unless Signed,  
 Sealed & Dated by Registered Professional

INDIAN RIVER COUNTY LANDFILL  
 HOUSEHOLD HAZARDOUS WASTE  
 AND RECYCLING FACILITY  
 Indian River County, Florida

| NO. | REVISIONS          | DATE       |
|-----|--------------------|------------|
| 1   | FIELD COORDINATION | 05/15/2021 |
| 2   | FIELD COORDINATION | 11/05/2021 |

JOB NO.  
**2016**

ISSUE DATE:  
 07/07/2021

DRAWN BY:  
 WG

SHEET TITLE  
 RISER DIAGRAM &  
 PANEL SCHEDULES  
 SHEET NO.  
**E300**

PERMIT SET



**FIRE PROTECTION GENERAL NOTES**

- THESE FIRE PROTECTION SYSTEM ENGINEERING DOCUMENTS PROVIDE THE ENGINEERING REQUIREMENTS TO BE USED IN THE PREPARATION OF THE FIRE PROTECTION SYSTEM LAYOUT DOCUMENTS AND INDICATE THE OVER ALL NATURE OF THE PROJECT SCOPE OF WORK.
- THE PROPOSED TYPE II 33,487 SQUARE FEET BUILDING SHALL BE PROTECTED BY AN WET AUTOMATIC SPRINKLER SYSTEM THROUGHOUT. THE PROPOSED CONSTRUCTION AREAS SHALL BE INSTALLED IN ACCORDANCE WITH THE 2016 EDITION OF NFPA 13, 2020 SEVENTH EDITION OF THE FLORIDA FIRE PREVENTION CODE, 2020 FLORIDA BUILDING CODE, CHAPTER 9 AND APPLICABLE LOCAL AND STATE REQUIREMENTS ADOPTED AT TIME OF PERMITTING.
- THE OCCUPANCY CLASSIFICATION OF THIS FACILITY PER NFPA 13, 2016 EDITION SHALL BE:
 

OFFICES, RESTROOMS AND LIKE AREAS SHALL BE DESIGNED PER LIGHT HAZARD OCCUPANCY, WITH A MINIMUM DENSITY OF 0.10 GPM OVER THE HYDRAULICALLY MOST DEMANDING OPERATING AREA PER NFPA 13 2016 11.2.3. TEMPERATURE RATING OF THE SPRINKLERS SHALL BE 155° OR AS INDICATED ON DRAWINGS. SPACING BETWEEN SPRINKLERS SHALL BE A MINIMUM OF 6' AND A MAXIMUM OF 15'. AREA OF COVERAGE PER SPRINKLER SHALL BE 225 SQUARE FEET MAXIMUM FOR STANDARD SPACING AND MANUFACTURERS LISTING REQUIREMENTS FOR EXTENDED COVERAGE SPACING.

ELECTRICAL/MECHANICAL EQUIPMENT ROOMS AND LIKE AREAS SHALL BE DESIGNED PER ORDINARY HAZARD GROUP I OCCUPANCY, WITH A MINIMUM DENSITY OF 0.15 GPM OVER THE HYDRAULICALLY MOST DEMANDING OPERATING AREA PER NFPA 13 2016 11.2.3. TEMPERATURE RATING OF THE SPRINKLERS SHALL BE 155° OR AS INDICATED ON DRAWINGS. SPACING BETWEEN SPRINKLERS SHALL BE A MINIMUM OF 6' AND A MAXIMUM OF 15'. AREA OF COVERAGE PER SPRINKLER SHALL BE 130 SQUARE FEET MAXIMUM FOR STANDARD SPACING AND MANUFACTURERS LISTING REQUIREMENTS FOR EXTENDED COVERAGE SPACING.

TIPPING, DROP OFF, STORAGE AND LIKE AREAS SHALL BE DESIGNED PER ORDINARY HAZARD GROUP II OCCUPANCY, WITH A MINIMUM DENSITY OF 0.20 GPM OVER THE HYDRAULICALLY MOST DEMANDING OPERATING AREA PER NFPA 13 2016 11.2.3. TEMPERATURE RATING OF THE SPRINKLERS SHALL BE 155° OR AS INDICATED ON DRAWINGS. SPACING BETWEEN SPRINKLERS SHALL BE A MINIMUM OF 6' AND A MAXIMUM OF 15'. AREA OF COVERAGE PER SPRINKLER SHALL BE 130 SQUARE FEET MAXIMUM FOR STANDARD SPACING AND MANUFACTURERS LISTING REQUIREMENTS FOR EXTENDED COVERAGE SPACING. THESE AREAS SHALL NOT EXCEED 12 FEET HEIGHT OF MODERATE COMBUSTIBILITY CONTENTS PER NFPA 13 2016 5.3.2.1.

H-2 STORAGE SHALL BE DESIGNED PER EXTRA HAZARD GROUP II OCCUPANCY, WITH A MINIMUM DENSITY OF 0.40 GPM OVER THE ENTIRE AREA AS THE OPERATING AREA PER NFPA 13 2016 11.2.3. TEMPERATURE RATING OF THE SPRINKLERS SHALL BE 175° STANDARD RESPONSE TYPE AS INDICATED ON DRAWINGS. SPACING BETWEEN SPRINKLERS SHALL BE A MINIMUM OF 6' AND A MAXIMUM OF 12'. AREA OF COVERAGE PER SPRINKLER SHALL BE 120 SQUARE FEET MAXIMUM FOR STANDARD SPACING AND MANUFACTURERS LISTING REQUIREMENTS FOR EXTENDED COVERAGE SPACING. WALLS SURROUNDING H-2 STORAGE AREA SHALL EXTEND TO THE DECK.
- THE SUPPORT SYSTEMS OF THE BUILDING HAVE ADEQUATE LOAD CARRYING CAPACITY FOR A 5 PSF DEAD LOAD WHICH WILL BE CONTRIBUTED BY THE FIRE SPRINKLER, MECHANICAL & ELECTRICAL SYSTEMS. THERE ARE NO SIGNIFICANT STRUCTURAL OPENINGS THAT WILL BE REQUIRED BY THE FIRE SPRINKLER SYSTEM. REFER TO STRUCTURAL DRAWINGS.
- THE NEW FLOW SWITCH, LOCATED ON THE RISER CONTROL VALVE ASSEMBLY, SHALL BE CONNECTED TO THE EXTERIOR ELECTRIC BELL AND TO THE BUILDING FIRE ALARM SYSTEM. THE NEW TAMPER SWITCH, LOCATED ON THE RISER CONTROL VALVE ASSEMBLY, SHALL BE CONNECTED TO THE BUILDING FIRE ALARM SYSTEM.
- THIS PROPOSED BUILDING IS TO BE PROTECTED BY A WET PIPE AUTOMATIC SPRINKLER SYSTEM. THE FIRE PROTECTION CONTRACTOR'S SCOPE OF WORK SHALL INCLUDE THE PREPARATION OF THE FIRE PROTECTION SYSTEM LAYOUT DOCUMENTS, AND THE INSTALLATION OF ALL NECESSARY COMPONENTS, SYSTEMS, MATERIALS, ASSEMBLIES, EQUIPMENT AND SUPPORT SYSTEMS REQUIRED FOR A COMPLETE AND FUNCTIONAL SYSTEM.
- THE ACCEPTANCE TESTING OF ALL FIRE PROTECTION SYSTEMS AND COMPONENTS SHALL BE IN ACCORDANCE WITH NFPA 13, 2016 EDITION FOR THE INSIDE (ABOVE GROUND) FIRE SPRINKLER SYSTEM AND NFPA 24, 2016 EDITION FOR THE OUTSIDE (UNDERGROUND) FIRE SPRINKLER SYSTEM.
- THE FIRE SPRINKLER POINT OF SERVICE FOR THIS NEW PROJECT SHALL BE PER F.S. 633.021(18) AT THE DISCHARGE SIDE OF THE PROPOSED BACKFLOW PREVENTOR.
- FIRE FLOW TEST:
 

PROVIDED BY: INDIAN RIVER COUNTY DEPARTMENT OF UTILITIES  
 DATE: 04/29/21  
 STATIC: 55 PSI  
 RESIDUAL: 42 PSI  
 FLOWING: 993 GPM

THE AWARDED CONTRACTOR SHALL OBTAIN AN AHJ PURVEYOR APPROVED HYDRANT FLOW TEST PER NFPA 13 2016 23.2.1.1. HYDRAULIC CALCULATIONS, LAYOUT DRAWINGS AND MATERIAL SUBMITTALS SHALL BE SUBMITTED TO THE ARCHITECT/ENGINEER AND FIRE MARSHAL AND SHALL BE APPROVED PRIOR TO ANY FABRICATION OR INSTALLATION INVOLVED WITH THIS PROJECT
- THERE ARE NO KNOWN CONDITIONS THAT WOULD INDICATE MICROBIAL INDUCED CORROSION IS PRESENT IN THE WATER SYSTEMS OF THIS JURISDICTION AS UNUSUAL PIPE FAILURES HAVE NOT BEEN KNOWN TO OCCUR.
- THE QUALITY AND PERFORMANCE SPECIFICATIONS OF THE INTERIOR FIRE PROTECTION COMPONENTS SHALL BE GROOVED SCHEDULE 10 PIPE WITH GROOVED FITTINGS. AND OR SCHEDULE 40 WITH THREADED CAST IRON FITTINGS OR GROOVED SCHEDULE 10 PIPE WITH GROOVED FITTINGS.
- ALL FIRE PROTECTION SYSTEM COMPONENTS SHALL BE UL LISTED FOR INTENDED USE.
- TO THE BEST OF THE ENGINEER'S KNOWLEDGE, THE PLANS AND SPECIFICATIONS COMPLY WITH THE APPLICABLE MINIMUM BUILDING CODES AND THE APPLICABLE FIRE SAFETY STANDARDS AS DETERMINED BY THE LOCAL AUTHORITY IN ACCORDANCE WITH CHAPTER 61G15-32 OF THE FLORIDA ADMINISTRATIVE CODE.
- ALL FIRE PROTECTION WORK SHALL BE IN STRICT ACCORDANCE WITH ALL RELATED NFPA STANDARDS, THE OWNER'S INSURANCE UNDERWRITER, UNDERWRITERS LABORATORY, THE FLORIDA STATE FIRE PREVENTION CODE 2020 AND ALL LOCAL CODES AND AMENDMENTS.
- FINAL INSPECTION AND APPROVAL OF AUTOMATIC SPRINKLER SYSTEM SHALL BE BY THE LOCAL FIRE MARSHAL (AHJ) AND ARCHITECT/ENGINEER
- THE CONTRACTOR SHALL FOLLOW THE DRAWINGS, NOTES AND SPECIFICATIONS AS CLOSE AS POSSIBLE. HOWEVER, THE ARCHITECT/ENGINEER RESERVES THE RIGHT TO CHANGE THE LOCATION(S) OF SPRINKLERS, PIPING, VALVES, ETC. TO ACCOMMODATE EXISTING CONDITIONS WHICH MAY ARISE DURING THE SYSTEM INSTALLATION WITHOUT ADDITIONAL COMPENSATION TO THE CONTRACTOR FOR SUCH CHANGES, PROVIDED SUCH CHANGES ARE REQUESTED PRIOR TO THE INSTALLATION OF THE CONTRACTOR'S WORK. COORDINATE WITH ALL OTHER TRADES.
- THE BIDDER IS REQUIRED, BEFORE SUBMITTING HIS PROPOSAL, TO VISIT THE SITE OF THE PROPOSED WORK AND FAMILIARIZE HIMSELF WITH THE NATURE AND EXTENT OF THE WORK AND ANY EXISTING CONDITIONS THAT MAY IN ANY MANNER AFFECT THE WORK TO BE DONE AND THE EQUIPMENT, MATERIALS AND LABOR REQUIRED. THE BIDDER IS ALSO REQUIRED TO EXAMINE CAREFULLY THE PLANS AND SPECIFICATIONS AND TO INFORM HIMSELF THOROUGHLY REGARDING ANY AND ALL CONDITIONS AND REQUIREMENTS THAT MAY IN ANY MANNER AFFECT THE WORK TO BE PERFORMED UNDER THIS CONTRACT.
- REFER TO ARCHITECTURAL REFLECTED CEILING PLANS FOR CEILING DESCRIPTIONS AND HEIGHTS.
- SPRINKLERS SHALL BE COORDINATED WITH ALL DIFFUSERS, SPEAKERS, LIGHTING FIXTURES, FIRE ALARM DEVICES, AND CEILING SYSTEMS. SPACING OF SPRINKLERS SHALL BE IN ACCORDANCE WITH NFPA 13 AND THE LISTING OF THE SPRINKLER.
- SPRINKLERS SHALL BE CENTERED IN THE CEILING TILE AS INDICATED ON THE DRAWINGS. PROVIDE RETURN BENDS OR SWING JOINTS AS REQUIRED.
- SLEEVE AND/OR FIRESTOP ALL PENETRATIONS THROUGH RATED WALLS, CEILINGS, AND FLOORS WITH UL LISTED ASSEMBLIES. FIRESTOP ASSEMBLIES SHALL BE EQUAL TO OR EXCEED THE RATING OF THE WALL, CEILING OR FLOOR. SEE ARCHITECTURAL DRAWINGS FOR FINAL FINISHES.
- PROVIDE A PERMANENTLY ATTACHED NAME TAG ATTACHED TO THE RISER STATING THE REQUIRED OR MODIFIED DESIGN CRITERIA FOR EACH HYDRAULICALLY DESIGNED SYSTEM.
- PROVIDE SPRINKLERS CAGES ON ALL SPRINKLERS IN ELECTRIC ROOMS, TELEPHONE ROOMS, MECHANICAL ROOMS, GYMNASIUMS, AND ON ANY SPRINKLER LESS THAN 7'-0" ABOVE FLOOR.
- COORDINATE SPRINKLER PIPING WITH ALL ELECTRICAL EQUIPMENT (PANELS, TRANSFORMERS, ETC.) PRIOR TO ANY INSTALLATION. DO NOT ROUTE ANY SPRINKLER PIPING OVER ANY ELECTRICAL PANELS UNDER ANY CIRCUMSTANCES. ANY SPRINKLER PIPING RUN OVER NEW PROPOSED ELECTRICAL PANELS/EQUIPMENT SHALL BE REROUTED AT ADDITIONAL COST AS APPROVED IN RFI PROCESS THROUGH GC TO ARCHITECT.
- THE CONTRACTOR SHALL INFORM THE OWNER (A MINIMUM OF ONE WEEK IN ADVANCE) OF ANY DISRUPTION OF SERVICES TO THE BUILDING AND SHALL NOT PROCEED TO WORK WITHOUT WRITTEN APPROVAL FROM THE OWNER. THE CONTRACTOR SHALL MAKE REPAIRS TO ANY SERVICES (ABOVE OR BELOW GROUND) DAMAGED BY WORK PERFORMED BY HIM. IF FOR ANY REASON OVERNIGHT SHUTDOWN IS REQUIRED, A "FIRE WATCH" CONDITION SHALL BE REQUEST AND APPROVED IN RFI PROCESS THROUGH GC TO ARCHITECT.


**FIRE PROTECTION CODE CRITERIA**

THE FOLLOWING IS A LIST OF ALL CODES AND STANDARDS ADOPTED DECEMBER 31, 2020 BY THE STATE FIRE MARSHAL'S RULE 69A3.012 F.A.C.:


FLORIDA BUILDING CODE, SEVENTH EDITION (2020) - ALL SECTIONS  
 FLORIDA FIRE PREVENTION CODE, SEVENTH EDITION (2020)  
 FLORIDA BUILDING CODE (FBC), SEVENTH EDITION (2020) ENERGY CONSERVATION SOFTWARE: ENERGY GAUGE SUMMIT VERSION 6.10  
 FLORIDA BUILDING CODE (FBC), SEVENTH EDITION (2020) ACCESSIBILITY - 2012 FLORIDA ACCESSIBILITY CODE FOR BUILDING CONSTRUCTION

(1) EXCEPT AS SPECIFICALLY MODIFIED BY STATUTE OR BY THE STATE FIRE MARSHAL'S RULES, THE "FLORIDA FIRE PREVENTION CODE, 7TH EDITION (2020)," WHICH IS COMPRISED OF THE FLORIDA SPECIFIC EDITION OF NFPA 101, THE LIFE SAFETY CODE (2018 EDITION) AND THE FLORIDA SPECIFIC EDITION OF NFPA 1, THE FIRE CODE (2018 EDITION), ARE HEREBY ADOPTED AND INCORPORATED BY REFERENCE AND ARE APPLICABLE TO THOSE BUILDINGS AND STRUCTURES SPECIFIED IN PARAGRAPHS (A) AND (B), OF SUBSECTION (1), OF SECTION 633.206, F.S. IN ADDITION, THE FOLLOWING STANDARDS, EXCEPT AS SPECIFICALLY MODIFIED IN THE RULE CHAPTERS IN RULE TITLE 69A, ARE HEREBY ADOPTED AND INCORPORATED BY REFERENCE AND SHALL TAKE EFFECT ON THE EFFECTIVE DATE OF THIS RULE, AS A PART OF THE UNIFORM FIRE SAFETY STANDARDS ADOPTED BY RULE BY THE STATE FIRE MARSHAL AND ARE APPLICABLE TO THOSE BUILDINGS AND STRUCTURES SPECIFIED IN SECTIONS 633.206(1)(A) AND (B), F.S.:


NFPA 13-2016 STANDARD FOR THE INSTALLATION OF SPRINKLER SYSTEMS  
 NFPA 24-2016 STANDARD FOR THE INSTALLATION OF PRIVATE FIRE SERVICE MAINS AND THEIR APPURTENANCES  
 NFPA 25-2017 STANDARD FOR THE INSPECTION, TESTING, AND MAINTENANCE OF WATER-BASED FIRE PROTECTION SYSTEMS, EXCEPT THAT QUARTERLY FLOW TESTS SHALL BE REQUIRED FOR THOSE SYSTEMS SUPPLIED BY A MUNICIPAL WATER SUPPLY.  
 NFPA 70-2017 NATIONAL ELECTRIC CODE  
 NFPA 72-2016 NATIONAL FIRE ALARM CODE  
 NFPA 241-2013 STANDARD FOR SAFEGUARDING CONSTRUCTION, ALTERATION AND DEMOLITION OPERATIONS

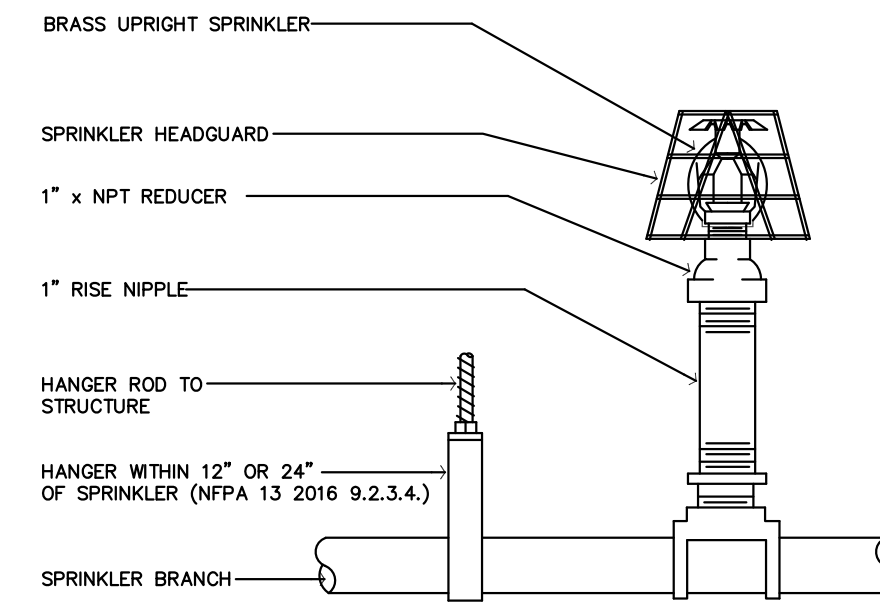

TYPICAL UPRIGHT SPRINKLER HEAD

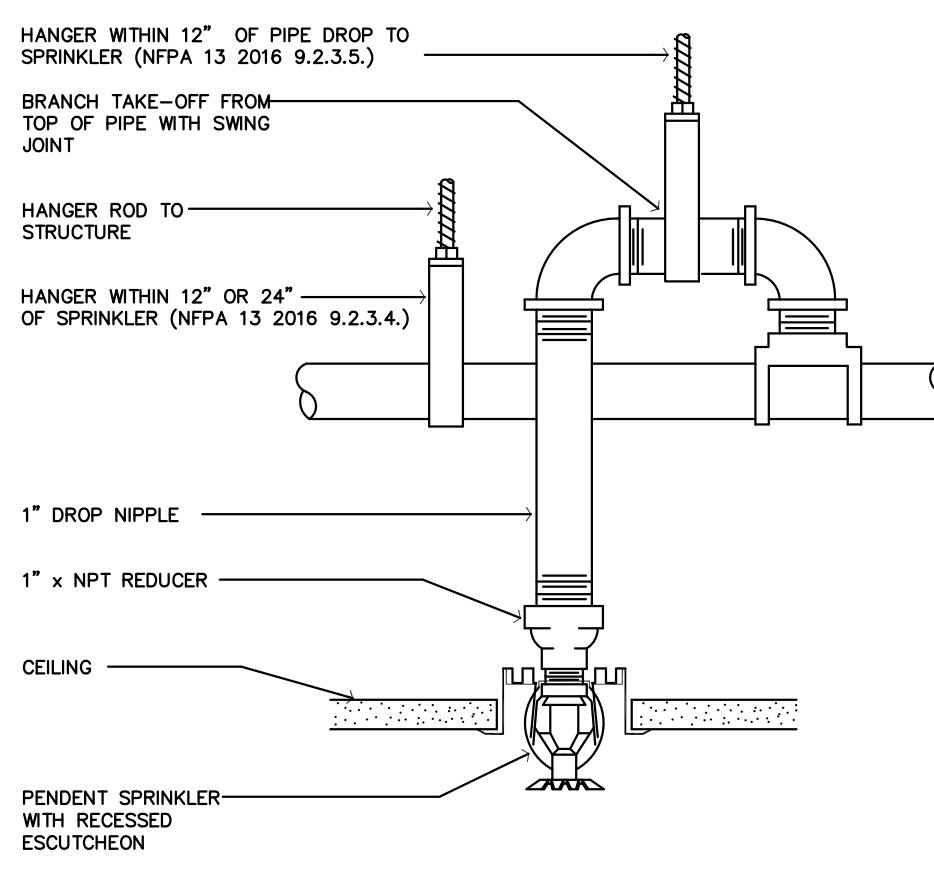


TYPICAL RECESSED PENDENT SPRINKLER HEAD

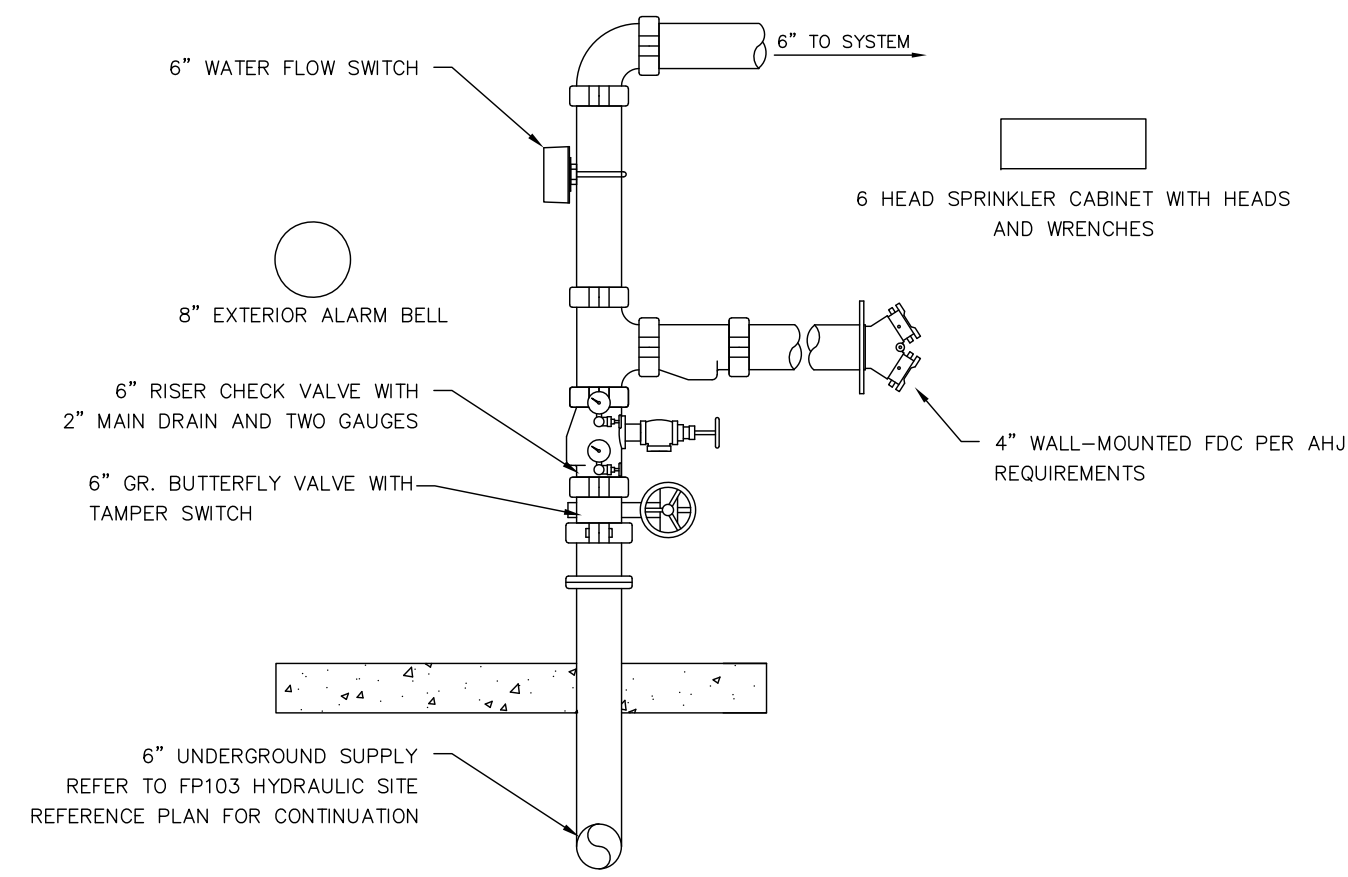

INTERIOR ISOLATION RISER ASSEMBLY

NO SCALE

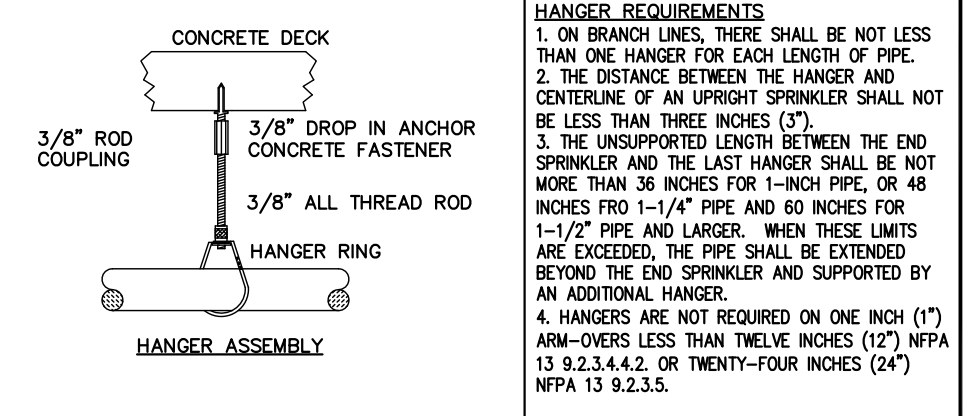

**HANGER REQUIREMENTS**

- ON BRANCH LINES, THERE SHALL BE NOT LESS THAN ONE HANGER FOR EACH LENGTH OF PIPE.
- THE DISTANCE BETWEEN THE HANGER AND CENTERLINE OF AN UPRIGHT SPRINKLER SHALL NOT BE LESS THAN THREE INCHES (3").
- THE UNSUPPORTED LENGTH BETWEEN THE END SPRINKLER AND THE LAST HANGER SHALL BE NOT MORE THAN 36 INCHES FOR 1-INCH PIPE, OR 48 INCHES FOR 1-1/4" PIPE AND 60 INCHES FOR 1-1/2" PIPE AND LARGER. WHEN THESE LIMITS ARE EXCEEDED, THE PIPE SHALL BE EXTENDED BEYOND THE END SPRINKLER AND SUPPORTED BY AN ADDITIONAL HANGER.
- HANGERS ARE NOT REQUIRED ON ONE INCH (1") DIA. OVERS LESS THAN TWELVE INCHES (12") NFPA 13 9.2.3.4.4.2, OR TWENTY-FOUR INCHES (24") NFPA 13 9.2.3.5.


**HANGER SPACING FOR STEEL FIRE SPRINKLER PIPING**

| PIPE SIZE | MAXIMUM SPACING |
|-----------|-----------------|
| 1" 40     | 12'-0"          |
| 1-1/4" 40 | 12'-0"          |
| 1-1/2" 40 | 15'-0"          |
| 2" 40     | 15'-0"          |
| 2-1/2" 10 | 15'-0"          |
| 3" 10     | 15'-0"          |
| 4" 10     | 15'-0"          |

**\* INFORMATION PER :**  
 NFPA 13 2016 - CHAPTER 9  
 PIPE HANGER EQUAL TO ANVIL MFG. NO. 69 TYPE SWIVEL LOOP RING


**\* CUMULATIVE HORIZONTAL LENGTH OF AN UNSUPPORTED ARMORER SHALL NOT EXCEED 24 INCHES FOR STEEL PIPE PER NFPA 13 9.2.3.5, 2016 EDITION**

TYPICAL NEW HANGER ASSEMBLY FOR SYSTEM

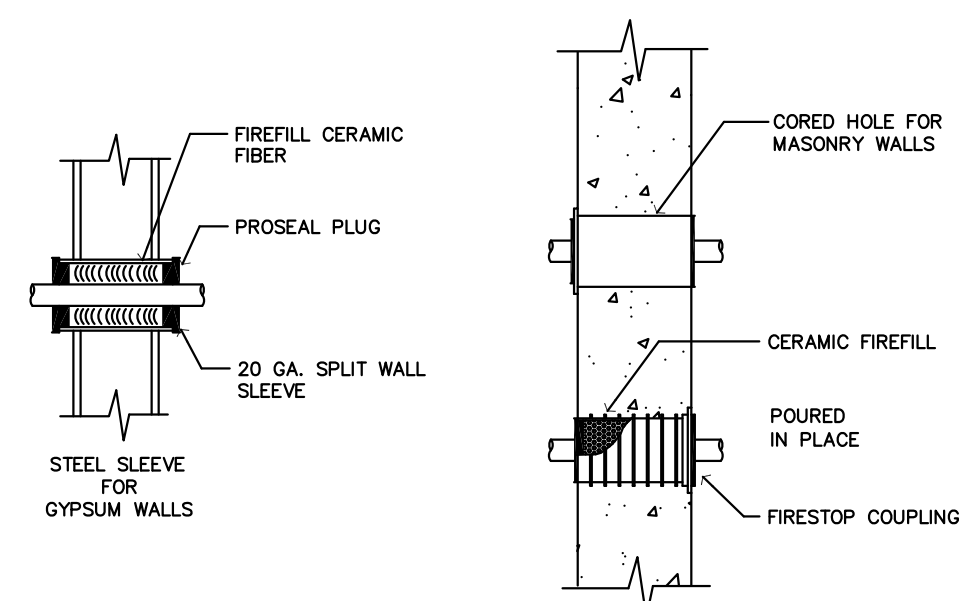

**SLEEVES & FIRESTOPPING**  
 USE PROSEAL "FIRESTOP PENETRATORS," U.L. CLASSIFIED IN THE BUILDING MATERIALS DIRECTORY, TESTED BY ASTM E814. USE ALL APPLICABLE PIPE PENETRATIONS THROUGH FIRE RATED WALLS OR FLOOR CEILING ASSEMBLIES IN ACCORDANCE WITH THE MANUFACTURERS INSTRUCTIONS.

FIRE RATED WALL SLEEVING SYSTEM

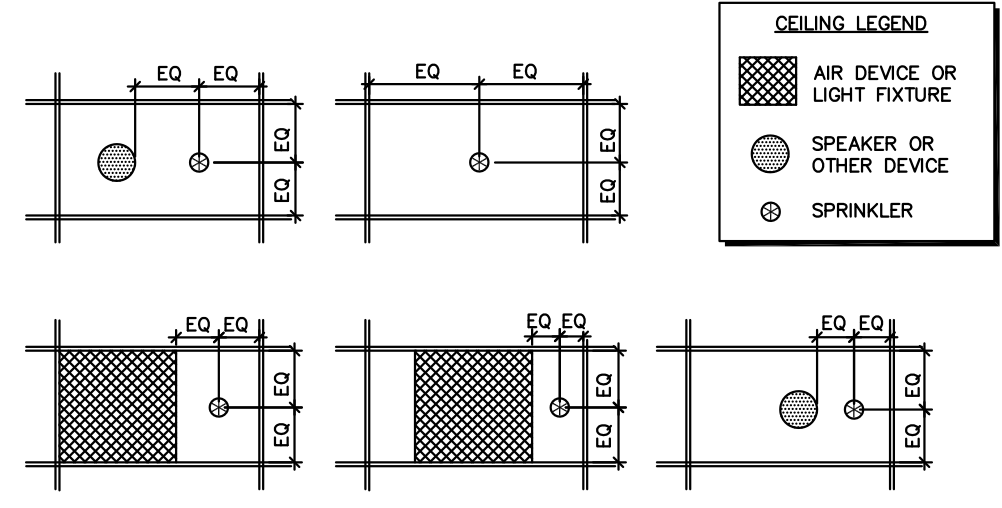

SPRINKLERS IN GRID CEILING SYSTEMS SHALL BE LOCATED AT THE MIDPOINT OR QUARTERPOINT OF THE FOUR FOOT (4') DIMENSION AND THE MIDPOINT OF THE TWO FOOT (2') DIMENSION, WHERE A CONFLICT OCCURS SYMMETRY ABOUT THE AXIS SHALL BE MAINTAINED.

TYPICAL SPRINKLER MOUNTING IN ACT

**DRAWING INDEX**

|       |  |
|-------|--|
| FP100 | OVERALL DETAILS & NOTES FIRE PROTECTION PLAN |
| FP101 | FIRE PROTECTION PLAN - SECTION A             |
| FP102 | FIRE PROTECTION PLAN - SECTION B             |
| FP103 | FIRE PROTECTION HYDRAULIC SITE PLAN          |

C.O.A. #28759

**WILSON ARGENTI**  
 ENGINEERING

1408 N WESTSHORE BLVD,  
 STE. 506 TAMPA, FL 33607

WORKWITHWG.COM  
 813.855.3330



**CMK Design Studio, Inc.**  
 Planning & Design of the Built Environment  
 6822 22nd Ave. N. #148  
 St. Petersburg, Florida 33710  
 Ph: 813.362.6381

FL LIC. NO.: AA2002803  
 marcos@cmkdesignstudio.com



Drawing Not Valid Unless Signed, Sealed & Dated by Registered Professional

INDIAN RIVER COUNTY LANDFILL  
 HOUSEHOLD HAZARDOUS WASTE  
 AND RECYCLING FACILITY  
 Indian River County, Florida

NO. REVISIONS DATE

|   |                    |            |
|---|--------------------|------------|
| 1 | FIELD COORDINATION | 05.15.2021 |
| 2 | FIELD COORDINATION | 11.05.2021 |

JOB NO.  
**2016**


ISSUE DATE:  
 07/07/2021

DRAWN BY:  
 WG

SHEET TITLE  
 DETAILS & NOTES

SHEET NO.  
**FP100**

PERMIT SET

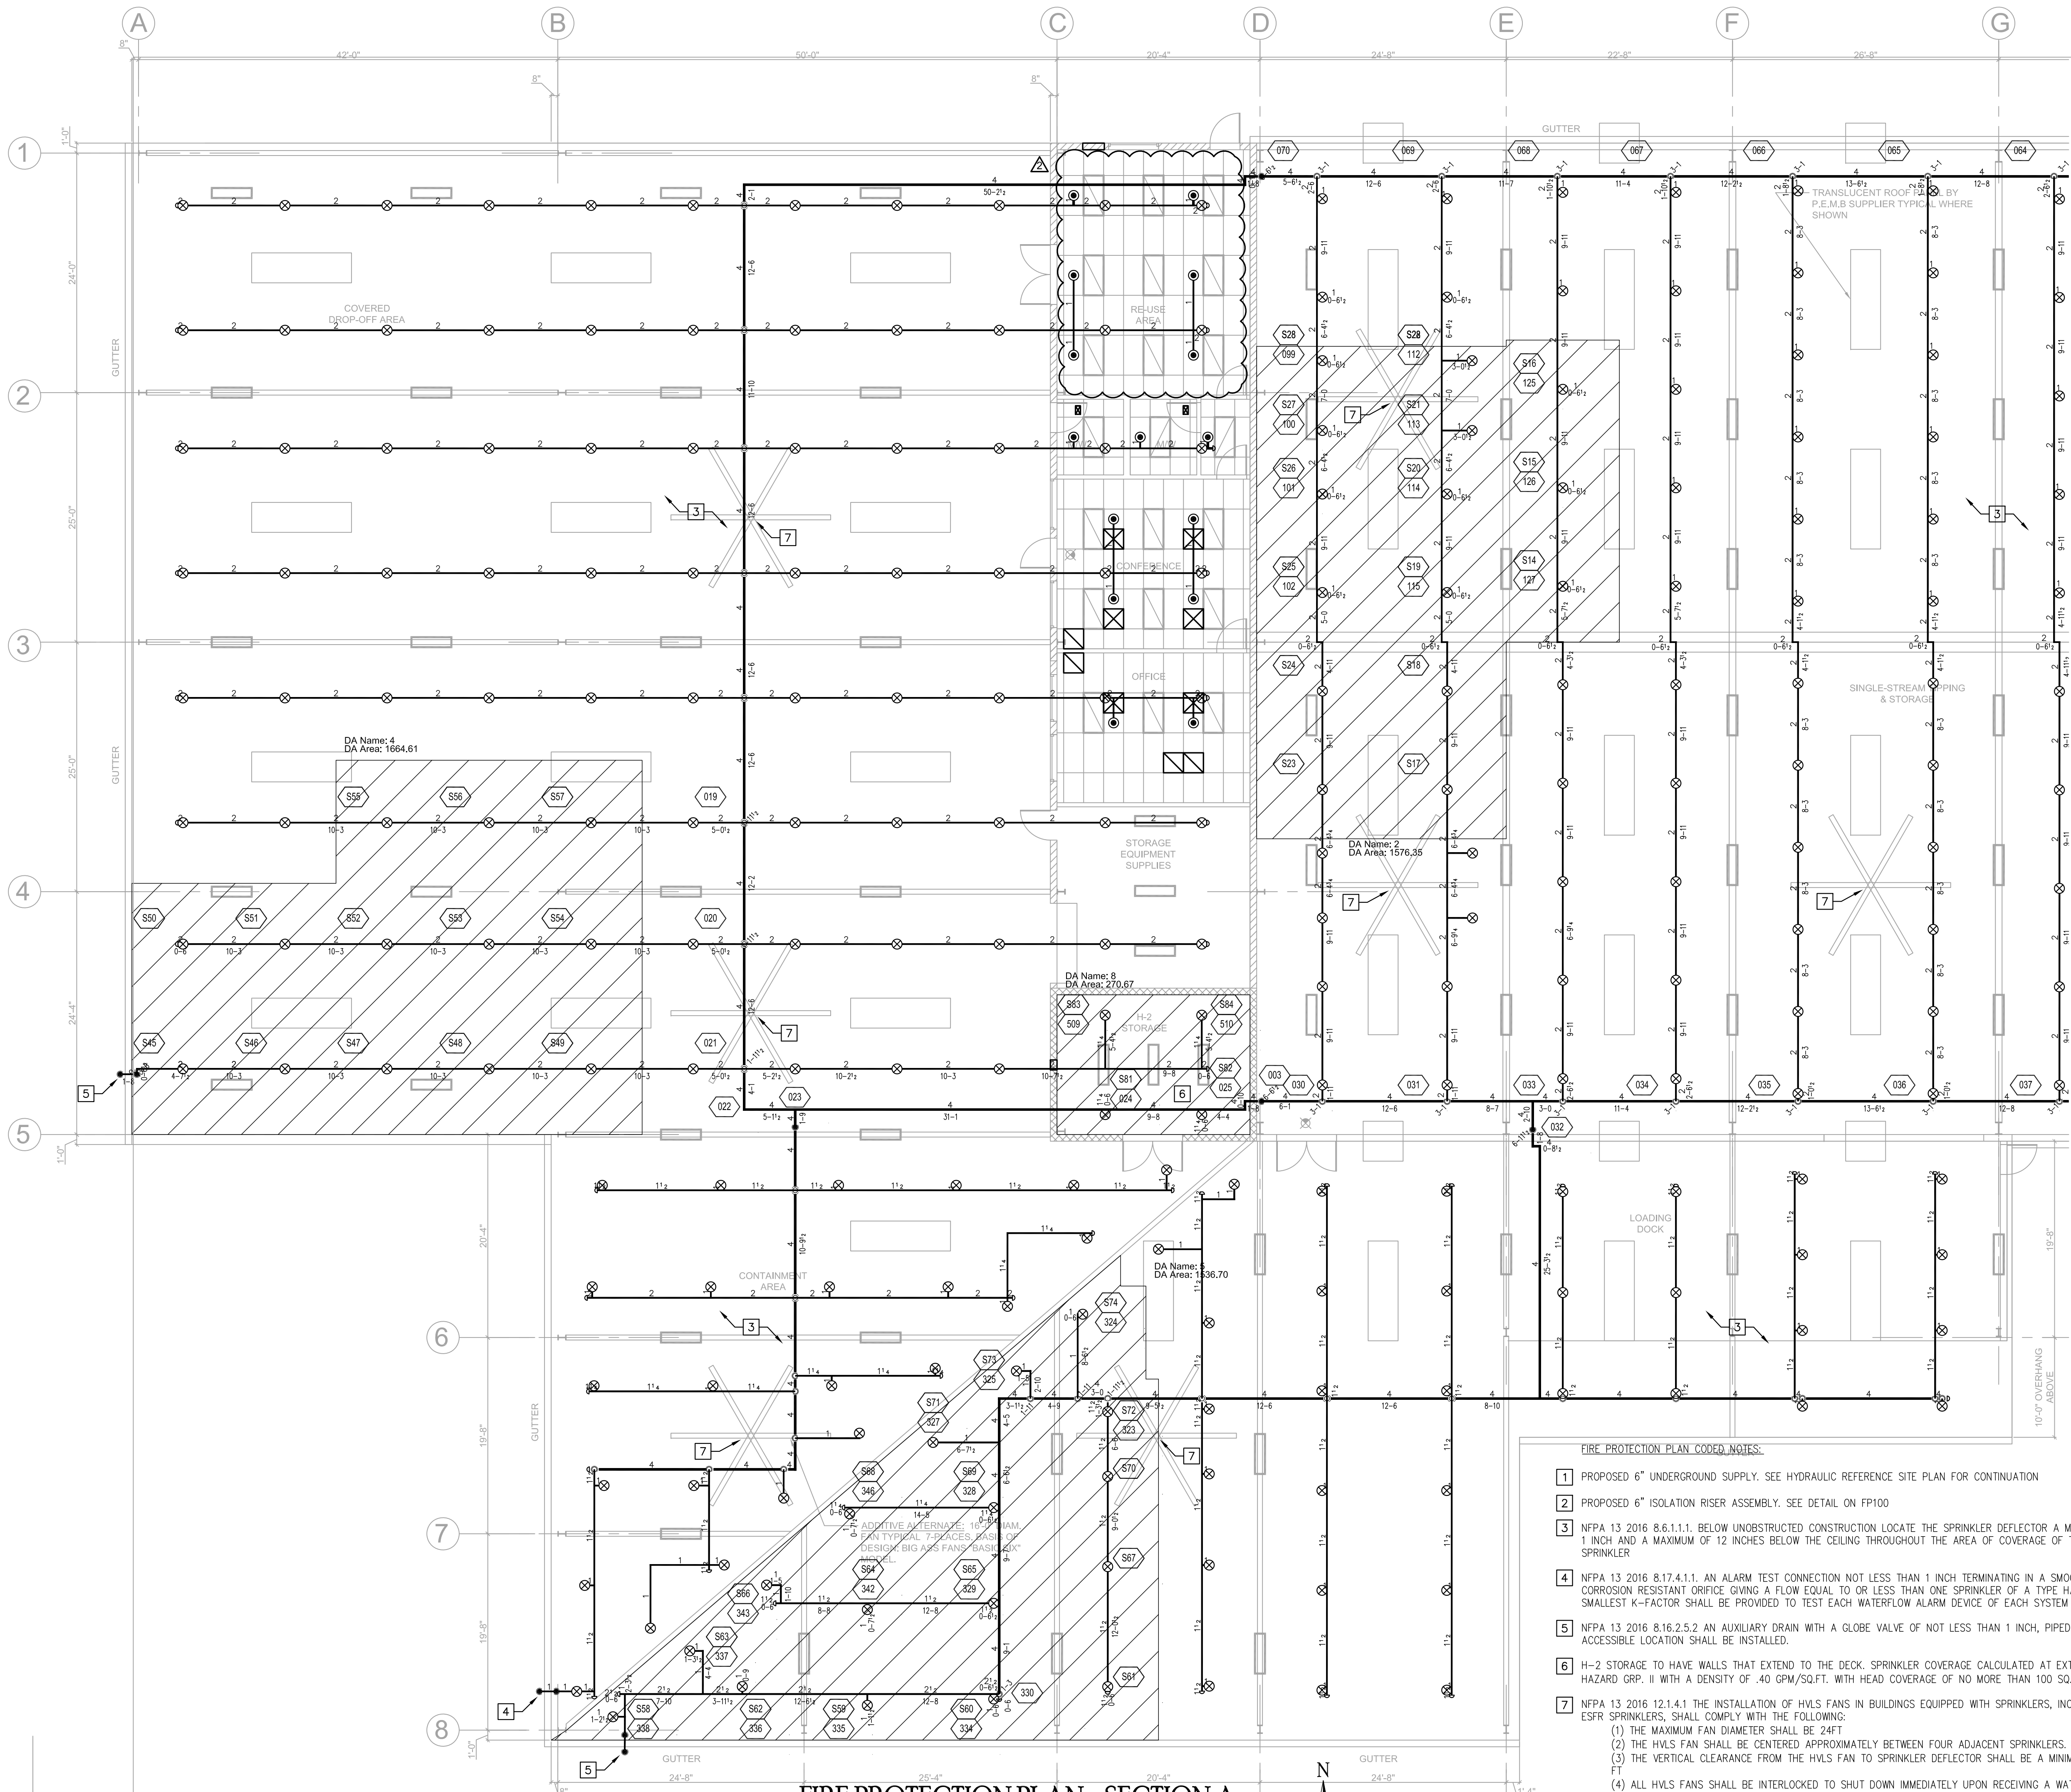

**BASE BUILDING CALCULATION - TIPPING STORAGE**

CALC AREA - RMA 2  
 OCCUPANCY CLASSIFICATION - OH-2  
 DENSITY - 0.20 GPM/SQ FT  
 AREA OF APPLICATION - 1576.35 SQ FT  
 CALCULATED SPRINKLER COVERAGE - 130 SQ FT  
 NFPA 13 2013 11.2.3.2.3. NO QR REDUCTION  
 20'0" MAXIMUM CEILING HEIGHT EXCEEDED  
 NUMBER OF SPRINKLERS CALCULATED - (13)  
 HOSE STREAM ALLOWANCE - 250  
 SYSTEM DEMAND @ SOURCE  
 659.1 GPM @ 36.0 PSI  
 SAFETY MARGIN 12.9 PSI OF SUPPLY

**BASE BUILDING CALCULATION - DROP OFF AREA**

CALC AREA - RMA 4  
 OCCUPANCY CLASSIFICATION - OH-2  
 DENSITY - 0.20 GPM/SQ FT  
 AREA OF APPLICATION - 1500.0 SQ FT  
 CALCULATED SPRINKLER COVERAGE - 130 SQ FT  
 NFPA 13 2013 11.2.3.2.3. NO QR REDUCTION  
 20'0" MAXIMUM CEILING HEIGHT EXCEEDED  
 NUMBER OF SPRINKLERS CALCULATED - (13)  
 HOSE STREAM ALLOWANCE - 250  
 SYSTEM DEMAND @ SOURCE  
 604.3 GPM @ 33.1 PSI  
 SAFETY MARGIN 16.8 PSI OF SUPPLY

**BASE BUILDING CALCULATION - CONTAINMENT AREA**

CALC AREA - RMA 5  
 OCCUPANCY CLASSIFICATION - OH-2  
 DENSITY - 0.20 GPM/SQ FT  
 AREA OF APPLICATION - 1536.7 SQ FT  
 CALCULATED SPRINKLER COVERAGE - 130 SQ FT  
 NFPA 13 2013 11.2.3.2.3. NO QR REDUCTION  
 20'0" MAXIMUM CEILING HEIGHT EXCEEDED  
 NUMBER OF SPRINKLERS CALCULATED - (16)  
 HOSE STREAM ALLOWANCE - 250  
 SYSTEM DEMAND @ SOURCE  
 715.0 GPM @ 43.1 PSI  
 SAFETY MARGIN 4.8 PSI OF SUPPLY



**BASE BUILDING CALCULATION - H-2 STORAGE**

CALC AREA - RMA 8  
 OCCUPANCY CLASSIFICATION - EH-2  
 DENSITY - 0.40 GPM/SQ FT  
 AREA OF APPLICATION - 400.0 SQ FT  
 CALCULATED SPRINKLER COVERAGE - 100 SQ FT  
 NFPA 13 2013 11.2.3.2.3. NO QR REDUCTION  
 20'0" MAXIMUM CEILING HEIGHT EXCEEDED  
 NUMBER OF SPRINKLERS CALCULATED - (4)  
 HOSE STREAM ALLOWANCE - 500  
 SYSTEM DEMAND @ SOURCE  
 667.50 GPM @ 44.4 PSI  
 SAFETY MARGIN 4.3 PSI OF SUPPLY

| SYM | POSITION | FINISH | TEMP | K    | NPT  | SIN    | IMG. | MODEL# |
|-----|----------|--------|------|------|------|--------|------|--------|
| ○   | PEND     | WHITE  | 155  | 5.60 | 1/2" | TY3231 | TYCO | TY-FRB |
| ⊗   | UPR      | BRASS  | 200  | 8.00 | 3/4" | TY4131 | TYCO | TY-FRB |


- FIRE PROTECTION PLAN CODED NOTES:**
- 1 PROPOSED 6" UNDERGROUND SUPPLY. SEE HYDRAULIC REFERENCE SITE PLAN FOR CONTINUATION
  - 2 PROPOSED 6" ISOLATION RISER ASSEMBLY. SEE DETAIL ON FP100
  - 3 NFPA 13 2016 8.6.1.1.1. BELOW UNOBSTRUCTED CONSTRUCTION LOCATE THE SPRINKLER DEFLECTOR A MINIMUM OF 1 INCH AND A MAXIMUM OF 12 INCHES BELOW THE CEILING THROUGHOUT THE AREA OF COVERAGE OF THE SPRINKLER
  - 4 NFPA 13 2016 8.17.4.1.1. AN ALARM TEST CONNECTION NOT LESS THAN 1 INCH TERMINATING IN A SMOOTH BORE CORROSION RESISTANT ORIFICE GIVING A FLOW EQUAL TO OR LESS THAN ONE SPRINKLER OF A TYPE HAVING THE SMALLEST K-FACTOR SHALL BE PROVIDED TO TEST EACH WATERFLOW ALARM DEVICE OF EACH SYSTEM
  - 5 NFPA 13 2016 8.16.2.5.2. AN AUXILIARY DRAIN WITH A GLOBE VALVE OF NOT LESS THAN 1 INCH, PIPED TO AN ACCESSIBLE LOCATION SHALL BE INSTALLED.
  - 6 H-2 STORAGE TO HAVE WALLS THAT EXTEND TO THE DECK. SPRINKLER COVERAGE CALCULATED AT EXTRA HAZARD GRP. II WITH A DENSITY OF .40 GPM/SQ.FT. WITH HEAD COVERAGE OF NO MORE THAN 100 SQ. FT.
  - 7 NFPA 13 2016 12.1.4.1 THE INSTALLATION OF HVLS FANS IN BUILDINGS EQUIPPED WITH SPRINKLERS, INCLUDING ESFR SPRINKLERS, SHALL COMPLY WITH THE FOLLOWING:
    - (1) THE MAXIMUM FAN DIAMETER SHALL BE 24FT
    - (2) THE HVLS FAN SHALL BE CENTERED APPROXIMATELY BETWEEN FOUR ADJACENT SPRINKLERS.
    - (3) THE VERTICAL CLEARANCE FROM THE HVLS FAN TO SPRINKLER DEFLECTOR SHALL BE A MINIMUM OF 3 FT
    - (4) ALL HVLS FANS SHALL BE INTERLOCKED TO SHUT DOWN IMMEDIATELY UPON RECEIVING A WATERFLOW SIGNAL FROM THE ALARM SYSTEM IN ACCORDANCE WITH THE REQUIREMENTS OF NFPA 72 2016

**FIRE PROTECTION PLAN - SECTION A**  
SCALE: 1/8" = 1'-0"

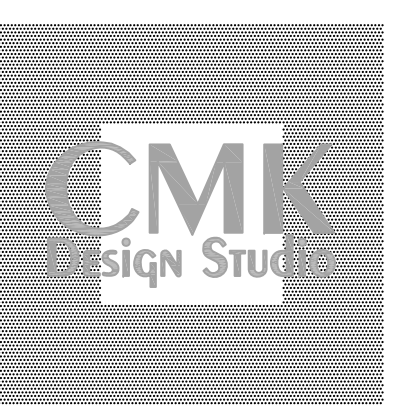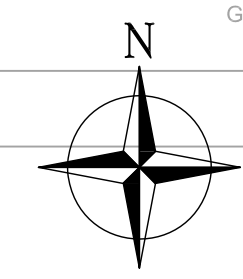

**CMK Design Studio, Inc.**  
Planning & Design of the Built Environment  
6822 22nd Ave. N. #148  
St. Petersburg, Florida 33710  
PH: 813.362.6381

FL LIC. NO. AA2002803  
marcos@cmkdesignstudio.com

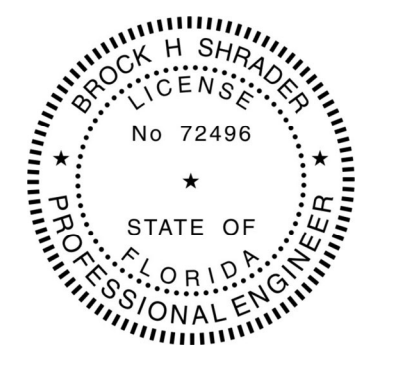

Drawing Not Valid Unless Signed, Sealed & Dated by Registered Professional

**INDIAN RIVER COUNTY LANDFILL  
HOUSEHOLD HAZARDOUS WASTE  
AND RECYCLING FACILITY**  
Indian River County, Florida

| NO. | REVISIONS          | DATE       |
|-----|--------------------|------------|
| 1   | FIELD COORDINATION | 05.15.2021 |
| 2   | FIELD COORDINATION | 11.05.2021 |

JOB NO. **2016**


ISSUE DATE:  
07/07/2021

DRAWN BY:  
WG

PERMIT SET

SHEET TITLE  
**FIRE PROTECTION PLAN - SECTION A**  
SHEET NO.  
**FP101**


C.O.A. #26759  
**WILSON ARGENTI**  
ENGINEERING  
1408 N WESTSHORE BLVD,  
STE. 506 TAMPA, FL 33607  
WORKWITHWG.COM  
813.855.3330

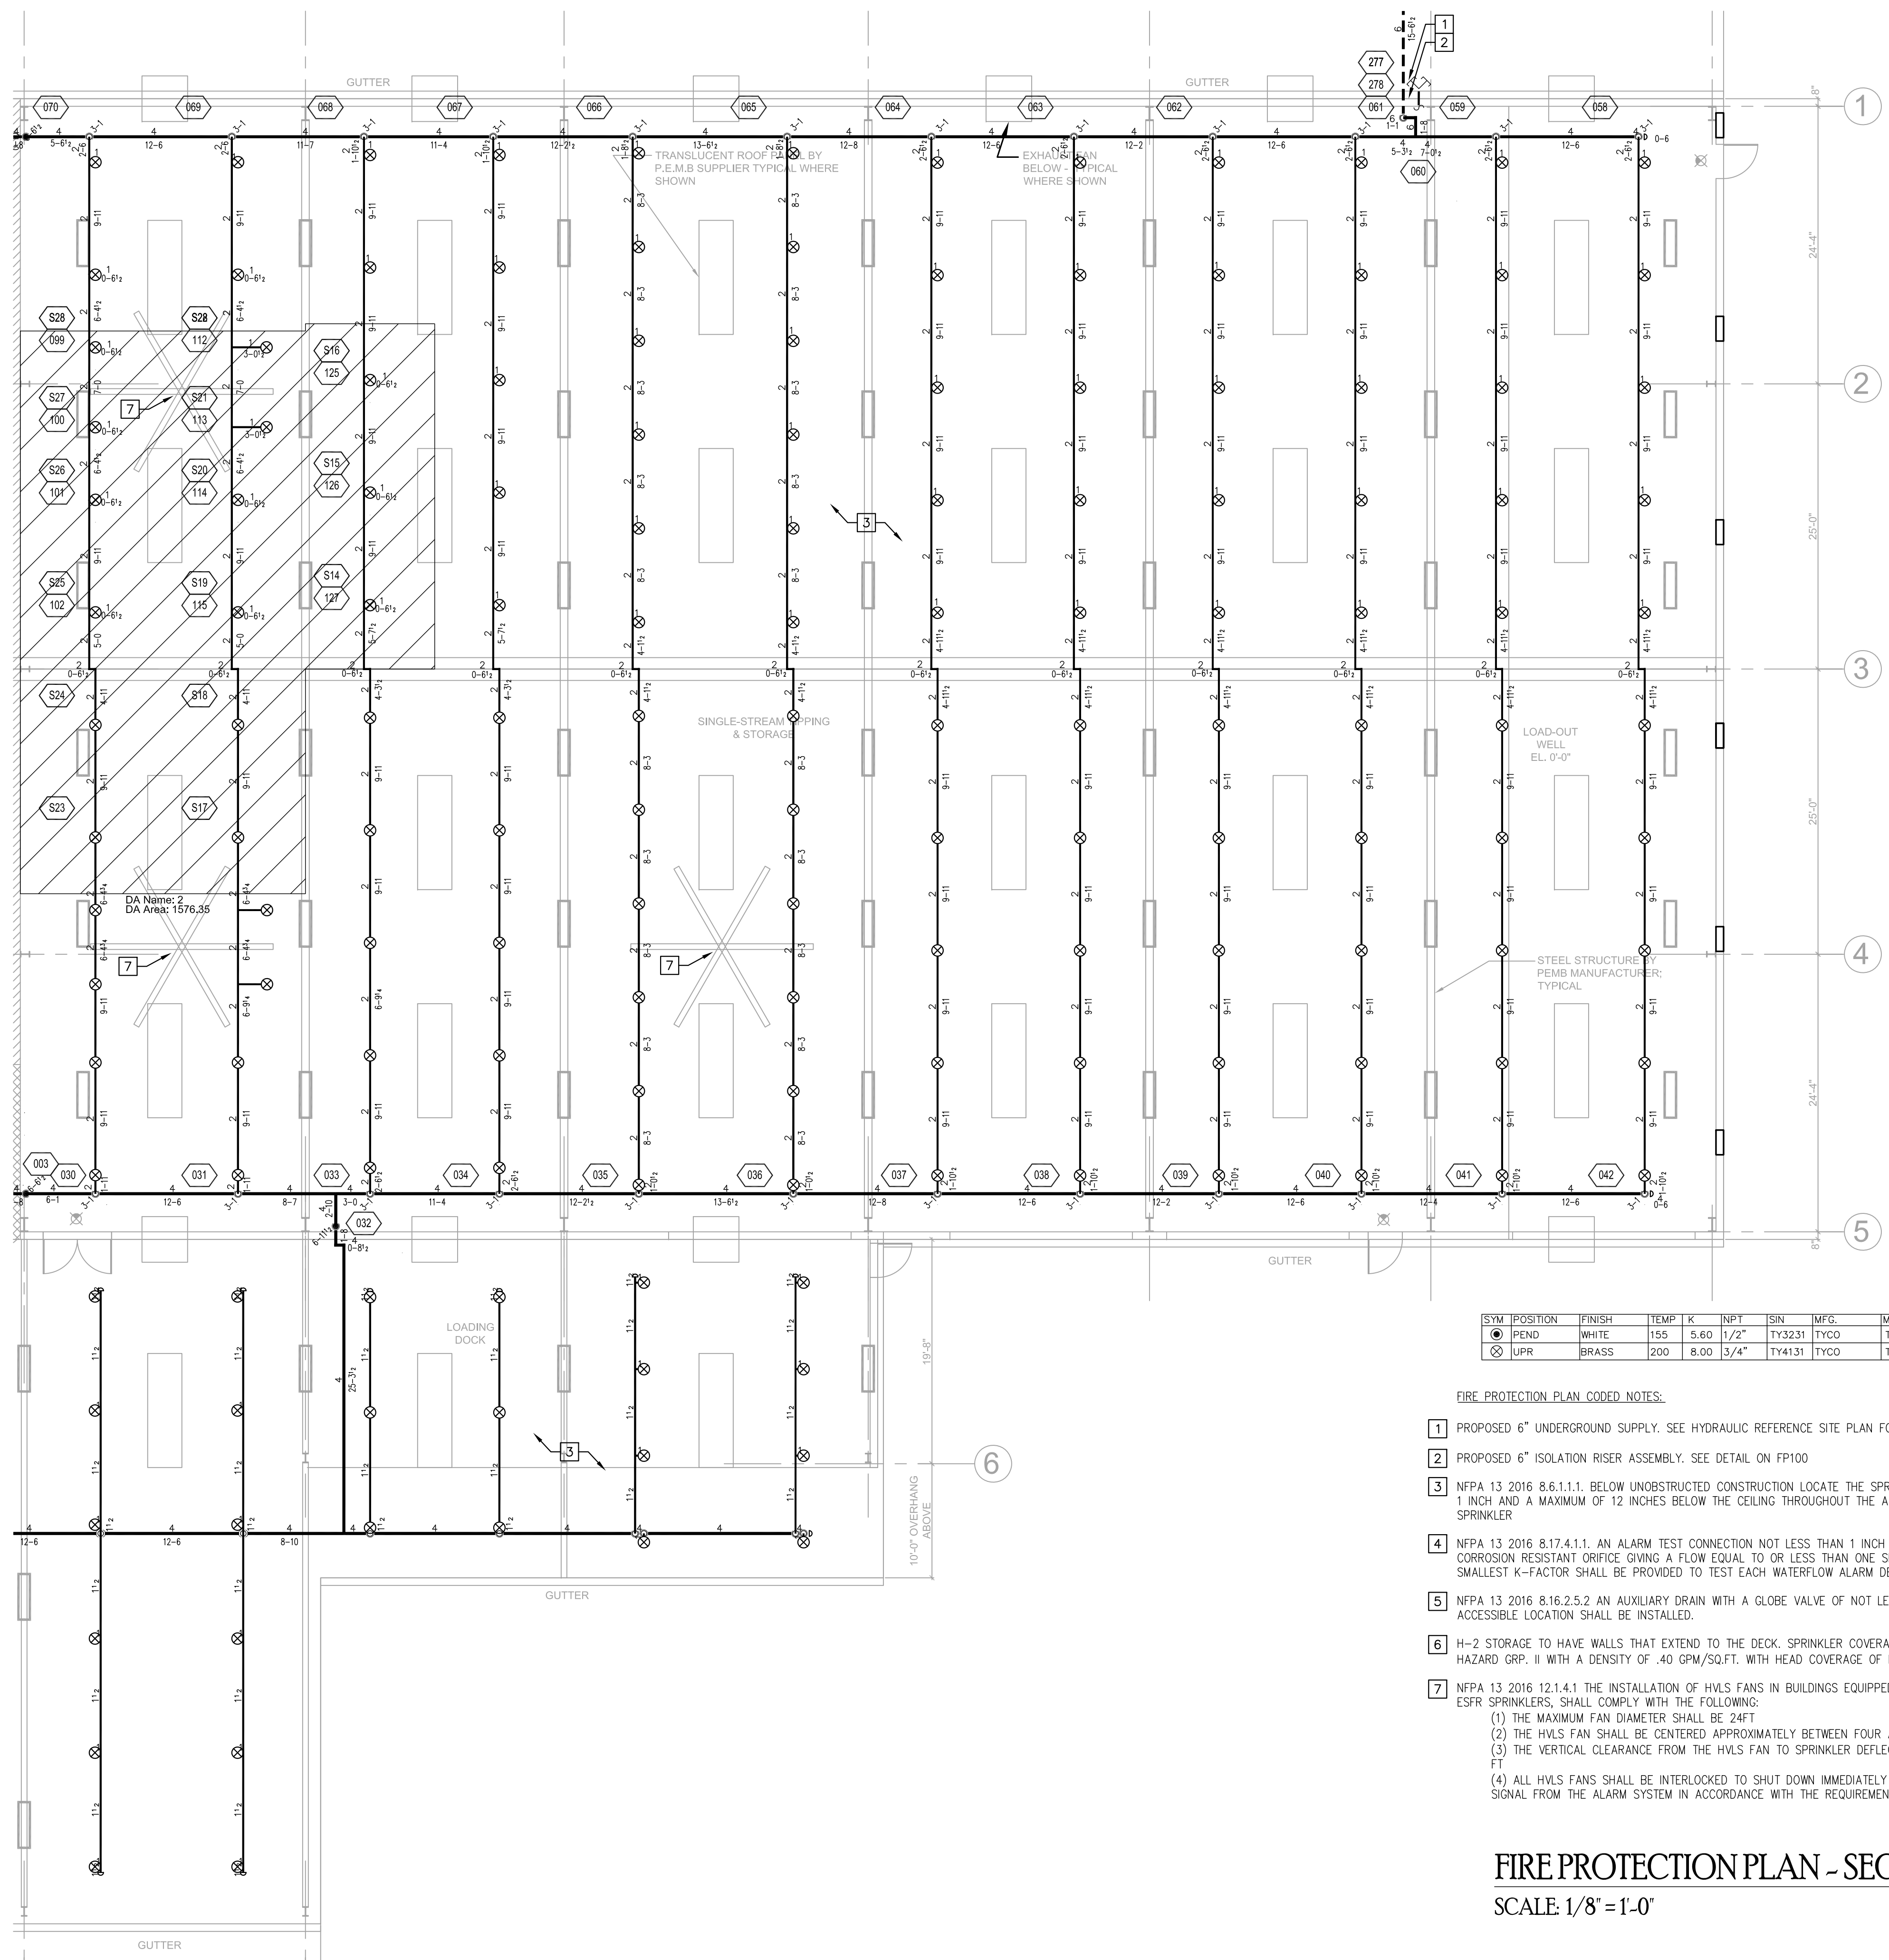

| SYM | POSITION | FINISH | TEMP | K    | RP T | ISN    | MF6  | MODEL# |
|-----|----------|--------|------|------|------|--------|------|--------|
| ●   | PEND     | WHITE  | 155  | 5.60 | 1/2" | TY3231 | TYCO | TY-FRB |
| ⊗   | UPR      | BRASS  | 200  | 8.00 | 3/4" | TY4131 | TYCO | TY-FRB |

- FIRE PROTECTION PLAN CODED NOTES:**
- 1 PROPOSED 6" UNDERGROUND SUPPLY. SEE HYDRAULIC REFERENCE SITE PLAN FOR CONTINUATION
  - 2 PROPOSED 6" ISOLATION RISER ASSEMBLY. SEE DETAIL ON FP100
  - 3 NFPA 13 2016 8.6.1.1.1. BELOW UNOBSTRUCTED CONSTRUCTION LOCATE THE SPRINKLER DEFLECTOR A MINIMUM OF 1 INCH AND A MAXIMUM OF 12 INCHES BELOW THE CEILING THROUGHOUT THE AREA OF COVERAGE OF THE SPRINKLER
  - 4 NFPA 13 2016 8.17.4.1.1. AN ALARM TEST CONNECTION NOT LESS THAN 1 INCH TERMINATING IN A SMOOTH BORE CORROSION RESISTANT ORIFICE GIVING A FLOW EQUAL TO OR LESS THAN ONE SPRINKLER OF A TYPE HAVING THE SMALLEST K-FACTOR SHALL BE PROVIDED TO TEST EACH WATERFLOW ALARM DEVICE OF EACH SYSTEM
  - 5 NFPA 13 2016 8.16.2.5.2 AN AUXILIARY DRAIN WITH A GLOBE VALVE OF NOT LESS THAN 1 INCH, PIPED TO AN ACCESSIBLE LOCATION SHALL BE INSTALLED.
  - 6 H-2 STORAGE TO HAVE WALLS THAT EXTEND TO THE DECK. SPRINKLER COVERAGE CALCULATED AT EXTRA HAZARD GRP. II WITH A DENSITY OF .40 GPM/SQ.FT. WITH HEAD COVERAGE OF NO MORE THAN 100 SQ. FT.
  - 7 NFPA 13 2016 12.1.4.1 THE INSTALLATION OF HVLS FANS IN BUILDINGS EQUIPPED WITH SPRINKLERS, INCLUDING ESFR SPRINKLERS, SHALL COMPLY WITH THE FOLLOWING:
    - (1) THE MAXIMUM FAN DIAMETER SHALL BE 24FT
    - (2) THE HVLS FAN SHALL BE CENTERED APPROXIMATELY BETWEEN FOUR ADJACENT SPRINKLERS.
    - (3) THE VERTICAL CLEARANCE FROM THE HVLS FAN TO SPRINKLER DEFLECTOR SHALL BE A MINIMUM OF 3 FT
    - (4) ALL HVLS FANS SHALL BE INTERLOCKED TO SHUT DOWN IMMEDIATELY UPON RECEIVING A WATERFLOW SIGNAL FROM THE ALARM SYSTEM IN ACCORDANCE WITH THE REQUIREMENTS OF NFPA 72 2016

**FIRE PROTECTION PLAN - SECTION B**  
 SCALE 1/8" = 1'-0"

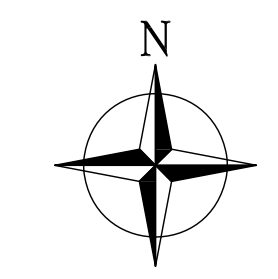


C.O.A. #26759

**WILSON IRGENTI**  
 ENGINEERING

1408 N WESTSHORE BLVD,  
 STE. 506 TAMPA, FL 33607  
 WORKWITHHWG.COM  
 813.855.3330



**CMK Design Studio, Inc.**  
 Planning & Design of the Built Environment  
 6822 22nd Ave. N. #148  
 St. Petersburg, Florida 33710  
 Ph: 813.362.6381  
 FL LIC. NO.: AA2002803  
 marcos@cmkdesignstudio.com

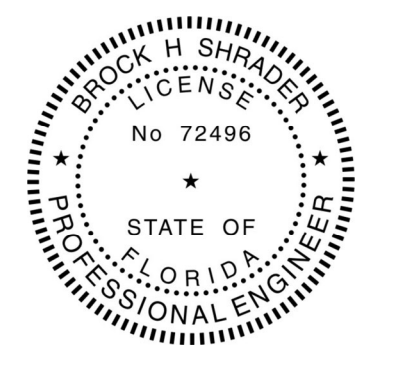

Drawing Not Valid Unless Signed, Sealed & Dated by Registered Professional

**INDIAN RIVER COUNTY LANDFILL  
 HOUSEHOLD HAZARDOUS WASTE  
 AND RECYCLING FACILITY**  
 Indian River County, Florida

| NO. | REVISIONS          | DATE       |
|-----|--------------------|------------|
| 1   | FIELD COORDINATION | 05.15.2021 |
| 2   | FIELD COORDINATION | 11.05.2021 |

JOB NO.  
**2016**


ISSUE DATE:  
 07/07/2021

DRAWN BY:  
 WG

SHEET TITLE  
**FIRE PROTECTION  
 PLAN - SECTION B**

SHEET NO.  
**FP102**

PERMIT SET

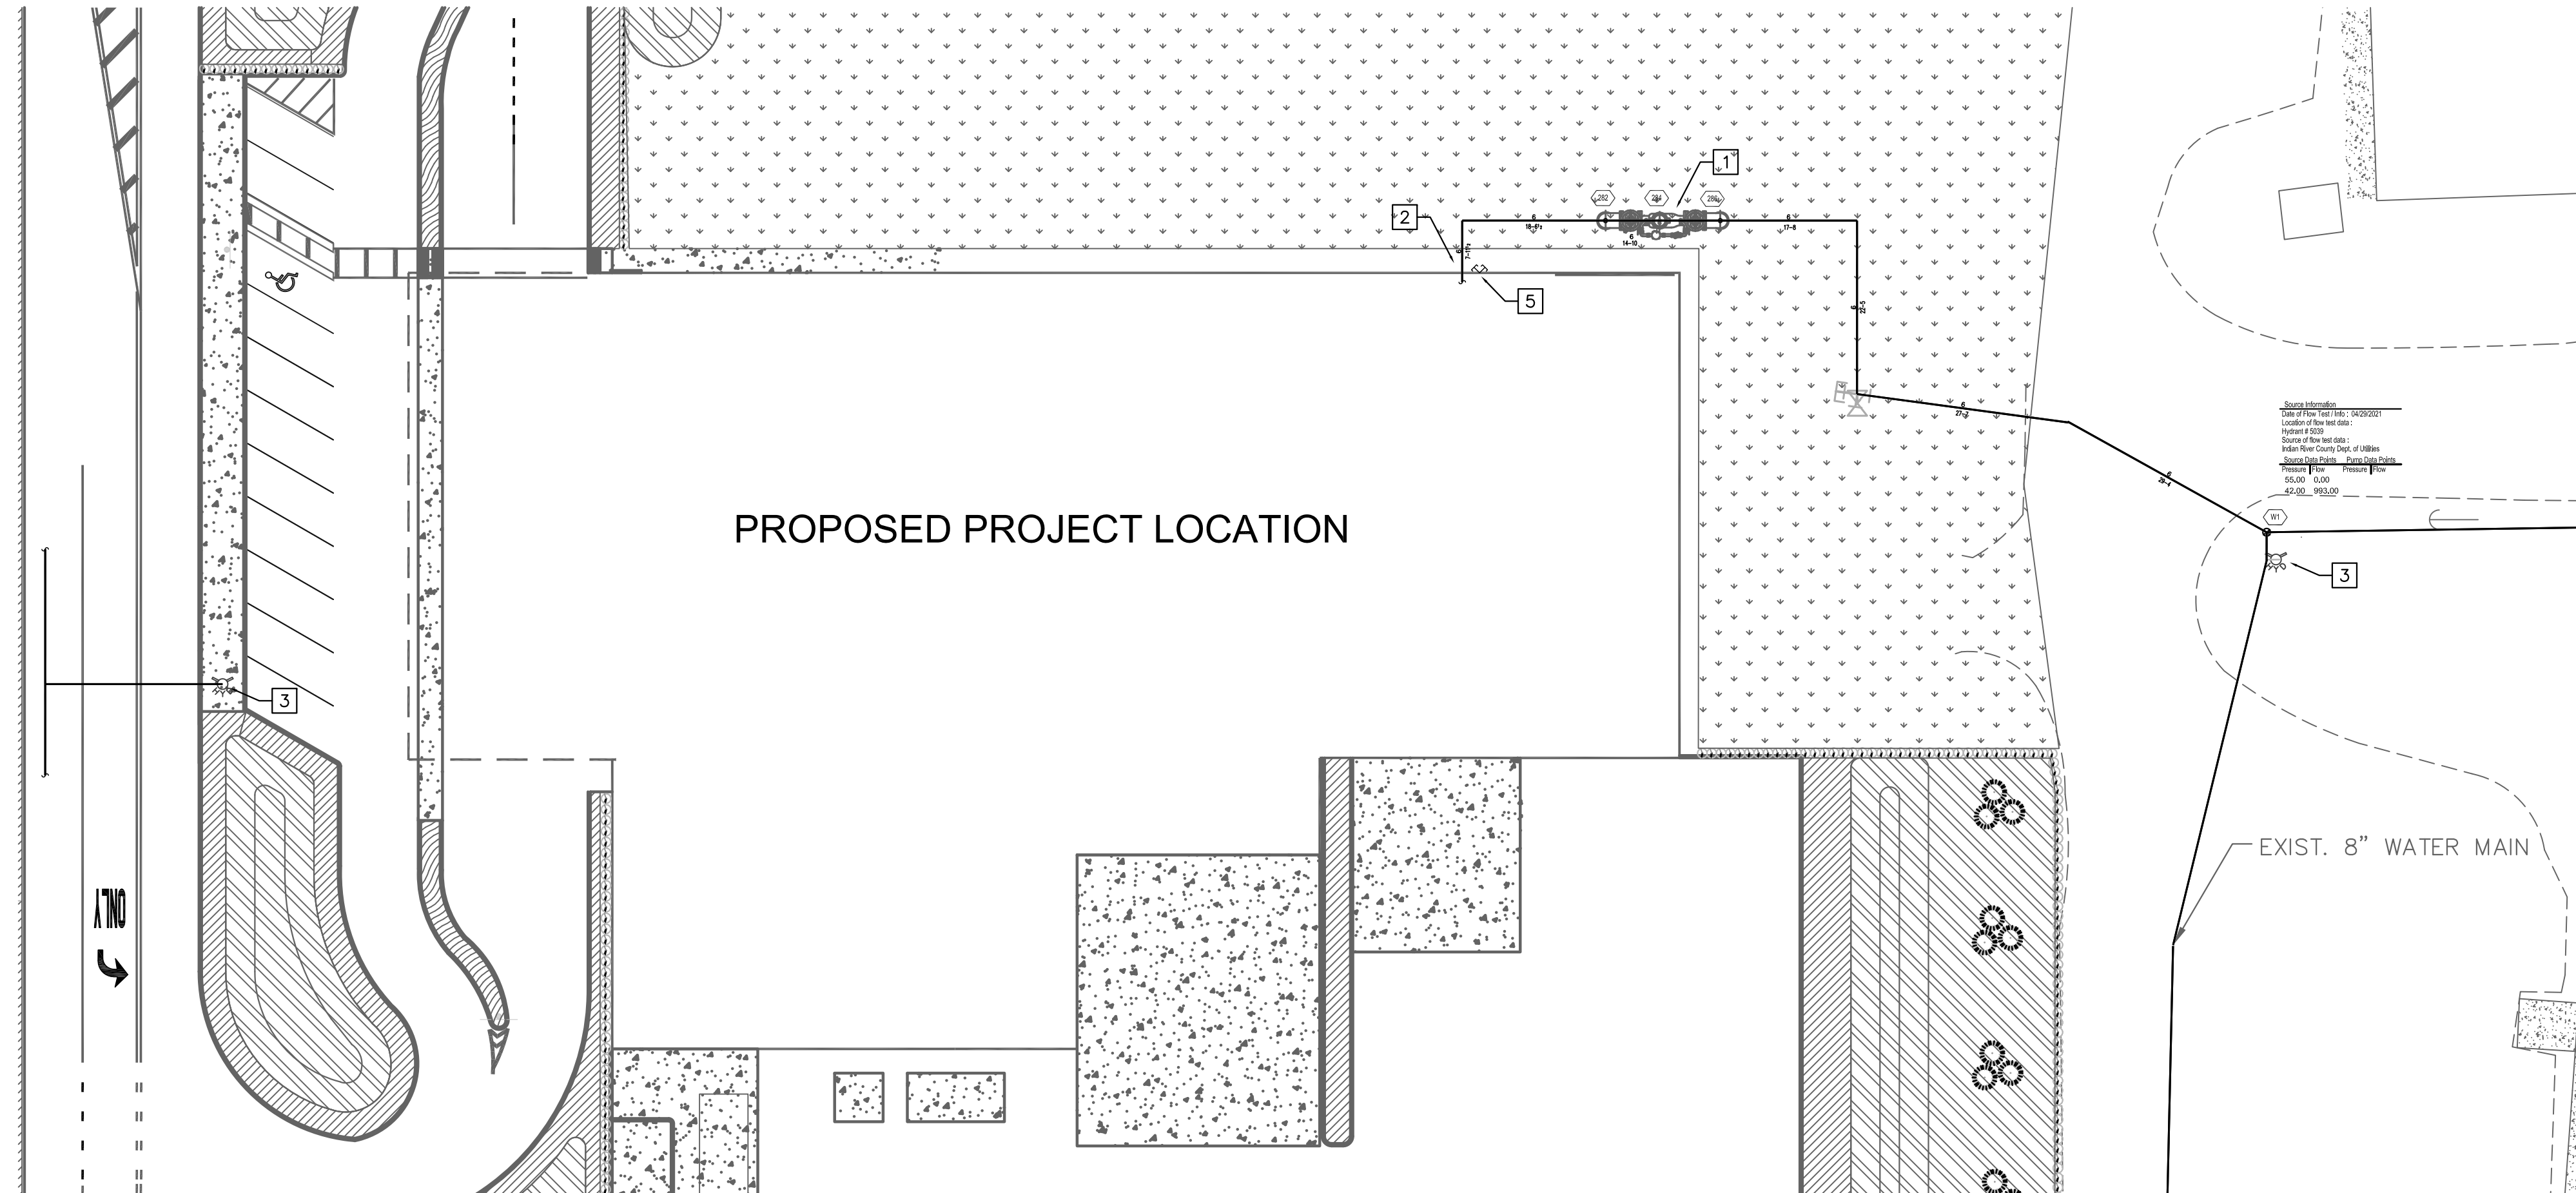


FIRE PROTECTION PLAN CODED NOTES:

- 1 PROPOSED 6" DDCVA WITH BOLLARDS. SEE CIVIL ENGINEERING DRAWINGS FOR DETAILS
- 2 FOR CONTINUATION OF SYSTEM PIPE INTO BUILDING, SEE FP101-FP102
- 3 EXISTING FIRE HYDRANT. SEE CIVIL ENGINEERING DRAWINGS FOR DETAILS
- 4 PROPOSED FIRE HYDRANT. SEE CIVIL ENGINEERING DRAWINGS FOR DETAILS
- 4 WALL-MOUNTED FDC. SEE RISER DETAIL ON FP100

DRAWING NOTE:  
 THE UNDERGROUND SITE WATER PIPING IS SHOWN IN ACCORDANCE WITH FAC 61G15-32 TO REFERENCE THE FIRE PROTECTION SYSTEM IN ITS ENTIRETY, INCLUDING HYDRAULIC NOTE POINT LOCATIONS. IT IS THE RESPONSIBILITY OF THE CIVIL ENGINEER OF RECORD TO DESIGN THE UNDERGROUND SITE WATER PIPING AND TO LOCATE WITH DETAIL ALL UNDERGROUND APPURTENANCES PER LOCAL AUTHORITY HAVING JURISDICTION REQUIREMENTS.

**HYDRAULIC SITE REFERENCE PLAN**  
 SCALE: 1/16" = 1'-0"

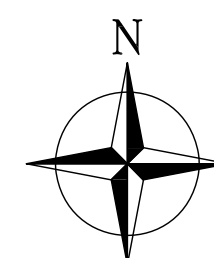

C.O.A. #26759

**WILSON  
IRGENTI**  
ENGINEERING

1408 N WESTSHORE BLVD,  
STE. 506 TAMPA, FL 33607  
WORKWITHWG.COM  
813.855.3330

PERMIT SET

SHEET TITLE  
**HYDRAULIC SITE REFERENCE PLAN**

SHEET NO.  
**FP103**


| NO. | REVISIONS          | DATE       |
|-----|--------------------|------------|
| △   | FIELD COORDINATION | 05.15.2021 |
| △   | FIELD COORDINATION | 11.05.2021 |

JOB NO.  
**2016**

ISSUE DATE:  
 07/07/2021

DRAWN BY:  
 WG

**INDIAN RIVER COUNTY LANDFILL  
 HOUSEHOLD HAZARDOUS WASTE  
 AND RECYCLING FACILITY**  
 Indian River County, Florida

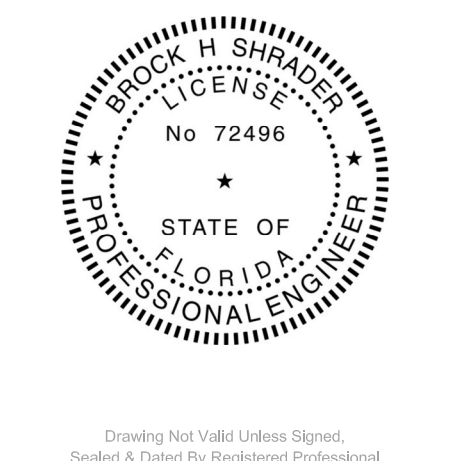


**CMK**  
Design Studio

**CMK Design Studio, Inc.**  
 Planning & Design of the Built Environment

6822 22nd Ave. N. #148  
 St. Petersburg, Florida 33710  
 PH: 813.362.6381

FL LIC. NO.: AA26002603  
 marcos@cmkdesignstudio.com

Plotted By: Ftpi, Carlos, Sheet Set: IRC LANDFILL, Layout: L-100, TREE DISPOSITION, November 16, 2021, 03:20:49pm, \\kimley-horn.com\F\A\MIB\_Civil\143228000 - IRC HHW and Recycling Facility\Landscaping\CADD\PlanSheets\L-100 TREE DISPOSITION.dwg  
 This document, together with the concepts and designs presented herein, as an instrument of service, is intended only for the specific purpose and client for which it was prepared. Reuse of and improper reliance on this document without written authorization and adaptation by Kimley-Horn and Associates, Inc. shall be without liability to Kimley-Horn and Associates, Inc.

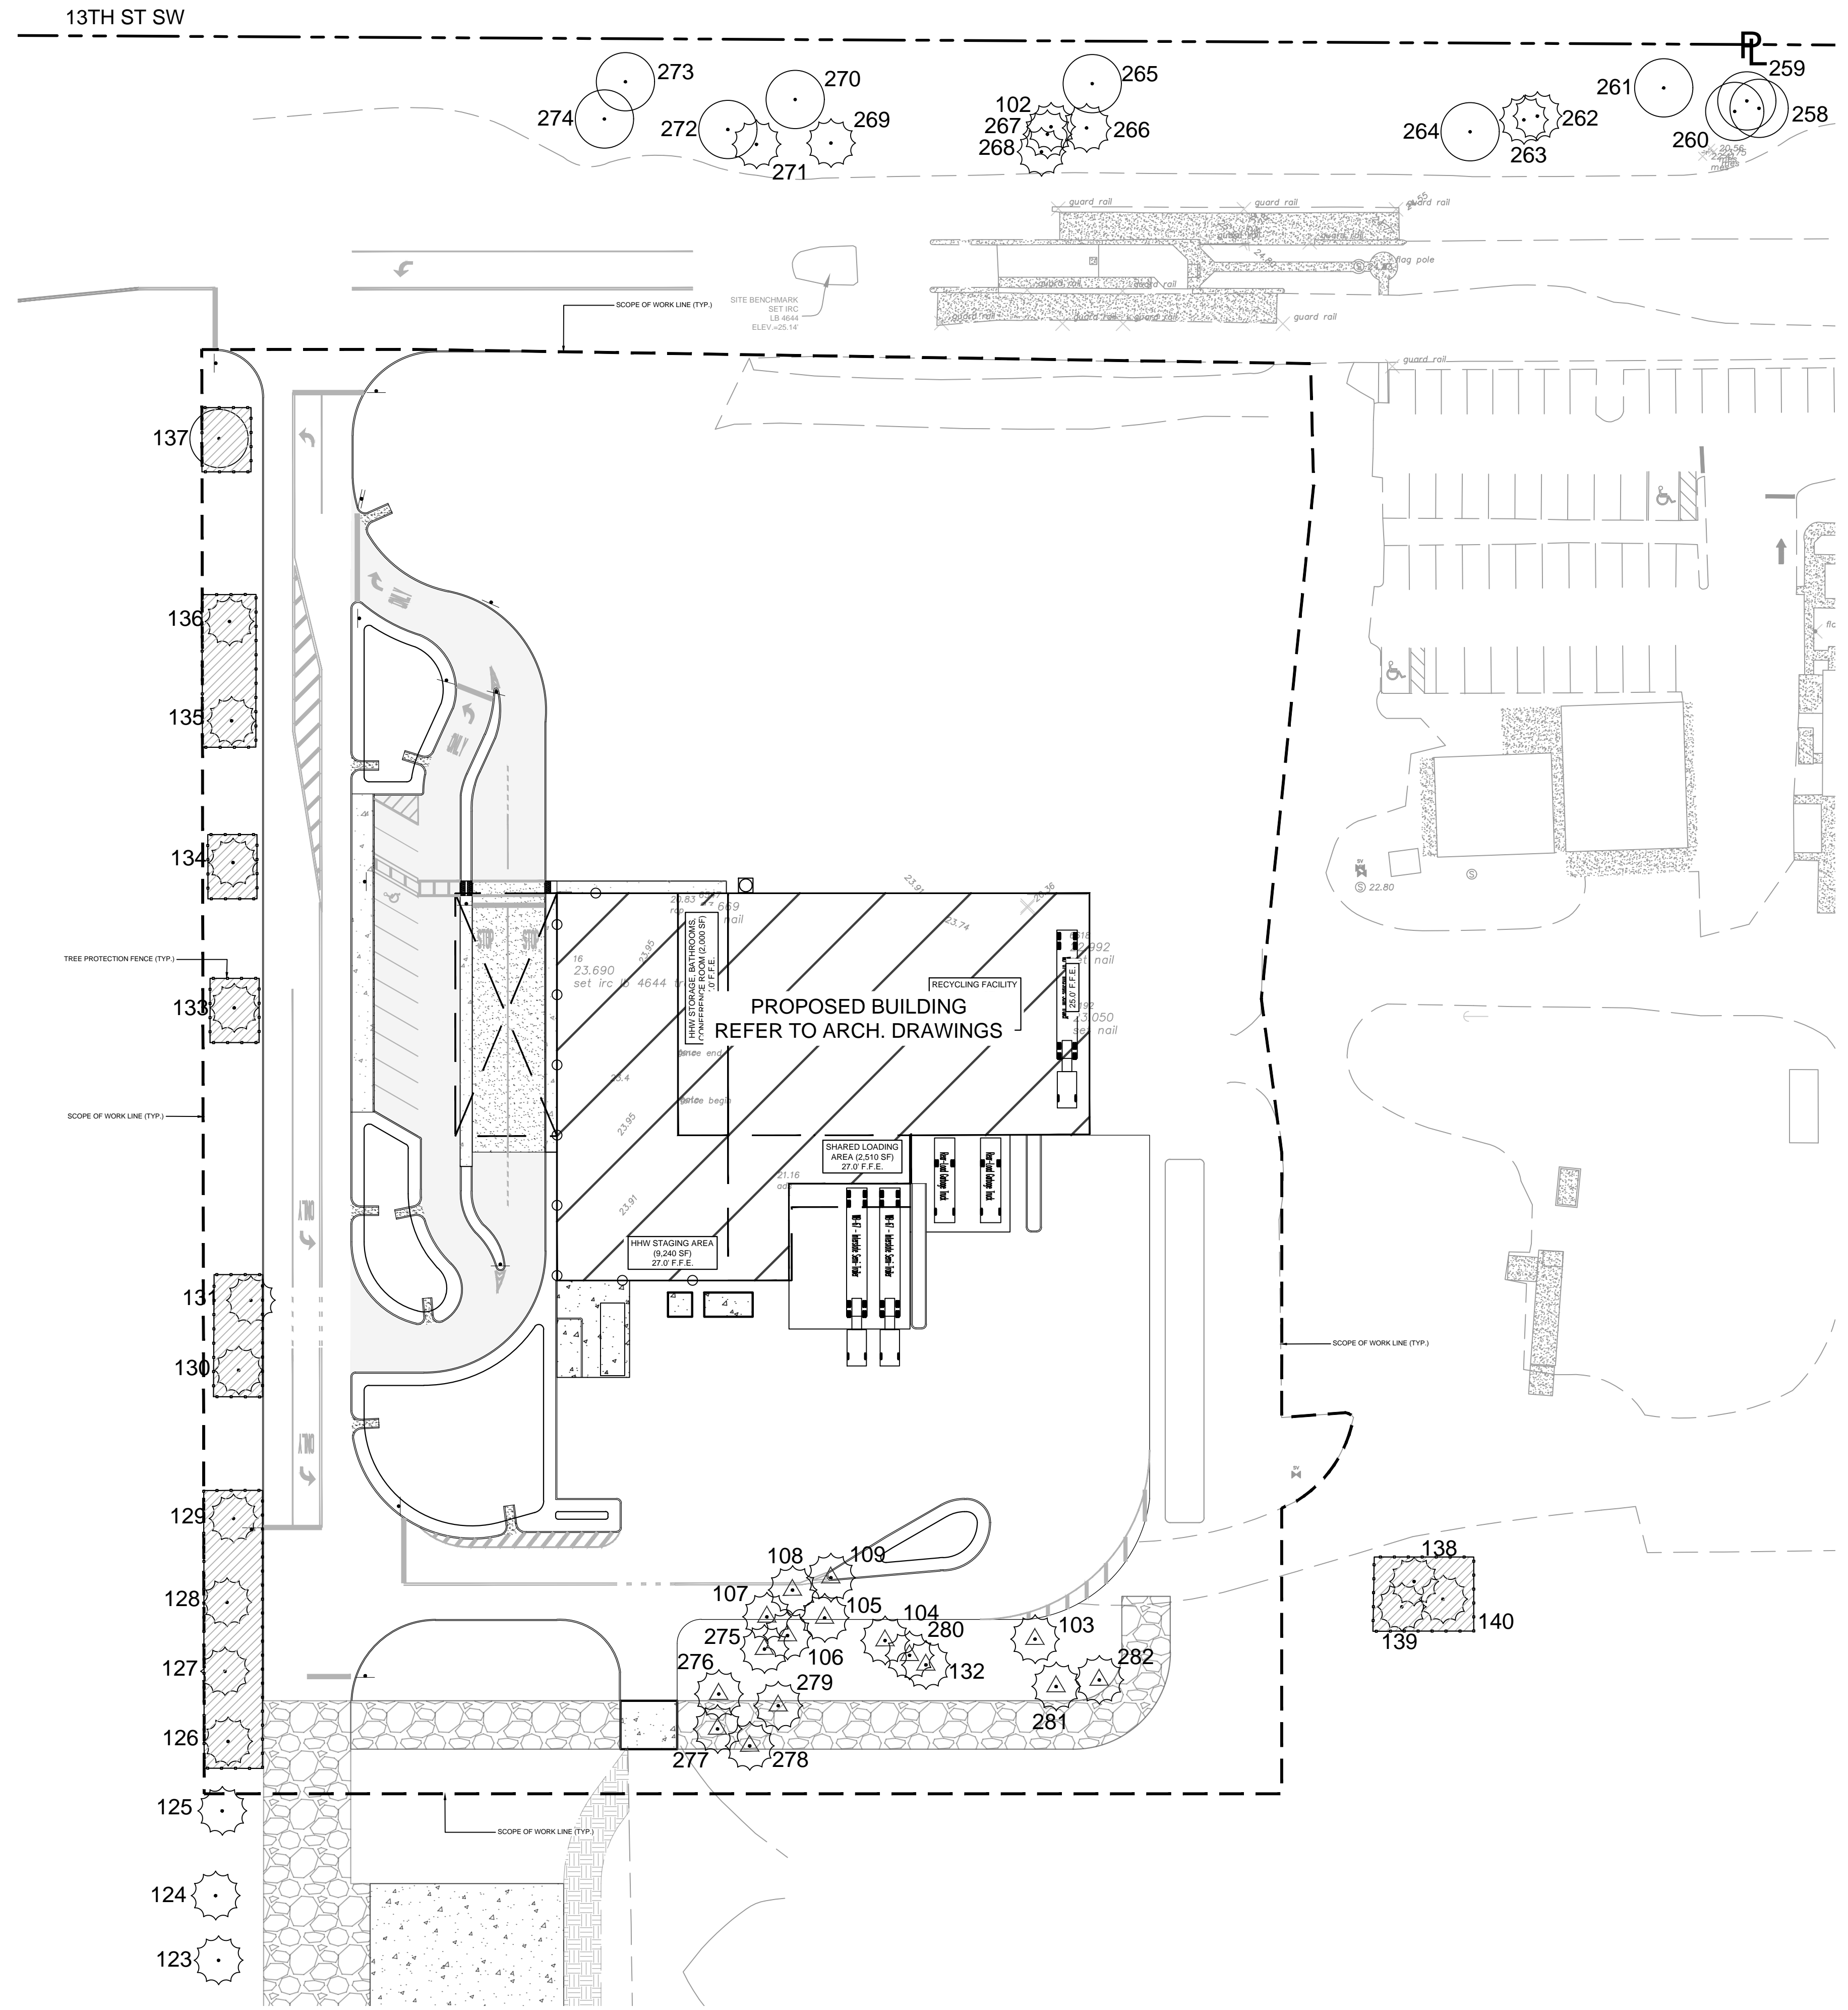

**TREE LIST**


| SURVEY TREE # | COMMON NAME | HEIGHT (FT) | DBH (IN) | CANOPY (FT) | CONDITION | DISPOSITION |
|---------------|-------------|-------------|----------|-------------|-----------|-------------|
| 102           | Palm        | 10          | 21       | 11          | GOOD      | REMAN       |
| 103           | Palm        | 14          | 18.5     | 10          | GOOD      | RELOCATE    |
| 104           | Palm        | 14          | 19       | 11          | GOOD      | RELOCATE    |
| 105           | Palm        | 16          | 22       | 11          | GOOD      | RELOCATE    |
| 106           | Palm        | 14          | 17       | 9           | GOOD      | RELOCATE    |
| 107           | Palm        | 14          | 21       | 10          | GOOD      | RELOCATE    |
| 108           | Palm        | 14          | 21       | 10          | GOOD      | RELOCATE    |
| 109           | Palm        | 14          | 20       | 10          | GOOD      | RELOCATE    |
| 110           | Palm        | 8           | 25       | 9           | GOOD      | REMAN       |
| 111           | Palm        | 10          | 24       | 10          | GOOD      | REMAN       |
| 112           | Palm        | 10          | 18       | 13          | MODERATE  | REMAN       |
| 113           | Palm        | 8           | 20       | 11          | GOOD      | REMAN       |
| 114           | Palm        | 6           | 16       | 9           | MODERATE  | REMAN       |
| 115           | Palm        | 12          | 20       | 13          | GOOD      | REMAN       |
| 116           | Palm        | 6           | 17       | 9           | GOOD      | REMAN       |
| 117           | Palm        | 8           | 21       | 12          | GOOD      | REMAN       |
| 118           | Palm        | 10          | 20       | 13          | GOOD      | REMAN       |
| 119           | Palm        | 10          | 26       | 16          | GOOD      | REMAN       |
| 120           | Palm        | 8           | 19       | 10          | GOOD      | REMAN       |
| 121           | Palm        | 12          | 19       | 13          | GOOD      | REMAN       |
| 122           | Palm        | 10          | 27       | 18          | GOOD      | REMAN       |
| 123           | Palm        | 14          | 19       | 13          | GOOD      | REMAN       |
| 124           | Palm        | 12          | 20       | 13          | GOOD      | REMAN       |
| 125           | Palm        | 10          | 21       | 11          | GOOD      | REMAN       |
| 126           | Palm        | 8           | 17       | 11          | GOOD      | REMAN       |
| 127           | Palm        | 10          | 18       | 9           | GOOD      | REMAN       |
| 128           | Palm        | 10          | 16       | 8           | GOOD      | REMAN       |
| 129           | Palm        | 10          | 18       | 7           | GOOD      | REMAN       |
| 130           | Palm        | 8           | 24       | 14          | GOOD      | REMAN       |
| 131           | Palm        | 10          | 10       | 18          | GOOD      | REMAN       |
| 132           | Palm        | 10          | 18       | 8           | MODERATE  | RELOCATE    |
| 133           | Palm        | 8           | 22       | 20          | GOOD      | REMAN       |
| 134           | Palm        | 8           | 18       | 8           | GOOD      | REMAN       |
| 135           | Palm        | 8           | 22       | 17          | GOOD      | REMAN       |
| 136           | Palm        | 8           | 17       | 10          | GOOD      | REMAN       |
| 137           | Oak Tree    | 10          | 21       | 16          | GOOD      | REMAN       |
| 138           | Palm        | 12          | 16.5     | 8           | GOOD      | REMAN       |
| 139           | Palm        | 10          | 16.5     | 8           | GOOD      | REMAN       |
| 140           | Palm        | 16          | 16.5     | 10          | GOOD      | REMAN       |
| 258           | Pine Tree   | 10          | 45       | 9           | GOOD      | REMAN       |
| 259           | Pine Tree   | 10          | 30       | 12          | GOOD      | REMAN       |
| 260           | Pine Tree   | 14          | 54       | 22          | GOOD      | REMAN       |
| 261           | Pine Tree   | 18          | 53       | 28          | GOOD      | REMAN       |
| 262           | Palm        | 12          | 19       | 8           | GOOD      | REMAN       |
| 263           | Palm        | 12          | 18       | 8           | GOOD      | REMAN       |
| 264           | Pine Tree   | 20          | 49       | 33          | GOOD      | REMAN       |
| 265           | Pine Tree   | 20          | 44       | 26          | GOOD      | REMAN       |
| 266           | Palm        | 14          | 26       | 10          | GOOD      | REMAN       |
| 267           | Palm        | 10          | 18       | 8           | GOOD      | REMAN       |
| 268           | Palm        | 10          | 17       | 8           | GOOD      | REMAN       |
| 269           | Palm        | 15          | 21       | 9           | GOOD      | REMAN       |
| 270           | Pine Tree   | 18          | 43       | 25          | GOOD      | REMAN       |
| 271           | Palm        | 12          | 23       | 11          | GOOD      | REMAN       |
| 272           | Pine Tree   | 12          | 45       | 12          | GOOD      | REMAN       |
| 273           | Pine Tree   | 15          | 43       | 12          | POOR      | REMAN       |
| 274           | Pine Tree   | 12          | 47       | 18          | MODERATE  | REMAN       |
| 275           | Palm        | 12          | 20       | 10          | GOOD      | RELOCATE    |
| 276           | Palm        | 12          | 21       | 10          | GOOD      | RELOCATE    |
| 277           | Palm        | 12          | 21       | 11          | GOOD      | RELOCATE    |
| 278           | Palm        | 12          | 19.5     | 10          | GOOD      | RELOCATE    |
| 279           | Palm        | 12          | 18       | 10          | GOOD      | RELOCATE    |
| 280           | Palm        | 12          | 27       | 12          | GOOD      | RELOCATE    |
| 281           | Palm        | 12          | 19       | 10          | GOOD      | RELOCATE    |
| 282           | Palm        | 12          | 25       | 12          | GOOD      | RELOCATE    |

**NOTE:**

INFORMATION UTILIZED IN PREPARATION OF THE TREE LIST ASCERTAINED FROM AND RELIANT UPON THE 1325 74th AVENUE SW, VERO BEACH, FL. BOUNDARY SURVEY PREPARED BY MASTELLER, MOLER & TAYLOR INC. DATED 05/18/20.

**TREE DISPOSITION GRAPHIC LEGEND**

| SYMBOL | DESCRIPTION               |
|--------|---------------------------|
|        | EXISTING TREE TO REMAIN   |
|        | TREE #                    |
|        | EXISTING PALM TO REMAIN   |
|        | EXISTING PALM TO RELOCATE |
|        | TREE PROTECTION FENCE     |

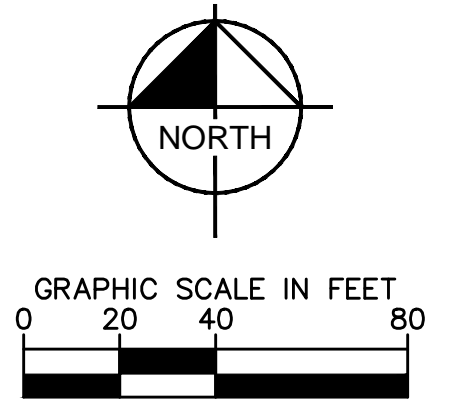

**LEGEND**

|  |                                   |
|--|-----------------------------------|
|  | RIGHT-OF-WAY LINE / PROPERTY LINE |
|  | PROP. BUILDING OUTLINE            |
|  | PROP. ASPHALT                     |
|  | PROP. CONC.                       |
|  | PROP. GRAVEL ROAD                 |
|  | SCOPE OF WORK LINE                |

THIS ITEM HAS BEEN DIGITALLY SIGNED AND SEALED BY MATTHEW VINCENT WISNIEWSKI LAG667406 ON DATE ADJACENT TO SEAL.  
 PRINTED COPIES OF THIS DOCUMENT ARE NOT CONSIDERED SIGNED AND SEALED AND THE SIGNATURE MUST BE VERIFIED ON ANY ELECTRONIC COPIES.  
 THE SEAL APPEARING ON THIS DOCUMENT WAS AUTHORIZED BY MATTHEW VINCENT WISNIEWSKI LAG667406 ON THE DATE ADJACENT TO THE SEAL.

KHA PROJECT  
14-3228000  
DATE  
JULY 2021  
SCALE AS SHOWN  
DESIGNED BY NW  
DRAWN BY NW  
CHECKED BY NW

REVISIONS  
No. DATE BY

**TREE DISPOSITION PLAN**

IRC LANDFILL  
PREPARED FOR  
INDIAN RIVER COUNTY  
INDIAN RIVER COUNTY  
FL

SHEET NUMBER  
**L-100**

Call 811 or www.sunshine811.com two business days before digging to have utilities located and marked.  
Check positive response codes before you dig!

© 2021 KIMLEY-HORN AND ASSOCIATES, INC.  
355 ALHAMBRA CIRCLE, SUITE 1400, CORAL GABLES, FL 33134  
PHONE: 305-673-2025  
WWW.KIMLEY-HORN.COM REGISTRY 696

# TREE REMOVAL/TRANSPLANT SPECIFICATIONS

## PART 1 - EXPLANATION OF NATURAL RESOURCE PRESERVATION PROCEDURES

- The sequence of operation is critical to the protection of the trees.
- Tree canopy pruning is to compensate for root loss and damage.
  - Fertilization is to stimulate root systems to heal quickly and grow back in root-pruned areas. It also produces faster availability of food to a root system that is less efficient due to the damage incurred.
  - Root pruning is to remove the roots with a trenching procedure that is less damaging to the roots than regular construction.
  - Mulching is to increase moisture-holding capacity and keep the temperature of the soil more constant.

## PART 2 - DEFINITIONS

- Combo Fence** - Combination silt and natural resource protection fence (see detail).
- Critical Root Zone** - The mass of roots surrounding a tree that is required by the tree to live. The critical root zone is often much larger than the canopy. Shown on the plans as dashed circles.
- DBH** - Diameter Breast High - Indicates the location on the trunk, approximately 4.5' above ground, to measure the diameter of a tree.
- Grade** - Refers specifically to grade on the Significant Tree or Transplant Schedule. The grade of a tree refers to the overall health and appearance of the tree. The grades range from 'A' being excellent to 'D' being hazardous.
- Preserve Trees** - Trees that are to be saved in place.
- Project Urban Forester** - A representative, hired and paid for by the owner, that supervises the construction of the procedures shown on the natural resource plans.
- Protection Zones/Areas** - Any area enclosed partially or completely by a fence shown on the natural resource plans.
- Spade Transplant** - A tree transplanted using a tree spade machine.
- Transplanted Trees** - Trees that are to be moved by hand, spade, crane or gantry to another location.

## PART 3 - PRODUCTS FOR TREE TREATMENT

Every effort shall be made to utilize chemicals of an organic or biodegradable nature in order to offer the least impact to the natural environment. Contractor is responsible for mixing, applying, and disposal of all chemicals in accordance with strict adherence to manufacturer's directions, unless otherwise directed in these drawings.

- Chemical Treatments.**
  - Recommended Fertilizer:
    - "XL Injecto Feed", product of Doggett Corp., Lebanon, New Jersey (908) 236-6335. Apply a 12/24/24 ratio with a dilution rate 1/3 more water than specified on bag.
    - Recommended Wetting Agent:
      - "APSA-80", product of Amway Corp. (800) 253-7088.
    - Mycorrhizal Treatment:
      - Plant Health Care, Inc. (800) 421-9051. Products of the same type from other sources shall not be excluded, provided they possess like physical and functional characteristics and are approved by the Project Landscape Architect.
  - Insecticide Treatments.
    - "Astro", a product of FMC Corporation. (800) 321-1362.
  - Fencing Materials.
    - Woven wire fence (Minimum 14.5 gauge maximum 6" mesh spacing).
    - Artic Vinyl Flagging, Color: International Orange. Forestry Suppliers Catalog (800) 647-5368. Artic Vinyl Flagging is required due to strength and longevity. No substitution without approval of Project Urban Forester.
    - 6" T-Bar Post.
    - T-Bar Post Caps.
      - Rebar Caps. Brilliant Orange mushroom type as manufactured by Mutual Industries North (800) 523-0888 or equal.
      - R-4 T-Bar Post Caps as manufactured by RammFence (800) 434-8455 or equal.

## PART 4 - EXECUTION

- Tree Canopy Pruning Operation**
  - Trees to be pruned shall include only trees affected by construction or as designated on Significant Tree or Transplant Schedule. This item is to be coordinated by the Project Urban Forester.
  - All pruning shall be done in accordance with ANSI A300 (Part 1) Pruning.
  - Certified Arborist shall perform all pruning.
  - Pruning shall consist of the following methods:
    - Cleaning, see Sect. 5.6.1.
    - Interfering branch removal.
    - Raising, see Sect. 5.6.4. Height to be 6' (min.) in parking lot areas only.
- Fertilization Operation**
  - Only trees affected by construction or as shown on the Tree Removal Plan shall be treated
  - Trees specified to receive fertilizer shall be treated in the fall of 2008. Preserve Tree Injectable Fertilizer Treatment. See detail sheet.
    - Mix fertilizer with a dilution rate 1/3 more water than label instructions into a tank with agitation capability (15lbs. = 133 Gallons).
    - Mix Wetting Agent at a rate of 5 oz. Per 100 gallons of fertilizer solution into same tank with fertilizer. Agitate mix.
    - Inject the mixture with a hydraulic injection system set at 100 to 150 p.s.i. for sandy soils, 200 p.s.i. for silty/clay soils, into the upper 6-12 inches of soil with a soil probe. Inject at the rate of one third (1/3) gallon at each injection site.
    - Critical Root Zone areas shall be injected, where possible, in the Critical Root Zone area plus 2' beyond Critical Root Zone, but not beyond Root Prunes. See detail.
    - Fertilizer shall be installed prior to installation of any aeration systems. AT THE REQUEST OF THE SPECIFIER, EMPTY PRODUCT BAGS TO BE RETURNED TO THE SPECIFIER FOR PROOF OF USE.
  - Transplant Injectable Fertilizer Treatment.
    - Mix fertilizer with a dilution rate 1/3 more water than label instructions into a tank with agitation capability (15lbs. = 133 Gallons).
    - Mix Wetting Agent at a rate of 5 oz. Per 100 gallons of fertilizer solution into same tank with fertilizer. Agitate mix.
    - Inject the mixture with a hydraulic injection system set at 100 to 150 p.s.i. for sandy soils, 200 p.s.i. for silty/clay soils, into the upper 6-12 inches of soil with a soil probe. Inject at the rate of one third (1/3) gallon at each injection site. See transplant details on this sheet for injection locations. EMPTY PRODUCT BAGS TO BE STOCKPILED FOR INSPECTION BY PROJECT LANDSCAPE ARCHITECT PRIOR TO DISPOSAL.
    - Transplant Inoculant & Biostimulant. See Detail Sheet.
      - Use one 3 oz. Packet of MycorTree Tree Saver Transplant Mycorrhizal Transplant Inoculant for every 1-foot diameter of root ball. Mix inoculant in 10' wide topsoil ring around the root ball.
      - Mix one 4 oz. Bag of MycorTree Tree Saver Injectable Mycorrhizal Inoculant and 4 packs (to equal 1 pound) PHC BioPack per 100 gallons of water.
      - Agitate for 10 minutes.
      - Inject the mixture with a hydraulic injection system set at 100 to 150 p.s.i. for sandy soils, 200 p.s.i. for silty/clay soils, into the upper 6-12 inches of soil with a soil probe. Inject at the rate of one third (1/3) gallon at each injection site. See transplant details on this sheet for injection locations. EMPTY PRODUCT BAGS TO BE STOCKPILED FOR INSPECTION BY PROJECT LANDSCAPE ARCHITECT PRIOR TO DISPOSAL.
    - Transplant Maintenance
      - Approximately one year after planting, the Tree Relocation Contractor shall refertilize all transplants utilizing the same procedure.
- Insecticide Operation**
  - Apply "Astro" as a topical solution if recommended by Project Landscape Architect or by these plans. Notify Project Landscape Architect if an infestation is noticed. Apply around base of trunk to soil line, trunk and any limb 1/3 the size of the trunk to 25'-30' high. Insure complete coverage. Reapply "Astro" 2-3 months after initial application utilizing same procedure.
  - Follow all manufacturers' recommendations concerning application when applying "Astro". Read all warning labels. Any pets, as well as, the pets food and water bowls should be removed from the area and any swimming pools should be covered. Coordinate with Project Urban Forester for further instruction.
- Root Pruning Trenching Operation**
  - Trenching locations shall be approved in the field by the Project Landscape Architect.
  - Trenching equipment that will turn at high RPM's is preferred. Trenching equipment is to be used to perform all root pruning operations. A minimum depth of three feet is required. Clean cut roots in trench on tree side with loppers or chain saw after trenching is complete.
  - The trench shall be backfilled and compacted immediately.
- Natural Resource Protection (or Tree Protection) Fencing**
  - See details for types and locations.
  - Fencing is to be located accurately per plan by General Contractors Surveyor.
- Tree Removals**
  - Natural Resource Contractor shall remove and discard all trees shown on the tree removal plan to be removed, see Existing Tree Schedule. All trees shown to be removed shall be felled with a chain saw and stump ground 6" below surface. Any tree shown to be removed and is in an area where compaction is critical the tree shall be felled with a chain saw and stump removed by Clearing Contractor. Care must be taken not to damage trees marked for

- Clearing Contractor is to clear all remaining trees after the Natural Resource Fencing is installed. If fence is damaged, repair is to be performed immediately. See Fence Penalties. Care must be taken not to damage trees marked for preservation.
- All wood from removals shall be hauled from the site the same day, except for tops. All tops are to be mulched and stockpiled or hauled directly to mulched areas, if scheduling permits. (See landscape plans for mulching). All excess wood chips should be hauled off site after landscaping is complete.
- Clearing Contractor is to haul off all stumps.
- All burn pits if applicable must be approved by the Project Urban Forester and owner.

## G. Topsoil

- All clean backfill/clean topsoil necessary for transplant operations shall fall within the limits of the planting specifications, located elsewhere in the contract documents.

## H. Machine Dug Transplant Operation

- Dig transplant-receiving hole.
- Set spade dug root ball into receiving hole 4"-6" above existing grade.
- Wash sand or topsoil into air pockets between root ball and receiving hole.
- Install topsoil ring, 4" high, 10" wide, around perimeter of root ball. Mix MycorTree Tree Saver Mycorrhizal Transplant Inoculant into topsoil ring. See Part 4 Section B for procedure.
- Install 4"-6" mulch from perimeter of root ball to within 6" of tree trunk.
- Cover topsoil ring with 1" of mulch and extend mulch 4"-6" deep, 6" away from perimeter of root ball.
- Water transplant.

## I. Holding Area for Transplants

- Coordinate with Owner's Representative for location. Coordinate construction and scheduling with Owner's Representative.
- Install protection fencing surrounding holding area after all transplants have been moved unless otherwise instructed by Owner's Representative.
- Transplants shall be placed into the soil at the holding area unless the soil is deemed unacceptable by Project Landscape Architect. If unacceptable soil is encountered, the holding area shall be relocated to a new location or excavated to a depth determined by Project Landscape Architect and new approved topsoil installed. Transplants shall be backfilled with approved topsoil.
- Install three (3) 1/2" tensiometers. One on opposite corners and one in the middle of the holding area. Project Landscape Architect shall adjust locations of tensiometers per observations in the field.
- General Contractor shall supply temporary irrigation to the holding area. Temporary irrigation shall consist of above the ground PVC or Polyethylene pipe, spray or rotor heads (with head to head coverage) and a controller. Set schedule per Part 7.

## PART 5 - PENALTIES

### A. Repair of Damaged Trees

- If any damage to trees or other natural resources should occur by accident or negligence during the construction period, the Project Urban Forester shall appraise the damage and make recommendations to the owner for repair by the General Contractor.
- If any tree that is designated to be saved is deemed substantially damaged or dead due to construction damage, at the sole discretion of Project Landscape Architect, the following penalties will apply:
  - Trees 1" - 12" of trunk diameter, measured at 1' from the ground will be valued at \$300.00 per diameter inch.
  - Trees 13" and above of trunk diameter measured at 4.5' from the ground will be valued at \$400.00 per diameter inch.
  - If any tree designated to be saved is removed from the site without permission of the owner's representative, the penalty will be \$600.00 per inch.

### B. Repair of Damaged Natural Resource Fences

- If any damage to Natural Resource Fences should occur by accident or negligence, the General Contractor will be responsible for immediate repairs of the initial damage. Fines will be imposed as follows:
  - First time offense, a fine of \$200.00 will be imposed.
  - In the event the fence is not repaired within 24 hours to the Owner's Representative's satisfaction, an additional fine of \$100.00 per day will be imposed, until the fence is satisfactorily repaired.
  - In the event a natural resource is damaged due to fence being down, a fine of \$200.00 plus the cost of repair or replacement of the natural resource as appraised by the Project Landscape Architect will be imposed.


## PART 6 - NATURAL RESOURCE PROTECTION SEQUENCE

- The sequence of tree treatment and preservation measures shall be:
  - Root Pruning and Root Barriers.
  - Natural Resource Fencing.
  - Clearing and Grading.
  - Tree Pruning.
  - Fertilization.
  - Insecticide.
- Maintain and repair Natural Resource fencing during site construction operations.
- General Contractor's access to Fenced protection areas will be permitted only with approval of owner's representative.
- Perform any excavation or grading required within the fenced root zone areas by hand. This operation is to be supervised by the Project Landscape Architect or Owner's Representative.
- Limit required grading to 3" cut or fill within the fenced tree root zone areas. All grading to be supervised by the Owner's Representative.
- Clear by hand designated trees, shrubs, vines and groundcover from protected root zone areas.
- Do not install conduit, sprinklers, or any utility line in any critical root zone area without the approval of the Project Landscape Architect.

## PART 7 - IRRIGATION


Every effort shall be made to water the transplants as shown below. The Landscape Architect and/or Owner's Representative shall inspect all irrigation zones during the initial irrigation months and adjust settings accordingly to insure proper watering. Water in all transplants immediately after planting. Tree Relocation Contractor shall water by hand or by temporary irrigation, all transplants after planting as required by Landscape Architect or Owner's Representative until permanent irrigation is installed and operating. Irrigation Contractor shall install systems and set controllers as shown below.

- Transplant Irrigation Zones & Holding Area Zones**
  - Use the following watering schedule for all transplants:
    - Set the controller to water for the following limits:
      - First 90 days = 15 minutes, 4 times a week. (0.5" per application = 2" per week)
      - 90 days - 270 days = 2 times a week (1" per application = 2" per week)
      - 270 days on = 2 times a week (0.5" per application = 1" per week)
    - Irrigation within current watering restrictions, as applicable.

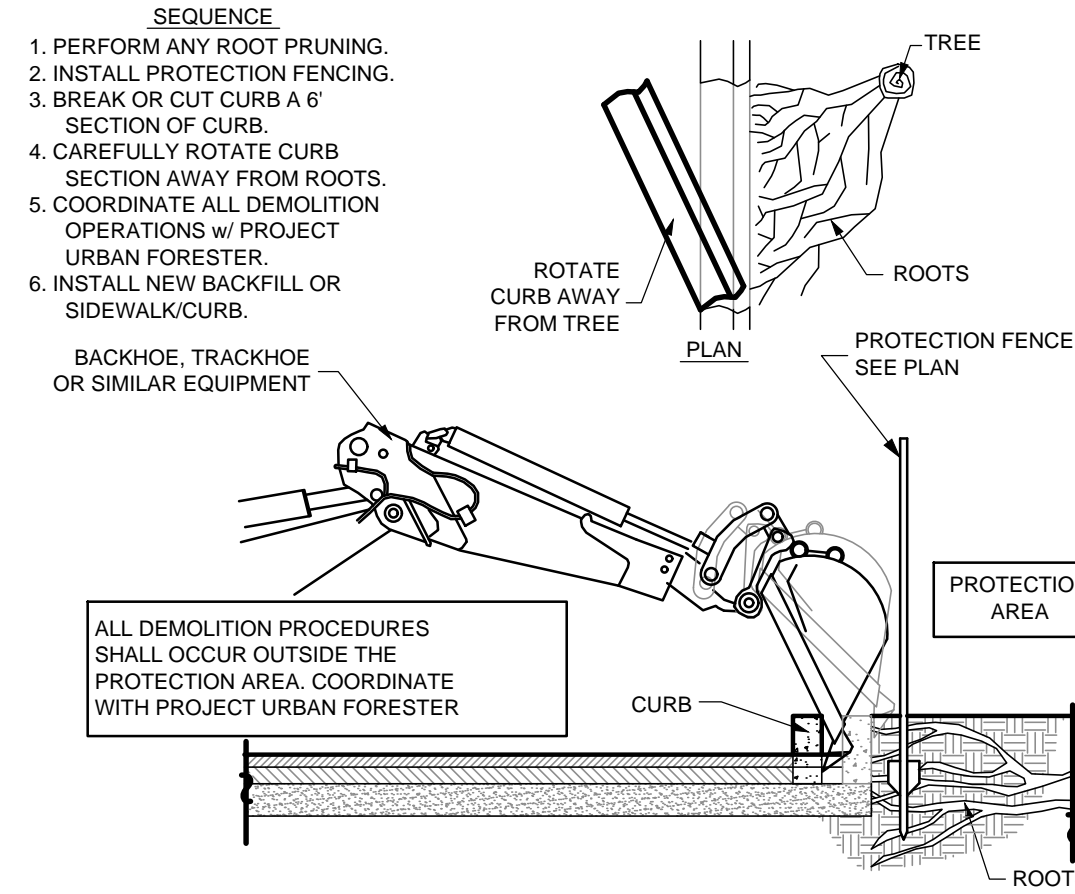


(A)

## DEMOLITION PROCEDURE - CURB NTS

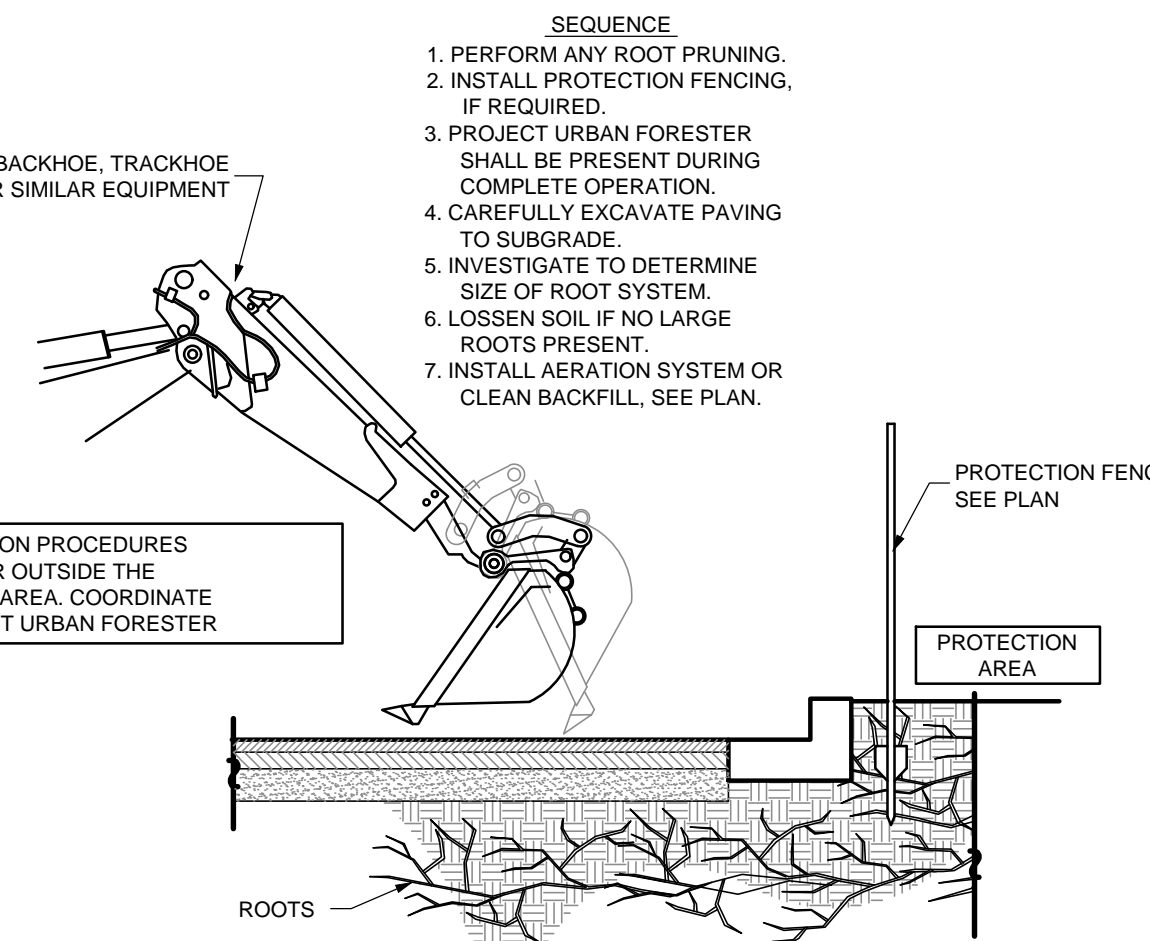

(B)

## DEMOLITION PROCEDURE - PAVEMENT NTS

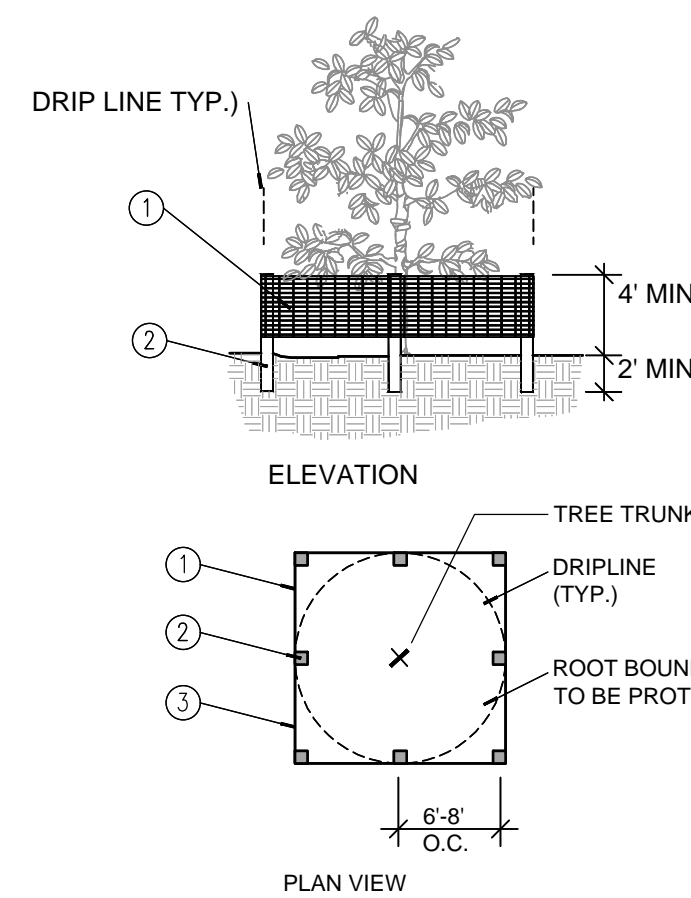

(C)

## TREE PROTECTION FENCE/BARRIER DETAIL NTS

**Kimley»Horn**  
© 2021 KIMLEY-HORN AND ASSOCIATES, INC.  
355 ALHAMBRA CIRCLE, SUITE 1400, CORAL GABLES, FL 33134  
PHONE: 305-673-2025  
WWW.KIMLEY-HORN.COM REGISTRY #696

**REGISTERED PROFESSIONAL ENGINEER**  
No. LA6667406  
STATE OF FLORIDA  
11/17/2021

KHA PROJECT  
14-3228000  
DATE  
JULY 2021  
SCALE AS SHOWN  
DESIGNED BY MW  
DRAWN BY CT  
CHECKED BY MW

PRINTED COPIES OF THIS DOCUMENT ARE NOT CONSIDERED SIGNED AND SEALED AND THE SIGNATURE MUST BE VERIFIED ON ANY ELECTRONIC COPIES.

## TREE DISPOSITION NOTES & DETAILS

## IRC LANDFILL PREPARED FOR INDIAN RIVER COUNTY INDIAN RIVER COUNTY

**Sunshine811**  
Call 811 or www.sunshine811.com two full business days before digging to have utilities located and marked.  
Check positive response codes before you dig!


SHEET NUMBER  
**L-150**

| NO. | REVISIONS | DATE | BY |
|-----|-----------|------|----|
|     |           |      |    |
|     |           |      |    |
|     |           |      |    |

Plotted By: Epiq Corios, Sheet Set: IRC LANDFILL, Layout: L-150 TREE NOTES, November 16, 2021, 03:20:51pm  
 This document, together with the concepts and designs presented herein, is intended only for the specific purpose and client for which it was prepared. Reuse of and improper reliance on this document without written authorization and adaptation by Kimley-Horn and Associates, Inc. shall be without liability to Kimley-Horn and Associates, Inc.

Plotted By: Fipj. Carlos, Sheet Set: IRC Landfill, November 16, 2021, 03:28:25pm, \\kimley-horn.com\EL\_MIA\WB\_Civil\143228000 - IRC-HW and Recycling Facility Landscape (CADD) Plans\Sheets\200 Landscape Plan.dwg  
This document, together with the concepts and designs presented herein, as an instrument of service, is intended only for the specific purpose and client for which it was prepared. Reuse of and improper reliance on this document without written authorization and adaptation by Kimley-Horn and Associates, Inc. shall be without liability to Kimley-Horn and Associates, Inc.



13TH ST SW

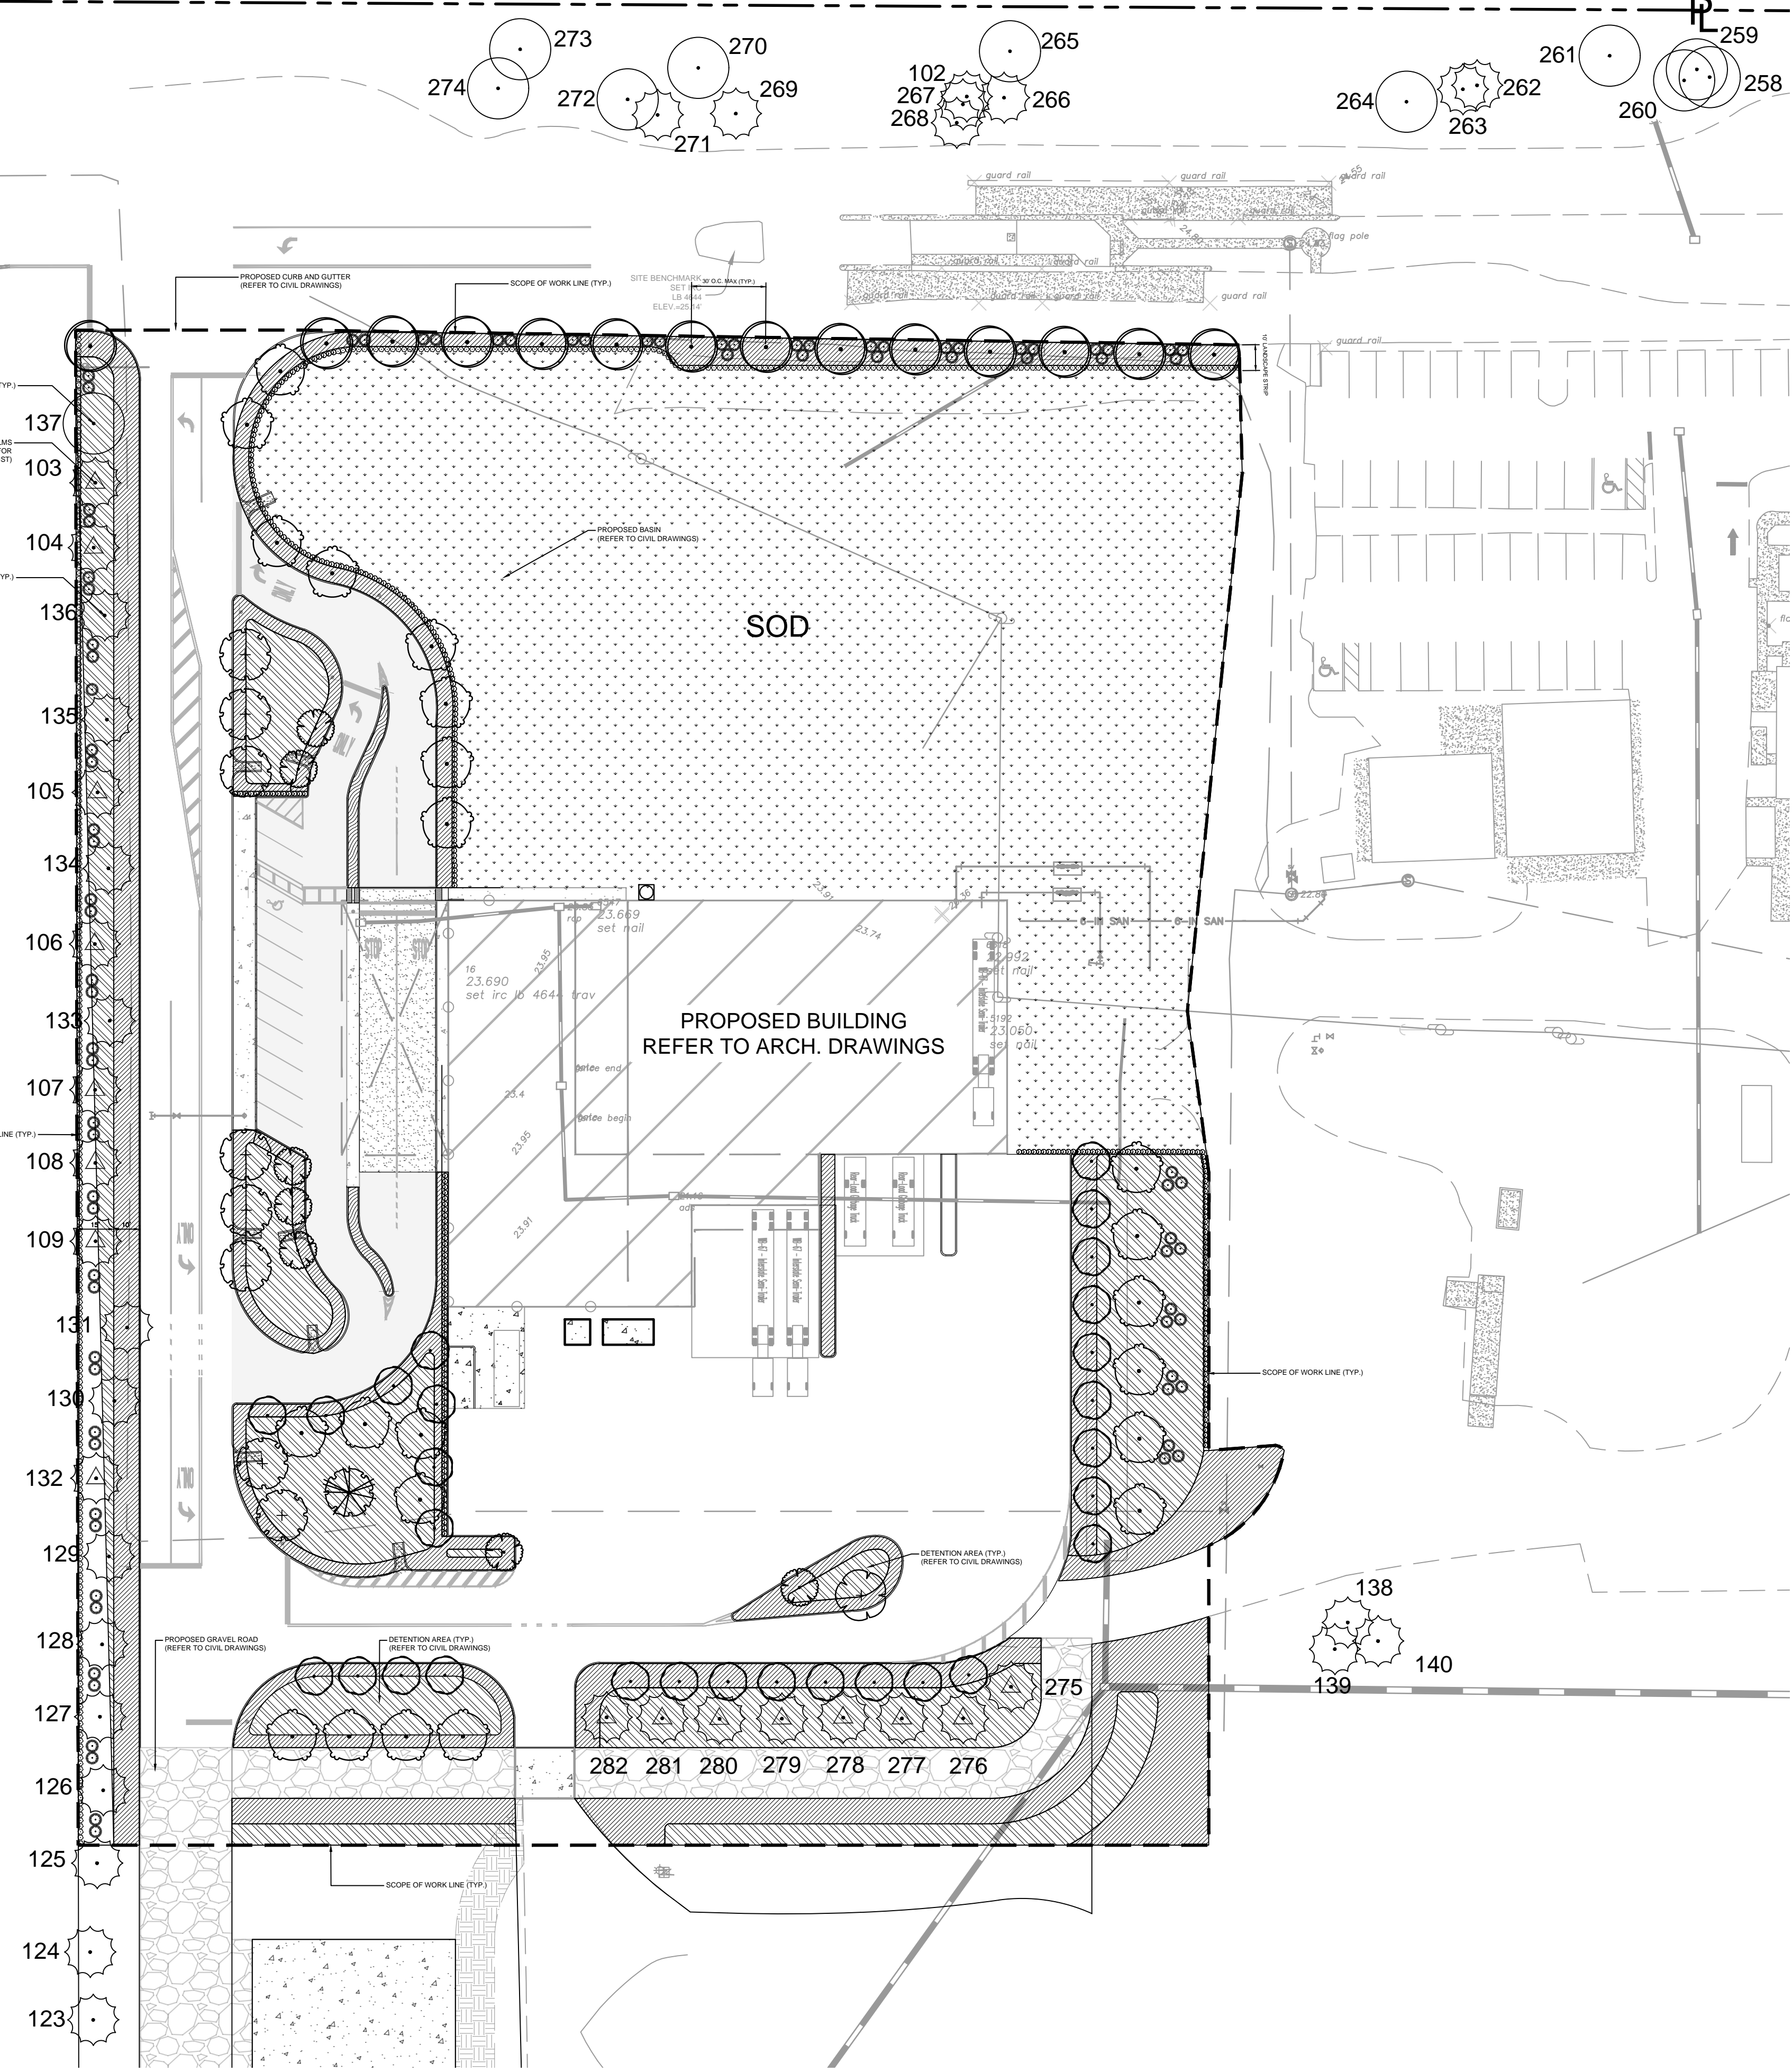

**INDIAN RIVER COUNTY LANDSCAPE CALCULATIONS**

Zoning District: A-1 Net Lot Area: 6.2 Acres or 266,536 SF\*

|  | REQUIRED         | PROVIDED         |
|--|------------------|------------------|
| <b>OPEN SPACE</b>  |                  |                  |
| A. Square feet of open space required by Section 911.06:<br>Open space area = 266,536 x 8% = 21,323 SF   | 21,323 SF        | 139,209 SF**     |
| <b>LAWN AREA CALCULATION</b>   |                  |                  |
| A. Total square feet of landscape open space required by Section 911.06 = 21,323 SF  | 21,323 SF        | 69,879 SF        |
| B. Maximum lawn area permitted = 80% = 17,059 SF   | 17,059 SF        | 69,879 SF        |
| <b>NON-VEHICULAR AREA LANDSCAPING</b>  |                  |                  |
| A. The number of canopy trees required per Section 928.10 (1 Tree/3000 SF of non-vehicular open space) = 46.42   | 47 trees         | 47 trees         |
| Less the existing number of trees that meet minimum requirements   | 0 existing trees | 0 existing trees |
| B. 30% palm trees allowed (three palms = one tree) = 15  | 15 palms         | 47 trees         |
| C. Percentage of native trees required = the number of trees provided / 50% =  | 30 trees         | 47 trees         |
| D. Percentage of low maintenance and drought-tolerant trees = graded trees x 50% =   | 15 trees         | 47 trees         |
| <b>PARKING AREA INTERIOR LANDSCAPING</b>   |                  |                  |
| A. Total square footage of paved areas per Section 928.09 (driving lanes, driveways, parking spaces, loading areas) = 16,122 SF  | 16,122 SF        | 12,919 SF        |
| B. Minimum interior landscaping in parking areas = 12% = total paved areas =   | 12,726 SF        | 12,919 SF        |
| <b>PLANTING ALONG ROADWAYS - NORTH</b>   |                  |                  |
| A. Trees along Exclusive Driveway per Section 928.09 (3.3 Canopy Trees, 6.8 Understory Trees per 100 LF):<br>422 linear feet along north driveway/100 x 3.3 Canopy Trees =     | 14 trees         | 14 trees         |
| 422 linear feet along north driveway/100 x 6.8 Understory Trees =  | 28 trees         | 31 trees         |
| B. Total number of shrubs along the exclusive driveway =   | 189 shrubs       | 175 shrubs       |
| C. The number of shrubs required = 50% = the number of native shrubs required =  | 94 shrubs        | 175 shrubs       |
| <b>PLANTING ALONG ROADWAYS - WEST</b>  |                  |                  |
| A. Trees along Exclusive Driveway per Section 928.09 (3.3 Canopy Trees, 6.8 Understory Trees per 100 LF):<br>597 linear feet along north driveway/100 x 3.3 Canopy Trees =     | 197 trees        | 197 trees        |
| 597 linear feet along north driveway/100 x 6.8 Understory Trees =  | 406 trees        | 406 trees        |
| B. Total number of shrubs along the exclusive driveway =   | 239 shrubs       | 262 shrubs       |
| C. The number of shrubs required = 50% = the number of native shrubs required =  | 119 shrubs       | 262 shrubs       |
| <b>BUILDING PLANTING</b>   |                  |                  |
| A. Total number of required building planting area (760 LF of Facade x 0.4 = 304 LF of Foundation planting):<br>304 LF x 100 LF Avg. Depth Min. = 2640 SF of Planting required | 20 trees         | 20 trees         |
| B. Canopy Trees (1 Tree/50 SF of Required Planting Area) =   | 10 trees         | 15 trees         |
| C. Understory Trees (1 Tree/300 SF of Required Planting Area) =  | 9 trees          | 5 trees          |
| D. Shrubs (15 Shrubs/100 SF of Required Planting Area) =   | 304 shrubs       | 308 shrubs       |
| E. The number of shrubs required = 50% = the number of native shrubs required =  | 152 shrubs       | 308 shrubs       |

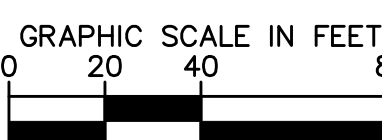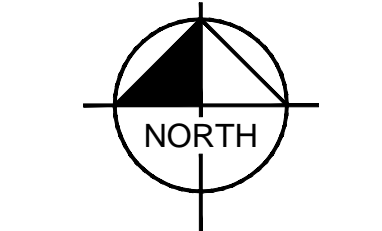

**TREE DISPOSITION GRAPHIC LEGEND**

- SYMBOL DESCRIPTION**
- EXISTING TREE TO REMAIN
  - EXISTING PALM TO REMAIN
  - EXISTING PALM TO RELOCATE
  - TREE PROTECTION FENCE
- LEGEND**
- RIGHT-OF-WAY LINE / PROPERTY LINE
  - PROP. BUILDING OUTLINE
  - PROP. ASPHALT
  - PROP. CONC.
  - PROP. GRAVEL ROAD
  - SCOPE OF WORK LINE

**PLANT SCHEDULE**

| CANOPY TREES        | CODE      | QTY                           | BOTANICAL NAME    | COMMON NAME | CONT.    | CAL / DBH                   | HT       | SPRD   | NATIVE           |          |
|---------------------|-----------|-------------------------------|-------------------|-------------|----------|-----------------------------|----------|--------|------------------|----------|
| BS                  | 22        | BURSERIA SIMARUBA             | GUMBO LIMBO       | FG          | 2" DBH   | 12' HT. MIN. / 5' C.T. MIN. | 4.5' MIN | YES    |                  |          |
| CS                  | 7         | CONOCARPUS ERECTUS SERICEUS   | SILVER BUTTWOOD   | FG          | 2" DBH   | 12' HT. MIN. / 5' C.T. MIN. | 4.5' MIN | YES    |                  |          |
| CU                  | 1         | COCCOLOBA UVIFERA             | SEA GRAPE         | FG          | 2" DBH   | 12' HT. MIN. / 5' C.T. MIN. | 4.5' MIN | YES    |                  |          |
| QV                  | 8         | QUERCUS VIRGINIANA            | SOUTHERN LIVE OAK | FG          | 2" DBH   | 12' HT. MIN. / 5' C.T. MIN. | 4.5' MIN | YES    |                  |          |
| TD                  | 1         | TAXODIUM DISTICHUM            | BALD CYPRESS      | FG          | 2" DBH   | 12' HT. MIN. / 5' C.T. MIN. | 4.5' MIN | YES    |                  |          |
| NARROW CANOPY TREES | CODE      | QTY                           | BOTANICAL NAME    | COMMON NAME | CONT.    | CAL / DBH                   | HT       | SPRD   | NATIVE           |          |
| MF                  | 28        | MYRCIANTHES FRAGRANS          | SIMPSON'S STOPPER | FG          | 2" DBH   | 12' HT. MIN. / 5' C.T. MIN. | 4.5' MIN | YES    |                  |          |
| STREET TREES        | CODE      | QTY                           | BOTANICAL NAME    | COMMON NAME | CONT.    | CAL / DBH                   | HT       | SPRD   | NATIVE           |          |
| QV2                 | 14        | QUERCUS VIRGINIANA            | SOUTHERN LIVE OAK | FG          | 2" DBH   | 12' HT. MIN. / 5' C.T. MIN. | 4.5' MIN | YES    |                  |          |
| SHRUBS              | CODE      | QTY                           | BOTANICAL NAME    | COMMON NAME | CONT.    | SPACING                     | SIZE     | NATIVE | DROUGHT TOLERANT |          |
| CR                  | 308       | CHRYSOBALANUS ICACO 'RED TIP' | RED TIP COCOPLUM  | CONT.       | 24" O.C. | 24" HT MIN                  |          | YES    | YES              |          |
| ROADWAY SHRUBS      | CODE      | QTY                           | BOTANICAL NAME    | COMMON NAME | CONT.    | SPACING                     | SIZE     | NATIVE | DROUGHT TOLERANT |          |
| MF2                 | 427       | MYRCIANTHES FRAGRANS          | SIMPSON'S STOPPER | CONT.       | 24" O.C. | 24" HT MIN                  |          | YES    | YES              |          |
| UNDERSTORY TREES    | CODE      | QTY                           | BOTANICAL NAME    | COMMON NAME | CONT.    | SPACING                     | SIZE     | NATIVE | DROUGHT TOLERANT |          |
| SR                  | 85        | SERENOA REPENS                | SAW PALMETTO      | CONT.       | 36" OC   | 36" HT MIN                  |          | YES    | YES              |          |
| SHRUB AREAS         | CODE      | QTY                           | BOTANICAL NAME    | COMMON NAME | CONT.    | SPACING                     | SIZE     | NATIVE | DROUGHT TOLERANT | SPACING  |
| CN                  | 81        | CLUSIA ROSEA 'NANA'           | DWARF PITCH APPLE | CONT.       | 30" OC   | 18" HT MIN                  |          | YES    | YES              | 30" o.c. |
| TF                  | 4,673     | TRIPSACUM DACTYLOIDES         | FAKAHATCHEE GRASS | CONT.       | 30" OC   | 18" HT.                     |          | YES    | YES              | 30" o.c. |
| GROUND COVERS       | CODE      | QTY                           | BOTANICAL NAME    | COMMON NAME | CONT.    | SPACING                     | SIZE     | NATIVE | DROUGHT TOLERANT |          |
| AG                  | 28,391 SF | ARACHIS GLABRATA              | PERENNIAL PEANUT  | SOD         | SOD      | SOD                         |          | NO     | YES              |          |
| PN                  | 76,418 SF | PASPALUM NOTATUM              | BAHIA GRASS       | PALLET      | SOD      | SOD                         |          | NO     |                  |          |

THIS ITEM HAS BEEN DIGITALLY SIGNED AND SEALED BY MATTHEW VINCENT WISNIEWSKI ON DATE ADJACENT TO SEAL. PRINTED COPIES OF THIS DOCUMENT ARE NOT CONSIDERED SIGNED AND SEALED AND THE SIGNATURE MUST BE VERIFIED ON ANY ELECTRONIC COPIES.

| NO. | REVISIONS | DATE | BY |
|-----|-----------|------|----|
|     |           |      |    |

**Kimley-Horn**  
© 2021 KIMLEY-HORN AND ASSOCIATES, INC.  
355 ALHAMBRA CIRCLE, SUITE 1400, CORAL GABLES, FL 33134  
PHONE: 305-673-2025  
WWW.KIMLEY-HORN.COM REGISTRY 696

**LANDSCAPE ARCHITECT**  
REGISTERED PROFESSIONAL  
No. LA6667406  
STATE OF FLORIDA  
11/17/2021

**LANDSCAPE PLAN**

**IRC LANDFILL**  
PREPARED FOR  
**INDIAN RIVER COUNTY**  
INDIAN RIVER COUNTY  
SHEET NUMBER  
**L-200**


**Sunshine811**  
Call 811 or www.sunshine811.com two full business days before digging to have utilities located and marked.  
Check positive response codes before you dig!

Plotted By: Epi. Carlos, Sheet Set: IRC LANDFILL, Layout: L-201 LANDSCAPE REQUIREMENTS, November 16, 2021, 03:21:45pm, \\kimley-horn.com\F1\MIA\MIB\_G\143228000 - IRC\_HHW\_and\_Recycling\_Facility\_Landscape\CADD\PlanSheets\L-200 LANDSCAPE PLAN.dwg  
 This document, together with the concepts and designs presented herein, is intended only for the specific purpose and client for which it was prepared. Reuse of and improper reliance on this document without written authorization and adaptation by Kimley-Horn and Associates, Inc. shall be without liability to Kimley-Horn and Associates, Inc.

| LANDSCAPING POINTS REQUIREMENTS   |                  |                 |
|---|------------------|-----------------|
| SEC. 926.11<br>LANDSCAPE POINT SYSTEM. NOTWITHSTANDING THE OTHER PROVISIONS OF THIS CHAPTER, EACH LANDSCAPE PLAN MUST SATISFY A MINIMUM OF THIRTY (30) POINTS FROM THE FOLLOWING LIST OF OPTIONS:   |                  |                 |
| DESIGN OPTIONS  | AVAILABLE POINTS | PROVIDED POINTS |
| <b>IRRIGATION SYSTEM:</b>   |                  |                 |
| 1. MOISTURE SENSING CONTROLLER  | 5                |                 |
| 2. PLAN SUBMITTED WITH LOW, MODERATE AND HIGH WATER USAGE ZONES INDICATED   | 5                |                 |
| <b>SHRUBS:</b>  |                  |                 |
| 1. FIFTY (50) TO SEVENTY-FIVE (75) PERCENT OF TOTAL QUANTITY OF PLANTS RATED "VERY DROUGHT TOLERANT"  | 5                |                 |
| 2. SEVENTY-SIX (76) TO ONE HUNDRED (100) PERCENT OF TOTAL QUANTITY OF PLANTS RATED "VERY DROUGHT TOLERANT"  | 10               | 10              |
| <b>TREES:</b>   |                  |                 |
| 1. FIFTY (50) TO SEVENTY-FIVE (75) PERCENT OF TOTAL QUANTITY OF TREES RATED "VERY DROUGHT TOLERANT"   | 5                |                 |
| 2. SEVENTY-SIX (76) TO ONE HUNDRED (100) PERCENT OF TOTAL QUANTITY OF TREES RATED "VERY DROUGHT TOLERANT"   | 10               | 10              |
| <b>EXTRA SHADE/CANOPY TREES IN VEHICULAR USE AREAS:</b>   |                  |                 |
| 1. TWENTY (20) TO FORTY (40) PERCENT MORE THAN REQUIRED   | 5                |                 |
| 2. MORE THAN FORTY (40) PERCENT MORE THAN REQUIRED  | 10               |                 |
| <b>SOD/GRASS AREAS:</b>   |                  |                 |
| 1. THIRTY-ONE (31) TO FIFTY (50) PERCENT OF LANDSCAPE AREA  | 5                | 5               |
| 2. LESS THAN THIRTY (30) PERCENT OF LANDSCAPE AREA  | 10               |                 |
| <b>FLORIDA NATIVE LANDSCAPE:</b>  |                  |                 |
| 1. ONE HUNDRED (100) PERCENT OF LANDSCAPE AREA IS PRESERVED OR RE-ESTABLISHED FLORIDA NATIVE VEGETATION, OR NEW NATIVE PLANTINGS OF SPECIES LISTED IN APPENDIX A AND APPENDIX C. PLAN MUST INCLUDE TREES, UNDERSTORY, AND GROUNDCOVER WITH A MAXIMUM OF FIFTY (50) PERCENT OF SITE SODDED/GRASSED                     | 30               | 30              |
| 2. SEVENTY-FIVE (75) TO NINETY-NINE (99) PERCENT OF LANDSCAPE AREA IS PRESERVED OR RE-ESTABLISHED FLORIDA NATIVE VEGETATION, OR NEW NATIVE PLANTINGS OF SPECIES LISTED IN APPENDIX A AND APPENDIX C. PLAN MUST INCLUDE TREES, UNDERSTORY, AND GROUNDCOVER WITH A MAXIMUM OF FIFTY (50) PERCENT OF SITE SODDED/GRASSED | 15               |                 |
| * THE LIST OF DROUGHT TOLERANT NATURAL GRASS, SHRUBS, AND TREE SPECIES IS CONTAINED IN WATERWISE, THE SOUTH FLORIDA WATER MANAGEMENT DISTRICT PLANT AND LANDSCAPE PRACTICES GUIDE, AS MAY BE AMENDED. THESE SPECIES SHOULD HOWEVER, NOT INCLUDE INVASIVE SPECIES.   | TOTAL            | 55              |

THIS ITEM HAS BEEN DIGITALLY SIGNED AND SEALED BY MATTHEW VINCENT WISNIEWSKI. DATE ADJACENT TO SEAL.  
 PRINTED COPIES OF THIS DOCUMENT ARE NOT CONSIDERED SIGNED AND SEALED AND THE SIGNATURE MUST BE VERIFIED ON ANY ELECTRONIC COPIES.  
 THE SEAL APPEARING ON THIS DOCUMENT WAS AUTHORIZED BY MATTHEW VINCENT WISNIEWSKI. DATE ADJACENT TO SEAL.

KHA PROJECT  
 14-3228000  
 DATE  
 JULY 2021  
 SCALE AS SHOWN  
 DESIGNED BY MRG  
 DRAWN BY RMR  
 CHECKED BY BFB

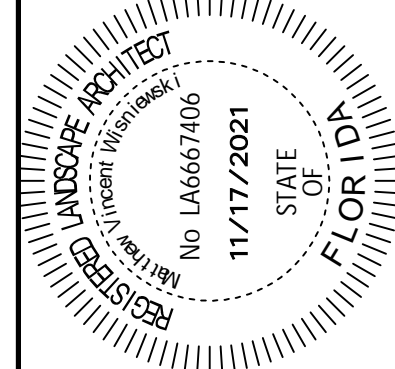

| No. | REVISIONS | DATE | BY |
|-----|-----------|------|----|
|     |           |      |    |
|     |           |      |    |
Call 811 or www.sunshine811.com two full business days before digging to have utilities located and marked.  
 Check positive response codes before you dig!


IRC LANDFILL  
 PREPARED FOR  
 INDIAN RIVER COUNTY  
 INDIAN RIVER COUNTY  
 FL

LANDSCAPE  
 REQUIREMENTS

SHEET NUMBER  
**L-201**




Plotted By: Epi, Carlos, Sheet Set: IRC LANDFILL, Layout: L-250 DETAILS, November 16, 2021, 03:21:45pm, \\kimley-horn.com\F\1\MA\MB-Civil\43228000 - IRC HW and Recycling Facility\Landscaping\CADD\PlanSheets\L-200 LANDSCAPE PLAN.dwg  
 This document, together with the concepts and designs presented herein, is intended only for the specific purpose and client for which it was prepared. Reuse of and improper reliance on this document without written authorization and adaptation by Kimley-Horn and Associates, Inc. shall be without liability to Kimley-Horn and Associates, Inc.

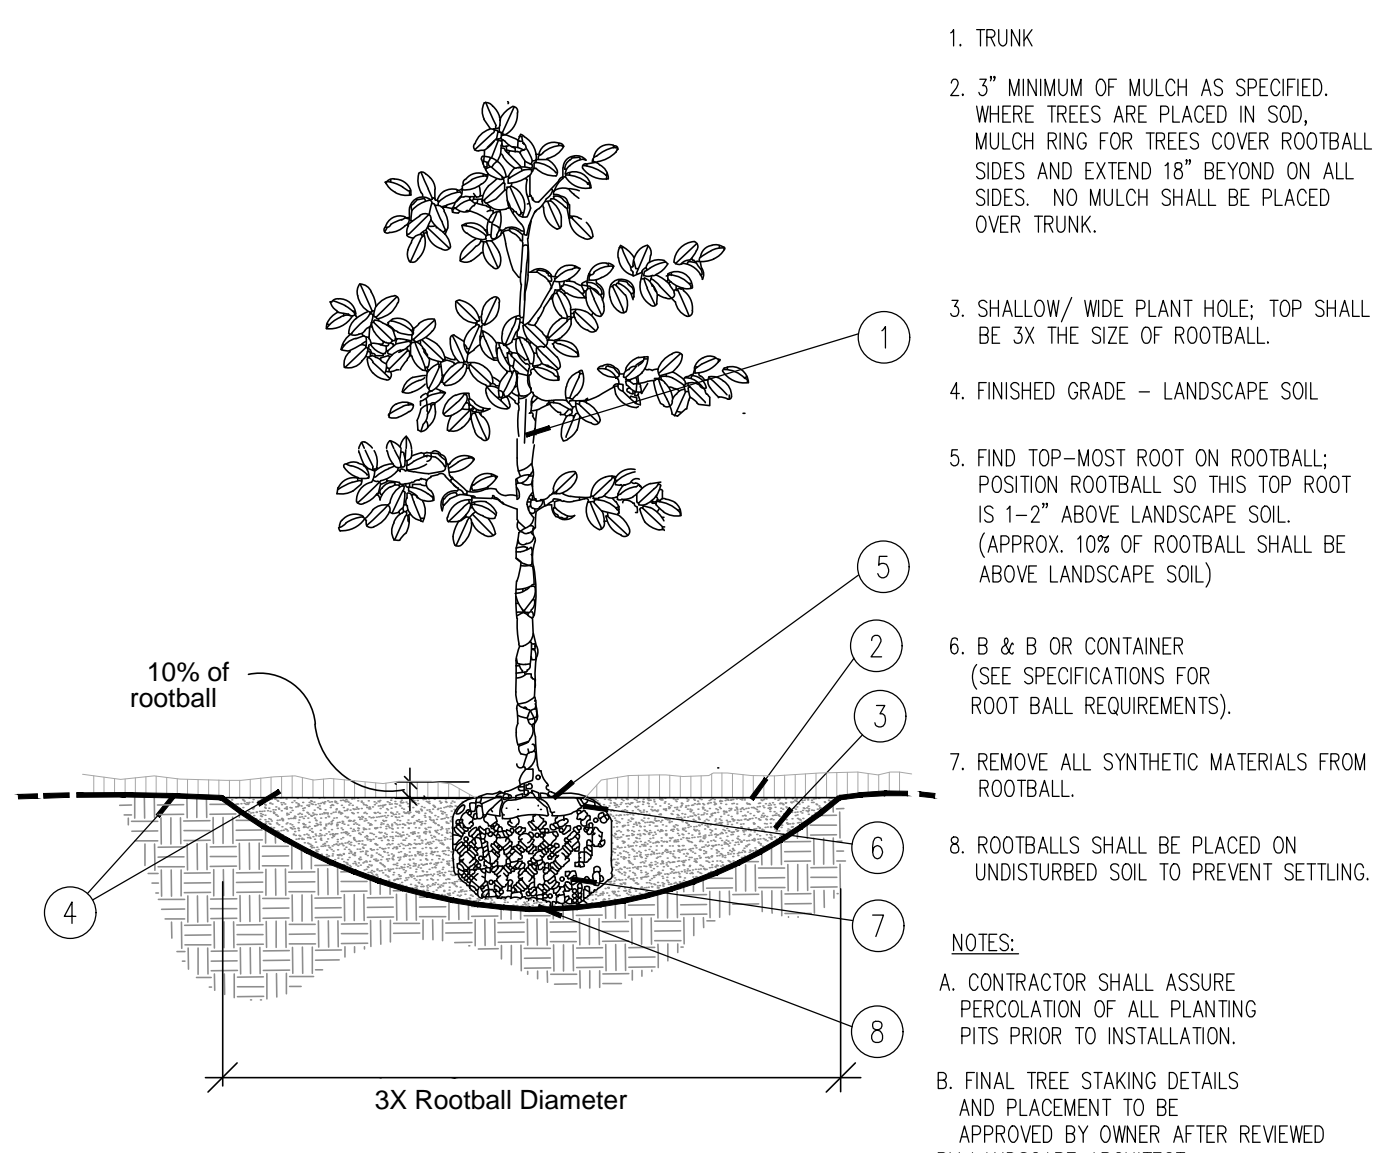


1. TRUNK
  2. 3" MINIMUM OF MULCH AS SPECIFIED, WHERE TREES ARE PLACED IN SOIL. MULCH RING FOR TREES COVER ROOTBALL SIDES AND EXTEND 18" BEYOND ON ALL SIDES. NO MULCH SHALL BE PLACED OVER TRUNK.
  3. SHALLOW/ WIDE PLANT HOLE; TOP SHALL BE 3X THE SIZE OF ROOTBALL.
  4. FINISHED GRADE - LANDSCAPE SOIL
  5. FIND TOP-MOST ROOT ON ROOTBALL; POSITION ROOTBALL SO THIS TOP ROOT IS 1-2" ABOVE LANDSCAPE SOIL. (APPROX. 10% OF ROOTBALL SHALL BE ABOVE LANDSCAPE SOIL)
  6. B & B OR CONTAINER (SEE SPECIFICATIONS FOR ROOT BALL REQUIREMENTS).
  7. REMOVE ALL SYNTHETIC MATERIALS FROM ROOTBALL.
  8. ROOTBALLS SHALL BE PLACED ON UNDISTURBED SOIL TO PREVENT SETTLING.
- NOTES:
- A. CONTRACTOR SHALL ASSURE PERCOLATION OF ALL PLANTING PITS PRIOR TO INSTALLATION.
  - B. FINAL TREE STAKING DETAILS AND PLACEMENT TO BE APPROVED BY OWNER AFTER REVIEWED BY LANDSCAPE ARCHITECT.
  - C. CONTRACTOR SHALL PAINT ALL STAKES BENJAMIN MOORE, EXTERIOR GRADE PAINT FLAT MATTE BLACK, 2 COATS.
  - D. SEE ALTERNATE STAKING METHODS, THIS SHEET.
- \* ALL TREES SHALL BE PLUMB VERTICALLY WITHIN A TOLERANCE OF THREE DEGREES, UNLESS OTHERWISE DIRECTED BY OWNER'S REPRESENTATIVE.

**A** Tree Planting  
SECTION  
NTS

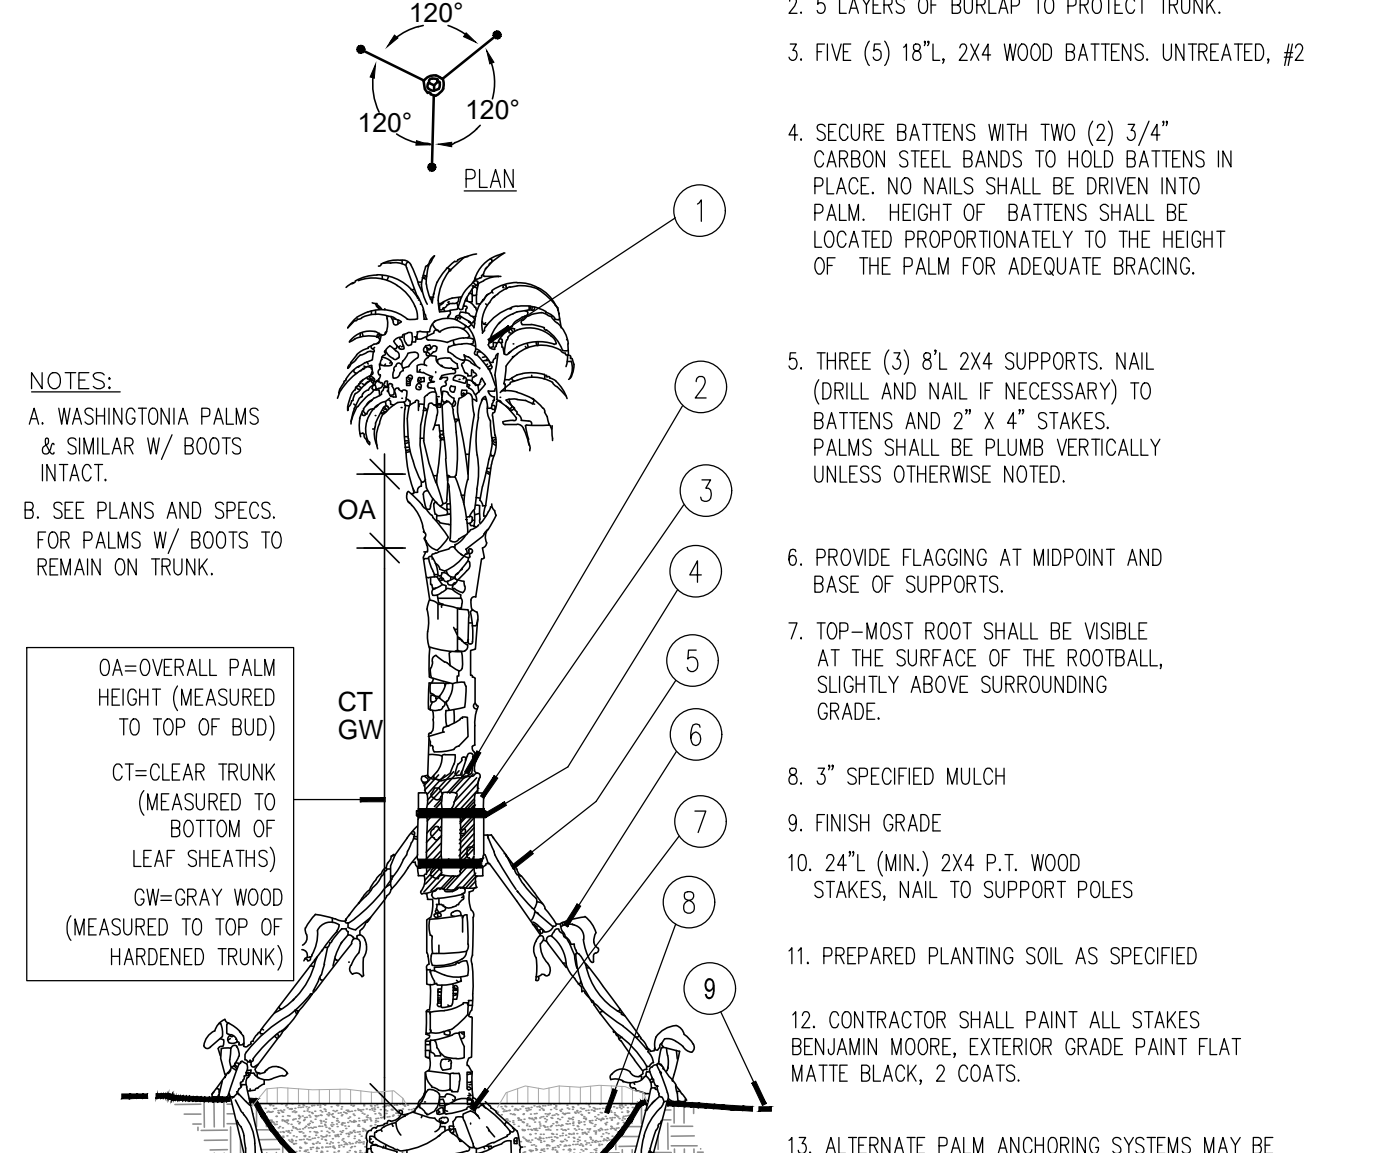


- NOTES:
- A. WASHINGTONIA PALMS & SIMILAR W/ BOOTS INTACT.
  - B. SEE PLANS AND SPECS. FOR PALMS W/ BOOTS TO REMAIN ON TRUNK.
- OA=OVERALL PALM HEIGHT (MEASURED TO TOP OF BUD)  
 CT=CLEAR TRUNK (MEASURED TO BOTTOM OF LEAF SHEATHS)  
 GW=GRAY WOOD (MEASURED TO TOP OF HARDENED TRUNK)
1. MINIMUM OF NINE (9) GOOD PALM FRONDS; PRUNE AND THE FRONDS WITH HEMP TWINE. SABAL PALMS TO BE SELECTIVELY "HURRICANE CUT", LEAVING ONLY NEWLY- EMERGING GROWTH.
  2. 5 LAYERS OF BURLAP TO PROTECT TRUNK.
  3. FIVE (5) 18"L, 2X4 WOOD BATTENS, UNTREATED, #2
  4. SECURE BATTENS WITH TWO (2) 3/4" CARBON STEEL BANDS TO HOLD BATTENS IN PLACE. NO NAILS SHALL BE DRIVEN INTO PALM. HEIGHT OF BATTENS SHALL BE LOCATED PROPORTIONATELY TO THE HEIGHT OF THE PALM FOR ADEQUATE BRACING.
  5. THREE (3) 8'L 2X4 SUPPORTS, NAIL (DRILL AND NAIL IF NECESSARY) TO BATTENS AND 2" X 4" STAKES. PALMS SHALL BE PLUMB VERTICALLY UNLESS OTHERWISE NOTED.
  6. PROVIDE FLAGGING AT MIDPOINT AND BASE OF SUPPORTS.
  7. TOP-MOST ROOT SHALL BE VISIBLE AT THE SURFACE OF THE ROOTBALL, SLIGHTLY ABOVE SURROUNDING GRADE.
  8. 3" SPECIFIED MULCH
  9. FINISH GRADE
  10. 24"L (MIN.) 2X4 P.T. WOOD STAKES, NAIL TO SUPPORT POLES
  11. PREPARED PLANTING SOIL AS SPECIFIED
  12. CONTRACTOR SHALL PAINT ALL STAKES BENJAMIN MOORE, EXTERIOR GRADE PAINT FLAT MATTE BLACK, 2 COATS.
  13. ALTERNATE PALM ANCHORING SYSTEMS MAY BE SUBSTITUTED UPON APPROVAL BY OWNER OR OWNER'S REPRESENTATIVE AFTER REVIEW BY LANDSCAPE ARCHITECT
- ALTERNATE SYSTEMS:  
 \*BROOKS TREE BRACE SYSTEM  
 \*ARBOR TIE TREE BRACING

**B** Palm Planting and Staking  
SECTION  
NTS

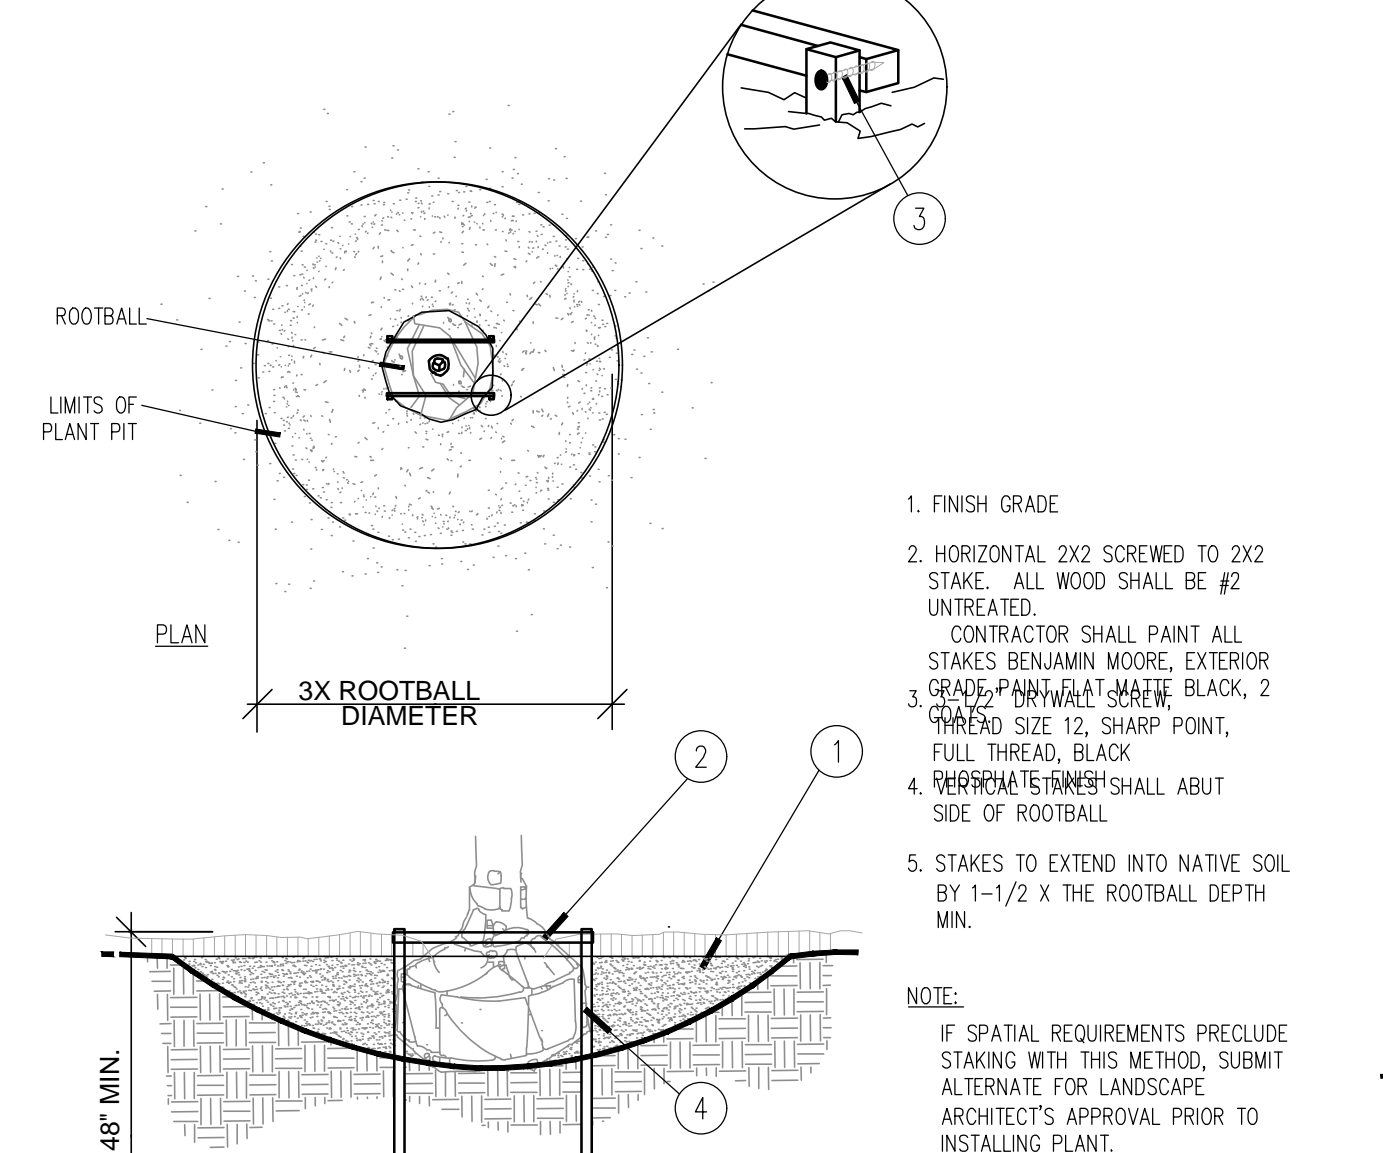


1. FINISH GRADE
  2. HORIZONTAL 2X2 SCREWED TO 2X2 STAKE. ALL WOOD SHALL BE #2 UNTREATED.
  3. CONTRACTOR SHALL PAINT ALL STAKES BENJAMIN MOORE, EXTERIOR GRADE PAINT FLAT MATTE BLACK, 2 COATS.
  4. STAKES SHALL BE PLUMB VERTICALLY, FULL THREAD, BLACK
  5. STAKES TO EXTEND INTO NATIVE SOIL BY 1-1/2 X THE ROOTBALL DEPTH MIN.
- NOTE:  
 IF SPATIAL REQUIREMENTS PRECLUDE STAKING WITH THIS METHOD, SUBMIT ALTERNATE FOR LANDSCAPE ARCHITECT'S APPROVAL PRIOR TO INSTALLING PLANT.
- \* Refer to details B and E for planting

**C** Staking - up to 65 gal. or B&B to 3-1/2" Cal.  
PLAN/SECTION  
NTS

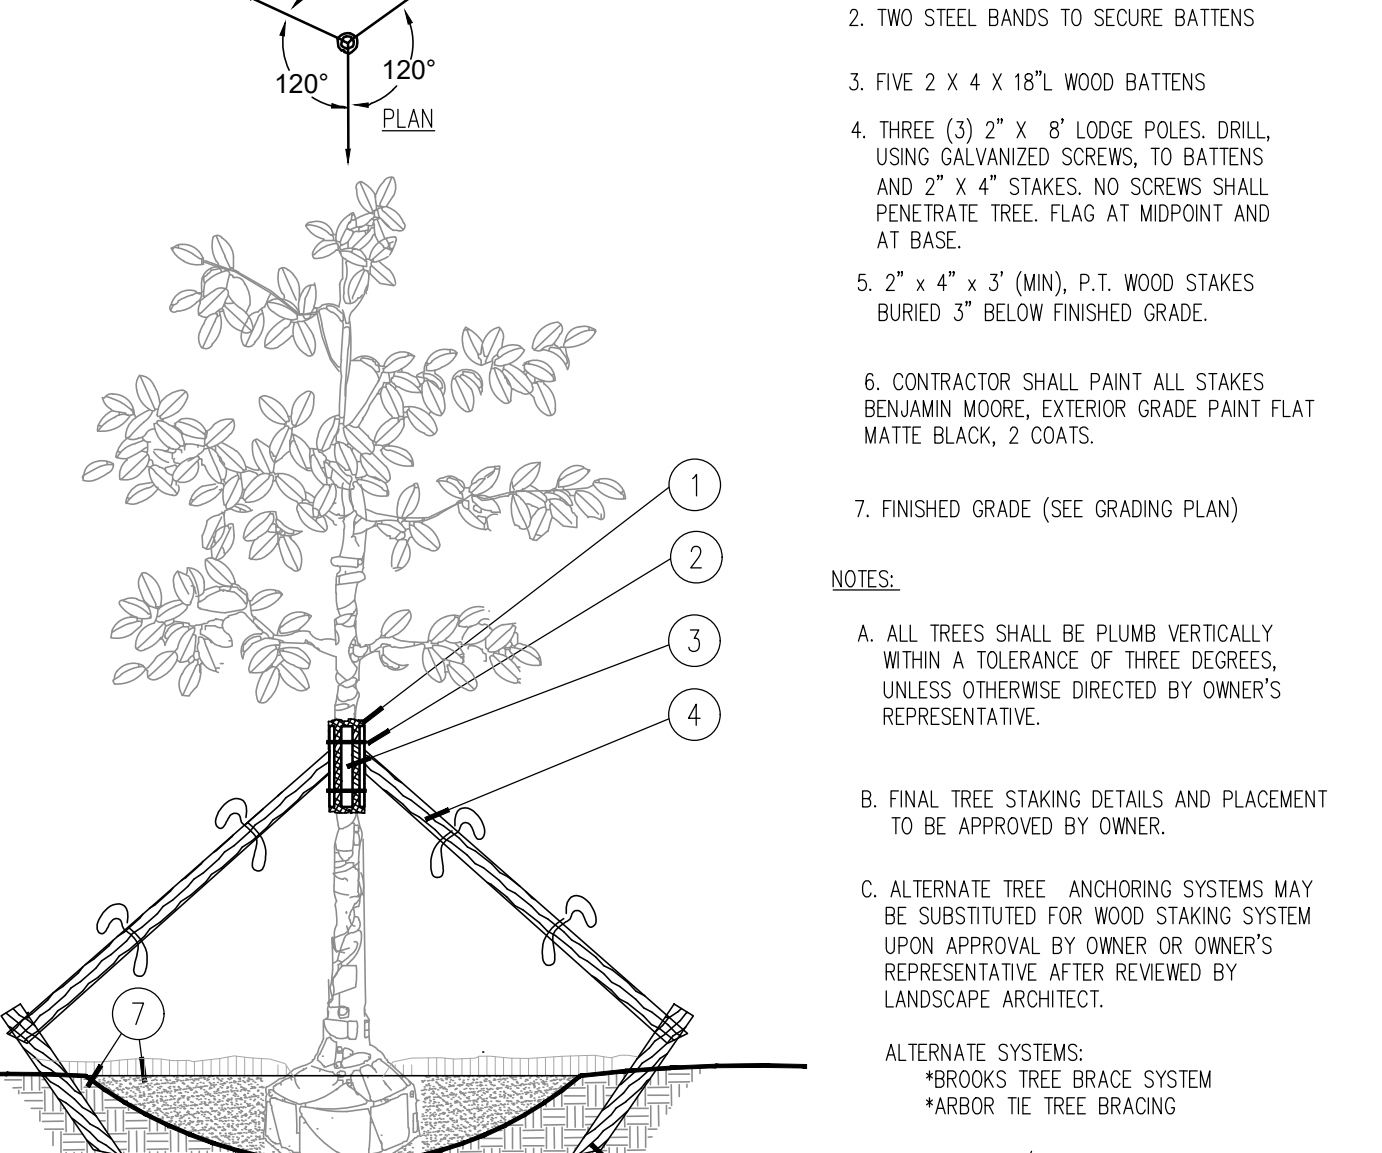


1. FIVE (5) LAYERS OF BURLAP TO PROTECT TRUNK
  2. TWO STEEL BANDS TO SECURE BATTENS
  3. FIVE 2 X 4 X 18", WOOD BATTENS
  4. THREE (3) 2" X 8" LODGE POLES, DRILL USING GALVANIZED SCREWS, TO BATTENS AND 2" X 4" STAKES. NO SCREWS SHALL PENETRATE TREE. FLAG AT MIDPOINT AND AT BASE.
  5. 2" X 4" X 3' (MIN), P.T. WOOD STAKES BURIED 3" BELOW FINISHED GRADE.
  6. CONTRACTOR SHALL PAINT ALL STAKES BENJAMIN MOORE, EXTERIOR GRADE PAINT FLAT MATTE BLACK, 2 COATS.
  7. FINISHED GRADE (SEE GRADING PLAN)
- NOTES:
- A. ALL TREES SHALL BE PLUMB VERTICALLY WITHIN A TOLERANCE OF THREE DEGREES, UNLESS OTHERWISE DIRECTED BY OWNER'S REPRESENTATIVE.
  - B. FINAL TREE STAKING DETAILS AND PLACEMENT TO BE APPROVED BY OWNER.
  - C. ALTERNATE TREE ANCHORING SYSTEMS MAY BE SUBSTITUTED FOR WOOD STAKING SYSTEM UPON APPROVAL BY OWNER OR OWNER'S REPRESENTATIVE AFTER REVIEWED BY LANDSCAPE ARCHITECT.
  - D. ALTERNATE SYSTEMS:  
 \*BROOKS TREE BRACE SYSTEM  
 \*ARBOR TIE TREE BRACING
- \* Refer to details B and D for planting

**D** Large Tree Staking - 100 Gal + or B&B 4" +  
SECTION  
NTS

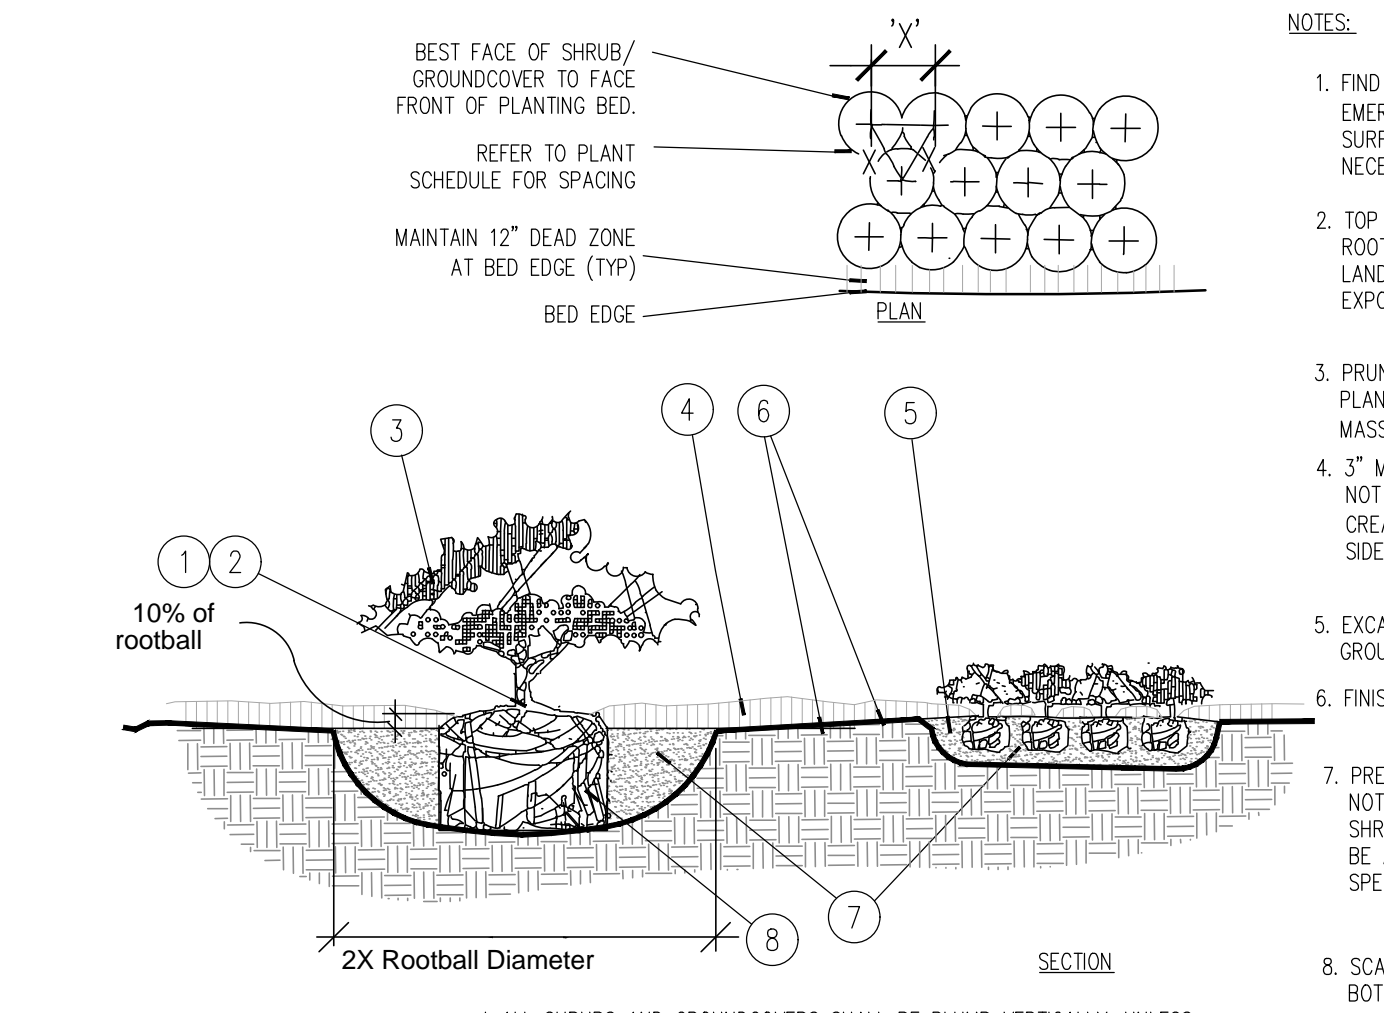


- NOTES:
1. FIND POINT WHERE TOPMOST ROOT EMERGES FROM TRUNK WITHIN 2" OF SURFACE. CLEAR EXCESS SOIL IF NECESSARY.
  2. TOP 10% OF SHRUB AND GROUNDCOVER ROOTBALLS TO BE PLANTED ABOVE THE LANDSCAPE GRADE. DO NOT COVER EXPOSED 10% ON SIDES WITH SOIL.
  3. PRUNE ALL LIKE SHRUBS WITHIN A PLANTED MASS TO ACHIEVE A UNIFORM MASS/HEIGHT.
  4. 3" MINIMUM MULCH AS SPECIFIED - DO NOT COVER ENTIRE SHRUB ROOTBALL OR CREATE "WATER RINGS" ONLY COVER SIDES OF ROOTBALL WITH MULCH
  5. EXCAVATE ENTIRE BED SPECIFIED FOR GROUNDCOVER BED.
  6. FINISHED GRADE (SEE GRADING PLAN).
  7. PREPARED PLANTING SOIL AS SPECIFIED. NOTE: WHEN GROUND- COVERS AND SHRUBS USED IN MASSES, ENTIRE BED TO BE AMENDED WITH PLANTING SOIL MIX AS SPECIFIED.
  8. SCARIFY ROOTBALL SIDES AND BOTTOM.
- \* ALL SHRUBS AND GROUNDCOVERS SHALL BE PLUMB VERTICALLY, UNLESS OTHERWISE DIRECTED BY OWNER'S REPRESENTATIVE.

**E** Shrub / Groundcover Planting  
PLAN/SECTION  
NTS

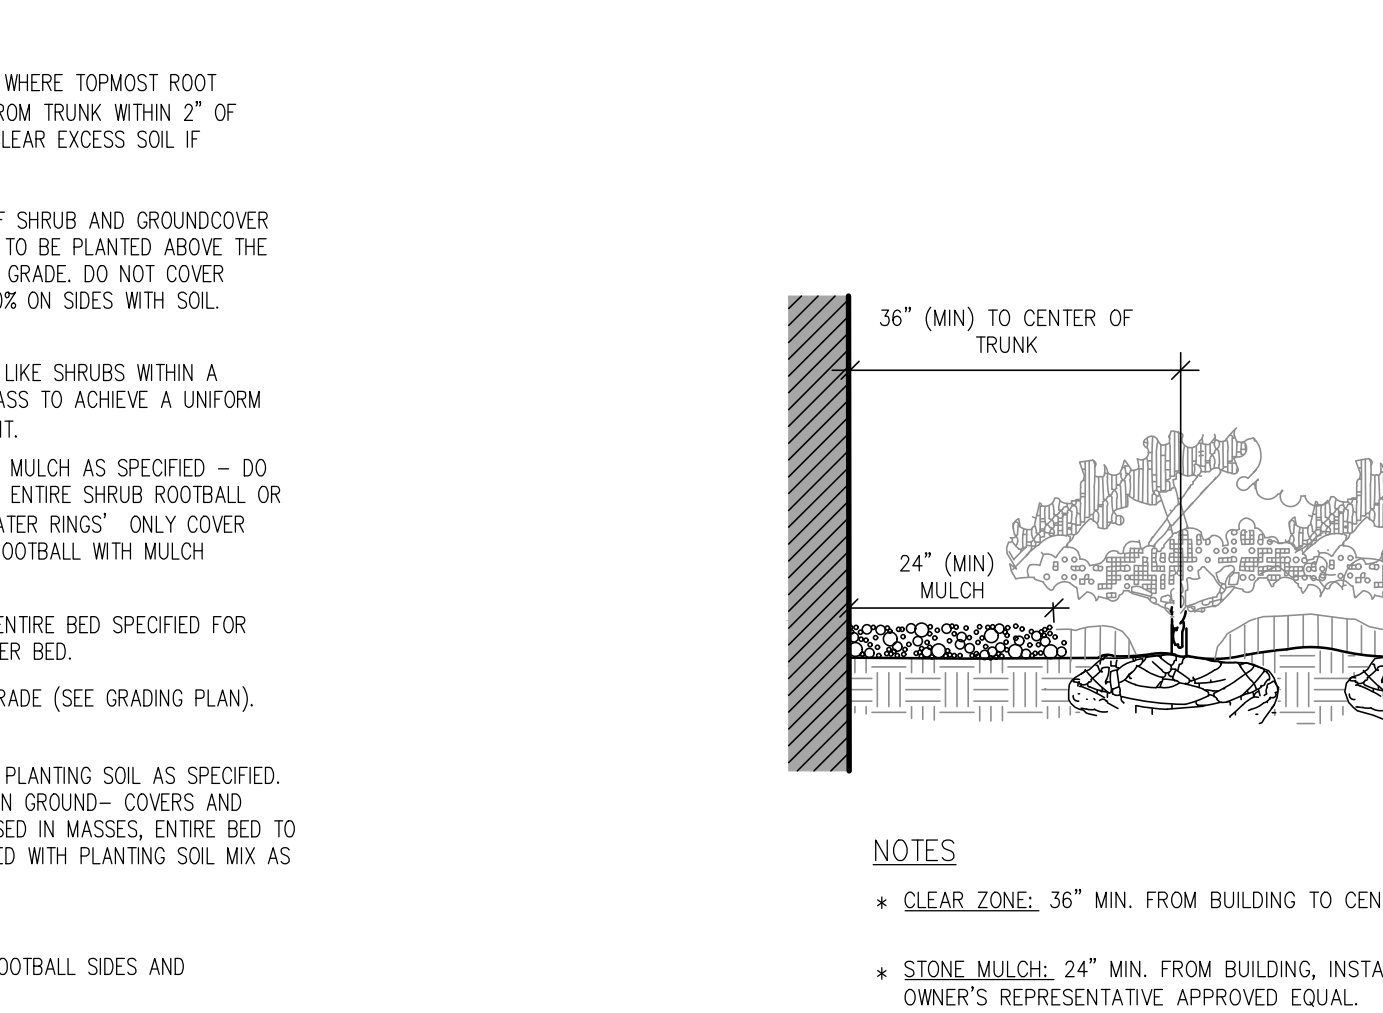

- NOTES:
- \* CLEAR ZONE: 36" MIN. FROM BUILDING TO CENTER OF NEAREST SHRUB.
  - \* STONE MULCH: 24" MIN. FROM BUILDING, INSTALL STONE MULCH. MULCH TYPE TO BE GRAY GRANITE OR OWNER'S REPRESENTATIVE APPROVED EQUAL. STONE MULCH TO BE INSTALLED TO A DEPTH OF 3" (MIN.) CONTRACTOR SHALL SUBMIT SAMPLE FOR APPROVAL.

**F** Plantings Adjacent to Buildings  
SECTION  
NTS

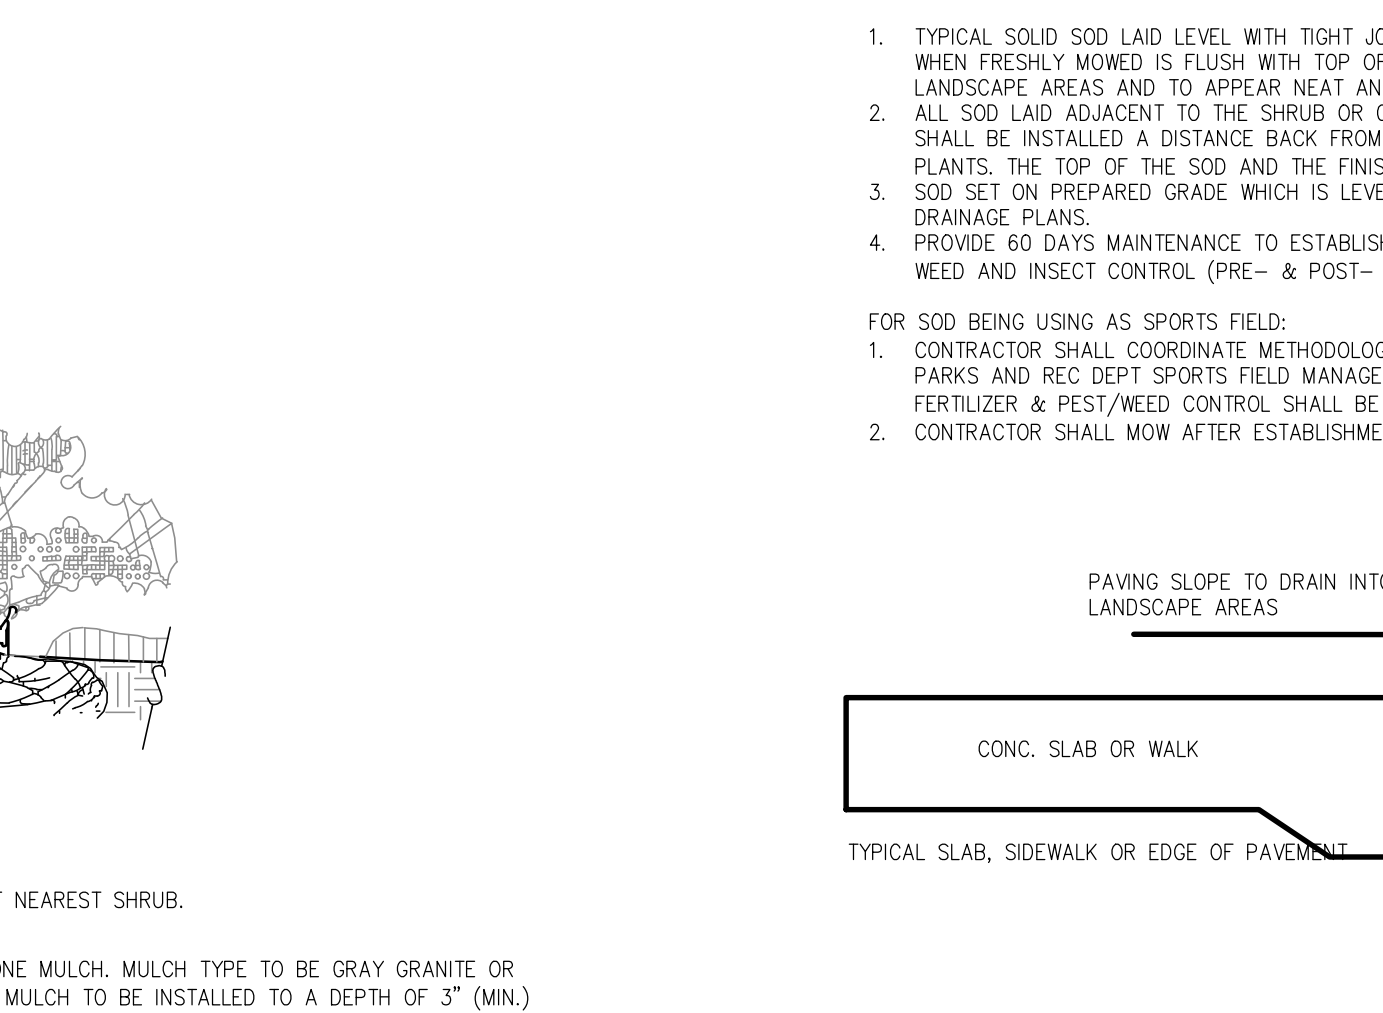

1. TYPICAL SOLID SOD LAID LEVEL WITH TIGHT JOINTS SET ADJACENT TO EDGE OF PAVEMENT SUCH THAT THE TOP OF SOD WHEN FRESHLY MOWED IS FLUSH WITH TOP OF PAVEMENT IN ORDER NOT TO IMPEDE THE FLOW OF RUNOFF INTO LANDSCAPE AREAS AND TO APPEAR NEAT AND WELL MAINTAINED.
  2. ALL SOD LAD ADJACENT TO THE SHRUB OR GROUNDCOVER PLANTING AREAS SHALL HAVE WELL DEFINED BEDLINES, AND SHALL BE INSTALLED A DISTANCE BACK FROM THE FACE EDGE OF PLANT MATERIALS TO ALLOW FOR GROWTH OF THE PLANTS. THE TOP OF THE SOD AND THE FINISHED GRADE OF THE 2" MULCH COVER SHALL BE FLUSH AND LEVEL.
  3. SOD SET ON PREPARED GRADE WHICH IS LEVEL OR GRADED TO MEET THE REQUIREMENTS OF THE ENGINEERED SITE DRAINAGE PLANS.
  4. PROVIDE 60 DAYS MAINTENANCE TO ESTABLISH THE NEW SOD. MAINTENANCE INCLUDES ROLLING, FERTILIZING MONTHLY, WEED AND INSECT CONTROL (PRE- & POST- EMERGENT), MOWING WITH REEL TYPE MOWERS, TRIMMING, AND EDGING.
- FOR SOD BEING USING AS SPORTS FIELD:  
 1. CONTRACTOR SHALL COORDINATE METHODOLOGY FOR INSTALLATION & SOD GROWING PERIOD PERIOD WITH CITY OF MIAMI'S PARKS AND REC DEPT SPORTS FIELD MANAGER PRIOR TO PROCUREMENT & INSTALLATION. ALL PRODUCTS, INCLUDING FERTILIZER & PEST/WEED CONTROL, SHALL BE APPROVED BY CITY OF MIAMI SPORTS FIELD MANAGER.  
 2. CONTRACTOR SHALL MOW AFTER ESTABLISHMENT PERIOD TO NO HIGHER THAN 1" PER CITY OF MIAMI, PARKS & REC. DEPT.

**G** Typical Sod Planting Detail  
SECTION  
NTS

|     |           |      |
|-----|-----------|------|
| NO. | REVISIONS | DATE |
|     |           |      |
|     |           |      |
|     |           |      |

**Kimley-Horn**

© 2021 KIMLEY-HORN AND ASSOCIATES, INC.  
 355 ALHAMBRA CIRCLE, SUITE 1400, CORAL GABLES, FL 33134  
 PHONE: 305-673-2025  
 WWW.KIMLEY-HORN.COM REGISTRY 696

LANDSCAPE ARCHITECT  
 REGISTERED PROFESSIONAL  
 No. LA6667406  
 11/17/2021  
 STATE OF FLORIDA  
 FLOOR 10C

KHA PROJECT  
 14-3228000  
 DATE  
 JULY 2021  
 SCALE AS SHOWN  
 DESIGNED BY MW  
 DRAWN BY CT  
 CHECKED BY MW

LANDSCAPE DETAILS

THIS ITEM HAS BEEN DIGITALLY SIGNED AND SEALED BY MATTHEW VINCENT WISNIEWSKI LA6667406 ON DATE ADJACENT TO SEAL.

PRINTED COPIES OF THIS DOCUMENT ARE NOT CONSIDERED SIGNED AND SEALED AND THE SIGNATURE MUST BE VERIFIED ON ANY ELECTRONIC COPIES.

IRC LANDFILL  
 PREPARED FOR  
 INDIAN RIVER COUNTY  
 INDIAN RIVER COUNTY

SHEET NUMBER  
**L-250**


**Sunshine811**

Call 811 or www.sunshine811.com two full business days before digging to have utilities located and marked.  
 Check positive response codes before you dig!



Plotted By: Ftp: Carlos Sheet Set: IRC LANDFILL Layout: IR-301 IRRIGATION November 16, 2021 03:28:38pm Kimley-Horn and Associates, Inc. This document, together with the concepts and designs presented herein, is intended only for the specific purpose and client for which it was prepared. Reuse of and improper reliance on this document without written authorization and adaptation by Kimley-Horn and Associates, Inc. shall be without liability to Kimley-Horn and Associates, Inc.

13TH ST SW

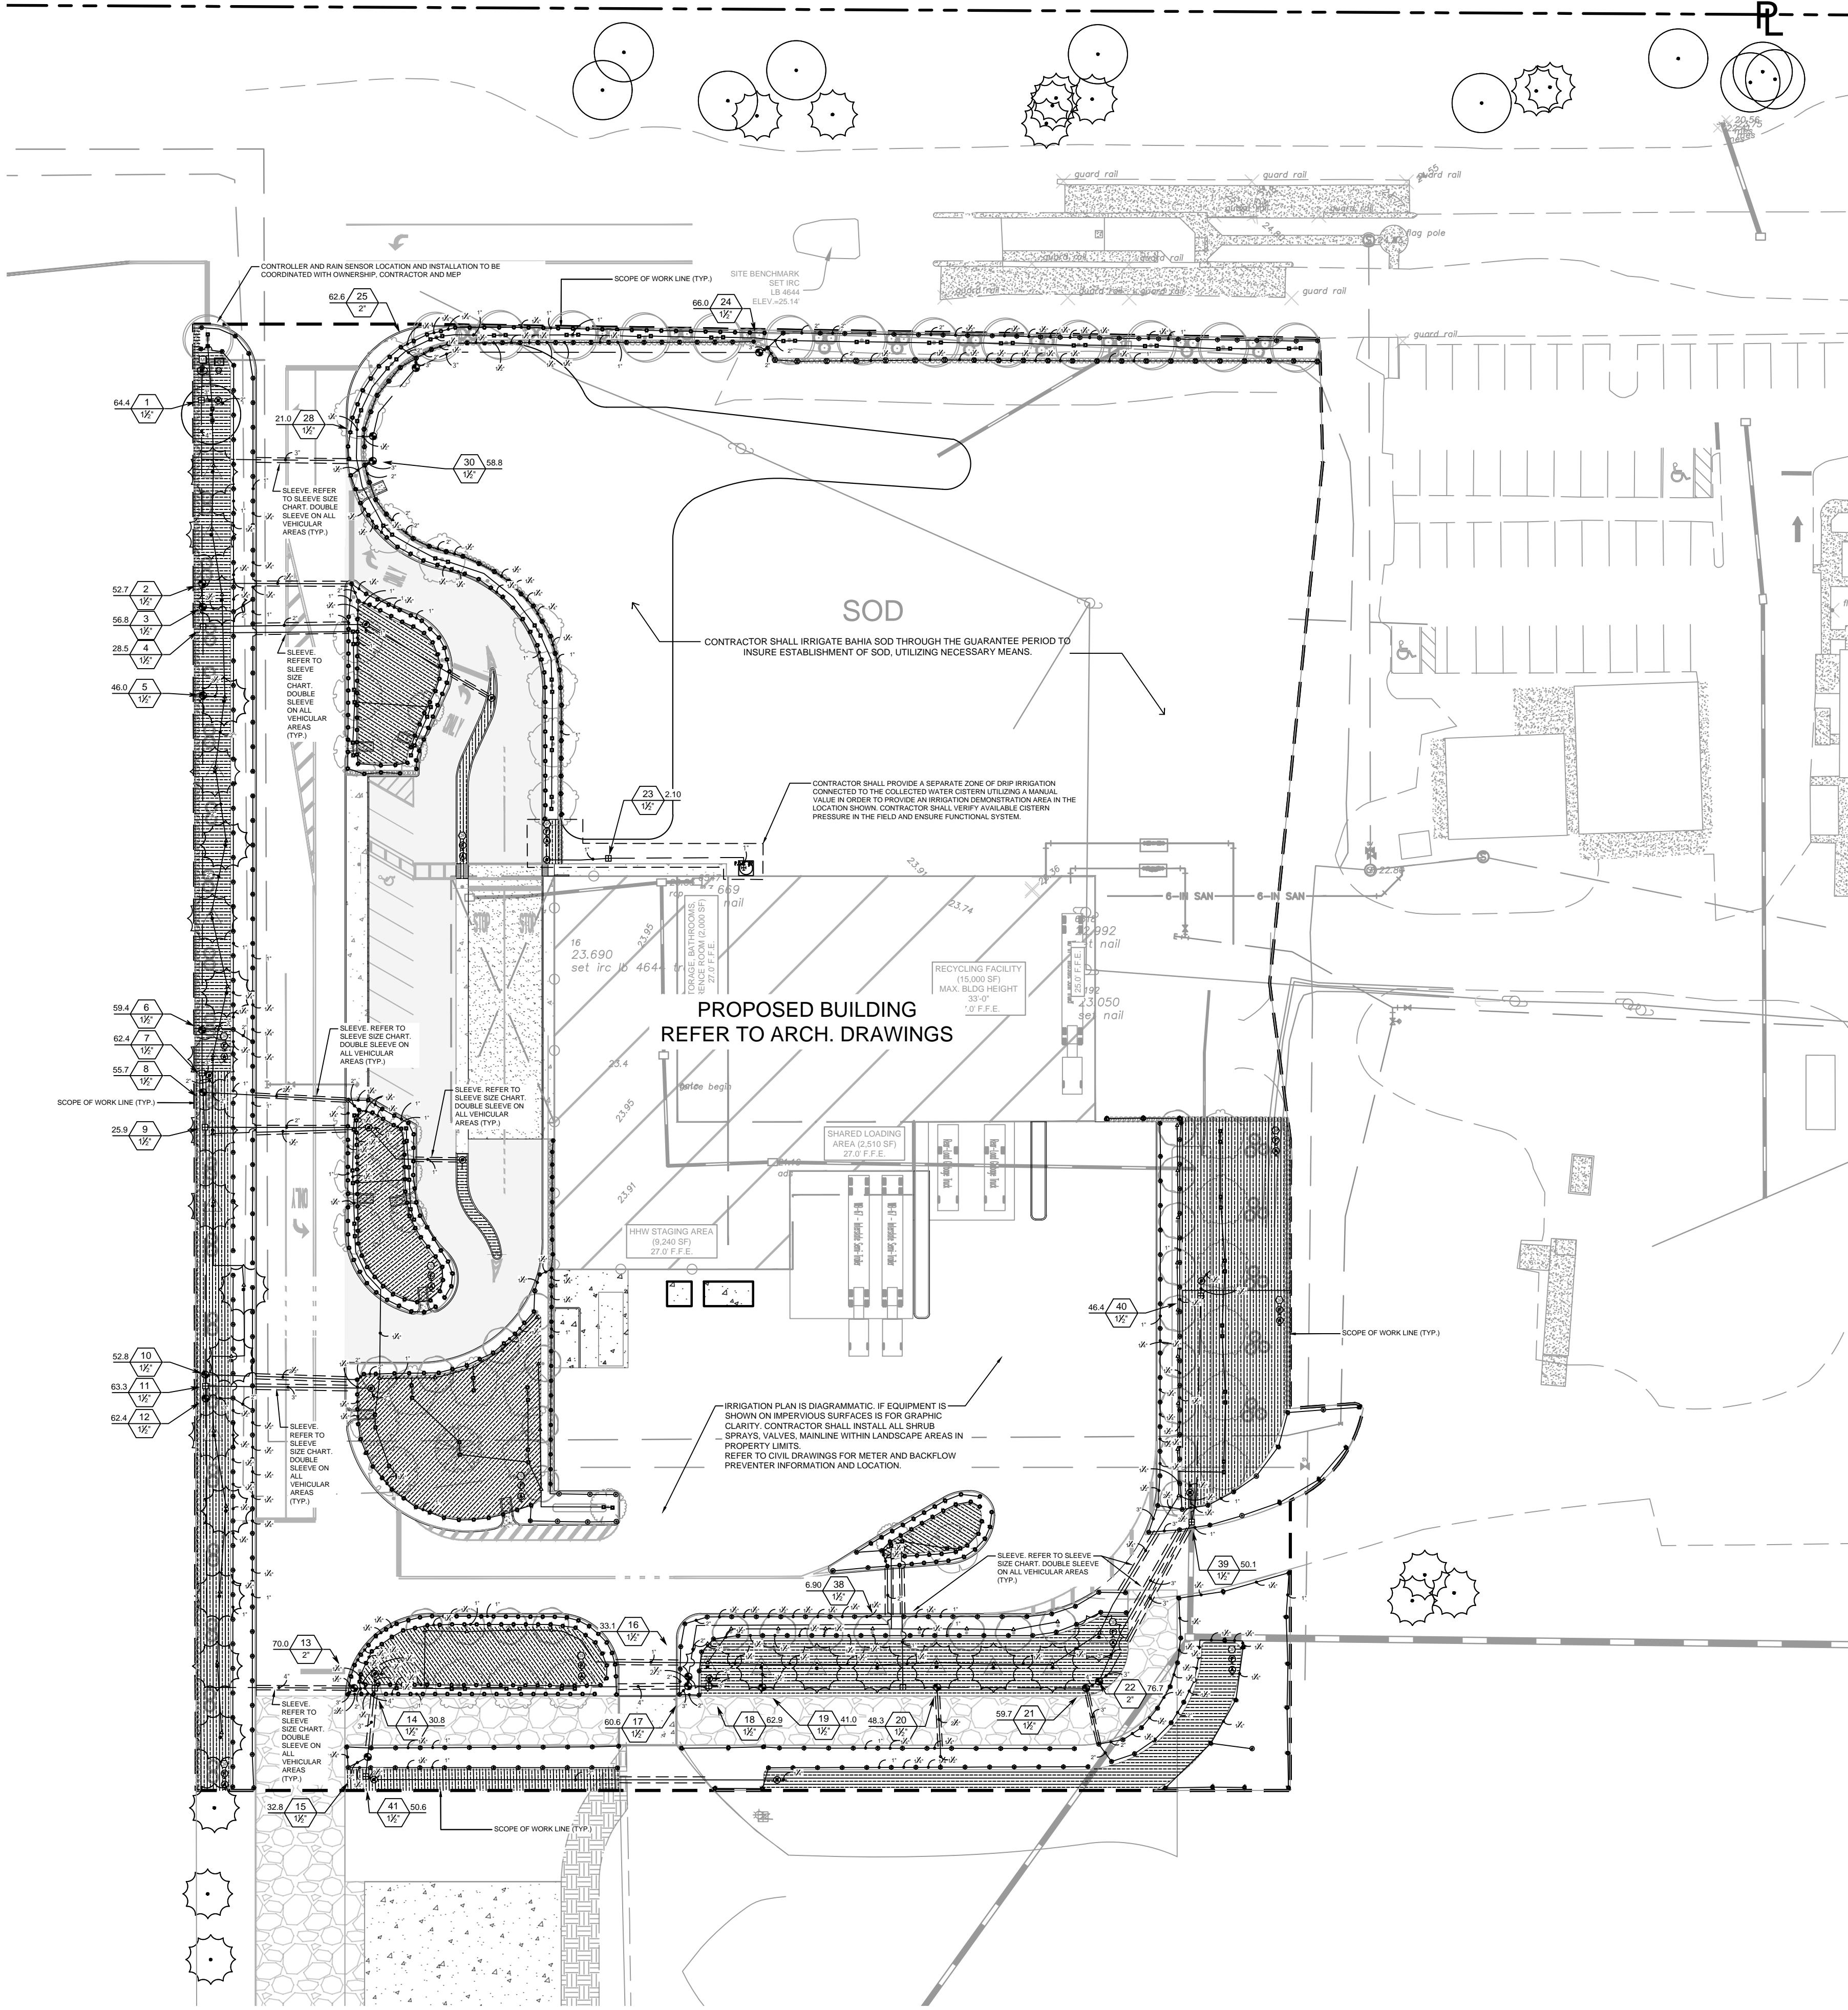


IRRIGATION SCHEDULE

Table with 3 columns: SYMBOL, MANUFACTURER/MODEL/DESCRIPTION, and QTY. Lists various irrigation equipment like rainbird sprinklers, valves, and pipe fittings.

LEGEND

- RAW - RIGHT-OF-WAY LINE / PROPERTY LINE
PROP. BUILDING OUTLINE
PROP. ASPHALT
PROP. CONC.
PROP. GRAVEL ROAD
SCOPE OF WORK LINE

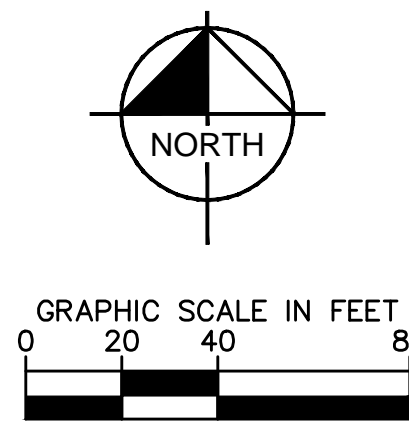

SLEEVE CHART table with 2 columns: PIPE SIZE and SLEEVE SIZE. Lists sleeve sizes for various pipe diameters.

IRRIGATION NOTES

- 1. REFER TO LANDSCAPE PLANS FOR THE LOCATIONS OF PLANTING MATERIAL.
2. INSTALLATION WORK SHALL BE COORDINATED WITH OTHER CONTRACTORS IN SUCH A MANNER AS TO ALLOW FOR SPEEDY AND ORDERLY COMPLETION OF ALL WORK ON THIS SITE.
3. ALL PROPOSED TREES AND SHRUBS SHALL BE IRRIGATED BY A 100% AUTOMATIC UNDERGROUND IRRIGATION SYSTEM.
... (notes 4-29)

PRINTED COPIES OF THIS DOCUMENT ARE NOT CONSIDERED SIGNED AND SEALED AND THE SIGNATURE MUST BE VERIFIED ON ANY ELECTRONIC COPIES.

Table with columns: NO., REVISIONS, DATE. Shows revision history.

Kimley-Horn logo and contact information: 355 ALHAMBRA CIRCLE, SUITE 1400, CORAL GABLES, FL 33134

Professional engineer seal for Matthew Vincent Wisniewski, No. LA6667406, State of Florida, dated 11/17/2021.

Project information: KHA PROJECT 14-3228000, DATE JULY 2021, SCALE AS SHOWN, DESIGNED BY MW, DRAWN BY CT, CHECKED BY MW.

IRC LANDFILL PREPARED FOR INDIAN RIVER COUNTY INDIAN RIVER COUNTY SHEET NUMBER L-300

Sunshine 811 logo and contact info: Call 811 or www.sunshine811.com two full business days before digging to have utilities located and marked. Check positive response codes before you dig!

Plotted By: Epiq. Carlos. Sheet Set: IRC LANDFILL. Layout: IR-350 SPECS. November 16, 2021. 03:22:42pm. \\kimley-horn.com\FL\MIA\MIB\_Civil\43228000 --- IRC HHW and Recycling Facility\Landscaping\CAD\PlanSheets\IR-350 IRRIGATION PLAN.dwg

This document, together with the concepts and designs presented herein, is intended only for the specific purpose and client for which it was prepared. Reuse of and improper reliance on this document without written authorization and adaptation by Kimley-Horn and Associates, Inc. shall be without liability to Kimley-Horn and Associates, Inc.

**UNDERGROUND IRRIGATION SYSTEM**

**PART I: GENERAL**  
**1.01 SCOPE**

- A. The work covered by this specification shall include the furnishing of all labor, materials, tools and equipment necessary to perform and complete the installation of an automatic irrigation system as specified herein and as shown on the drawings and any incidental work not shown or specified which can reasonably be determined to be part of the work and necessary to provide a complete and functional system.
- B. The work covered by this specification also includes all permits, federal, state and local taxes and all other costs, both foreseeable and unforeseeable at the time of construction.
- C. No deviation from these specifications, the accompanying drawings, or agreement is authorized or shall be made without prior written authorization signed by the Owner or his duly appointed representative.

**1.02 QUALITY ASSURANCE**

- D. **Installer Qualifications:** A firm specializing in irrigation work with not less than five (5) years of experience in installing irrigation systems similar to those required for this project.
- E. **Coordination:** Coordinate and cooperate with other contractors to enable the work to proceed as rapidly and efficiently as possible.
- F. **Inspection of Site:** The Contractor shall acquaint himself with all site conditions, including underground utilities before construction is to begin. Contractor shall coordinate placement of underground materials with contractors previously working underground in the vicinity or those scheduled to do underground work in the vicinity. Contractor is responsible for minor adjustments in the layout of the work to accommodate existing facilities.
- G. **Protection of Existing Plants and Site Conditions:** The Contractor shall take necessary precautions to protect site conditions to remain. Should damages be incurred, this Contractor shall repair the damage to its original condition at his own expense. Any disruption, destruction, or disturbance of any existing plant, tree, shrub, or turf, or any structure shall be completely restored to the satisfaction of the Owner and his representatives, solely at the Contractor's expense.
- H. **Protection of Work and Property:** The Contractor shall be liable for and shall take the following actions as required with regard to damage to any of the Owner's property.

- 1. Any existing building, equipment, piping, pipe coverings, electrical systems, sewers, sidewalks, roads, grounds, landscaping or structure of any kind (including without limitation, damage from leaks in the piping system being installed or having been installed by Contractor) damaged by the Contractor, or by his agents, employees, or subcontractors, during the course of his work, whether through negligence or otherwise, shall be replaced or repaired by Contractor at his own expense in a manner satisfactory to Owner, which repair or replacement shall be a condition precedent to Owner's obligation to make final payment under the Contract.

- 2. Contractor shall also be responsible for damage to any work covered by these specifications before final acceptance of the work. He shall securely cover all openings into the systems and cover all apparatus, equipment and appliances, both before and after being set in place to prevent obstructions on the pipes and the breakage, misuse or disfigurement of the apparatus, equipment or appliance.

- 3. All trenching or other work under the leaf canopy of any and all trees shall be done by hand or by other methods so that no branches are damaged in any way.

Buildings, walks, walls, and other property shall be protected from damage. Open ditches left exposed shall be flagged and barricaded by the Contractor by approved means. The Contractor shall restore disturbed areas to their original condition.

- 4. The Contractor shall be responsible for requesting the proper utility company to stake the exact location of any underground lines including but not limited to electric, gas, telephone service, water, and cable.

The Contractor shall take whatever precautions are necessary to protect these underground lines from damage. In the event damage does occur, all damage shall be completely repaired to its original condition, at no additional cost to the Owner.

- 5. The Contractor shall request the Owner, in writing, to locate any private utilities (i.e., electrical service to outside lighting) before proceeding with any excavation. If, after such requests and necessary staking, private utilities which were not staked are encountered and damaged by the Contractor, they shall be repaired by the Owner at no cost to the Contractor. If the Contractor damages staked or located utilities, they shall be repaired at the Contractor's expense.

- J. **Codes and Inspections:** The entire installation shall comply fully with all local and state laws and ordinances and with all established codes arrange for all necessary inspections and shall pay all fees and expenses in connection with same, as part of the work under this Contract. Upon completion of the work, he shall furnish to the "Owner" all inspection certificates customarily issued in connection with the class of work involved.

- K. The Contractor shall keep on his work, during its progress, a competent superintendent and any necessary assistants, all satisfactory to the Owner, or Owner's representative.

- L. The superintendent shall represent the Contractor in his absence and all directions given to him shall be as binding as if given to the Contractor.

- M. The Owner's Landscape Architect or designated individual shall have full authority to approve or reject work performed by the Contractor. The Owner's Authorized Representative shall also have full authority to make field changes that are deemed necessary.

- N. **Final Acceptance:** Final acceptance of the work may be obtained from the Owner upon the satisfactory completion of all work. Acceptance by the Landscape Architect and/or Owner in no way removes the Contractor of his responsibility to make further repairs, corrections and adjustments to eliminate any deficiencies which may later be discovered.

- O. **Guarantee:** All work shall be guaranteed for one year from date of final acceptance against all defects in material, equipment and workmanship to the satisfaction of the Owner. Repairs, if required, shall be done promptly at no cost to the Owner.

- 1. The guarantee shall also cover repair of damage to any part of the premises resulting from leaks or workmanship, to the satisfaction of the Owner. The Contractor shall not be responsible for work damaged by others. Repairs, if required, shall be done promptly. The guarantee shall state the name of the Owner, provide full guarantee terms, effective and termination date, name and license number of Contractor providing guarantee, address, and telephone number. It shall be signed by the chief executive of the Contractor of his liability under the guarantee. Such warranties shall only supplement the guarantee.

- 2. If, within ten (10) days after mailing of written notice by the Owner to the Contractor requesting repairs or replacement resulting from a breach of warranty, the Contractor shall neglect to make or undertake with due diligence to make the same, the Owner may make such repairs at the Contractor's expense; provided, however, that in the case of emergency where, in the judgment of the Owner, delay would cause serious loss or damage, repairs or replacement may be made without notice being sent to the Contractor, and Contractor shall pay the cost thereof.

- P. The Contractor shall provide full, 100% irrigation coverage in all areas designed with proposed plantings, in accordance with the site's governing permitting requirements and as designed.

- Q. On-site Observation: At any time during the installation of the irrigation system by the Contractor, the Owner or Landscape Architect may visit the site to observe work underway. Upon request, the Contractor shall be required to uncover specified work as directed by the Owner or material, workmanship or method of installation not meet the standards specified herein, the Contractor shall replace the work at his own expense.

- R. **Workmanship:** All work shall be installed by qualified, skilled personnel, proficient in the trades required, in a neat, orderly, and responsible manner with recognized standards of workmanship. The Contractor shall have had considerable experience and demonstrated ability in the installation of sprinkler irrigation systems of this type.

**1.04 SUBMITTALS**

All materials shall be those specified and/or approved by the Landscape Architect.

- A. **Product Data:** After the award of the Contract and prior to beginning work, the Contractor shall submit for approval by the Owner and Landscape Architect, two copies of the complete list of materials, manufacturer's technical data, and installation instructions which he proposes to install.

- B. Commence no work before approval of material list and descriptive material by the Landscape Architect.

- C. **Record Drawings:** The Contractor shall record on reproducibles, all changes that may be made during actual installation of the system. Provide controller sequencing and control valve locations.

- 1. Immediately upon installation of any piping, valves, wiring, sprinklers, etc., in locations other than shown on the original drawings or of sizes other than indicated, the Contractor shall clearly indicate such changes on a set of blue-line prints. Records shall be made on a daily basis. All records shall be neat and subject to the approval of the Owner.

- 2. The Contractor shall also indicate on the record prints the location of all wire splices, original or due to repair, that are installed underground in a location other than the controller pedestal, remote control valve box, power source or connection to a valve-in-head sprinkler.

- 3. These drawings shall also serve as work progress sheets. The Contractor shall make neat and legible notations review daily as the work proceeds, showing the work as actually installed. These drawings shall be available at all times for review and shall be kept in a location designated by the Owner's Representative.

- 4. Progress payment request and record drawing information must be approved by Landscape Architect before payment is made.

- 5. If in the opinion of the Owner or his representative, the record drawing information is not being properly or promptly recorded, construction payment may be stopped until the proper information has been recorded and submitted.

- 6. Before the date of the final site observation and approval, the Contractor shall deliver one set (copies) of reproducible record drawing plans and notes to the Landscape Architect. Record drawing information shall be approved by the Landscape Architect prior to submittal to Owner for final payments, including retentions.

- D. The contractor shall provide detailed engineered shop drawings for irrigation system design for review and approval by landscape architect prior to procurement and fabrication of system. The contractor shall certify in writing that the irrigation system provided in shop drawing complies with Section 926.11 Irrigation Standards.

- E. **Operations and Maintenance Manuals:** The Contractor shall prepare and deliver to the Owner, or his designated representative within ten (10) calendar days prior to completion of construction, a hard cover binder with three rings containing the following information:

- 1. Index sheet stating the Contractor's address and business telephone number, list of equipment with name(2) and address(es) of local manufacturer's representative(s).

- 2. Catalog and parts sheets on every material and equipment installed under this Contract.

- 3. Complete operating and maintenance instruction on all major equipment. Include initial controller schedule and recommended schedule after establishment period.

- 4. Demonstrate to and provide the Owner's maintenance personnel with instructions for major equipment and show evidence in writing to the Owner, or his designated representative at the conclusion of the project that this service has been rendered.

**1.05 EXPLANATION OF DRAWINGS**

- A. Due to the scale of the drawings, it is not possible to indicate all offsets, fittings and sleeves which may be required. The Contractor shall carefully investigate the structural and finished conditions affecting all of the work and plan his work accordingly, furnishing such offsets, fittings and sleeves as may be required to meet such conditions.

- B. The drawings are generally diagrammatic and indicative of the work to be installed. The work shall be installed in such a manner as to avoid conflicts between irrigation systems, planting and architectural features. Deviations shall be brought to the Landscape Architects attention.

- C. All work called for on the drawings by notes or details shall be furnished and installed whether or not specifically mentioned in the specifications.

- D. The Contractor shall not willfully install the irrigation system as shown on the drawings when it is obvious in the field that obstructions, grade differences or discrepancies in area dimensions exist that might not have been known in engineering. Such obstructions or differences should be brought to the attention of the Landscape Architect. In the event that notification is not performed, the Contractor shall assume full responsibility for any revision necessary.

- E. If, in the opinion of the Landscape Architect, the labor furnished by the Contractor is incompetent, unskilled, or unreliable, his equipment inadequate, improper or unsafe, or if the Contractor shall fail to continuously and diligently execute the construction, the Landscape Architect or Owner shall, in writing, instruct the Contractor to remove all such causes of noncompliance and the Contractor shall promptly comply.

- F. The Contractor shall be responsible for full and complete coverage of all irrigation areas. The Landscape Architect shall be notified of any necessary adjustments at no additional cost to the Owner. Any revisions to the irrigation system must be submitted and answered in written form, along with any change in Contract price. Layout may be modified, if necessary to obtain coverage. Spacing not to exceed 60% of the diameter.

**PART II: PRODUCTS**

**2.01 MATERIALS**

Material and equipment shall be supplied by the Contractor. No substitutions shall be allowed without the prior written approval of the Owner/Landscape Architect. The Contractor shall inspect all materials and equipment prior to installation, and defective materials shall be replaced with the proper materials and equipment. Those items used in the installation found to be defective, improperly installed or not as specified, shall be removed and the proper materials and equipment installed in the proper manner, as interpreted by the Owner/Landscape Architect. The Contractor shall remove all damaged and defective pipe and equipment from the site.

**2.02 PIPING**

- A. **General Provisions:** All materials throughout the system shall be new and in perfect condition unless otherwise directed by the Landscape Architect.

- B. **Polyvinyl Chloride Pipe (PVC):** (Where indicated on plan, use non-potable purple piping.)

- 1. **Laterals:** PVC shall conform to the requirements of ASTM Designation D 2241, Class 1120 or 1220. All lateral piping less than 3" in diameter shall be Class 200 SDR-21.

- 2. **Main Line Under Pressure:** PVC shall conform to the requirements of ASTM Designation D 2241, Class 1120 or 1220, Schedule 40 with belled end for solvent weld connection.

- 3. **Pipe Markings:** All PVC pipe shall bear the following markings:

- o Manufacturer's Name
- o Nominal Pipe Size
- o Schedule or Class
- o Pressure Rating of PSI
- o NSF (National Sanitation Foundation) Approval
- o Date of Extrusion

**2.04 PVC JOINTS**

Joints in PVC pipe smaller than 3" shall be solvent welded in accordance with the recommendations of the pipe manufacturer; the solvent cleaner and welding compound furnished with the pipe.

**2.05 THREADED CONNECTIONS**

- A. Threaded PVC connections shall be made up using Teflon tape only.

- B. Connection between mainline pipe fittings and automatic or manual control valves shall be made using Schedule 80 threaded fittings and nipples.

**2.06 SOLVENT CEMENT**

- A. **General:** Provide solvent cement and primer for PVC solvent weld pipe and fittings recommended by the manufacturer. Pipe joints for solvent weld pipe to be belled end. Pipe joints for gasketed pipe to be intricate ring type. Insert gaskets will not be accepted.

- B. **Thrust Blocks:** Main line piping 3" or greater in diameter shall have thrust blocks sized and placed in accordance with the pipe manufacturer's recommendations or, in the absence of specified recommendations by the pipe manufacturer. 3000 PSI concrete thrusts shall be properly installed at tees, elbows, 45's, crosses, reducers, plugs, caps and valves.

**2.07 PIPE AND WIRE SLEEVES**

- A. Sleeves to be installed:

- 1. The Contractor shall install irrigation system pipe and wire sleeves conforming to the following:

- a. All pipe sleeves shall extend a minimum of 36" beyond the edges of pavement.

- b. All pipe sleeves to be installed beneath future/existing road surfaces shall be PVC pipe Schedule 40 or jack and bore steel pipe as per FDOT specifications, and as shown on plans.

- c. All irrigation system wires shall be sleeved separately from main or lateral lines.

- d. All pipe sleeves shall be installed at the minimum depth specified for main lines, lateral lines, and electric wire.


- e. Contractor shall coordinate all pipe sleeve locations and depths prior to initiating installation of the irrigation system.

**2.08 SPRINKLER HEADS**

- A. **Spray Sprinklers:** The sprinkler shall be a fixed spray type designed for in-ground installation. The nozzle shall elevate 6" (or as designated on plan) when in operation. The body of the sprinkler shall be constructed of non-corrosive heavy duty Cyclolac. A filter screen shall be in the nozzle piston. All sprinkler parts shall be removable through the tip of the unit by removal of a threaded cap.

Riser mounted spray shall be as indicated on the plans. The sprinkler shall consist of a nozzle and body. The body of the riser-mount sprinkler shall be constructed of non-corrosive materials. A cone strainer shall be a separate part with the nozzle assembly to allow for easy flushing of the sprinkler. Maximum working pressure at the base of the sprinkler shall be 40 PSI.

THIS ITEM HAS BEEN DIGITALLY SIGNED AND SEALED BY MATTHEW VINCENT WISNIEWSKI DATE ADJACENT TO SEAL.  
PRINTED COPIES OF THIS DOCUMENT ARE NOT CONSIDERED SIGNED AND SEALED AND THE SIGNATURE MUST BE VERIFIED ON ANY ELECTRONIC COPIES.

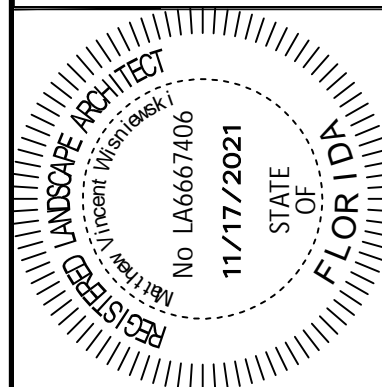

KHA PROJECT  
14-3228000  
DATE  
JULY 2021  
SCALE AS SHOWN  
DESIGNED BY  
DRAWN BY  
CHECKED BY

**IRRIGATION  
SPECIFICATIONS**

**IRC LANDFILL  
PREPARED FOR  
INDIAN RIVER COUNTY**

SHEET NUMBER  
**L-350**



No. \_\_\_\_\_  
REVISIONS  
DATE \_\_\_\_\_

**Sunshine 811**  
Call 811 or www.sunshine811.com two full business days before digging to have utilities located and marked.  
Check positive response codes before you dig!

Plotted By: Epiq, Carlos, Sheet Set: IRC LANDFILL, Layout: IR-351\_SPECS, November 16, 2021, 03:22:42pm, Kimley-Horn.com, FL: MA: WBA: CVA: 143228000, IRC: HHW and Recycling Facility, Landscape: CAD: PlanSheets\143228000 - IRRIGATION PLAN.dwg  
 This document, together with the concepts and designs presented herein, is intended only for the specific purpose and client for which it was prepared. Reuse of and improper reliance on this document without written authorization and adaptation by Kimley-Horn and Associates, Inc. shall be without liability to Kimley-Horn and Associates, Inc.

## 2.09 AUTOMATIC CONTROL VALVE

The automatic remote control valves shall be as specified on the plans, or approved equal.

## 2.10 GATE VALVES

- A. Gate valves for 3/4" through 2-1/2" shall be of brass or bronze construction, solid wedge, IPS threads, non-rising stem with wheel operating handle, for a continuous working pressure of 150 PSI.
- B. Gate valves for 3" and larger: Iron body, brass or bronze mounted AWWA gate valves, with a clear waterway equal to the full nominal diameter of the valve, rubber gasket for a continuous working pressure of 150p PSI. Valve shall be equipped with a square operating nut.

## 2.11 VALVE BOXES

- A. For gate valves, use AMETEK #10-181-014 box with #10-181-015 locking lid, or as per the drawings.
- B. For control valves 3/4" through 2", the drip valve assemblies, use AMETEK #10-181-014 box with #10-181-015 locking lid, or sized as necessary to effectively house the equipment
- C. For control wiring splices, use AMETEK #10-181-014 box with #10-181-015 locking lid, or as per the drawings.

## 2.12 IRRIGATION WIRING

- A. Wiring used for connecting the electric control valves to the controllers shall be Type UF, 600 volt, single strand, solid copper with PVC insulation 4/64" thick. Size shall be 14 gauge, red for "hot" or lead wires, and common wire to be 14 gauge, white in color.
- B. Contractor shall perform an ohm test on ground to assure adequate protection against surges and indirect lightning strikes.

## 2.13 MISCELLANEOUS MATERIALS

- A. Drainage Backfill: Cleaned gravel or crushed stone, graded from 1" maximum to 3/4" minimum.
- B. Metalized Underground Tape: The detectable, underground utility marking tape shall consist of a minimum: 5 mil (0.005") overall thickness; five-ply composition; ultra-high molecular weight, 100% virgin polyethylene; acid, alkaline and corrosion resistant; with no less than 150 pounds of tensile break strength per 6" width; color -code impregnated with color stable, lead-free, organic pigments suitable for direct burial. Tapes utilizing reprocessed plastics or resins shall not be acceptable. The detectable, underground utility marking tape shall have a 35 gauge (0.0035") solid aluminum foil, core encapsulated within a 2.55 mil (0.00255") polyethylene backing and a 0.6 mil (0.006") PET cover coating. The laminate on each side shall consist of a 0.75 mil (0.00075") layer of hot LPDE, poly-fusing the "sandwich" without use of adhesives.

## 2.14 AUTOMATIC CONTROL SYSTEM

An Independent Station Controller: Furnish a solid state controller, as specified on the plans.  
 Each station shall be capable of timing from zero (0) minute to 99 minutes per station in one (1) minute increments.  
 Each station shall be capable of operating two (2) 7VA electric valve-in-head solenoids.

The stand-alone controller shall have two (2) possible programs.

The stand-alone controller shall provide global percentage increase/decrease (water budget) for all stations simultaneously, from ten (10) to two hundred (200) percent, in ten (10) percent increments.

All stations shall be able to be turned on/off manually buy operating timing mechanism or by manual switch at station output.

The stand-alone controller shall incorporate an integral MOV surge protection into the terminal block for each of its 24 VAC field wire outputs. Controller power input wires will also incorporate surge protection.

The control panel shall provide continuous display time. It shall have alphanumeric displays of descriptive English menus and legend identifiers with cursor selection of function and precision value adjustment by rotary dial input.

The stand-alone controller shall be UL listed and FCC approved.

The stand-alone controller shall have 117 VAC, 60 Hz input, 26.5 VAC, 60 Hz output for operating 24 VAC solenoids.

The stand-alone controller cabinet shall be a lockable and weather-resistant outdoor cabinet. Mount as noted on plans.

The controller shall be equipped with lightning protection, by the Contractor, on both the primary (120v) and each secondary (24v) circuit. The controller circuits shall be grounded to a copper clad grounding rod located at each controller.

The controller shall be equipped for a water conservation device, as specified.

## PART III: EXECUTION

### 3.01 INSPECTION

The Contractor shall examine the areas and conditions under which landscape irrigation system is to be installed and notify the Landscape Architect in writing of conditions detrimental to the proper and timely completion of the work. The Contractor shall proceed with the work until unsatisfactory conditions have been corrected in a manner acceptable to the Landscape Architect.

### 3.02 PREPARATION

The Contractor shall provide sleeves to accommodate piping under walks or paving. The Contractor shall coordinate with other trades and install to accurate levels prior to paving work. Cutting and patching of paving and concrete will not be permitted. The Contractor shall maintain all warning signs, shoring, barricades, flares and red lanterns, as required by any local codes, ordinances or permits.

### 3.03 TRENCHING AND BACKFILLING

- A. Excavation: The Contractor shall stake out the location of each run of pipe, sprinkler heads, sprinkler valves and isolation valves prior to trenching. Excavation shall be open vertical construction sufficiently wide to provide free working space around the work installed and to provide ample space or backfilling and tamping. Trenches for pipe shall be cut to required grade lines, and compacted to provide accurate grade and uniform bearing for the full length of the line. The bottom of the trenches shall be free of rock or other sharp edged objects. Minimum cover shall be as follows:

#### Pipe and Wire Depth

|                         |                                      |
|-------------------------|--------------------------------------|
| Pressure Mainline       | 18" at top of pipe from Finish Grade |
| Lateral Piping (rotor)  | 12" at top of pipe from Finish Grade |
| Lateral Piping (pop-up) | 12" at top of pipe from Finish Grade |
| Control Wiring          | Side of main Line                    |

- B. Minimum Clearances: All pipelines shall have a minimum clearance of six inches from each other and from lines of other crafts. Parallel lines shall not be installed directly over one another. No lateral line shall be installed in the main-line trench.

### 3.04 INSTALLATION OF PIPING

- A. PVC Pipe and Joints: The Contractor shall not install solvent wild pipe when air temperature is below 40o F. Installation shall be in accordance with the manufacturer's instructions.

1. Only the solvent recommended by the pipe manufacturer shall be used. All PVC pipe and fittings shall be installed as outlined and instructed by the pipe manufacturer, and it shall be the Contractor's full responsibility to make arrangements with the pipe manufacturer for any field assistance that may be necessary. The Contractor shall assume full responsibility for the correct installation.

### 3.05 BACKFILLING PROCEDURES

Initial backfill on PVC lines shall be pulverized native soil, free of foreign matter. Within radius of 4" of the pipe shall be clean soil or sand. Plant locations shall take precedence over sprinkler and pipe locations. The Contractor shall coordinate the location of trees and shrubs with the routing of lines and final head locations.

- A. Backfill and Compaction: The Contractor shall leave trenches slightly mounded to allow for settlement after the backfilling is completed. The Contractor shall clean the site of the work continuously of excess waste materials as the backfilling progresses, and leave in a neat condition. No trenches shall be left open for a period of more than 48 hours. Protect open trenches as required.

The Contractor shall carefully backfill excavated materials approved for backfilling, consisting of earth, loam, sand, and other approved materials, free of rock and debris over 1" in size. Backfill shall be compacted to original density of surrounding soil without dips, sunken areas, or irregularities.

The Contractor shall conform to DOT requirements for methods and required compaction percentages, for roads and paving.

The Contractor shall hand place the first 6" of backfill (or to top of pipe) and have it walked on so as to secure the position of the pipe and wire.

No wheel rolling will be allowed. The Contractor shall remove rock or debris extracted from backfill materials and dispose of offsite. The Contractor shall fill any voids left in backfill with approved backfill materials.

- B. Existing Lawns: Where trenching is required across existing lawns, uniformly cut strips of sod 6" wider than trench. The Contractor shall remove sod in rolls of suitable size for handling and keep moistened until replanted. The Contractor shall replant sod within 48 hours after removal, roll and water generously. The Contractor shall resod any areas not in healthy condition equal to adjoining lawns 10 days after replanting.

- C. Seeded Area: Trenching will be required across existing seeded areas, primarily roadway edging. The Contractor shall conform to the requirements of seeding, Section 02930 for the reseeded of the disturbed trench area.

- D. Pavements: Jack and bore or directional bore piping under paving materials as per local regulatory codes. No cutting and patching of pavement will be permitted.

### 3.06 VALVES

- A. Isolation Valves: Shall be sized corresponding to adjacent pipe size. Specified valve boxes shall be installed flush with finish grade in such a manner that surface forces applied to their exposed area will not be transmitted to the piping in which the valve is installed nor any other piping, wiring or other lines in the vicinity of said valves.
- B. Gate Valves: Install where shown, in valve boxes.
- C. Electric Control Valves: Shall be installed in specified valve boxes. The valve shall have 6" of 3/4" pea gravel installed below the bottom of the valve. If the valve box does not extend to the base of the valve, a valve box extension shall be installed. Electric control valves shall be installed where shown and grouped together where practical. The Contractor shall place no closer than 24" to walk edges, bikeway edges, buildings and walls. The Contractor shall adjust the valve to provide flow rate or rated operating pressure required for each sprinkler circuit.

### 3.07 CONDUIT AND SLEEVES

- A. Conduit and Sleeves for Control Wiring and Main/Lateral Pipe: The Contractor shall provide and install where necessary. Contractor shall coordinate locations of previously installed sleeving with the General Site Contractor.  
 The Contractor shall coordinate installation of sleeves with work of other disciplines.

### 3.08 CONTROLS

- A. The Contractor shall connect electric control valves to controllers in a clockwise sequence to correspond with station settings beginning with Stations 1, 2, 3, etc. Automatic controllers shall be provided and installed by the Contractor as noted on the drawings. All zones will be labeled on the controller.
- B. Controllers shall be equipped with lightning protection and grounded to a standard 5/8" copper clad steel ground rod driven a minimum of 8' into the ground and clamped.
- C. The electrical service to the controllers shall be performed by an electrical subcontractor in compliance with NEC requirements.

### 3.09 CONTROL WIRE

- A. Control wiring between the controller and electric valves shall be buried in main line trenches or in separate trenches. Electrical connection at valve will allow for pigtail so solenoid can be removed from valve with sufficient slack to allow ends to be pulled 12" above ground for examination and cleaning.
- B. An expansion loop shall be provided at every valve at 100' o.c. Expansion loop shall be formed by wrapping wire at least eight times around a 3/4" pipe and withdrawing pipe.
- C. The wire shall be bundled and taped every ten feet. The wire shall be laid in the trench prior to installing the pipe being careful to install wire beneath and 6" to the side of the main pipe line.
- D. Electrical connections to electric control valves shall be made with Rainbird Pen-Tite or Techdel GT-3-GEL - Tite connectors or equal.  
 Power Connections: Electrical connections to power and signal wires shall be made using 3M 82-A2 power cable splice kits.

### 3.10 SPRINKLER HEADS

- A. General Provisions:

1. Sprinkler heads shall be installed as designated on the shop drawings. Heads shall be installed on flexible PVC. Top to be flush with finish grade or top of curb.
2. Spacing of heads shall not exceed the maximum indicated on the shop drawings (unless directed by the Landscape Architect). In no case shall the spacing exceed the maximum recommended by the manufacturer.

- B. Head Types:

1. Pop-up- Rotary Sprinkler Heads: Shall be installed on flex joint and be set with top of head flush with finish grade. Heads installed at curb shall have 6" to 10" between perimeter of head and concrete. Heads placed at edge of pavement having no curb shall be installed 24" from edge of pavement.
2. Spray Pop-up Sprinkler Heads: Shall be installed on flexible PVC and be set with top of head flush with finished grade. Sprinkler heads placed adjacent to curbs will be installed 9" from concrete. Sprinkler heads placed adjacent to pavement having no curb shall be installed 24" from the edge of pavement.

### 3.11 COMPLETION

- A. Flushing: Before sprinkler heads are set, the Contractor shall flush the lines thoroughly to make sure there is no foreign matter in the lines.  
 The Contractor shall flush the main lines from dead end fittings for a minimum of five minutes under a full head of pressure.
- B. Testing: The Contractor shall notify Landscape Architect and Owner forty-eight (48) hours in advance of testing.  
 Prior to backfilling of main line fittings, Contractor shall fill the main line piping with water, in the presence of the Owner/Landscape Architect, taking care to purge the air from it by operating all the sprinkler control valves one or more times and/or such other means as may be necessary. A small, high pressure pump or other means of maintaining a continuous water supply shall be connected to the main line and set so as to maintain 100 PSI in the main line system for two (2) hours without interruption. When this has been accomplished and while the pressure in the system is still 100 PSI, leakage testing shall be performed in accordance with AWWA Standard C-600. Pressure readings shall be noted and make up water usage shall be recorded. Should the rate of make up water usage indicate significant leakage, the source of such leakage shall be found and corrected and the system then retested until the Owner/Landscape Architect is satisfied that the system is reasonably sound. Lateral line testing shall be conducted during the operating testing of the system by checking visually the ground surface until no leaks in this portion of the system are evident. Leaks shall be repaired or paid for by the Contractor at any time they appear during the warranty period.

- C. Adjustment and Coverage of System: Coordinate pressure testing with adjustments and coverage test of system so both may occur at the same time. The Contractor shall balance and adjust the various components of the system so that the overall operation of the system is most efficient. This includes a synchronization of the controllers, adjustments to pressure regulators, pressure relief valves, part circle sprinkler heads, and individual station adjustments on the controllers.

### 3.12 WARRANTY

- A. The Contractor shall fully warrant the landscape irrigation system for a period of one (1) year after the written final acceptance and will receive a written confirmation from the Landscape Architect that the warranty period is in effect.
- B. During the warranty period, the Contractor will enforce all manufacturer's and supplier's warranties as if made by the Contractor himself. Any malfunctions, deficiencies, breaks, damages, disrepair, or other disorder due to materials, workmanship, or installation by the Contractor and his suppliers shall be immediately and properly corrected to the proper order as directed by the Owner and/or Landscape Architect.
- C. Any damages caused by system malfunction shall be the responsibility of the Contractor who shall make full and immediate restoration for said damages.

THE SEAL APPEARING ON THIS DOCUMENT IS NOT AUTHORIZED BY MATTHEW VINCENT WISNIEWSKI LAG6667406 ON THE DATE ADJACENT TO THE SEAL.  
 PRINTED COPIES OF THIS DOCUMENT ARE NOT CONSIDERED SIGNED AND SEALED AND THE SIGNATURE MUST BE VERIFIED ON ANY ELECTRONIC COPIES.  
 THIS ITEM HAS BEEN DIGITALLY SIGNED AND SEALED BY MATTHEW VINCENT WISNIEWSKI LAG6667406 ON DATE ADJACENT TO SEAL.

© 2021 KIMLEY-HORN AND ASSOCIATES, INC.  
 355 ALHAMBRA CIRCLE, SUITE 1400, CORAL GABLES, FL 33134  
 PHONE: 305-673-2025  
 WWW.KIMLEY-HORN.COM REGISTRY 696

|             |            |
|-------------|------------|
| KHA PROJECT | 14-3228000 |
| DATE        | JULY 2021  |
| DESIGNED BY | NW         |
| DRAWN BY    | CT         |
| CHECKED BY  | NW         |

**IRRIGATION SPECIFICATIONS**


**IRC LANDFILL**  
 PREPARED FOR  
**INDIAN RIVER COUNTY**  
 INDIAN RIVER COUNTY

SHEET NUMBER  
**L-351**


| No. | REVISIONS | DATE |
|-----|-----------|------|
|     |           |      |
|     |           |      |
Call 811 or www.sunshine811.com two full business days before digging to have utilities located and marked.  
 Check positive response codes before you dig!


Plotted By: Epiq Carlos, Sheet Set: IRC LANDFILL, Layout: IR-352 DETAILS, November 15, 2021, 03:22:44pm, \\kimley-horn.com\EL\MA\WIB\_Civil\143228000 - IRC HW and Recycling Facility\Landscapes\CADD\PlanSheets\1-300 IRRIGATION.PLAN.dwg, This document, together with the concepts and designs presented herein, is intended only for the specific purpose and client for which it was prepared. Reuse of and improper reliance on this document without written authorization and adaptation by Kimley-Horn and Associates, Inc. shall be without liability to Kimley-Horn and Associates, Inc.

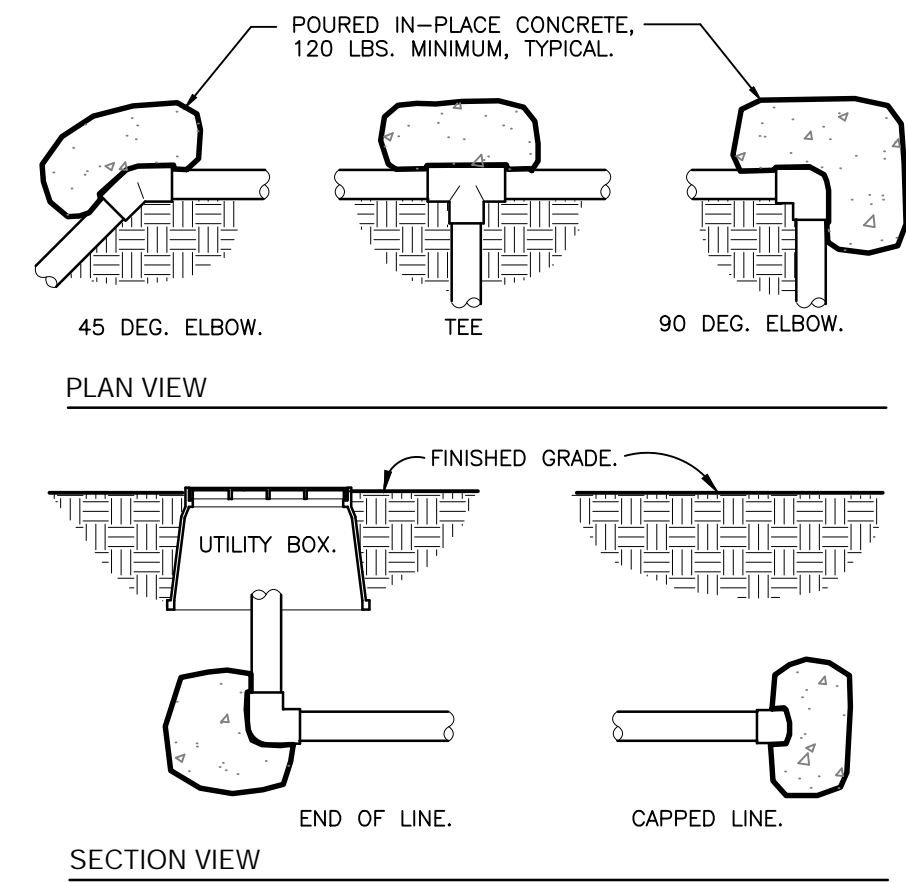


1 THRUST BLOCKING  
3/4" = 1'-0"

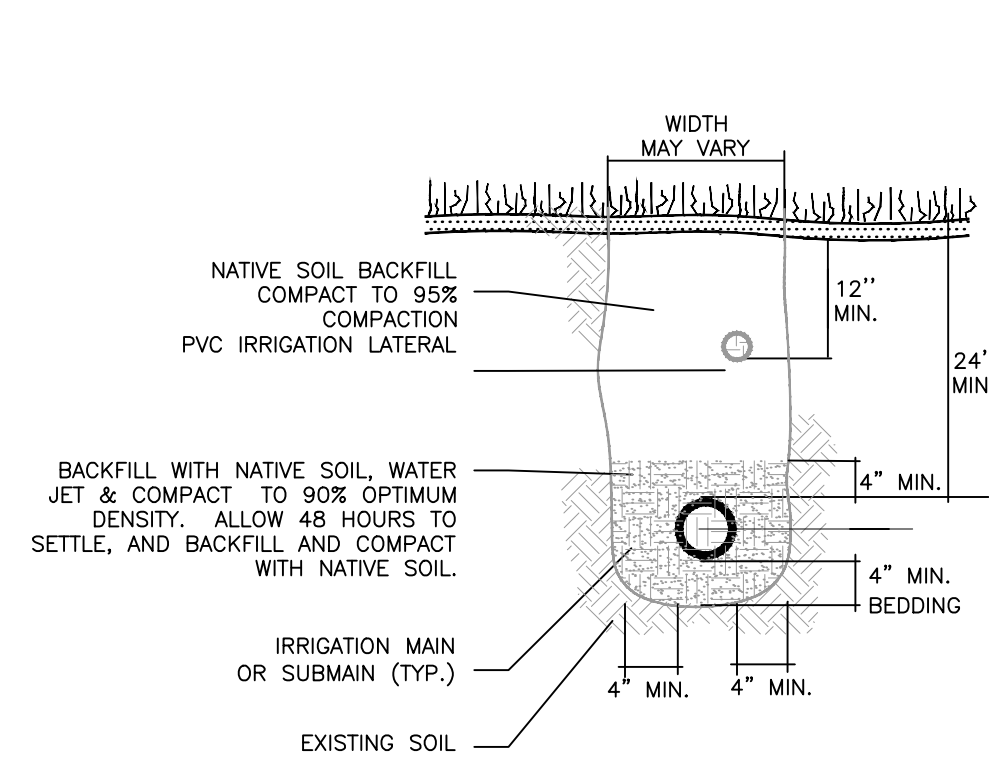


2 TRENCHING DETAIL  
NOT TO SCALE

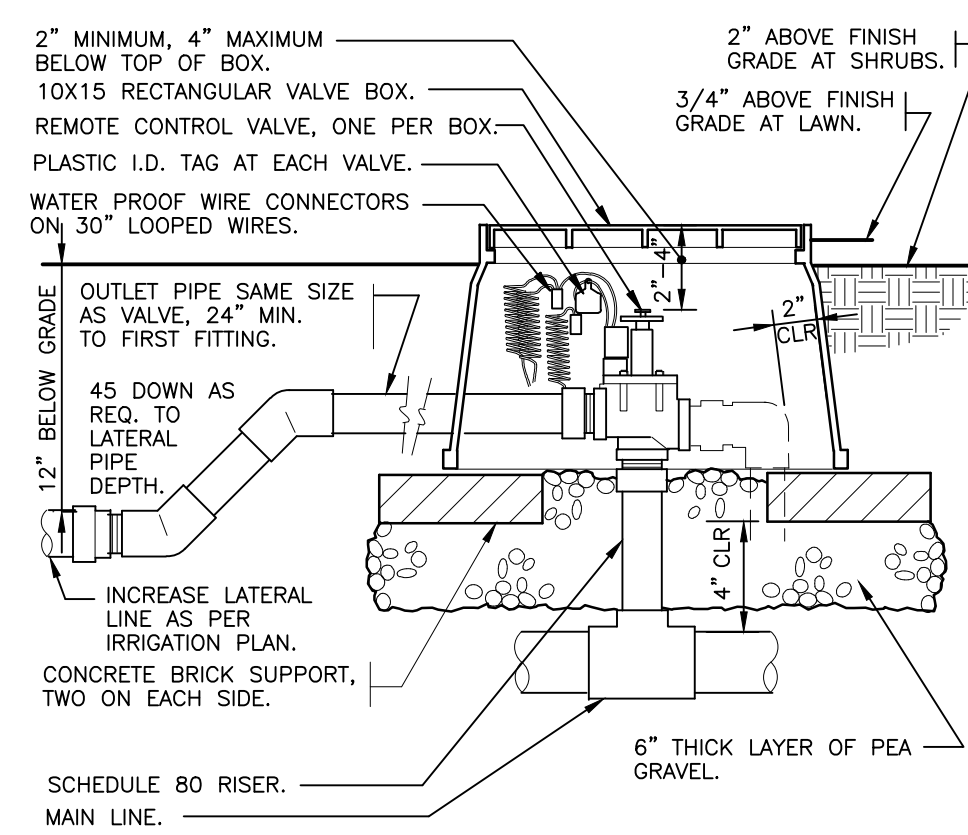


3 ELECTRIC REMOTE CONTROL VALVE  
1 1/2" = 1'-0"

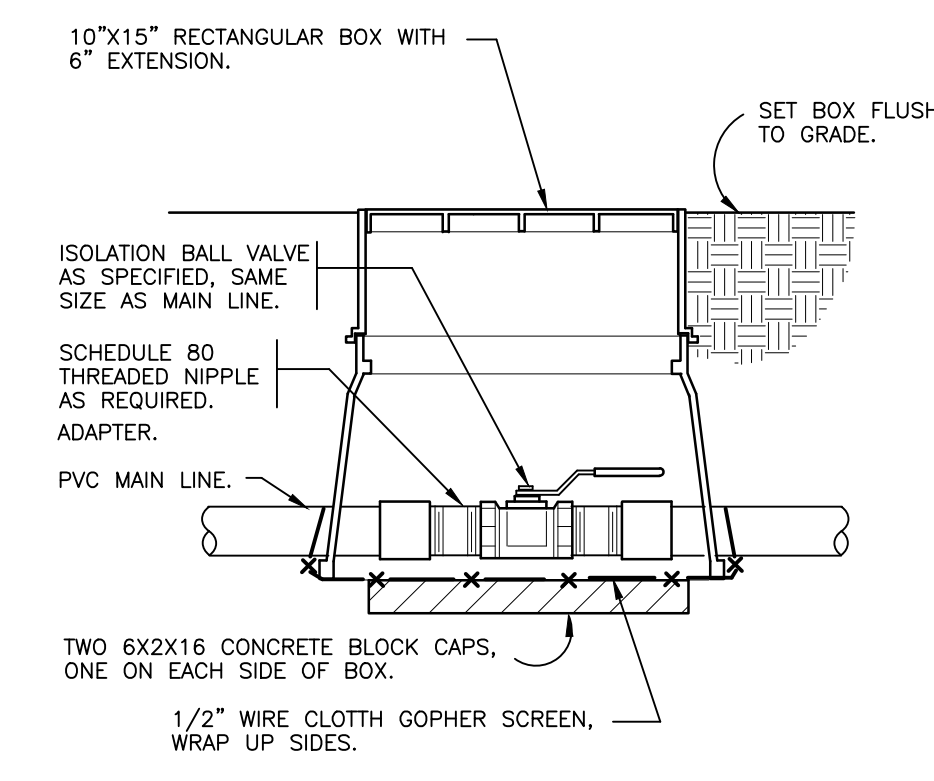


4 BRASS BALL ISOLATION VALVE  
1 1/2" = 1'-0"

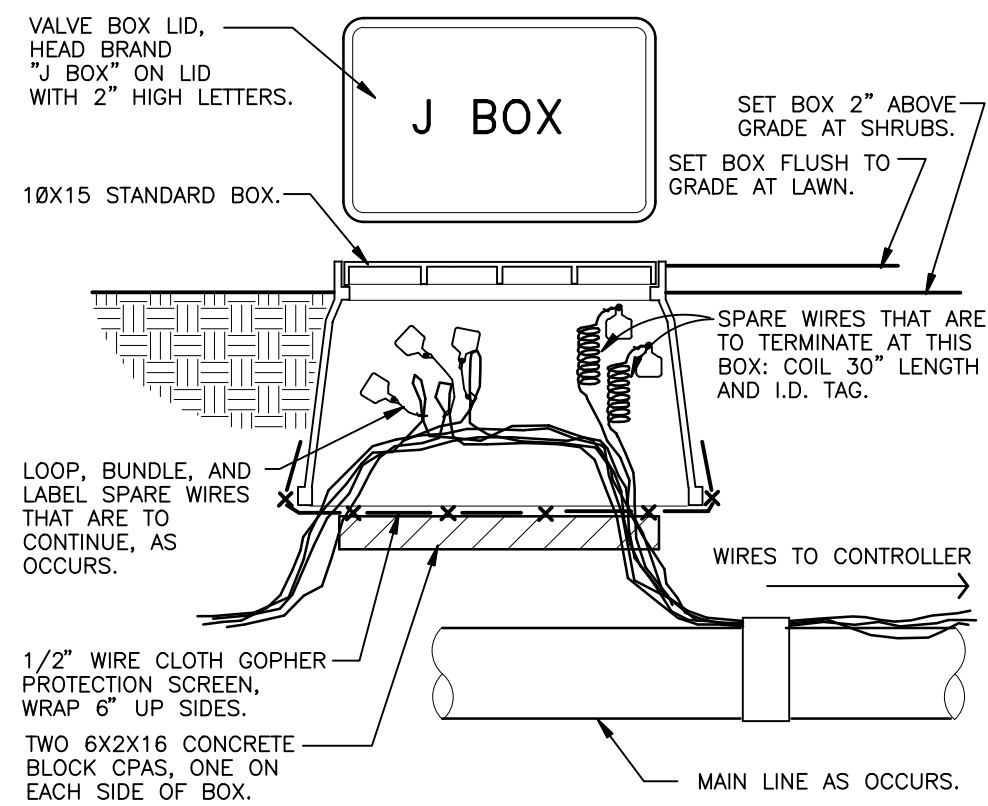


5 WIRE BUNDLE JUNCTION BOX  
1 1/2" = 1'-0"

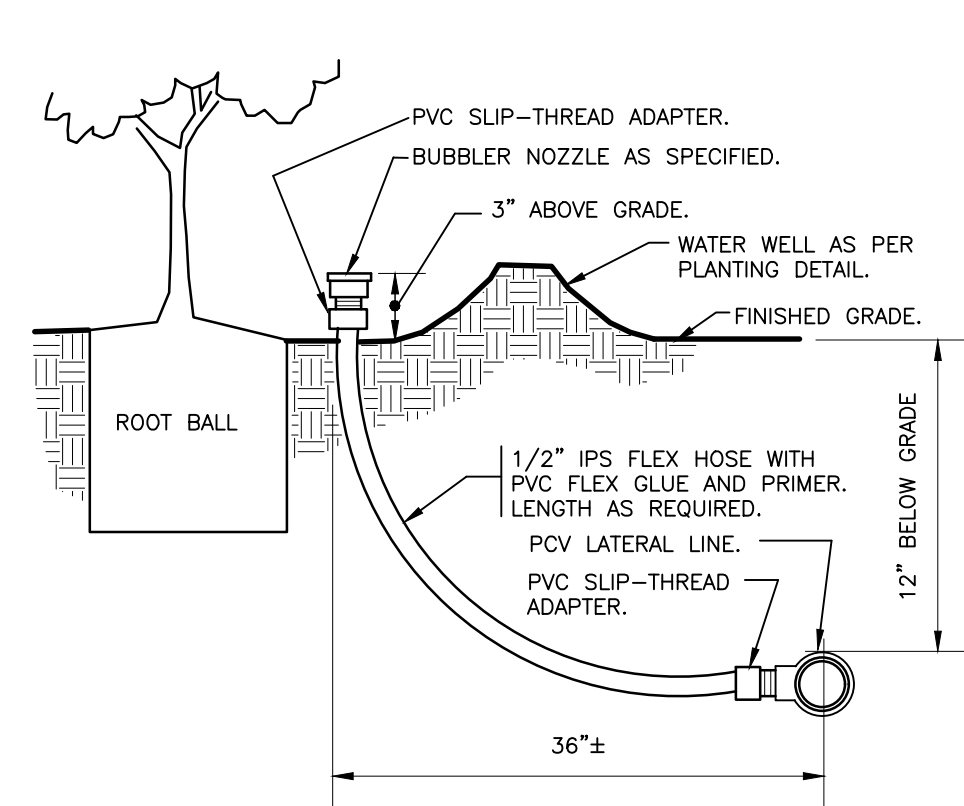

6 BUBBLER ON FLEX HOSE RISER  
3" = 1'-0"

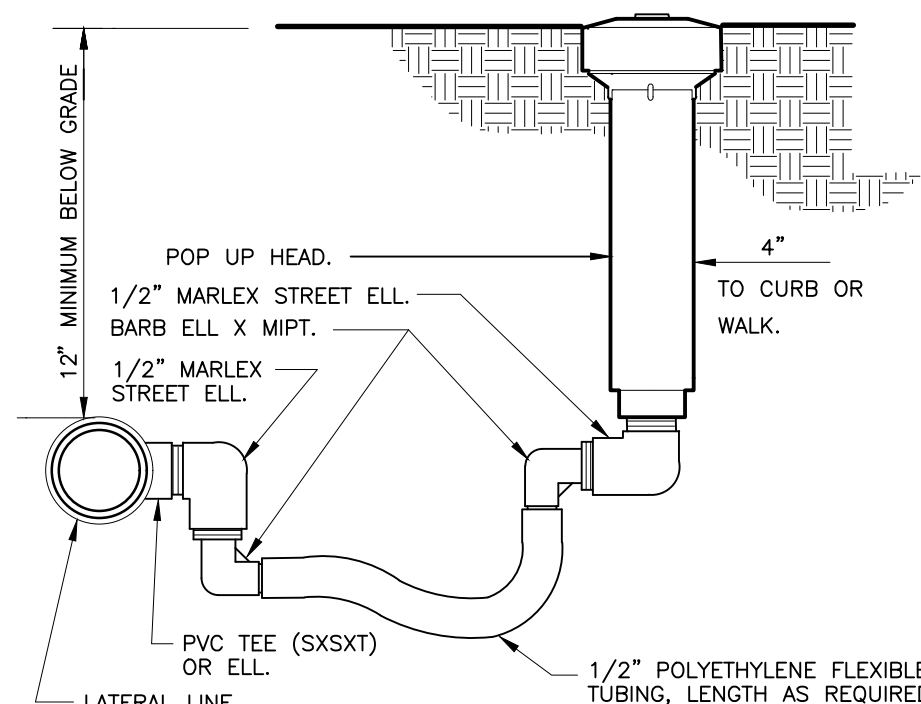


7 POP-UP SPRAY FLEX ASSEMBLY  
3" = 1'-0"

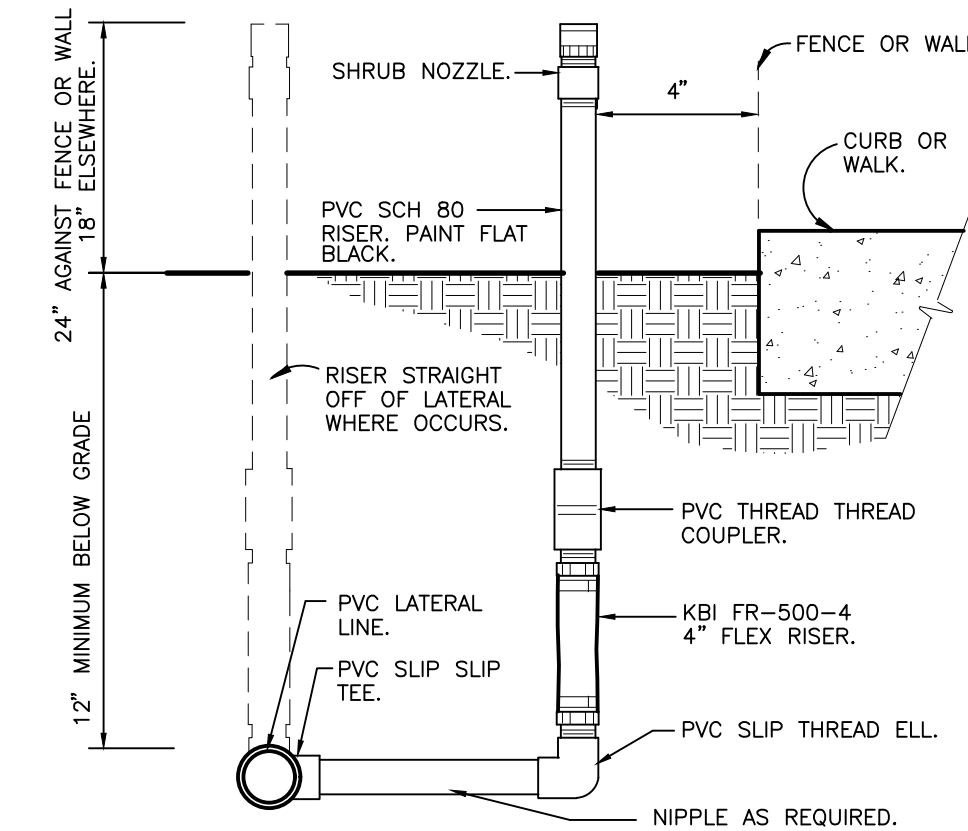


8 SHRUB SPRAY FIXED RISER  
3" = 1'-0"

32 8403.23-01

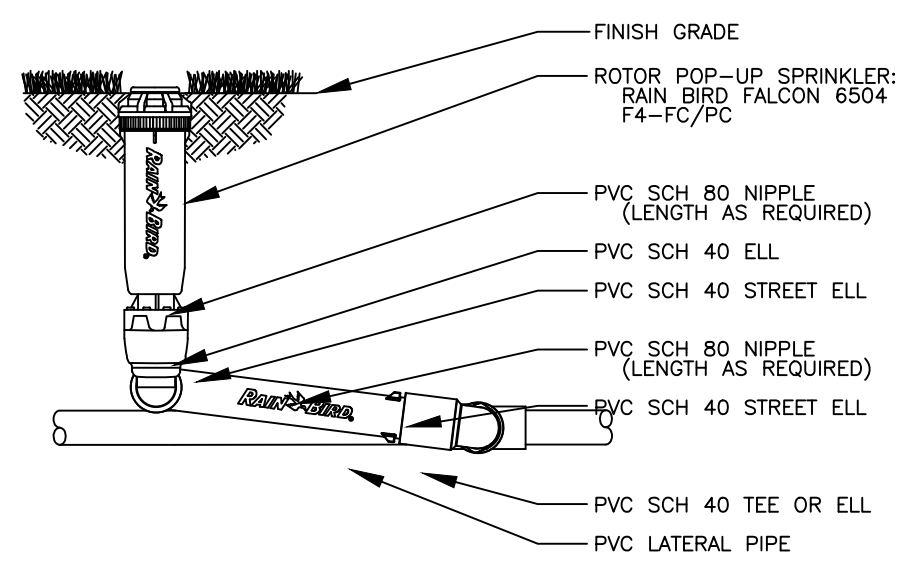


9 ROTOR POP UP SPRINKLER  
NOT TO SCALE

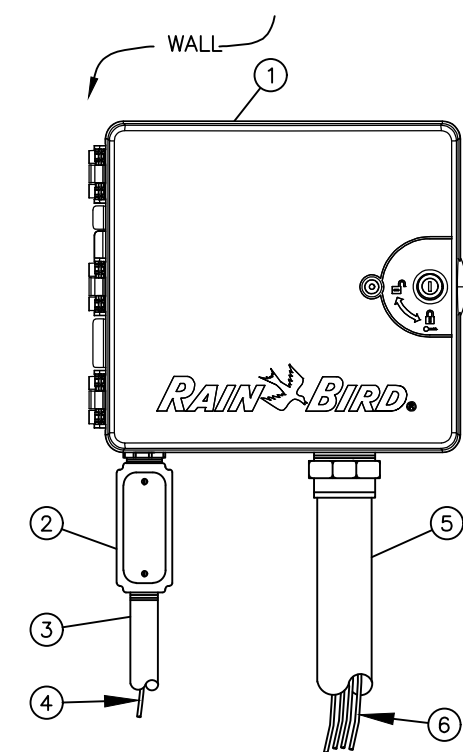

10 ESP-LXMEF CONTROLLER IN PLASTIC CABINET  
NOT TO SCALE

- IRRIGATION CONTROLLER: RAIN BIRD ESP-LXMEF CONTROLLER IN PLASTIC CABINET WITH WALL MOUNT. INSTALL CONTROLLER AND CABINET ON WALL PER MANUFACTURER'S RECOMMENDATIONS.
- JUNCTION BOX
- 1-INCH CONDUIT AND FITTINGS TO POWER SUPPLY
- POWER SUPPLY WIRE
- 2-INCH CONDUIT AND FITTINGS FOR STATION WIRES
- WIRES TO REMOTE CONTROL VALVES


NOTES:  
1. ESP-LXMEF CONTROLLER IS AVAILABLE IN 8- OR 12-STATION BASE MODELS. ADDITIONAL MODULES IN 4-, 8- AND 12-STATION VERSIONS MAY BE ADDED TO BRING THE CONTROLLER UP TO 48 STATIONS MAXIMUM.  
2. FOR EASE OF INSTALLATION INTO A CONTROLLER WITH MORE THAN 24 STATIONS, INSTALL A JUNCTION BOX AT THE BASE OF CONTROLLER AND TRANSITION LARGER VALVE AND COMMON WIRES FROM FIELD TO 15 AWG MULTI CONDUCTOR WIRE TO BE USED IN CONTROLLER.  
3. USE STEEL CONDUIT FOR ABOVE GRADE AND SCH 40 PVC CONDUIT FOR BELOW GRADE CONDITIONS.  
3. PROVIDE PROPER GROUNDING COMPONENTS TO ACHIEVE GROUND RESISTANCE OF 10 OHMS OR LESS.

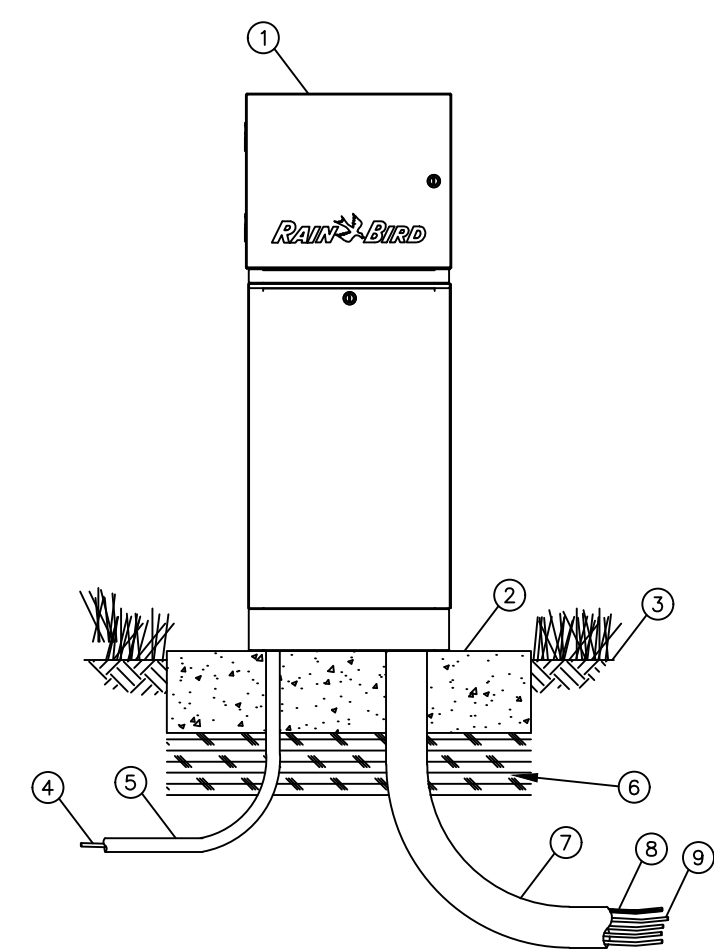

11 ESP-LXMEF CONTROLLER IN STAINLESS STEEL PEDESTAL - LXMM5 SPED  
NOT TO SCALE

- IRRIGATION CONTROLLER: RAIN BIRD ESP-LXMEF CONTROLLER WITH FLOW SMART MODULE IN LXMM METAL CABINET AND LXMMPED METAL PEDESTAL. INSTALL CONTROLLER, CABINET AND PEDESTAL PER MANUFACTURER'S RECOMMENDATIONS.
- CONCRETE PAD: 6-INCH MINIMUM THICKNESS.
- FINISH GRADE
- POWER SUPPLY WIRE
- 1-INCH SCH 40 PVC CONDUIT, FITTINGS AND SWEEP ELL FOR POWER SUPPLY
- COMPACTED SUBGRADE
- 3-INCH SCH 40 PVC CONDUIT, FITTINGS AND SWEEP ELL FOR STATION WIRES
- FLOW SENSOR WIRE (PE 39, 89 OR 54) TO FLOW SENSOR
- MASTER VALVE AND REMOTE CONTROL VALVE WIRES

NOTES:  
1. ESP-LXMEF CONTROLLER IS AVAILABLE IN 8- OR 12-STATION BASE MODELS. ADDITIONAL MODULES IN 4-, 8- AND 12-STATION VERSIONS MAY BE ADDED TO BRING THE CONTROLLER UP TO 48 STATIONS MAXIMUM.  
2. FOR EASE OF INSTALLATION INTO A CONTROLLER WITH MORE THAN 24 STATIONS, INSTALL A JUNCTION BOX AT THE BASE OF CONTROLLER AND TRANSITION LARGER VALVE AND COMMON WIRES FROM FIELD TO 15 AWG MULTI CONDUCTOR WIRE TO BE USED IN CONTROLLER.  
3. PROVIDE PROPER GROUNDING COMPONENTS TO ACHIEVE GROUND RESISTANCE OF 10 OHMS OR LESS.

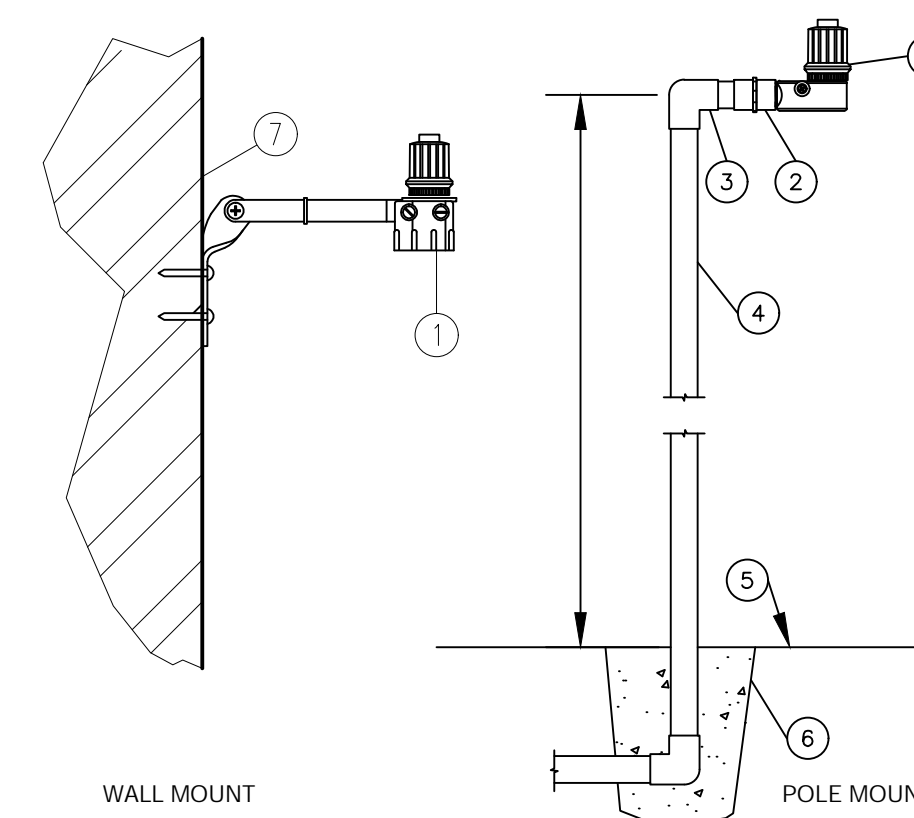

12 RAIN SENSOR  
NOT TO SCALE

- RAIN SENSOR: RAIN BIRD WR2 WIRELESS
- FEMALE ADAPTER (SLIP X FIPT)
- GALVANIZED 90° EL (1 OF 2)
- 3/4-INCH GALVANIZED PIPE
- FINISHED GRADE
- CONCRETE BASE
- EXTERIOR WALL (SEE NOTES BELOW)

NOTES:  
MOUNT SENSOR ON SURFACE WHERE IT WILL BE EXPOSED TO UNOBSTRUCTED RAINFALL, BUT NOT IN PATH OF SPRINKLER SPRAY. COORDINATE MOUNTING WITH OWNER AND ARCHITECT.

PAINT PIPE SEMI GLOSS BLACK AND SISTER THE PIPE TO A LIFT STATION FENCE POST WITH SS PIPE CLAMPS


THIS ITEM HAS BEEN DIGITALLY SIGNED AND SEALED BY MATTHEW VINCENT WISNIEWSKI L68667406 ON DATE ADJACENT TO SEAL.  
PRINTED COPIES OF THIS DOCUMENT ARE NOT CONSIDERED SIGNED AND SEALED AND THE SIGNATURE MUST BE VERIFIED ON ANY ELECTRONIC COPIES.  
KHA PROJECT 14-3228000  
DATE JULY 2021  
SCALE AS SHOWN  
DESIGNED BY NW  
DRAWN BY CT  
CHECKED BY NW

IRRIGATION DETAILS

IRC LANDFILL  
PREPARED FOR  
INDIAN RIVER COUNTY  
INDIAN RIVER COUNTY

SHEET NUMBER  
L-352


**Kimley-Horn**  
© 2021 KIMLEY-HORN AND ASSOCIATES, INC.  
355 ALHAMBRA CIRCLE, SUITE 1400, CORAL GABLES, FL 33134  
PHONE: 305-673-2025  
WWW.KIMLEY-HORN.COM REGISTRY 696

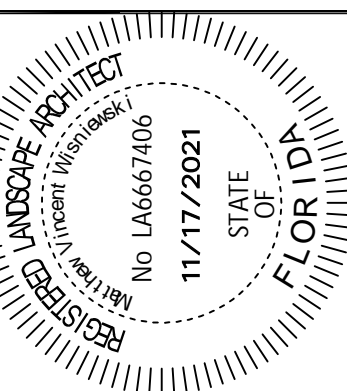

| NO. | REVISIONS | DATE | BY |
|-----|-----------|------|----|
|     |           |      |    |
|     |           |      |    |
|     |           |      |    |
|     |           |      |    |

**Sunshine811**  
Call 811 or www.sunshine811.com two full business days before digging to have utilities located and marked.  
Check positive response codes before you dig!


Plotted By: Epiq. Carlos. Sheet Set: IRC LANDFILL. Layout: IR-353. Details: November 15, 2021. 03:22:46pm. \\kimley-horn.com\EL\MA\WIB\_Civil\143228000 - IRC HHW and Recycling Facility\Landscaping\CADD\PlanSheets\1-300 IRRIGATION PLAN.dwg  
 This document, together with the concepts and designs presented herein, is intended only for the specific purpose and client for which it was prepared. Reuse of and improper reliance on this document without written authorization and adaptation by Kimley-Horn and Associates, Inc. shall be without liability to Kimley-Horn and Associates, Inc.

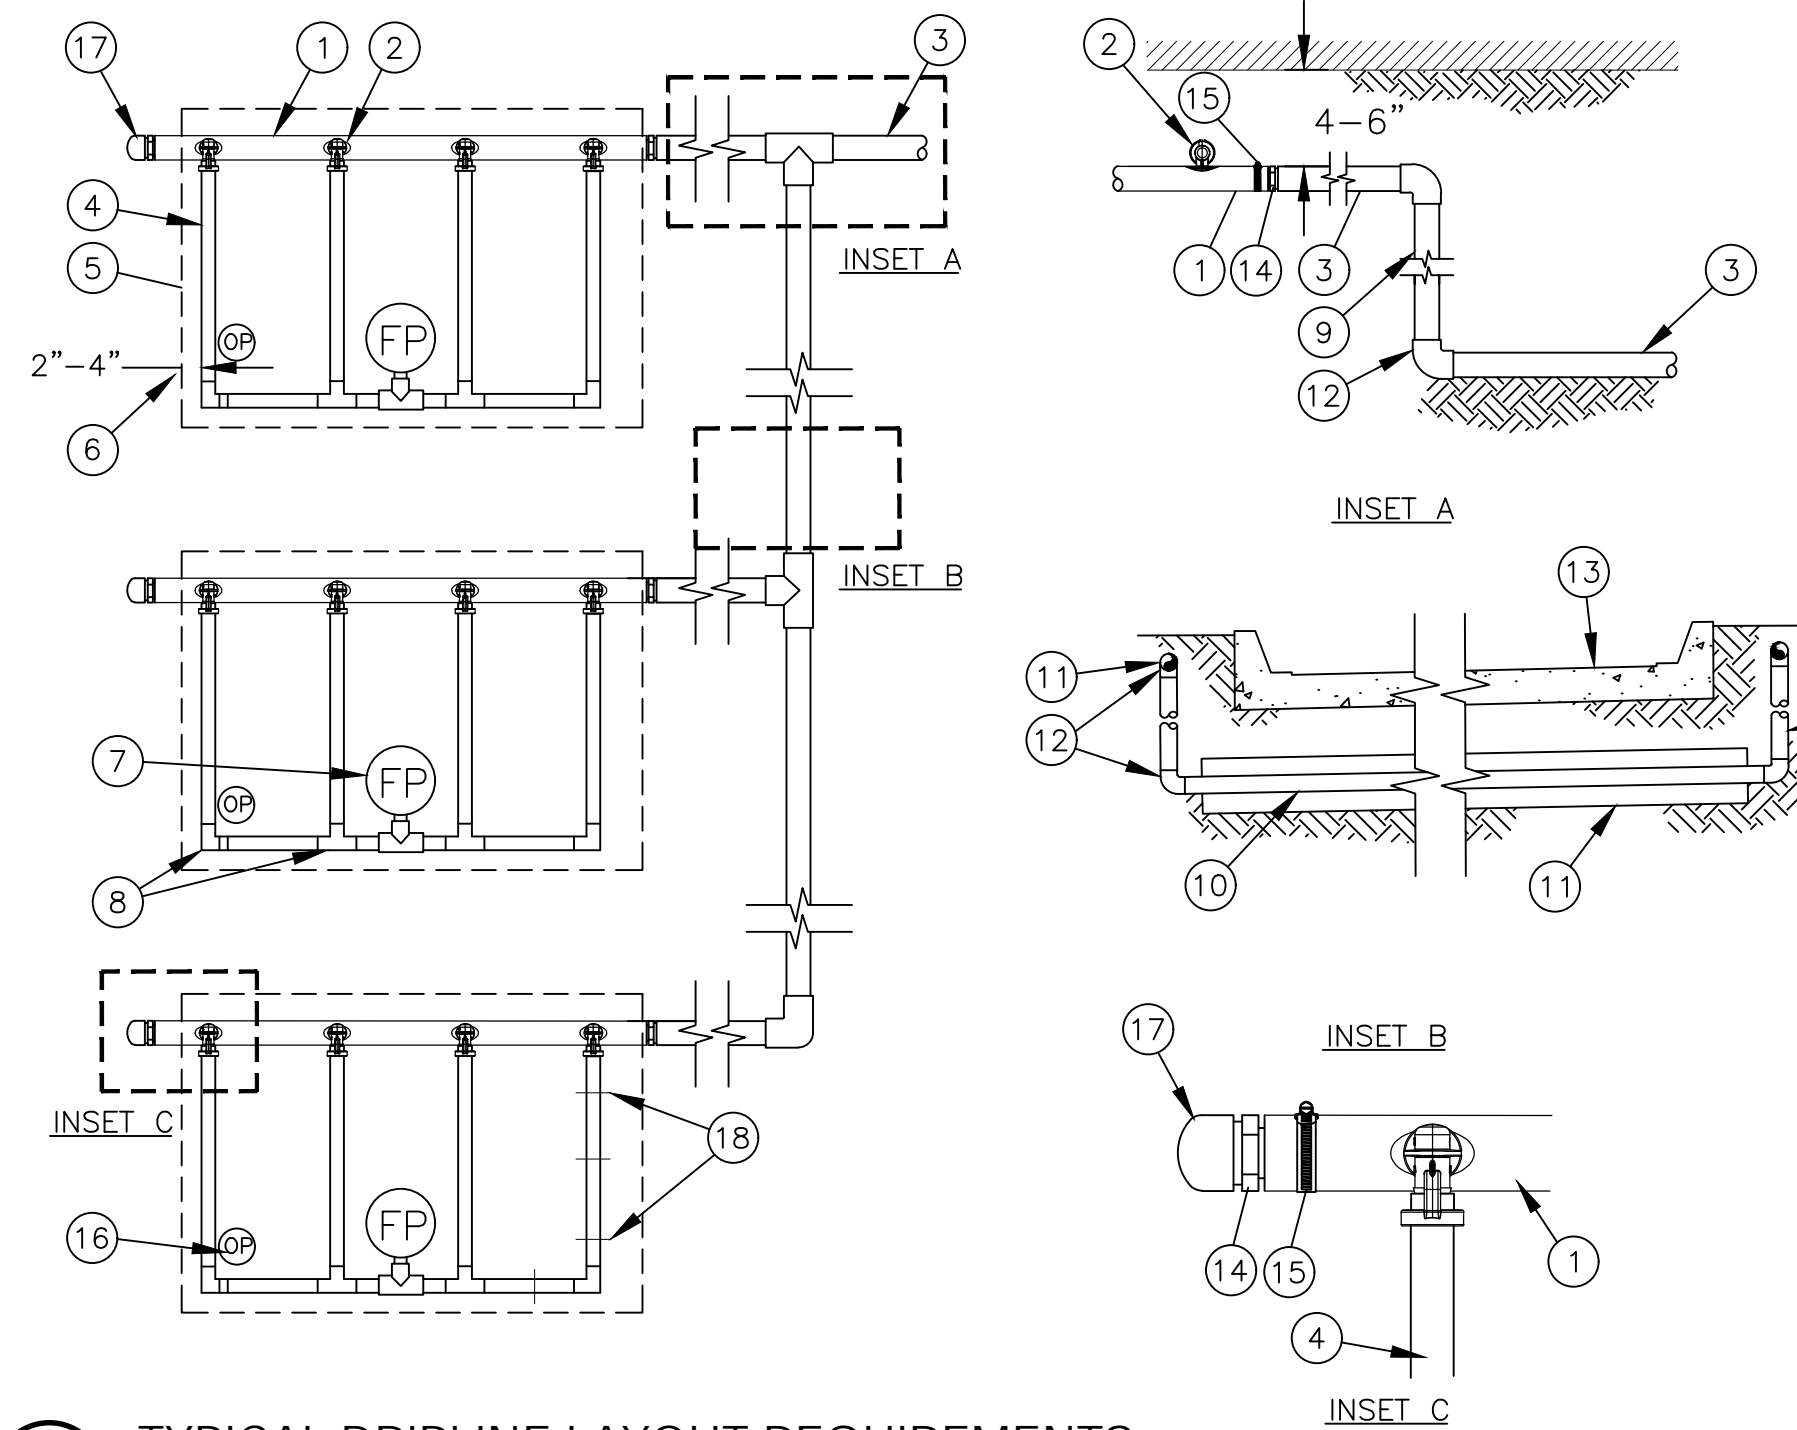

- 1 QF-SUPPLY HEADER
- 2 PRE-INSTALLED BARB FITTING
- 3 PVC DRIP MANIFOLD FROM RAIN BIRD CONTROL ZONE VALVE KIT (SIZED TO MEET LATERAL FLOW DEMAND)
- 4 RAIN BIRD XFS SERIES DRIPLINE (TYPICAL)
- 5 PERIMETER OF AREA
- 6 PERIMETER DRIPLINE PIPE TO BE INSTALLED 2"-4" FROM PERIMETER OF AREA
- 7 FLUSH POINT (TYPICAL) - SEE RAIN BIRD XFD DETAILS FOR FLUSH POINT INSTALLATION
- 8 BARB X BARB INSERT TEE OR ELL: RAIN BIRD XFF-TEE OR RAIN BIRD XFF-ELBOW (TYPICAL)
- 9 PVC RISER PIPE
- 10 PVC SUPPLY MANIFOLD
- 11 PVC SCH 40 SLEEVE PIPE SIZED TWICE THE SIZE OF MANIFOLD PIPE SIZE
- 12 PVC SCH 40 TEE OR ELL (TYPICAL)
- 13 PAVEMENT AND CURB
- 14 MALE ADAPTER INSERT
- 15 STAINLESS STEEL, OETIKER OR MURRAY CLAMP
- 16 OPERATION INDICATOR RAIN BIRD MODEL: OPERIND
- 17 PVC SCH 40 CAP
- 18 XF SERIES TIE-DOWN STAKES (TDS-050) REFER TO RAIN BIRD DRIPLINE DESIGN GUIDE FOR PROPER SPACING


NOTES:  
 1. DISTANCE BETWEEN LATERAL ROWS AND EMITTER SPACING TO BE BASED ON SOIL TYPE, PLANT MATERIALS AND CHANGES IN ELEVATION. SEE INSTALLATION SPECIFICATIONS ON RAIN BIRD WEB SITE (WWW.RAINBIRD.COM) FOR SUGGESTED SPACING.  
 2. LENGTH OF LONGEST DRIPLINE LATERAL SHOULD NOT EXCEED THE MAXIMUM SPACING SHOWN IN THE ACCOMPANYING TABLE.  
 3. PLACE TIE DOWN STAKES EVERY THREE FEET IN SAND, FOUR FEET IN LOAM, AND FIVE FEET IN CLAY.  
 4. AT FITTINGS WHERE THERE IS A CHANGE OF DIRECTION SUCH AS TEES OR ELBOWS, USE TIE-DOWN STAKES ON EACH LEG OF THE CHANGE OF DIRECTION.

| Inlet Pressure psi | 12" Spacing        |                    | 18" Spacing        |                    | 24" Spacing        |                    |
|--------------------|--------------------|--------------------|--------------------|--------------------|--------------------|--------------------|
|                    | Nominal Flow (gph) | Nominal Flow (gph) | Nominal Flow (gph) | Nominal Flow (gph) | Nominal Flow (gph) | Nominal Flow (gph) |
| 15                 | 0.6                | 0.9                | 0.6                | 0.9                | 0.6                | 0.9                |
| 20                 | 273                | 155                | 314                | 250                | 424                | 322                |
| 30                 | 318                | 169                | 353                | 294                | 508                | 368                |
| 40                 | 360                | 230                | 413                | 350                | 586                | 414                |
| 50                 | 395                | 255                | 465                | 402                | 652                | 474                |
| 60                 | 417                | 285                | 528                | 420                | 720                | 488                |
| 60                 | 460                | 290                | 596                | 455                | 780                | 514                |

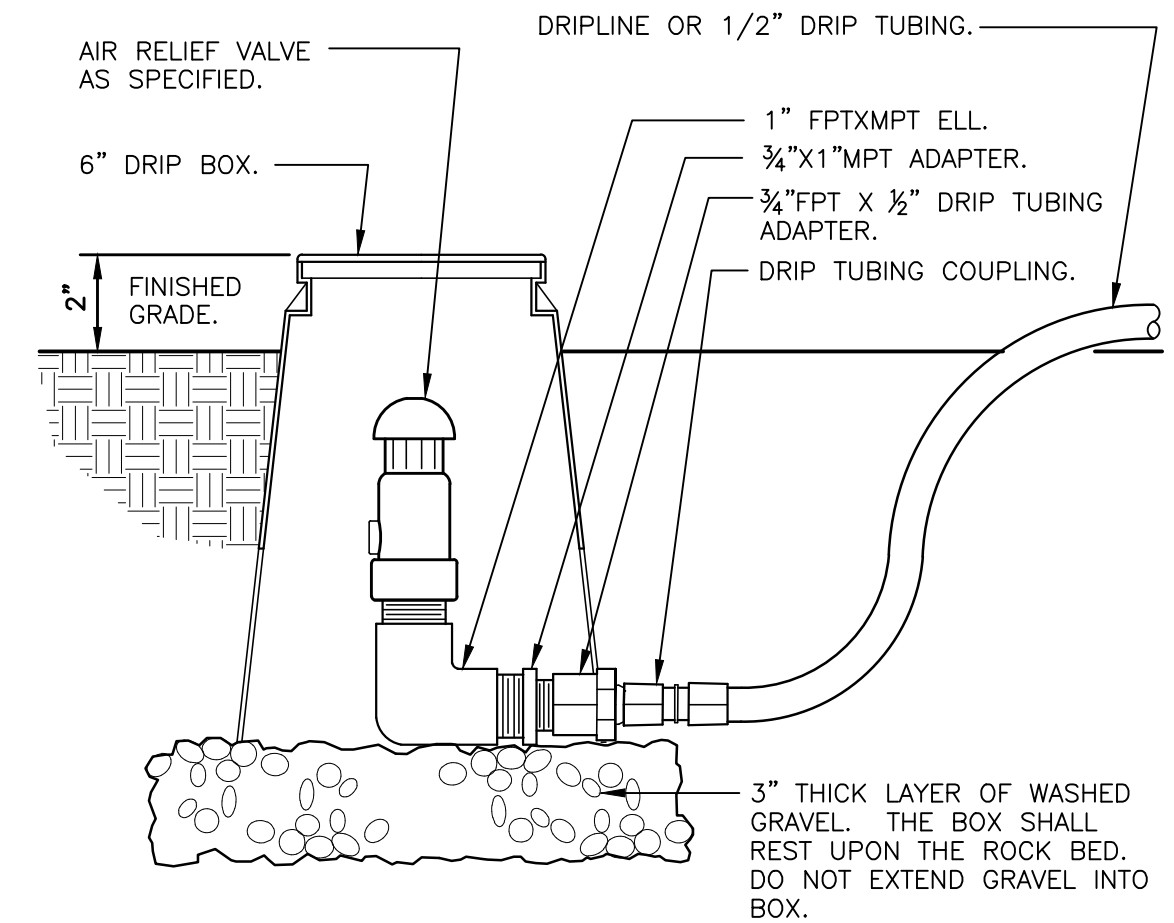


1 TYPICAL DRIPLINE LAYOUT REQUIREMENTS  
 NOT TO SCALE


2 DRIFT AIR RELIEF VALVE IN BOX  
 3" = 1'-0" 32 8413.53-03

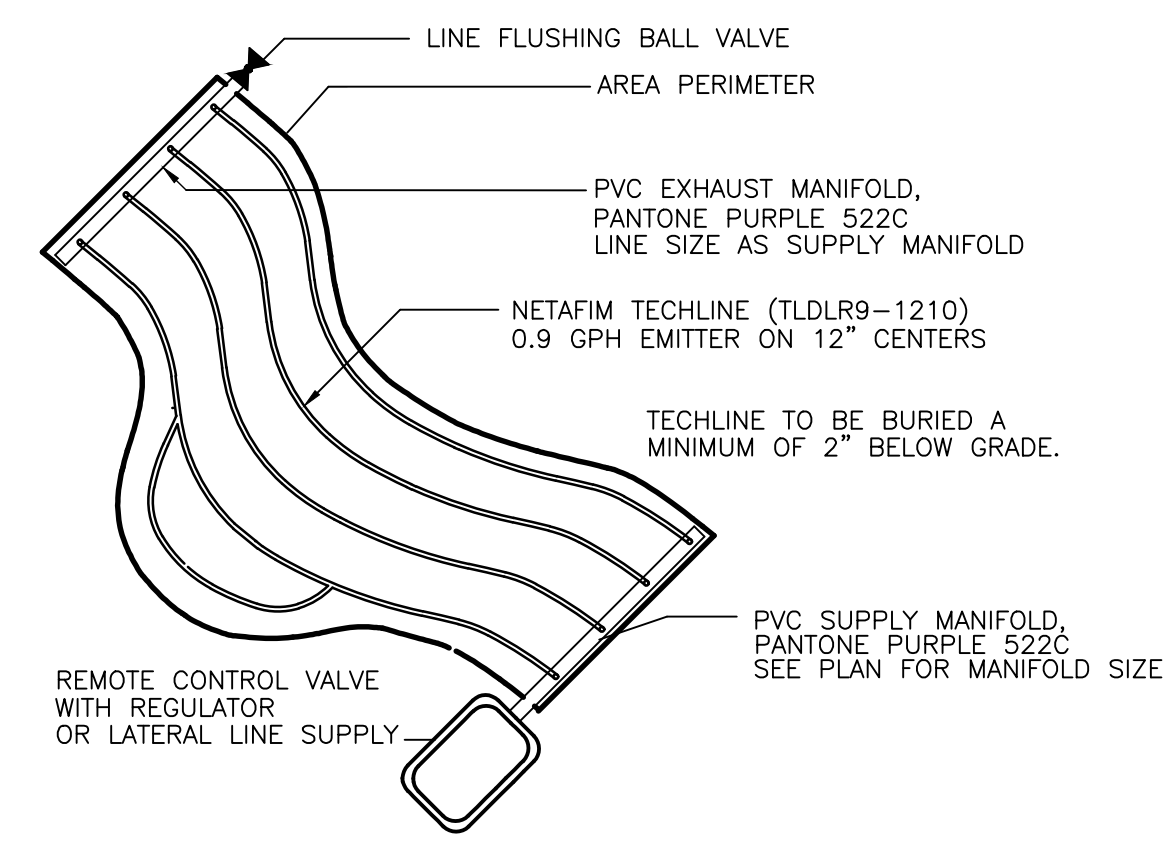


3 IRREGULAR AREAS  
 NOT TO SCALE

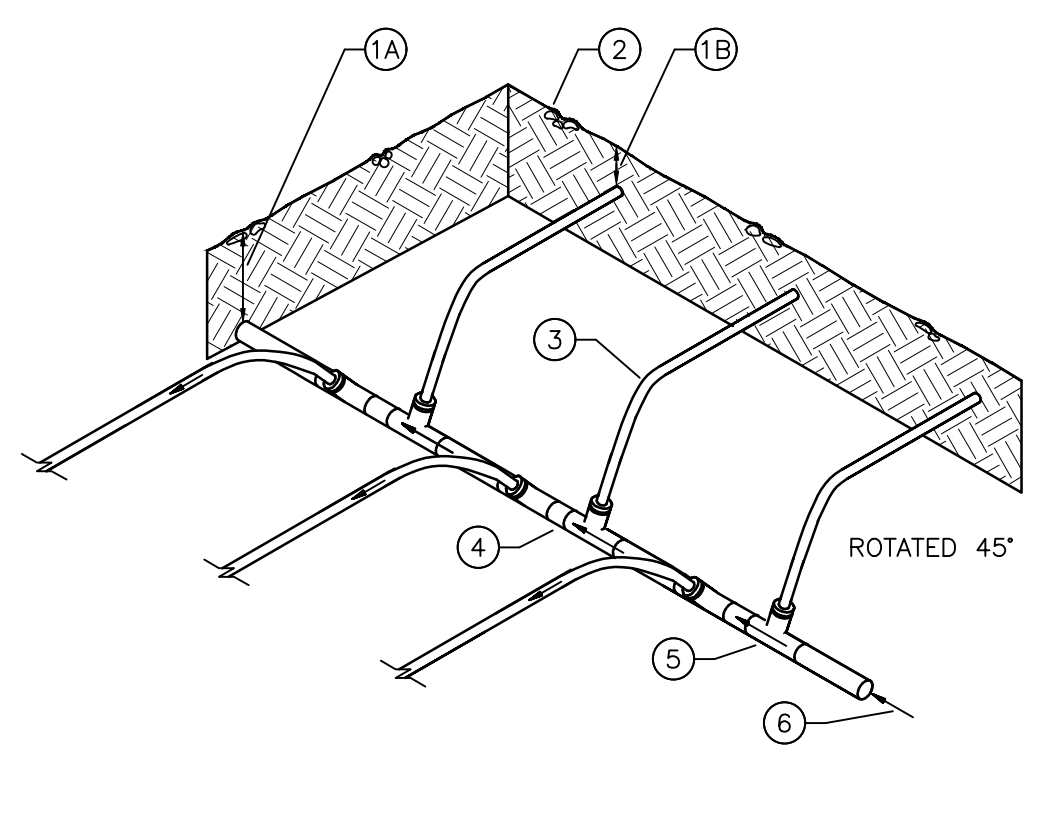


4 LATERAL TO DRIP FEED DETAILS  
 NOT TO SCALE

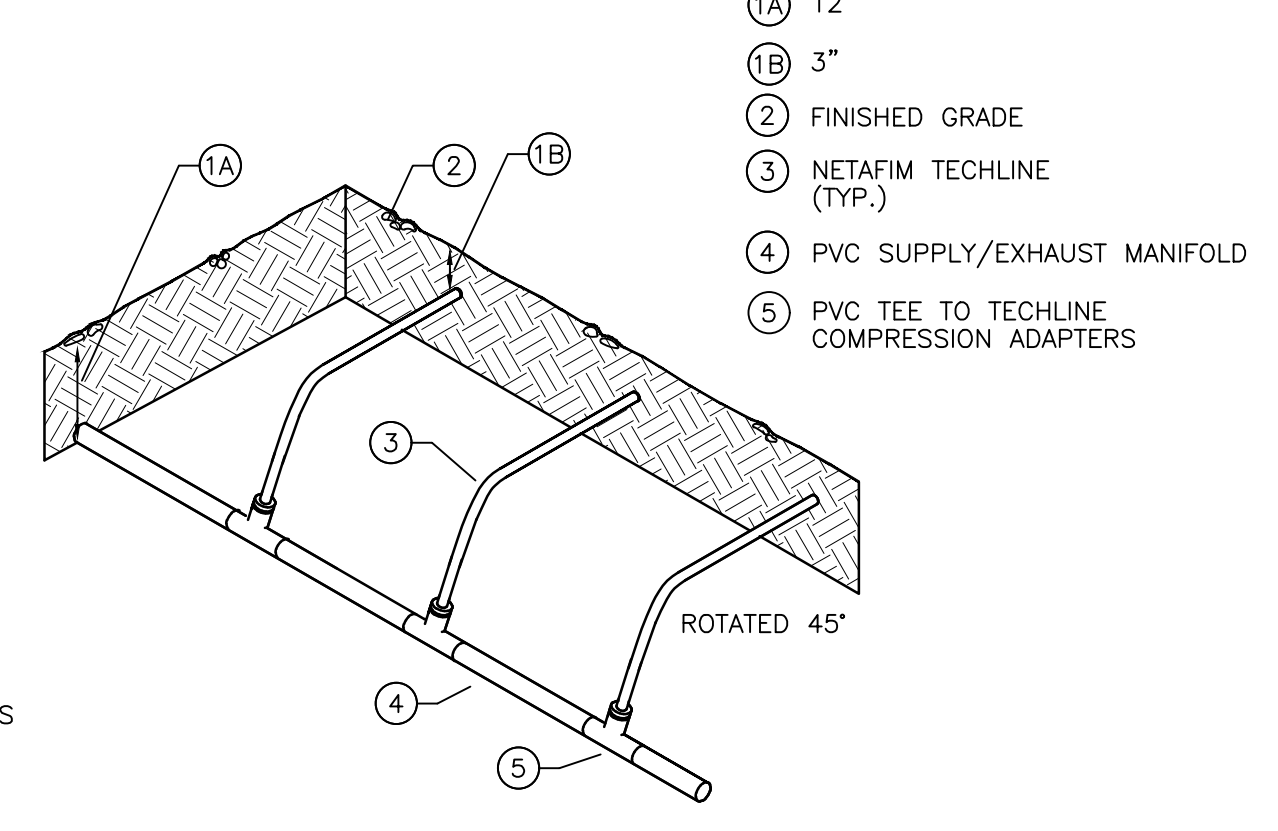


5 ZONE CONTROL  
 3" = 1'-0" 32 8413.46-03

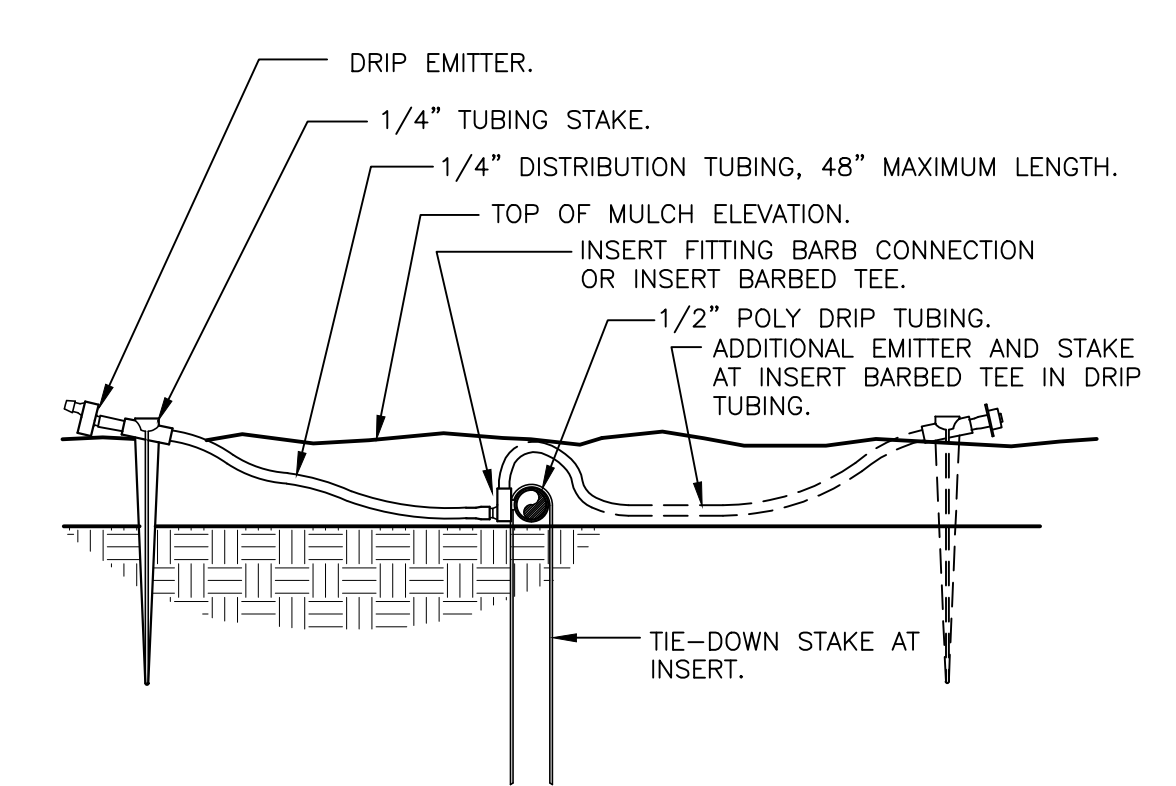

6 DRIP EMITTER AT 1/4" TUBING  
 3" = 1'-0" 32 8413.13-13

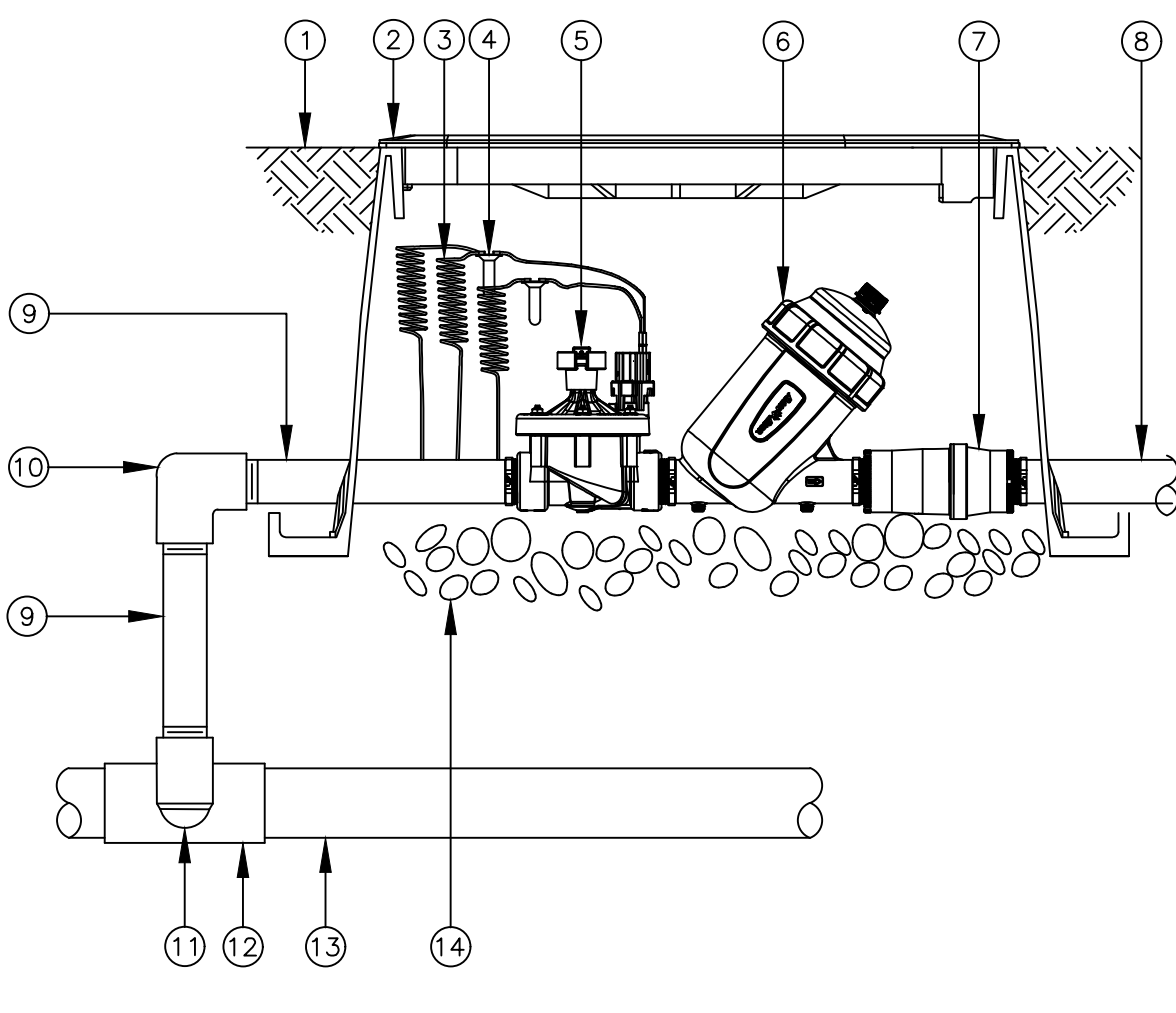

7 DRIP ZONE CONTROL VALVE KIT IN JUMBO VALVE BOX  
 3" = 1'-0" 32 8413.49-03

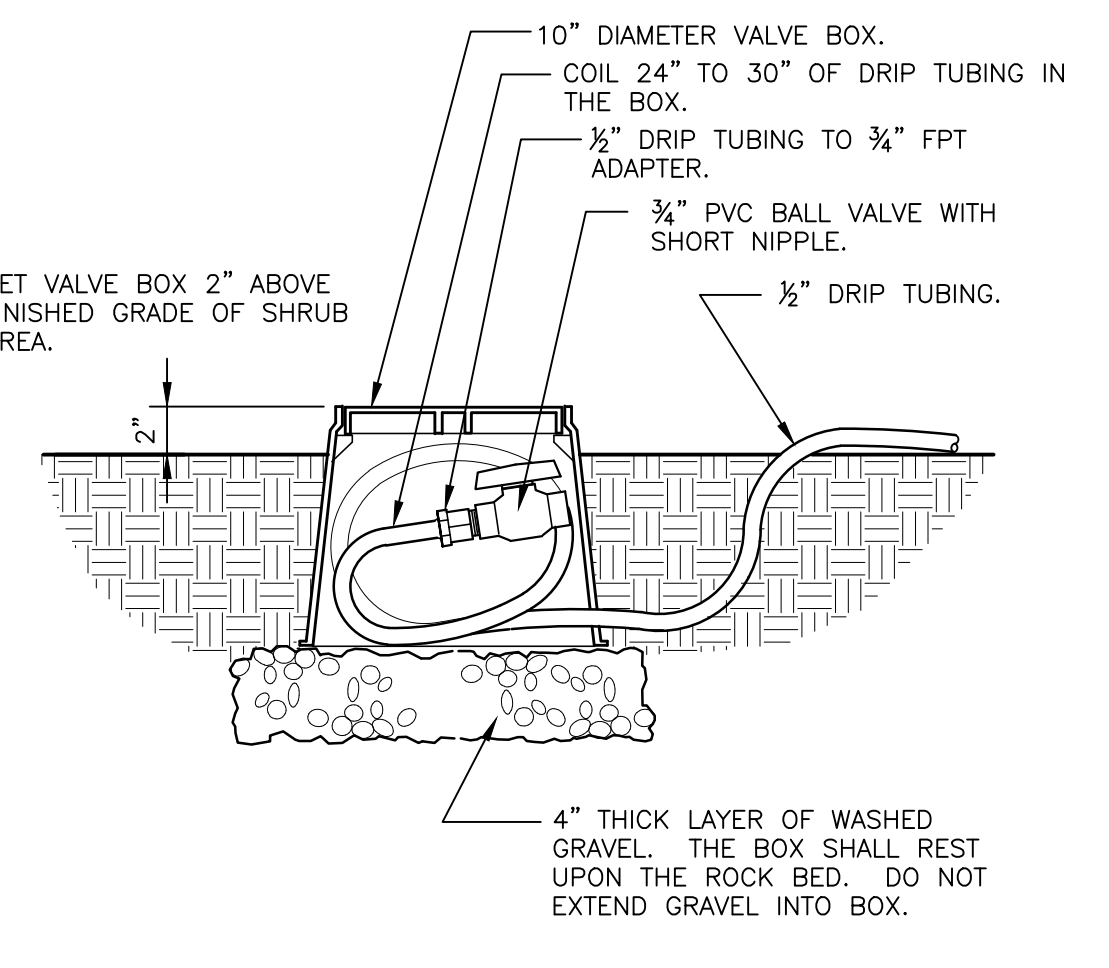

8 DRIP FLUSH VALVE  
 1 1/2" = 1'-0" 32 8413.49-03

PRINTED COPIES OF THIS DOCUMENT ARE NOT CONSIDERED SIGNED AND SEALED AND THE SIGNATURE MUST BE VERIFIED ON ANY ELECTRONIC COPIES.  
 THIS ITEM HAS BEEN DIGITALLY SIGNED AND SEALED BY MATTHEW VINCENT WISNIEWSKI LAG667406 ON DATE ADJACENT TO SEAL.  
 THE SEAL APPEARING ON THIS DOCUMENT WAS AUTHORIZED BY MATTHEW VINCENT WISNIEWSKI LAG667406 ON THE DATE ADJACENT TO THE SEAL.

**Kimley-Horn**

© 2021 KIMLEY-HORN AND ASSOCIATES, INC.  
 355 ALHAMBRA CIRCLE, SUITE 1400, CORAL GABLES, FL 33134  
 PHONE: 305-673-2025  
 WWW.KIMLEY-HORN.COM REGISTRY 696

REGISTERED PROFESSIONAL ENGINEER  
 STATE OF FLORIDA  
 No. LA6667406  
 DATE 11/17/2021

KHA PROJECT  
 143228000

DATE  
 JULY 2021

SCALE AS SHOWN

DESIGNED BY  
 NW

DRAWN BY  
 CT

CHECKED BY  
 NW

IRREGIGATION DETAILS

IRC LANDFILL  
 PREPARED FOR  
 INDIAN RIVER COUNTY  
 INDIAN RIVER COUNTY

SHEET NUMBER  
**L-353**

REVISIONS

| No. | DATE | BY |
|-----|------|----|
|     |      |    |

**Sunshine811**

Call 811 or www.sunshine811.com two full business days before digging to have utilities located and marked.  
 Check positive response codes before you dig!


**GENERAL MECHANICAL NOTES:**

- ALL WORK SHALL BE DONE IN ACCORDANCE WITH 2020 FLORIDA BUILDING CODE 7TH EDITION - MECHANICAL TO THE BEST OF THE ENGINEER'S KNOWLEDGE. ALL DRAWINGS AND SPECIFICATIONS COMPLY WITH MINIMUM EXISTING CODES.
- CONTRACTOR SHALL PROVIDE ALL WORK CUSTOMARILY INCLUDED IF NOT SPECIFICALLY CALLED FOR ON THE PLANS. ALL WORK SHALL BE IN ACCORDANCE WITH BASE BUILDING PLANS AND SPECIFICATIONS.
- CONTRACTOR TO CONSULT BUILDING OWNER FOR BUILDING STANDARDS AND CONTROL SEQUENCES.
- CONTRACTOR SHALL CONFIRM THE EXISTENCE OF FIRE DAMPERS AS REQUIRED BY CODE IN ANY DUCT PENETRATING EXISTING FIRE RATED PARTITIONS.
- CONTRACTOR SHALL VISIT THE SITE AND FAMILIARIZE THEMSELV WITH ALL DETAILS OF THE WORK AND EXISTING CONDITIONS. THE INTENT OF THESE NOTES AND MECHANICAL NOTES ON DRAWINGS IS TO CLARIFY THE SCOPE OF WORK AND ALERT CONTRACTOR OF EXISTING CONDITIONS. CONTRACTOR SHALL VERIFY ALL CLEARANCES BEFORE FABRICATION OF DUCTWORK AND PROVIDE ADDITIONAL OFFSET AND/OR CHANGES IN DUCT SIZES TO MEET FIELD CONDITIONS AND COORDINATE WITH ELECTRICAL AND PLUMBING SUBCONTRACTOR BEFORE ANY CONSTRUCTION WORK.
- CONTRACTOR SHALL PROVIDE A COPY OF THE INDEPENDENT TEST AND BALANCE REPORT AT THE FINAL INSPECTION. CONTRACTOR SHALL ALSO PROVIDE ALL REPORTS AS REQUIRED BY THE SPECIFICATIONS.
- THE GENERAL CONTRACTOR IS RESPONSIBLE FOR ALL TRADES INSTALLATION SCHEDULES. FIXED WORK SUCH AS DUCTWORK AND PLUMBING SHALL BE INSTALLED PRIOR TO ANY TRADE WORK THAT CAN BE EASILY RELOCATED OR OFFSET SUCH AS ELECTRICAL CONDUITS AND SMALL WATER LINES, ETC.
- CONTRACTOR SHALL REVIEW STRUCTURAL DRAWINGS BEFORE INSTALLATION TO AVOID ANY BEAM CONFLICTS AND COORDINATE PIPING AND HVAC DUCTWORK ACCORDINGLY.
- BALANCE AIR DISTRIBUTION SYSTEMS TO QUANTITIES AS INDICATED ON DRAWINGS.
- ALL SUPPLY TAKE-OFFS ARE CONNECTED TO HARD TRUNK DUCT WITH SPIN-IN FITTING (WITH MANUAL DAMPER) OF SIZE EQUAL TO DIFFUSER INLET AND DUCT CONNECTION. FLEXIBLE DUCT SHALL BE STRAIGHT WITH NO SAGS OR EXCESS DUCT. TOTAL TURNS SHALL NOT EXCEED 135 DEGREES. FLEX CONNECTIONS ARE NOT TO EXCEED 8 FEET IN LENGTH. PROVIDE HARD DUCT FOR OVER 8 FEET OR AS SPECIFICALLY CALLED FOR ON THE PLANS. THERMA-FLEX OR EQUAL INSULATED FLEX DUCT CONFORMING TO NFPA-90A AND UL 181 FOR "AIR DUCT CONNECTOR."
- ALL EXHAUST VENTS MUST BE AT LEAST 10' FROM ANY OUTSIDE AIR INTAKE. CONTRACTOR TO ADJUST VENTS ACCORDINGLY.
- ALL DUCT SIZES INDICATED ON DRAWINGS ARE INSIDE CLEAR DIMENSIONS.
- ALL DUCTWORK SHALL BE FIBERBOARD WITH 1.5" THICK INSULATION, EXCLUDING FLEX DUCT CONNECTIONS. ALL FLEXIBLE DUCT SHALL BE ATCO BRAND (CLASS 1) WITH AN INSULATION VALUE OF R8. ALL JOINTS MUST BE MECHANICALLY FASTENED AND SEALED TO 100% CLOSURE. METHODS FOR ATTACHMENT AND SEALING SHALL BE APPROVED METHOD AS STATED IN FBCM TABLE 603 AND SECTIONS 603.1 THRU 603.17. ALL DUCTWORK CONSTRUCTION SHALL MEET SECTION C403 OF THE FBC ENERGY CONSERVATION.
- ALL CEILING MOUNTED DIFFUSERS SHALL BE 4-WAY THROW UNLESS OTHERWISE NOTED.
- CONTRACTOR SHALL PROVIDE CONCEALED DAMPER REGULATOR OR ACCESS PANEL OF ALL MANUAL VOLUME DAMPERS/SPIN-IN DAMPERS ABOVE HARD CEILINGS OR OTHERWISE INACCESSIBLE AREAS ABOVE CEILING.
- IN GENERAL, PLANS AND DIAGRAMS ARE SCHEMATIC ONLY AND SHOULD NOT BE SCALED.
- COORDINATE AIR DEVICE LOCATIONS WITH LIGHTING FIXTURES.
- PROVIDE ADDITIONAL DUCTWORK AND PIPING SUPPORTS ON BOTH SIDES AND WITHIN 18" OF FIRE RATED WALL. DUCTWORK OR PIPING SHALL NOT BE SUPPORTED FROM ANY FIRE RATED WALL.
- TURNING VANES SHALL BE PROVIDED IN ALL SUPPLY DUCT RECTANGULAR ELBOWS WITH ANGLES BETWEEN 15 DEGREES AND LESS THAN 90 DEGREES PER SMACNA.
- DUCTWORK SHALL NOT BE SUPPORTED BY THE CEILING OR CEILING SUSPENSION SYSTEM.
- ALL WALL MOUNTED THERMOSTATS AND/OR TEMPERATURE SENSORS SHALL BE INSTALLED AT AN ELEVATION OF 48" A.F.F. ALL THERMOSTATS NEED TO BE RECALIBRATED BY A MECHANICAL CONTRACTOR IF THEY ARE RELOCATED. THERMOSTATS SHALL BE FASTENED BY PLASTIC SHIELD AND SCREWS.
- OUTSIDE AIR SUPPLY RATES CONFORM TO ASHRAE 62-2016 STANDARDS.
- UNLESS OTHERWISE NOTED, INSTALL DUCTWORK AS HIGH AS POSSIBLE, TIGHT TO BOTTOM OF STRUCTURE. COORDINATE DUCT ELEVATION WITH WATER PIPING, SANITARY DRAINS AND MAJOR ELECTRICAL CONDUITS.
- PROVIDE ALL SUPPLEMENTARY STEEL REQUIRED TO INSTALL MECHANICAL EQUIPMENT AND MATERIALS.
- INSTALL AND INSULATE REFRIGERANT PIPING AS PER MANUFACTURER.
- CONDENSATE PIPING SHALL BE COPPER. PROVIDE A TRAP IN ALL CONDENSATE PIPING LOCATED AT THE AIR HANDLING UNIT. INSULATE ALL CONDENSATE LINES WITH 1/2" THICK CLOSED CELL FOAM INSULATION. SLOPE CONDENSATE LINES AT 1/8" PER FOOT MINIMUM.
- INSTALLATION OF MECHANICAL EQUIPMENT SHALL COMPLY WITH THE MANUFACTURER'S SPECIFICATIONS AND CLEARANCE REQUIREMENTS.
- MATCH DIFFUSER MOUNTING FRAME WITH CEILING TYPE.
- ALL DASHED LINED EQUIPMENT AND DUCTWORK ARE EXISTING. ALL SOLID LINED EQUIPMENT AND DUCTWORK ARE NEW UNDER TENANT WORK EXCEPT FOR DIFFUSERS.
- FOR DUCTWORK PENETRATING ONE HOUR FIRE RATED WALL: THE ENTIRE DUCT SYSTEM TO BE CONSTRUCTED PER SMACNA STANDARDS WITH A MINIMUM OF 26 GAUGE STEEL DUCT AND SHALL CONTINUE IN THE HORIZONTAL DIRECTION WITHOUT ANY GRILLE OR OPENING FOR NOT LESS THAN 5'-0" FROM THE WALL AND DUCT SHALL NOT EXCEED SQUARE INCH REQUIREMENTS OF LOCAL CODE, OTHERWISE A FIRE DAMPER SHALL BE PROVIDED.
- PENETRATIONS THROUGH SMOKE OR FIRE RATED ASSEMBLIES: PENETRATIONS FOR PIPES, CONDUITS OR OTHER PURPOSES THROUGH ASSEMBLIES (FLOORS, ROOF, WALLS PARTITIONS, ETC.) WITH A REQUIRED FIRE RESISTANCE RATING SHALL BE SEALED TO THE PENETRATING MEMBER IN AN APPROVED MANNER WHICH MAINTAINS THE REQUIRED FIRE RESISTANCE RATING OF THE ASSEMBLY.
- TO THE BEST OF THE ENGINEER'S KNOWLEDGE, THE PLANS AND SPECIFICATIONS COMPLY WITH THE APPLICABLE MINIMUM BUILDING CODES AND THE APPLICABLE FIRE SAFETY STANDARDS AS DETERMINED BY THE LOCAL AUTHORITY IN ACCORDANCE WITH SECTION AND CHAPTER 633, FLORIDA STATUTES. FBC 110.8.4.4 2020.

**FMC TABLE 403.3.11 VENTILATION REQUIREMENTS**

|  |                |  |                 |
|--|----------------|--|-----------------|
| <b>REQUIRED OUTSIDE AIR</b>  |                |  |                 |
| CONFERENCE: 12 PEOPLE X 5 CFM/PERSON + 329 SQ FT X 0.06 CFM/SQ FT = 80 CFM                                     |                |  |                 |
| OFFICE: 2 PEOPLE X 5 CFM/PERSON + 232 SQ FT X 0.06 CFM/SQ FT = 24 CFM  |                |  |                 |
| <b>AVAILABLE OUTSIDE AIR</b>   |                |  |                 |
| NEW MAIN AIR HANDLER SERVING THE CONDITIONED SPACES ARE DESIGNED TO DELIVER A TOTAL OF 150 CFM OF OUTSIDE AIR. |                |  |                 |
| <b>OUTSIDE AIR</b>   |                |  |                 |
| AHU-1  | 150 CFM        |  |                 |
| <b>TOTAL OUTSIDE AIR</b>   | <b>150 CFM</b> | <b>TOTAL</b>                           |                 |
|  |                | OUTSIDE AIR                            | + 150 CFM       |
|  |                | EXHAUST                                | - 140 CFM       |
| <b>EXHAUST AIR</b>   |                |  |                 |
| EF-1   | 70 CFM         |  |                 |
| EF-2   | 70 CFM         |  |                 |
| <b>TOTAL EXHAUST</b>   | <b>140 CFM</b> | <b>TOTAL CONDITIONED AREA PRESSURE</b> | <b>+ 10 CFM</b> |

**AIR BALANCE**

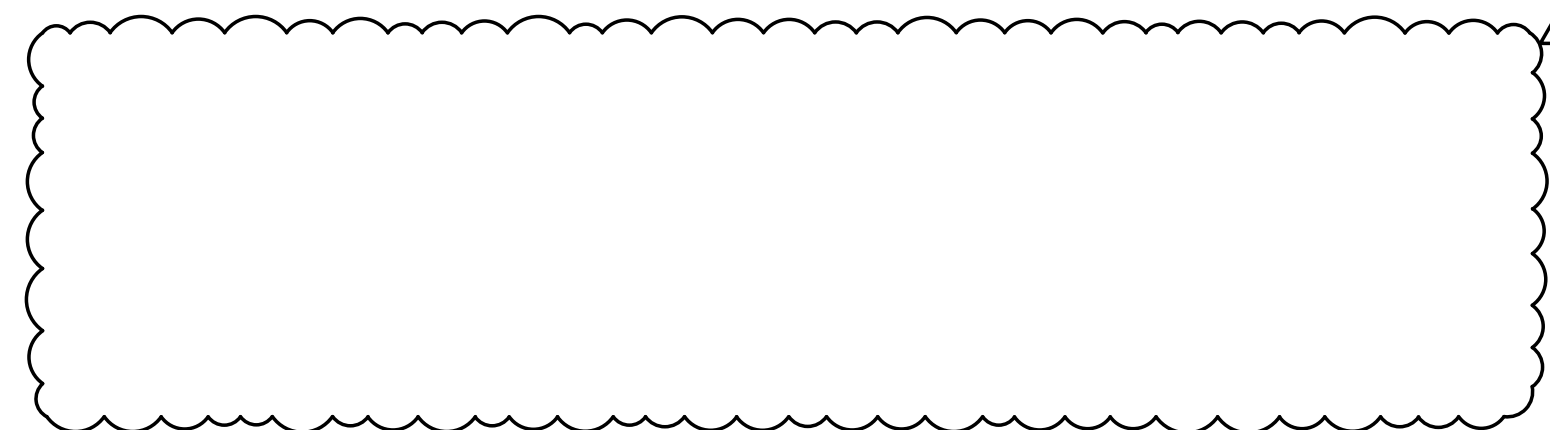

| MECHANICAL LEGEND |                                     |
|-------------------|-------------------------------------|
| MVD               | MANUAL VOLUME DAMPER                |
| EXIST.            | EXISTING                            |
| RA                | RETURN AIR                          |
| OA                | OUTSIDE AIR                         |
|                   | DUCT REDUCTION IN DIRECTION OF FLOW |
|                   | DUCT MOUNTED SMOKE DETECTOR         |
|                   | MOTORIZED DAMPER                    |
|                   | RETURN (OR EXHAUST) GRILLE          |
|                   | SUPPLY DIFFUSER                     |
| ETR               | EXISTING TO REMAIN                  |
| RE                | RELOCATE EXISTING                   |
| ER                | EXISTING RELOCATED                  |
|                   | FIRE DAMPER                         |
|                   | EXISTING FIRE DAMPER                |
|                   | SMOKE TIGHT DUCT SEAL               |
|                   | SMOKE DAMPER                        |
|                   | FIRE/SMOKE DAMPER                   |
|                   | NEW HARD DUCT                       |
|                   | EXISTING HARD DUCT                  |
|                   | NEW FLEXIBLE DUCT                   |
|                   | EXISTING FLEXIBLE DUCT              |
|                   | THERMOSTAT                          |
|                   | NEW CONNECTION                      |
|                   | BACKDRAFT DAMPER                    |
|                   | REMOTE TEST STATION                 |

C.O.A. #26759

**GILSON ARGENTI**  
ENGINEERING

1408 N WESTSHORE BLVD,  
STE. 506 TAMPA, FL 33607

WORKWITHWG.COM  
813.855.3330

**CMK Design Studio**

Planning & Design of the Built Environment

6822 22nd Ave. N. #148  
St. Petersburg, Florida 33710  
Ph: 813.362.6381

FL LIC. NO.: AA2002003  
marcos@cmkdesignstudio.com

**INDIAN RIVER COUNTY LANDFILL  
HOUSEHOLD HAZARDOUS WASTE  
AND RECYCLING FACILITY**  
 Indian River County, Florida

| NO. | REVISIONS          | DATE       |
|-----|--------------------|------------|
| 1   | FIELD COORDINATION | 05.15.2021 |
| 2   | FIELD COORDINATION | 11.05.2021 |

JOB NO.  
**2016**

ISSUE DATE:  
07/07/2021


DRAWN BY:  
WG

SHEET TITLE  
MECHANICAL NOTES

SHEET NO.  
**M101**

PERMIT SET




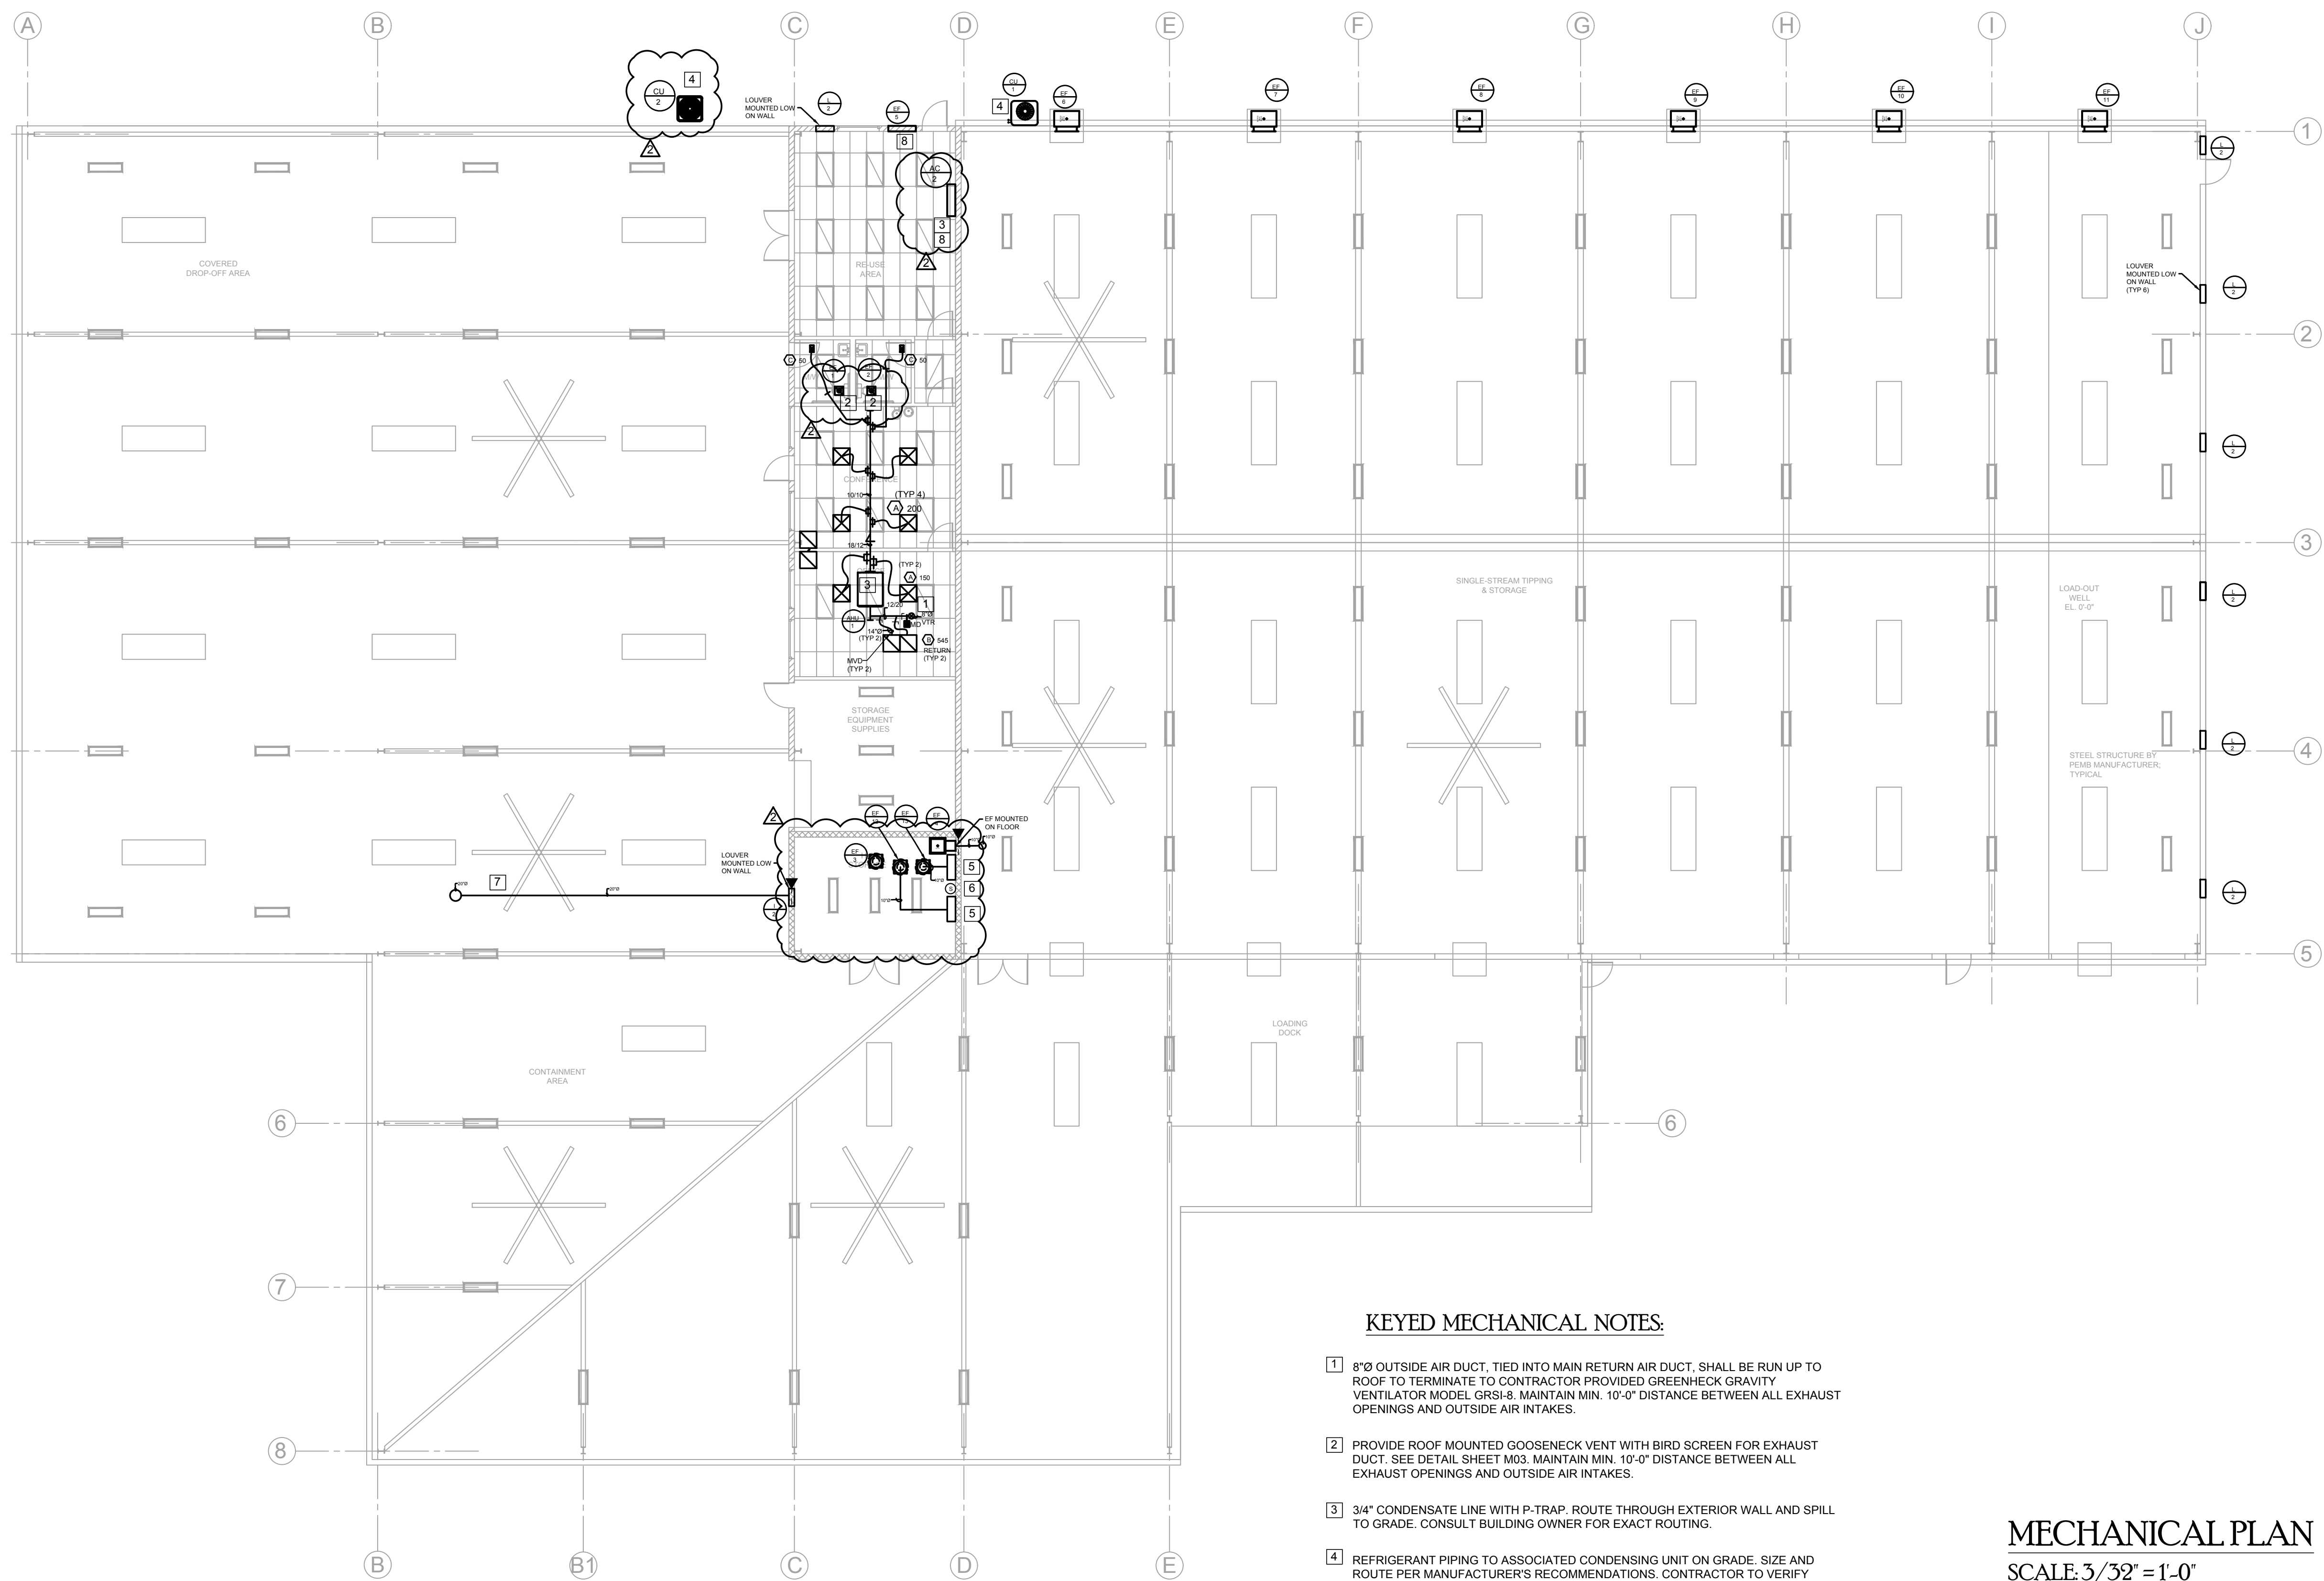

**KEYED MECHANICAL NOTES:**

- 1 8"Ø OUTSIDE AIR DUCT, TIED INTO MAIN RETURN AIR DUCT, SHALL BE RUN UP TO ROOF TO TERMINATE TO CONTRACTOR PROVIDED GREENHECK GRAVITY VENTILATOR MODEL GRSI-8. MAINTAIN MIN. 10'-0" DISTANCE BETWEEN ALL EXHAUST OPENINGS AND OUTSIDE AIR INTAKES.
- 2 PROVIDE ROOF MOUNTED GOOSENECK VENT WITH BIRD SCREEN FOR EXHAUST DUCT. SEE DETAIL SHEET M03. MAINTAIN MIN. 10'-0" DISTANCE BETWEEN ALL EXHAUST OPENINGS AND OUTSIDE AIR INTAKES.
- 3 3/4" CONDENSATE LINE WITH P-TRAP. ROUTE THROUGH EXTERIOR WALL AND SPILL TO GRADE. CONSULT BUILDING OWNER FOR EXACT ROUTING.
- 4 REFRIGERANT PIPING TO ASSOCIATED CONDENSING UNIT ON GRADE. SIZE AND ROUTE PER MANUFACTURER'S RECOMMENDATIONS. CONTRACTOR TO VERIFY ROUTE AND CONSULT BUILDING OWNER FOR EXACT LOCATION OF CONDENSING UNIT.
- 5 CONTRACTOR TO DUCT 10" ROUND EXHAUST FROM ROOF MOUNTED EXHAUST FAN TO VENDOR PROVIDED BULKING HOOD. CONTRACTOR TO CONSULT VENDOR FOR FUTURE CONNECTIONS TO BULKING HOOD.
- 6 CONTRACTOR TO PROVIDE H2 SENSOR AND MONITORING SYSTEM. MOUNT SENSOR ABOVE BULKING HOODS' EXHAUST INTAKE.
- 7 CONTRACTOR TO PROVIDE INTAKE WITH 40 FEET MINIMUM FROM H2 STORAGE. CONTRACTOR TO RUN DUCTWORK TIGHT TO STRUCTURE BEFORE ROOF PENETRATION.
- 8 WHEN SWITCH IS TURNED ON, EF-5 SHALL BE ENERGIZED AND AC-2 SHALL TURN OFF. WHEN SWITCH IS TURNED OFF EF-5 SHALL DE-ENERGIZE AND AC-2 WILL TURN ON.

**MECHANICAL PLAN**  
SCALE: 3/32" = 1'-0"

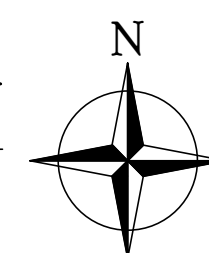

C.O.A. #26759

**WILSON ARGENTI**  
ENGINEERING

1408 N WESTSHORE BLVD,  
STE. 506 TAMPA, FL 33607  
WORKWITHWG.COM  
813.855.3330

| NO. | REVISIONS          | DATE       |
|-----|--------------------|------------|
| 1   | FIELD COORDINATION | 05.15.2021 |
| 2   | FIELD COORDINATION | 11.05.2021 |
|     |                    |            |
|     |                    |            |
JOB NO.  
**2016**

ISSUE DATE:  
07/07/2021

DRAWN BY:  
WG

SHEET TITLE  
MECHANICAL PLAN

SHEET NO.  
**M102**

**PERMIT SET**

**CMK Design Studio, Inc.**  
Planning & Design of the Built Environment

6822 22nd Ave. N. #148  
St. Petersburg, Florida 33710  
Ph: 813.362.6381

FL LIC. NO.: AA26002603  
marcos@cmkdesignstudio.com

Drawing Not Valid Unless Signed, Sealed & Dated By Registered Professional

**INDIAN RIVER COUNTY LANDFILL HOUSEHOLD HAZARDOUS WASTE AND RECYCLING FACILITY**

Indian River County, Florida

### SPLIT SYSTEM AIR HANDLING UNIT SCHEDULE

REMARKS:  
ALL AHUS TO UTILIZE R-410A REFRIGERANT AND TO HAVE MINIMUM 13.0 SEER RATING

| MARK AHU NO. | MIN. O.A. CFM | MAX. O.A. CFM | FAN DATA |             |          | COOLING DATA |        |               |               | ACCESSORY HEATER DATA |      |       |      | ELECTRICAL DATA |       |     | WEIGHT (LBS) | BASIS OF DESIGN | SEER                 | ACCESSORIES |          |
|--------------|---------------|---------------|----------|-------------|----------|--------------|--------|---------------|---------------|-----------------------|------|-------|------|-----------------|-------|-----|--------------|-----------------|----------------------|-------------|----------|
|              |               |               | CFM      | EXT. SP. WG | MOTOR HP | EDB °F       | EWB °F | TOTAL CAP MBH | SENS. CAP MBH | V/φ                   | (KW) | STEPS | MCA  | MOCP            | V/φ   | MCA |              |                 |                      |             | MOCP     |
| AHU-1        | 0             | 150           | 1200     | 0.5         | 0.5      | 80           | 67     | 34            | 27.4          | 460/3                 | 10   | 1     | 19.3 | 20              | 208/1 | 5.1 | 15           | 163             | CARRIER FV4CMB006L00 | 14.0        | ①②③④⑤⑥⑦⑧ |

ACCESSORIES:  
 ① AUXILIARY DRAIN PAN WITH FLOAT SWITCH. UNIT TO SHUT DOWN UPON WATER DETECTION. CONDENSATE DRAIN SHALL BE FULL SIZE FROM UNIT. PROVIDE CONDENSATE PUMP AND ROUTE CONDENSATE TO NEAREST BASE BUILDING CONDENSATE RISER.  
 ② SINGLE POINT ELECTRICAL CONNECTION.  
 ③ 1" DISPOSABLE FILTERS.  
 ④ PROGRAMMABLE DIGITAL THERMOSTAT.  
 ⑤ DISCONNECTS BY DIVISION 16.  
 ⑥ VARIABLE SPEED FAN.  
 ⑦ PROVIDE WITH ACCESSORY DUCT HEATER WARREN WKF1005A  
 ⑧ PROVIDE RAWAL/APR DEVICE FOR CAPACITY CONTROL

### SPLIT SYSTEM CONDENSING UNIT SCHEDULE

REMARKS:  
 1. SIZE AND ROUTE REFRIGERANT LINES PER MANUFACTURER'S RECOMMENDATIONS.  
 2. COORDINATE EXACT LOCATION OF UNIT WITH OWNER.  
 3. ALL AHUS TO UTILIZE R-410A REFRIGERANT.

| MARK CU NO. | PAIR WITH | LOCATION | ELECTRICAL DATA |      |            | BASIS OF DESIGN      | WEIGHT (LBS) | ACCESSORIES |
|-------------|-----------|----------|-----------------|------|------------|----------------------|--------------|-------------|
|             |           |          | V/φ             | MCA  | MPS (amps) |                      |              |             |
| CU-1        | AHU-1     | GRADE    | 460/3           | 21.5 | 30         | CARRIER 24ABB336A006 | 170          | ①②          |

ACCESSORIES: ① DISCONNECTS BY DIVISION 16 ② PROVIDE WITH LOW AMBIENT CONTROLS

### AIR DISTRIBUTION SCHEDULE

REMARKS:  
 1. COORDINATE FRAME & BORDER TYPE WITH CEILING TYPE. REFER TO ARCHITECTURAL PLANS.  
 2. COORDINATE WITH BLDG MGT FOR BLDG STANDARDS.

| MARK | CFM     | NECK SIZE (INCHES) | FACE SIZE (INCHES) | BASIS OF DESIGN   | ACCESSORIES |
|------|---------|--------------------|--------------------|---|-------------|
| A    | 0-120   | 6"Ø                | 24"x24"            | SUPPLY DIFFUSER EQUAL TO TITUS MODEL PAS TO MATCH EXISTING. INSULATE BACK OF ALL DIFFUSERS.             |             |
|      | 121-250 | 8"Ø                | 24"x24"            |   |             |
|      | 251-350 | 10"Ø               | 24"x24"            |   |             |
|      | 351-450 | 12"Ø               | 24"x24"            |   |             |
| B    | 0-1600  | 22"x22"            | 24"x24"            | PERFORATED RETURN/TRANSFER GRILLE EQUAL TO TITUS PAR TO MATCH EXISTING. INSULATE BACK OF ALL DIFFUSERS. |             |
| C    | 0-120   | 6"Ø                | 11.75"x7.75"       | SUPPLY GRILLE EQUAL TO PRICE MODEL 640.   |             |

### FAN SCHEDULE

| MARK   | SERVICE               | LOCATION | CFM  | EXT. SP. WG | MOTOR HP | MOTOR V/φ | MAX RPM | DRIVE TYPE | WEIGHT  | INTERLOCK  | BASIS OF DESIGN    | ACCESSORIES |
|--|-----------------------|----------|------|-------------|----------|-----------|---------|------------|---------|------------|--------------------|-------------|
| EF-1   | RESTROOM              | CEILING  | 70   | 0.25        | 74.7 W   | 115/1     | 1400    | DIRECT     | 26 lbs  | LIGHTS     | COOK GEMINI GC-146 | ①②          |
| EF-2   | RESTROOM              | CEILING  | 70   | 0.25        | 74.7 W   | 115/1     | 1400    | DIRECT     | 26 lbs  | LIGHTS     | COOK GEMINI GC-146 | ①②          |
| EF-3   | H-2 STORAGE           | ROOF     | 1200 | 0.5         | .25      | 460/3     | 1725    | BELT       | 127 lbs | CONTINUOUS | COOK ACRU-B        | ①③④⑤⑩⑪⑫     |
| EF-4   | H-2 STORAGE           | WALL     | 400  | 0.25        | 0.25     | 460/3     | 1140    | BELT       | 282 lbs | CONTINUOUS | COOK SQI-HP        | ①③④⑤        |
| EF-5   | RE-USE AREA           | WALL     | 850  | 0.25        | 0.25     | 460/3     | 1140    | BELT       | 64 lbs  | SWITCH     | COOK ACW-B         | ①③④⑤        |
| EF-6<br>EF-7<br>EF-8<br>EF-9<br>EF-10<br>EF-11 | SINGLE STREAM TIPPING | WALL     | 6850 | 0.25        | 0.948    | 460/3     | 840     | BELT       | 572     | SWITCH     | COOK AWB           | ①⑬⑭⑮        |
| EF-12<br>EF-13                                 | H-2 STORAGE           | ROOF     | 600  | 1.0         | .293     | 460/3     | 1538    | BELT       | 106 lbs | SWITCH     | COOK ACE-B         | ①③④⑤⑩⑪⑫△    |

ACCESSORIES:  
 ① SPEED CONTROLLER ⑥ OSHA BELT GUARD ⑬ MANUFACTURER'S ROOF CURB + BIRD SCREEN ⑮ MOTORIZED DAMPER  
 ② MOTOR WITH THERMAL OVERLOAD ⑦ INLET SAFETY SCREEN ⑭ MIAMI-DADE HURRICANE RATED CONSTRUCTION  
 ③ EXPLOSION PROOF MOTOR ⑧ OSHA BELT GUARD ⑮ PREMIUM EFFICIENCY MOTOR  
 ④ BACKDRAFT DAMPER ⑨ VIBRATION ISOLATORS ⑯ GRAVITY SHUTTER  
 ⑤ EXPLOSION PROOF DISCONNECT ⑩ AMCA A CONSTRUCTION ⑰ WALL COLLAR

### LOUVER SCHEDULE

| MARK | DESCRIPTION  |
|------|--|
| L-1  | 12"x12" INTAKE LOUVER. COOK MODEL SG-10 FINISH TBD BY ARCH |
| L-2  | 26"x26" INTAKE LOUVER. COOK MODEL SG-24 FINISH TBD BY ARCH |

### DUCTLESS FAN COIL UNIT SCHEDULE

| MARK A/C # | FAN DATA |             |          | COIL DATA |        |        |               | FILTER DATA    |      | BASIS OF DESIGN       | ELECTRIC MCA | ELECTRICAL MOCP | REMARKS |
|------------|----------|-------------|----------|-----------|--------|--------|---------------|----------------|------|-----------------------|--------------|-----------------|---------|
|            | CFM      | EXT. SP. WG | MOTOR HP | V/φ       | EDB °F | EWB °F | TOTAL CAP MBH | SENS. CAP. MBH | TYPE |                       |              |                 |         |
| 2          | 775      | -           | -        | 230/1     | 80     | 67     | 24.0          | -              | -    | MITSUBISHI PKA-A24HA4 | 1.0          | SEE CU          | ①②③④    |

① PROVIDE DIGITAL THERMOSTAT FOR EACH UNIT ② PROVIDE LOW AMBIENT COOLING. ③ POWER FEED FROM CONDENSING UNIT  
 ④ PROVIDE CONDENSATE PUMP ⑤ CONDENSATE TO BE ROUTED TO EXTERIOR

### DUCTLESS AIR COOLED CONDENSING UNIT SCHEDULE

| MARK CU # | LOCN.    | PAIRED WITH A/C#... | V/φ   | ELECTRICAL DATA |      | BASIS OF DESIGN        | REMARKS |
|-----------|----------|---------------------|-------|-----------------|------|------------------------|---------|
|           |          |                     |       | MCA             | MOCP |                        |         |
| 2         | ON GRADE | AC-1                | 230/1 | 18              | 30   | MITSUBISHI PUY-A24NHA4 | ①②③     |

① 95 OUT DOOR AIR TEMP. ② ROUTE REFRIGERANT LINE TO ROOF.  
 ③ CONDENSING UNIT ON ROOF. LOCATION TO BE COORDINATED WITH BUILDING OWNER.




INDIAN RIVER COUNTY LANDFILL  
 HOUSEHOLD HAZARDOUS WASTE  
 AND RECYCLING FACILITY  
 Indian River County, Florida

| NO. | REVISIONS          | DATE       |
|-----|--------------------|------------|
| △   | FIELD COORDINATION | 05.15.2021 |
| △   | FIELD COORDINATION | 11.05.2021 |


JOB NO.  
**2016**  
 ISSUE DATE:  
 07/07/2021  
 DRAWN BY:  
 WG

SHEET TITLE  
 MECHANICAL SCHEDULES  
 SHEET NO.  
**M103**


PERMIT SET

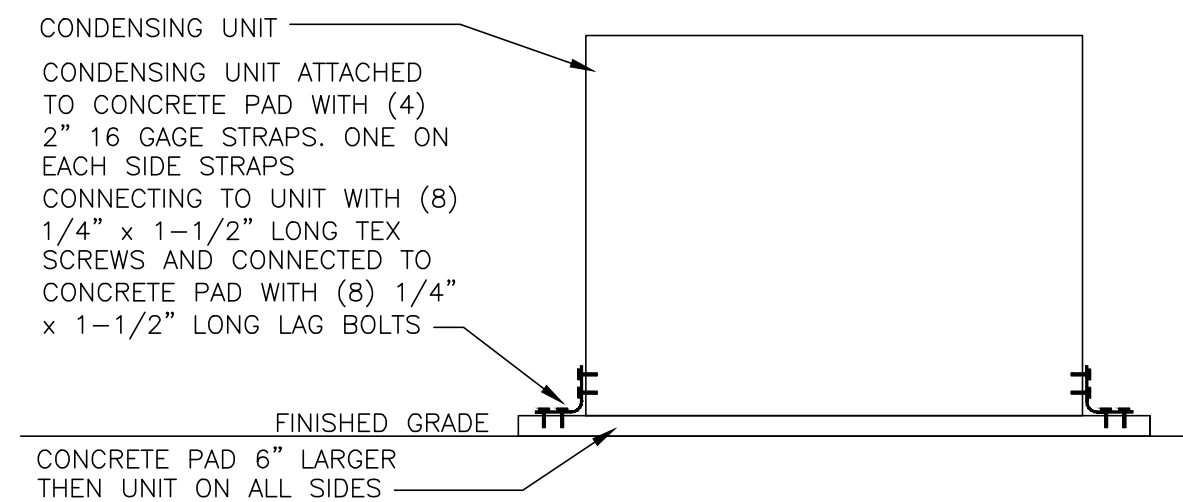


**CONDENSING UNIT MOUNTED DETAIL**  
NTS

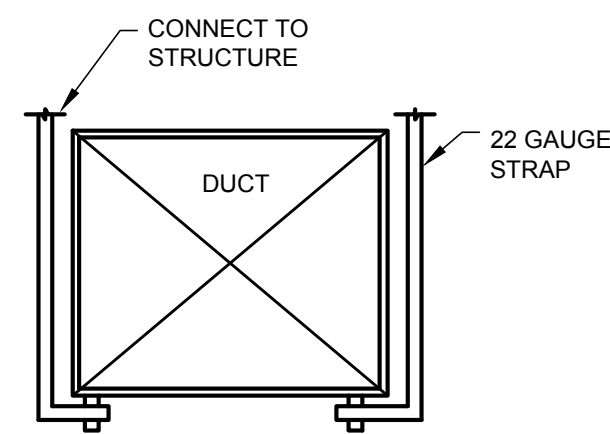


**DUCT SUPPORT DETAIL**  
NTS

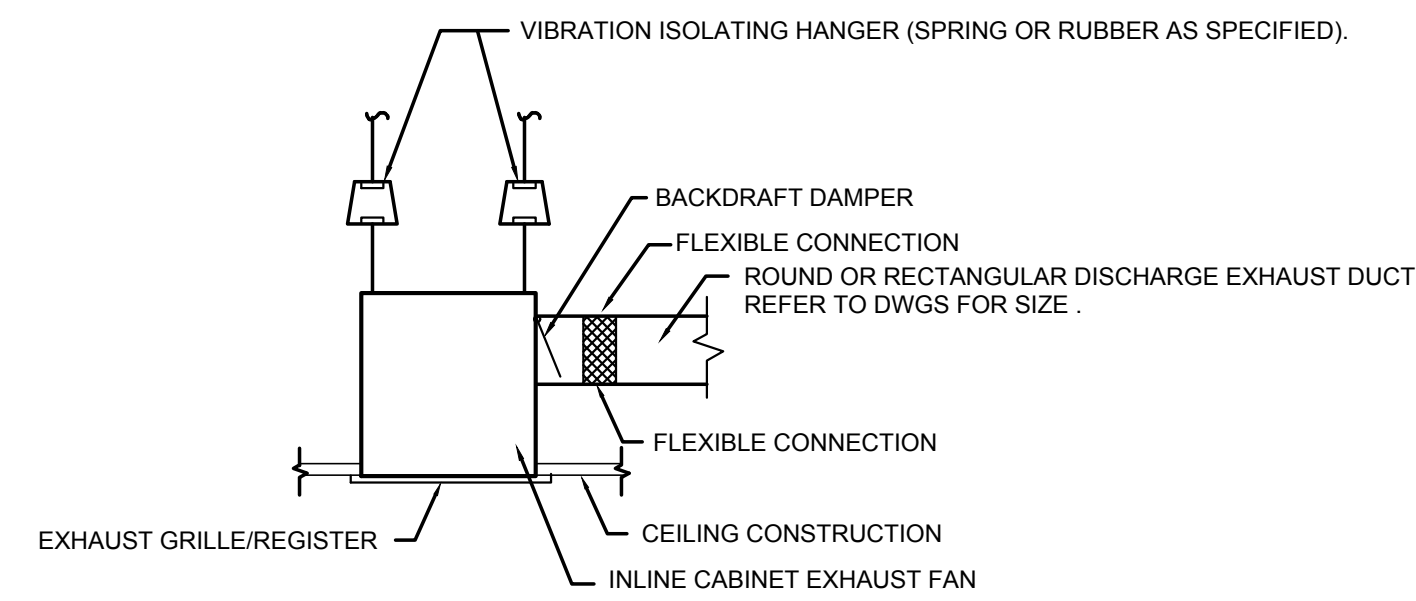


**CABINET EXHAUST FAN DETAIL**  
NTS

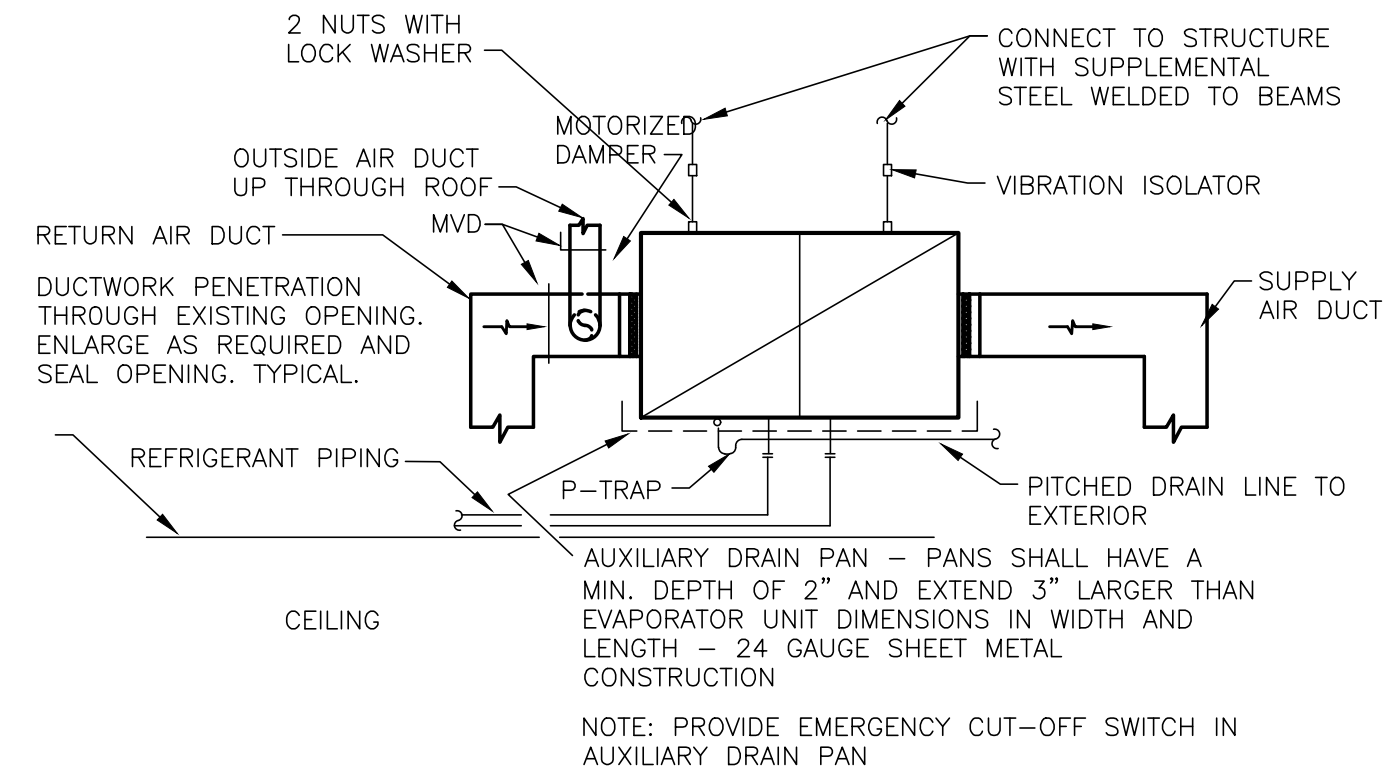


**AIR HANDLING UNIT INSTALLATION DETAIL**  
NTS

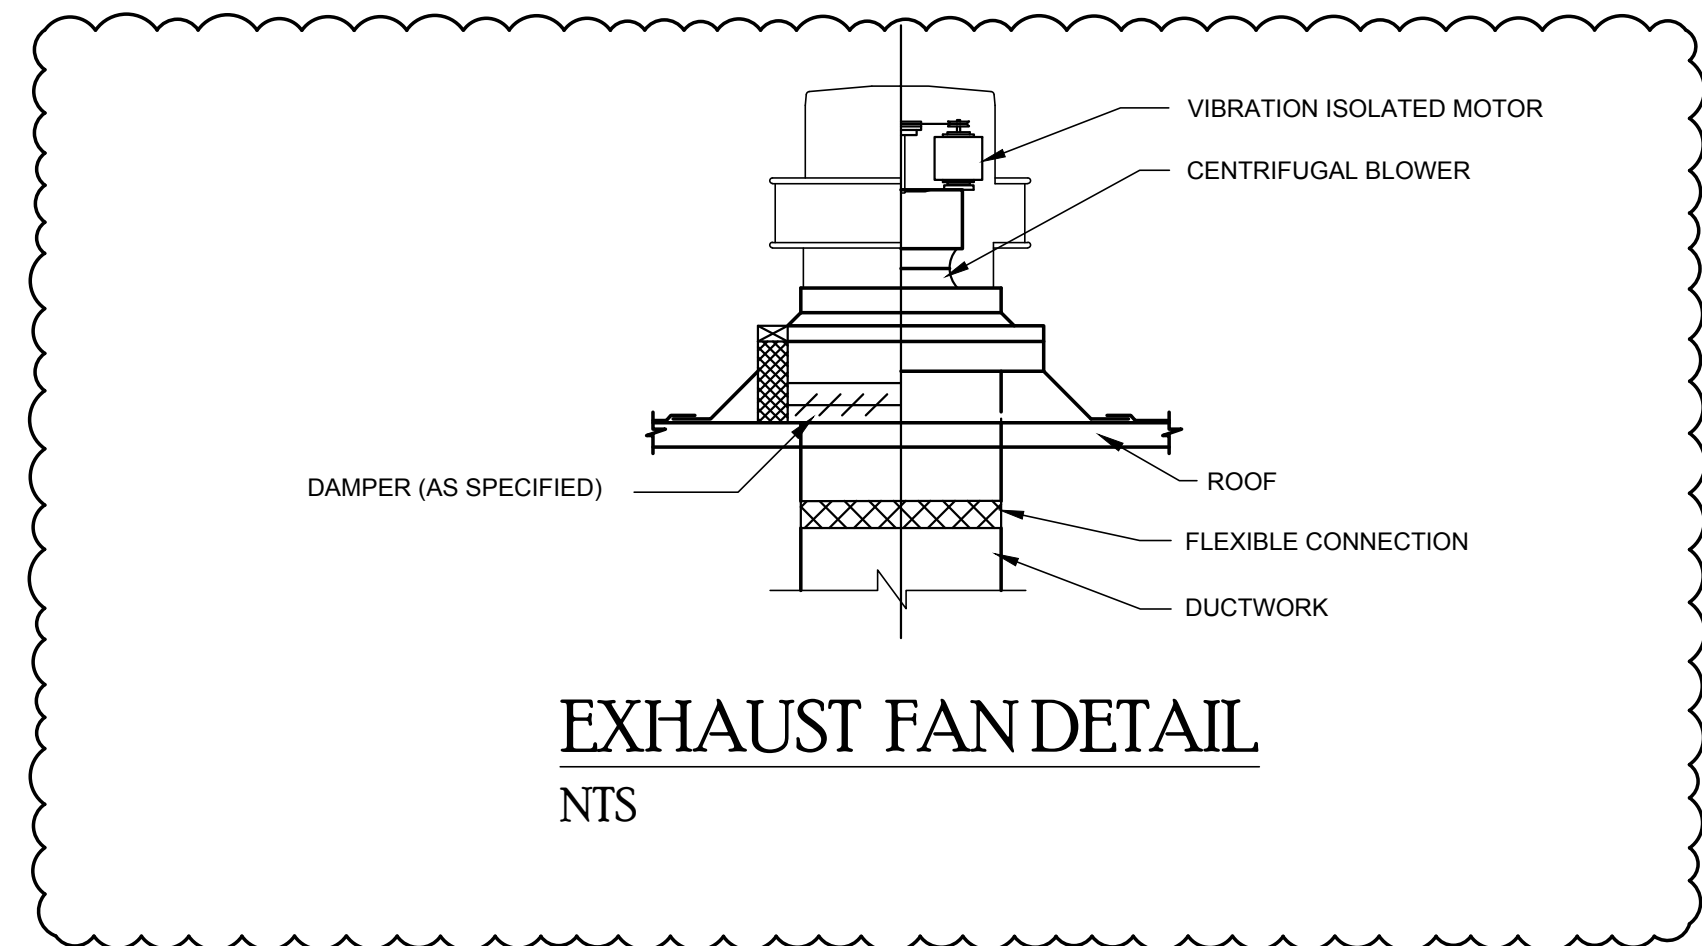

**EXHAUST FAN DETAIL**  
NTS

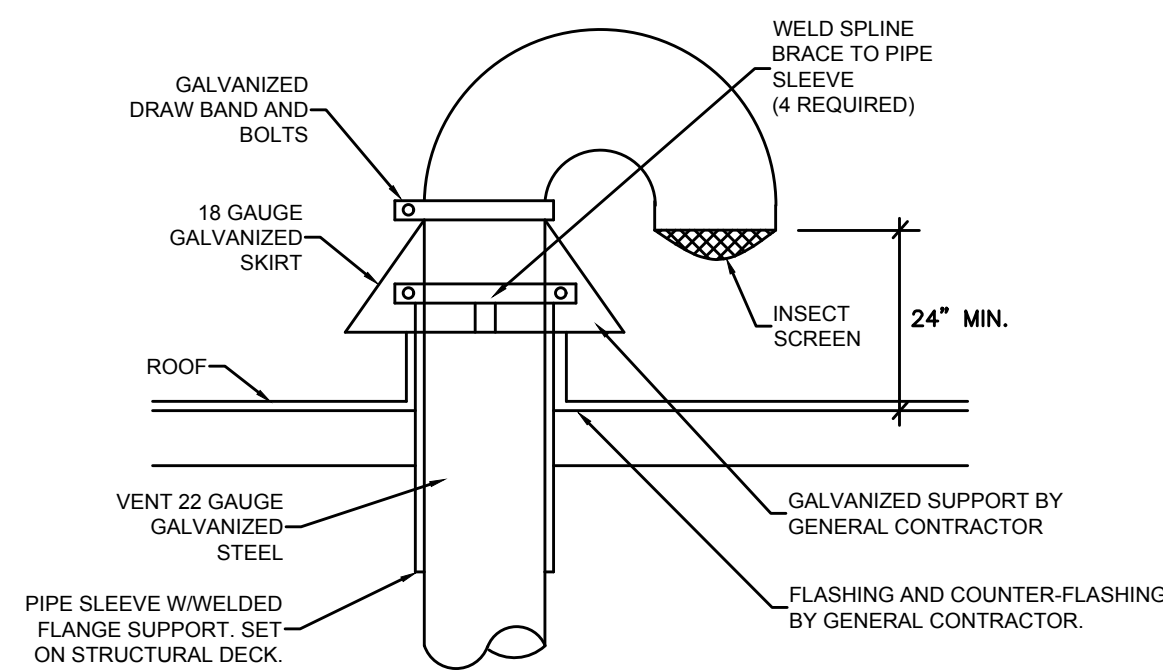

**DUCT GOOSENECK DETAIL**  
NTS

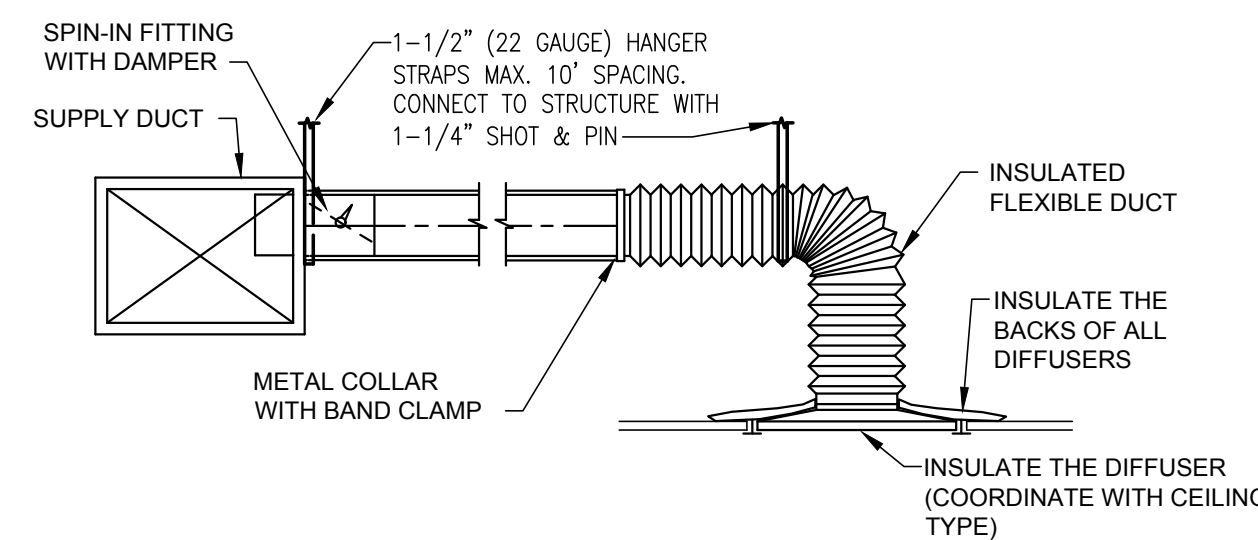

**SUPPLY DIFFUSER FLEX SUPPORT DETAIL**  
NTS



**CMK Design Studio, Inc.**  
Planning & Design of the Built Environment  
6822 22nd Ave. N. #148  
St. Petersburg, Florida 33710  
Ph: 813.362.6381  
FL LIC. NO.: AA6002603  
marcos@cmkdesignstudio.com

Drawing Not Valid Unless Signed,  
Sealed & Dated By Registered Professional

**INDIAN RIVER COUNTY LANDFILL  
HOUSEHOLD HAZARDOUS WASTE  
AND RECYCLING FACILITY**  
Indian River County, Florida

| NO. | REVISIONS          | DATE       |
|-----|--------------------|------------|
| 1   | FIELD COORDINATION | 05.15.2021 |
| 2   | FIELD COORDINATION | 11.05.2021 |

JOB NO.

**2016**

ISSUE DATE:  
07/07/2021

DRAWN BY:  
WG

SHEET TITLE  
MECHANICAL DETAILS

SHEET NO.  
**M104**

PERMIT SET