

11011

SCALE: 1"=10'



Bedding material: Type I



SCALE: $\frac{1}{2}" = 1'-0"$



SCALE: 1" = 15'-0"

- B**

" Shall be," " Provide," " Install," " Remove," etc., indicates work was accomplished under the contract.



<div style="border: 1px solid black; padding: 2px;"> DWS A.S.P. </div>	DWN. BY R.J.P.	INV. NO. CIV. ENG. 08-123-66-66	SIZE F	DWG. NO.
	CKD. BY	DATED: 28 APRIL 1966		
		SCALE: AS SHOWN	DATED: APRIL 1966	SHEET 59 OF 72

D. O. FILE NO. 496-29,370 496-30,952



type II

AS BUILT

Hand crank operated
near lift.
B Required

Hoist

Grout $\frac{1}{2}$ " min. thickness

El. 26.25

El. 28.0

Anchor bolts
(to suit)

Hole diameter to suit

Corrosion resisting stem
(see specifications)

To suit gate furnished

Adjustable stem guide

Stem

9" 9"

Face of concrete
headwall





72" ϕ 3/4 slide gate with
flat back frame.
B Required.
(See specifications)

Grout $\frac{1}{2}$ " min thickness
between frame and
headwall.

72" ϕ Pipe


FLOW

El. 5.5

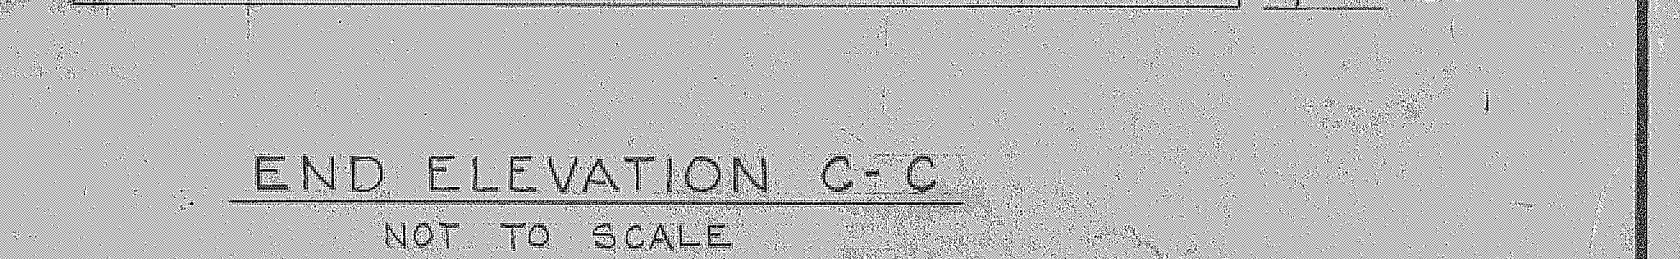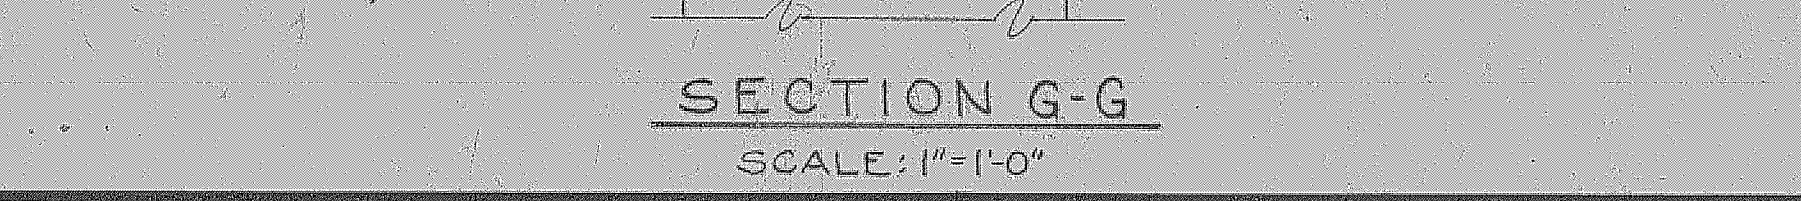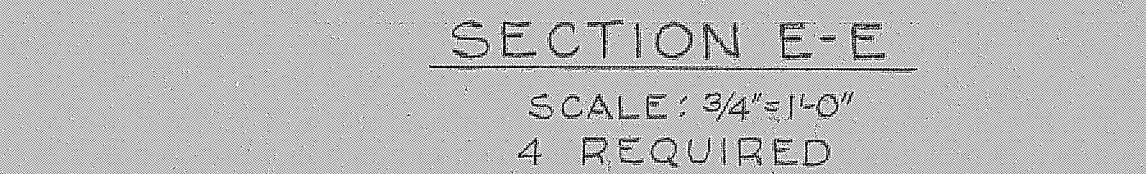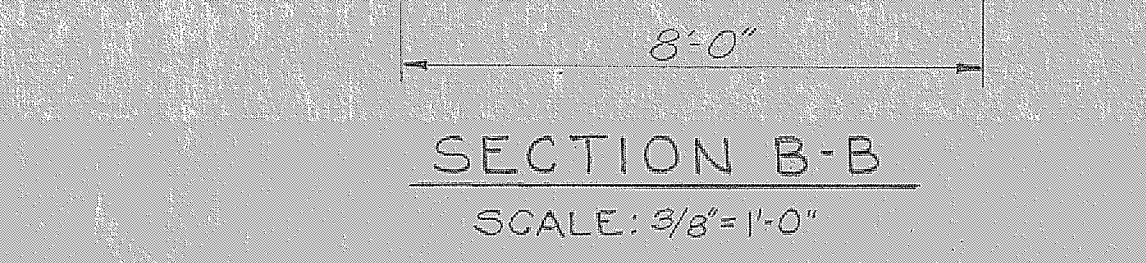

RECORD DRAWING NOTE

"Shall be," "Provide," "Install,"
"Remove," etc., indicates work
was accomplished under the
contract.

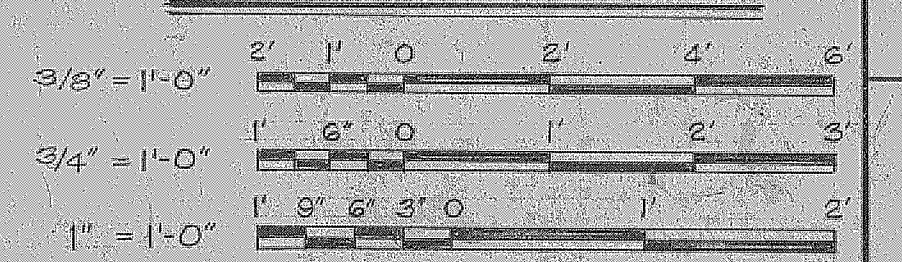

D. O. FILE NO. ~~496-29,370~~ ^{8/70} 496-30 952 ¹⁰¹ 103

