

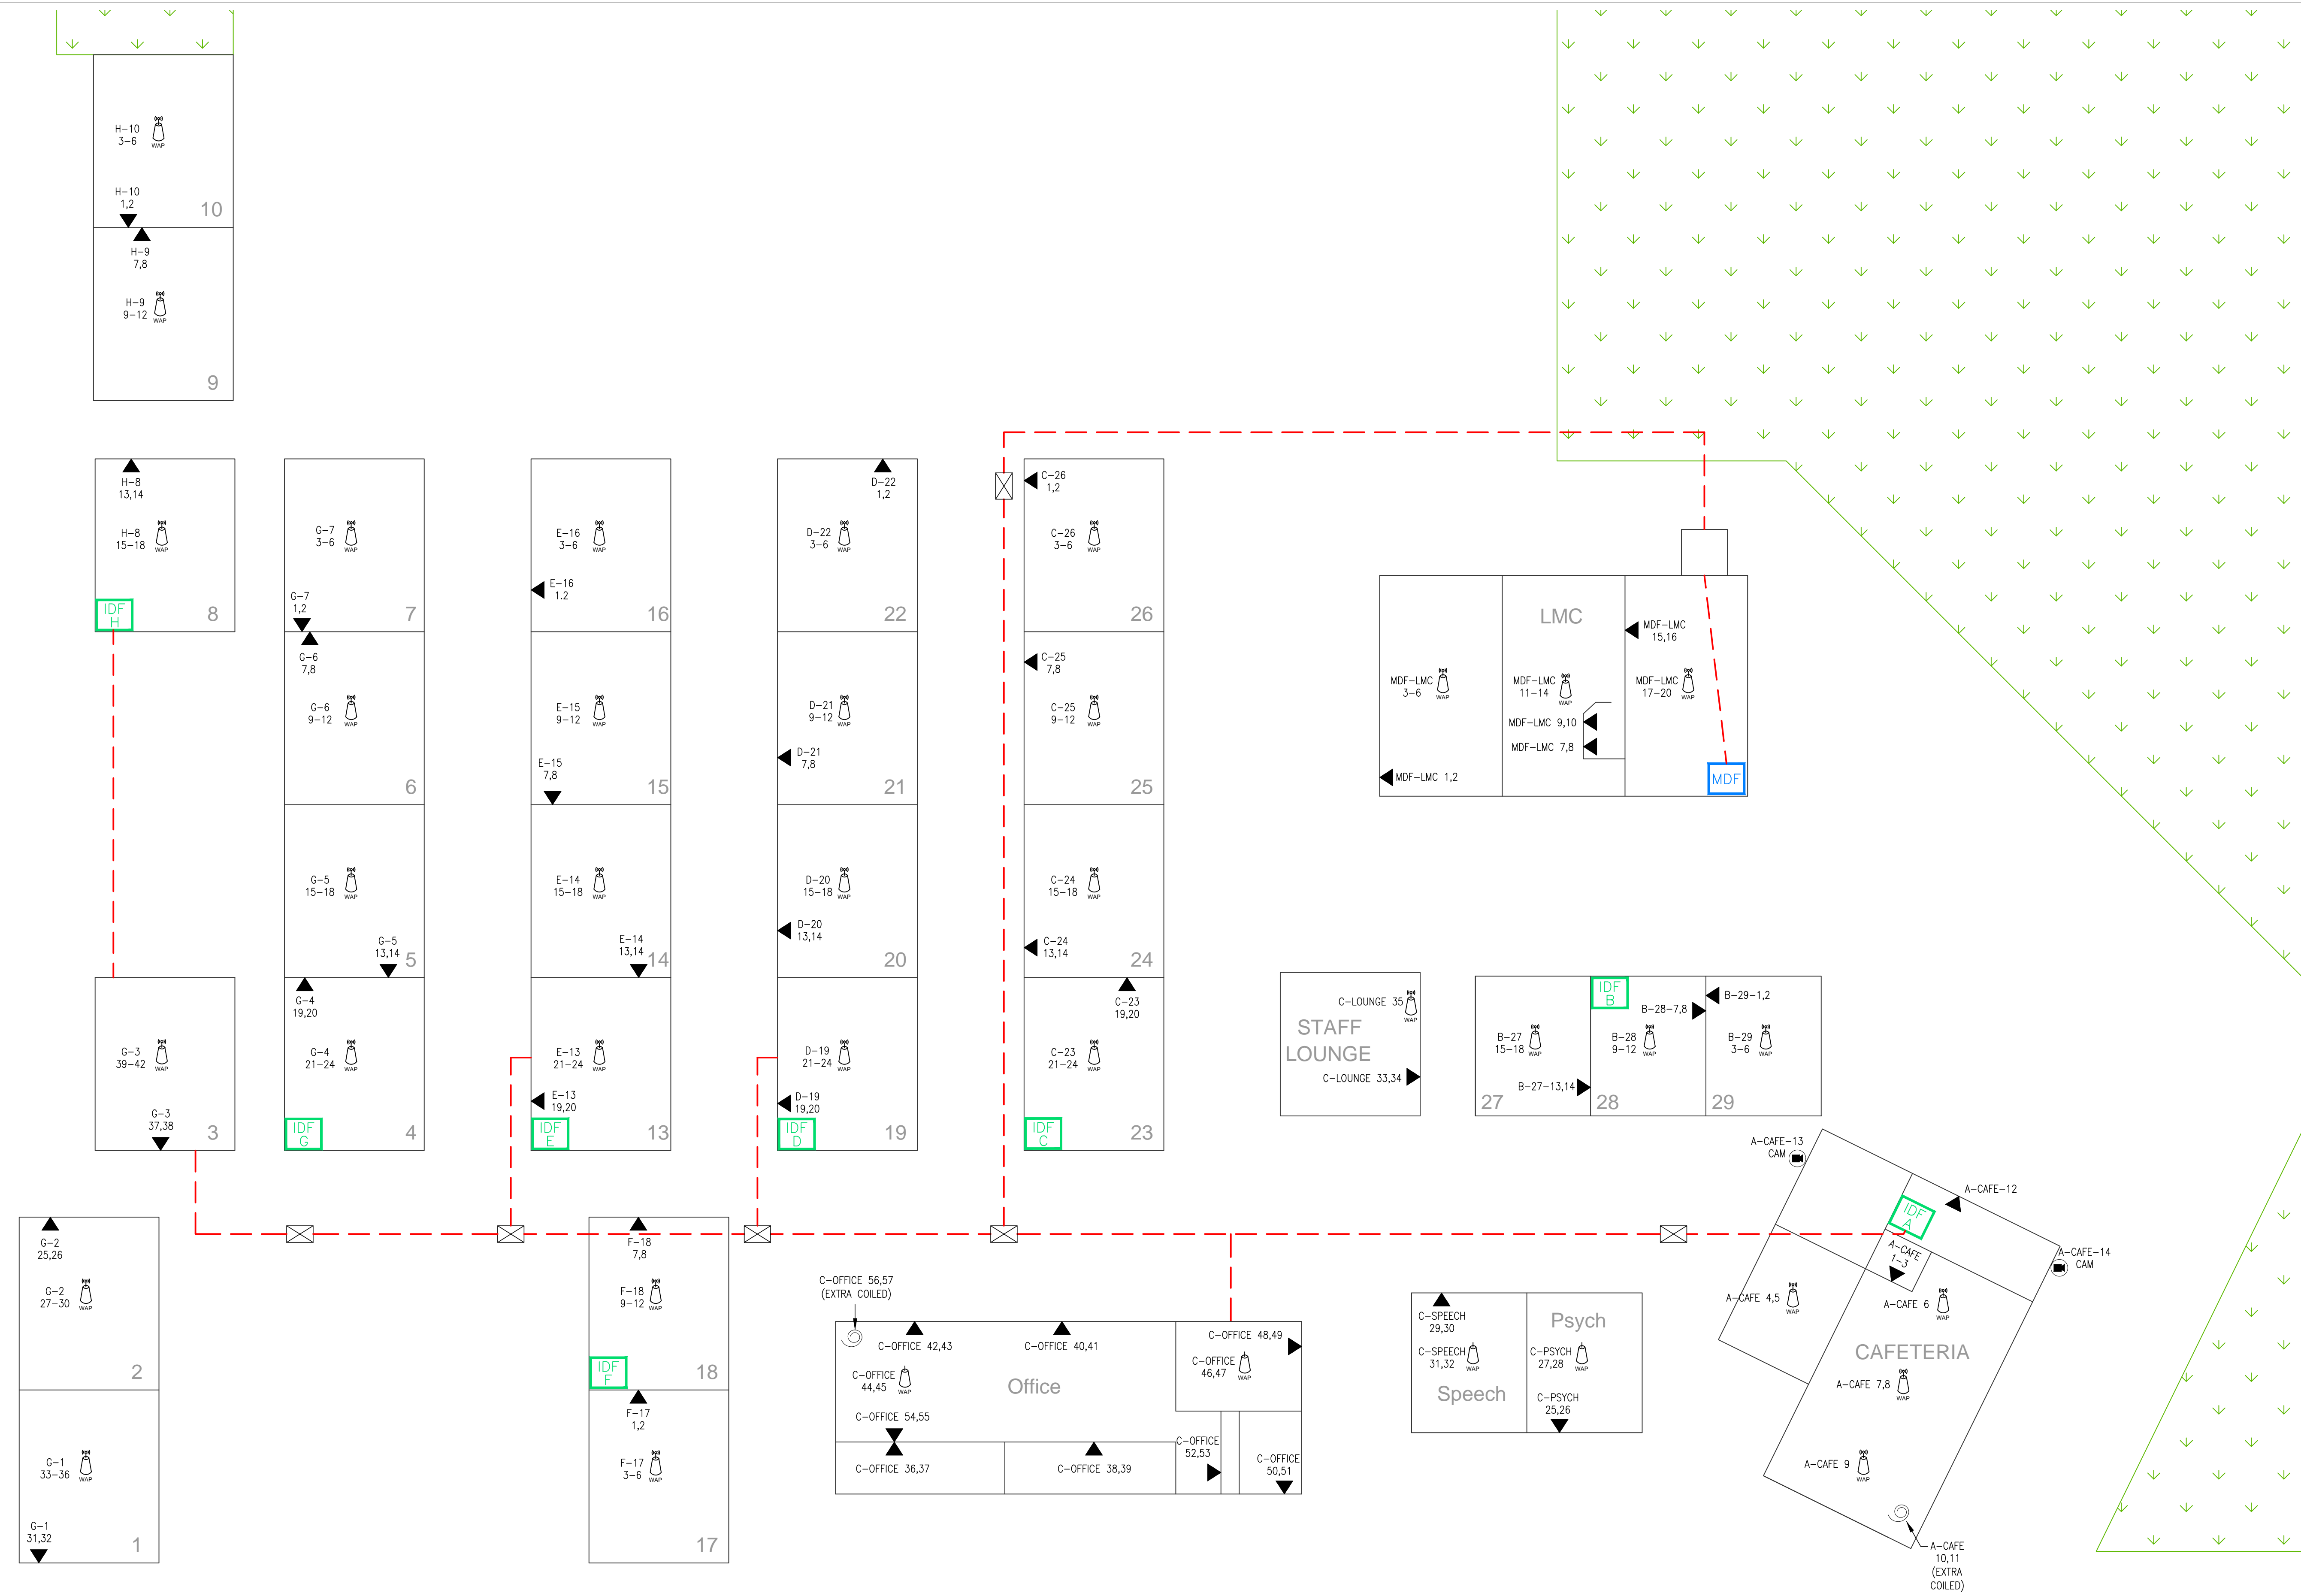


Exhibit 5: District Site Maps

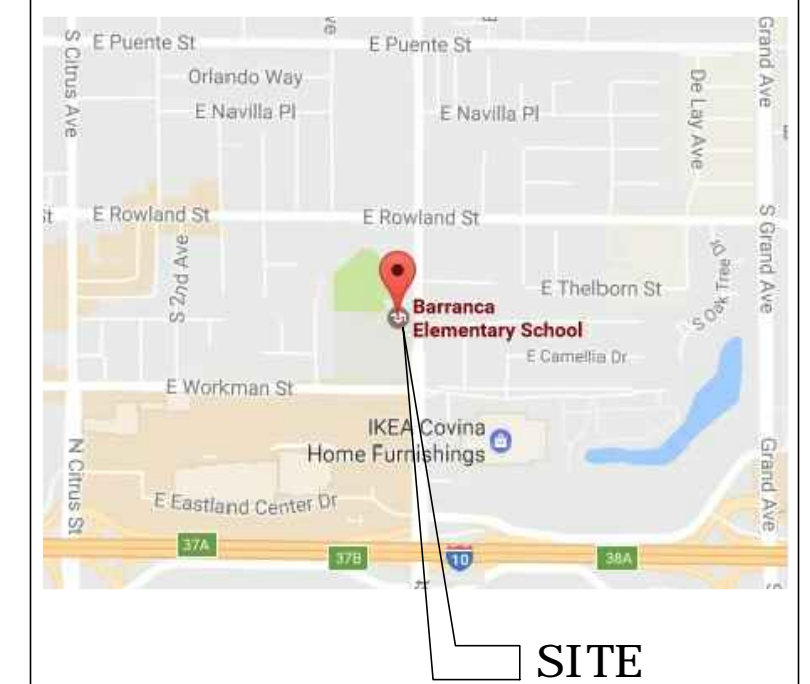

- MAIN DISTRIBUTION FRAME (MDF)
- INTERMEDIATE DISTRIBUTION FRAME (IDF)
- DATA - WALL DROPS
- CAMERA
- VAULT
- WIRELESS ACCESS POINT
- FIBER BACK BONE PATH

Covina Valley Unified School District Telecommunication	
<small>Project Name and Address</small>	
Barranca Elementary School 727 S Barranca Ave Covina, CA 91723	
<small>Description</small>	
SITE PLAN	
<small>Date</small>	
MARCH 10, 2017	
<small>Drawn By</small>	
R.G.S.	
<small>Project</small>	
JOB# xxxxxx	
<small>SHEET#</small>	
1 OF 1	

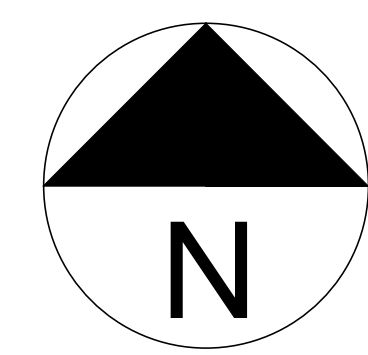








Covina Valley Unified School District
 Barranca Elementary School
 Telecommunications As-Builts

SHEET SIZE: 36" x 24"
 SCALE: NOT TO SCALE



SITE

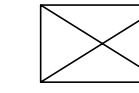


-  MAIN DISTRIBUTION FRAME (MDF)
-  INTERMEDIATE DISTRIBUTION FRAME (IDF)
-  DATA - WALL DROPS
-  CAMERA
-  VAULT
-  WIRELESS ACCESS POINT
-  FIBER BACK BONE PATH

Covina Valley Unified School District
 Telecommunication


Project Name and Address
 Ben Lomond Elementary School
 621 E. Covina Blvd
 Covina, CA 91722

Description	SITE PLAN
Date	November, 2017
Drawn By	R.G.S.
Project	JOB# xxxxxx
SHEET#	1 OF 11

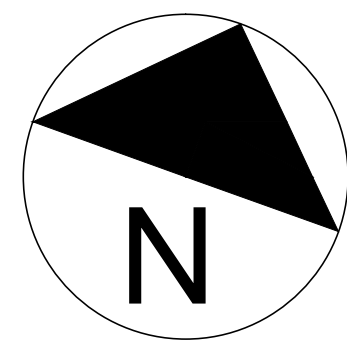





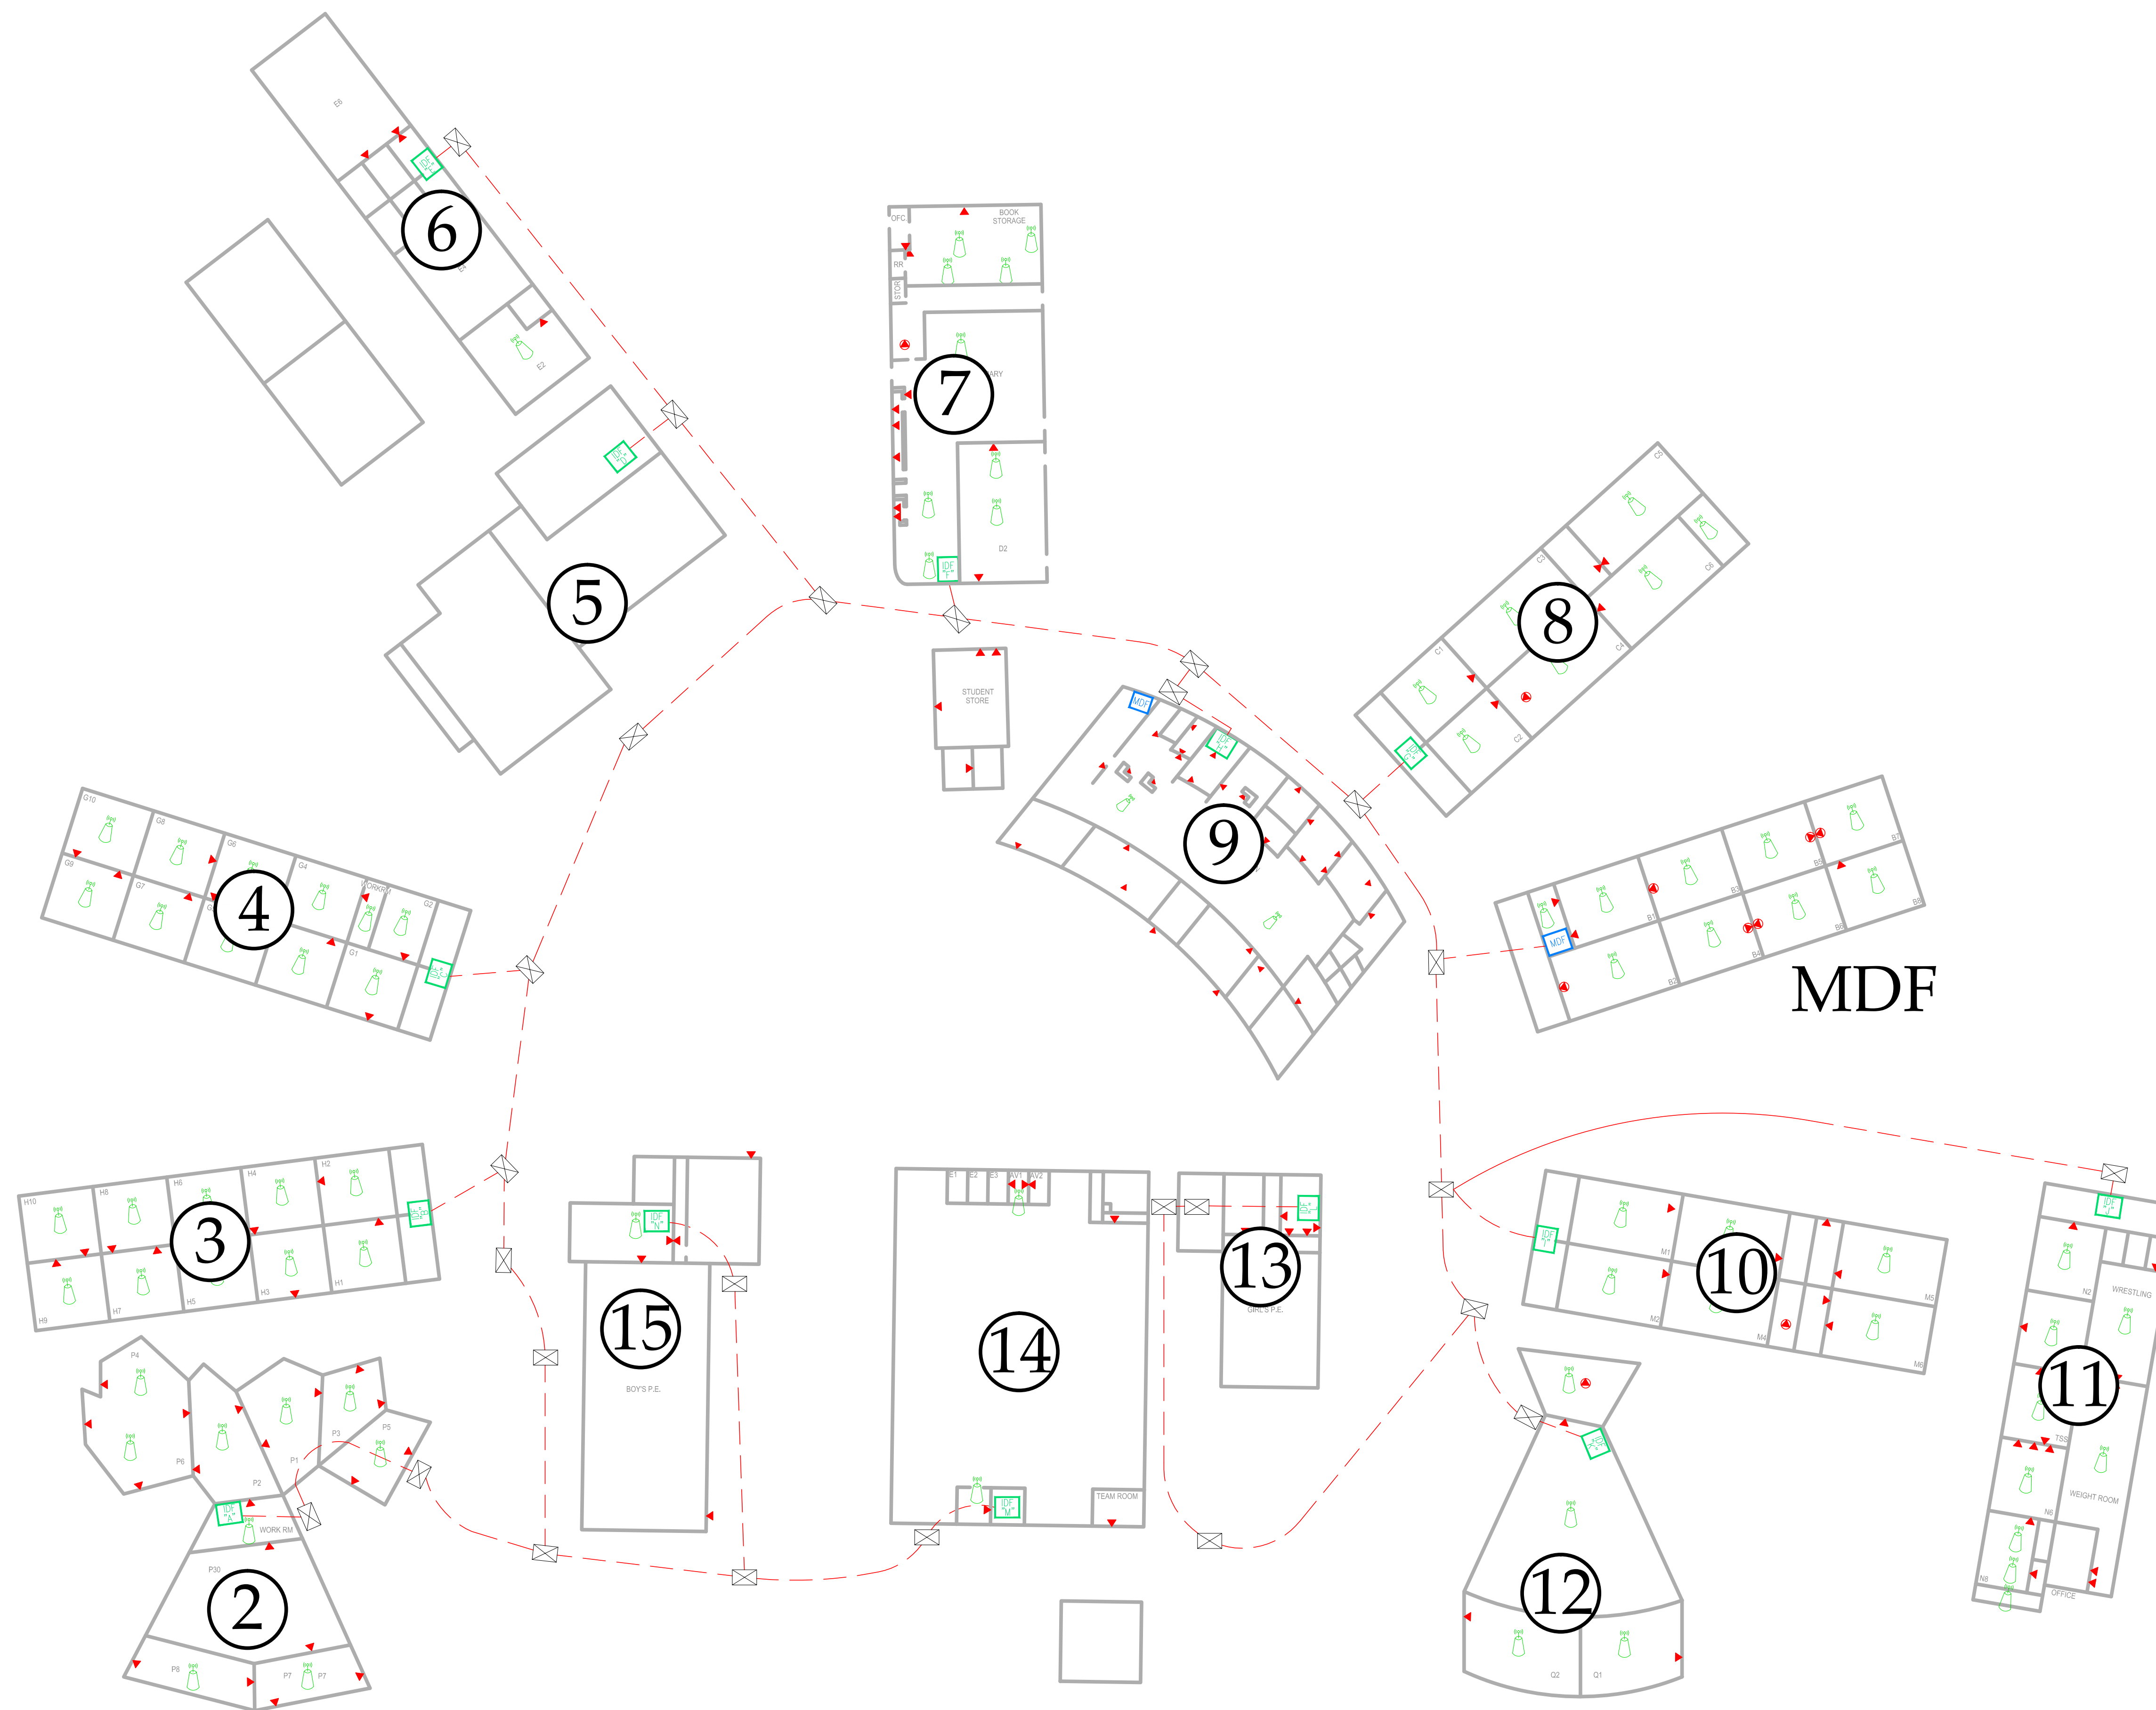


Covina Valley Unified School District
 Ben Lomond Elementary School
 Telecommunications As-Builts

SHEET SIZE: 36" x 24"
 SCALE: NOT TO SCALE




MDF

-  MAIN DISTRIBUTION FRAME (MDF)
-  INTERMEDIATE DISTRIBUTION FRAME (IDF)
-  DATA - WALL DROPS
-  CAMERA
-  VAULT
-  WIRELESS ACCESS POINT
-  FIBER BACK BONE PATH


Project Name and Address
 Covina High School
 463 S Hollenbeck Avenue
 Covina, CA 91723

Description
 SITE PLAN COMM AS-BUILTS
 Date
 November, 2017
 Drawn By
 R.G.S.
 Project
 JOB# XXXXXX
 SHEET#
 1 OF 16

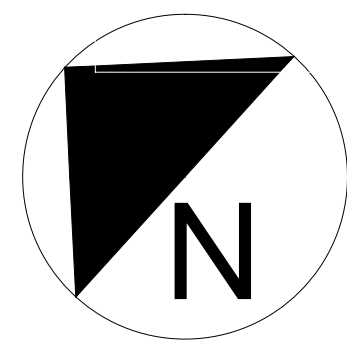

Covina High School
 Covina Valley Unified School District
 Telecommunications As-Built

SHEET SIZE: 36" x 24"
 SCALE: NOT TO SCALE

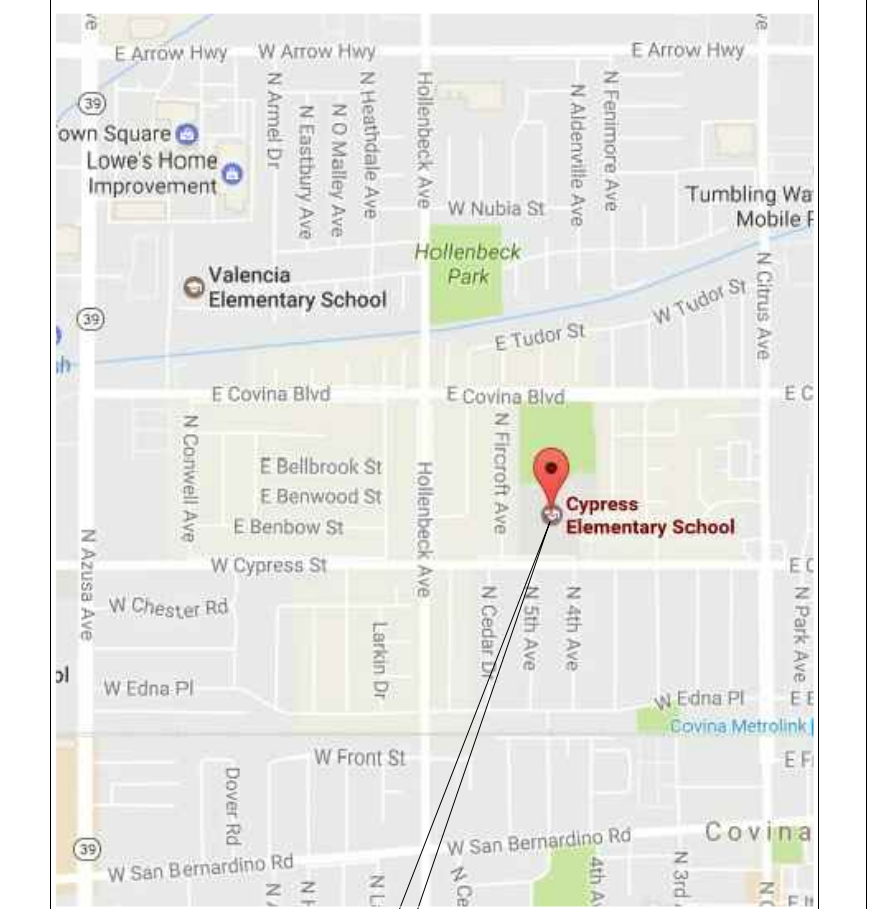

SITE

- MDF MAIN DISTRIBUTION FRAME (MDF)
- IDF #XX INTERMEDIATE DISTRIBUTION FRAME (IDF)
- DATA - WALL DROPS
- CAMERA
- VAULT
- WIRELESS ACCESS POINT
- FIBER BACK BONE PATH


**Covina Valley Unified School District
 Telecommunication**

Project Name and Address
 Cypress Elementary School
 351 W Cypress St.
 Covina, CA 91723

Description
 SITE PLAN
 Date
 March 11, 2017


Drawn By
 R.G.S.

Project
 JOB# xxxxxx
 SHEET#
 1 OF 3

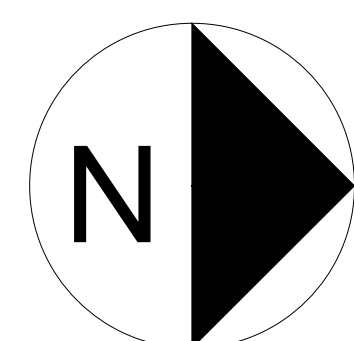



**Covina Valley Unified School District
 Cypress Elementary School
 Telecommunications As-Builts**

SHEET SIZE: 36" x 24"
 SCALE: NOT TO SCALE

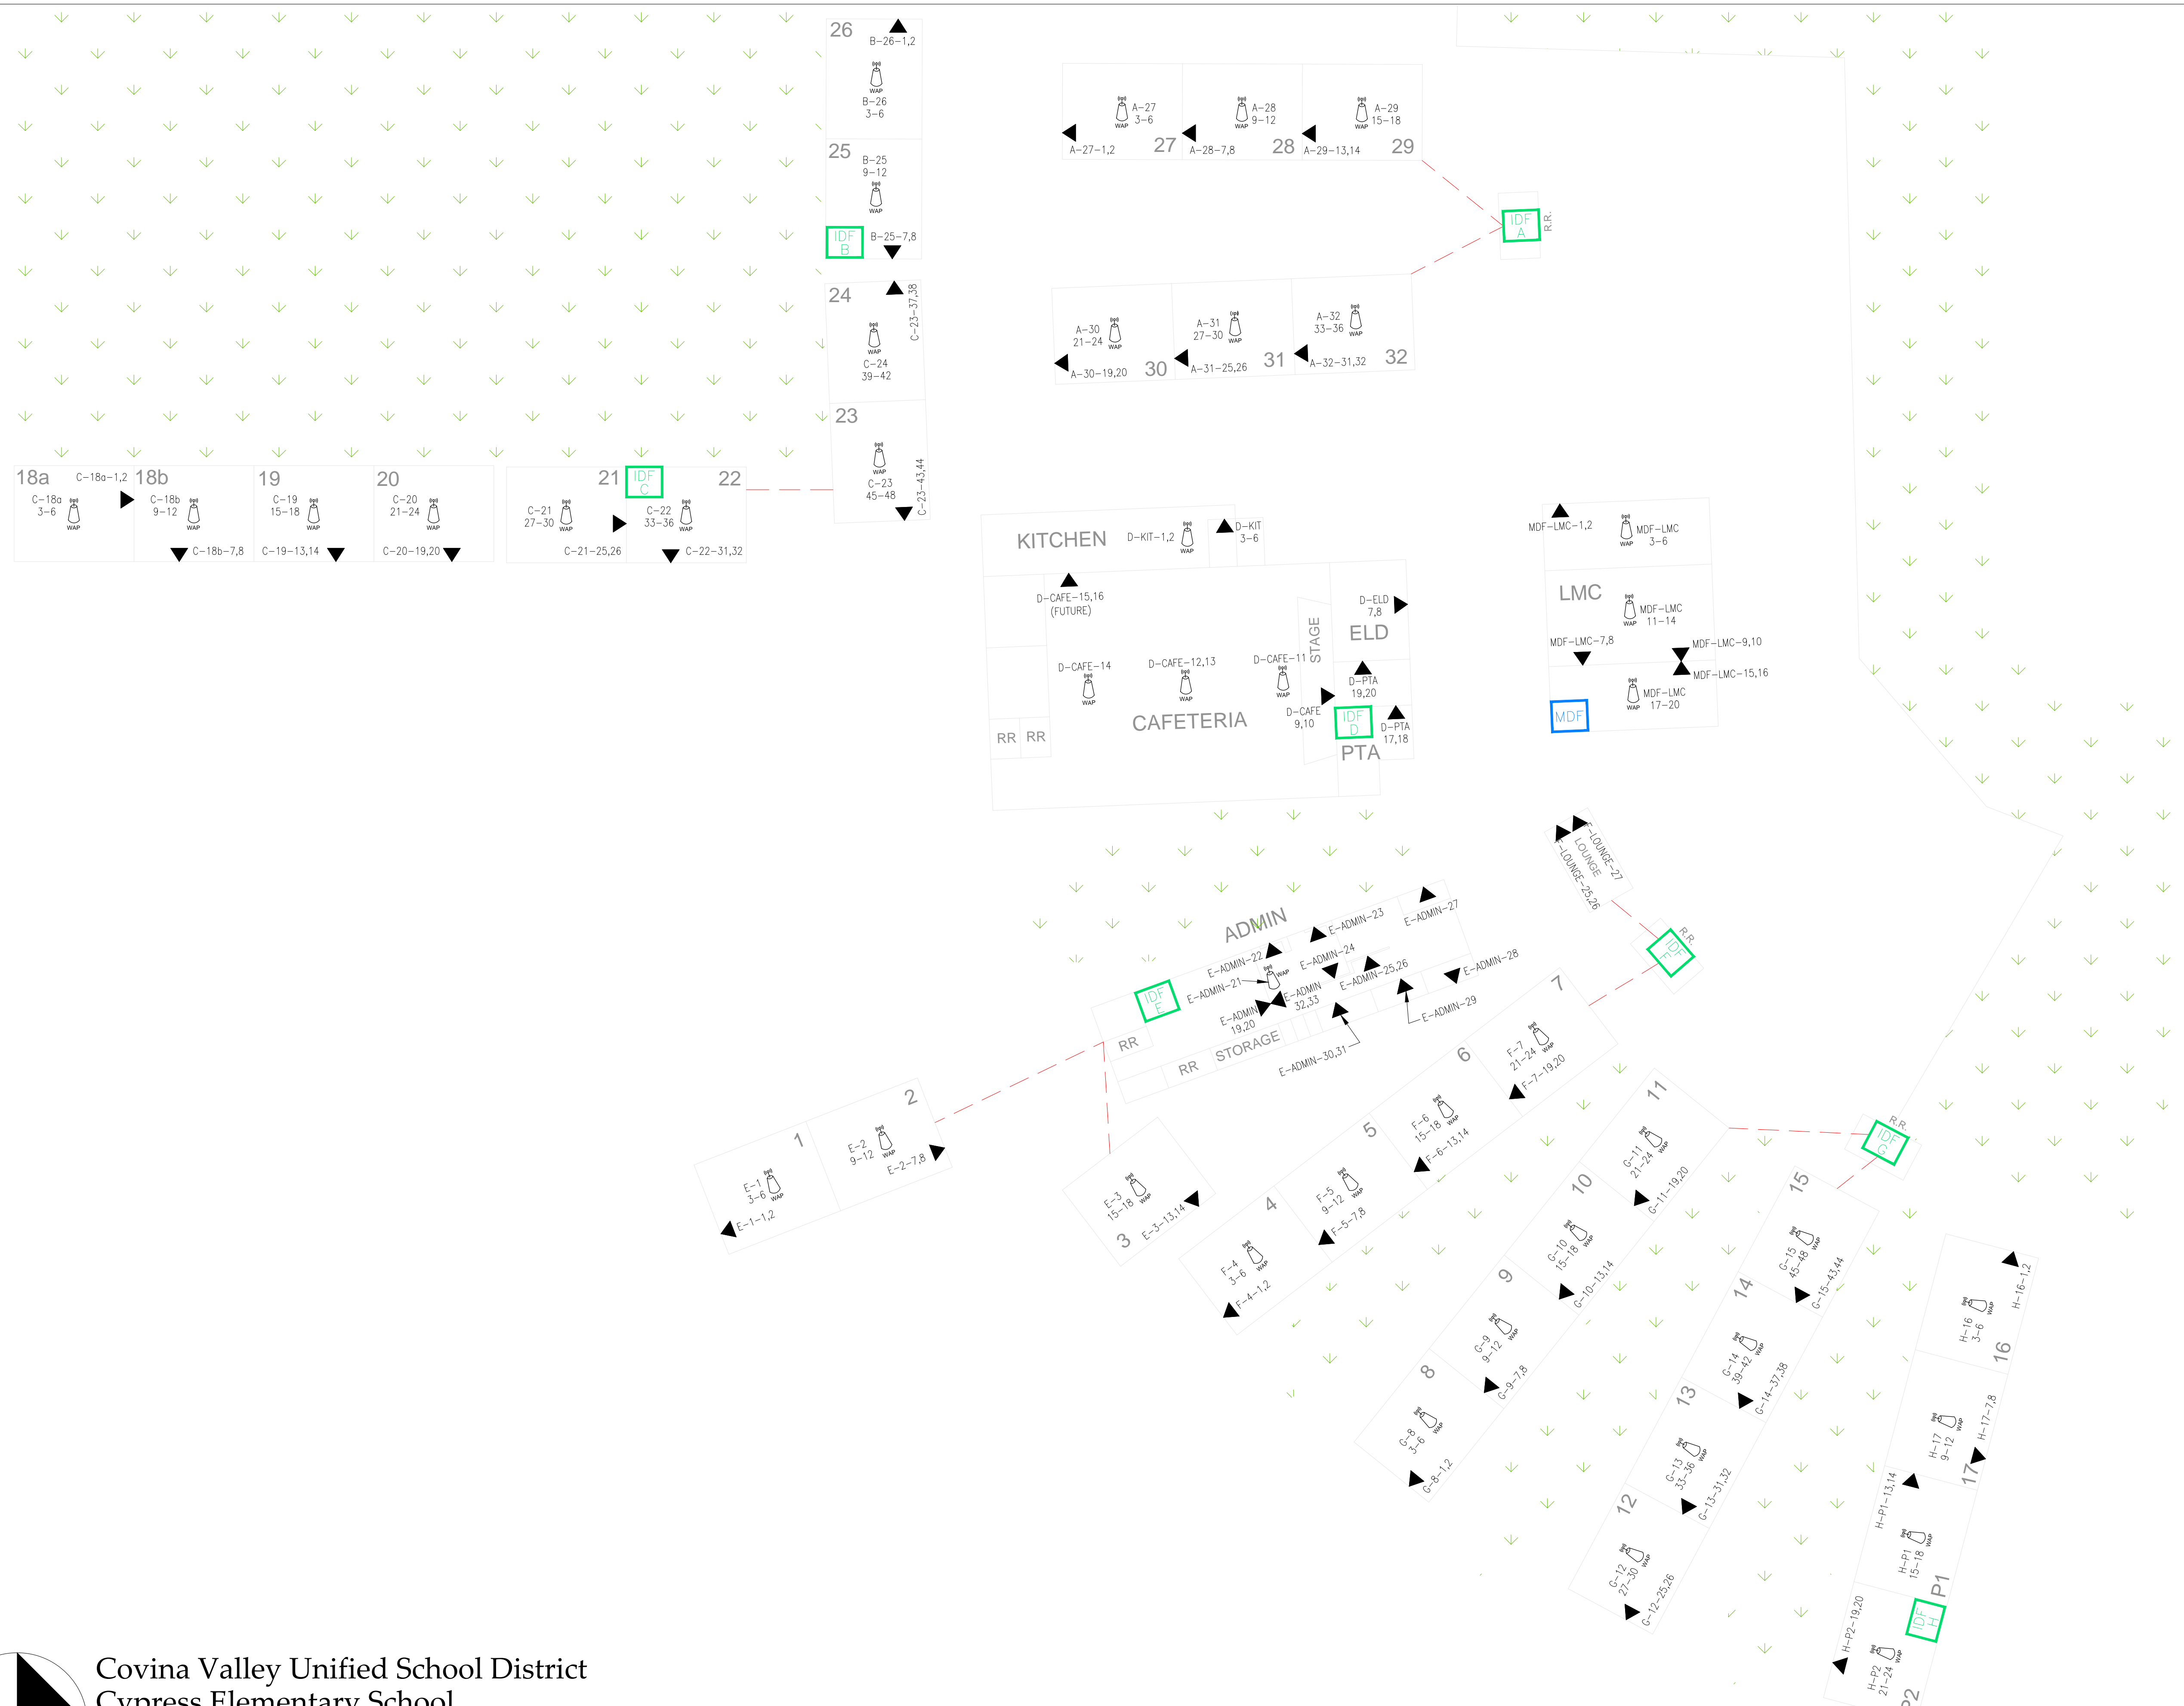

Fairvalley
758 W. Grondahl St., Covina

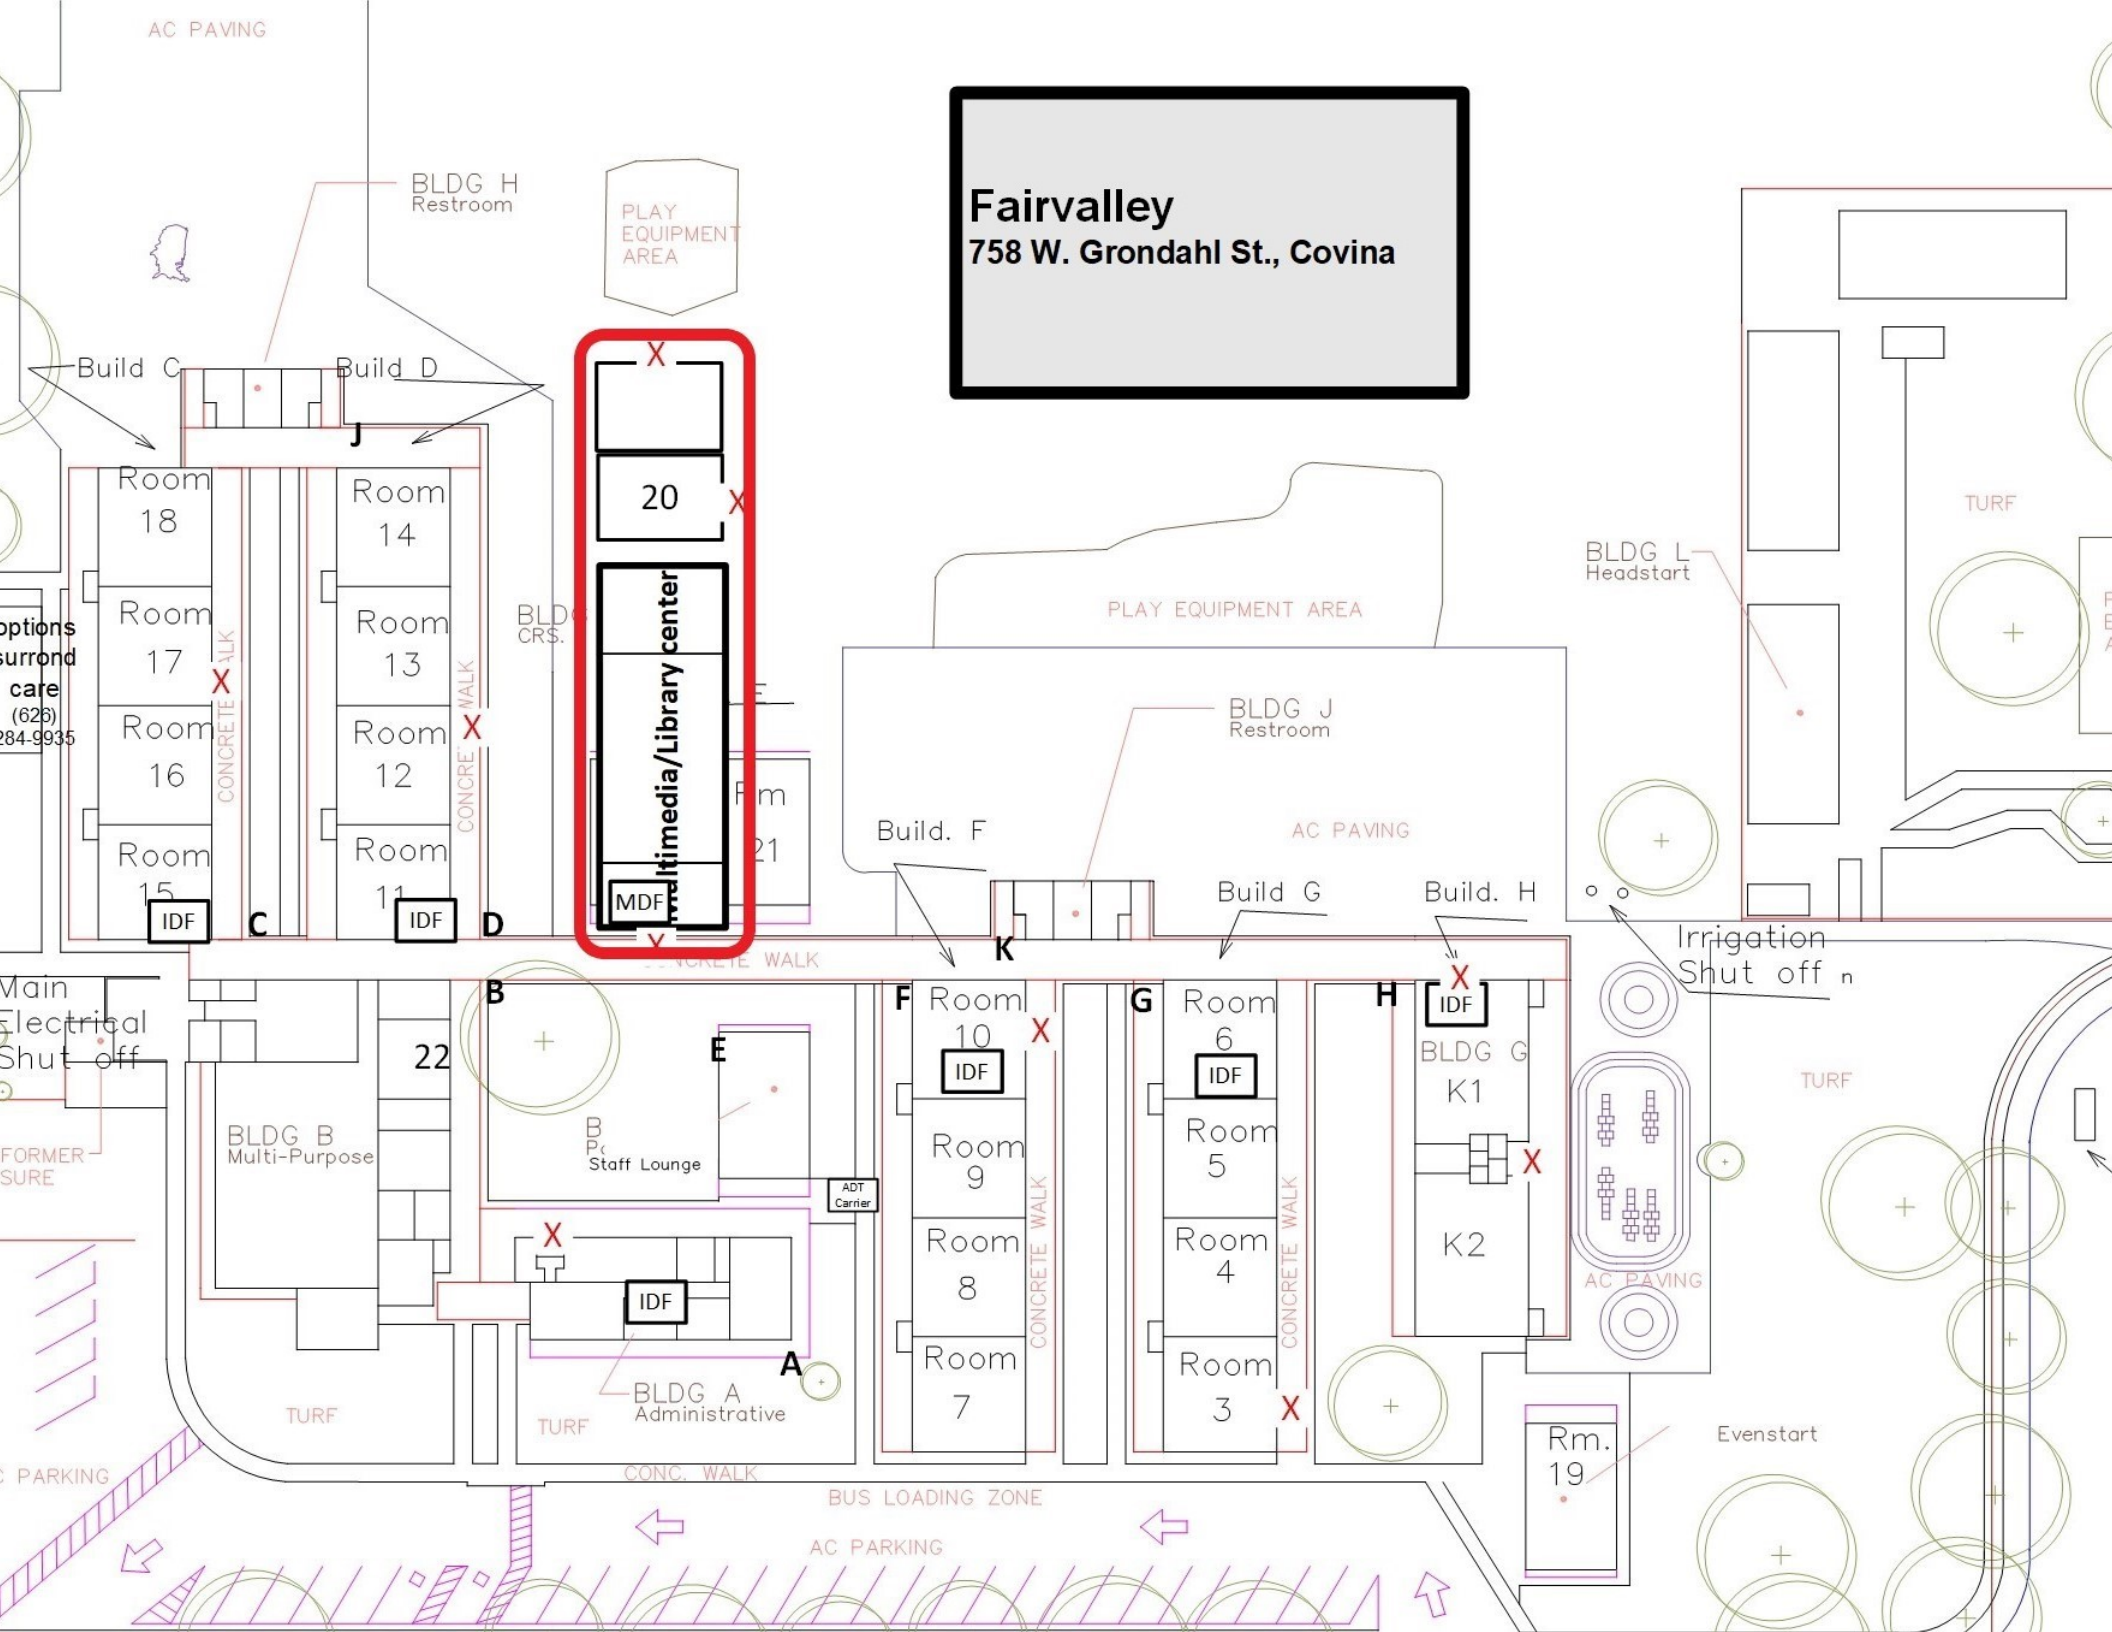

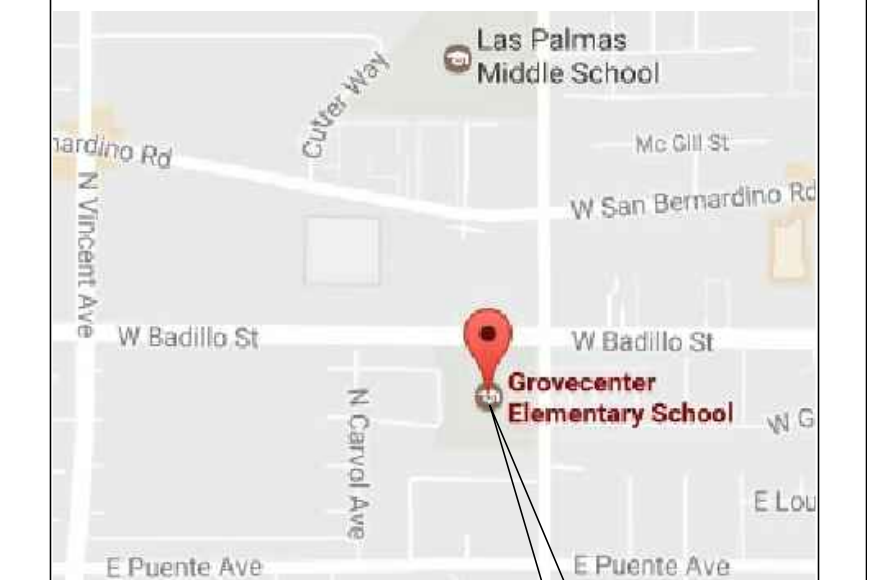

SITE


SYMBOL LEGEND

- MDF/IDF CABINET
- WALLPHONE
- DATA
- VOICE/DATA
- SURFACE BOX WITH CAMERA STRANDS
- PTZ CAMERA
- WIRELESS CAMERA
- DOME/MINI DOME CAMERA
- DIGITAL VIDEO RECORDER
- SPEAKER CLOCK
- SPEAKER
- WAP
- PROJECTOR
- WIRE CABLE
- UG WIRE CABLE
- FIBER OPTIC CABLE
- UG FIBER OPTIC CABLE
- CONDUIT
- SLEEVE
- ROOF/COVER PROFILE ABOVE
- NAME/ID DENOTES UNIT ID/REFERENCE NAME
- DTL/SHT DENOTES DTL REFERENCE/SHT NO.

Covina Valley Unified School District
 Telecommunication

Project Name and Address
 Grovecenter Elementary School
 775 N Lark Ellen Ave
 West Covina, CA 91791

Description
 SITE PLAN
 Date
 MARCH 22, 2017
 Drawn By
 R.G.S.
 Project
 JOB# xxxxxx
 SHEET#
 1 OF 1

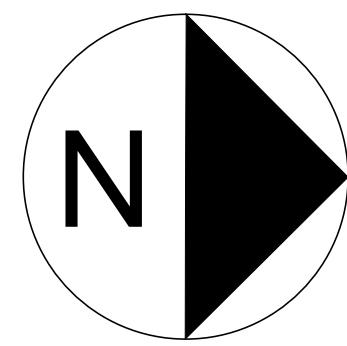

Covina Valley Unified School District
 Grovecenter Elementary School
 Telecommunications As-Builts

SHEET SIZE: 36" x 24"
 SCALE: NOT TO SCALE



SITE



SYMBOL LEGEND

	MDF/IDF CABINET
	WALLPHONE
	DATA
	VOICE/DATA
	FIXED CAMERA DENOTES APPROXIMATE VIEW ANGLE/DIRECTION
	PTZ CAMERA
	WIRELESS CAMERA
	DOME/MINI DOME CAMERA
	DIGITAL VIDEO RECORDER
	SPEAKER CLOCK
	SPEAKER
	WAP
	PROJECTOR
	WIRE CABLE
	UG WIRE CABLE
	FIBER OPTIC CABLE
	UG FIBER OPTIC CABLE
	CONDUIT
	VAULT/PULL BOX
	UTILITY BOX
	NAME/ID DENOTES UNIT ID/REFERENCE NAME
	DTL/SHT DENOTES DTL REFERENCE/SHT NO.

**Covina Valley Unified School District
 Telecommunication**

Project Name and Address
 Las Palmas Middle School
 641 N Lark Ellen Ave.
 Covina, CA 91722


Description
 SITE PLAN (WEST)
 Date
 MARCH 29, 2017
 Drawn By
 R.G.S.
 Project
 JOB# xxxxxx
 SHEET#
 1 OF 2

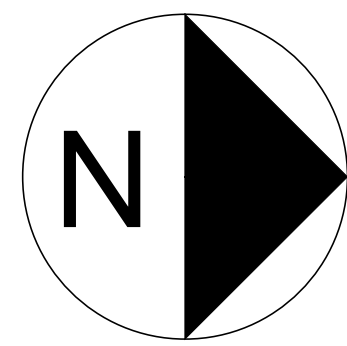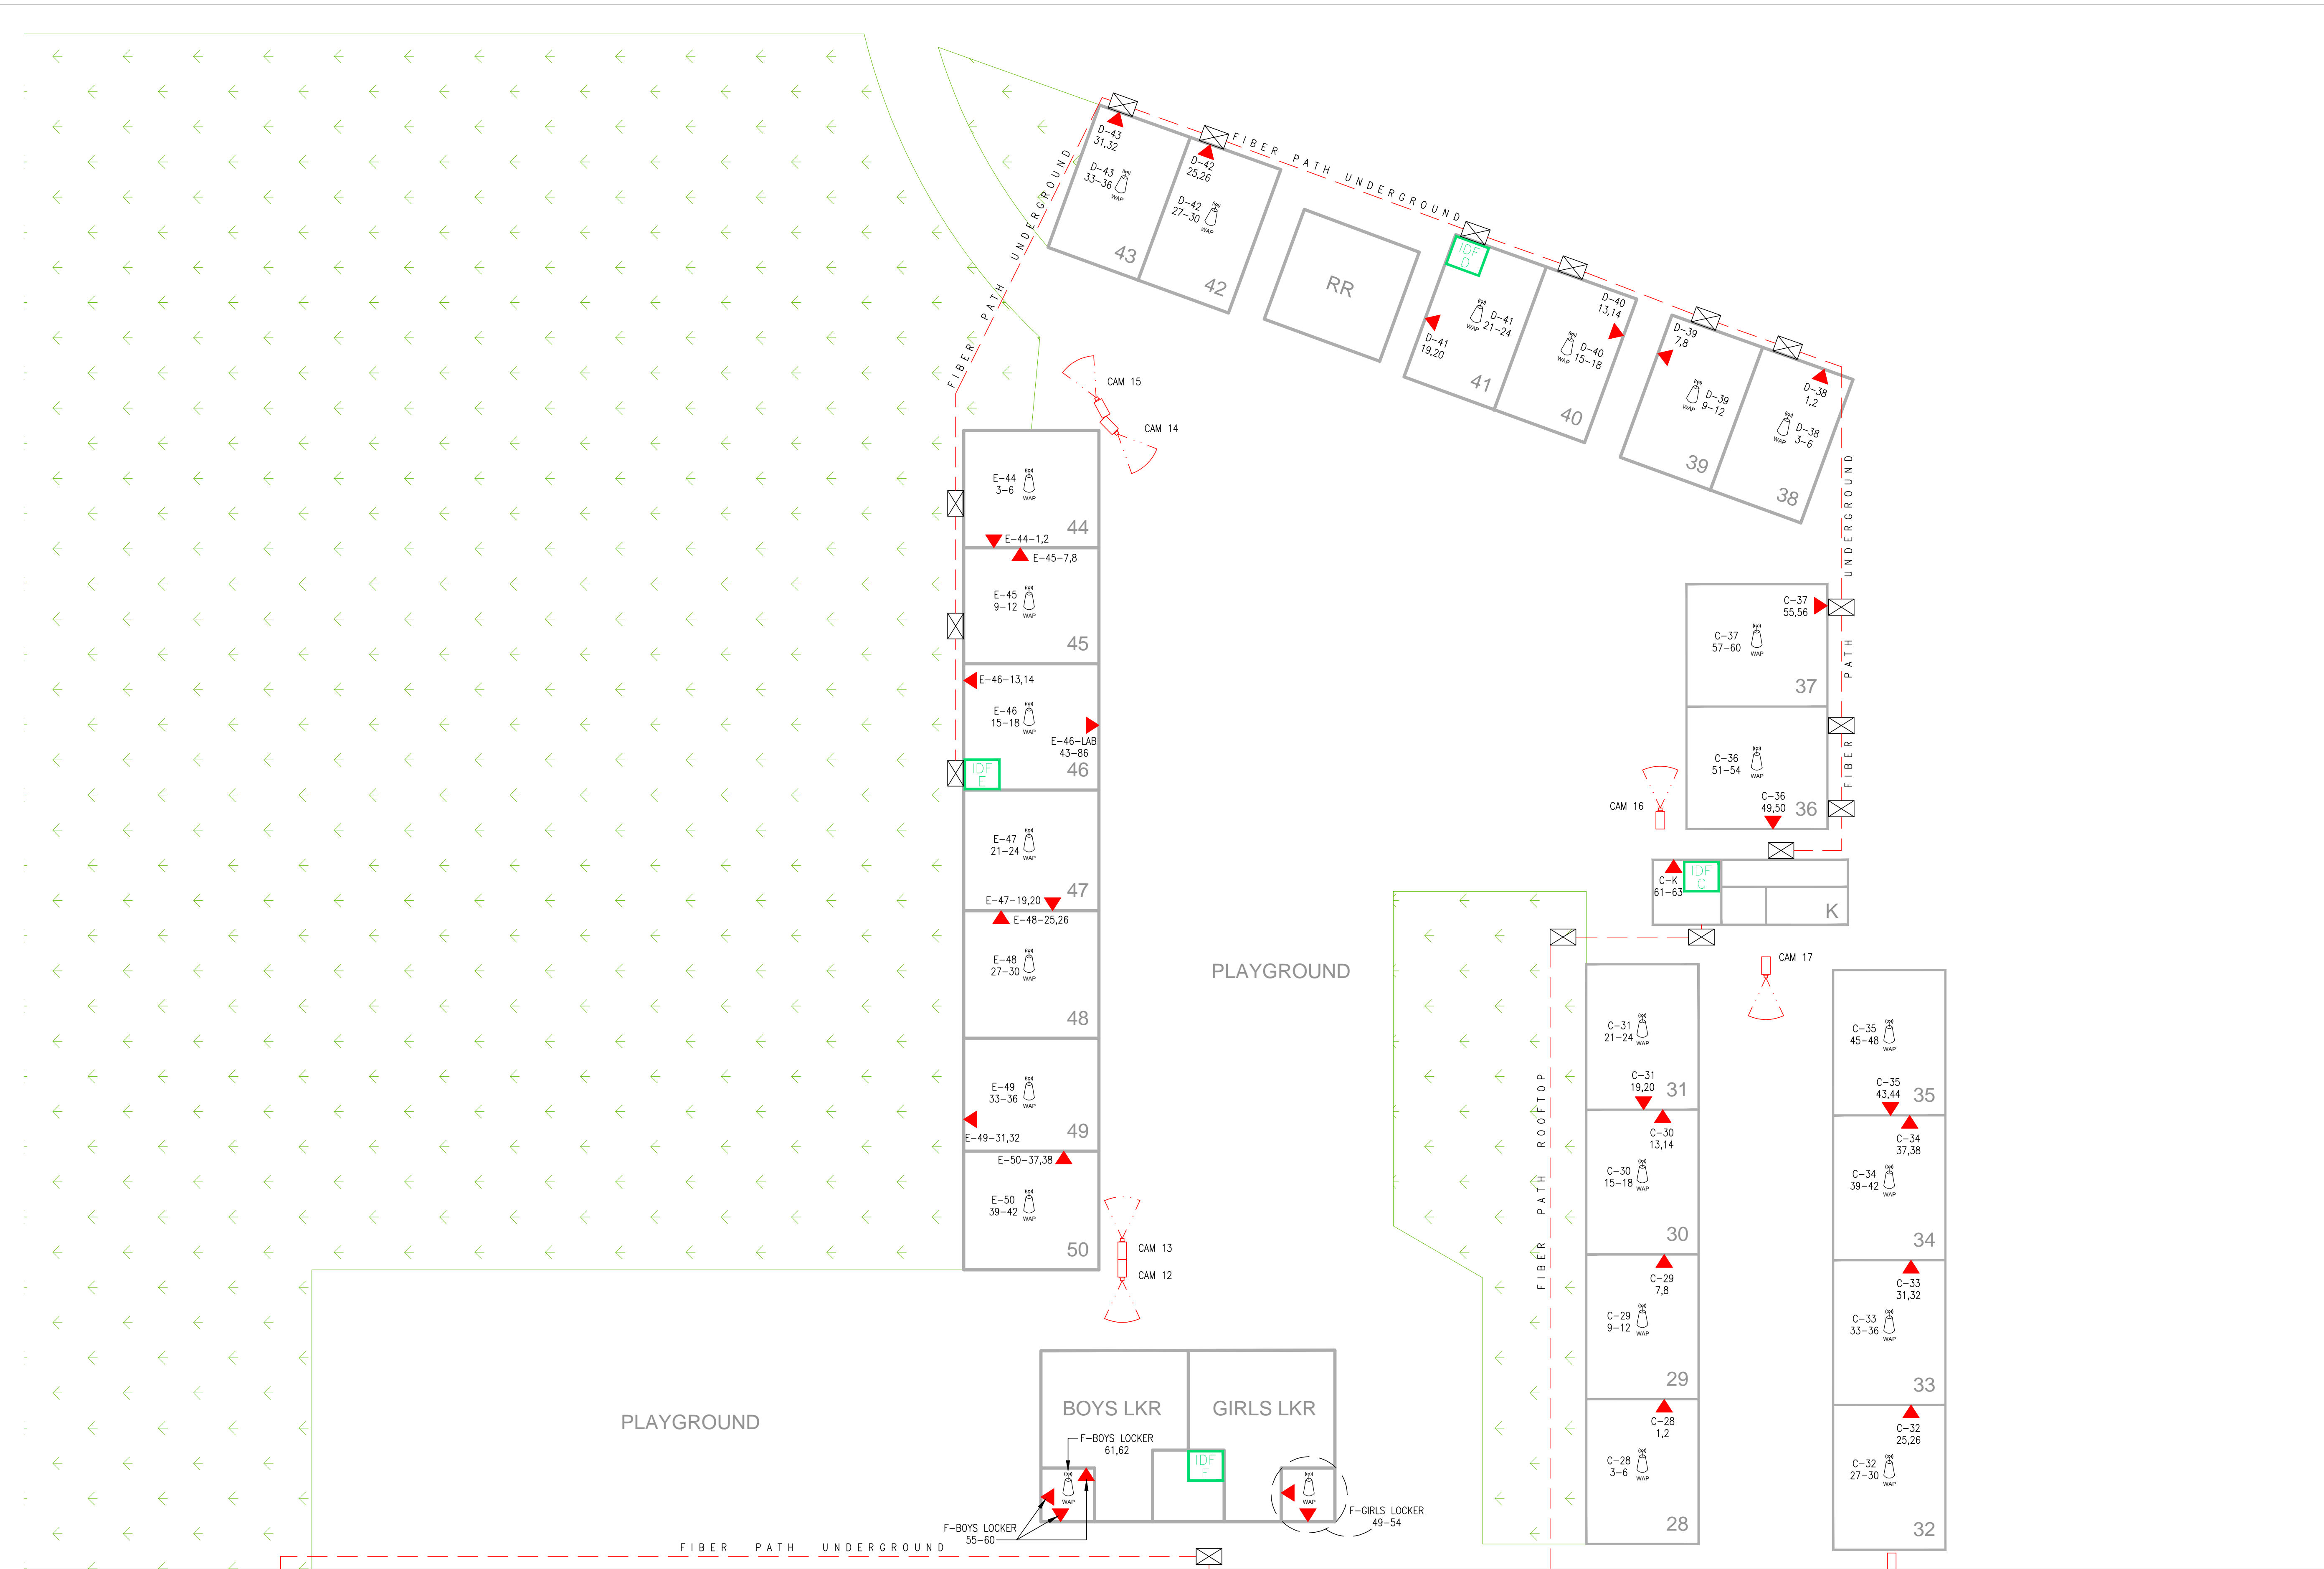

Covina Valley Unified School District
 Las Palmas Middle School
 Telecommunications As-Builts

SHEET SIZE: 36" x 24"
 SCALE: NOT TO SCALE

MATCH LINE - SEE SHEET 1

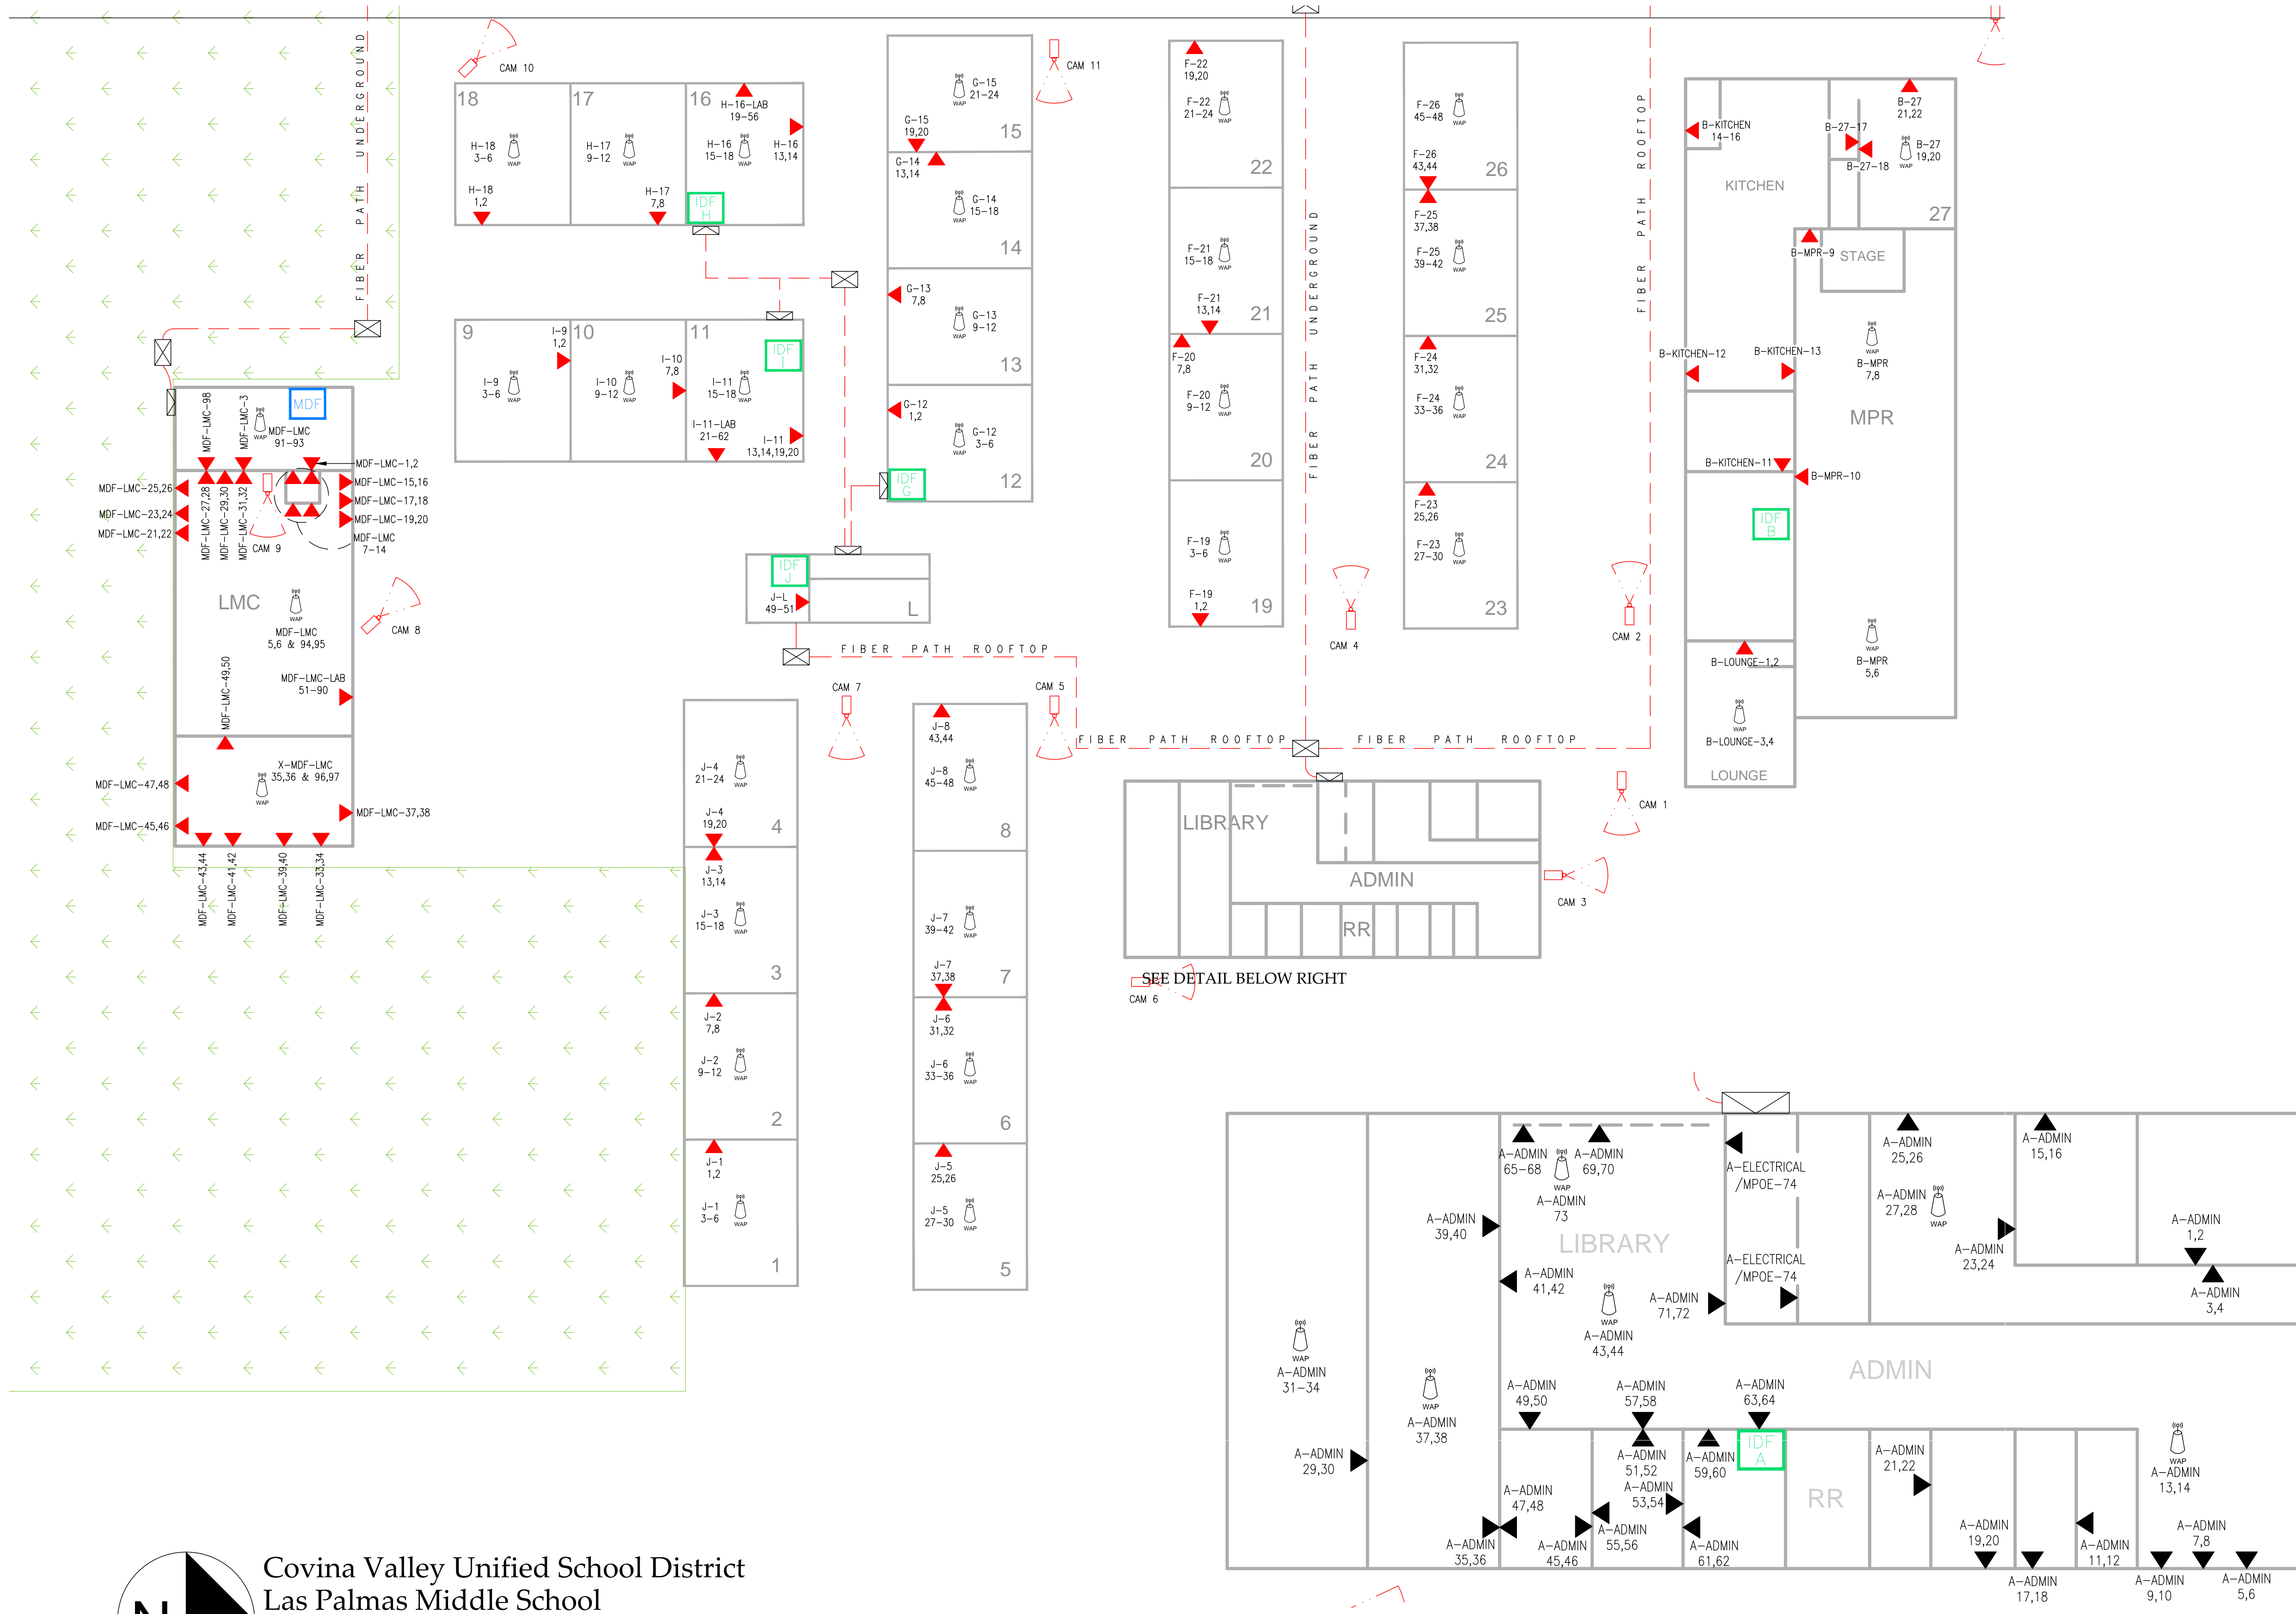

SEE DETAIL BELOW RIGHT



11981 Jack Benny Dr. #103
 Rancho Cucamonga, CA 91739
 (909) 919-2800
 www.nicpartnersinc.com



SITE

SYMBOL LEGEND

- MDF/IDF CABINET
- WALLPHONE
- DATA
- VOICE/DATA
- FIXED CAMERA
- PTZ CAMERA
- WIRELESS CAMERA
- DOME/MINI DOME CAMERA
- DIGITAL VIDEO RECORDER
- SPEAKER CLOCK
- SPEAKER
- WAP
- PROJECTOR
- WIRE CABLE
- UG WIRE CABLE
- FIBER OPTIC CABLE
- UG FIBER OPTIC CABLE
- CONDUIT
- VAULT/PULL BOX
- UTILITY BOX
- NAME/ID DENOTES UNIT ID/REFERENCE NAME
- DTL/SHT DENOTES DTL REFERENCE/SHT NO.

Covina Valley Unified School District
 Telecommunication

Project Name and Address
 Las Palmas Middle School
 641 N Lark Ellen Ave.
 Covina, CA 91722


Description
 SITE PLAN (EAST)

Date
 MARCH 29, 2017

Drawn By
 R.G.S.

Project
 JOB# xxxxxx

SHEET#
 2 OF 2

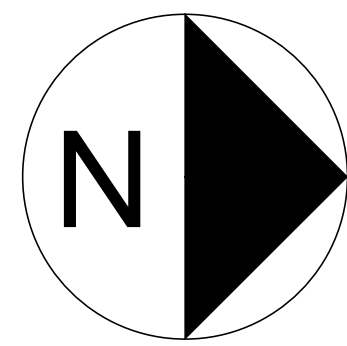

Covina Valley Unified School District
 Las Palmas Middle School
 Telecommunications As-Builts

SHEET SIZE: 36" x 24"
 SCALE: NOT TO SCALE



SITE



SYMBOL LEGEND

	MDF/IDF CABINET
	WALLPHONE
	DATA
	VOICE/DATA
	FIXED CAMERA DENOTES APPROXIMATE VIEW ANGLE/DIRECTION
	PTZ CAMERA
	WIRELESS CAMERA
	DOME/MINI DOME CAMERA
	DIGITAL VIDEO RECORDER
	SPEAKER CLOCK
	SPEAKER
	WAP
	PROJECTOR
	WIRE CABLE
	UG WIRE CABLE
	FIBER OPTIC CABLE
	UG FIBER OPTIC CABLE
	CONDUIT
	SLEEVE
	ROOF/COVER PROFILE ABOVE
	NAME/ID DENOTES UNIT ID/REFERENCE NAME
	DTL/SHT DENOTES DTL REFERENCE/SHT NO.

Covina Valley Unified School District
 Telecommunication

Project Name and Address
 Manzanita Elementary School
 4131 N Nora Ave.
 Covina, CA 91722

Description	SITE PLAN
Date	MARCH 23, 2017
Drawn By	R.G.S.
Project	JOB# xxxxxx
SHEET#	1 OF 2

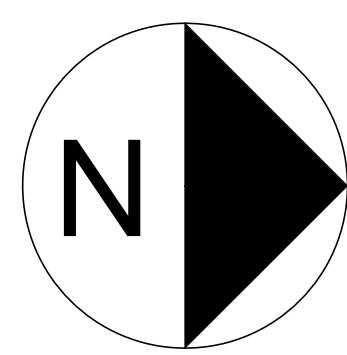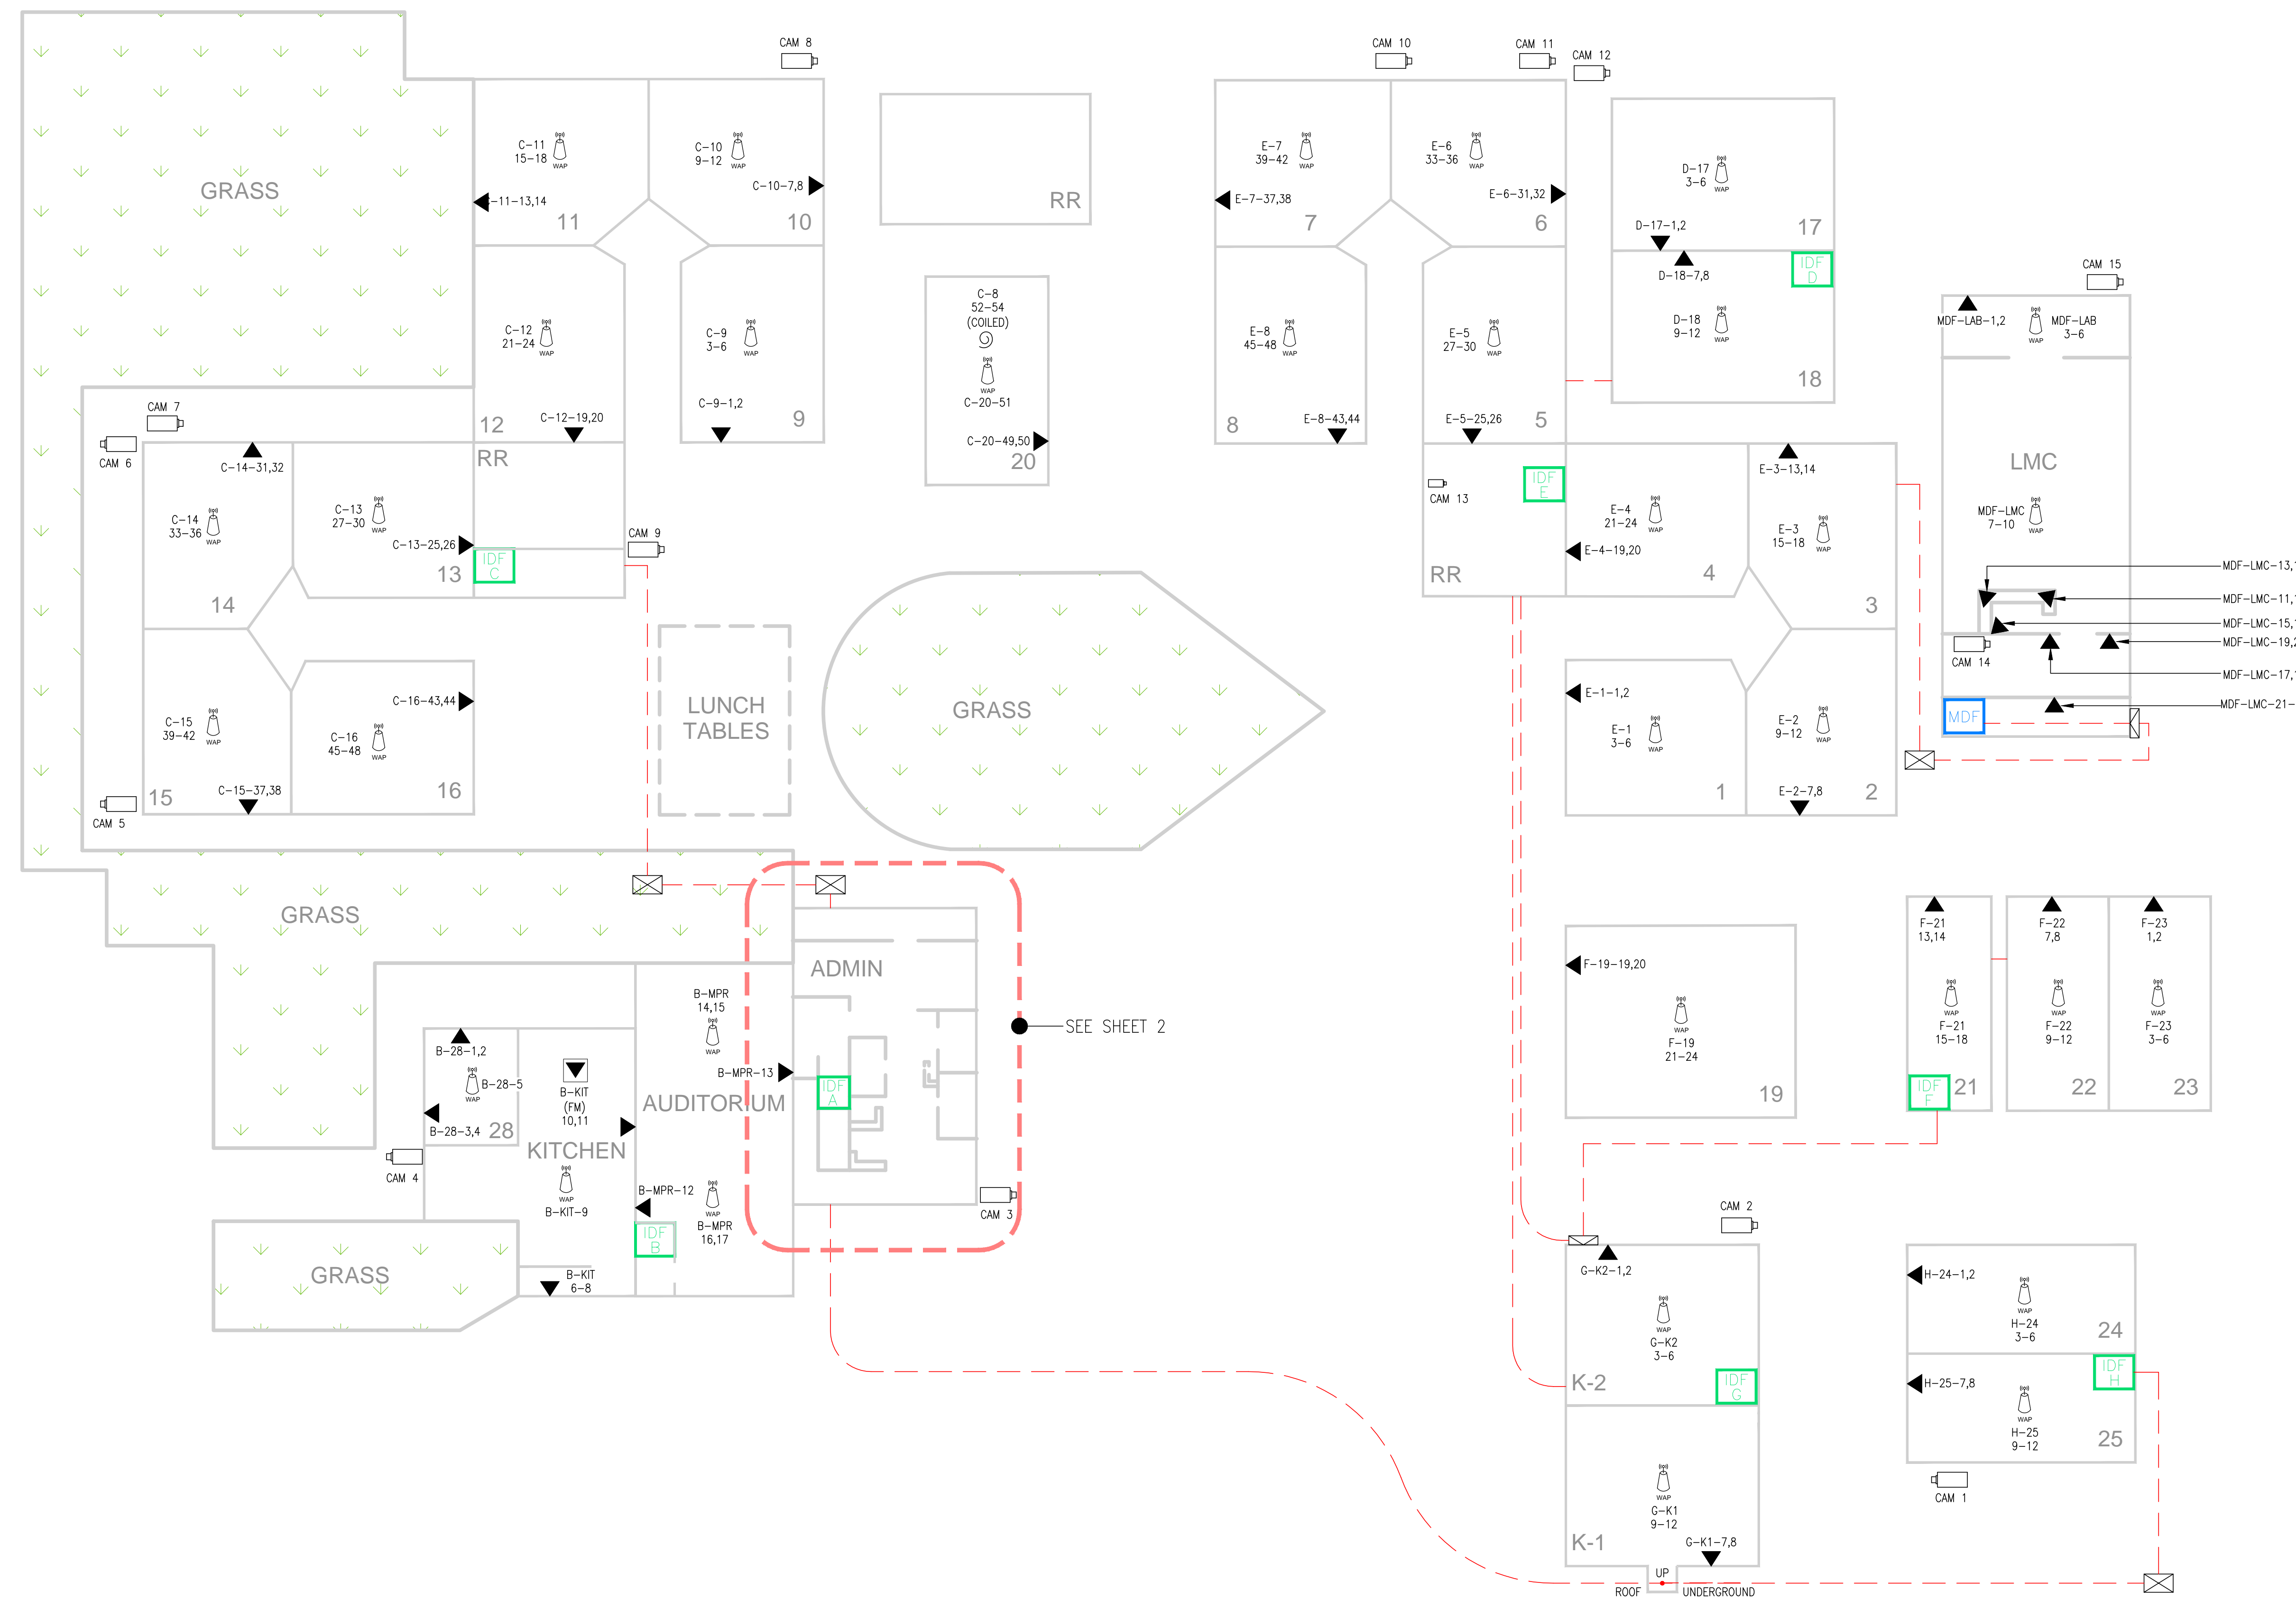



SITE

SYMBOL LEGEND

	MDF/IDF CABINET
	WALLPHONE
	DATA
	VOICE/DATA
	FIXED CAMERA
	PTZ CAMERA
	WIRELESS CAMERA
	DOME/MINI DOME CAMERA
	DIGITAL VIDEO RECORDER
	SPEAKER CLOCK
	SPEAKER
	WAP
	PROJECTOR
	WIRE CABLE
	UG WIRE CABLE
	FIBER OPTIC CABLE
	UG FIBER OPTIC CABLE
	CONDUIT
	VAULT/PULL BOX
	UTILITY BOX
	NAME/ID
	DTL/SHT

Covina Valley Unified School District
Telecommunication

Project Name and Address
Merwin Elementary School
16125 Cypress Street
Covina, CA 91722


DESCRIPTION
SITE PLAN

Date:
MARCH 28, 2017


Drawn By:
R.G.S.

Project:
JOB# xxxxxx

SHEET#
1 OF 2

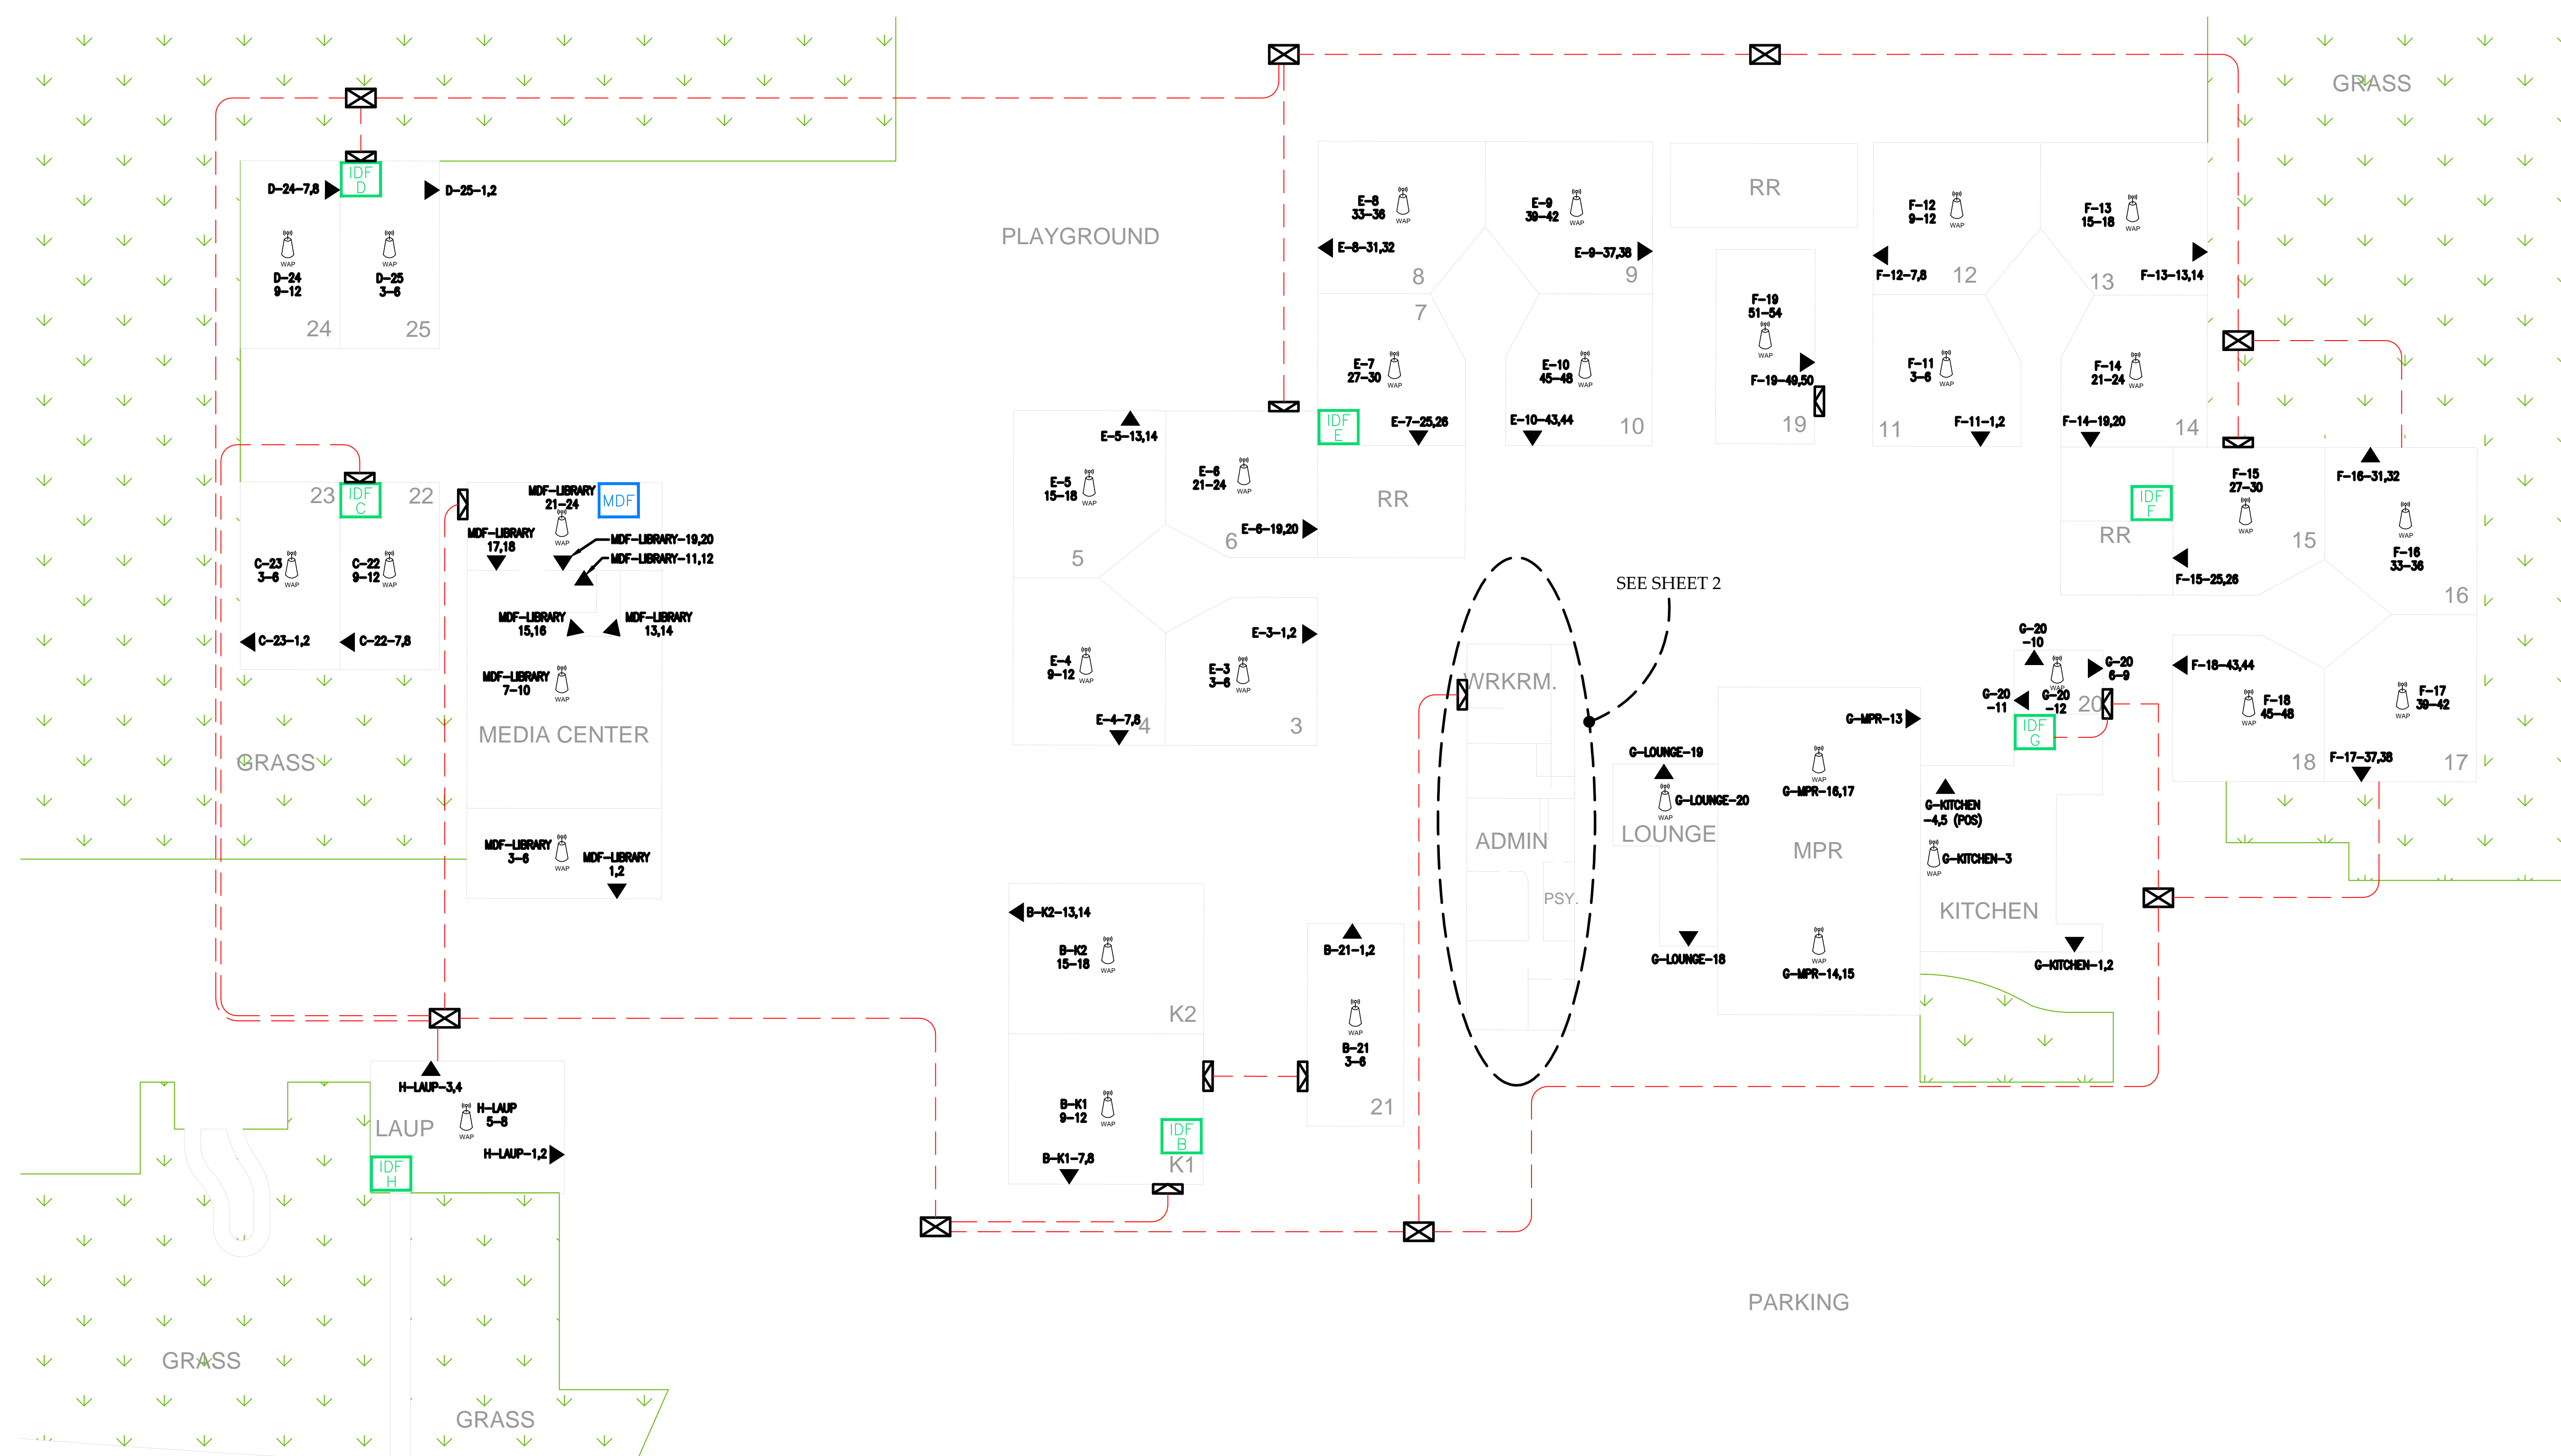


EAST CYPRESS STREET

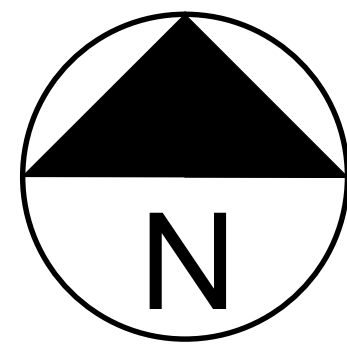


Covina Valley Unified School District
Merwin Elementary School
Telecommunications As-Built

SHEET SIZE: 36" x 24"
SCALE: NOT TO SCALE

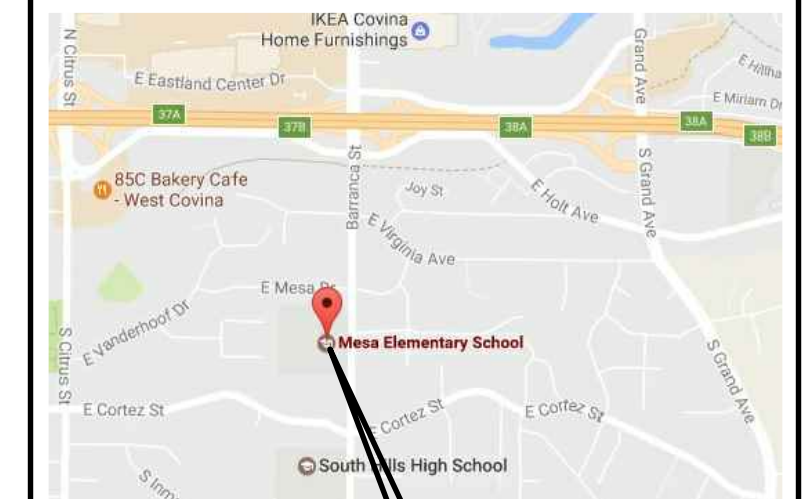


SITE

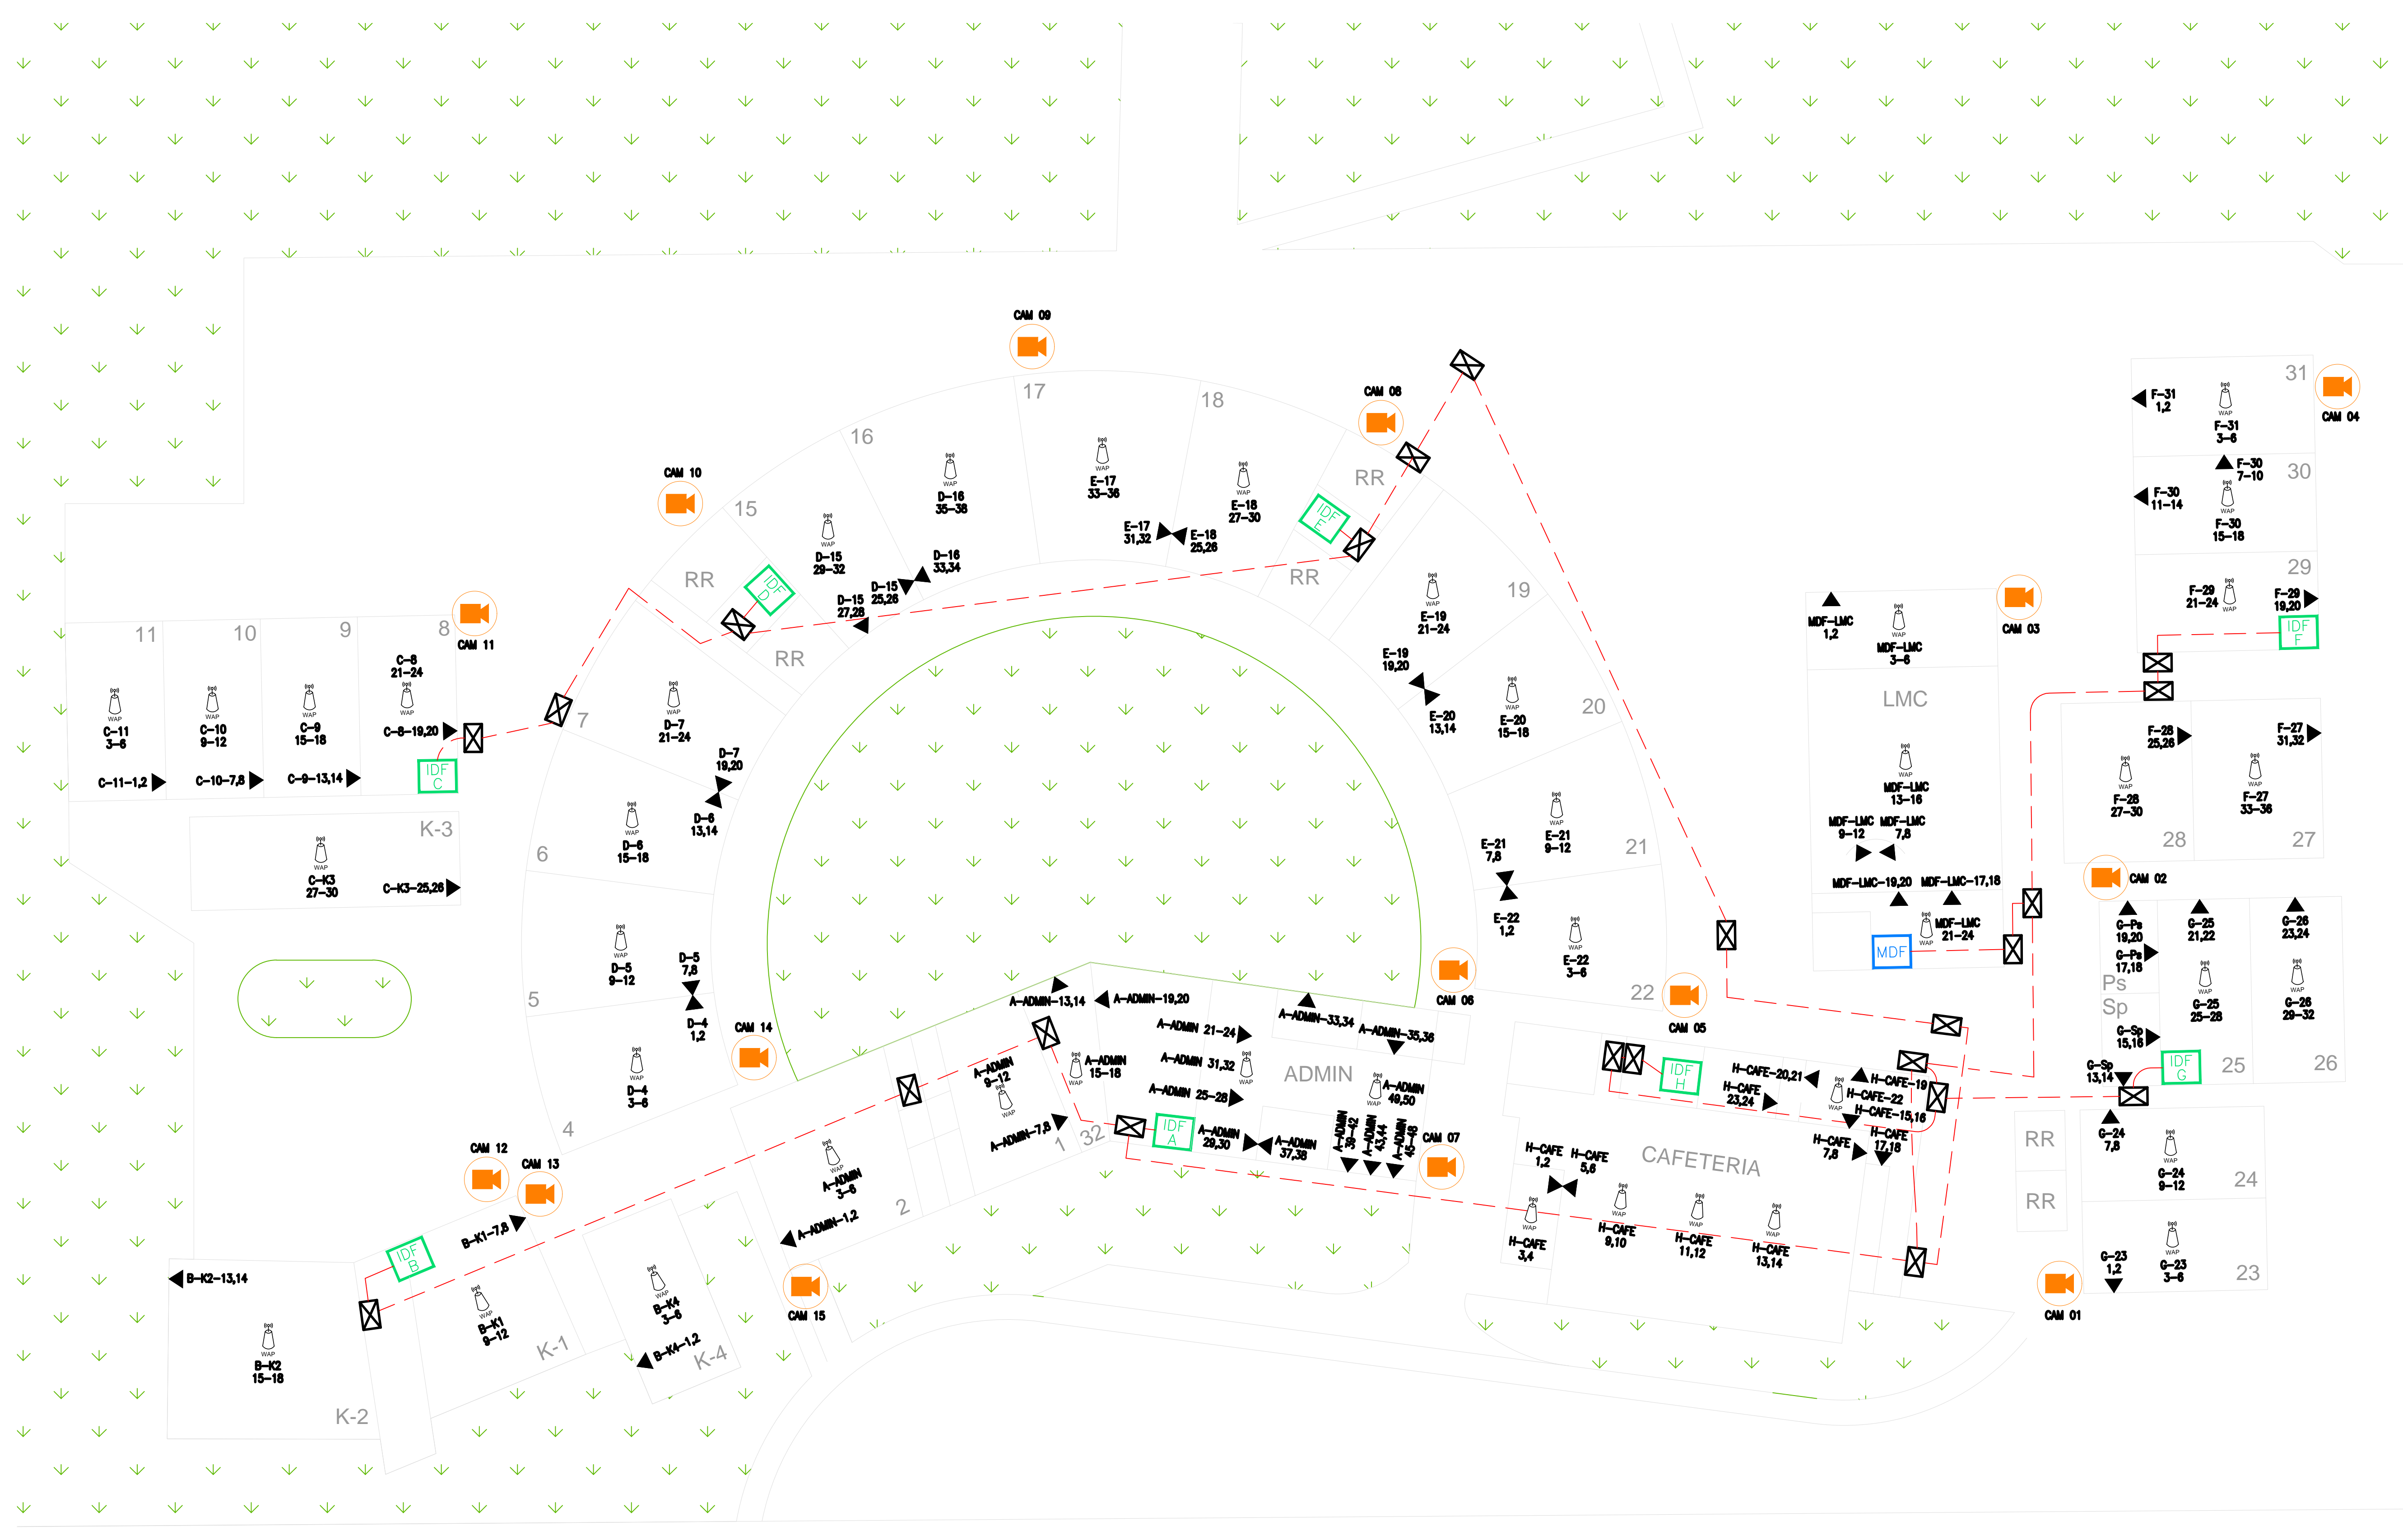

- MDF MAIN DISTRIBUTION FRAME (MDF)
- IDF #XX INTERMEDIATE DISTRIBUTION FRAME (IDF)
- DATA - WALL DROPS
- CAMERA
- VAULT
- WIRELESS ACCESS POINT
- FIBER BACK BONE PATH

SOUTH BARRANCA STREET

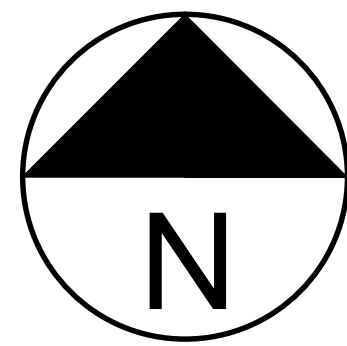

Covina Valley Unified School District
 Mesa Elementary School
 Telecommunications As-Builts

SHEET SIZE: 36" x 24"
 SCALE: NOT TO SCALE

Covina Valley Unified School District Telecommunication
Project Name and Address Mesa Elementary School 409 S Barranca Ave Covina, CA 91723
Description SITE PLAN
Date FEB. 24, 2017
Drawn By R.G.S.
Project JOB# xxxxxx
Sheet# 1 OF 1




SYMBOL LEGEND

- MDF/IDF CABINET
- WALLPHONE
- DATA
- VOICE/DATA
- FIXED CAMERA
DENOTES APPROXIMATE VIEW ANGLE/DIRECTION
- PTZ CAMERA
- WIRELESS CAMERA
- DOME/MINI DOME CAMERA
- DIGITAL VIDEO RECORDER
- SPEAKER CLOCK
- SPEAKER
- WAP
- PROJECTOR
- WIRE CABLE
- UG WIRE CABLE
- FIBER OPTIC CABLE
- UG FIBER OPTIC CABLE
- CONDUIT
- VAULT/PULL BOX
- UTILITY BOX
- NAME/ID DENOTES UNIT ID/REFERENCE NAME
- DTL/SHT DENOTES DTL REFERENCE/SHT NO.


**Covina Valley Unified School District
 Telecommunication**

Project Name and Address
 Northview High School
 1016 W. Cypress Street
 Covina, CA 91722

Description
 SITE PLAN (WEST)
 Date
 MARCH 31, 2017
 Drawn By
 R.G.S.
 Project
 JOB# xxxxxx
 SHEET#
 1 OF 3

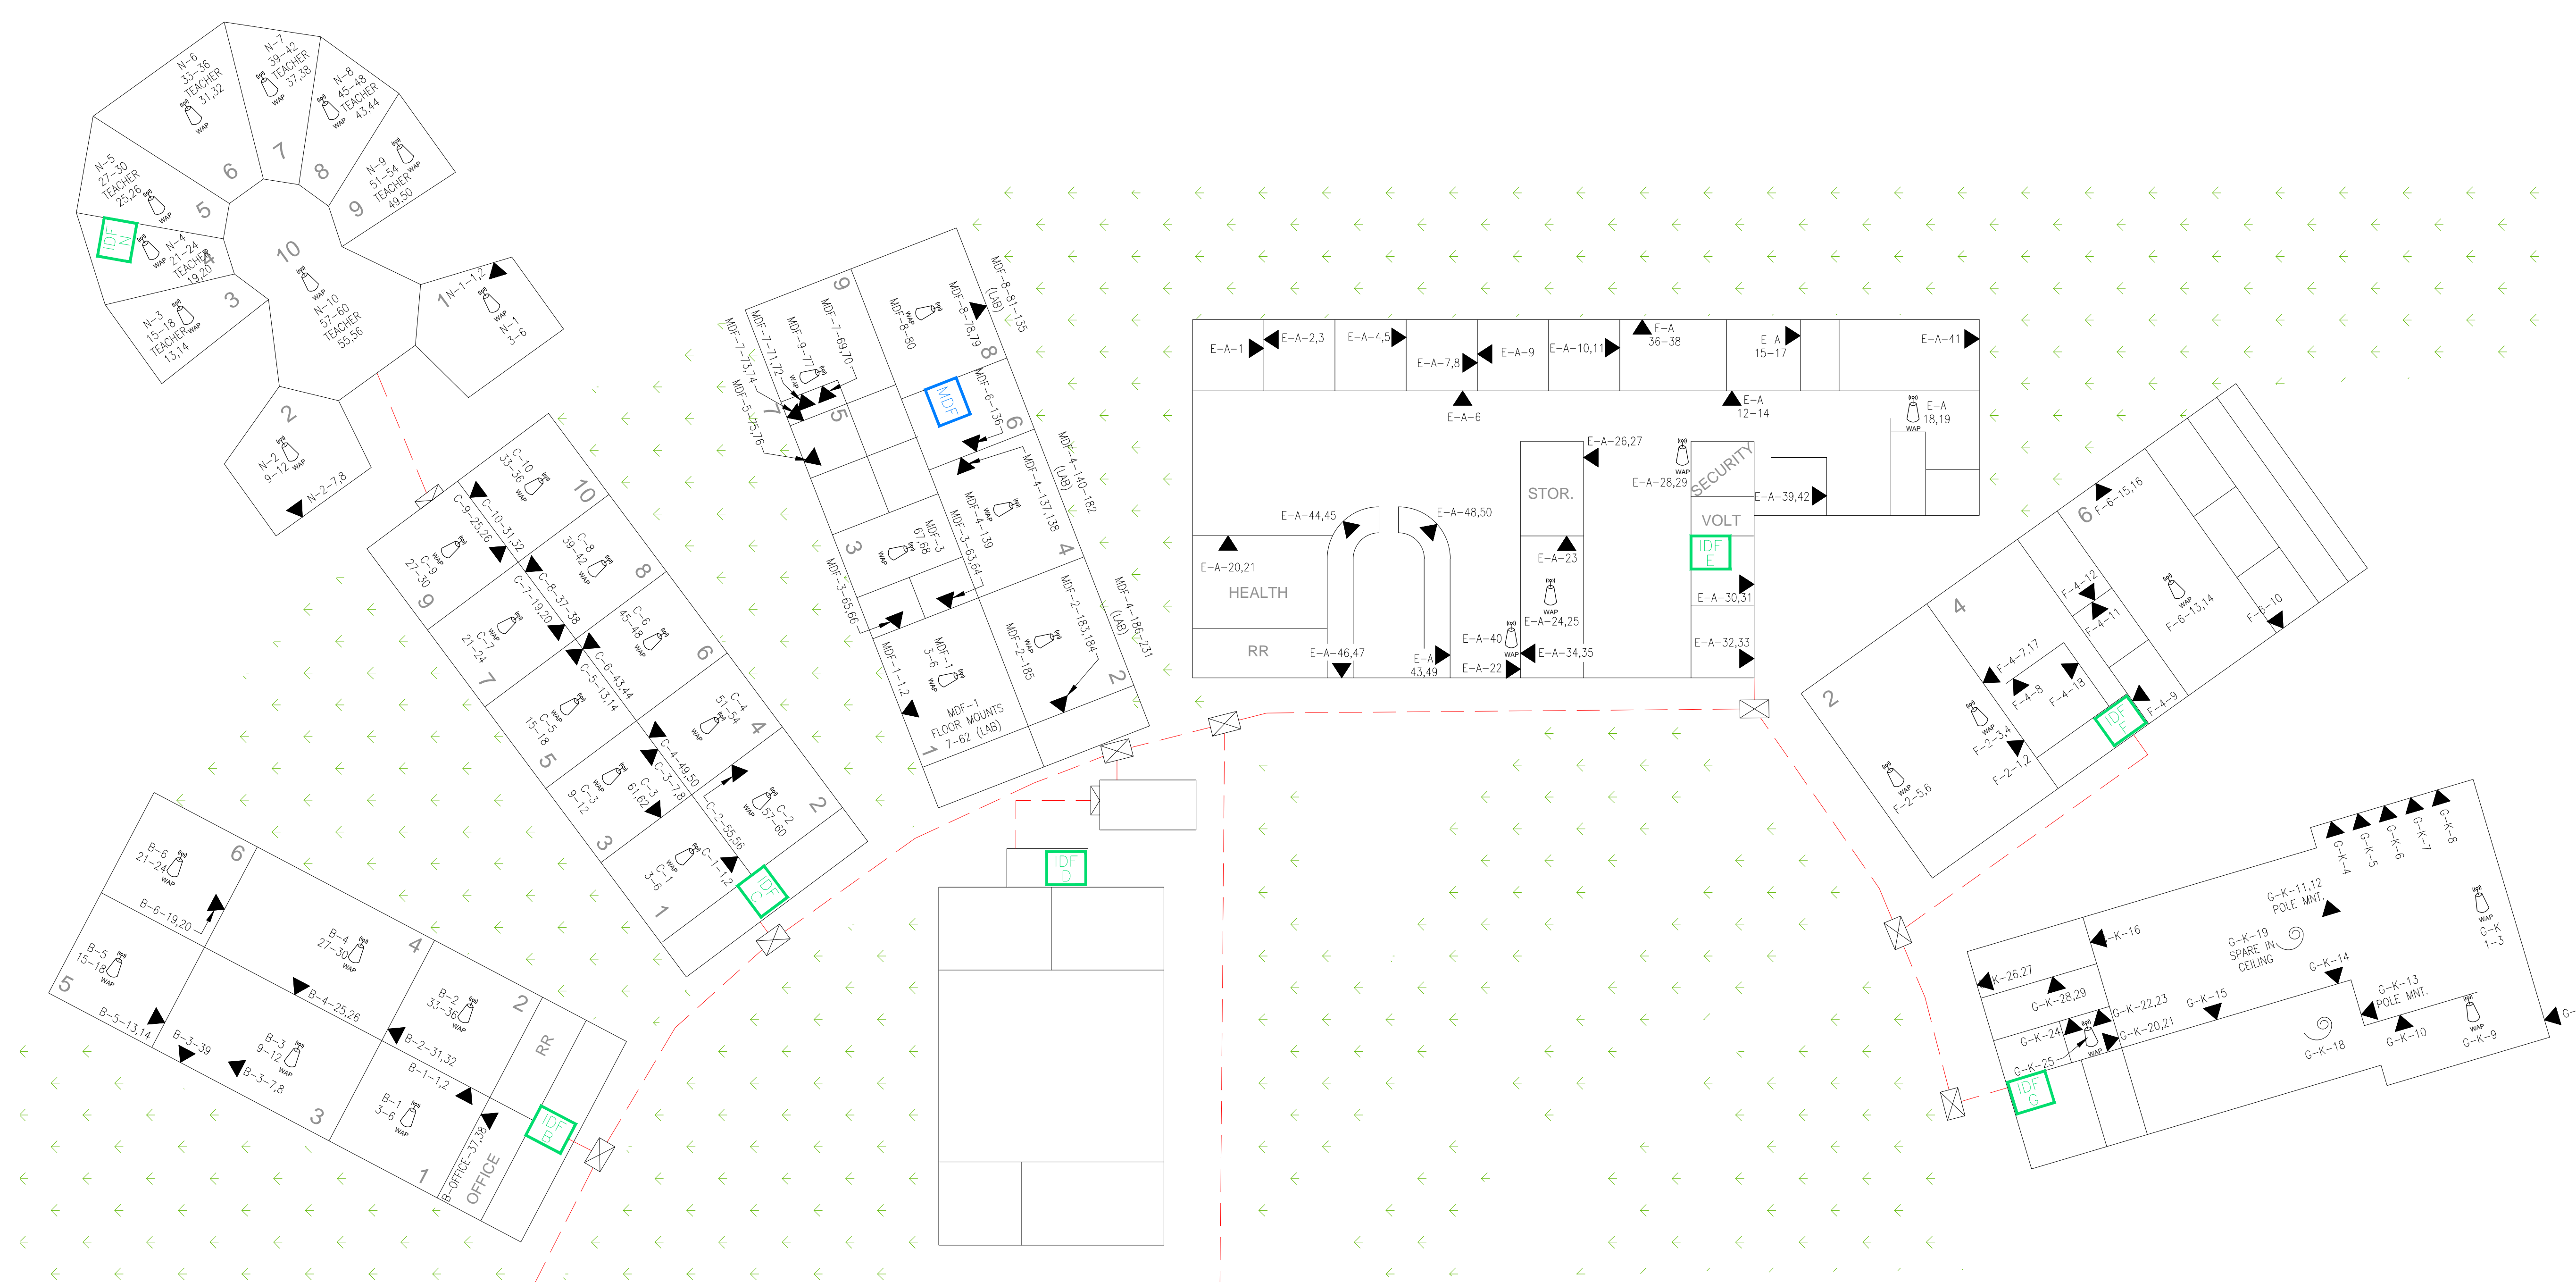

MATCH LINE - SEE SHEET 2

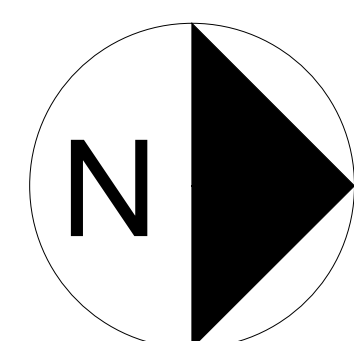

Covina Valley Unified School District
 Northview High School
 Telecommunications As-Builts

SHEET SIZE: 36" x 24"
 SCALE: NOT TO SCALE



SYMBOL LEGEND

- MDF/IDF CABINET
- WALLPHONE
- DATA
- VOICE/DATA
- FIXED CAMERA
- PTZ CAMERA
- WIRELESS CAMERA
- DOME/MINI DOME CAMERA
- DIGITAL VIDEO RECORDER
- SPEAKER CLOCK
- SPEAKER
- WAP
- PROJECTOR
- WIRE CABLE
- UG WIRE CABLE
- FIBER OPTIC CABLE
- UG FIBER OPTIC CABLE
- CONDUIT
- VAULT/PULL BOX
- UTILITY BOX
- NAME/ID DENOTES UNIT ID/REFERENCE NAME
- DTL/SHT DENOTES DTL REFERENCE/SHT NO.

**Covina Valley Unified School District
 Telecommunication**

Project Name and Address
 Northview High School
 1016 W. Cypress Street
 Covina, CA 91722

Description
 SITE PLAN (WEST)



Date
 MARCH 31, 2017


Drawn By
 R.G.S.

Project
 JOB# xxxxxx


SHEET#
 2 OF 3

MATCH LINE - SEE SHEET 1

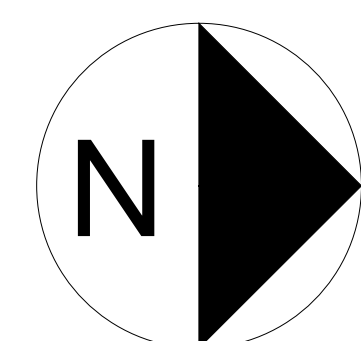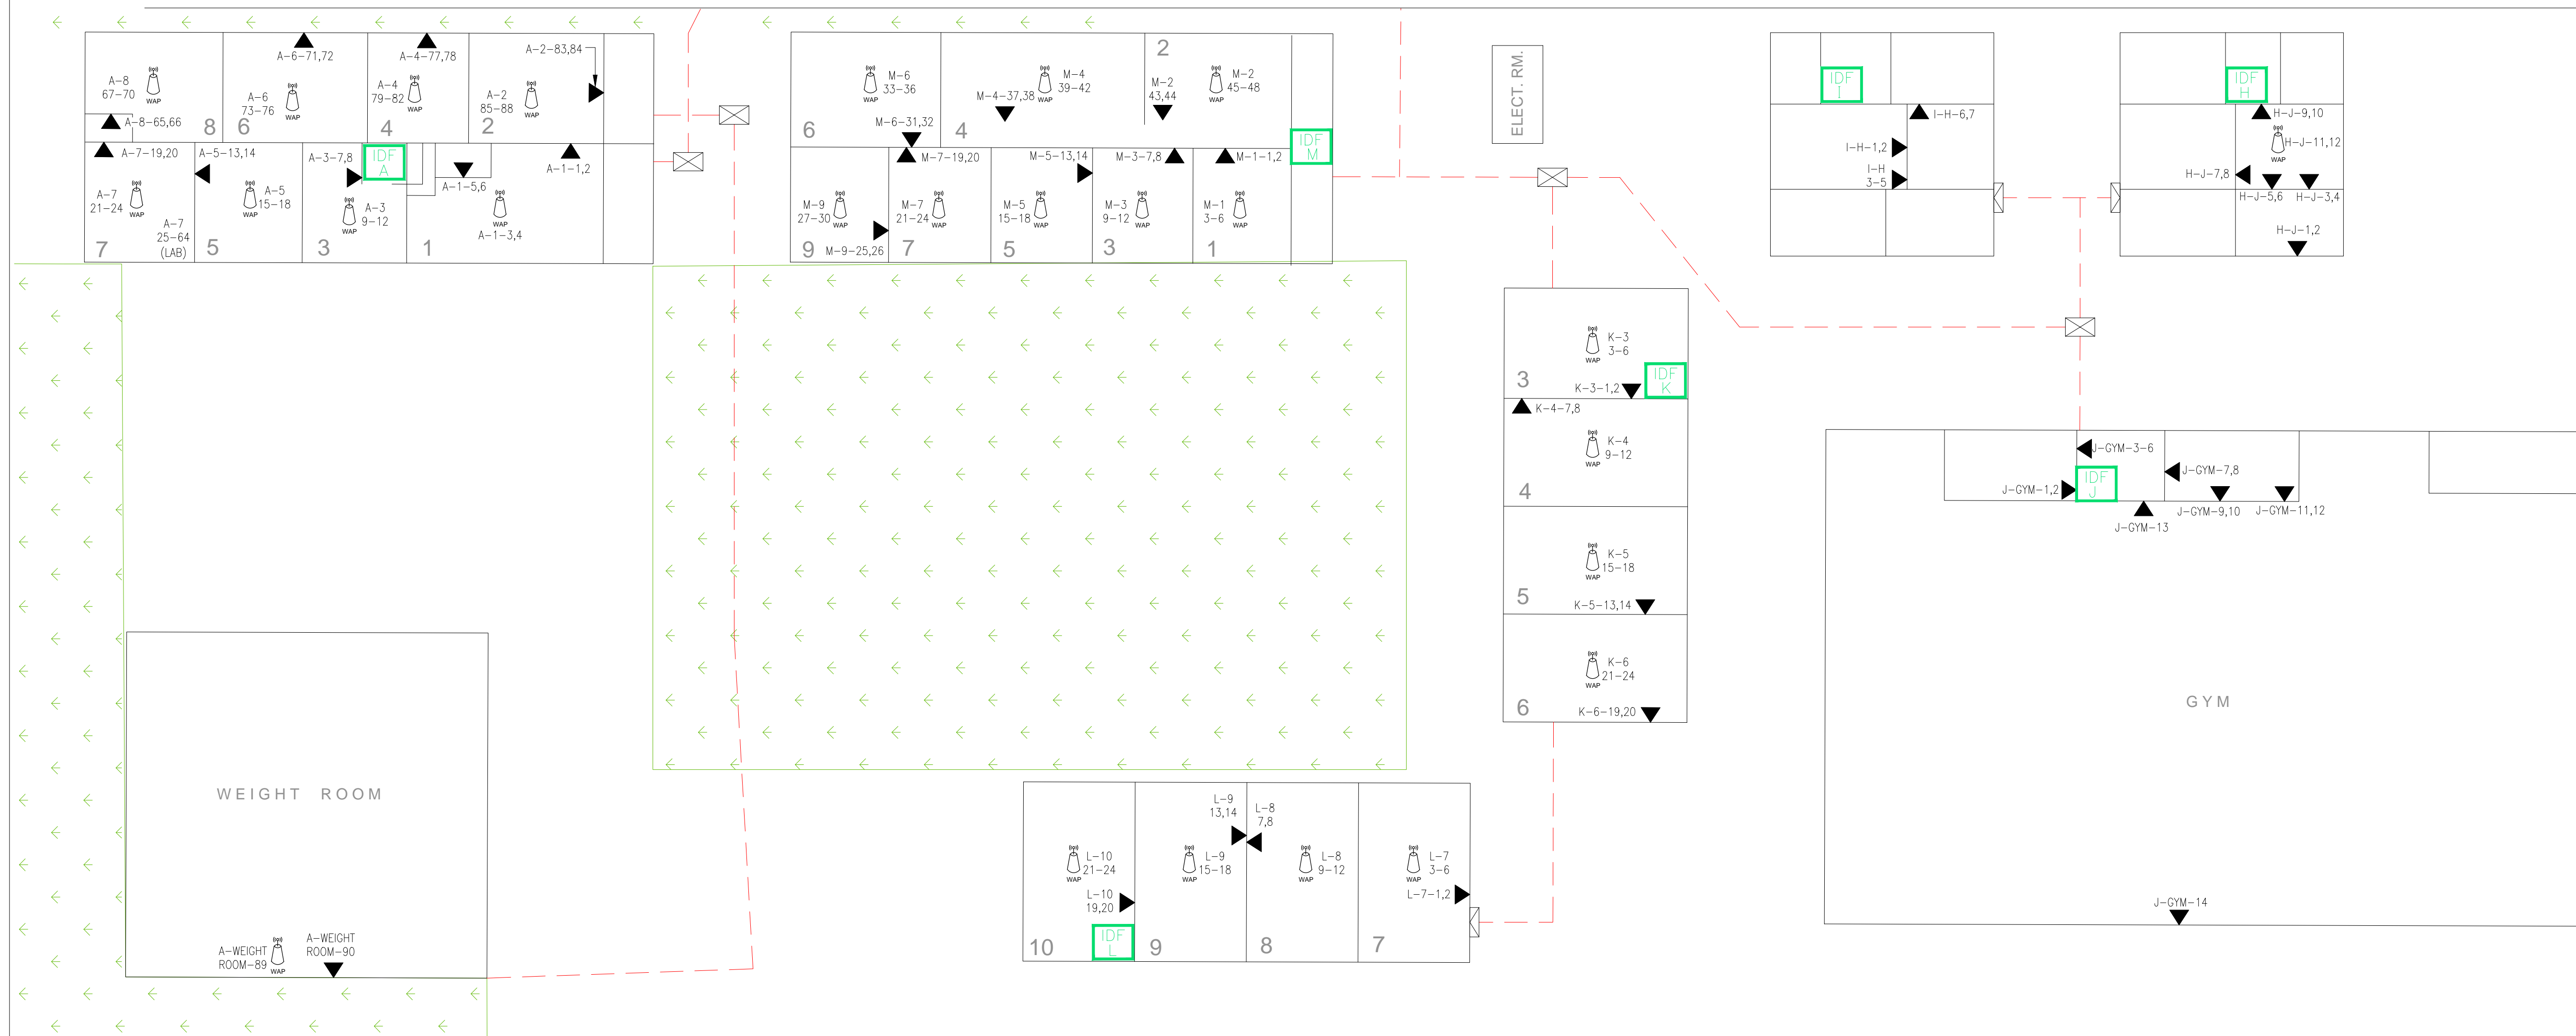


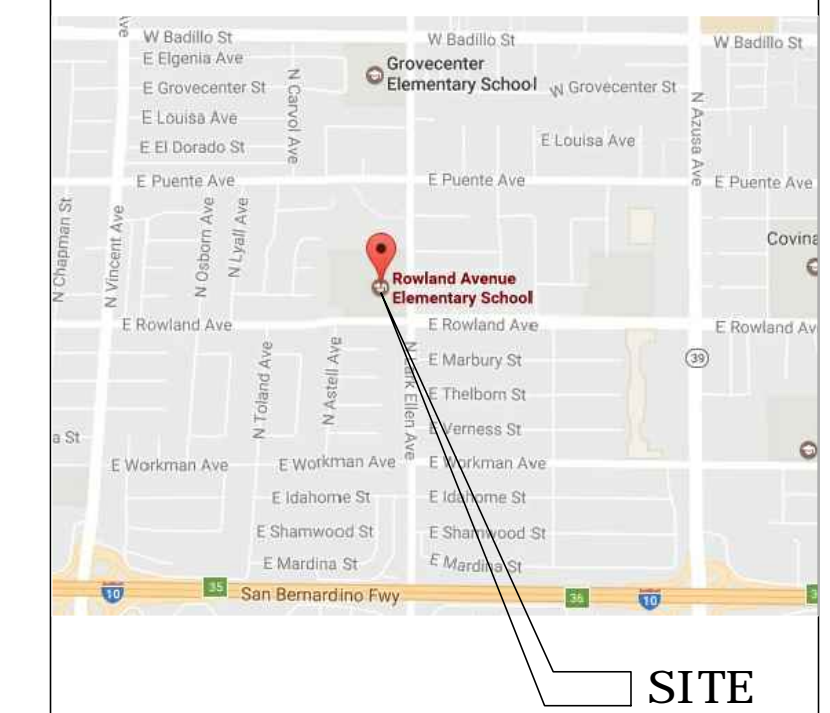

SITE

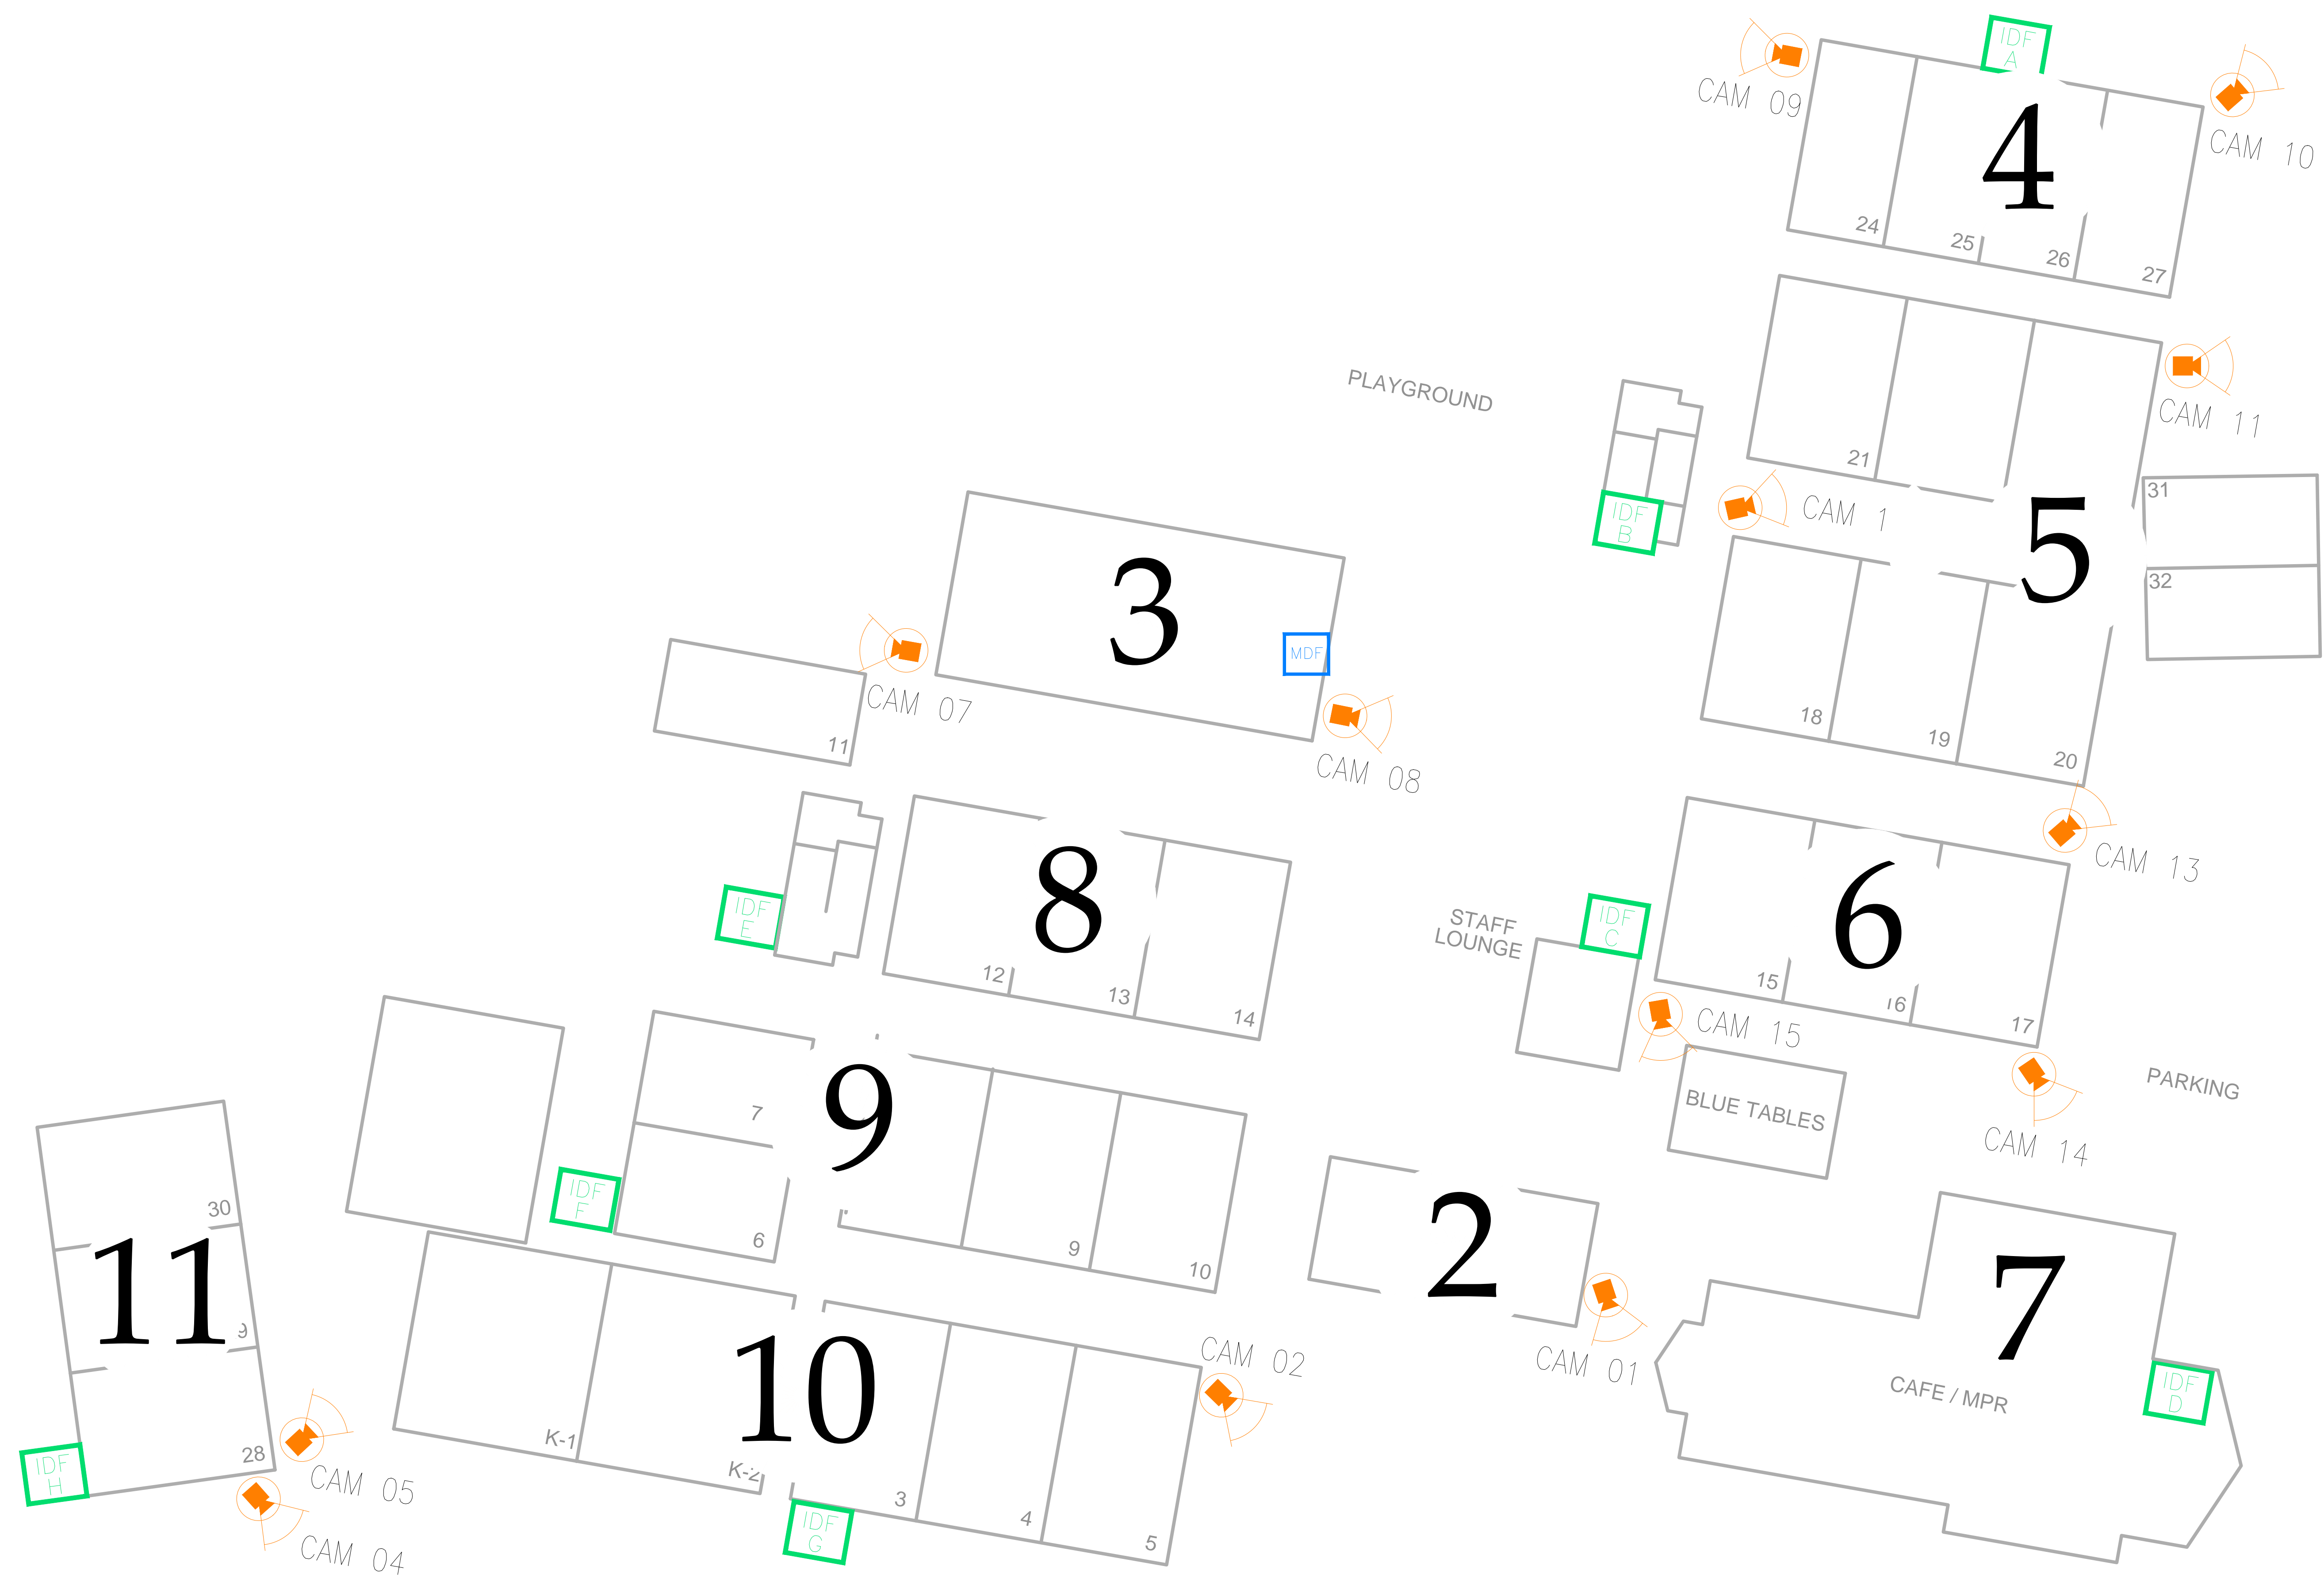

- MDF MAIN DISTRIBUTION FRAME (MDF)
- IDF #XX INTERMEDIATE DISTRIBUTION FRAME (IDF)

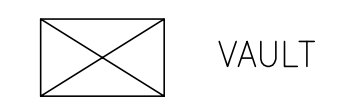

VAULT



FIBER BACK BONE PATH

Covina Valley Unified School District
 Telecommunication

Project Name and Address
 Rowland Avenue Elementary School
 1355 E Rowland Ave
 West Covina, CA 91790


Description
 SITE PLAN AND CAM LOCATIONS

Date
 OCT., 2017

Drawn By
 R.G.S.


Project
 JOB# xxxxxx

SHEET#
 1 OF 11

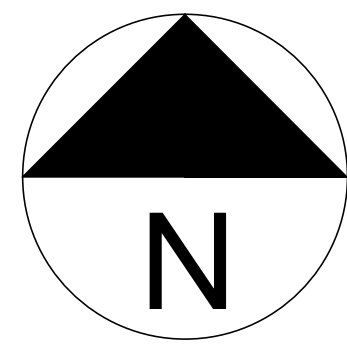


Covina Valley Unified School District
 Rowland Avenue Elementary School
 Telecommunications As-Builts

SHEET SIZE: 36" x 24"
 SCALE: NOT TO SCALE

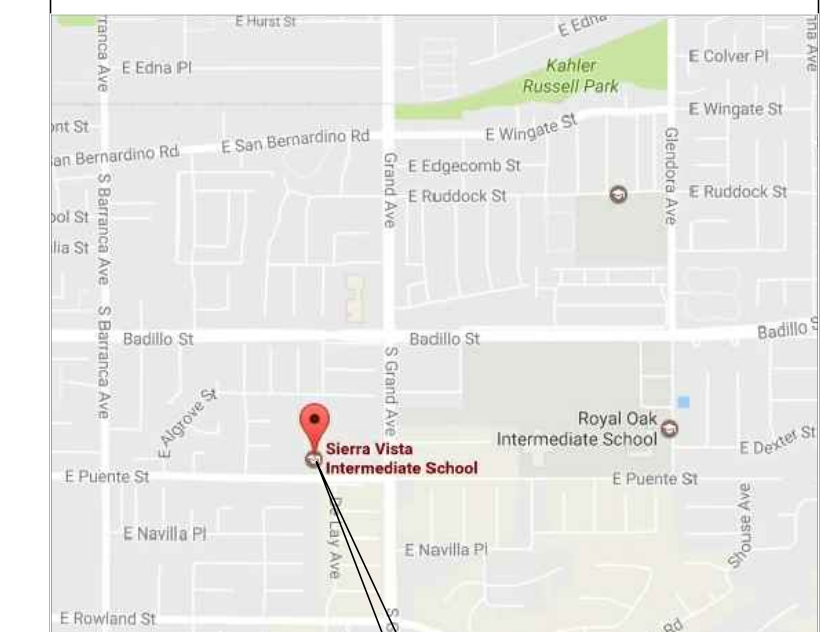

SITE

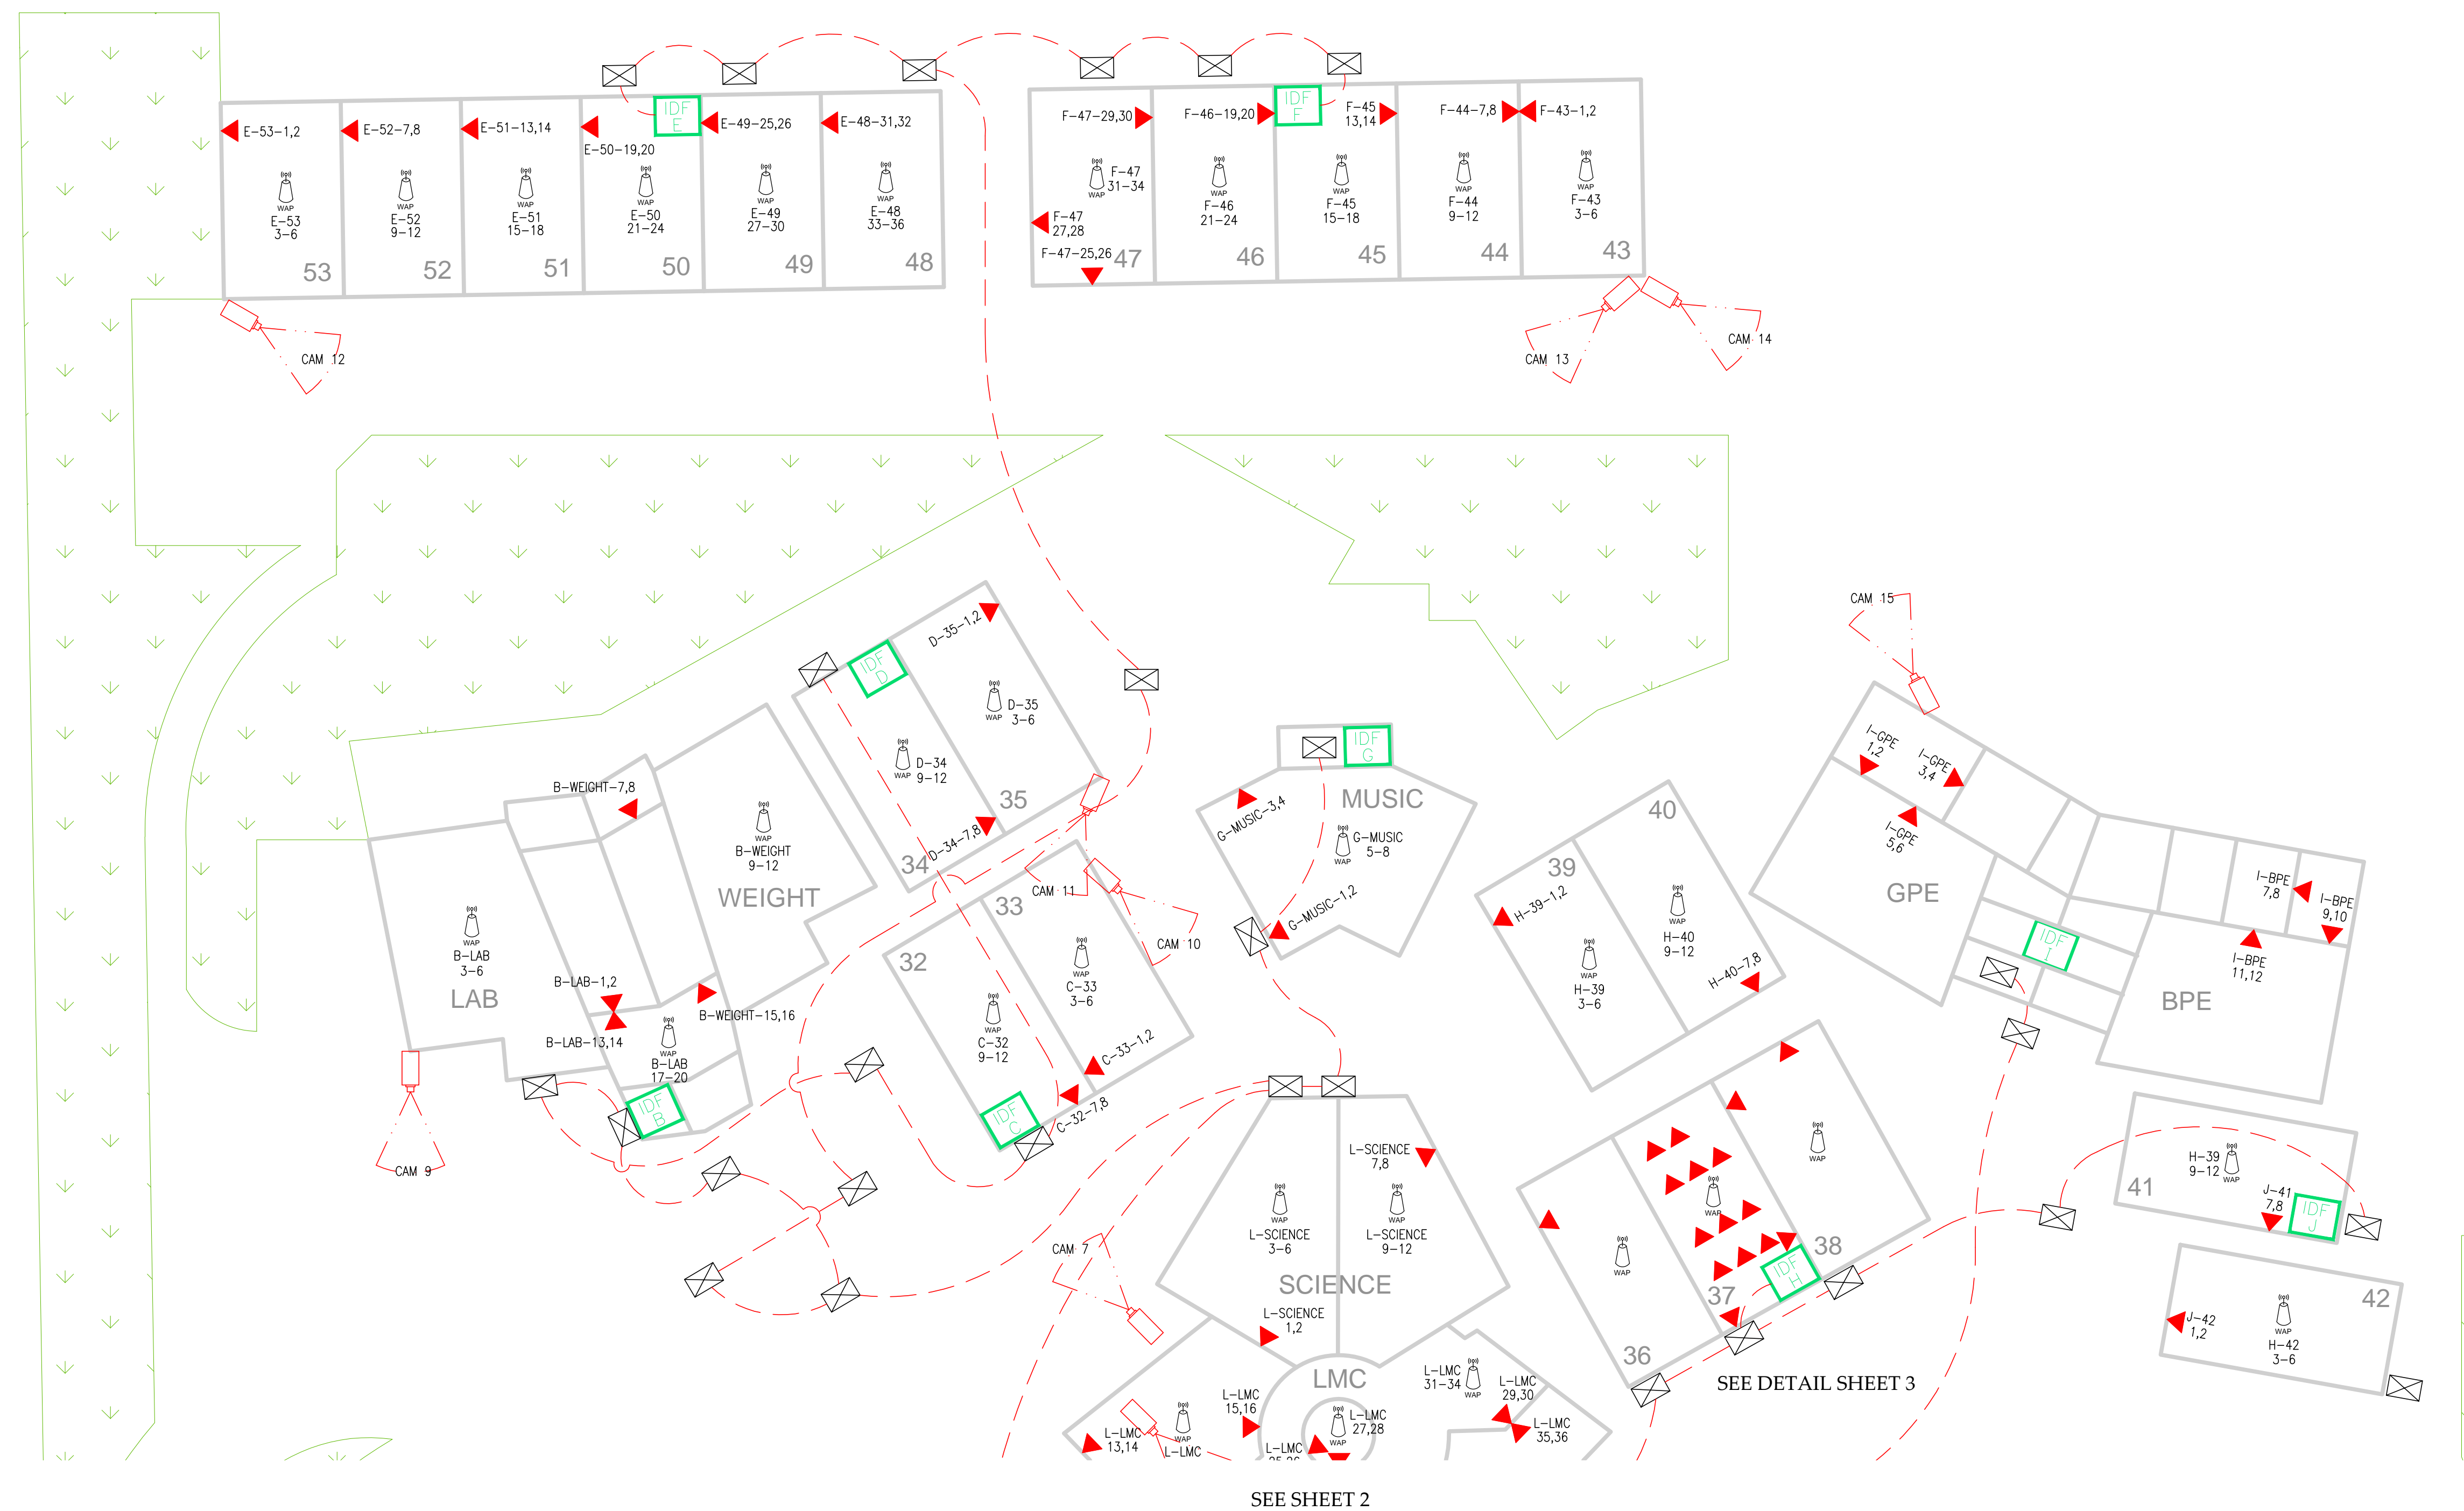

SEE SHEET 2

SEE DETAIL SHEET 3

- MDF MAIN DISTRIBUTION FRAME (MDF)
- IDF #XX INTERMEDIATE DISTRIBUTION FRAME (IDF)
- ▶ DATA - WALL DROPS
- CAM CAMERA
- VAULT VAULT
- WAP WIRELESS ACCESS POINT
- FIBER BACK BONE PATH

**Covina Valley Unified School District
 Telecommunication**

Project Name and Address
 Sierra Vista Middle School
 777 E Puente St.
 Covina, CA 91723


Description
 SITE PLAN - NORTH


Date
 March 8, 2017

Drawn By
 R.G.S.


Project
 JOB# xxxxxx

SHEET#
 1 OF 3

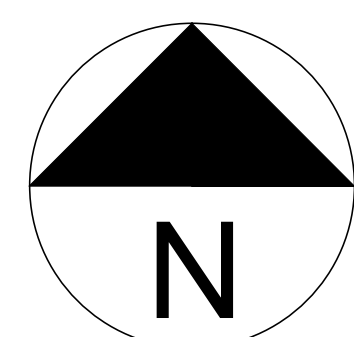

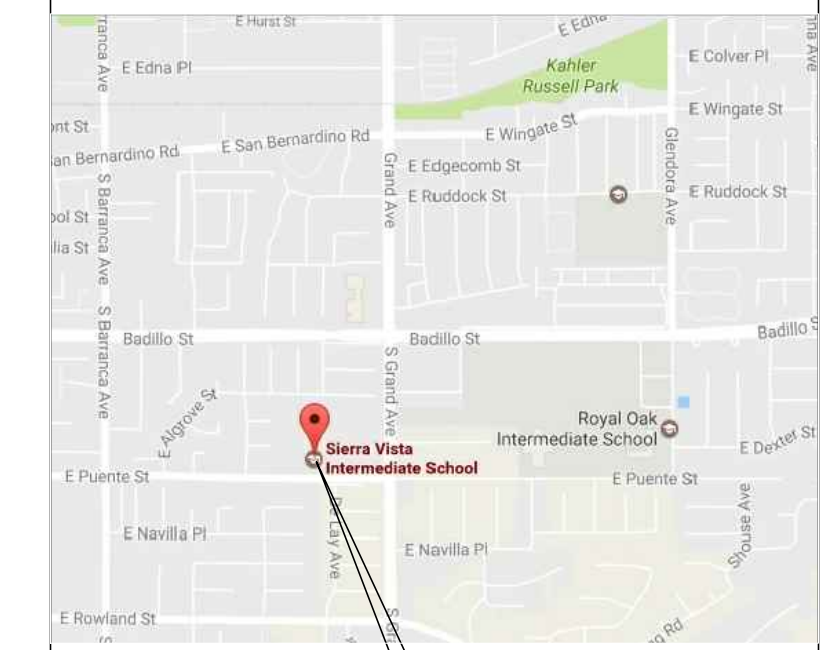

SITE

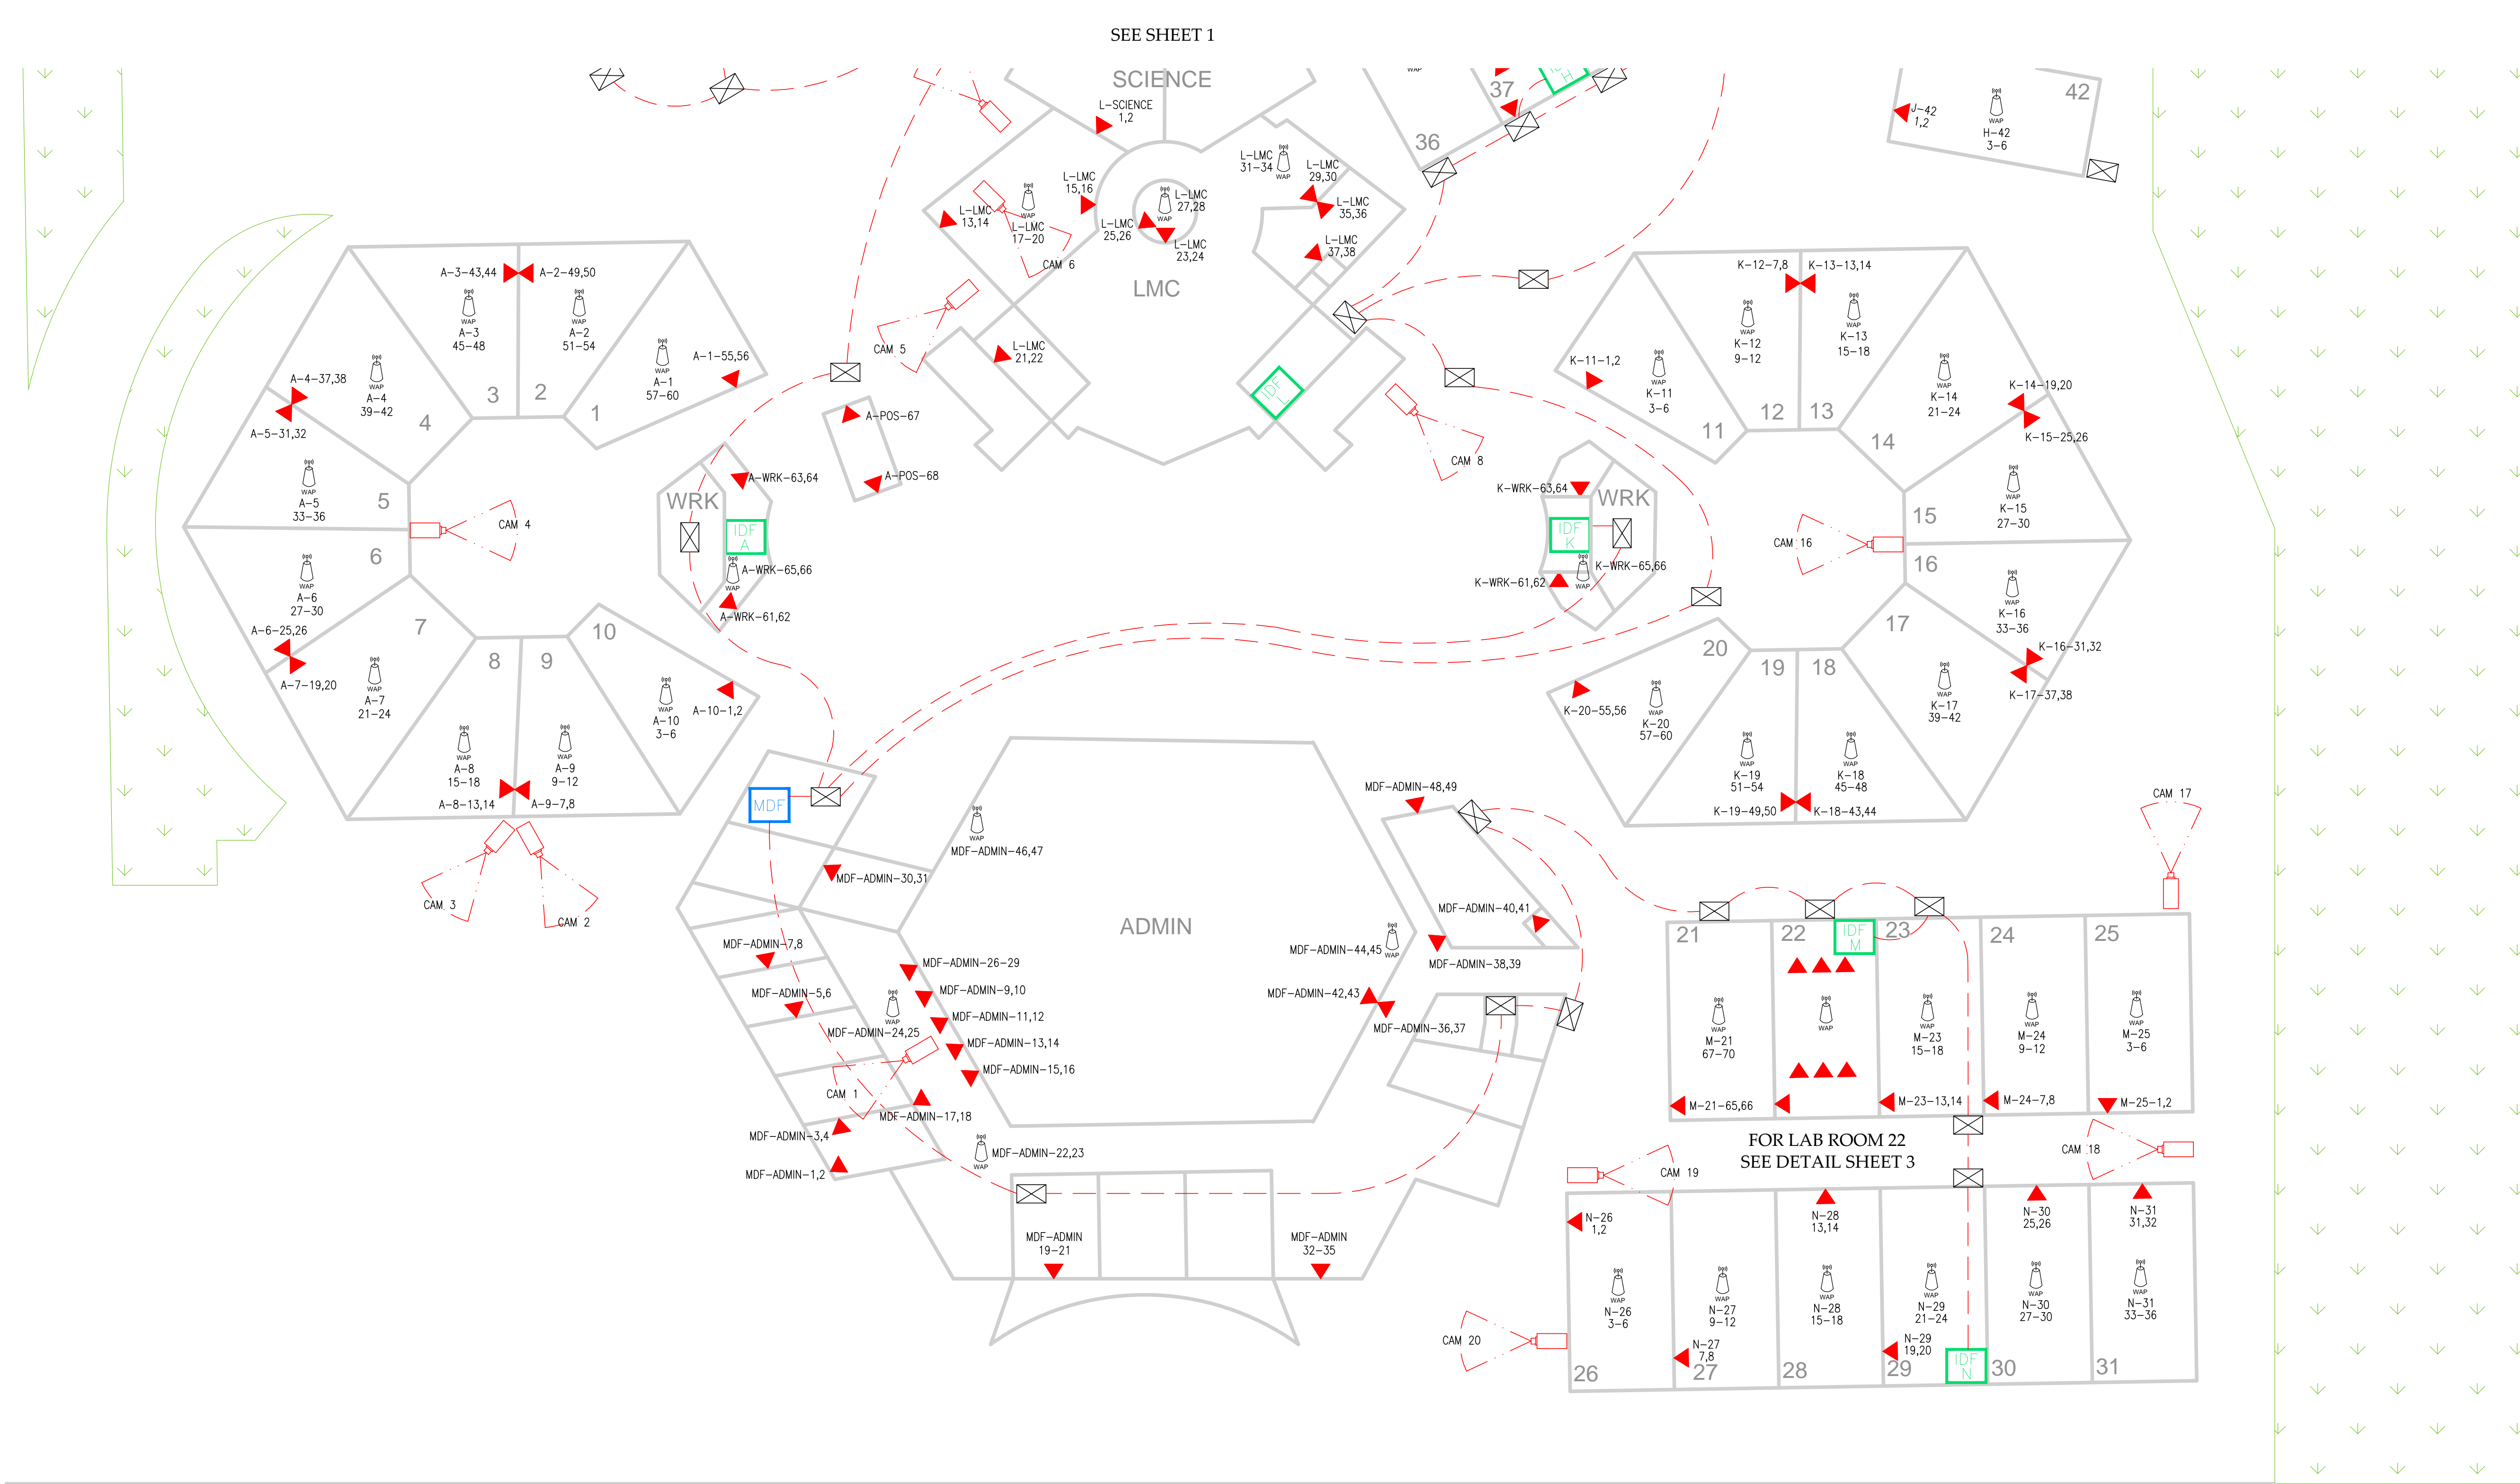

EAST PUENTE STREET

- MAIN DISTRIBUTION FRAME (MDF)
- INTERMEDIATE DISTRIBUTION FRAME (IDF)
- DATA - WALL DROPS
- CAMERA
- VAULT
- WIRELESS ACCESS POINT
- FIBER BACK BONE PATH


Covina Valley Unified School District
 Telecommunication


Project Name and Address
 Sierra Vista Middle School
 777 E Puente St.
 Covina, CA 91723

Description
 SITE PLAN - SOUTH
 Date
 March 8, 2017

Drawn By
 R.G.S.

Project
 JOB# xxxxxx
 SHEET#
 2 OF 3

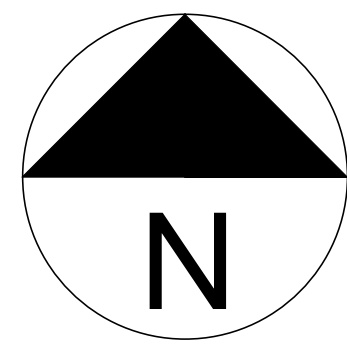

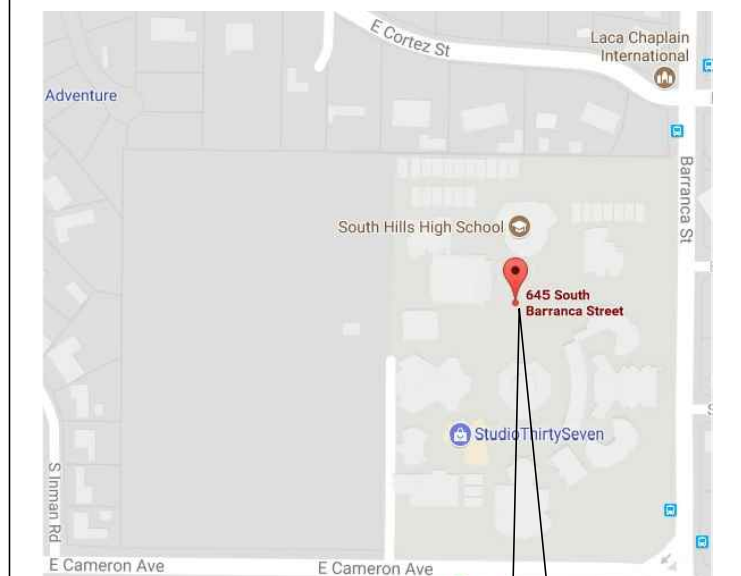

SITE

SYMBOL LEGEND

	MDF/IDF CABINET
	DATA
	FIXED CAMERA DENOTES APPROXIMATE VIEW ANGLE/DIRECTION
	PTZ CAMERA
	WIRELESS CAMERA
	DOME/MINI DOME CAMERA
	DIGITAL VIDEO RECORDER
	SPEAKER CLOCK
	SPEAKER
	WAP
	PROJECTOR
	WIRE CABLE
	UG WIRE CABLE
	FIBER OPTIC CABLE
	UG FIBER OPTIC CABLE
	CONDUIT
	SLEEVE
	ROOF/COVER PROFILE ABOVE
	NAME/ID DENOTES UNIT ID/REFERENCE NAME
	DTL/SHT DENOTES DTL REFERENCE/SHT NO.

**Covina Valley Unified School District
 Telecommunication**

Project Name and Address
 South Hills High School
 645 S Barranca St
 West Covina, CA 91791


**Description
 SITE PLAN**

Date
 AUGUST 11, 2017


Drawn By
 R.G.S.


Project
 JOB# xxxxxx

SHEET#
 18 OF 18

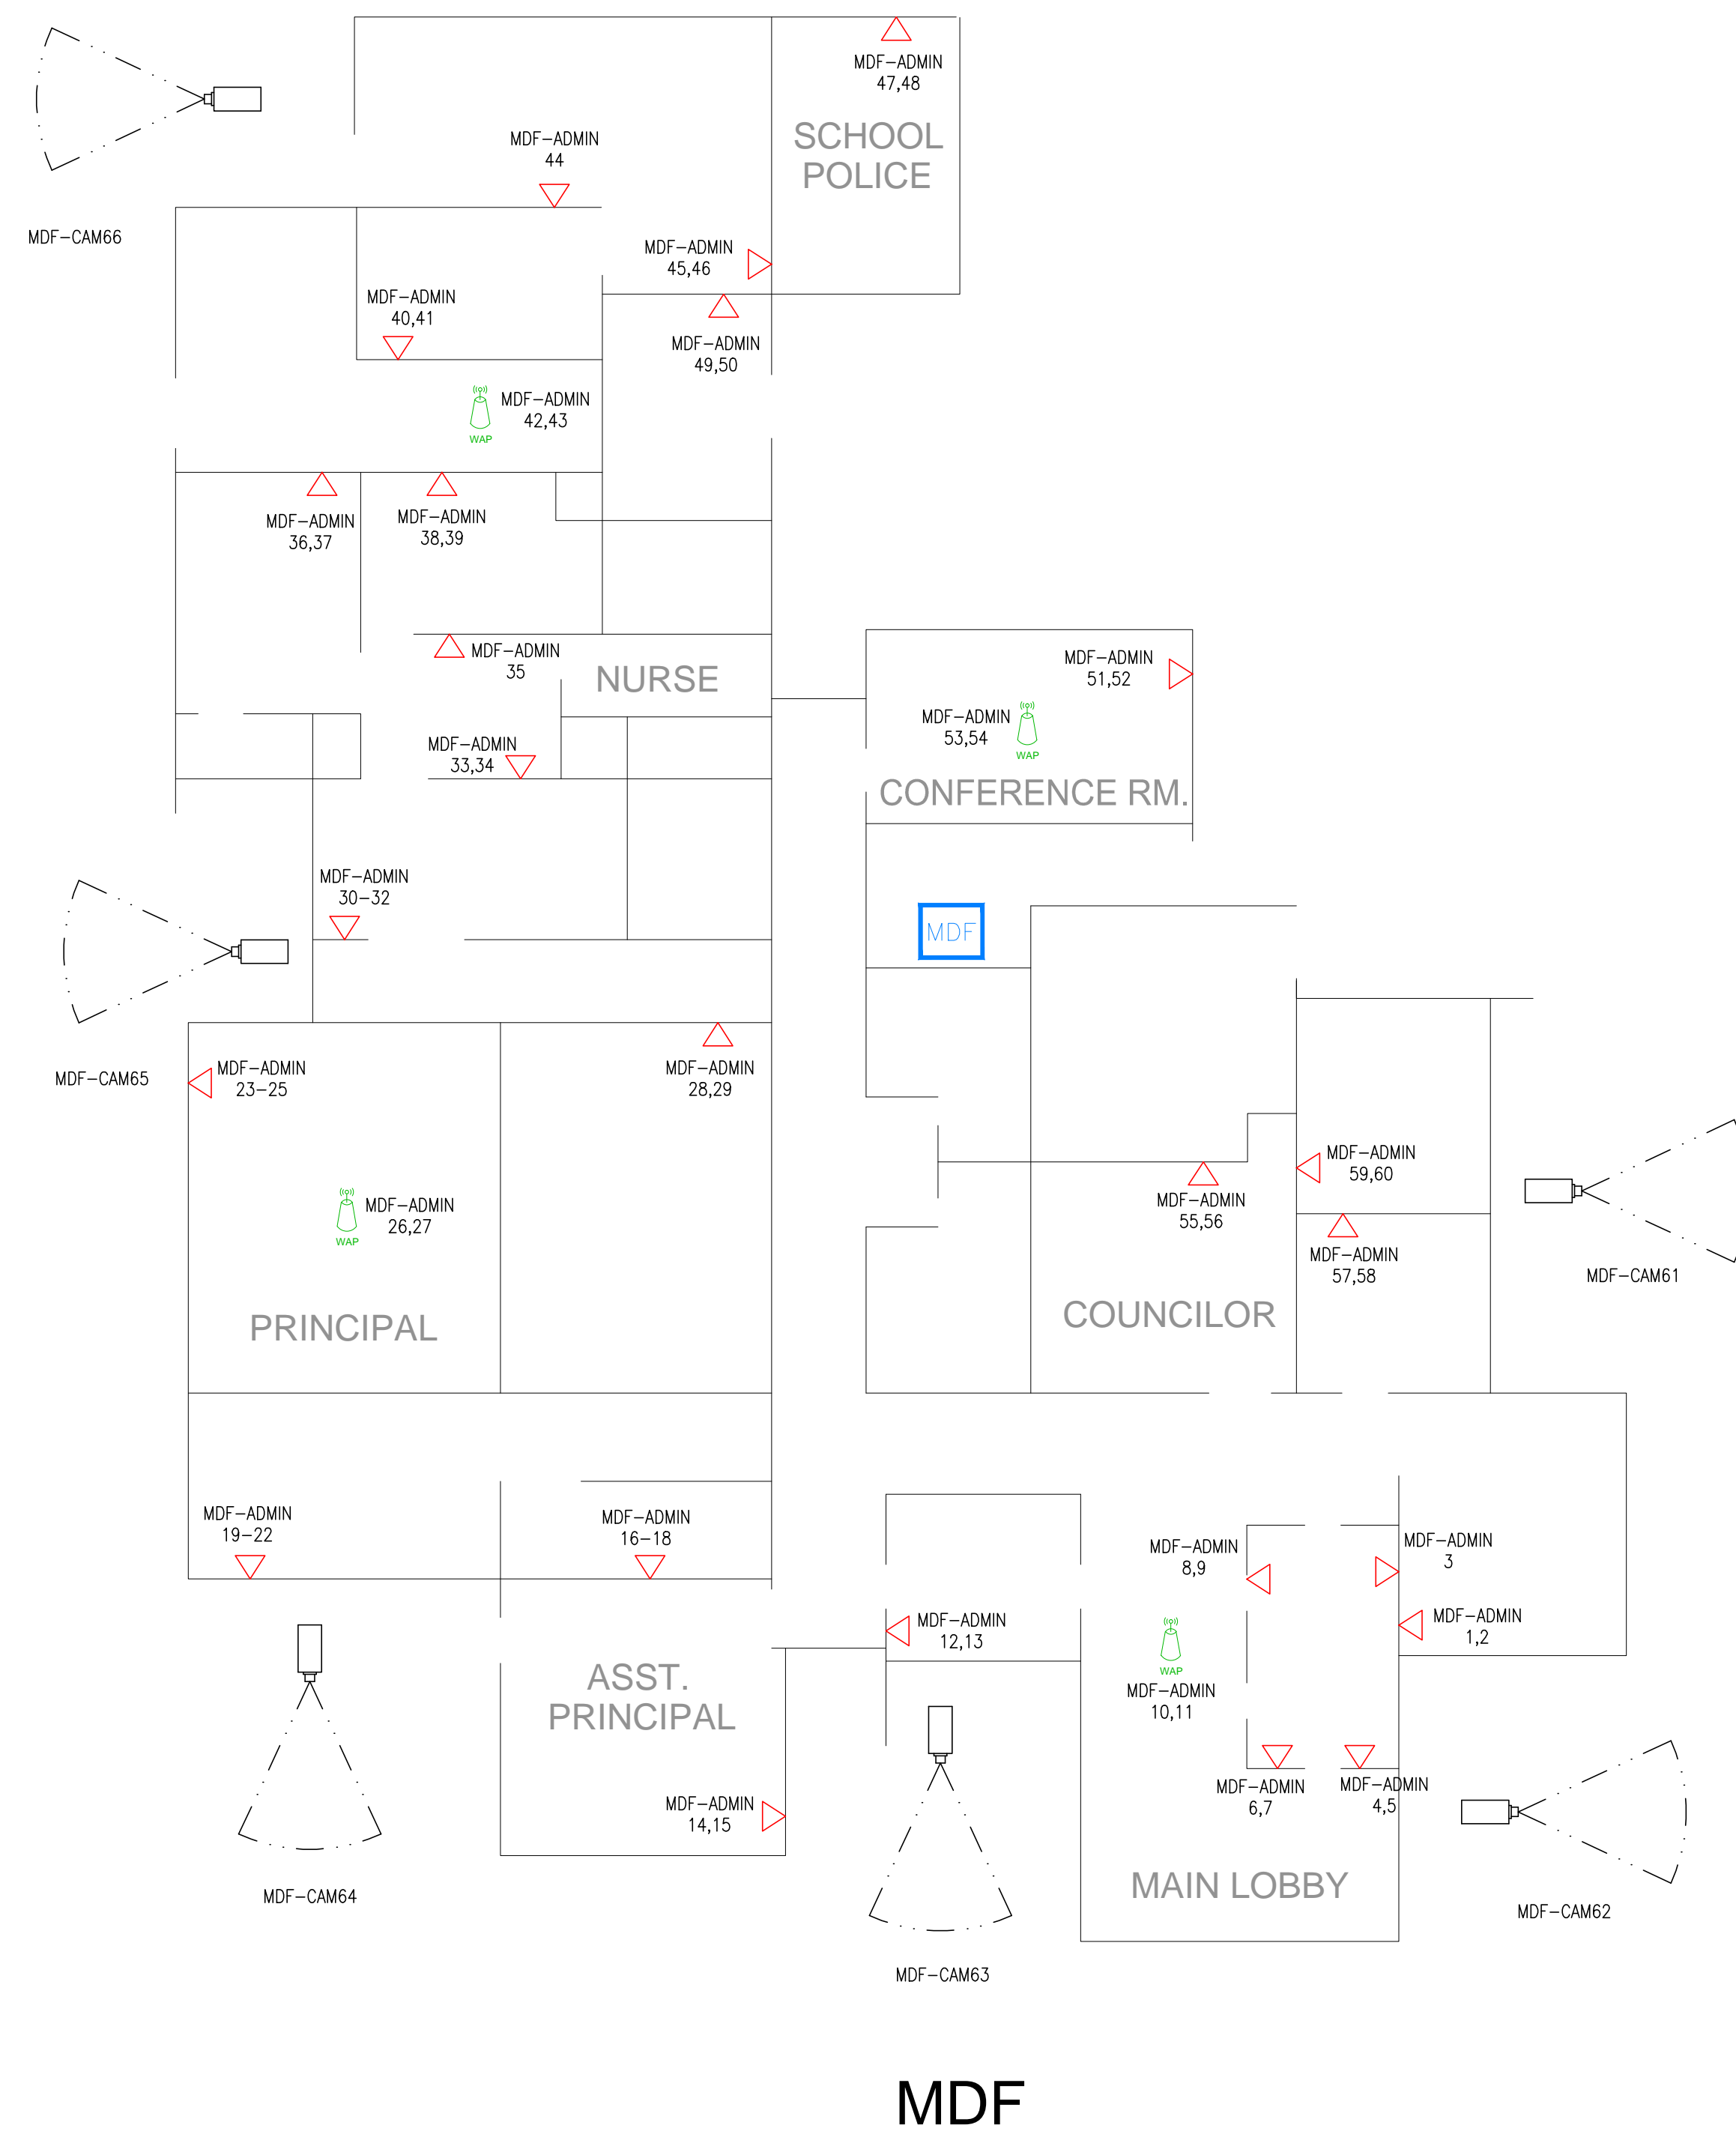

MDF

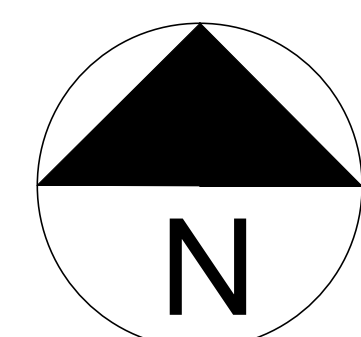

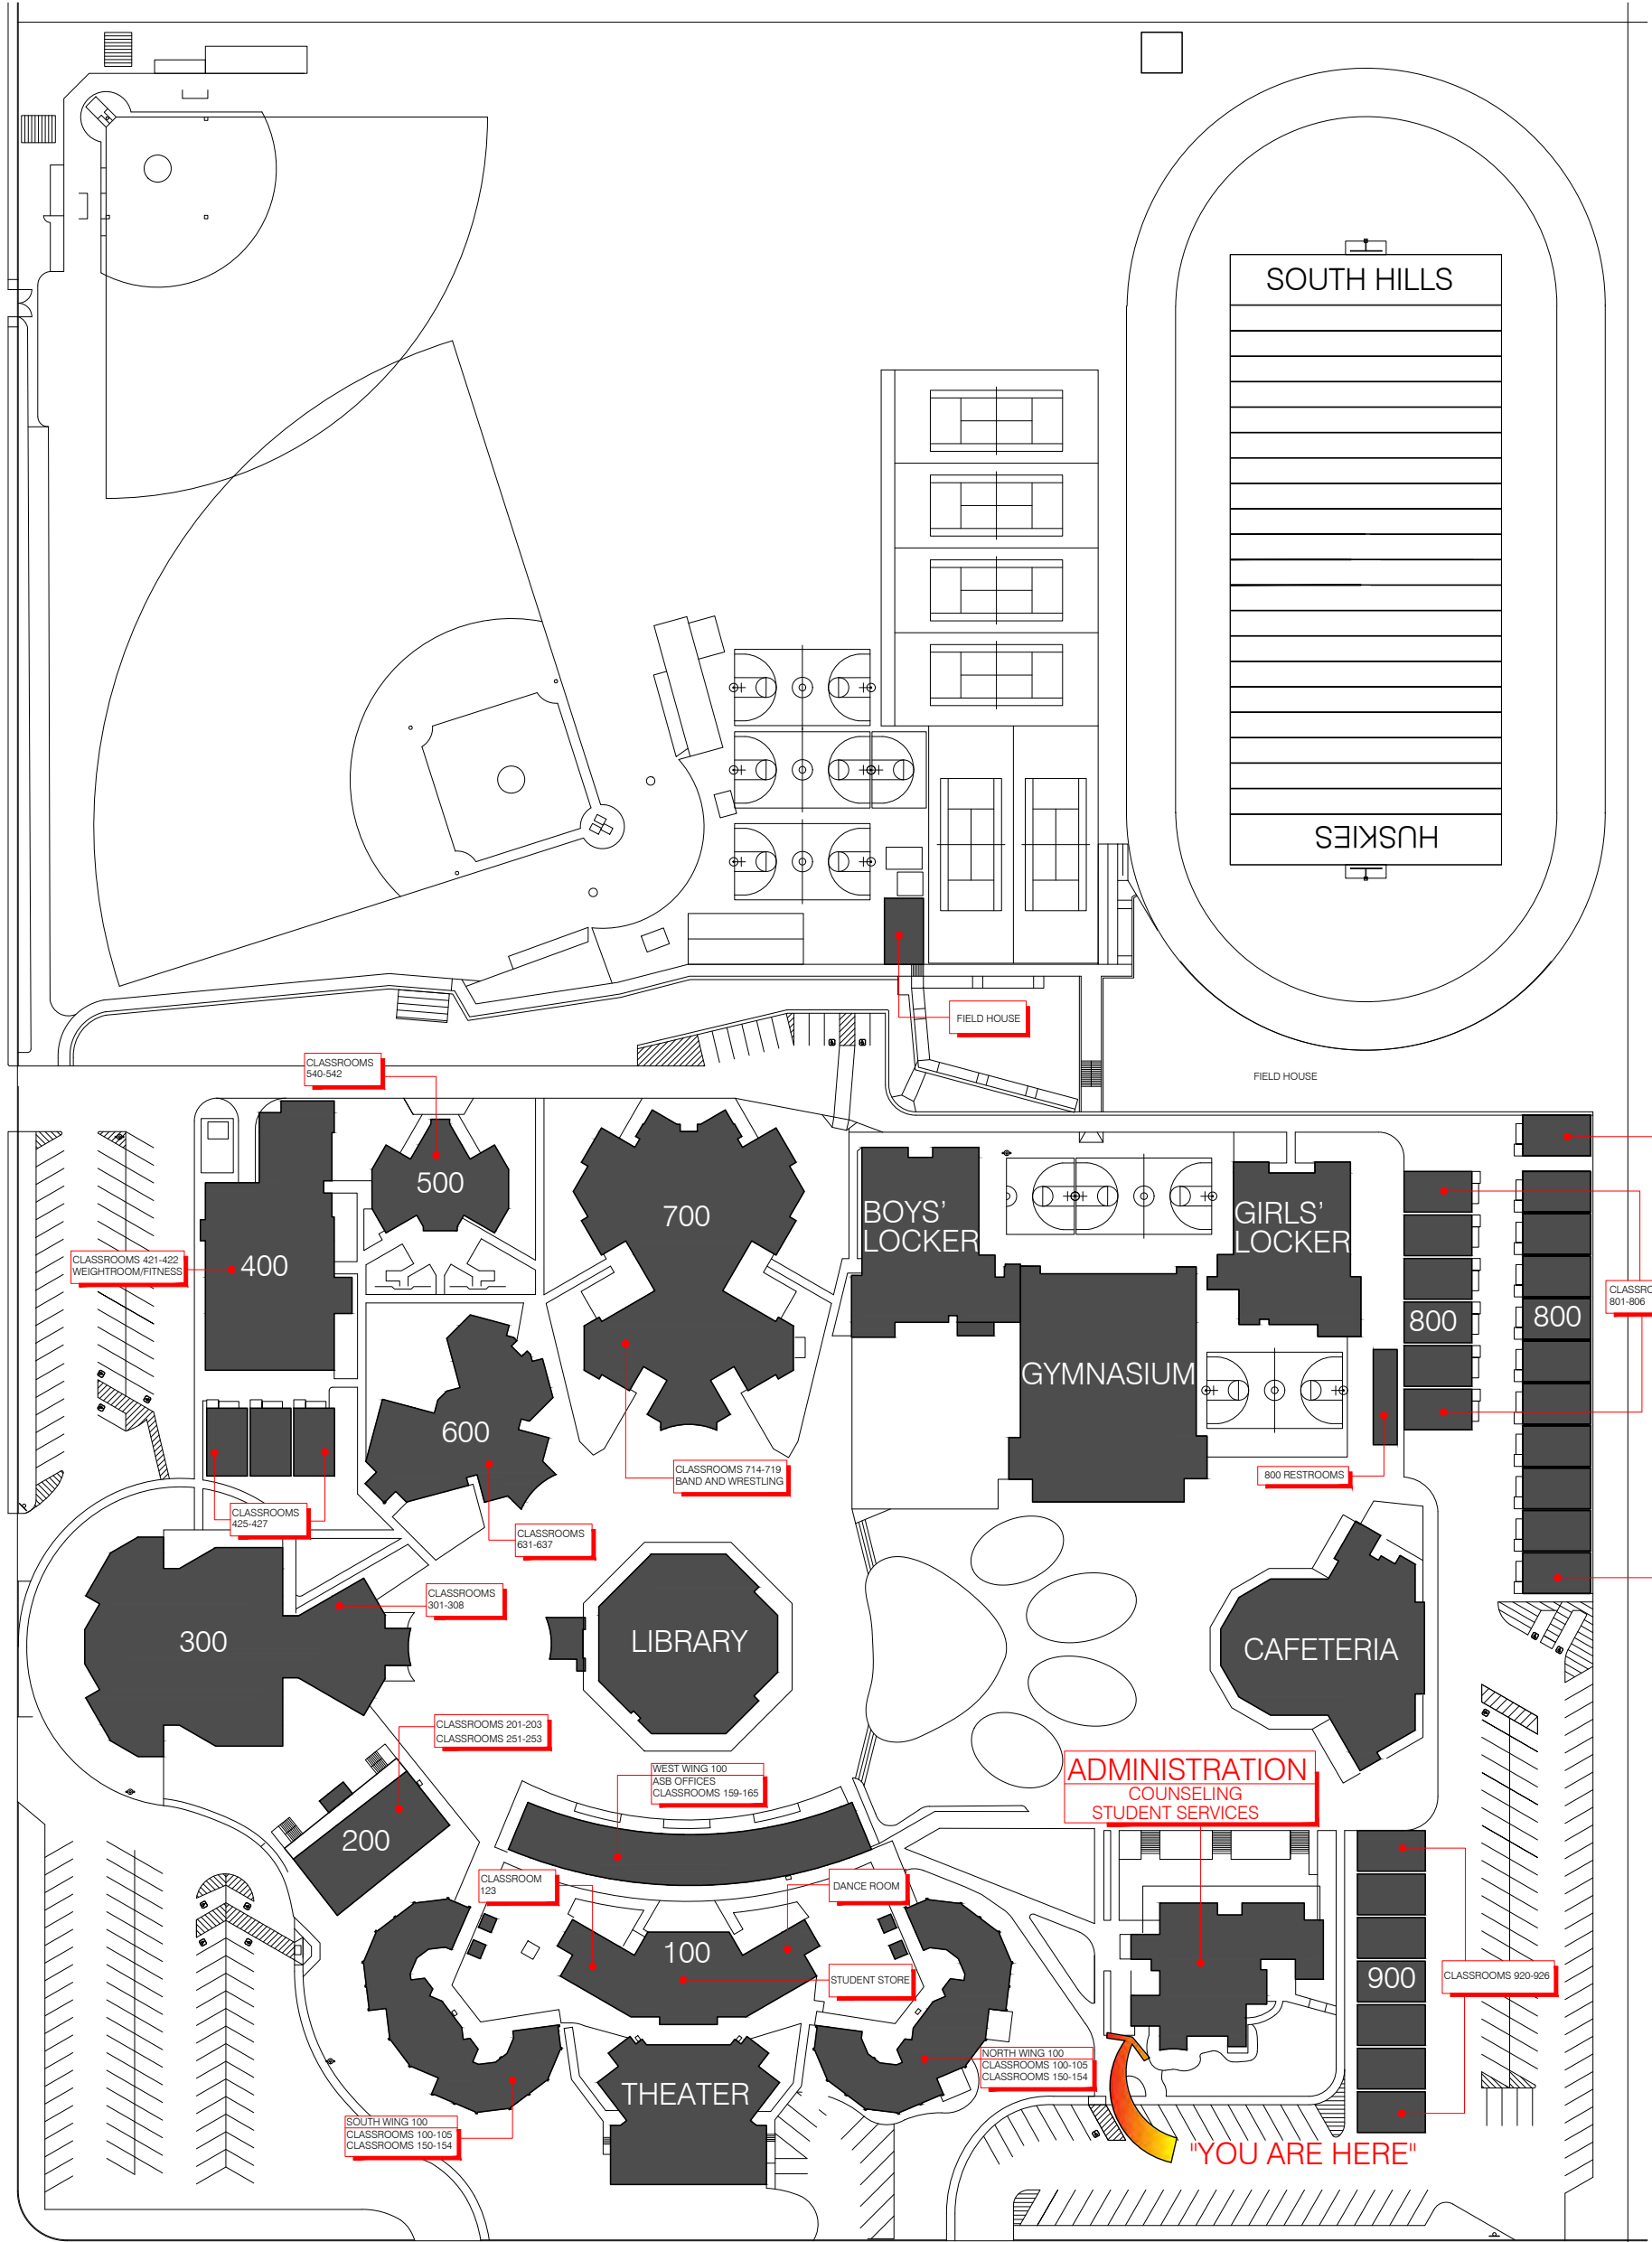


CAMERON AVENUE


BARRANCA ST.




SOUTH HILLS HIGH SCHOOL
 645 S. BARRANCA ST.
 WEST COVINA, CA 91791

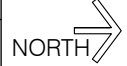

Covina-Valley Trade Tech

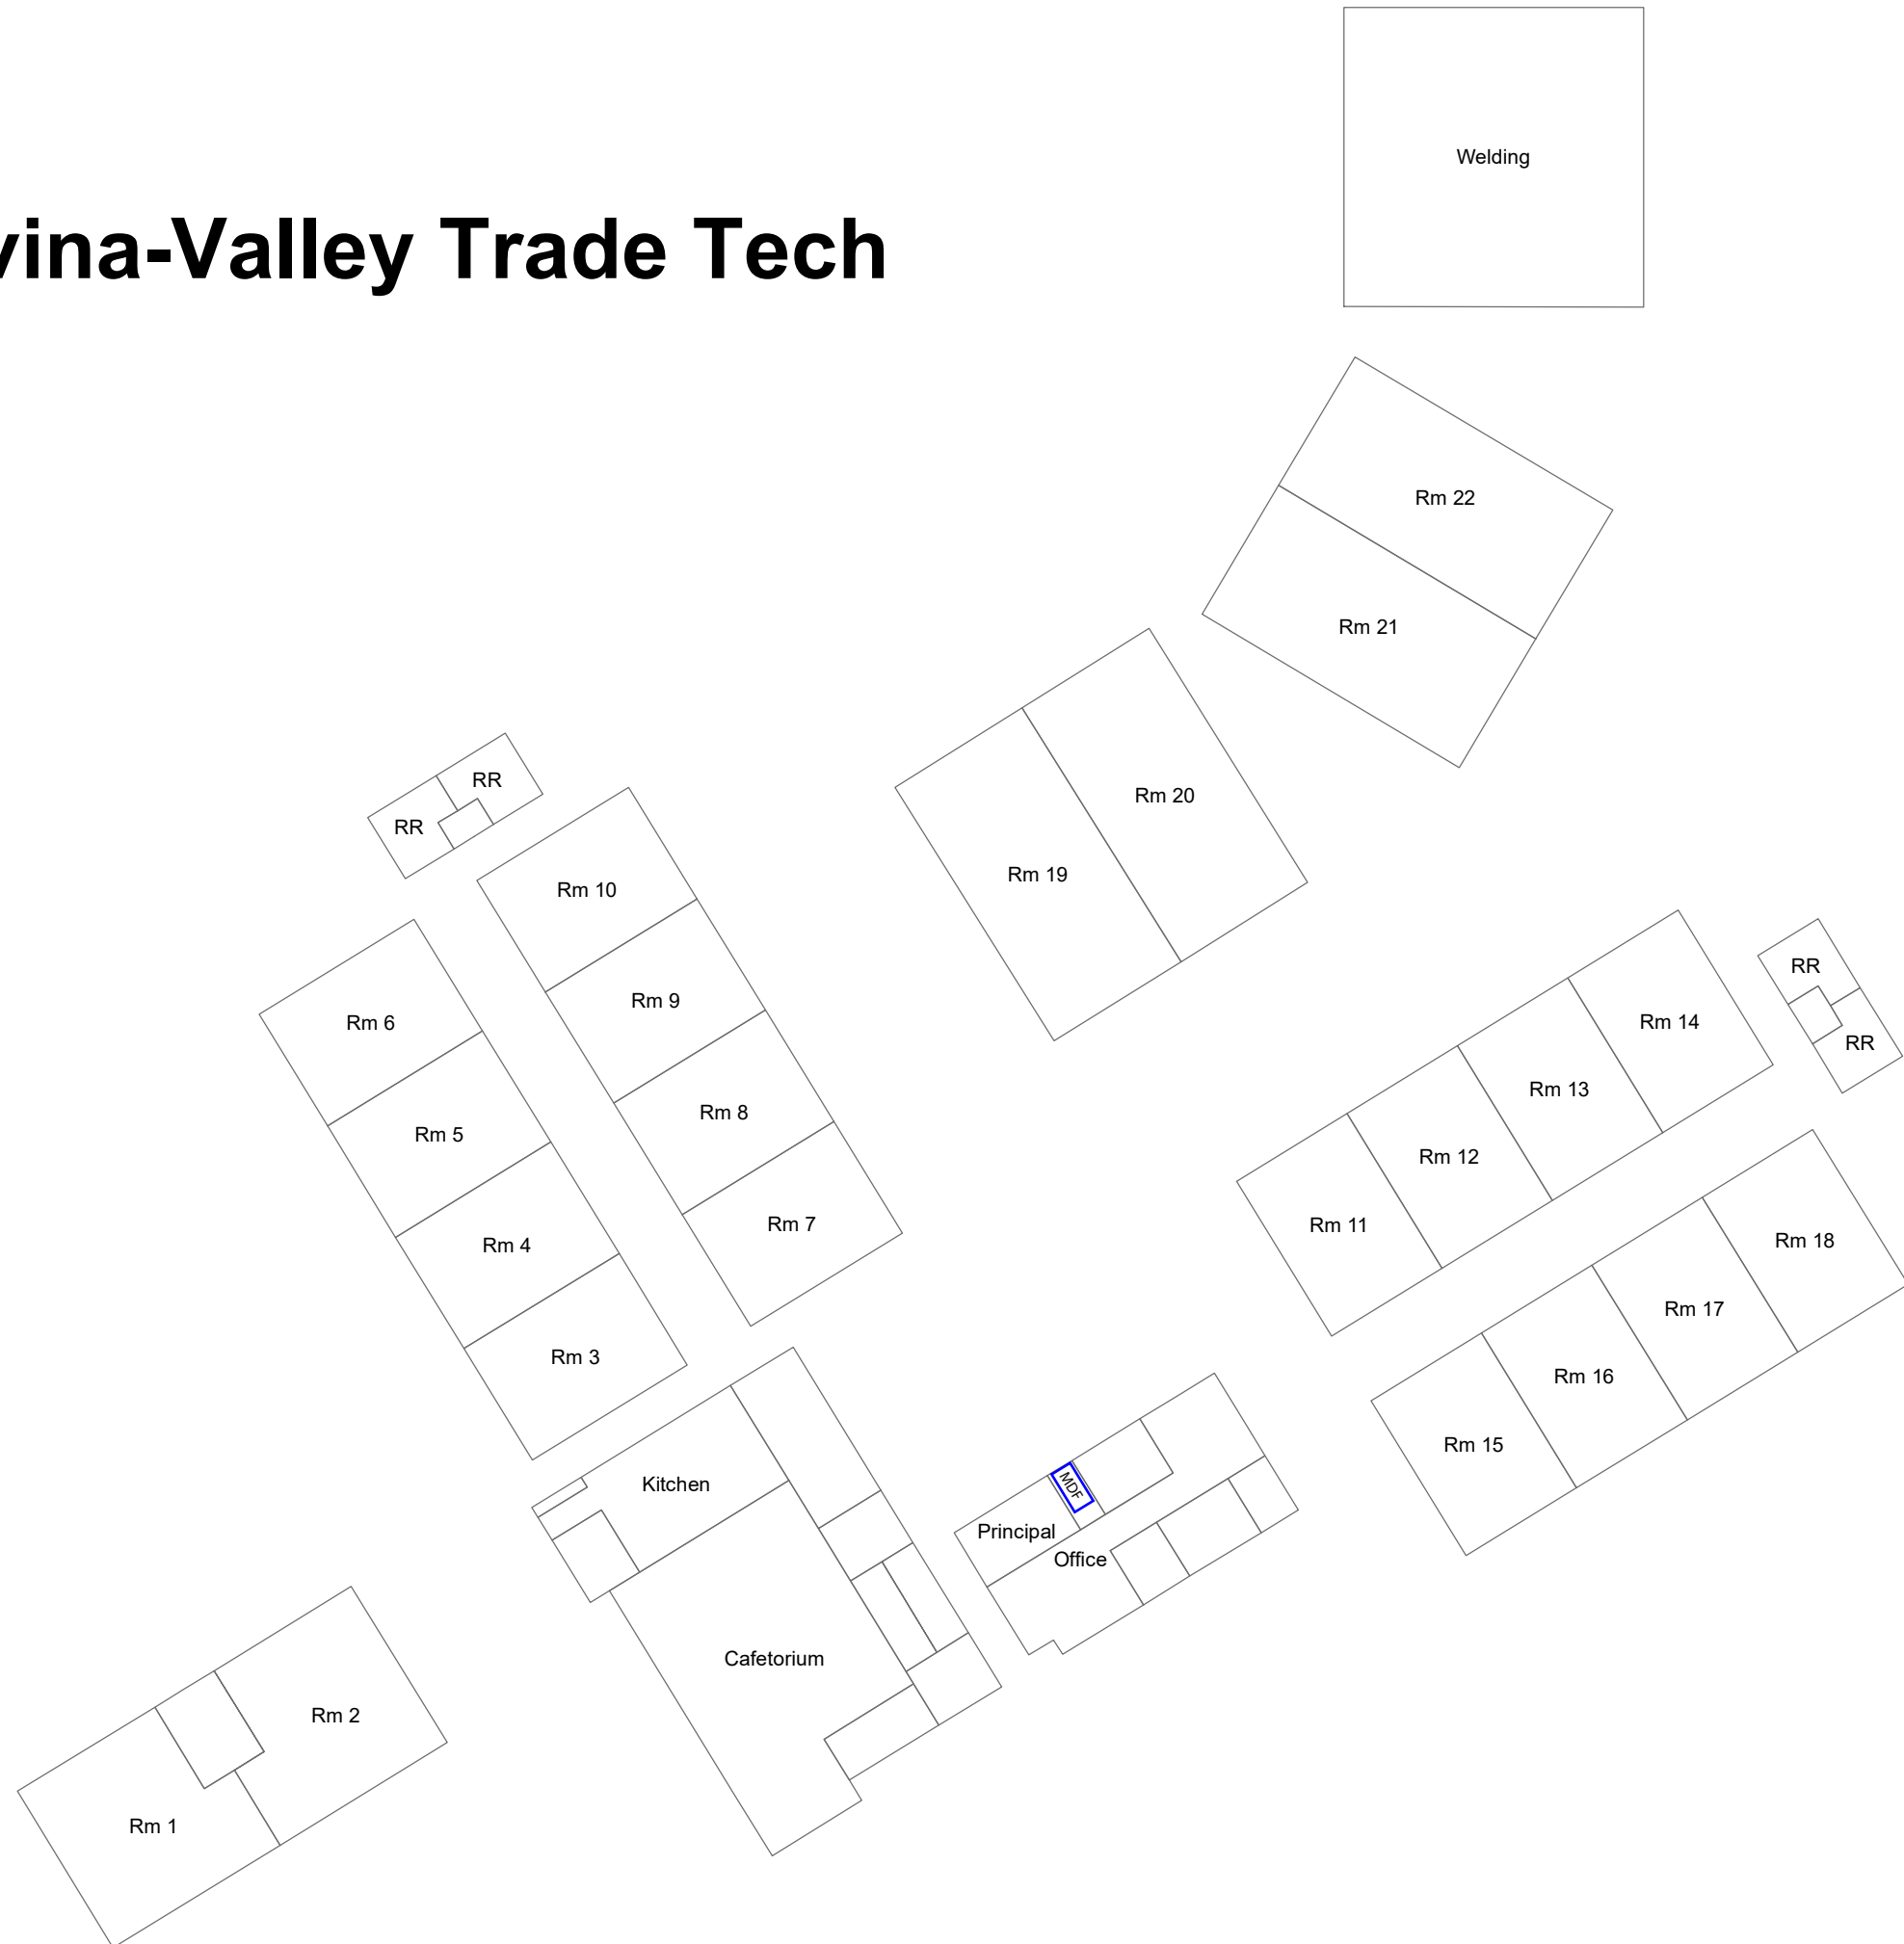

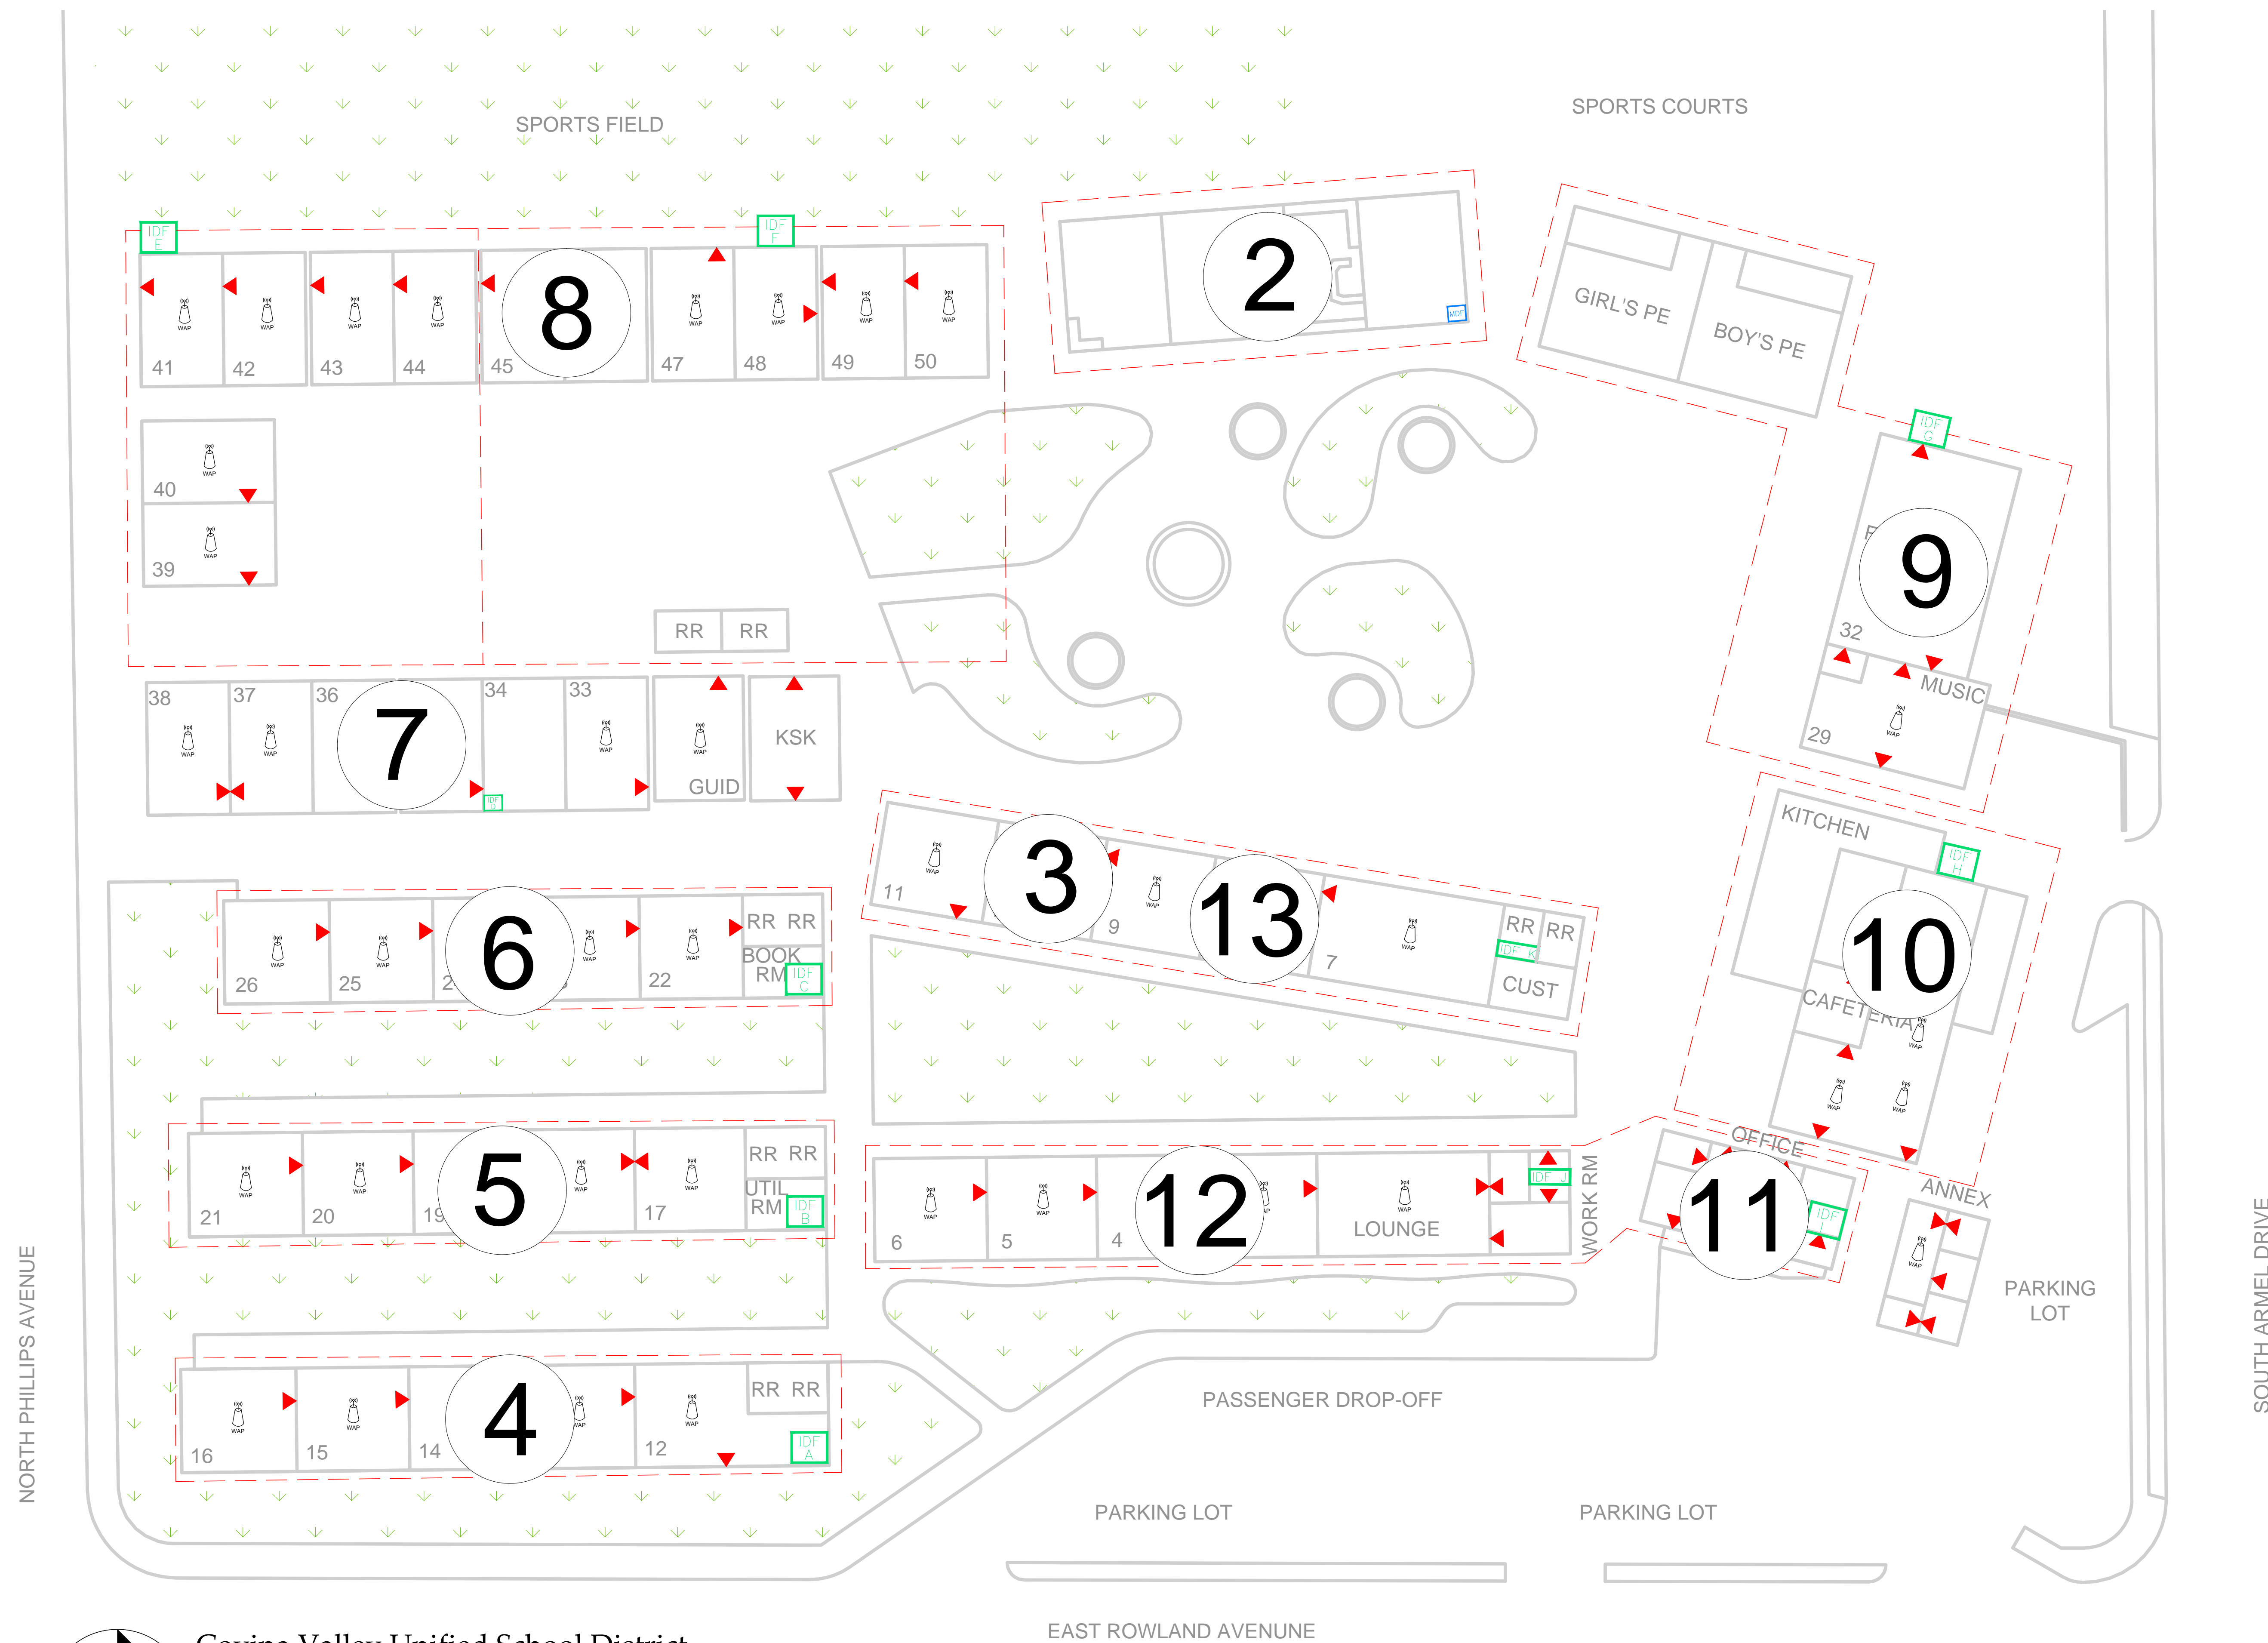

- MDF MAIN DISTRIBUTION FRAME (MDF)
- IDF #XX INTERMEDIATE DISTRIBUTION FRAME (IDF)
- ▶ DATA - WALL DROPS
- CAMERA
- VAULT
- WIRELESS ACCESS POINT
- FIBER BACK BONE PATH


Covina Valley Unified School District
 Telecommunications

Project Name and Address
 Traweek Middle School
 1941 E Rowland Ave
 West Covina, CA 91791

Description
 SITE PLAN
 Date
 March 11, 2017

Drawn By
 R.G.S.

Project
 JOB# xxxxxx
 SHEET#
 1 OF 13

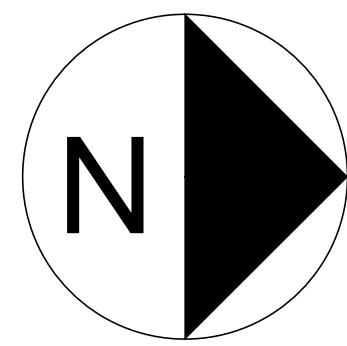












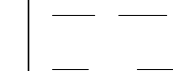
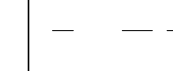









Covina Valley Unified School District
 Traweek Middle School
 Telecommunications As-Builts

SHEET SIZE: 36" x 24"
 SCALE: NOT TO SCALE

SEE SHEET 2 FOR
VICINITY MAP

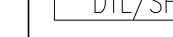SYMBOL LEGEND

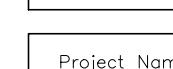	MDF/IDF CABINET
	WALLPHONE
	DATA
	VOICE/DATA
	FIXED CAMERA
	PTZ CAMERA
	WIRELESS CAMERA
	DOME/MINI DOME CAMERA
	DIGITAL VIDEO RECORDER
	SPEAKER CLOCK
	SPEAKER
	WAP
	PROJECTOR
	WIRE CABLE
	UG WIRE CABLE
	FIBER OPTIC CABLE
	UG FIBER OPTIC CABLE
	CONDUIT
	SLEEVE
	ROOF/COVER PROFILE ABOVE
	NAME/ID DENOTES UNIT ID/REFERENCE NAME
	DTL/SHT DENOTES DTL REFERENCE/SHT NO.

Covina Valley Unified School District
Telecommunication

Project Name and Address

Workman Elementary School
 1941 E Workman Ave
 West Covina, CA 91791

Description

SITE PLAN & CAMERA LOCATIONS

Date

October 22, 2017

Drawn By



R.G.S.

Project

JOB# xxxxxx

SHEET#

1 OF 9

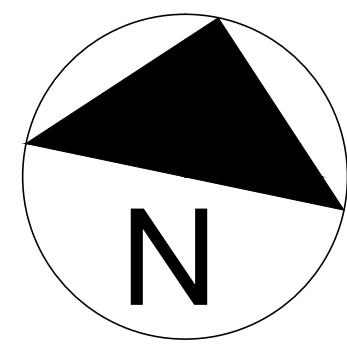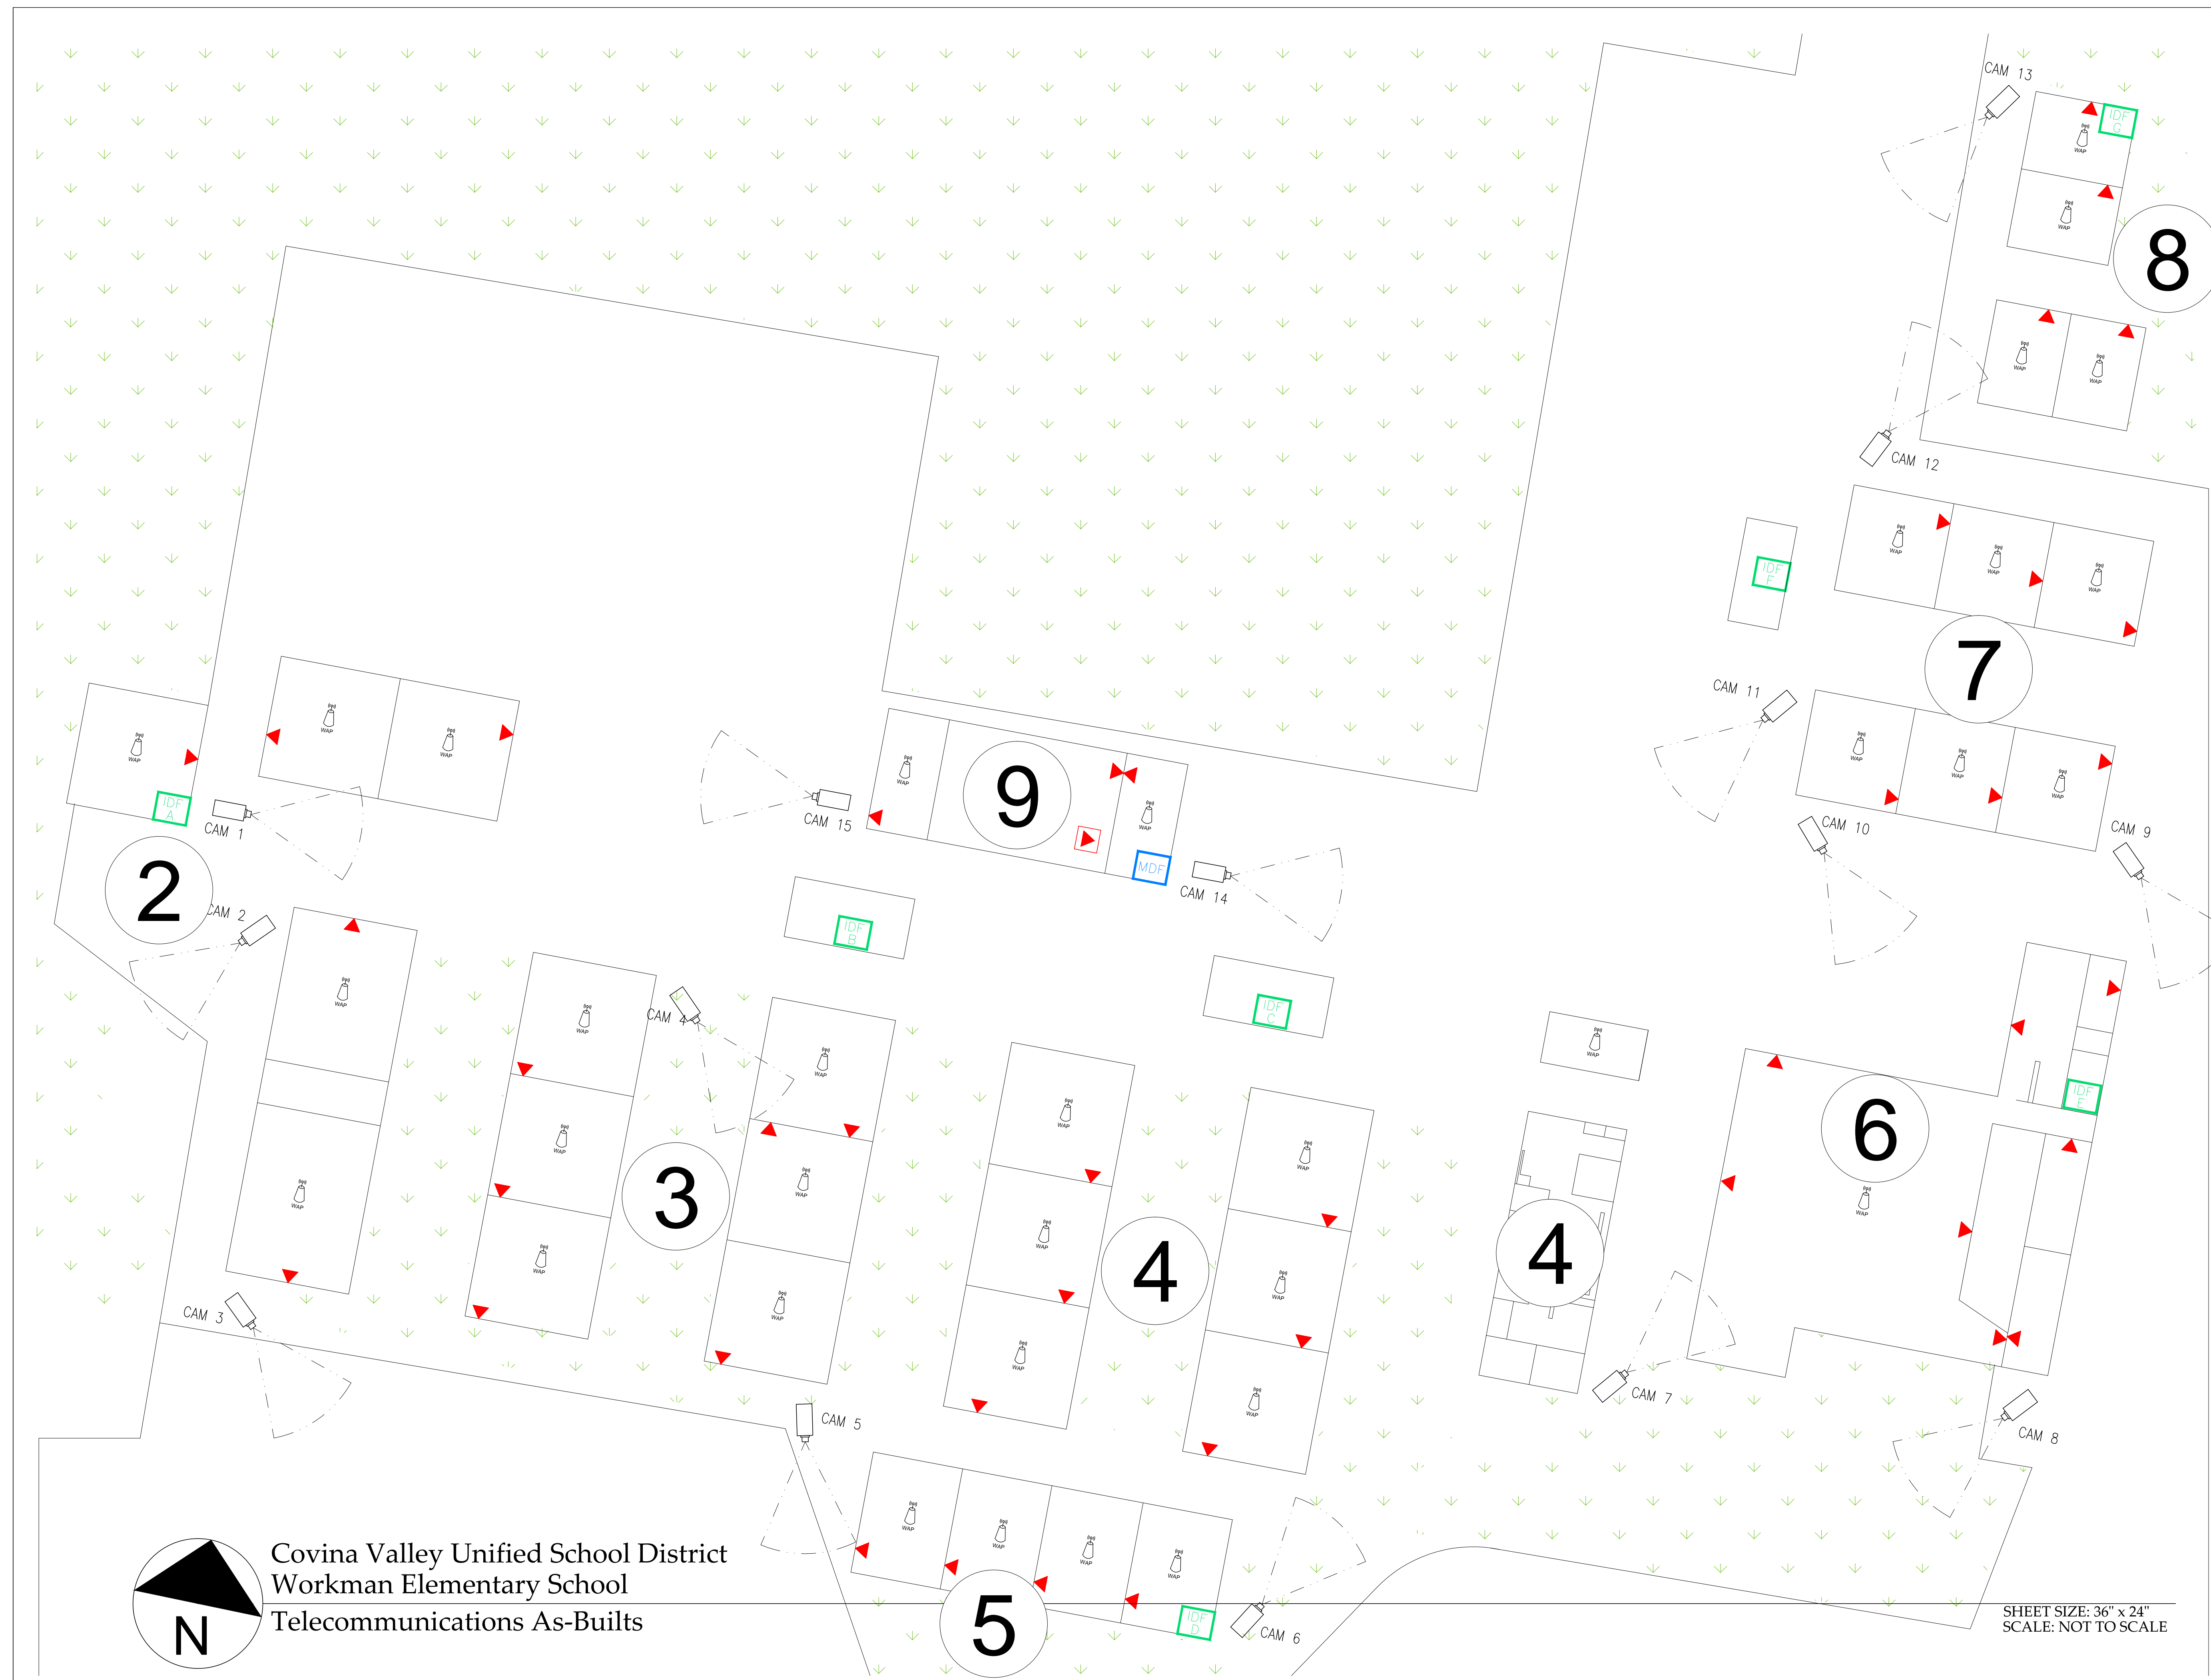

Covina Valley Unified School District
 Workman Elementary School
 Telecommunications As-Builts

SHEET SIZE: 36" x 24"
 SCALE: NOT TO SCALE