

ADDENDUM NUMBER TWO

100% Construction Documents (Dated 11.04.22)

Date: **December 21, 2022**

Project: **Sandia Base Elementary School**

Notice to all Perspective Offerors:

*This **Addendum No.2** becomes a part of the Contract Documents and modifies the original bidding documents dated November 04, 2022. All other provisions of the Contract Documents shall remain unchanged.*

Section 1 – GENERAL

1. The Deadline for Questions has been extended to Wednesday, December 28th, 2022 by 3:00pm MST.
2. Construction Industries Division (CID) Permit Review Fee:
 - a. Please include the initial construction Permit Review Fee of **\$19,480.50** (Nineteen thousand four hundred eighty and fifty cents) in the bid. The actual building permit fee amount will be determined based on the approved construction cost.
3. Approximate Square Footage of Buildings to be demolished:
 - a. The existing one-story mini gym to be demolished is approximately 4,160 Square Feet.
 - b. The existing one-story school building to be demolished is approximately 50,919 Square Feet.
 - c. See Attachments for As-Built Diagrams provided by APS.

Section 2 – QUESTIONS AND ANSWERS

1. On Sheet EL101A, the area 'marked security entry 100' and the wall that shares with the nurses restroom-114D have a light type WL2 that is not in the electrical luminaire schedule. What kind of light is this? Please clarify.
 - a. **RESPONSE: Revised fixture schedule to be provided in Addendum #3.**

2. On Sheet EL101A, in the Elevator Area EV, the light fixture diagram looks like the N3W light fixture on the same page. It does not look like the BV light fixture diagram. Please clarify.
 - a. **RESPONSE: The BV fixture is the correct fixture type.**
3. EL101B: In Stage Area 133A, under note EL24, RGBW led light bar-surface mount chauvet dj6spot. This is not in the electrical luminaire schedule. Please clarify the fixture model number.
 - a. **RESPONSE: Specification per keyed note**
4. EL101B: On the east end of the plan sheet, there are fixtures with WXL. Are these light fixtures that need to be counted? They are not in the electrical luminaire schedule. Please clarify.
 - a. **RESPONSE: Revised fixture schedule to be provided in Addendum #3.**
5. Will there be any restrictions regarding noise or odor during roofing operations, either before or after the new gym becomes occupied per Phasing General Note, Sheet A.103?
 - a. **RESPONSE: Noise and odor should be kept to a minimum during construction. Please review Specification Section 01 3510, paragraph 1.8 Schedule and Hours of Operation and Kirtland AFB requirements for Hazardous Materials. Prior to commencement of the work, the awarded Contractor shall meet with APS and the KAFB Contracting Officer to discuss and develop a mutual understanding relative, but not limited, to safety, noise and air quality, schedule and required KAFB permits.**
6. Burn Permits for Hot Asphalt Work – Will this be the General Contractors' Responsibility or the Roofing Subcontractor's?
 - a. **RESPONSE: The responsibility for Hot asphalt Burn Permits shall be the General Contractor's decision and coordinated with the Fire Marshal.**
7. At Quality Requirements (01 4000) Summary includes Item No. 3 – Mock-ups. Section does not define Mock-up and/or their limitation. Will Mock-ups be required?
 - a. **RESPONSE: Mock-ups are not required. Assemblies will have third-party envelope testing and inspections.**
8. At 07 51 10, 1.05, D. uplift resistance is called to be no less than ninety (90) psf. Plan Page S.003 has calculated uplifts presented. Does 07 51 10, 1.05, D supersede the

work presented on S.003?

- a. **RESPONSE: The wind uplift loads for the roofing material per spec 07 51 10 are different than the roof wind loads shown on S.003. The roof loads shown on S.003 are for the roof structure, including beams, joists, metal deck, etc., and should not be superseded by the wind uplift load provided in spec 07 51 10.**

9. At 07 56 13, 2.3, C. Protection Board 1/2-inch Cement Backer Board Thinset (applied) directly to sloping Concrete Topping Slab. Detail 2 / A.803 shows board on top of Roofing Membrane – Specification would have this board applied under Hot Rubberized Asphalt (HRA) Membrane which would be correct.

If board is to be applied under membrane, it is not necessary as the HRA can be applied directly to the Sloped Concrete Topping Slab. Can the Board be eliminated?

If there is a protection board required above the HRA membrane either an integrally applied protection board (sheet) provided by the HRA Membrane Manufacturer should be utilized or an Insulation Board (Extruded Polystyrene) should be applied. Which application would be appropriate for this install?

- a. **RESPONSE: Please provide an integrally-applied protection board OVER the HRA Membrane.**

10. Roof plan notes and Spec Section 075110 G.2 state that PermaFlash requires a TopGuard base and 2 coats of TopGuard 4000, and that the coatings must be applied a minimum of 90 days after PermaFlash application (General Note 8). Since Perma-Flash cures within 2-3 days:

Is the coating and 90 day time requirement meant for application over plastic cement flashing instead? Can broadcast granules be used immediately over the PermaFlash system to achieve a matching color to the roof field for cost savings?

- a. **RESPONSE: To be provided in next Addendum.**

11. Detail 4 on Sheet A.821 shows an 8" radius joint cover on a 4" expansion joint. Specifications call for an elastomeric joint by InPro. Is this detail intended to be the 671-G02-200 which has a 4" radius and allows for 4" movement horizontal and vertical?

- a. **RESPONSE: Yes, 4 inches of movement horizontal and vertical is required. However, due to the thickness and geometry of the wall that the joint cover sits on, an 8" radius joint cover needs to be used. The model number is 674-G02-200.**

12. Detail 4 / A.803 indicates a “2-Ply Roofing up Sloped Surface” Is this to be the same system as the Base Flashings? Base Flashing vertical rise is less than 24” above the Knee Wall transition to vertical. Will the small insert of EPDM Flashing be required at this detail? At Base Flashing Heights of 24” or less (i.e. 6 / A.803) can the EPDM be eliminated?

a. **RESPONSE: To be provided in next Addendum.**

13. The metal coping at ACM walls (10/A.801) is called out to have a Kynar finish that matches the ACM panels. If the metal coping is to be fabricated from steel sheets and be included in the roofing warranty, the metal finishes will not match unless the coping is a custom color with minimum order quantities. Is the metal coping at ACM walls to be custom color steel installed by the roofer, or a standard steel color selected by architect as a close match? Or should the coping be provided and installed by the ACM subcontractor?

a. **RESPONSE: The metal coping at ACM walls is to be color ‘White’ from standard steel color selections to be included in the roofing warranty. It is the Architect’s intent to have the coping match the white ACM panels as much as possible.**

14. Sealant beads are shown between the kick of the metal coping and the wall finishes. This is not recommended due to the differential movement between the finishes. Is this sealant going to be required, and is it to match the wall finish color or the coping color?

a. **RESPONSE: The sealant beads shown at metal coping conditions are NOT required.**

15. Stair 3 roof structure seems to be sloped east to west, yet roof plan calls for drainage to go from north to south. Does this roof require tapered insulation to counteract the deck slope and discharge to the scupper at the center of the south parapet?

a. **RESPONSE: The roof structure at Stair No.3 roof is to be flat with the slope achieved by tapered insulation sloping north to south as shown on the Roof Plan. A structural clarification drawing will be forthcoming.**

16. Building sections and Spec Section 07 56 13 Fluid Applied Roofing reference a concrete paver system on pedestals, but no section on the pavers (32 14 14) were provided. Can specifications on the required paver system be provided via Addendum?

a. **RESPONSE: Please see Attachments for specifications Section 32 14 14 - Pressed Concrete Pavers.**

17. Storefront sill detail 13/A.832 calls for sill flashing with back and end dams. Is this metal to match the storefront system and be provided by the storefront subcontractor as part of their system?
- a. **RESPONSE: Sill flashing and Parapet Coping colors vary depending on the adjacent materials. See the clarification schedule below. The GC shall determine the subcontractor's scope of work; however, the architect prefers to have the storefront contractor install the window flashing.**
 - b. *Metal Parapet Coping color schedule:*
 - i. *At ACM and Stucco, White Finish.*
 - ii. *At CMU and Translucent Panel, Galvalume Finish.*
 - c. *Storefront sill flashing color schedule:*
 - i. *At ACM, Stucco and Translucent Panel, White Finish.*
 - ii. *At CMU, Dark Bronze Finish (to match storefront)*
18. Specification section 07 41 13, 1.3 H calls for ES-1 tested edge metal (at standing seam metal roof areas). IBC Section 1504.5 states that ES-1 testing is only required at low slope Built Up or membrane roofs. Will this requirement be removed from the project?
- a. **RESPONSE: To be provided in next Addendum.**
19. Specification section 07 41 13, Part 3 calls for 3/4" plywood underlayment where detail 8/A.802 calls for 1/2" plywood. Which thickness of plywood will be required?
- a. **RESPONSE: The plywood underlayment should be 1/2 inch fire-rated.**
20. Specification section 07 41 13, 2.3 calls for MBCI Ultra Dek with a 3" rib as the basis of design. This panel system is a structural panel that does not typically require a solid underlay. Since "Ultra-Dek" profile is only available from MBCI, will other profiles be acceptable or is this to be a closed specification for MBCI? Since a solid underlay is provided, should the system be revised to an architectural panel with a lower rib height?
- a. **RESPONSE: A structural panel is not required for the standing seam roof; the profile should have 1-1/2 inch ribs. Please refer to Changes to the Specifications.**
21. There is a round opening through the roof in the Kinder Court. Section A1/A.351 shows the inner wall with an EIFS finish and an outer wall finish of roof flashing (black EPDM). Since this inner round wall is 12" above the outer parapet, it may be visible from the ground. Should the visible portion of the outer wall also have an EIFS finish to match the building elevations? Is the metal coping on this wall to be segmented, or factory curved? Specifications are not provided on metal coping; can we assume 24 gauge, standard

color options?

- a. **RESPONSE: The round 'oculus' parapet at the Kindergarten Courtyard should be the same height as the adjacent parapet, 18-2", obscured from view. The metal coping may be segmented, 24 gage, with factory standard White Finish.**
22. Sheet SN201, Detail 13, Hallway 100A – East – Decal & Wayfinding Legend horses calls out "9.70" which Keynote reads "Painted Wall Graphic"; however, Sheet A701, Detail 2, ST-1 – Section A calls out "10.14" which Keynote reads "Custom color Vinyl Wall Graphic." Please confirm if fabrication method is to be painted or vinyl graphic.
- a. **RESPONSE: The wall graphics in high-traffic areas are to be Keynote 09.70, "Painted Wall Graphic" per APS preference.**
23. Sheet SN201, Detail 6, 7, and 8 "BOYS", "GIRLS" and "LIBRARY" call out Keynote "9.70" which reads "Painted Wall Graphic"; however, Sheet A431, Details 7 and 3 and Sheet A41, Detail 9 "GIRLS", "BOYS", and "LIBRARY", respectively, call out Keynote 10.14B and 10.14C which reads "Custom Color Vinyl Wall Graphic". Please confirm if fabrication method is to be painted or vinyl graphic.
- a. **RESPONSE: The wall graphics in high-traffic areas are to be Keynote 09.70, "Painted Wall Graphic" per APS preference.**
24. Sheet SN201 Signage & Graphics Details, Detail 1 Cafeteria Vinyl Graphic Sign graphic calls out keynote "9.70" which reads "Painted Wall Graphic" Sheet A405 Detail 7 Cafeteria Sign call out Keynote 10.14 which reads "Custom color vinyl wall graphic". Please confirm if fabrication method is to be painted or vinyl graphic.
- a. **RESPONSE: The wall graphics in high-traffic areas are to be Keynote 09.70, "Painted Wall Graphic" per APS preference.**
25. Is playground equipment salvage by APS?
- a. **RESPONSE: Playground equipment salvage will be by APS On-call Contractor. The General Contractor will be responsible for demolition of the play courts, basketball posts, and dining tables.**
26. AD101/3: Are we to demolish curb and gutter along E. Sandia Cir?
- a. **RESPONSE: The new design is matching grades at the existing E. Sandia Circle so it is possible that some of the existing curb and gutter can remain depending on tie-in transitions and conditions at new driveways and**

sidewalks.

27. Please identify what gas lines are to be abandoned in place and what gas lines will need to be removed.

a. ***RESPONSE: To be provided in next Addendum.***

28. Are all site furnishings NIC?

a. ***RESPONSE: There are several site furnishings that are to be provided by the Contractor unless noted as N.I.C including site benches, waste receptacles, bicycle racks, etc. See specification sections 12 93 00 and 12 93 13 and Sheets AS.101A and AS.101B.***

29. What material should the outdoor basketball courts be constructed with?

a. ***RESPONSE: The outdoor basketball court play surface is to be 3" asphalt per Keynote 8 on Sheet CP.102.***

30. Sheet A.602B indicates CT02 Carpet for 2/3 of the Media Center. The flooring on the Reading Area side is not indicated. Please clarify.

a. ***RESPONSE: The floor finish of the Reading Area within the Media Center is also CT02 Carpet Tile.***

31. Please provide a specification for the Pedestal Paver System located on the balcony of Copy Room 209.

a. ***RESPONSE: Please see Attachments for specifications Section 32 14 14 - Pressed Concrete Pavers.***

32. 1/A.401 Detail shows SS1 counter tops but calls out Keyed Note 09.39 that designates Plastic Laminate tops. Please clarify if countertops are to be Solid Surface or Plastic Laminate.

a. ***RESPONSE: The countertop shown in the Art Room should be Solid Surface. Please revise Keynote 09.39 to be "09.46 Solid Surface Countertop and Backsplash."***

33. Regarding the RFP, please confirm that residential/veteran contractor preference is not applicable.

- a. **RESPONSE: Correct, Veteran Contractor preference is not applicable for this project.**
34. Section 2, B6 there is no reference to digital/electronic copies of the RFP. However, 4B and 4C reference digital copies on flash drive. Are flash drives required?
- a. **RESPONSE: To be provided in next Addendum.**
35. Can the question deadline be pushed closer to the bid date?
- a. **RESPONSE: The Deadline for Questions has been extended to Wednesday December 28th, 2022 by 3:00pm MST.**
36. Does Kirtland have a separate Covid safety protocol?
- a. **RESPONSE: To be provided in next Addendum.**
37. Please confirm if the sub-qualification list is complete. Do any other trades require qualification?
- a. **RESPONSE: The sub-qualification list in the RFP is complete.**

Section 3 – PRIOR APPROVALS (Per Section 01 63 00 Product Substitution Procedures)

1. Section 05 73 00 - Tempered Glass Guardrails
 - a. Product: OPTK in lieu of CRL or GlasPro.
 - b. Manufacturer: HDI Railings
 - c. Submitted by: Shawn Maguire, HDI Railings, 3905 Continental Dr. Columbia PA 17512, (717) 381-0830.
2. Section 07 28 00 – Thermal and Air Barrier Wall System
 - a. Product: ECOMAX ci Wall Solution in lieu of Thermax XArmor
Ecomax ci FR Air Barrier (Board)
LF 2000 (Liquid Flashing)
 - b. Manufacturer: RMax, a Sika Company.
 - c. Submitted by: Ben Herlache, RMax, 210 Lyon Dr. Fernley, NV 89408, (279) 206-1407.
3. Section 08 80 00 - Glazing
 - a. Product - SuperLite II XL 60 in GPX Architectural Series Framing in lieu of FireLite.
 - b. Manufacturer: SAFTI FIRST

- c. Submitted by: Armane Pita, SAFTI FIRST Fire Rated Glazing Solutions, 100 N Hill Drive Suite 12, Brisbane, CA 94005, (888) 653-3333.
 - 4. Section 09 54 34 - Suspended Acoustical Clouds
 - a. Product: USG Ensemble in lieu of Armstrong Acoustibuilt
 - b. Manufacturer: United States Gypsum
 - c. Submitted by: Megan Peters, United States Gypsum Company, 550 West Adams St., Chicago, IL 60661, (904) 252-9013.
 - 5. Section 12 31 30 - Trophy Case
 - a. Product: SDC Series Display Case
 - b. Manufacturer: Nelson Adams NACO
 - c. Submitted by: Melanie Mojica, Nelson Adams NACO, 160 N Cactus Ave. Rialto, CA 92376, (909) 879-0421.
-

Section 4 – CHANGES TO THE PROJECT MANUAL (SPECIFICATIONS)

- 1. Add Section 32 14 14 - Pressed Concrete Pavers. See Attachments.
 - 2. Revise Section 07 41 13, 3.1B to read “1/2 inch layer of fire-rated plywood” in lieu of 3/4 inch.
 - 3. Revise Section 07 41 13, 2.3B and 2.3D as follows:
 - B. Type: Factory roll formed, standing seam with concealed clip attachment and mechanically joined with double lock at 180 degrees; Una-Clad UC-3 as manufactured by Firestone Building Products.
 - D. Profile: 1-1/2 inch high rib each side panel and 20 inch wide, smooth surface.
-

Section 5 – CHANGES TO THE DRAWINGS

ARCHITECTURAL DRAWINGS

- 1. Sheet A.431 ENLARGED RESTROOMS + ELEVATIONS
 - a. Detail 3: Change Keynote 10.14C to “09.70 Painted Wall Graphic”.
 - b. Detail 7: Change Keynote 10.14B to “09.70 Painted Wall Graphic”.
- 2. Sheet A.432 ENLARGED RESTROOMS + ELEVATIONS
 - a. Detail 1: Change Keynote 10.14B to “09.70 Painted Wall Graphic”
- 3. Sheet A3.51 WALL SECTIONS

- a. Detail 1: Change height of round 'oculus' parapet to 18'-2".
4. Sheet A8.01 EXTERIOR DETAILS
 - a. Details 5 & 10: Remove sealant from typical metal coping conditions

MECHANICAL DRAWINGS

1. Sheet MH.101A – HVAC LEVEL 1 FLOOR PLAN – AREA A
 1. **ADD** sound attenuator, SA-1, to DOAS-1 supply duct.
 2. **MODIFY** outside air cfm for 125 Teacher's Workroom.
 3. **MODIFY** transfer air duct size in 114 Nurse.
 4. **ADD** transfer air duct to 300 Hallway.
 5. **REMOVE** keynote 2.
 6. **MODIFY** exhaust duct size and routing in 125 Teacher Workroom.
 7. **MODIFY** exhaust duct sizes and cfm values in Nurse's Suite.
2. Sheet MH.101B – HVAC LEVEL 1 FLOOR PLAN – AREA B
 1. **ADD** sound attenuator, SA-2, to FC3-04 supply duct.
 2. **ADD** sound attenuator, SA-3, to FC3-05 supply duct.
 3. **MODIFY** duct sizes and cfm values for FC7-07.
 4. **MODIFY** cfm values for FC7-08.
 5. **MODIFY** cfm in 100A Hallway.
 6. **ADD** return grille to 142 Family RR, 100B Hallway.
 7. **ADD** transfer duct to 141 Unisex.
 8. **MODIFY** duct sizes and cfm values for RTU-3.
 9. **ADD** duct sizes to kitchen hood make-up air duct.
 10. **ADD** keyed note 21 to cooler/freezer condensing units.
 11. **ADD** keyed note 22 to exposed rectangular duct in 129 STEAM.
 12. **ADD** keyed note 21 and 22.
 13. **ADD** sound attenuator, SA-7, to RTU-4 supply duct
 14. **REROUTE** supply duct to 133D Chair.
3. Sheet MH.102A – HVAC LEVEL 2 FLOOR PLAN – AREA A
 1. **ADD** sound attenuator, SA-4, to FC5-01 supply duct.
 2. **MODIFY** outside air cfm for 209 Copy Room.
 3. **MODIFY** exhaust duct sizes.
4. Sheet MH.102B – HVAC LEVEL 2 FLOOR PLAN – AREA B
 1. **ADD** sound attenuator, SA-8, to DOAS-2 exhaust duct.
 2. **RELOCATE** thermostat for FC5-06.
 3. **ADD** duct sizes in 212 Media Center.
 4. **MODIFY** duct size and cfm values for FC5-07.
 5. **MODIFY** cfm values for FC9-10.
 6. **ADD** keyed note 7.

7. **MODIFY** cfm value in Breakout 238, 200A Hallway.
 8. **ADD** sound attenuator, SA-6, to DOAS-4 supply drop in chase.
 9. **MODIFY** exhaust duct from 212C Workroom and 209 Copy Room.
 10. **ADD** transfer duct and grille from 212 Media Center to 240 Girls.
 11. **REROUTE** outside air duct to 212A Office.
 12. **ADD** transfer duct in 212C Workroom and 212A Office.
5. Sheet MH.102C – HVAC LEVEL 2 FLOOR PLAN – AREA C
 1. **ADD** sound attenuator, SA-5, to DOAS-5 supply duct drop.
 2. **MODIFY** cfm value in Hallway 200B.
 3. **ADD** keyed note 4.
 4. **ADD** exhaust duct and balancing damper to Hallway 200B.
 6. Sheet M-502 – MECHANICAL DETAILS
 1. **ADD** Drum Punkah Louver Connection Detail, A4/M-502.
 7. Sheet M-701 – MECHANICAL SCHEDULES
 1. **ADD** Sound Attenuator Schedule
 2. **MODIFY** Area Served for AC-11, and RTU-3.
 3. **MODIFY** Dedicated Outside Air Units Schedule for DOAS-5.
 8. Sheet M-702 – MECHANICAL SCHEDULES
 1. **MODIFY** Exhaust Fan Schedule for EF-3.
 2. **MODIFY** Area Served for CEF-1.
 9. Sheet M-801 – MECHANICAL SCHEDULES
 1. **MODIFY** IAQ Calculations
-

List of Attachments:

1. Sheet MH.101A, MH.101B, MH-102A, MH.102B, MH.102C, M-502, M-701, M-702, M-801.
2. Specification Section 32 14 14 - Pressed Concrete Pavers.
3. As-Built Floor Plan Diagrams.

Note: Questions that have been submitted or approved Substitution Requests not yet addressed in this Addendum No.2 will be issued in the forthcoming Addendum.


ATTACHMENTS

GENERAL NOTES:

- COORDINATE DUCT ROUTING AND EQUIPMENT INSTALLATION WITH STRUCTURAL PLANS, ARCHITECTURAL PLANS AND ELECTRICAL PLANS. GIVE SPECIAL ATTENTION TO STRUCTURAL BEAM ELEVATIONS, CEILING HEIGHTS, CABLE TRAYS, AND ROOF DRAIN LEADERS. SUBMIT 3D COORDINATION DRAWINGS FOR REVIEW PER SPECIFICATIONS 23 0500.
- ALL DUCT SIZES SHOWN ON THE DRAWING ARE NET INSIDE DIMENSIONS. SEE SPECIFICATION 230700 FOR REQUIREMENTS.
- PROVIDE 1" ACOUSTICAL LINING IN ALL RECTANGULAR SUPPLY AND RETURN DUCTWORK FOR ALL VRF FAN COIL UNITS AND RTUS, AND ALL OUTSIDE AIR AND EXHAUST AIR DUCTWORK FOR ALL DOAS UNITS.
- COORDINATE WITH ARCHITECTURAL REFLECTED CEILING PLAN FOR EXACT LOCATION OF GRILLES AND DIFFUSERS.
- SEE DETAIL D2M-501 FOR LOW VELOCITY FITTING DETAILS.
- SEE DETAILS C3M-501 FOR DIFFUSER AND REGISTER CONNECTIONS. PROVIDE MANUAL BALANCING DAMPERS FOR EACH CONNECTION.
- SEE DETAIL B4M-502 FOR SIDEWALL LINEAR SLOT INSTALLATION.
- SEE DETAIL B1M-501 FOR DUCT MOUNTED LINEAR SLOT INSTALLATION.
- SEE DETAIL C2M-501 FOR EXHAUST REGISTER CONNECTION.
- MOUNT TEMPERATURE SENSORS PER SPECIFICATION.
- THERMOSTATS LOCATED IN COMMON AREAS TO BE PROVIDED WITH METAL COVER AND LOCK.
- PROVIDE SOUND TEE FOR ALL CEILING RETURN AIR GRILLES PER DETAIL A3M-501.
- INSTALL TRANSFER AIR DUCTS AND TRANSFER AIR OPENINGS ABOVE CEILING LEVEL. SIZE AS SHOWN ON PLANS. SEE DETAIL B4M-501.
- ALL EQUIPMENT, DUCTWORK, PIPING, CONDUIT, ETC. IN EXPOSED CEILING AREAS ARE TO BE PAINTED PER ARCHITECTURAL FINISH SCHEDULE.
- USE TURNING VANES IN ALL RECTANGULAR TEES AND MITERED ELBOWS.
- ALL EXPOSED ROUND DUCT SHALL BE SPIRAL CONSTRUCTION.
- INSTALL FAN COILS PER DETAIL C1M-501.
- REFER TO SHEETS M-501 THROUGH M-502 FOR MECHANICAL DETAILS.

KEYNOTES

- INDOOR AIR CONDITIONING UNIT MOUNTED ABOVE ROOM.
- NOT USED.
- OUTSIDE AIR DUCT AND EXHAUST DUCT, OF SIZE INDICATED, UP THROUGH ROOF TO ENERGY RECOVERY UNIT.
- ELECTRIC UNIT HEATER PER EQUIPMENT SCHEDULE. MOUNT BOTTOM OF UNIT 8" A.F.F. MAINTAIN ALL MANUFACTURER'S REQUIRED CLEARANCES.
- OUTSIDE AIR DUCT AND EXHAUST DUCT, OF SIZE INDICATED, UP IN CHASE TO LEVEL ABOVE. SEE HVAC LEVEL 2 FLOOR PLAN - AREA A, SHEET MH-102A, FOR CONTINUATION.
- INSTALL FAN COIL WITH VIBRATION ISOLATORS SIMILAR TO MASON INDUSTRIES ISOLATION HANGERS.
- INSTALL MANUAL BALANCING DAMPER SYSTEM BY METROPOLITAN AIR TECHNOLOGY: DAMPER (RT-200RT-250) WITH UNIVERSAL DAMPER DRIVE (RT-WGA) AND MINIATURE ROUND CEILING CLIP (RT-COM). PROVIDE AND INSTALL 24V MOTORIZED DAMPER. INTERLOCK WITH EF-3.

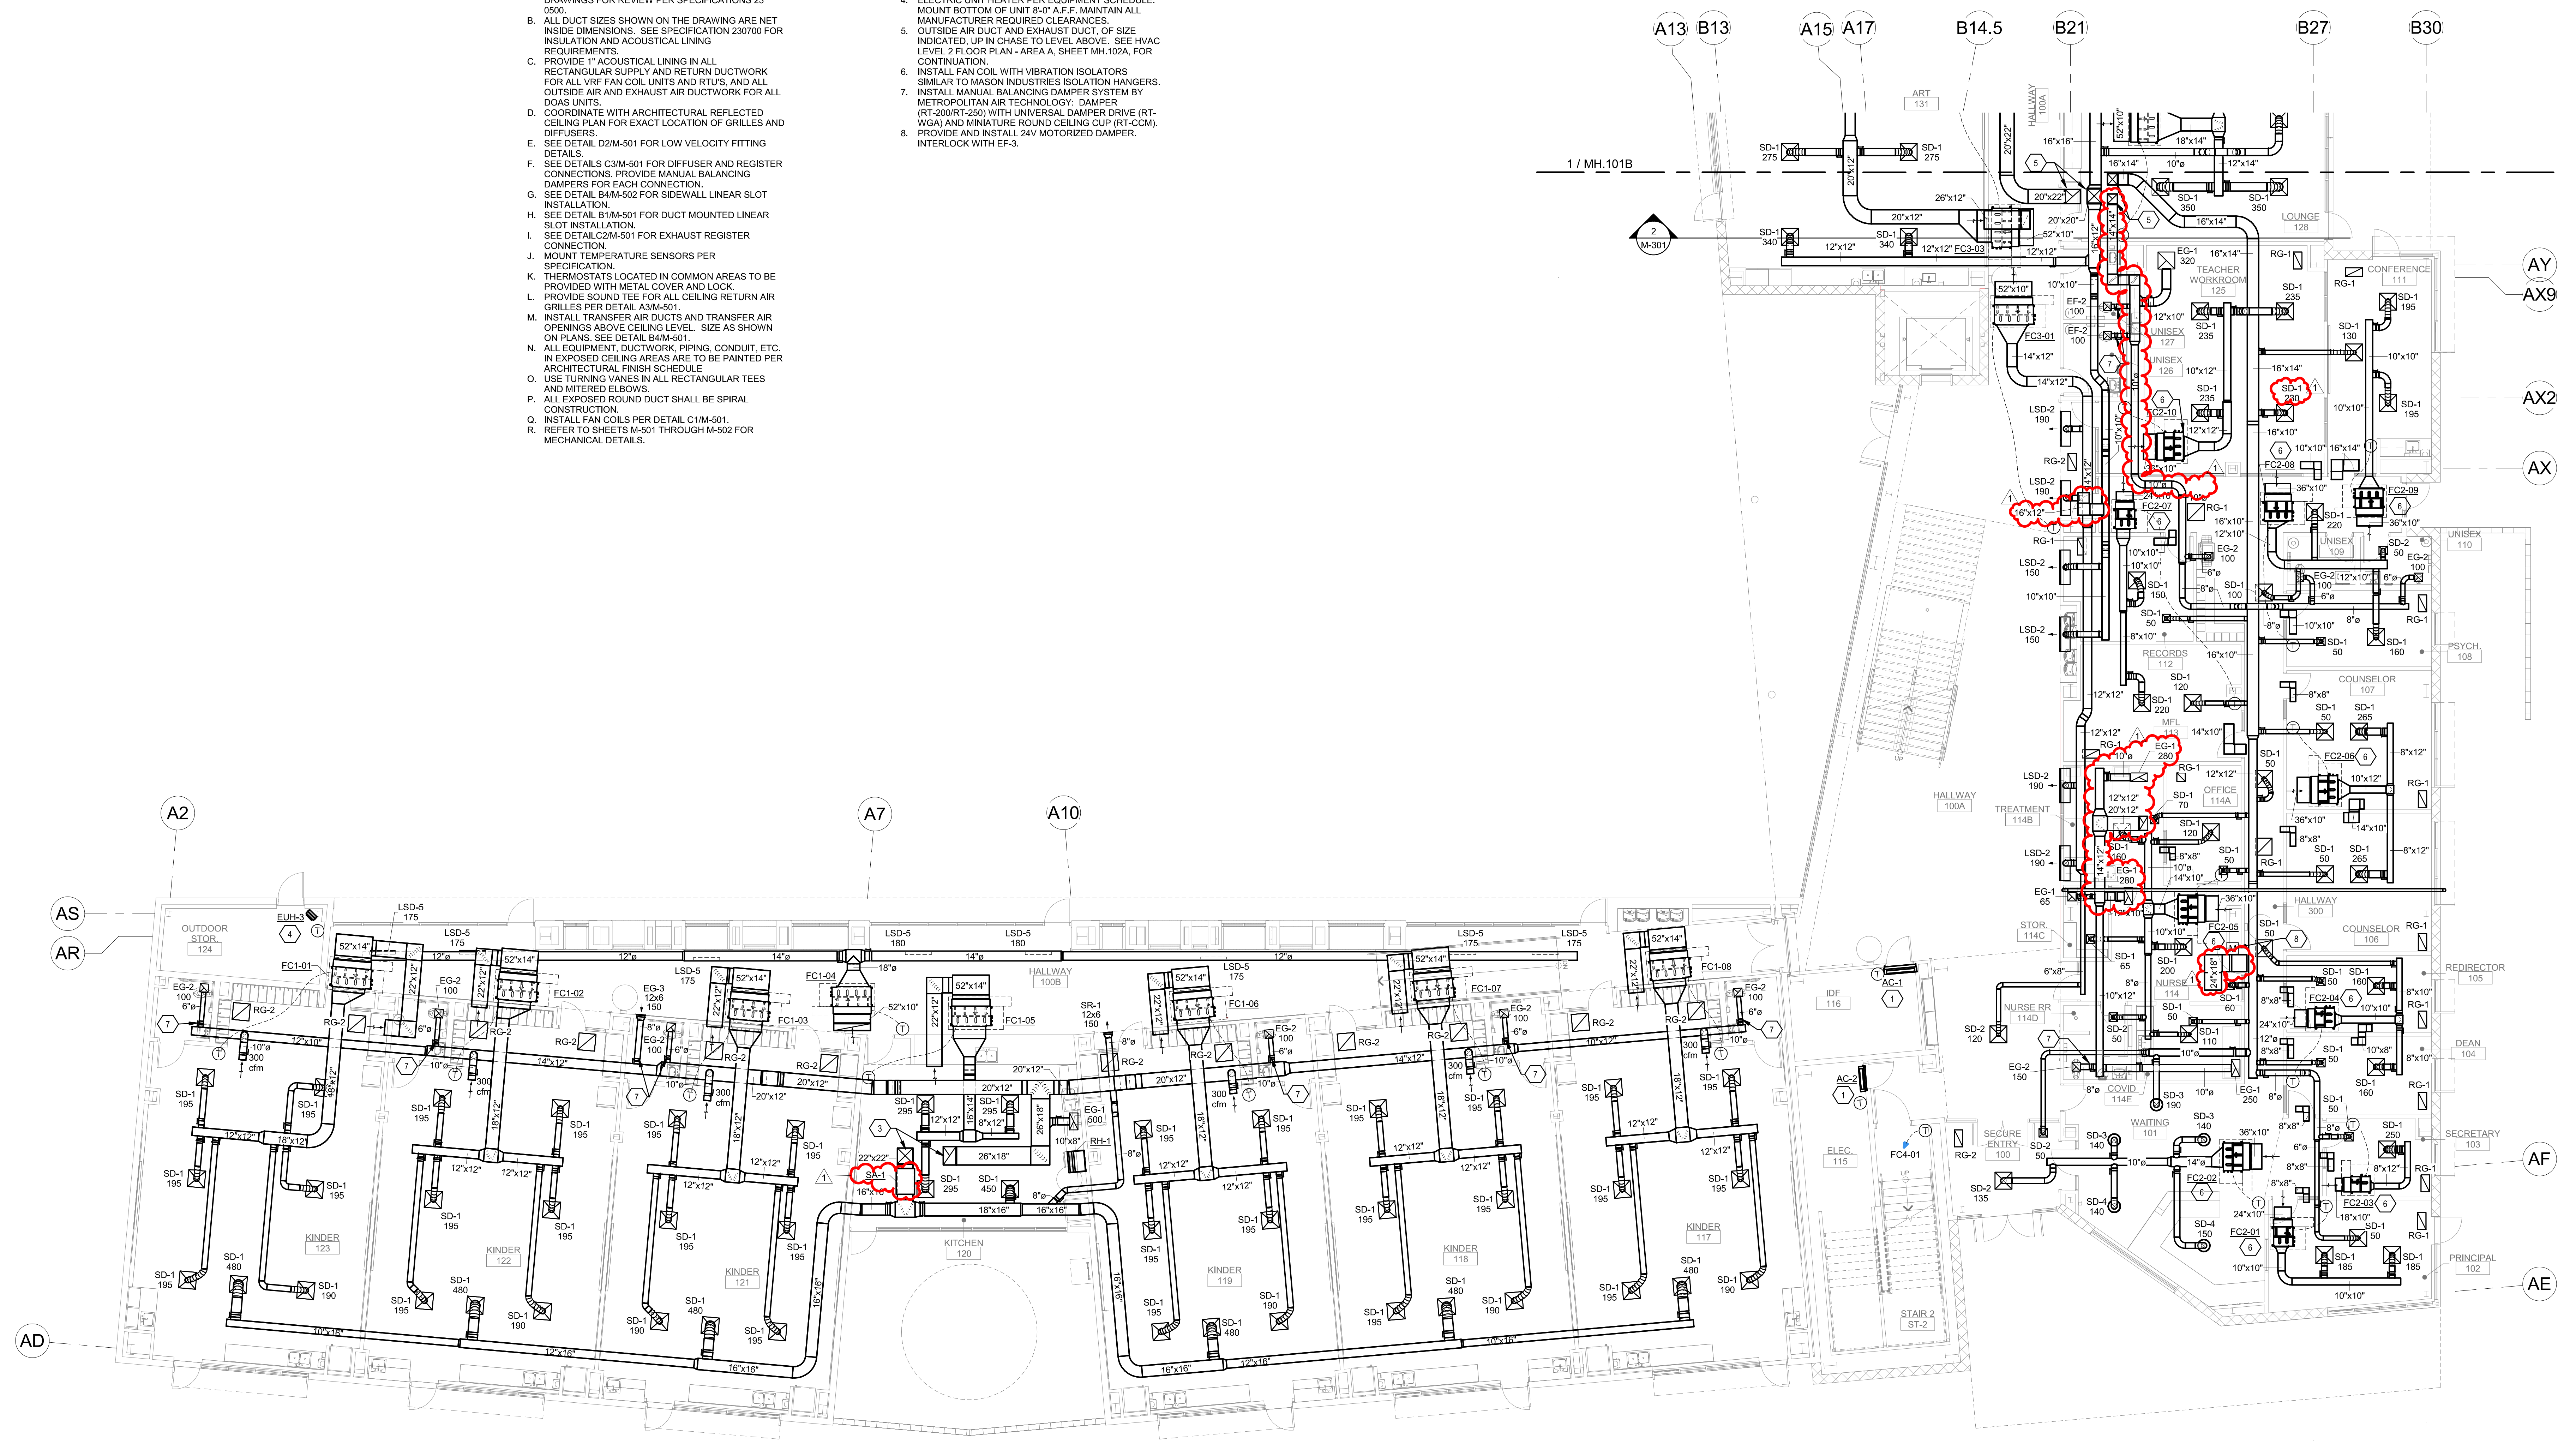

12/19/2022 1:27:51 PM D:\Revit\2022\Projects\6331_SBES_MEP_Imagery\6331_SBS_MEP.dwg
 12/19/2022 1:27:51 PM
 Bridgers & Paxton Project No. 8331


GENERAL NOTES:

- A. COORDINATE DUCT ROUTING AND EQUIPMENT INSTALLATION WITH STRUCTURAL PLANS, ARCHITECTURAL PLANS AND ELECTRICAL PLANS. GIVE SPECIAL ATTENTION TO STRUCTURAL BEAM ELEVATIONS, CEILING HEIGHTS, CABLE TRAYS, AND ROOF DRAIN LEADERS. SUBMIT 3D COORDINATION DRAWINGS FOR REVIEW PER SPECIFICATIONS 23 0500.
- B. ALL DUCT SIZES SHOWN ON THE DRAWING ARE NET INSIDE DIMENSIONS. SEE SPECIFICATION 230700 FOR INSULATION AND ACOUSTICAL LINING REQUIREMENTS.
- C. PROVIDE 1" ACOUSTICAL LINING IN ALL RECTANGULAR SUPPLY AND RETURN DUCTWORK FOR ALL VRF FAN COIL UNITS AND RTU'S, AND ALL OUTSIDE AIR AND EXHAUST AIR DUCTWORK FOR ALL DOAS UNITS.
- D. COORDINATE WITH ARCHITECTURAL REFLECTED CEILING PLAN FOR EXACT LOCATION OF GRILLES AND DIFFUSERS.
- E. SEE DETAIL D2/M-501 FOR LOW VELOCITY FITTING DETAILS.
- F. SEE DETAILS C3/M-501 FOR DIFFUSER AND REGISTER CONNECTIONS. PROVIDE MANUAL BALANCING DAMPERS FOR EACH CONNECTION.
- G. SEE DETAIL B4/M-502 FOR SIEB-WALL LINEAR SLOT INSTALLATION.
- H. SEE DETAIL B1/M-501 FOR DUCT MOUNTED LINEAR SLOT INSTALLATION.
- I. SEE DETAIL C2/M-501 FOR EXHAUST REGISTER CONNECTION.
- J. MOUNT TEMPERATURE SENSORS PER SPECIFICATION.
- K. THERMOSTATS LOCATED IN COMMON AREAS TO BE PROVIDED WITH METAL COVER AND LOCK. PROVIDE SOUND TEE FOR ALL CEILING RETURN AIR GRILLES PER DETAIL A3/M-501.
- M. INSTALL TRANSFER AIR DUCTS AND TRANSFER AIR OPENINGS ABOVE CEILING LEVEL. SIZE AS SHOWN ON PLANS. SEE DETAIL B4/M-501.
- N. ALL EQUIPMENT, DUCTWORK, PIPING, CONDUIT, ETC. IN EXPOSED CEILING AREAS ARE TO BE PAINTED PER ARCHITECTURAL FINISH SCHEDULE.
- O. USE TURNING VANES IN ALL RECTANGULAR TEES AND MITERED ELBOWS.
- P. ALL EXPOSED ROUND DUCT SHALL BE SPIRAL CONSTRUCTION.
- Q. INSTALL FAN COILS PER DETAIL C1/M-501.
- R. REFER TO SHEETS M-501 THROUGH M-502 FOR MECHANICAL DETAILS.



KEYNOTES

1. INDOOR AIR CONDITIONING UNIT MOUNTED ABOVE DOOR. COORDINATE LOCATION WITH ARCHITECT.
2. SUPPLY AND RETURN AIR DUCT. OF SIZE INDICATED. UP THROUGH ROOF TO ROOFTOP UNIT. SEE MECHANICAL ROOF PLAN, SHEET MH.103, FOR CONTINUATION.
3. WATER HEATER 4" STAINLESS STEEL DOUBLE-WALLED CATEGORY IV VENT PIPING AND 4" GALVANIZED STEEL COMBUSTION AIR PIPING UP THROUGH ROOF. ALL JOINTS AND SEAMS MUST BE SEALED GAS TIGHT. INSTALL PER MANUFACTURER'S INSTALLATION MANUAL.
4. OUTSIDE AIR DUCT. OF SIZE INDICATED. UP IN CHASE TO FLOOR ABOVE. SEE SECOND FLOOR HVAC PLAN, SHEET MH.102B, FOR CONTINUATION.
5. EXHAUST AIR DUCT. OF SIZE INDICATED. UP IN CHASE TO FLOOR ABOVE. SEE SECOND FLOOR HVAC PLAN, SHEET MH.102B, FOR CONTINUATION.
6. MAKE-UP AIR DUCT UP THROUGH ROOF TO MAKE-UP AIR UNIT. DO NOT ACOUSTICALLY LINE. SEE MECHANICAL ROOF PLAN, SHEET MH.103, FOR CONTINUATION.
7. 18"X18" GREASE EXHAUST DUCT UP THROUGH ROOF TO KITCHEN EXHAUST FAN. SEE MECHANICAL ROOF PLAN, SHEET MH.103, FOR CONTINUATION. INSTALL PER DETAIL A2/M-502.
8. INSTALL MANUAL BALANCING DAMPER SYSTEM BY METROPOLITAN AIR TECHNOLOGY: DAMPER (RT-200RT-250) WITH UNIVERSAL DAMPER DRIVE (RT-WGA) AND MINIATURE ROUND CEILING CUP (RT-CCM). EXHAUST DUCT. OF SIZE INDICATED. UP THROUGH ROOF TO EXHAUST FAN.
9. GREASE EXHAUST DUCT SHALL BE CONSTRUCTED OF 16 GA. WELDED BLACK IRON WITH ALL JOINTS WELDED LIQUID TIGHT. INSULATE ALL GREASE DUCT IN CEILING SPACE WITH 2" THICK UNIFRAX FIREWRAP MAX 2.0 - ICC SYSTEM OR EQUIVALENT 2-HOUR RATED MATERIAL. PROVIDE ACCESS DOORS IN DUCTWORK FOR CLEANING AS REQUIRED BY LOCAL CODES. REFER TO DETAIL A2/M-502 AND SPECIFICATIONS.
11. 4" Ø RIGID DUCT DRYER VENT UP THROUGH ROOF TO GOOSENECK. DO NOT ASSEMBLE WITH FASTENERS THAT EXTEND INTO DUCT. DO NOT INSTALL SCREEN IN OR OVER DRYER VENT. WRAP DRYER VENT IN WALL AND IN CEILING PLENUM WITH TYPE D-6 INSULATION.
12. 4" DIA. FRESH AIR DUCT THROUGH EXTERIOR WALL. TERMINATE WITH MANUFACTURER APPROVED WALL CAP.
13. KILN DOWNDRAFT VENTILATION SYSTEM. INSTALL VENT SYSTEM PER DETAIL C4/M-502 AND MANUFACTURER'S INSTALLATION MANUAL. PROVIDE 20 GA. 1/2" MESH SCREEN GUARD OVER WALL CAP. LEAVE MIN. 4" GAP BETWEEN GUARD AND CAP.
14. 24"X18" EXHAUST WALL LOUVER, RUSKIN MODEL ELF375DX.
15. 4" DIA. OUTSIDE AIR DUCT UP THROUGH ROOF TO RAIN CAP. TERMINATE 3'-0" ABOVE ROOF LEVEL. MOUNT THERMOSTAT AS HIGH AS POSSIBLE BELOW CEILING.
17. CONNECT MAKE-UP AIR DUCT TO KITCHEN HOOD. PROVIDE TRANSITION NECESSARY. VERIFY DUCT CONNECTION SIZE WITH HOOD PROVIDED BY FOOD SERVICE EQUIPMENT CONTRACTOR.
18. CONNECT GREASE EXHAUST DUCT TO KITCHEN HOOD. PROVIDE TRANSITION NECESSARY. VERIFY DUCT CONNECTION SIZE WITH HOOD PROVIDED BY FOOD SERVICE EQUIPMENT CONTRACTOR.
19. ELECTRIC UNIT HEATER PER EQUIPMENT SCHEDULE. MOUNT BOTTOM OF UNIT 7'-6" A.F.F.
20. BALANCING DAMPER TO ZPP-CEV.
21. COOLER/FREEZER CONDENSING UNIT FINISHED BY FOOD SERVICE EQUIPMENT CONTRACTOR. MECHANICAL CONTRACTOR SHALL PROVIDE AND INSTALL REFRIGERANT PIPING FROM ROOFTOP CONDENSING UNIT TO INDOOR COOLER/FREEZER EVAPORATOR COIL. INSTALL PIPING PER MANUFACTURER'S REQUIREMENTS. SEE ARCHITECTURAL PLANS FOR EXACT LOCATION.
22. LAG EXPOSED RECTANGULAR SUPPLY DUCT MAINS.

SEE HVAC LEVEL 2 FLOOR PLAN, SHEET MH.102B, FOR DUCTWORK IN THIS AREA

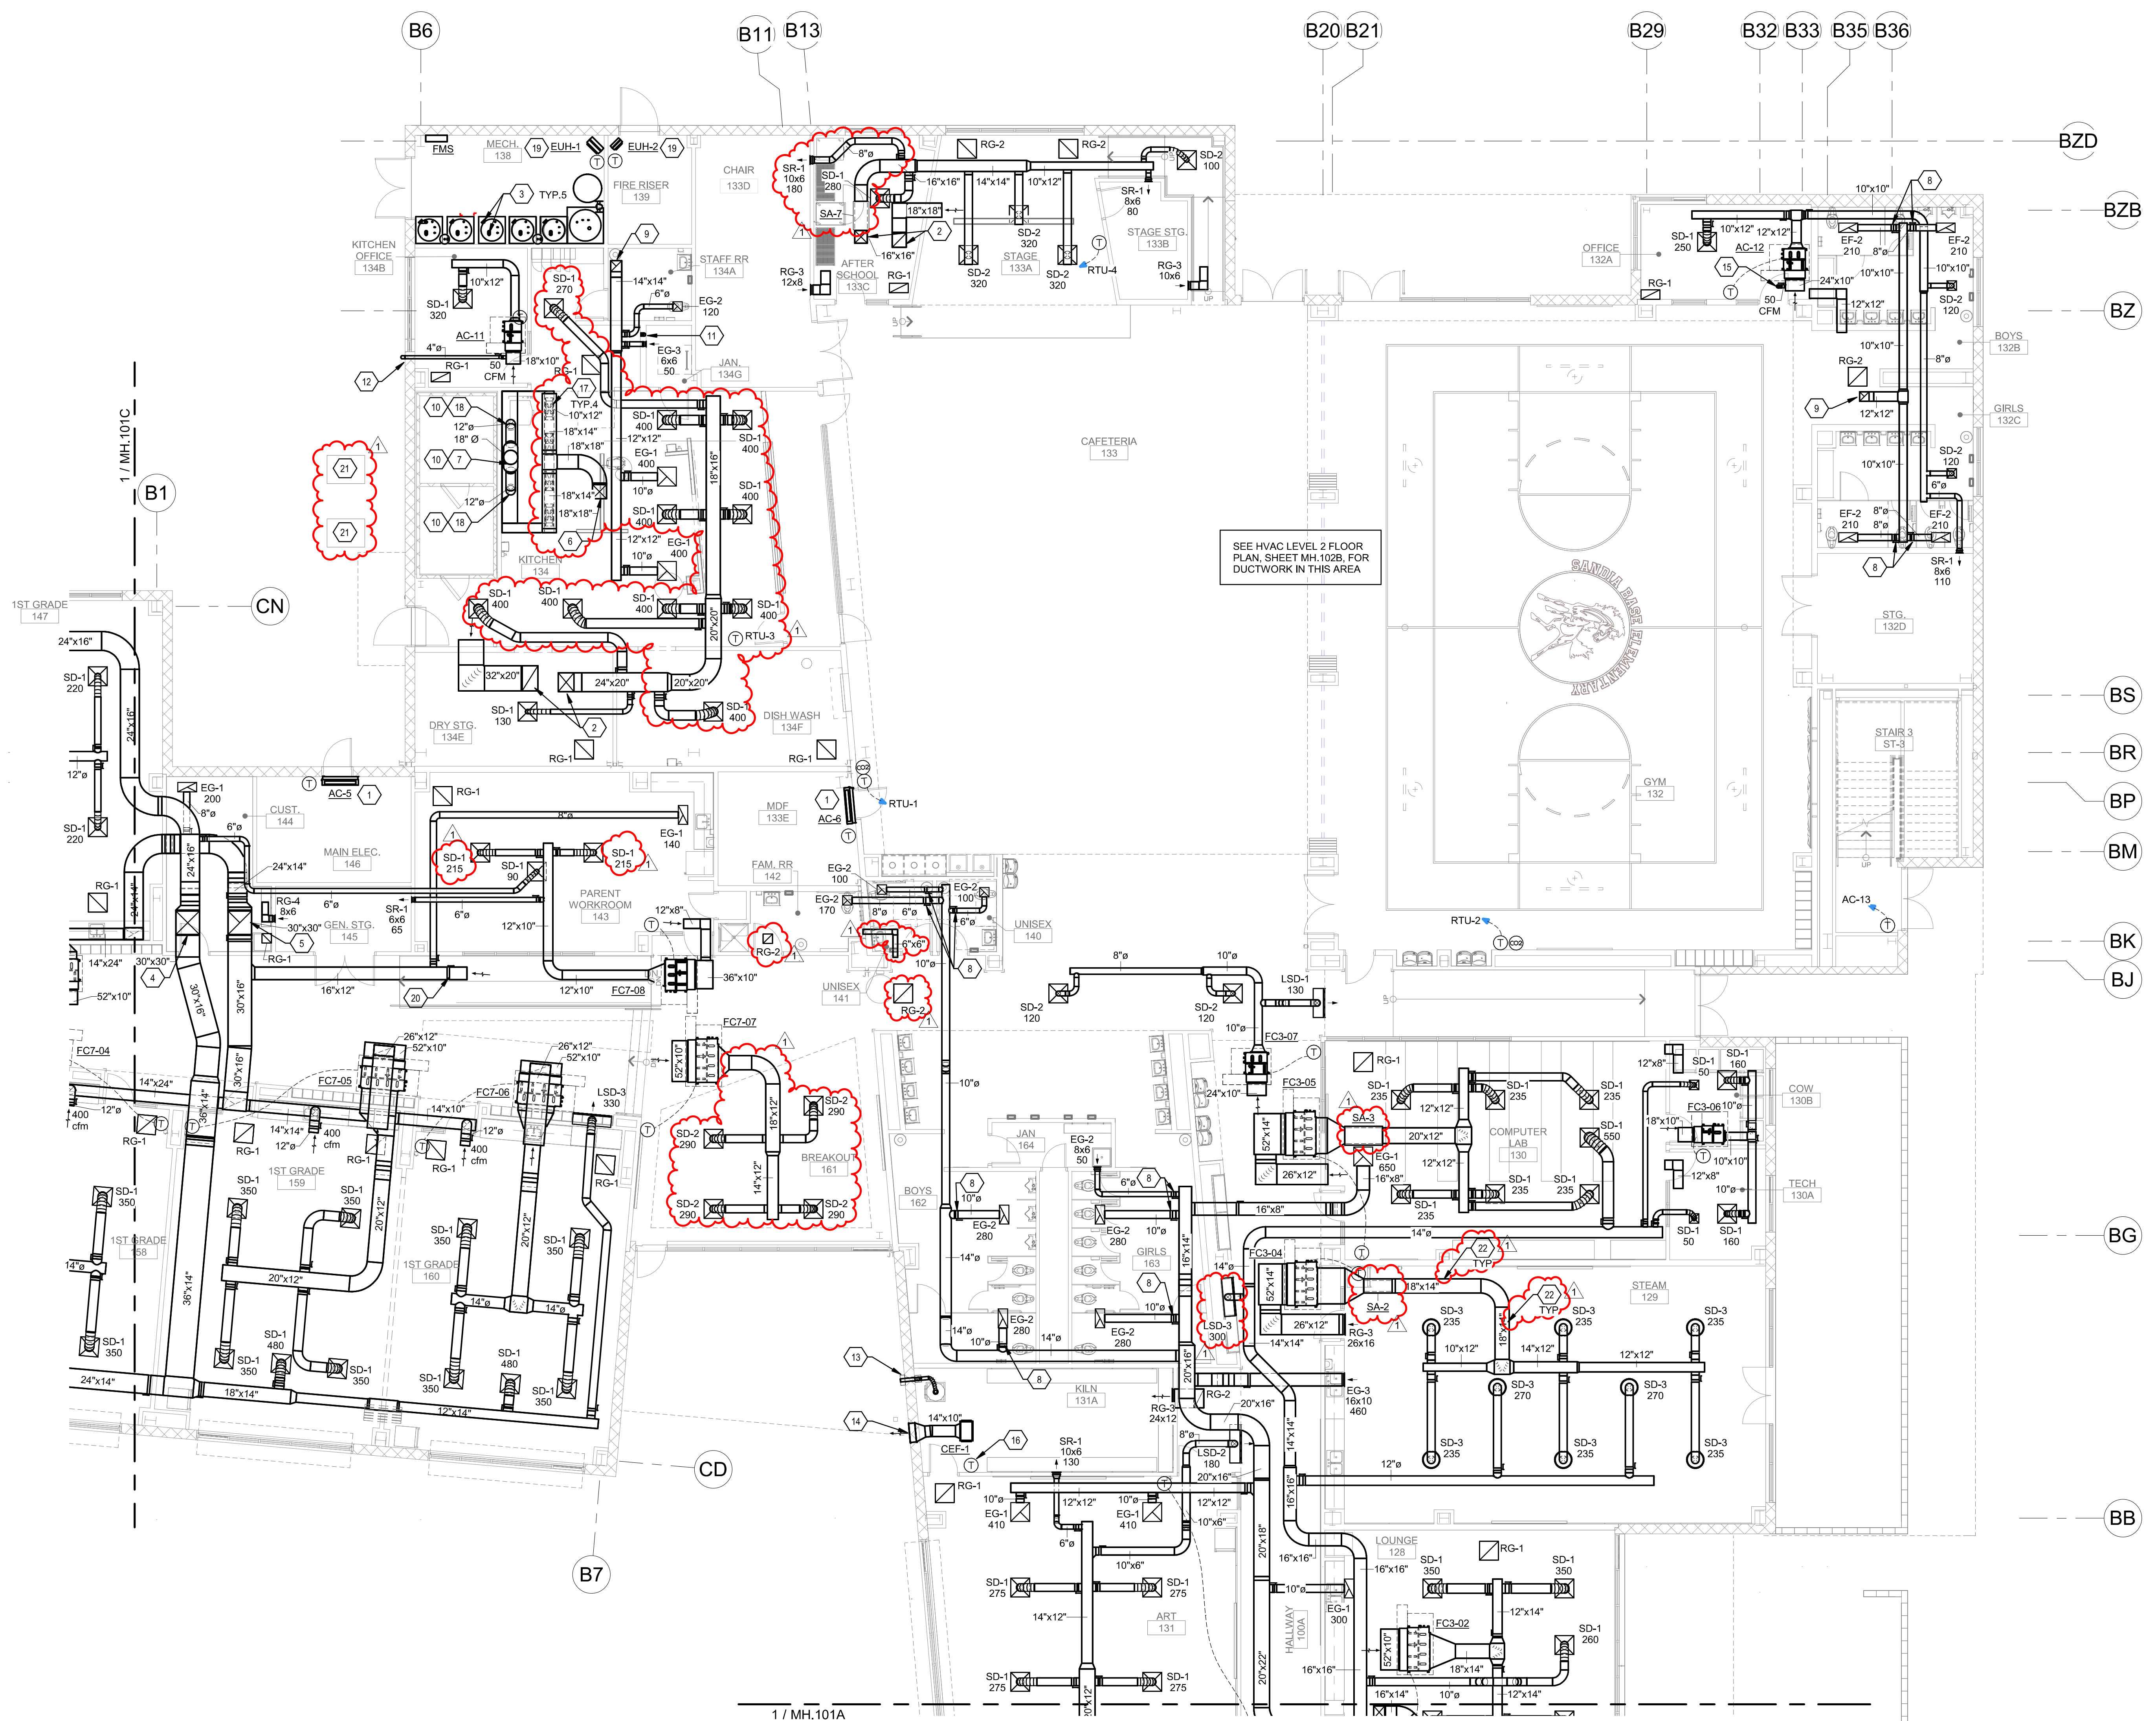

1 HVAC LEVEL 1 FLOOR PLAN - AREA B
 1/8" = 1'-0"

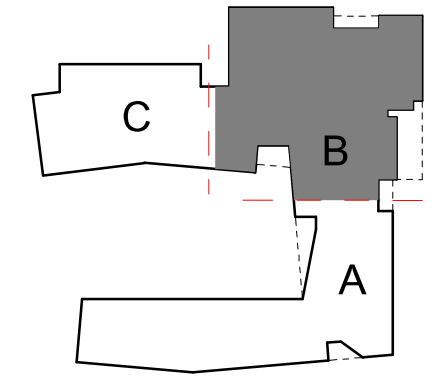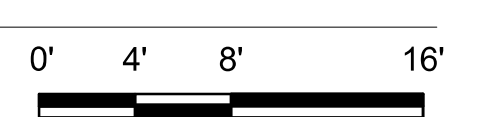


GENERAL NOTES:

- A. COORDINATE DUCT ROUTING AND EQUIPMENT INSTALLATION WITH STRUCTURAL PLANS, ARCHITECTURAL PLANS AND ELECTRICAL PLANS. GIVE SPECIAL ATTENTION TO STRUCTURAL BEAM ELEVATIONS, CEILING HEIGHTS, CABLE TRAYS, AND ROOF DRAIN LEADERS. SUBMIT 3D COORDINATION DRAWINGS FOR REVIEW PER SPECIFICATIONS 23 0500.
- B. ALL DUCT SIZES SHOWN ON THE DRAWING ARE NET INSIDE DIMENSIONS. SEE SPECIFICATION 230700 FOR INSULATION AND ACOUSTICAL LINING REQUIREMENTS.
- C. PROVIDE 1" ACOUSTICAL LINING IN ALL RECTANGULAR SUPPLY AND RETURN DUCTWORK FOR ALL VRF FAN COIL UNITS AND RTUS, AND ALL OUTSIDE AIR AND EXHAUST AIR DUCTWORK FOR ALL DOAS UNITS.
- D. COORDINATE WITH ARCHITECTURAL REFLECTED CEILING PLAN FOR EXACT LOCATION OF GRILLES AND DIFFUSERS.
- E. SEE DETAIL D2M-501 FOR LOW VELOCITY FITTING DETAILS.
- F. SEE DETAILS C3M-501 FOR DIFFUSER AND REGISTER CONNECTIONS. PROVIDE MANUAL BALANCING DAMPERS FOR EACH CONNECTION.
- G. SEE DETAIL B4M-502 FOR SIDEWALL LINEAR SLOT INSTALLATION.
- H. SEE DETAIL B1M-501 FOR DUCT MOUNTED LINEAR SLOT INSTALLATION.
- I. SEE DETAIL C2M-501 FOR EXHAUST REGISTER CONNECTION.
- J. MOUNT TEMPERATURE SENSORS PER SPECIFICATION.
- K. THERMOSTATS LOCATED IN COMMON AREAS TO BE PROVIDED WITH METAL COVER AND LOCK.
- L. PROVIDE SOUND TEE FOR ALL CEILING RETURN AIR GRILLES PER DETAIL A3M-501.
- M. INSTALL TRANSFER AIR DUCTS AND TRANSFER AIR OPENINGS ABOVE CEILING LEVEL. SIZE AS SHOWN ON PLANS. SEE DETAIL B4M-501.
- N. ALL EQUIPMENT, DUCTWORK, PIPING, CONDUIT, ETC. IN EXPOSED CEILING AREAS ARE TO BE PAINTED PER ARCHITECTURAL FINISH SCHEDULE.
- O. USE TURNING VANES IN ALL RECTANGULAR TEES AND MITERED ELBOWS.
- P. ALL EXPOSED ROUND DUCT SHALL BE SPIRAL CONSTRUCTION.
- Q. INSTALL FAN COILS PER DETAIL C1M-501.
- R. REFER TO SHEETS M-501 THROUGH M-502 FOR MECHANICAL DETAILS.


KEYNOTES

- 1. INDOOR AIR CONDITIONING UNIT MOUNTED ABOVE DOOR. COORDINATE LOCATION WITH ARCHITECT.
- 2. OUTSIDE AIR DUCT AND EXHAUST DUCT, OF SIZE INDICATED, DOWN FROM DEDICATED OUTSIDE AIR UNIT ON ROOF. CONTINUE DUCTS DOWN IN CHASE TO FLOOR BELOW. SEE HVAC LEVEL 1 FLOOR PLAN - AREA A, SHEET MH-101A, FOR CONTINUATION.
- 3. OUTSIDE AIR DUCT AND EXHAUST DUCT, OF SIZE INDICATED, DOWN IN CHASE TO LEVEL BELOW. SEE HVAC LEVEL 1 FLOOR PLAN - AREA A, SHEET MH-101A, FOR CONTINUATION.

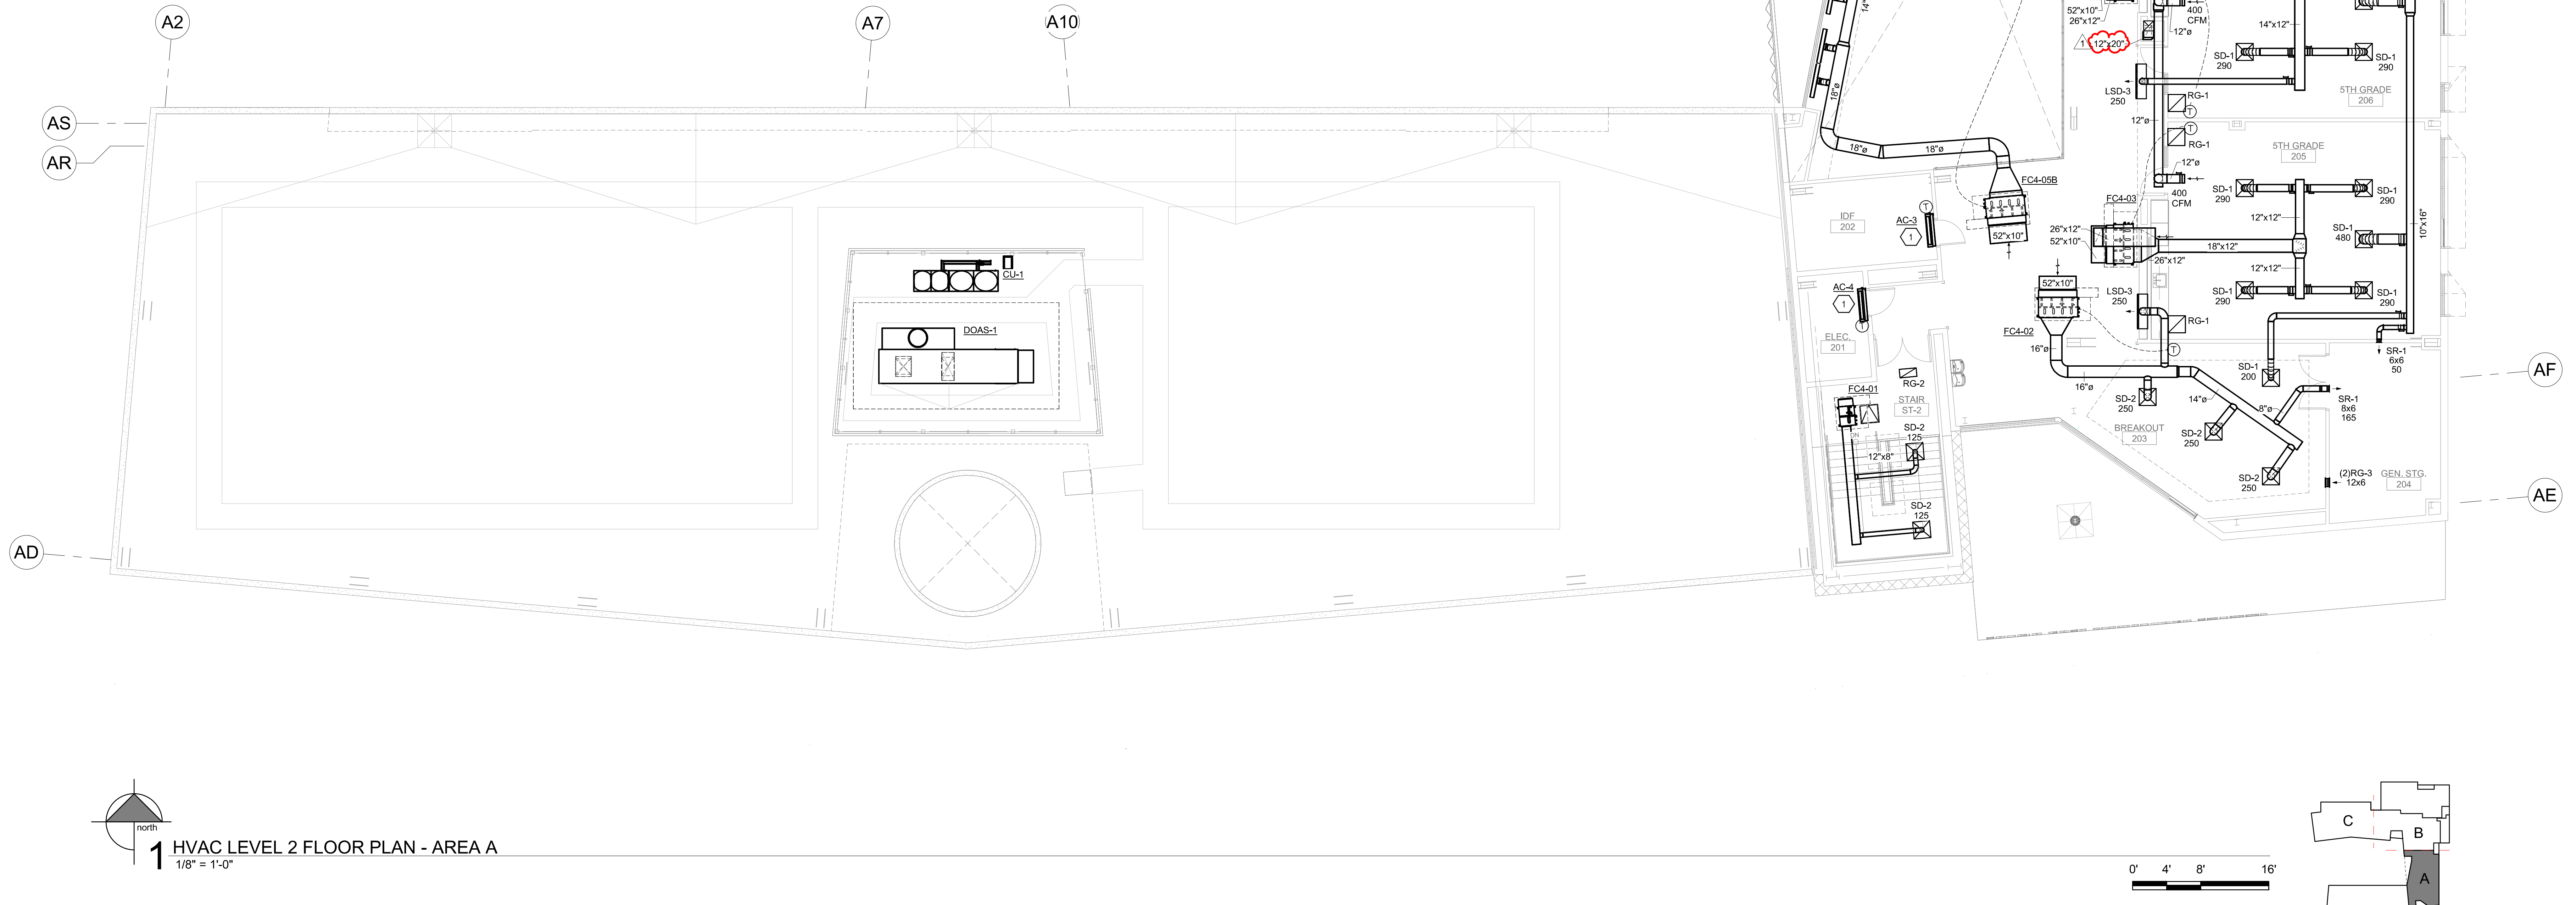

1 HVAC LEVEL 2 FLOOR PLAN - AREA A
1/8" = 1'-0"

0' 4' 8' 16'

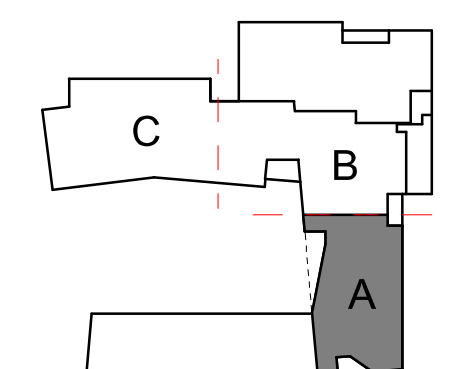

Bridgers & Paxton Project No. 8331 12/19/2022 1:26:01 PM D:\Revit\2022\Projects\8331_SBES_MEP_Imboghery@lps.com.rvt



JON ANDERSON ARCHITECTURE
912 ROMA AVE NW | ALBUQUERQUE, NEW MEXICO
P 505.764.8306 F 505.764.2879 www.jonandersonarchitecture.com



SANDIA BASE ELEMENTARY



REVISIONS	Revision #	Date	Revision Description
	1	12.19.22	Addendum 2


PHASE DATE
100% CD 11.04.22



MH.102A
HVAC LEVEL 2 FLOOR PLAN - AREA A

REVISIONS	Revision #	Date	Revision Description
	1	12.19.22	Addendum 2

PHASE DATE
 100% CD 11.04.22

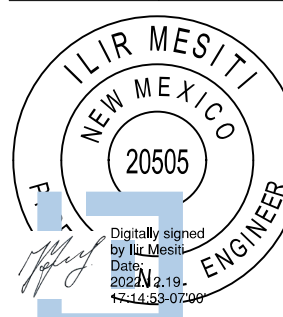


MH.102B
 HVAC LEVEL 2 FLOOR PLAN - AREA B

GENERAL NOTES:



- COORDINATE DUCT ROUTING AND EQUIPMENT INSTALLATION WITH STRUCTURAL PLANS, ARCHITECTURAL PLANS AND ELECTRICAL PLANS. GIVE SPECIAL ATTENTION TO STRUCTURAL BEAM ELEVATIONS, CEILING HEIGHTS, CABLE TRAYS, AND ROOF DRAIN LEADERS. SUBMIT 3D COORDINATION DRAWINGS FOR REVIEW PER SPECIFICATIONS 23 0500.
- ALL DUCT SIZES SHOWN ON THE DRAWING ARE NET INSIDE DIMENSIONS. SEE SPECIFICATION 230700 FOR INSULATION AND ACOUSTICAL LINING REQUIREMENTS.
- PROVIDE 1" ACOUSTICAL LINING IN ALL RECTANGULAR SUPPLY AND RETURN DUCTWORK FOR ALL VRF FAN COIL UNITS AND RTUS, AND ALL OUTSIDE AIR AND EXHAUST AIR DUCTWORK FOR ALL DASH UNITS.
- COORDINATE WITH ARCHITECTURAL REFLECTED CEILING PLAN FOR EXACT LOCATION OF GRILLES AND DIFFUSERS.
- SEE DETAIL D2/M-501 FOR LOW VELOCITY FITTING DETAILS.
- SEE DETAILS C3/M-501 FOR DIFFUSER AND REGISTER CONNECTIONS. PROVIDE MANUAL BALANCING DAMPERS FOR EACH CONNECTION.
- SEE DETAIL B4/M-502 FOR SIDEWALL LINEAR SLOT INSTALLATION.
- SEE DETAIL C2/M-501 FOR DUCT MOUNTED LINEAR SLOT INSTALLATION.
- SEE DETAIL C2/M-501 FOR EXHAUST REGISTER CONNECTION.
- MOUNT TEMPERATURE SENSORS PER SPECIFICATION.
- THERMOSTATS LOCATED IN COMMON AREAS TO BE PROVIDED WITH METAL COVER AND LOCK.
- PROVIDE SOUND TEE FOR ALL CEILING RETURN AIR GRILLES PER DETAIL A3/M-501.
- INSTALL TRANSFER AIR DUCTS AND TRANSFER AIR OPENINGS ABOVE CEILING LEVEL. SIZE AS SHOWN ON PLANS. SEE DETAIL B4/M-501.
- ALL EQUIPMENT, DUCTWORK, PIPING, CONDUIT, ETC. IN EXPOSED CEILING AREAS ARE TO BE PAINTED PER ARCHITECTURAL FINISH SCHEDULE.
- USE TURNING VANES IN ALL RECTANGULAR TEES AND MITERED ELBOWS.
- ALL EXPOSED ROUND DUCT SHALL BE SPIRAL CONSTRUCTION.
- INSTALL FAN COILS PER DETAIL C1/M-501.
- REFER TO SHEETS M-501 THROUGH M-502 FOR MECHANICAL DETAILS.

KEYNOTES

- INDOOR AIR CONDITIONING UNIT MOUNTED ABOVE DOOR. COORDINATE LOCATION WITH ARCHITECT. SUPPLY AND RETURN DUCT, OF SIZE INDICATED, UP THROUGH ROOF TO ROOFTOP UNIT.
- OUTSIDE AIR DUCT AND EXHAUST DUCT, OF SIZE INDICATED, UP THROUGH ROOF TO ENERGY RECOVERY UNIT.
- OUTSIDE AIR DUCT AND EXHAUST DUCT, OF SIZE INDICATED, DOWN FROM ROOFTOP ENERGY RECOVERY UNIT. ROUTE DOWN IN CHASE TO LEVEL BELOW. SEE HVAC LEVEL 1 FLOOR PLAN - AREA B, SHEET MH.101B, FOR CONTINUATION.
- INSTALL MANUAL BALANCING DAMPER SYSTEM BY METROPOLITAN AIR TECHNOLOGY: DAMPER (RT-200/RT-250) WITH UNIVERSAL DAMPER DRIVE (RT-WGA) AND MINATURE ROUND CEILING CUP (RT-CCM).
- MOUNT DRUM PUNKERS 45 DEGREES FROM HORIZONTAL, DIRECT DOWN.
- INSTALL MESH SCREEN AT RETURN DUCT TERMINATION.

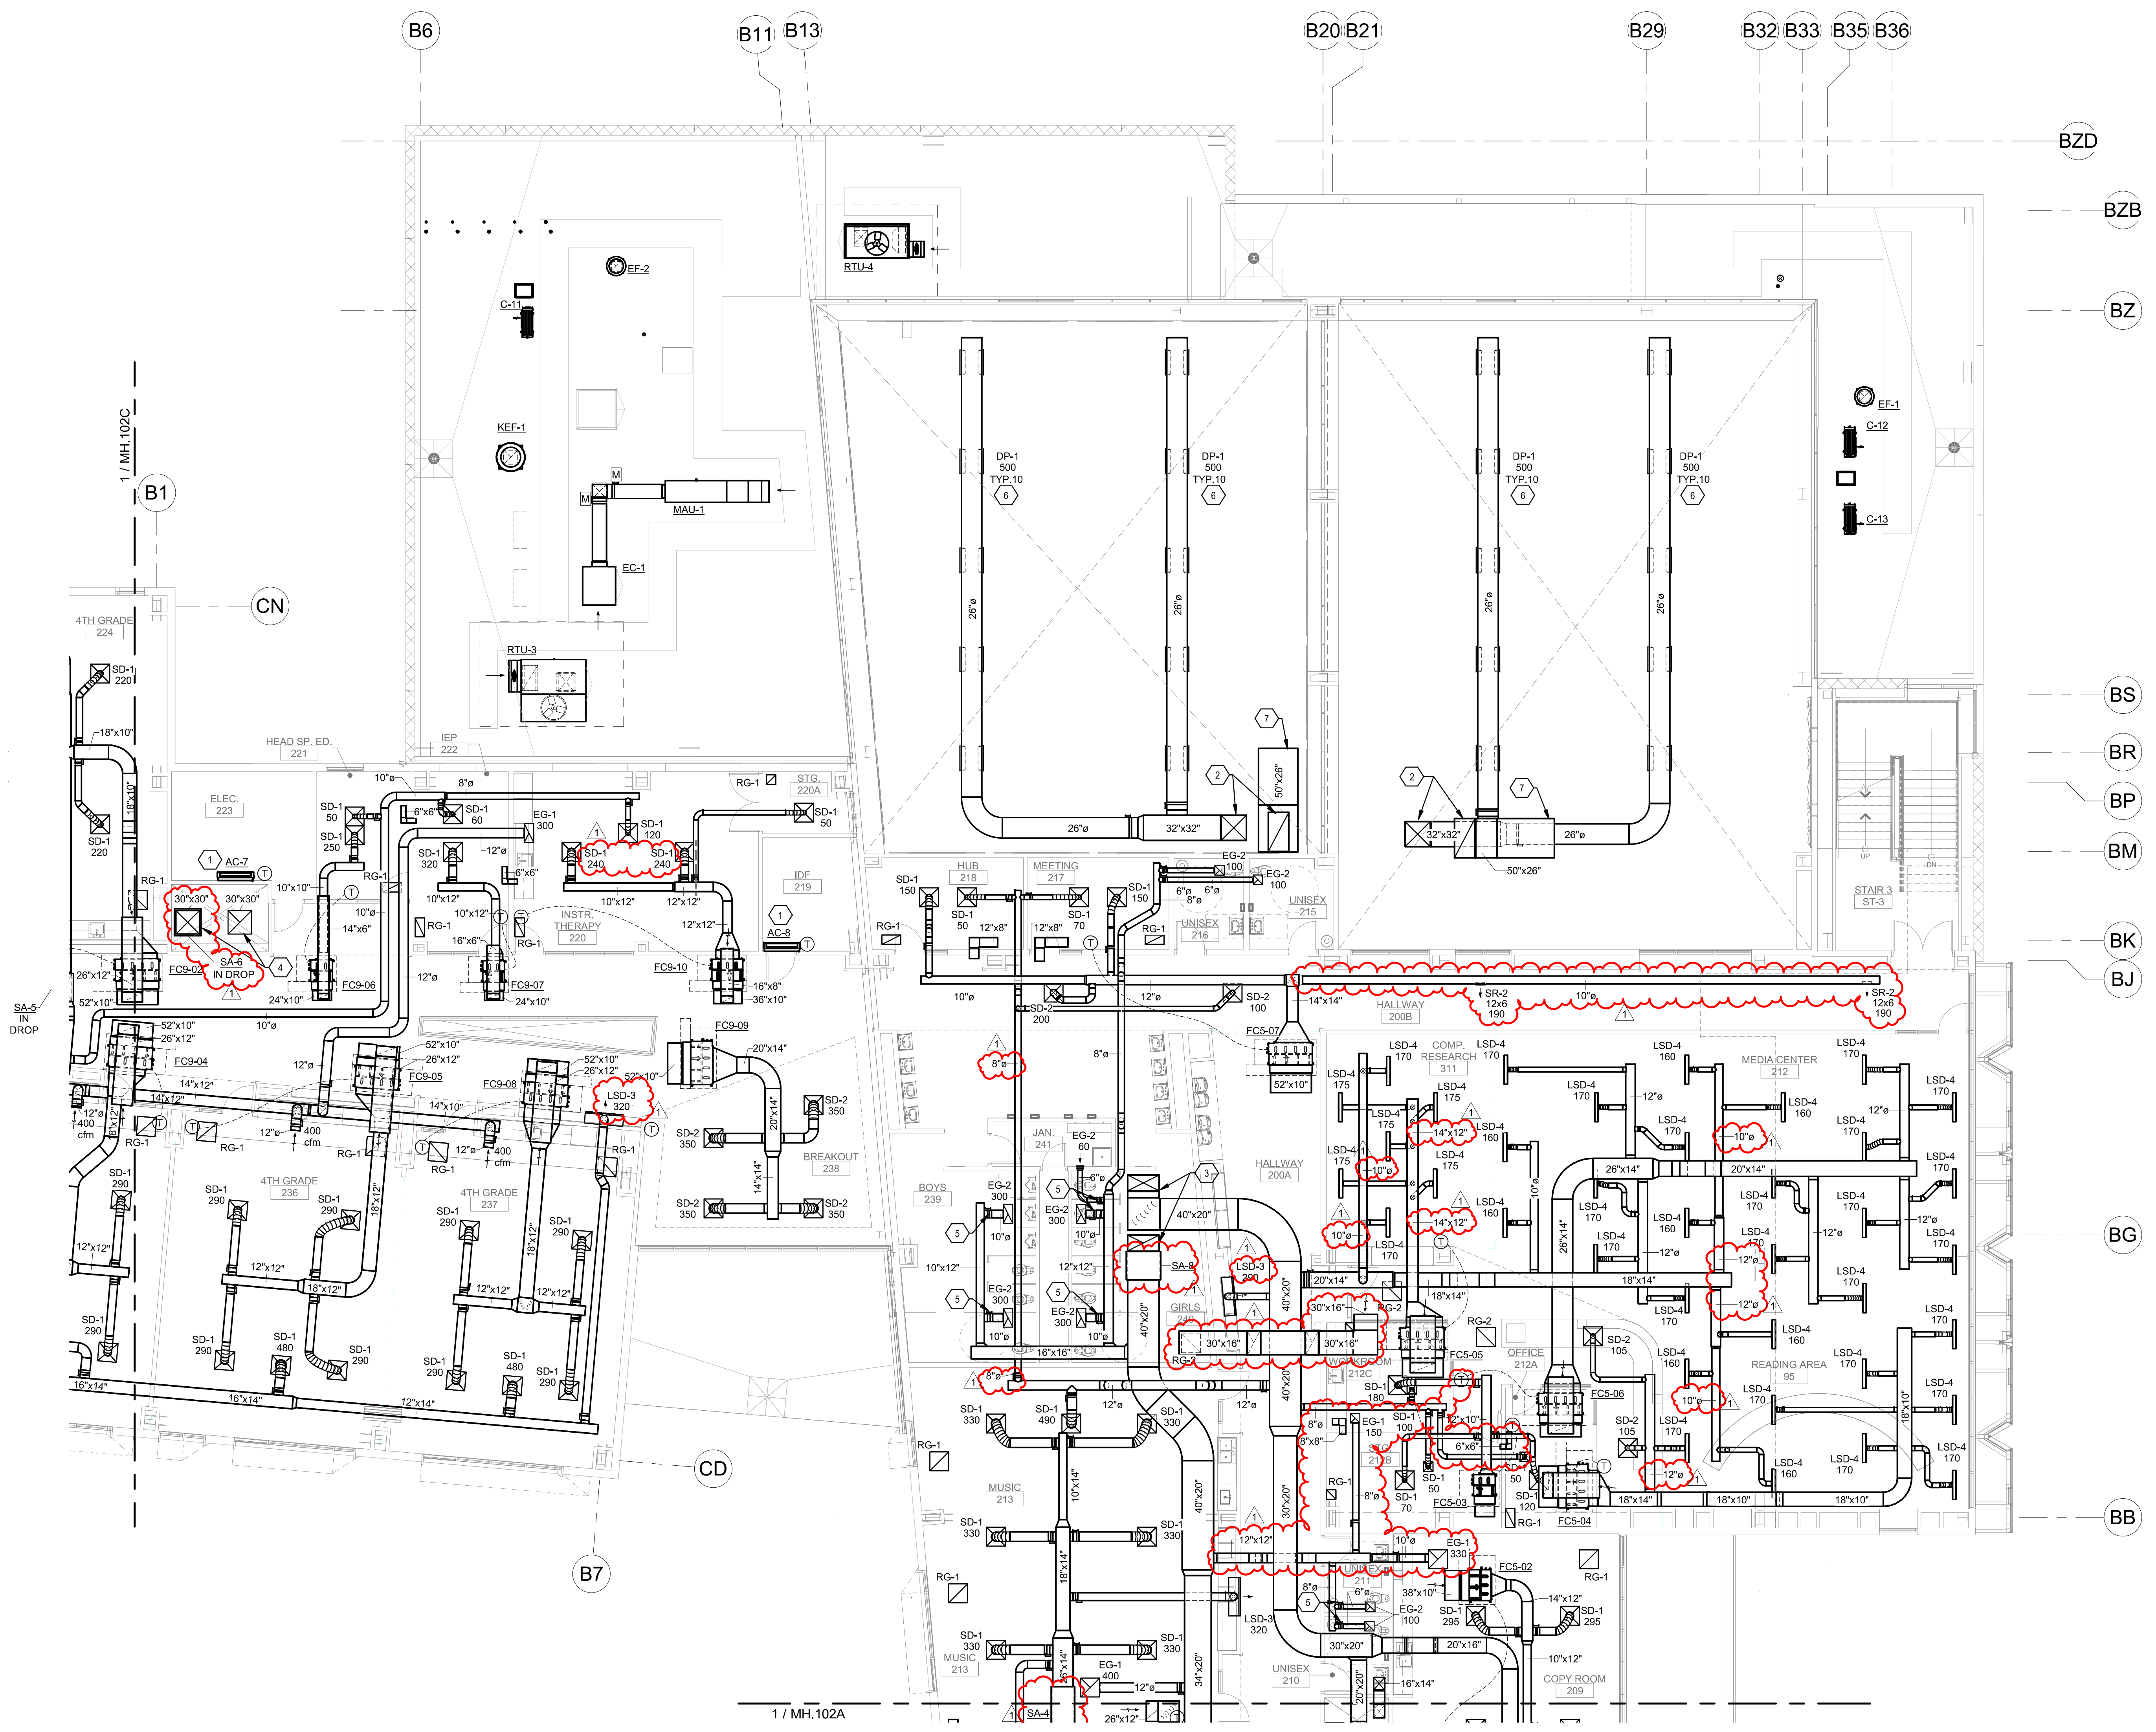

1 HVAC LEVEL 2 FLOOR PLAN - AREA B
 1/8" = 1'-0"

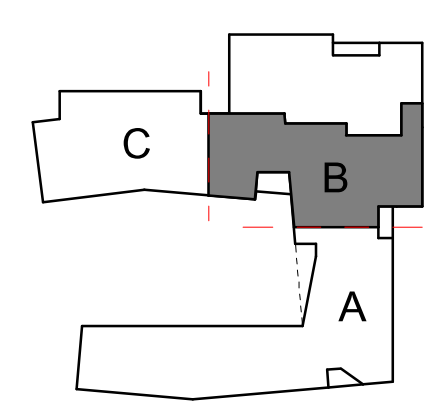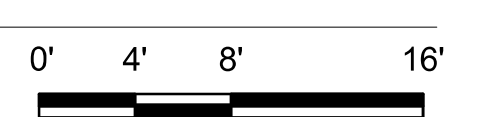


GENERAL NOTES:



- A. COORDINATE DUCT ROUTING AND EQUIPMENT INSTALLATION WITH STRUCTURAL PLANS, ARCHITECTURAL PLANS AND ELECTRICAL PLANS. GIVE SPECIAL ATTENTION TO STRUCTURAL BEAM ELEVATIONS, CEILING HEIGHTS, CABLE TRAYS, AND ROOF DRAIN LEADERS. SUBMIT 3D COORDINATION DRAWINGS FOR REVIEW PER SPECIFICATIONS 23 0500.
- B. ALL DUCT SIZES SHOWN ON THE DRAWING ARE NET INSIDE DIMENSIONS. SEE SPECIFICATION 230700 FOR INSULATION AND ACOUSTICAL LINING REQUIREMENTS.
- C. PROVIDE 1" ACOUSTICAL LINING IN ALL RECTANGULAR SUPPLY AND RETURN DUCTWORK FOR ALL VRF FAN COIL UNITS AND RTUS, AND ALL OUTSIDE AIR AND EXHAUST AIR DUCTWORK FOR ALL DOAS UNITS.
- D. COORDINATE WITH ARCHITECTURAL REFLECTED CEILING PLAN FOR EXACT LOCATION OF GRILLES AND DIFFUSERS.
- E. SEE DETAIL D2/M-501 FOR LOW VELOCITY FITTING DETAILS.
- F. SEE DETAILS C3/M-501 FOR DIFFUSER AND REGISTER CONNECTIONS. PROVIDE MANUAL BALANCING DAMPERS FOR EACH CONNECTION.
- G. SEE DETAIL B4/M-502 FOR SIDEWALL LINEAR SLOT INSTALLATION.
- H. SEE DETAIL B1/M-501 FOR DUCT MOUNTED LINEAR SLOT INSTALLATION.
- I. SEE DETAIL C2/M-501 FOR EXHAUST REGISTER CONNECTION.
- J. MOUNT TEMPERATURE SENSORS PER SPECIFICATION.
- K. THERMOSTATS LOCATED IN COMMON AREAS TO BE PROVIDED WITH METAL COVER AND LOCK.
- L. PROVIDE SOUND TEE FOR ALL CEILING RETURN AIR GRILLES PER DETAIL A3/M-501.
- M. INSTALL TRANSFER AIR DUCTS AND TRANSFER AIR OPENINGS ABOVE CEILING LEVEL. SIZE AS SHOWN ON PLANS. SEE DETAIL B4/M-501.
- N. ALL EQUIPMENT, DUCTWORK, PIPING, CONDUIT, ETC. IN EXPOSED CEILING AREAS ARE TO BE PAINTED PER ARCHITECTURAL FINISH SCHEDULE.
- O. USE TURNING VANES IN ALL RECTANGULAR TEES AND MITERED ELBOWS.
- P. ALL EXPOSED ROUND DUCT SHALL BE SPIRAL CONSTRUCTION.
- Q. INSTALL FAN COILS PER DETAIL C1/M-501.
- R. REFER TO SHEETS M-501 THROUGH M-502 FOR MECHANICAL DETAILS.

KEYNOTES

1. INDOOR AIR CONDITIONING UNIT MOUNTED ABOVE DOOR. COORDINATE LOCATION WITH ARCHITECT.
2. OUTSIDE AIR DUCT, OF SIZE INDICATED, UP IN CHASE TO FLOOR ABOVE. SEE SECOND FLOOR HVAC PLAN, SHEET MH.102B, FOR CONTINUATION.
3. EXHAUST AIR DUCT, OF SIZE INDICATED, UP IN CHASE TO FLOOR ABOVE. SEE SECOND FLOOR HVAC PLAN, SHEET MH.102B, FOR CONTINUATION.
4. BALANCING DAMPER SET TO 800 CFM.

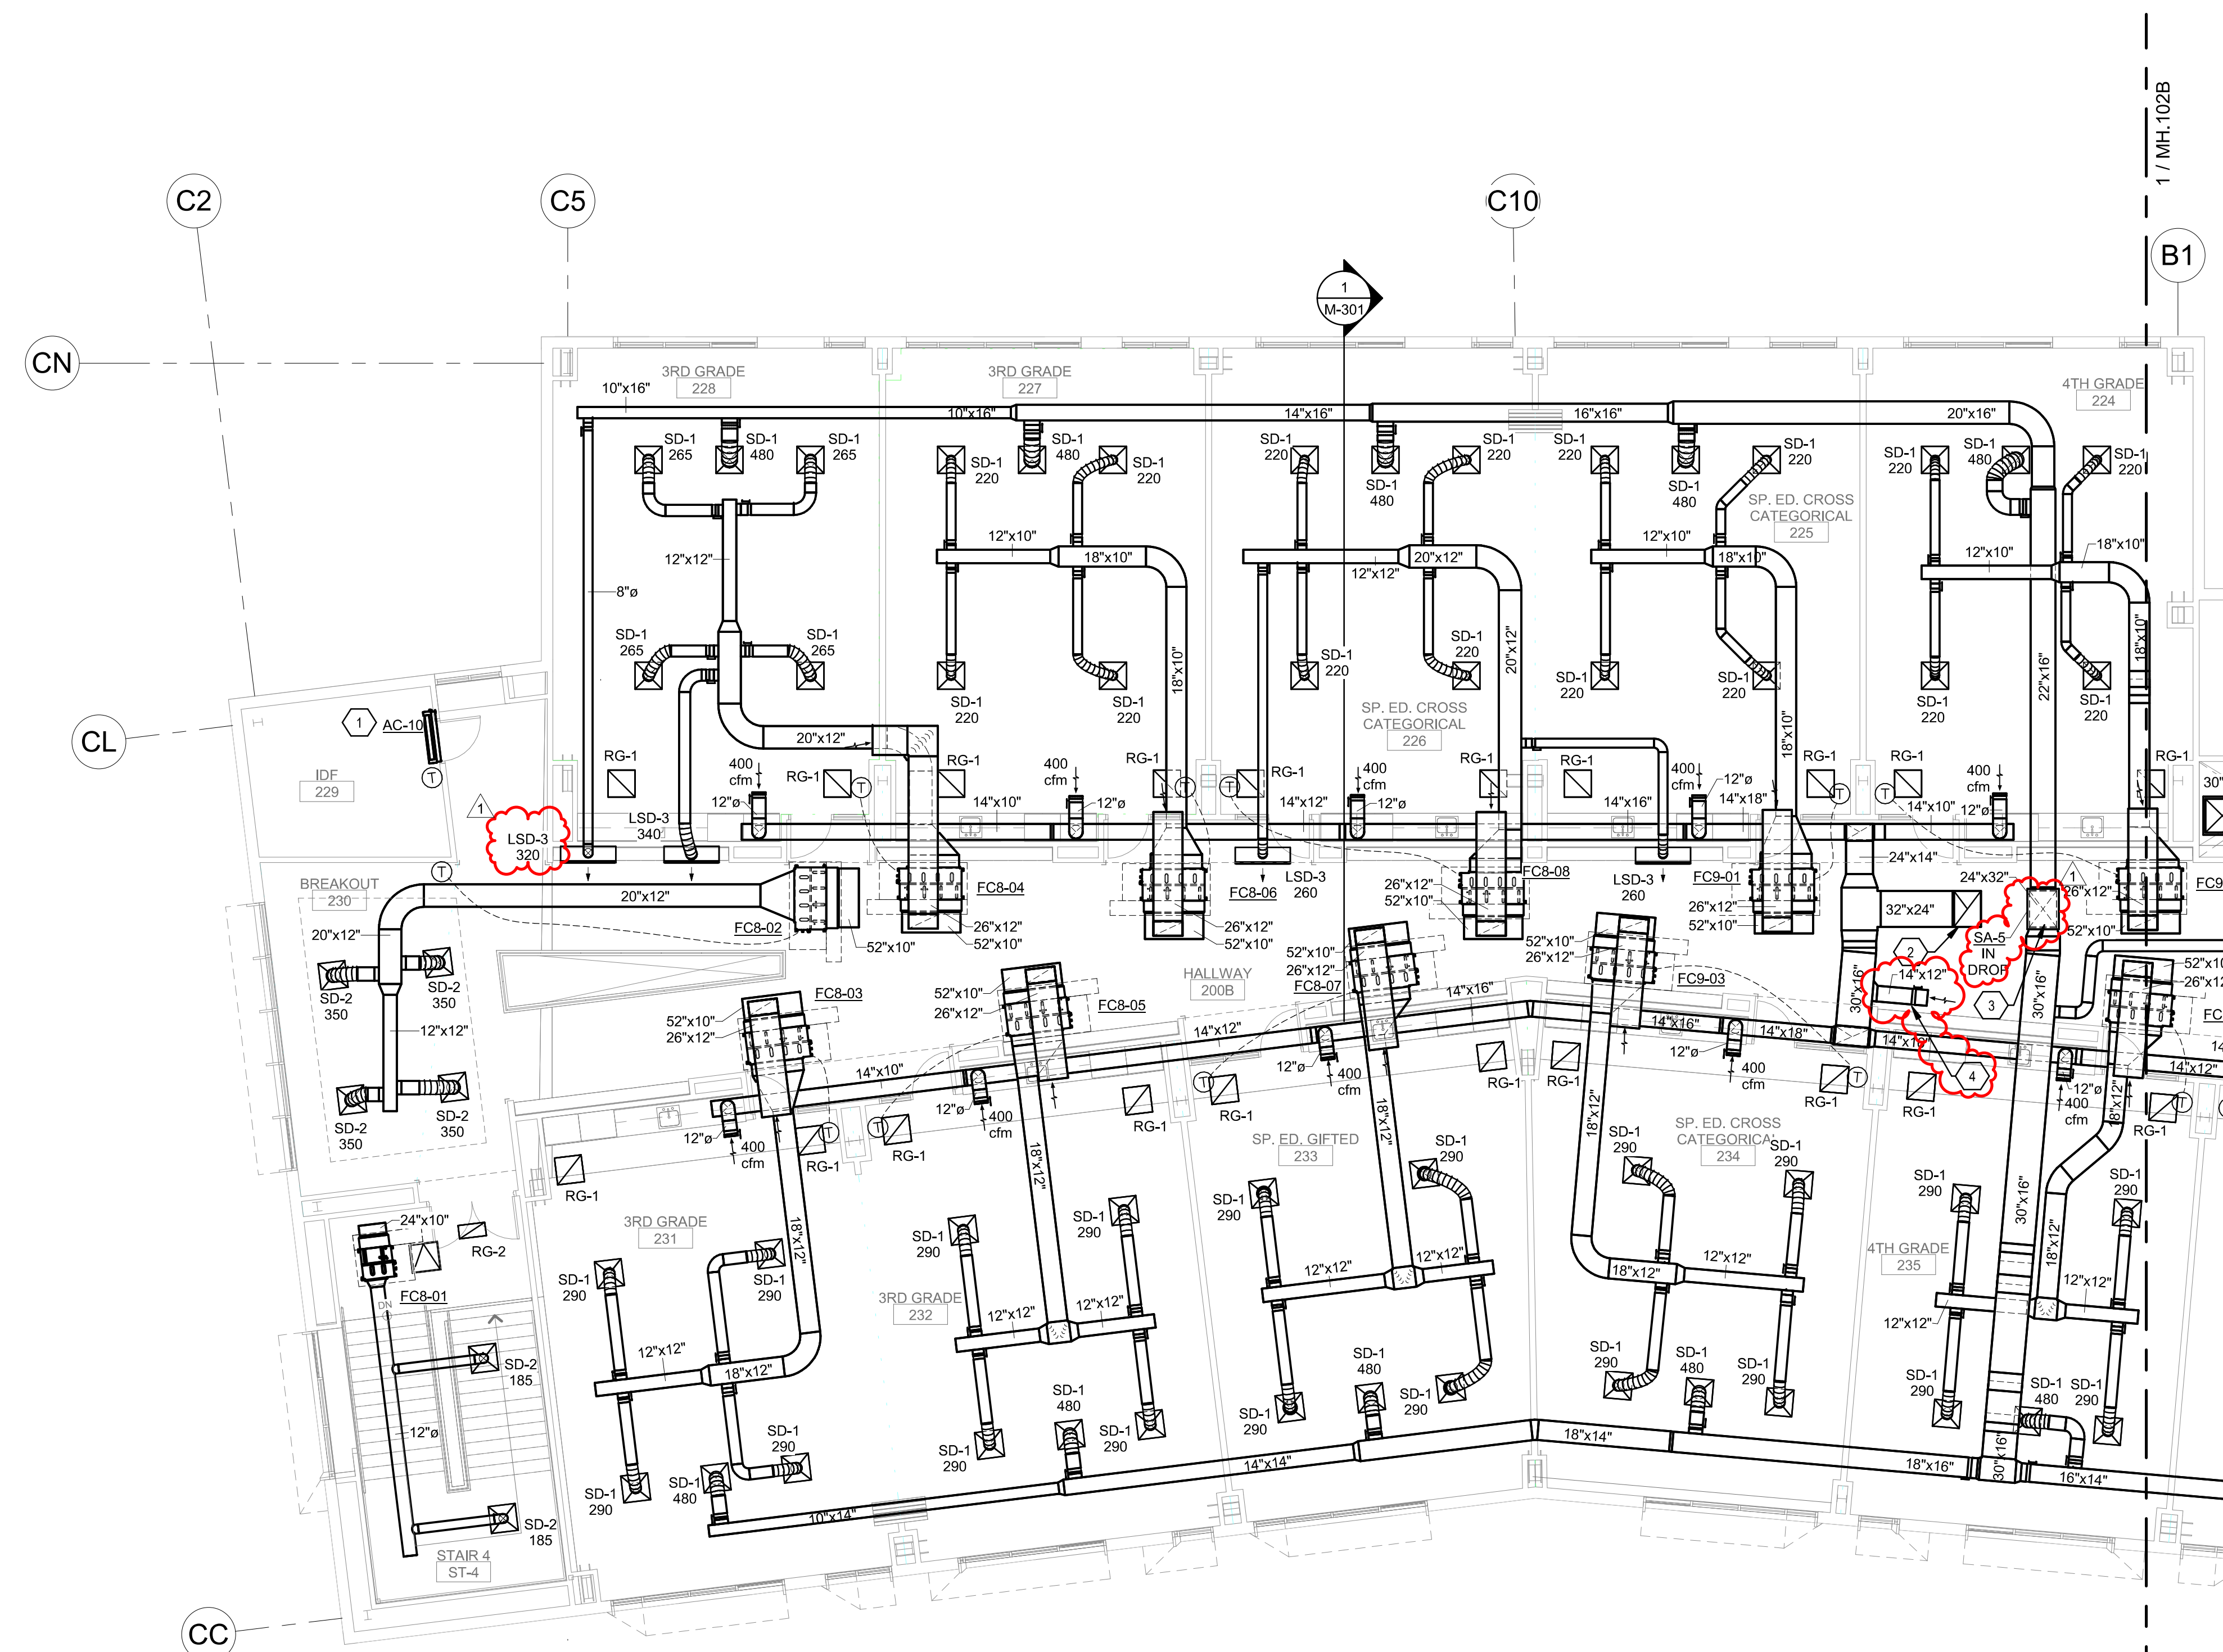


1 HVAC LEVEL 2 FLOOR PLAN - AREA C
 1/8" = 1'-0"

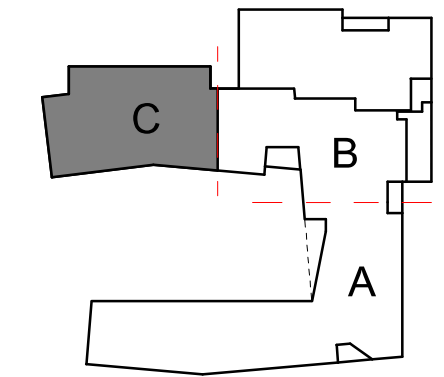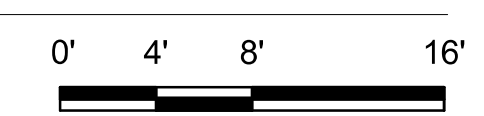


REVISIONS	Revision #	Date	Revision Description
	1	12.19.22	Addendum 2

PHASE	DATE
100% CD	11.04.22

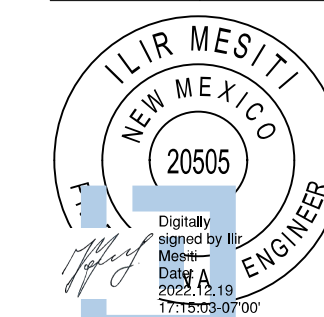



MH.102C
 HVAC LEVEL 2
 FLOOR PLAN -
 AREA C

12/19/2022 1:27:38 PM D:\Revit\2022\Projects\6331_SBES_MEP_Imooghery@lps.com.rvt

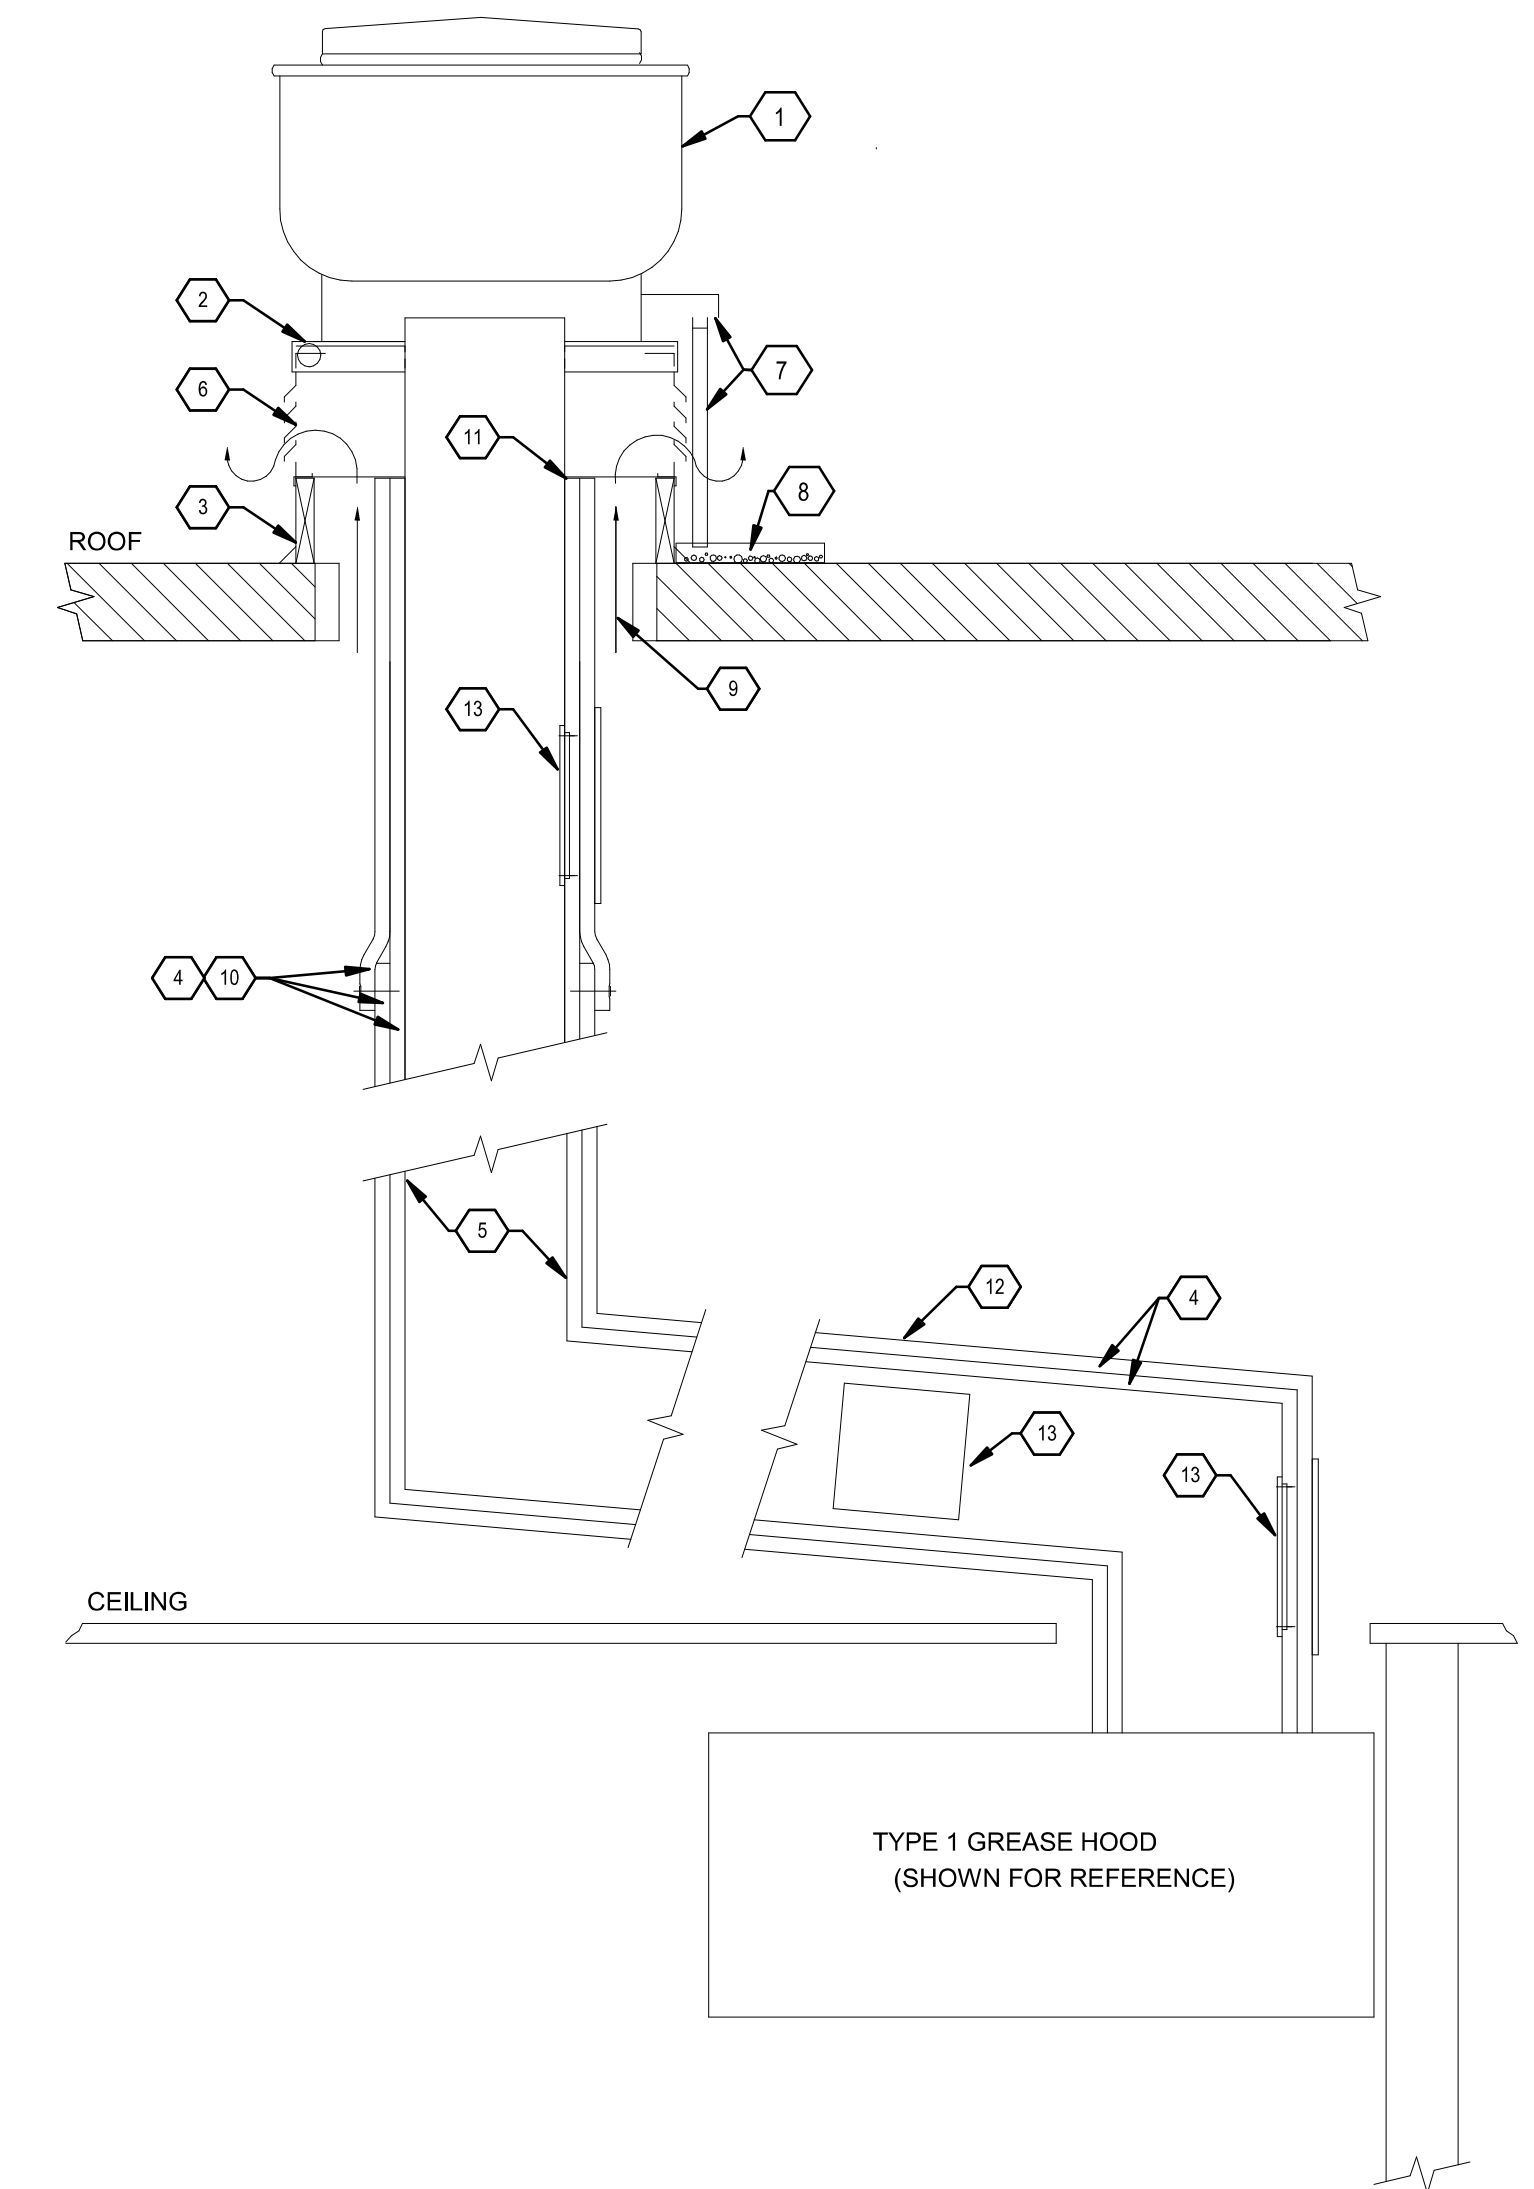


A2 GREASE EXHAUST FAN AND DUCT DETAIL
SCALE = NONE

- 1 TOP DISCHARGE POWER ROOF EXHAUSTER
- 2 INTEGRAL CURB CAP. SECURE AND CAULK TO CURB.
- 3 12" TALL MIN. FACTORY ROOF CURB SECURELY ANCHORED TO ROOF AS SHOWN ON ARCHITECTURAL DRAWINGS. FLASH AND COUNTERFLASH CURB TO ROOF.
- 4 FIELD APPLIED 2 HOUR FIRE RATED DUCT WRAP. (TYP. COMPRISING OF 2 LAYERS OF MATERIAL). UNIFRAX "FIREWRAP MAX 2.0 - ICC SYSTEM". INSTALL DUCT WRAP PER MANUFACTURER'S INSTALLATION REQUIREMENTS.
- 5 16 GA. WELDED BLACK IRON DUCTWORK FROM KITCHEN HOOD.
- 6 VENTILATED CURB EXTENSION
- 7 GREASE CUP WITH DRAIN TUBE
- 8 2'x2'x3" GREASE PAN WITH 2" PEA GRAVEL BED. SOLDER BOTTOM AND SIDES OF PAN.
- 9 MAINTAIN 1" CLEARANCE (MINIMUM) BETWEEN ROOF OPENING AND 2 HOUR FIRE RATED DUCT WRAP. AN AIR GAP SHALL BE MAINTAINED AROUND DUCT SO THAT AIR CIRCULATES FROM CEILING CAVITY UP AND OUT OF VENTILATED CURB EXTENSION.
- 10 OVERLAP 2 HOUR FIRE WRAP AT SEAMS AND SECURE FIRE WRAP WITH METAL PINS AND STAINLESS STEEL BANDING PER MANUFACTURER'S INSTALLATION REQUIREMENTS. NOTE: WHERE SEAMS OCCUR, DUCT WRAP MATERIAL CAN BE UP TO 3 LAYERS THICK. CONSIDER MATERIAL THICKNESS WHEN COORDINATING ROOF OPENINGS AND DUCT ENCLOSURES.
- 11 2 HOUR RATED FIRE WRAP MATERIAL SHALL EXTEND UP THROUGH ROOF TO TOP OF ROOF CURB AND/OR BOTTOM OF VENTILATED CURB EXTENSION.
- 12 SLOPE GREASE DUCT A MINIMUM OF 1/4" PER FOOT TOWARDS HOOD.
- 13 UL LISTED GREASE DUCT ACCESS DOOR CONSTRUCTED OF SAME GAUGE MATERIAL AS GREASE DUCT. INSTALL ACCESS DOOR ON SIDE OF GREASE DUCT EVERY 8'-0".

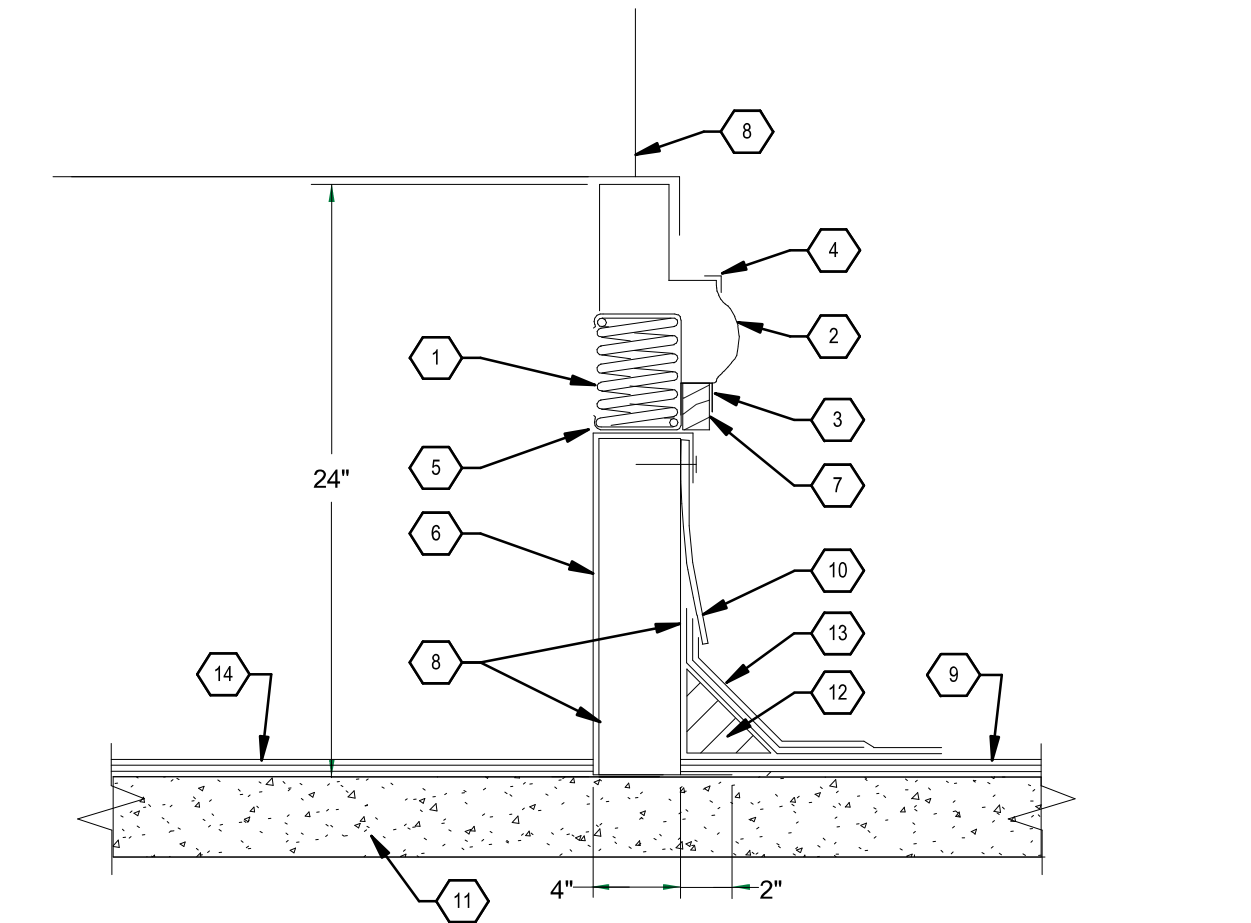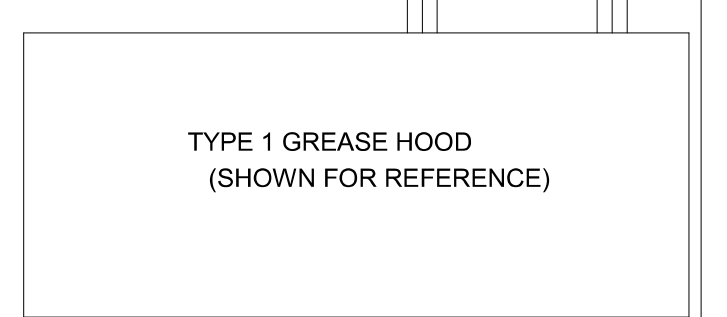

- 1 2" SPRING ISOLATORS WITH RETAINERS THYCURB MODEL TRSV OR EQUIVALENT.
- 2 EPDM ROOFING MATERIAL.
- 3 18 G.A. STRIP
- 4 CLIP ANGLE
- 5 WEATHERPROOF SEAL, CONTINUOUS
- 6 1" DEFLECTION 4" STRUCTURAL CHANNEL
- 7 2x4 WOOD NAILER STRIP, CONTINUOUS
- 8 14 GA. GALVANIZED STEEL CONSTRUCTION
- 9 ROOFING, SEE ARCHITECTURAL FOR TYPE
- 10 20 GA. GALV. STEEL COUNTERFLASH, CONTINUOUS
- 11 6" CONCRETE PAD, SEE STRUCTURAL.
- 12 FIBER CANT STRIP, BY OTHERS
- 13 FLASHING, BY OTHERS
- 14 ROOFING, SEE ARCHITECTURAL FOR TYPE
- 15 FLASHING, BY OTHERS


C3 SPRING ISOLATED CURB DETAIL
SCALE = NONE

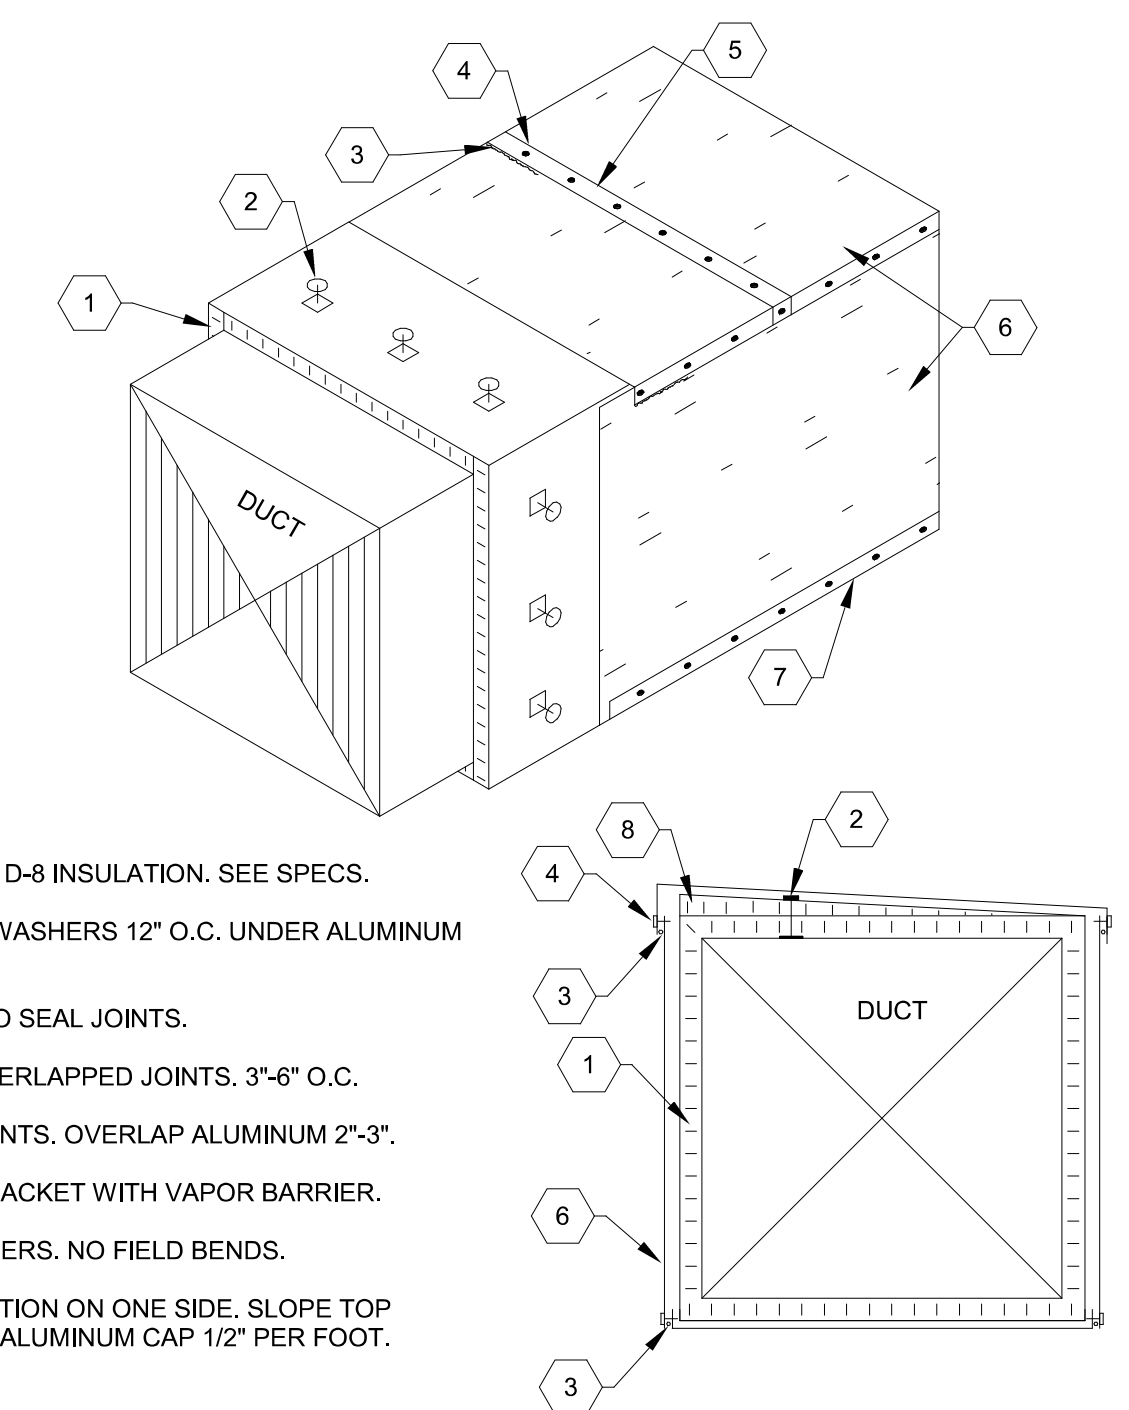


- 1 MINIMUM 2" TYPE D-8 INSULATION. SEE SPECS.
- 2 STICK PINS AND WASHERS 12" O.C. UNDER ALUMINUM JACKET.
- 3 USE CAULKING TO SEAL JOINTS.
- 4 SCREWS FOR OVERLAPPED JOINTS. 3"-6" O.C.
- 5 OVERLAPPED JOINTS. OVERLAP ALUMINUM 2"-3".
- 6 .016" ALUMINUM JACKET WITH VAPOR BARRIER.
- 7 BREAK ALL CORNERS, NO FIELD BENDS.
- 8 TAPERED INSULATION ON ONE SIDE. SLOPE TOP INSULATION AND ALUMINUM CAP 1/2" PER FOOT.

- GENERAL NOTES**
- A. TAKE CARE TO ENSURE STICK PINS DO NOT PROTRUDE THROUGH ALUMINUM JACKET. IF STICK PIN PROTRUDES THROUGH ALUMINUM JACKET USE S.S. DOMED WASHER AND CAULK. NO FLAT WASHERS TO BE USED.
 - B. BOTTOM ALUMINUM CAP MUST BE INSTALLED FIRST TO PROVIDE FOR A MOUNTING SURFACE FOR ALUMINUM SIDES.
 - C. ALUMINUM SIDES SHALL BE MOUNTED SECOND. SCREW INTO BOTTOM ALUMINUM CAP.
 - D. LASTLY, INSTALL TOP ALUMINUM CAP. SCREW INTO FLAT ALUMINUM SIDES AND SEAL JOINTS WITH CAULKING.

B3 EXTERIOR DUCT INSULATION DETAIL
SCALE = NONE

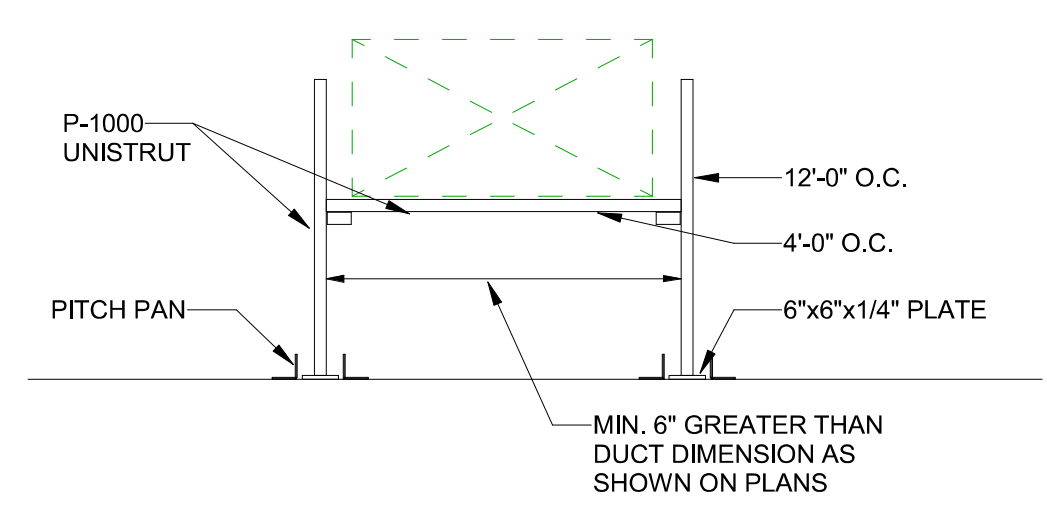


A4 ABOVE ROOF DUCT SUPPORT DETAIL
SCALE = NONE

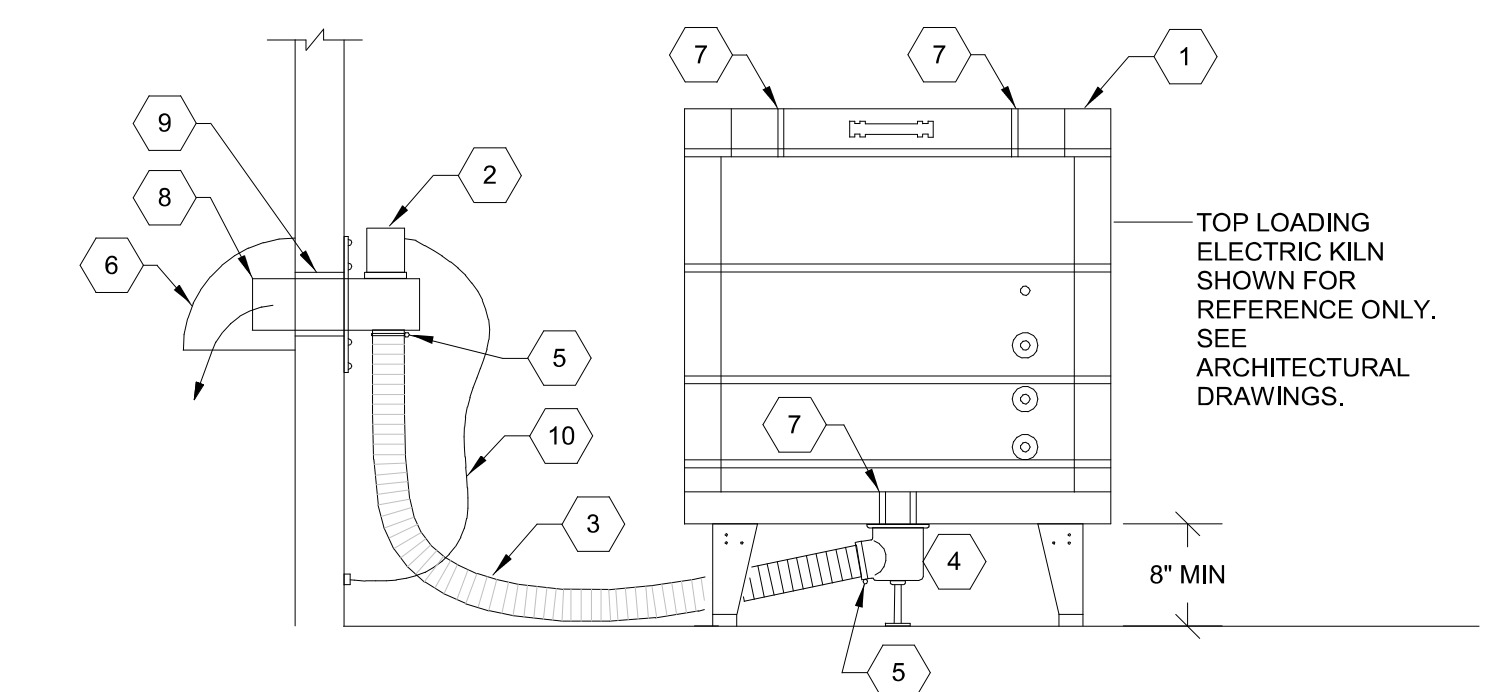

- 1 TOP LOADING 12 CUBIC FOOT (OR SMALLER) ELECTRIC KILN - SEE ARCH DWGS FOR MANUFACTURER AND MODEL NUMBER
- 2 BLOWER WITH MOTOR: - 115/60/1 MOTOR, 1.4 AMPS - 6 FT POWER CORD WITH IN-LINE SWITCH - 140 CFM - 8"x12" WALL MOUNTING PLATE
- 3 FLEXIBLE EXHAUST HOSE: - TRIPLE PLY LAMINATE, ALUMINIZED POLYESTER FACE AND AN ALUMINUM FOIL BACKING - CORROSION, MOISTURE, TEMPERATURE (250°F), AND FLAME RESISTANT - 3" DIAMETER, 9 FOOT MAX LENGTH - FLEXIBLE HOSE FASTENED BY PLASTIC HOSE CLAMPS (QTY=2)
- 4 SPRING LOADED PLENUM CUP ASSEMBLY
- 5 HOSE CLAMP
- 6 RAIN HOOD OR VENT
- 7 DRILLED OPENINGS THRU LID AND DECK OF KILN PER FAN MANUFACTURER'S INSTALLATION INSTRUCTIONS
- 8 DISCHARGE TUBE
- 9 3-1/8" CUTOUT IN WALL
- 10 115V CORDSET W/SWITCH


NOTE:
KILN VENT TO BE SKUTT ENVIROVENT 2 WITH ENVIROLINK CONTROLLER. INSTALL ALL COMPONENTS PER MANUFACTURER'S REQUIREMENTS.

C4 KILN VENTING DETAIL
SCALE = NONE

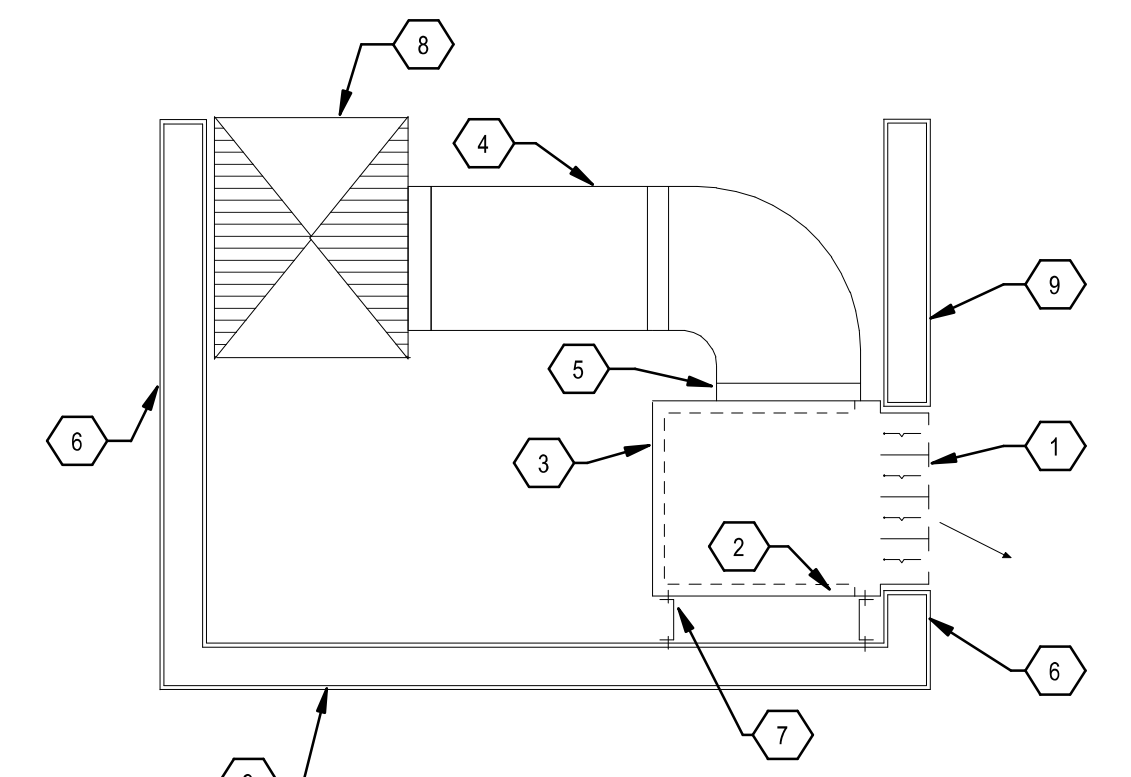

- 1 SLOT DIFFUSER. SEE PLANS FOR NUMBER OF SLOTS AND LENGTH
- 2 INTERNAL INSULATION
- 3 FACTORY PLENUM
- 4 BRANCH RUNOUT. SEE PLANS FOR SIZE
- 5 ROUND INLET
- 6 SOFFIT. SEE ARCH. DWGS. FOR CONSTRUCTION
- 7 PLENUM SUPPORT MOUNTED PLENUM AND ARCH. FRAMING
- 8 SUPPLY DUCT. SEE PLANS FOR SIZE
- 9 ARCHITECTURAL ENCLOSURE. SEE ARCH DWGS.

B4 SIDEWALL LINEAR DIFFUSER DETAIL
SCALE = NONE

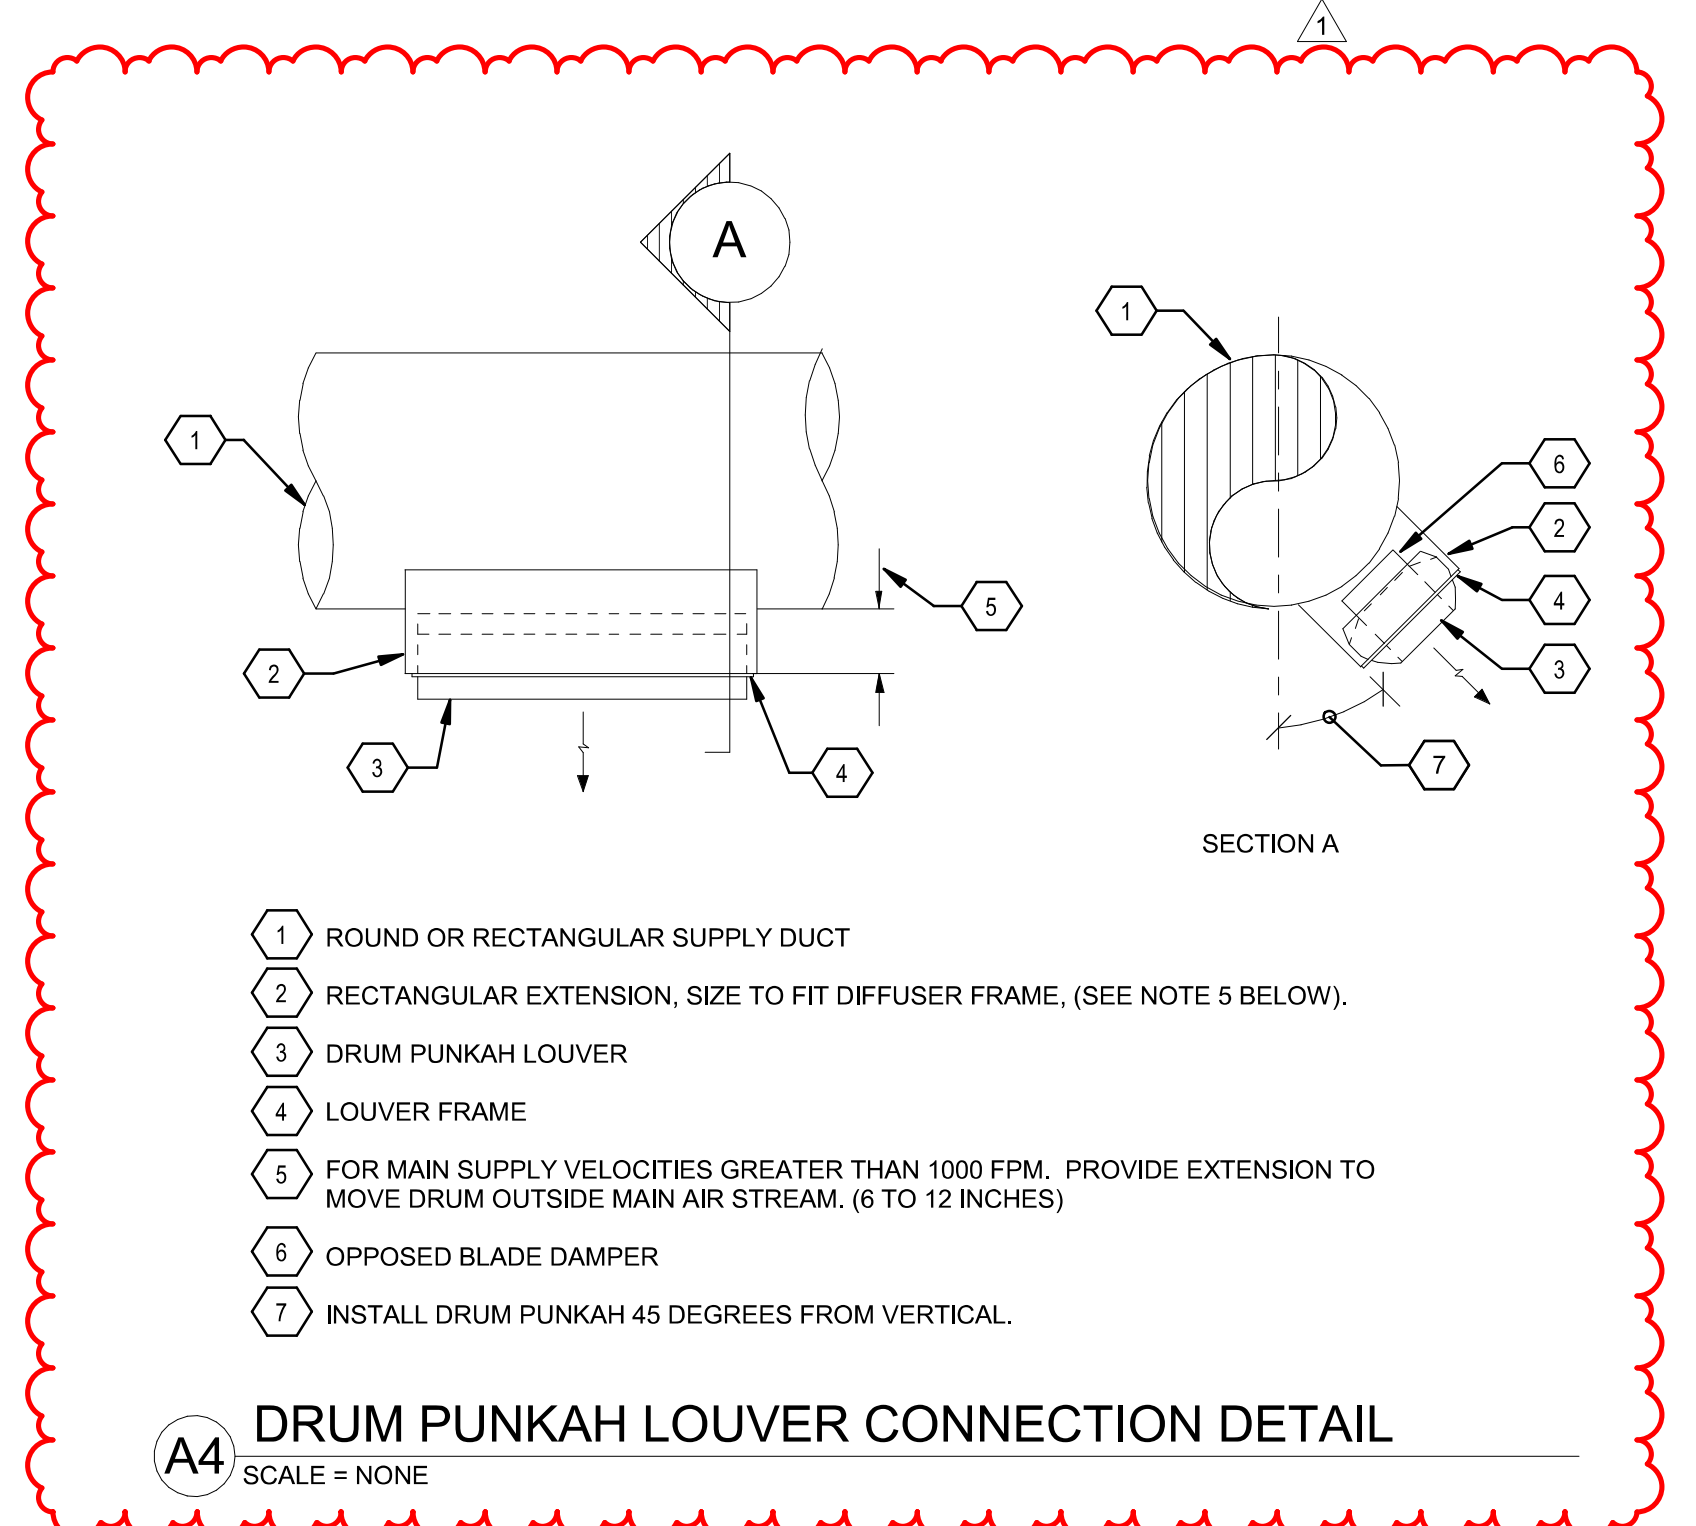

- 1 ROUND OR RECTANGULAR SUPPLY DUCT
- 2 RECTANGULAR EXTENSION, SIZE TO FIT DIFFUSER FRAME. (SEE NOTE 5 BELOW).
- 3 DRUM PUNKAH LOUVER
- 4 LOUVER FRAME
- 5 FOR MAIN SUPPLY VELOCITIES GREATER THAN 1000 FPM. PROVIDE EXTENSION TO MOVE DRUM OUTSIDE MAIN AIR STREAM. (6 TO 12 INCHES)
- 6 OPPOSED BLADE DAMPER
- 7 INSTALL DRUM PUNKAH 45 DEGREES FROM VERTICAL.

A4 DRUM PUNKAH LOUVER CONNECTION DETAIL
SCALE = NONE



JON ANDERSON ARCHITECTURE
912 ROMA AVE NW | ALBUQUERQUE, NEW MEXICO
P. 1.505.764.8306 F. 1.505.764.2879
www.jonandersonarchitecture.com



SANDIA BASE ELEMENTARY



BRIDGERS & PAXTON
4600 C. Montgomery Blvd. NE
Albuquerque, NM 87109 | 505.863.4111 | www.bpc.com



REVISIONS	Revision #	Date	Revision Description
	1	12.19.22	Addendum 2

PHASE DATE
100% CD 11.04.22




M-502
MECHANICAL DETAILS

architecture + design
JON ANDERSON ARCHITECTURE
 912 ROMA AVE NW | ALBUQUERQUE, NEW MEXICO
 P 505.764.8396 F 505.764.8279 www.jonandersonarchitecture.com


SANDIA BASE ELEMENTARY
 4600 C. Montgomery Blvd. NE
 Albuquerque, NM 87109 | 505.863.4111 www.spcc.com



BRIDGERS & PAXTON
 1219/2022 Projects/8331_SBES_MEP_Imoghera@spcc.com.nx
 12/19/2022 1:27:43 PM

REVISIONS	Revision #	Date	Revision Description
1	12-19-22	12-19-22	Addendum 2

PHASE DATE
100% CD 11.04.22



ALIR MESTI
20505
Professional Engineer

M-701
MECHANICAL SCHEDULES

SYMBOL	VALENT MODEL NO.	SUPPLY FAN				EXHAUST FAN				DX COOLING COIL PERFORMANCE				HEATING PERFORMANCE- FORCE-DRAFT INDIRECT GAS FURNACE					SUMMER OPERATION				HEATING OPERATION				ELECTRICAL DATA		SOUND POWER BY OCTAVE BAND								WEIGHT (LBS.)					
		AIRFLOW (CFM)	EXT. SP (IN. WC)	FAN RPM	FAN BHP	AIRFLOW (CFM)	EXT. SP (IN. WC)	FAN RPM	FAN BHP	REFRIG TYPE	TOTAL CAPACITY (MBH)	SENSIBLE CAPACITY (MBH)	LAT DB	LAT WB	INPUT @ SEA LEVEL (MBH)	OUTPUT (MBH)	LAT DB	FURNACE CONTROLS	GAS TYPE	EAT DB	EAT WB	LAT WB	LAT WB	FLAT PLATE HEAT EXCHANGER PERFORMANCE OUTSIDE AIR	FLAT PLATE HEAT EXCHANGER PERFORMANCE EXHAUST AIR	FLAT PLATE HEAT EXCHANGER PERFORMANCE OUTSIDE AIR	FLAT PLATE HEAT EXCHANGER PERFORMANCE EXHAUST AIR	TYPE	V/PH/Hz	MCA (A)	MOP (A)	63Hz	125Hz	250Hz	500Hz	1000Hz		2000Hz	4000Hz	8000Hz		
		DOAS-1	VPRP-210-8F-20I-C-1GC	3,600	1.0	2000	2.36	3	3,600	0.8	1896	2	3	R410A	81.2	56.9	51.4	NATURAL GAS	200	141	83.2	MODULATING 5:1	96	82	72	82	12	47	72	47	MERV 13	460/360	25.3	35	92	90		92	88	88	84	81
DOAS-2	VPRP-310-25C-60I-C-1DC	8,000	1.5	1610	6.67	10	8,000	1.0	2087	2.67	3	R410A	263.7	245.8	47.4	46.6	NATURAL GAS	600	424	96.8	MODULATING 5:1	96	81.6	72	81.6	12	47.9	72	47.9	MERV 13	460/360	79.1	90	81	84	91	93	89	84	81	74	7,500
DOAS-3	VPRP-110-5C-10I-C-1DC	1,400	1.6	2236	.94	1.5	1,400	1.0	1755	.48	.75	R410A	54.8	46.5	43.6	43.1	NATURAL GAS	100	71	97.3	MODULATING 5:1	96	80.5	72	80.5	12	50.7	72	50.7	MERV 13	460/360	18.7	25	84	81	92	87	88	88	79	76	4,000
DOAS-4	VPRP-210-16F-40I-C-1GC	6,800	1.5	1657	6.15	7.5	6,800	1.0	2293	3.13	5	R410A	178.1	170.1	54.6	58.5	NATURAL GAS	400	283	84.2	MODULATING 5:1	96	82.5	72	82.5	12	45.8	72	45.8	MERV 13	460/360	55.7	60	83	85	90	86	83	85	73	71	5,600
DOAS-5	VPRP-210-16F-40I-C-1GC	6,800	1.5	1657	6.15	7.5	6,800	1.0	2293	3.13	5	R410A	170.1	170.1	54.6	50.5	NATURAL GAS	400	283	84.2	MODULATING 5:1	96	82.5	72	82.5	12	45.8	72	45.8	MERV 13	460/360	55.7	60	83	85	90	86	83	85	73	71	5,500

PROVIDE 24" TALL VIBRATION ISOLATION CURB PER DETAIL C3/M-502. LOW LEAKAGE DAMPER, SINGLE POINT CONNECTION, NON-POWERED CONVENIENCE OUTLET, STARTER/DISCONNECT. SEE SPECIFICATION 23 7200.

SYMBOL	AAON MODEL NO.	TYPE	AREA SERVED	SUPPLY FAN				COOLING PERFORMANCE				GAS HEAT EXCHANGER				FILTER TYPE	ELECTRICAL												
				CFM	FAN RPM	EXT. SP (IN. WC)	FAN BHP	NOMINAL CAPACITY (TONS)	EER @ ARI	GROSS TOTAL COOLING (MBH)	GROSS SENSIBLE COOLING (MBH)	EAT DB (°F)	EAT WB (°F)	LAT DB (°F)	LAT WB (°F)		HEATING INPUT AT SEA LEVEL (MBH)	HEATING OUTPUT AT ALTITUDE (MBH)	EAT DB (°F)	LAT DB (°F)	MINIMUM OUTSIDE AIR (CFM)	REFRIG. TYPE	OPERATING WEIGHT (LBS.)	V	PH	Hz	MCA	MOP	
RTU-1	RN-025-3-0-EA09-5CB	VERTICAL SUPPLY/ VERTICAL RETURN	132 GYMNASIUM	10,000	1852	1.0	9.52	10	25	11.4	270.38	270.38	82	60	54	50	540	354.1	40.1	80.1	2000	MERV 13	R410A	3,500	460	3	60	61	70
RTU-2	RN-025-3-0-EA09-5CB	VERTICAL SUPPLY/ VERTICAL RETURN	133 CAFETERIA	10,000	1852	1.0	9.52	10	25	11.4	270.38	270.38	82	60	54	50	540	354.1	40.1	80.1	4000	MERV 13	R410A	3,500	460	3	60	61	70
RTU-3	RN-010-3-0-EA09-5KB	VERTICAL SUPPLY/ VERTICAL RETURN	134 KITCHEN	4,000	2117	0.5	2.9	3	10	11.7	97.63	97.63	77	56	52	46	150	98.4	64.2	92.1	350	MERV 13	R410A	2,000	460	3	60	27	40
RTU-4	RQ-004-9-V-EA09-53B	VERTICAL SUPPLY/ VERTICAL RETURN	133A STAIRS	1,600	1858	0.5	0.86	1	4	13.3	43.56	40.97	80	57	50	46	100	66.4	44	91	560	MERV 13	R410A	1,200	208	1	60	36	50

PROVIDE INLET HOOD, STD REFRIG CONTROLS, FROSTAT AND CRANKCASE HEATER, PACKAGED LOW VOLT CONTROLS, 100% ECONOMIZER - DRY BULB, COMMUNICATIONS, STD. CONDENSOR COIL W/ HAIL GUARD, NON-POWERED CONVENIENCE OUTLET, STARTER/DISCONNECT. RTU-1, RTU-2, RTU-4: 24" TALL VIBRATION ISOLATION CURB PER DETAIL C3/M-502. RTU-3: STANDARD 24" TALL ROOF CURB.

SYMBOL	VIBRO-ACOUSTICS MODEL NO.	LOCATION	DIMENSIONS WxHxL (INCH)	AIR VOLUME (CFM)	VELOCITY (FPM)	PD (IN.WG)	MINIMUM/MAXIMUM DYNAMIC INSERTION LOSS (dB)							
							63 HZ	125 HZ	250 HZ	500 HZ	1000 HZ	2000 HZ	4000 HZ	8000 HZ
							SA-1	RED-HV-F5	DOAS-1 SUPPLY	22 X 22 X 36	3600	1071	0.16	5/59
SA-2	RED-MV-F7	FC3-04 SUPPLY	18 X 18 X 36	1410	628	0.11	5/52	9/37	12/32	21/31	25/29	22/26	18/19	17/24
SA-3	RD-MLV-F6	FC3-05 SUPPLY	20 X 12 X 48	1410	847	0.15	5/47	9/40	17/34	29/33	34/33	21/33	14/24	10/22
SA-4	RED-MHV-F9	FC5-01 SUPPLY	26 X 14 X 48	2540	1006	0.19	5/58	8/46	13/38	20/36	31/37	33/37	25/29	21/24
SA-5	RMB-MV-F9	DOAS-5 SUPPLY	24 X 32 X 36	5400	1013	0.11	4/52	6/47	13/43	23/46	33/49	24/51	15/39	10/27
SA-6	BMB-MHV-F1	DOAS-4 SUPPLY	30 X 30 X 36	6800	1088	0.09	4/53	8/48	12/47	13/47	15/49	13/45	12/33	11/25
SA-7	REMB-MV-F8	RTU-4 SUPPLY	16 X 16 X 48	1600	900	0.2	6/52	11/43	17/41	24/43	32/41	33/35	25/26	19/27
SA-8	RMB-MV-F6	DOAS-2 EXHAUST	40 X 20 X 36	8000	1440	0.21	4/55	7/54	12/50	19/52	24/55	18/57	12/48	8/35

ALL SELECTIONS ARE BASED ON 5300 FT. ABOVE SEA LEVEL.

SYMBOL	MITSUBISHI INDOOR MODEL NUMBER	AREA SERVED	TYPE	REFRIG TYPE	AIRFLOW (CFM)	COOLING CAPACITY (BTUH)	HEATING CAPACITY (BTUH)	EAT DB (°F)	EAT WB (°F)	SOUND LEVEL (dBA)	EER/SEER	MOTOR DATA			WEIGHT (LBS.)	HEIGHT / WIDTH / DEPTH (IN)
												VOLT	PH	Hz		
AC-1	PKA-A36KA7 (CO)	116 IDF	COOLING ONLY	R-410A	920	36,000	N/A	80	67	49	10.8/18.8	208	1	60	46	46-1/16" X 11-5/8" X 14-3/8"
AC-2	PKA-A12HA7 (CO)	115 ELEC	COOLING ONLY	R-410A	425	12,000	N/A	80	67	43	12.0/20.8	208	1	60	30	35-3/8" X 9-13/16" X 11-5/8"
AC-3	PKA-A36KA7	202 IDF	HEAT PUMP	R-410A	920	36,000	38,000	80	67	49	10.8/18.8	208	1	60	46	46-1/16" X 11-5/8" X 14-3/8"
AC-4	PKA-A12HA7	201 ELEC	HEAT PUMP	R-410A	425	12,000	14,000	80	67	43	12.0/20.8	208	1	60	30	35-3/8" X 9-13/16" X 11-5/8"
AC-5	PKA-A24KA7	146 MAIN ELECTRICAL	HEAT PUMP	R-410A	775	24,000	26,000	80	67	45	12.2/21.4	208	1	60	46	46-1/16" X 11-5/8" X 14-3/8"
AC-6	PKA-A36KA7 (CO)	133E IDF	COOLING ONLY	R-410A	920	36,000	N/A	80	67	49	10.8/18.8	208	1	60	46	46-1/16" X 11-5/8" X 14-3/8"
AC-7	PKA-A12HA7	223 ELEC	HEAT PUMP	R-410A	425	12,000	14,000	80	67	43	12.0/20.8	208	1	60	30	35-3/8" X 9-13/16" X 11-5/8"
AC-8	PKA-A36KA7 (CO)	219 IDF	COOLING ONLY	R-410A	920	36,000	N/A	80	67	49	10.8/18.8	208	1	60	46	46-1/16" X 11-5/8" X 14-3/8"
AC-9	PKA-A36KA7	152 IDF	HEAT PUMP	R-410A	920	36,000	38,000	80	67	49	10.8/18.8	208	1	60	46	46-1/16" X 11-5/8" X 14-3/8"
AC-10	PKA-A36KA7	228 IDF	HEAT PUMP	R-410A	920	36,000	38,000	80	67	49	10.8/18.8	208	1	60	46	46-1/16" X 11-5/8" X 14-3/8"
AC-11	PEAD-A09AA7	134B OFFICE	HEAT PUMP	R-410A	320	9,000	11,400	80	67	28	12.5/19.4	208	1	60	60	35-7/16" X 28-7/8" X 9-7/8"
AC-12	PEAD-A18AA7	132A OFFICE	HEAT PUMP	R-410A	600	18,000	19,000	80	67	37	10.8/19.9	208	1	60	31	35-7/16" X 28-7/8" X 9-7/8"
AC-13	PEAD-A18AA7	ST-3 STAIRS	HEAT PUMP	R-410A	600	18,000	19,000	80	67	37	10.8/19.9	208	1	60	31	35-7/16" X 28-7/8" X 9-7/8"

INDOOR UNIT SHALL BE ELECTRICALLY SERVED FROM THE OUTDOOR UNIT PER THE MANUFACTURER'S ELECTRICAL REQUIREMENTS AND DIAGRAMS. PROVIDE REFRIGERANT PIPING AND ALL ACCESSORIES FOR A COMPLETE AND FUNCTIONAL SYSTEM PER MANUFACTURER'S INSTALLATION MANUAL. PROVIDE WALL MOUNTED, HARD-WIRED T-STAT, CONDENSATE LIFT PUMP.

SYMBOL	MITSUBISHI MODEL NUMBER	LOCATION	INDOOR UNIT SERVED	TYPE	RATED CAPACITY (BTUH)	AMBIENT DB (F)	COMPRESSOR DATA				ELECTRICAL DATA				SOUND POWER (dBA)	WEIGHT (LBS)	WIDTH X DEPTH X HEIGHT (IN.)		
							REFRIG. TYPE	MAX PIPING LENGTH	LIQUID SIZE	SUCTION SIZE	VOLTS	PH	Hz	MCA				MOP	
C-1	PUY-A36NKA7	ROOF	AC-1	COOLING ONLY	36,000	95	INVERTOR	R-410A	225"	3/8"	5/8"	208	1	60	25	31	52	210	41-5/16" X 14-3/16" X 52-11/16"
C-2	PUY-A12NKA7	ROOF	AC-2	COOLING ONLY	12,000	95	INVERTOR	R-410A	165"	1/4"	1/2"	208	1	60	11	28	44	95	34-1/4" X 11-13/16" X 24-13/16"
C-3	PUZ-A36NKA7	ROOF	AC-3	HEAT PUMP	36,000	95	INVERTOR	R-410A	165"	3/8"	5/8"	208	1	60	25	31	52	215	41-5/16" X 14-3/16" X 52-11/16"
C-4	PUZ-A12NKA7	ROOF	AC-4	HEAT PUMP	12,000	95	INVERTOR	R-410A	100"	1/4"	1/2"	208	1	60	11	28	44	95	34-1/4" X 11-13/16" X 24-13/16"
C-5	PUZ-A24NKA7	ROOF	AC-5	HEAT PUMP	24,000	95	INVERTOR	R-410A	165"	3/8"	5/8"	208	1	60	19	26	48	160	37-13/32" X 14-3/16" X 37-1/8"
C-6	PUY-A36NKA7	ROOF	AC-6	COOLING ONLY	36,000	95	INVERTOR	R-410A	225"	3/8"	5/8"	208	1	60	25	31	52	210	41-5/16" X 14-3/16" X 52-11/16"
C-7	PUZ-A12NKA7	ROOF	AC-7	HEAT PUMP	12,000	95	INVERTOR	R-410A	100"	1/4"	1/2"	208	1	60	11	28	44	95	34-1/4" X 11-13/16" X 24-13/16"
C-8	PUY-A36NKA7	ROOF	AC-8	COOLING ONLY	36,000	95	INVERTOR	R-410A	225"	3/8"	5/8"	208	1	60	25	31	52	210	41-5/16" X 14-3/16" X 52-11/16"
C-9	PUZ-A36NKA7	ROOF	AC-9	HEAT PUMP	36,000	95	INVERTOR	R-410A	165"	3/8"	5/8"	208	1	60	25	31	52	215	41-5/16" X 14-3/16" X 52-11/16"
C-10	PUZ-A36NKA7	ROOF	AC-10	HEAT PUMP	36,000														

VRF HEAT RECOVERY BRANCH CIRCUIT CONTROLLER table with columns: SYMBOL, SYSTEM, MODEL NUMBER, NUMBER OF PORTS, CONNECTED CAPACITY, V/PH/Hz. Rows include BS1-1 through BS9-1.

INCLUDE DIAMONDBACK BALL VALVES BV-SERIES, 700PSIG WORKING PRESSURE, FULL PORT, 410A RATED.

MITSUBISHI ELECTRIC TRANE HVAC US: CITY MULTI VRF OUTDOOR UNIT SCHEDULE table with columns: SYMBOL, MODEL NUMBER, MODULES, NOMINAL COOLING CAPACITY, NOMINAL HEATING CAPACITY, COOLING EFFICIENCY, HEATING COP, etc.


EFFICIENCY VALUES FOR EER, IEER, COP ARE BASED ON AHRI 1230 TEST METHOD FOR MIXTURE OF DUCTED & NON-DUCTED INDOOR UNITS. FOR SYSTEMS WITH MULTIPLE MODULES, REFRIGERANT PIPE DIMENSIONS INDICATE TOTAL SYSTEM COMBINED PIPING DOWNSTREAM OF MODULE TWINNING.

MITSUBISHI ELECTRIC TRANE HVAC US: CITY MULTI VRF INDOOR UNIT SCHEDULE table with columns: SYMBOL, MODEL, NOMINAL COOLING CAPACITY, NOMINAL HEATING CAPACITY, COOLING DESIGN ENTERING TEMP, HEATING DESIGN ENTERING TEMP, CORRECTED CAPACITY (COOLING, HEATING, TOTAL), ESTIMATED COOLING COIL, ESTIMATED HEATING COIL, REFRIG PIPE SIZE, PEAK FAN AIRFLOW, SOUND PRESSURE, V/PH/Hz, ELECTRICAL MCA/MFS.


ALL SELECTIONS ARE BASED ON 5300 FT. ABOVE SEA LEVEL.

SEE OUTDOOR UNIT SCHEDULE FOR OUTDOOR AMBIENT CONDITIONS, CONNECTED CAPACITY, AND OTHER FACTORS ASSOCIATED WITH CORRECTED CAPACITIES. SEE SCHEMATIC PIPING/CONTROL DIAGRAM FOR INDICATION OF REQUIRED INDOOR UNIT REMOTE CONTROLLERS, SYSTEM CONTROLLERS, AND INTEGRATION DEVICES.

EXHAUST FANS table with columns: SYMBOL, GREENHECK MODEL NO., LOCATION, AREA SERVED, TYPE, CFM, S.P. (IN. WC), FAN RPM, BHP, MOTOR DATA (HP, VOLT, PH, HZ, FLA), INLET SOUND POWER BY OCTAVE BAND (63 Hz to 8000 Hz), OPERATING WEIGHT (LBS.), NOTES.

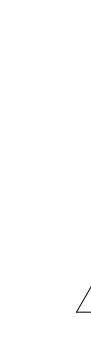

JON ANDERSON ARCHITECTURE 912 ROMA AVE NW | ALBUQUERQUE, NEW MEXICO P 505.764.8306 F 505.764.2879 www.jonandersonarchitecture.com

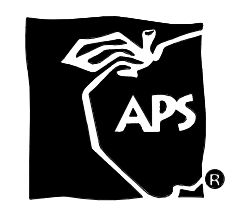

SANDIA BASE ELEMENTARY




BRIDGERS & PAXTON

4600 C. Montgomery Blvd. NE Albuquerque, NM 87109 | 505.863.4111 | www.jpce.com

REVISIONS Table header

REVISIONS table with columns: Revision #, Date, Revision Description. Includes entries for 1, 2, and 3.

PHASE DATE 100% CD 11.04.22

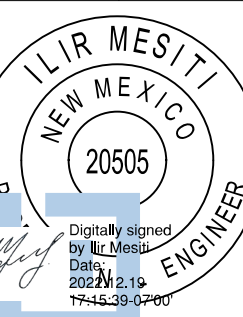

M-702 MECHANICAL SCHEDULES

**100% Outdoor air
DOAS-1**

Show simple view

System name and number	DOAS-1
Condition analyzed (Impacts Etc)	Heating

Zone Name and Number	Occupancy Category	Zone Floor Area Az (sq ft)	Are you using default value for zone population?	Zone Population Pz (people)	Zone Air Distribution Effectiveness Et	Zone Outdoor Airflow Voz (cfm)	Zone Outdoor Airflow Provided (measured or design) (cfm)
100B Hallway	Corridors	1,700	Yes	0.00	1.00	132.60	150
120 Kindergarten Kitchen	Classrooms (ages 5-8)	800	No	22.00	1.00	380.53	450
121 Kindergarten	Classrooms (ages 5-8)	1,200	No	22.00	1.00	473.30	480
122 Kindergarten	Classrooms (ages 5-8)	1,200	No	22.00	1.00	473.30	480
123 Kindergarten	Classrooms (ages 5-8)	1,200	No	22.00	1.00	473.30	480
117 Kindergarten	Classrooms (ages 5-8)	1,200	No	22.00	1.00	473.30	480
118 Kindergarten	Classrooms (ages 5-8)	1,200	No	22.00	1.00	473.30	480
119 Kindergarten	Classrooms (ages 5-8)	1,200	No	22.00	1.00	473.30	480
						0.00	

System area (sq ft)	As	(sq ft)	5,506.00
System population	Ps	(people)	154.00
Outdoor air intake flow (30% above 62.1 requirement)	Vof	(cfm)	3,352
Outdoor air intake flow provided (measured or design)		(cfm)	3,480

**100% Outdoor air
DOAS-2**

Show simple view

System name and number	DOAS-2
Condition analyzed (Impacts Etc)	Heating

Zone Name and Number	Occupancy Category	Zone Floor Area Az (sq ft)	Are you using default value for zone population?	Zone Population Pz (people)	Zone Air Distribution Effectiveness Et	Zone Outdoor Airflow Voz (cfm)	Zone Outdoor Airflow Provided (measured or design) (cfm)
200a Corridor	Corridors	2,870	Yes	0.00	1.00	223.86	260
204 Gen Storage	Storage rooms	271	Yes	0.00	1.00	42.27	50
205 Breakout	Conference / meeting	500	No	24.00	1.00	195.00	200
206 5th	Classrooms (age 5 plus)	860	No	26.00	1.00	473.16	480
206 6th	Classrooms (age 6 plus)	860	No	26.00	1.00	473.16	480
207 6th	Classrooms (age 6 plus)	860	No	26.00	1.00	473.16	480
208 6th	Classrooms (age 6 plus)	860	No	26.00	1.00	473.16	480
214 Books	Occupiable storage rooms for dry materials	340	No	0.00	1.00	26.52	50
213 Music	Main / Rehearsal dance	1,223	No	26.00	1.00	433.00	480
209 Copy Room	Office space	800	No	8.00	1.00	102.70	230
212 Media Center	Media center	1,900	No	40.00	1.00	678.40	620
311 Computer Research	Computer lab	400	No	18.00	1.00	298.40	300
215 Workrooms	Office space	150	No	2.00	1.00	26.70	100
216a Storage	Storage rooms	200	Yes	0.00	1.00	31.20	50
216b Office	Office space	140	No	2.00	1.00	23.00	50
95 Reading Area	Media center	880	No	24.00	1.00	418.08	420
134 Lab	Storage rooms	800	Yes	0.00	1.00	48.40	60
131 Art	Art classroom	1,200	No	26.00	1.00	618.80	620
100B Corridor	Corridors	1,000	Yes	0.00	1.00	81.90	220
130 Computer Lab	Computer lab	800	No	32.00	1.00	543.60	550
130a COW	Storage rooms	110	Yes	0.00	1.00	17.16	50
130 Tech	Office space	100	No	2.00	1.00	22.36	50
150 STEM	Classrooms (age 5 plus)	1,270	No	26.00	1.00	538.12	540
128 Lounge	Break rooms (panes)	600	No	30.00	1.00	290.94	280
200B Corridor	Corridors	1,215	Yes	0.00	1.00	94.77	100
218 Hall	Office space	160	No	2.00	1.00	29.44	50
217 Meeting	Conference / meeting	150	No	2.00	1.00	24.70	70
100a Corridor/Lobby	Main entry lobbies	3,170	No	20.00	1.00	377.26	380

System area (sq ft)	As	(sq ft)	23,151.00
System population	Ps	(people)	368.00
Outdoor air intake flow (30% above 62.1 requirement)	Vof	(cfm)	7,171
Outdoor air intake flow provided (measured or design)		(cfm)	7,550

**100% Outdoor air
DOAS-4**

Show simple view

System name and number	DOAS-4
Condition analyzed (Impacts Etc)	Heating

Zone Name and Number	Occupancy Category	Zone Floor Area Az (sq ft)	Are you using default value for zone population?	Zone Population Pz (people)	Zone Air Distribution Effectiveness Et	Zone Outdoor Airflow Voz (cfm)	Zone Outdoor Airflow Provided (measured or design) (cfm)
153 Breakout	Conference / meeting	270	No	24.00	1.00	177.06	180
161 Breakout	Conference / meeting	470	No	24.00	1.00	192.66	200
161 Corridor-1st	Corridors	3,280	Yes	0.00	1.00	258.84	290
160 1st	Classrooms (ages 5-8)	850	No	26.00	1.00	470.60	480
159 1st	Classrooms (ages 5-8)	850	No	26.00	1.00	470.60	480
158 1st	Classrooms (ages 5-8)	850	No	26.00	1.00	470.60	480
157 Sp Ed	Classrooms (ages 5-8)	850	No	26.00	1.00	470.60	480
156 Sp Ed	Classrooms (ages 5-8)	850	No	26.00	1.00	470.60	480
155 2nd	Classrooms (ages 5-8)	850	No	26.00	1.00	470.60	480
154 2nd	Classrooms (ages 5-8)	850	No	26.00	1.00	470.60	480
153 Sp Ed	Classrooms (ages 5-8)	850	No	26.00	1.00	470.60	480
152 Sp Ed	Classrooms (ages 5-8)	850	No	26.00	1.00	470.60	480
149 2nd	Classrooms (ages 5-8)	850	No	26.00	1.00	470.60	480
148 2nd	Classrooms (ages 5-8)	850	No	26.00	1.00	470.60	480
147 1st	Classrooms (ages 5-8)	850	No	26.00	1.00	470.60	480
143 Parent Workroom	Conference / meeting	590	No	0.00	1.00	65.02	90

System area (sq ft)	As	(sq ft)	14,810.00
System population	Ps	(people)	368.00
Outdoor air intake flow (30% above 62.1 requirement)	Vof	(cfm)	6,357
Outdoor air intake flow provided (measured or design)		(cfm)	6,490

**100% Outdoor air
DOAS-5**

Show simple view

System name and number	DOAS-5
Condition analyzed (Impacts Etc)	Heating

Zone Name and Number	Occupancy Category	Zone Floor Area Az (sq ft)	Are you using default value for zone population?	Zone Population Pz (people)	Zone Air Distribution Effectiveness Et	Zone Outdoor Airflow Voz (cfm)	Zone Outdoor Airflow Provided (measured or design) (cfm)
220 Inst Therapy	Conference / meeting	540	No	6.00	1.00	81.12	120
222 EP	Conference / meeting	190	No	0.00	1.00	53.82	60
224 4th	Classrooms (age 9 plus)	870	No	26.00	1.00	473.72	480
223 Sp Ed	Classrooms (age 9 plus)	870	No	26.00	1.00	473.72	480
229 Sp Ed	Classrooms (age 9 plus)	870	No	26.00	1.00	473.72	480
227 3rd	Classrooms (age 9 plus)	870	No	26.00	1.00	473.72	480
228 3rd	Classrooms (age 9 plus)	870	No	26.00	1.00	473.72	480
231 3rd	Classrooms (age 9 plus)	850	No	26.00	1.00	470.60	480
232 3rd	Classrooms (age 9 plus)	850	No	26.00	1.00	470.60	480
233 3rd	Classrooms (age 9 plus)	850	No	26.00	1.00	470.60	480
234 Sp Ed	Classrooms (age 9 plus)	850	No	26.00	1.00	470.60	480
236 4th	Classrooms (age 9 plus)	850	No	26.00	1.00	470.60	480
235 4th	Classrooms (age 9 plus)	850	No	26.00	1.00	470.60	480
237 4th	Classrooms (age 9 plus)	850	No	26.00	1.00	470.60	480
221 Inst Special Ed	Office space	150	Yes	4.00	1.00	36.53	50
200B Hallway	Corridors	3,390	Yes	0.00	1.00	263.64	290
238 Breakout	Conference / meeting	480	No	24.00	1.00	193.44	195
230 Breakout	Conference / meeting	290	No	24.00	1.00	178.62	180

System area (sq ft)	As	(sq ft)	15,315.00
System population	Ps	(people)	376.00
Outdoor air intake flow (30% above 62.1 requirement)	Vof	(cfm)	6,489
Outdoor air intake flow provided (measured or design)		(cfm)	6,830

**100% Outdoor air
DOAS-3**

Show simple view

System name and number	DOAS-3
Condition analyzed (Impacts Etc)	Heating

Zone Name and Number	Occupancy Category	Zone Floor Area Az (sq ft)	Are you using default value for zone population?	Zone Population Pz (people)	Zone Air Distribution Effectiveness Et	Zone Outdoor Airflow Voz (cfm)	Zone Outdoor Airflow Provided (measured or design) (cfm)
308 Hallway	Corridors	600	Yes	0.00	1.00	46.80	50
101 Waiting	Reception areas	360	No	16.00	1.00	133.64	140
118 Records	Office space	200	No	1.00	1.00	22.10	50
101 Reception	Reception areas	200	No	2.00	1.00	28.60	50
108 Secure entry	Corridors	158	Yes	0.00	1.00	12.56	50
108 Psych	Office space	160	No	2.00	1.00	25.48	50
107 Courtyard	Office space	280	No	4.00	1.00	47.84	50
106 Counselor	Office space	280	No	4.00	1.00	47.84	50
106 Radrock	Office space	160	No	2.00	1.00	25.48	50
104 Dean	Office space	160	No	2.00	1.00	25.48	50
111 MPL	Conference / meeting	280	No	6.00	1.00	60.84	70
102 Principal	Office space	250	No	4.00	1.00	48.56	50
103 Secretary	Office space	150	No	2.00	1.00	22.36	50
125 Teachers Workroom	Office space	640	No	8.00	1.00	101.92	230
111 Conference	Conference / meeting	305	No	14.00	1.00	114.76	130
114a Covid	Office space	110	No	1.00	1.00	15.08	50
114b Treatment	Office space	170	No	2.00	1.00	26.26	70
114a Nurse Office	Office space	125	No	2.00	1.00	22.75	50
114 Nurse	Office space	220	No	6.00	1.00	56.16	80
114a Nurse Storage	Storage rooms	45	Yes	0.00	1.00	7.32	50
						0.00	

System area (sq ft)	As	(sq ft)	4,840.00
System population	Ps	(people)	79.00
Outdoor air intake flow (30% above 62.1 requirement)	Vof	(cfm)	885
Outdoor air intake flow provided (measured or design)		(cfm)	1,400

D:\Revit\2022\Projects\6331_SBES_MEP_Imagery\@Dose.com.rvt

JON ANDERSON ARCHITECTURE
 912 ROMA AVE NW | ALBUQUERQUE, NEW MEXICO
 P. 505.764.8306 | F. 505.764.2879 | www.jonandersonarchitecture.com

SANDIA BASE ELEMENTARY

BRIDGERS & PAXTON
 4600 G. Montgomery Blvd. NE
 Albuquerque, NM 87109 | 505.863.4111 | www.spce.com

REVISIONS
 Revision # | Date | Revision Description
 1 | 12.19.22 | Addendum 2

PHASE DATE
 100% CD 11.04.22

M-801
 IAQ CALCULATIONS

ILIR MESTI
 20505
 Professional Engineer

SECTION 32 14 14

PRESSED CONCRETE PAVERS

PART 1 GENERAL

1.1 SUMMARY

- A. Section included hydraulically pressed concrete pavers for outdoor roof terrace adjacent to Copy Room 209.
- B. Related Sections:
 - A. Section 07 56 00 – Fluid Applied Roofing: Waterproofing roof membrane and protection board for installation of concrete pavers specified in this Sections.

1.2 SUBMITTALS

- A. Submit in accordance with Section 01 33 00 – Submittal Procedures:
 - A. Product data for concrete pavers, pedestals, and accessories.
 - B. Shop drawings showing layout, method of installation, and junctures with adjacent materials.
 - C. Samples:
 - a. Manufacturer’s color sample of each unit paver showing expected color and texture.
 - b. Pedestals, shims, and metal anchors.
 - D. Installation instructions and maintenance data.

1.3 QUALITY ASSURANCE

- A. Installer: Company experienced in installing concrete pavers and having successfully completed one project of similar scope.
- B. All materials and products for concrete pavers shall be provided from a single source.

1.4 PRE-INSTALLATION CONFERENCE

- A. In accordance with Section 01 31 00 – Project Management and Coordination, convene a pre-installation conference prior to commencing work of this Section.
- B. Participants shall be representative of Owner, Architect, concrete paver installer, waterproofing installer, and other concerned entities.
- C. Review:
 - A. Substrate condition, surface preparation, and preparation of penetrations.

- B. Installation procedures for roof decks.
- C. Protection of pavers, waterproofing membrane, and adjacent installed items and finishes.
- D. Special details and conditions.

1.5 DELIVERY, STORAGE, AND HANDLING

- A. Protect unit pavers during storage and construction against soiling or contamination from earth and other materials.
- B. Wrap pavers in plastic or use other packaging materials that will prevent rust marks from steel strapping.

PART 2 - PRODUCTS

2.1 ACCEPTABLE MANUFACTURERS

- A. American Hydrotech, Inc., Chicago, Illinois; 800-877-6125; www.hydrotechusa.com.
- B. Hanover Architectural Products, Inc., Hanover, Pennsylvania; 717-637-0500; hanoverpavers.com
- C. Requests to use equivalent products of other manufacturers shall be submitted in accordance with Section 01 25 13 – Product Substitution Procedures. Architect reserves right to reject proposed substitutions on basis of color compatibility even though fabrication and materials are equivalent.

2.2 CONCRETE PAVERS

- A. Type: Solid, precast concrete paving units formed under intense vibration and hydraulic pressure.
- B. Type: Flat, rectangular panels with nominal size of 24 by 24 by 2 inches.
- C. Compressive strength in accordance with ASTM C140: 7,000 PSI average minimum.
- D. Flexural strength in accordance with ASTM C293: 600 PSI average minimum.
- E. Water absorption in accordance with ASTM C140: Less than 5 percent.
- F. Freeze-thaw resistance in accordance with ASTM C67: Less than 1 percent loss of dry weight after 50 cycles.

2.3 SUPPORT PEDESTALS AND SHIMS

- A. Support pedestals: Octagonal, high density polyethylene grid type leveling and spacing support device; Hanover Paver Support Pedestals as manufactured by Hanover Architectural Products, Inc.
 - A. Size: 7 inches across by 5/8 inch thick.

- B. Capable of being separated into halves and quarters to accommodate perimeter edges and corners.
- C. Provide with drainage holes.
- B. Leveling shims: Octagonal, high density polyethylene leveling shims to be used with pedestal supports; Hanover Leveling Shims as manufactured by Hanover Architectural Products, Inc.
- C. Compensator shims: High density polyethylene, circular base to compensate for 1/8 inch minimum roof slope and provide level concrete paver surface: Hanover Compensator Leveling Systems as manufactured by Hanover Architectural Products, Inc.

PART 3 - EXECUTION

3.1 EXAMINATION

- A. Examine surfaced indicated to receive paving for compliance with requirements for installation tolerances and other conditions affecting performance of unit pavers. Do not proceed with installation until unsatisfactory conditions have been corrected.
- B. Examine fluid applied roofing installation, with waterproofing installer present. Determine methods of protecting waterproofing from paving operations. Examine area where waterproofing system is turned up or flashed against vertical surfaces as well as horizontal waterproofing. Do not proceed with installation until protection is in place.

3.2 INSTALLATION, GENERAL

- A. Do not use pavers with chips, cracks, voids, discolorations, and other defects that might be visible or cause staining in finished work.
- B. Mix pavers from several pallets to produce uniform blend of colors and textures.
- C. Cut unit pavers with motor driven masonry saw to provide clean, sharp, unchipped edges. Hammer cutting is not acceptable. Cut units to provide pattern indicated and to neatly fit adjoining work. Use full units without cutting where possible.
- D. Place pavers in pattern shown on Drawings and reviewed shop drawings. Joints shall be parallel to adjacent building lines.

3.3 INSTALLATION

- A. Install pavers on pedestals over waterproofing protection board on roof terrace.
- B. Place protective separation between pedestal and protection board. Use leveling and compensating shims to ensure paver surface is level and joints are flush.
- C. Exercise care in placing pavers over waterproofing so protection materials are not displaced and waterproofing is not punctured or otherwise damaged. Carefully replace protection materials that become displaced and arrange for repair of damaged

waterproofing before covering with paving.

- D. Tolerances: For finished surface do not exceed 1/32 inch unit-to-unit offset from flush not 1/8 inch in 10 feet from level or indicated slope.

3.4 REPAIR, CLEANING, AND PROTECTION

- A. Remove and replace unity pavers that are loosed, chipped, broken, stained, or otherwise damaged or if units do not match adjoining units. Provide new units to match adjoining units and install in same manner as original units, with same joint treatment to eliminate evidence of replacement.
- B. Provide final protection that ensures that pavers are without damage or deterioration at the time of Substantial Completion.



END OF SECTION



Sandia Base

Elementary School


21001 Wyoming Blvd SE

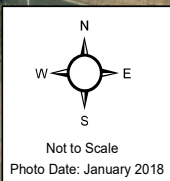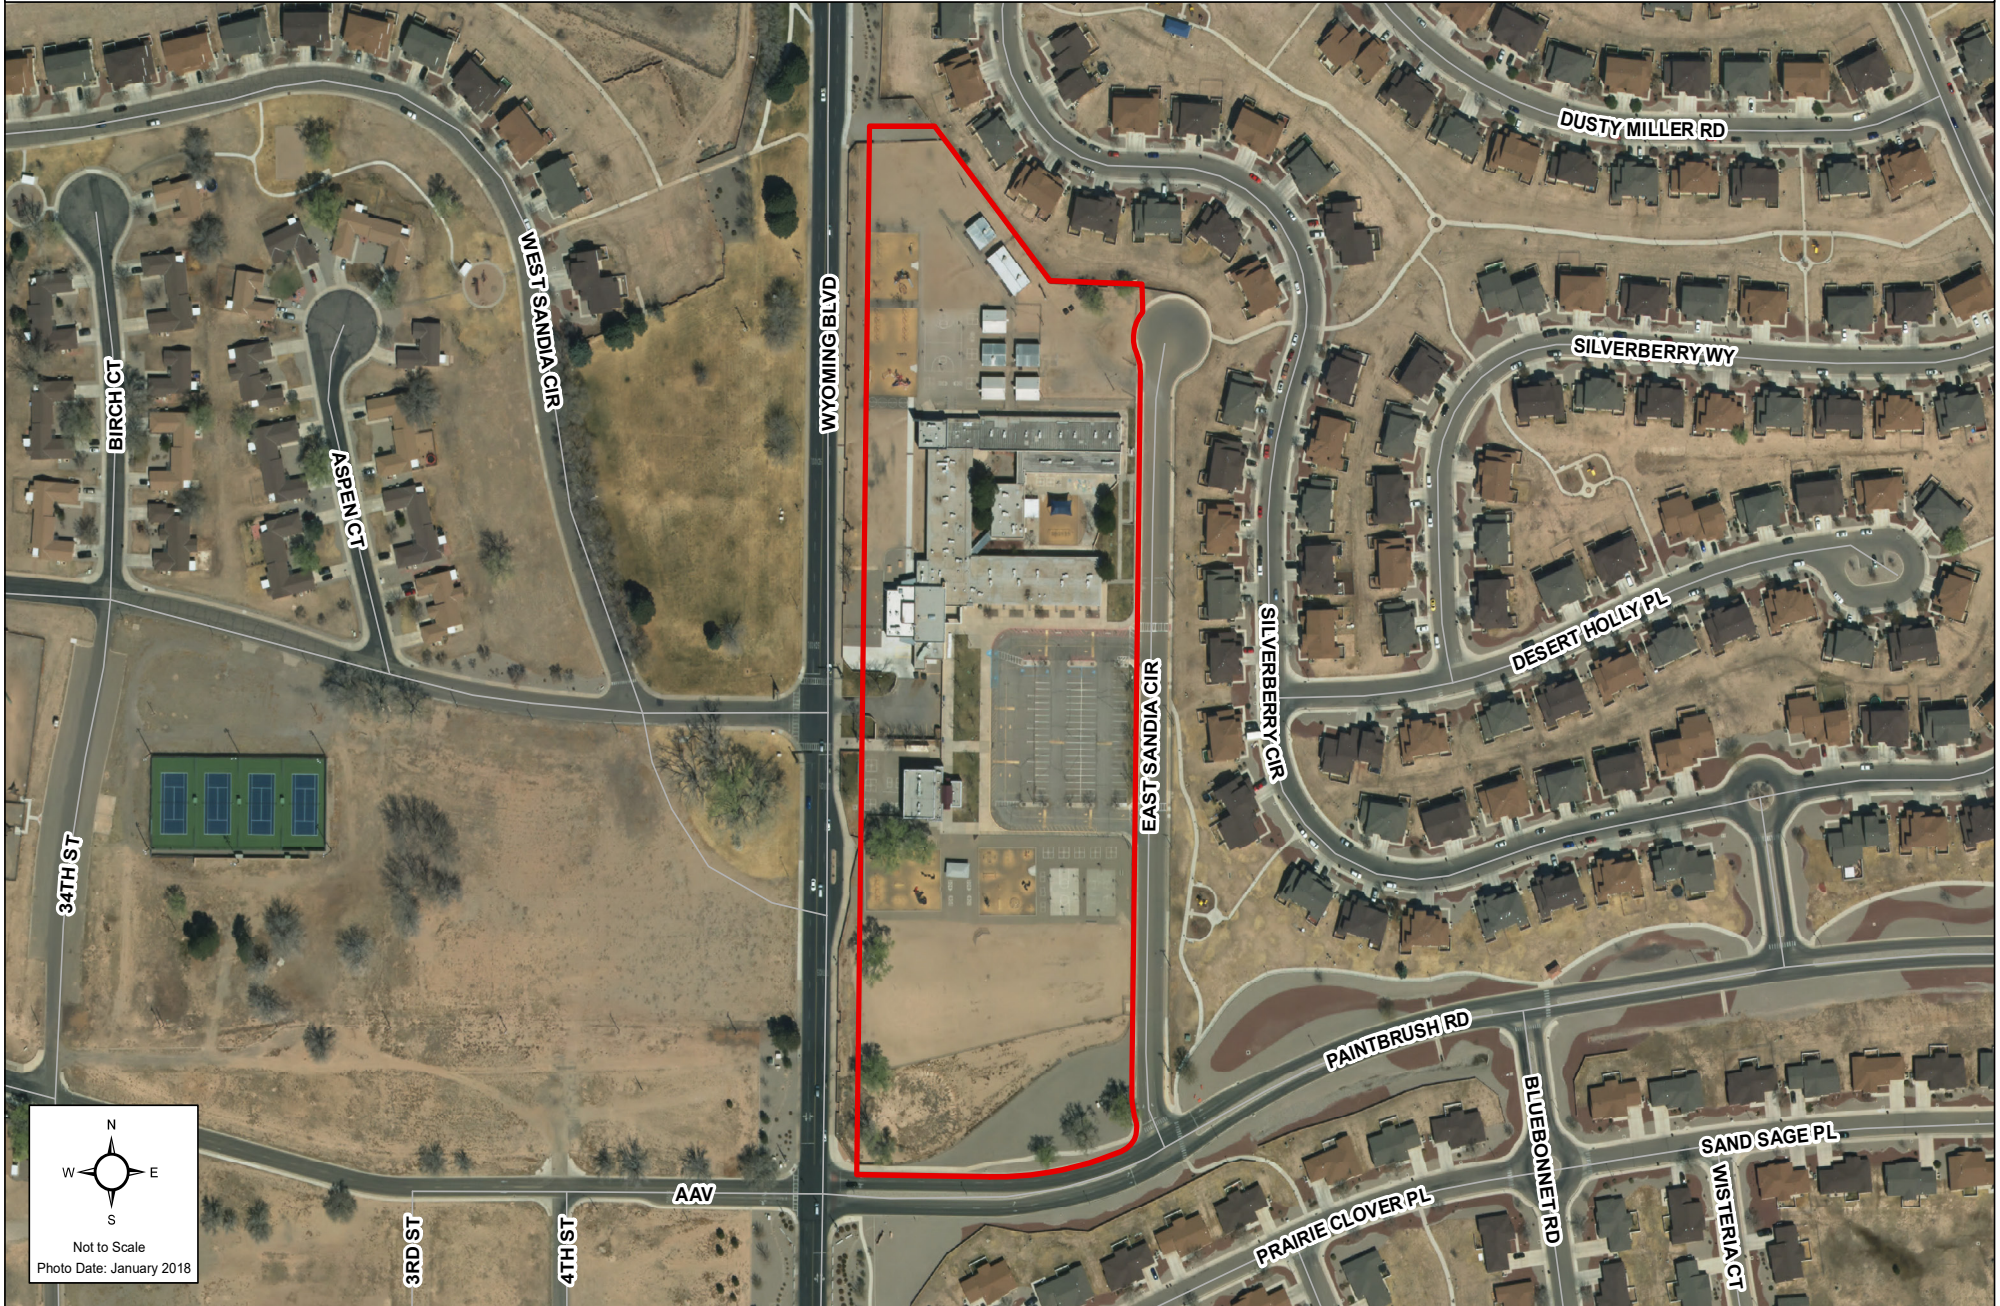

Sandia Base ES

Coded Floor Plan


SY 2019-20

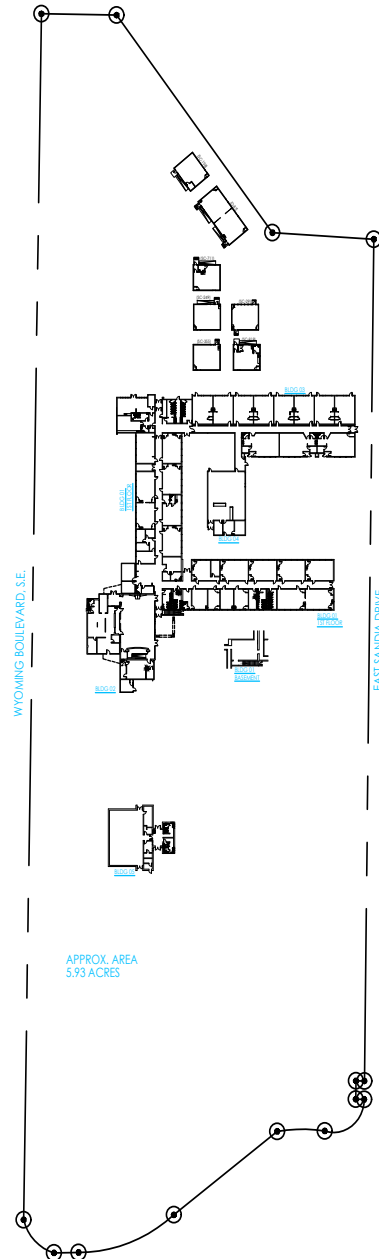

SCHOOL ADDITIONS TO SANDIA BASE E.S.

1949 - MAIN SCHOOL BUILDING	10,927 S.F.
1950 - CLASSROOMS	13,916 S.F.
1961 - CLASSROOMS	9,850 S.F.
1980 - LIBRARY AND KITCHEN ADDITIONS	4,200 S.F.
1992 - KINDERGARTEN ADDITION	5,366 S.F.
1997 - MULTIPURPOSE ADDITION	4,158 S.F.
2014 - CAFETERIA ADDITION	2,502 S.F.
TOTAL SQUARE FEET	50,919 S.F.
PORTABLES (7)	7,056 S.F.

CONSTRUCTION PHASES	DATE:
PERMANENT BLDG. 50,919 S.F.	04-14-2017
PORTABLE BLDG. 7,007 S.F.	

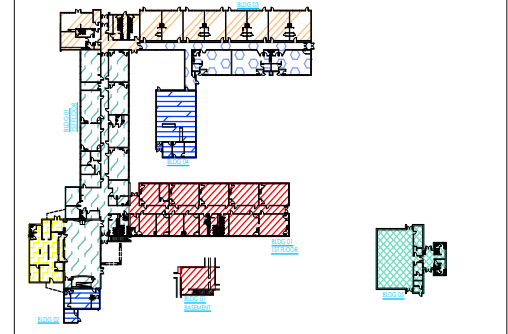

Sandia Base ES

Coded Floor Plan


SY 2019-20

PROGRAM USE

 GENERAL INSTRUCTION	 SPED	 SPECIAL PROGRAMS	X PROGRAM USE NO FTE
 SHARED / SIGN-UP	 DISTRICT SPED	 OTHER	

LEGEND

FIRE EXTINGUISHER (FE)	FIRE PULL STATIONS (FP)	FIRE HYDRANT (FH)	FIRE ALARM PANEL (FA)	FIRE RISER CONNECTION (FR)	KNOCK BOX (KB)	DEFIBRILLATOR (DB)	BLANKET (B1) CHEM ETOR (CS)

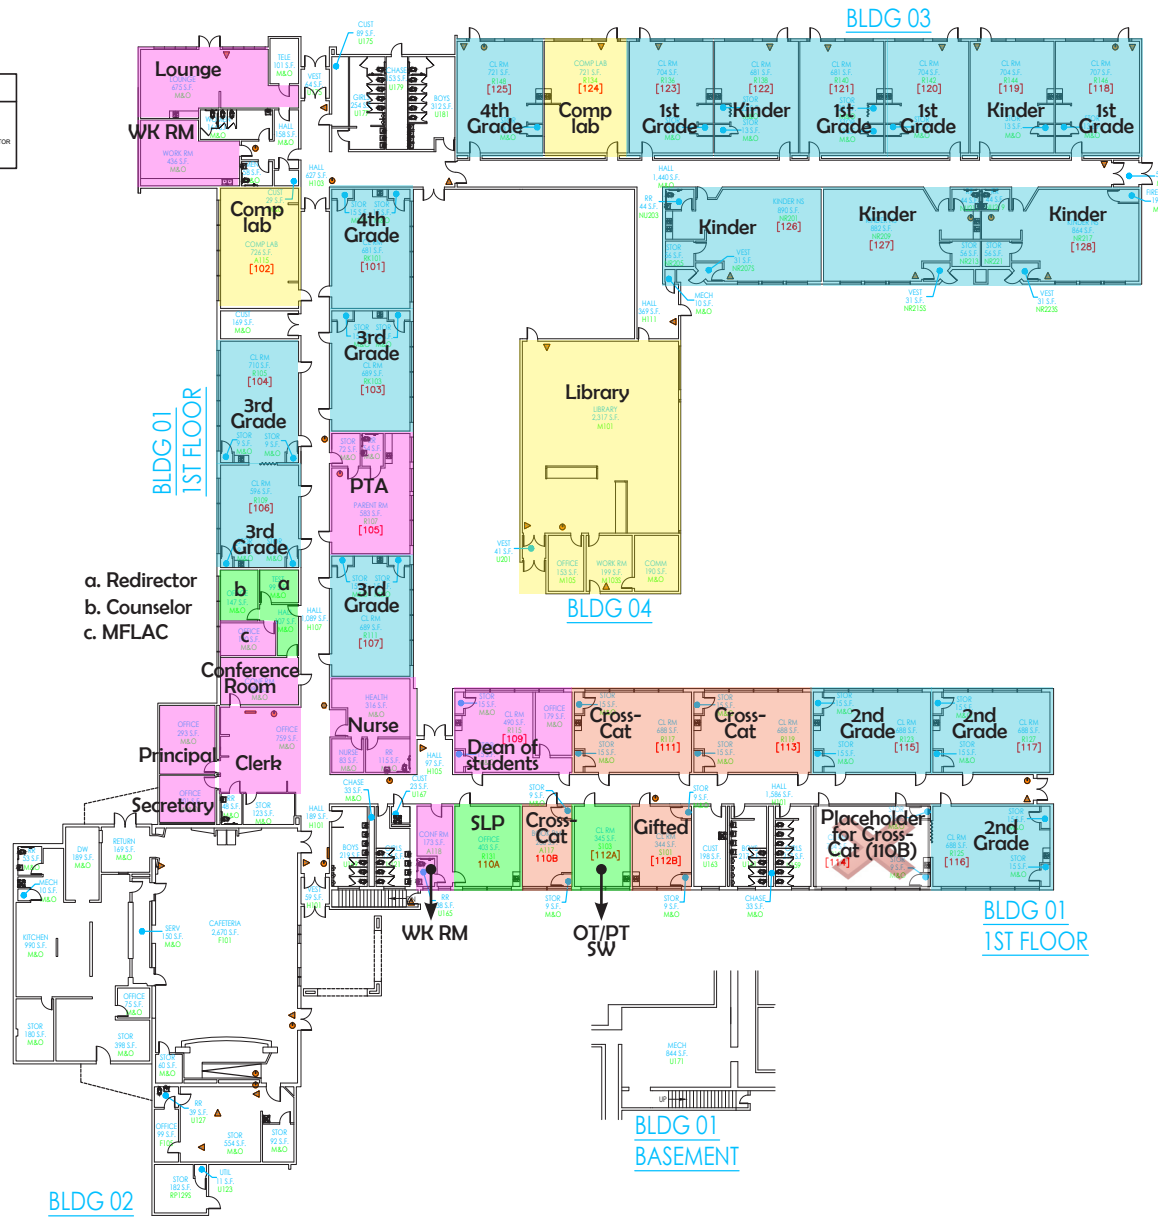

Sandia Base ES

Coded Floor Plan

SY 2019-20

PROGRAM USE

GENERAL INSTRUCTION
 SPED
 SPECIAL PROGRAMS
 ✗ PROGRAM USE NO FTE

SHARED / SIGN-UP
 DISTRICT SPED
 OTHER

