

**City of Kingman** 

310 NORTH FOURTH STREET • KINGMAN • ARIZONA • 86401 • 928.753.5561 WWW.CITYOFKINGMAN.GOV

### CITY OF KINGMAN EASTERN STREET IMPROVEMENTS, PHASE 1

ADDENDUM NO. 1 (Total of 1 Page with Attachments) Prepared: March 17, 2023 ENG21-0001

The following information is provided to supplement the project Bid Documents for EASTERN STREET IMPROVEMENTS, PHASE 1. This Addendum #1 is being issued to address the following comments. Receipt of this Addendum No. 1 shall be acknowledged on the Proposal Form.

### **COMMENT RESOLUTION:**

- 1. What specification should we be using for the mix design and reinforcement? **RESPONSE:** Channel lining shall follow M.A.G. Specification Section 505 – Concrete Structures (See Sheet 6 and Sheet 13 of Stantec as-built plans).
- 2. Will there be any reinforcement (fiber mesh, wire mesh or rebar)? **RESPONSE:** Reinforcing steel shall conform to M.A.G. Specification Section 727 (See Sheet 13 of Stantec as-built plans for rebar size and spacing).
- 3. Is there a detail for joining new and old shotcrete channel (i.e., thickened edge with drilling and pinning with epoxy or otherwise)? **RESPONSE:** A detail has been provided (See Sheet 13 of Stantec as-built plans).
- 4. Will we need any special finish other than standard nozzle finish? *RESPONSE: Rough broom finish.*
- 5. Are joints required and if so could we get some details or spec to reference? **RESPONSE:** Joints shall be installed per attached details (See Sheets 6 and 13 of Stantec as-built plans).
- Is there a chosen preferred supplier for the concrete already or should we just use our preferred ready mix supplier?
   RESPONSE: There is not a preferred concrete supplier.
- For the box culvert would the City accept precast in lieu of cast in place?
  RESPONSE: For this bid the box culvert shall be cast in place.



### END OF ADDENDUM NO. 1 Total of 1 Page with Attachments

Addendum #1 Prepared by: Eric Sparkman, P.E. Assistant City Engineer Attachments: Stantec As-Builts (3 pages)

Rugged, Adventurous & Unafraid.



**Stantec** 

Stantec Consulting Inc. 8211 South 48th Street Phoenix AZ 85044 U.S.A. Tel. 602.438.2200 Fax. 602.431.9562 www.stantec.com



MAYOR MONICA GATES

### COUNCIL MEMBERS


DAVE FRENCH TOM SPEAR. PHILLIP MOON JIM BAKER TOM CARTER RAY LYONS CITY MANAGER

CITY ENGINEER PETER R. JOHNSON, P.E.

PUBLIC WORKS DIRECTOR JACK KRAMER

# **CITY OF KINGMAN** PUBLIC WORKS DEPARTMENT

310 N. Fourth Street Kingman, AZ 86401 928-753-8122

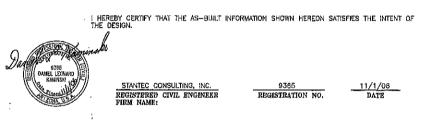

(AS-BUIL'

# Airway Avenue Railroad Crossing Improvement District Andy Devine to Castle Rock Road

THE NORTH 1/2 OF SECTION 8, T.21 N., R. 16 W., G.& S.R.M., MOHAVE COUNTY, ARIZONA.


W.,

APPROVED:

PROJECT NO. 05-ID-0015

## **NOVEMBER 2006** STANTEC JOB NO.: 81760059

DIRECTOR OF PUBLIC	WORKS	DATE
	;	
CITY ENGINEER		DATE

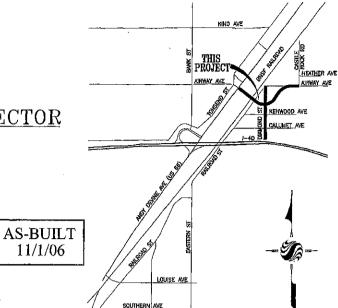


VICINITY MAP

### SHEET INDEX

SHT NO.	DESCRIPTION
1	COVER SHEET
2	KEYMAP & LINETYPES
3	GENERAL NOTES
4	DEMOLITION & UTILITY RELOCATION PLAN
5-6	TYPICAL SECTIONS
7	HORIZONTAL CONTROL
8-9	GRADING PLANS
10-13	DETAILS
1416	SHOO FLY PLAN & PROFILE
17	UNDERPASS DETAIL
1825	AIRWAY AVENUE PLAN & PROFILE
26	APACHE STREET PLAN & PROFILE
27	DIAMOND STREET PLAN & PROFILE
2835	RAILROAD CHANNEL PLAN & PROFILE
36	YAVAPAI DRAINAGE CHANNEL PLAN & PROFILE
37-38	NORTH DRAINAGE CHANNEL PLAN & PROFILE
39	TRANSITION WALL DETAILS
40	YAVAPAI CHANNEL INLET STRUCTURE DETAILS
41-44	STORMDRAIN PLAN & PROFILE
45-47	STORMDRAIN CONNECTOR PIPE PROFILES
48-51	SEWER PLAN & PROFILE
52-53	WATERLINE PLAN & PROFILE
54-59	PUMP STATION PLANS & DETAILS
60-66	PUMP STATION ELECTRICAL PLANS
67-71	STREET LIGHT PLANS
72-75	TRAFFIC SIGNAL PLANS
76-84	SIGNING & PAVEMENT MARKING PLANS
85-91	B.N.S.F. BRIDGE PLANS
92-95	AGENCY DETAILS
	· · · · · · · · · · · · · · · · · · ·

### 05-10-0015

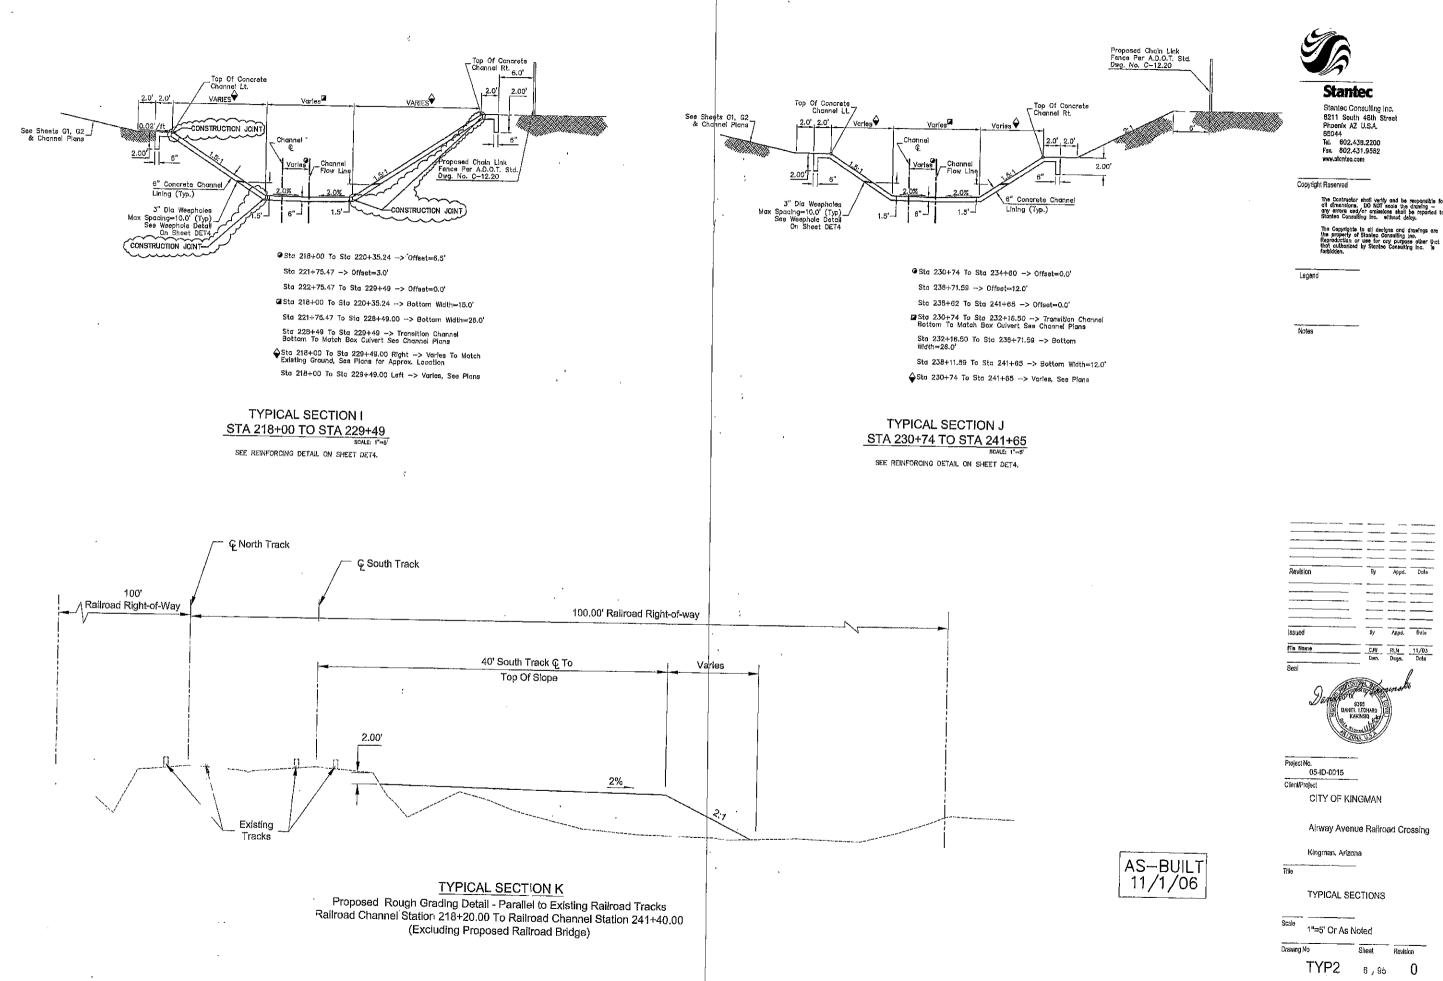




itanlee Consulting Inc. use for any purpose other that y Stantee Consulting Inc. is

n Channel Ians	
n	

By Appd. Dole -----· ···· By Appd, Dule CJW RLN 11/03 Dwn. Dsgn. Date Alrway Avenue Railroad Crossing

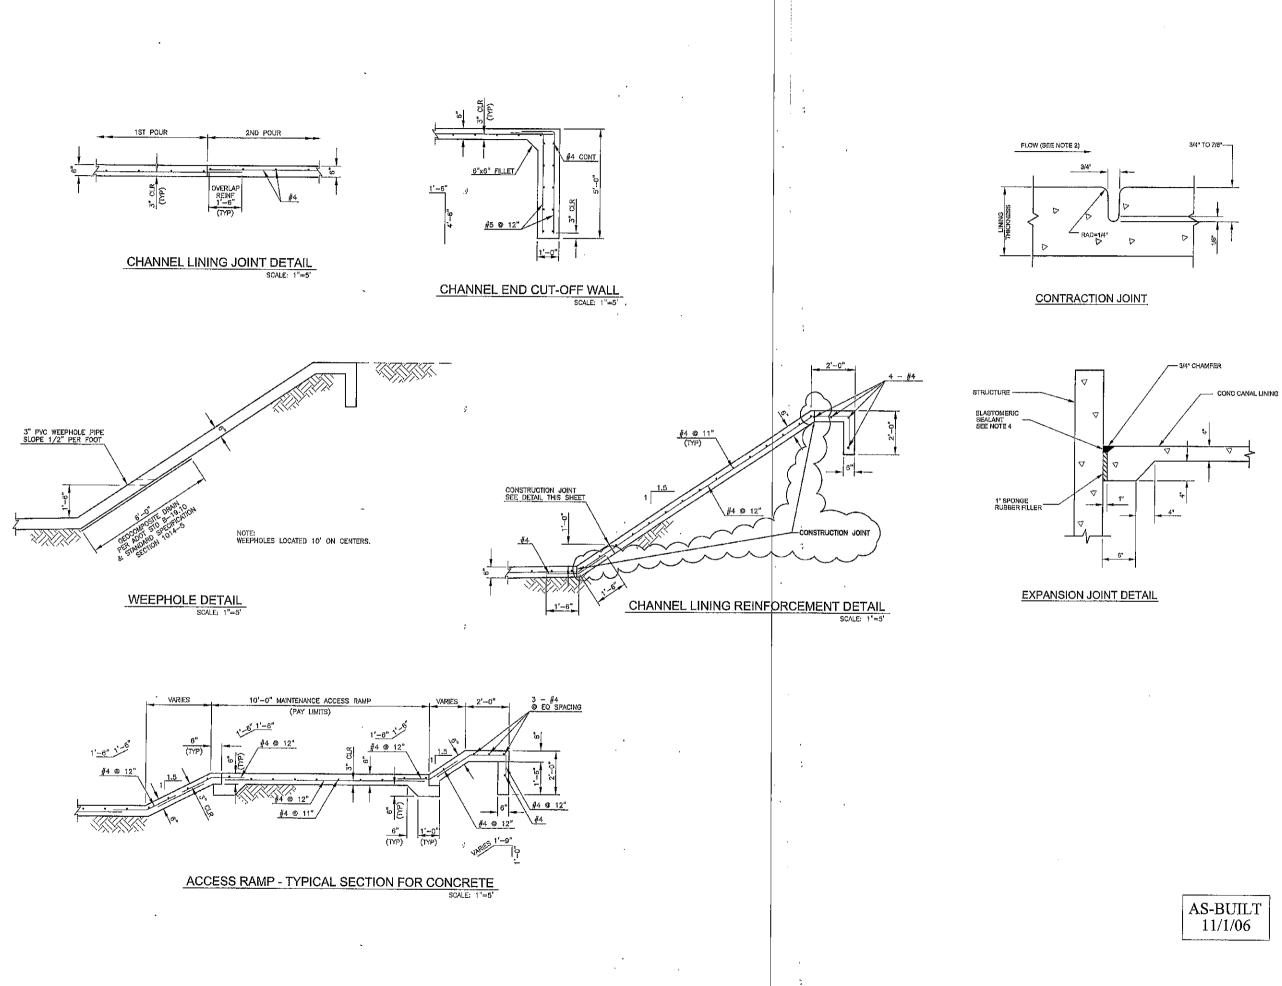




### Stantec

Stanlec Consulting Inc. 8211 South 48th Street Phoenix AZ U.S.A. 85044 Tei. 602.438.2200 Fox. 602.431.9562 www.stantec.com

Copyright Reserved

Legend

Note

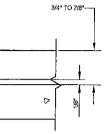

Appd. Data Appd. By Dote issued File Nan 11/03 C'W RLN Sea Project No. 05-ID-0015 Client/Project CITY OF KINGMAN Alrway Avenue Railroad Crossing Kingman, Arizona

Tille

DETAILS

Scale As Noted Drawing No. Sheet Revision DET4 13/95 0