





CROSS SECTION A-A

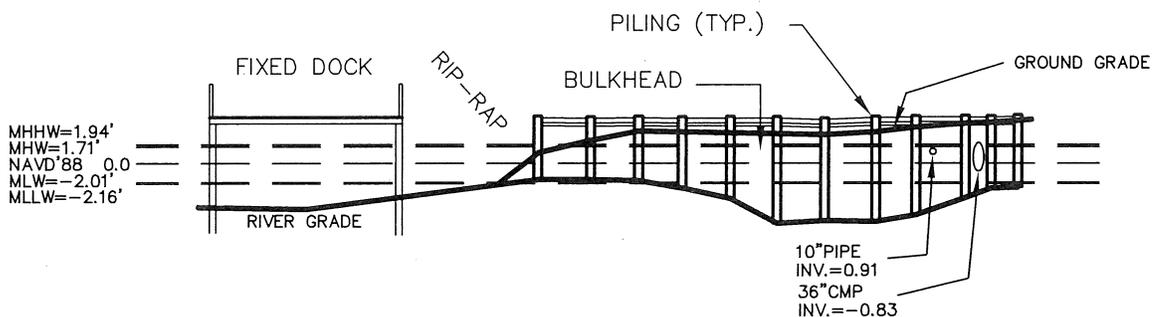

CROSS SECTION B-B

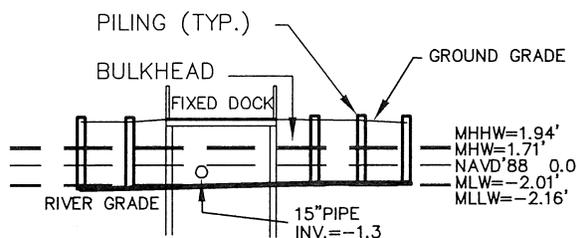

CROSS SECTION C-C

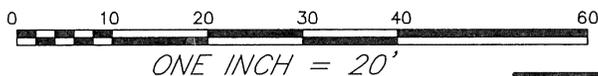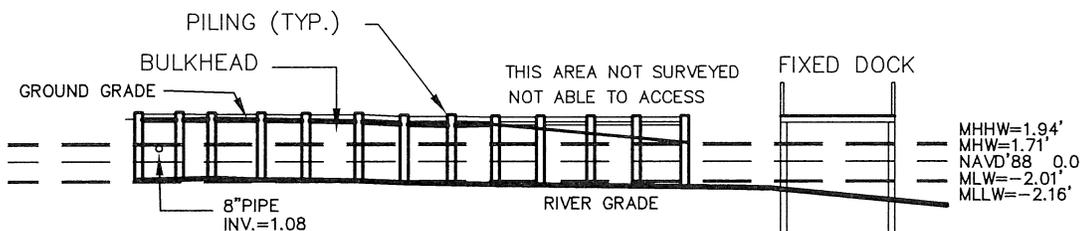

ELEVATIONS SHOWN HEREON BASED ON NAVD '88 DATUM.

TIDAL DATUM BASED ON TIDAL BENCHMARK STATION ID 8662926 (GEORGETOWN, SAMPIT RIVER) TIDAL #4



L. BRUCE ABBOTT
SCPLS 29504
150 VEREEN ROAD
GEORGETOWN, SC 29440
843-833-2190
lbruceabbott@gmail.com

OCTOBER 17, 2017
SHEET 2 OF 2

AS BUILT DRAWINGS
OF A FIXED DOCK AND BULKHEAD
LOCATED AT THE SOUTHERN END
OF ORANGE STREET,
CITY OF GEORGETOWN
GEORGETOWN COUNTY, SC

SURVEYED FOR
McSWEENEY ENGINEERS LLC