FOR THE PROJECT TITLED:

FCPS NEW MIDDLE SCHOOL – POLO CLUB KDE BG # 21-176 FCPS BID # 20-21 JRA Project No. 202078 Fayette County Public Schools Lexington, Kentucky

To: Prospective Bidders

From: JRA Architects 3225 Summit Square Place, Suite 200 Lexington, KY 40509

Project Contact: D. Robert Deal, AIA, LEED AP

The Addendum will form a part of the Contract Documents and modifies the original Bidding Documents dated September 2021.

Bidders must acknowledge receipt of this Addendum in the space provided on the Form of Proposal. Failure to do so may subject the bidder to disqualification.

Bidding Documents, including the Drawings and Specifications, are amended as described herein.

ADDENDUM ITEMS:

ITEM NO. 1.01


Refer to the Advertisement for Bids and Specification Section 00 2513 "Prebid Meetings". Change to pre-bid date to Thursday, October 7, 2021. Time and format remain unchanged.

ITEM NO. 1.02

Refer to the Project Manual, Volume I. Replace Specification Section 00 6000-03 "Supplementary Conditions". Replace the version contained within the Project Manual with the version contained within Addendum 1.00.


ITEM NO. 1.03

Refer to Sheet A-618 – Interior Frame Types. Revise Frame Type M1 (HM) to clean up graphics.

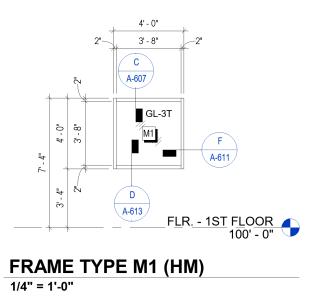

ITEM NO. 1.04

Refer to Sheet A-619 – Interior Frame Types. Revise Frame Type E2 (HM), B1 (HM), E3 (HM), J2 (HM) to clean up graphics.

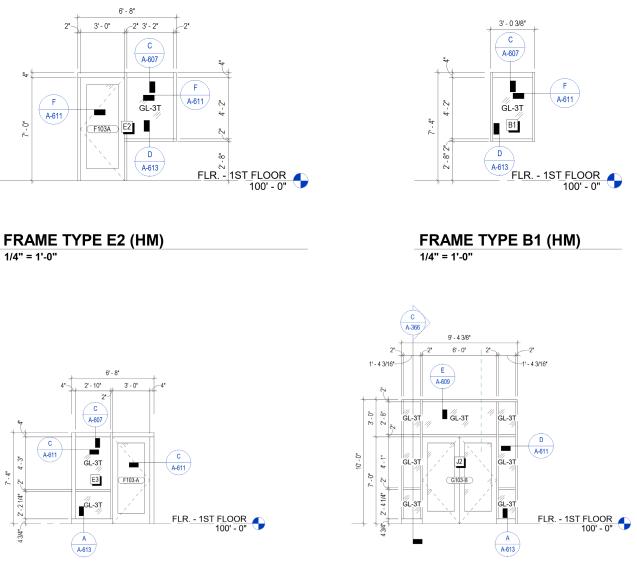

FRAME TYPE E3 (HM) 1/4" = 1'-0"

FRAME TYPE J2 (HM) 1/4" = 1'-0"

ITEM NO. 1.05 Refer to Sheet A-417 – Enlarged Computer/Flex Classroom. Add note to drawings sheet.

> NOTE: EQUIPMENT SHOWN IS TYPICAL FOR 3 CLASSROOMS

ITEM NO. 1.06

Refer to sheet S-502 – In detail A/S-502 change the D1 weld for Type II Connection to be both sides and replace the Moment Connection Schedule table with the following table:

		МО	MENT	CON	INECTIO	ON SC	CHED	ULE				
MARK	CONNECTION			ТОР	FLANGE PLA	TE	BOTTO	M	WELDS			
	TYPE	Тр	W1	W2	LENGTH	Тр	WIDTH	LENGTH	D1	D2	Lw 🚽	2
MC1	1	1/2	3	6	14	1/2	6	14		1/4	10	2
MC2		1/2	5	7	15	1/2	7	15	5/16	1/4	13	2
MC3		-	N	I/A			N/A		:	SEE DETAI	L	
MC4	IV	1/2	3		26	3/8	6	26		1/4	10	
	L. L				\sim				\sim	p ~	\sim	1

ITEM NO. 1.07

Refer to Sheet P-211F - Add note to drawing, "Refer to Enlarged Kitchen Plan, P-400, for domestic water kitchen requirements."

ITEM NO. 1.08

Refer to sheet E-111B – Add control of parking lot receptacles and add lighting to trophy cases.

ITEM NO. 1.09

Refer to sheet E-211B – Add power to trophy cases.

ITEM NO. 1.10

Refer to sheet E-211E – Add power to trophy cases.

ITEM NO. 1.11

Refer to sheet E-211F – Add power to trophy cases.

ITEM NO. 1.12

Refer to sheets E-410 and E-411 – Revise panel schedules.

ITEM NO. 1.13

Refer to sheet U-100 – Add control of parking lot receptacle circuits by lighting control relay and switch.

END OF ADDENDUM NO. 1.00

DOCUMENT 006000.03 - SUPPLEMENTARY CONDITIONS

1.1 SUPPLEMENTARY CONDITIONS

- A. Supplementary Conditions for Project consist of the following:
 - 1. AIA Document A201-2007, "General Conditions of the Contract for Construction KDE Version," a copy of which is bound in this Project Manual.
 - 2. The following Supplementary Conditions that modify and add to the requirements of the General Conditions of the Contract for Construction.

1.2 SUPPLEMENTARY CONDITIONS, GENERAL

A. The following instructions modify, change delete from or add to AIA Document A201 - General Conditions of the Contract for Construction – KDE Version as amended by the Kentucky Department of Education, Division of Facilities Management. Where any article of the General Conditions is modified or any paragraph, subparagraph or clause thereof is modified or deleted by these Supplementary instructions to Bidders, the unaltered provisions of the Article, paragraph, subparagraph or clause shall remain in effect.

1.3 ARTICLE 1 - GENERAL PROVISIONS

- A. 1.1 Basic Definitions:
 - 1. Add the following:
 - a. 1.1.9 A Material Supplier (Supplier) is a person or organization who has a direct Purchase Order responsibility to the Owner. A Material Supplier cannot be an installing contractor.

1.4 ARTICLE 2 - OWNER

- A. 2.2 Information and Services Required of the Owner:
 - 1. Delete Section 2.2.5 and replace with the following:
 - a. 2.2.5 FCPS <u>will not be providing copies of the plans and specification free of charge to the contractor. The contractor will be responsible for providing all copies of plans and specifications necessary to complete the work on the project.</u>

1.5 ARTICLE 3 - CONTRACTOR

- A. 3.4 Labor and Materials:
 - 1. Add the following:
 - a. 3.4.4 Material Supplier assumes all responsibility for materials until delivery is accepted by the Contractor. The designated Contractor or Subcontractor

responsible for installation of Purchase Order material or equipment is to supervise and accept delivery, unload, handle store, layout and install the items.

- 3.4.4.1 Upon delivery, the designated Contractor is to verify product suitability, quantity, quality and condition as soon as it can be ascertained and shall accept care, custody and control responsibility as if it were he own purchase. Any damage or loss after delivery will be the responsibility of the responsible Contractor or Subcontractor.
- B. 3.5 Warranty:
 - 1. Add Section 3.5.1:
 - a. 3.5.1 The Owner expects that all building materials to be incorporated into the completed work shall be in 100% new condition and shall be reasonably clean of moisture, dirt, and contaminants that may facilitate the growth of mold or rust in the future. A clean and orderly jobsite is required.
 - b. Add Section 3.5.1.1:
 - 1) 3.5.1.1 Materials stored on the site shall be sorted and stored to protect from damage due to construction activities. Damaged materials shall not be installed in any assembly but shall be replaced with a new item of equal specifications.
 - c. Add Section 3.5.1.2:
 - 1) 3.5.1.2 Materials shall be stored on pallets or other devices to prevent direct ground contact. Mud and other foreign matter shall be completely removed from each component (including concealed surfaces) prior to installation.
 - d. Add Section 3.5.1.3:
 - 1) 3.5.1.3 The manufacturer's recommendations regarding the allowable temperature and humidity for storage and installation of materials shall be strictly observed.
 - 2. Add Section 3.5.2:
 - a. 3.5.2 Material Supplier will guarantee all materials furnished under a purchase order to be in accordance with the requirements of the contract documents. This guarantee shall extend through the construction period and one (1) year from the date of Substantial Completion, upon final acceptance by the Owner. The Contractor shall also guarantee and warrant to the Owner all materials purchased directly by the Owner by Purchase Order shall fully conform to the requirements of the Contract Documents.
- C. 3.6 Taxes
 - 1. Add Section 3.6.1:
 - a. 3.6.1 As provided by KRS 139.310 and Kentucky Administrative Regulation 103 KAR 26:070 (Contract Construction). Each contractor is responsible for Kentucky Sales and Use Tax on all material purchased and installed by the contractor or a third party hired by the contractor.

- 2. Add Section 3.6.2:
 - a. 3.6.2 For those bid packages identified as Supplier Only or Contractor/Supplier (containing bid breakout items), the sales and use tax is to be excluded only on those material items purchased by the Owner directly from the material supplier. If a contractor lists his own company as the supplier on those bid packages containing bid breakout items, the Owner will not issue a purchase order and exemption certificate. Accordingly, the sales and use tax on the materials used to fulfill the terms of the contract will be the liability of the contractor.
- D. 3.10 Contractor's Construction Schedules:
 - 1. Add Section 3.10.1.1:
 - a. 3.10.1.1 The specifications include a project schedule that meets the needs of the Owner. The Owner understands that the submittal of a bid proposal from the contractor (and subcontractors) indicates an agreement that this schedule can be met barring unusual weather or other unforeseen and uncontrollable conditions.
 - 2. Add Section 3.10.2.1:
 - a. 3.10.2.1 The contractor's schedule shall be presented in bar chart form with sufficiently detailed activities and tasks to fully describe the work and its sequence.
 - b. The actual sequence of the work shall suit the storage and installation requirements of the materials being used throughout the project and the schedule shall accurately describe that sequence.
 - c. The contractor's schedule shall identify intervals in the sequence of the work when space is ready for the Owner furnished and installed fixtures. The schedule shall allow time for coordination of the work or the general contractor's subcontractors with others working directly for the Owner.
 - d. Activities shall be charted by phase and shall include the following activities:
 - 1) Shop drawings, permits, etc.
 - 2) Temporary utility connections established
 - 3) Rough excavation, fine grading, paving, lawns, plantings, etc.
 - 4) Utility service outages
 - 5) New buried utilities
 - 6) Under-slab
 - 7) Site
 - 8) Foundations & slab
 - 9) Exterior walls including insulation (rough to weather-tight)
 - 10) Doors
 - 11) Windows
 - 12) Roofing including insulation (rough to weather-tight)
 - 13) Interior walls
 - 14) MEP
 - a) HVAC systems (rough-in to full operation)
 - b) Electrical systems (rough-in to full operation)
 - c) Plumbing systems (rough-in to full operation)
 - 15) Interior finishes
 - a) Wall paint
 - b) Ceiling

- c) Floor coverings
- 16) Fixtures and equipment
 - a) FCPS furnished & installed plastic laminate casework
 - b) FCPS furnished & installed wood laboratory casework
 - c) FCPS furnished & installed library casework
 - d) FCPS installed permanent lock cores
 - e) FCPS HVAC testing & balancing
 - f) Transfer of building utilities to FCPS
 - g) FCPS installed telephone, cable and data systems
 - h) FCPS furnished & installed interior signage
 - i) FCPS furnished & installed loose furniture
 - j) Substantial completion
 - k) FCPS move-in
 - I) Final completion
- 3. Add Section 3.10.4:
 - a. 3.10.4 Target dates established by the contractor for each project are required if school and FCPS staff are to meet the dates for Owner activities demanded by the schedule. FCPS will not be liable for delays caused by poorly planned contractor progress schedules. No claims for the cost of delay of the contractor's work will be considered by the Owner until the GC has provided a bar chart schedule with the minimum detail described above and the work has been progressing according to the schedule with reasonable accuracy for a period of at least ninety days.
- 4. Add Section 3.10.5:
 - a. 3.10.5 The actual sequence of the work shall suit the storage and installation requirements of the materials specified throughout the project and the contractor's schedule shall accurately describe that sequence. Materials (e.g., as insulation, gypsum products, duct work, etc.) that are to be stored in a dry condition and shall be protected from rain and weather.
- 5. Add Section 3.10.6:
 - a. 3.10.6 Finish materials (e.g., paint, flooring, acoustical tile, etc.) shall only be installed once the building is weather-tight, and once temperature and humidity control has been established through the operation of the building's HVAC system. Payment for prematurely installed materials shall be withheld until the interior environment is under control. The contractor shall be held responsible for interior finishes that fail due to premature installation under adverse environmental conditions. When prematurely installed finishes fail after space is occupied, the cost of inconvenience to the Owner to replace those finishes shall be charged to the contractor via liquidated damages.
- 6. Add Section 3.10.7:
 - a. 3.10.7 The contractor's schedule shall identify intervals in the sequence of the work when space is ready for Owner furnished and installed fixtures. The contractor shall provide that space finished and environmentally controlled in preparation for the installation of Owner furnished and installed fixtures. The schedule shall allow time for coordination of the work of the general contractor's subcontractors with others working directly for the Owner.

1.6 ARTICLE 6 - CONSTRUCTION BY OWNER OR BY SEPARATE CONTRACTORS

- A. 6.1 Owner's Right to Perform Construction and to Award Separate Contracts:
 - 1. Delete Section 6.1.1 and replace with the following:
 - a. 6.1.1 As stated in other provisions of the specifications the Owner intends to fulfill other project needs through contracts with forces working directly for the Owner. Among those direct construction-phase contracts are included: 1) Special Inspections, Testing & Balancing, Building Commissioning, and Water Treatment services; 2) Upon declaration of final completion the Owner intends to utilize separate outside contractors for HVAC filter changes and turf development. 3) The general contractor's cooperation and assistance is required by the Owner to coordinate the activities of these separate contractors and to facilitate a smooth transition between work activities.
- 1.7 ARTICLE 8 TIME
 - A. 8.2 Progress and Completion:
 - 1. Add Section 8.2.1.1:
 - a. 8.2.1.1 Time limits stated in the Contract Documents shall be included the Contractor's Construction Schedules and requirements thereof.

1.8 ARTICLE 9 - PAYMENTS AND COMPLETION

- A. 9.3 Application for Payment:
 - 1. Add Section 9.3.1.3:
 - a. 9.3.1.3 The Contractor and Sub-Contractor shall submit with each Application for Payment a Purchase Order Payment Authorization, authorizing the Owner to make payment for materials being supplied via a Purchase Order. The Contractor and/or Subcontractors shall assemble and attach to the Purchase Order Payment Authorization, <u>Original Invoices</u> for materials that are to be incorporated in the work. Invoiced materials must either be at the job site at the time of invoice, or, if properly stored off-site, invoices must be accompanied by a properly executed certificate of insurance as required by Article 11.4.1.4 of the General Conditions. Each invoice must indicate the purchase order number, and include <u>only</u> changes for material incorporated into the Work. Invoices that include items such as tools, sales tax, finance charges, deposits, etc. will be rejected and returned to the Contractor. Invoices submitted directly to the Owner will be rejected and returned to the Contractor.
 - 1) Add Section 9.3.1.3.1:
 - a) 9.3.1.3.1 Interest/Finance charges by a Material Supplier, due to the Contractor approval of a partial payment of a submitted invoice, shall be the responsibility of the Contractor.
 - 2) Add Section 9.3.1.3.2:

- a) 9.3.1.3.2 In the event that at the completion of the Work the contractor has not submitted invoices totaling the value of any individual purchase order, that purchase order shall be considered complete and closed. NO ADJUSTMENT WILL BE MADE TO THE CONTRACTOR'S CONTRACT.
- 3) Add Section 9.3.1.3.3:
 - a) 9.3.1.3.3 All payment applications shall be sent, distributed, and processed through the Owner's web-based project management website, eComm, hosted by Lynn Imaging.
- 2. Add Section 9.3.1.4:
 - a. 9.3.1.4 Applications for Payment shall be made with AIA Document G702, Application and Certificate for Payment, and AIA Document G703, Continuation Sheet for G702.
- 3. Delete Section 9.3.2 and replace with the following:
 - a. 9.3.2 Request for Payment for stored materials or equipment must include: 1.) List of materials consigned to the project, copies of invoices with project I.D. and storage location (Materials must be stored inside McCracken County Kentucky and accessible for viewing and verification by the architect or engineer during regular business hours to be listed on pay application.); 2.) Certification that all items have been tagged for the project and no other purpose; 3.) A letter from the bonding company indicating agreement to the arrangement; 4.) Evidence of adequate insurance with FCPS as insured; and 5.) Evidence that the A/E has viewed the items. If the above conditions are met, FCPS will pay 80% of the invoiced value for materials suitably stored off site.
- 4. Revise the first sentence of Section 9.3.4 to read:
 - a. 9.3.4 The Owner shall retain ten percent (10%) from each Application for Payment and an amount equal to ten percent (10%) of approved Purchase Order payments up to fifty percent (50%) completion of the Work, then, provided the Work is on schedule and satisfactory, and upon written request of the Contractor along with consent of surety and the recommendation of the Architect, the Owner may approve a reduction in retainage to (5%) of the total of the current Contract Sum plus Purchase Orders.
 - b. Add Section 9.3.4.1:
 - 1) 9.3.4.1 No retainage will be withheld from approved payment to Material Suppliers. Retainage will be withheld from the Contractors' Application for Payment as noted in paragraph 9.3.4.
- B. 9.8 Substantial Completion:
- C. Revise Section 9.8.1 to read:
 - a. 9.8.1 Substantial Completion is the stage in the progress of the Work when the Work or designated portion thereof is sufficiently complete in accordance with the Contract Documents so that the Owner can occupy and maintain the Work for its intended use. The ability to occupy, maintain, and utilize the Work or designated

portion thereof shall require a final occupancy permit for all phases of the project issued by the Kentucky Department of Housing, Buildings, and Construction and any other agencies that have statuary authority and approval requirements. In addition to the final certificate of occupancy, the General Contractor is required to submit the following items, as applicable to the Work, in order for the Architect to prepare a Certificate of Substantial Completion and to establish the date of Substantial Completion:

- b. Add Section 9.8.1.1:
 - 1) Final Certificate of Occupancy
 - 2) Final Sprinkler Certificate
 - 3) Final Emergency Generator Testing
 - 4) Final Plumbing Certificate
 - 5) Final Fire Alarm Certificate
 - 6) Final Electrical Certificate
 - 7) SWPPP Notice of Termination Sent to KYDOW
 - 8) Operation and Maintenance Manuals Storm Water Structures
 - 9) Range Hood Extinguishing System Inspection/Test Report
 - 10) Fuel Tank Installation Inspection Report
 - 11) Final Boiler Certificate
 - 12) Final Elevator Certificate
 - 13) Operation and Maintenance Manuals Electrical
 - 14) Operation and Maintenance Manuals Mechanical
 - 15) Operation and Maintenance Manuals Architectural
 - 16) Record Set of Drawings Transmitted to Architect
 - 17) Final Set of Shop Drawings in Architects Possession
 - 18) All Keys and Cores Turned Over to Owner
 - 19) Surplus/Stock Materials Turned Over to Owner
 - 20) User/Owner Training, Demonstrations, In Service Orientation
 - 21) Guarantees and Warranties Transmitted to Owner
 - 22) All Keys to Owner Buildings Returned to Owner

1.9 ARTICLE 11 – INSURANCE AND BONDS

- A. 11.1 Contractor's Liability Insurance:
 - 1. Add Section 11.1.5: General Liability
 - a. 11.1.5 Upon execution of Contract for the Work, the General Contractor shall immediately provide proof with Certificate of Insurance naming Fayette County Board of Education as an additional insured with the limits of insurance described elsewhere in the Contract Documents and as noted below:
 - b. Add Section 11.1.5.1:
 - 1) 11.1.5.1 Complete a Certificate of Insurance (COI) naming the Fayette County Board of Education as an "insured" under the Contractor's Policy with the limits on the policy applying solely for this project.
 - 2) Add Section 11.1.5.1.1:
 - a) 11.1.5.1.1 Under "General Liability, the "per project: box shall be checked making it Non-contributory.
 - 3) Add Section 11.1.5.1.2:

09/21


- a) 11.1.5.1.2 The Contractor shall furnish to the Owner a Waiver of Subrogation endorsement on the Contractor's insurance policy.
- c. Add Section 11.1.5.2:
 - 1) 11.1.5.2 Provide a complete CG 2010 Form giving the Fayette County Board of Education coverage while the Project is on-going.
- d. Add Section 11.1.5.3:
 - 1) 11.1.5.3 Provide a completed CG20374 Form giving the Fayette County Board of Education coverage for "Products & Completed Operation."
- B. 11.3 Property Insurance:
 - 1. Add Section 11.3.1.6:
 - a. 11.3.1.6 The General Contractor will provide property insurance related to the Bid Breakout and Owner purchased components, including current Contract sum plus Purchase Orders.
 - 2. Add Section 11.3.1.7:
 - a. 11.3.1.7 Property Insurance The General Contractor shall purchase and maintain, in a company or companies lawfully authorized to do business in the jurisdiction in which the Project is located, property insurance written on a builder's risk "all risk" or equivalent policy form in the amount of the initial Contract Sum and The Direct Purchase Orders value, plus the value of all subsequent Contract Modification.
 - 3. Add Section 11.3.1.8:
 - a. 11.3.1.8 Builders' Risk Insurance shall be an "all-risk" policy, to cover the life of the project with a \$5,000 deductible.
- C. 11.4 Performance and Payment Bond
 - 1. Revise the last sentence of Section 11.4.1 to read::
 - a. 11.4.1 "The amount of each bond shall be equal to 100% of the Contract sum plus the total of all Purchase Orders."
 - 2. Add Section 11.4.3:
 - a. 11.4.3 Specific sub-contractors shall furnish, to the Prime/General Contractor, Performance and Payment bonds in the full amount of the value of work they are providing, including purchase order. Evidence of ability to meet bonding requirements shall be presented to the Owner within 48 hours of the time set for receipt of bids. Attempts to circumvent this requirement by dividing sub-contractor contracts into "labor only" contracts with materials supplied by the prime contractor, or by having multiple contracts, will invalidate the bid. Bonds shall be furnished by the following sub-contractors:
 - .1 Masonry
 - .2 Roofing

- .3 ICF
- .4 Steel fabricator
- .5 Steel erector
- .6 Plumbing
- .7 Mechanical
- .8 Electrical
- b. Add Section 11.4.3.1
 - 1) 11.4.3.1 Required Subcontractor Performance and Payment Bonds cannot be co-signed by the General Contractor. These bonds are to be provided by the subcontractors noted above.

1.10 ARTICLE 13 - MISCELLANEOUS PROVISIONS

- A. Add Section 13.1.2:
 - 1. 13.1.2 The Kentucky Fairness in Construction Act, KRS 371.400 to 371.990, applies to Construction contract, and where there is a conflict between the terms and Conditions of these contract documents and the provisions of the Kentucky Fairness in Construction Act, the letter shall prevail.
- 1.11 ARTICLE 16 SPECIAL PROCEDURES (ADD ARTICLE)
 - A. Add Article 16 Special Procedures
 - 1. Add Section 16.1:
 - a. Contractors and Subcontractors working on FCPS property shall be responsible for notifying the Owner of any personnel doing work on site that have a communicable disease, including, but not limited to: Tuberculosis, measles, mumps, rubella, COVID-19, etc. or other pandemic disease or outbreak.

END OF DOCUMENT 00 6000.03

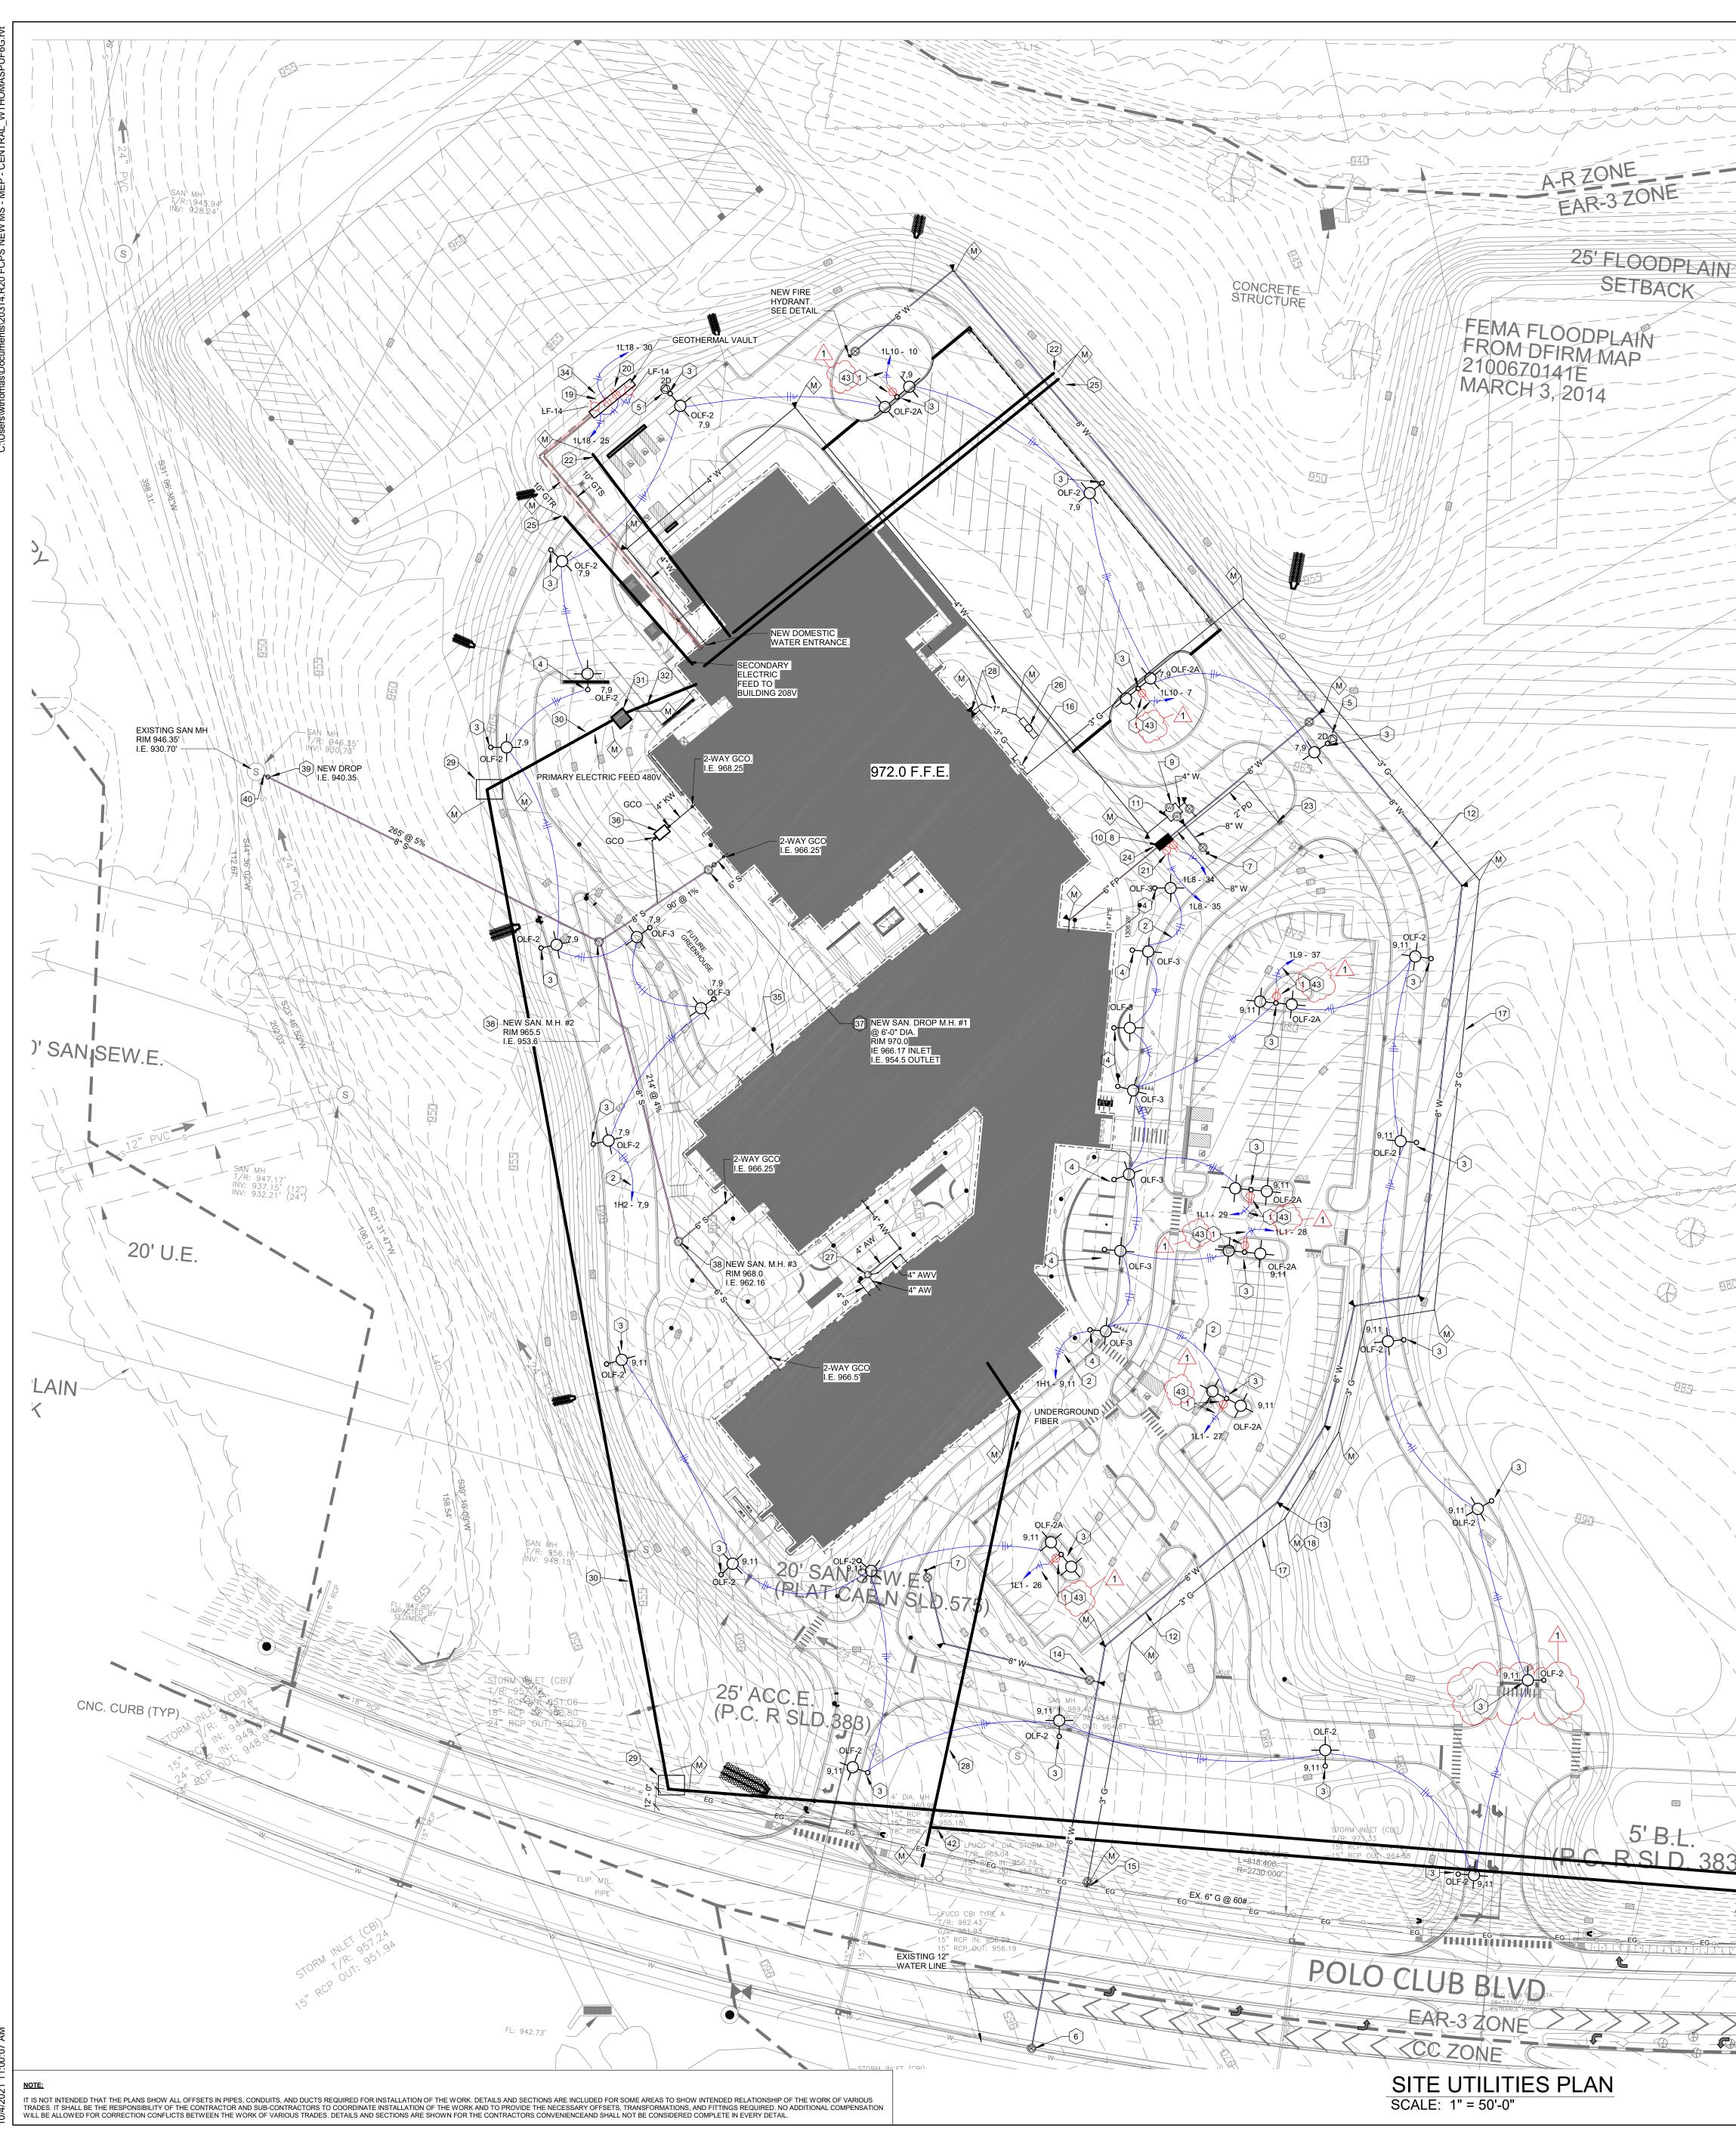

	30 TWO	4" SCH 40 PVC CONDUITS	FOR KENTUCKY UTILITES PRIMARY ELECTRIC.	INSTALL 200 POUND PULL STRING IN CONDUITS	6. 42" MINIMUM BURY.
	31 ELEC	TRIC SERVICE TRANSFOR	MER.		
	32 UND	ERGROUND ELECTRIC SEC	CONDARY.		
	33 ROU	TE PRIMARY CONDUITS TO) KENTUCKY UTILITIES' FACILITIES. COORDINAT	E TERMINATION POINT AND REQUIREMENTS WI	TH KENTUCKY UTILIT
	34 COO	RDINATE LOCATIONS OF A	LL DEVICES WITHIN THE VAULT WITH THE ENG	INEER PRIOR TO ROUGH-IN.	
	35 CAPF	PED 2" DCW LINE FOR FUT	URE CONNECTION TO GREENHOUSE 5'-0" FROM	/ FOUNDATION WALL. SEE SHEET P-000C FOR C	ONTINUATION.
	36 NEW	1500 GAL. GREASE TRAP,	SEE DETAIL ON SHEET U-200.		
	37 NEW	SANITARY DROP MANHOL	E, SEE DETAILS ON SHEET U-201.		
	38 NEW	SANITARY MANHOLE, SEE	DETAIL ON SHEET U-201.		
	39 NEW	SANITARY DROP, SEE DET	TAIL ON SHEET U-201.		
	40 CONI	NECTION TO EXISTING SAM	NITARY MANHOLE PER LFUCG REQUIREMENTS.	COORDINATE SCHEDULING OF TIE-IN WITH LFU	ICG PRIOR TO CONST
	41 RUN PRO	ONE 4" SCH 40 PVC DUCT /IDE A 12" MINIMUM CLEAR	FOR WINDSTREAM SERVICE TO PROPERTY LIN ANCE BETWEEN THIS DUCT AND POWER CONI	E. INSTALL 200 POUND PULL STRING IN DUCT. 3 DUIT. COORDINATE ALL WORK WITH WINDSTRE	0" MINIMUM BURRY. N AM.
	42 INST	ALL WINDSTREAM PEDEST	AL AT THIS LOCATION. TERMINATE WINDSTRE	AM CONDUITS IN PEDESTAL. SEE CODED NOTES	28 AND 41 THIS SHE
	43 RECE	Y Y EPTACLE IS TO BE CONTRO		Y LOCATED BY PANEL THAT FEEDS THIS RECEP	Y Y TACLE. SWITCHING IS
		IROLLED BY A SWITCH ON		5 ON SHEET E-111B.	\sim
			WATER:	PROPANE GAS:	ELECTRIC:
			KENTUCKY AMERICAN WATER COMPANY COLE MITCHAM	SOUTHERN STATES GEORGETOWN, KY	KENTUCKY UTIL JOE OAKLEY
			2300 RICHMOND ROAD LEXINGTON, KY 40502 859-335-3415	ANDREW OWENS 502-863-3630	859-367-4306
	-		COLE.MITCHAM@AMWATER.COM	<u>SANITARY:</u> LFUCG SANITARY SEWER TAP-ON DESK	TELECOMMUNIC WINDSTREAM (\ JEREMY MASON
	-		NATURAL GAS: COLUMBIA GAS COMPANY	DIVISION OF WATER QUALITY TATE BUILDING	SPECTRUM (FIE
	-		TOM WALKER 859-288-0236	125 LISLE INDUSTRIAL AVE., STE. 180 859-258-3433	MATT MERCURI 502-235-5671
			TWALKER@NISOURCE.COM		SPECTRUM (CO
					MATT MERCURI 502-235-5671
30 20'IIF				677.1	
83) 20' U.E. (P.C. R SLD. 383)		5 E	B.I., C. COMM, Bdy		
$(F.C. R SLD. 383)^{-1}$					
			33	TRANS. X4	
				F	
S43°06'14"E					
	-				
	5' S.W. (TYP)		GAS_VALVE		
111111		(TY	CURB		
				<u> </u>	
			1 mai		

REQUIREMENTS WITH KU.

- 24 PROVIDE AND INSTALL ONE TAMPER SWITCH AND ONE FLOW SWITCH TO PIV IN FIRE PROTECTION VAULT. CAPPED WITH PROPER PIPE CAPPING. PROVIDE PROPER UTILITY MARKER ON GRADE. 26 1000 GAL. UNDERGROUND PROPANE TANK AND FILL STATION, INSTALLATION BY OTHERS. ALL ASSOCIATED COST BY THIS CONTACT. SEE SCHEMATIC DETAIL ON SHEET U-202.
 - 25 RUN (1) 4" CONDUIT FROM MECHANICAL ROOM TO 4' PAST DRIVE. RUN CONDUIT 24" BELOW GRADE. CONDUIT IS TO BE TERMINATED UNDERGROUND AND
- 23 TIE SUMP PUMP DISCHARGE INTO STORM STRUCTURE UNDERGROUND.

27 ACID WASTE DILUTION PIT, SEE DETAIL ON SHEEET U-200. SEE UNDERFLOOR PLUMBING PLAN P-000A FOR CONTINUATION.

28 1" PROPANE GAS LINE TO REGULATOR AT BUILDING. INSTALLATION BY TANK SUPPLIER. SEE DETAIL ON SHEET U-202.

- 22 RUN (1) 4" CONDUIT FROM IDF F108 TO 4' PAST DRIVE AND SIDEWALK. RUN CONDUIT 24" BELOW GRADE. CONDUIT IS TO BE TERMINATED UNDERGROUND AND CAPPED WITH PROPER PIPE CAPPING. PROVIDE PROPER UTILITY MARKER ON GRADE.
- PROVIDE AND INSTALLWEATHERPROOF/GFI RECEPTACLES INSIDE FIRE PROTECTION VAULT FOR CONVENIENCE AND FOR FIRE PROTECTION SUMP PUMP. USE #8 CONDUCTORS.
- 20 CONTINUE CIRCUIT TO LIGHT FIXTURES IN VAULT. RECEPTACLE AND LIGHT TO BE ON THE SAME CIRCUIT.
- 18 UTILITY MARKER. SEE DETAIL ON SHEET U-200. 19 PROVIDE AND INSTALLWEATHERPROOF /GFI RECEPTACLES INSIDE GEOTHERMAL VAULT FOR CONVENIENCE AND FOR GEOTHERMAL SUMP PUMP. USE #8 CONDUCTORS
- 17 NEW 3" G. SERVICE LINE. INSTALLATION AND FINAL ROUTING BY COLUMBIA GAS.
- 16 NEW GAS METER SET BY COLUMBIA GAS. CONTRACTOR SHALL PROVIDE BUILDING SIDE REGULATOR AND EXTEND NEW 3" G. LINE TO BUILDING PER COLUMBIA GAS SPECIFICATIONS. SEE DETAIL ON SHEETE U-202.
- FEES BY THIS CONTRACT. WORK BY COLUMBIA GAS.
- 15 CONTRACTOR SHALL COORDINATE WITH COLUMBIA GAS FOR NEW GAS SERVICE AND GAS METER SET AS REQUIRED. ALL SUBMITTALS AND ASSOCIATED
- 14 VALVE AND VALVE BOX (TYPICAL). SEE DETAIL ON SHEET U-202.
- 13 THRUST BLOCK (TYPICAL). SEE DETAIL ON SHEET U-200.

- 12 NEW 8" W. BY KAWC. KAWC REQUIRES A 20 FT UTILITY EASEMENT.
- 11 CONNECT NEW 4" W. PER KAWC REQUIREMENTS
- 10 CONNECT NEW 6" FP PER KAWC REQUIREMENTS.

GENERAL NOTES:

EXCAVATION.

OF THIS CONTRACTOR.

CODED NOTES:

18

FUTURE WO BASIN PLAT CAB R SLD 7/

TEMP. DRAINAGE EASE PLAT CAB R SLD 754 (SEE NOTE 12)

975--

- 9 DOMESTIC WATER METER BATTERY SET BY KAWC.
- 8 NEW FIRE PROTECTION VAULT WITH FDC AND PIV. SEE DETAIL ON SHEET U-202.

2 CIRCUIT FOR SITE LIGHTING USE #6 CONDUCTORS FOR ENTIRE CIRCUIT.

3 PROVIDE POLE BASE PER " POLE BASE DETAIL - TYPE A".

4 PROVIDE POLE BASE PER " POLE BASE DETAIL - TYPE B".

AND FEES BY THIS CONTRACT. ALL WORK BY KAWC

REQUIRED SUBMITTALS AND ASSOCIATED FEES BY THIS CONTRACTOR.

COMPANIES BEFORE DOING ANY EXCAVATING

INSTALL DOMESTIC WATER PIPING WITH 3'-6" MINIMUM COVER.

INSTALL FIRE PROTECTION WITH 4'-0" MINIMUM COVER.

INSTALL NATURAL GAS PIPING WITH 2'-0" MINIMUM COVER.

INSTALL SITE SANITARY PIPING WITH 3'-0" MINIMUM COVER.

SITE LIGHTING CIRCUITS SHALL BE #6 CONDUCTORS IN 1-1/4" CONDUITS. TESTING OF EXTERIOR SEWER MANHOLES SHALL BE AS FOLLOWS:

ALL TESTS SHALL BE DONE PRIOR TO BACKFILLING.

PROVIDE INSULATED COPPER TRACER WIRE WHERE REQUIRED BY PLUMBING CODE.

WORK CONTINUOUSLY TO RESTORE SERVICE TO SATISFACTION OF THE OWNER.

THE CONTRACTOR'S RESPONSIBILITY TO PROTECT ALL UTILITIES DURING CONSTRUCTION.

BE THE SAME AS FINISHED GRADE IN THE SAME AREA. SEE ARCHITECTURAL PLANS FOR FINISHED GRADES.

SHALL REMAIN CONSTANT WITHOUT PUMPING ADDITIONAL AIR INTO THE SYSTEM.

POLE BASE TO ACCOMMODATE BOLLARD. RUN CIRCUIT USING #8 CONDUCTORS FOR THE ENTIRE CIRCUIT.

LOCATION OF UTILITIES ARE APPROXIMATE AND SUBJECT TO MINOR CHANGES IN THE FIELD. DO NOT SCALE THE DRAWINGS.

OOPERATE WITH THE OWNER TO MAKE THE REQUIRED ADJUSTMENTS AT AN EQUITABLE CHANGE IN THE CONTRACT PRICE.

INSTALL UNDERGROUND FEEDERS WITH 2'-0" MINIMUM COVER. PRIMARY ELECTRIC FEEDER SHALL HAVE MINIMUM OF 42" OF COVER.

- 7 NEW FIRE HYDRANT BY KAWC.

THIS CONTRACTOR SHALL COORDINATE ALL SITE UTILITY WORK REQUIRED WITH LOCAL UTILITY COMPANIES TO MEET PROJECT SCHEDULE. ALL

THE CONTRACT DOCUMENTS SHOW THE APPROXIMATE LOCATION OF THE EXISTING AND NEW SUBSURFACE UTILITY LINES. THESE LINES HAVE BEEN IDENTIFIED AND LOCATED AS ACCURATELY AS POSSIBLE USING AVAILABLE INFORMATION. THE CONTRACTOR IS RESPONSIBLE FOR VERIFYING ALL ACTUAL LOCATIONS. IF ANY CHARTED, UNCHARTED, OR MIS-LOCATED UTILITY SERVICE IS INTERRUPTED FOR ANY REASON, THE CONTRACTOR WILL

SHOULD EXISTING UTILITIES REQUIRE RELOCATION OR REROUTING NOT SHOWN OR INDICATED TO BE RELOCATED OR REROUTED, CONTACT AND

EXISTING UTILITIES SHOWN MAY ACTUALLY BE IN DIFFERENT LOCATIONS AND ADDITIONAL UTILITIES NOT SHOWN MAY EXIST AND MAY BE IN USE. IT IS HE CONTRACTOR IS RESPONSIBLE FOR LOCATING ALL EXISTING UNDERGROUND UTILITIES PRIOR TO EXCAVATING. THE OWNER WILL NOT LOCATE THE UTILITIES FOR THE CONTRACTOR IS RESPONSIBLE FOR LOCATING ALL EXISTING UNDERGROUND UTILITIES FRIOR TO EXCAVATING. THE OWNER WILL NOT LOCATE THE UTILITIES FOR THE CONTRACTOR. IF AN OUTSIDE SERVICE OR COMPANY IS REQUIRED TO ACCURATELY LOCATE BURIED UTILITIES THE CONTRACTOR IS RESPONSIBLE FOR SCHEDULING THIS WORK AND IS RESPONSIBLE FOR THE COSTS. THE CONTRACTOR SHOULD CONTACT APPROPRIATE UTILITY

TOP ELEVATIONS OF NEW UNDERGROUND STRUCTURE ARE APPROXIMATE AND ARE FOR ESTIMATING PURPOSES ONLY. ACTUAL TOP ELEVATIONS MUST

EXCAVATION: MATERIALS TO BE EXCAVATED SHALL INCLUDE EARTH AND ANY OTHER MATERIAL, INCLUDING ROCK ENCOUNTERED IN TRENCH

EXTERIOR SANITARY SEWER SHALL BE PLUGGED BETWEEN MANHOLES AND SUBJECTED TO AN AIR PRESSURE TEST WITH ALL OPENINGS TIGHTLY CLOSED. AIR SHALL BE PUMPED IN UNTIL THE PRESSURE IS NOT LESS THAN 5 POUNDS PER SQUARE INCH. THE AIR PRESSURE GAGE MANHOLE SHALL BE PLUGGED AND FILLED WITH WATER AND A VISUAL INSPECTION MADE FOR LEAKS. ALL LEAKS SHALL BE CORRECTED.

PROVIDE SLEEVE ON WATER SERVICE PIPING WHERE WATER AND SEWER PIPING INTERSECT AS REQUIRED BY PLUMBING CODE. ALL ASSOCIATED UTILITY SUBMITTALS, COORDINATION, TAP FEES AND CONSTRUCTION COST FOR UTILITIES BY OTHERS SHALL BE RESPONSIBLITY

CIRCUIT FOR 120V RECEPTACLE IN RECEPTACLE BOLLARD. RECEPTACLE BOLLARD IS TO BE ANCHORED IN CONCRETE POLE BASE AS LIGHT POLE. EXTEND

RUN DATA CABLES UP INSIDE LIGHT POLE TO A SURFACE MOUNTED 4" X 4" WEATHERPROOF BOX MOUNTED ON POLE AT 12' ABOVE GRADE. TERMINATE CABLES ON JACKS INSIDE BOX. MAKE PENETRATION THROUGH POLE AND APPLY RUST PREVENTING TOUCH-UP PAINT PER MANUFACTURER'S RECOMMENDATIONS. DATA IS FOR FUTURE OWNER PROVIDED WIFI.

6 CONTRACTOR SHALL COORDIANTE WITH KAWC FOR NEW SERVICE LINE, FIRE HYDRANTS AND DOMESTIC WATER METER SET AS REQUIRED. ALL SUBMITTALS

29 INSTALL KENTUCKY UTILITIES ABOVE GRADE PULL BOX. PULL BOX WILL BE PROVIDED BY KU. ROUTE PRIMARY CONDUITS INTO PULL BOX COORDINATE


FUCKY UTILITIES.

R TO CONSTRUCTION. JM BURRY. MUST


41 THIS SHEET. SWITCHING IS TO BE TUCKY UTILITIES


ECOMMUNICATIONS: DSTREAM (VOICE): EMY MASON 859-357-6250 CTRUM (FIBER) T MERCÙRIO 235-5671

CTRUM (COAX) : T MERCÙRIO 235-5671

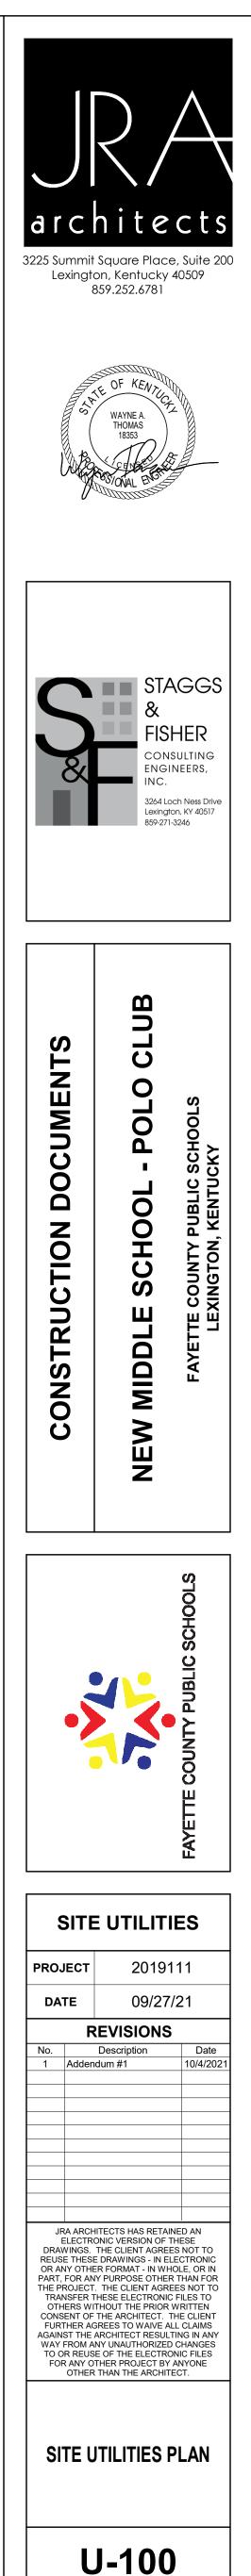

COPYRIGHT 2021 - JRA, INC.

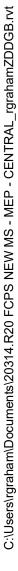

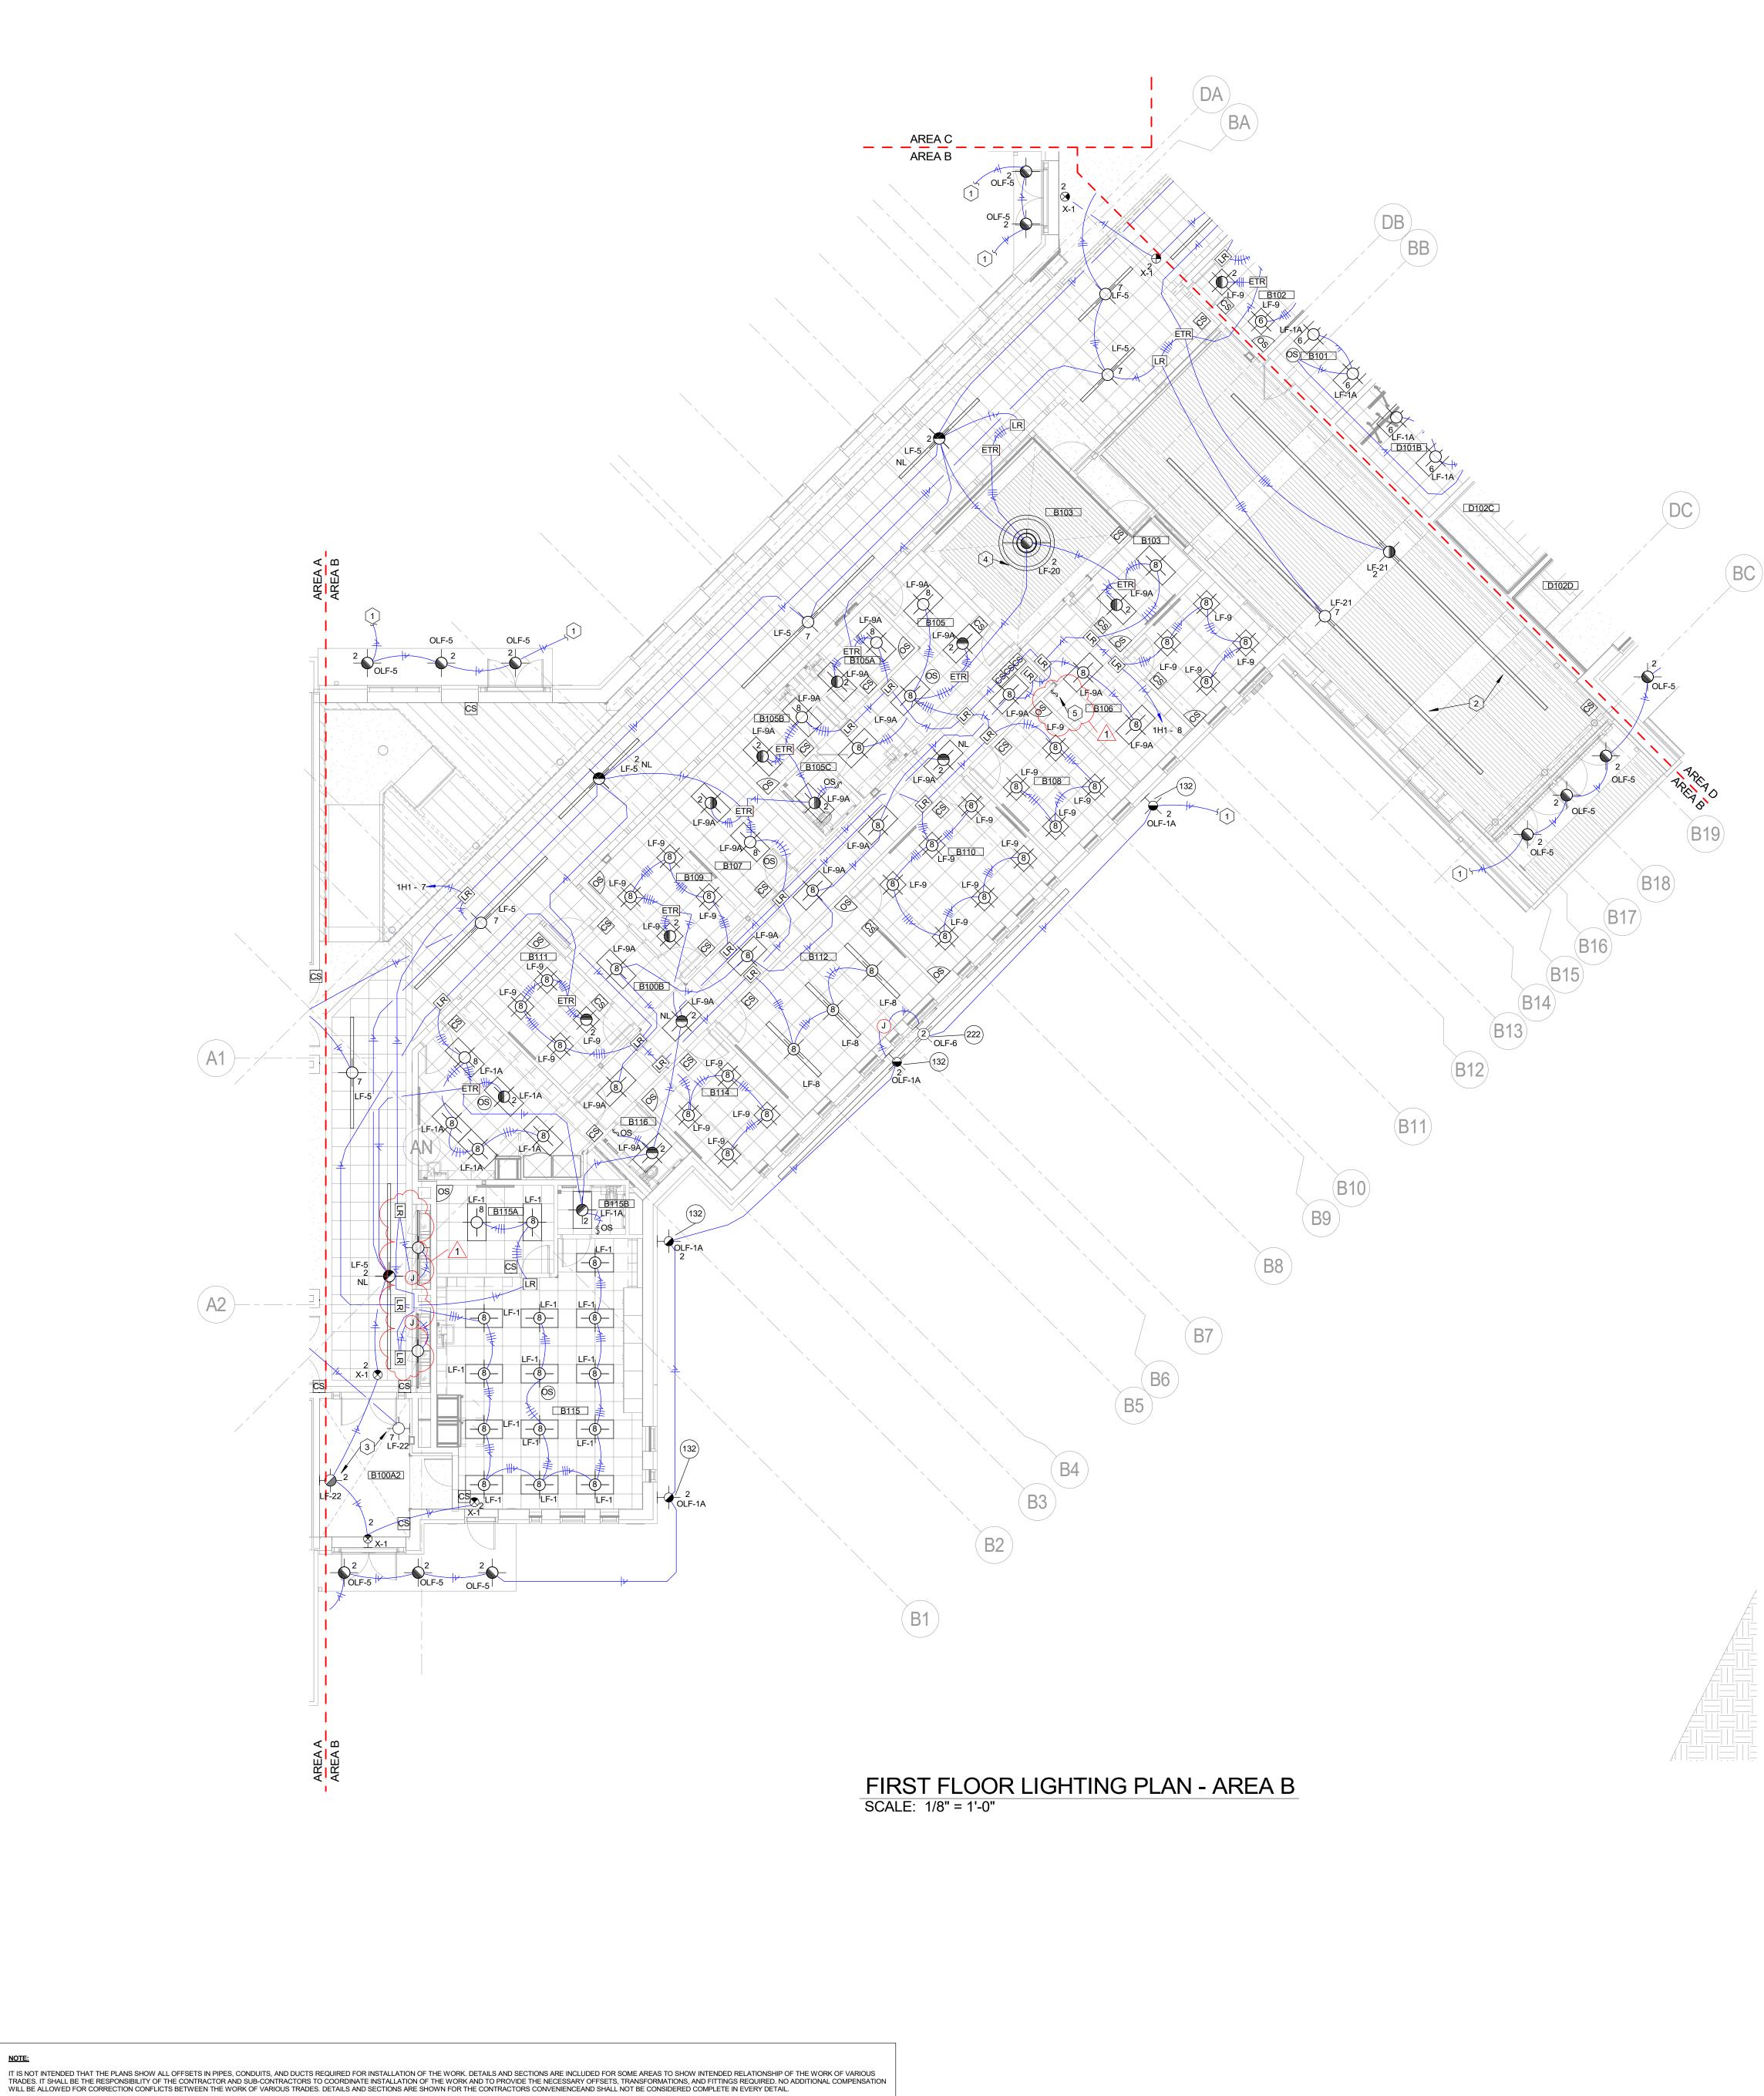

		ROOM SCHEDULE
	ROOM NUMBER	ROOM NAME
CODED NOTES:		
	A100A	CORRIDOR
1 CONTINUE TO LIGHT FIXTURE ON SECOND FLOOR.	A100B	CORRIDOR
	A100C	CORRIDOR
2 FIXTURE IS TO BE AT 21' - 9" A.F.F. TO BOTTOM OF FIXTURE.	A100D	CORRIDOR
	A100E	CORRIDOR
3 FIXTURE IS TO BE AT 10' - 0" A.F.F. TO BOTTOM OF FIXITURE.	A101	CUST.
	A102	SCIENCE CLASSROOM
4 MOUNT FIXTURE TO CEILING WITH AN OVERALL HEIGHT OF 131,5"	A102A	SCIENCE STORAGE
	A103	CHASE
5 SWITCH IS TO BE INSTALLED FOR PARKING LOT RECEPTACLES AND IS	A104	STORAGE
TO BE CONNECTED TO LIGHTING CONTROL SYSTEM RELAYS PER NOTE	A105	RESTROOMS
43 ON SHEET U-100. SWITCH IS TO BE LABELED "PARKING LOT	A105A	RR
RECEPTACLES."	A105B	RR
	A105C	RR
	A105D	RR
	A105E	RR
	A105F	RR
	A106	CLASSROOM
	A107	MDF
	A108	CLASSROOM
	A109	WORKROOM
	A110	CLASSROOM
	A111	AP OFFICE
	A112	CLASSROOM
	A113	(COMPUTER) FLEX / MAK
	A114	CLASSROOM
	A115	RESTROOMS
	A115A	RR
	A115B	RR
	A115C	RR
	A115D	RR
	A115E	RR
	A115F	RR
	A116	CLASSROOM
	A117	CHASE
	A118A	RESOURCE
	A118B	RESOURCE
	A119	STAFF

A120 A121

A122

A123 A124 A124A A125 A126 A127 A128 A130 A132A A132B A134 A136 A136A B100A B100A1 B100A2 B100B B101 B102

B102 B103 B104 B105 B105A B105B

B105C

B106 B107

B108 B109 B110

B111

B112 B113 B114

B115 B115A B115B B116 C100A C100A C100C C100C C100C C100C C100E C101 C102 C103 C104 C105 C105A C105B C105C C105D C105E C105F C105F C106 C107 C108 C109 C110 C111

C112 C112A C113 C114 C114A C114B C115 C115A C115B C115C C115D C115E

C115F C116 C117 C118 C118A C118A C118B C119 C120 C120

E111 E111A

EL1

F100A F101 F101A F101B F101C F102B F102B F102D F103 F103A F103A F103A F103C F103D F103E F103F F103G F103H F104 F105


F106 F107 F108 G100A G100B G101 G101A G101B G101C G101D G101E G101F


G101G

G101H G101J G102 G103


G103A G104 G105 G105A G105B G105C G106 G106A G107 G107A G107A G108A G108B G108A G108B G108C G109 G1001A1 R1

STA1 STB1 STC1 STD1

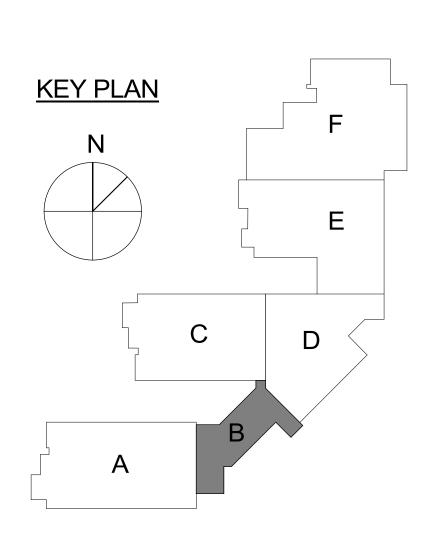

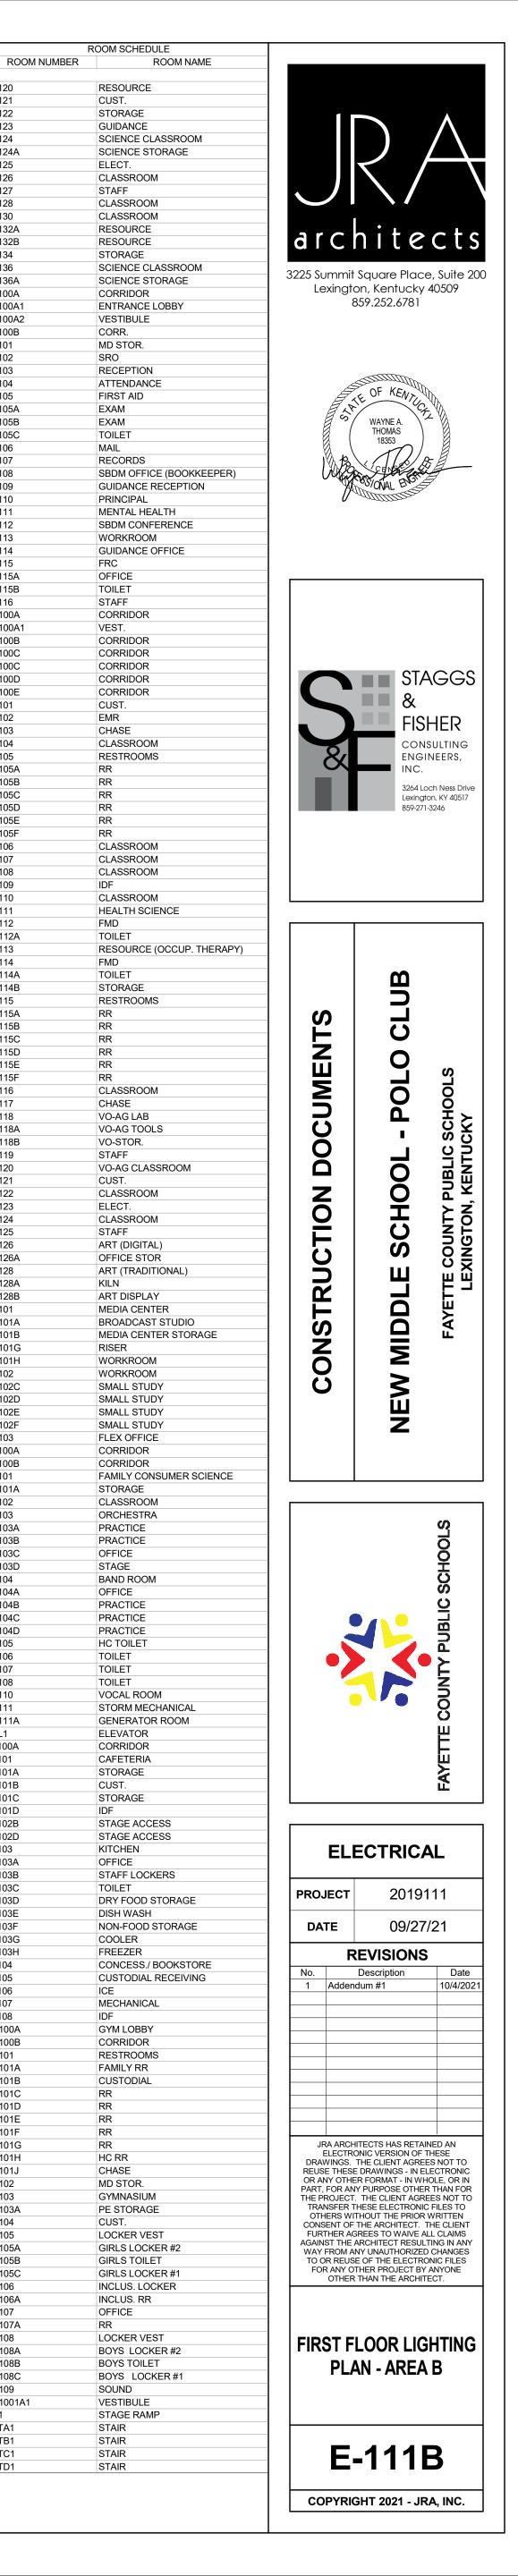



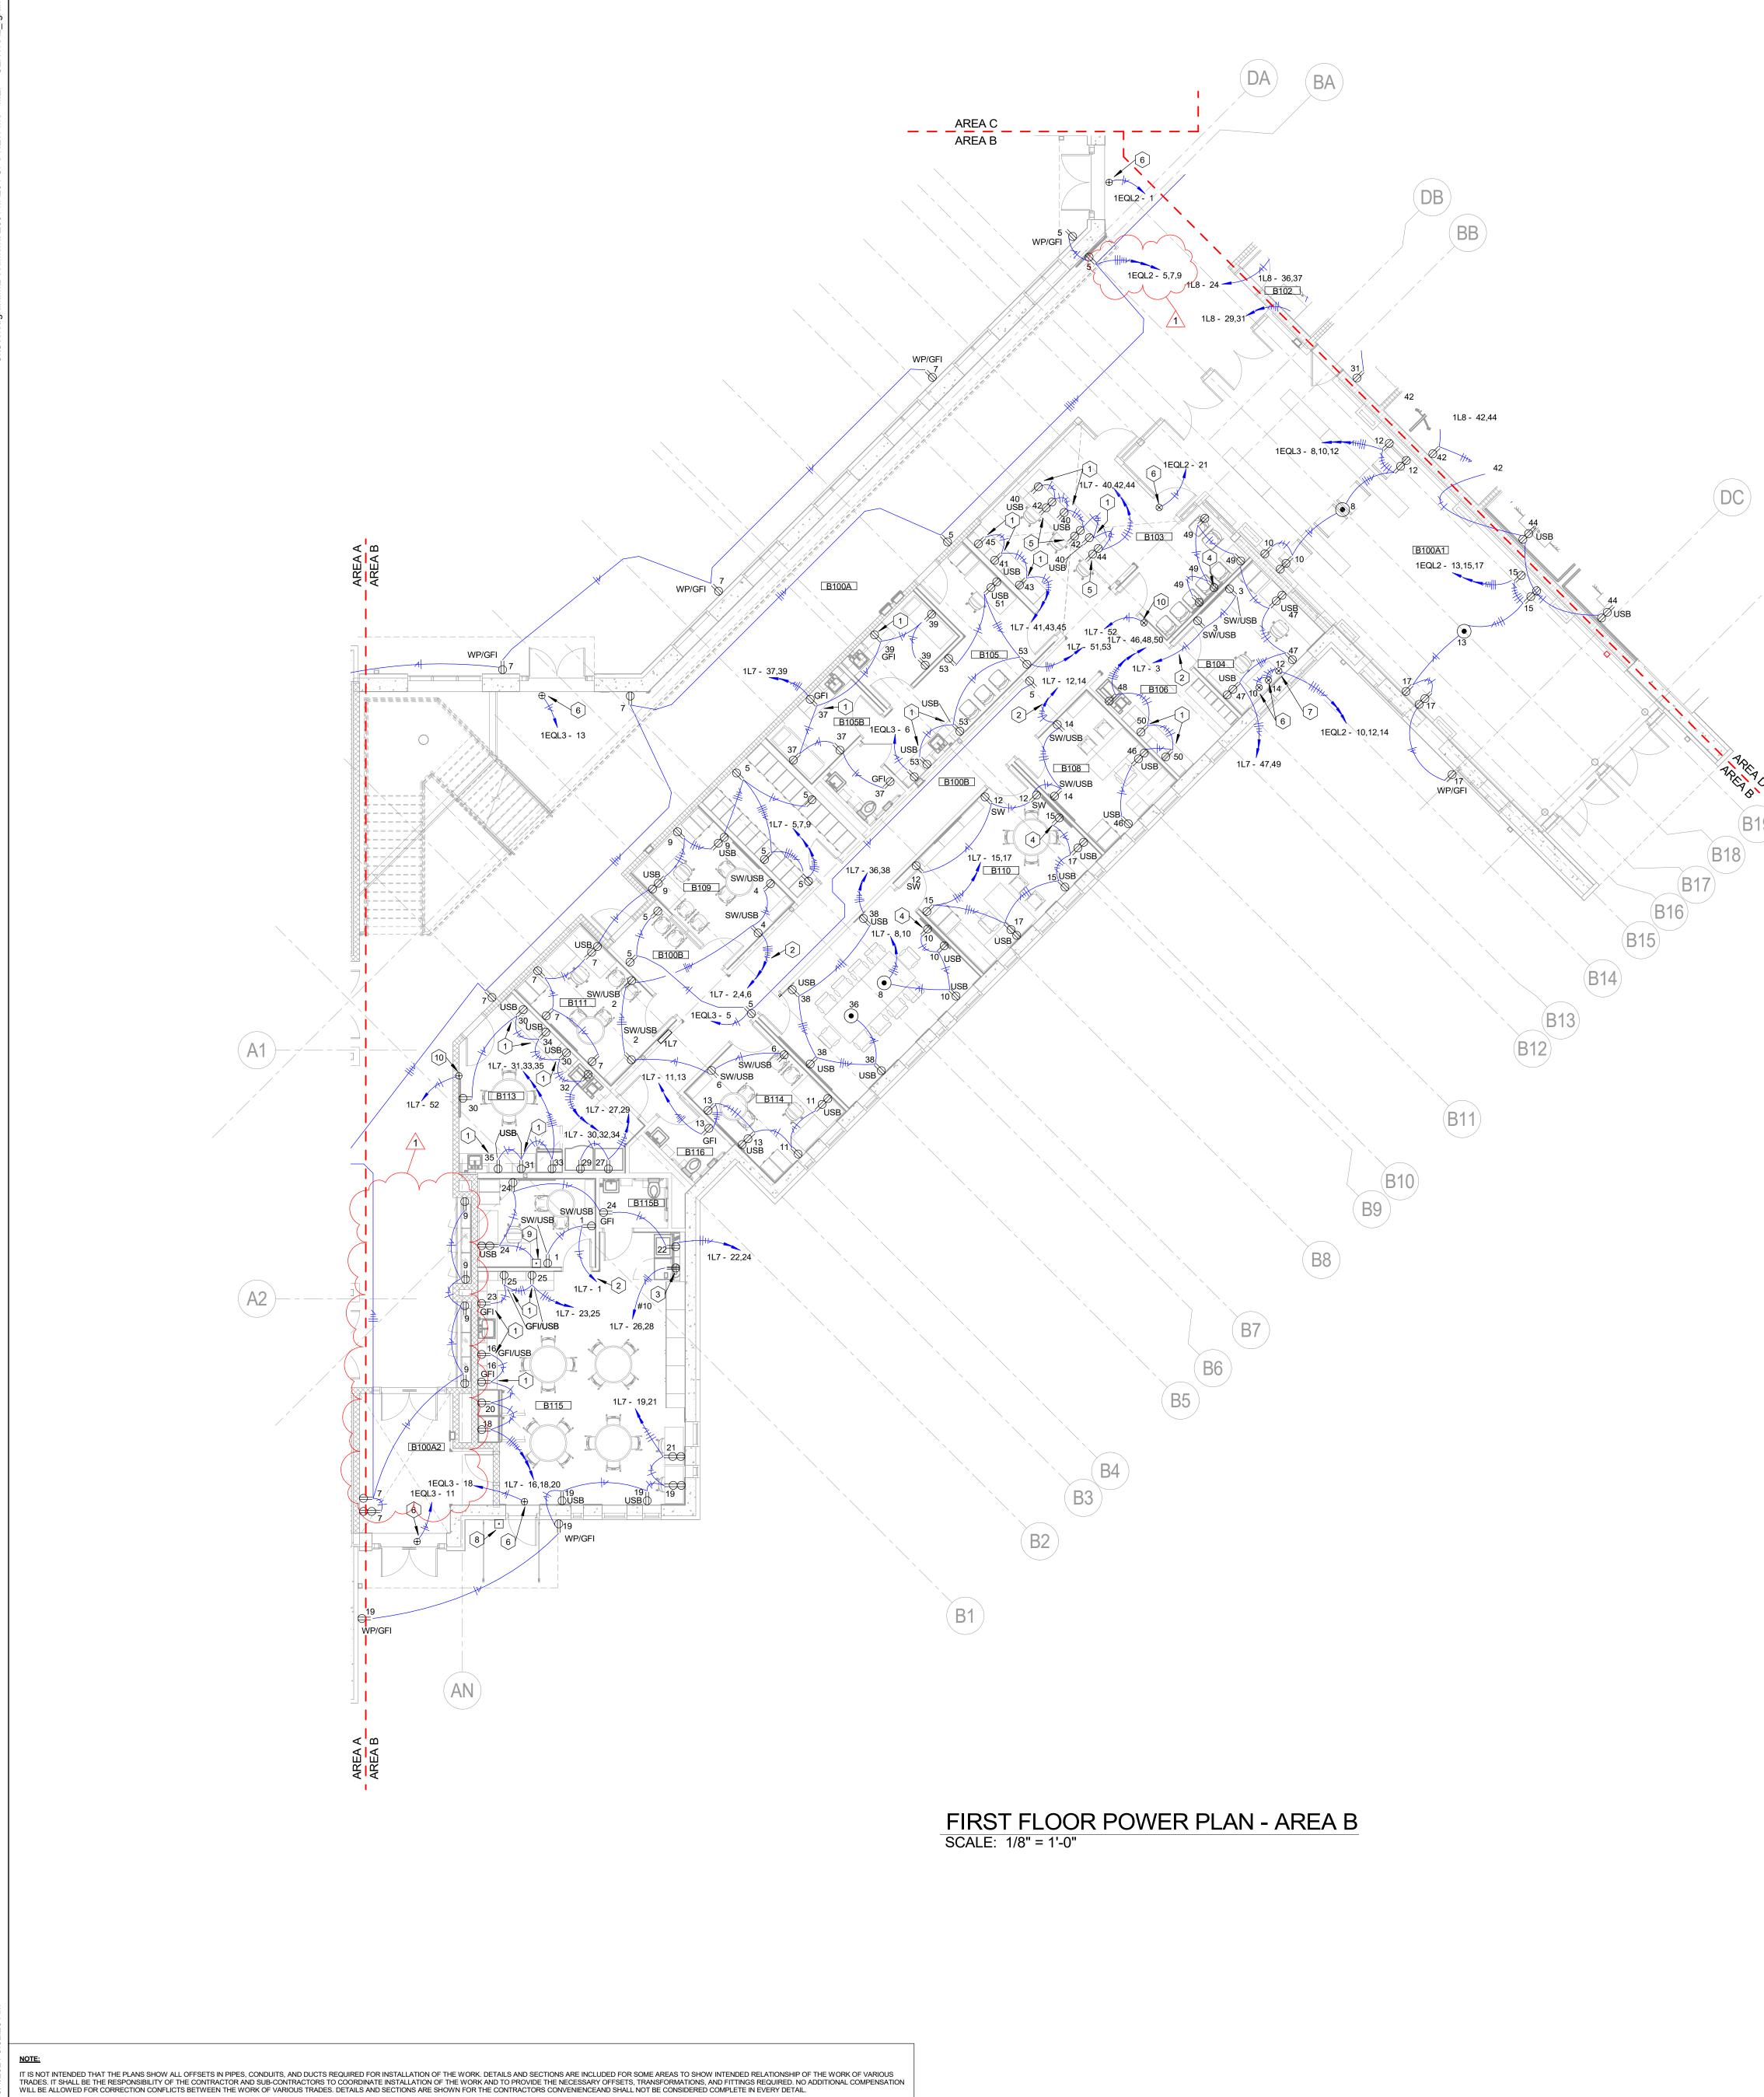

CODED NOTES:

- 1 INSTALL RECEPTACLES 2" ABOVE BACKSPLASH/COUNTER. REFER TO ARCHITECTURAL DRAWINGS AND APPROVED CASEWORK SHOP DRAWINGS.
- 2 RECEPTACLE CIRCUIT TO BE CONTROLLED BY THE LIGHTING CONTROL SYSTEM RELAY.
- 3 30A/2P+GND DRYER RECEPTACLE.
- 4 INSTALL RECEPTACLE AT SAME ELEVATION AND ADJACENT TO TELEVISION MOUNT. COORDINATE WITH ARCHITECTURAL DRAWINGS.
- 5 INSTALL RECEPTACLE IN KNEE SPACE OF CASEWORK. COORDINATE WITH APPROVED CASEWORK SHOP DRAWINGS PRIOR TO ROUGH IN.
- 6 MAKE CONNECTION TO DOOR POWER SUPPLY. FIELD VERIFY.
- 7 MAKE 120V CONNECTION TO MOTORIZED DOOR OPERATOR. 8 PROVIDE CONNECTION TO WEATHERPROOF FRC DOORBELL. INSTALL AT 48" A.F.F. TO TOP. CONNECT TO DOORBELL BUZZER/LIGHT. SEE NOTE #9
- THIS SHEET. 9 DOORBELL BUZZER/LIGHT WITH 120V TRANSFORMER. INSTALL AT 8' A.F.F. CONNECT TO FRC DOORBELL. SEE NOTE #8 THIS SHEET.
- 10 120V POWER CONNECTION FOR TIME CLOCK AT 48" A.F.F.

ROOM NUMBER	ROOM NAME
A100A	CORRIDOR
A100B	CORRIDOR
A100C	CORRIDOR
A100D	CORRIDOR
A100E	CORRIDOR
A101	CUST.
A102	SCIENCE CLASSROOM
A102A	SCIENCE STORAGE
A103	CHASE
A104	STORAGE
A105	RESTROOMS
A105A	RR
A105B	RR
A105C	RR
A105D	RR
A105E	RR
A105F	RR
A106	CLASSROOM
A107	MDF
A108	CLASSROOM
A109	WORKROOM
A110	CLASSROOM
A111	AP OFFICE
A112	CLASSROOM
A113	(COMPUTER) FLEX / MAKER
A114	CLASSROOM
A115	RESTROOMS
A115A	RR
A115B	RR
A115C	RR
A115D	RR
A115E	RR
A115F	RR
A116	CLASSROOM
A117	CHASE
A118A	RESOURCE
A118B	RESOURCE
A119	STAFF

ROOM SCHEDULE

ROOM NUMBER

A122

A123

A124

A124A

A125

A126

A127 A128

A130 A132A

A132B

A134 A136 A136A

B100A

B100A1

B100A2 B100B

B101

B102

B103

B104 B105

B105A

B105B

B105C

B106

B108

B109

B110

B111

B112

B113

B114

B115

B115A

B115B

B116 C100A

C100A1 C100B C100C C100C C100D C100D

C101

C102

C103 C104

C105 C105A C105B

C105C C105D

C105E C105F C106

C107 C108

C109

C110

C111

C112

C112A

C113

C114

C114A C114B C115 C115A C115B

C115C C115D

C115E

C115F C116 C117 C118 C118A C118A C118B C119 C120 C121

C122 C123 C124 C125 C126 C126A C128 C128A C128B D101 D101A D101B D101G D101H D102 D102C D102C D102C D102C D102C D102C D102C E103 E104 E103 E103A E103A

E108 E110

E111

E111A

F100A F101 F101A F101D F102B F102D F102B F102D F103 F103A F103A F103C F103C F103C F103C F103F F103G F103H F104 F105

F106 F107 F108 G100A G100B G101 G101A G101B G101C G101D G101E G101F

G101G

G101H G101J G102 G103

G103A

G105A G104 G105 G105A G105B G105C G106 G106A G107

G107 G107A G108 G108A G108B G108C G109 G1001A1

R1

STA1 STB1 STC1

STD1

EL1

B107

CUST.

ELECT.

STAFF

CORR.

SRO

EXAM

EXAM

MAIL

FRC

OFFICE

TOILET

STAFF

VEST.

CUST.

CHASE

FMR

IDF

FMD

FMD

TOILET

TOILET

CHASE

STAFF

CUST.

ELECT.

STAFF

KILN

RISER

OFFICE

OFFICE

TOILET

IDF

OFFICE

TOILET

ICE

IDF

HC RR

CHASE

CUST.

OFFICE

SOUND

STAIR STAIR

STAIR


STAIR


RR


STAGE


TOILET

BC

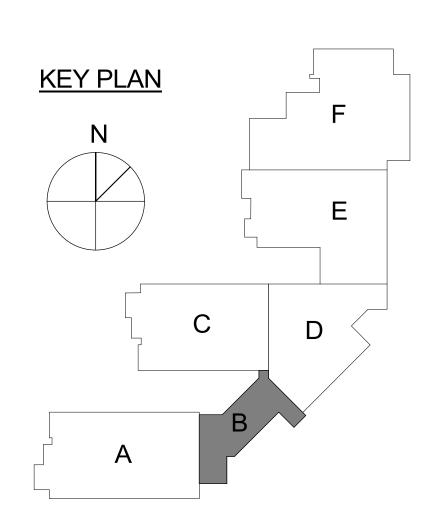

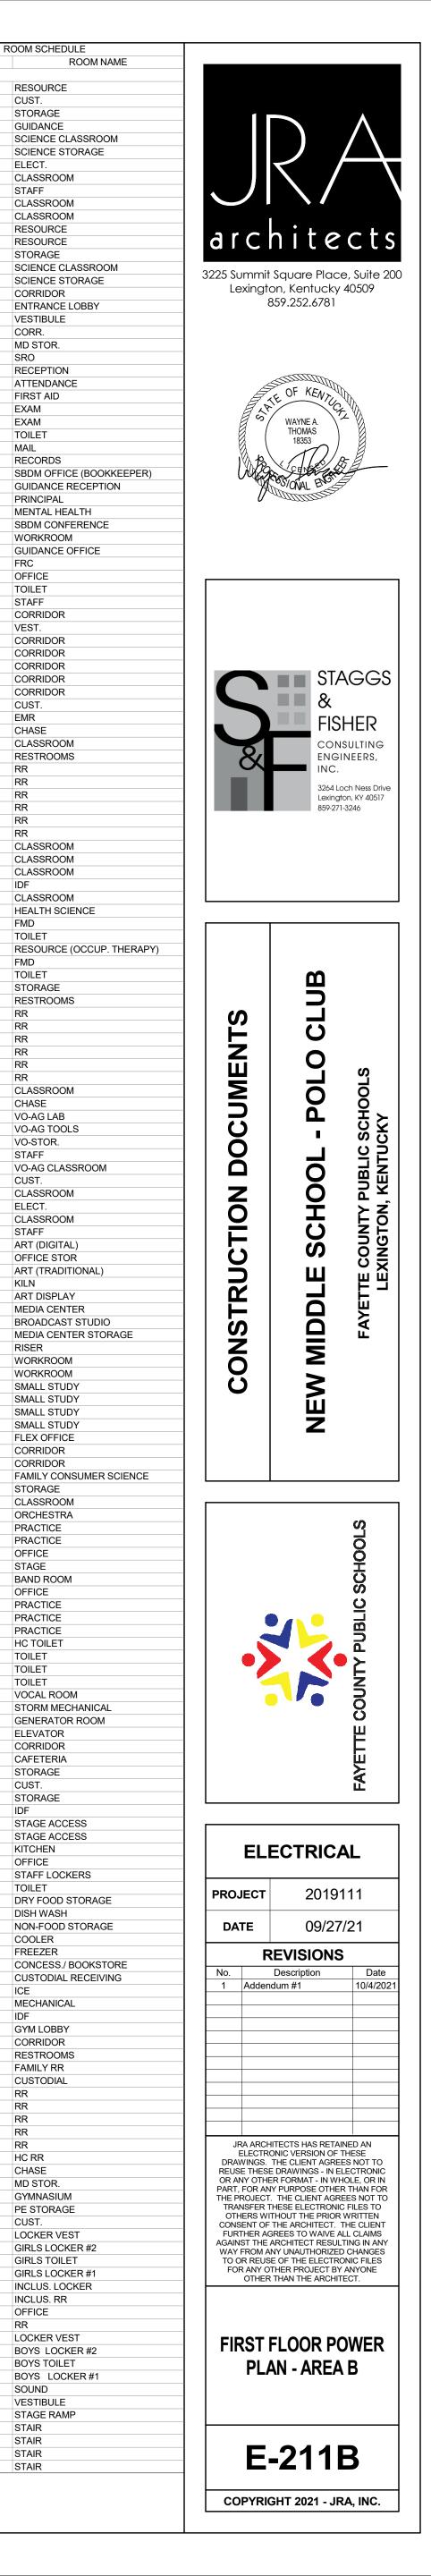

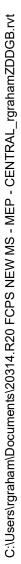

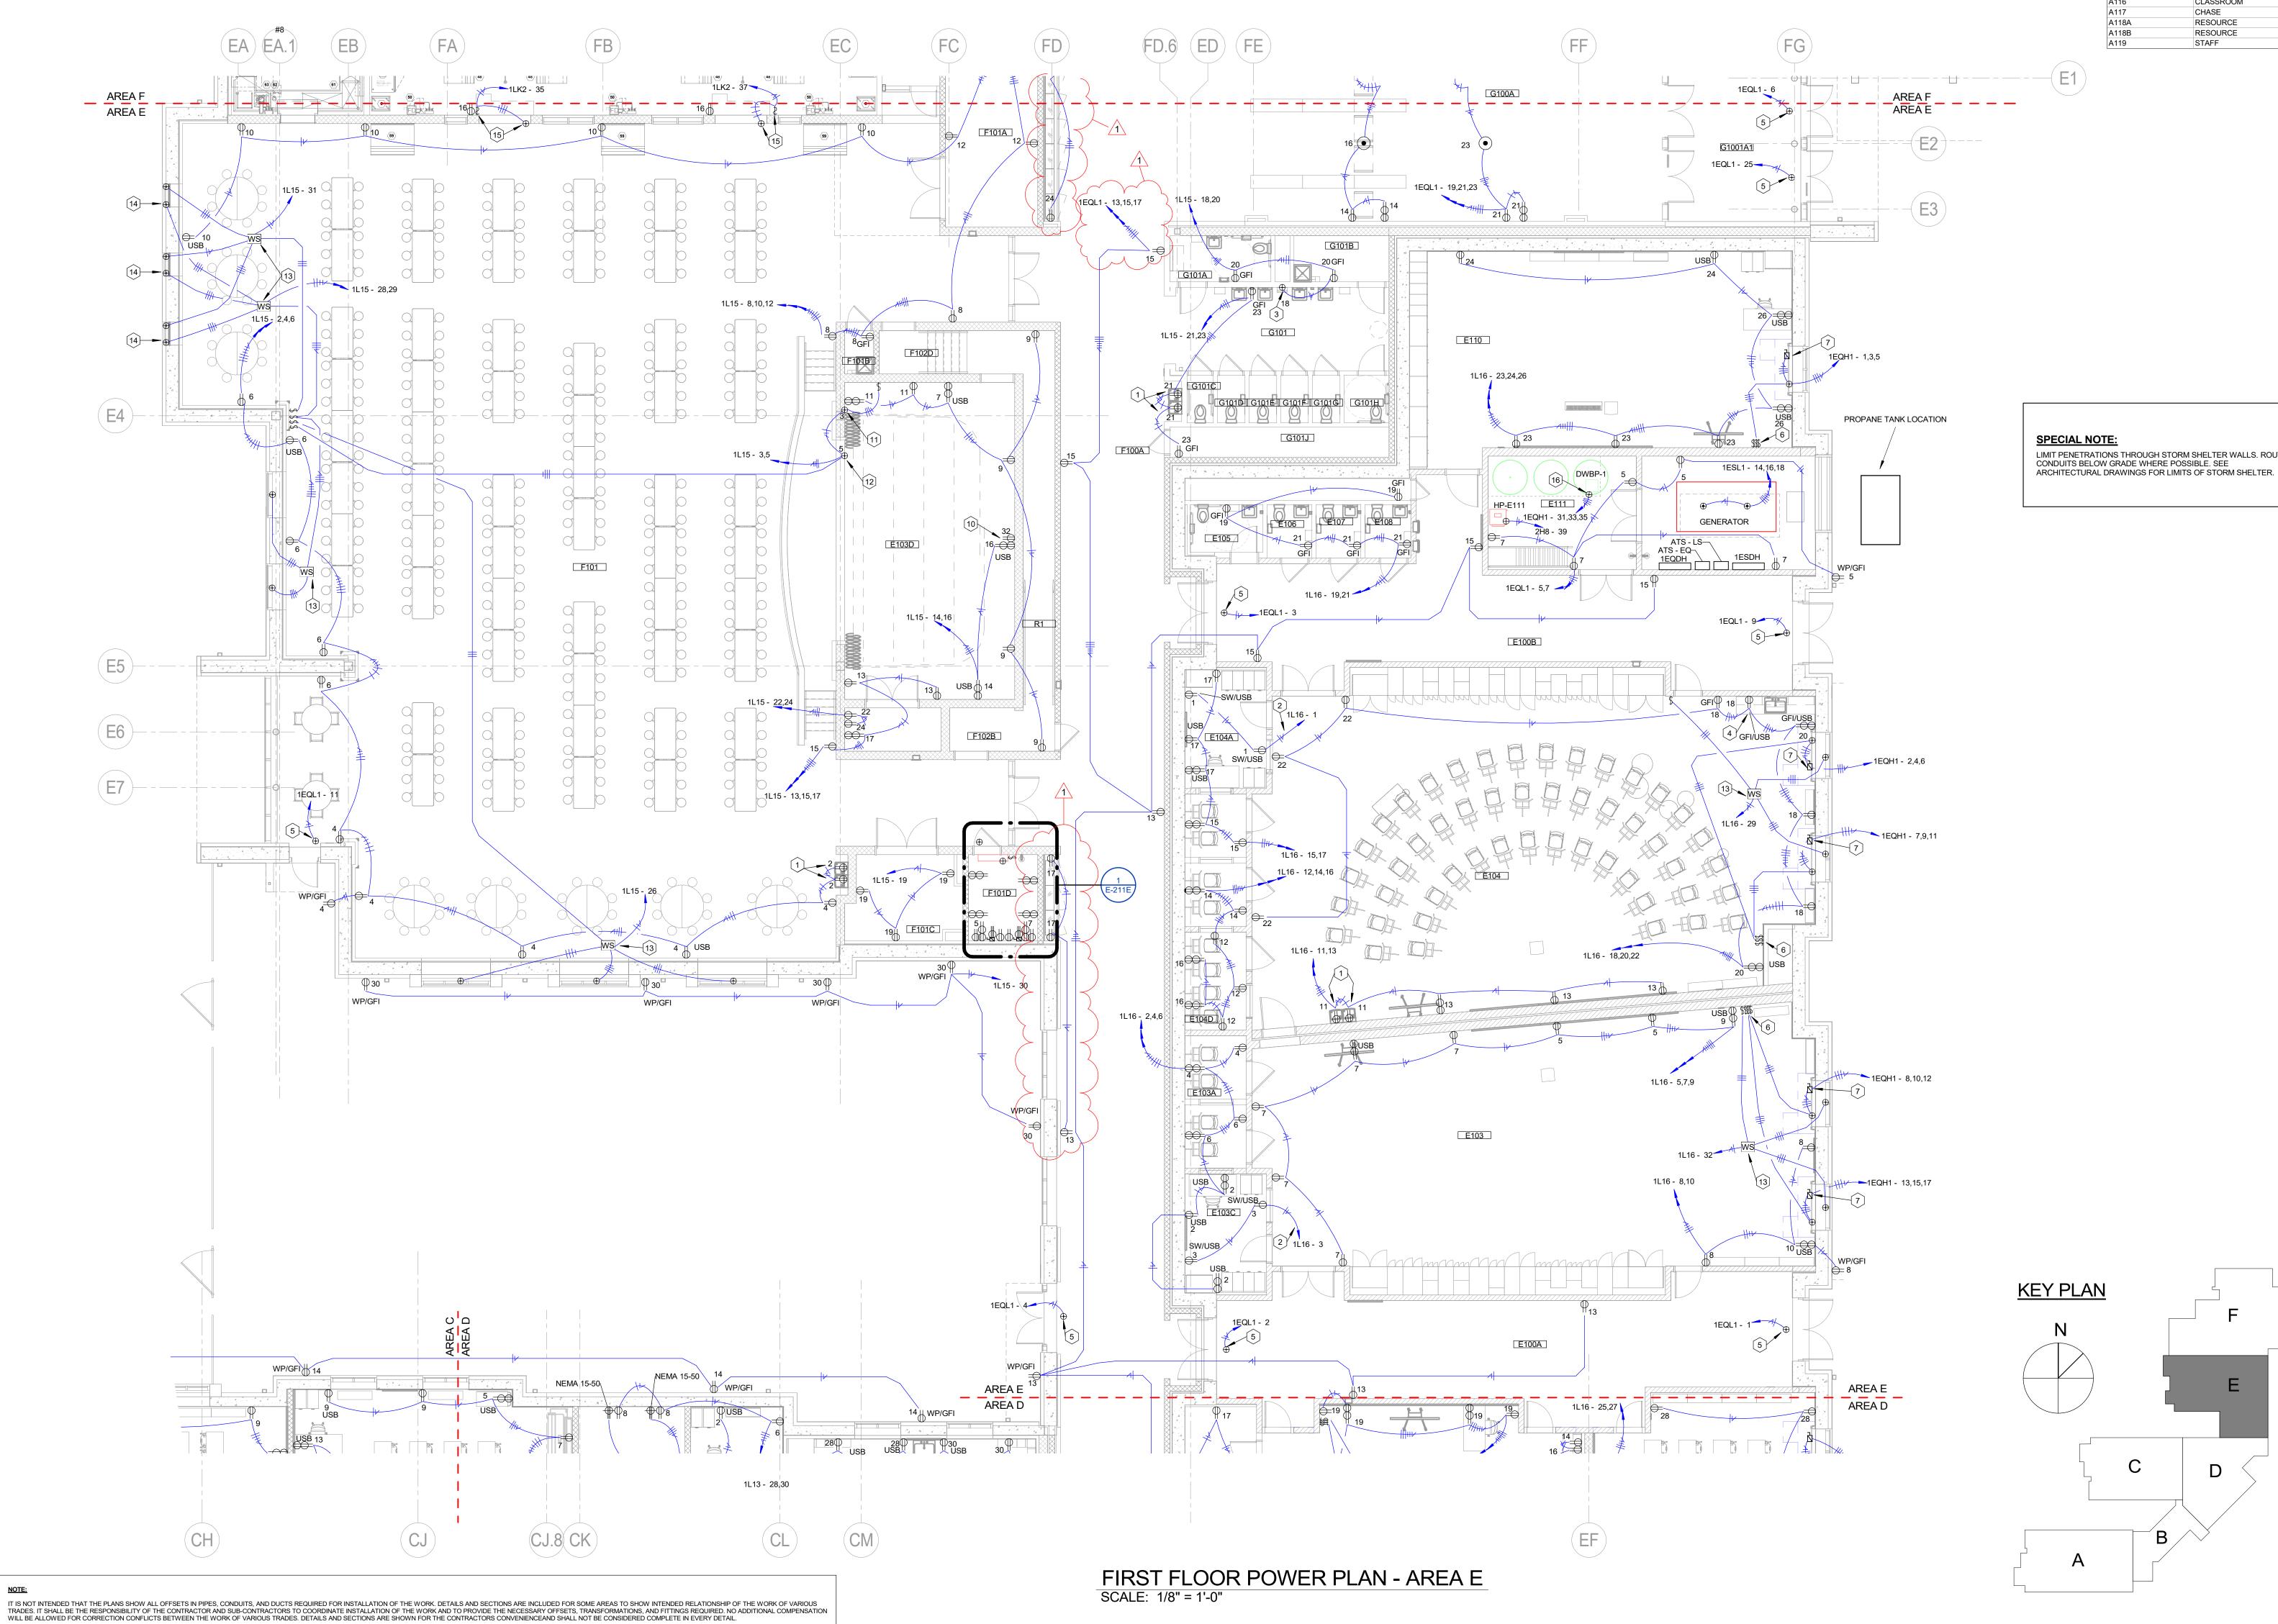




CODED NOTES: 1 PROVIDE RECEPTACLE FOR WATER COOLER. INSTALL RECEPTACLE BEHIND WATER COOLER SKIRT AND PER MANUFACTURER'S INSTRUCTIONS. 2 RECEPTACLE CIRCUIT TO BE CONTROLLED BY THE LIGHTING CONTROL SYSTEM RELAY. 3 PROVIDE ELECTRICAL POWER CONNECTION TO HAND DRYER PER MANUFACTURER'S SPECIFICATIONS. COORDINATE EXACT LOCATION/ELEVATION WITH ARCHITECTURAL DRAWIGNS. 4 INSTALL RECEPTACLES 2" ABOVE BACKSPLASH/COUNTER. REFER TO ARCHITECTURAL DRAWINGS AND APPROVED CASEWORK SHOP DRAWINGS. 5 MAKE CONNECTION TO DOOR POWER SUPPLY. FIELD VERIFY. 6 INSTALL CONTROL STATION AT 48" A.F.F TO TOP OF BUTTON. CONTROL STATION WILL BE PROVIDED WITH THE SHUTTER SYSTEM. COVER WITH A CLEAR, PLASTIC, HINGED COVER. LABEL WITH SIGN READING, "STORM SHELTER SHADES". COORDINATE SIZE OF WIREGUARD WITH CONTROL STATION SHOP DRAWING. INSTALL 15A FUSED DISCONNECT AT SAME ELEVATION AS ROLLER SHADE ENCLOSURE. COORDINATE EXACT LOCATION AND ELEVATION WITH ARCHITECTURAL DRAWINGS.



- CODED NOTES:
- 8 60A/2P/208V FUSED DISCONNECT. OWNER WILL REQUIRE INSTALLATION OF A NEMA L5-30 OR L6-30 RECEPTACLE. COORDINATE RECEPTACLE TYPE NEEDED AT TIME OF INSTALLATION AND PROVIDE/ INSTALL RECEPTACLE REQUIRED. FUSE DISCONNECT PER RECEPTACLE INSTALLED. INSTALL RECEPTACLE BELOW DISCONNECT.
- 9 INSTALL 30A/2P TOGGLE SWITCH FUSED DISCONNECT AT SAME ELEVATION AS HVAC EQUIPMENT. COORDINATE EXACT LOCATION AND ELEVATION WITH HVAC DRAWINGS. 10 PROVIDE AND INSTALL RECEPTACLE FOR PROJECTOR.
- 11 PROVIDE ELECTRICAL CONNECTION TO STAGE CURTAIN MOTOR. COORDINATE EXACT HEIGHT AND LOCATION WITH ARCHITECTURAL DRAWINGS
- 12 PROVIDE ELECTRICAL CONNECTION TO PROJECTION SCREEN. COORDINATE EXACT HEIGHT AND LOCATION WITH ARCHITECTURAL DRAWINGS. INSTALL SWITCH PROVIDED WITH PROJECTION SCREEN AND MAKE CONNECTIONS.
- 13 LOW VOLTAGE WINDOW SHADES POWER PANEL LOCATED ABOVE CEILING WITH CONNECTIONS TO LOW VOLTAGE WINDOW SHADES MOTORS (QUANTITY PER ARCHITECTURAL DRAWINGS). COORDINATE CABLING TYPE AND REQUIREMENTS WITH WINDOW SHADE SHOP DRAWINGS. COORDINATE WITH WINDOW SHADES
- 14 THIS CONNECTION IS FOR THE MOTORIZED ROLLER SHADE AT THE UPPER WINDOW.
- 15 CONNECTION TO DOOR OPERATOR. INSTALL SWITCH PROVIDED WITH DOOR OPERATOR AND MAKE CONNECTION.
- 16 PROVIDE 480V/3P CONNECTION FOR STORM SHELTER WATER BOOSTER.

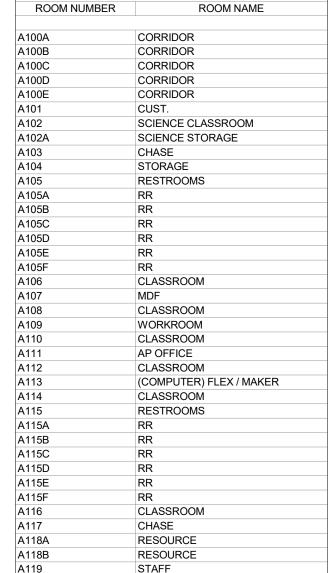

ROOM SCHEDULE

ROOM NUMBER

A122

A123

A124

A124A

A125

A126

A127

A128

A130

A132A

A132B

A134

A136

A136A

B100A

B100A1

B100A2 B100B

B101

B102

B103

B104

B105A

B105B

B105C

B106

B107

B108

B109

B110

B112

B113

B114

B115

B115A

B115B

B116 C100A

C100A1 C100B C100C C100C C100D

C100E

C101

C102

C103

C104

C105 C105A

C105B

C105C

C105D

C105E C105F

C106

C107 C108

C109

C110 C111

C112

C112A

C113

C114

C114A

C114B

C115

C115A

C115B

C115C C115D

C115E

C115F

C116 C117

C118

C118A

C118B

C119

C120

C121

C122

C123

C124

C125

C126

C126A

C128 C128A C128B

D101

D101A

D101B D101G

D1013 D101H D102 D102C D102D D102E D102F D103

E100A

E100B

E101A

E102

E103

E103A E103B

E103C E103D

E104

E104A

E104B

E104C E104D

E105

E106

E107

E108

E110

E111

E111A

F100A

F101

F101A

F101B

F101C F101D F102B F102D F103

F103A F103B

F103C F103D

F103E

F103F F103G

F103H

F104

F105

F106

F107

F108

G100A

G100B

G101A

G101B

G101C G101D G101E G101F

G101G

G101H

G101J

G102

G103

G103A G104 G105

G105A

G105B

G105C G106 G106A G107

G107A

G108 G108A G108B

G108C G109

G1001A1

STA1

STB1

STC1

STD1

G101

E101

B105

CUST.

ELECT.

STAFF

CORR.

EXAM

TOILET

EXAM

MAIL

FRC

OFFICE

TOILET

STAFF

VEST.

CUST.

CHASE

FMR

IDF

FMD

FMD

TOILET

STORAGE

CHASE

STAFF

CUST.

ELECT.

STAFF

KILN

RISER

OFFICE STAGE

OFFICE

PRACTICE

TOILET

TOILET

CUST.

OFFICE

TOILET

COOLER

ICE

IDF

HC RR

CHASE

CUST.

OFFICE

SOUND

STAIR

STAIR

STAIR

STAIR

RR


MD STOR.


IDF


TOILET


TOILET


SRC

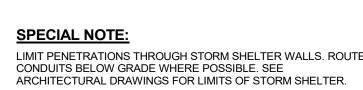

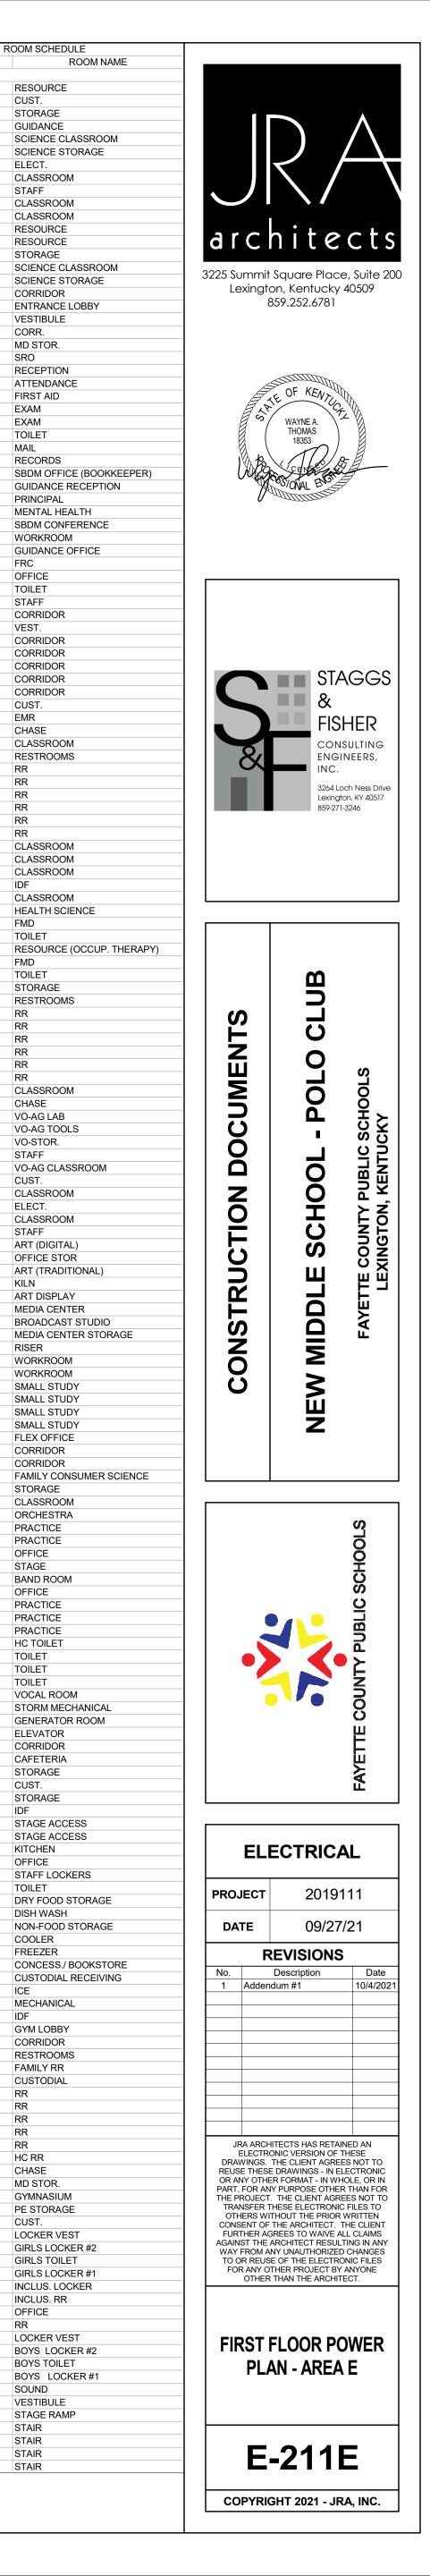

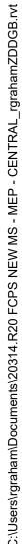

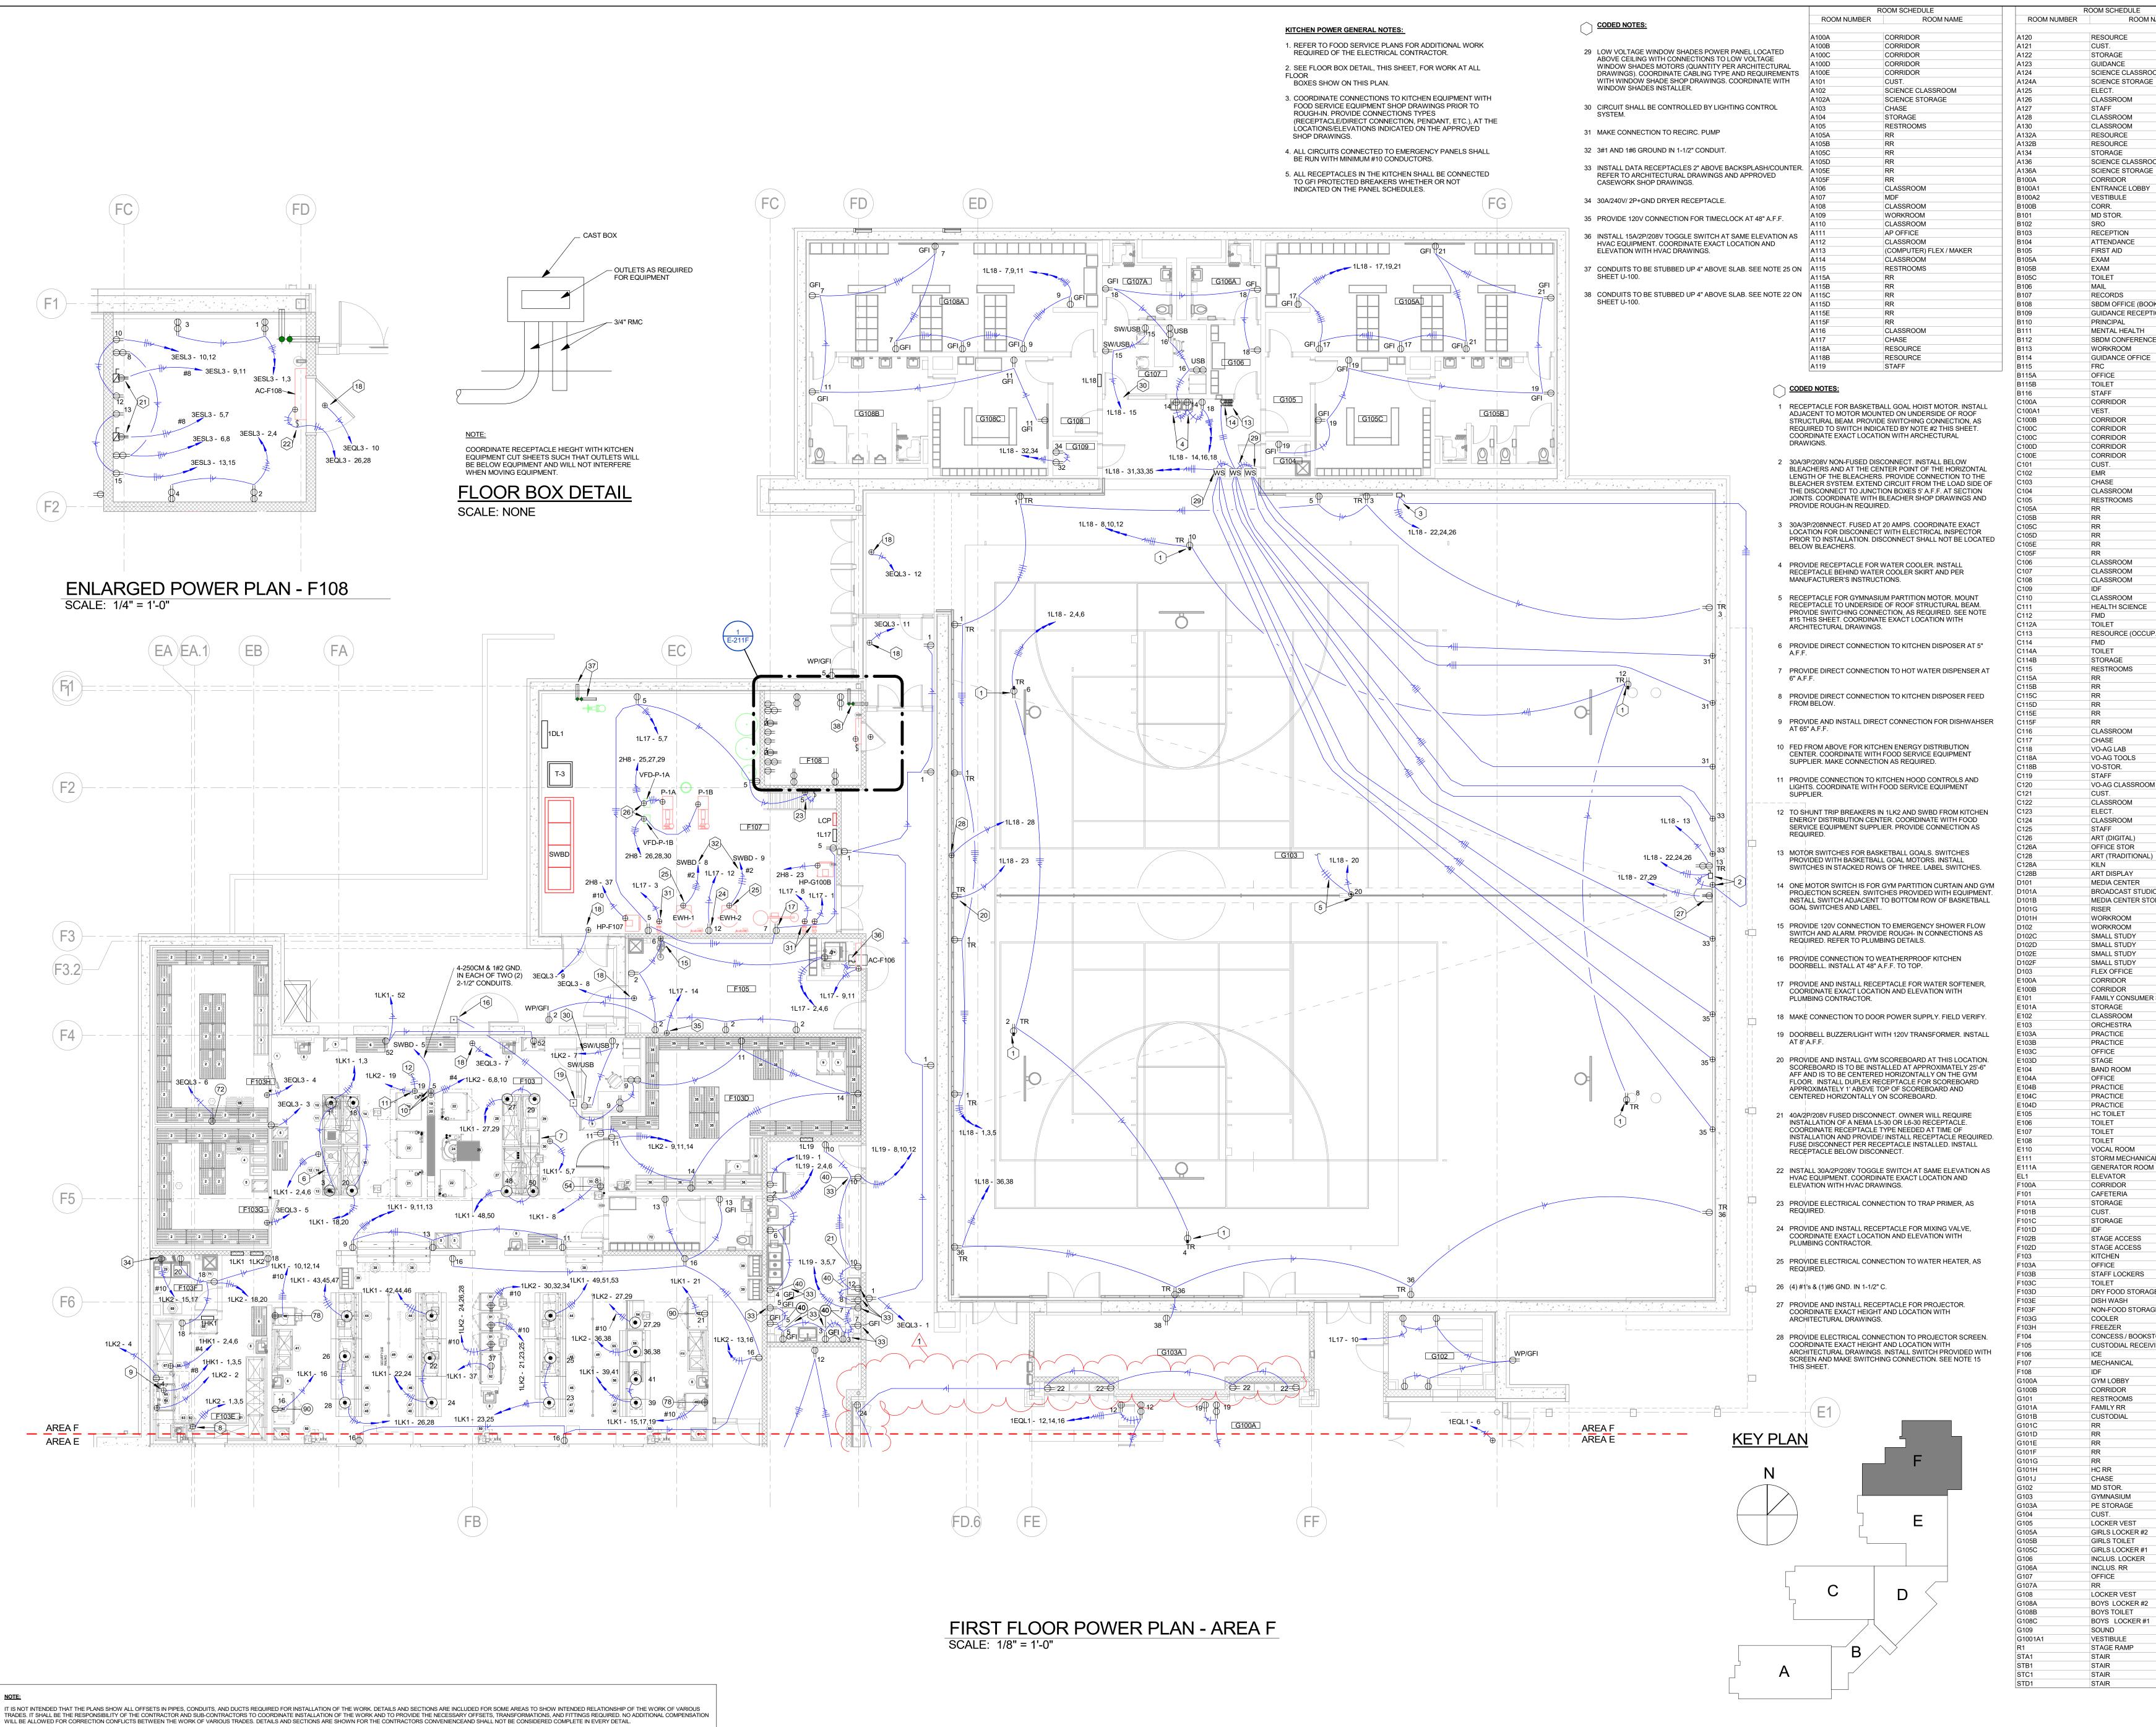

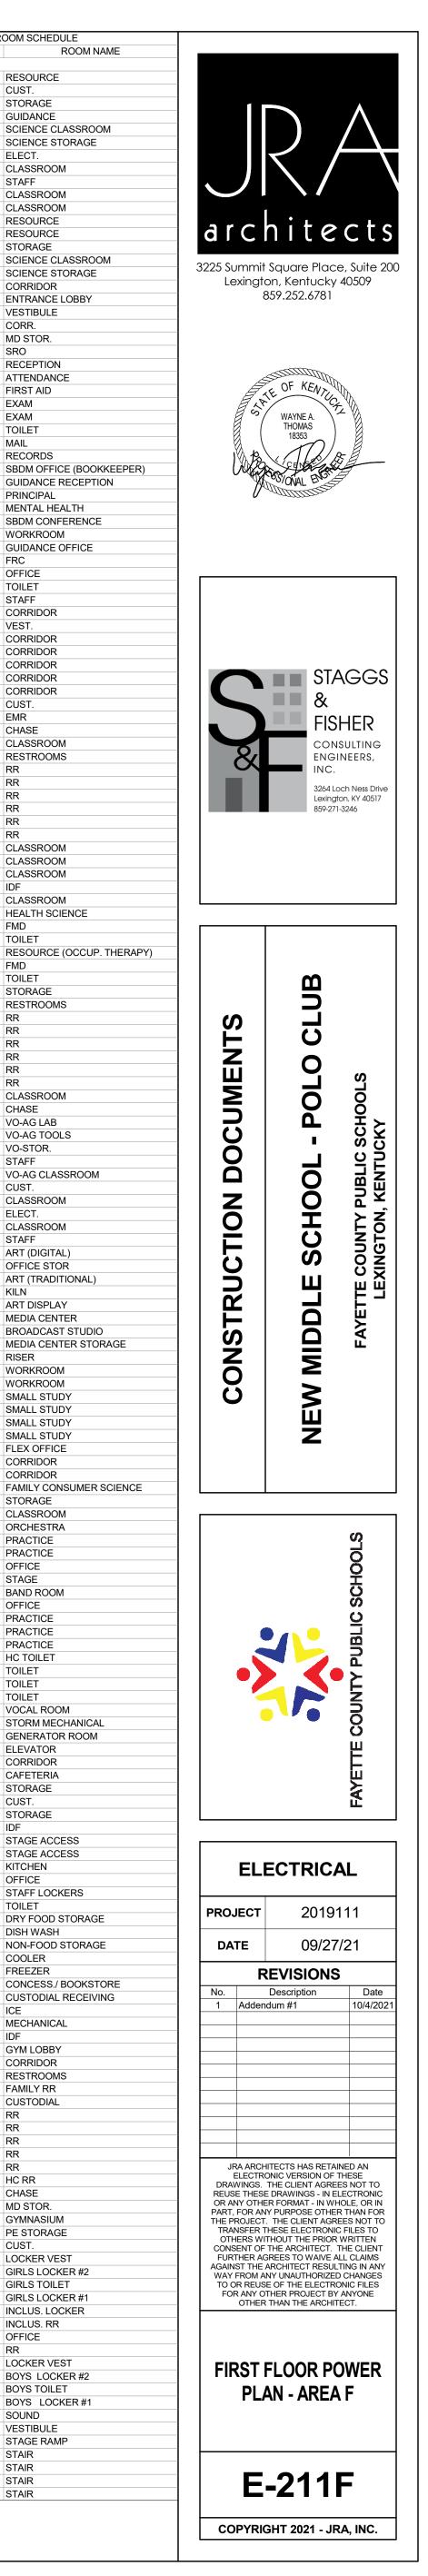

Notes:	Location: MECH PLA Supply From: ET-1Q Mounting: SURFACE Enclosure: TYPE 1	IFORM E301				Volts: Phases: Wires:		Wye			Μ	A.I.C. Rating: 22,000 Mains Type: MCB CB/MLO Rating: 100
скт	Circuit Description	Trip	Poles		A		в		C	Poles	Trip	Circuit Description
1	DOOR POWER SUPPLY E100A-1	20 A	1	120 VA	120 VA					1	20 A	DOOR POWER SUPPLY E10
3	DOOR POWER SUPPLY E100B-1	20 A	1			120 VA	120 VA			1	20 A	DOOR POWER SUPPLY F10
5	RECS - STORM MECHANICAL E110	20 A	1					540 VA	120 VA	1	20 A	DOOR POWER SUPPLY G1
7	RECS - STORM MECHANICAL E111	20 A	1	540 VA	42 VA					-2	20 A	HVAC - AC-F101D
9	DOOR POWER SUPPLY E100B-1	20 A	1			120 VA	42 VA			2	20 7	
11	DOOR POWER SUPPLY F101	20 A	1					120 VA	360 VA	1	20 A	RECS - GYM LOBBY F100A
13	RECS - Room E100A, E100C	20 A	1	1080 VA	360 VA					1	20 A	RECS - GYM LOBBY G100A
15	RECS - CORRIDOR E100B	20 A	1	γ		900 VA	180 VA			1	20 A	RECEPTACLES GYM LOBB
17	RECS - DISPLAY CASE CORRIDOR F100A	20 A	1					360 VA	120 VA	1	20 A	DOOR POWER SUPPLY F10
19	RECS - GYM LOBBY F100A	20 A	1	360 VA	900 VA	//	\nearrow				20 A	RECS - LOWER PLATEORM
21	RECS - GYM LOBBY G100A	20 A	1			360 VA	720 VA		r r	1	20 A	RECS - DISPLAY CASE GYI
23	RECEPTACLES GYM LOBBY G100A	20 A	1			\[180 VA	360 VA	1	20 A	RECS - DISPLAY CASE COF
25	DOOR POWER SUPPLY G1001A1	20 A	1	120 VA	0 VA	1		\square		1	20 A	SPARE
27	SPARE	20 A	1			0 VA	OVA				20 A	SPARE
29	SPARE	20 A	1					0 VA	0 VA	1	20 A	SPARE
31	SPARE	20 A	1	0 VA	0 VA					1	20 A	SPARE
33	SPARE	20 A	1			0 VA	0 VA			1	20 A	SPARE
35	SPARE	20 A	1					0 VA	0 VA	1	20 A	SPARE
37	SPARE	20 A	1	0 VA	0 VA					1	20 A	SPARE
39	SPARE	20 A	1			0 VA	0 VA			1	20 A	SPARE
41	SPARE	20 A	1					0 VA	0 VA	1	20 A	SPARE
		Total Lo	ad:	3642 VA		2562 VA		2160 VA				1
		Total An		31 A		22 A		18 A		_		


СКТ	Circuit Description	Trip	Poles		Α		В		С	Poles	Trip	Circuit Description	
1				831 VA	831 VA								
3	STORM SHUTTER E110	15 A	3			831 VA	831 VA			3	15 A	STORM SHUTTER E104	
5								831 VA	831 VA				
7					831 VA	831 VA							
9	STORM SHUTTER E104	15 A	3			831 VA	831 VA			3	15 A	STORM SHUTTER E103	
11								831 VA	831 VA				
13				831 VA	831 VA								
15	STORM SHUTTER E103	15 A	3			831 VA	831 VA			3	15 A	STORM SHUTTER E10	
17								831 VA	831 VA				
19				831 VA	831 VA								
21	STORM SHUTTER E102	15 A	3			831 VA	831 VA			3	15 A	STORM SHUTTER E10	
23								831 VA	831 VA				
25				831 VA	3642 VA								
27	STORM SHUTTER E101	15 A	3			831 VA	2562 VA			3	50 A	TRANSFORMER - ET-1	
29								831 VA	2160 VA				
31	STORM SHELTER WATER BOOSTER MECHANICAL			467 VA	0 VA					1	20 A	SPARE	
33	E111	15 A	3			467 VA	0 VA			1	20 A	SPARE	
35								467 VA	0 VA	1	20 A	SPARE	
37	SPARE	20 A	1	0 VA	0 VA					1	20 A	SPARE	
39	SPARE	20 A	1			0 VA	0 VA			1	20 A	SPARE	
41	SPARE	20 A	1					0 VA	0 VA	1	20 A	SPARE	
43	SPARE	20 A	1	0 VA	0 VA					1	20 A	SPARE	
45	SPARE	20 A	1			0 VA	0 VA			1	20 A	SPARE	
47	SPARE	20 A	1					0 VA	0 VA	1	20 A	SPARE	
49	SPARE	20 A	1	0 VA	0 VA					1	20 A	SPARE	
51	SPARE	20 A	1			0 VA	0 VA			1	20 A	SPARE	
53	SPARE	20 A	1					0 VA	0 VA	1	20 A	SPARE	
		Total L	oad:	11588 V/	4	10508 V/	4	10106 V	4				

Location: MECH PLATFORM E301 Supply From: 1EQDH Mounting: SURFACE Enclosure: TYPE 1

Branch Panel: 1EQH1

Volts: 480/277 Wye Phases: 3 Wires: 4

A.I.C. Rating: 42,000 Mains Type: MLO MCB/MLO Rating: 150

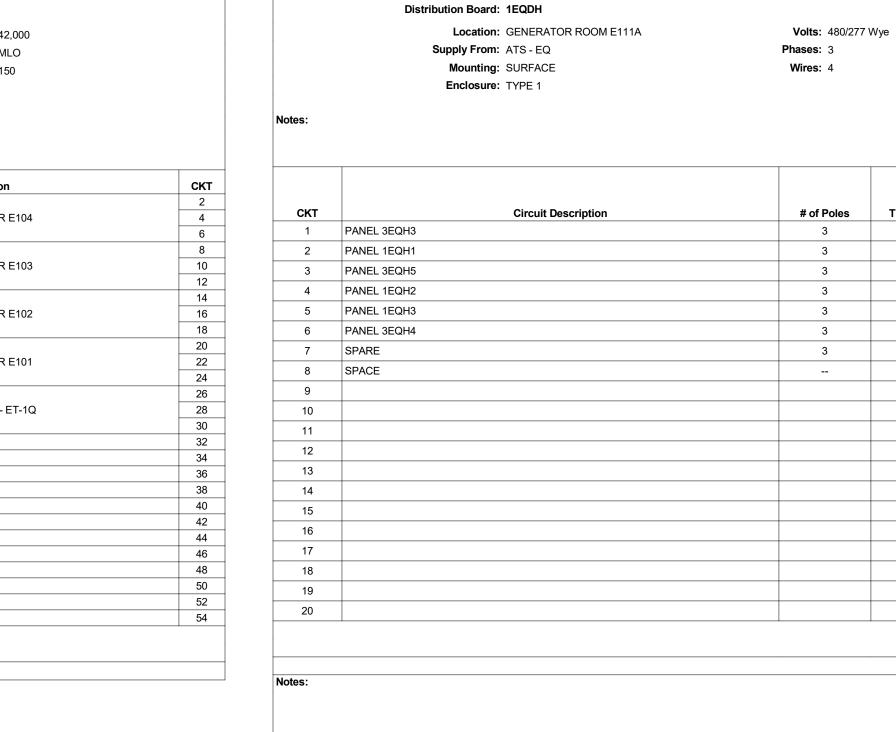


Branch Panel: 1EQH3

Supply From: 1EQDH

Mounting: SURFACE

Enclosure: TYPE 1

Location: ELECT. A125

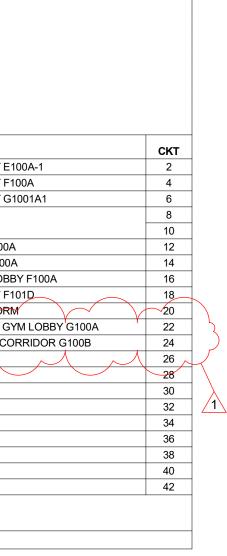

СКТ	Circuit Description	Trip	Poles		4	E	3		C	Poles	Trip	Circuit Description	СКТ
1				1980 VA	0 VA					1	20 A	SPARE	2
3	TRANSFORMER ET-3Q	50 A	3			1902 VA	0 VA			1	20 A	SPARE	4
5								2542 VA	0 VA	1	20 A	SPARE	6
7	SPARE	20 A	1	0 VA	0 VA					1	20 A	SPARE	8
9	SPARE	20 A	1			0 VA	0 VA			1	20 A	SPARE	10
11	SPARE	20 A	1					0 VA	0 VA	1	20 A	SPARE	12
13	SPARE	20 A	1	0 VA	0 VA					1	20 A	SPARE	14
15	SPARE	20 A	1			0 VA	0 VA			1	20 A	SPARE	16
17	SPARE	20 A	1					0 VA	0 VA	1	20 A	SPARE	18
19	SPARE	20 A	1	0 VA	0 VA					1	20 A	SPARE	20
21	SPARE	20 A	1			0 VA	0 VA			1	20 A	SPARE	22
23	SPARE	20 A	1					0 VA	0 VA	1	20 A	SPARE	24
		Total Lo	ad:	1980 VA		1902 VA		2542 VA					
		Total An	nps:	7 A		7 A		9 A		-			

Volts: 480/277 Wye

Phases: 3

Wires: 4

of PolesTrip RatingLoadRemarks3100 A24740 VA 32201 VA 150 A 3 3 100 A 12836 VA 100 A 8604 VA 3 3 100 A 6424 VA 3 100 A 10916 VA 100 A 3 0 VA 0 VA ----95721 VA 115 A

Switchboard:	SWBD
Location:	MECHANICAL F107
Supply From:	
Mounting:	CONCRETE PAD
Enclosure:	NEMA 1

A.I.C. Rating: 65,000 Mains Type: MCB MCB/MLO Rating: 3000

SERVICE ENTRANCE RATED. GFCI MAIN CIRCUIT BREAKER

2 AT 3 TR 4 KI	TS - LS TS - EQ	3	300 A		
3 TR 4 KI			300 A	170636 VA	
4 KI		3	200 A	95721 VA	
	RANSFORMER T-3 (SUPPLIES 1DL1)	3	350 A	209158 VA	
5 KI	TCHEN HOOD ELECTRIC HEATER	3	200 A	126500 VA	
J N	TCHEN ENERGY DISTRIBUTION CENTER - SHUNT TRIP	3	450 A	373950 VA	SHUNT TRIP BREAKER
6 PA	ANEL 1HK1	3	225 A	63585 VA	
7 PA	ANEL 1H3	3	400 A	0 VA	
8 EV	NH - 1	3	90 A	54000 VA	
9 EV	NH - 2	3	90 A	54000 VA	
10 PA	ANEL 2H7	3	225 A	124057 VA	
11 PA	ANEL 2H8	3	600 A	304779 VA	
12 PA	ANEL 3DH1	3	1000 A	565657 VA	
13 PA	ANEL 3DH2	3	1000 A	774993 VA	
14 SF	PARE	3	225 A	0 VA	
15 SF	PARE	3	225 A	0 VA	
16 SF	PARE	3	150 A	0 VA	
17 SF	PACE			0 VA	
18 SF	PACE			0 VA	
19					
20					

Volts: 480/277 Wye

Phases: 3 Wires: 4

Notes:

A.I.C. Rating: 42,000

Mains Type: MCB

A.I.C. Rating: 42,000

Mains Type: MLO

MCB/MLO Rating: 100

MCB/MLO Rating: 200

	Switchboard: 1DL1				
	Location: MECHANICAL F107 Supply From: T-3 Mounting: SURFACE Enclosure: TYPE 1	Volts: 120/208 Phases: 3 Wires: 4	Wye		A.I.C. Rating: 22,000 Mains Type: MCB MCB/MLO Rating: 800
otes:					
скт	Circuit Description	# of Poles	Trip Rating	Load	Remarks
1	PANEL 1L17	3	100 A	6310 VA	
2	PANEL 1L18	3	150 A	28963 VA	
3	PANEL 1LK1	3	300 A	79281 VA	
4	PANEL 1LK2	3	225 A	55592 VA	
5	PANEL 1L15	3	100 A	18352 VA	
6	PANEL 1L16	3	100 A	16360 VA	
7	PANEL 1L19	3	100 A	4300 VA	
8	SPARE	3	100 A	0 VA	
9	SPACE			0 VA	
10					
11					
12					
13					
14					
15					
16					
17					
18					
19					
20					
				209158 VA 581 A	

	Branch Panel: 1EQH2											
	Location: ELECT. C123					Volts:	480/277 V	Vye				A.I.C. Rating: 42,000
	Supply From: 1EQDH					Phases:	3					Mains Type: MLO
	Mounting: SURFACE					Wires:	4				I	MCB/MLO Rating: 100
	Enclosure: TYPE 1											-
Notes:												
скт	Circuit Description	Trip	Poles		A		B		C	Poles	Trip	Circuit Description
1	SPARE	20 A	1	0 VA	3000 VA							
3	SPARE	20 A	1			0 VA	1782 VA			3	50 A	TRANSFORMER ET-2Q
5	SPARE	20 A	1					0 VA	3822 VA			
7	SPARE	20 A	1	0 VA	0 VA					1	20 A	SPARE
9	SPARE	20 A	1			0 VA	0 VA			1	20 A	SPARE
11	SPARE	20 A	1					0 VA	0 VA	1	20 A	SPARE
13	SPARE	20 A	1	0 VA	0 VA					1	20 A	SPARE
15	SPARE	20 A	1			0 VA	0 VA			1	20 A	SPARE
17	SPARE	20 A	1					0 VA	0 VA	1	20 A	SPARE
19	SPARE	20 A	1	0 VA	0 VA					1	20 A	SPARE
		20.4	1			0 VA	0 VA			1	20 A	SPARE
 21	SPARE	20 A	1				-				-	
21 23	SPARE SPARE	20 A 20 A	1			-		0 VA	0 VA	1	20 A	SPARE

6 A


14 A


3000 VA 12 A

Total Amps:





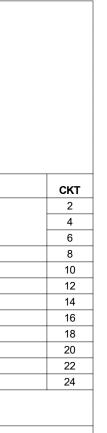

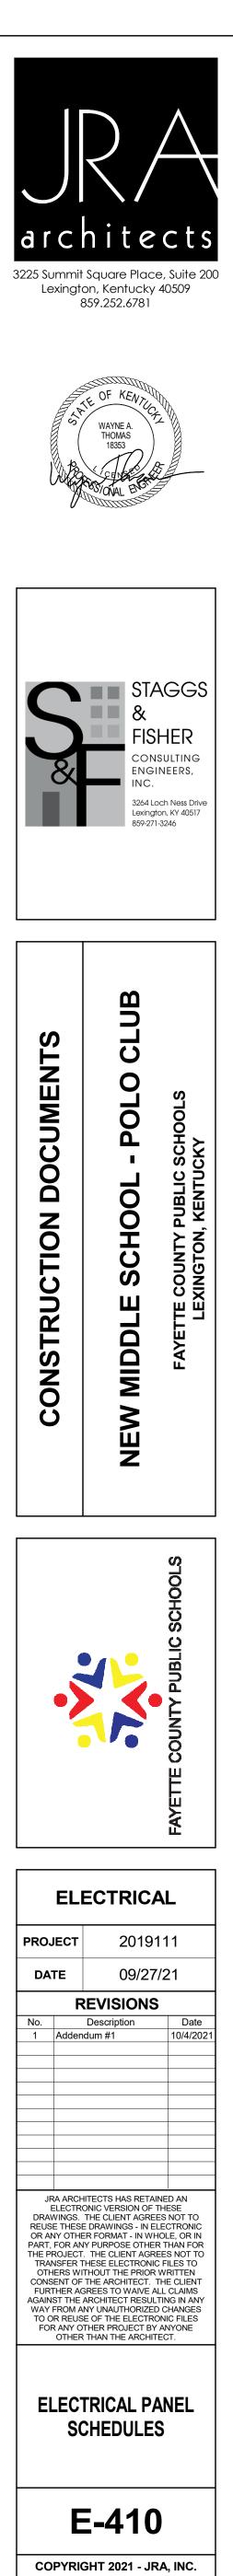

	Distribution Board: 1ESDH					
Location: GENERATOR ROOM E111A Supply From: ATS - LS Mounting: SURFACE Enclosure: TYPE 1		Volts: 480/277 Phases: 3 Wires: 4		A.I.C. Rating: 42,000 Mains Type: MCB MCB/MLO Rating: 300		
otes:						
СКТ	Circuit Description	# of Poles	Trip Rating	Load	Remarks	
1	PANEL 1ESH2	3	225 A	80197 VA	Remains	
2	PANEL 3ESH3	3	100 A	16228 VA		
3	PANEL 1ESH3	3	100 A	18672 VA		
4	PANEL 3ESH5	3	100 A	16553 VA		
5	PANEL 3ESH4	3	100 A	12425 VA		
6	PANEL 1ESH1	3	100 A	27195 VA		
7	SPARE	3	100 A	0 VA		
8	SPACE			0 VA		
9						
10						
11						
12						
13						
14						
15						
16						
17						
18						
19						
20						
				170636 VA 205 A		

	Branch Panel: 1ESH3											
	Location: ELECT. A125	i i				Volts:	480/277	7 Wye				A.I.C. Rating: 42,00
	Supply From: 1ESDH					Phases:	3					Mains Type: MLO
	Mounting: SURFACE					Wires:	4					MCB/MLO Rating: 100
	Enclosure: TYPE 1											J
lotes:												
скт	Circuit Description	Trip	Poles		A		В		с	Poles	Trip	Circuit Description
1	LTG - CORRIDOR A100B	20 A	1	2618 VA	3703 VA					1	20 A	LTG - CORRIDOR B10
3						3589 VA	0 VA			1	20 A	SPARE
5	ET-3S	50 A	3					5593 VA	0 VA	1	20 A	SPARE
7				3265 VA	0 VA					1	20 A	SPARE
9	SPARE	20 A	1			0 VA	0 VA			1	20 A	SPARE
11	SPARE	20 A	1					0 VA	0 VA	1	20 A	SPARE
13	SPARE	20 A	1	0 VA	0 VA					1	20 A	SPARE
15	SPARE	20 A	1			0 VA	0 VA			1	20 A	SPARE
17	SPARE	20 A	1					0 VA	0 VA	1	20 A	SPARE
19	SPARE	20 A	1	0 VA	0 VA					1	20 A	SPARE
21	SPARE	20 A	1			0 VA	0 VA			1	20 A	SPARE
23	SPARE	20 A	1					0 VA	0 VA	1	20 A	SPARE
25	SPARE	20 A	1	0 VA	0 VA					1	20 A	SPARE
27	SPARE	20 A	1			0 VA	0 VA			1	20 A	SPARE
29	SPARE	20 A	1					0 VA	0 VA	1	20 A	SPARE
		Total L	oad:	9558 VA		3589 VA		5593 VA				
		Total A				13 A		21 A				

	Branch Panel: 1ESL3											
	Location: ELECT. A1	25				Volts:	120/208 \	Nye				A.I.C. Rating: 22,000
	Supply From: ET-3S					Phases:	3					Mains Type: MCB
	Mounting: SURFACE					Wires:	4					MCB/MLO Rating: 100
	Enclosure: TYPE 1											
Notes:												
	1					1		1				
СКТ	Circuit Description	Trip	Poles		Α		В		C	Poles	Trip	Circuit Description
1	RECS - MDF A107	20 A	1	360 VA	2500 VA					-2	40 A	RECS - MDF A107
3	RECS - MDF A107	20 A	1			360 VA	2500 VA			2	40 A	RECS - MDF ATO
5	RECS - MDF A107	20 A	1					360 VA	360 VA	1	20 A	RECS - MDF A107
7	RECS - MDF A107	20 A	1	360 VA	360 VA					1	20 A	RECS - MDF A107
9	RECS - MDF A107	40 A	2			2500 VA	180 VA			1	20 A	RECS - MDF A107
11	RECS - MDF ATOT	40 A	2					2500 VA	180 VA	1	20 A	RECS - MDF A107
13	RECS - MDF A107	20 A	1	180 VA	0 VA					1	20 A	SPARE
15	RECS - MDF A107	20 A	1			180 VA	0 VA			1	20 A	SPARE
17	SPARE	20 A	1					0 VA	0 VA	1	20 A	SPARE
19	SPARE	20 A	1	0 VA	0 VA					1	20 A	SPARE
21	SPARE	20 A	1			0 VA	0 VA			1	20 A	SPARE
23	SPARE	20 A	1					0 VA	0 VA	1	20 A	SPARE
25	SPARE	20 A	1	0 VA	0 VA					1	20 A	SPARE
27	SPARE	20 A	1			0 VA	0 VA			1	20 A	SPARE
29	SPARE	20 A	1					0 VA	0 VA	1	20 A	SPARE
		Total L	oad:	3589 VA		5593 VA		3265 VA				
		Total A		30 A		47 A		27 A		-		

Branch Panel: 1EQL3

Branch Panel: 1ESH2

Supply From: 1ESDH

Branch Panel: 1ESL2

Supply From: ET-2S

Mounting: SURFACE

Enclosure: TYPE 1

Location: ELECT. C123

Location: ELECT. C123

Mounting: SURFACE

Enclosure: TYPE 1

Location: ELECT. A125

								200 1190					A.i.o. Ruling: 22,000									. 120/200 (,				A.i.o. Nating. 22,000
	Supply From: ET-3Q					Phases	s: 3						Mains Type: MCB				Supply From: ET-2Q				Phases	: 3					Mains Type: MCB
	Mounting: SURFACE					Wires	s: 4					M	CB/MLO Rating: 100				Mounting: SURFACE				Wires	: 4				N	MCB/MLO Rating: 100
	Enclosure: TYPE 1																Enclosure: TYPE 1										
tes:															N	otes:											
кт	Circuit Description	Trip Po	oles	А			в		с	Po	oles T	Trip	Circuit Description	скт		скт	Circuit Description	Trip	Poles	A		в	C	;	Poles	Trip	Circuit Description
1	RECS - CORRIDOR A100A	20 A 1	-	720 VA 🕴	540 VA					1	2	20 A	RECS - CORRIDOR A100B	2		1	DOOR POWER SUPPLY B100A	20 A	1	120 VA 120 VA					1	20 A	DOOR POWER SUPPLY C100A1
5	RECS - CORRIDOR A100A	20 A 1				720 VA	540 ∖	VA		1	2	20 A	RECS - CORRIDOR A100B	4		3	DOOR POWER SUPPLY C100C	20 A	1		120 VA	120 VA			1	20 A	DOOR POWER SUPPLY C109
5	RECS - CORR. B100B	20 A 1						720 V	/A 100	VA 1ر	2	20 A	RECS - FIRST AID B105	6		5	RECS - Room B100A, D100A	20 A	1		\frown		1080 VA	720 VA	1	20 A	RECS - CORRIDOR C100B
7	DOOR POWER SUPPLY STA1	20 A 1		120 VA 🤺	180 VA					1	2	20 A	RECEPTACLES ENTRANCE LOBBY B100A1	8	\mathbf{Y}	\neg	REC8 - Room B100A, B100A2	20 A	-1/	900 VA 720 VA					1	20 A	RECS - CORRIDOR C100B
9	DOOR POWER SUPPLY COORIDOR A100A	20 A 1				120 VA	360 V	JA A		1	2	20 A	RECS - ENTRANCE LOBBY B100A1	10		9	RECS - CORRIDOR B100A	20 A	1		720 VA	120 VA			1	20 A	DOOR POWER SUPPLY B100A1
1	DOOR POWER SUPPLY B100A2	20 A 1						120 V	/A 540	JVA 1	2	20 A	RECS - ENTRANCE LOBBY B100A1	12		11	RECS - CORRIDOR C100A	20 A	1 ~	$\Lambda \qquad \square \qquad \square$	\sim		720 VA	600 VA	1	20 A	DOOR POWER SUPPLY B100A1
3	DOOR POWER SUPPLY B100A	20 A 1		120 VA 🤺	120 VA					1	2	20 A	DOOR POWER SUPPLY A107	14		13	RECEPTACLES ENTRANCE LOBBY B100A1	20 A	1	180 VA 120 VA					1	20 A	DOOR POWER SUPPLY B100A1
15	HVAC - AC-107	15 A 2				42 VA	120 \	VA		1	2	20 A	DOOR POWER SUPPLY COORIDOR A100B	16		15	RECS - ENTRANCE LOBBY B100A1	20 A	1		540 VA	0 VA			1	20 A	SPARE
17	11046 - 40-107							42 VA	A 120	VA 1	2	20 A	DOOR POWER SUPPLY B115	18		17	RECS - ENTRANCE LOBBY B100A1	20 A	1				540 VA	0 VA	1	20 A	SPARE
19	RECS - ELECT. A127	20 A 1		180 VA 🛛 (0 VA					1	2	20 A	SPARE	20		19	DOOR POWER SUPPLY VO-AG LAB C118	20 A	1	120 VA 540 VA					1	20 A	RECS - EMR C102
21	SPARE	20 A 1				0 VA	0 VA			1	2	20 A	SPARE	22		21	DOOR POWER SUPPLY RECEPTION	20 A	1		120 VA	42 VA			2	20 A	HVAC - AC-C109
23	SPARE	20 A 1						0 VA	0 V/	A 1	2	-	SPARE	24		23	DOOR POWER SUPPLY STC1	20 A	1				120 VA	42 VA		20 A	111740 - AC-C 109
5	SPARE	20 A 1	(0 VA 🛛	0 VA					1	2	20 A	SPARE	26		25	RECS - ELECT. C123	20 A	1	180 VA 0 VA							SPARE
27	SPARE	20 A 1				0 VA	0 VA			1	2	20 A	SPARE	28		27	SPARE	20 A	1		0 VA	0 VA			1	20 A	SPARE
29	SPARE	20 A 1						0 VA	0 V/	A 1	2	20 A	SPARE	30		29	SPARE	20 A	1				0 VA	0 VA	1	20 A	SPARE
	SPARE	20 A 1	(0 VA (0 VA					1	2	20 A	SPARE	32		-		20 A	1	0 VA 0 VA							SPARE
	SPARE	20 A 1				0 VA	0 VA			1			SPARE	34				20 A	1		0 VA	0 VA					SPARE
35	SPARE	20 A 1						0 VA	0 V/	A 1	2	20 A	SPARE	36		35	SPARE	20 A	1				0 VA	0 VA			SPARE
7	SPARE	20 A 1	(0 VA (0 VA					1	2		SPARE	38				20 A	1	0 VA 0 VA							SPARE
39	SPARE	20 A 1				0 VA	0 VA			1	2	20 A	SPARE	40				20 A	1		0 VA	0 VA			1	20 A	SPARE
41	SPARE	20 A 1						0 VA	0 V/	A 1	2	20 A	SPARE	42		41	SPARE	20 A	1				0 VA	0 VA	1	20 A	SPARE
		Total Load:		1980 VA		1902 VA	Α	2542 \	VA									Total Lo	ad:	3000 VA	1782 VA		3822 VA				
		Total Amps	: .	17 A		16 A		21 A										Total Ar	nns	27 A	15 A		33 A				

A.I.C. Rating: 22,000

A.I.C. Rating: 42,000

Mains Type: MLO

A.I.C. Rating: 22,000


Mains Type: MCB

MCB/MLO Rating: 100

MCB/MLO Rating: 225

Branch Panel: 1EQL2

Location: ELECT. C123

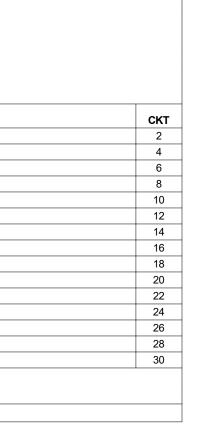

Notes:


кт	Circuit Description	Trip	Poles		4		в		C	Poles	Trip	Circuit Description
1	LTG - CORRIDOR C100B	20 A	1	2911 VA	20775							
3						4160 VA	20775			3	110 A	ELEVATOR
5	TRANSFORMER ET-2S	50 A	3					4413 VA	20775	1		
7				6776 VA	0 VA					1	20 A	SPARE
9	SPARE	20 A	1			0 VA	0 VA			1	20 A	SPARE
11	SPARE	20 A	1					0 VA	0 VA	1	20 A	SPARE
13	SPARE	20 A	1	0 VA	0 VA					1	20 A	SPARE
15	SPARE	20 A	1			0 VA	0 VA			1	20 A	SPARE
17	SPARE	20 A	1					0 VA	0 VA	1	20 A	SPARE
19	SPARE	20 A	1	0 VA	0 VA					1	20 A	SPARE
21	SPARE	20 A	1			0 VA	0 VA			1	20 A	SPARE
23	SPARE	20 A	1					0 VA	0 VA	1	20 A	SPARE
	•	Total Lo	oad:	30272 VA		24805 VA		25133 VA				
		Total A	mps:	109 A		90 A		91 A		-		

Volts: 480/277 Wye

Phases: 3

Wires: 4

Volts: 120/208 Wye

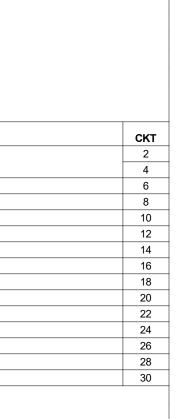

Т	Circuit Description	Trip	Poles		Α		В	C)	Poles	Trip	Circuit Description
1	PANEL - FACP - ELECT. C123	20 A	1	120 VA	180 VA					1	20 A	RECS - IDF C109
3	ELEVATOR CAB	30 A	1			800 VA	2500 VA			2	10.0	RECS - IDF C109
5	RECS - IDF C109	20 A	1					360 VA	2500 VA	2	40 A	RECS - IDF C 109
7	RECS - IDF C109	20 A	1	360 VA	180 VA					1	20 A	RECS - IDF C109
9	SPARE	20 A	1			0 VA	180 VA			1	20 A	RECS - IDF C109
11	RECS - IDF C109	40 A	2					2500 VA	180 VA	1	20 A	RECS - IDF C109
13	RECS-IDF C109	40 A	2	2500 VA	180 VA					1	20 A	RECS - IDF C109
15	RECS - ELEVATOR EL1	20 A	1			218 VA	360 VA			1	20 A	RECS - IDF C109
17	SUMP PUMP ELEVATOR PIT	20 A	1					1176 VA	360 VA	1	20 A	RECS - IDF C109
19	RECS - IDF C109	20 A	1	360 VA	500 VA					1	20 A	RECS - IDF C109
21	RECS - IDF C109	20 A	1			360 VA	180 VA			1	20 A	RECS - IDF C109
23	SPARE	20 A	1					0 VA	0 VA	1	20 A	SPARE
25	SPARE	20 A	1	0 VA	0 VA					1	20 A	SPARE
27	SPARE	20 A	1			0 VA	0 VA			1	20 A	SPARE
29	SPARE	20 A	1					0 VA	0 VA	1	20 A	SPARE
		Total Lo	ad:	4160 VA		4413 VA		6776 VA				
		Total A	nps:	35 A		37 A		57 A				

Volts: 120/208 Wye


Phases: 3

Wires: 4

Volts: 120/208 Wye

A.I.C. Rating: 22,000 Mains Type: MCB

	Branch Panel: 1ESH1											
	Location: MECH PL	ATFORM E301				Volts:	480/277	Nye				A.I.C. Rating: 42,000
	Supply From: 1ESDH					Phases:	3					Mains Type: MLO
	Mounting: SURFACE	E				Wires:	4				I	MCB/MLO Rating: 150
	Enclosure: TYPE 1											
Notes:												
скт		Trite	Dalas							Dalas	Tain	
1	Circuit Description	20 A	Poles	812 VA	A 1258 VA		B			Poles	Trip 20 A	Circuit Description
3	LTG - PLATFORM / LOWER PLATFORM	20 A	1		1200 VA		4387 VA			1	20 A	LTG - CORRIDOR F100A
5		2071						4048 VA	2190 VA	1	20 A	LTG - CORRIDOR A200A
7	TRANSFORMER ET-1S	50 A	3	4535 VA	0 VA				2.00	1	20 A	SPARE
9					-	6477 VA	0 VA			1	20 A	SPARE
11	SPARE	20 A	1					0 VA	0 VA	1	20 A	SPARE
13	SPARE	20 A	1	0 VA	0 VA					1	20 A	SPARE
15	SPARE	20 A	1			0 VA	0 VA			1	20 A	SPARE
17	SPARE	20 A	1					0 VA	0 VA	1	20 A	SPARE
19	SPARE	20 A	1	0 VA	0 VA					1	20 A	SPARE
21	SPARE	20 A	1			0 VA	0 VA			1	20 A	SPARE
	SPARE	20 A	1					0 VA	0 VA	1	20 A	SPARE
23				000514	•	14364 VA	7	6235 VA	•			
23		Total Lo	oad:	6605 VA		14304 VF	`	0200 071				

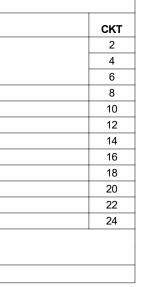

OVT
CKT
OKT
OVT
СКТ
2
4
	Branch Panel:	1ESL1							
	Location:	MECH PLATFO	RM E301				Volts:	120/208 V	Vye
	Supply From:	ET-1S					Phases:	3	
	Mounting:	SURFACE					Wires:	4	
	Enclosure:	TYPE 1							
Circuit Description			Trip	Poles		A	E		
RECS - IDF E101H			20 A	1	360 VA	360 VA			
RECS - IDF E101H			20 A	1			360 VA	360 VA	
RECS - IDF E101H			20 A	1					360 V
RECS - IDF E101H			20 A	1	360 VA	2500 VA			
RECS - IDF F101D			40 A	2			2500 VA	180 VA	
RECS-IDFFIUID			40 A	2					2500 \
RECS - IDF F101D			20 A	1	180 VA	500 VA			
			00 4	4			100.1/4	1000 1/4	

A.I.C. Rating: 22,000 Mains Type: MCB MCB/MLO Rating: 100

кт	Circuit Description	Trip	Poles		Α		в	(С	Poles	Trip	Circuit Description
1	RECS - IDF E101H	20 A	1	360 VA	360 VA					1	20 A	RECS - IDF E101H
3	RECS - IDF E101H	20 A	1			360 VA	360 VA			1	20 A	RECS - IDF E101H
5	RECS - IDF E101H	20 A	1					360 VA	2500 VA	2	40 A	RECS - IDF F101D
7	RECS - IDF E101H	20 A	1	360 VA	2500 VA					2	40 A	RECS - IDF F 101D
9	RECS - IDF F101D	40 A	2			2500 VA	180 VA			1	20 A	RECS - IDF F101D
11	RECS-IDFFI0ID	40 A	2					2500 VA	180 VA	1	20 A	RECS - IDF F101D
13	RECS - IDF F101D	20 A	1	180 VA	500 VA					1	20 A	GENERATOR CHARGER
15	RECS - IDF F101D	20 A	1			180 VA	1200 VA			2	20 A	GENERATOR JACKET HEATER
17	SPARE	20 A	1					0 VA	1200 VA	2	20 A	GENERATOR JACKET HEATER
19	SPARE	20 A	1	0 VA	0 VA					1	20 A	SPARE
21	SPARE	20 A	1			0 VA	0 VA			1	20 A	SPARE
23	SPARE	20 A	1					0 VA	0 VA	1	20 A	SPARE
25	SPARE	20 A	1	0 VA	0 VA					1	20 A	SPARE
27	SPARE	20 A	1			0 VA	0 VA			1	20 A	SPARE
29	SPARE	20 A	1					0 VA	0 VA	1	20 A	SPARE
		Total Lo	oad:	4048 VA		4535 VA		6477 VA				
		Total A	mps:	34 A		38 A		55 A		-		

