


Proj 93-11


• INDICATES 1804 RAINBIRD SPRINKLER,
 NOTE: ALL P.V.C. PIPE INSTALLED WITH
 TRACE WIRE.
 F.O.C. INDICATES DISTANCE MEASURED
 FROM FRONT OF CURB.
 E - INDICATES ELECTRIC WIRE FOR
 IRRIGATION VALVE.
 + INDICATES CHANGE IN PIPE SIZE.

IRRIGATION
 AS-BUILT

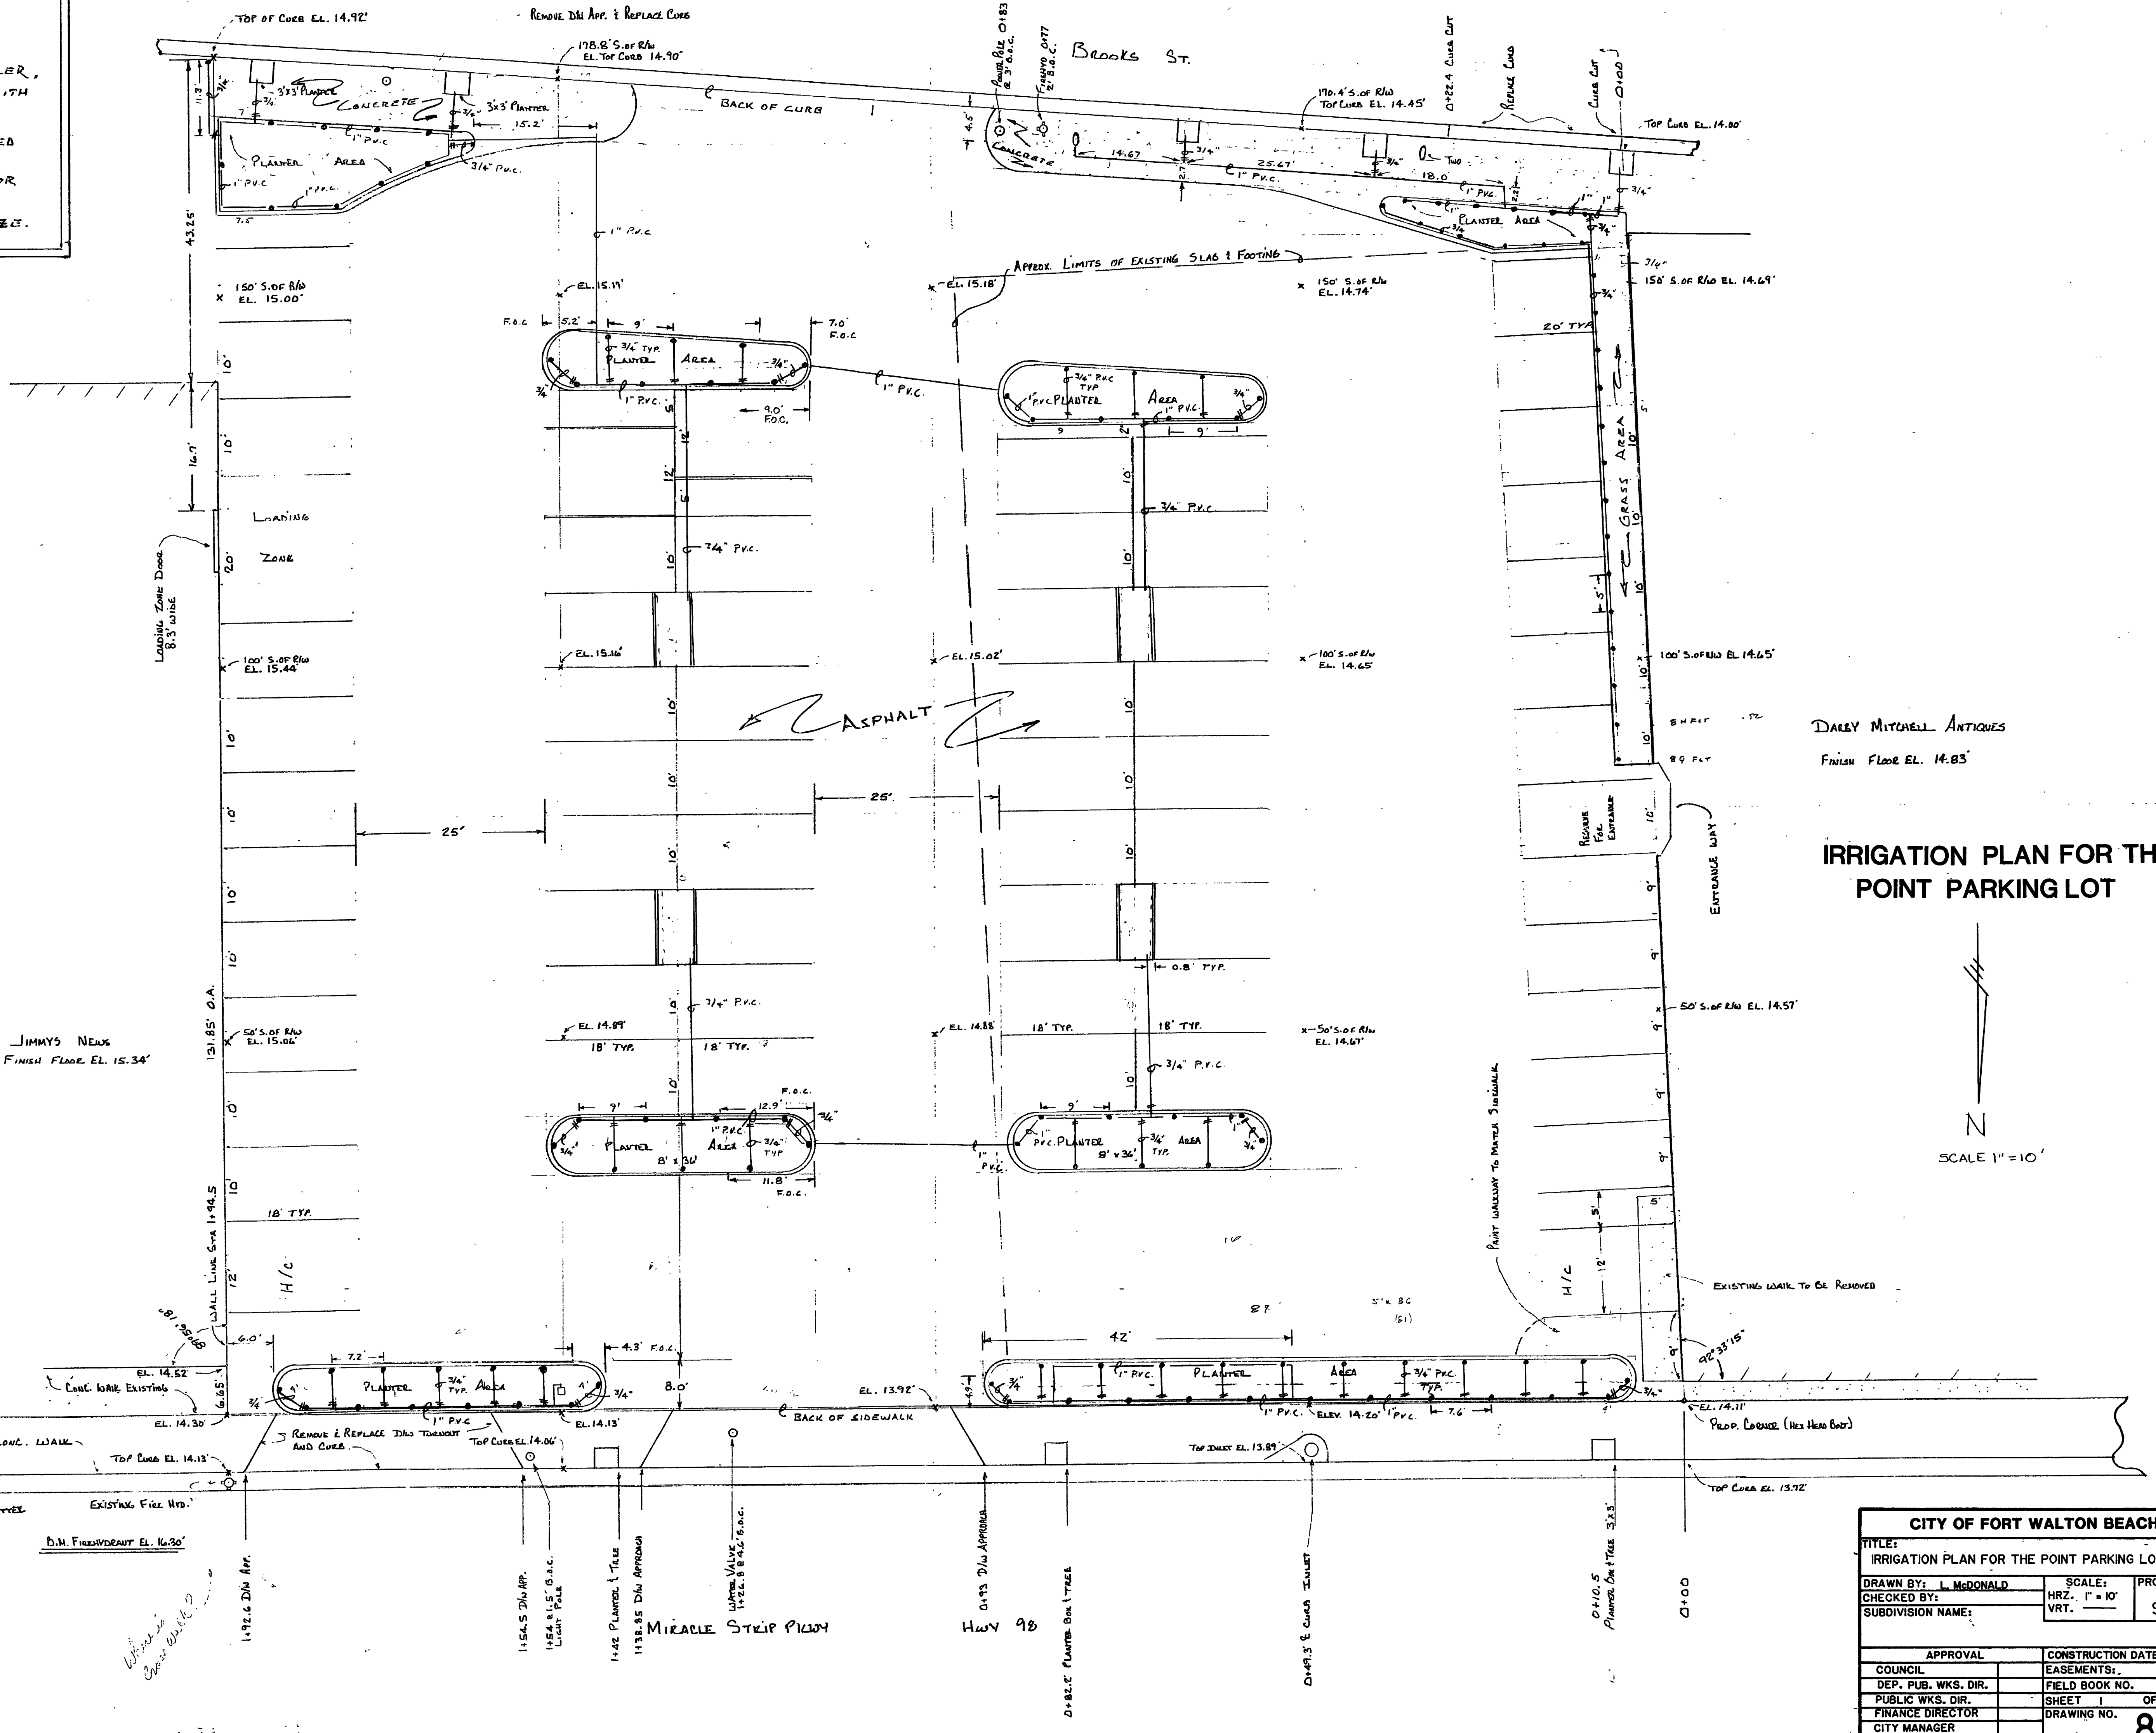

DARBY MITCHELL ANTIQUES
 FINISH FLOOR EL. 14.83'

IRRIGATION PLAN FOR THE
 POINT PARKING LOT

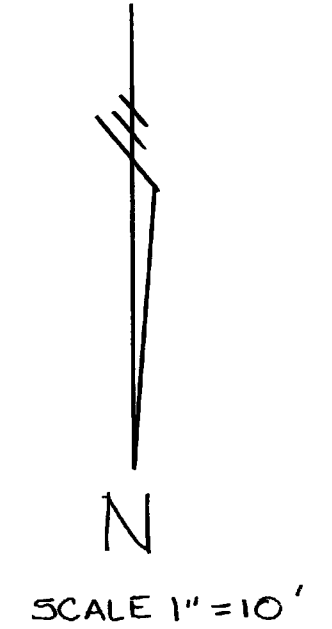

CITY OF FORT WALTON BEACH		
TITLE: IRRIGATION PLAN FOR THE POINT PARKING LOT		
DRAWN BY: L. McDONALD	SCALE: 1" = 10'	PROJECT NO. 93-11
CHECKED BY:	HRZ. VRT.	
SUBDIVISION NAME:		
APPROVAL		CONSTRUCTION DATE: 2/8/93
COUNCIL	EASEMENTS:	
DEP. PUB. WKS. DIR.	FIELD BOOK NO.	
PUBLIC WKS. DIR.	SHEET 1 OF 1	
FINANCE DIRECTOR	DRAWING NO.	
CITY MANAGER	BILL OF MATERIAL	