
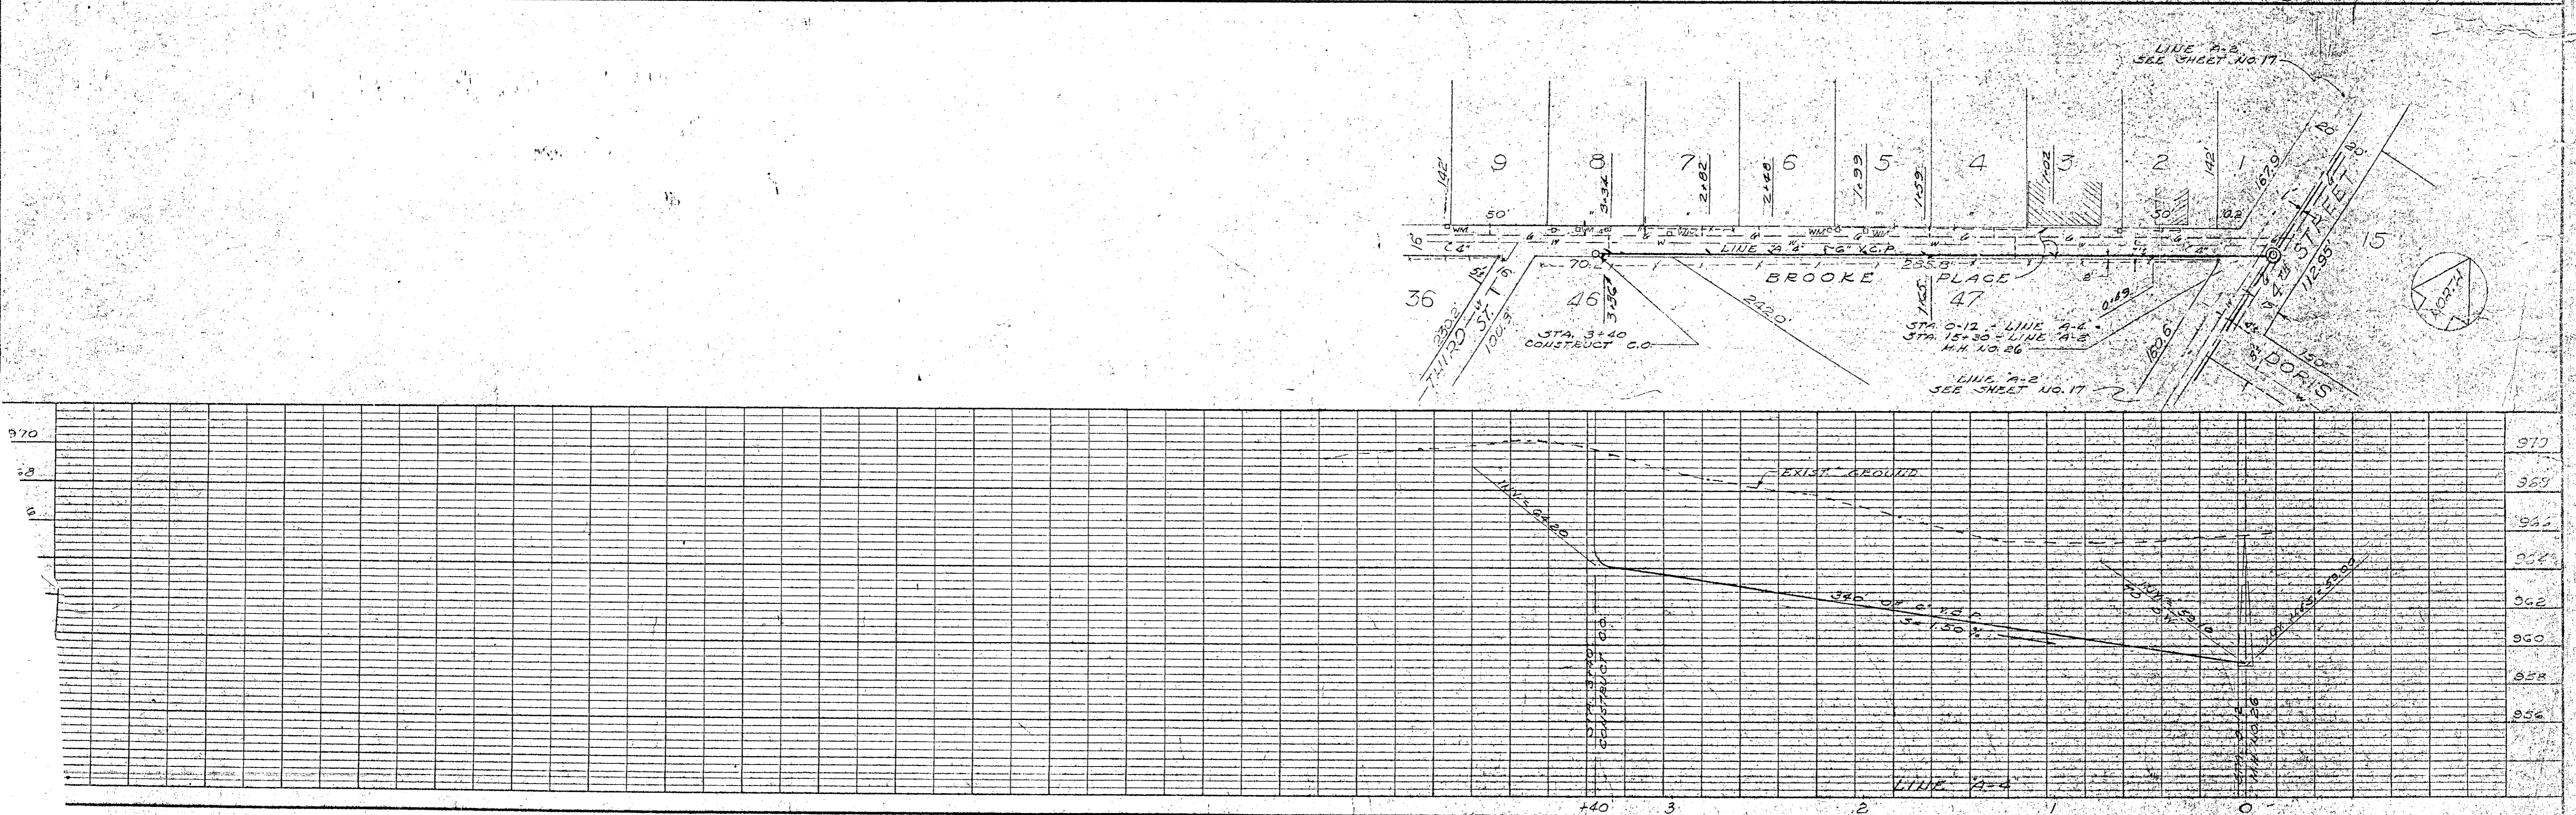


# SEWER SYSTEM

AS BUILT APR. 1953 SHEET 20 OF 57  
 DESIGNED BY: JOHANNESSEN & GIRARD PHOENIX, ARIZONA  
 SEWAGE COLLECTION & DISPOSAL SYSTEM AVONDALE, ARIZONA  
 LINES A-4 & A-10  
 SCALE: HOR. 1" = 40' VERT. 1" = 4'

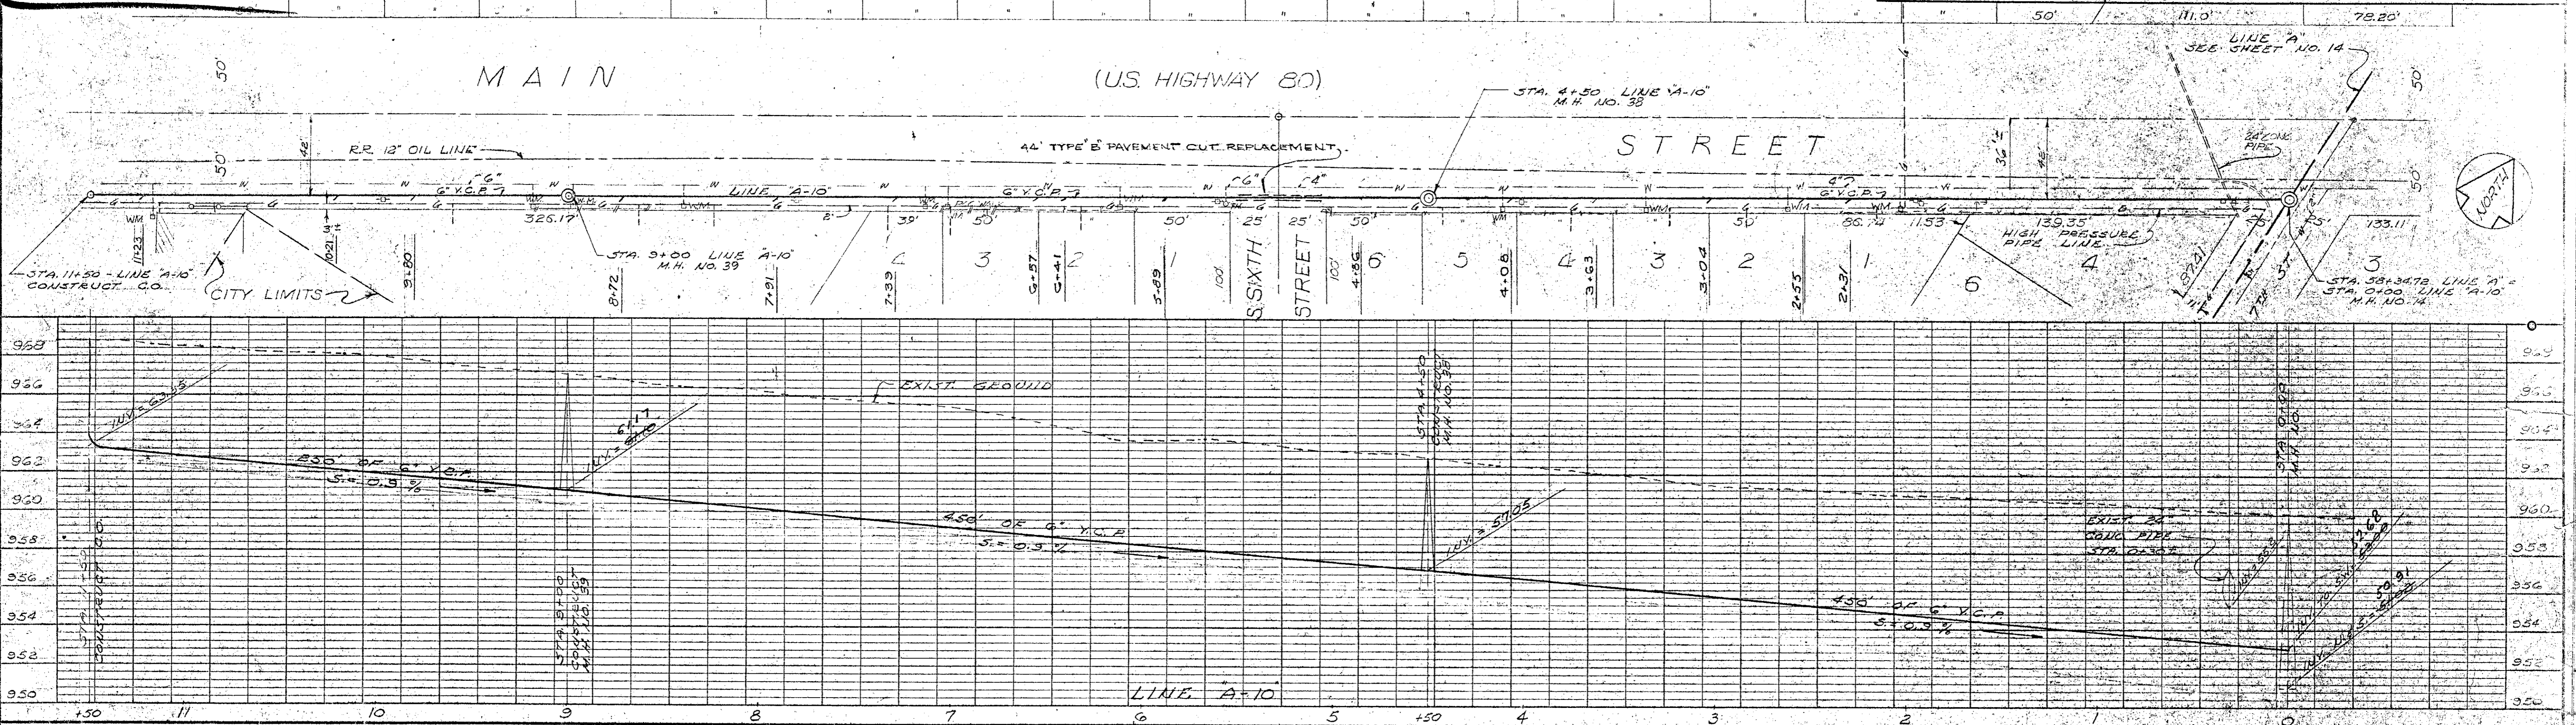

PLAN  
 SUPERVISED BY: \_\_\_\_\_  
 NOTE BOOK NO. \_\_\_\_\_  
 ALIGNMENT CHECKED BY: \_\_\_\_\_  
 RT. OF WAY CHECKED BY: \_\_\_\_\_