



**HARTMANN
ARCHITECTURE
STUDIO**

A D D E N D U M N O 3

Project: OJAI UNIFIED SCHOOL DISTRICT

LIBRARY RENOVATION
MATILIJIA MIDDLE SCHOOL
OUSD JOB # 2021-1617
Hartmann Project No.: 2020.032

Date: October 22, 2021

To all bidders submitting proposals for the above captioned project. This Addendum is hereby included in the Contract Documents to the same extent as though it were originally included therein. The following items modify, add to, delete from, or explain the drawings and/or specifications. The contents of this Addendum shall take precedence over the original specifications and plans.

Item #2.1: Sheet A-201 – Revised acoustic tile patterns.

Item #2.2: Approved acoustic tile product substitution request.


ATTACHMENTS:

Sheet A-201


J2 PET Felt Geo Panel Substitution Request

Martin Hartmann, Architect
CA License C-37789


Hartmann Architecture Studio
430 S. Carrillo Rd.
Ojai, CA 93023
(805) 530-5559
martin@hartmannarchitecturestudio.com

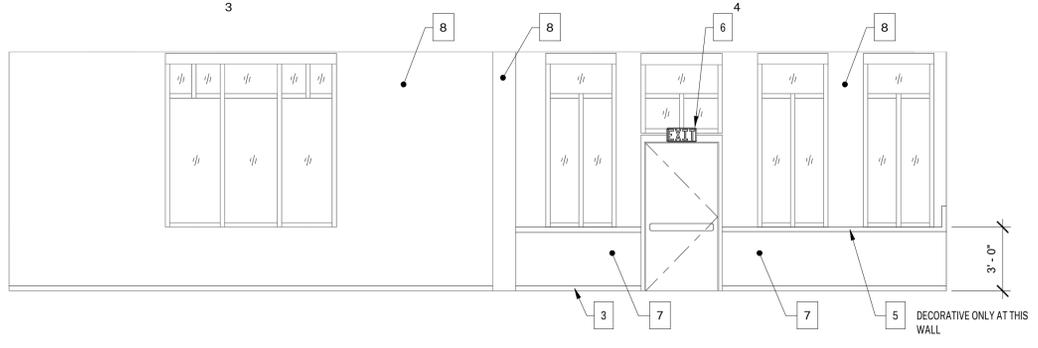


7 EAST INT ELEV
1/4" = 1'-0"

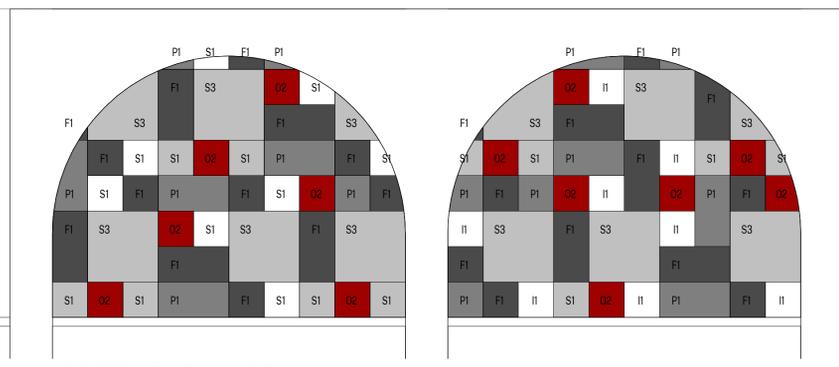


1 ACOUSTICAL PANEL - LAYOUT 1
1/2" = 1'-0"

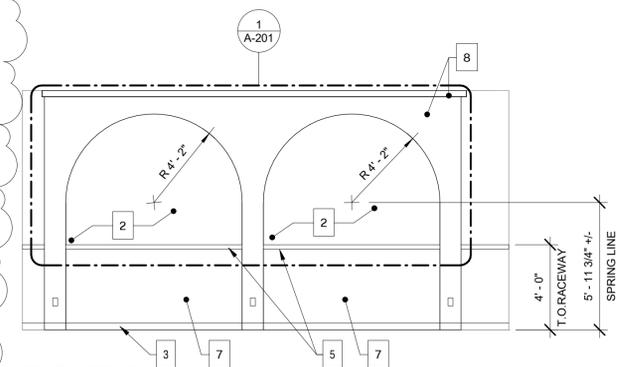


8 SOUTH INT ELEV
1/4" = 1'-0"

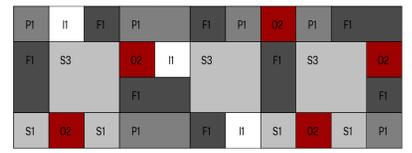


2 ACOUSTICAL PANEL - LAYOUT 2
1/2" = 1'-0"

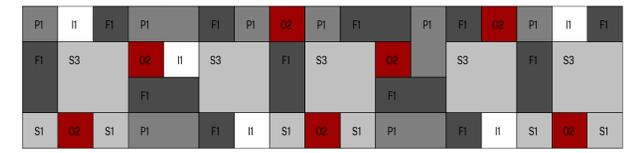


3 ACOUSTICAL PANEL - LAYOUT 3
1/2" = 1'-0"

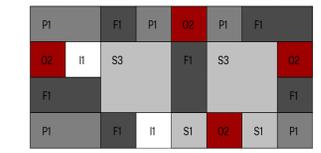


4 ACOUSTICAL PANEL - LAYOUT 4
1/2" = 1'-0"

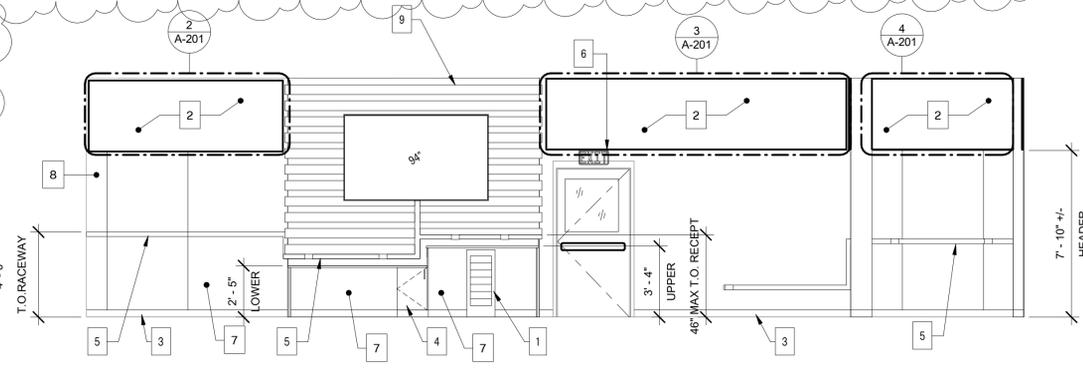


9 WEST INT ELEV
1/4" = 1'-0"

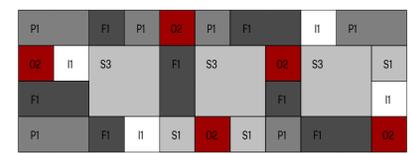

5 ACOUSTICAL PANEL - LAYOUT 5
1/2" = 1'-0"

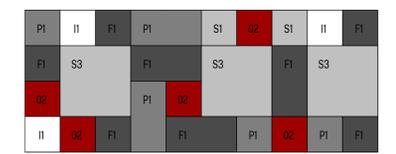

6 ACOUSTICAL PANEL - LAYOUT 6
1/2" = 1'-0"

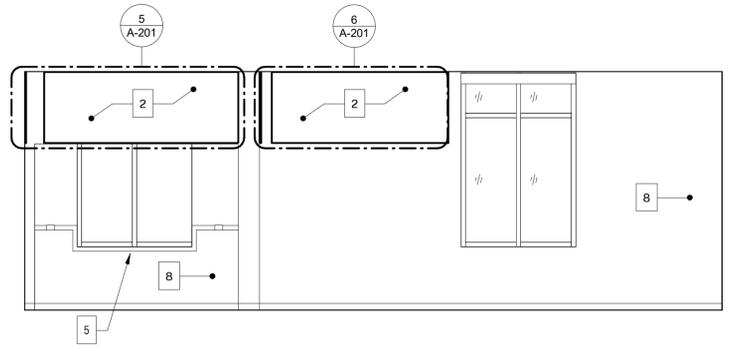

10 NORTH INT ELEV
1/4" = 1'-0"


FINISH NOTES

- COUNTERTOP LAMINATE COLOR = WILSONART CRISP LINEN OR EQUAL
- CABINET BASE AND SUPPORTS LAMINATE COLOR = WILSONART FUSION MAPLE
- PLUGMOLD & RACEWAY PRODUCT = LEGRAND STEEL 2000 SERIES WIREMOLD WITH ACCESSORIES AND FITTING REQUIRED FOR A COMPLETE INSTALLATION
- PATCH/REPAIR/PAINT ALL DOORS, WINDOWS, AND TRIM THROUGHOUT.

SHEET KEYNOTES

- (E) RETURN AIR CRILLE, TO REMAIN
- ACOUSTICAL PANEL
- RESILIENT BASE THROUGHOUT
- BASE CABINET WITH WORKSURFACES ABV
- PLUG MOLD, PROVIDE AT LOCATIONS INDICATED
- SELF-LUMINOUS EXIT SIGN, ACUITY DSWIR20IF OR EQUAL
- PAINTED WAINSCOT, COLOR = DUNN EDWARDS SHINING KNIGHT
- PAINTED WALL, COLOR = DUNN EDWARDS WISP OF SMOKE
- WOOD ACCENT WALL, SEE 1/A-301

ACOUSTIC PANEL SCHEDULE

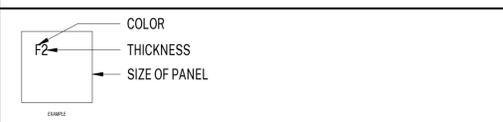

- COLOR LEGEND**
- I = IVORY
 - S = SMOKE
 - P = PEWTER
 - F = FOSSIL
 - O = OCHRE

- THICKNESS LEGEND**
- 1 = 0.5"
 - 2 = 1"
 - 3 = 1.8"

- PANEL SIZE LEGEND**
- 20" x 20"
 - 20" x 10"
 - 10" x 10"

AGENCY APPROVAL:

HARTMANN ARCHITECTURE STUDIO
HARTMANNARCHITECTURESTUDIO.COM
430 S. CARRILLO RD.
OJAI, CALIFORNIA 93023
(805) 530-5559

CONSULTANTS:

SEALS:

PROJECT:
MATILJA MIDDLE SCHOOL LIBRARY RENOVATION

OWNER:
OJAI UNIFIED SCHOOL DISTRICT
414 E. OJAI AVENUE
OJAI, CA 93023
(805) 640-4300
CONTACT: ADAM DUTTER, BOND MANAGER
EMAIL: adutter@ojaiusd.org

PROJECT ADDRESS:
MATILJA MIDDLE SCHOOL
703 EL PASEO ROAD
OJAI, CA 93023

ISSUE:		
MARK	DATE	DESCRIPTION
2	10/22/21	ADDENDUM #3

PROJECT INFORMATION:
PROJECT NUMBER: 2020.032
PROJECT PHASE: CD
DRAWN BY: PBS/MH
REVIEWED BY: MH

SHEET TITLE:
PROPOSED INTERIOR ELEVATIONS & FINISH SCHEDULE

SHEET NUMBER:
A-201
DATE: 10/22/2021 4:37:52 PM

UNIVERSITY OF CALIFORNIA ARCHITECTURAL RECORDS: THIS DOCUMENT IS THE PROPERTY OF HARTMANN ARCHITECTURE STUDIO AND SHALL NOT BE REPRODUCED OR TRANSMITTED IN ANY FORM OR BY ANY MEANS, WITHOUT THE WRITTEN AUTHORIZATION OF HARTMANN ARCHITECTURE STUDIO.



SUBSTITUTION REQUEST

(During the Bidding/Negotiating Stage)

Project: _____ Substitution Request Number: _____

From: _____

To: _____ Date: _____

A/E Project Number: _____

Re: _____ Contract For: _____

Specification Title: _____ Description: _____

Section: _____ Page: _____ Article/Paragraph: _____

Proposed Substitution: _____

Manufacturer: _____ Address: _____ Phone: _____

Trade Name: _____ Model No.: _____

Attached data includes product description, specifications, drawings, photographs, and performance and test data adequate for evaluation of the request; applicable portions of the data are clearly identified.

Attached data also includes a description of changes to the Contract Documents that the proposed substitution will require for its proper installation.

The Undersigned certifies:

- Proposed substitution has been fully investigated and determined to be equal or superior in all respects to specified product.
- Same warranty will be furnished for proposed substitution as for specified product.
- Same maintenance service and source of replacement parts, as applicable, is available.
- Proposed substitution will have no adverse effect on other trades and will not affect or delay progress schedule.
- Proposed substitution does not affect dimensions and functional clearances.
- Payment will be made for changes to building design, including A/E design, detailing, and construction costs caused by the substitution.

Submitted by: _____

Signed by: Shandelle Carpenter

Firm: _____

Address: _____

Telephone: _____

A/E's REVIEW AND ACTION

- Substitution approved - Make submittals in accordance with Specification Section 01 25 00 Substitution Procedures.
- Substitution approved as noted - Make submittals in accordance with Specification Section 01 25 00 Substitution Procedures.
- Substitution rejected - Use specified materials.
- Substitution Request received too late - Use specified materials.

Signed by: Martin Hartmann **Martin Hartmann, AIA** Date: **10/22/2021**

Supporting Data Attached: Drawings Product Data Samples Tests Reports _____