


- NOTES:
1. TOPOGRAPHY BASED ON SURVEY PERFORMED IN SEPTEMBER 2004. ELEVATIONS AT CONSTRUCTION MAY DEVIATE FROM SURVEY DUE TO SETTLEMENT.
  2. 8" HEADER PIPE TO BE LAYED WITH MINIMUM 24" COVER.
  3. CONSTRUCTION OF LATERALS BEYOND 8"x4" HDPE CROSS IS EXCLUDED FROM THIS CONTRACT. LATERAL SHALL HAVE 1/2" DIAMETER ORIFICES ON 6-FOOT CENTERS IN A SPIRAL ROTATION AROUND ITS DIAMETER AT 0, 60, 120, 180, 240 AND 300 DEGREES. ORIFICE SHALL TERMINATE 115' FROM CROSS.
  4. CONTRACTOR TO LOCATE AND PROTECT EXISTING LATERALS WITHIN CONSTRUCTION AREA.
  5. CONTRACTOR IS RESPONSIBLE FOR WELDING OWNER-INSTALLED LATERALS TO 8"x4" CROSSES.



REVISED DATE	
REVISION NO.	
DRAWN BY	TWK
REV.	DATE
	11-08-07
SCALE	NONE

SOLID WASTE MANAGEMENT CENTER  
 HIGHLANDS COUNTY, FLORIDA  
 LEACHATE RECIRCULATION SYSTEM MODIFICATIONS  
 DETAILS  
 CELL 3B, ELEVATION 102

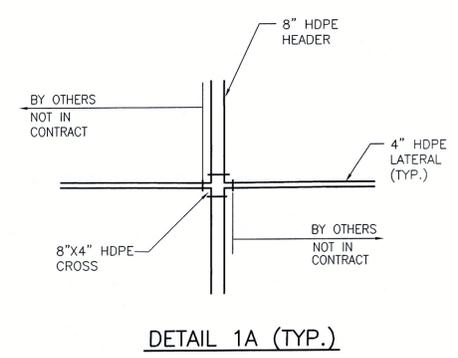

RECORD DRAWING