


**C1 BARRANCAS AVENUE**  
SCALE: 1" = 60' 0 30' 60' 120'



**A1 BARRANCAS AVENUE**  
SCALE: 1" = 60' 0 30' 60' 120'

AS-BUILT  
1-30-19

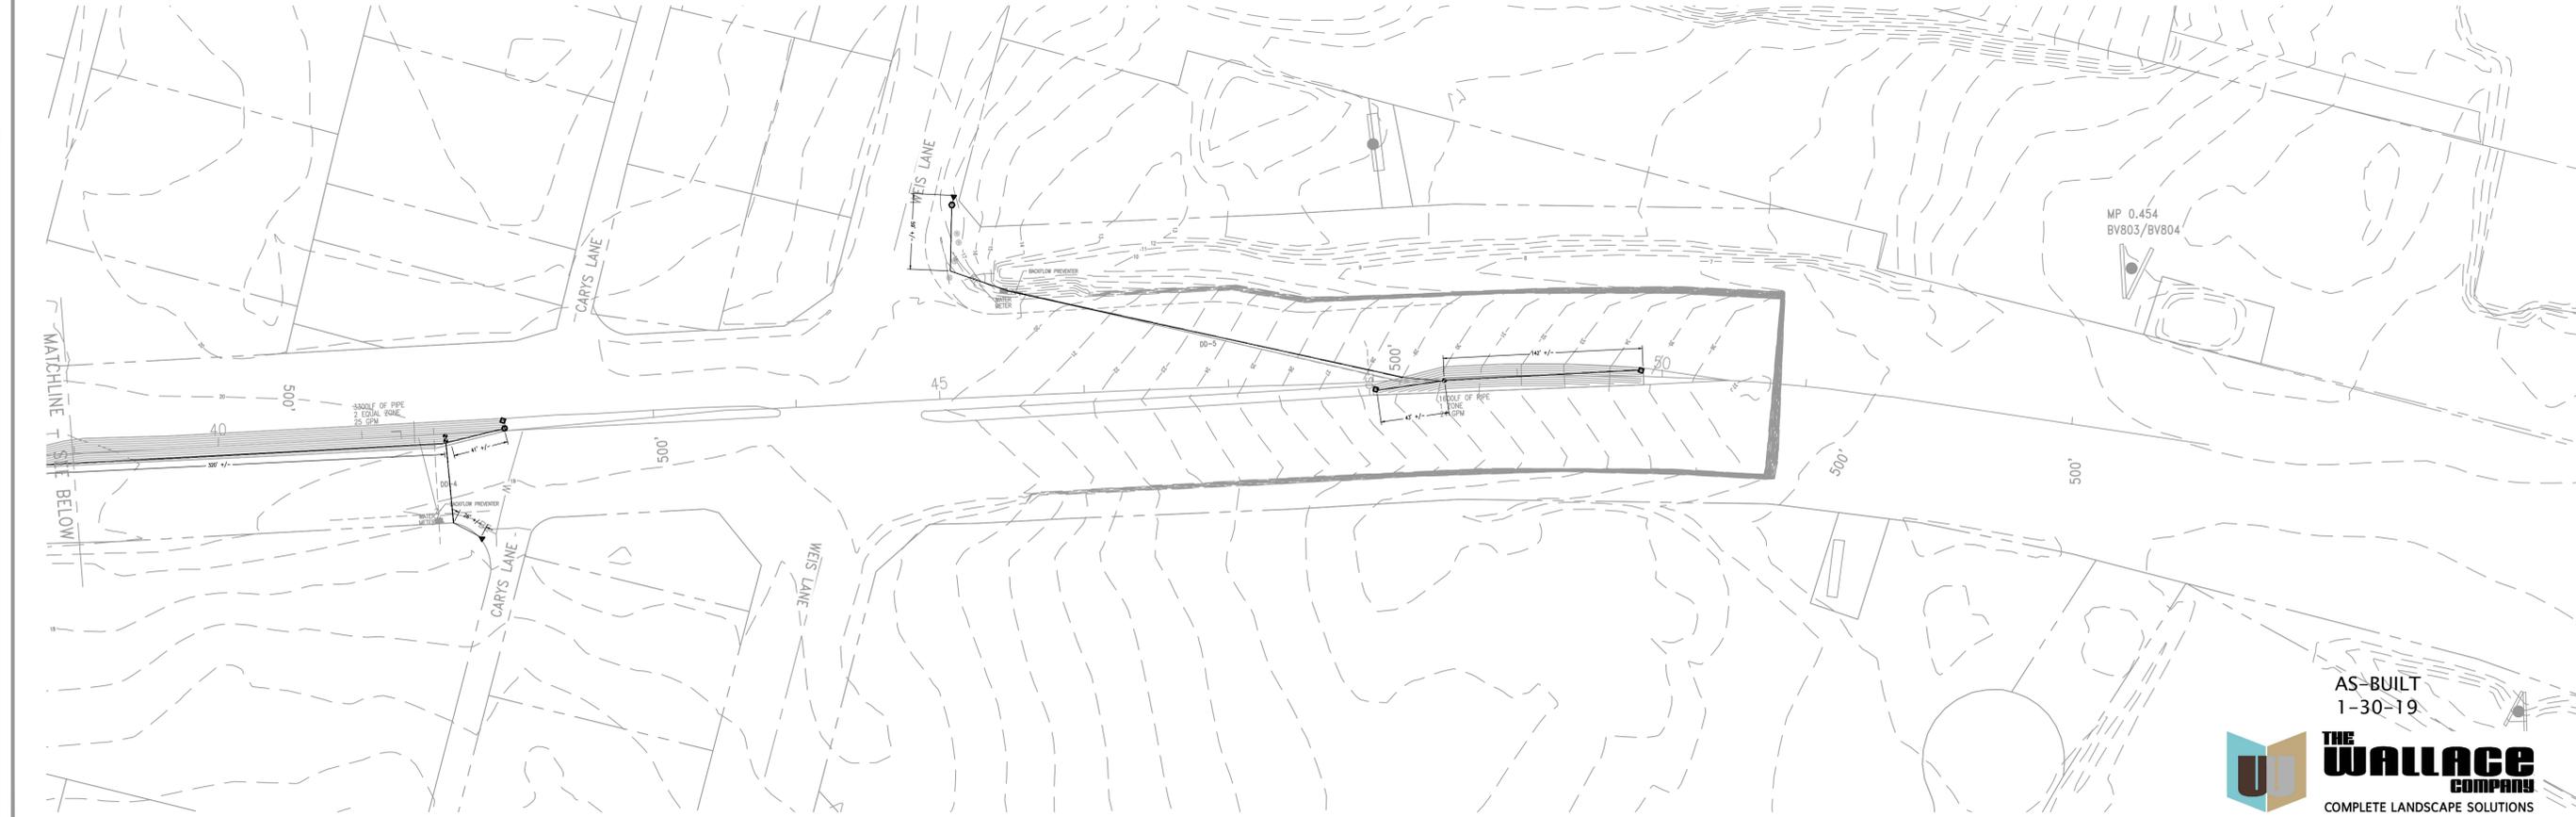

**BASKERVILLE-DONOVAN, INC.**  
Innovative Infrastructure Solutions  
448 W. MAIN ST., PENSACOLA, FL 32502 (850)438-9881  
ENGINEERING BUSINESS: EB-0000340  
Pensacola - Panama City Beach - Melbourne - Tallahassee - Mobile

DAVID K. HEIPHILL  
FL Reg. Landscape Architect  
Architect #02

BARRANCAS AVENUE  
BEAUTIFICATION

| NO. | DATE       | APPR. | REVISION/ACTION TAKEN   |
|-----|------------|-------|-------------------------|
| 1   | APRIL 2018 | DKH   | RELEASED FOR PERMITTING |

PROJECT NO: 258103.01  
DESIGNED BY: DKH  
DRAWN BY: THO  
CHK'D BY: DKH  
PROJ. MGR: DKH  
DATE: APRIL 2018


BARRANCAS AVENUE  
ANALYSIS PLAN

OVERALL

This drawing is the property of BASKERVILLE-DONOVAN, INC. and is not to be reproduced in whole or in part. It is not to be used on any other project and is to be returned upon request.

| IRRIGATION LEGEND |          |   |
|-------------------|----------|---|
| SYMBOL            | QUANTITY | MODEL NUMBER SPECIFICATION (RAINBIRD OR APPROVED EQUAL) |
|                   | PER PLAN | VALVE   |
|                   | PER PLAN | AIR RELEASE VALVE                                       |
|                   | PER PLAN | FLUSH VALVE   |
|                   | PER PLAN | 1-1/2" BALL VALVE                                       |
|                   | PER PLAN | WATER METER W/ BACKFLOW PREVENTER                       |
|                   | PER PLAN | MAIN IRRIGATION LINE WITH TRACER WIRE                   |
|                   | PER PLAN | IRRIGATION SLEEVE                                       |

MEDIAN 1 = 4360 SF  
 MEDIAN 2 = 9276 SF  
 MEDIAN 3 = 825 SF

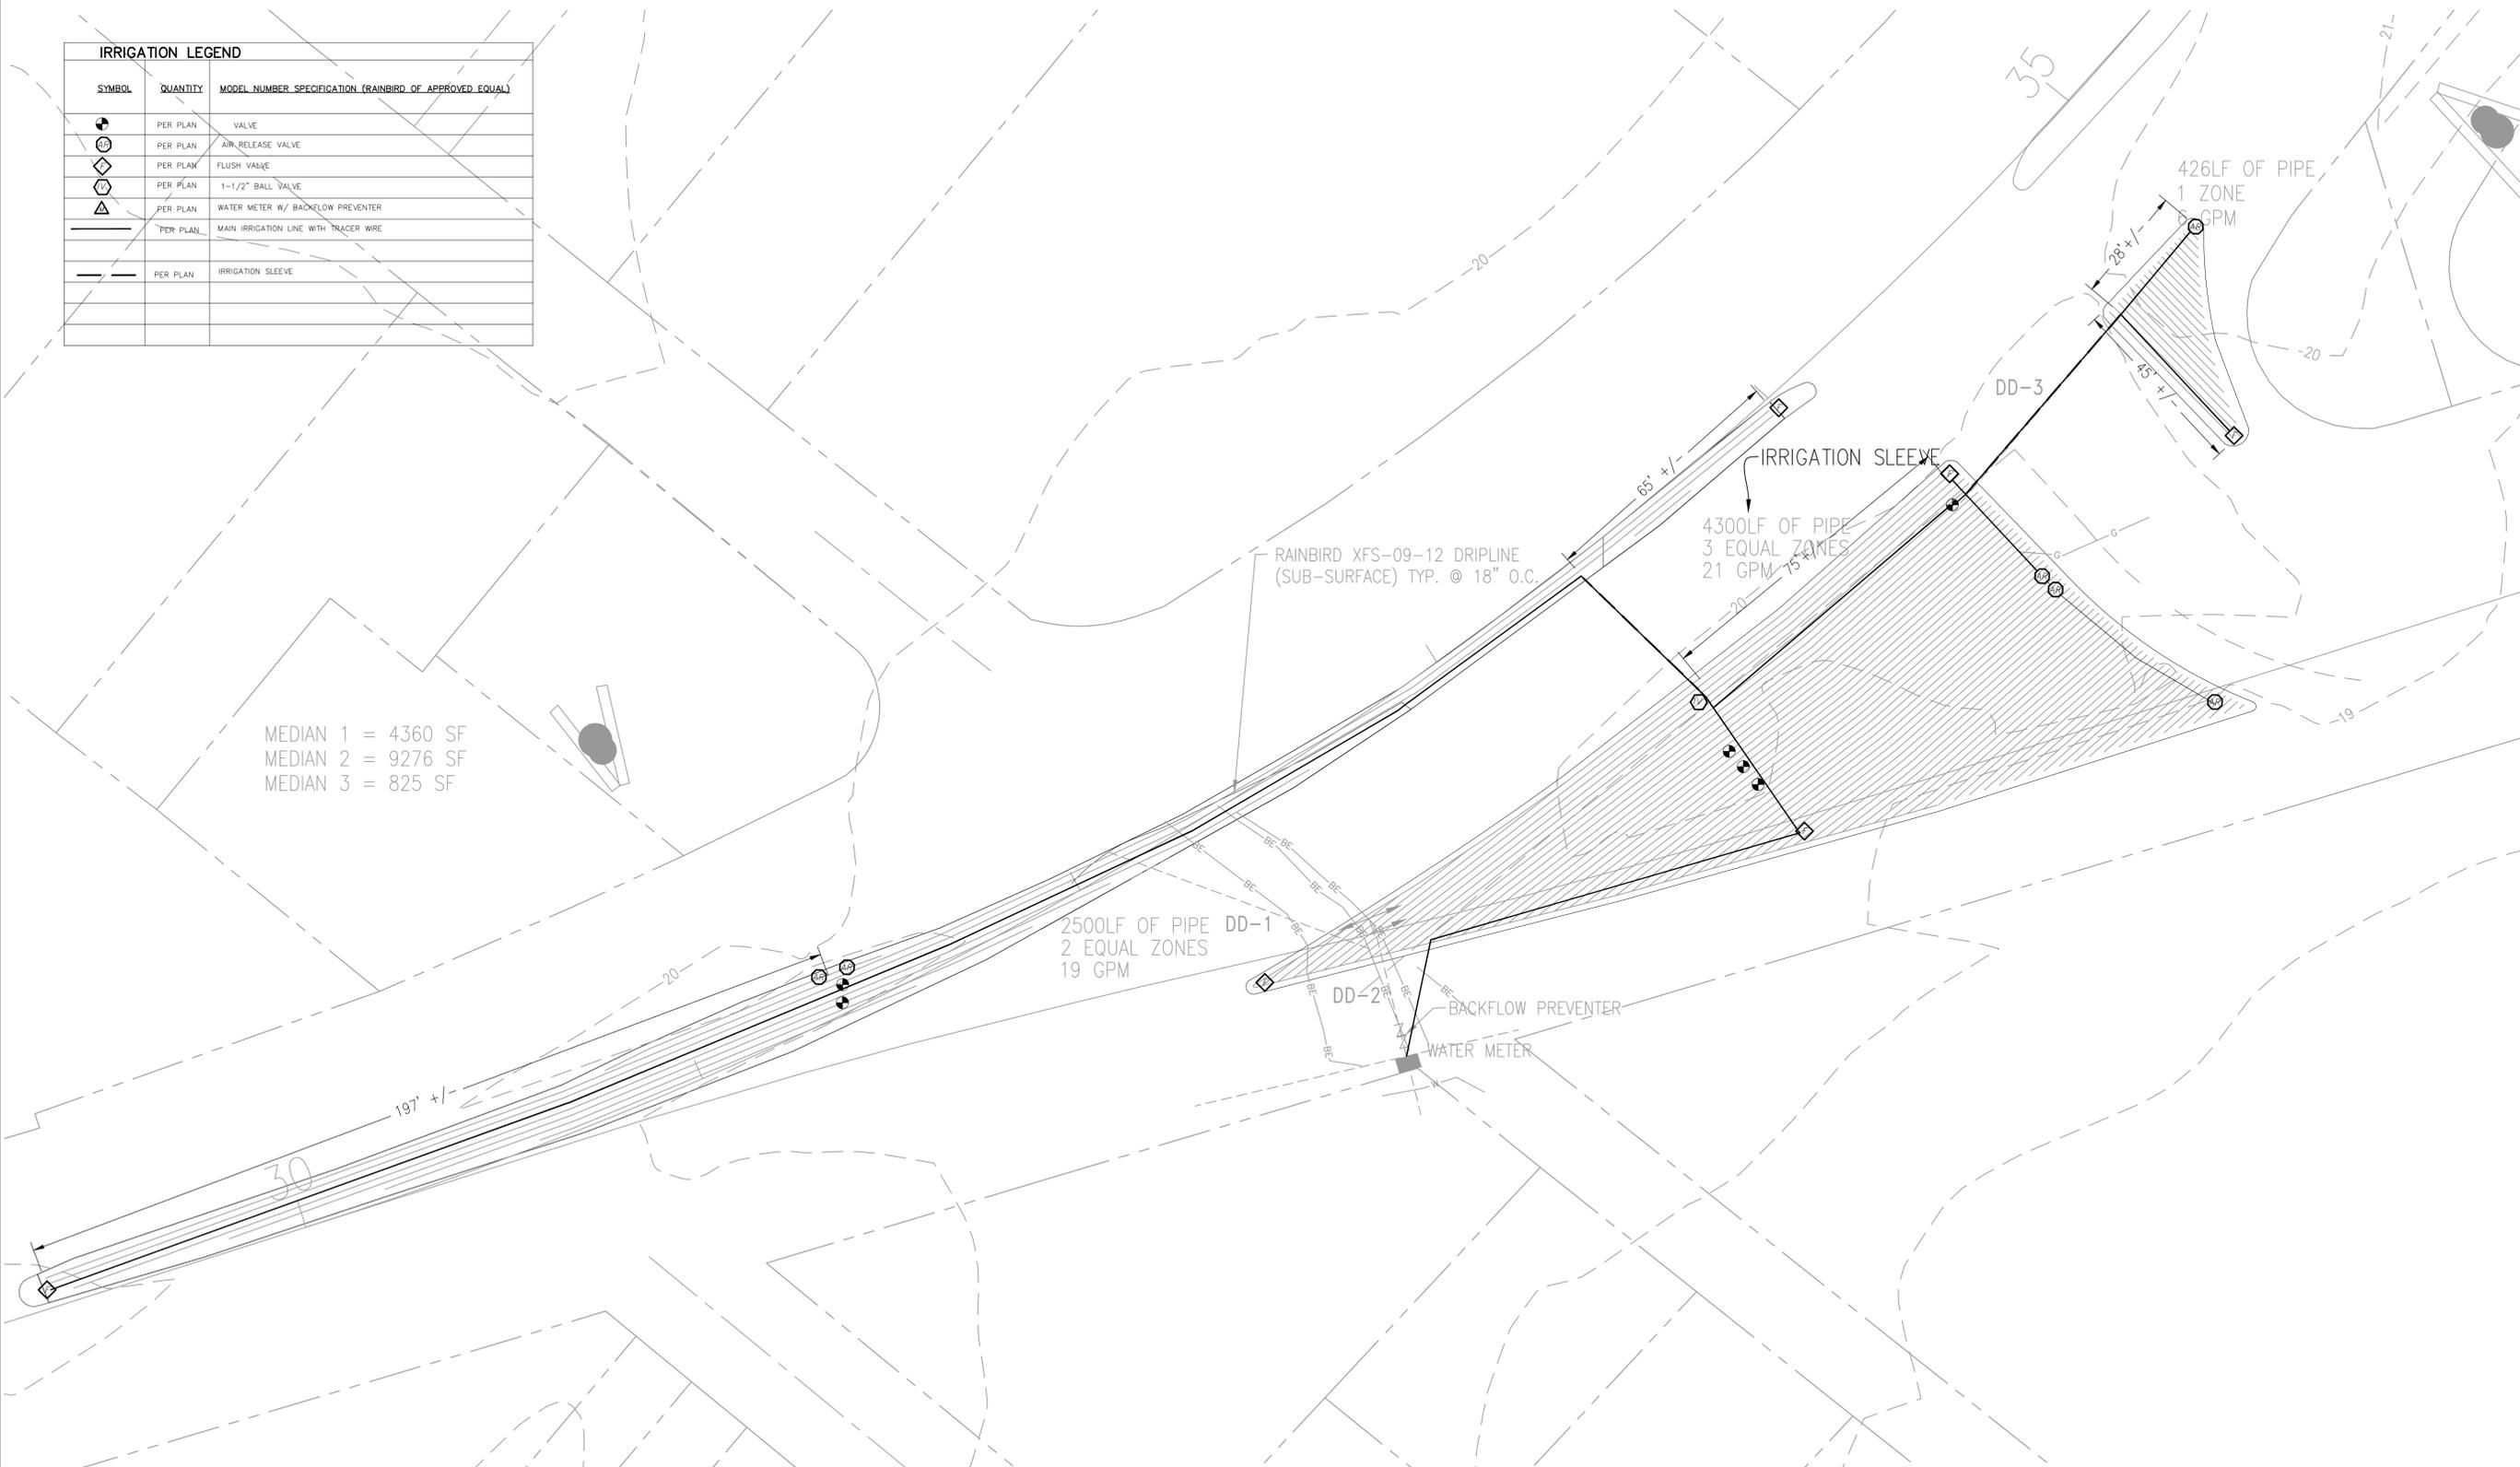

**A1** MEDIAN 1, 2 & 3 IRRIGATION PLAN  
 SCALE: 1" = 20'



AS-BUILT  
 1-30-19

**BASKERVILLE-DONOVAN, INC.**  
 Innovative Infrastructure Solutions  
 449 W. MAIN ST., PENSACOLA, FL 32502 (850)438-8661  
 ENGINEERING BUSINESS EB-0000340  
 Pensacola - Panama City Beach - Melbourne - Tallahassee - Mobile

DAVID K. HEMPHILL  
 FL Reg. Landscape  
 Architect #502

BARRANCAS AVENUE  
 BEAUTIFICATION

| PROJECT NO. | DESIGNED BY | DRAWN BY | CHK'D BY | PROJ. MGR. | DATE       |
|-------------|-------------|----------|----------|------------|------------|
| 258103.01   | DKH         | THO      | DKH      | DKH        | APRIL 2018 |


  

| NO. | DATE       | APPR. | REVISION/ACTION TAKEN                             |
|-----|------------|-------|---|
| 1   | APRIL 2018 | DKH   | RELEASED FOR PERMITTING                           |
|     |            |       | NOT RELEASED FOR CONSTRUCTION BY _____ DATE _____ |

MEDIAN 1, 2 & 3  
 IRRIGATION PLAN

This drawing is the property of BASKERVILLE-DONOVAN, INC. and is not to be reproduced in whole or in part. It is not to be used on any other project and is to be returned upon request.

| IRRIGATION LEGEND |          |   |
|-------------------|----------|---|
| SYMBOL            | QUANTITY | MODEL NUMBER SPECIFICATION (RAINBIRD OR APPROVED EQUAL) |
|                   | PER PLAN | VALVE   |
|                   | PER PLAN | AIR RELEASE VALVE                                       |
|                   | PER PLAN | FLUSH VALVE   |
|                   | PER PLAN | 1-1/2" BALL VALVE                                       |
|                   | PER PLAN | WATER METER W/ BACKFLOW PREVENTER                       |
|                   | PER PLAN | MAIN IRRIGATION LINE WITH TRACER WIRE                   |
|                   | PER PLAN | IRRIGATION SLEEVE                                       |

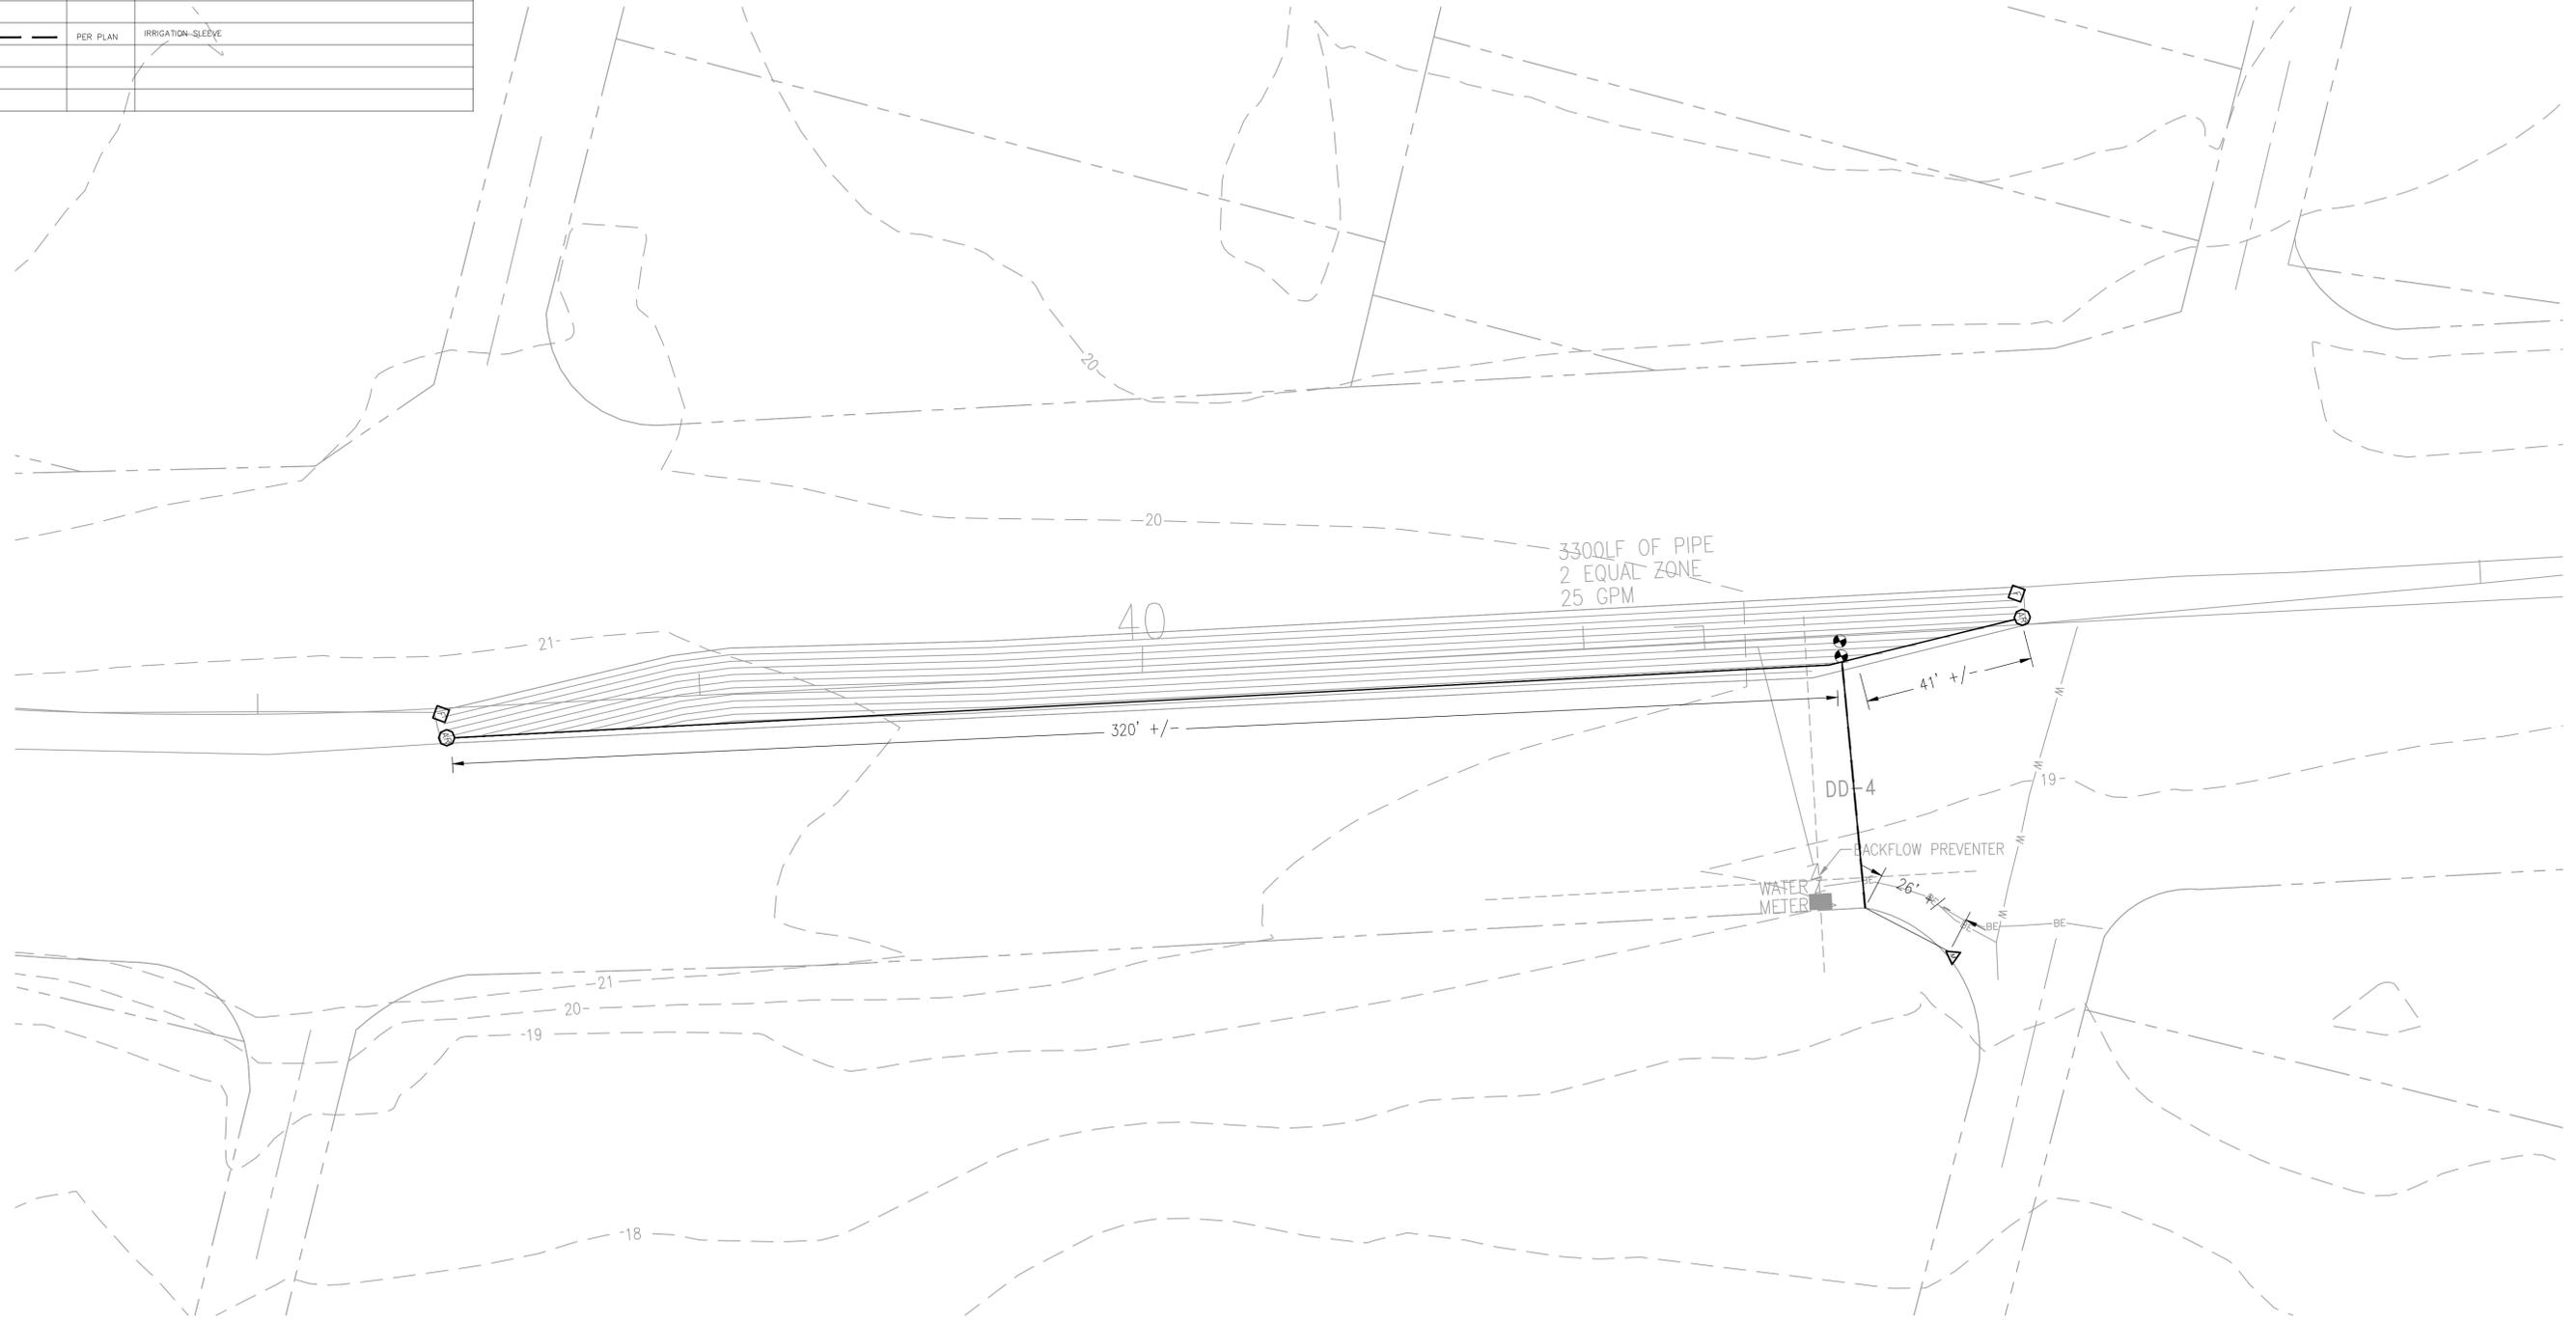


A1 MEDIAN 4 IRRIGATION PLAN  
SCALE: 1" = 20' 0 10' 20' 40'



| PROJECT NO.      | NO. | DATE       | APPR. | REVISION/ACTION TAKEN                             |
|------------------|-----|------------|-------|---|
| 258103.01        | 1   | APRIL 2018 | DKH   | RELEASED FOR PERMITTING                           |
| DESIGNED BY: THO |     |            |       |   |
| DRAWN BY: DKH    |     |            |       |   |
| CHK'D BY: DKH    |     |            |       |   |
| PROJ. MGR: DKH   |     |            |       |   |
| DATE: APRIL 2018 |     |            |       | NOT RELEASED FOR CONSTRUCTION BY _____ DATE _____ |

| IRRIGATION LEGEND |          |   |
|-------------------|----------|---|
| SYMBOL            | QUANTITY | MODEL NUMBER SPECIFICATION (RAINBIRD OR APPROVED EQUIV) |
|                   | PER PLAN | VALVE   |
|                   | PER PLAN | AIR RELEASE VALVE                                       |
|                   | PER PLAN | FLUSH VALVE   |
|                   | PER PLAN | 1-1/2" BALL VALVE                                       |
|                   | PER PLAN | WATER METER W/ BACKFLOW PREVENTER                       |
|                   | PER PLAN | MAIN IRRIGATION LINE WITH TRACER WIRE                   |
|                   | PER PLAN | IRRIGATION SLEEVE                                       |

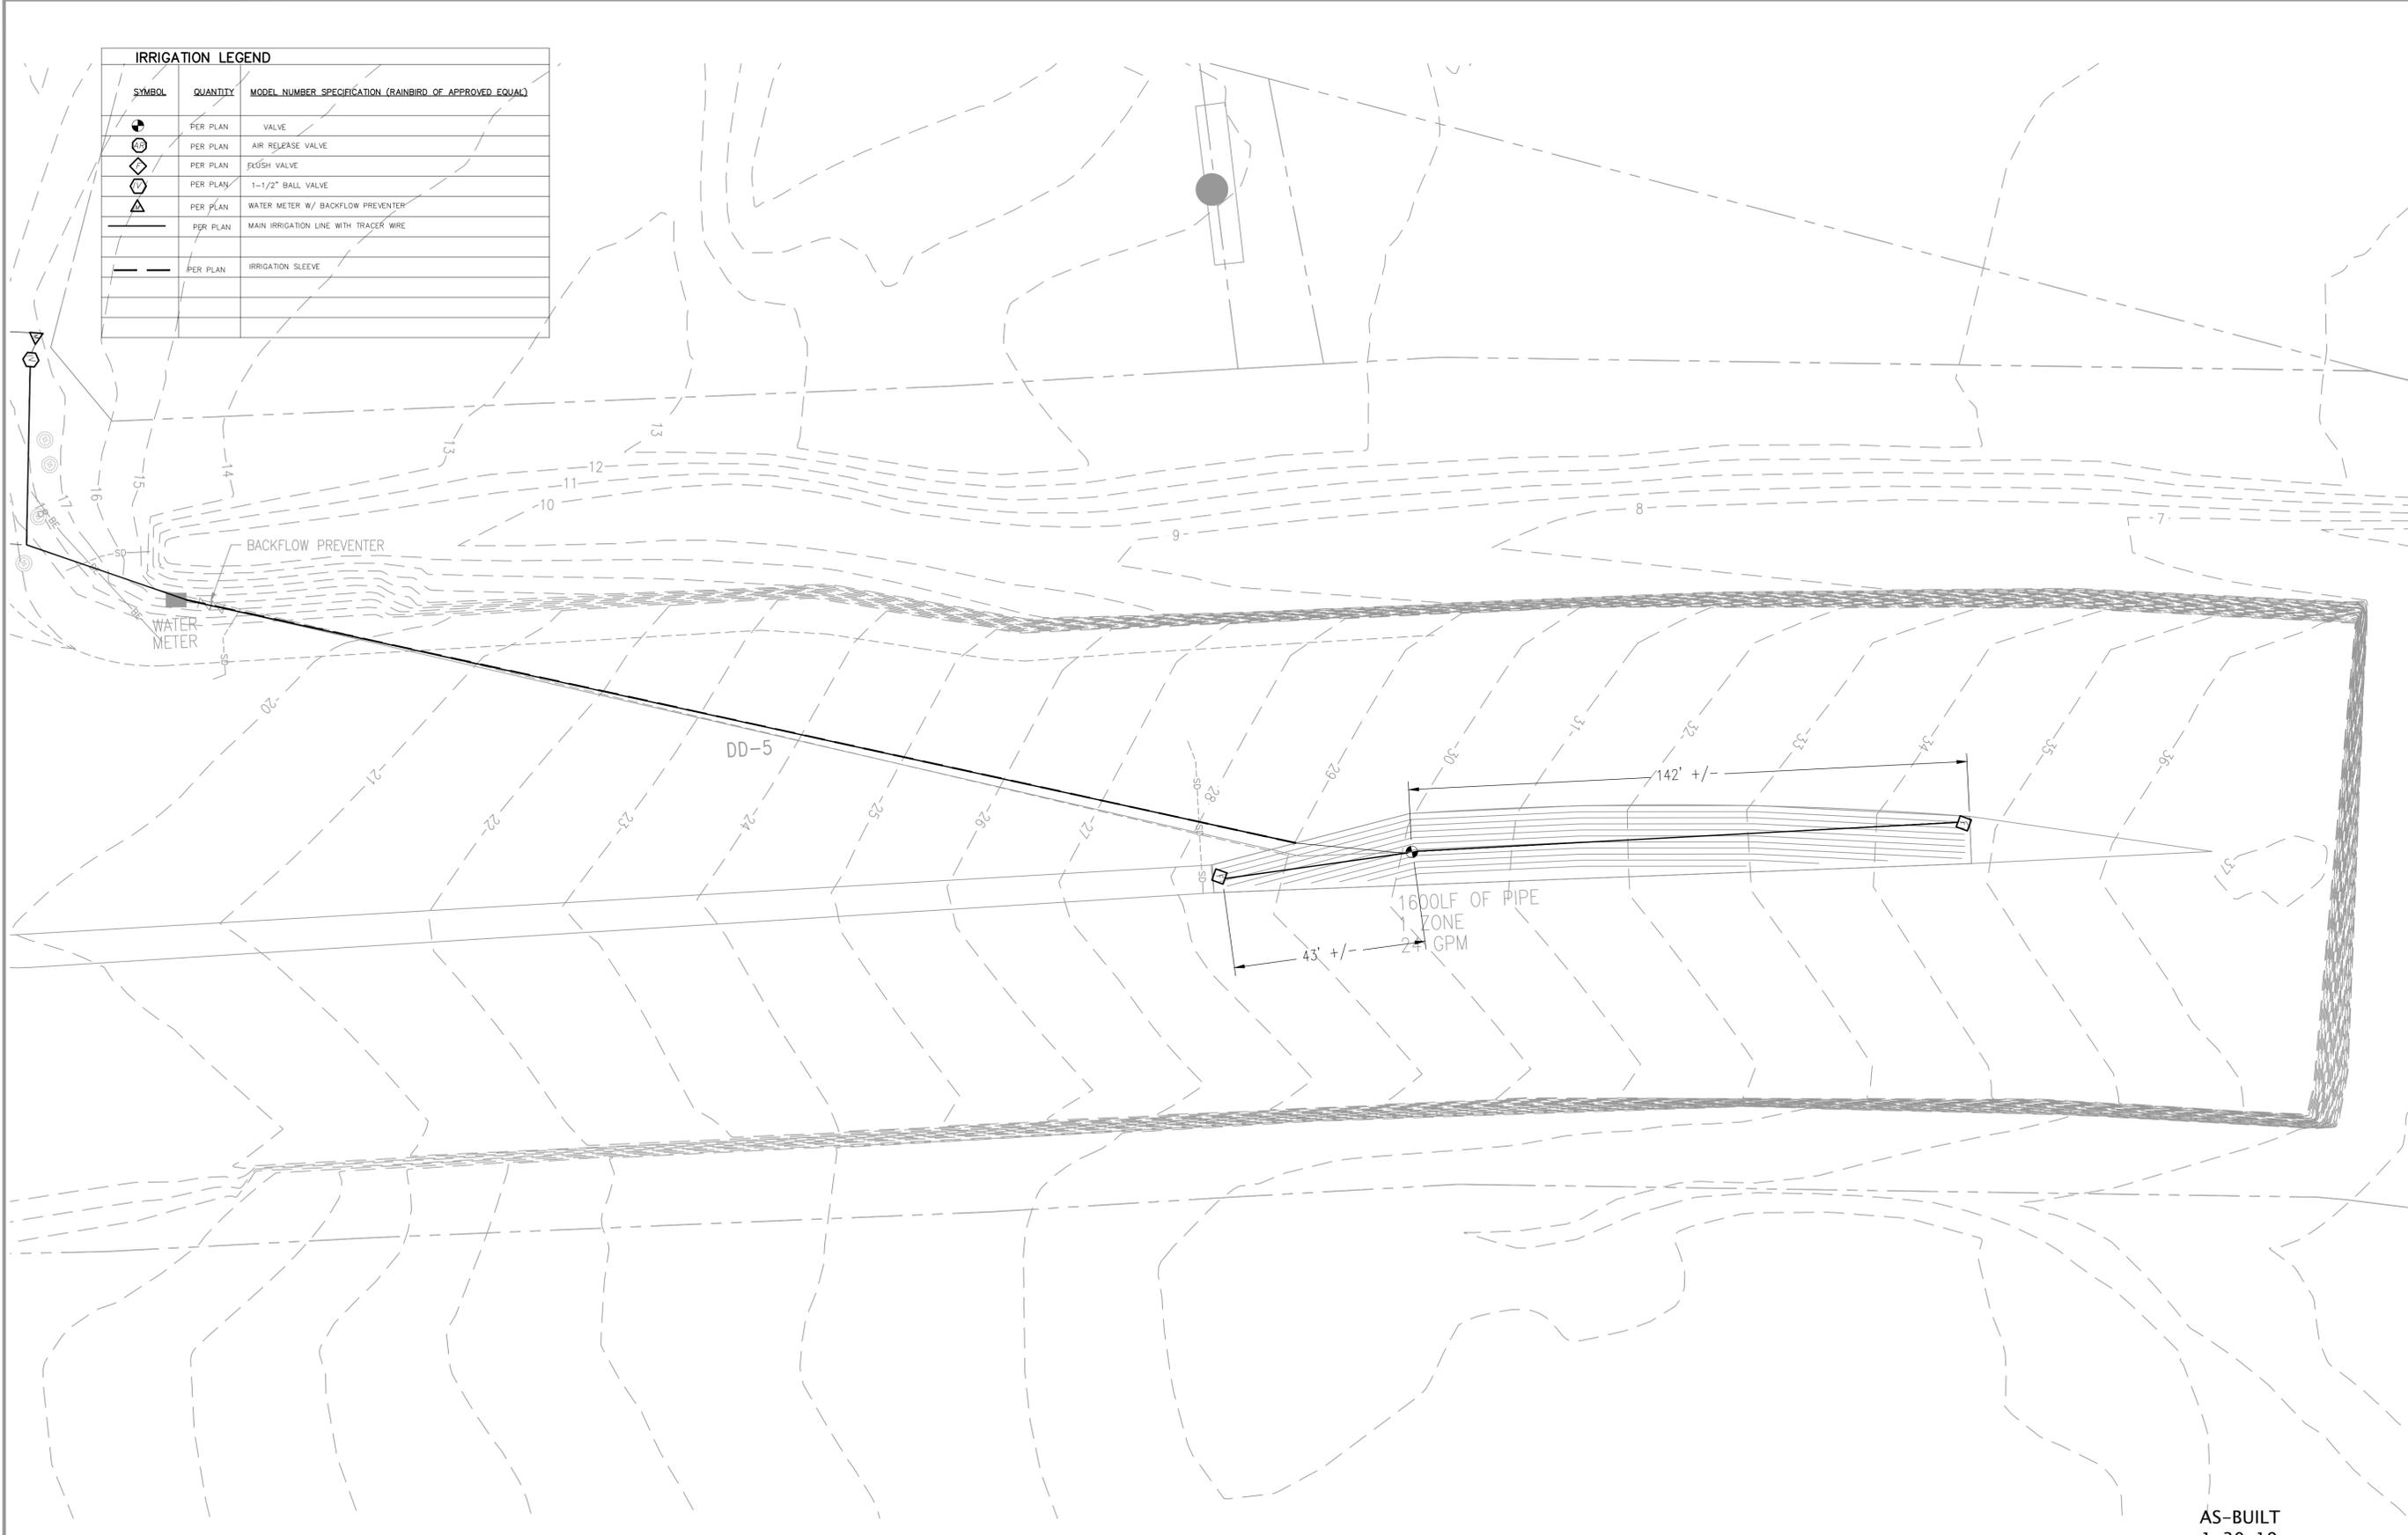

A1 MEDIAN 5 IRRIGATION PLAN  
SCALE: 1" = 20' 0 10' 20' 40'



AS-BUILT  
1-30-19



**BASKERVILLE-DONOVAN, INC.**  
Innovative Infrastructure Solutions  
449 W. MAIN ST. PENSACOLA, FL 32502 (850) 438-9861  
ENGINEERING BUSINESS: EB-0000340  
Pensacola - Panama City Beach - Melbourne - Tallahassee - Mobile  
This drawing is the property of BASKERVILLE-DONOVAN, INC. and is not to be reproduced in whole or in part. It is not to be used on any other project and is to be returned upon request.

DAVID K. HEMPHILL  
FL Reg. Landscape Architect #502

BARRANCAS AVENUE  
BEAUTIFICATION

| PROJECT NO. | DESIGNED BY | DRAWN BY | CHK'D BY | PROJ. MGR. | DATE       | NO. | DATE       | APPR. | REVISION/ACTION TAKEN                             |
|-------------|-------------|----------|----------|------------|------------|-----|------------|-------|---|
| 258103.01   | DKH         | THO      | DKH      | DKH        | APRIL 2018 | 1   | APRIL 2018 | DKH   | RELEASED FOR PERMITTING                           |
|             |             |          |          |            |            |     |            |       | NOT RELEASED FOR CONSTRUCTION BY _____ DATE _____ |

MEDIAN 5  
IRRIGATION PLAN