

## CONTRACT, LEASE, AGREEMENT CONTROL FORM

Date: 01/19/2022

Contract/Lease Control #: C21-3081-PW

Procurement#: ITB PW 32-21

Contract/Lease Type: AGREEMENT

Award To/Lessee: HARRIS-INMAN CONSTRUCTION, CO., INC.

Owner/Lessor: OKALOOSA COUNTY

Effective Date: 05/18/2021

Expiration Date: 04/07/2022

Description of: OKALOOSA COUNTY SIDEWALK RAMPS IMPROVEMENT

Department: PW

Department Monitor: AUTREY

Monitor's Telephone #: 850-689-5772

Monitor's FAX # or E-mail: JAUTREY@MYOKALOOSA.COM

Closed:

Cc: BCC RECORDS

**CHANGE ORDER FORM**

Date: January 18, 2022 Contract No.: C21-3081-PW Change Order No.: 01

Owner: OKALOOSA COUNTY BOARD OF COUNTY COMMISSIONERS

Contractor: Harris-Inman Construction Company

The Contract/Agreement is modified as follows upon execution of this Change Order:

Description - The time of completion of Okaloosa County Sidewalk Ramps Improvements is revised as follows: Add additional detectable warning pads at four intersections and install additional concrete curb and gutter. Increase the final completion by 145 days which includes weather delay, crew illness due to COVID-19 and time to complete additional work items described in the attachments. The additional work requested will add \$4,244.00 to the original contract price.

Attachments: Drawings with markup; Contractor Estimate.


CHANGE TO CONTRACT PRICE	
DESCRIPTION	AMOUNT
Original Contract Price:	\$109,245.00
Net change by previously authorized Change Orders:	\$0.00
Present Contract Price:	\$109,245.00
This Change Order will (add):	\$4,244.00
New Contract Price:	\$113,489.00
CHANGE TO CONTRACT TIME	
DESCRIPTION	DATE or NUMBER OF DAYS
Original Contract Time:	90 Days to Substantial; 135 Days to Final
Original Substantial & Final Completion Dates:	9/29/2021 & 11/13/2021
Net change by previously authorized Change Orders:	None
This Change Order will add:	170 days to Substantial Completion 145 days to Final Completion
New Contract Time:	280 Days to Final
New Final Completion Date:	7-Apr-22

**APPROVALS**

REQUESTED BY: [Signature] DATE: 01/04/2022  
PROJECT ENGINEER: [Signature] DATE: 1/5/22  
CONTRACTOR: [Signature] DATE: 1/6/22  
OWNER: [Signature] DATE: JAN 18 2022  
Mal Ponce, Chairman



This Change Order is an amendment to the Contract/Agreement between Contractor and the Owner, and all other contract provisions shall remain in full force and effect unless specifically amended in writing, signed by both parties.

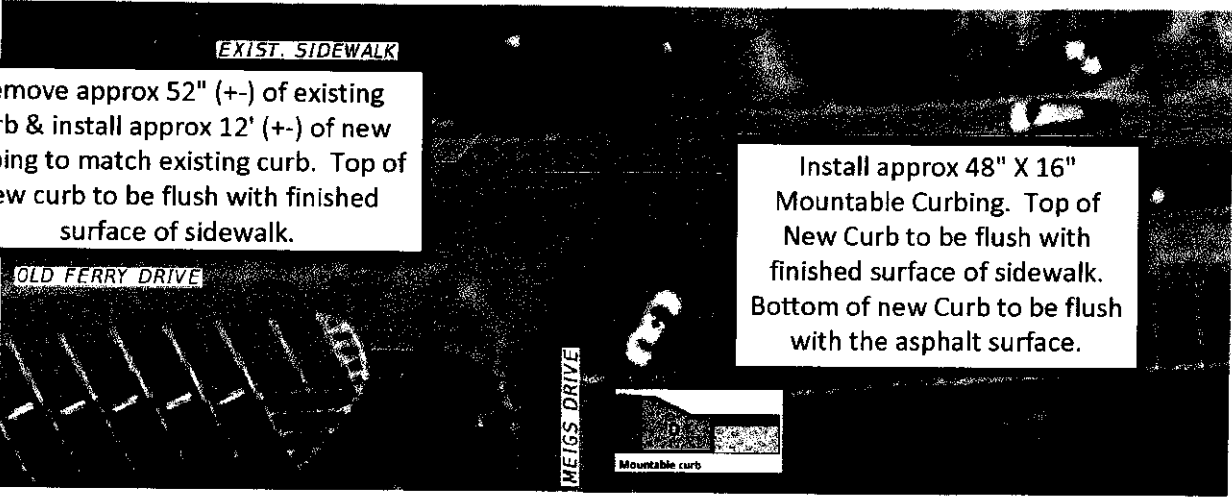

**EXIST. SIDEWALK**

Remove approx 52" (+-) of existing curb & install approx 12' (+-) of new curbing to match existing curb. Top of new curb to be flush with finished surface of sidewalk.

Install approx 48" X 16" Mountable Curbing. Top of New Curb to be flush with finished surface of sidewalk. Bottom of new Curb to be flush with the asphalt surface.


**OLD FERRY DRIVE**

**MEIGS DRIVE**



**CONSTRUCTION NOTES:**

1. MAINTAIN A SINGLE LONGITUDINAL SLOPE ALONG EACH SIDE OF THE CURB RAMP. RAMP SLOPES SHALL BE A MINIMUM OF 10 FEET AND MAXIMUM OF 15 FEET IN LENGTH, UNLESS OTHERWISE NOTED. REMOVE AND REPLACE EXISTING CURB, CURB AND GUTTER, OR SIDEWALK TO THE NEAREST JOINT OR TO THE EXTENT THAT NO REMAINING SECTION IS LESS THAN 5 FEET LONG.
2. RAMP SLOPES SHALL BE A MINIMUM OF 2% AND MAXIMUM OF 8%.
3. FOR CONSTRUCTION REQUIREMENTS, SEE SHEET RR 1. THESE REQUIREMENTS WILL DICTATE THE LIMITS OF CONSTRUCTION, FINAL CURB RAMP TYPE, ELEVATIONS, AND CURB RAMP ALIGNMENT & PLACEMENT.
4. SEE STANDARD DETAIL SHEETS FOR MORE INFORMATION.

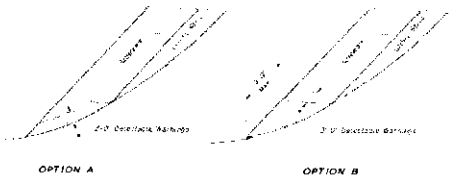

SUMMARY OF PAY ITEMS			
ITEM NO	DESCRIPTION	UNIT	QUANTITY
1	CONCRETE SIDEWALKS AND DRIVEWAYS INCLUDING CLEARING AND GRUBBING AND EARTHWORK (E. REMOVAL OF EXISTING CONCRETE AND ASPHALT, EXCAVATION, ROUGH CRACKING)	SY	6
2	DETECTABLE WARNING	SF	7

DATE	REVISIONS DESCRIPTION



DRMP, Inc.  
2111 Thomas Drive, Suite 1  
Panama City Beach, FL 32408  
Phone: (850) 387-1262 Fax: (850) 459-9073  
John Magrath, P.E. License No. 48166


STATE OF FLORIDA  
DEALOOSA COUNTY  
CURB RAMPS AND  
ADA IMPROVEMENTS

**INTERSECTION 19**

SHEET NO.  
1 19

THE OFFICIAL RECORD OF THIS SHEET IS THE ELECTRONIC FILE DIGITALLY SIGNED AND SEALED UNDER RULE 61G15-23.004, F.A.C.



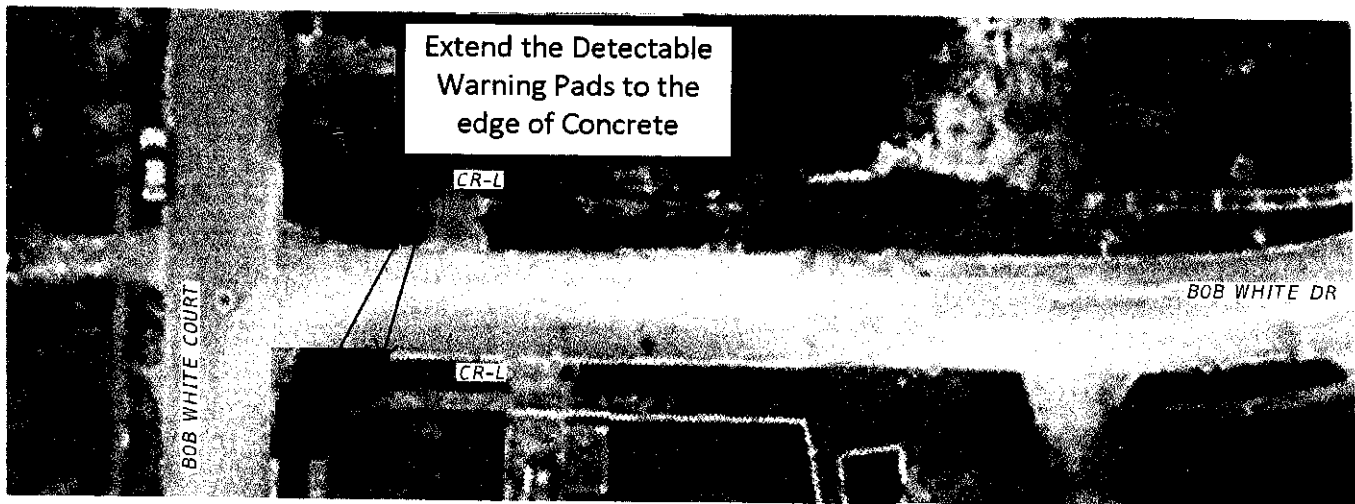


Extend the Detectable Warning Pads to the edge of Concrete

CR-L

BOB WHITE COURT

BOB WHITE DR

CR-L

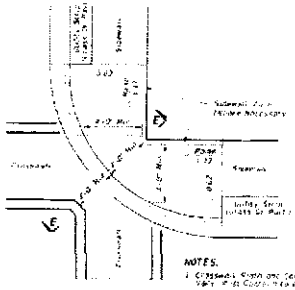


PLAN VIEW

- NOTES:
1. Crosswalk Signs and Signals shall be as shown on the Plans.
  2. The Ramp Slopes shall be as shown on the Plans.
  3. All ADA/ADAAG requirements for sidewalk and curb construction shall be as shown on the Plans.

**CONSTRUCTION NOTES:**

1. MAINTAIN A SINGLE LONGITUDINAL SLOPE ALONG EACH SIDE OF THE CURB RAMP. RAMP SLOPES SHALL BE A MINIMUM OF 10 FEET AND MAXIMUM OF 15 FEET IN LENGTH, UNLESS OTHERWISE NOTED. REMOVE AND REPLACE EXISTING CURB, CURB AND GUTTER, OR SIDEWALK TO THE NEAREST JOINT OR TO THE EXTENT THAT NO REMAINING SECTION IS LESS THAN 5 FEET LONG.
2. RAMP SLOPES SHALL BE A MINIMUM OF 2% AND MAXIMUM OF 8%.
3. FOR CONSTRUCTION REQUIREMENTS, SEE SHEET RR 1. THESE REQUIREMENTS WILL DICTATE THE LIMITS OF CONSTRUCTION, FINAL CURB RAMP TYPE, ELEVATIONS, AND CURB RAMP ALIGNMENT & PLACEMENT.
4. SEE STANDARD DETAIL SHEETS FOR MORE INFORMATION.

SUMMARY OF PAY ITEMS			
ITEM NO.	DESCRIPTION	UNIT	QUANTITY
1	CONCRETE SIDEWALKS AND DRIVEWAYS (INCLUDING CURBING AND CURBS) AND EXISTING CONCRETE AND ASPHALT EXCAVATION (WASH DISBURS)	SY	75
2	CONCRETE CURB AND GUTTER (ALL TYPES) (MATCH EXISTING)	LF	64
3	DETECTABLE WARNING	SF	55

DATE	REVISION DESCRIPTION		DPHP, Inc. 2113 Thermal Drive, Suite 1 Panama City Beach, FL 32408 Phone: (904) 367-1262 Fax: (904) 664-4171 John Waples, P.E. License No. 48166	STATE OF FLORIDA DEKALB COUNTY	<b>INTERSECTION 21</b>	SHEET NO.
				CURB RAMPS AND ADA IMPROVEMENTS		121

Extend the Detectable Warning Pad to the edge of Concrete (Both Sides).

12" WHITE @ 6'  
24" PREFORMED WHITE  
(SPACING PER INDEX  
711-001 SHEET SD 2)

REMOVE EXIST. SIGN & POST  
CONSTRUCT 50 LF OF 5'  
SIDEWALK TO MATCH EXIST.

REMOVE EXIST. ASPH.  
SIDEWALK AND RAMP

REMOVE EXIST. STOP BAR

INSTALL SOD TO STABILIZE SLOPE AND ALLOW FOR  
POSITIVE DRAINAGE TOWARDS EXISTING INLET

EXTEND DBL. YELLOW TO STOP BAR

HOLLY AVENUE

24" WHITE


REMOVE EXIST.  
CROSSWALK MARKING

POQUITO  
ROAD

FLUSH WITH  
EDGE OF  
PAVEMENT

0.02 MAX. 0.02 MAX.

FLUSH  
WITH EDGE  
OF CONSTR.  
SIDEWALK

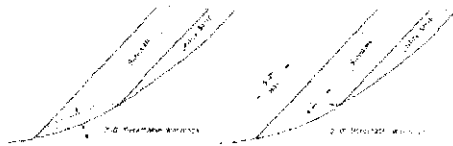

OPTION A

OPTION B

CONSTRUCTION NOTES:

1. MAINTAIN A SINGLE LONGITUDINAL SLOPE ALONG EACH SIDE OF THE CURB RAMP. RAMP SLOPES SHALL BE A MINIMUM OF 10 FEET AND MAXIMUM OF 15 FEET IN LENGTH, UNLESS OTHERWISE NOTED. REMOVE AND REPLACE EXISTING CURB, CURB AND GUTTER, OR SIDEWALK TO THE NEAREST JOINT OR TO THE EXTENT THAT NO REMAINING SECTION IS LESS THAN 5 FEET LONG.

2. RAMP SLOPES SHALL BE A MINIMUM OF 2% AND MAXIMUM OF 8%.

3. FOR CONSTRUCTION REQUIREMENTS, SEE SHEET RR 1. THESE REQUIREMENTS WILL DICTATE THE LIMITS OF CONSTRUCTION, FINAL CURB RAMP TYPE, ELEVATIONS, AND CURB RAMP ALIGNMENT & PLACEMENT.

4. SEE STANDARD DETAIL SHEETS FOR MORE INFORMATION.

SUMMARY OF PAY ITEMS			
ITEM NO.	DESCRIPTION	UNIT	QUANTITY
1	THERMOPLASTIC PAVEMENT MARKINGS (BOLD WHITE & YELLOW)	LF	420
2	CONCRETE SIDEWALKS AND DRIVEWAYS (INCLUDING CLEARING AND GRUBBING AND EXISTING REPAIR, REMOVAL OF EXISTING CONCRETE AND ASPHALT EXCAVATION, REINFORCING)	SF	90
3	DETECTABLE WARNING	SF	10
4	THERMOPLASTIC MARKING REMOVAL	SF	150

REVISIONS	
DATE	DESCRIPTION



DAMP, Inc.  
2111 Thomas Drive, Suite 1  
Pompano City Beach, FL 33068  
Phone: (954) 287-1767 Fax: (954) 859-9073  
1876 Knightwood, P.O. Box 40326


STATION OF PROJECT  
ON FLORIDA COUNTY

CURB RAMP AND  
ADA IMPROVEMENTS

INTERSECTION 18

SHEET NO.


1 18

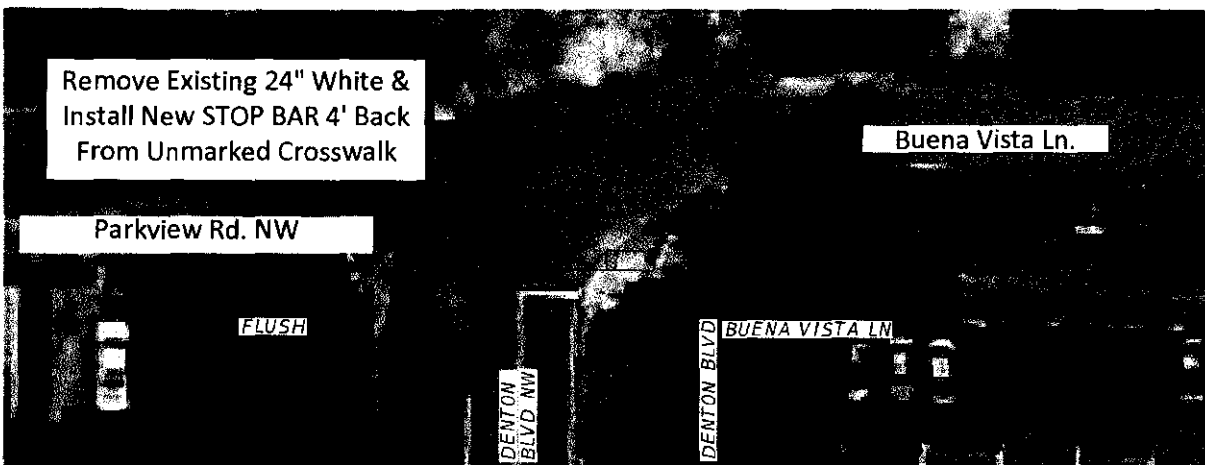


**CONSTRUCTION NOTES:**

1. MAINTAIN A SINGLE LONGITUDINAL SLOPE ALONG EACH SIDE OF THE CURB RAMP. RAMP SLOPES SHALL BE A MINIMUM OF 10 FEET AND MAXIMUM OF 15 FEET IN LENGTH, UNLESS OTHERWISE NOTED. REMOVE AND REPLACE EXISTING CURB, CURB AND GUTTER, OR SIDEWALK TO THE NEAREST JOINT OR TO THE EXTENT THAT NO REMAINING SECTION IS LESS THAN 5 FEET LONG.
2. RAMP SLOPES SHALL BE A MINIMUM OF 2% AND MAXIMUM OF 8%.
3. FOR CONSTRUCTION REQUIREMENTS, SEE SHEET RR 1. THESE REQUIREMENTS WILL DICTATE THE LIMITS OF CONSTRUCTION, FINAL CURB RAMP TYPE, ELEVATIONS, AND CURB RAMP ALIGNMENT & PLACEMENT.
4. SEE STANDARD DETAIL SHEETS FOR MORE INFORMATION.

PAY ITEMS			
ITEM NO.	DESCRIPTION	UNIT	QTY
1	THERMOPLASTIC PAVEMENT MARKINGS (ISOLATED)	LF	13
2	CONCRETE SIDEWALKS AND DRIVEWAYS INCLUDING LEARNING AND CURBING AND EARTHWORK (REMOVAL OF EXISTING CONCRETE AND ASPHALT EXCAVATION, SUBSEQUENT REPAIR)	SY	12
3	DETECTABLE MARKINGS	SF	16
4	REMOVAL OF THERMOPLASTIC PAVEMENT MARKINGS (ISOLATED)	SF	26

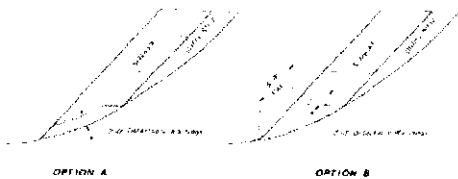

DATE	REVISIONS DESCRIPTION		D&M, Inc. 2111 Magnolia Drive, Suite 1 Panama City Beach, FL 32408 Phone: (904) 267-1767 Fax: (904) 468-0072 Info: Appleman, P.E. License No. 48166	STATE OF FLORIDA DADE COUNTY	CURB RAMPS AND ADA IMPROVEMENTS	<b>INTERSECTION 2</b>	SHEET NO. 12
------	--------------------------	---	---	---------------------------------	------------------------------------	-----------------------	--------------------

THE OFFICIAL RECORD OF THIS SHEET IS THE ELECTRONIC FILE DIGITALLY SIGNED AND SEALED UNDER RULE 61G15-23.004, F.A.C.

**PROJECT NAME: OKALOOSA COUNTY SIDEWALK RAMPS IMPROVEMENTS**

**BASIS OF BID**

ITEM NO.	DESCRIPTION	UNIT	QTY	UNIT PRICE	AMOUNT
1	THERMOPLASTIC PAVEMENT MARKINGS (SOLID)	LF	941		
2	THERMOPLASTIC PAVEMENT MARKINGS (MESSAGE)	EA	1		
3	U-CHANNEL POST	EA	17		
4	STOP SIGN, R1-1, 30"X 30"	EA	9		
5	SCHOOL CROSSWALK, YELLOW, S1-1, 36" X 36"	EA	4		
6	CROSSWALK WARNING, W11-2, 30"X 30"	EA	2		
7	ARROW PLAQUE, YELLOW, W16-7, 24" X 12"	EA	2		
8	AHEAD PLAQUE, YELLOW, W16-9P, 36" X 12"	EA	4		
9	ALL-WAY PLAQUE, R01-04, 30"X 12"	EA	2		
10	SIGN RELOCATE	EA	4		
11	SIGN REMOVAL	EA	4		
12	CONCRETE SIDEWALKS AND DRIVEWAYS (INCLUDING CLEARING AND GRUBBING AND EARTHWORK IE. REMOVAL OF EXISTING CONCRETE AND ASPHALT, EXCAVATION, ROUGH GRADING)	SY	5.33	63.00	336.00
13	CONCRETE CURB AND GUTTER (ALL TYPES) (MATCH EXISTING)	LF	20	21.00	420.00
14	DETECTABLE WARNINGS	SF	104	22.00	2288.00
15	REMOVAL OF THERMOPLASTIC PAVEMENT MARKINGS (SOLID)	SF	180		
16	15" ADS PIPE WITH MES	LF	20		
17	SOD	LS	1		
18	MOBILIZATION	LS	1	1200.00	1200.00
19	MAINTENANCE OF TRAFFIC	LS	1		
20	EROSION AND SEDIMENT CONTROL (INCLUDING BUT NOT LIMITED TO SILT FENCE, HAY BALES, SOIL TRACKING PREVENTION DEVICE, SEDIMENT BARRIER, INLET PROTECTION)	LS	1		

CONSTRUCTION TOTAL \$ 4,244.00 *PTH*

*Peter T Harris*  
 Peter T Harris - INMAN