



ADDENDUM NO. 1

Issue Date: February 10, 2023
Project Name: Engineering Consulting Services for Landfill Closure, Landfill Gas System Expansion and Cell Construction
RFQ Number: 2023031
RFQ Opening Date: February 23, 2023


This addendum is being released to answer questions received to date. Duplicate questions may not receive a direct response. The information and documents contained in this addendum are hereby incorporated in the RFQ. This addendum must be acknowledged where indicated on the firm information form, or the SOQ may be declared non-responsive.

Attachments

SWDD Landfill Development Plan


Questions and Answers

- The cover page indicates that the submittal for this RFQ will be one electronic copy as a single PDF by email to purchasing@ircgov.com. This is reiterated under “Submittal Instructions” section on page 6 and “Submission” subsection of “General Instructions” on page 8 of the RFQ. However, there is a subsection on “Sealed Submittals and Envelope Markings”, also on page 8 of the RFQ, which says that all responses shall be submitted in a sealed envelope or box. Please confirm if printed hard copy of submittal will be needed.**
- We are only accepting electronic copies for this RFQ.
- 1. The IRCL Development Plan that shows the current and future permitted improvements was not attached in the RFQ. Please provide a copy.**
Please see attachment.

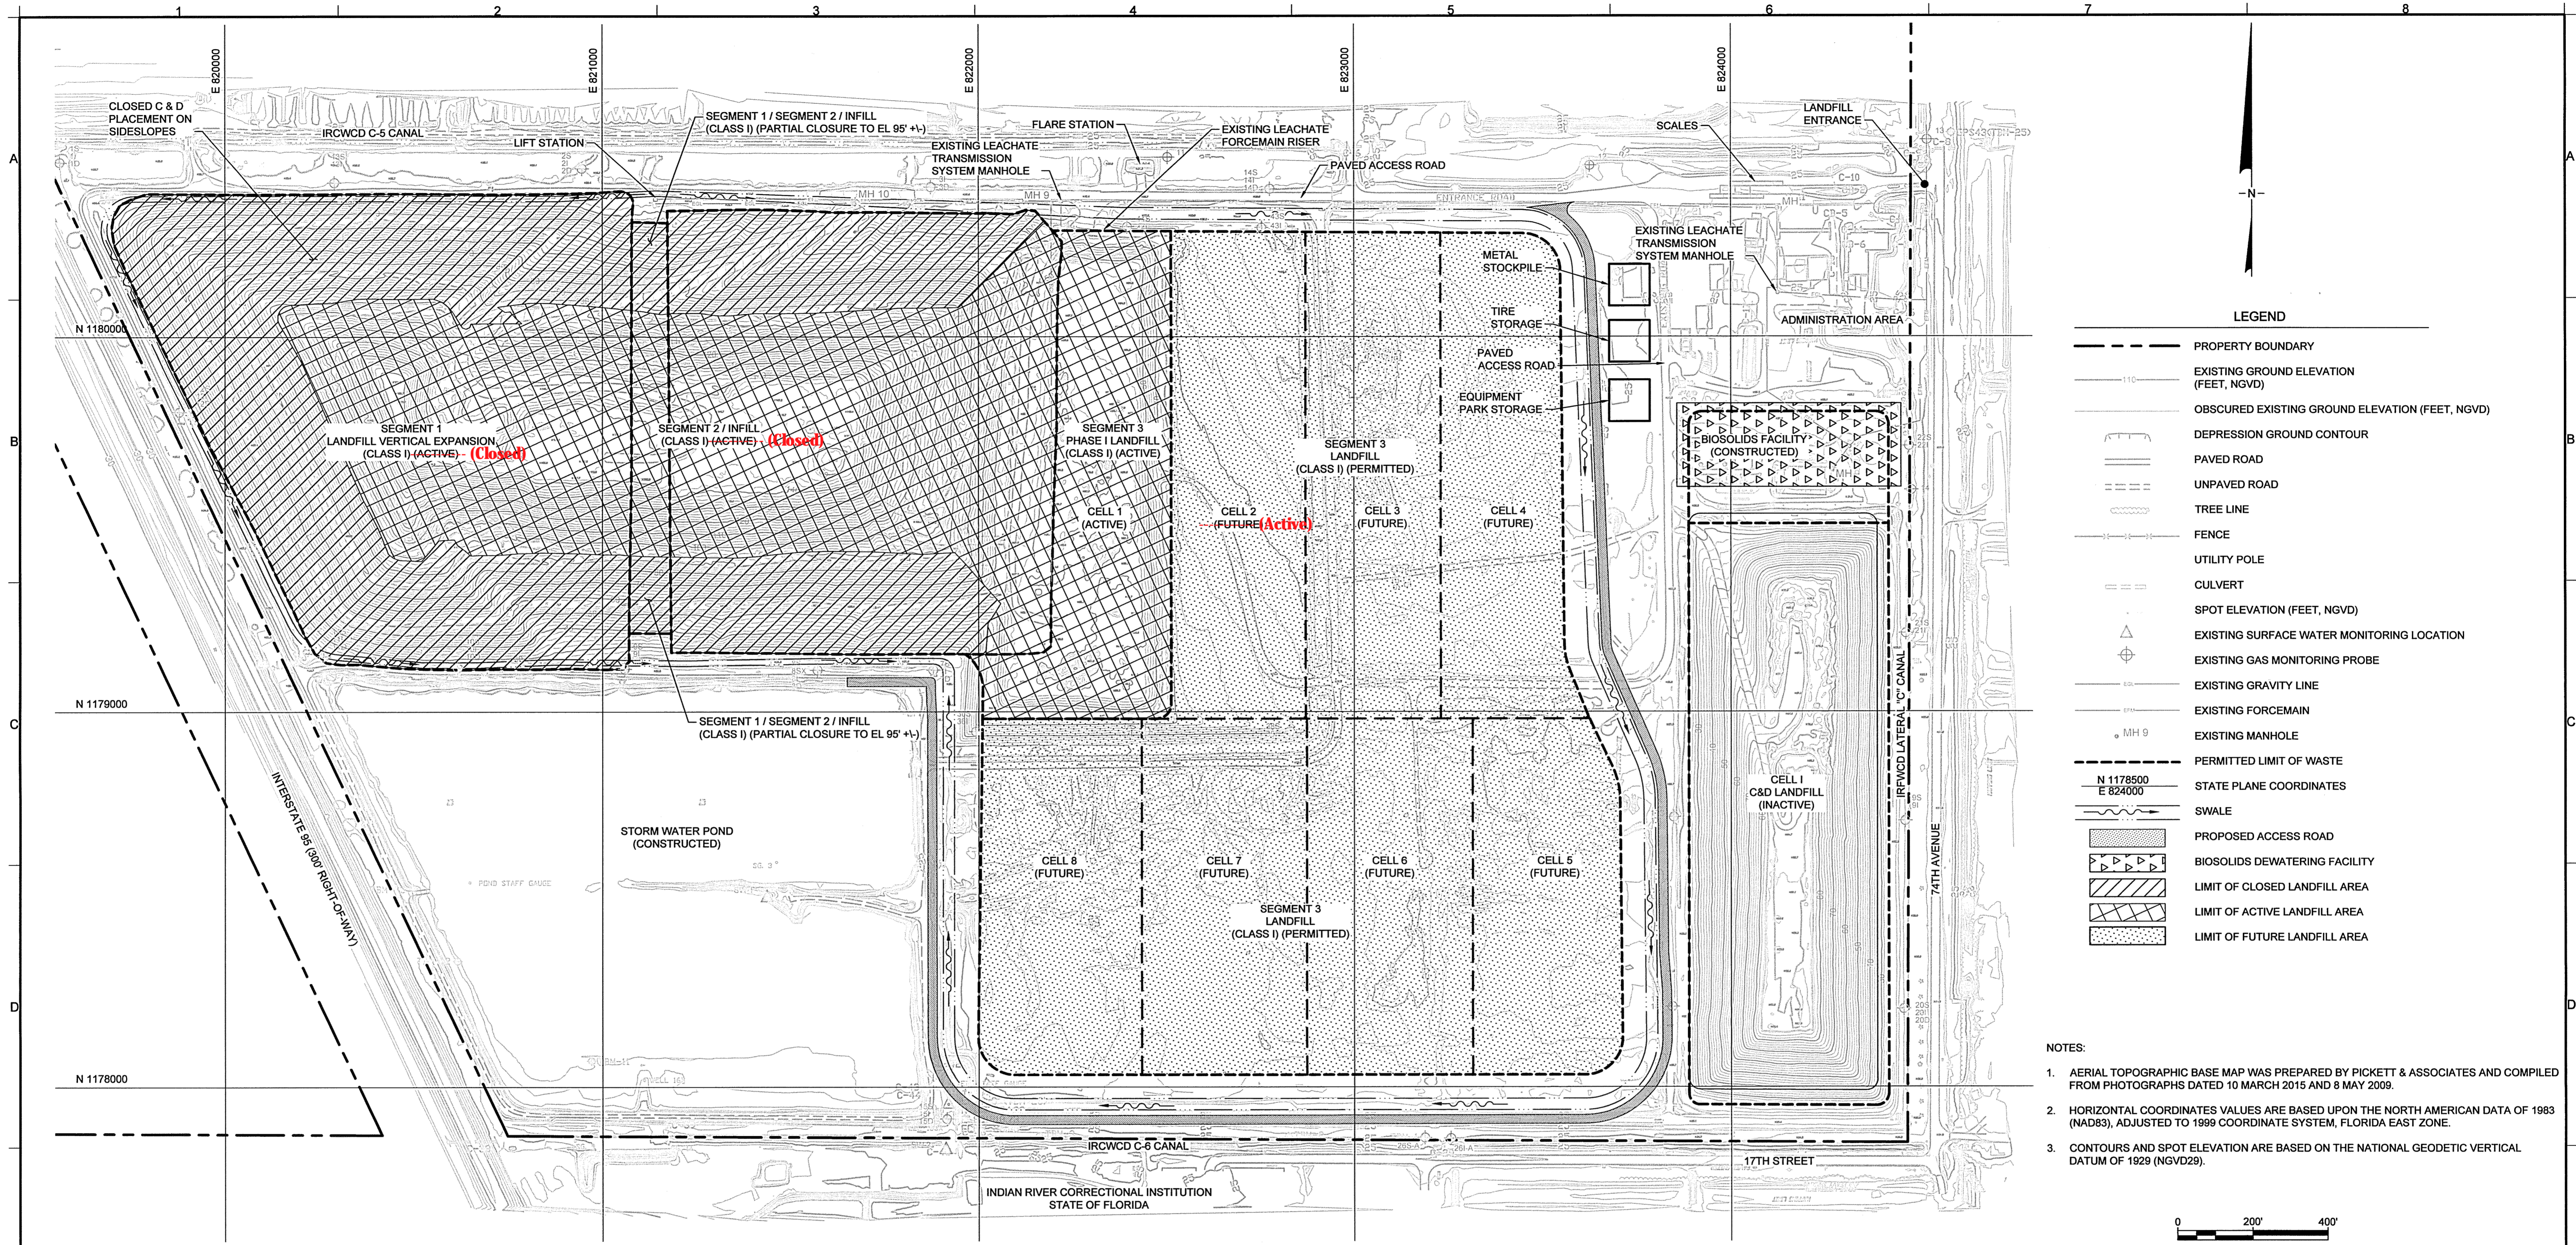

- LEGEND**
- PROPERTY BOUNDARY
 - EXISTING GROUND ELEVATION (FEET, NGVD)
 - OBSCURED EXISTING GROUND ELEVATION (FEET, NGVD)
 - DEPRESSION GROUND CONTOUR
 - PAVED ROAD
 - UNPAVED ROAD
 - TREE LINE
 - FENCE
 - UTILITY POLE
 - CULVERT
 - SPOT ELEVATION (FEET, NGVD)
 - EXISTING SURFACE WATER MONITORING LOCATION
 - EXISTING GAS MONITORING PROBE
 - EXISTING GRAVITY LINE
 - EXISTING FORCEMAIN
 - MH 9 EXISTING MANHOLE
 - PERMITTED LIMIT OF WASTE
 - STATE PLANE COORDINATES
 - SWALE
 - PROPOSED ACCESS ROAD
 - BIOSOLIDS DEWATERING FACILITY
 - LIMIT OF CLOSED LANDFILL AREA
 - LIMIT OF ACTIVE LANDFILL AREA
 - LIMIT OF FUTURE LANDFILL AREA

- NOTES:**
1. AERIAL TOPOGRAPHIC BASE MAP WAS PREPARED BY PICKETT & ASSOCIATES AND COMPILED FROM PHOTOGRAPHS DATED 10 MARCH 2015 AND 8 MAY 2009.
 2. HORIZONTAL COORDINATES VALUES ARE BASED UPON THE NORTH AMERICAN DATA OF 1983 (NAD83), ADJUSTED TO 1999 COORDINATE SYSTEM, FLORIDA EAST ZONE.
 3. CONTOURS AND SPOT ELEVATION ARE BASED ON THE NATIONAL GEODETIC VERTICAL DATUM OF 1929 (NGVD29).

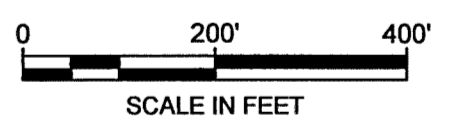

I:\CADD PROJECTS\INDIAN RIVER COUNTY LANDFILL\PERMITS\SOLID WASTE PERMIT REVIEW\FL2523\DWG\SP4_2523P4

0	SEP 2015	ISSUED PER FDEP APPROVAL	CMV	KBT
REV	DATE	DESCRIPTION	DRN	APP

Geosyntec
consultants

1200 RIVERPLACE BOULEVARD, SUITE 710
JACKSONVILLE, FLORIDA 32207 USA
PHONE: 904.858.1818 - FAX: 904.396.1143
CERTIFICATE OF AUTHORIZATION NO. 4321

1325 74th AVENUE SW
VERO BEACH, FLORIDA 32968 USA
PHONE: 772.770.5112

TITLE: SITE DEVELOPMENT PLAN - SEGMENT 3 EXPANSION

PROJECT: 20-YEAR RENEWAL PERMIT APPLICATION FOR A CLASS I LANDFILL

SITE: INDIAN RIVER COUNTY LANDFILL

THIS DRAWING MAY NOT BE ISSUED FOR PROJECT TENDER OR CONSTRUCTION, UNLESS SEALIZED

Kwasi Badu-Tweneboah
SIGNATURE
9/23/15
DATE

KWASI BADU-TWENEBOAH
LICENSE NO. 42460
STATE OF FLORIDA
PROFESSIONAL ENGINEER

DESIGN BY:	AR	DATE:	SEPTEMBER 2015
DRAWN BY:	CMV	PROJECT NO.:	FL2523
CHECKED BY:	KBT	FILE:	FL2523P04
REVIEWED BY:	CRB	DRAWING NO.:	
APPROVED BY:	KBT		4 OF 31

PERMIT DRAWING