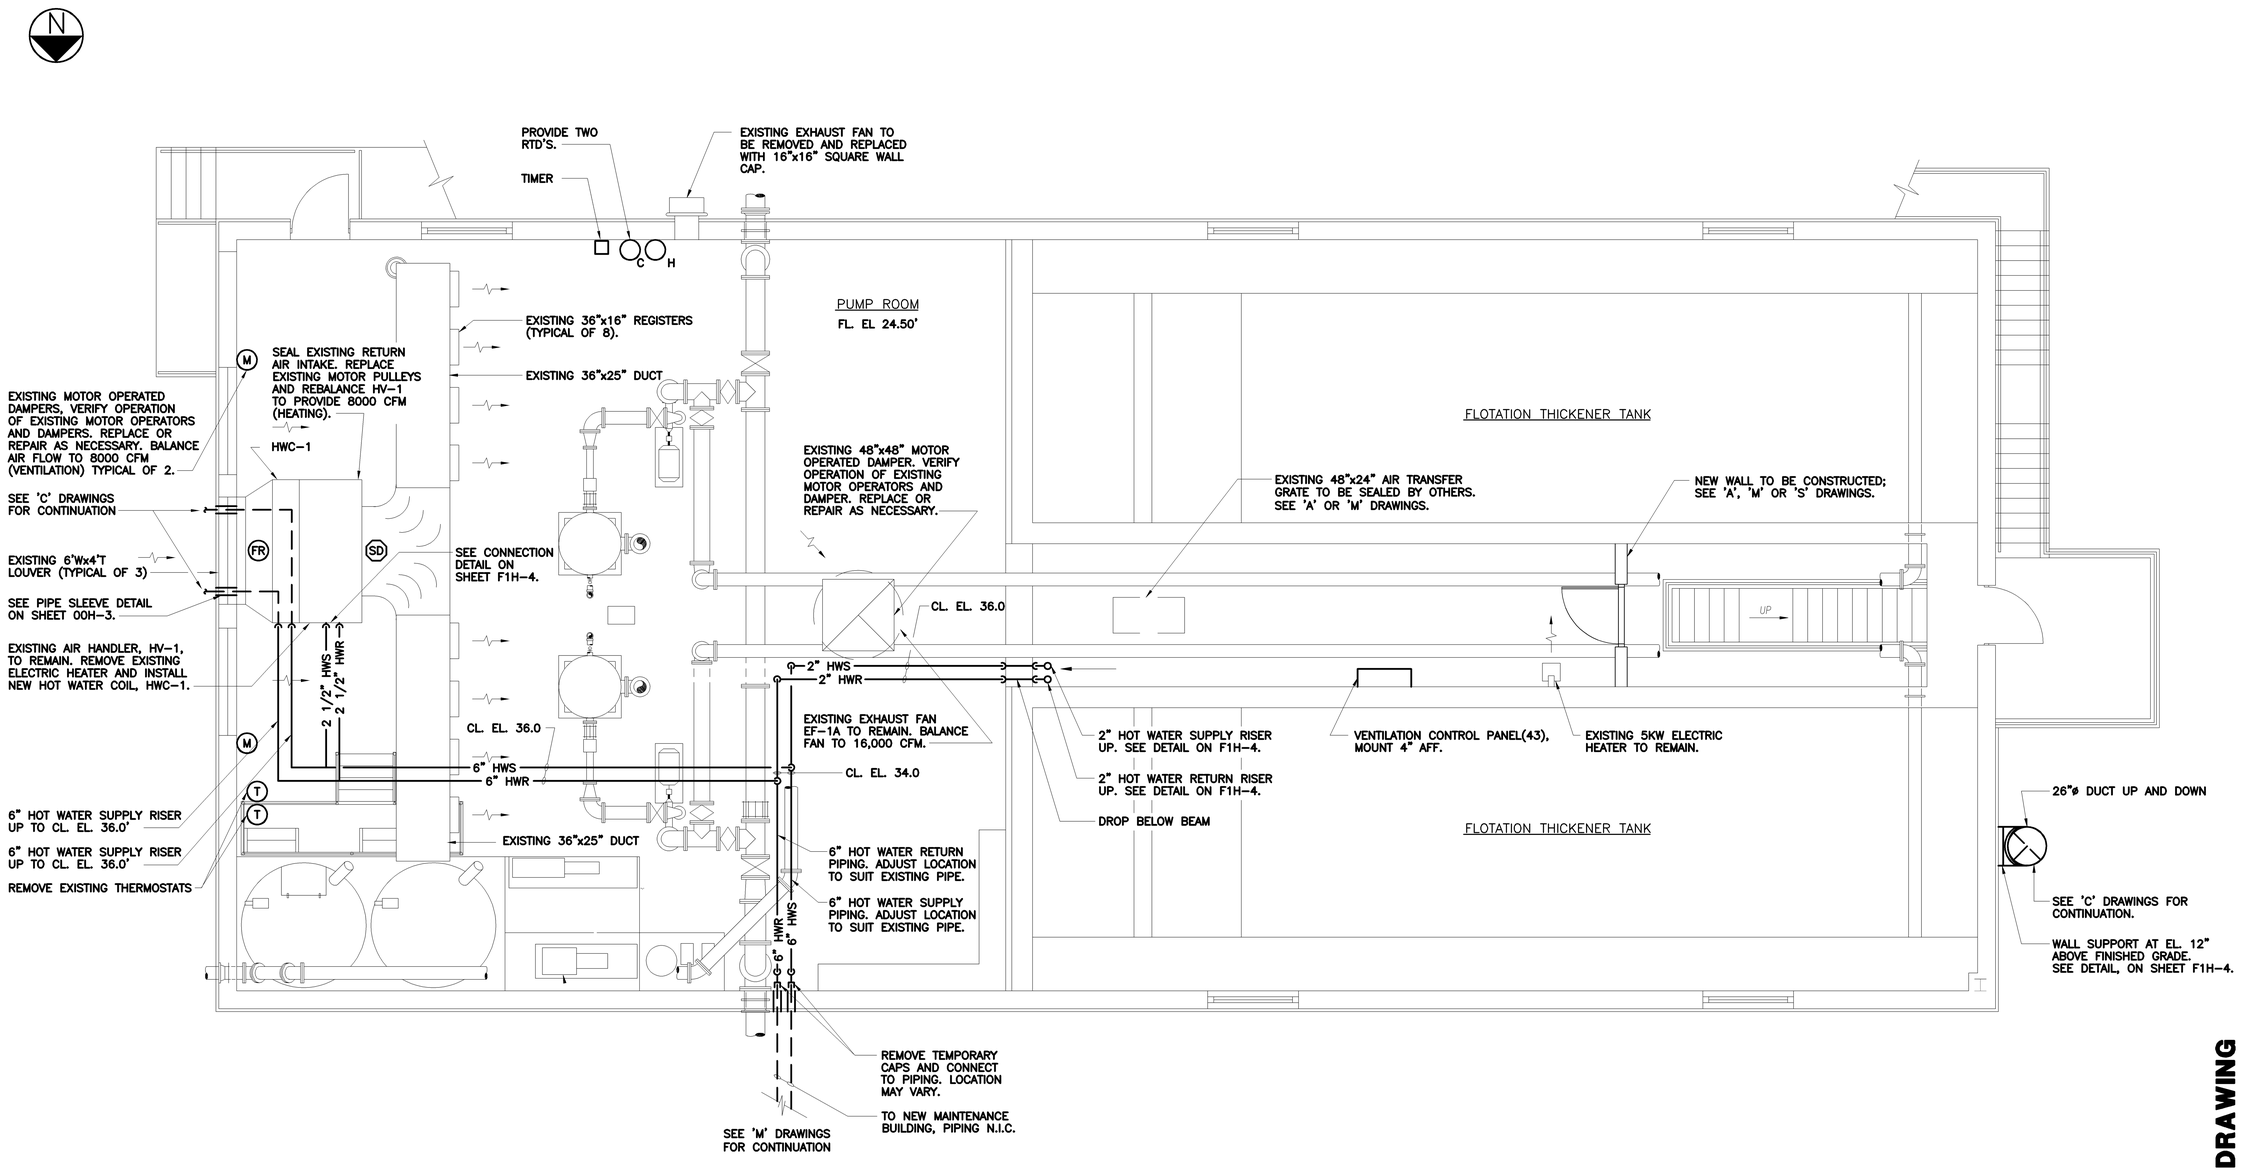

PLAN
SCALE: 1/4"=1'-0"

NO.	DATE	DRWN	CHK'D	DESCRIPTION
1	9/97	FXP	ASG	RECORD DRAWING

REVISIONS

DESIGNED BY: WRH
DRAWN BY: RMM,SFP
CHECKED BY/DATE: WRH/9-91
APPRV'D BY/DATE: WRH/9-91

CAMP DRESSER & McKEE

THIS DRAWING HAS BEEN REVISED BY HAZEN AND SAWYER, P.C. TO REFLECT MODIFICATIONS MADE DURING CONSTRUCTION

environmental engineers, scientists, planners, & management consultants CDM

ARLINGTON COUNTY, VIRGINIA
WATER POLLUTION CONTROL PLANT
UPGRADE AND EXPANSION- PHASE IIB

FLOTATION THICKNENER
HVAC
LOWER LEVEL PLAN

SCALE NOTE
SCALE BAR SHOWN BELOW IS ONE INCH LONG ON A FULL SIZE DRAWING. WHEN SCALING DRAWINGS, MEASURE BAR TO DETERMINE IF SCALES SHOWN WILL REQUIRE ADJUSTING.
ONE INCH

RECORD DRAWING


YEAR 1991
LOCATION CODE F1
SPECIALTY CODE H
PROJECT NO. 5002-33
FILE NAME F1H1.DWG
DRAWING NO. F1H-1
SHEET NO. 123