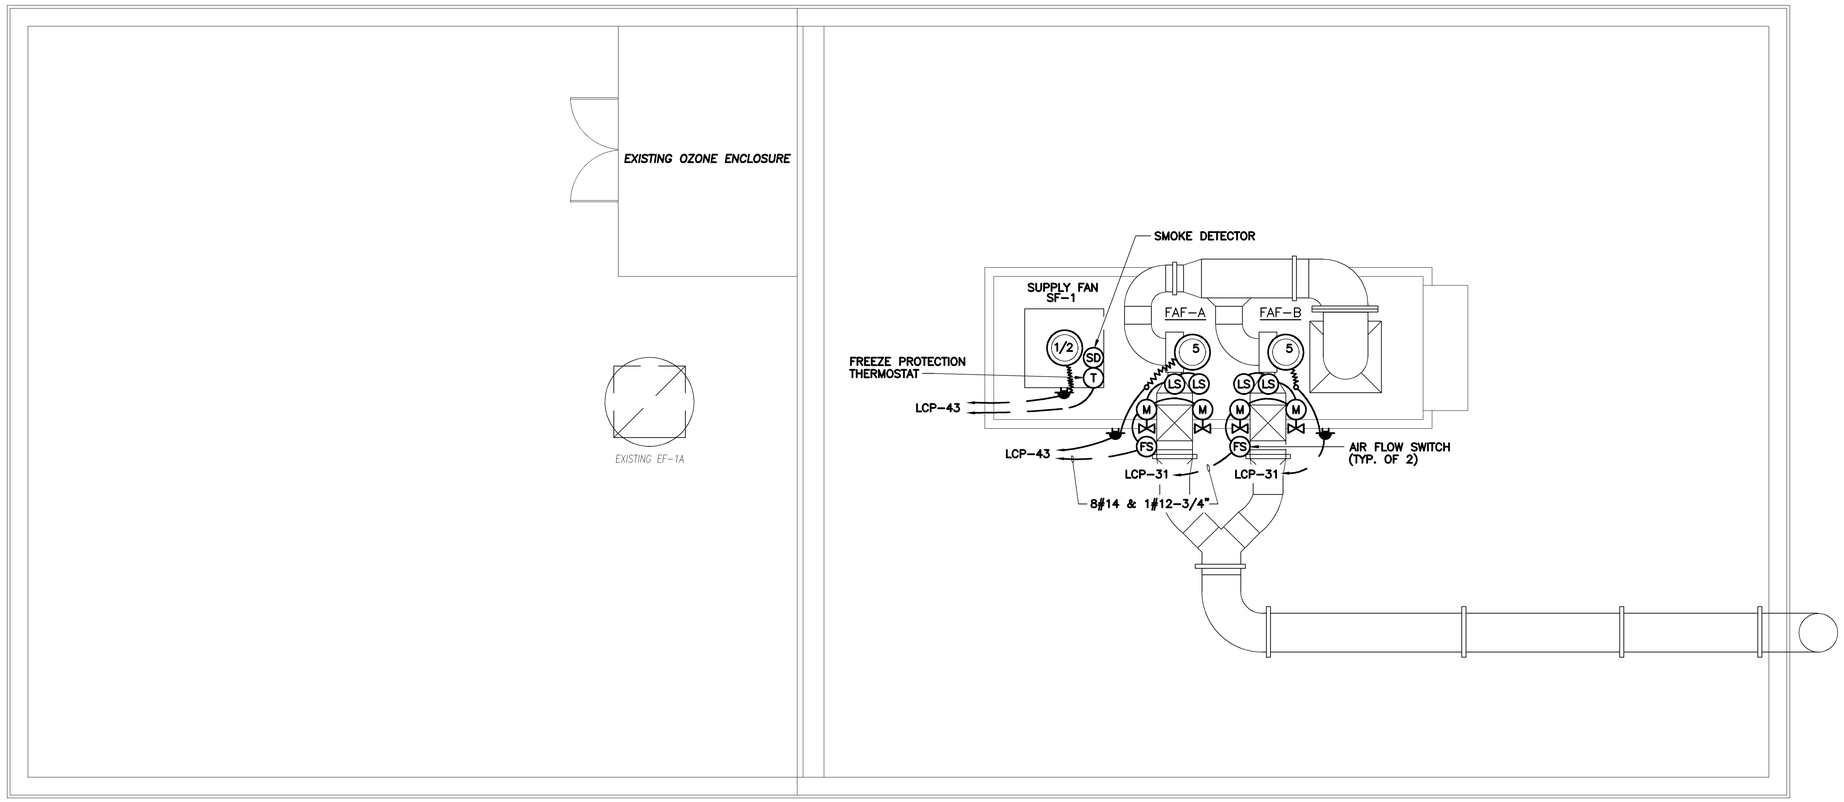

PLAN

SCALE: 1/4"=1'

RECORD DRAWING

C.E. BAILEY & ASSOCIATES, INC.
CONSULTING ENGINEERS
ORLANDO, CLEARWATER &
FORT LAUDERDALE, FLORIDA

NO.	DATE	DRWN	CHK'D	DESCRIPTION
1	9/97	FXP	ASG	RECORD DRAWING

REVISIONS

DESIGNED BY: SEB
DRAWN BY: TRH
CHECKED BY/DATE: CEB/9-91
APPRV'D BY/DATE: CEB/9-91

CAMP DRESSER & McKEE

THIS DRAWING HAS BEEN REVISED BY HAZEN AND SAWYER, P.C. TO REFLECT MODIFICATIONS MADE DURING CONSTRUCTION

environmental engineers, scientists, planners, & management consultants CDM

ARLINGTON COUNTY, VIRGINIA
WATER POLLUTION CONTROL PLANT
UPGRADE AND EXPANSION- PHASE B

FLOTATION THICKENER
ELECTRICAL
ROOF PLAN

SCALE NOTE

SCALE BAR SHOWN BELOW IS ONE INCH LONG ON A FULL SIZE DRAWING. WHEN SCALING DRAWINGS, MEASURE BAR TO DETERMINE IF SCALES SHOWN WILL REQUIRE ADJUSTING.

ONE INCH

CONTRACT NO.

YEAR 1991

LOCATION CODE	SPECIALTY CODE
F1	E

PROJECT NO. 5002-33

FILE NAME F1E-0003.DWG

DRAWING NO. F1E-3

SHEET NO. 129