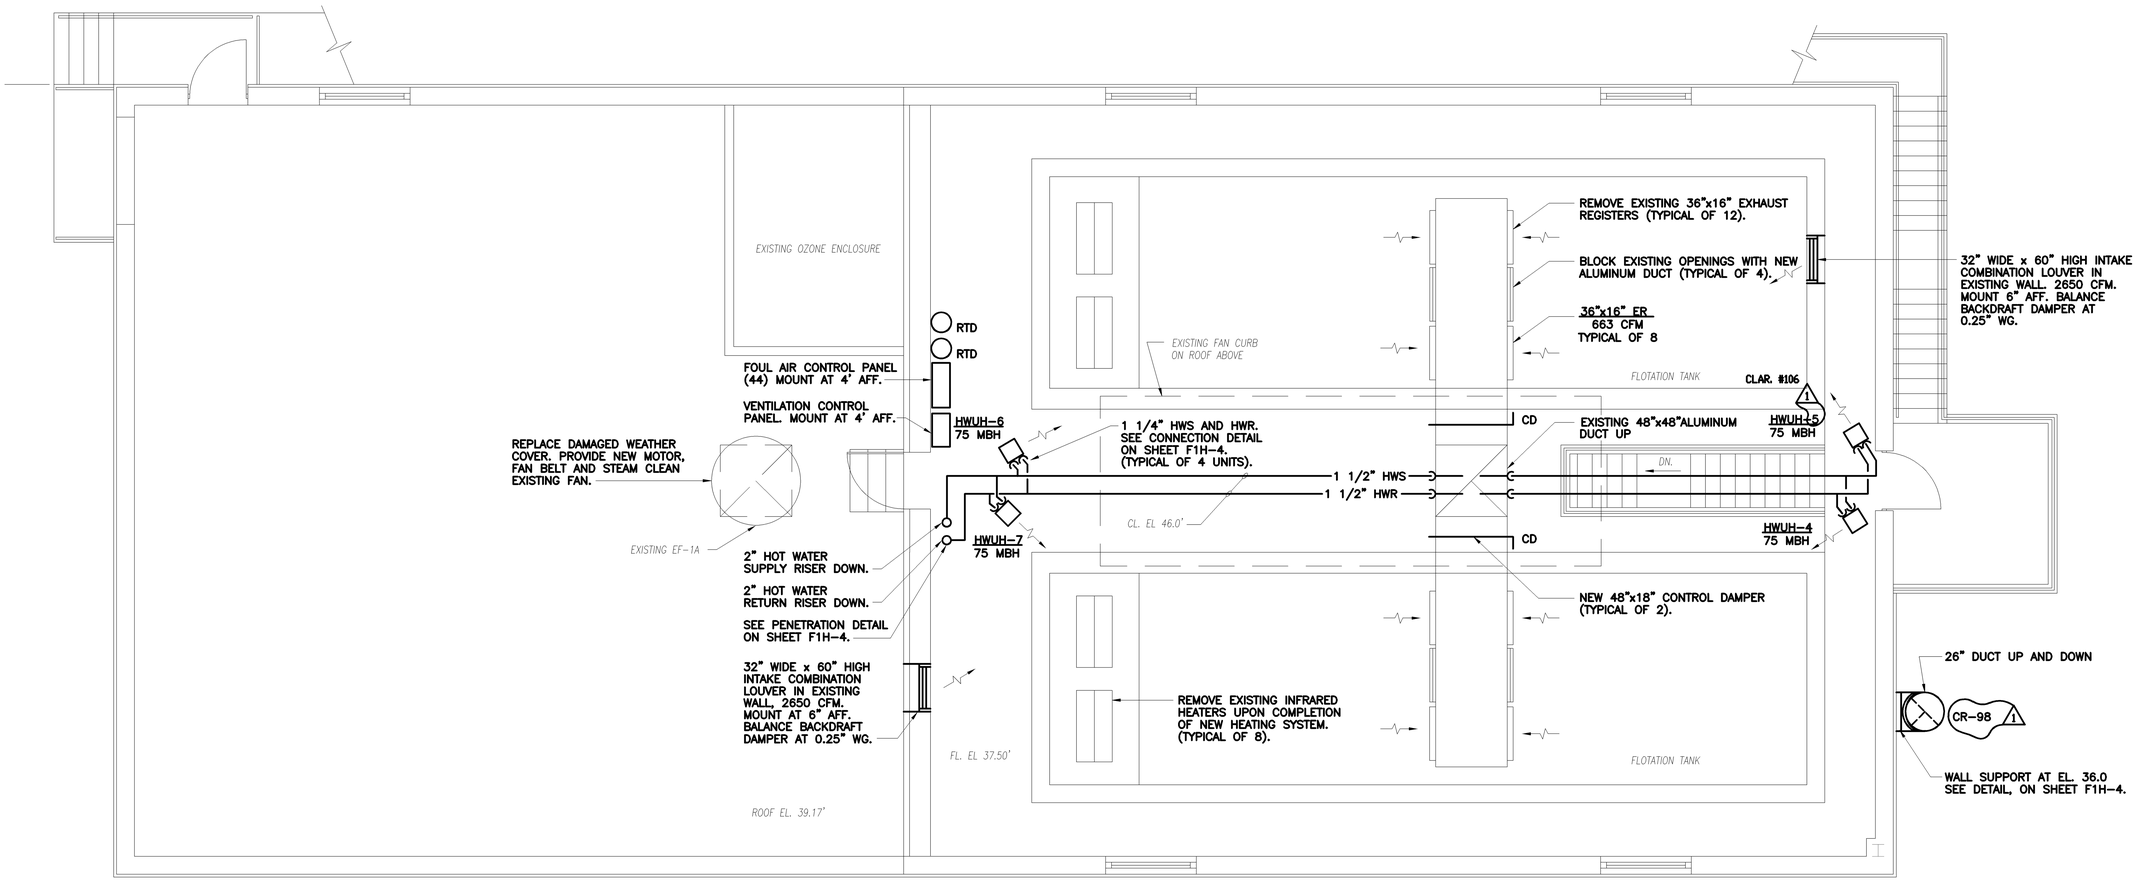

PLAN
SCALE: 1/4"=1'-0"

RECORD DRAWING

C.E. BAILEY & ASSOCIATES, INC.
CONSULTING ENGINEERS
ORLANDO, CLEARWATER & FORT LAUDERDALE, FLORIDA

NO.	DATE	DRWN	CHK'D	DESCRIPTION
1	9/97	FXP	ASG	RECORD DRAWING

REVISIONS

DESIGNED BY: WRH
DRAWN BY: RMM,SFP
CHECKED BY/DATE: WRH/9-91
APPRV'D BY/DATE: WRH/9-91

CAMP DRESSER & McKEE

THIS DRAWING HAS BEEN REVISED BY HAZEN AND SAWYER, P.C. TO REFLECT MODIFICATIONS MADE DURING CONSTRUCTION

environmental engineers, scientists, planners, management consultants CDM

ARLINGTON COUNTY, VIRGINIA
WATER POLLUTION CONTROL PLANT
UPGRADE AND EXPANSION- PHASE IIB

FLOTATION THICKENER
HVAC
UPPER LEVEL PLAN

SCALE NOTE
SCALE BAR SHOWN BELOW IS ONE INCH LONG ON A FULL SIZE DRAWING. WHEN SCALING DRAWINGS, MEASURE BAR TO DETERMINE IF SCALES SHOWN WILL REQUIRE ADJUSTING.
ONE INCH

CONTRACT NO. 000000000
YEAR 1991
LOCATION CODE F1
SPECIALTY CODE H
PROJECT NO. 5002-33
FILE NAME F1H2.DWG
DRAWING NO. F1H-2
SHEET NO. 124