NOTE: ALL COLUMNS AT OFFICE/CLASSROOM AREAS TO BE WRAPPED WITH GYP-BOARD - SEE DETAIL SHEET A-8

NOTE: ALIGN POST FOR CHAIN LINK FENCE WITH EDGE OF STEEL COLUMN AS SHOWN

CHAIN LINK FENCE AND GATE WITH 2-1/2" MIN. DIAMETER POSTS - PROVIDE 5 POSTS ALONG LONG SIDE AND 2 POSTS AT END OF SPACE - EXTEND FENCE FROM FLOOR LEVEL TO A HEIGHT OF 8'-0" A.F.F.

NOTE: ALIGN STEEL STUD WALL WITH EDGE OF STEEL COLUMN AS SHOWN

NOTE: WRAP STEEL COLUMNS WITH GYP-BOARD SEE DETAIL A-8

NOTE: THIS DIMENSION TO INSIDE OF STEEL GIRT WALL

3-5/8" STEEL STUDS AT 16" O.C. ALIGN STUD WALL INSIDE OF GIRT WALL

VERIFY IN FIELD

PROVIDE LINER PANELS WITH CAP TRIM AT SHOP AREA - SEE SECTION 2/A-7

NOTE: AT THIS ROOM TAKE RATED WALLS UP TO ROOF DECK AND SEAL TIGHT AS REQUIRED TO ACHEIVE REQUIRED 2-HOUR RATING

2-HOUR FIRE WALL SEE DETAIL 1/A-5

1-HOUR FIRE WALL

NOTE: CEILING OF THIS ROOM TO HAVE 1-HOUR RATED CEILING SIMILAR TO HALLWAY

LOW 8" BLOCK WALL WITH 6" STEEL STUD WALL ON TOP - SEE SECTION 3/A-5

SEE INTERIOR ELEVATION "A" SHEET A-9

NOTE: DOTTED WALLS INDICATE 1-HOUR FIRE WALL SEE DETAIL 2/A-5

SEE SECTION 1/A-3 FOR BLOCK STEP-OUT DETAIL

CANVAS AWNING

ALIGN WALL WITH COLUMN INSIDE OFFICE AS SHOWN

THIS 7-5 3/8 " DIMENSION IS 7'-4" AS-BUILT

LOW 8" BLOCK WALL WITH 6" STEEL STUD WALL ON TOP - SEE SECTION 3/A-5

NOTE: CEILING OF THIS ROOM TO HAVE 1-HOUR RATED CEILING SIMILAR TO HALLWAY

SEE SHEET A-4 FOR RAMP DETAILS

PROVIDE LINER PANELS WITH CAP TRIM AT SHOP AREA - TOP OF PANEL TO BE 8'-0" A.F.F. - SEE SECTION 2/A-7

EDGE OF DOCK MOUNTED DOCK LEVELER - SEE SPECIFICATIONS

4" X 4'-6" HIGH BOLLARDS

3-5/8" STEEL STUDS AT 16" O.C. ALIGN STUD WALL INSIDE OF GIRT WALL

THIS 7-5 3/8 " DIMENSION IS 7'-2" AS-BUILT

24'-6" | 25'-0" | 25'-0" | 25'-0" | 24'-0" | 1'-0"

125'-0"

F E D C B A

FLOOR PLAN - DIMENSIONS

1/8" = 1'-0"

NOTE: SEE "FLOOR PLAN - CALLS & FINISHES" FOR ROOM NAMES AND NUMBERS AND FOR ADDITIONAL CALLS

NOTE: ALL INTERIOR DIMENSIONS ARE TO EXTERIOR FACE OF BLOCK

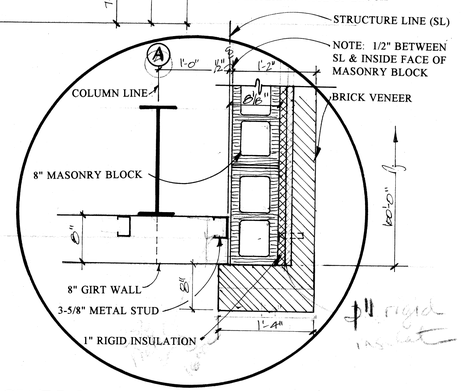

BRICK/BLOCK DETAIL

1" = 1'-0"

SEE DETAIL SHEET A-8 FOR GYP-BOARD WRAPPING AT COLUMNS

Reedy & Sykes
Architecture and Design
613 East Elk Avenue
Elizabethton, Tennessee 37643
(615) 543-4781

No.	Revisions	Dr.	Date

This Drawing is an Instrument of Service and remains the copyrighted property of Reedy & Sykes, Architecture & Design. It shall not be copied, reproduced, or used in any manner without written permission.

TENNESSEE
VOCATIONAL TRAINING CENTER
CHEROKEE INDUSTRIAL PARK
ELIZABETHTON, TENNESSEE

FLOOR PLAN

Pr. No. F03895
Dr. by KPO
Ck. by RER
Date 8/31/95

A-1