
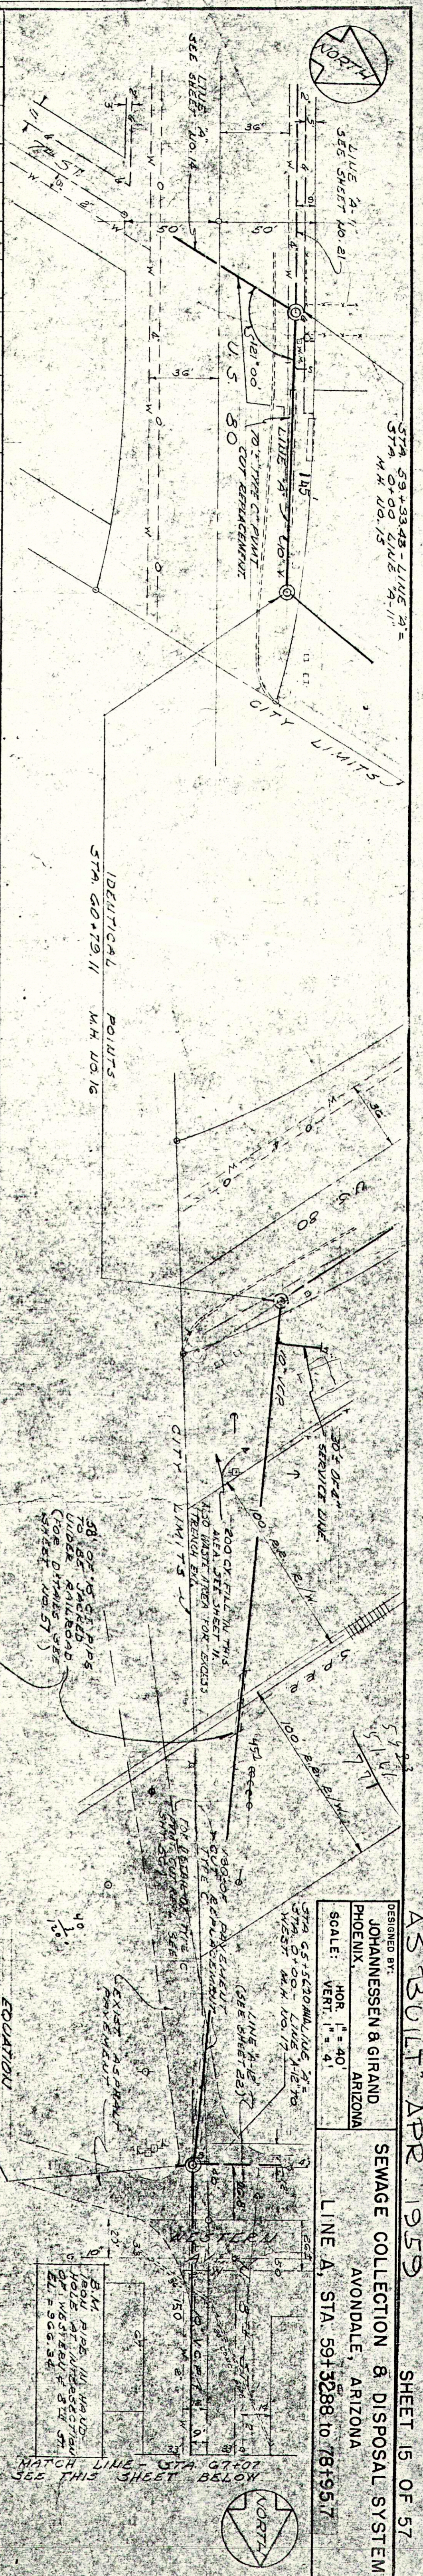
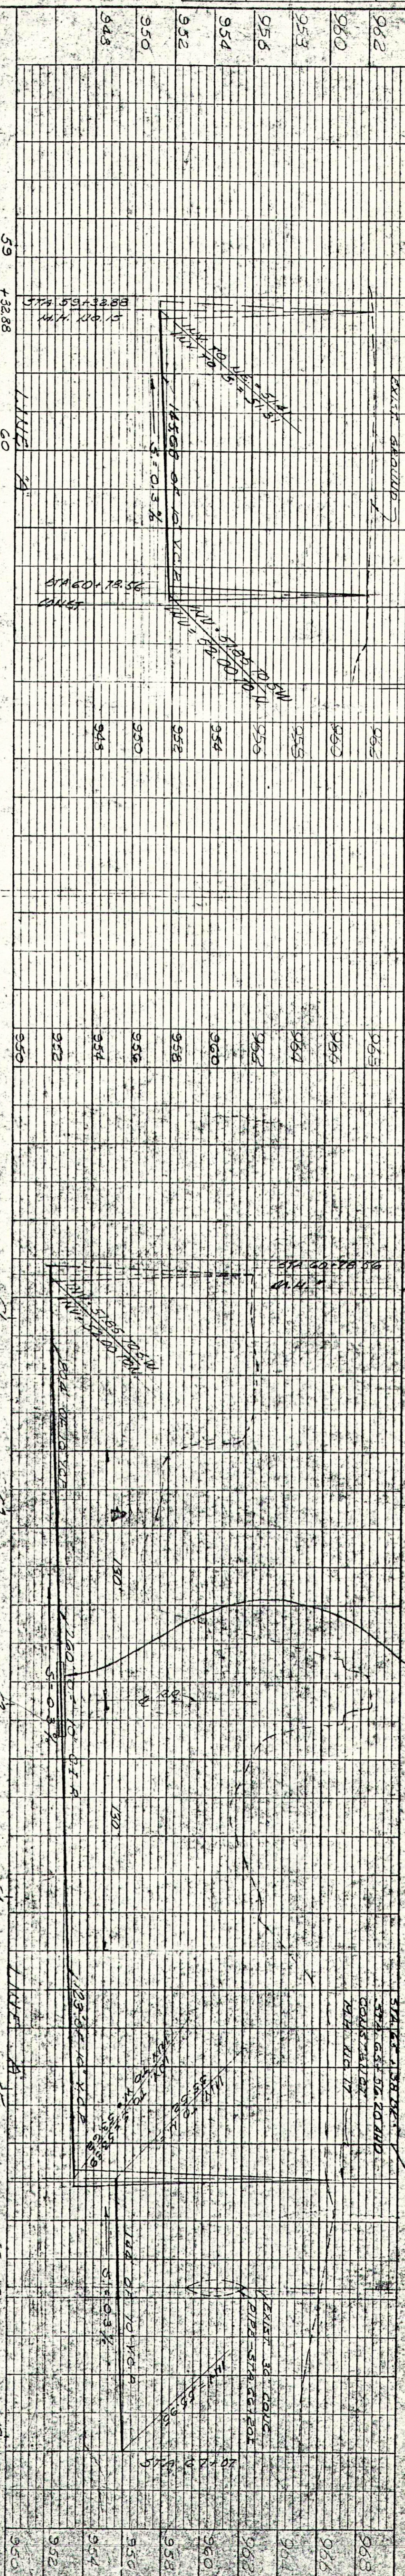


PROFILE	SURVEYED	BY	DATE
NOTE BOOK	PLOTTED		
NO.	GRADES CHECKED		
	BY M. NOTED		
	STRUCTURE NOT AT NSCH'KO		

PLAN	SURVEYED	BY	DATE
NOTE BOOK	PLOTTED		
NO.	ALIGNMENT CHECKED		
	RT. OF WAY CHECKED		

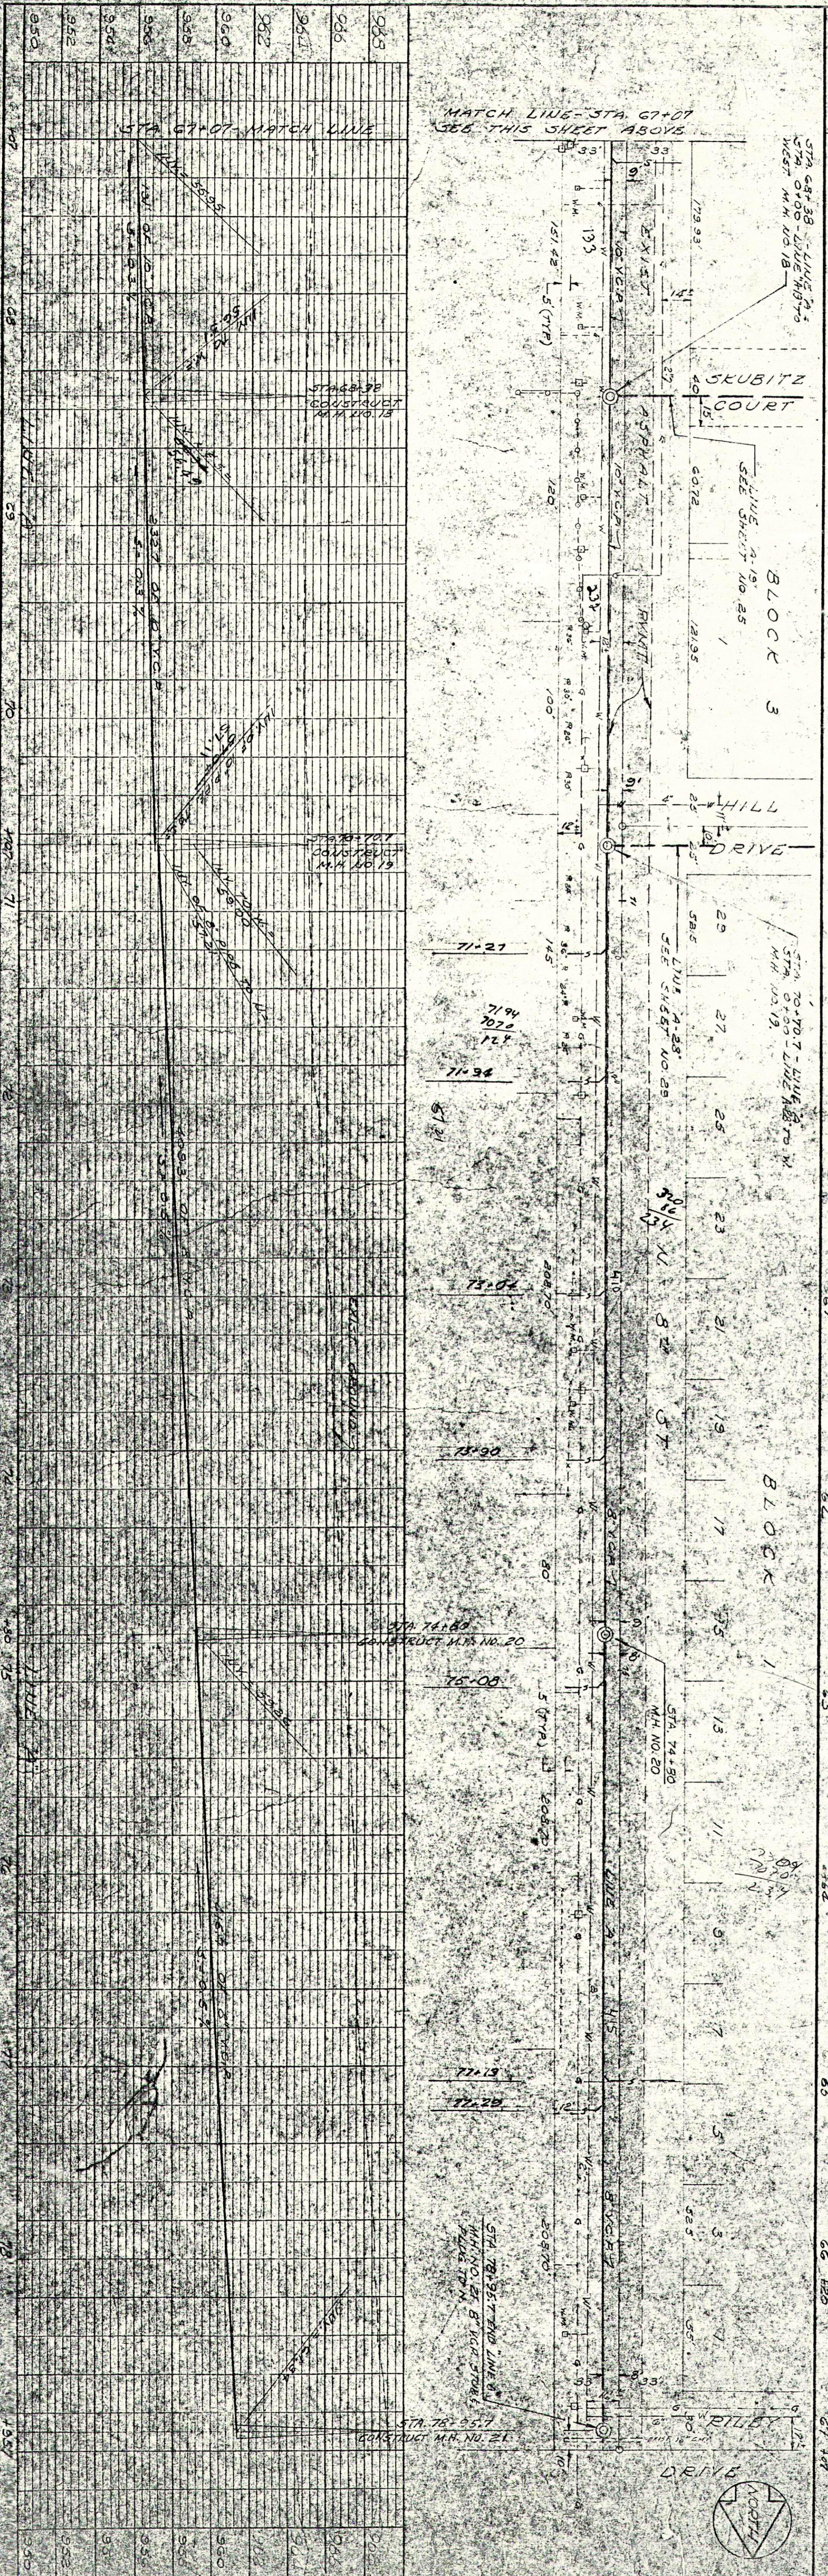

AS BUILT APR 1959 SHEET 15 OF 57  
 DESIGNED BY JOHANNESSEN & GRAND  
 PHOENIX, ARIZONA  
 SCALE: HOR. 1" = 40' VERT. 1" = 4'  
 LINE A, STA. 59+32.88 TO 78+95.7  
 SEWAGE COLLECTION & DISPOSAL SYSTEM  
 AVONDALE, ARIZONA